	•
	INDEX TO DRAWINGS
SHEET NO.	DESCRIPTION
l	TITLE SHEET
2	TYPICAL SECTIONS AND QUANTITY SCHEDULE
3 - 4	PLAN
5-7	PAVEMENT MARKING PLANS AND DETAILS
,	
	· ·





HAWAII

DEPARTMENT OF TRANSPORTATION HIGHWAYS DIVISION

> HONOLULU, HAWAII "AS - BUILT"

PLANS FOR CONSTRUCTION OF


INTERSTATE ROUTE H-1


RESURFACING

WAIAU INTERCHANGE TO HALAWA INTERCHANGE

PROJECT NO. HIE-01-80M

DISTRICT OF EWA ISLAND OF OAHU

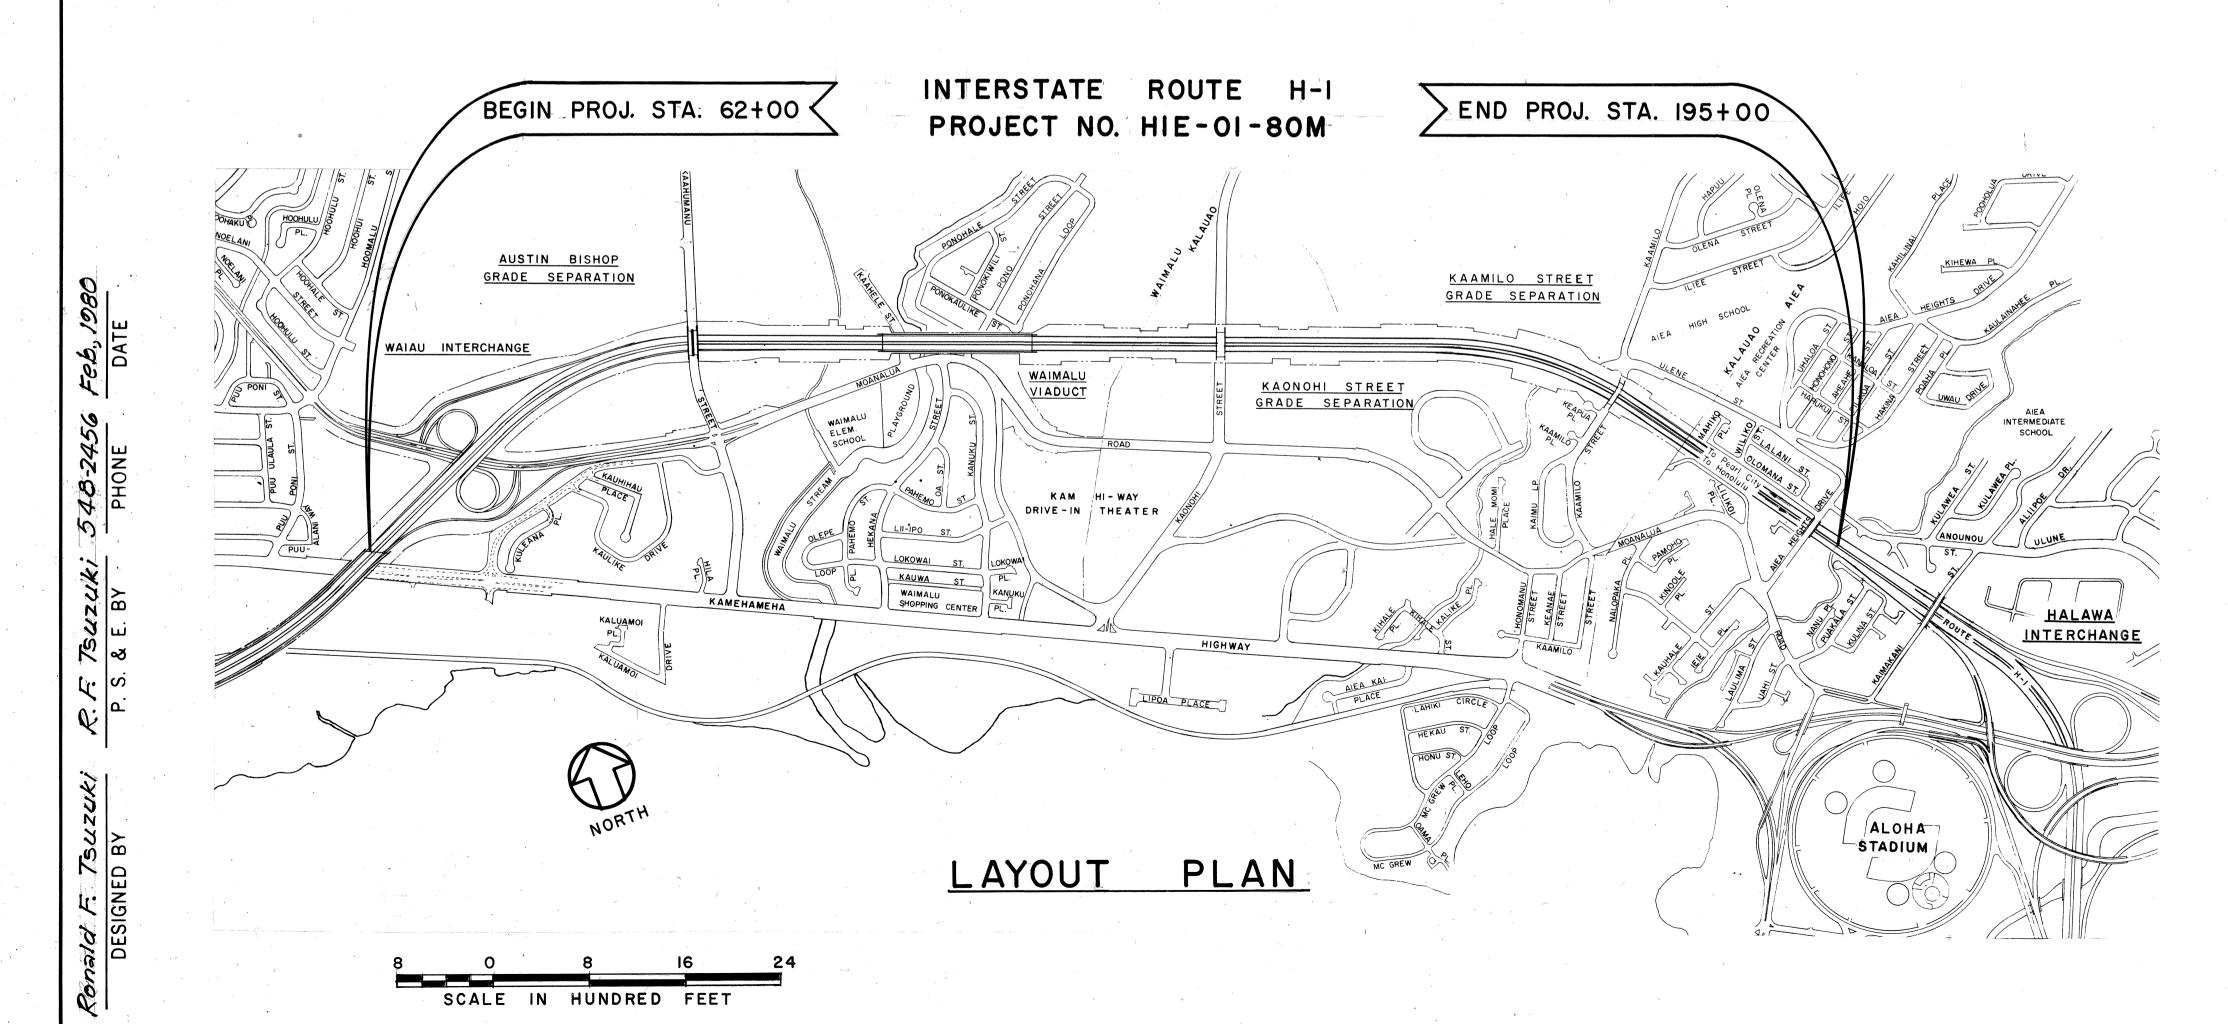

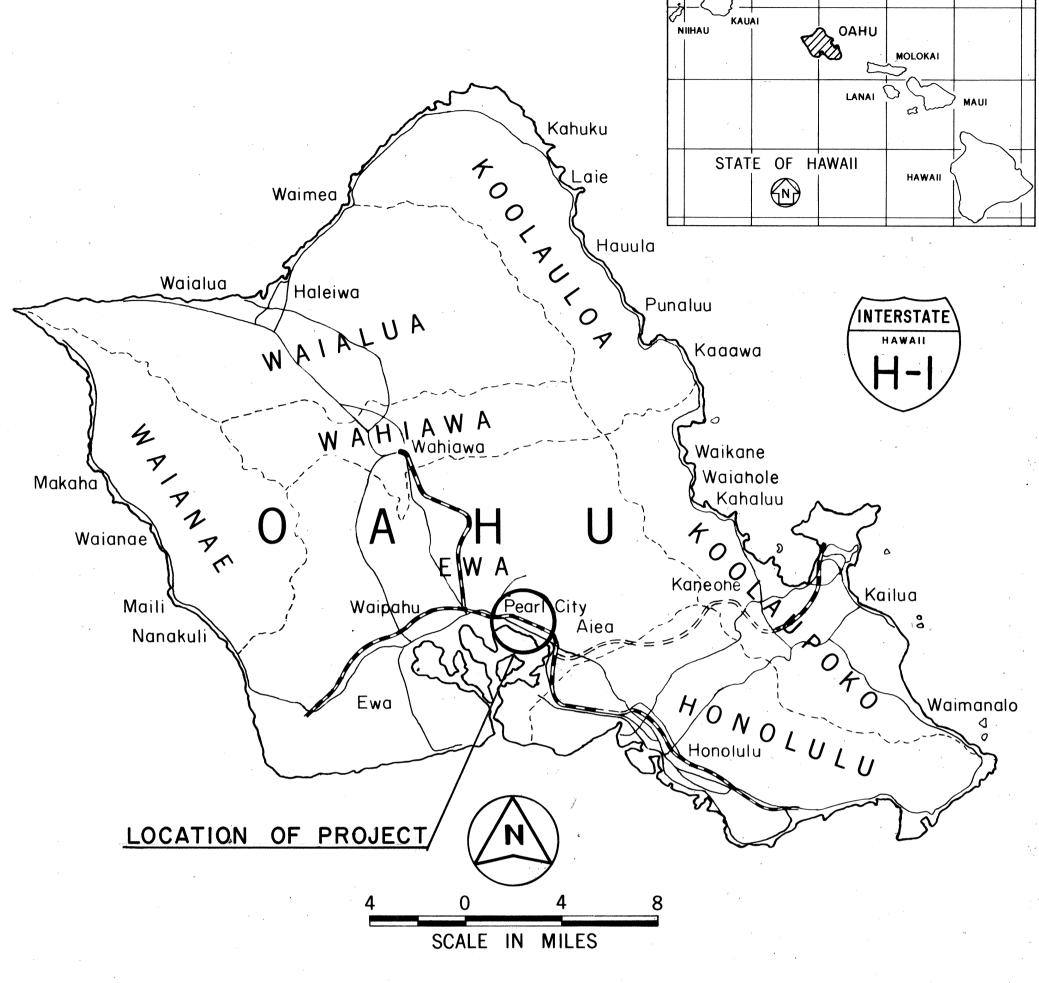

FED. ROAD DIST. NO.

HIE-01-80 M

TOTAL SHEETS

ALL CHANGES MADE DURING CONSTRUCTION HAVE BEEN INCORPORATED ON THESE PLANS IN RED EXCEPT CHANGES IN THE ORIGINAL THEORETICAL QUANTITIES. FOR ACTUAL QUANTITIES, REFER TO

FEDERAL AID INTERSTATE PROJECTS PREVIOUSLY CONSTRUCTED

OR UNDER CONSTRUCTION

25 Feb. 1981 DATE

PROJECT LEDGER AND/OR COMPUTATION BOOK.

DEPARTMENT OF TRANSPORTATION STATE OF HAWAII		
APPROVED:	· · · · · · · · · · · · · · · · · · ·	
James R Canas	2/6/80	
DIR. OF TRANSPORTATION	DATE	
	,	