

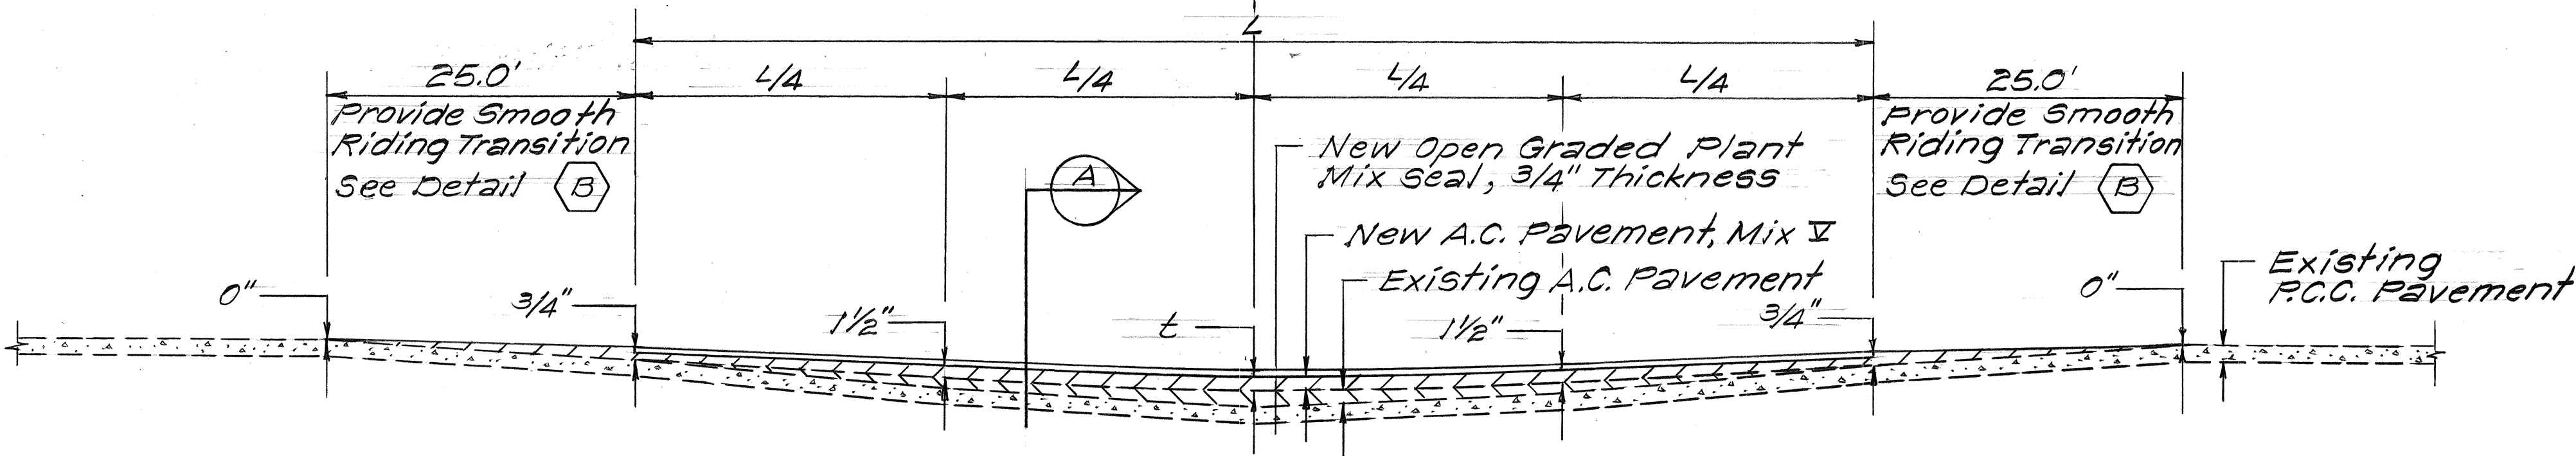




FED. ROAD DIST. NO.	STATE	PROJ. NO.	FISCAL YEAR	SHEET NO.	TOTAL SHEETS
HAWAII	HAW.	HIE-01-80M	1980	2	7

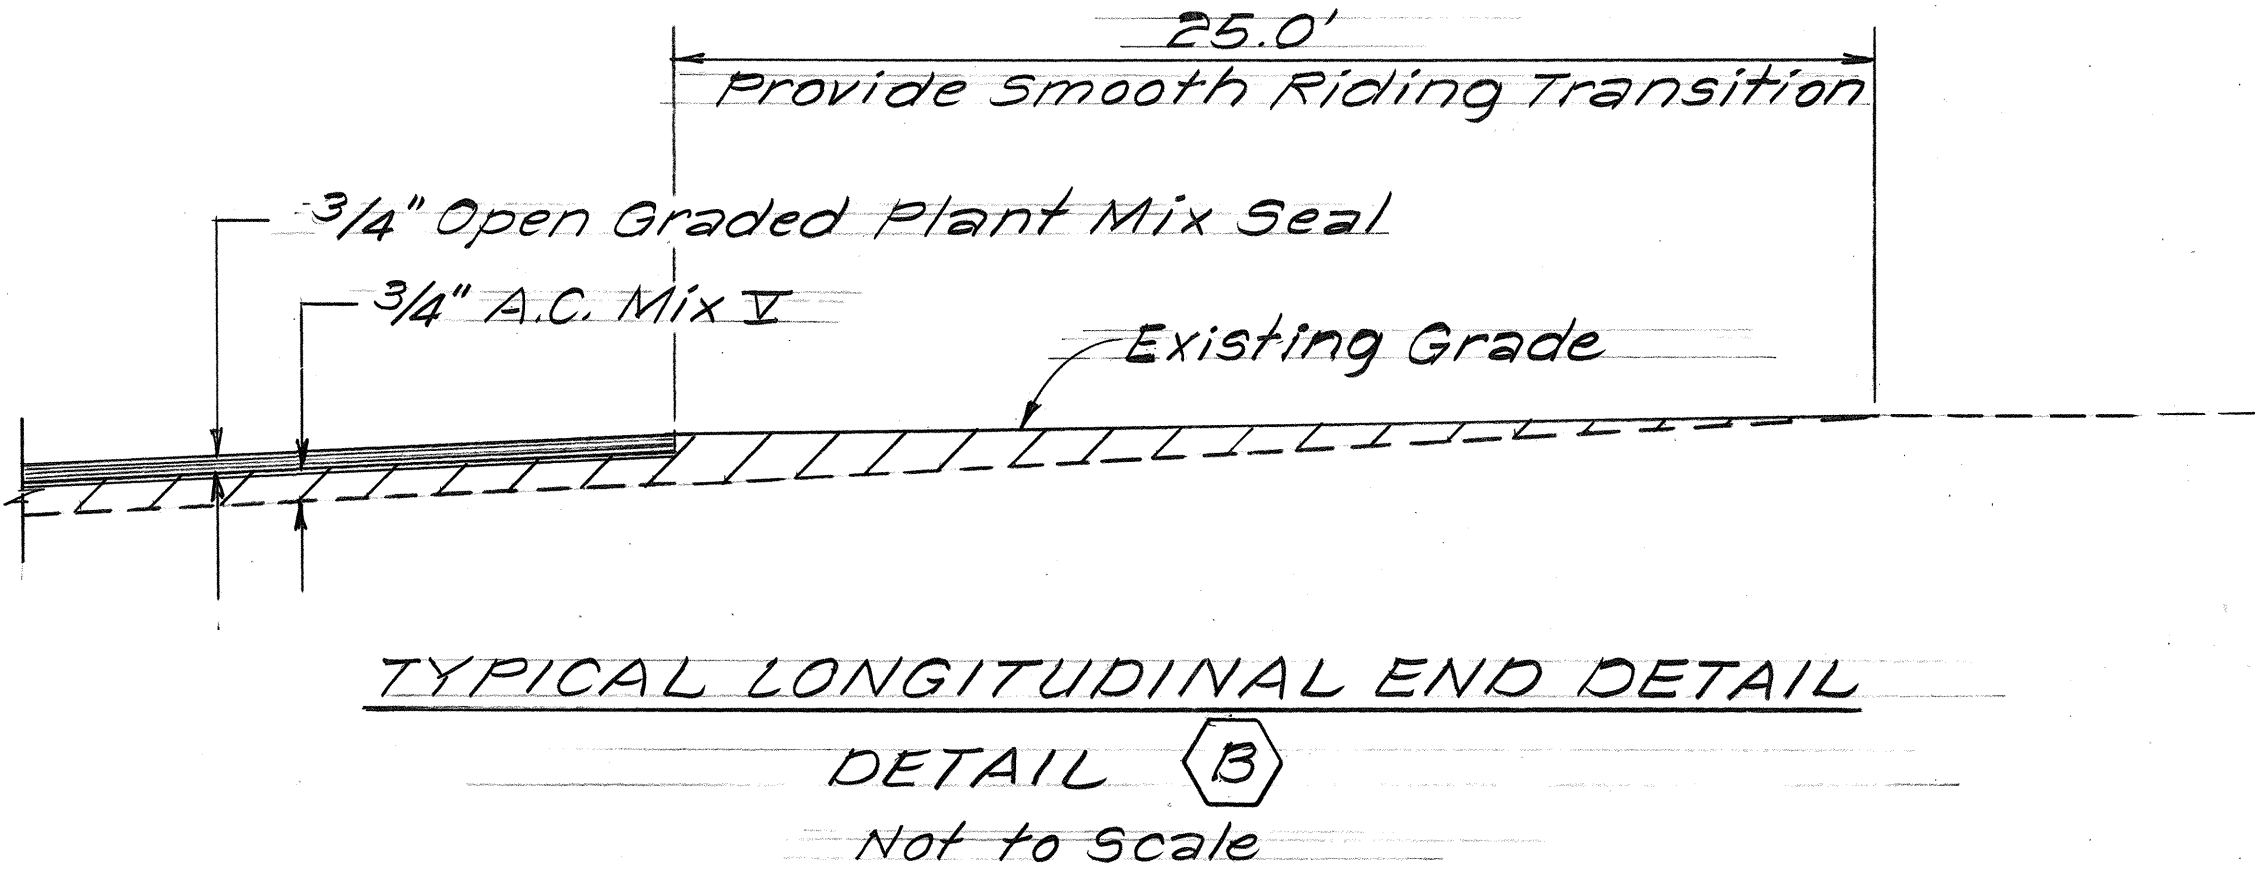

- NOTES:
- Exact "L" in feet to be determined in field by Engineer. Given "L" values for bidding purposes only.
 - See Special Provisions for directives and requirements for the following:
 - Traffic control during construction.
 - Removal of pavement markers.
 - Construction requirements for resurfacing.

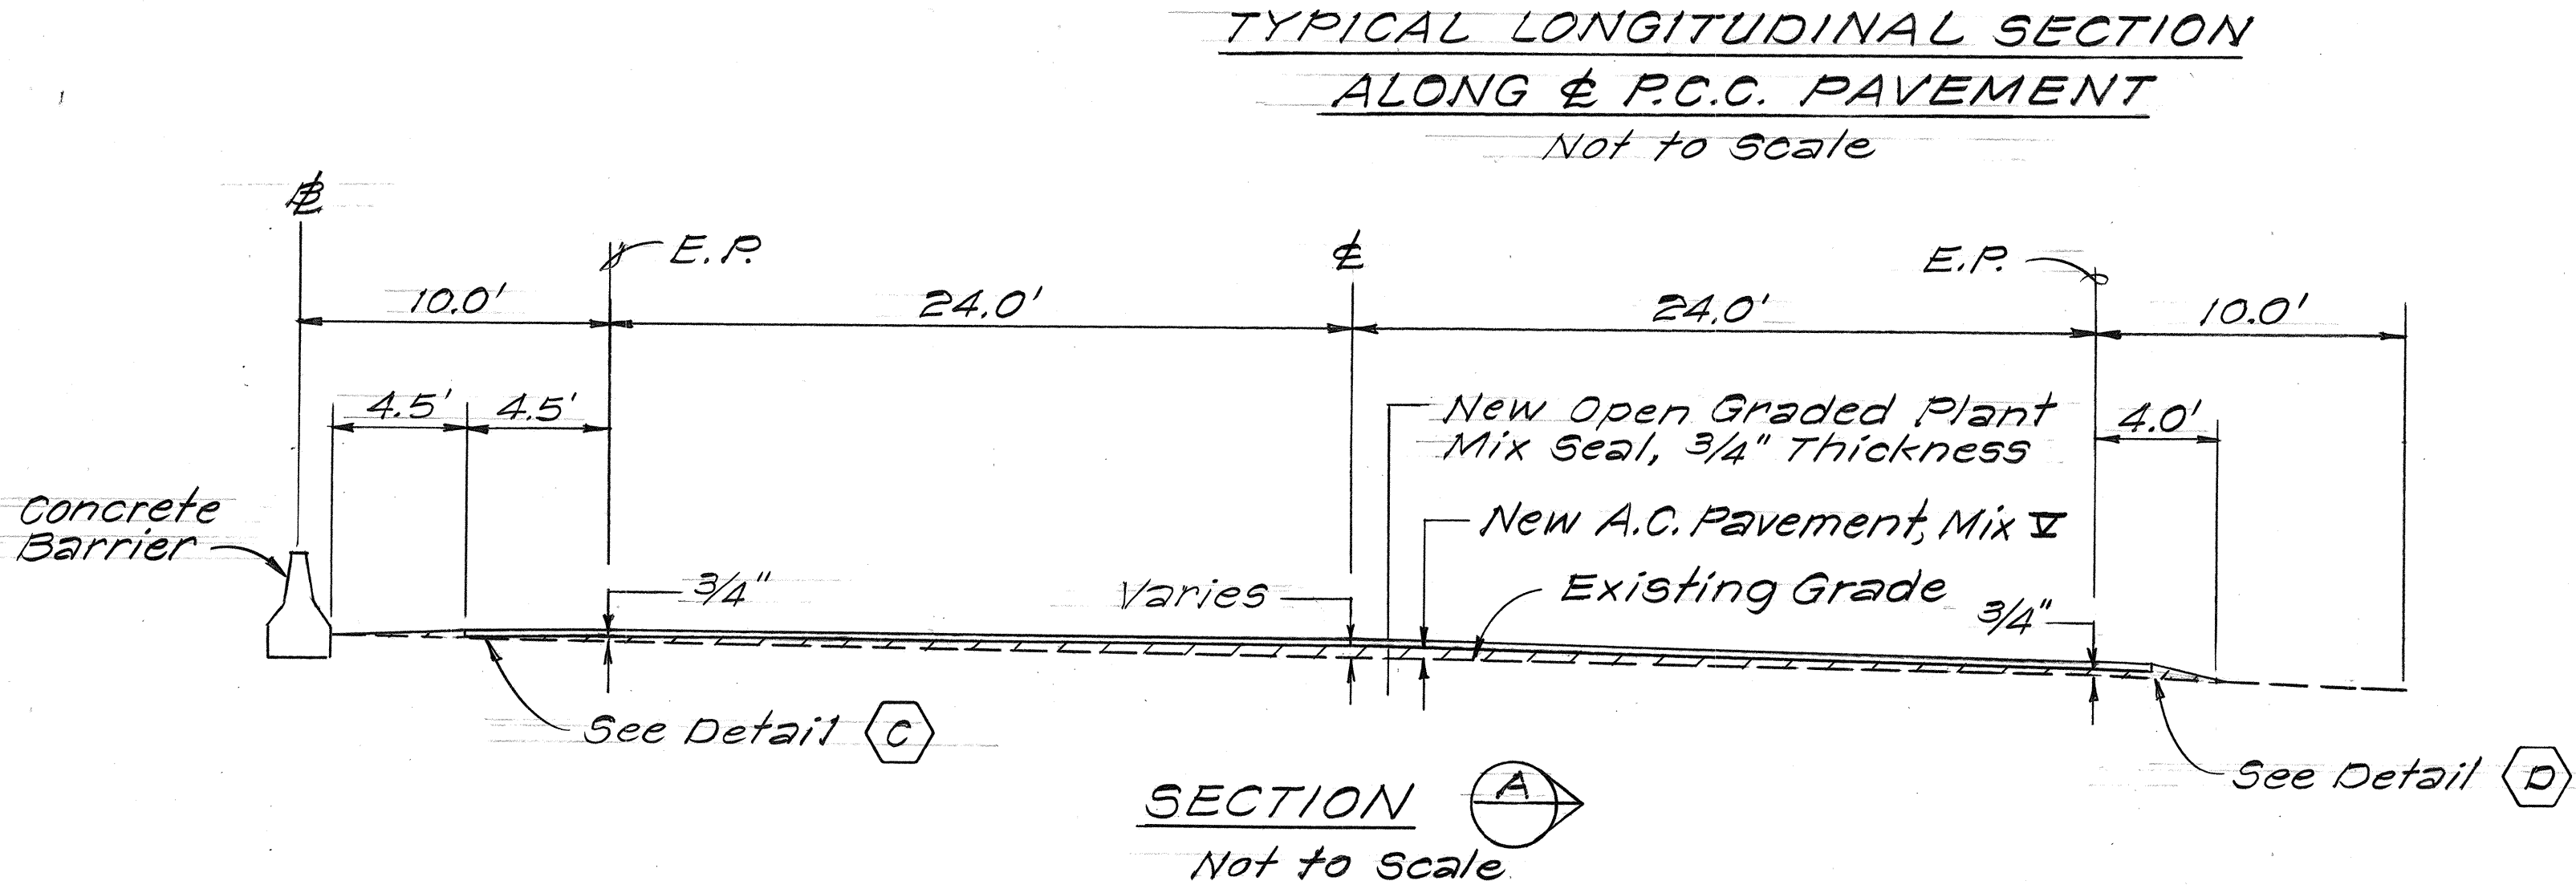

APPROXIMATE SCOPE OF WORK									
OPEN GRADED PLANT MIX SEAL QUANTITIES									
OUTBOUND LANES				INBOUND LANES					
STA. LOCATION	"L" LENGTH IN FEET	SURFACE AREA IN S.Y.	WEIGHT IN TONS	STA. LOCATION	"L" LENGTH IN FEET	SURFACE AREA IN S.Y.	WEIGHT IN TONS		
102 + 00± 105 + 60±	360±	2200 ±	90±	102 + 14± 110 + 84±	870±	5300±	215±		
108 + 24± 110 + 84±	260±	1600 ±	65±	145 + 00± 150 + 25±	525±	3200±	130±		
146 + 00± 149 + 50±	350±	2100 ±	90±	162 + 00± 168 + 00± *	600±	3650±	150±		
				183 + 75± 184 + 25±	50±	300±	15±		
A.C. MIX V QUANTITIES									
OUTBOUND LANES				INBOUND LANES					
STA. LOCATION	"L" LENGTH IN FEET	"2" A.C. THICK NESS IN INCH	SURFACE AREA IN S.Y.	WEIGHT IN TONS	STA. LOCATION	"L" LENGTH IN FEET	"2" A.C. THICK NESS IN INCH	SURFACE AREA IN S.Y.	WEIGHT IN TONS
102 + 00± 105 + 60±	360±	2 1/2"	2800±	250±	102 + 14± 110 + 84±	870±	2 1/2"	6300±	580±
108 + 24± 110 + 84±	260±	2 1/2"	2100±	180±	145 + 00± 150 + 25±	525±	2 1/2"	3950±	350±
146 + 00± 149 + 50±	350±	2 1/2"	2750±	240±	162 + 00± 168 + 00± *	600±	2 1/2"	4450±	400±
					183 + 75± 184 + 25±	50±	2 1/2"	700±	40 ±

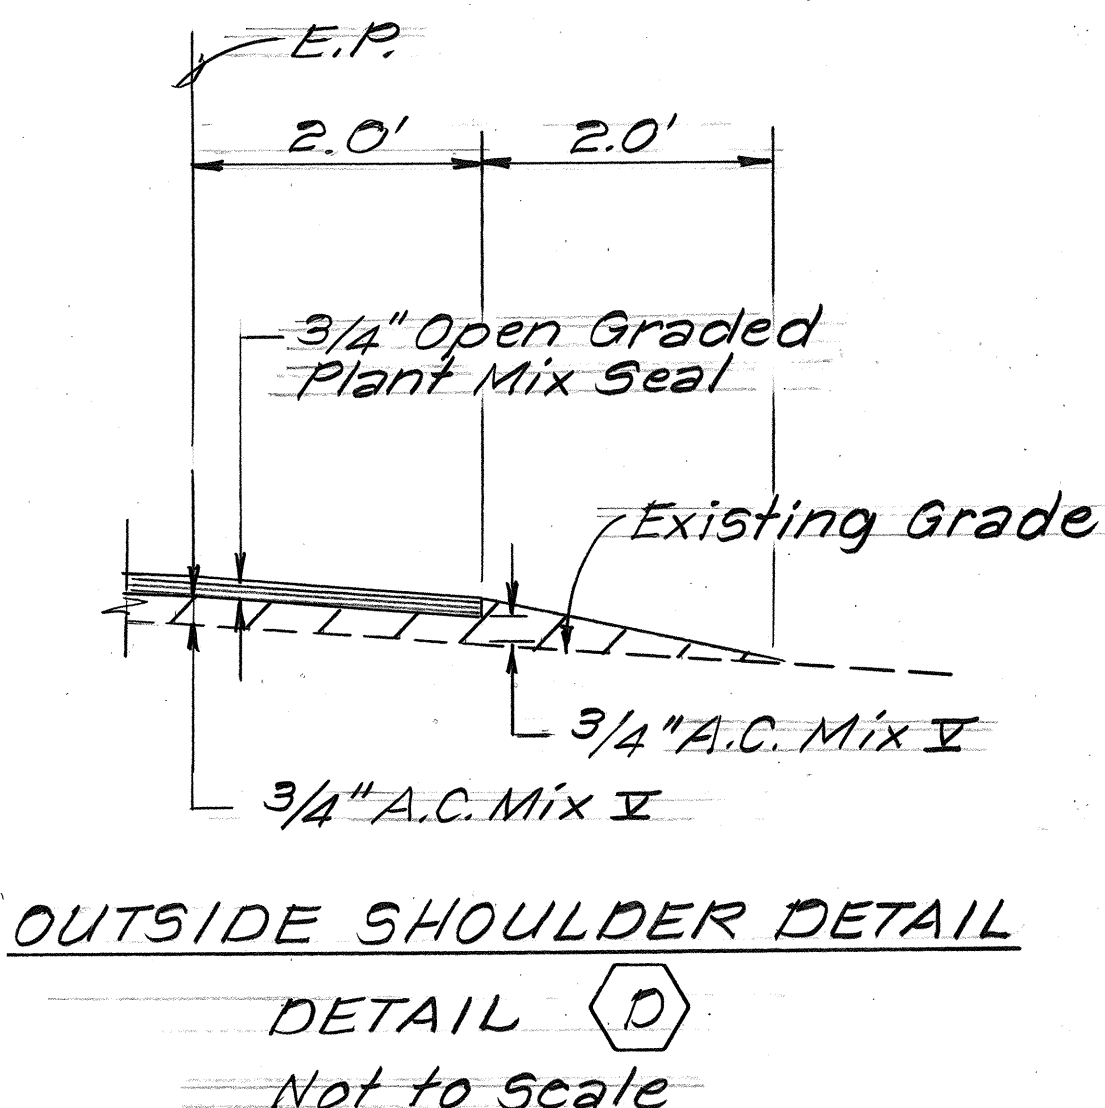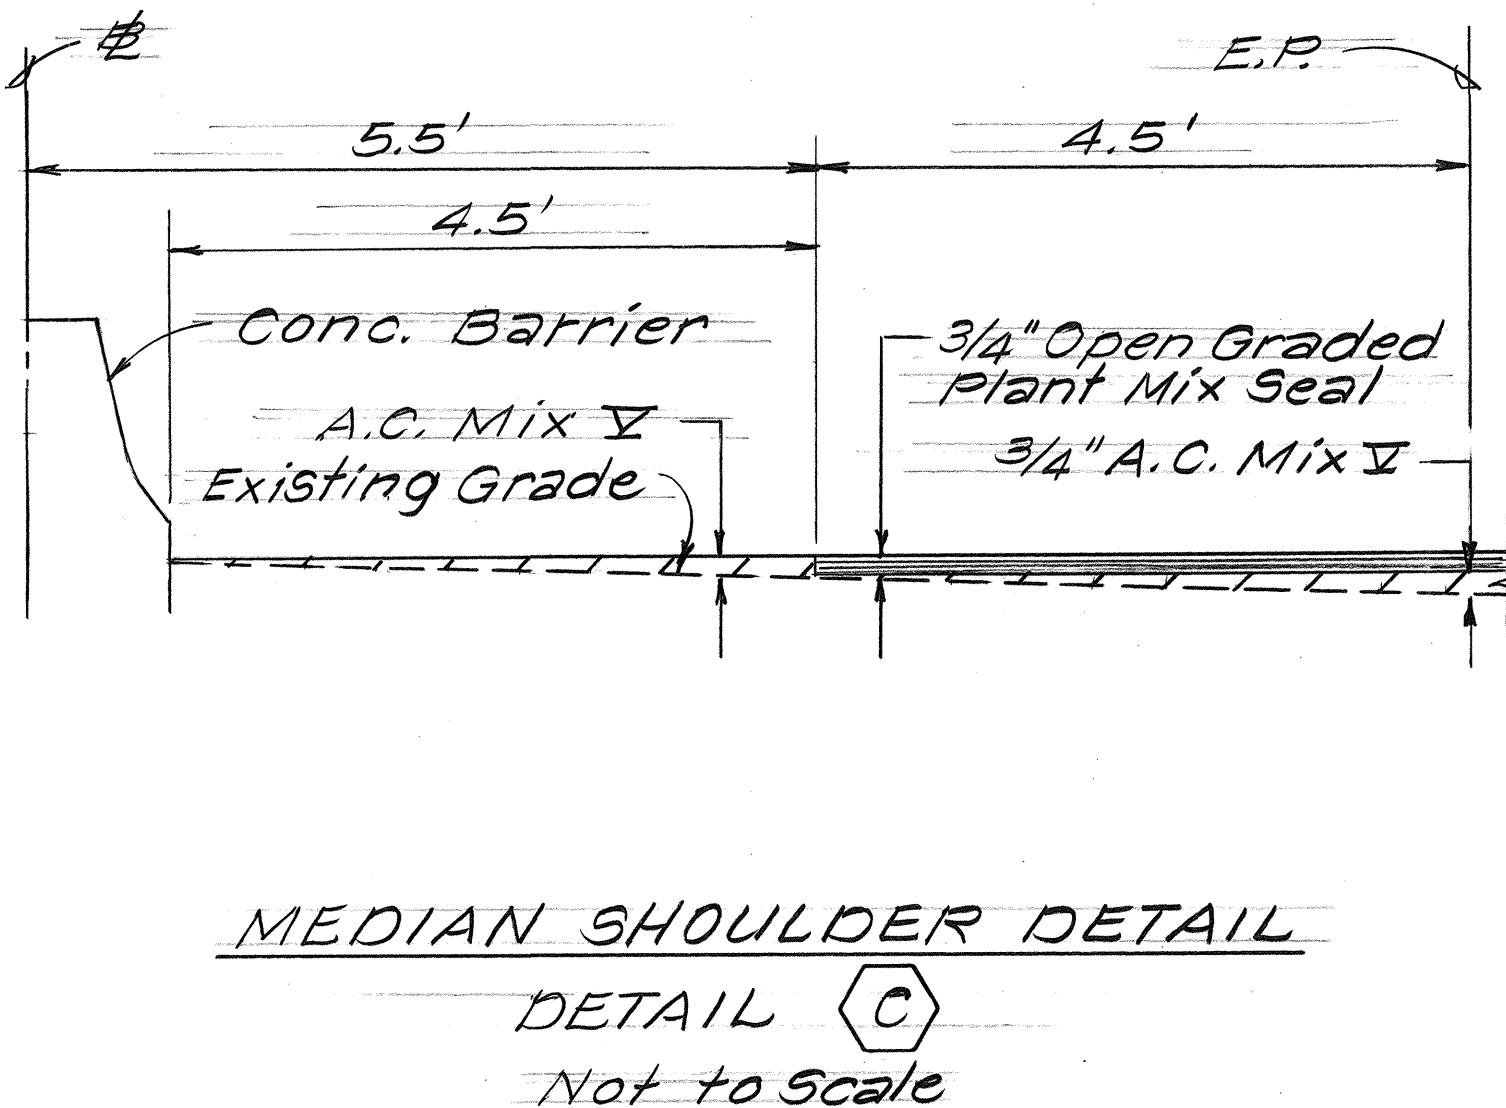

LEGEND

* Denotes "NOT IN CONTRACT"

STATE OF HAWAII

DEPARTMENT OF TRANSPORTATION

LAND TRANSPORTATION FACILITIES DIVISION

TYPICAL SECTIONS

& QUANTITY SCHEDULE

INTERSTATE ROUTE H-1

H-1 RESURFACING

WAI'AU I.C. TO HALAWA I.C.

PROJECT NO. HIE-01-80M

Scale: Not to Scale Date: Sept. 1979

SHEET NO. 1 OF 1

SHEETS

ORIGINAL PLAN	DATE
SURVEY PLOTTED BY	
DRAWN BY	
DESIGNED BY	
CHECKED BY	
NOTED BY	
QUANTITIES BY	
NO.	