


FED. ROAD DIST. NO.	STATE	FED. AID PROJ. NO.	FISCAL YEAR	SHEET NO.	TOTAL SHEETS
HAWAII	HAW.	FHH-(147):17	1980	1	338

INDEX TO DRAWINGS	
SHEET NO.	DESCRIPTION
1	TITLE SHEET
2	CONSTRUCTION PHASING
3-4	TYPICAL ROADWAY SECTIONS
5-8	ALIGNMENT PLANS
9-11	ROADWAY PROFILES & SUPERELEVATION DIAGRAMS
12-17	RAMP TERMINAL AND INTERSECTION DETAILS
18-22	ROADWAY CONSTRUCTION PLANS
23-41	ROADWAY DETAILS
42-45	DRAINAGE AND GRADING PLANS
46-48	DRAINAGE PROFILES
49-70	DRAINAGE STRUCTURES, DETAILS & QUANTITIES SUMMARY
71	SOIL SURCHARGE AT RDWY "K" & PILE INCLINOMETER SYSTEM
71A-71B	PILE INSTALLATION (ROD EXTENSION TEST)
72	CLEARING OF PILE TEST SITE
72A	CUTTING AND REFACING OF BLDG. AT MAUKA FR. RD. STA. 224+30±
76-83	SIGNING AND PAVEMENT MARKING PLANS
84-112	SIGNING AND PAVEMENT MARKING DETAILS
113-118	HIGHWAY LIGHTING & TRAFFIC SIGNALS
120-135	HIGHWAY LIGHTING & TRAFFIC SIGNALS
136-137	LANDSCAPING AND IRRIGATION
138-140	UTILITY PLANS
141-154	BORING LOCATION PLANS AND LOGS
155-214	H-I VIADUCT (WB)
215-255	MAUKA FRONT. RD. STRUCTURE
256-272A-283A-285	TYP. DETAILS FOR STRUCTURES
286-304	TEMP RAMP III STRUCTURE
305-307	STRUCTURAL STANDARD DETAILS
308-324	CROSS SECTIONS
325-337	AIRPORT I/C PORTION: SIGNING & PAVEMENT MARKINGS
NOTE: SHEET NOS. 73, 74, 75 & 119 HAVE BEEN DELETED.	



- ① C.O. 20S-1 ② C.O. 71A S-1
 - ③ C.O. 78 S-1 ④ C.O. 84 S-1
 - ⑤ 170S-1, 170S-2, 170S-3, 170S-4, 170S-5, 192S-1
 - ⑥ 221S-1, 228S-1, 255S-1, 255S-2, 255S-3
 - ⑦ 280S-1, 280S-2, ADD284S-1, ADD284S-2, C.O. 285S-1, C.O. 285S-2, C.O. 285S-3
 - ⑧ 326S-1, C.O. 334S-1, C.O. 334S-2
- THESE ARE SUPPLEMENT SHEETS TO CONTRACT PLANS. NEW TOTAL = 363

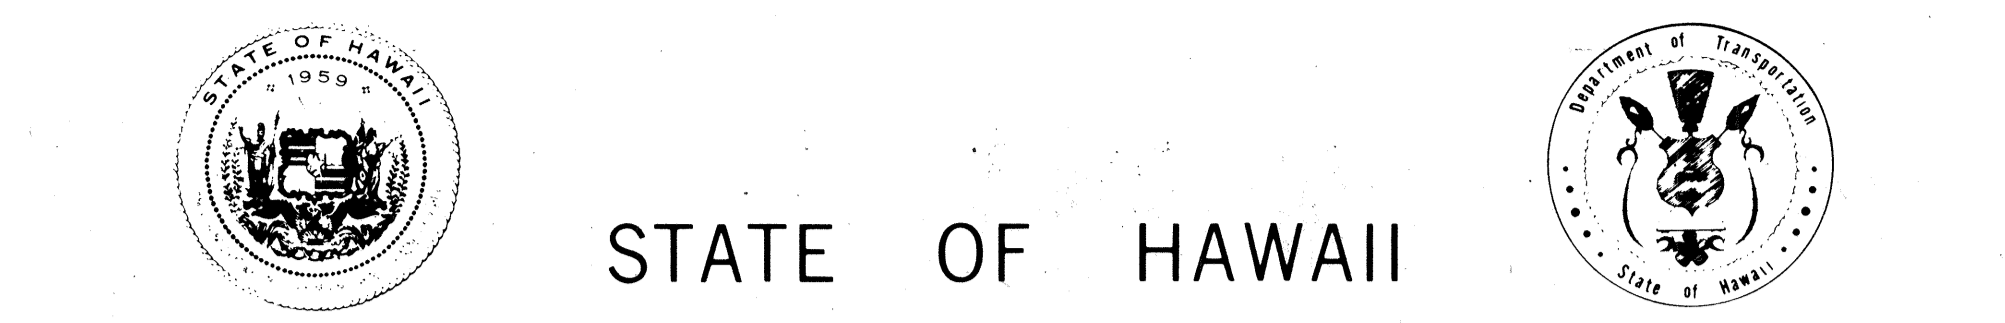

STATE OF HAWAII
DEPARTMENT OF TRANSPORTATION
HIGHWAYS DIVISION
HONOLULU, HAWAII
"AS-BUILT"
PLANS FOR
CONSTRUCTION OF A PORTION OF
INTERSTATE ROUTE H-1
KEEHI INTERCHANGE

FEDERAL AID INTERSTATE PROJECT NO. I-HI-1 (147):17

DISTRICT OF HONOLULU
ISLAND OF OAHU

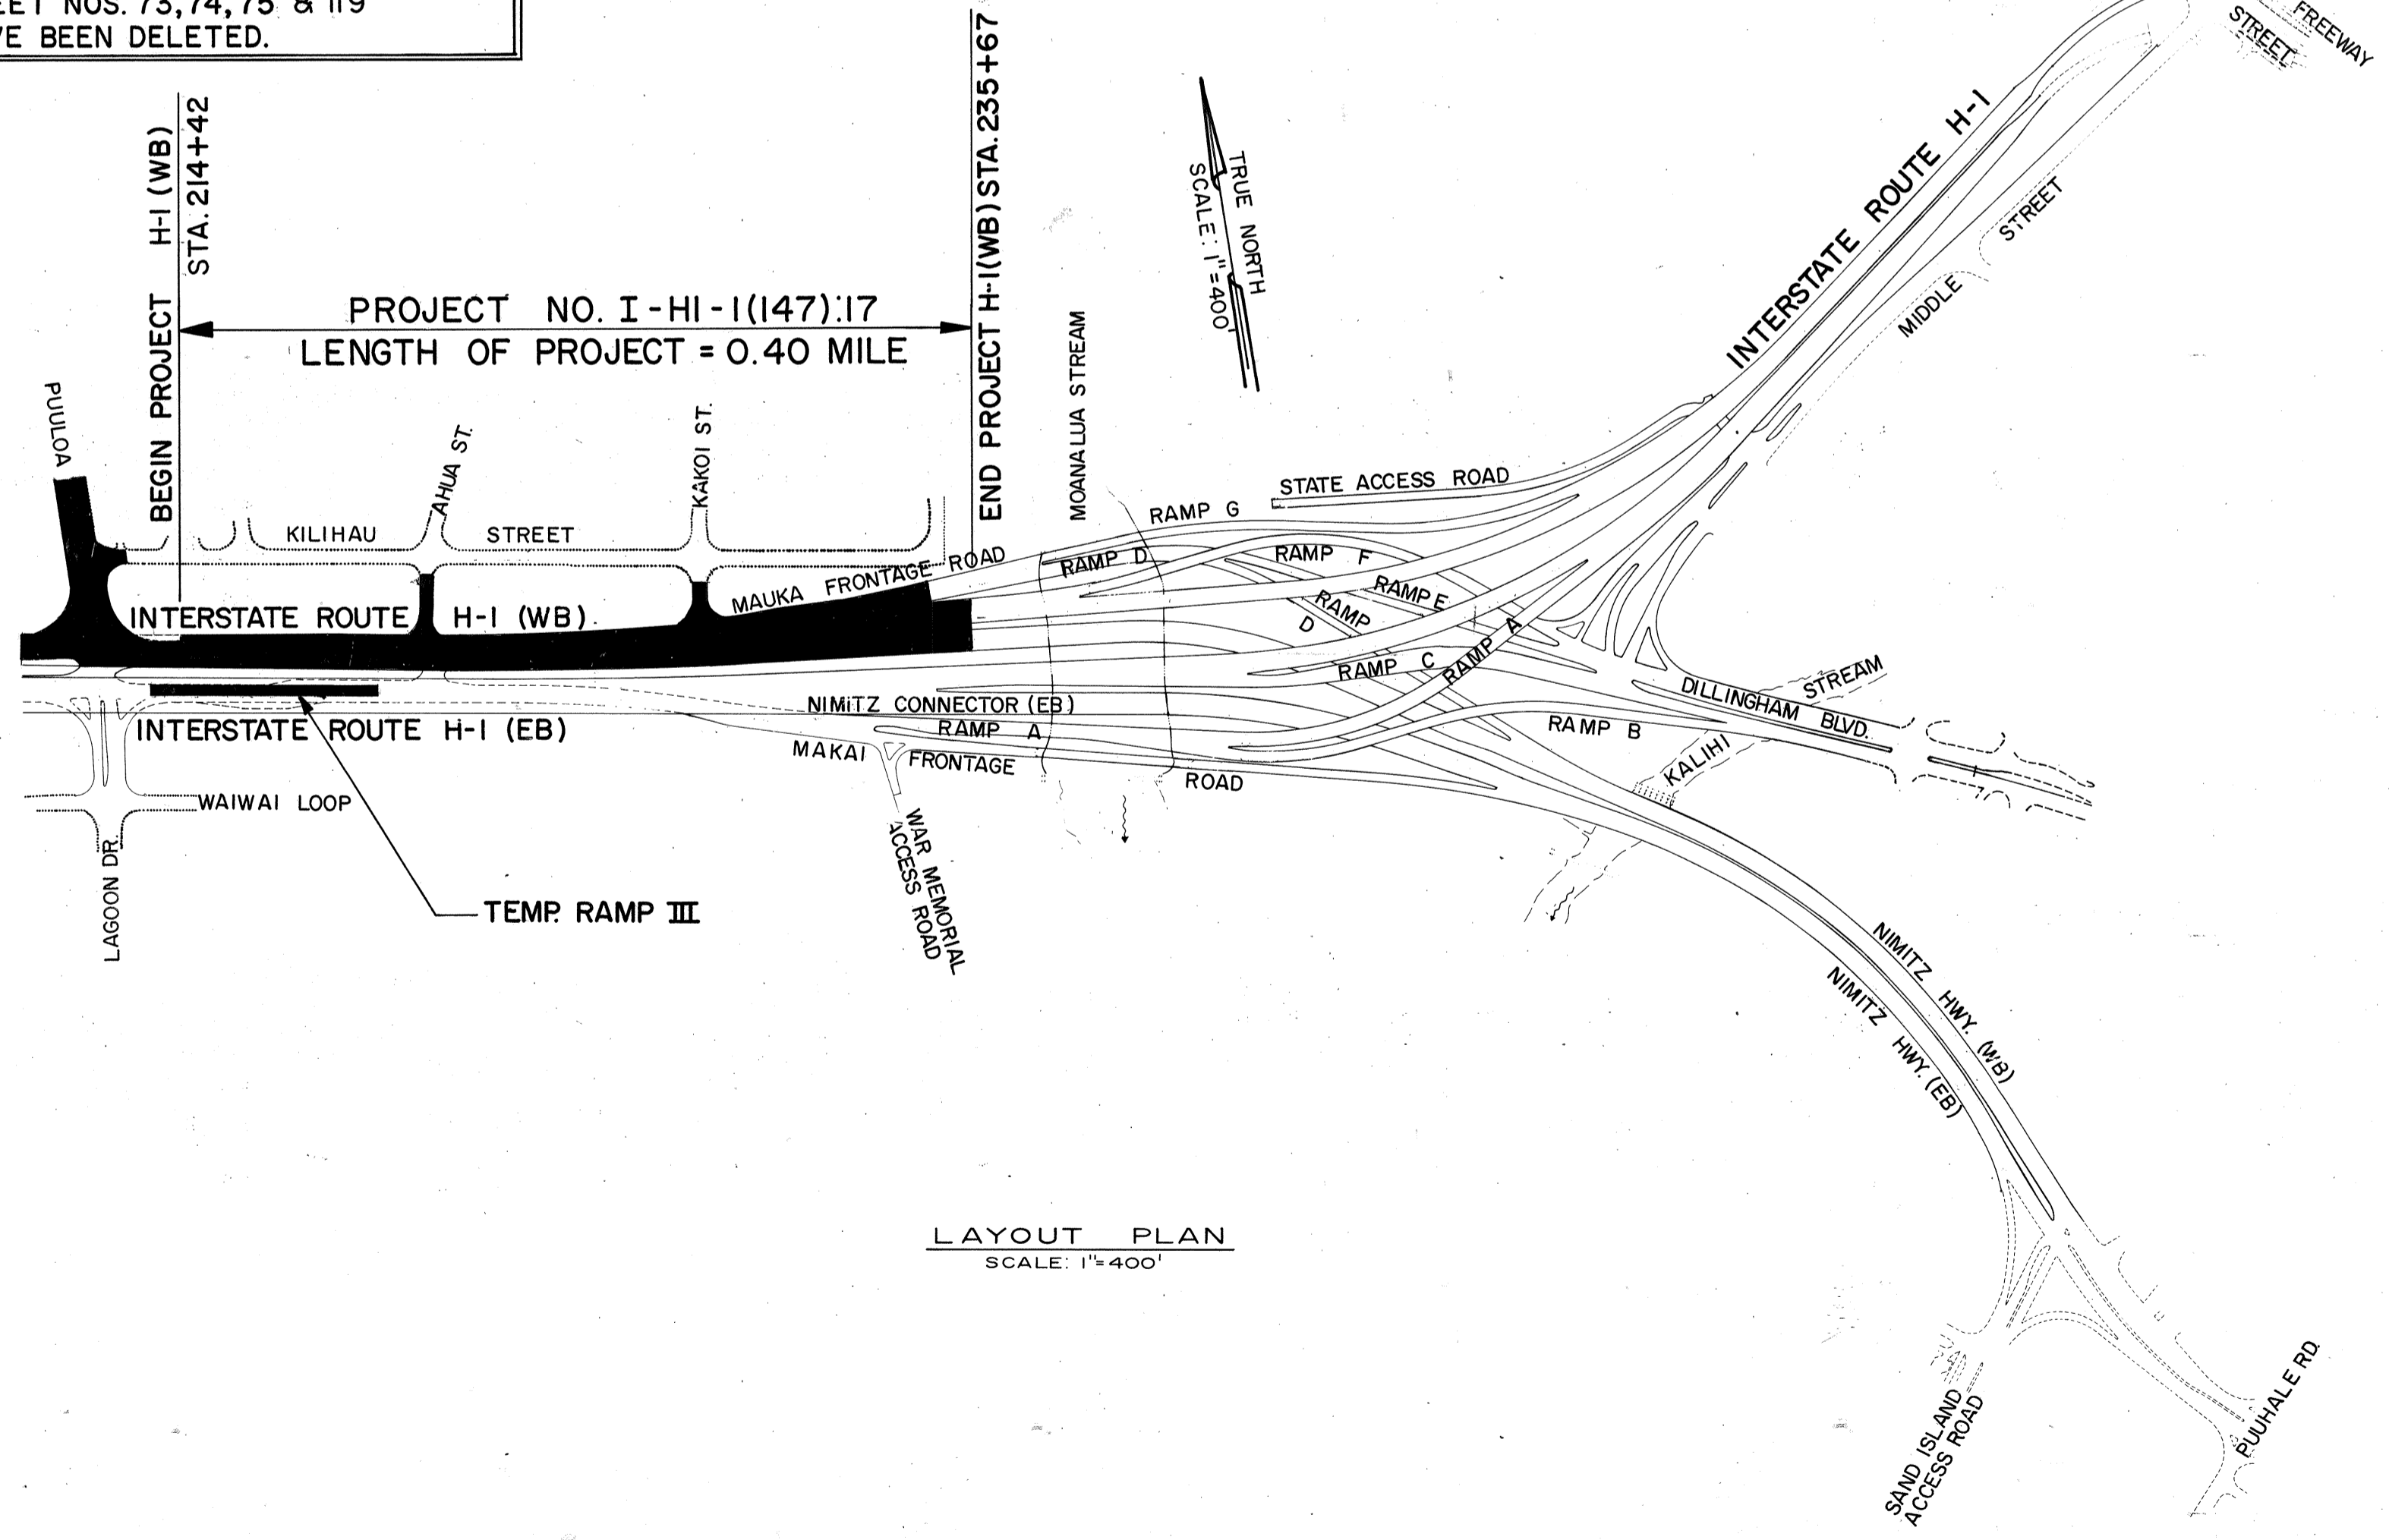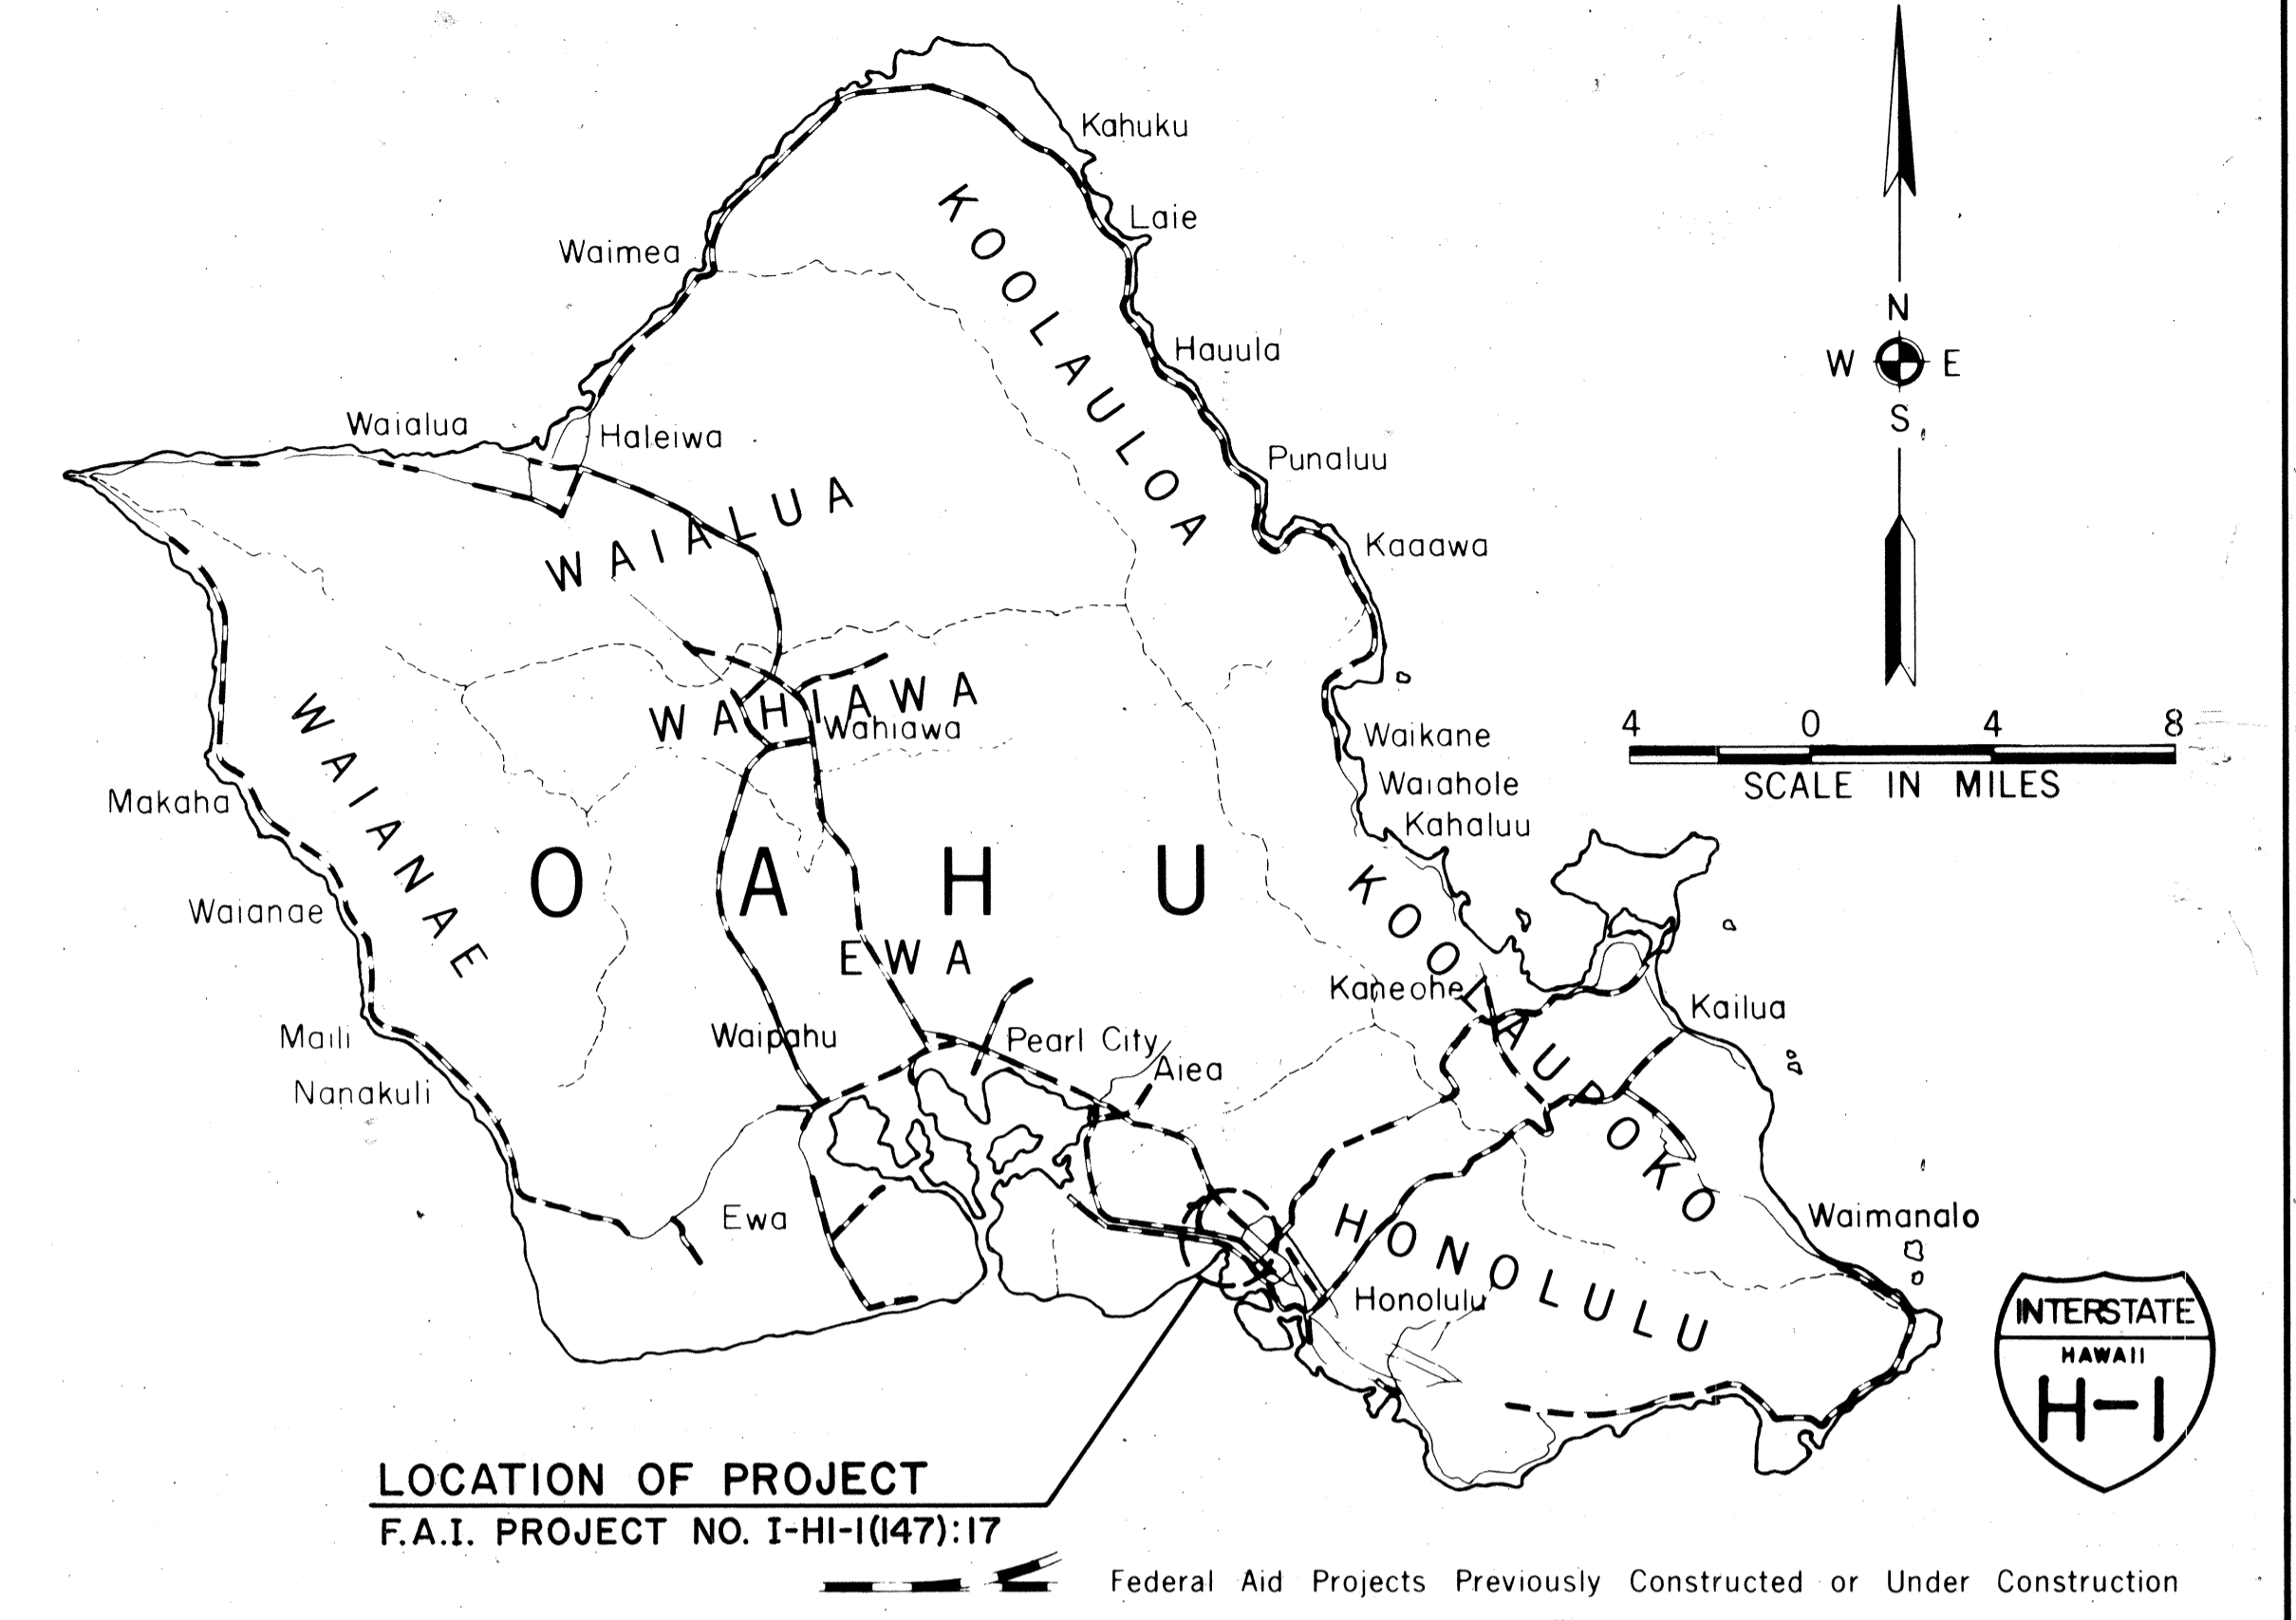

DESIGN CLASSIFICATION

DESIGN ADT (1994).....	98,000
DHV.....	10,800
D.....	60/40
T.....	5%
V.....	60 MPH

CHANGES MADE DURING CONSTRUCTION HAVE BEEN INCORPORATED ON THESE PLANS EXCEPT CHANGES IN THE ORIGINAL THEORETICAL QUANTITIES. FOR ACTUAL QUANTITIES, REFER TO PROJECT LEDGER AND/OR COMPUTATION BOOK.

David Jamashiro 1/26/84
RESIDENT ENGINEER DATE

DEPARTMENT OF TRANSPORTATION
FEDERAL HIGHWAY ADMINISTRATION
APPROVED: *[Signature]* 7.25.80
DIVISION ADMINISTRATOR DATE

DEPARTMENT OF TRANSPORTATION
STATE OF HAWAII
APPROVED: *James R. Carras* 12/7/79
DIR. OF TRANSPORTATION DATE

DATE 4/2/79
PHONE 521-3051
BY STANLEY UEHARA
DESIGNED BY PARSONS BRINCKERHOFF-HIROTA ASSOCIATES

DD-C-8-142