




FED. ROAD DIST. NO.	STATE	FED. AID PROJ. NO.	FISCAL YEAR	SHEET NO.	TOTAL SHEETS
HAWAII	HAW.	I-HI-1(163):16	1980	10	16

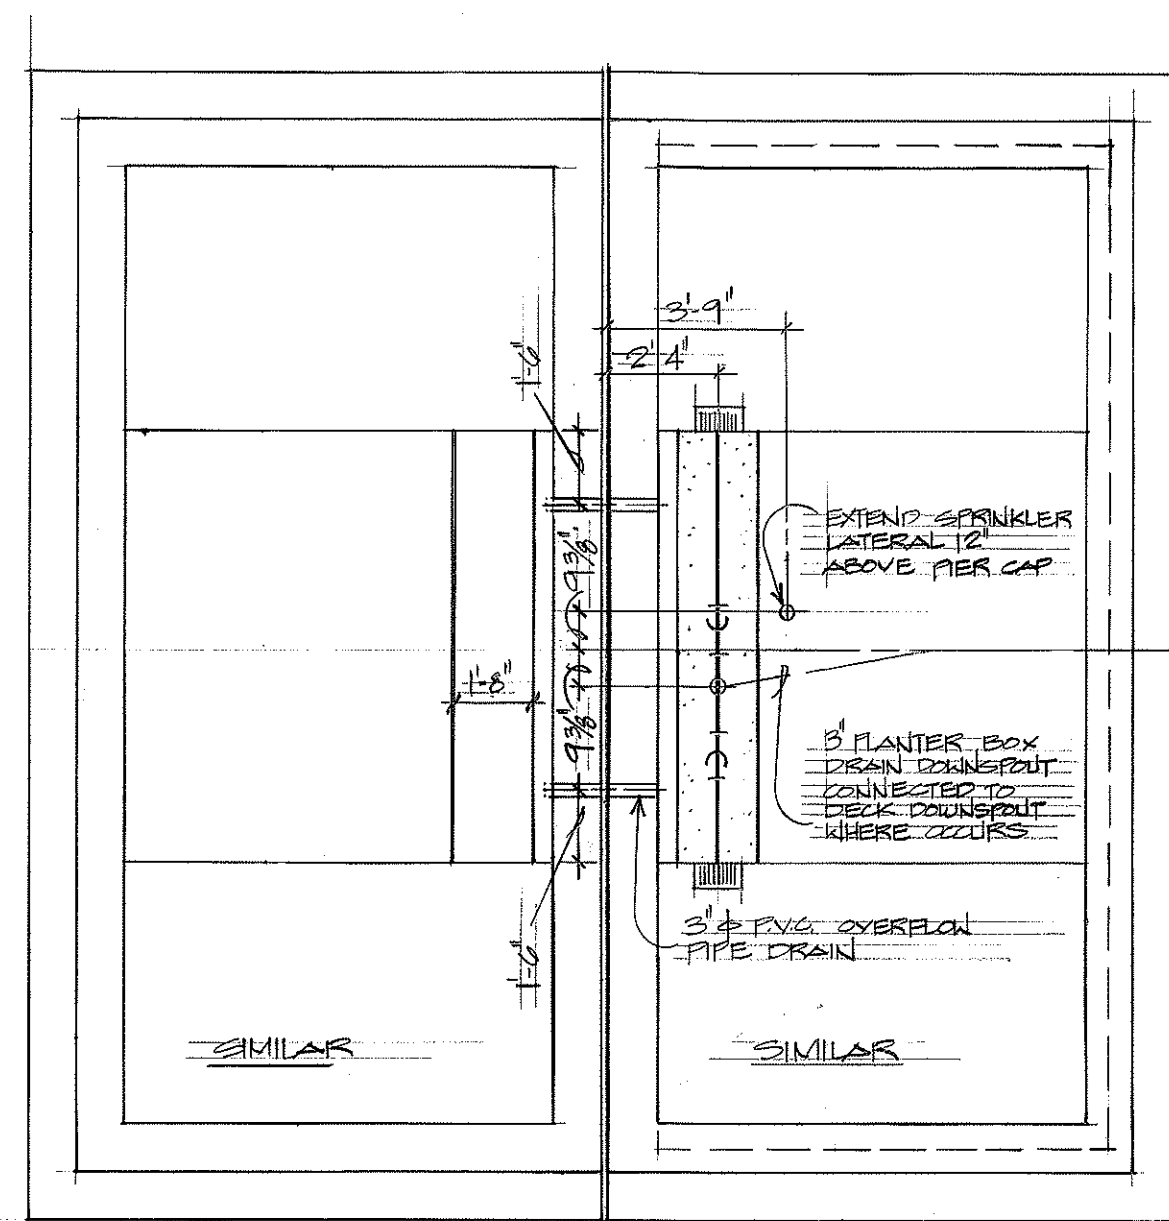

AT PIER LINE 2 THRU 14

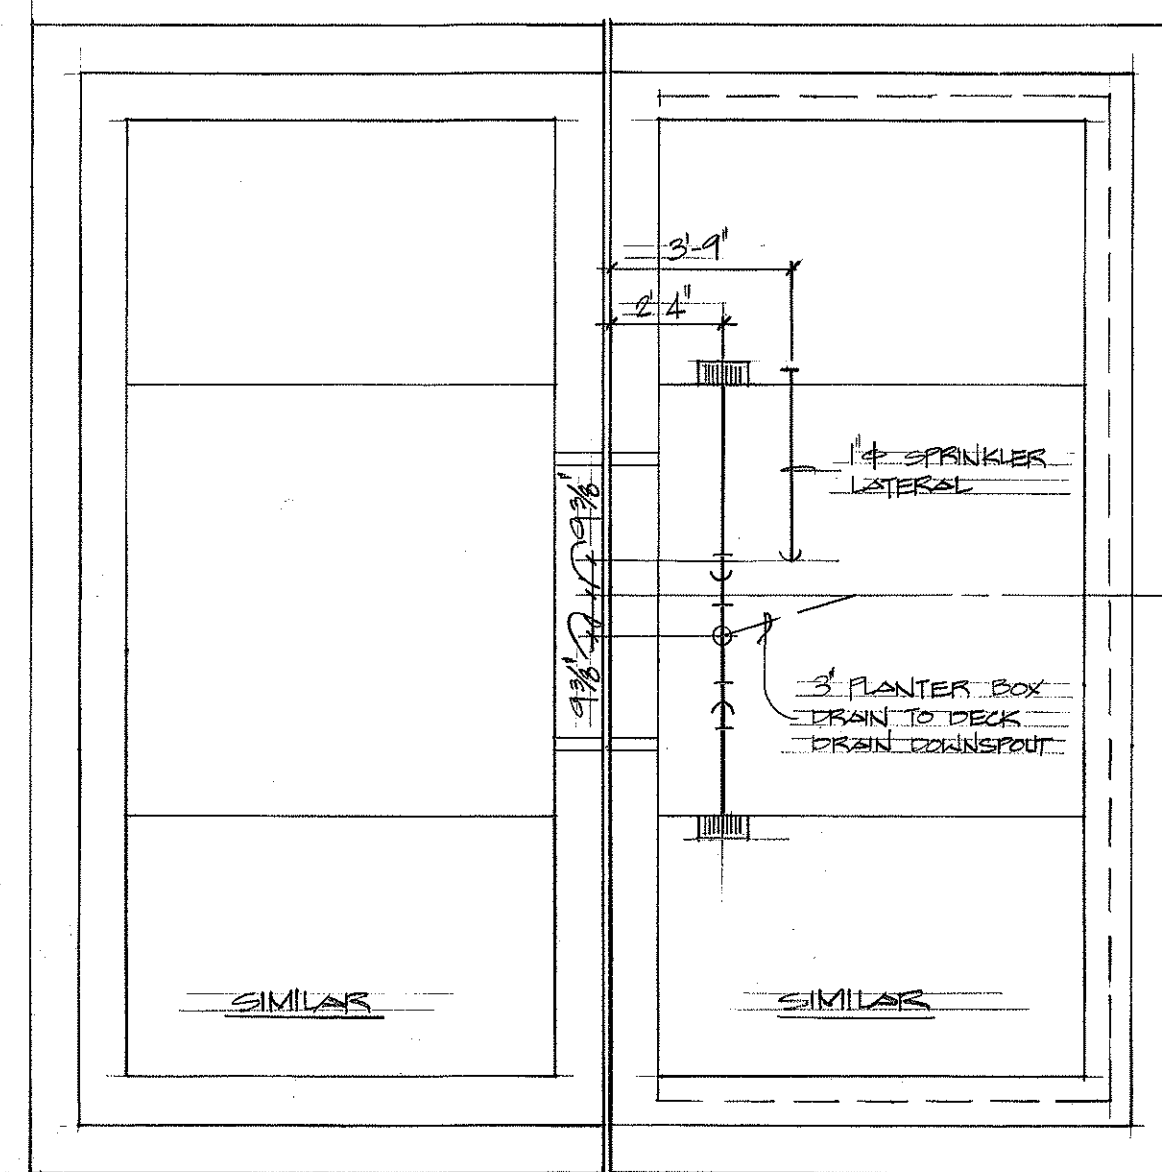


AT PIER LINE 15 THRU 17

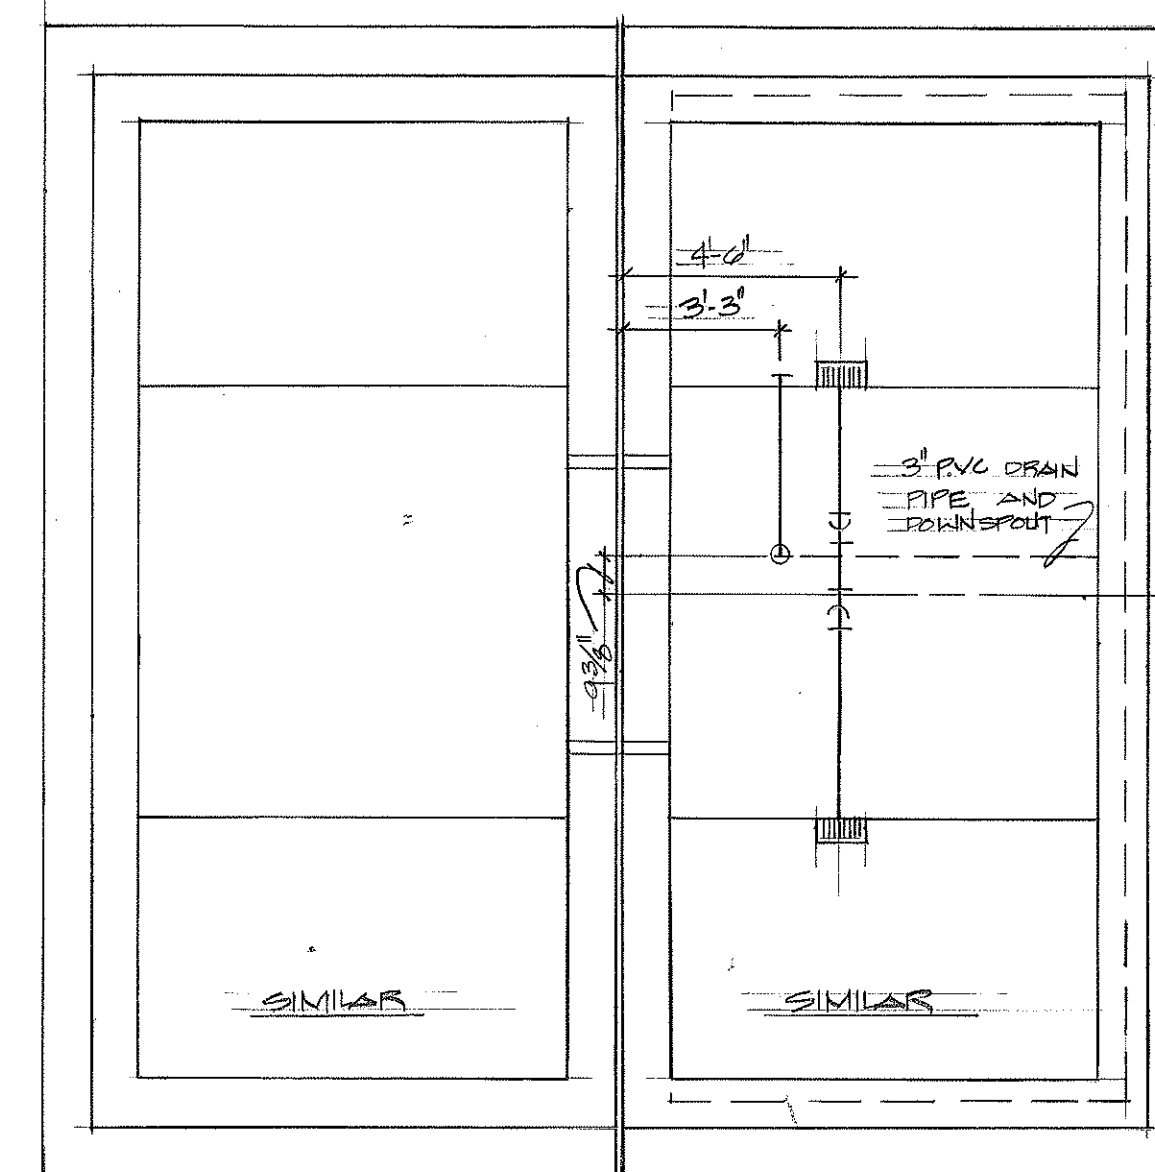

AT PIER LINE 18 THRU 22

TYPICAL "AS-BUILT" PLANTER BOX DRAINAGE DETAIL

ORIGINAL PLAN	SURVEY PLOTTED BY	DATE
NOTE BOOK	DRAWN BY	"
No.	DESIGNED BY	"
	QUANTITIES BY	"
	CHECKED BY	"

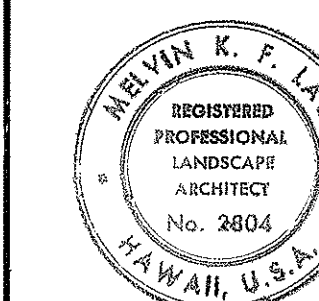

THIS WORK WAS PREPARED BY ME OR UNDER MY SUPERVISION.
 Signature: *Melvin K. F. Lau*

STATE OF HAWAII
 DEPARTMENT OF TRANSPORTATION
 LAND TRANSPORTATION FACILITIES DIVISION

IRRIGATION DETAILS

AIRPORT INTERCHANGE VIADUCT LANDSCAPING

F.A.I. PROJ. NO. I-HI-1 (163):16
 SCALE: 1/4"=1'-0" DATE: JAN 20 1981

SHEET NO. L-9 OF 15 SHEETS