
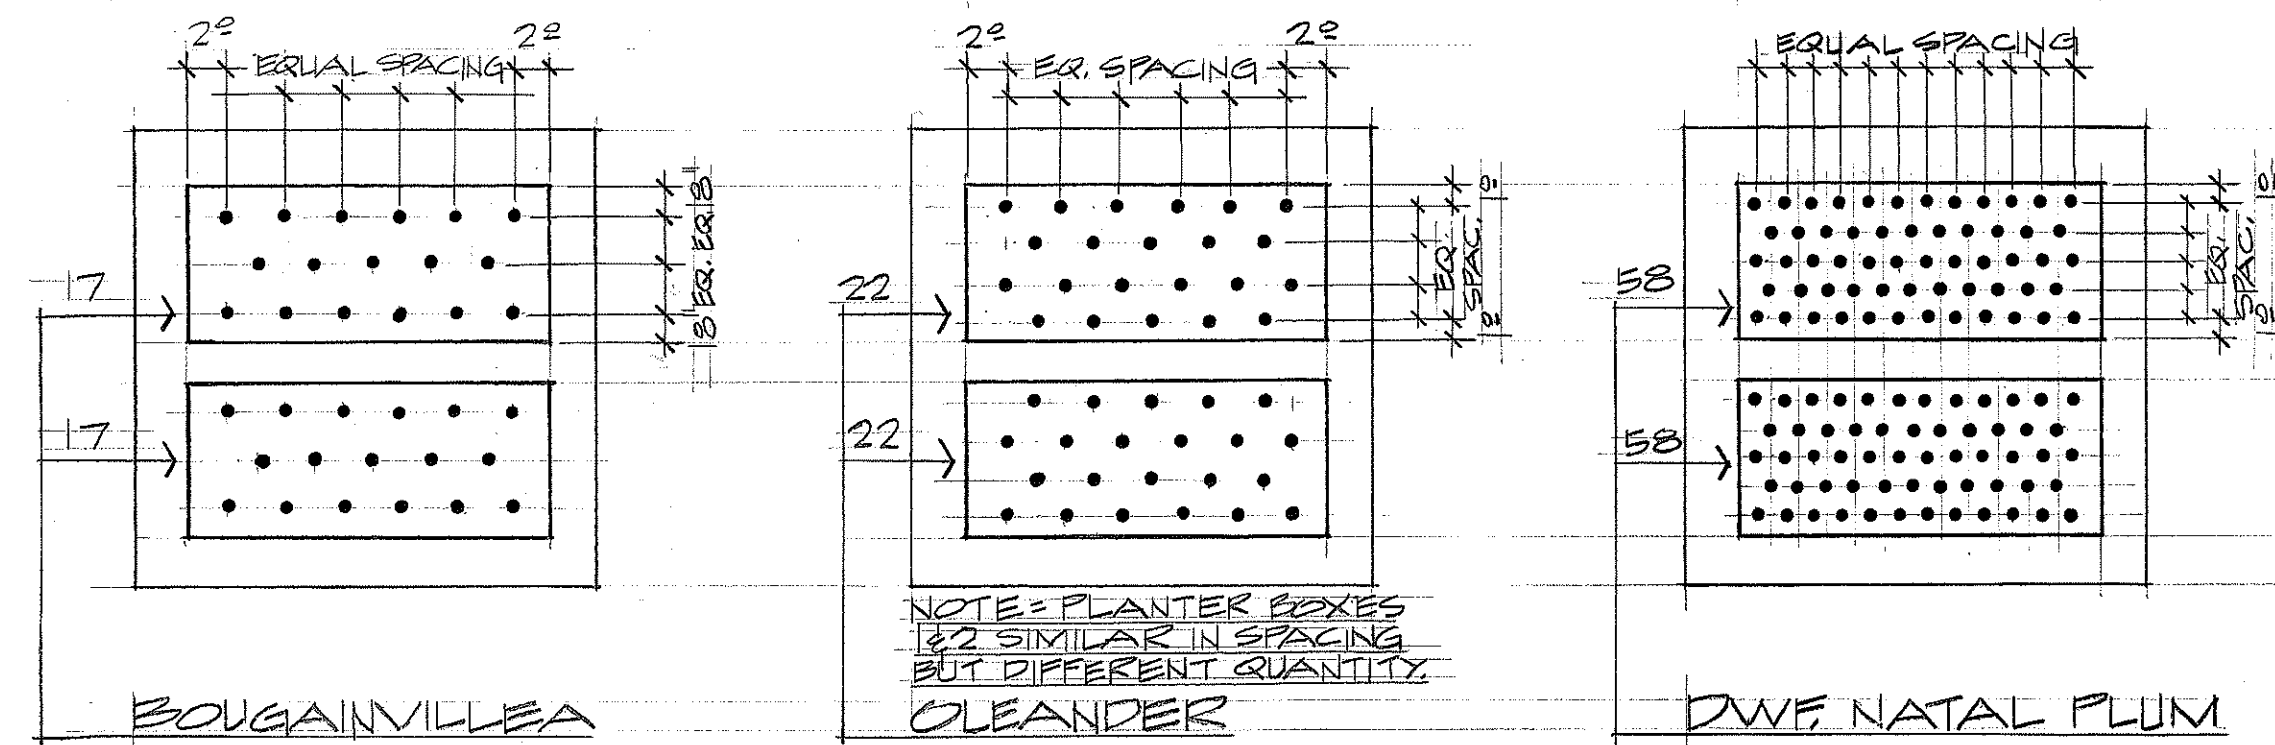
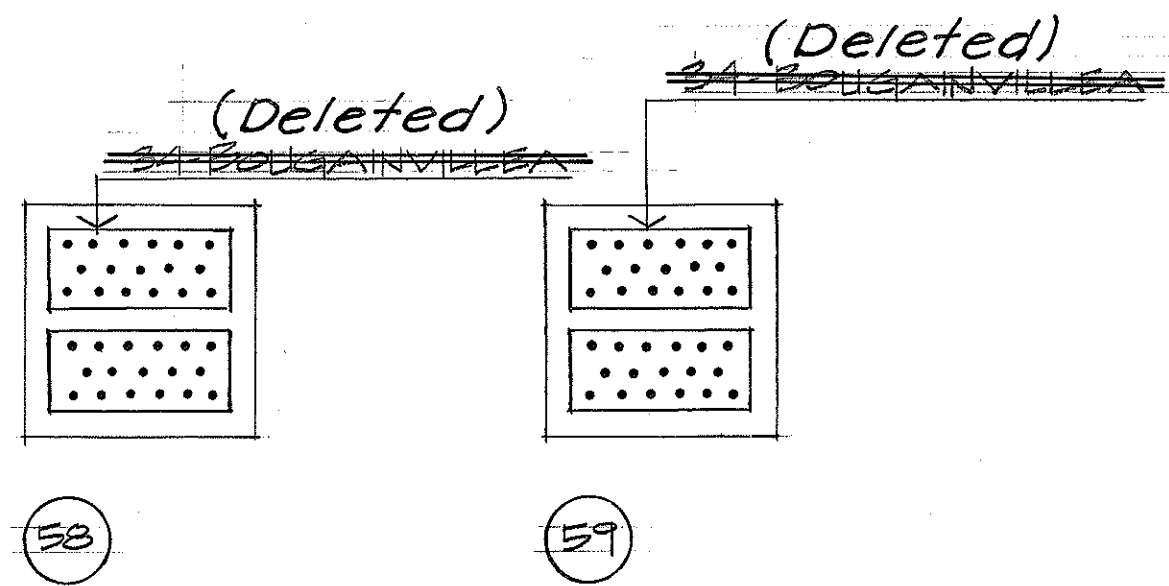
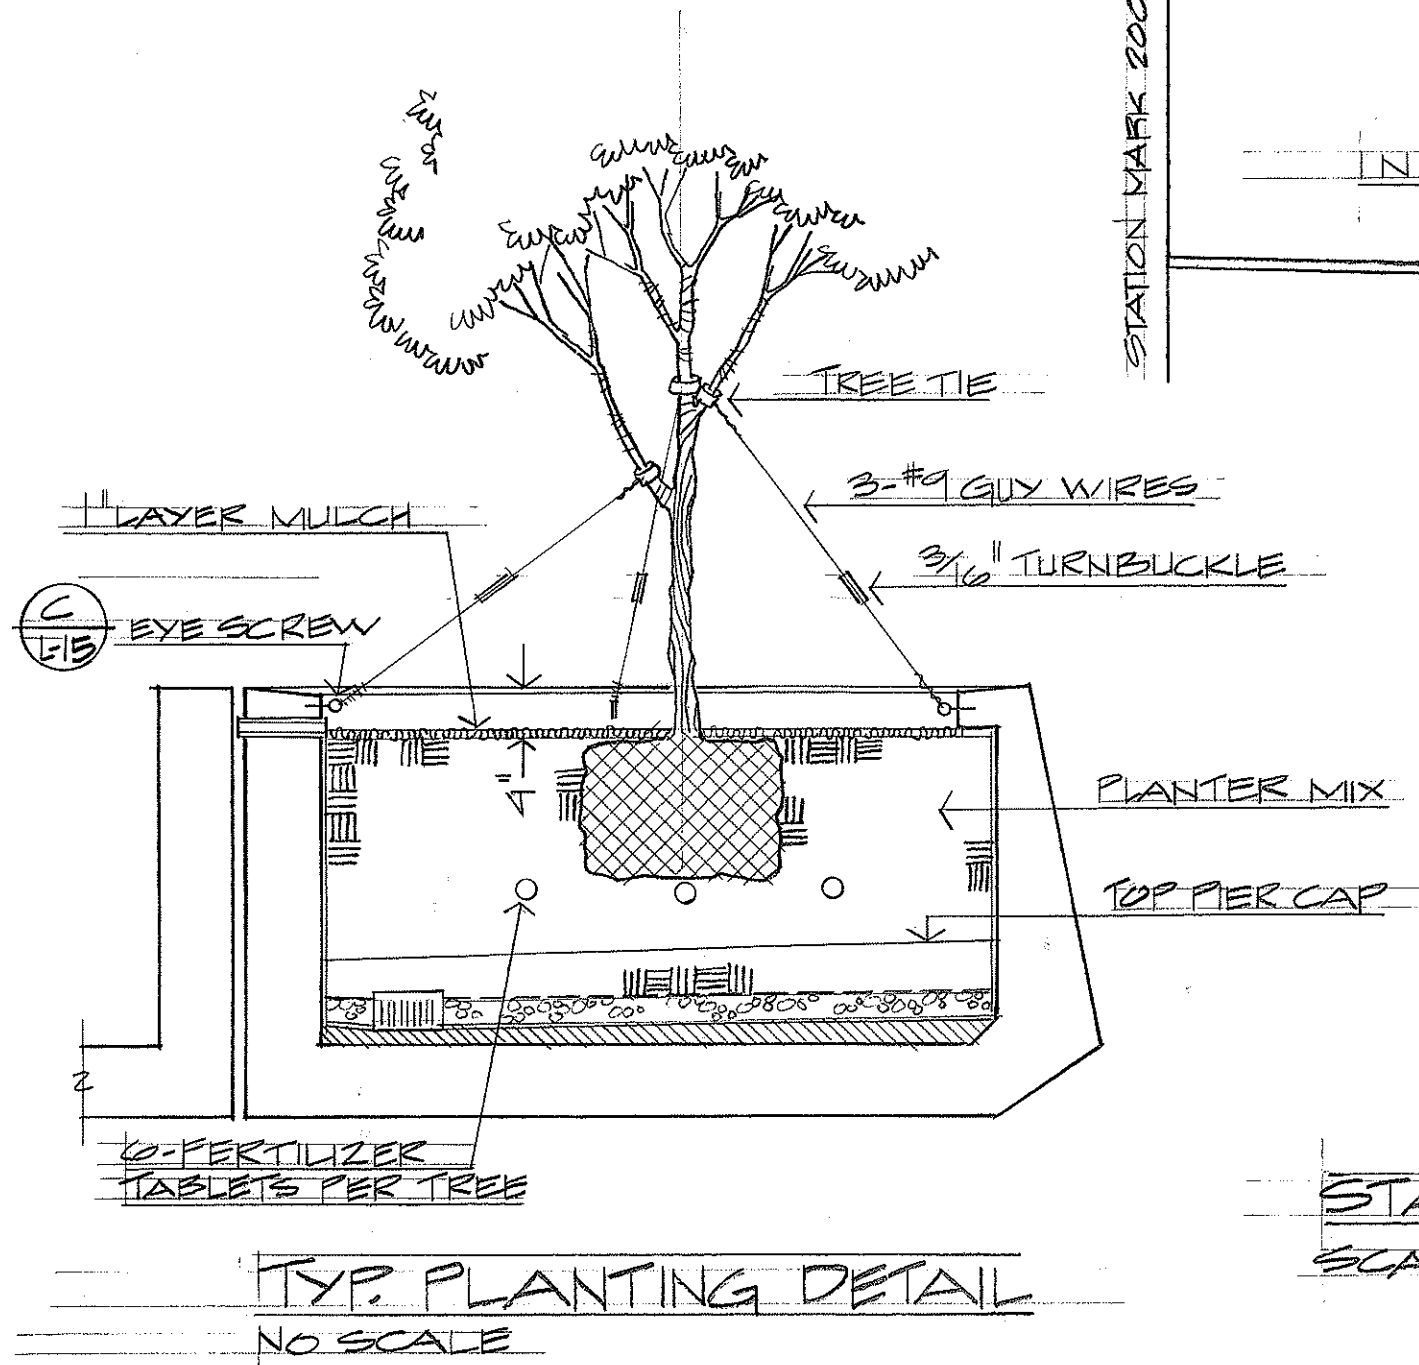


FED. ROAD DIST. NO.	STATE	FED. AID PROJ. NO.	FISCAL YEAR	SHEET NO.	TOTAL SHEETS
HAWAII	HAW.	I-H-1(163)16	1980	15	16

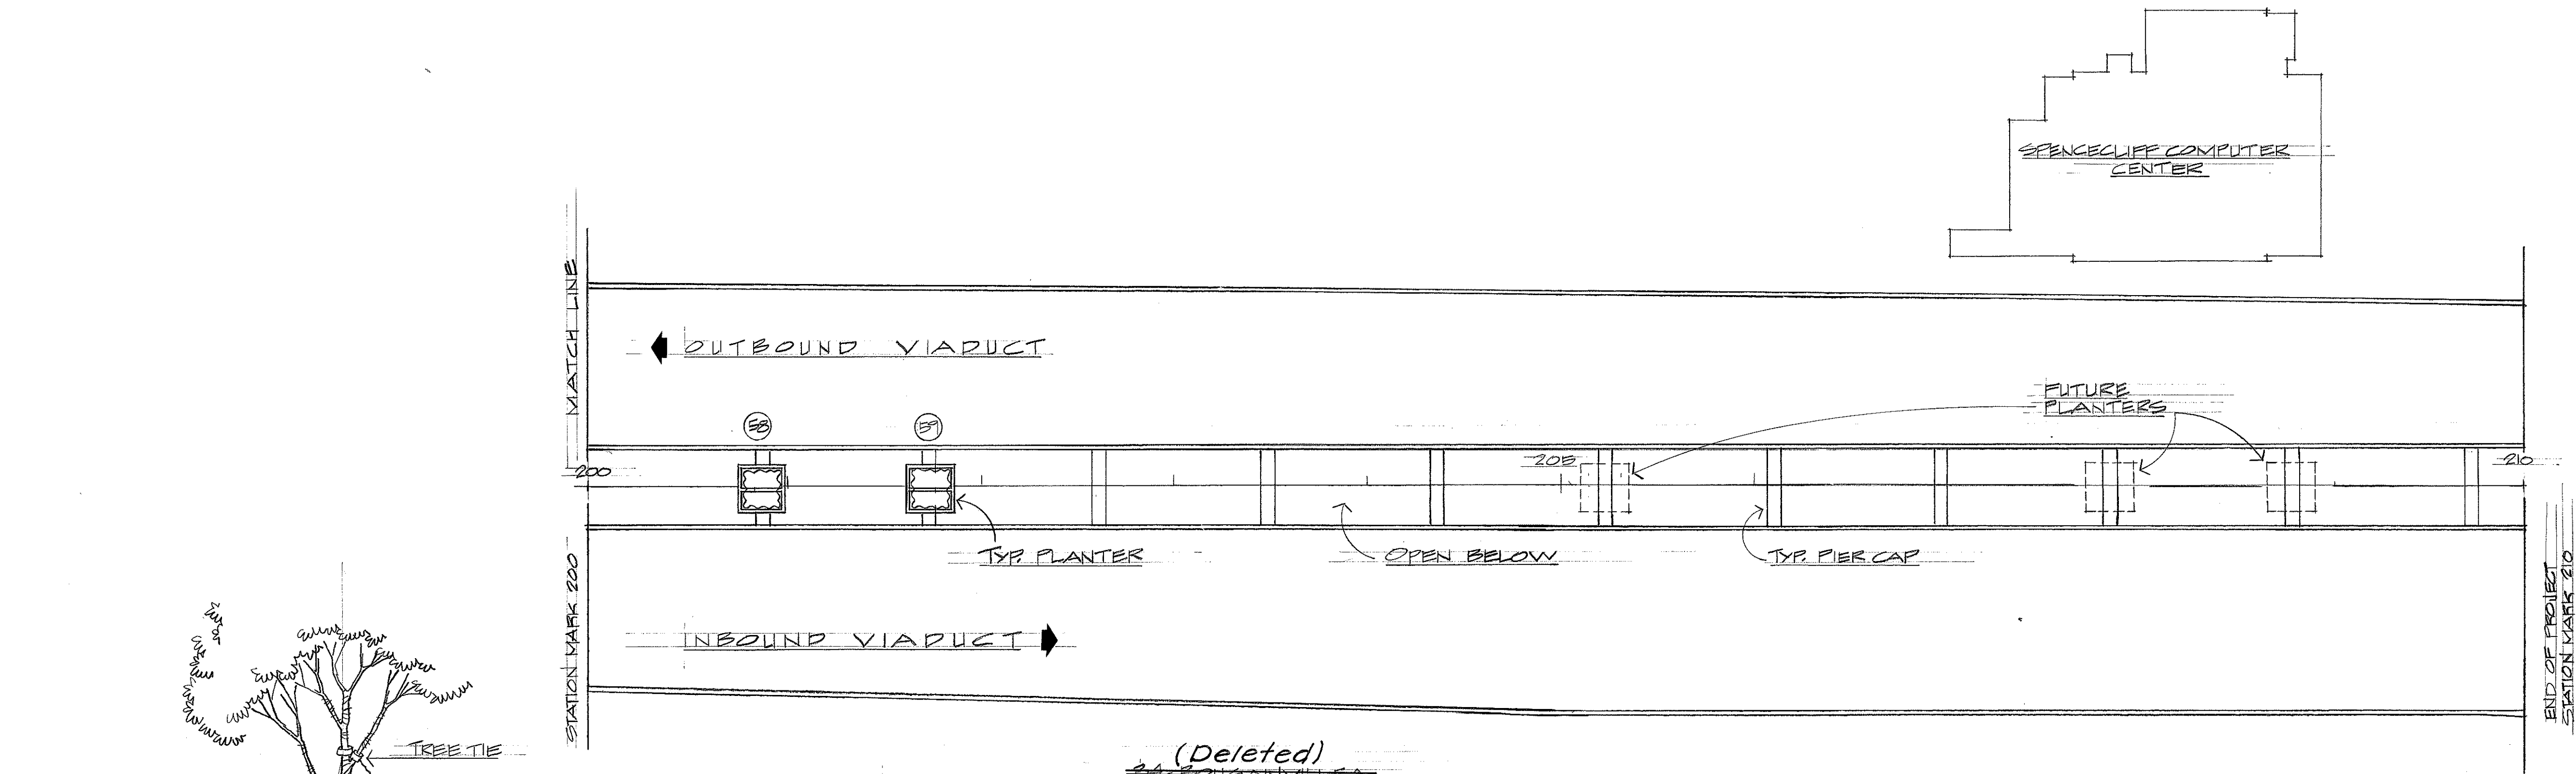

PLANT LIST		
QUANTITY	NAME	DESCRIPTION
26	SILVER BUTTWOOD = CONOCARPUS ERECTUS VAR. ARGENTUS	30\"
572	OLEANDER \"PETITE PINK\" = NERIUM OLEANDER DWF. HYB.	20\"
513	OLEANDER \"PETITE SALMON\" = NERIUM OLEANDER DWF. HYB.	20\"
544	OLEANDER \"MISS MANILA\" = NERIUM OLEANDER DWF. HYB.	20\"
512	BOUGAINVILLEA \"EMPEROR\" = BOUGAINVILLEA GLABRA SPP.	10\"
1,624	DWF. NATAL PLUM = CARISSA GRANDIFLORA VAR. \"BOXWOOD BEAUTY\"	12\"

STATE OF HAWAII
DEPARTMENT OF TRANSPORTATION
LAND TRANSPORTATION FACILITIES DIVISION

PLANTING PLAN

AIRPORT INTERCHANGE VIADUCT LANDSCAPING
F.A.I. PROJECT NO. I-H-1(163)16

SCALE = 1\"

DATE: JAN 20 1981

SHEET NO. 14 OF 15 SHEETS

THIS WORK WAS PREPARED BY ME OR UNDER MY SUPERVISION.

Mervin K. F. Lau
Signature

SURVEY PLOTTED BY	DATE
DRAWN BY	
DESIGNED BY	
QUANTITIES BY	
CHECKED BY	
ORIGINAL PLAN	
NOTE BOOK	
No.	