
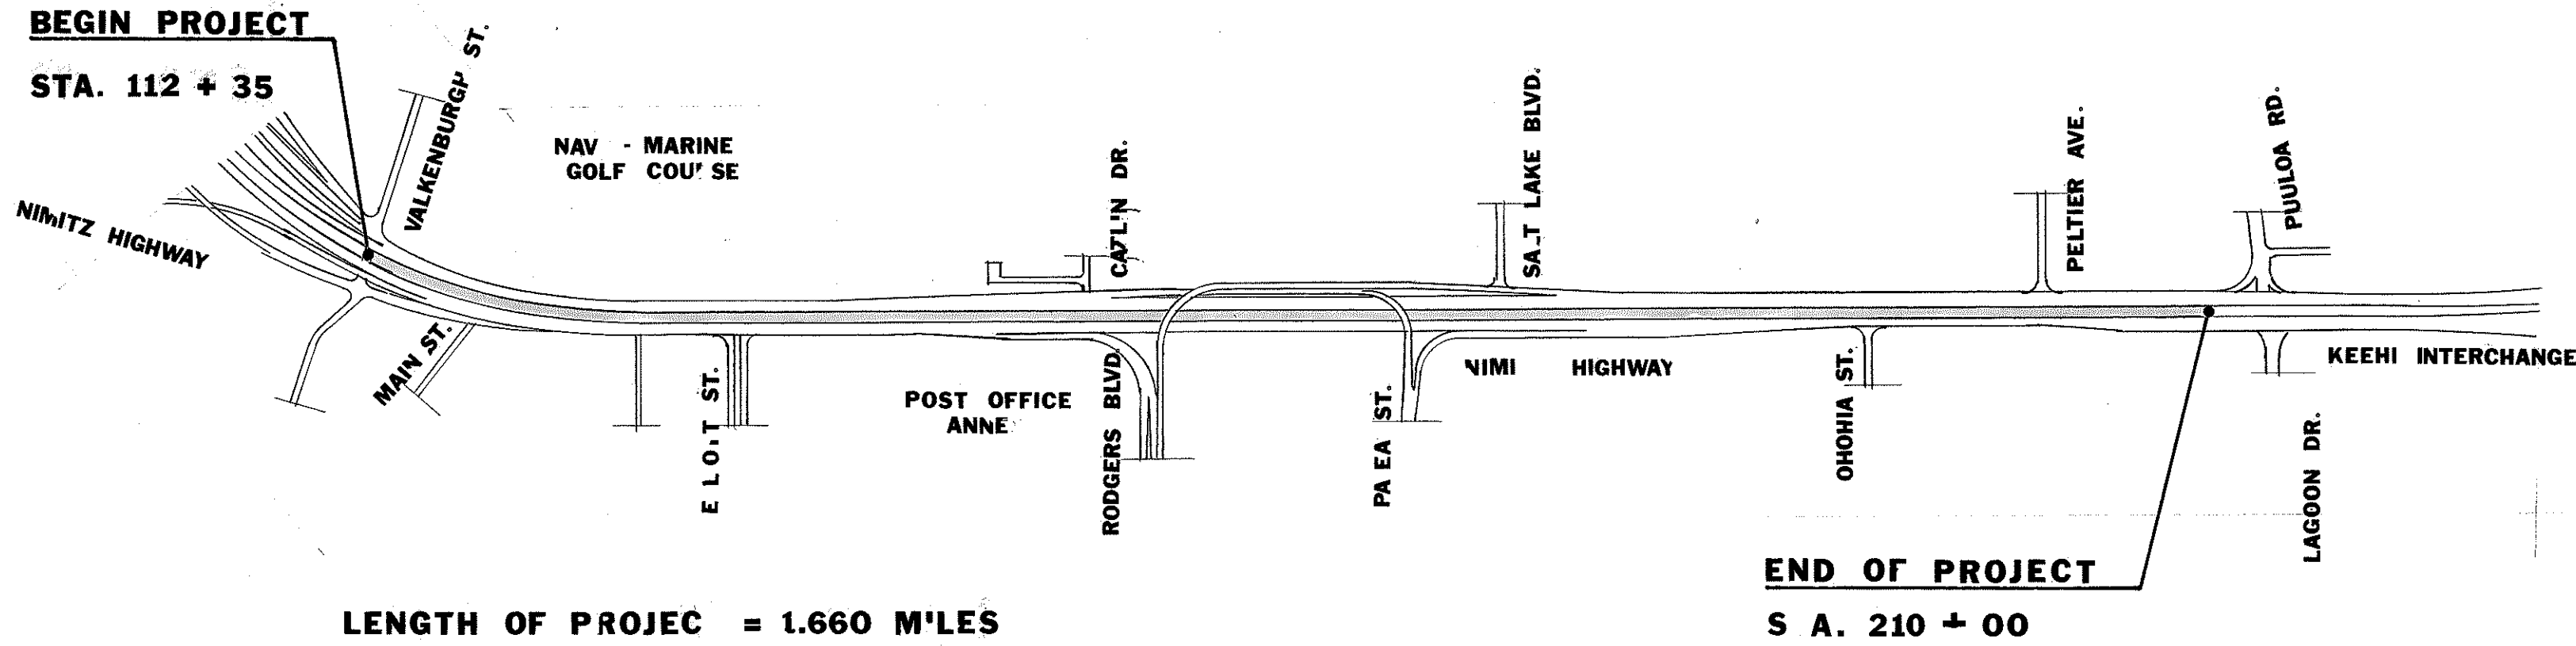


INDEX TO DRAWINGS	
SHEET NO	DESCRIPTION
T-1	TITLE SHEET
L-1	IRRIGATION, LEGEND & NOTES
L-2 to L-7	IRRIGATION PLANS
L-8	IRRIGATION DETAILS
L-9	"AS-BUILT" PLANS
L-10	IRRIGATION SUMMARY
L-11 to L-13	PLANTING PLANS
L-14	PLANTING, PLANT LIST & DETAILS
L-15	LANDSCAPE DETAILS

STATE OF HAWAII
DEPARTMENT OF TRANSPORTATION
HIGHWAYS DIVISION
HONOLULU, HAWAII
"AS BUILT"
PLANS FOR
CONSTRUCTION OF A PORTION OF
INTERSTATE ROUTE H-1
AIRPORT INTERCHANGE
VIADUCT LANDSCAPING
FEDERAL AID INTERSTATE PROJECT I-H1-1(163):16
DISTRICT OF HONOLULU
ISLAND OF OAHU

FED. ROAD DIST. NO.	STATE	FED. AID PROJ. NO.	FISCAL YEAR	SHEET NO.	TOTAL SHEETS
HAWAII	HAW.	I-H1-1(163):16	1980	1	16

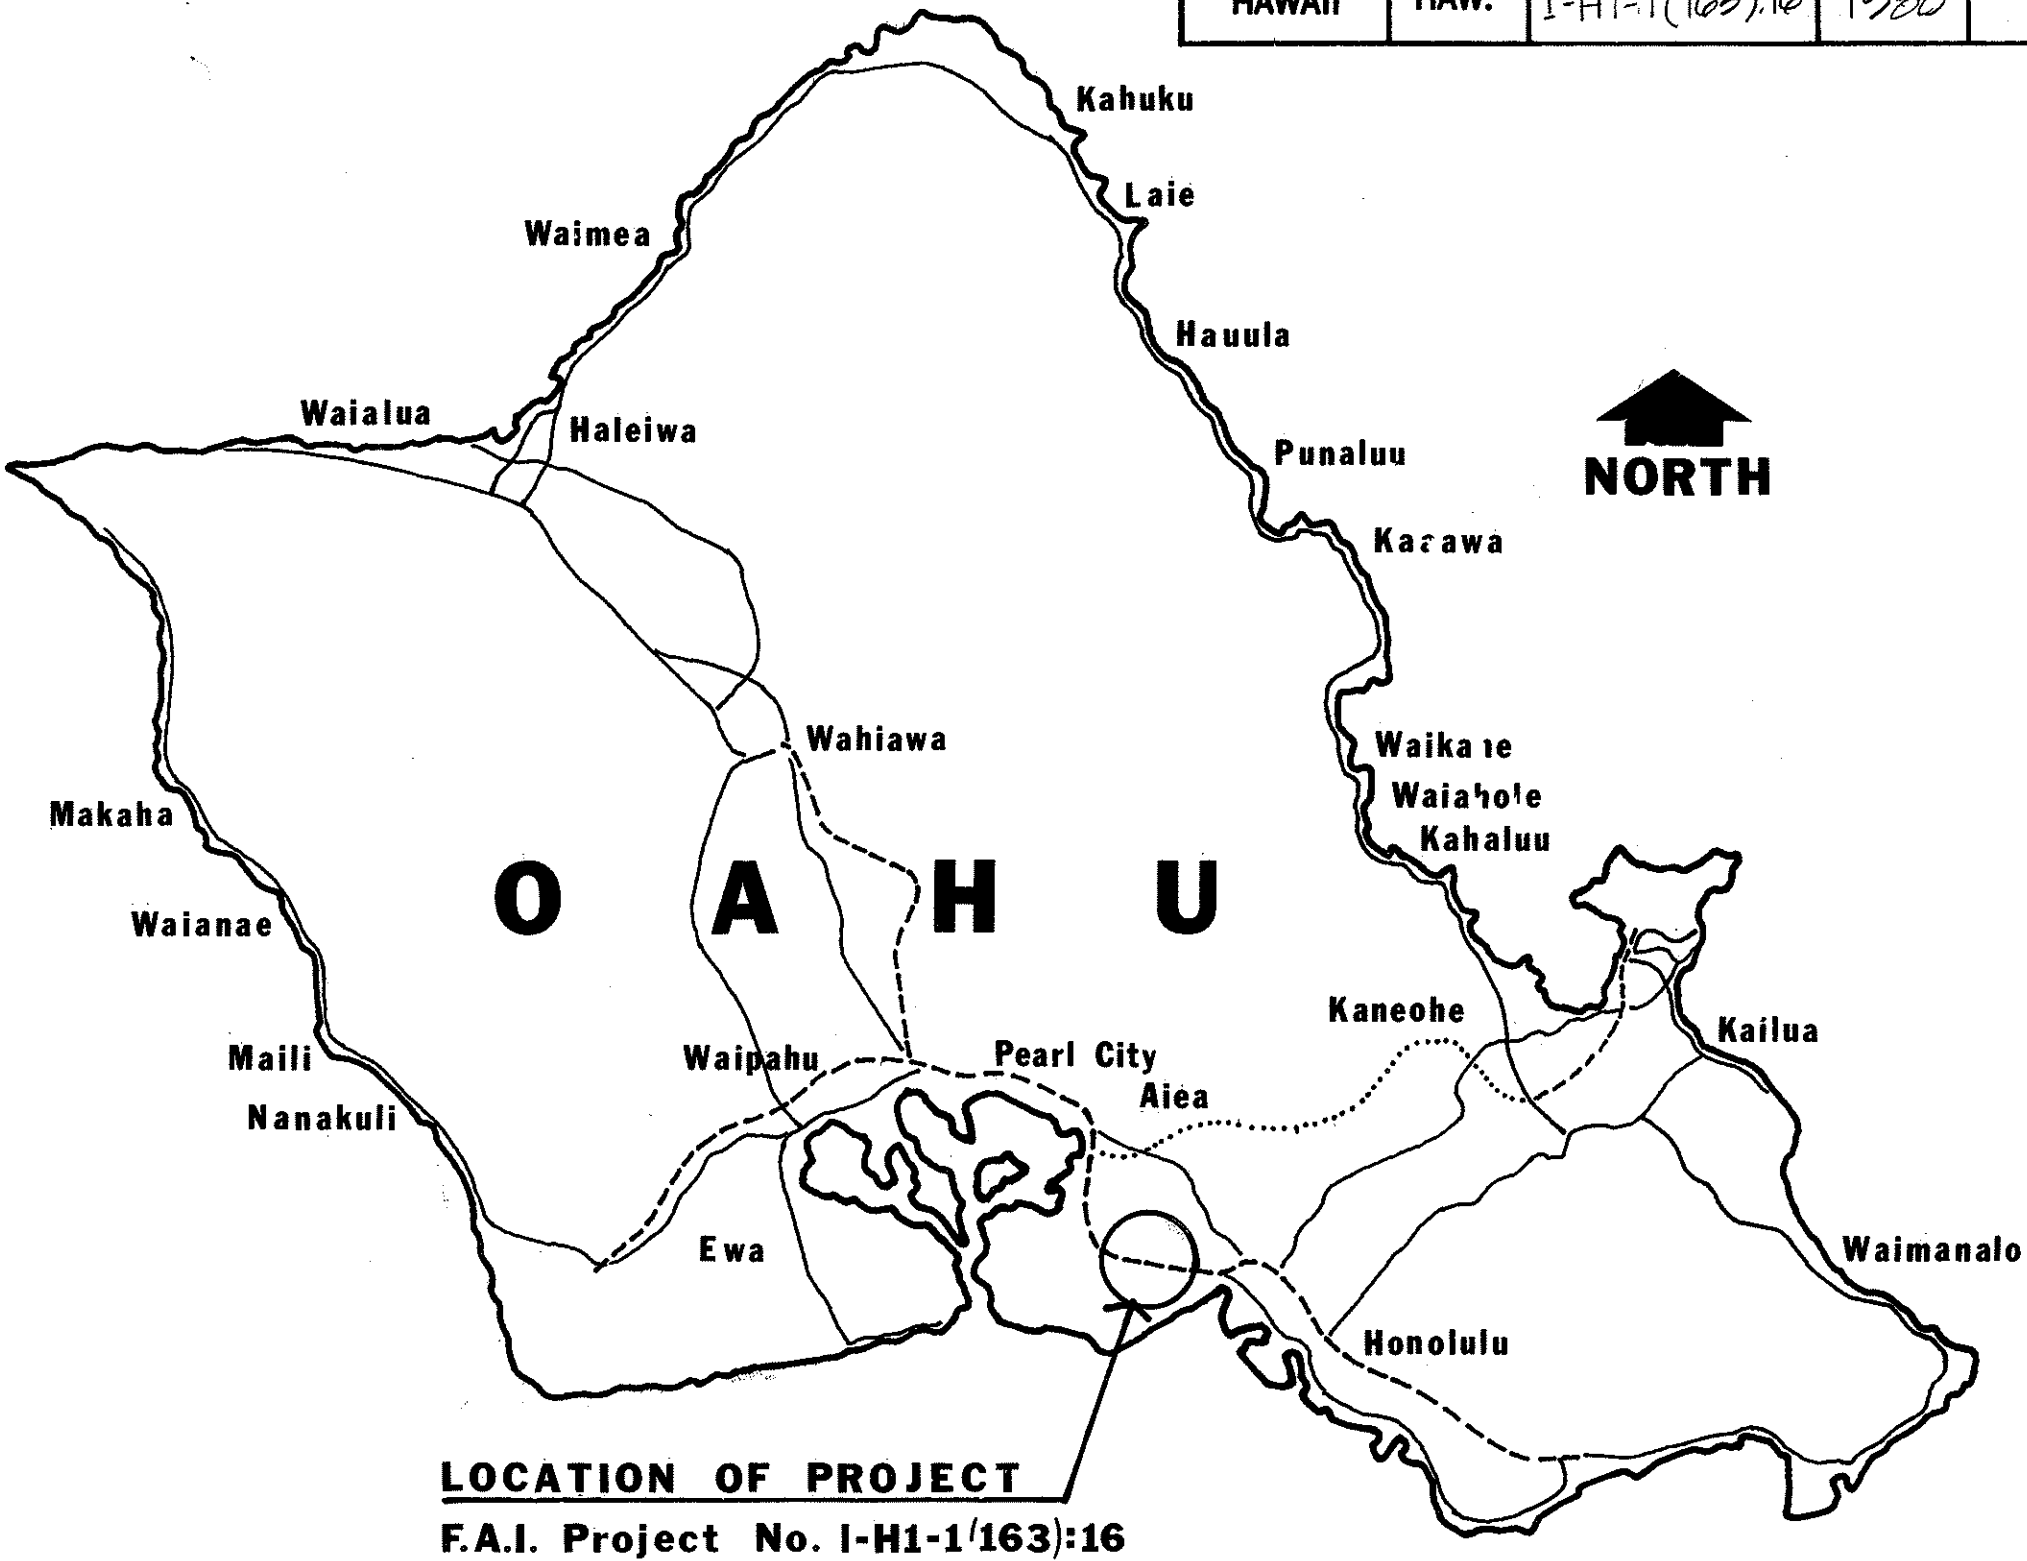

ALL CHANGES MADE DURING CONSTRUCTION HAVE BEEN INCORPORATED ON THESE PLANS IN RED EXCEPT CHANGES IN THE ORIGINAL THEORETICAL QUANTITIES. FOR ACTUAL QUANTITIES, REFER TO PROJECT LEDGER AND/OR COMPUTATION BOOK.

Paul D. Drumm
RESIDENT ENGINEER
5-16-83
DATE

DEPARTMENT OF TRANSPORTATION
FEDERAL HIGHWAY ADMINISTRATION
APPROVED:
Paul D. Drumm
DIVISION ADMINISTRATOR
3/17/81
DATE

DEPARTMENT OF TRANSPORTATION
STATE OF HAWAII
APPROVED:
Ryota H. Higashimura
DIR. OF TRANSPORTATION
DATE

SURVEY PLOTTED BY	DATE
DRAWN BY	
TRACED BY	
NOTED BY	
CHECKED BY	