



FED. ROAD DIST. NO.	STATE	FED. AID PROJ. NO.	FISCAL YEAR	SHEET NO.	TOTAL SHEETS
HAWAII	HAW.	I-HI-1(36)-13	1981	101	112

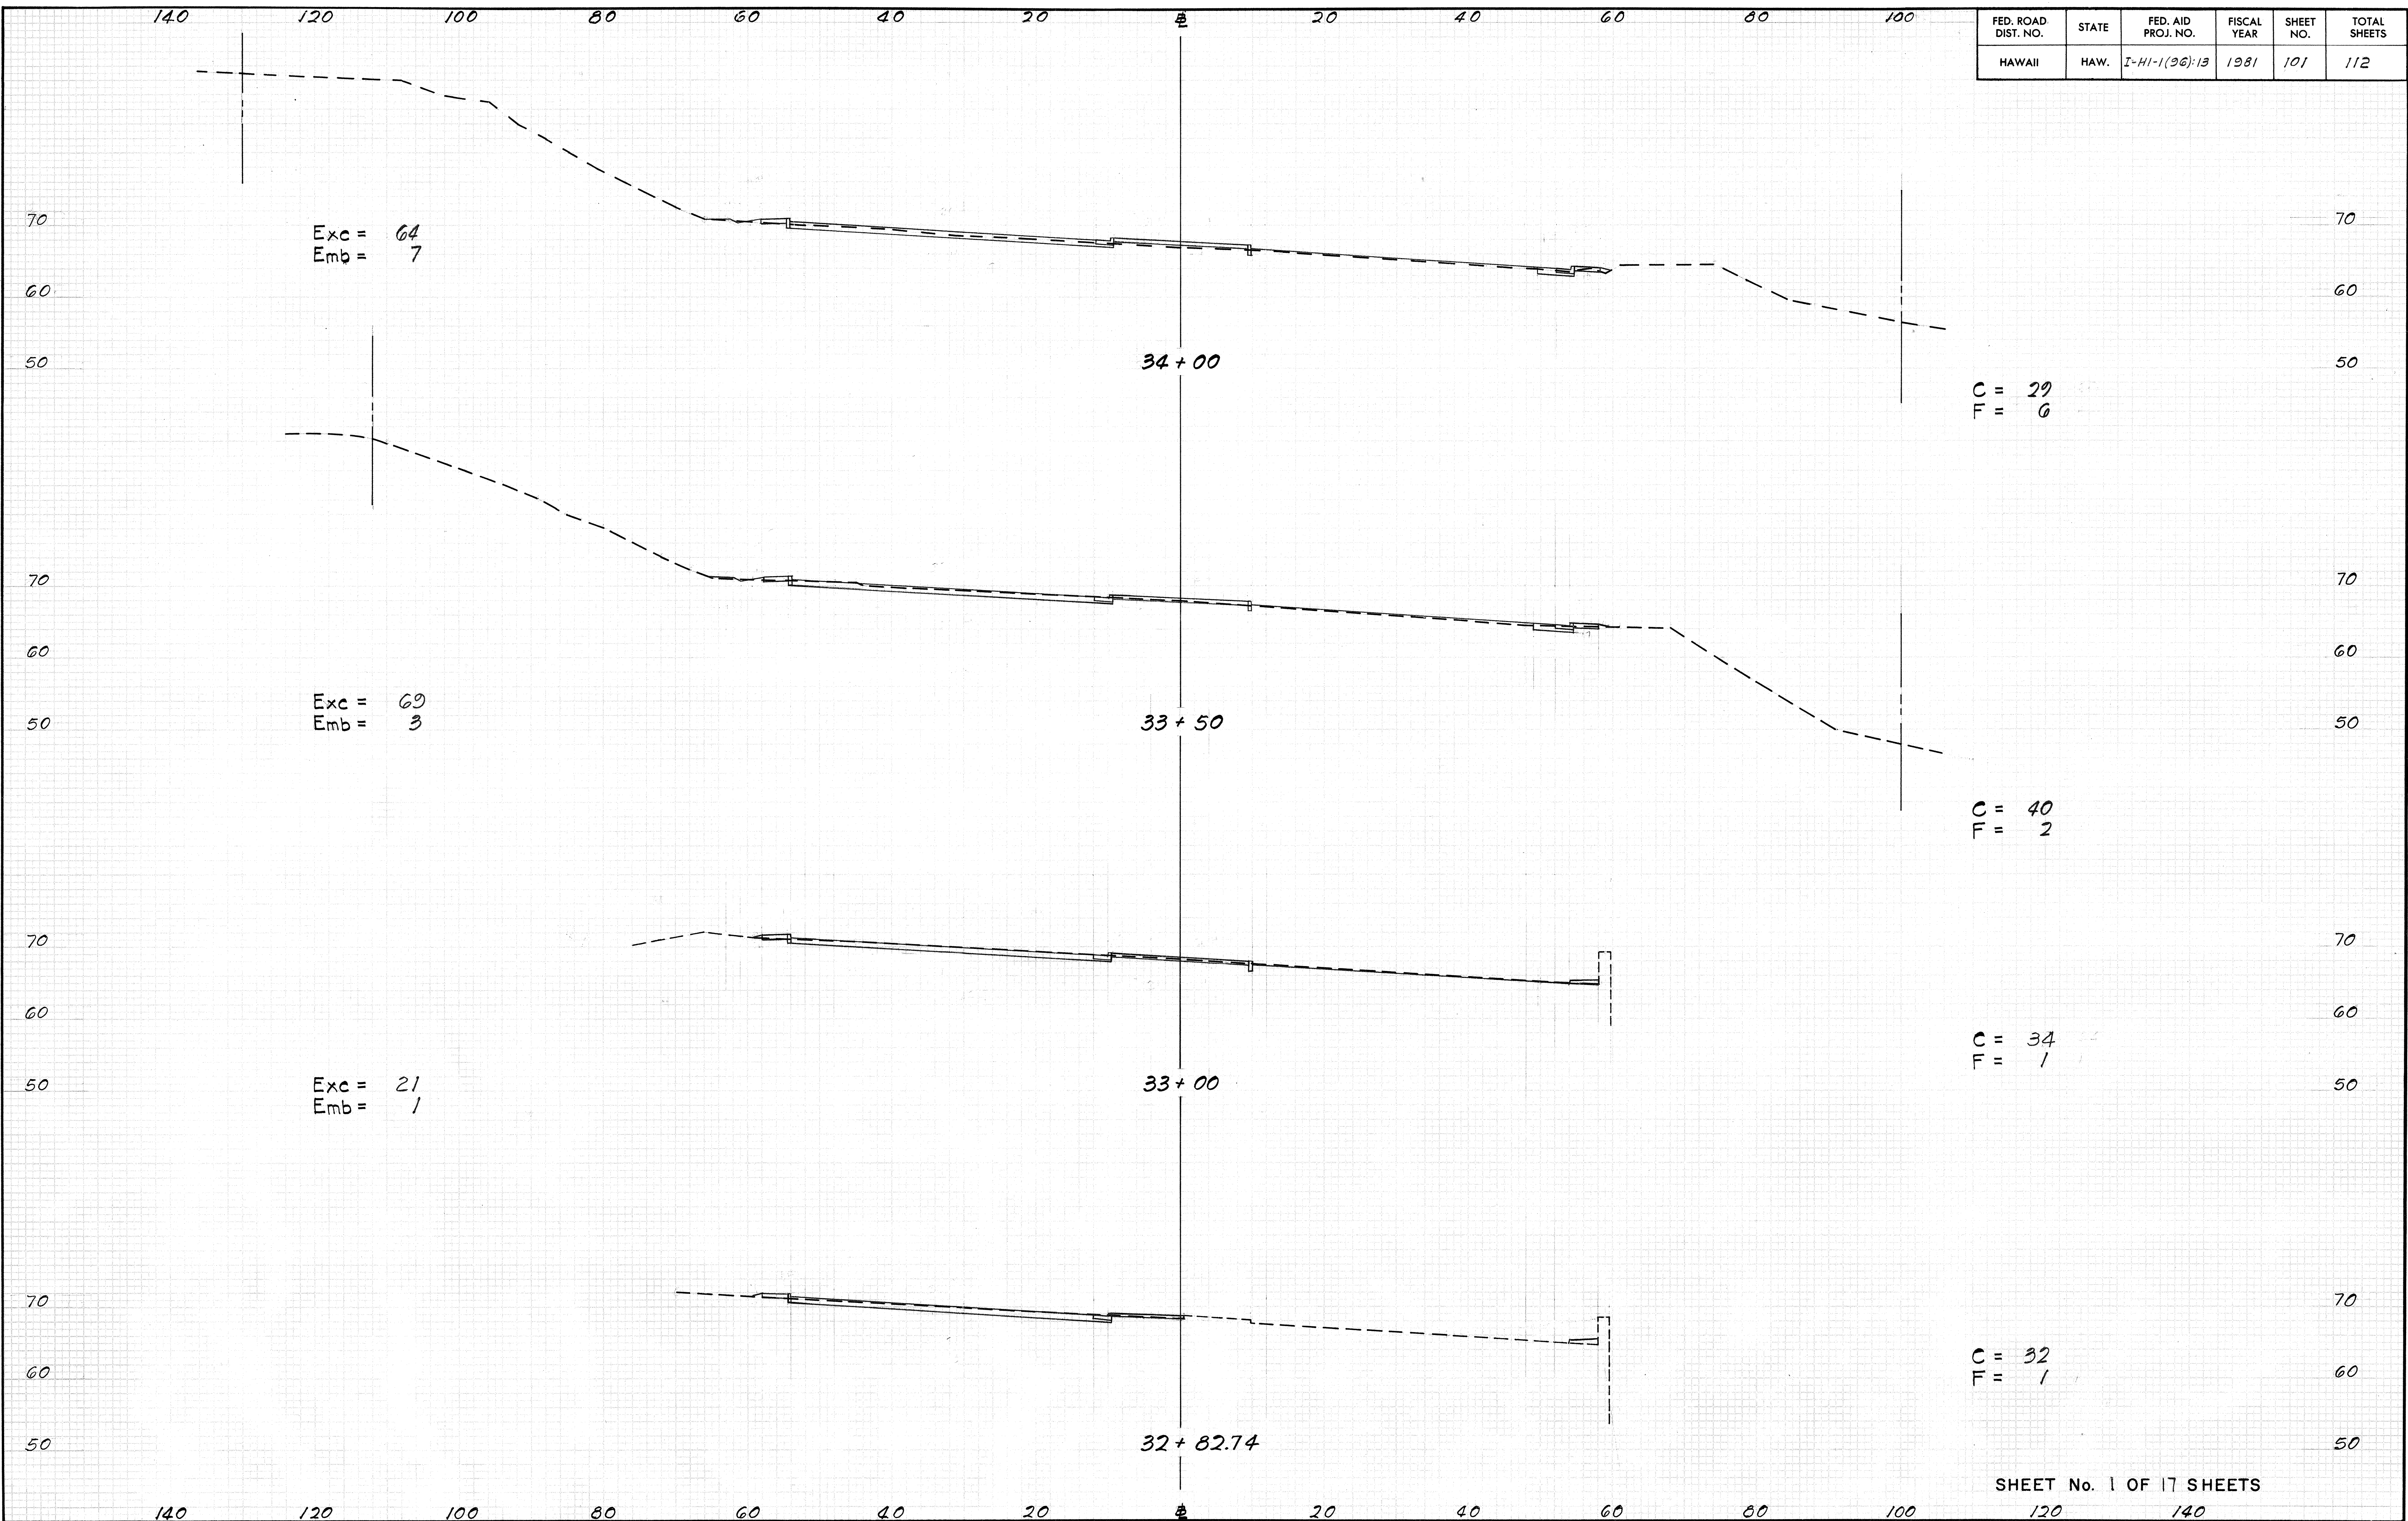

SHEET No. 1 OF 17 SHEETS

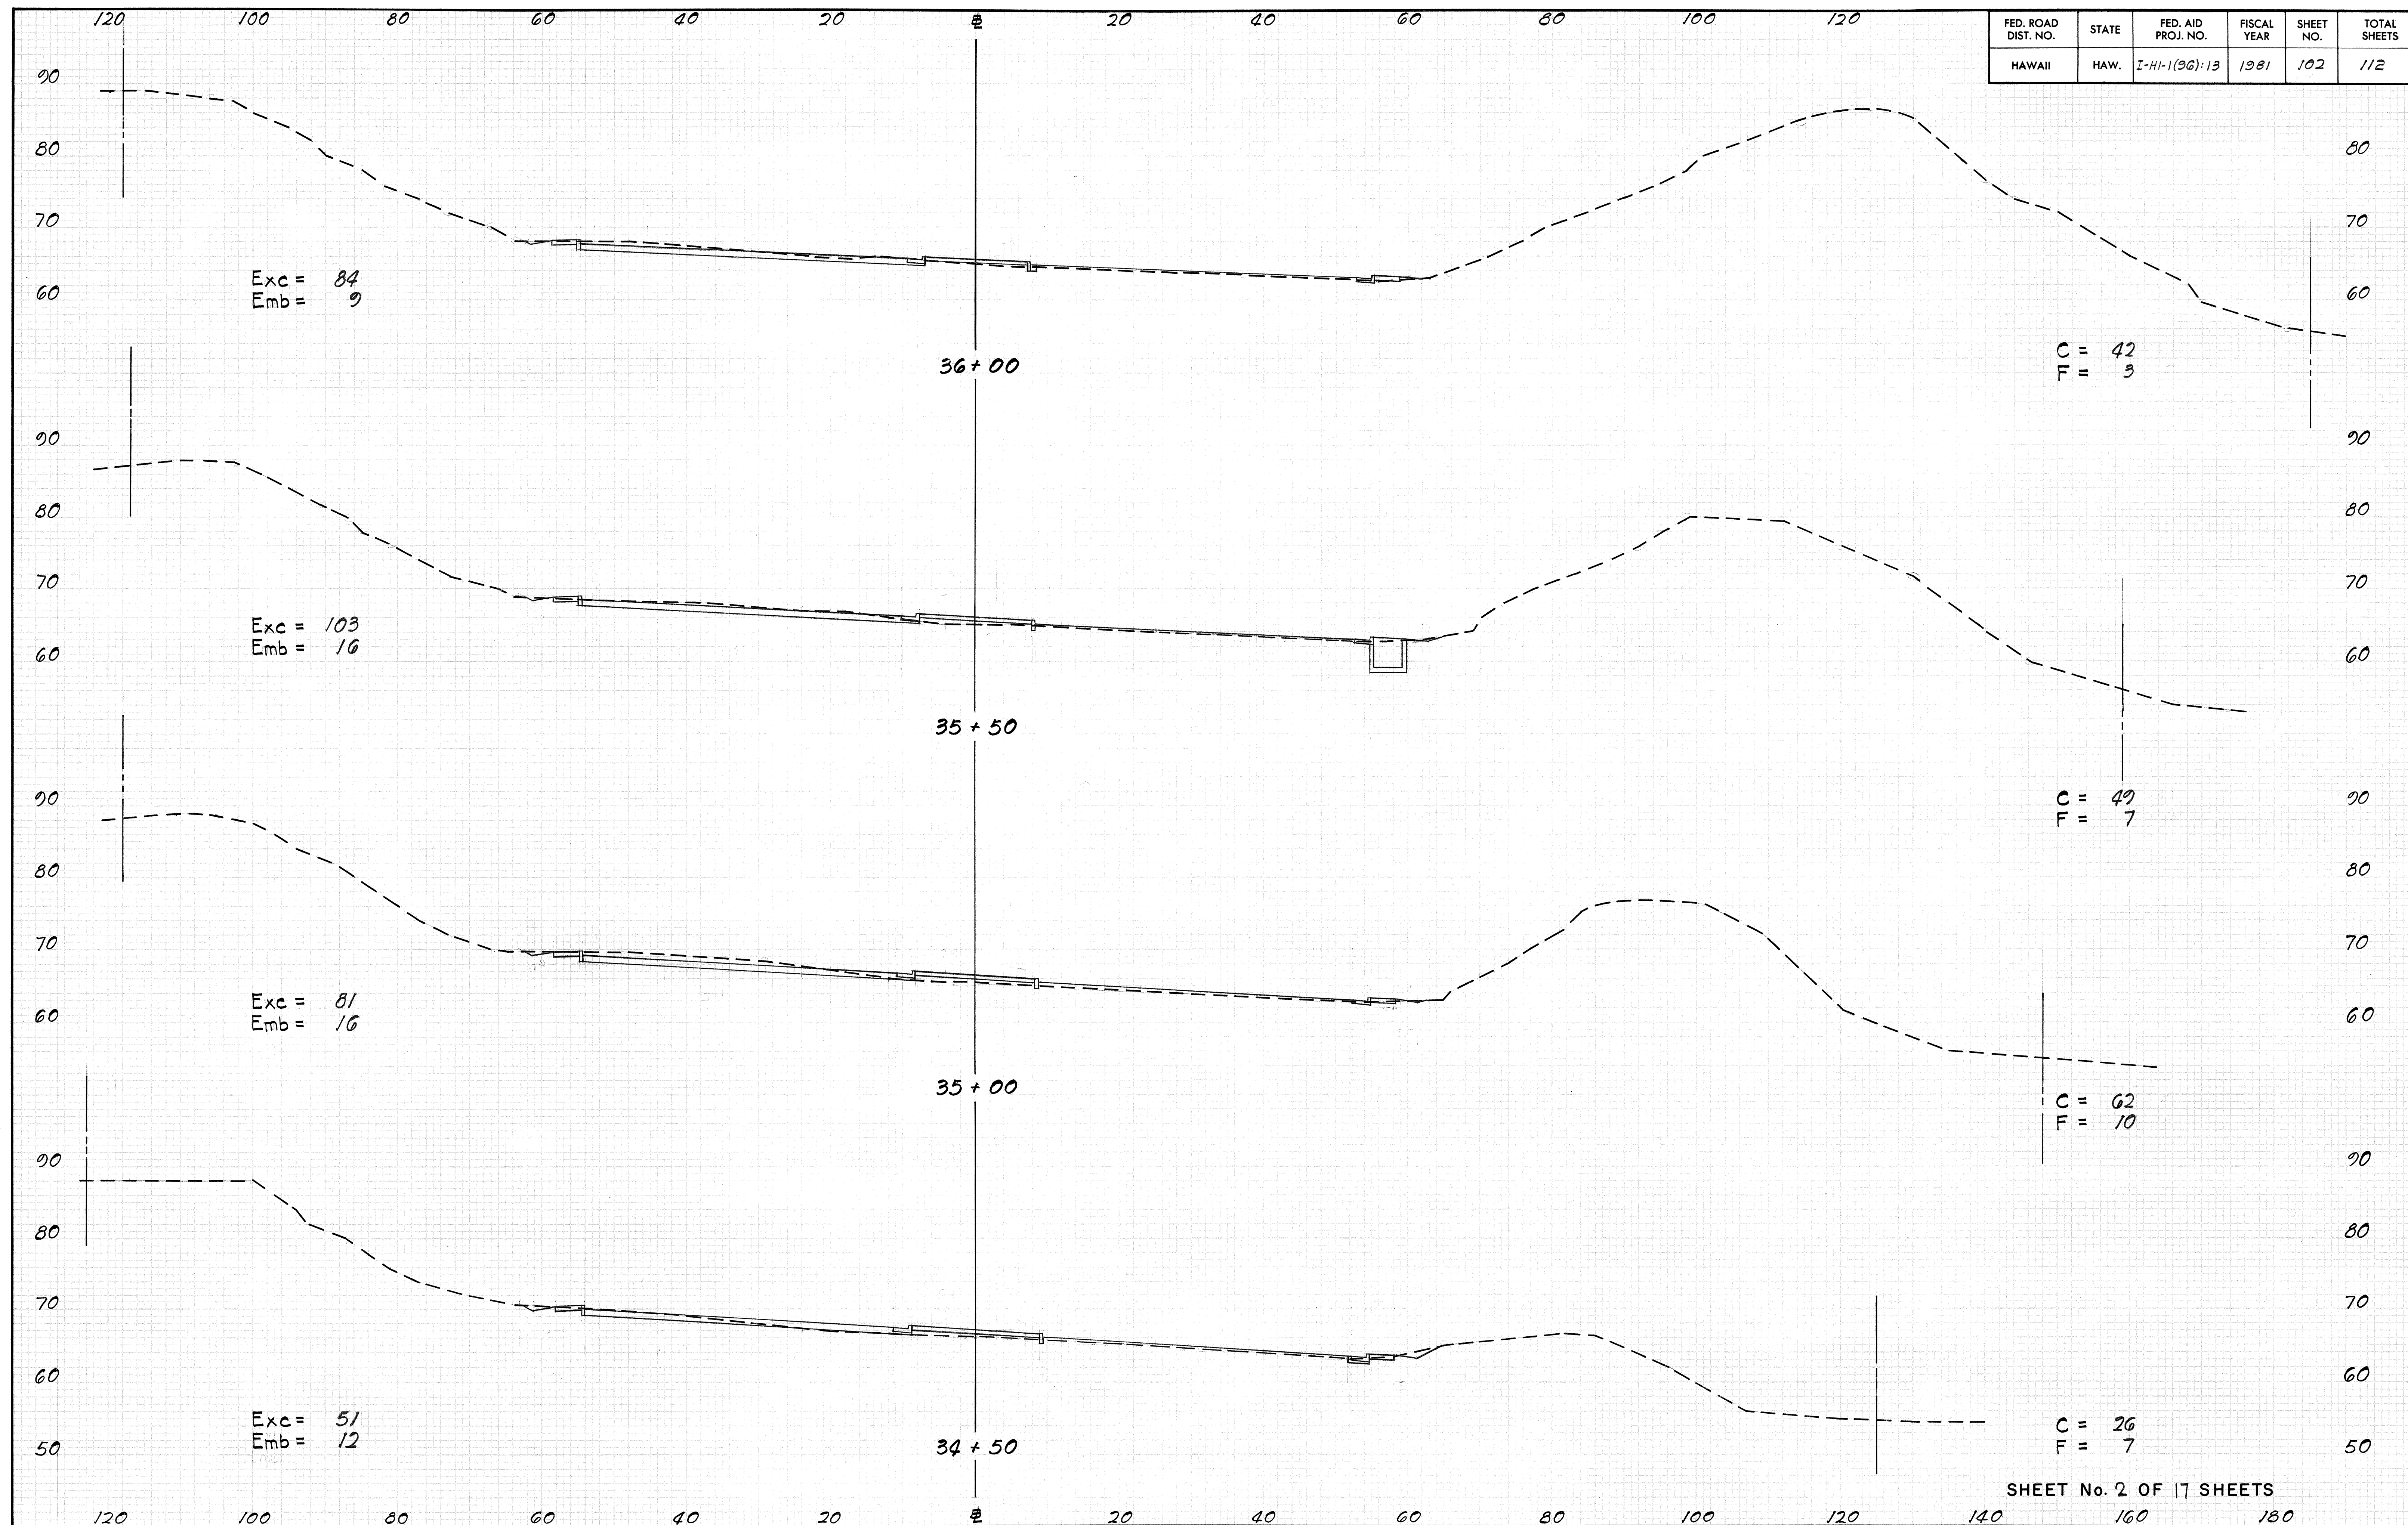

FED. ROAD DIST. NO.	STATE	FED. AID PROJ. NO.	FISCAL YEAR	SHEET NO.	TOTAL SHEETS
HAWAII	HAW.	I-HI-1(36):13	1981	103	112

Exc = 74
Emb = 19

Exc = 92
Emb = 3

Exc = 98
Emb = 0

Exc = 88
Emb = 15

Exc = 78
Emb = 18

C = 46
F = 3

C = 53
F = 0

C = 53
F = 0

C = 42
F = 16

FED. ROAD DIST. NO.	STATE	FED. AID PROJ. NO.	FISCAL YEAR	SHEET NO.	TOTAL SHEETS
HAWAII	HAW.	I-HI-1(36):13	1981	104	112

Exc = 60
Emb = 6

Exc = 58
Emb = 7

Exc = 63
Emb = 6

Exc = 66
Emb = 19

C = 32
F = 5


C = 31
F = 3

C = 37
F = 3

C = 34
F = 17

SHEET No. 4 OF 17 SHEETS


FED. ROAD DIST. NO.	STATE	FED. AID PROJ. NO.	FISCAL YEAR	SHEET NO.	TOTAL SHEETS
HAWAII	HAW.	I-41-1(26):13	1981	105	112

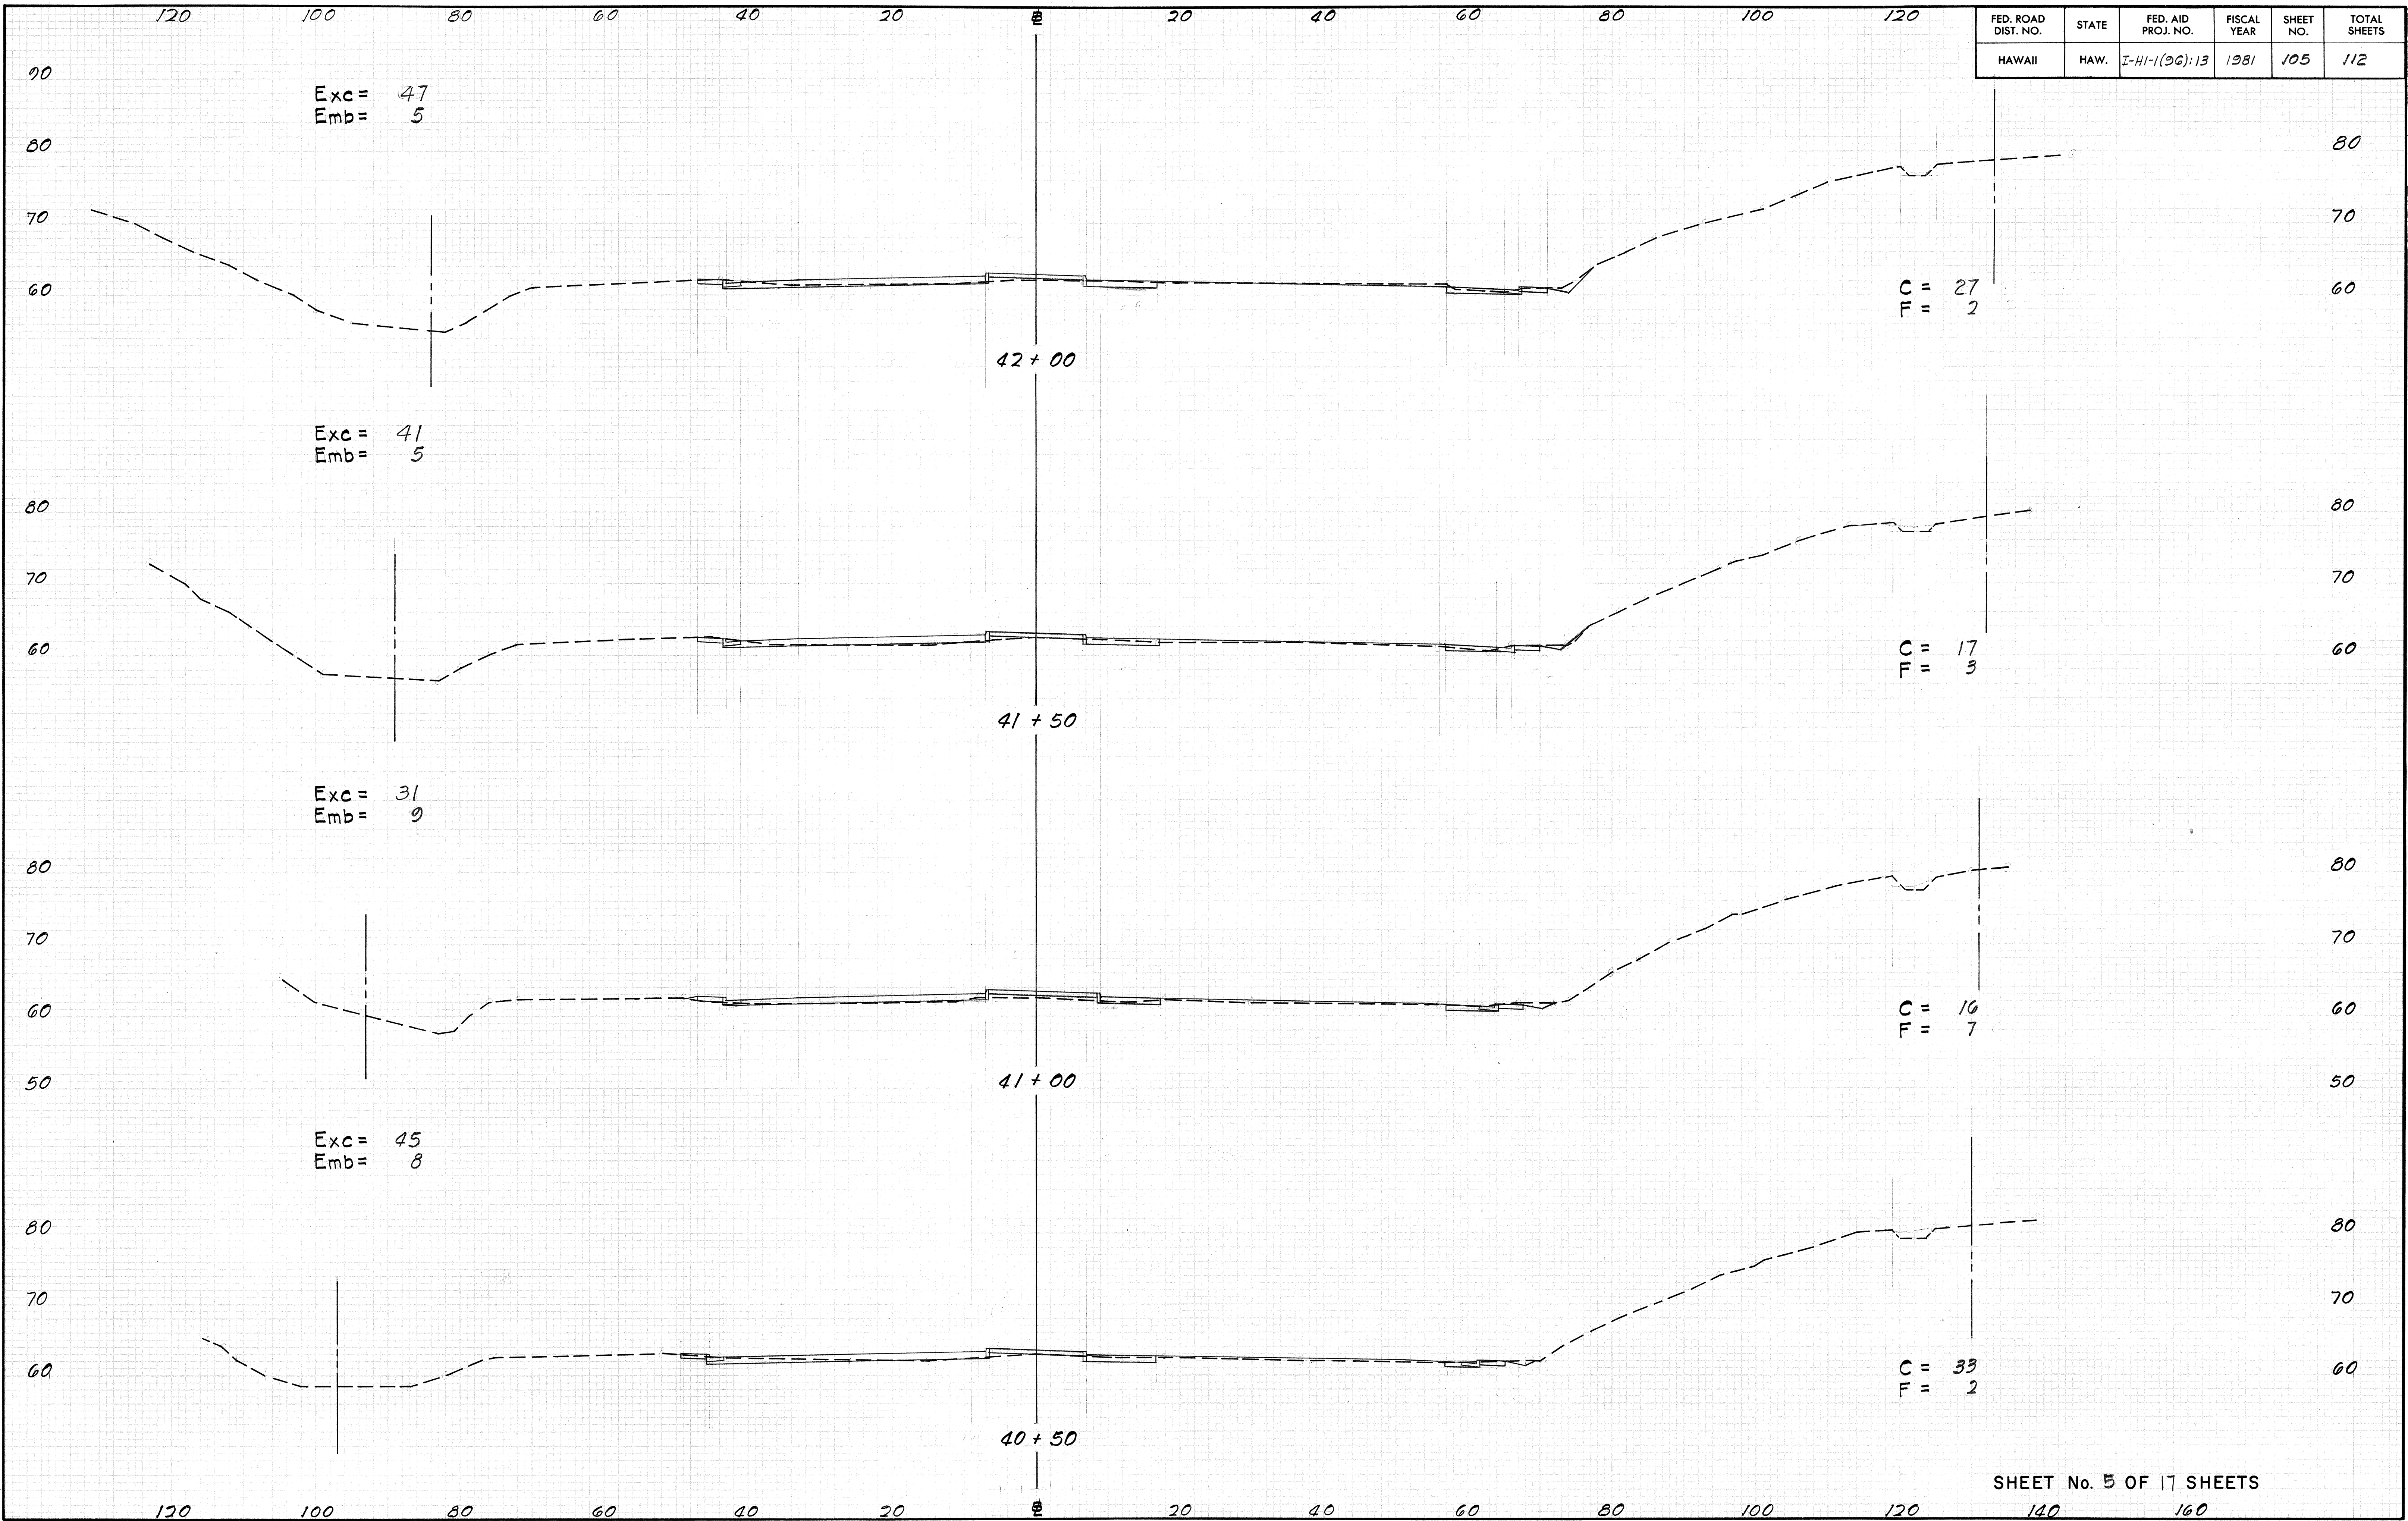


FED. ROAD DIST. NO.	STATE	FED. AID PROJ. NO.	FISCAL YEAR	SHEET NO.	TOTAL SHEETS
HAWAII	HAW.	I-HI-1(96)-13	1981	106	112

DATE	BY	FINAL SURVEY	DATE	BY	FINAL SURVEY

DATE	BY	ORIGINAL SURVEY	DATE	BY	ORIGINAL SURVEY

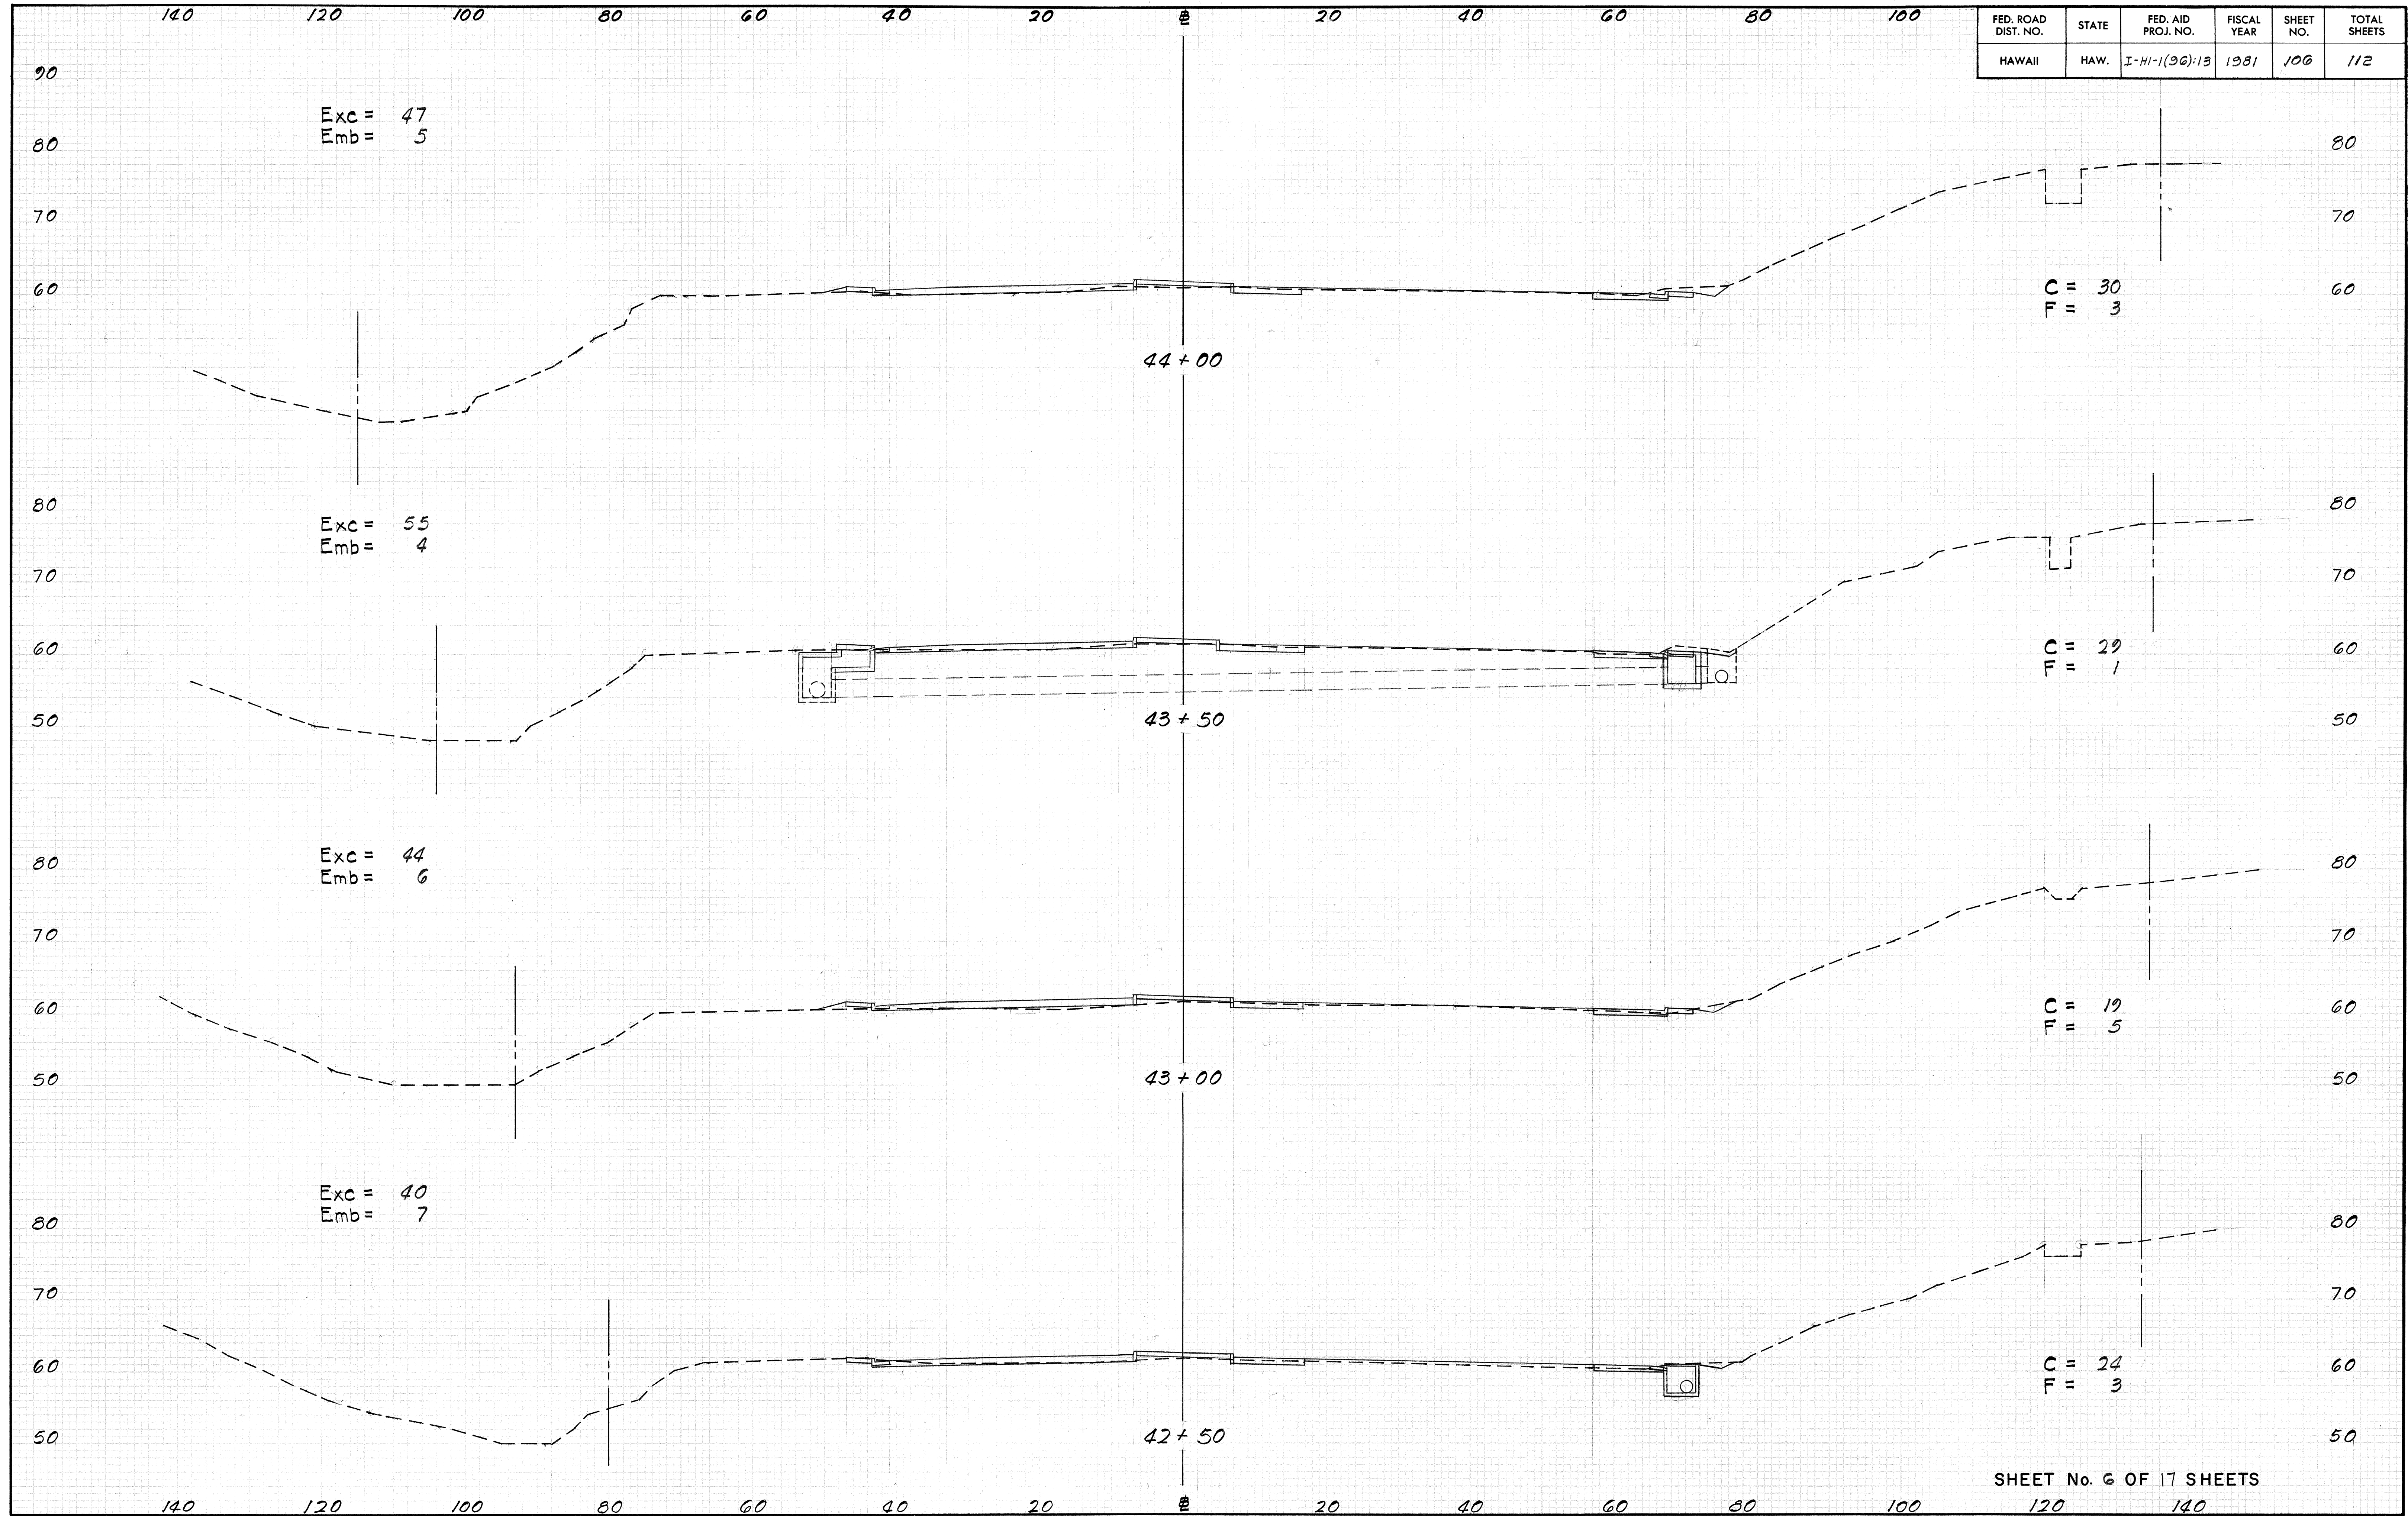


SHEET No. 6 OF 17 SHEETS

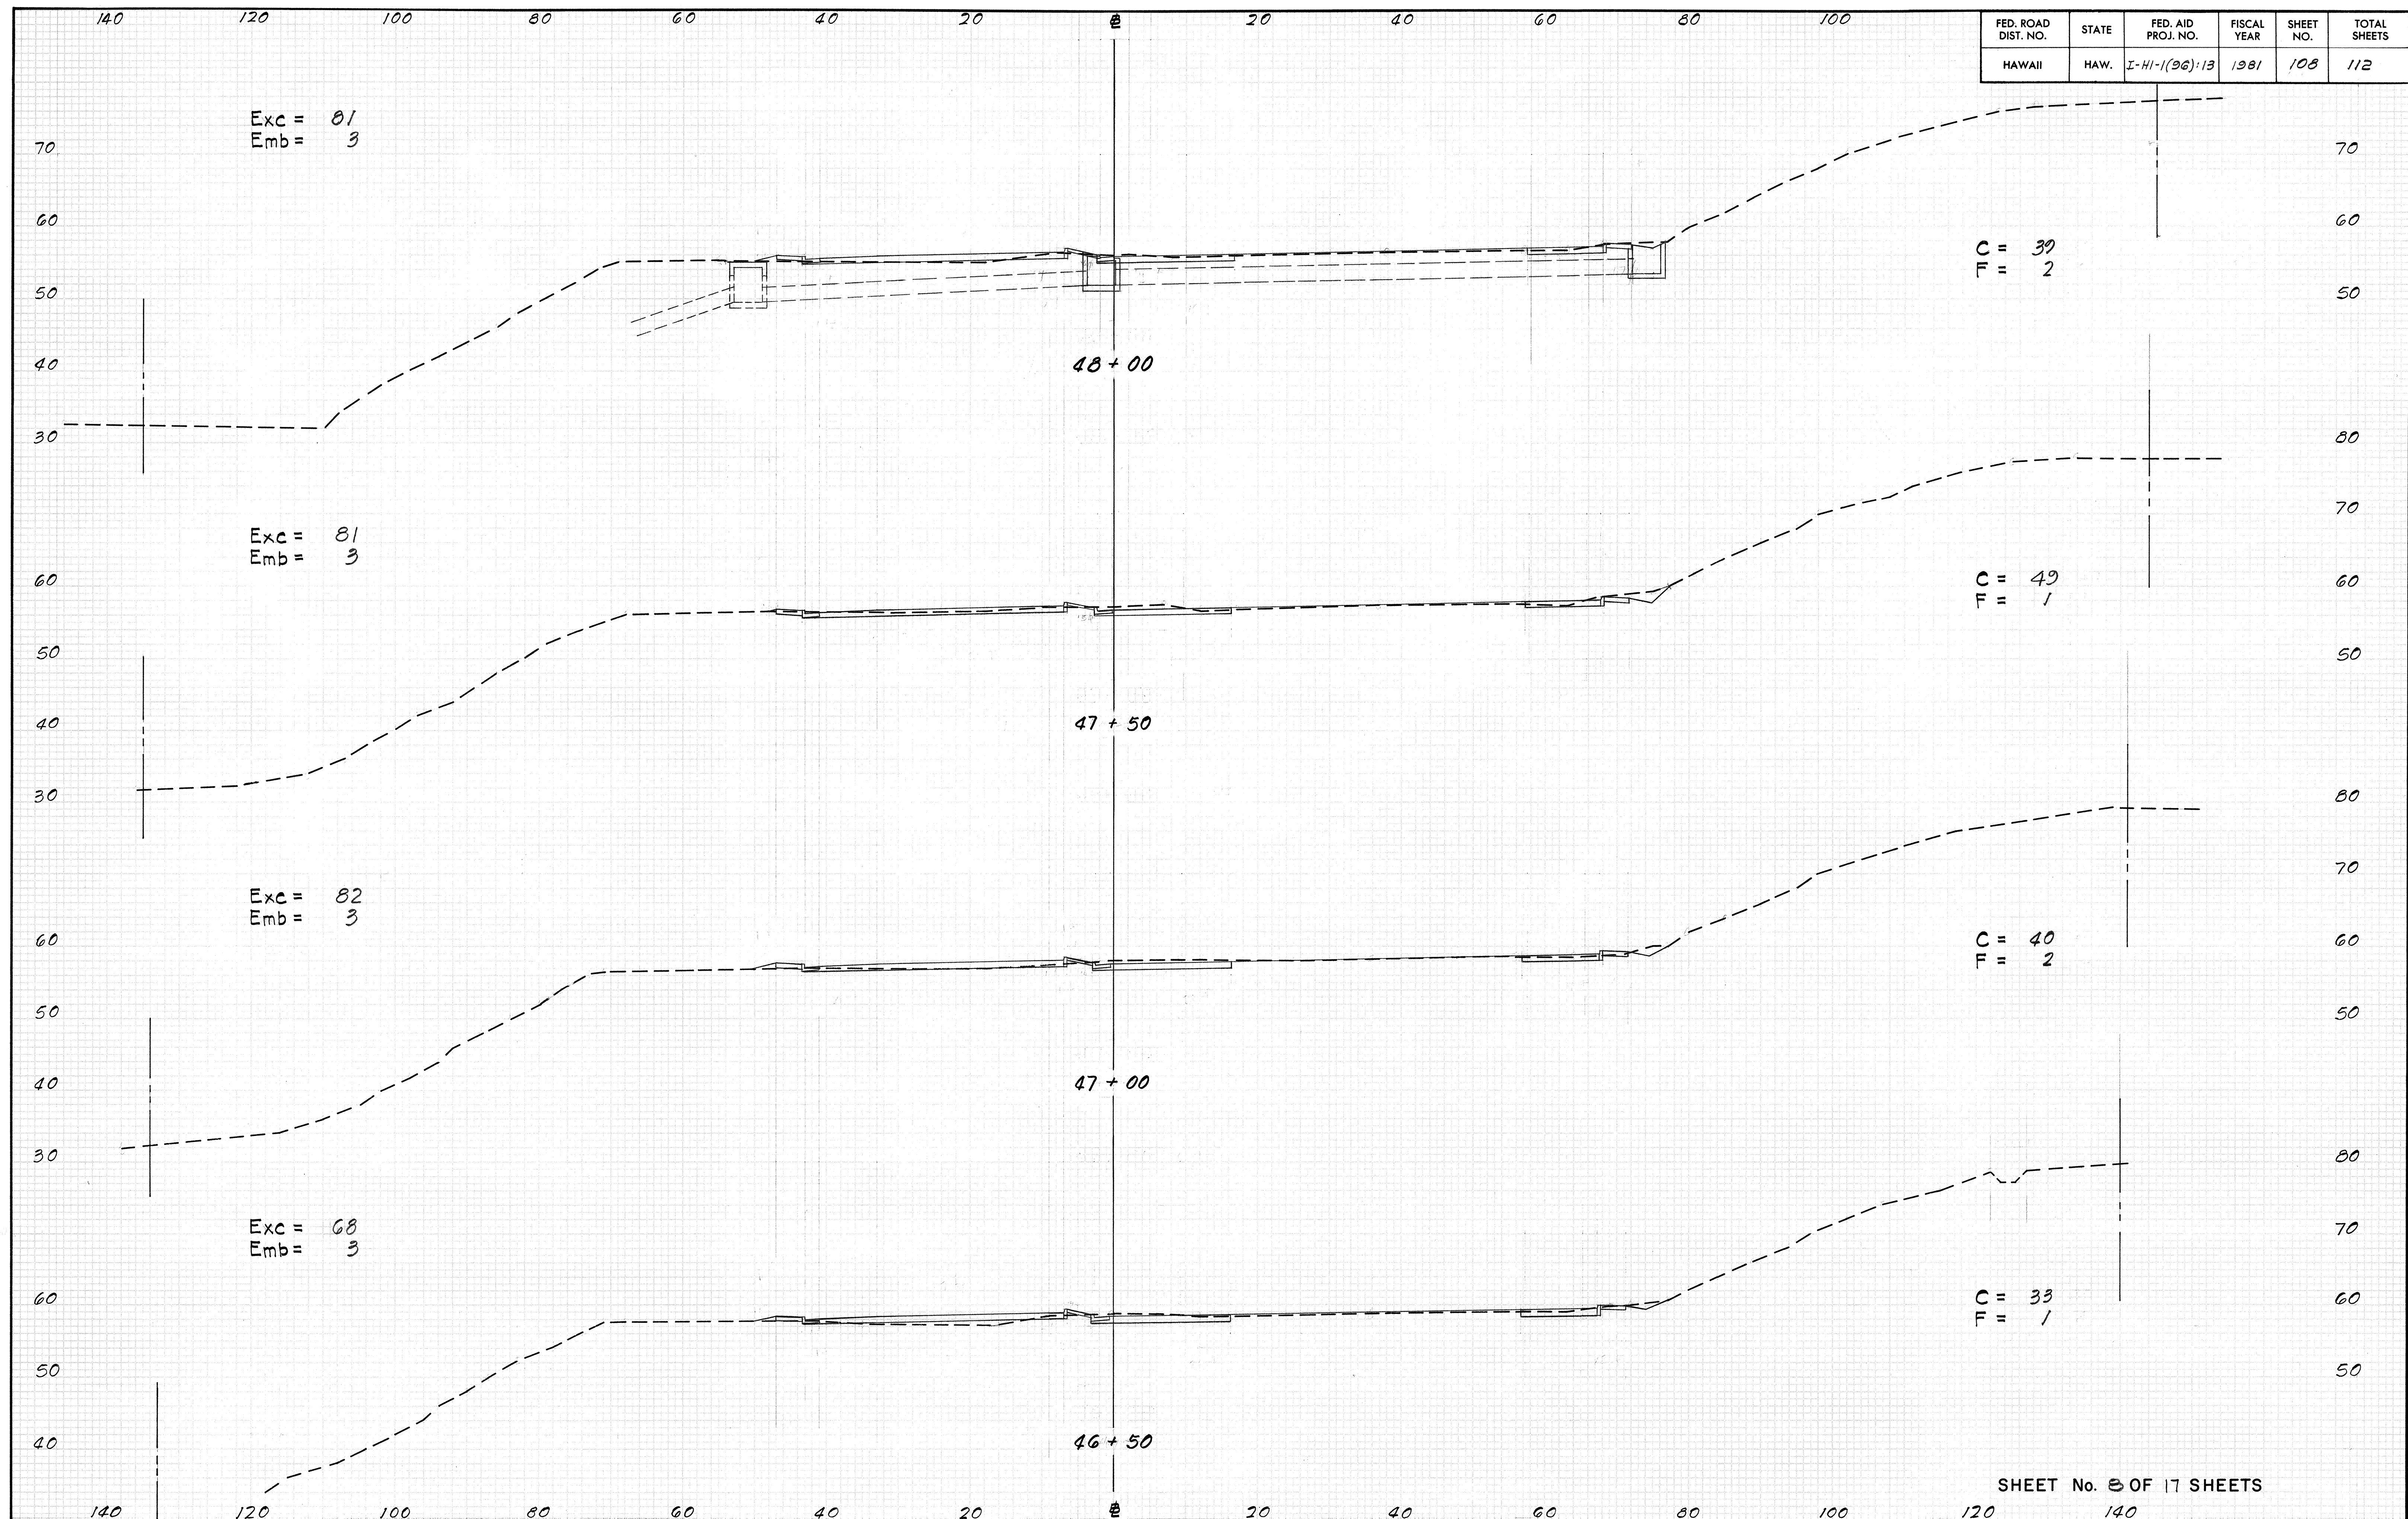

FED. ROAD DIST. NO.	STATE	FED. AID PROJ. NO.	FISCAL YEAR	SHEET NO.	TOTAL SHEETS
HAWAII	HAW.	I-HI-1(36):13	1981	109	112

DATE	BY	REVIEWED	DATE
ORIGINAL SURVEY	NOTED	PLANNED	PLANNED
NOTE BOOK	PLANNED	PLANNED	PLANNED
NO.	NO.	NO.	NO.

DATE	BY	REVIEWED	DATE
ORIGINAL SURVEY	NOTED	PLANNED	PLANNED
NOTE BOOK	PLANNED	PLANNED	PLANNED
NO.	NO.	NO.	NO.

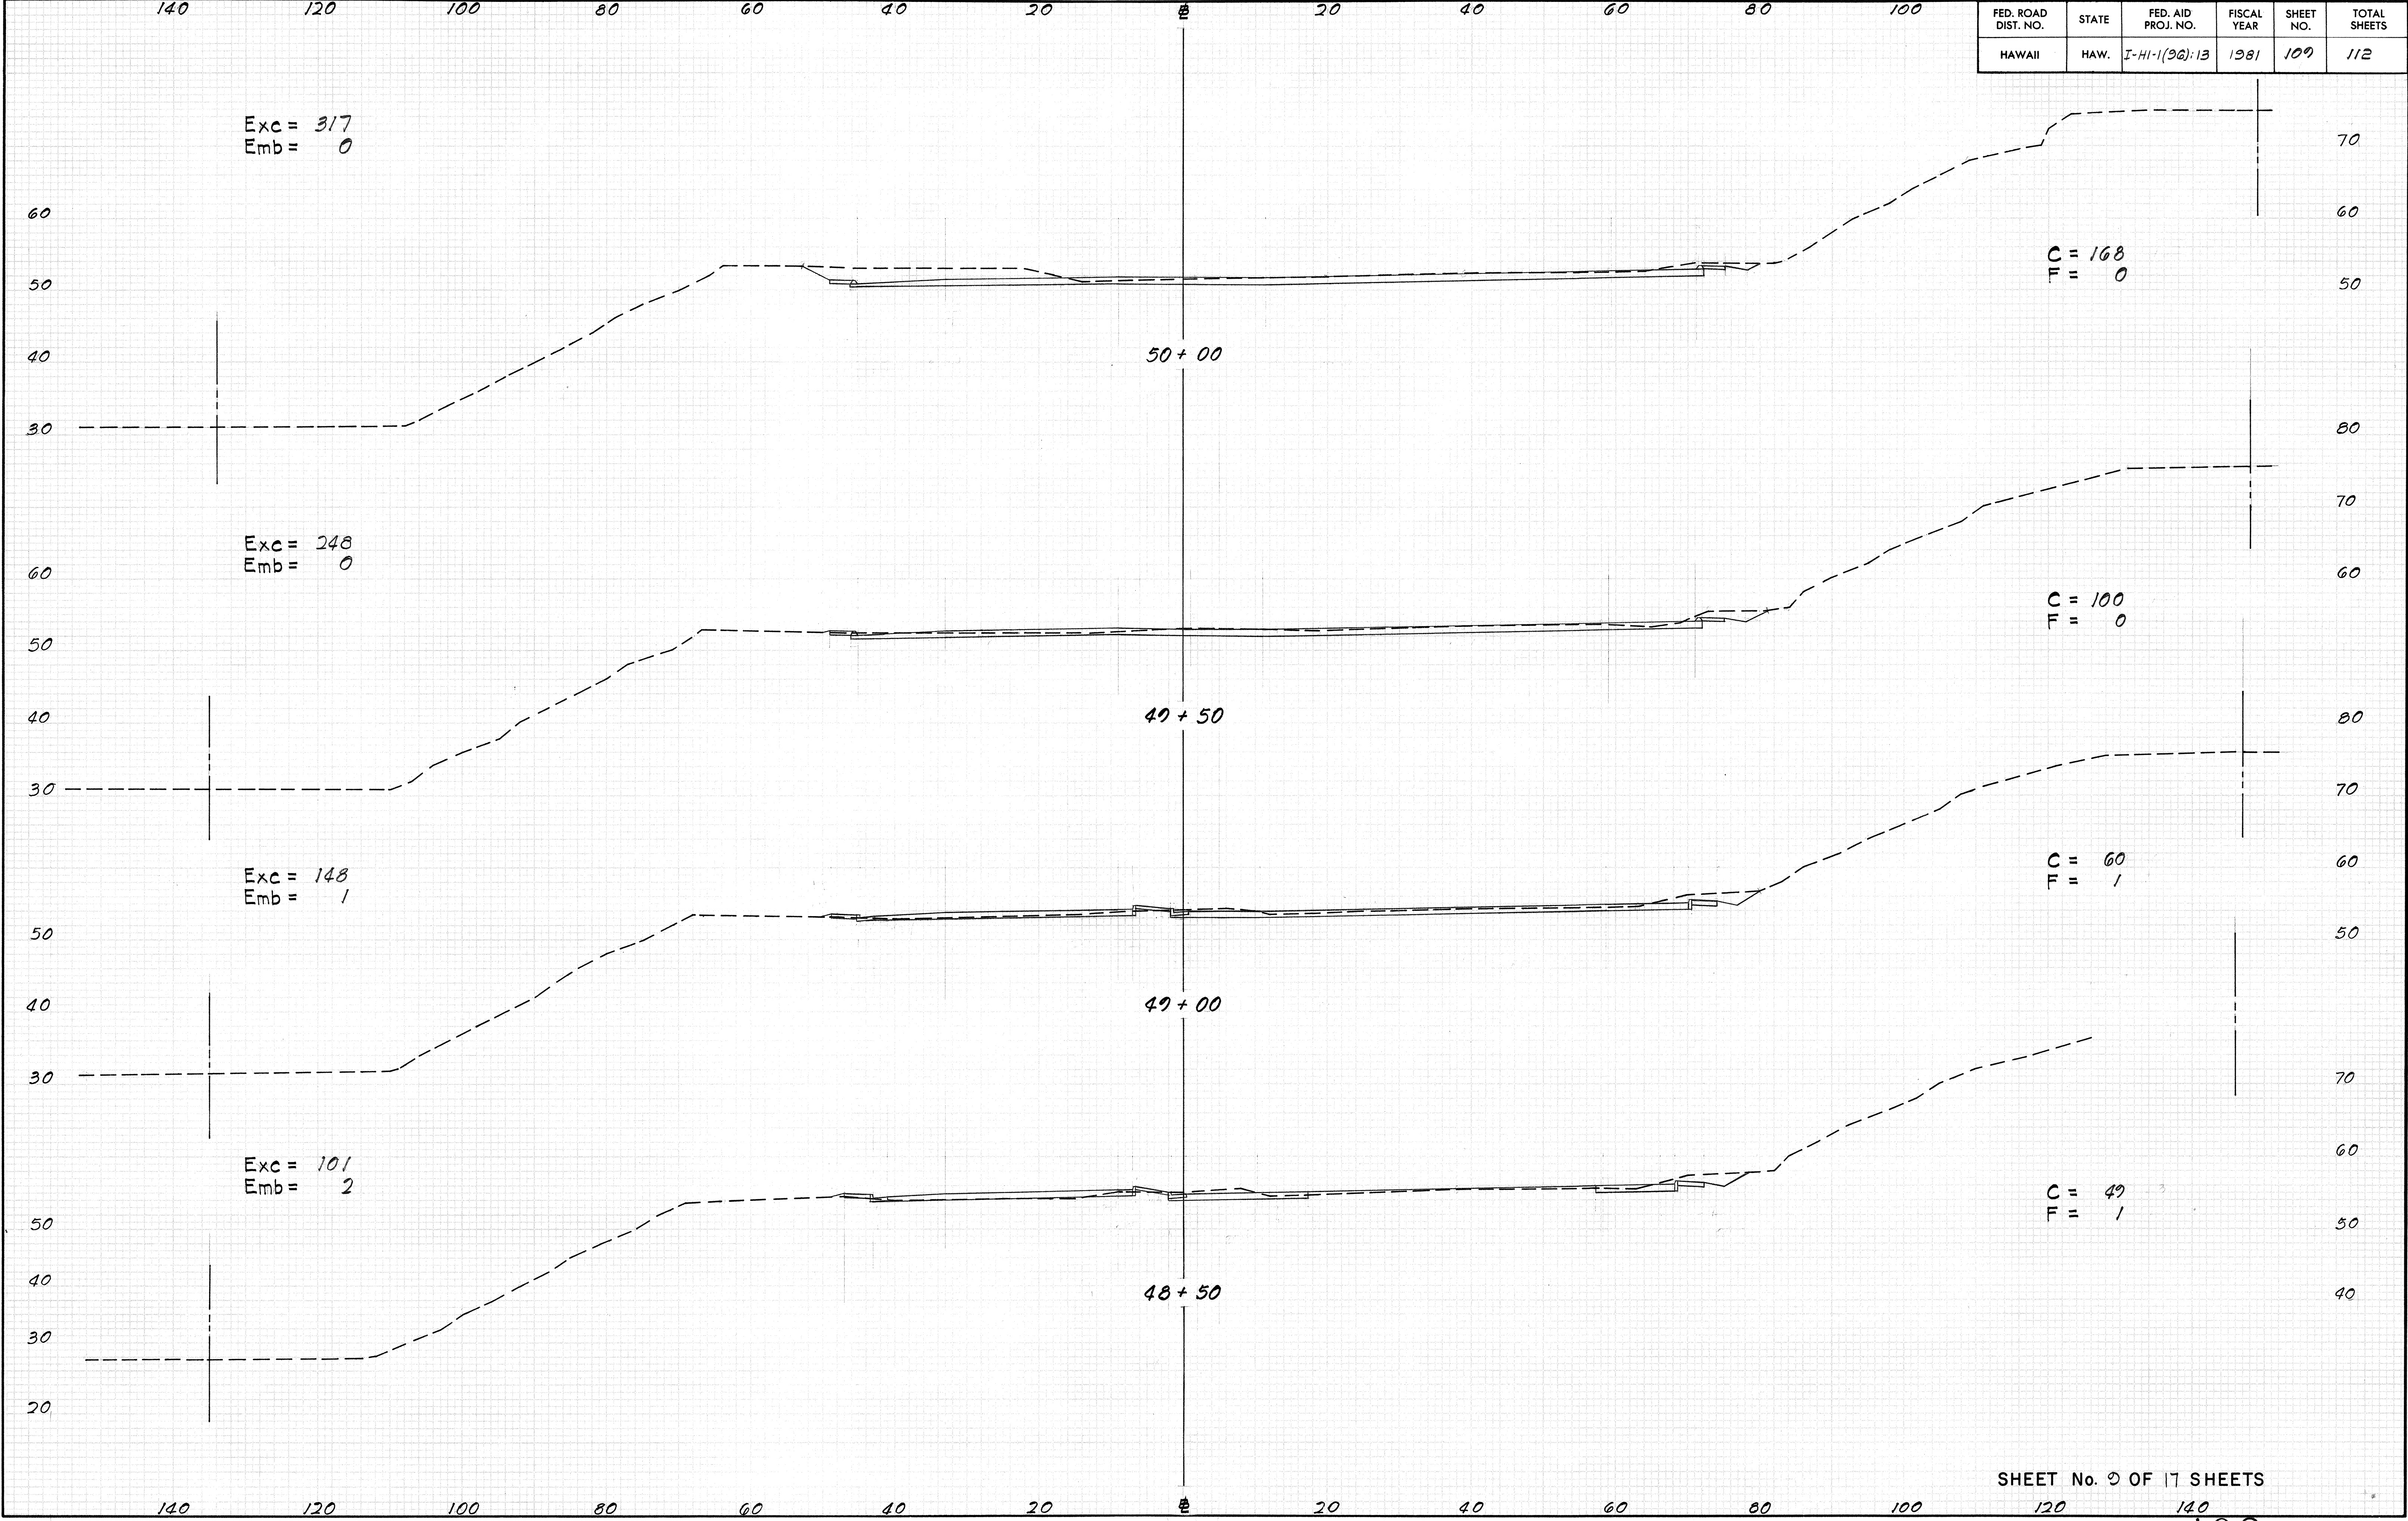

FED. ROAD DIST. NO.	STATE	FED. AID PROJ. NO.	FISCAL YEAR	SHEET NO.	TOTAL SHEETS
HAWAII	HAW.	I-HI-1(96)-13	1981	110	112

Exc = 575
Emb = 0

C = 263
F = 0

Exc = 471
Emb = 0

C = 246
F = 0


Exc = 419
Emb = 1

C = 207
F = 1

Exc = 353
Emb = 1


C = 174
F = 0

FED. ROAD DIST. NO.	STATE	FED. AID PROJ. NO.	FISCAL YEAR	SHEET NO.	TOTAL SHEETS
HAWAII	HAW.	I-HI-1(36):13	1981	111	112

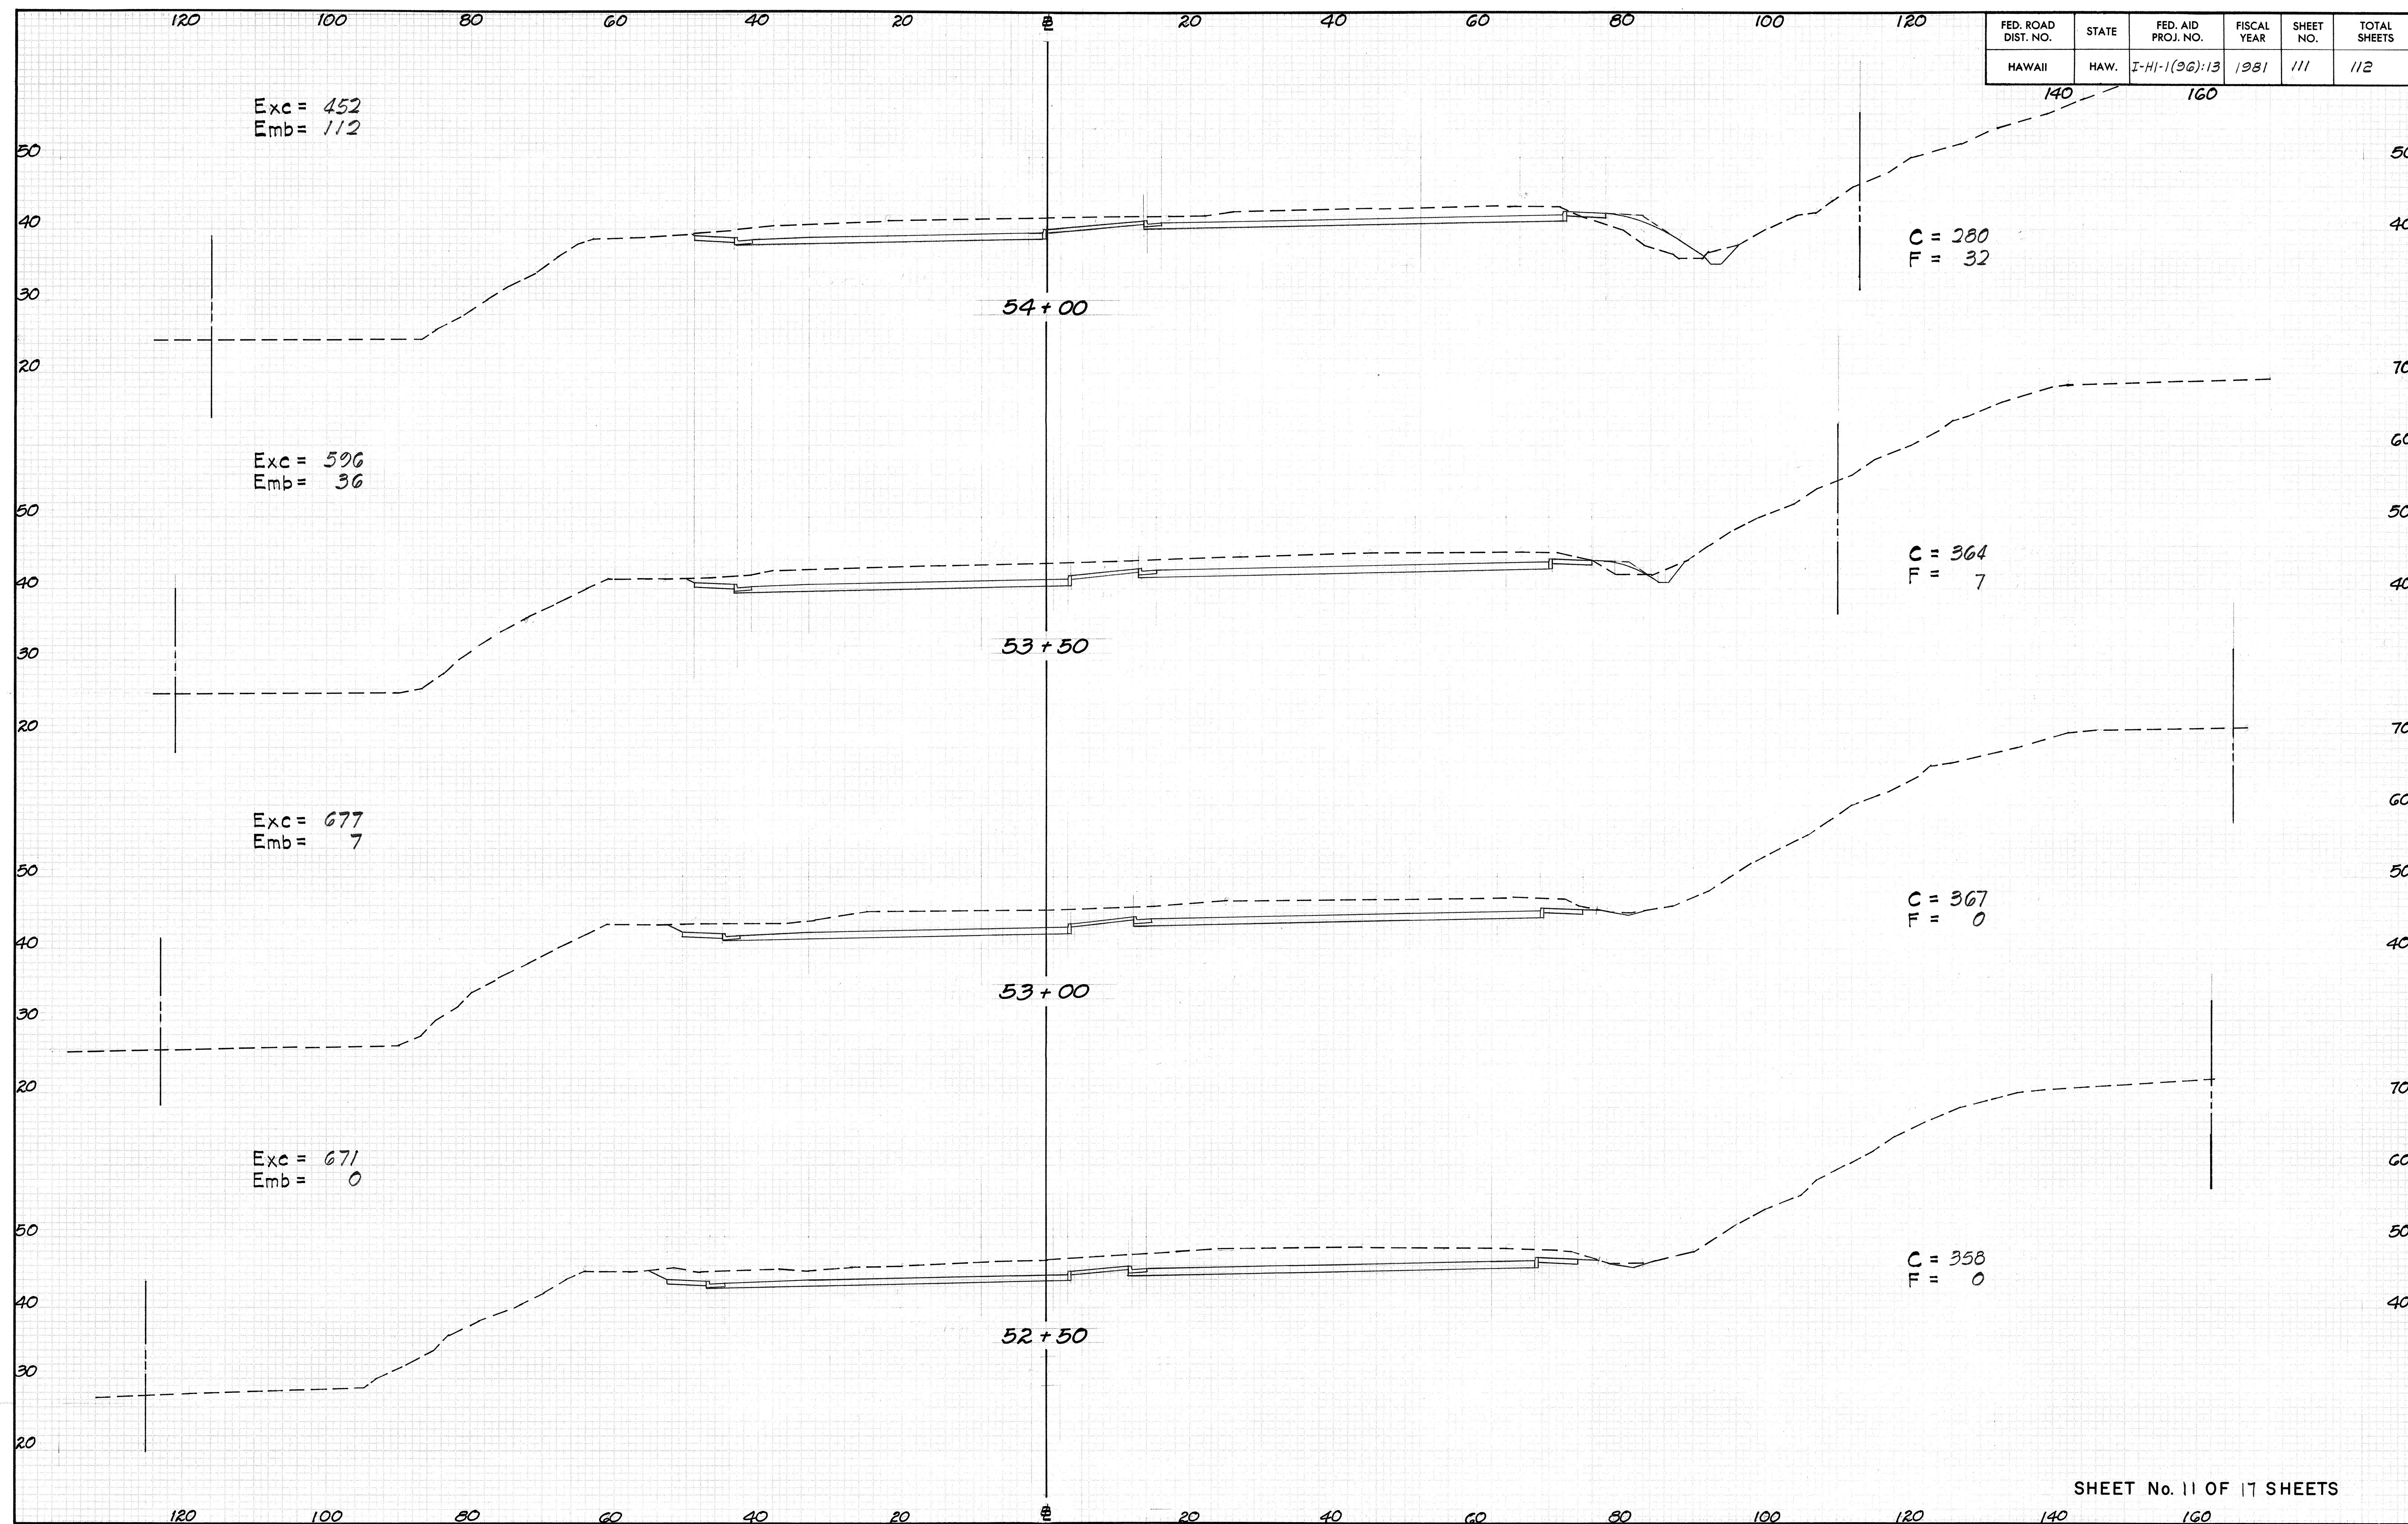


FED. ROAD DIST. NO.	STATE	FED. AID PROJ. NO.	FISCAL YEAR	SHEET NO.	TOTAL SHEETS
HAWAII	HAW.	I-HI-1(36)-13	1981	112	112

120 140 160

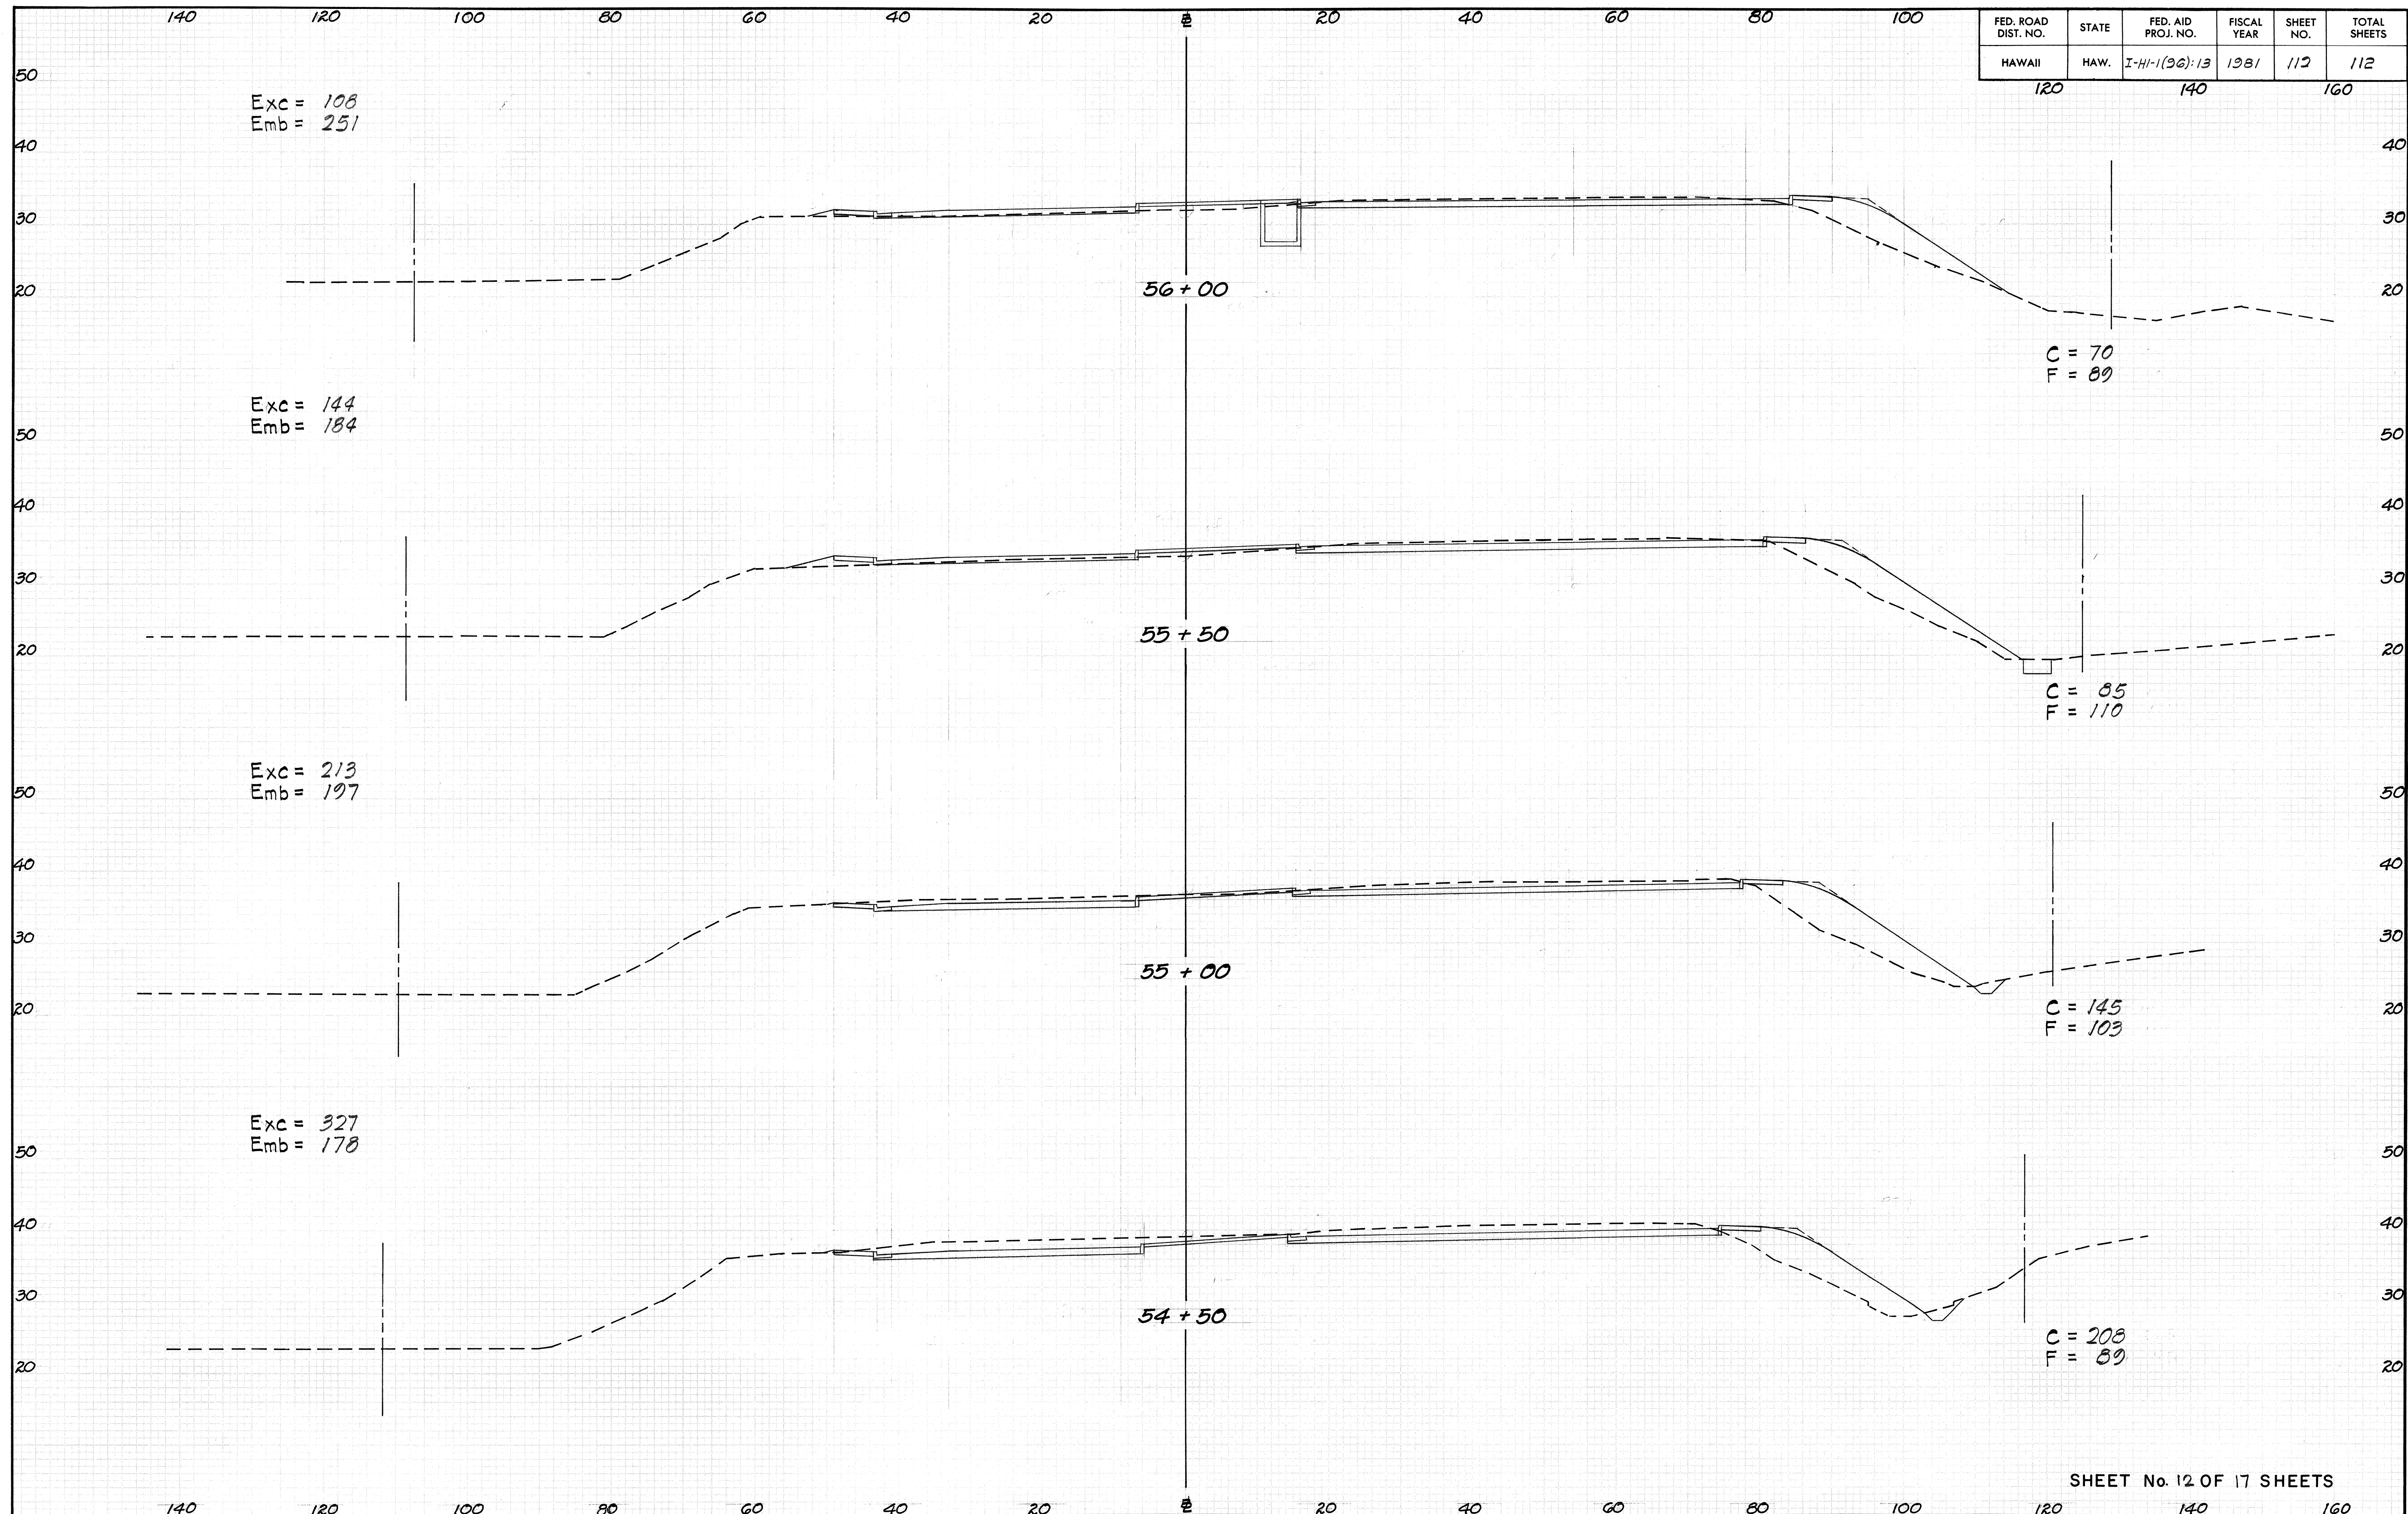

FED. ROAD DIST. NO.	STATE	FED. AID PROJ. NO.	FISCAL YEAR	SHEET NO.	TOTAL SHEETS
HAWAII	HAW.	I-HI-1(96):13	1981	113	112

120 140 160

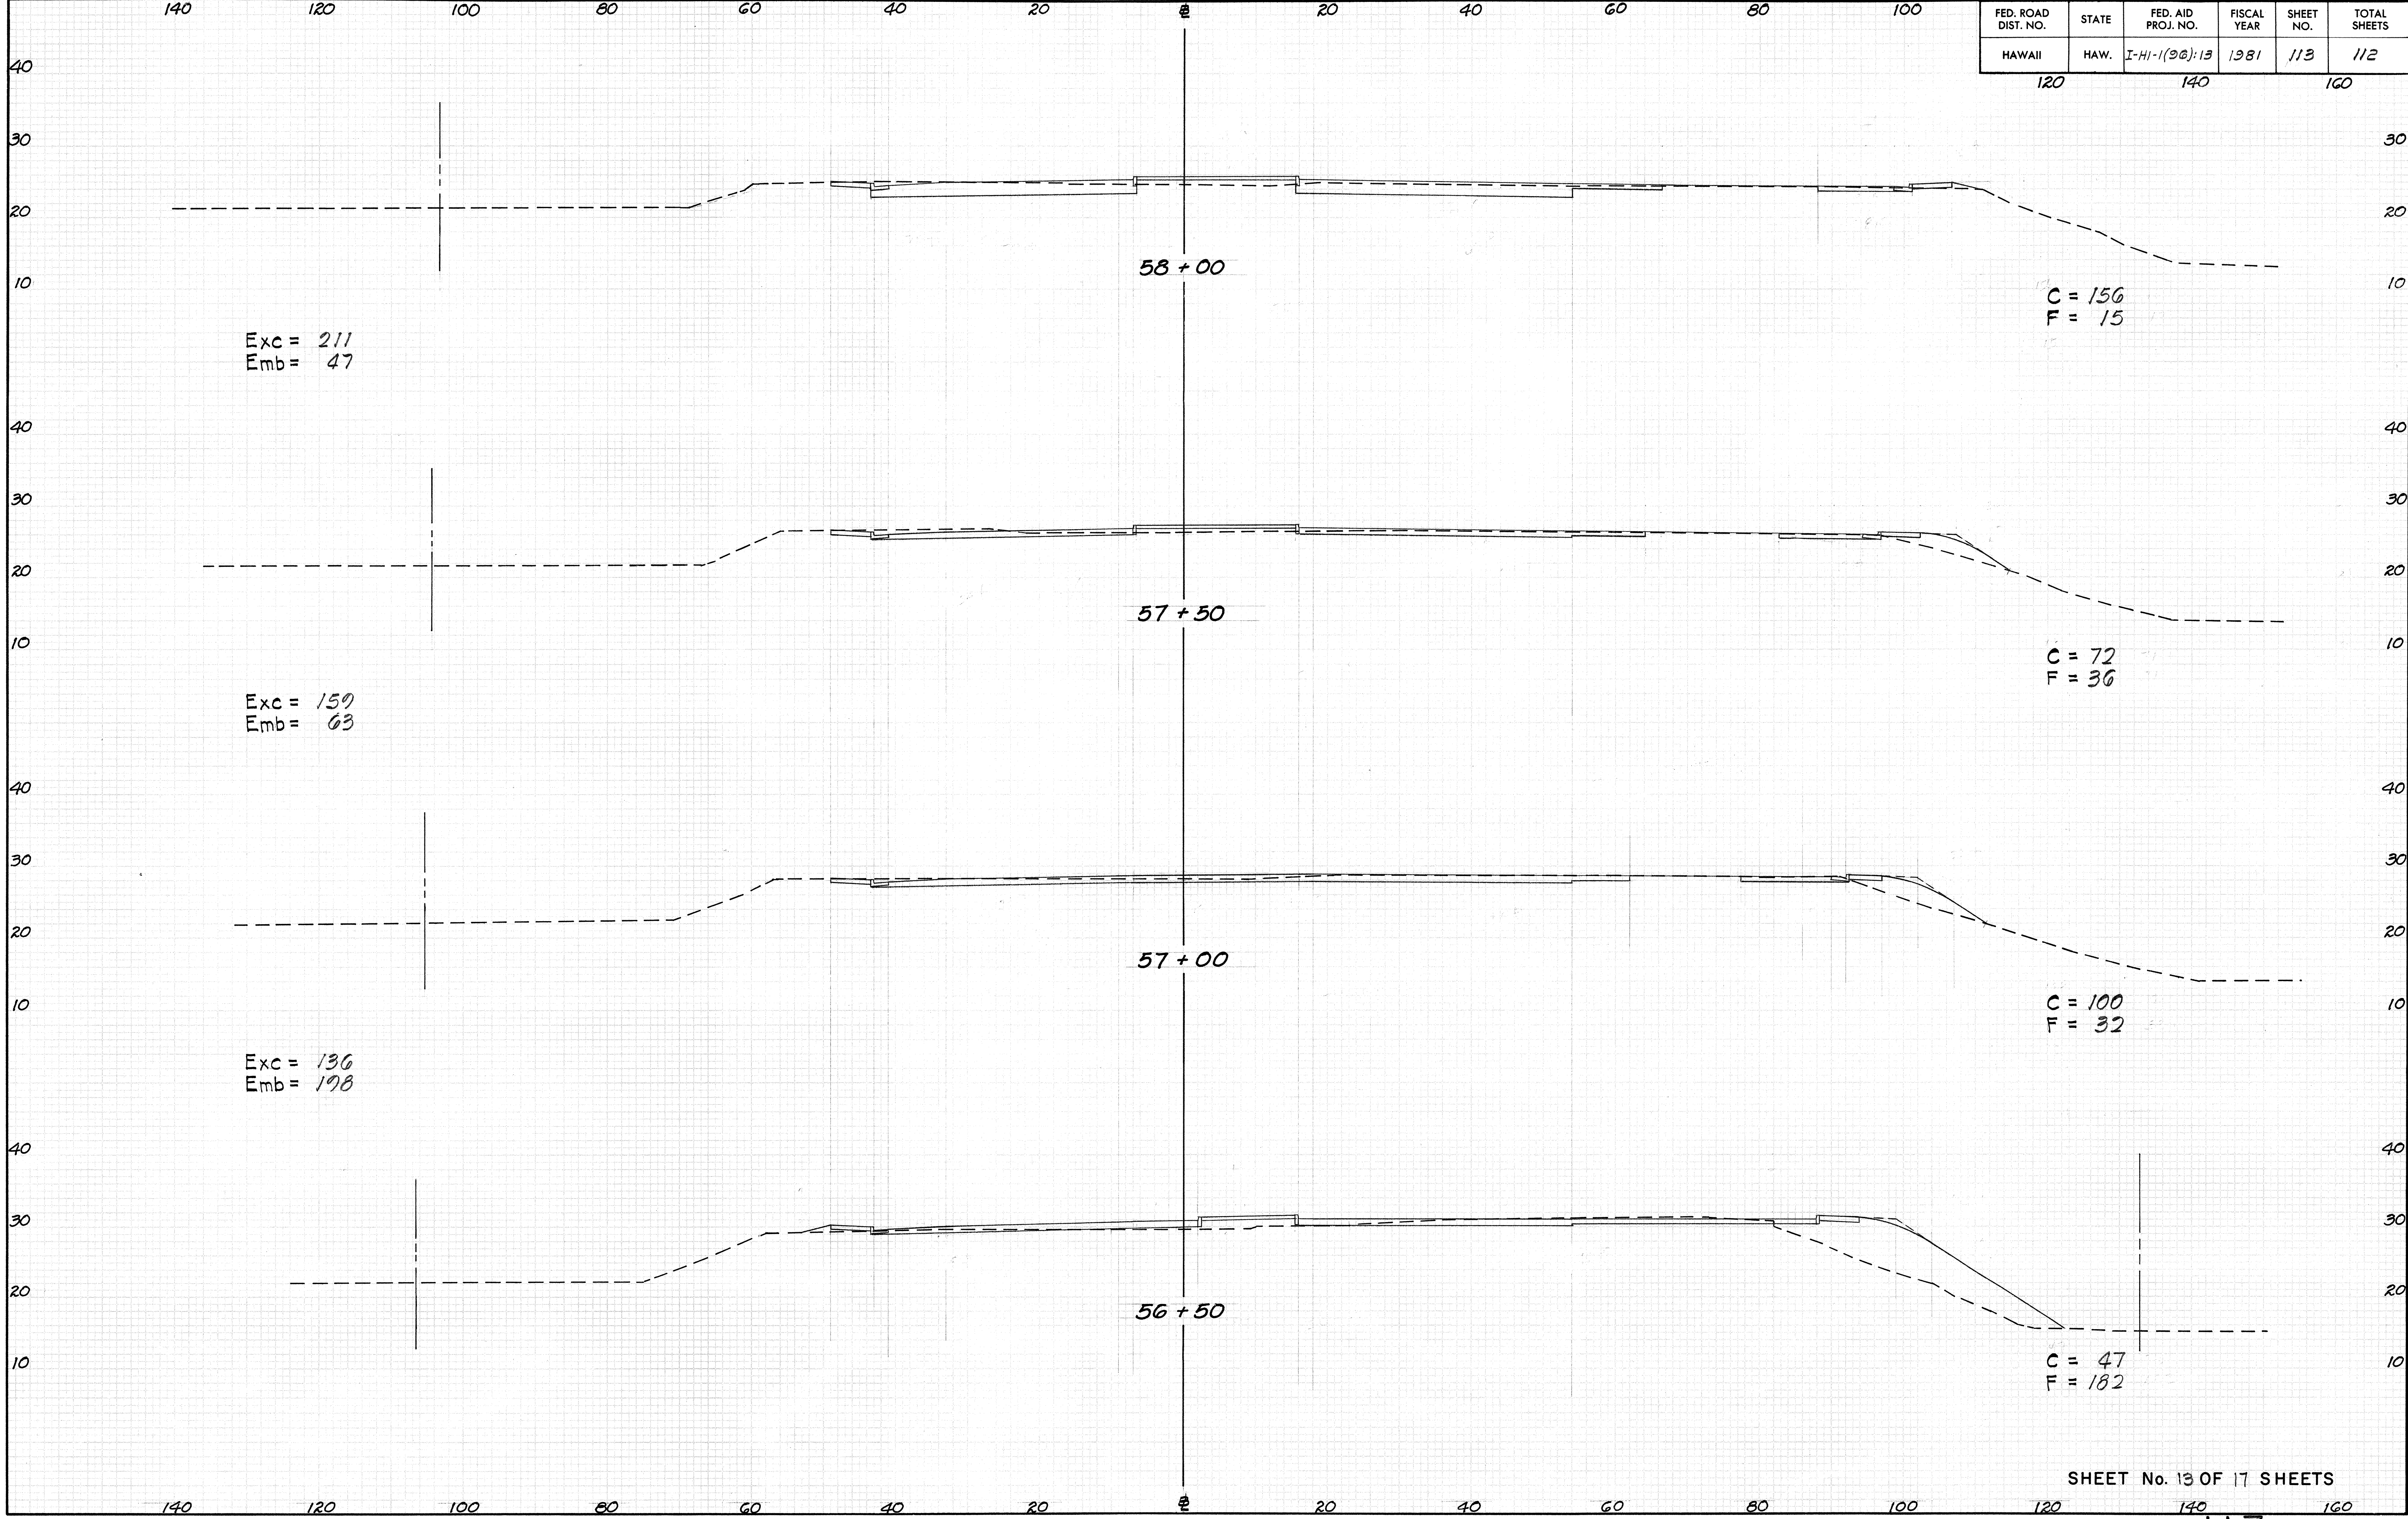

FED. ROAD DIST. NO.	STATE	FED. AID PROJ. NO.	FISCAL YEAR	SHEET NO.	TOTAL SHEETS
HAWAII	HAW.	I-HI-1(96):13	1981	114	112

Exc = 399
Emb = 28

Exc = 299
Emb = 33

Exc = 263
Emb = 47

Exc = 244
Emb = 56

Exc = 256
Emb = 47

C = 182
F = 10


C = 141
F = 26

C = 143
F = 25


C = 121
F = 36

FED. ROAD DIST. NO.	STATE	FED. AID PROJ. NO.	FISCAL YEAR	SHEET NO.	TOTAL SHEETS
HAWAII	HAW.	I-HI-1(96):13	1981	115	112

120 140 160

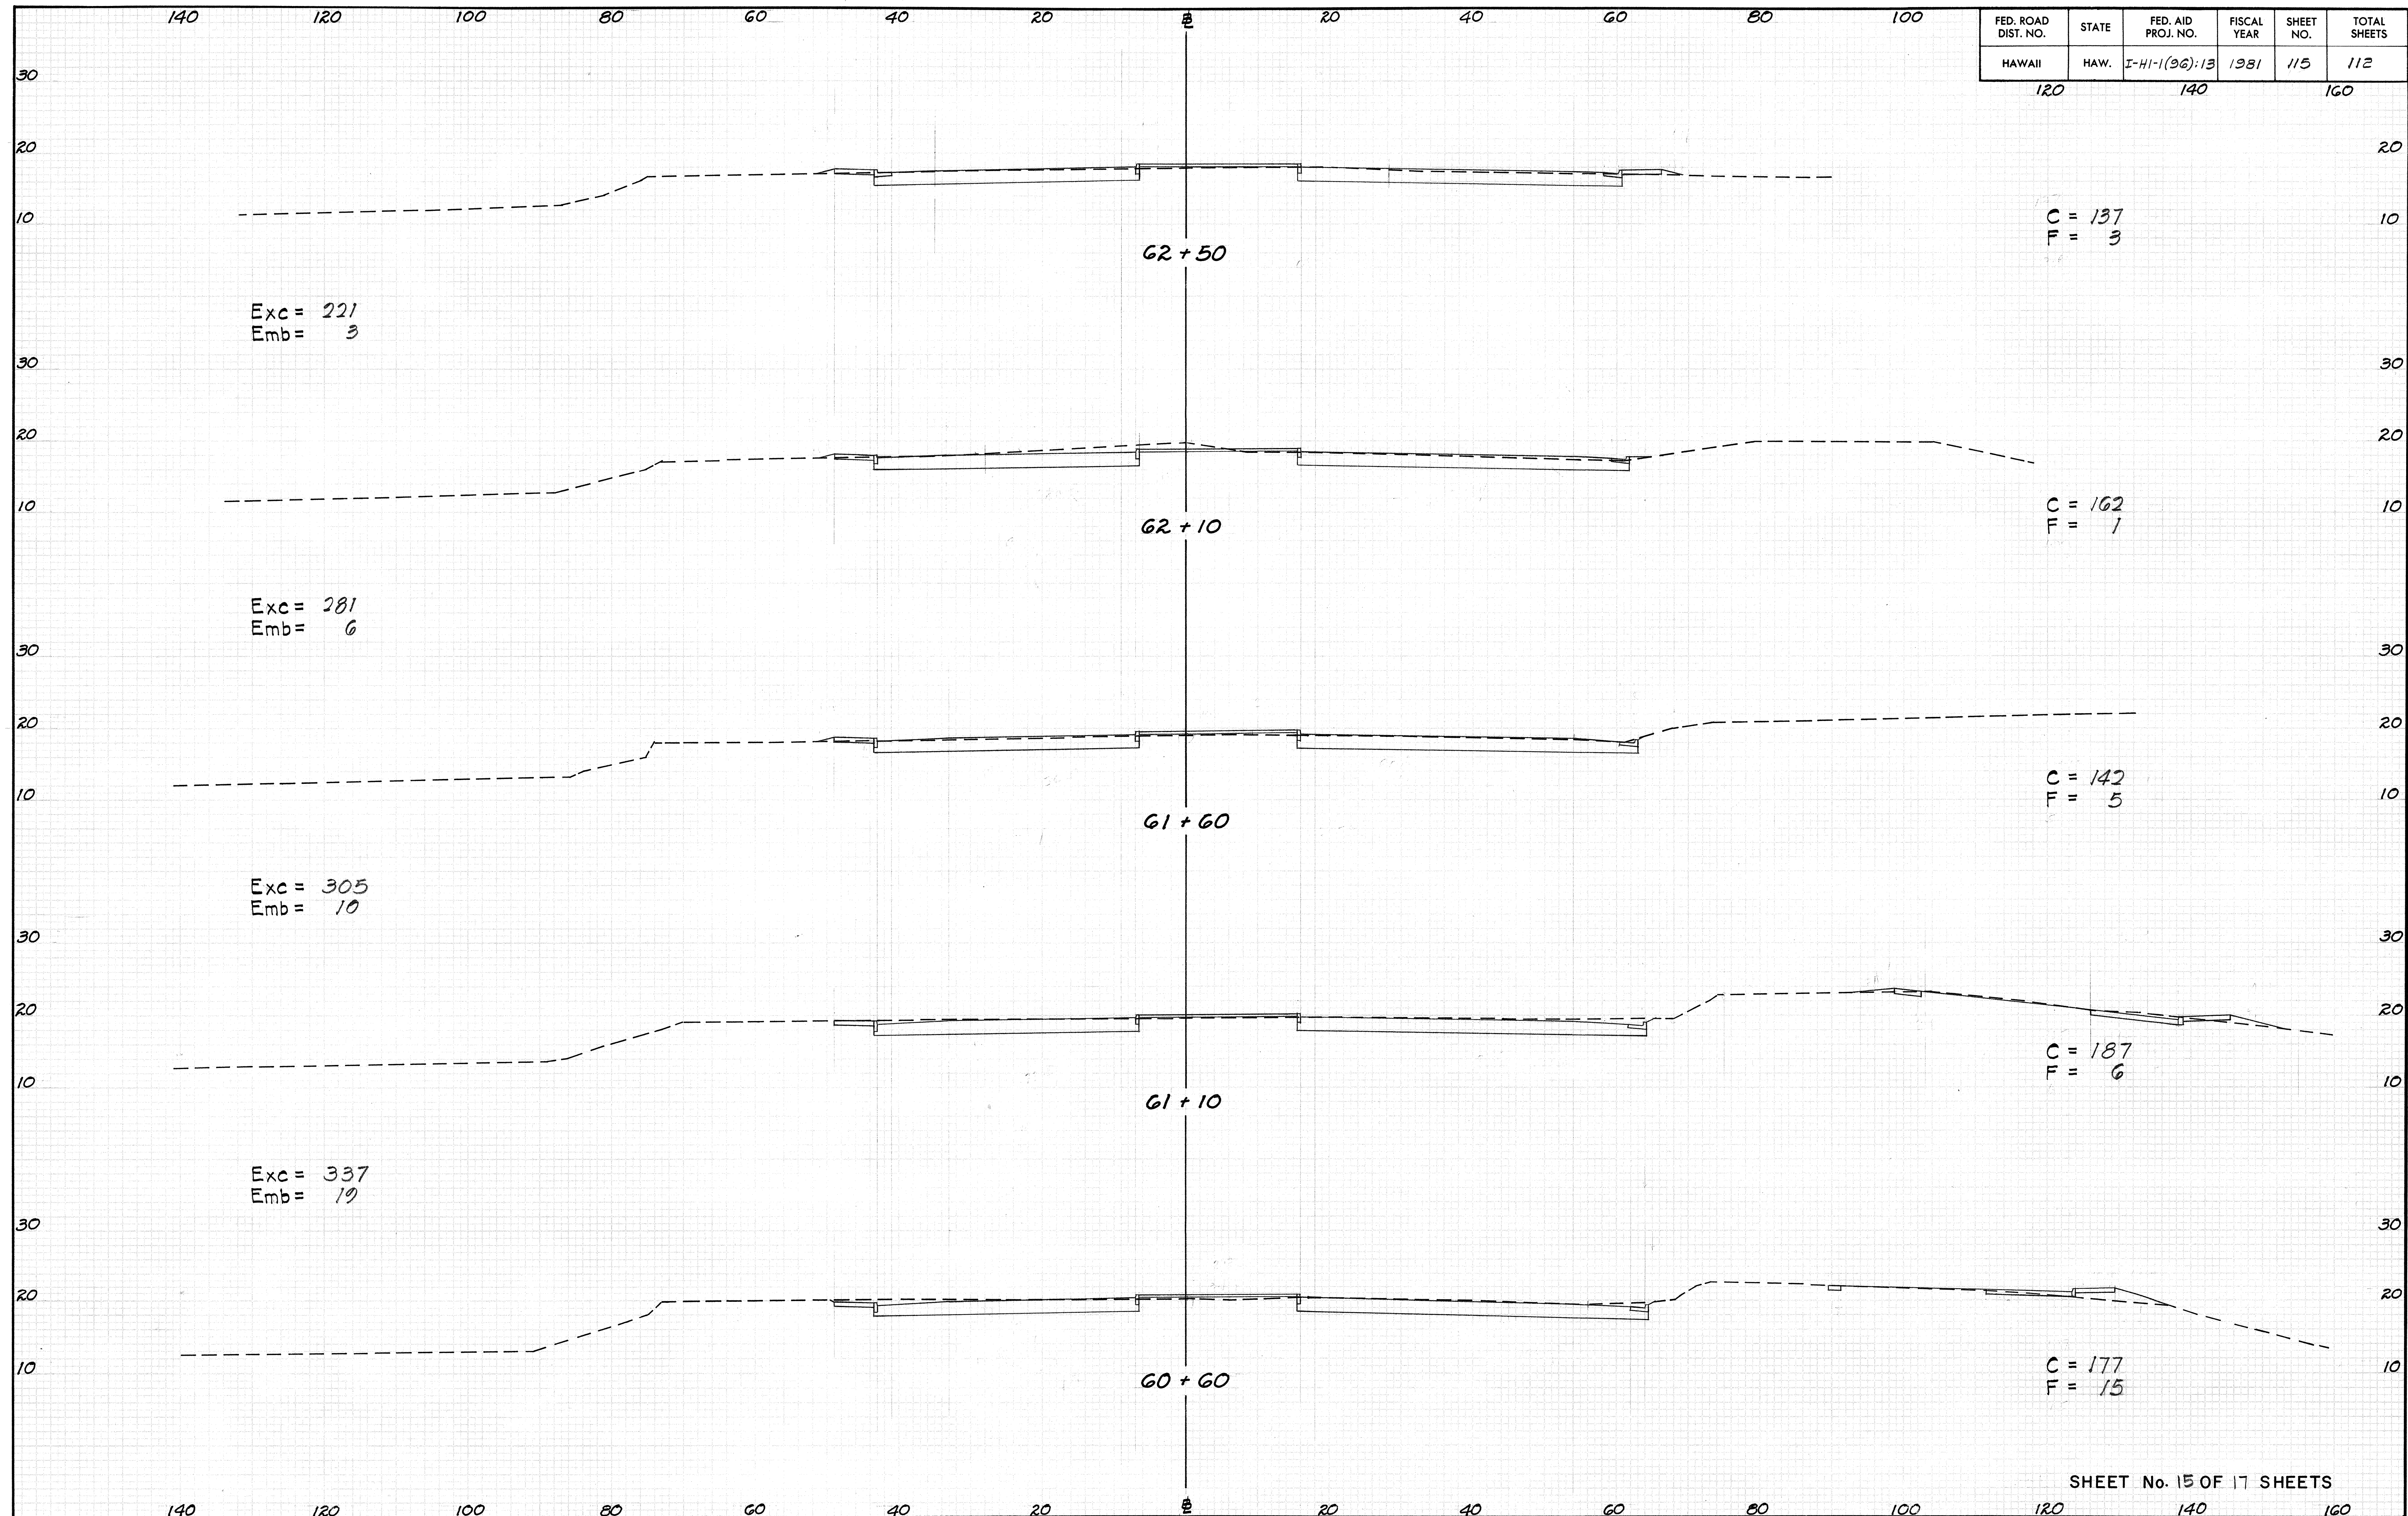


SHEET No. 15 OF 17 SHEETS

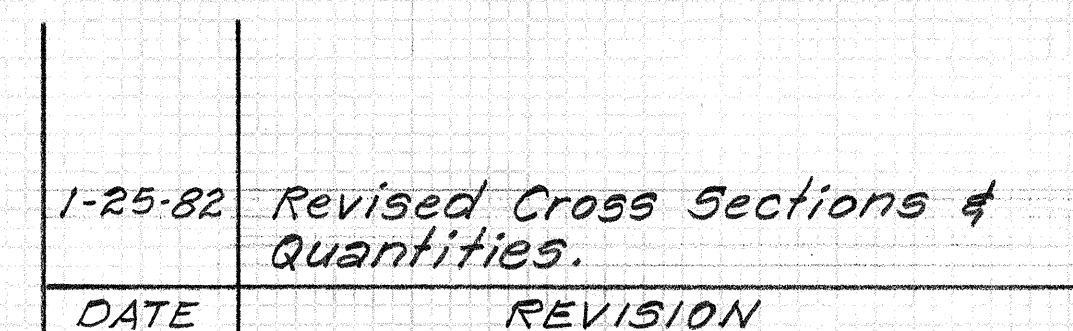

CO116

FED. ROAD DIST. NO.	STATE	FED. AID PROJ. NO.	FISCAL YEAR	SHEET NO.	TOTAL SHEETS
HAWAII	HAW.	I-HI-1(96)-13	1981	117	112

DATE	REVISION

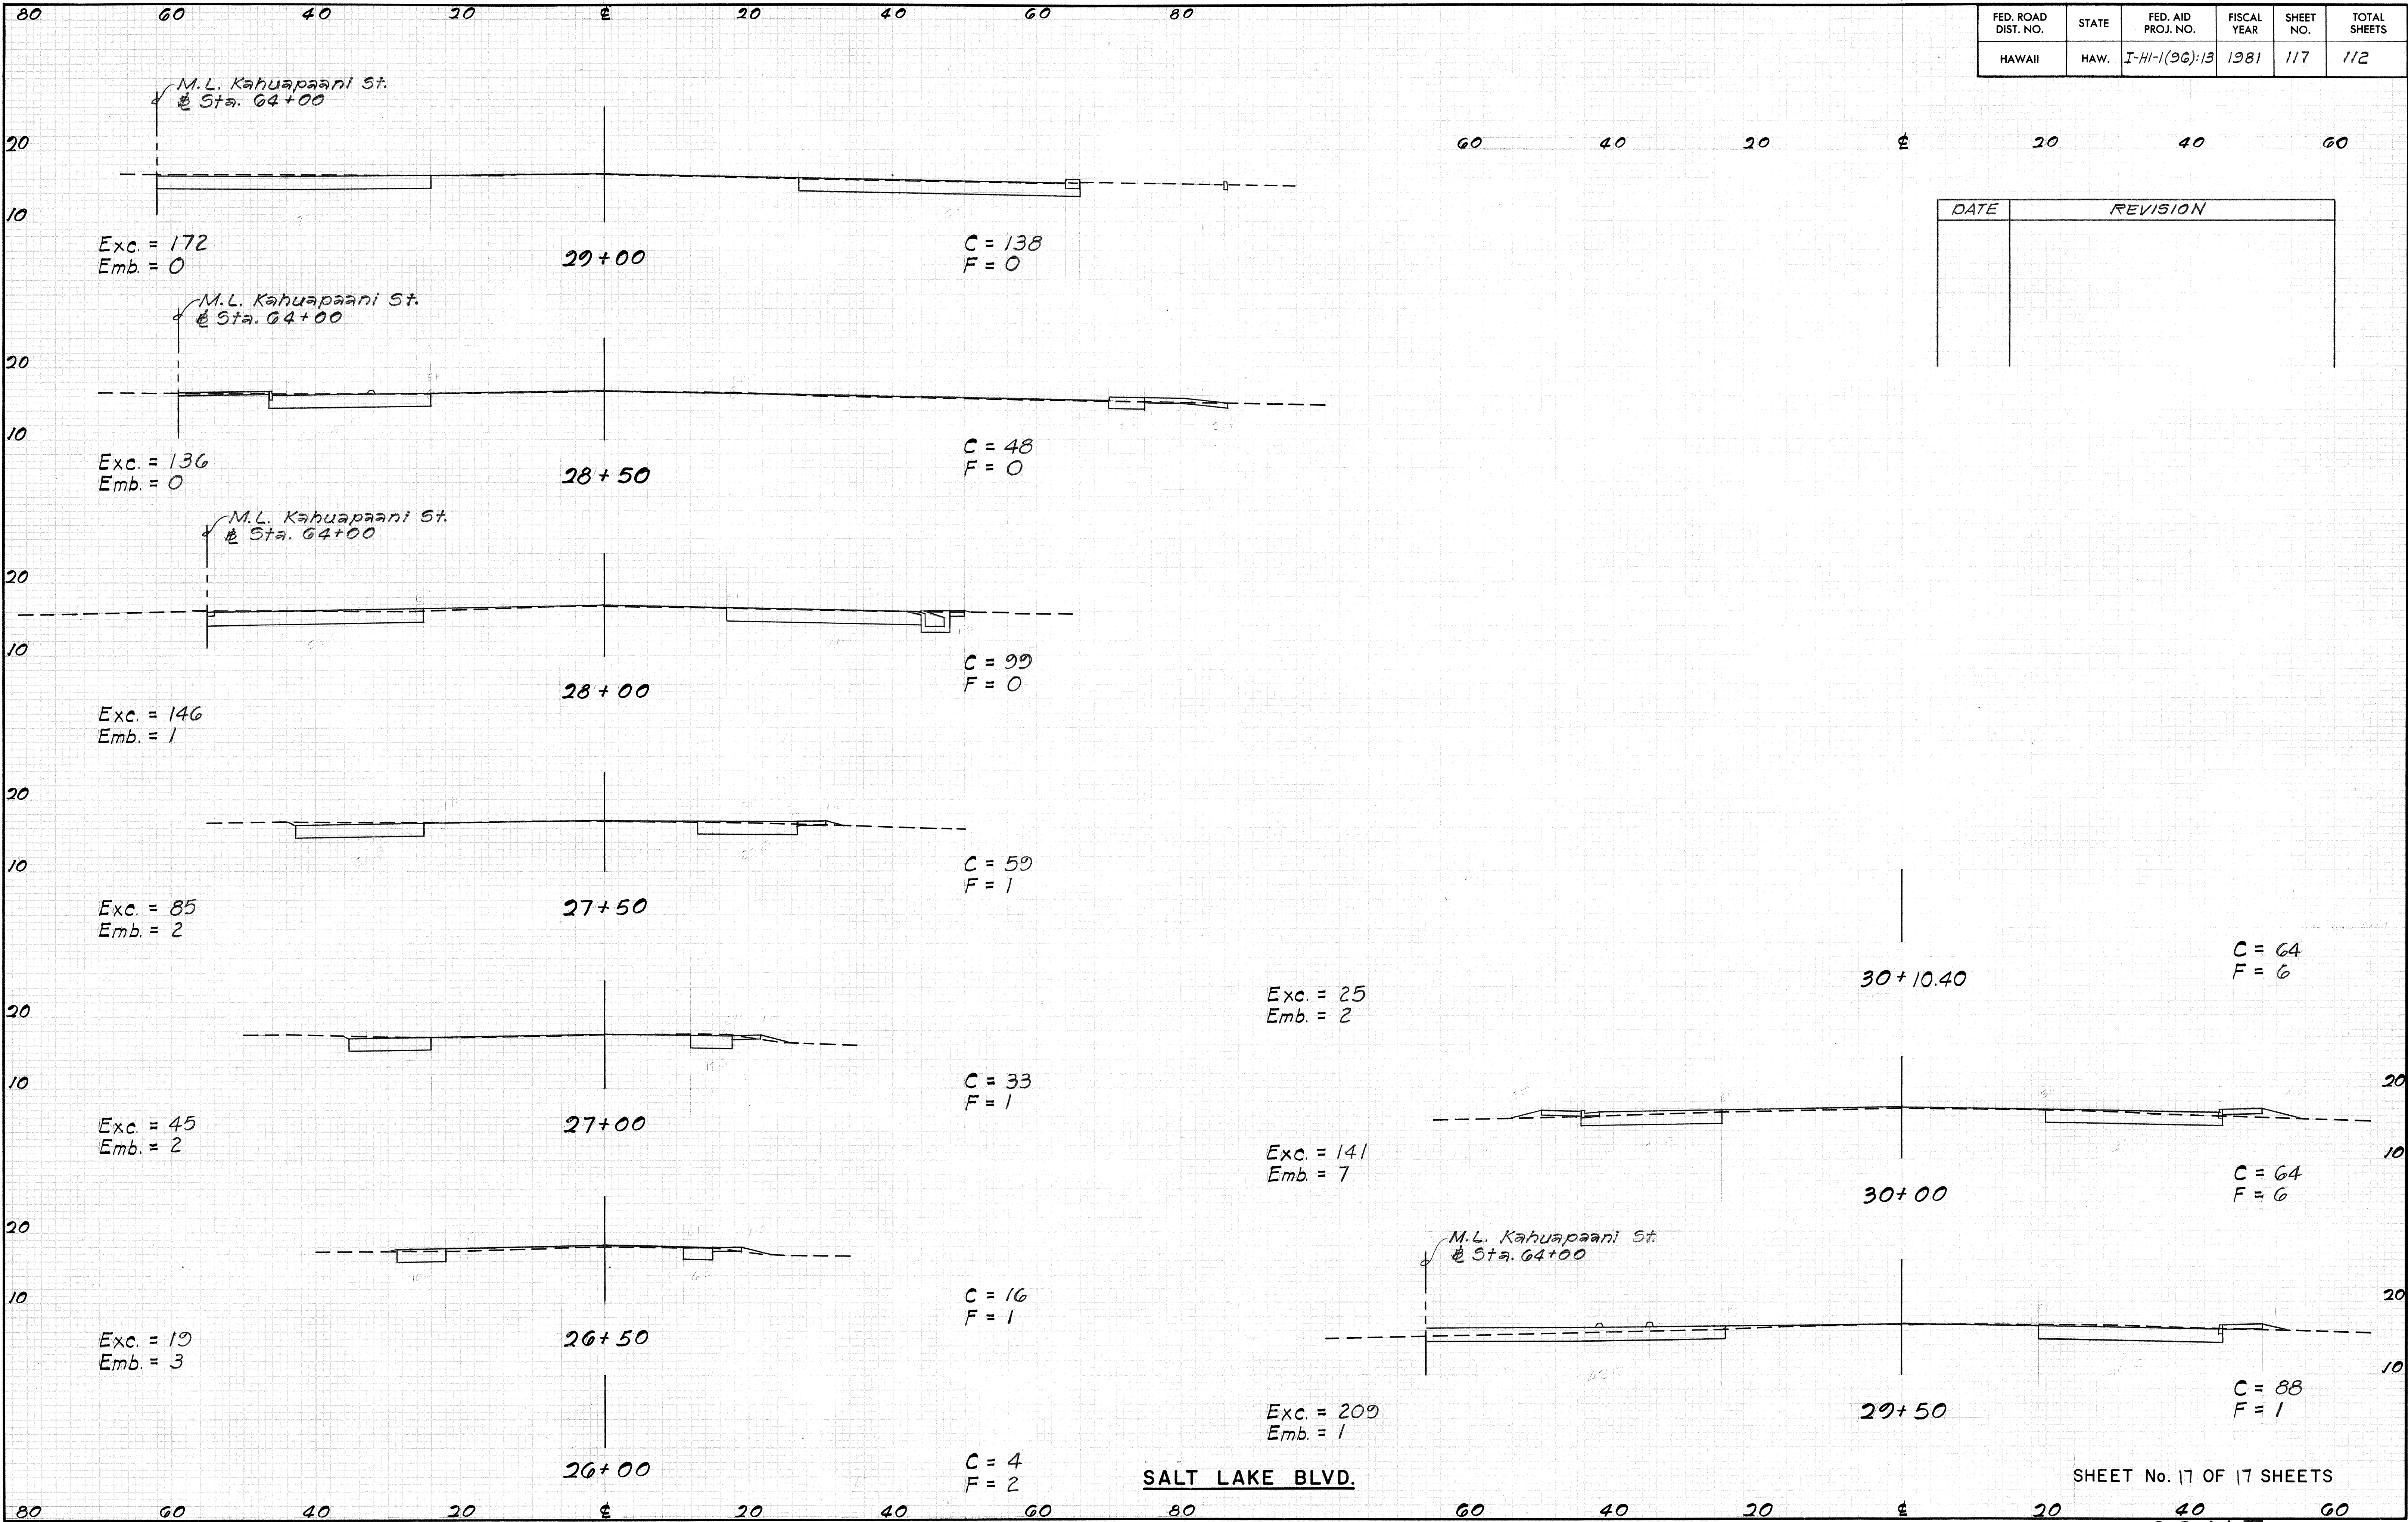

SHEET No. 17 OF 17 SHEETS


CO117

DATE	BY

DATE	BY

FED. ROAD DIST. NO.	STATE	FED. AID PROJ. NO.	FISCAL YEAR	SHEET NO.	TOTAL SHEETS
HAWAII	HAW.	I-41-1(96)-13	1983	1175-1	112

20 40 60

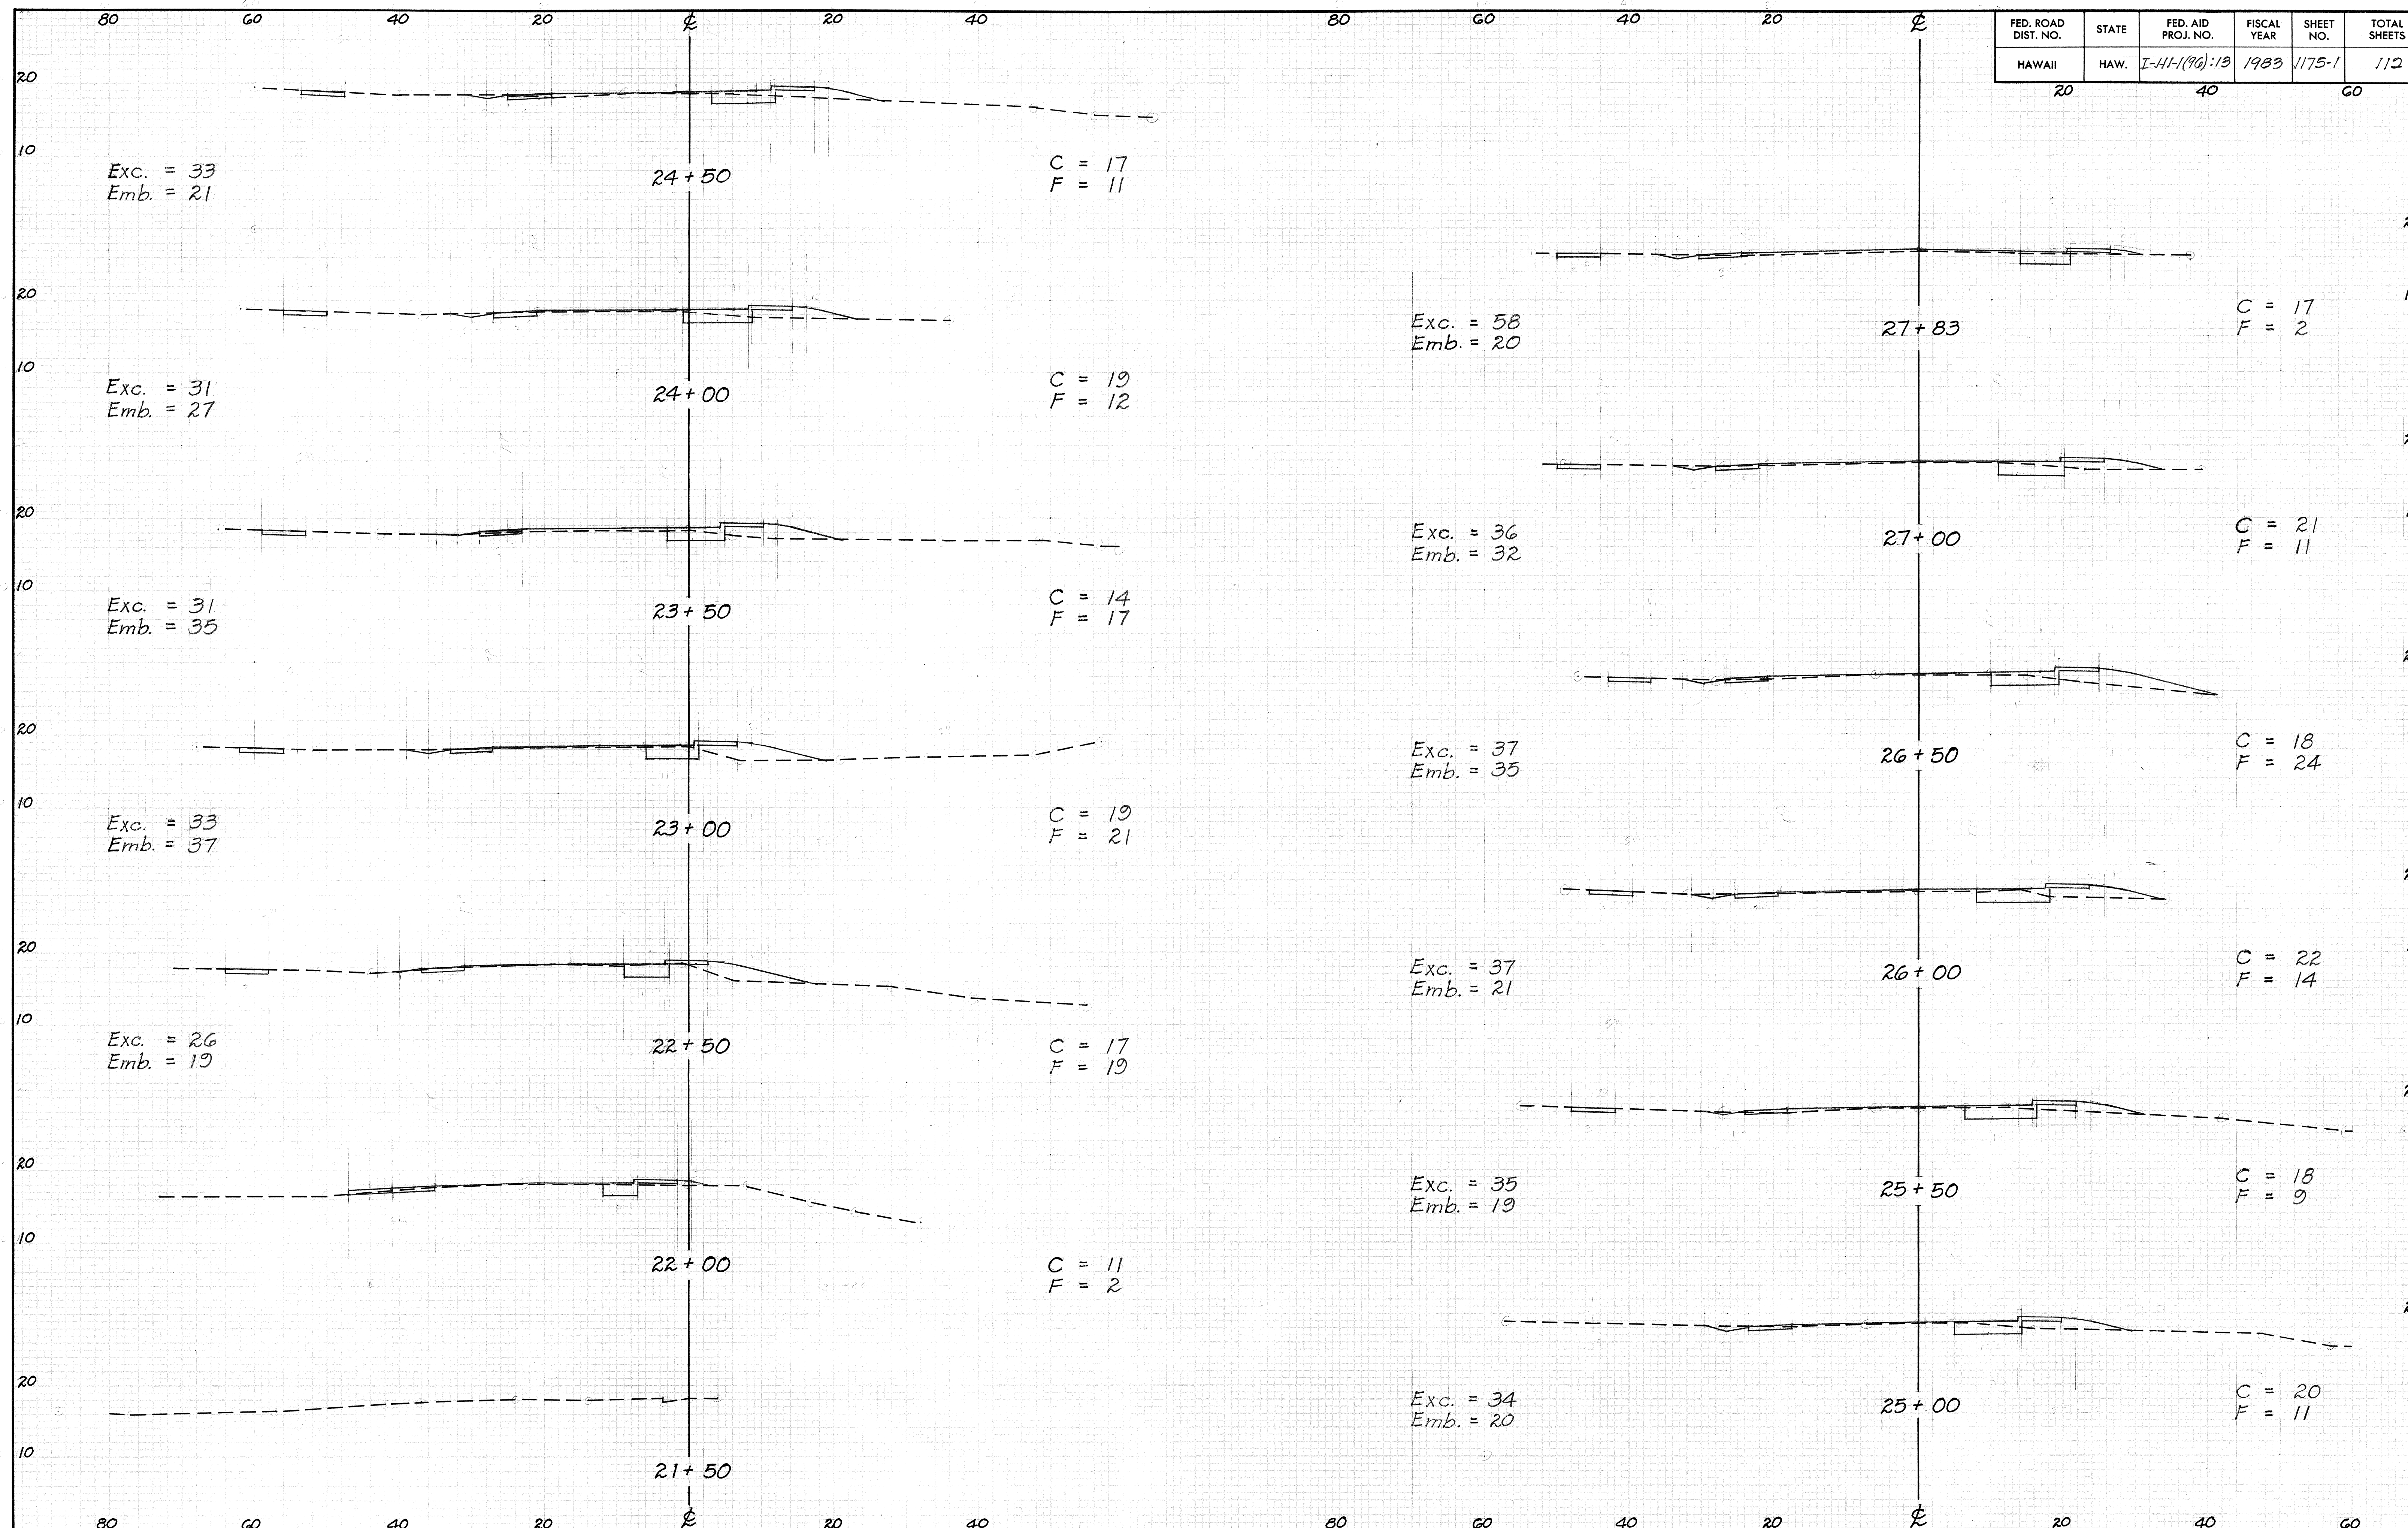

117S-1

117 S-1