Can day	
	INDEX TO DRAWINGS
SHEET NO.	DESCRIPTION
	TITLE SHEET
2	PLAN AND DETAILS




STATE OF HAWAII

TRANSPORTATION OF DEPARTMENT HIGHWAYS DIVISION


> "AS-BUILT" PLANS FOR


INTERSTATE ROUTE H-I HALAWA INTERCHANGE REPAIR OF HALAWA STREAM CHANNEL PROJECT NO. HIF-01-81M

> DISTRICT OF EWA ISLAND OF OAHU

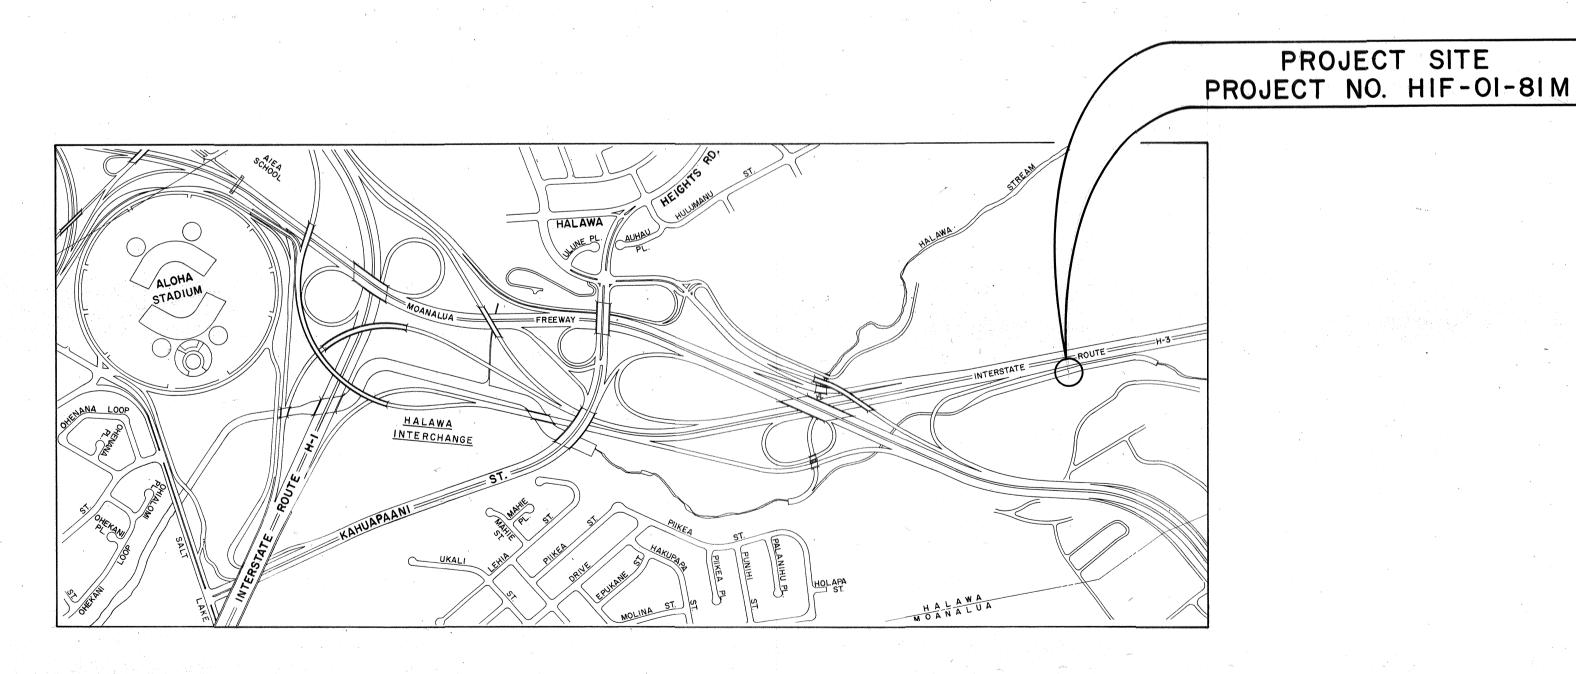

LAYOUT PLAN

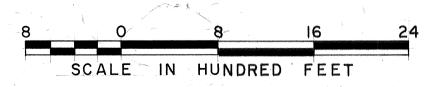

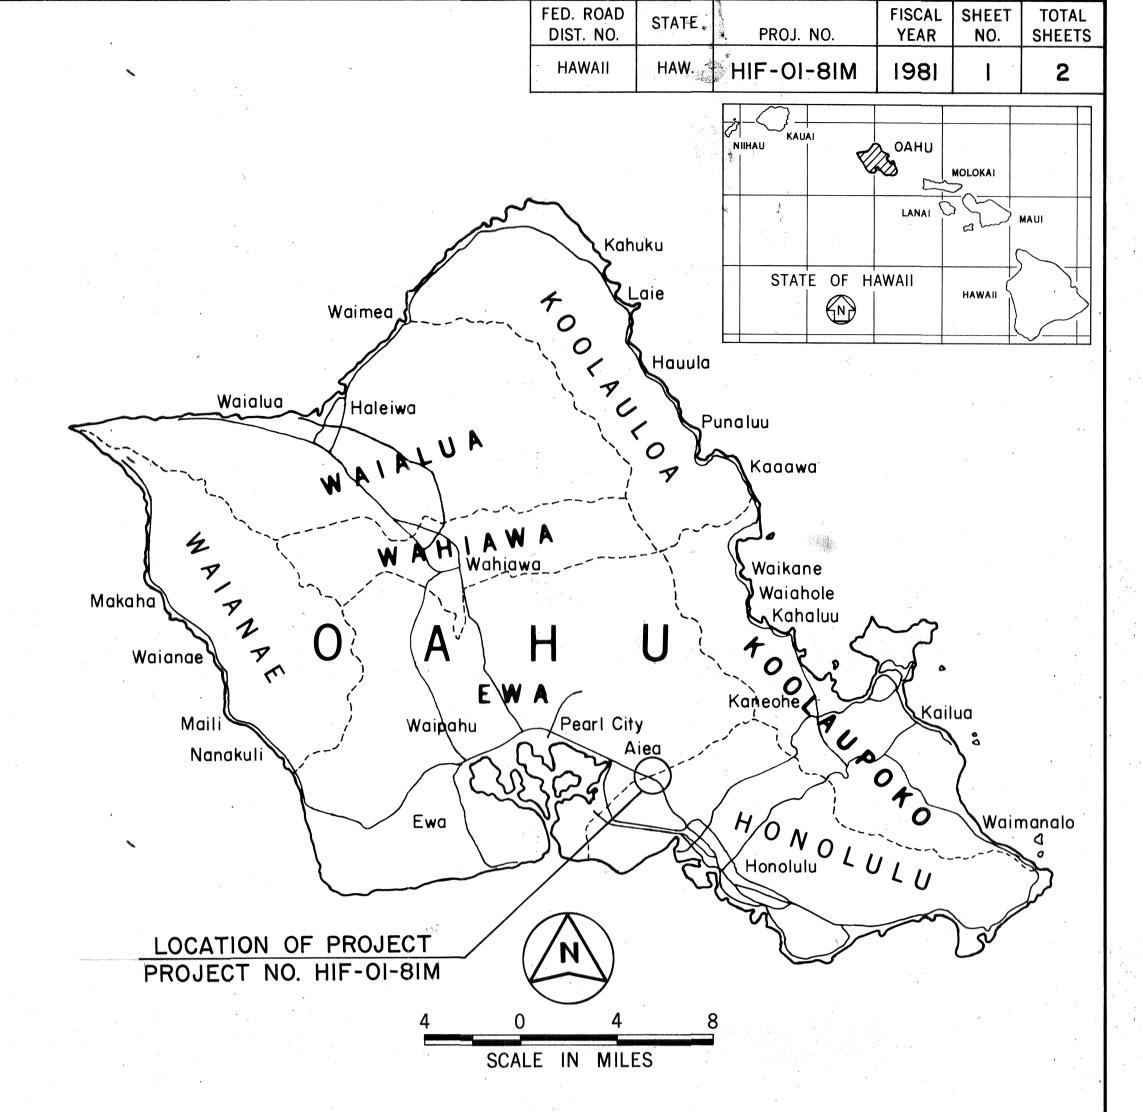

THIS PROJECT IS LOCATED ON SOUTH HALAWA STREAM IN THE LINED PORTION OF STREAM ADJACENT TO THE H-3 FREEWAY.

IMPROVEMENTS CONSIST OF INSTALLING FILTER ROCK AND REPAIRING THE EXISTING CONCRETE STREAM

ALL. CHANGES MADE DURING CONSTRUCTION HAVE BEEN INCORPORATED ON THESE PLANS IN RED EXCEPT CHANGES IN THE ORIGINAL THEORETICAL QUANTITIES. FOR ACTUAL QUANTITIES, REFER TO PROJECT LEDGER AND/OR COMPUTATION BOOK.

Pard Jamashiro
RESIDENT ENGINEER

DEPARTMENT OF TRANSPORTATION STATE OF HAWAII APPROVED:

April, 1981 DATE