



FED. ROAD DIST. NO.	STATE	FED. AID PROJ. NO.	FISCAL YEAR	SHEET NO.	TOTAL SHEETS
HAWAII	HAW.	IR-HI-1(167)	1982	3	17

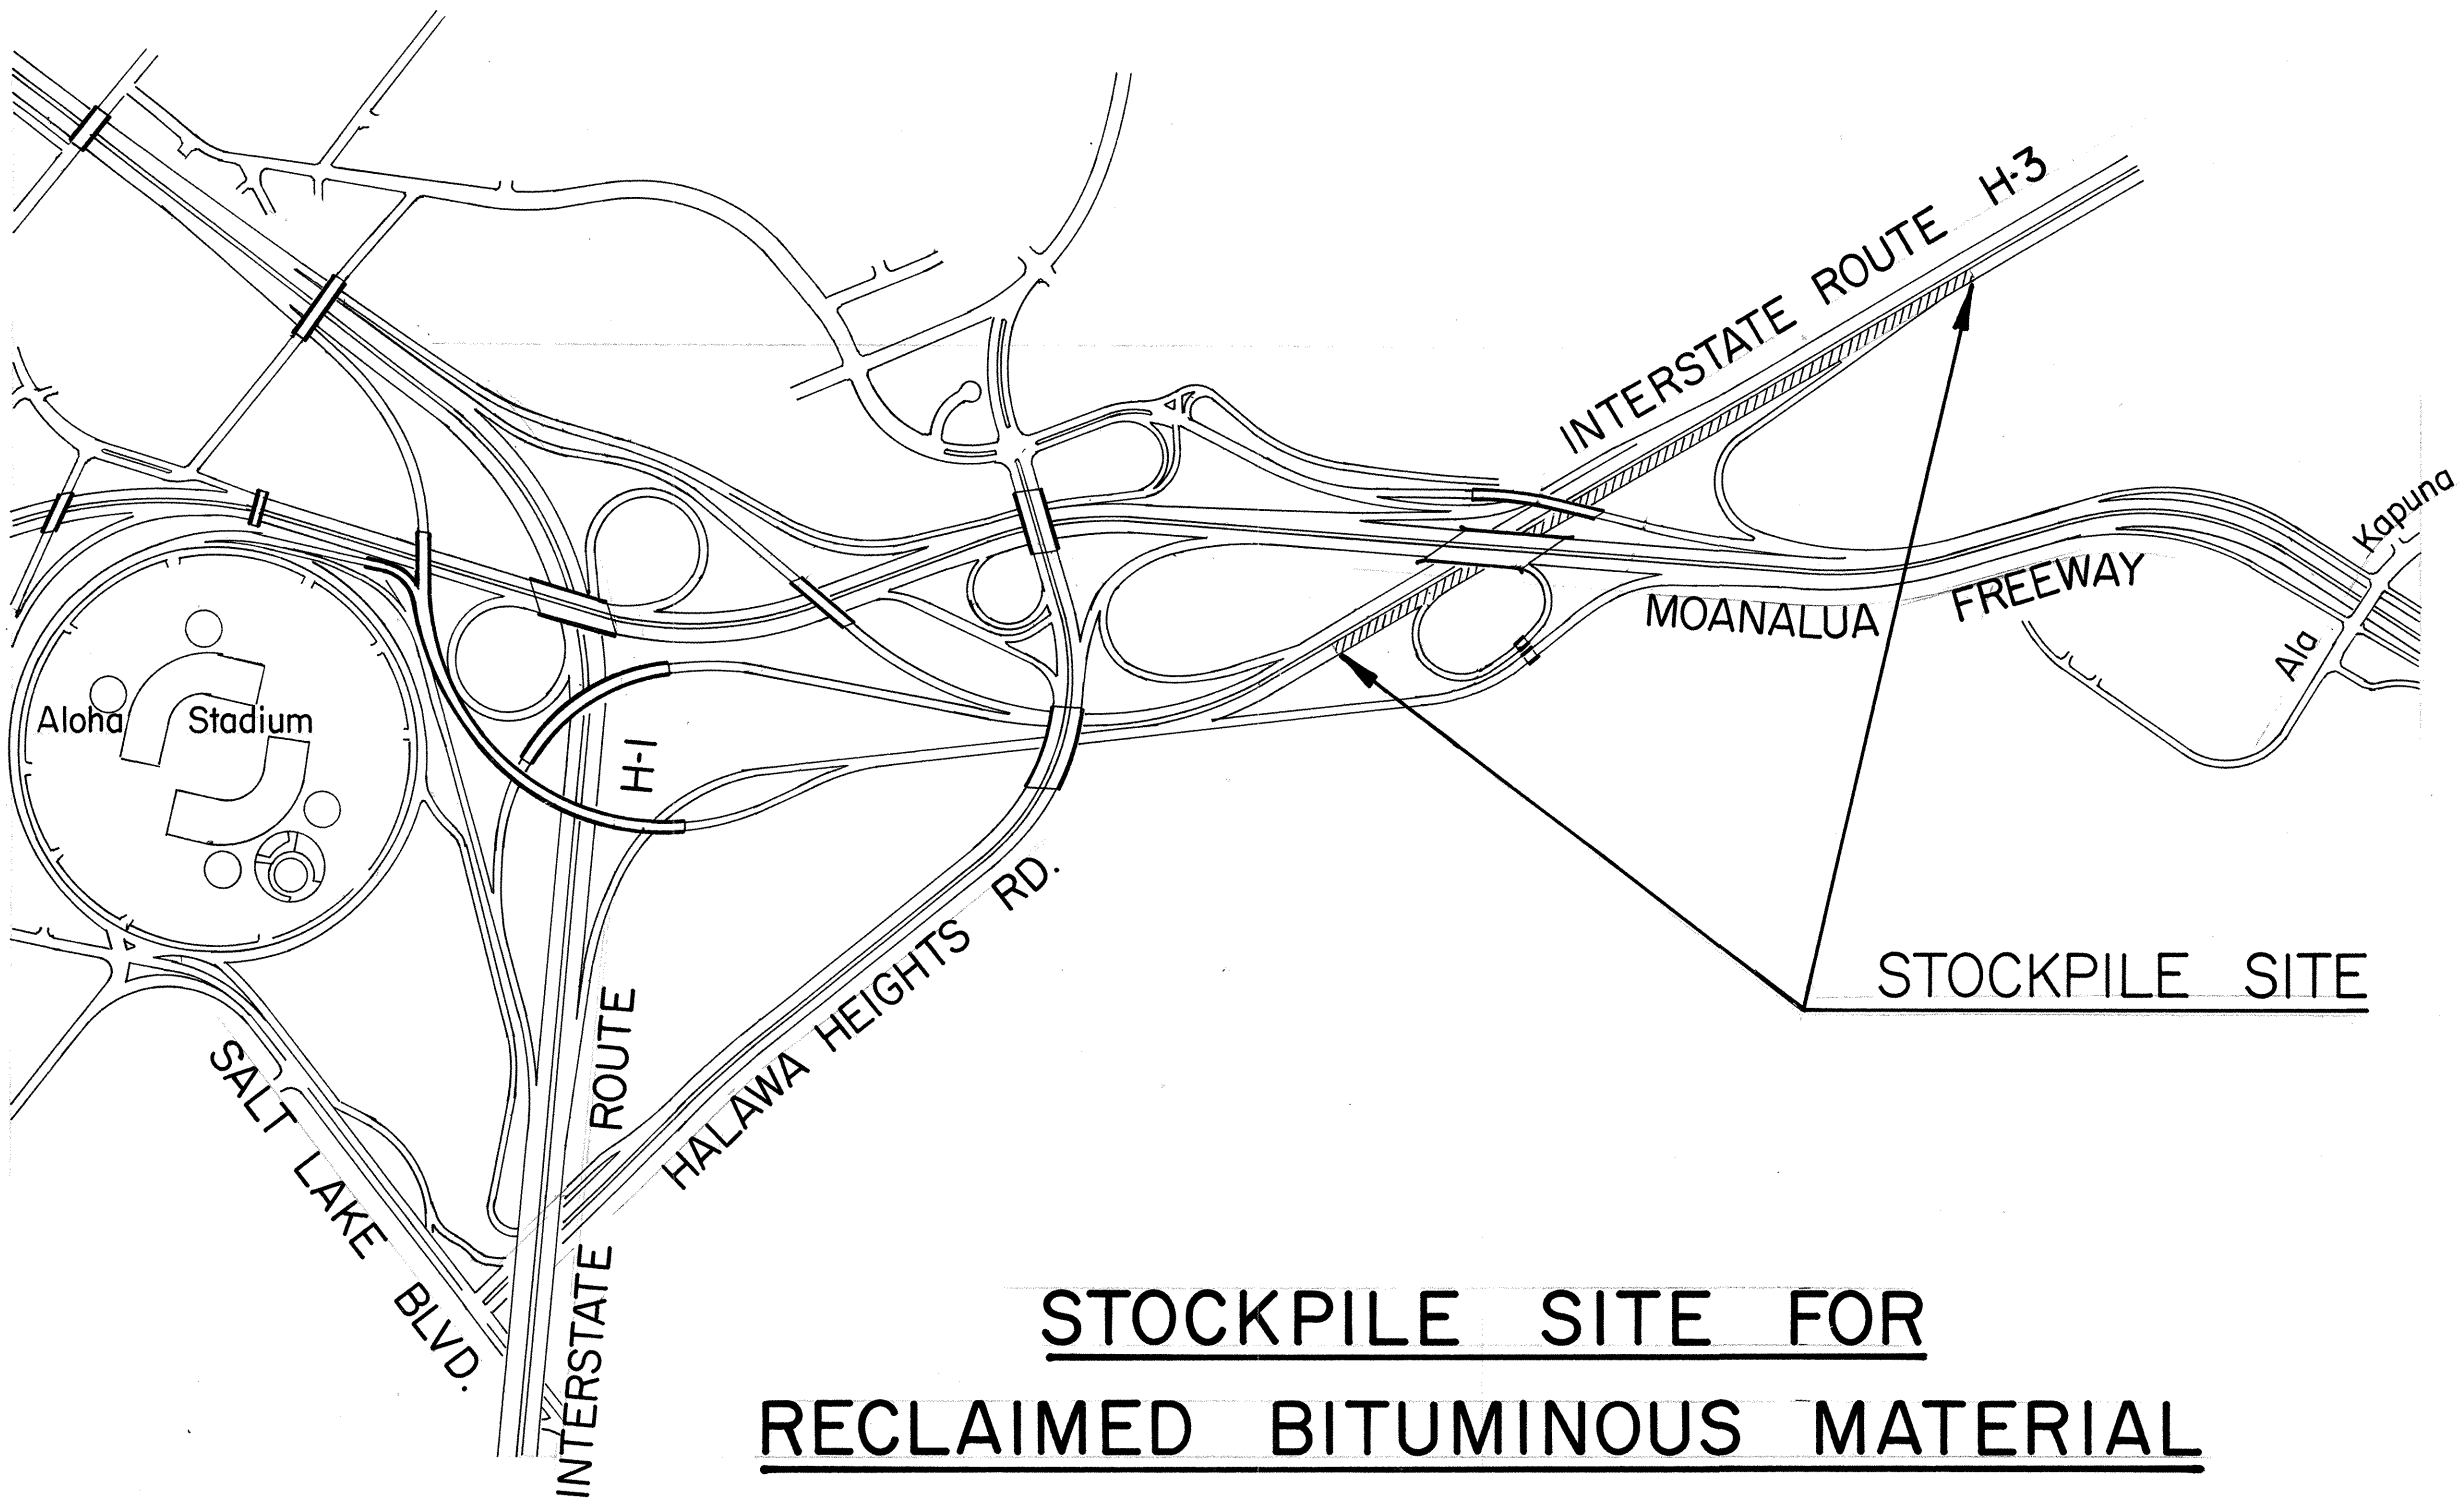

STOCKPILE SITE FOR RECLAIMED BITUMINOUS MATERIAL

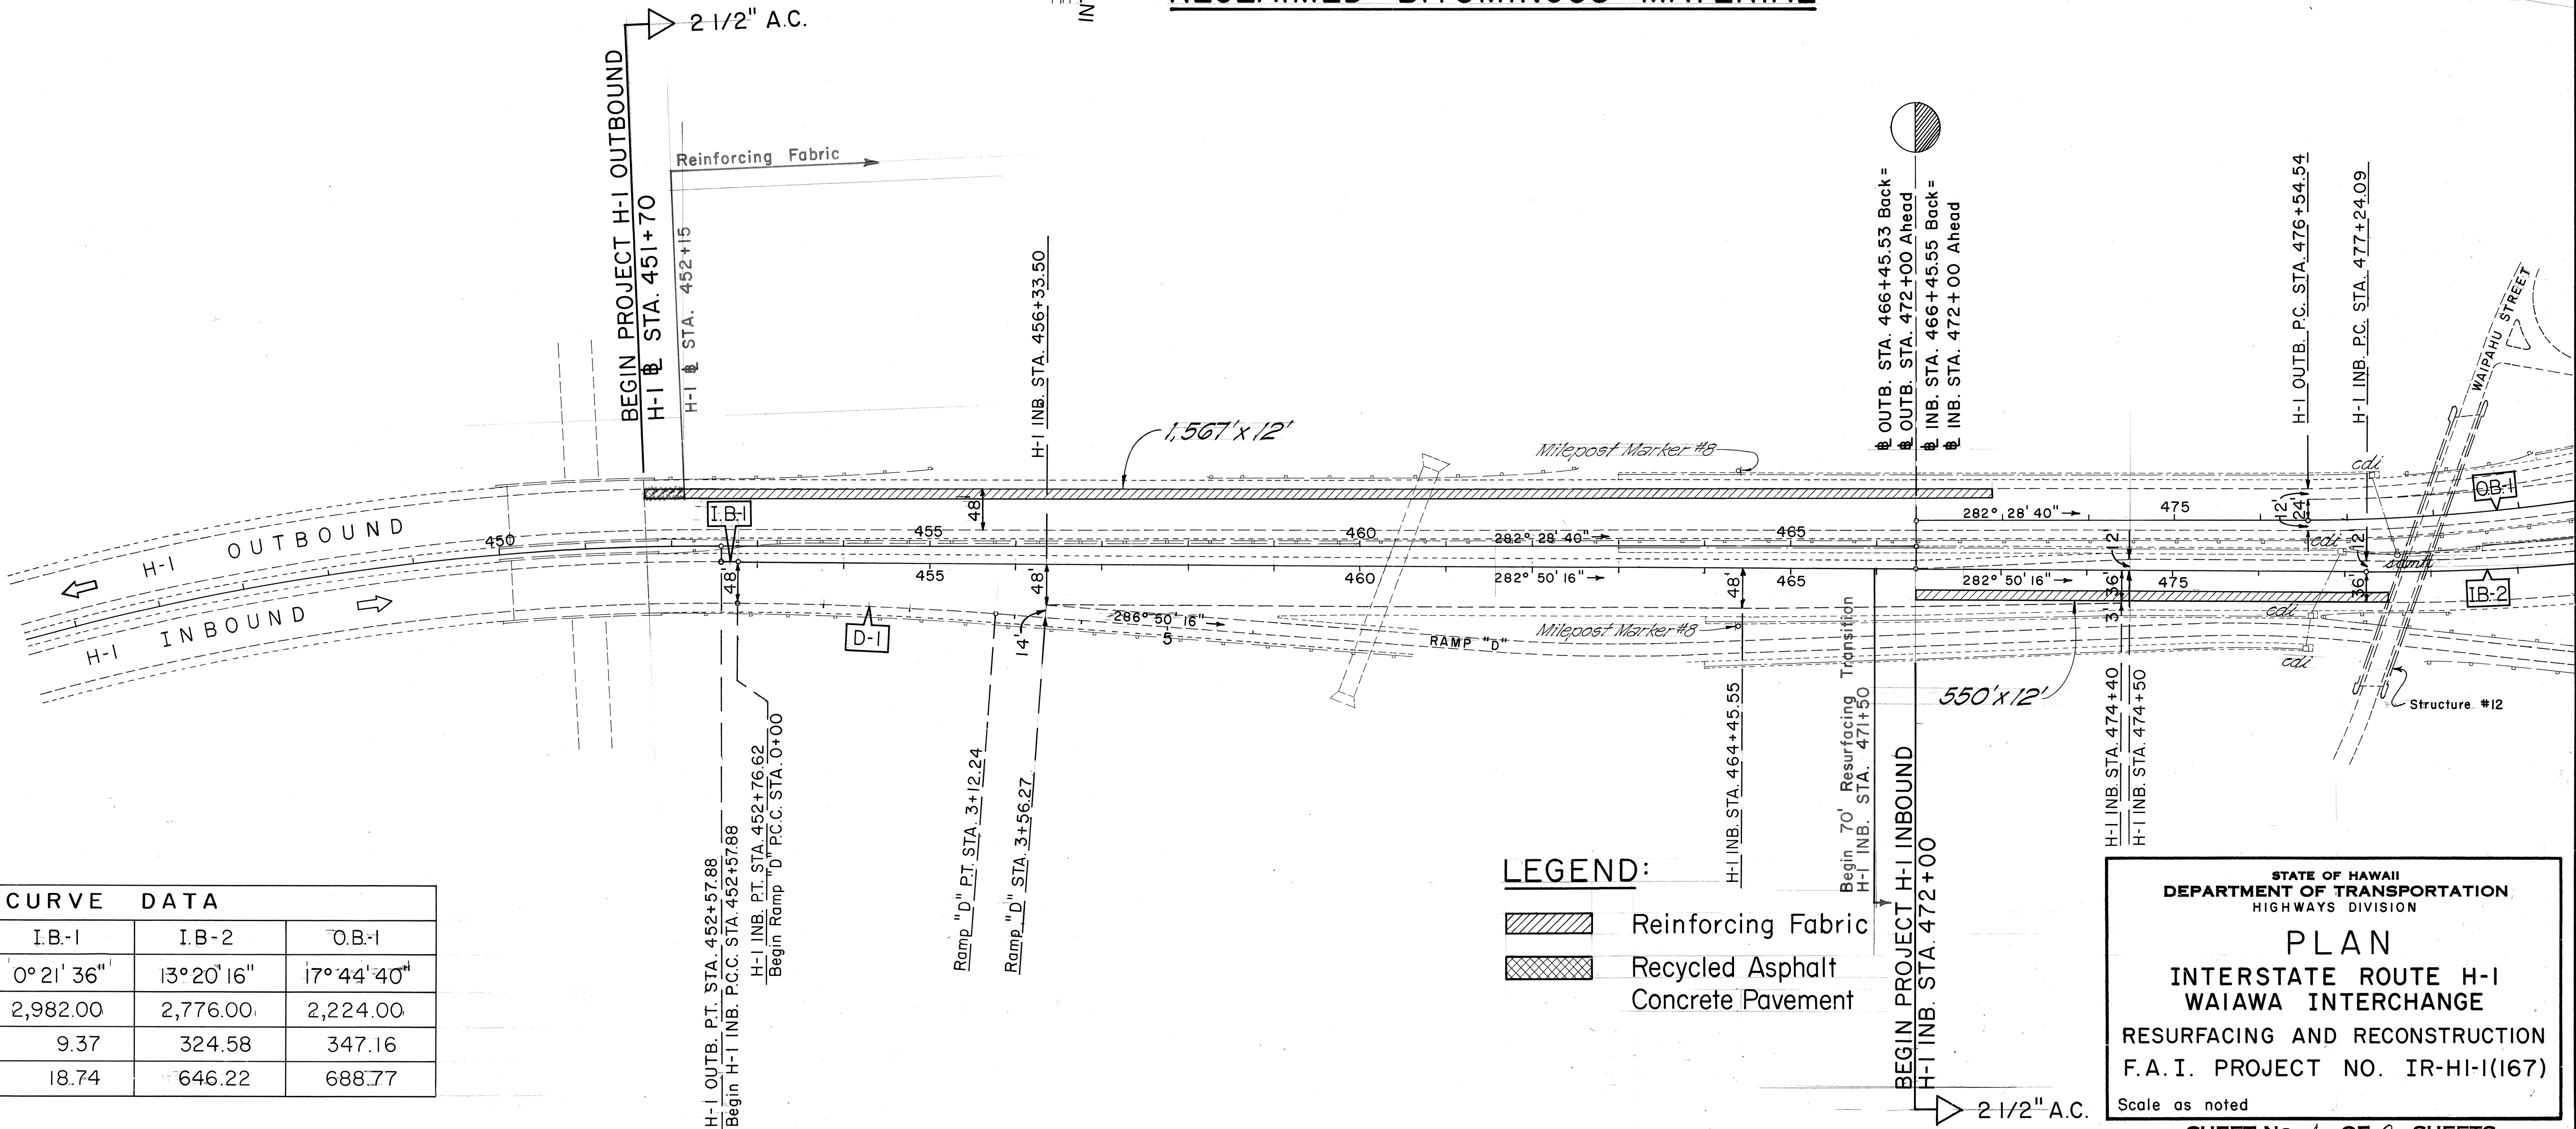

ORIGINAL PLAN	SURVEY PLOTTED BY	DATE
DESIGNED BY		
CHECKED BY		
NOTED BY		
NO.		

CURVE DATA				
	D-1	I.B-1	I.B-2	O.B-1
Δ	4° 00' 00"	0° 21' 36"	13° 20' 16"	17° 44' 40"
R	4,472.48	2,982.00	2,776.00	2,224.00
T	156.18	9.37	324.58	347.16
L	312.24	18.74	646.22	688.77

- LEGEND:
- Reinforcing Fabric
 - Recycled Asphalt Concrete Pavement


STATE OF HAWAII
DEPARTMENT OF TRANSPORTATION
HIGHWAYS DIVISION

PLAN
INTERSTATE ROUTE H-1
WAI'AWA INTERCHANGE
RESURFACING AND RECONSTRUCTION
F.A.I. PROJECT NO. IR-HI-1(167)
Scale as noted

FED. ROAD DIST. NO.	STATE	FED. AID PROJ. NO.	FISCAL YEAR	SHEET NO.	TOTAL SHEETS
HAWAII	HAW.	IR-HI-1(167)	1982	4	17

CURVE DATA						
	O.B.-1	O.B.-2	O.B.-3	I.B.-2	I.B.-3	I.B.-4
Δ	17° 44' 40"	42° 00' 00"	41° 28' 00"	13° 20' 16"	33° 30' 00"	55° 00' 00"
R	2,224.00	2,500.00	1,524.00	2,776.00	1,910.00	1,500.00
T	347.16	959.66	576.88	324.58	574.84	780.85
L	688.77	1,832.60	1,102.96	646.22	1,116.75	1,439.90

SURVEY PLOTTED BY	DATE
DRAWN BY	
DESIGNED BY	
CHECKED BY	
ORIGINAL PLAN	
NOTE BOOK	
No.	

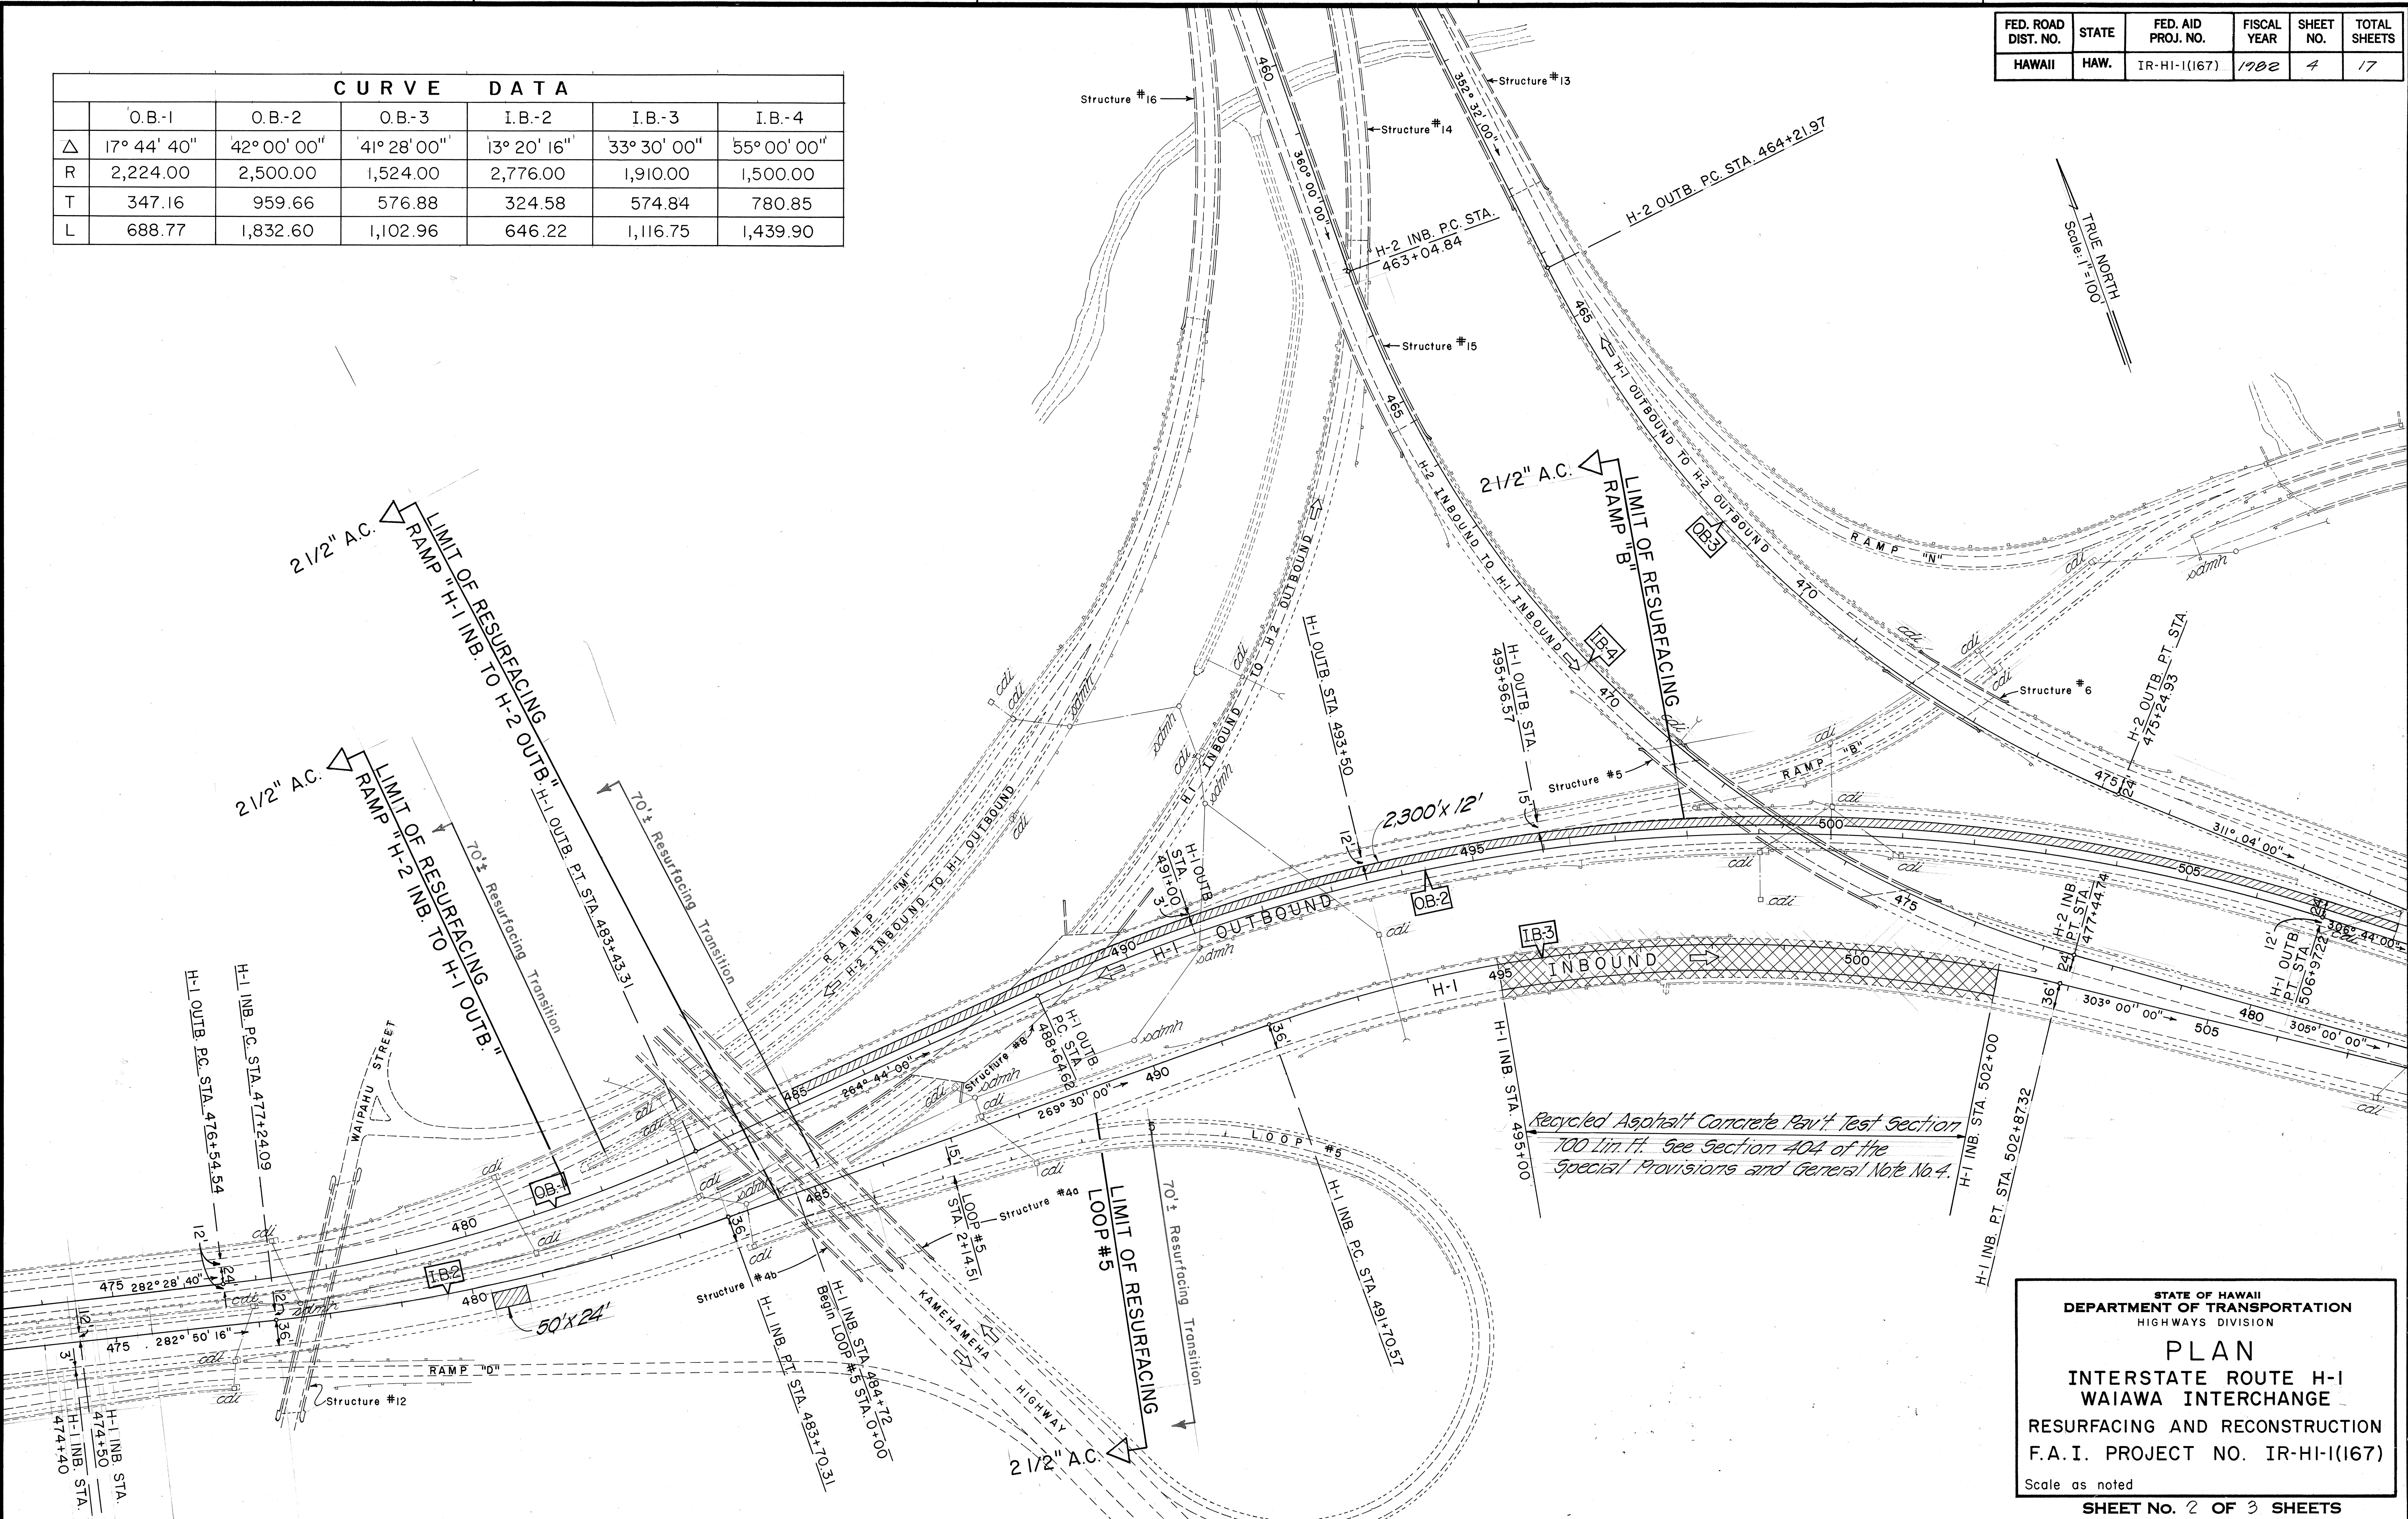

STATE OF HAWAII
DEPARTMENT OF TRANSPORTATION
HIGHWAYS DIVISION

PLAN
INTERSTATE ROUTE H-1
WAIAWA INTERCHANGE
RESURFACING AND RECONSTRUCTION
F.A.I. PROJECT NO. IR-HI-1(167)
Scale as noted
SHEET NO. 2 OF 3 SHEETS

FED. ROAD DIST. NO.	STATE	FED. AID PROJ. NO.	FISCAL YEAR	SHEET NO.	TOTAL SHEETS
HAWAII	HAW.	IR-HI-1(167)	1982	5	17

ORIGINAL PLAN	SURVEY PLOTTED BY	DATE
NOTED BY	DRAWN BY	
QUANTITIES BY	CHECKED BY	
No.		

	CURVE DATA						
	O.B.-2	O.B.-3	O.B.-4	O.B.-5	I.B.-3	I.B.-4	I.B.-5
Δ	42° 00' 00"	41° 28' 00"	6° 16' 40"	14° 04' 20"	33° 30' 00"	55° 00' 00"	12° 20' 20"
R	2,500.00	1,524.00	3,273.74	3,600.00	1,910.00	1,500.00	3,600.00
T	959.66	576.88	179.53	444.33	574.84	780.85	389.14
L	1,832.60	1,102.96	358.70	884.18	1,116.75	1,439.90	775.28

STATE OF HAWAII
DEPARTMENT OF TRANSPORTATION
HIGHWAYS DIVISION

PLAN

INTERSTATE ROUTE H-1
WAIAWA INTERCHANGE
RESURFACING AND RECONSTRUCTION
F.A.I. PROJECT NO. IR-HI-1(167)

Scale as noted

SHEET NO. 3 OF 3 SHEETS

