
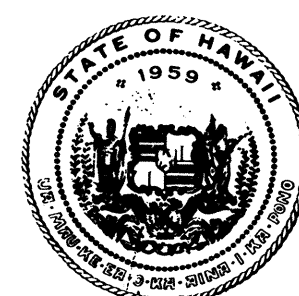




[illegible]

STATE OF HAWAII  
DEPARTMENT OF TRANSPORTATION  
HIGHWAYS DIVISION

INTERSTATE ROUTE H-1 RESURFACING  
WAIAWA INTERCHANGE SECTION  
FEDERAL AID INTERSTATE PROJ. NO. IR-HI-1(167)  
DISTRICT OF EWA  
ISLAND OF OAHU

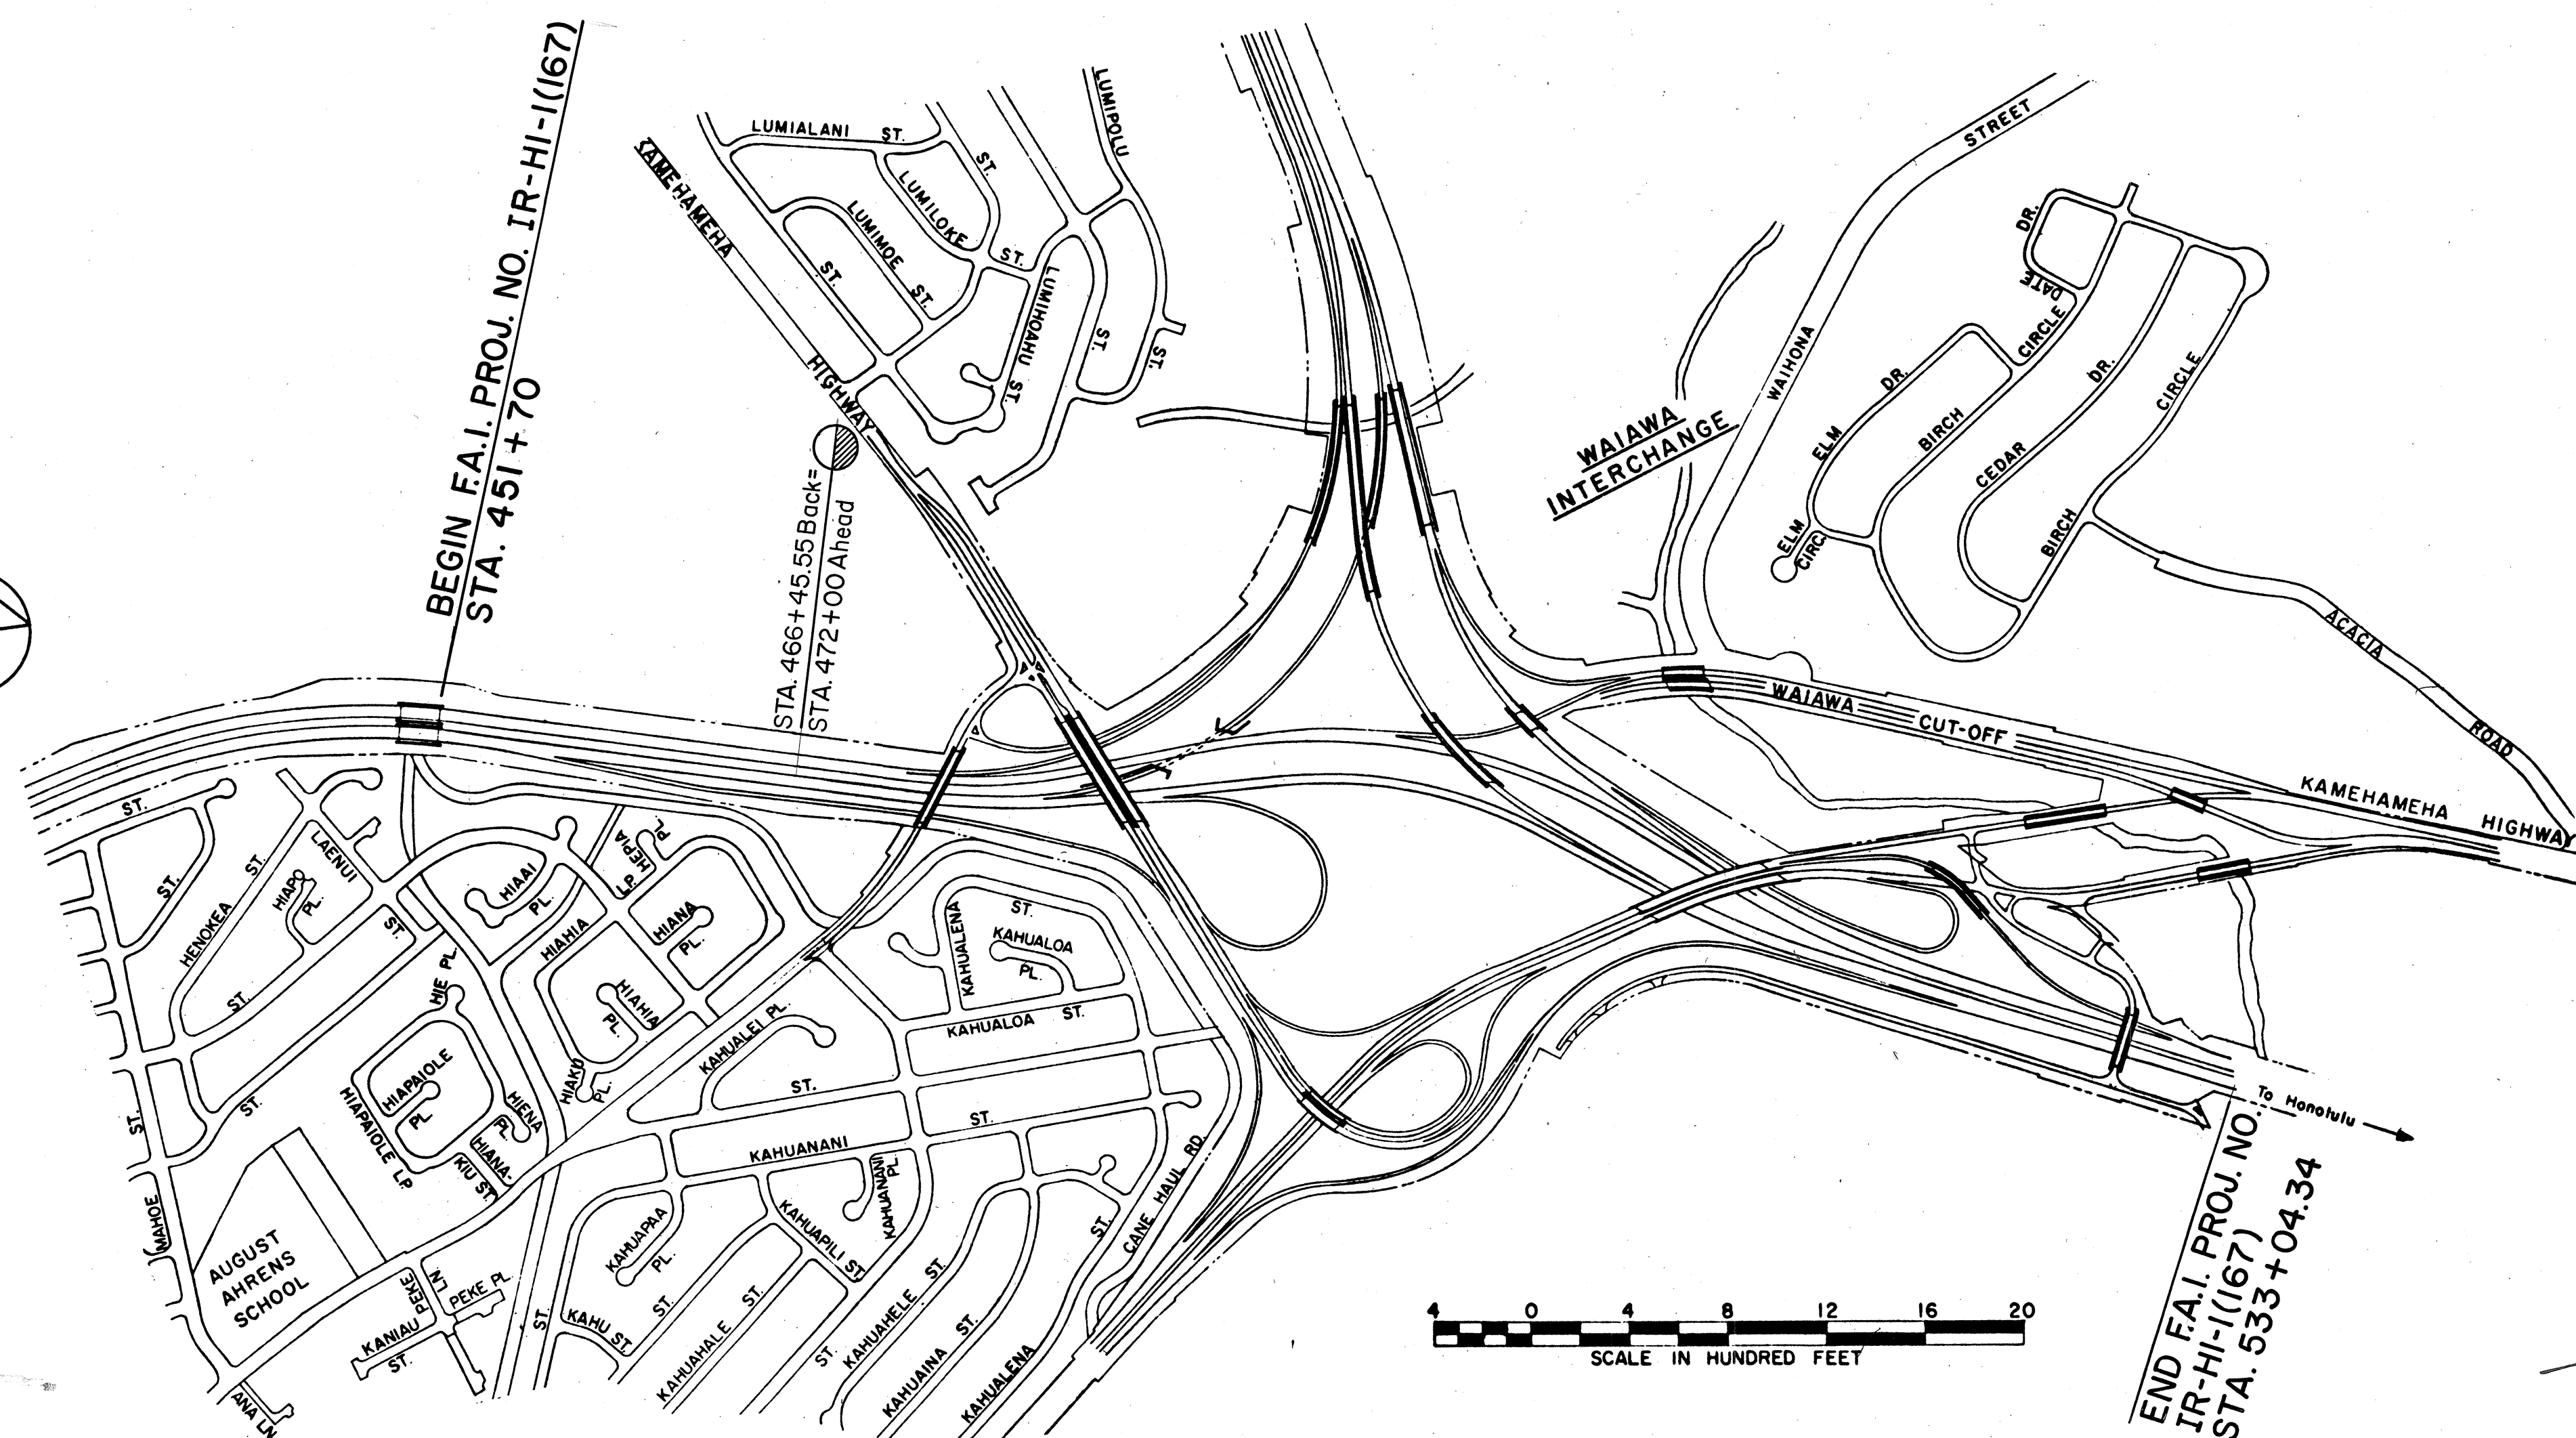

FED. ROAD DIST. NO.	STATE	FED. AID PROJ. NO.	FISCAL YEAR	SHEET NO.	TOTAL SHEETS
HAWAII	HAW.	IR-HI-1(167)	1982	1	17

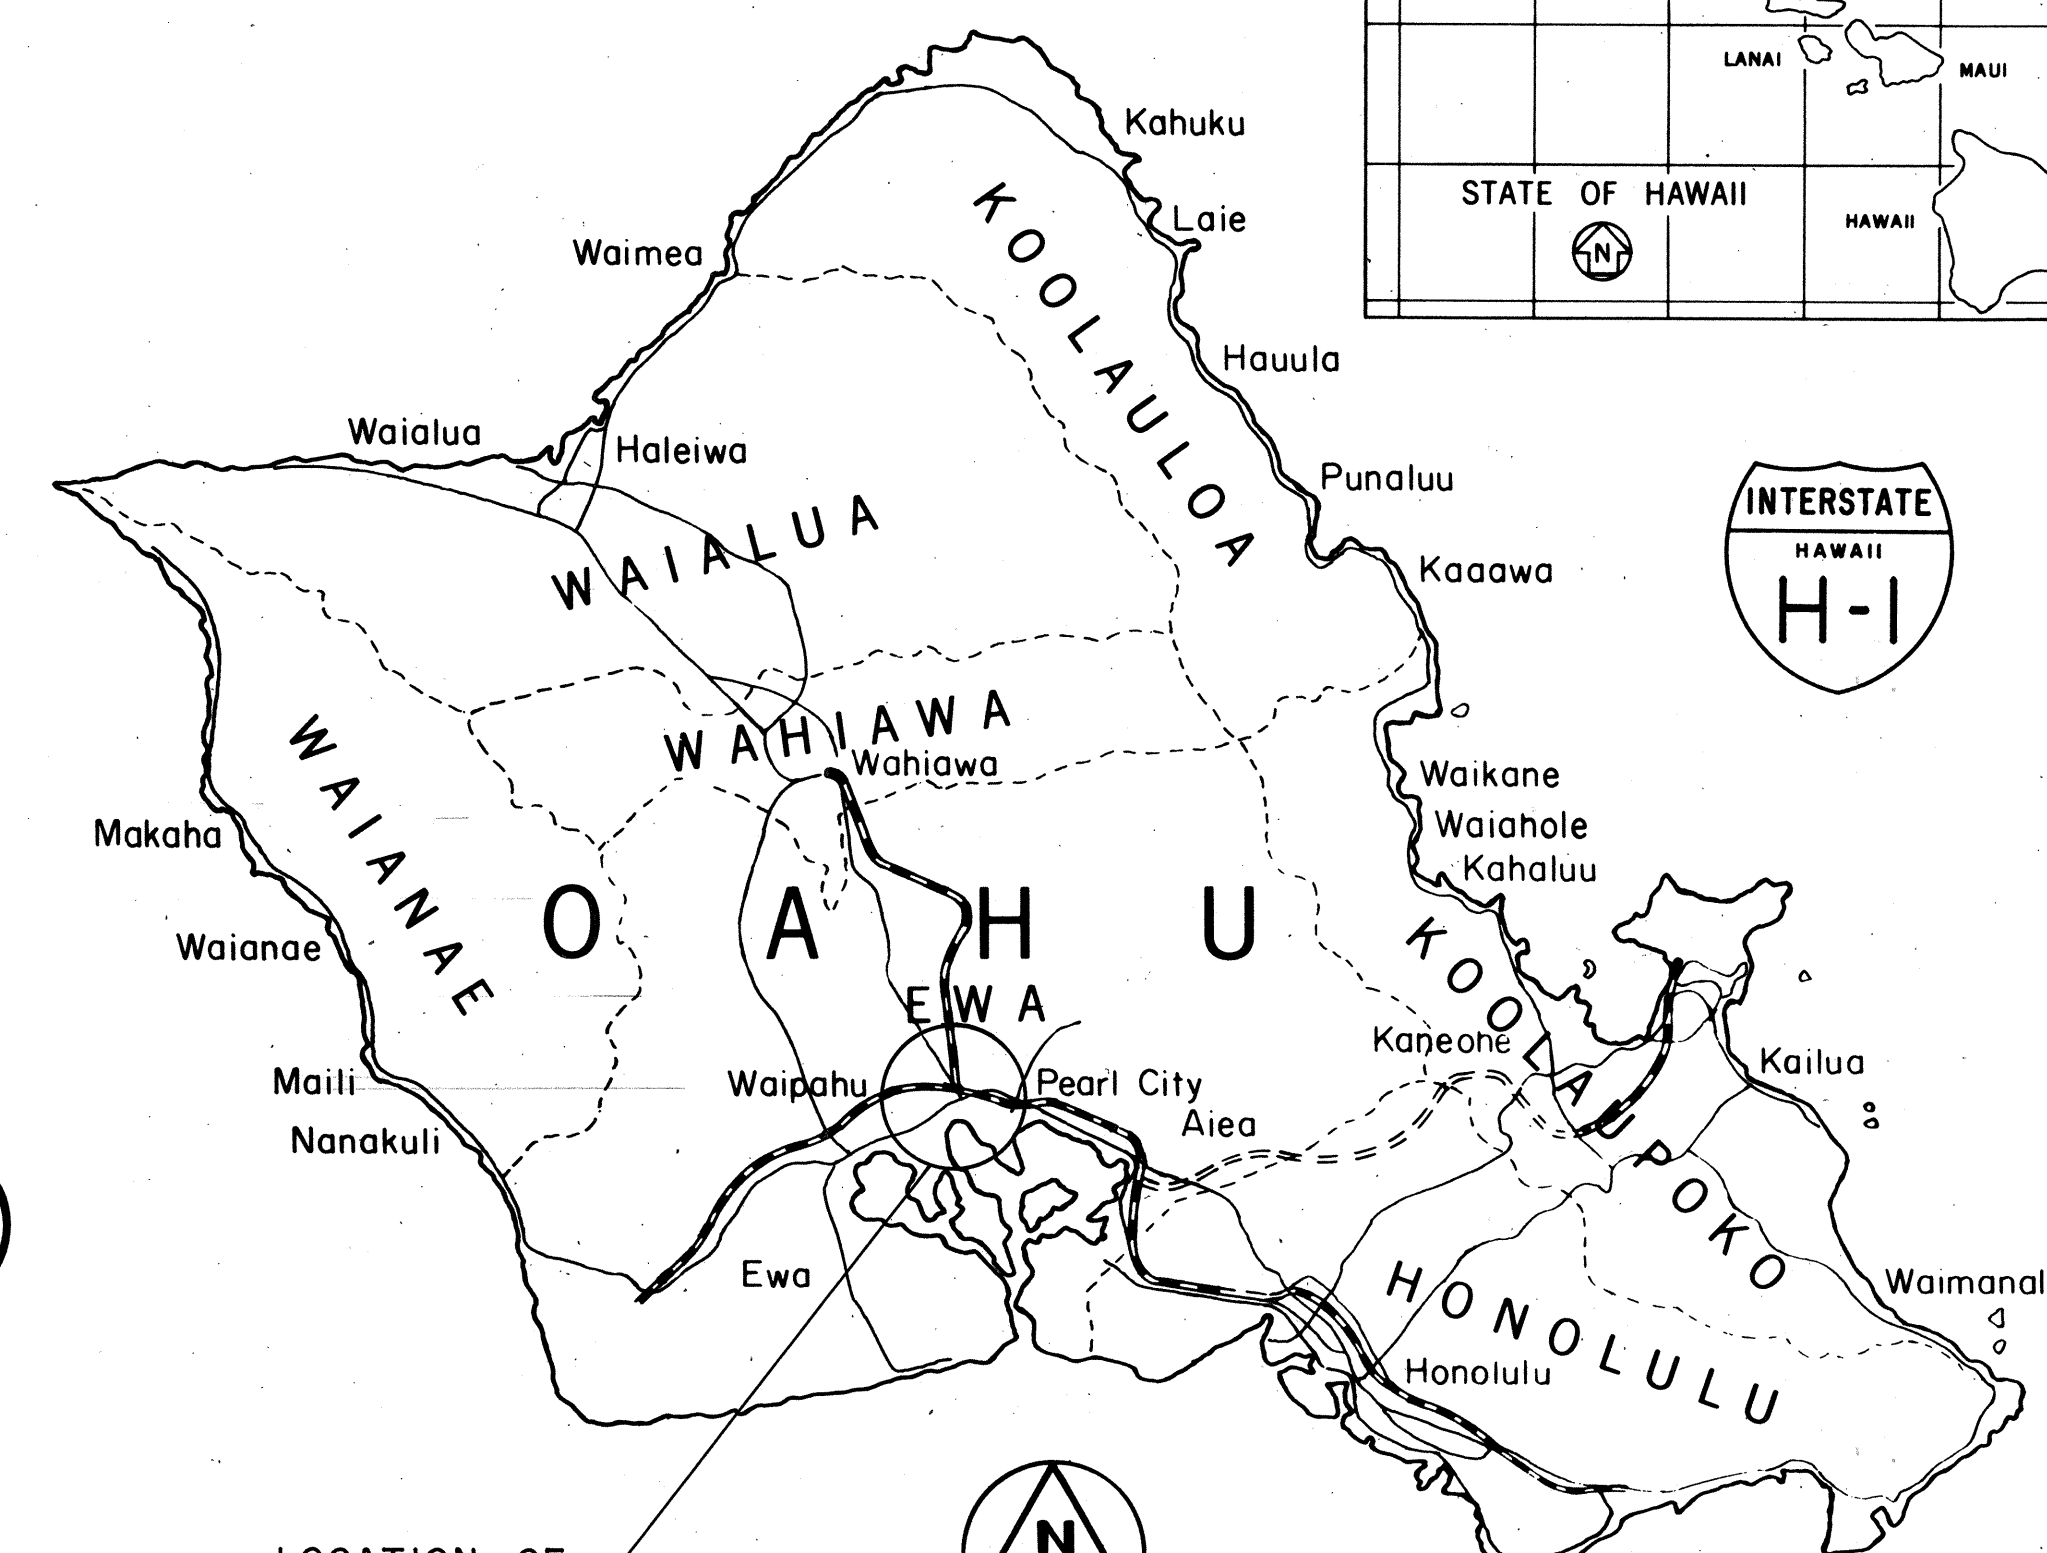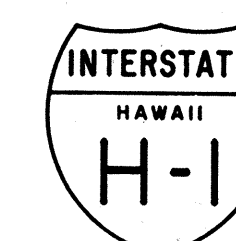

4 0 4  
SCALE IN MILES



 FEDERAL AID INTERSTATE PROJECTS PREVIOUSLY CONSTRUCTED  
 OR UNDER CONSTRUCTION


DESIGN	DESIGNATION
1	1
2	2
3	3
100	100


ALL CHANGES MADE DURING CONSTRUCTION HAVE BEEN INCORPORATED ON THESE PLANS IN RED EXCEPT CHANGES IN THE ORIGINAL THEORETICAL QUANTITIES.

FOR ACTUAL QUANTITIES REFER TO PROJECT LEDGER.

*Michael Omega*  
RESIDENT ENGINEER

5/26/8  
DATE

DEPARTMENT OF TRANSPORTATION FEDERAL HIGHWAY ADMINISTRATION	
APPROVED:	
	8.20.8
DIVISION ADMINISTRATOR	DATE

DEPARTMENT OF TRANSPORTATION STATE OF HAWAII	
APPROVED: 	7/30/81
DIR. OF TRANSPORTATION	DATE