


FED. ROAD DIST. NO.	STATE	FED. AID PROJ. NO.	FISCAL YEAR	SHEET NO.	TOTAL SHEETS
HAWAII	HAW.	I-HH-1(133)17	1981	10	159

LEGEND


13.10 Future Finish Grade Elevation
(Fin. Grade for this Contract is lower. See Typical Sections.)

Temporary Pavement

3:45 Flare = Parabolic Curve, $x=45'$, $y=3'$

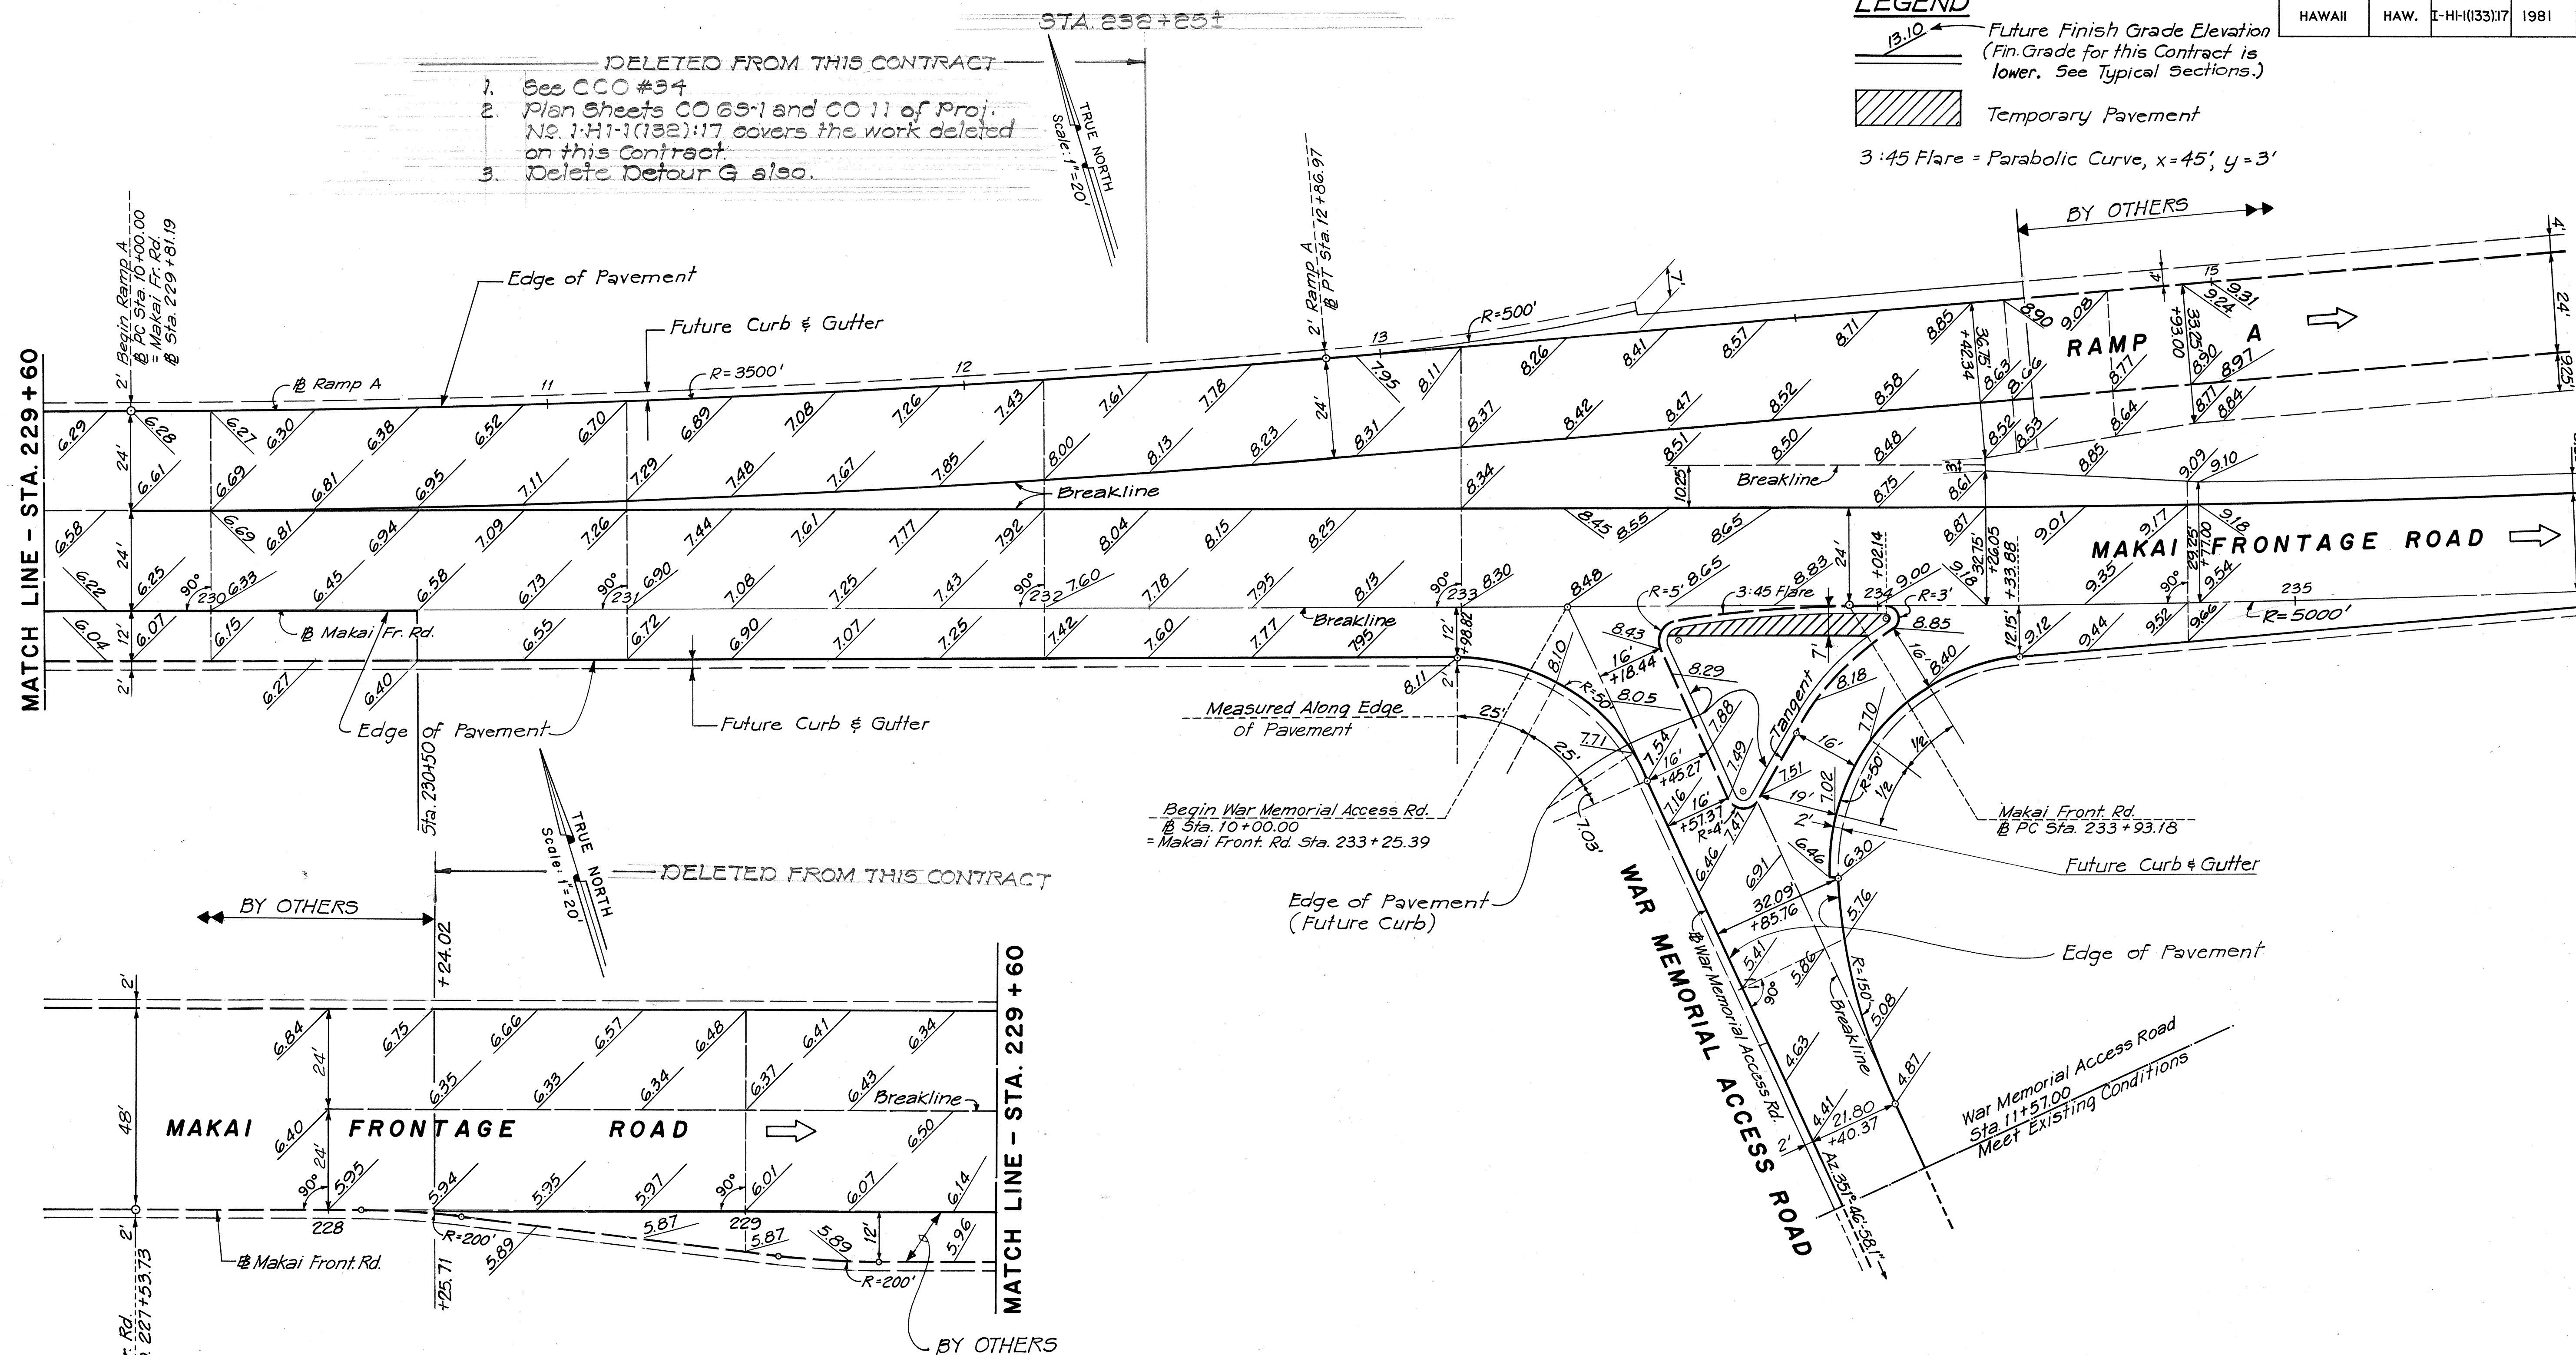

RAMP A & MAKAI FRONTAGE ROAD and WAR MEMORIAL ACCESS ROAD
SCALE: 1" = 20'

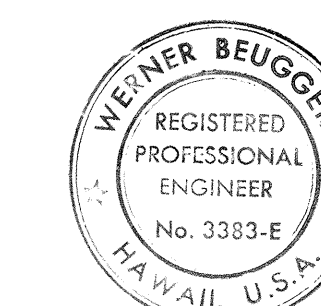

THIS WORK WAS PREPARED BY
ME OR UNDER MY SUPERVISION.



W. Weiner Beugert

STATE OF HAWAII
DEPARTMENT OF TRANSPORTATION
HIGHWAYS DIVISION
RAMP TERMINAL & INTERSECTION
MAKAI FR. RD. / RAMP A /
WAR MEMORIAL ACC. RD.
INTERSTATE ROUTE H-1
PROJECT NO. I-HH-1 (133):17

SCALE: 1" = 20' DATE: 4/30/81
SHEET No. A-7 OF A-8 SHEETS

FED. ROAD DIST. NO.	STATE	FED. AID PROJ. NO.	FISCAL YEAR	SHEET NO.	TOTAL SHEETS
HAWAII	HAW.	I-H1-1(133)17	1981	11	159


NOTE :
For Legend - See Sheet No. A-7.

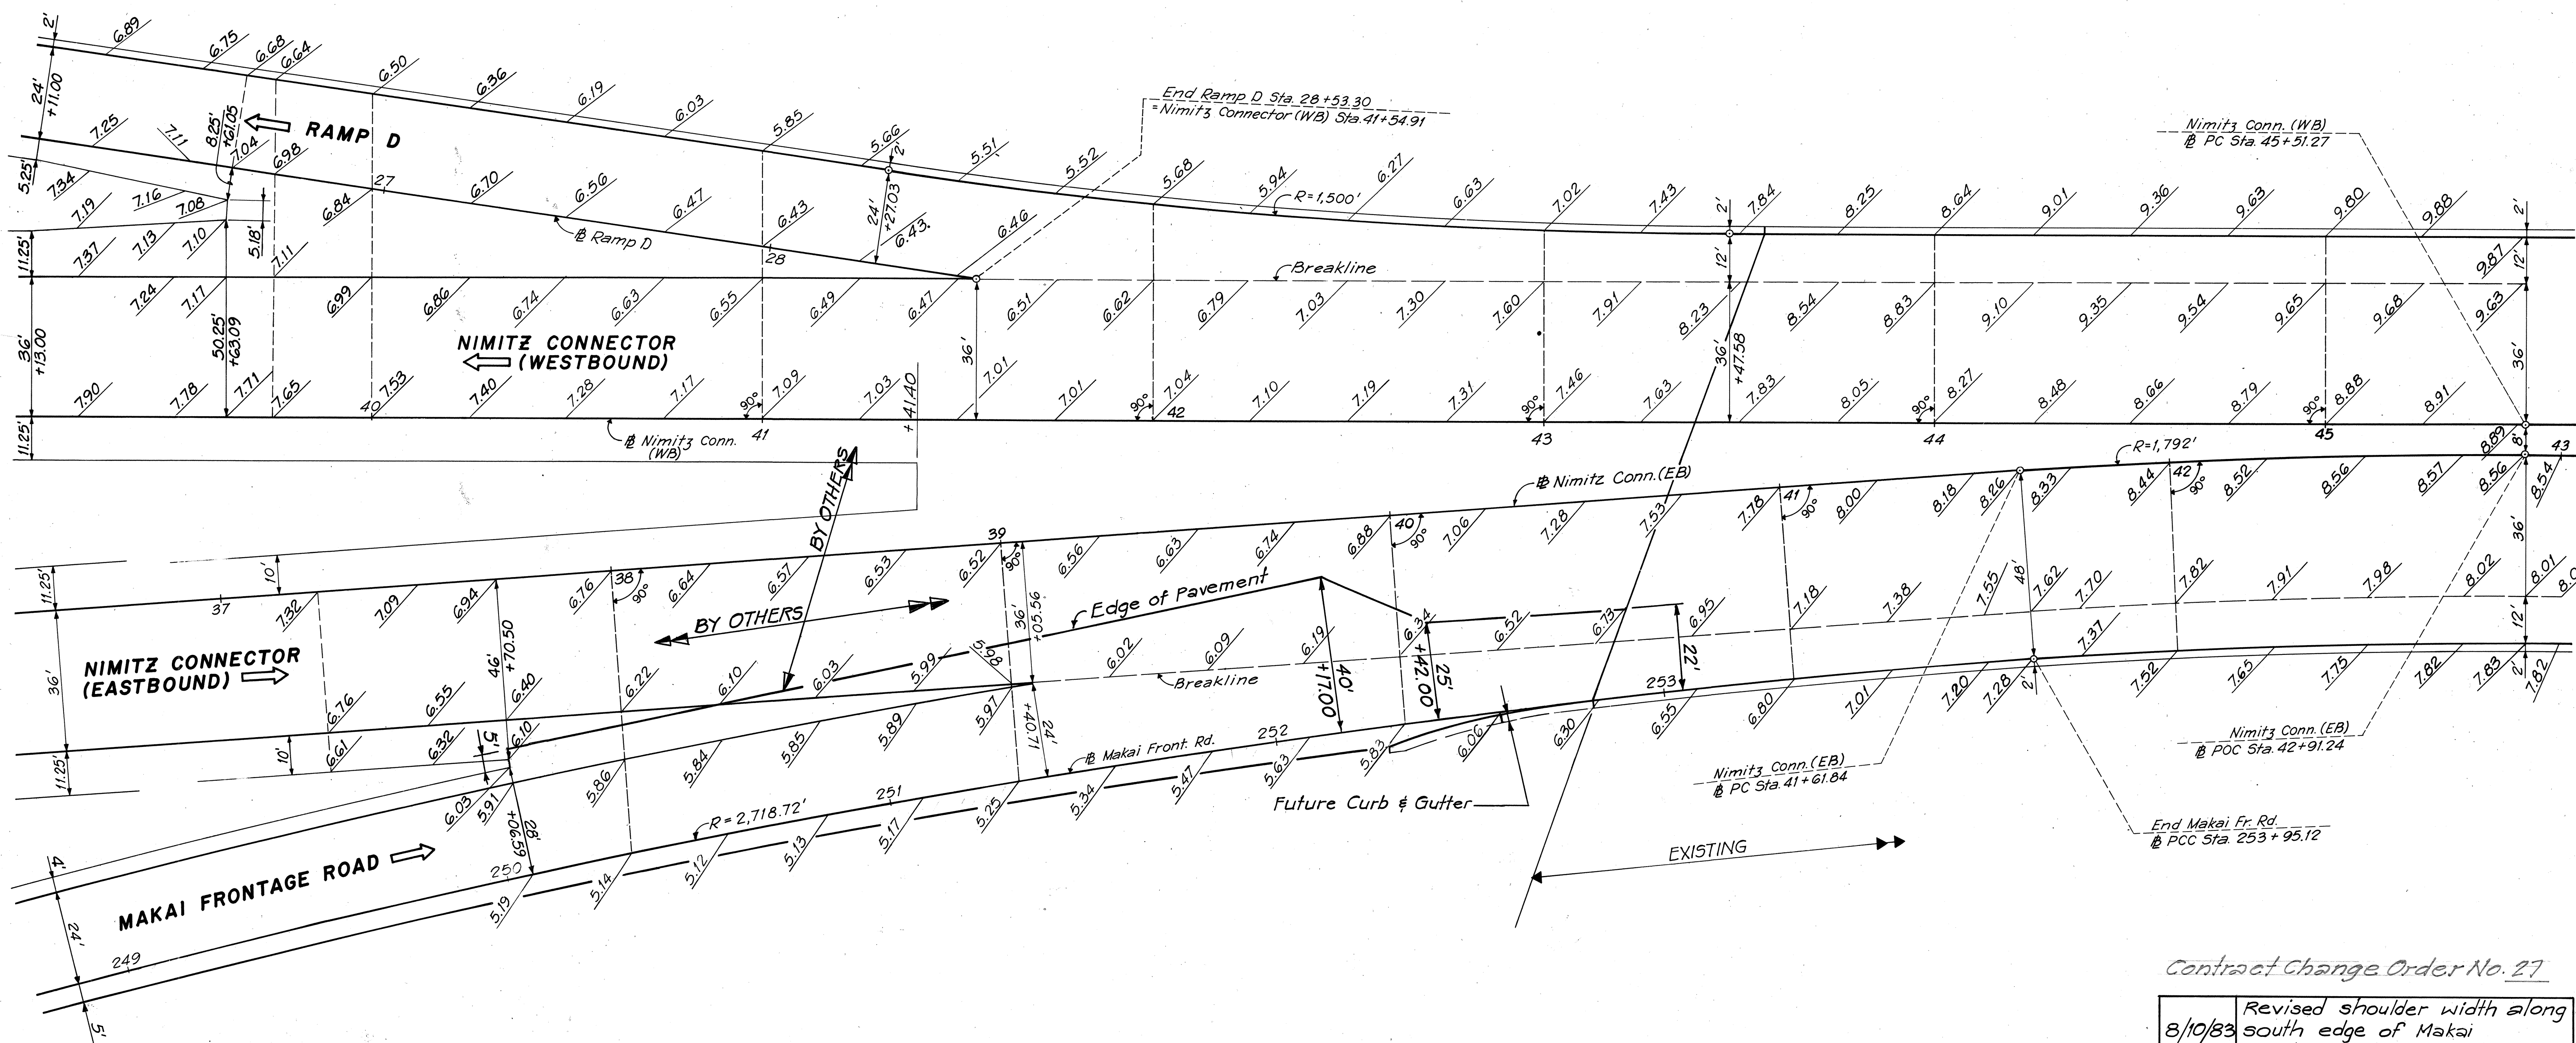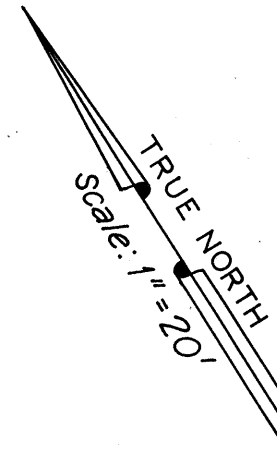

**RAMP D & NIMITZ CONNECTOR (WB) and
NIMITZ CONNECTOR (EB) & MAKAI FRONTAGE ROAD**
SCALE: 1" = 20'

Contract Change Order No. 27


8/10/83	Revised shoulder width along south edge of Makai Frontage Rd.
DATE	REVISION

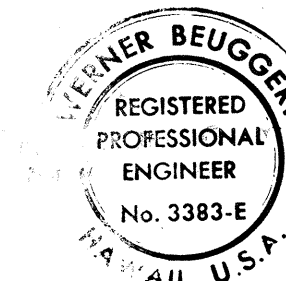

THIS WORK WAS PREPARED BY ME OR UNDER MY SUPERVISION.

STATE OF HAWAII
DEPARTMENT OF TRANSPORTATION
HIGHWAYS DIVISION
RAMP TERMINAL DETAILS
INTERSTATE ROUTE H-1
PROJECT NO. I-H1-1 (133) 17
SCALE: 1" = 20' DATE: 4/30/81
SHEET No. A-8 OF A-8 SHEETS

DESIGNED BY	DATE
DRAWN BY	
CHECKED BY	
NOTED BY	
NO.	

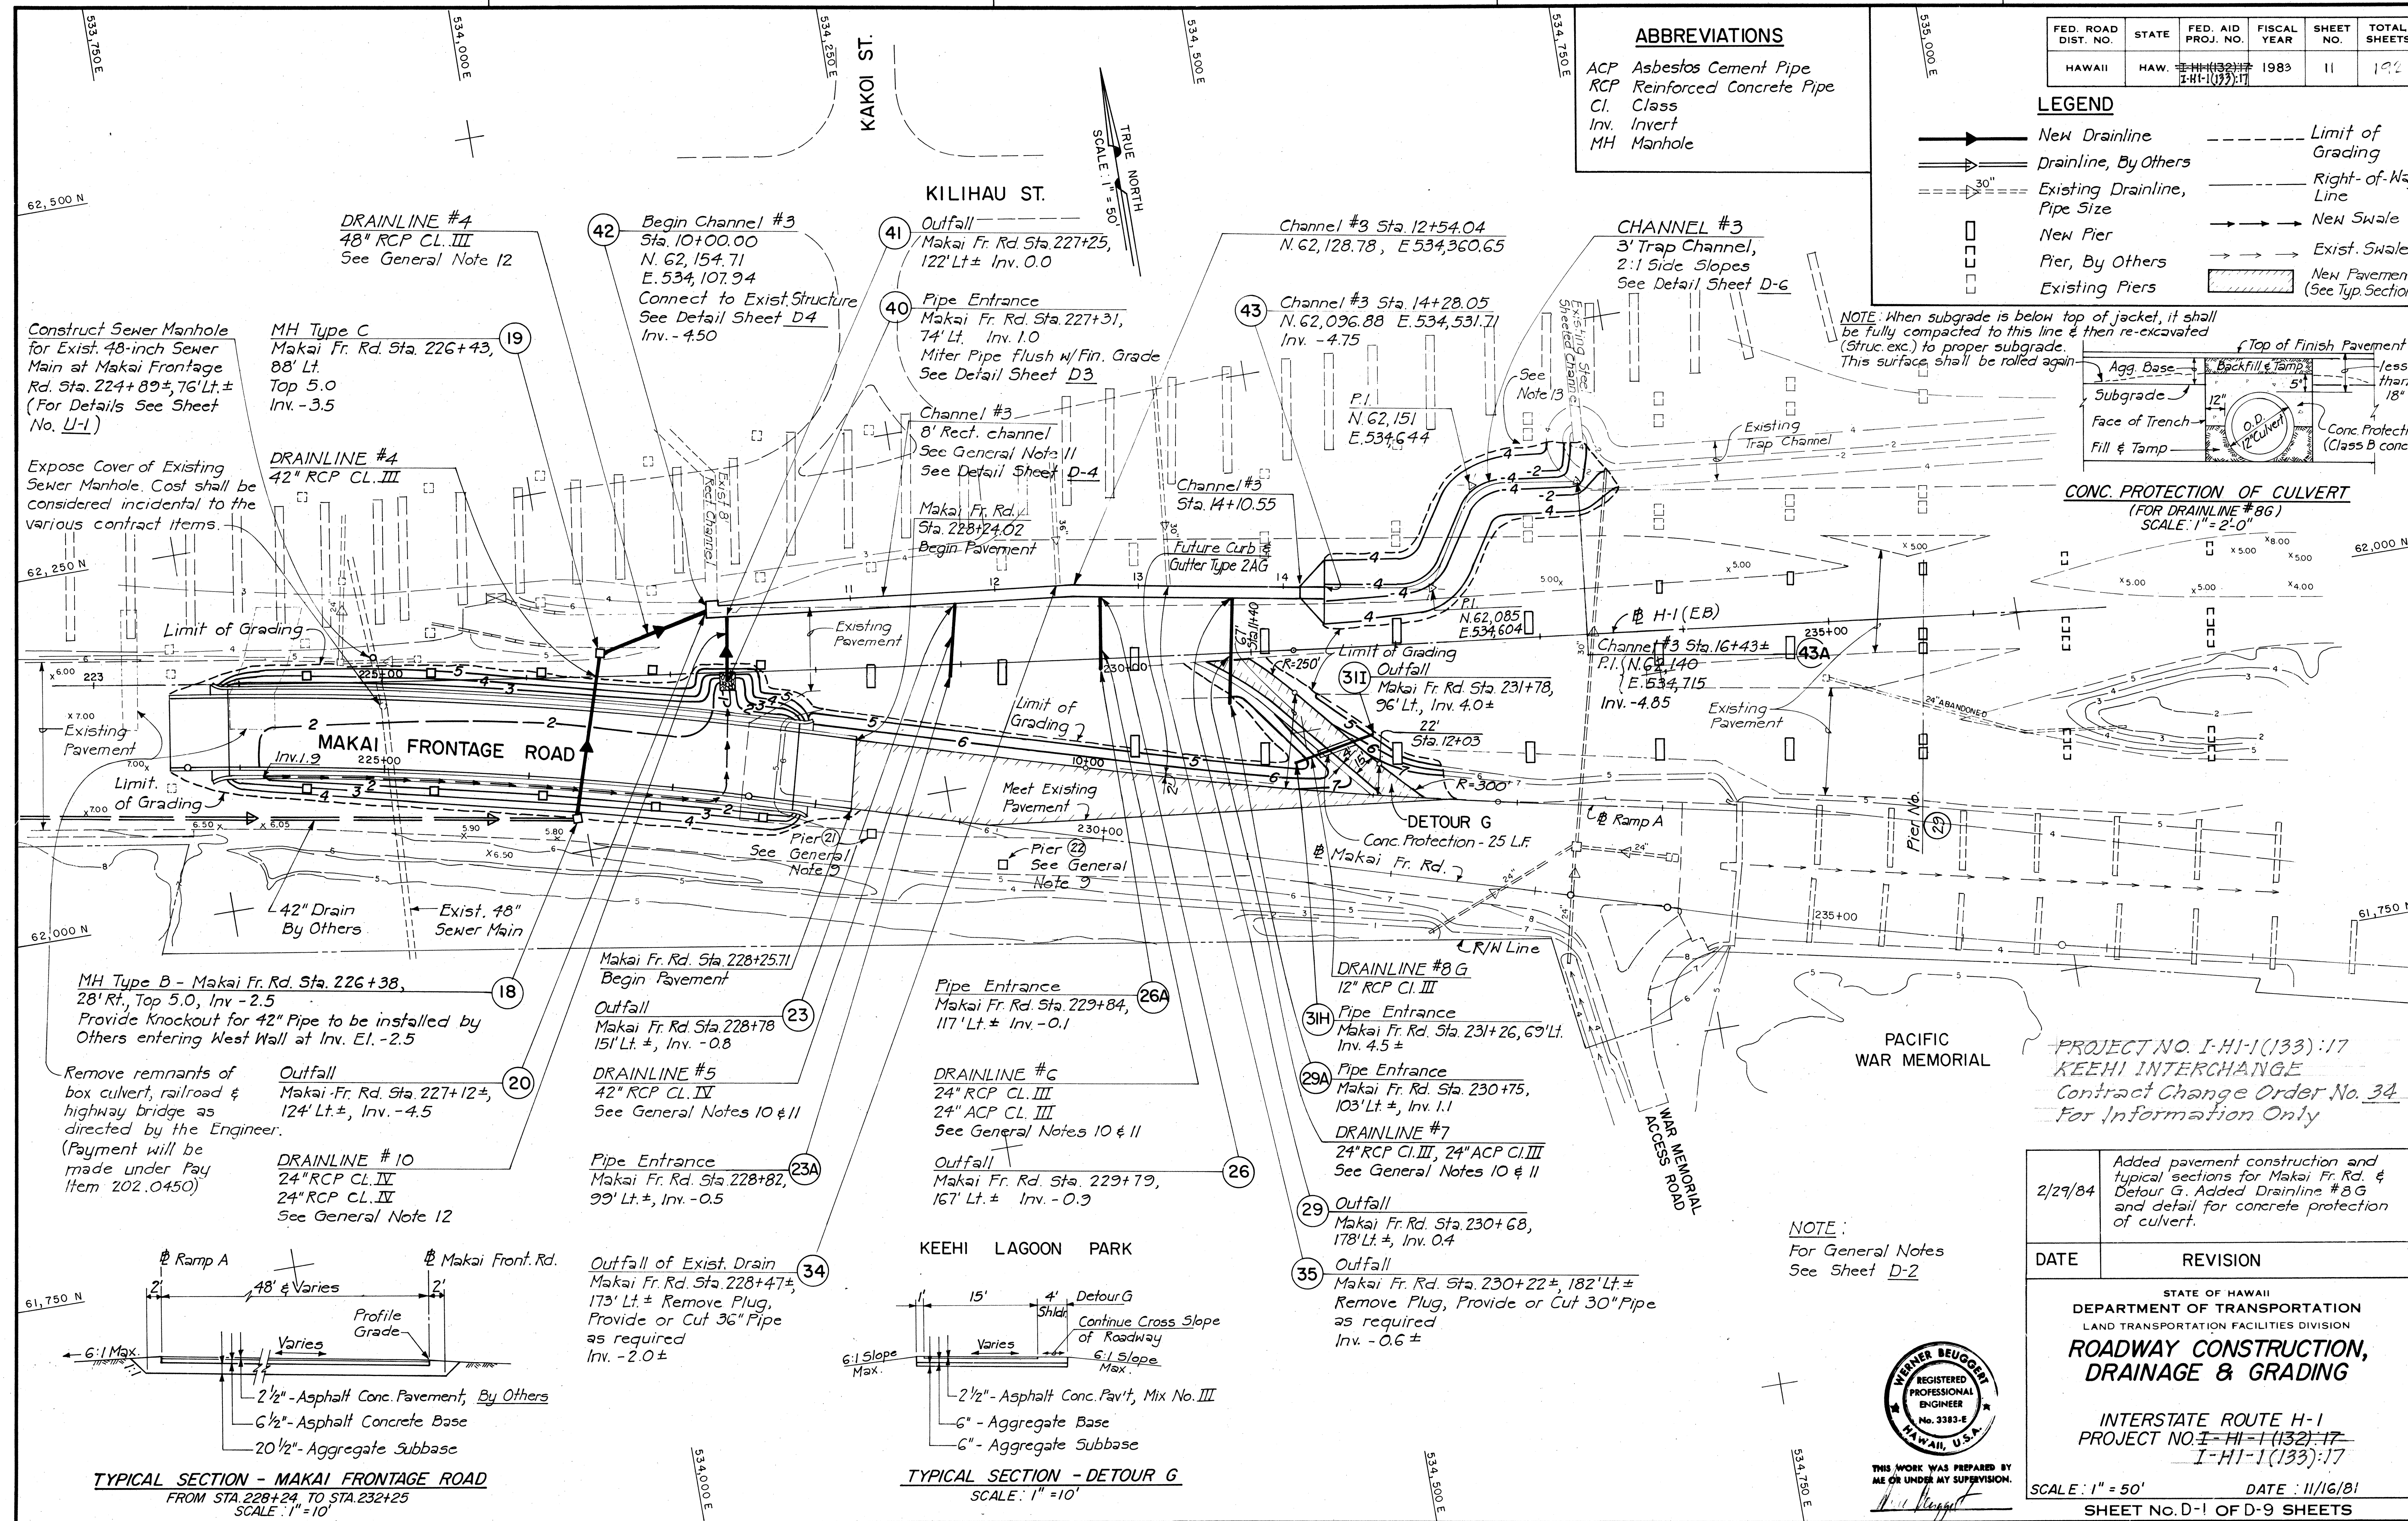

SURVEY PLOTTED BY	DATE
DRAWN BY	
CHECKED BY	
DESIGNED BY	
QUANTITIES BY	
NOTE BOOK	
CHECKED BY	
ORIGINAL PLAN	
NO.	

TYPICAL SECTION - MAKAI FRONTAGE ROAD
FROM STA. 228+24 TO STA. 232+25
SCALE: 1" = 10'

TYPICAL SECTION - DETOUR G
SCALE: 1" = 10'