

FED. ROAD DIST. NO.	STATE	FED. AID PROJ. NO.	FISCAL YEAR	SHEET NO.	TOTAL SHEETS
HAWAII	HAW.	I-HI-1(133):17	1981	7	159

SUPERELEVATION DIAGRAM-MAKAI FRONTAGE ROAD

Scale: Horiz. 1"=50'
Vert. 1"=0.05 ft/ft

PROFILE-MAKAI FRONTAGE ROAD

Scale: Horiz. 1"=50'
Vert. 1"=10'

SUPERELEVATION DIAGRAM-MAKAI FRONTAGE ROAD


Scale: Horiz. 1"=50'
Vert. 1"=0.05 ft/ft

PROFILE-MAKAI FRONTAGE ROAD

Scale: Horiz. 1"=50'
Vert. 1"=10'

GENERAL NOTE FOR PROFILES:

- Existing ground lines are not up-to-date. See Drainage & Grading Plans for ground surface.
- Finish Pavement of at Grade Roadways for this Contract is lower than shown (See Typical Sections).

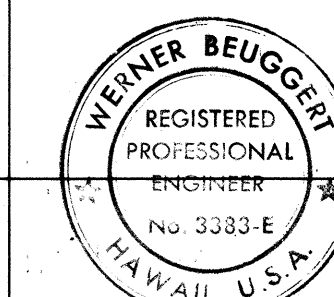

THIS WORK WAS PREPARED BY
ME OR UNDER MY SUPERVISION



Werner Beugert

STATE OF HAWAII
DEPARTMENT OF TRANSPORTATION
HIGHWAYS DIVISION
**ROADWAY PROFILE AND
SUPERELEVATION DIAGRAM**

INTERSTATE ROUTE H-1
PROJECT NO. I-HI-1(133):17
SCALE: AS SHOWN DATE: 4/30/81
SHEET No. A-4 OF A-8 SHEETS

Checked by 4 ✓

FED. ROAD DIST. NO.	STATE	FED. AID PROJ. NO.	FISCAL YEAR	SHEET NO.	TOTAL SHEETS
HAWAII	HAW.	I-HI-1(133):17	1981	8	159

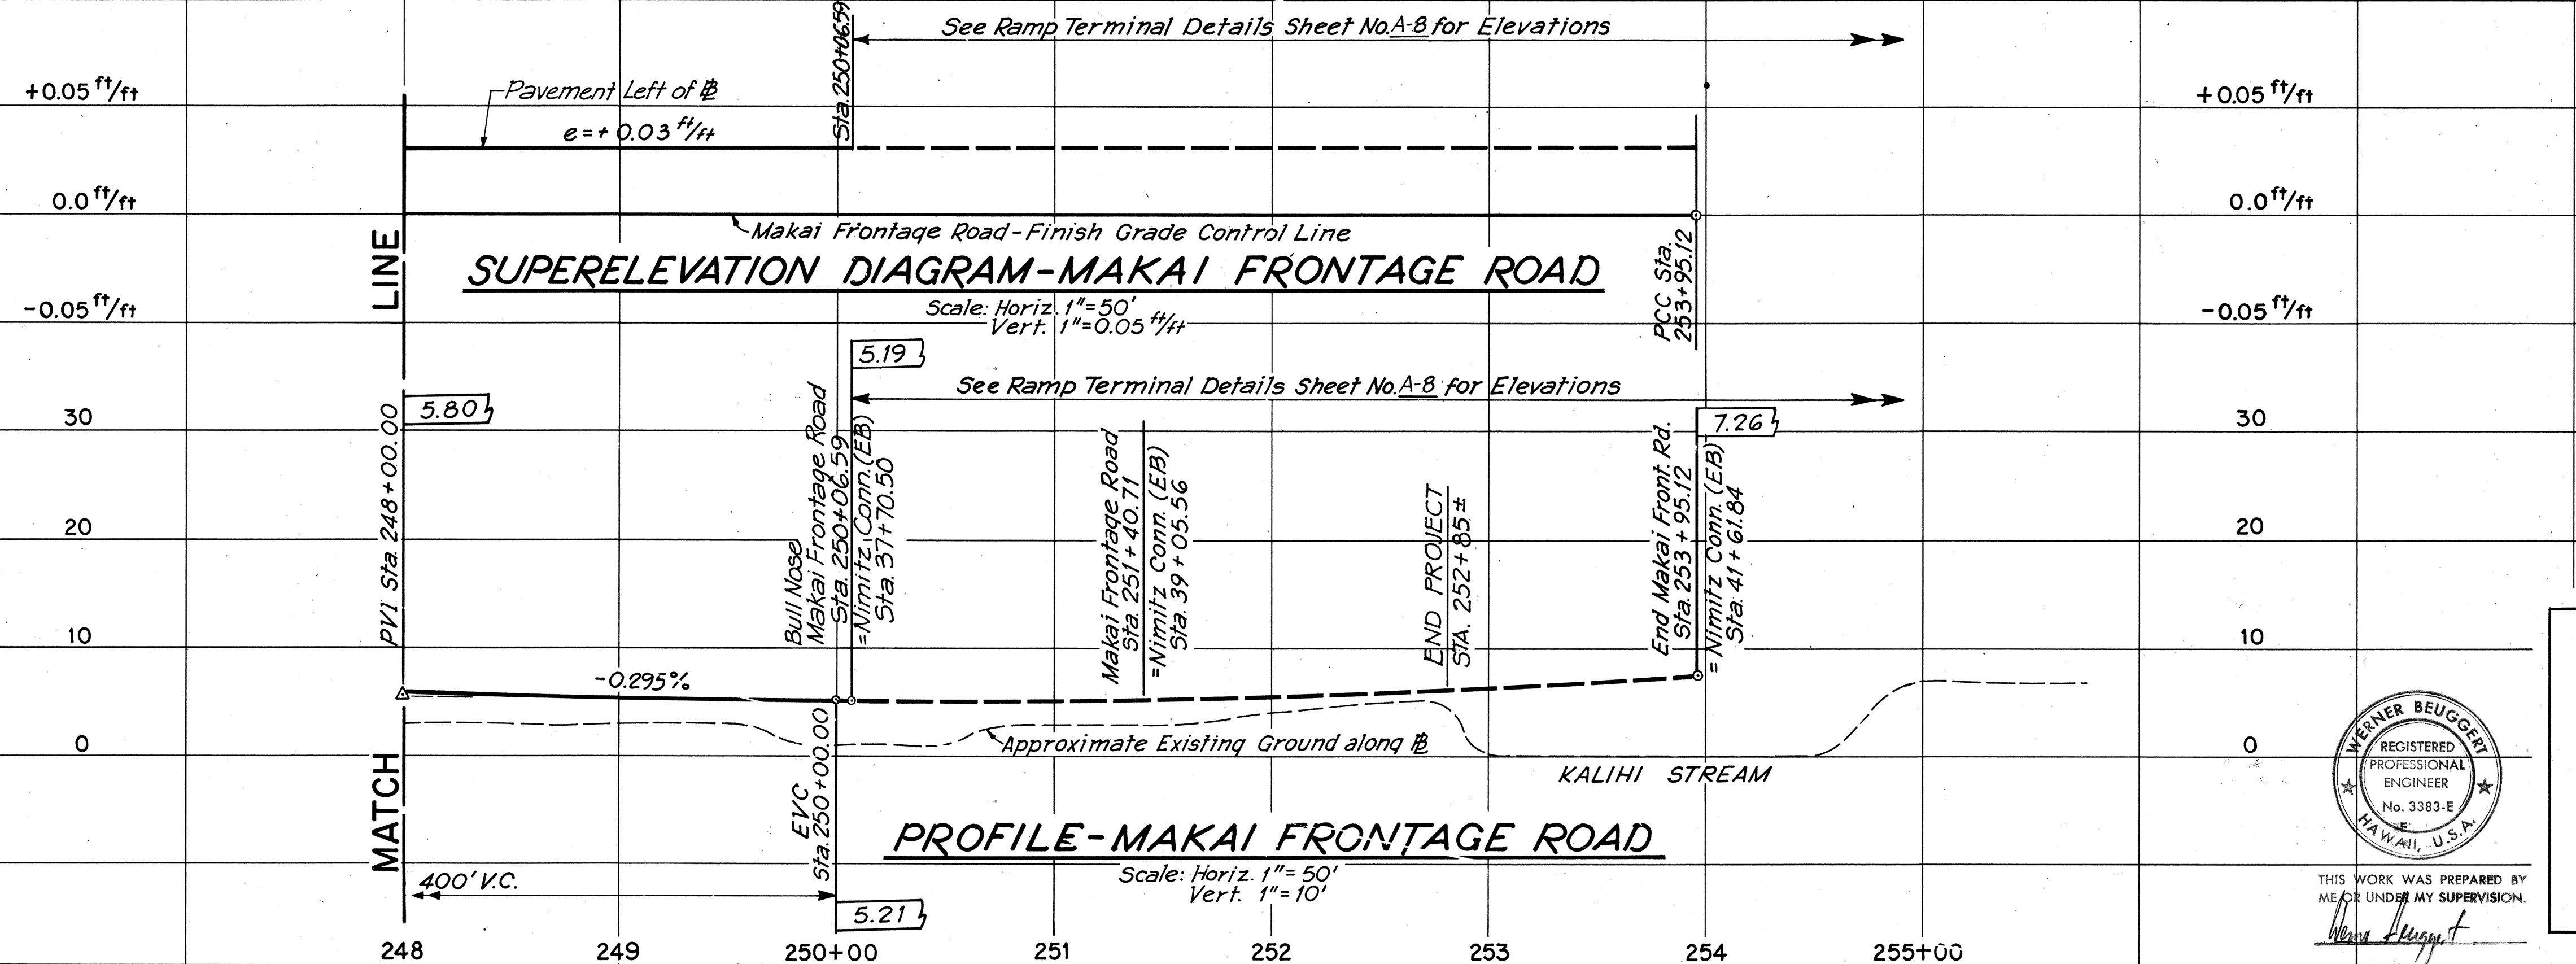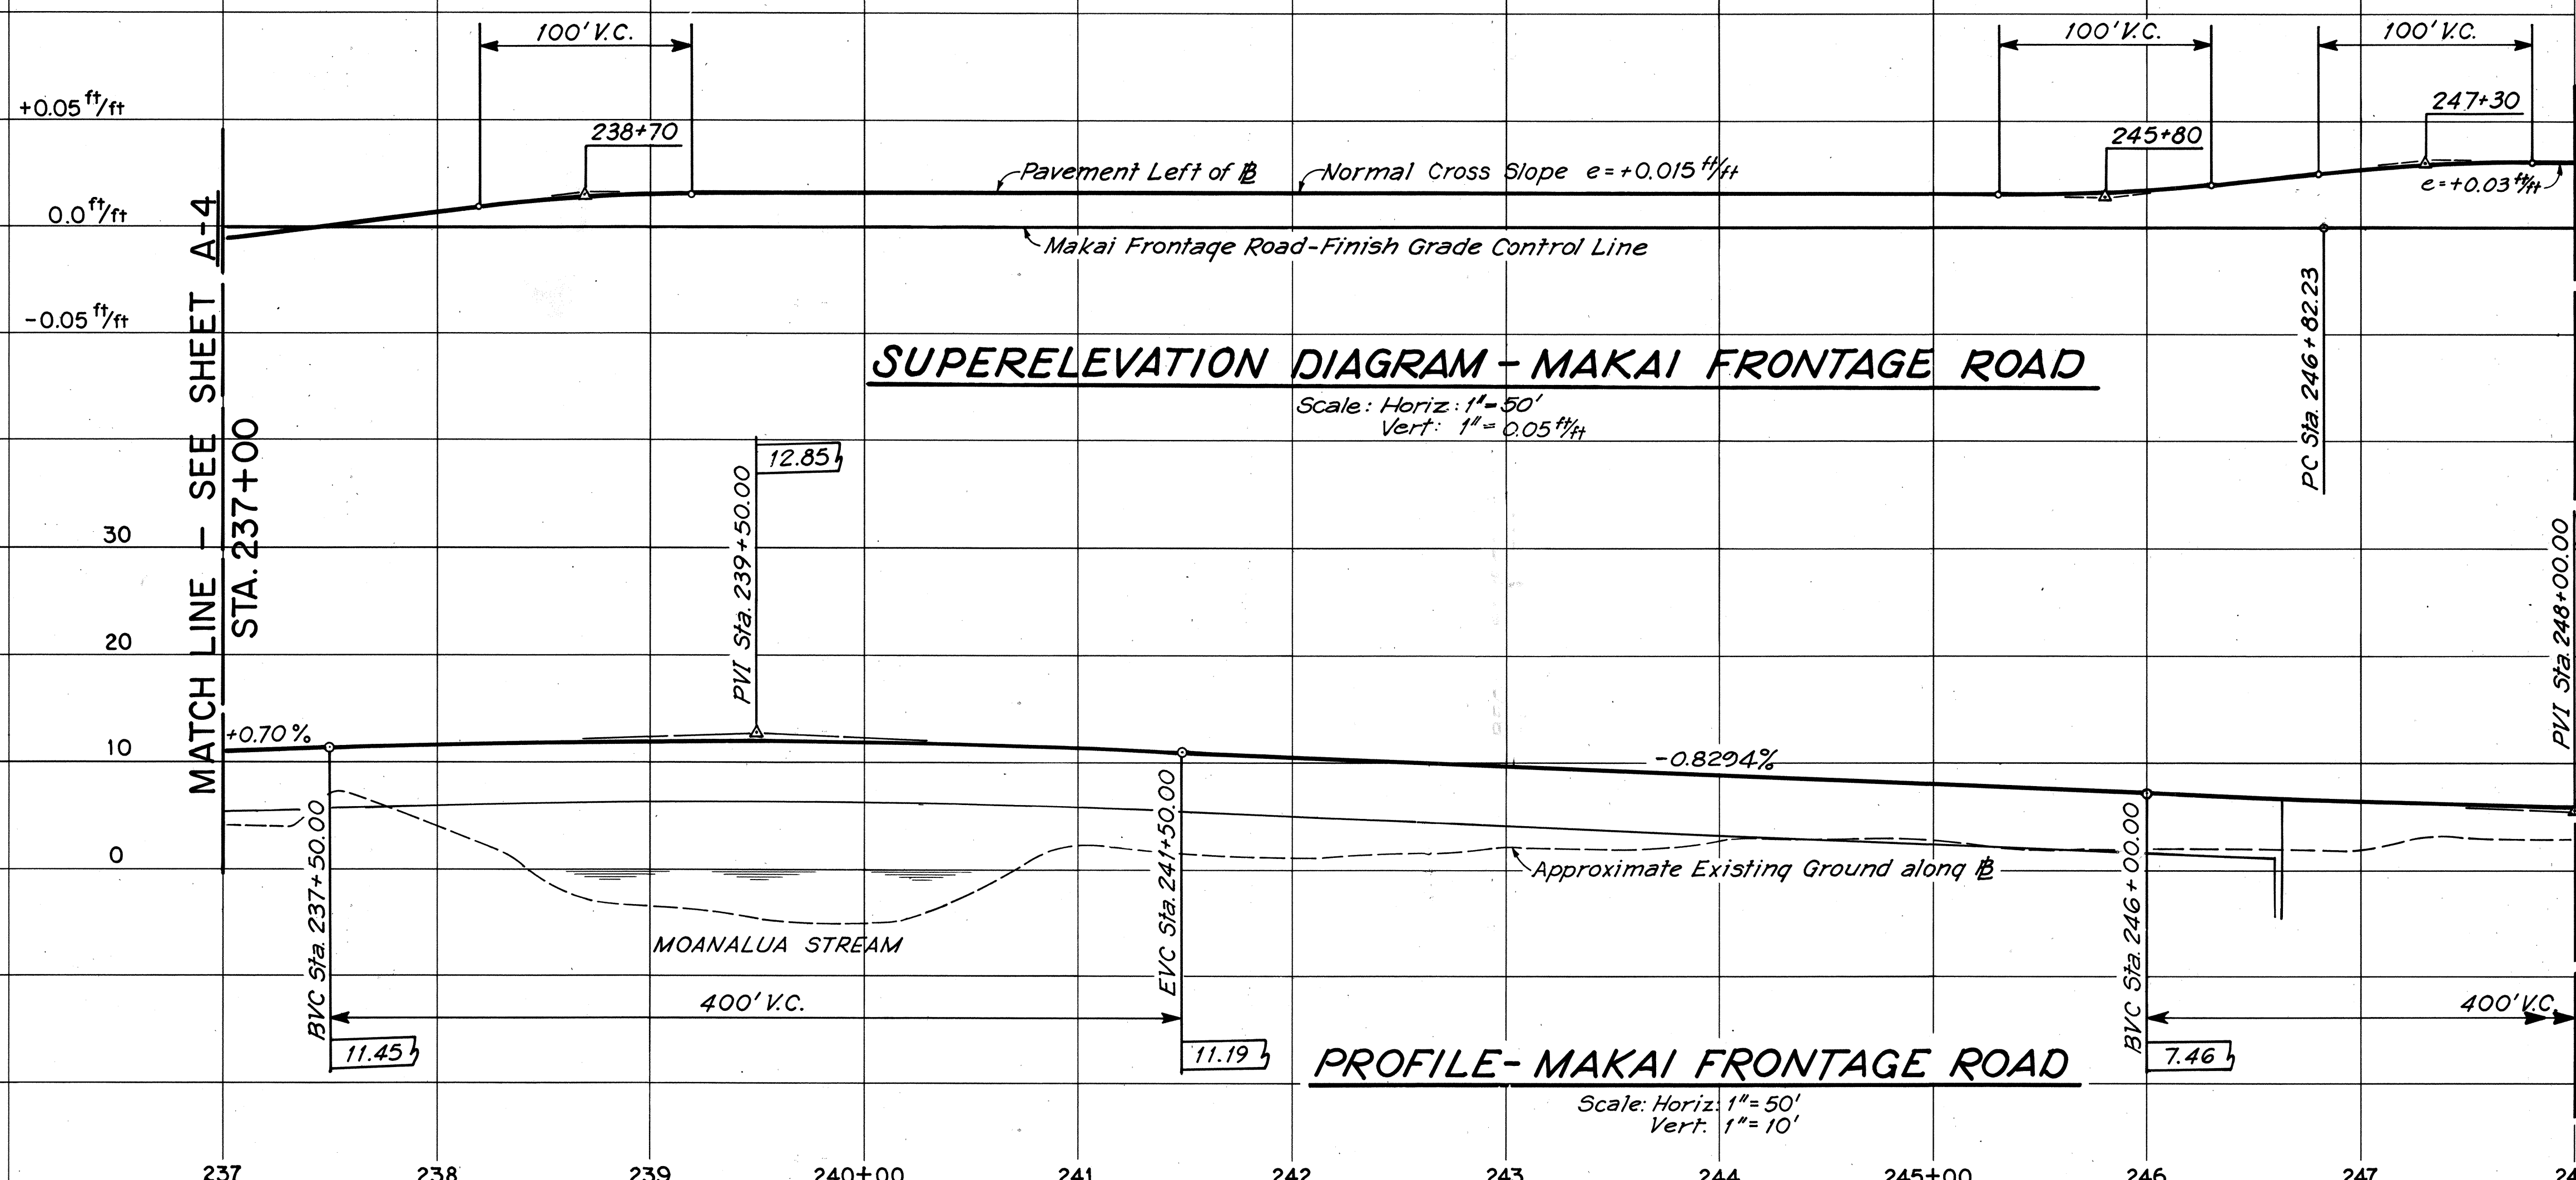

NOTE:
See Sheet A-4 for General Notes

WERNER BEUGGER
 REGISTERED PROFESSIONAL ENGINEER
 No. 3383-E
 HAWAII, U.S.A.

THIS WORK WAS PREPARED BY ME OR UNDER MY SUPERVISION.



STATE OF HAWAII
 DEPARTMENT OF TRANSPORTATION
 HIGHWAYS DIVISION

ROADWAY PROFILE AND SUPERELEVATION DIAGRAM


INTERSTATE ROUTE H-1
 PROJECT NO. I-HI-1(133):17
 SCALE: AS SHOWN DATE: 4/30/81
 SHEET No. A-5 OF A-8 SHEETS

ORIGINAL PLAN	DATE
DRAWN BY	
DESIGNED BY	
QUANTITIES BY	
CHECKED BY	

FED. ROAD DIST. NO.	STATE	FED. AID PROJ. NO.	FISCAL YEAR	SHEET NO.	TOTAL SHEETS
HAWAII	HAW.	I-HI-1(133):17	1981	9	159

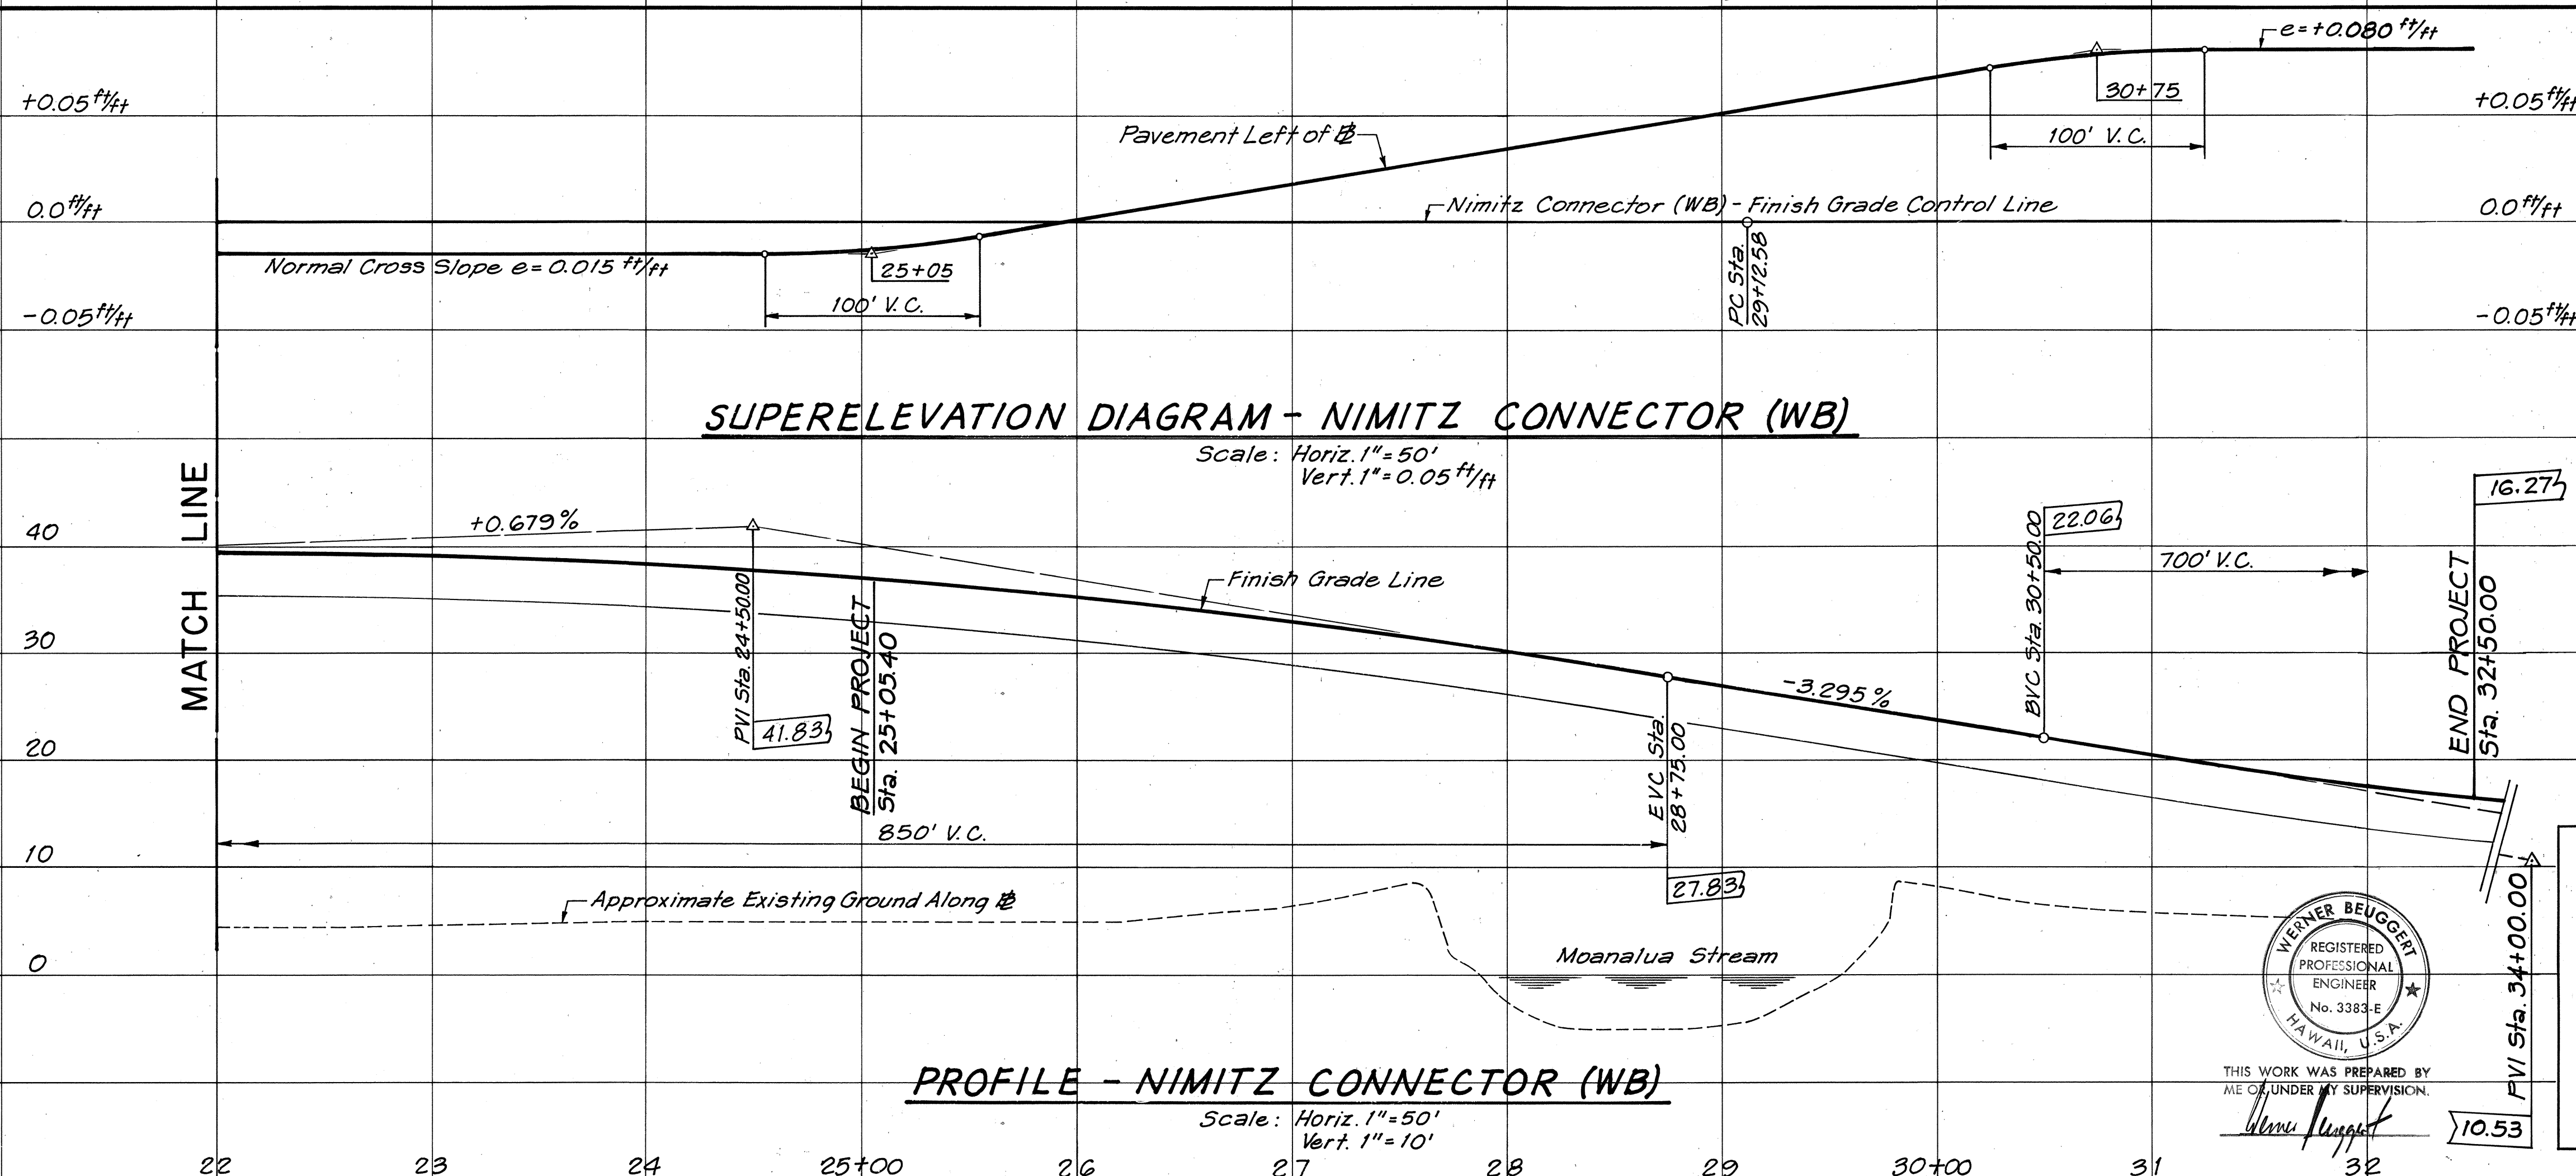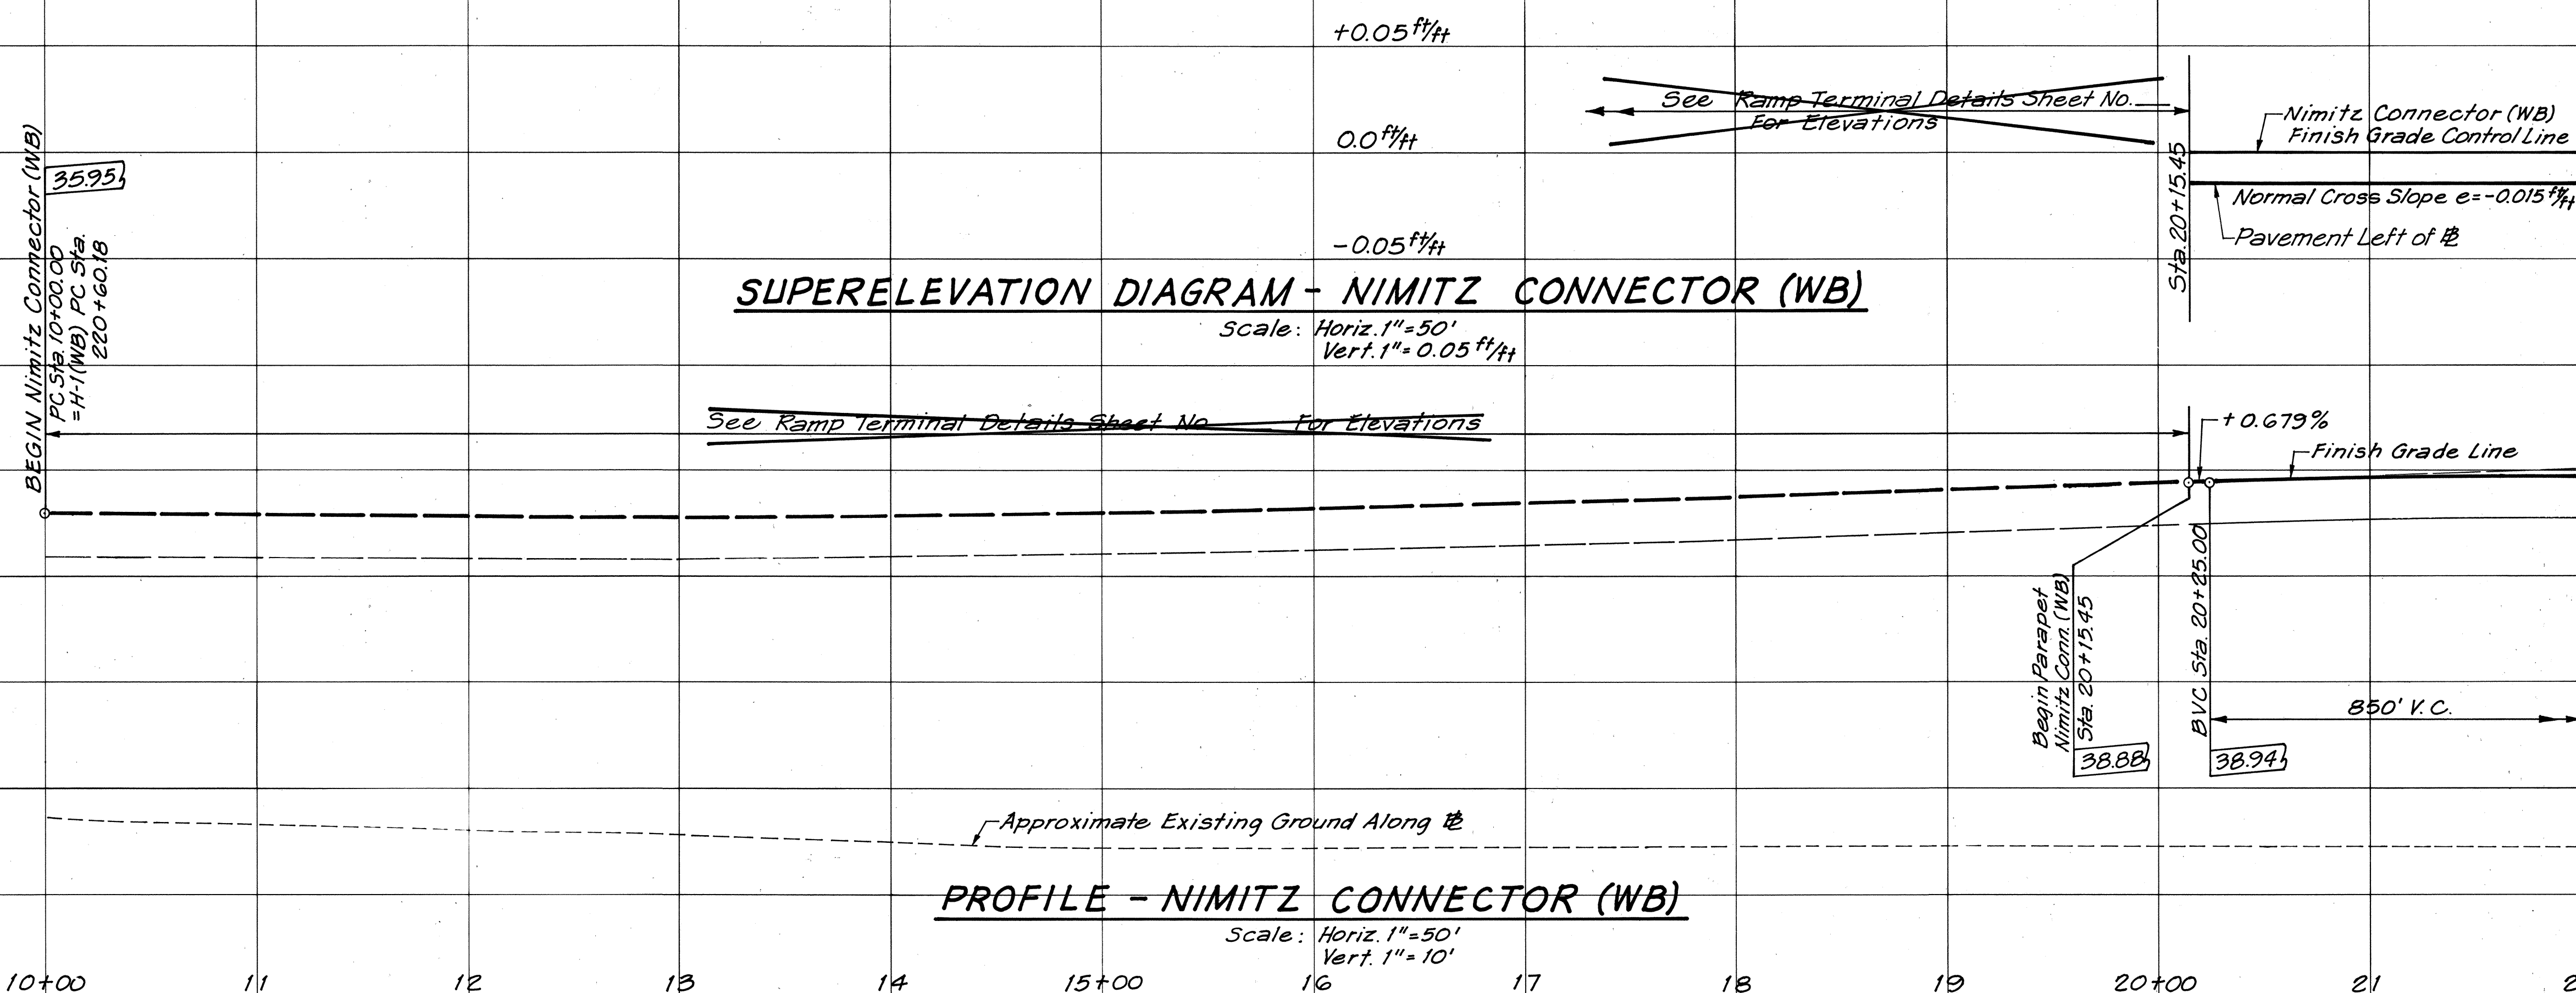

NOTE:
See Sheet A-4 for General Notes

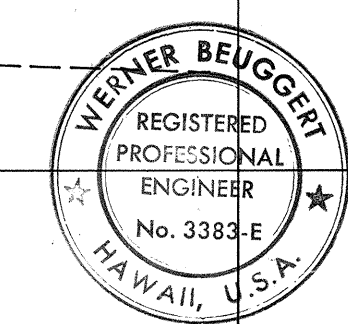

THIS WORK WAS PREPARED BY
ME OR UNDER MY SUPERVISION.

STATE OF HAWAII
DEPARTMENT OF TRANSPORTATION
HIGHWAYS DIVISION

**ROADWAY PROFILE AND
SUPERELEVATION DIAGRAM**

INTERSTATE ROUTE H-1
PROJECT NO. I-HI-1(133):17

SCALE: AS SHOWN DATE: 4/30/81

SHEET No. A-6 OF A-8 SHEETS

ORIGINAL PLAN NOTE BOOK
DATE
SURVEY PLOTTED BY
DESIGNED BY
CHECKED BY