
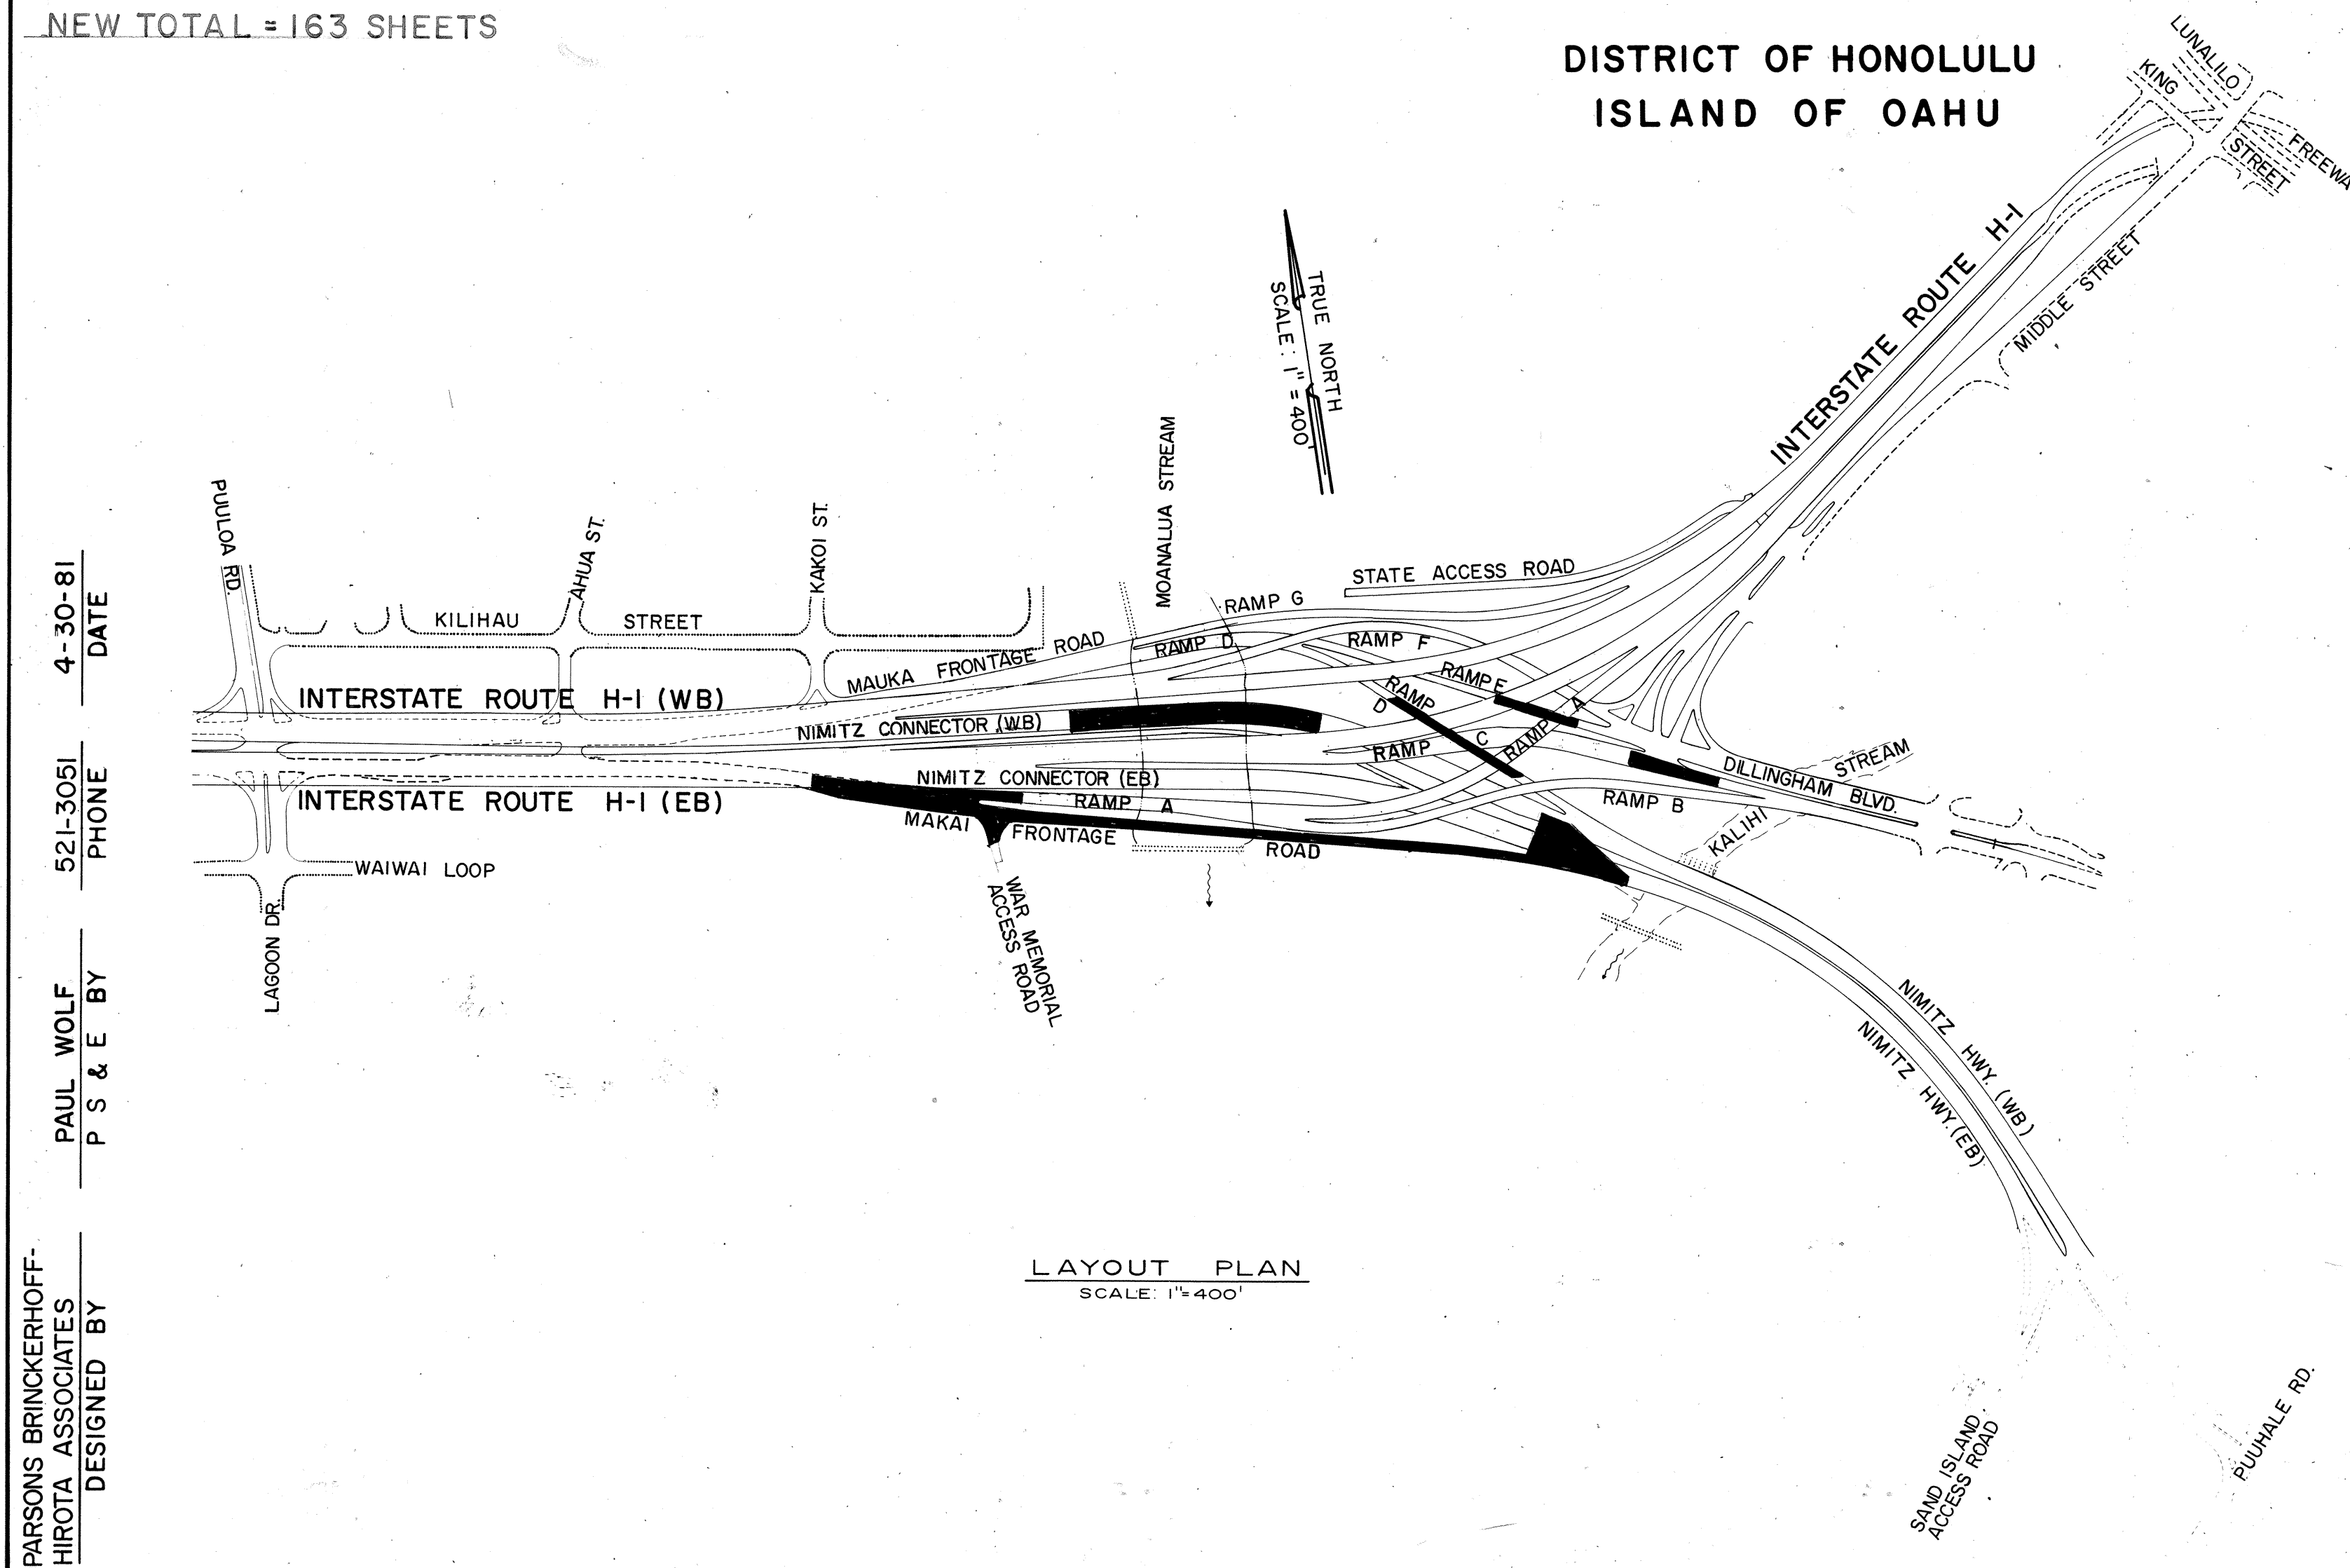


INDEX TO DRAWINGS	
SHEET NO.	DESCRIPTION
1	TITLE SHEET
2	RECOMMENDED CONSTRUCTION PHASING
3	TYPICAL ROADWAY SECTIONS
① 4-6	ALIGNMENT PLANS
7-9	ROADWAY PROFILES AND SUPERELEVATION DIAGRAMS
② 10-11	RAMP TERMINAL AND INTERSECTION DETAILS
12-14	ROADWAY CONSTRUCTION, DRAINAGE & GRADING PLANS
15	DRAINAGE PROFILES
16-19	DRAINAGE DETAILS & SUMMARY SHEET
20-28	STANDARD ROADWAY CONSTRUCTION & DRAINAGE DETAILS
29	EROSION CONTROL NOTES & DETAILS
30-33	SOIL CONSOLIDATION PLANS
③ 34-39	SIGNING & PAVEMENT MARKING PLANS
40-50	SIGNING & PAVEMENT MARKING DETAILS
51-57	HIGHWAY LIGHTING
58-59	EXISTING UTILITIES
60-73	BORING LOCATION PLAN & LOGS
74-90	NIMITZ CONN. (WB) STRUCTURE
91-122	MAKAI FRONTAGE RD. STRUCTURE
123-140	STRUCTURE STANDARD DETAILS
141-159	CROSS SECTIONS

① C.O. 6S-1, ② C.O. 11S-1,
③ C.O. 39S-1, C.O. 39S-2,
ARE SUPPLEMENT SHEETS
TO THE CONTRACT PLANS.
NEW TOTAL = 163 SHEETS

STATE OF HAWAII
DEPARTMENT OF TRANSPORTATION
HIGHWAYS DIVISION
HONOLULU, HAWAII
"AS BUILT"
PLANS FOR
CONSTRUCTION OF A PORTION OF
INTERSTATE ROUTE H-1
KEEHI INTERCHANGE
FEDERAL AID INTERSTATE PROJECT NO. I-HI-1 (I33):17
DISTRICT OF HONOLULU
ISLAND OF OAHU

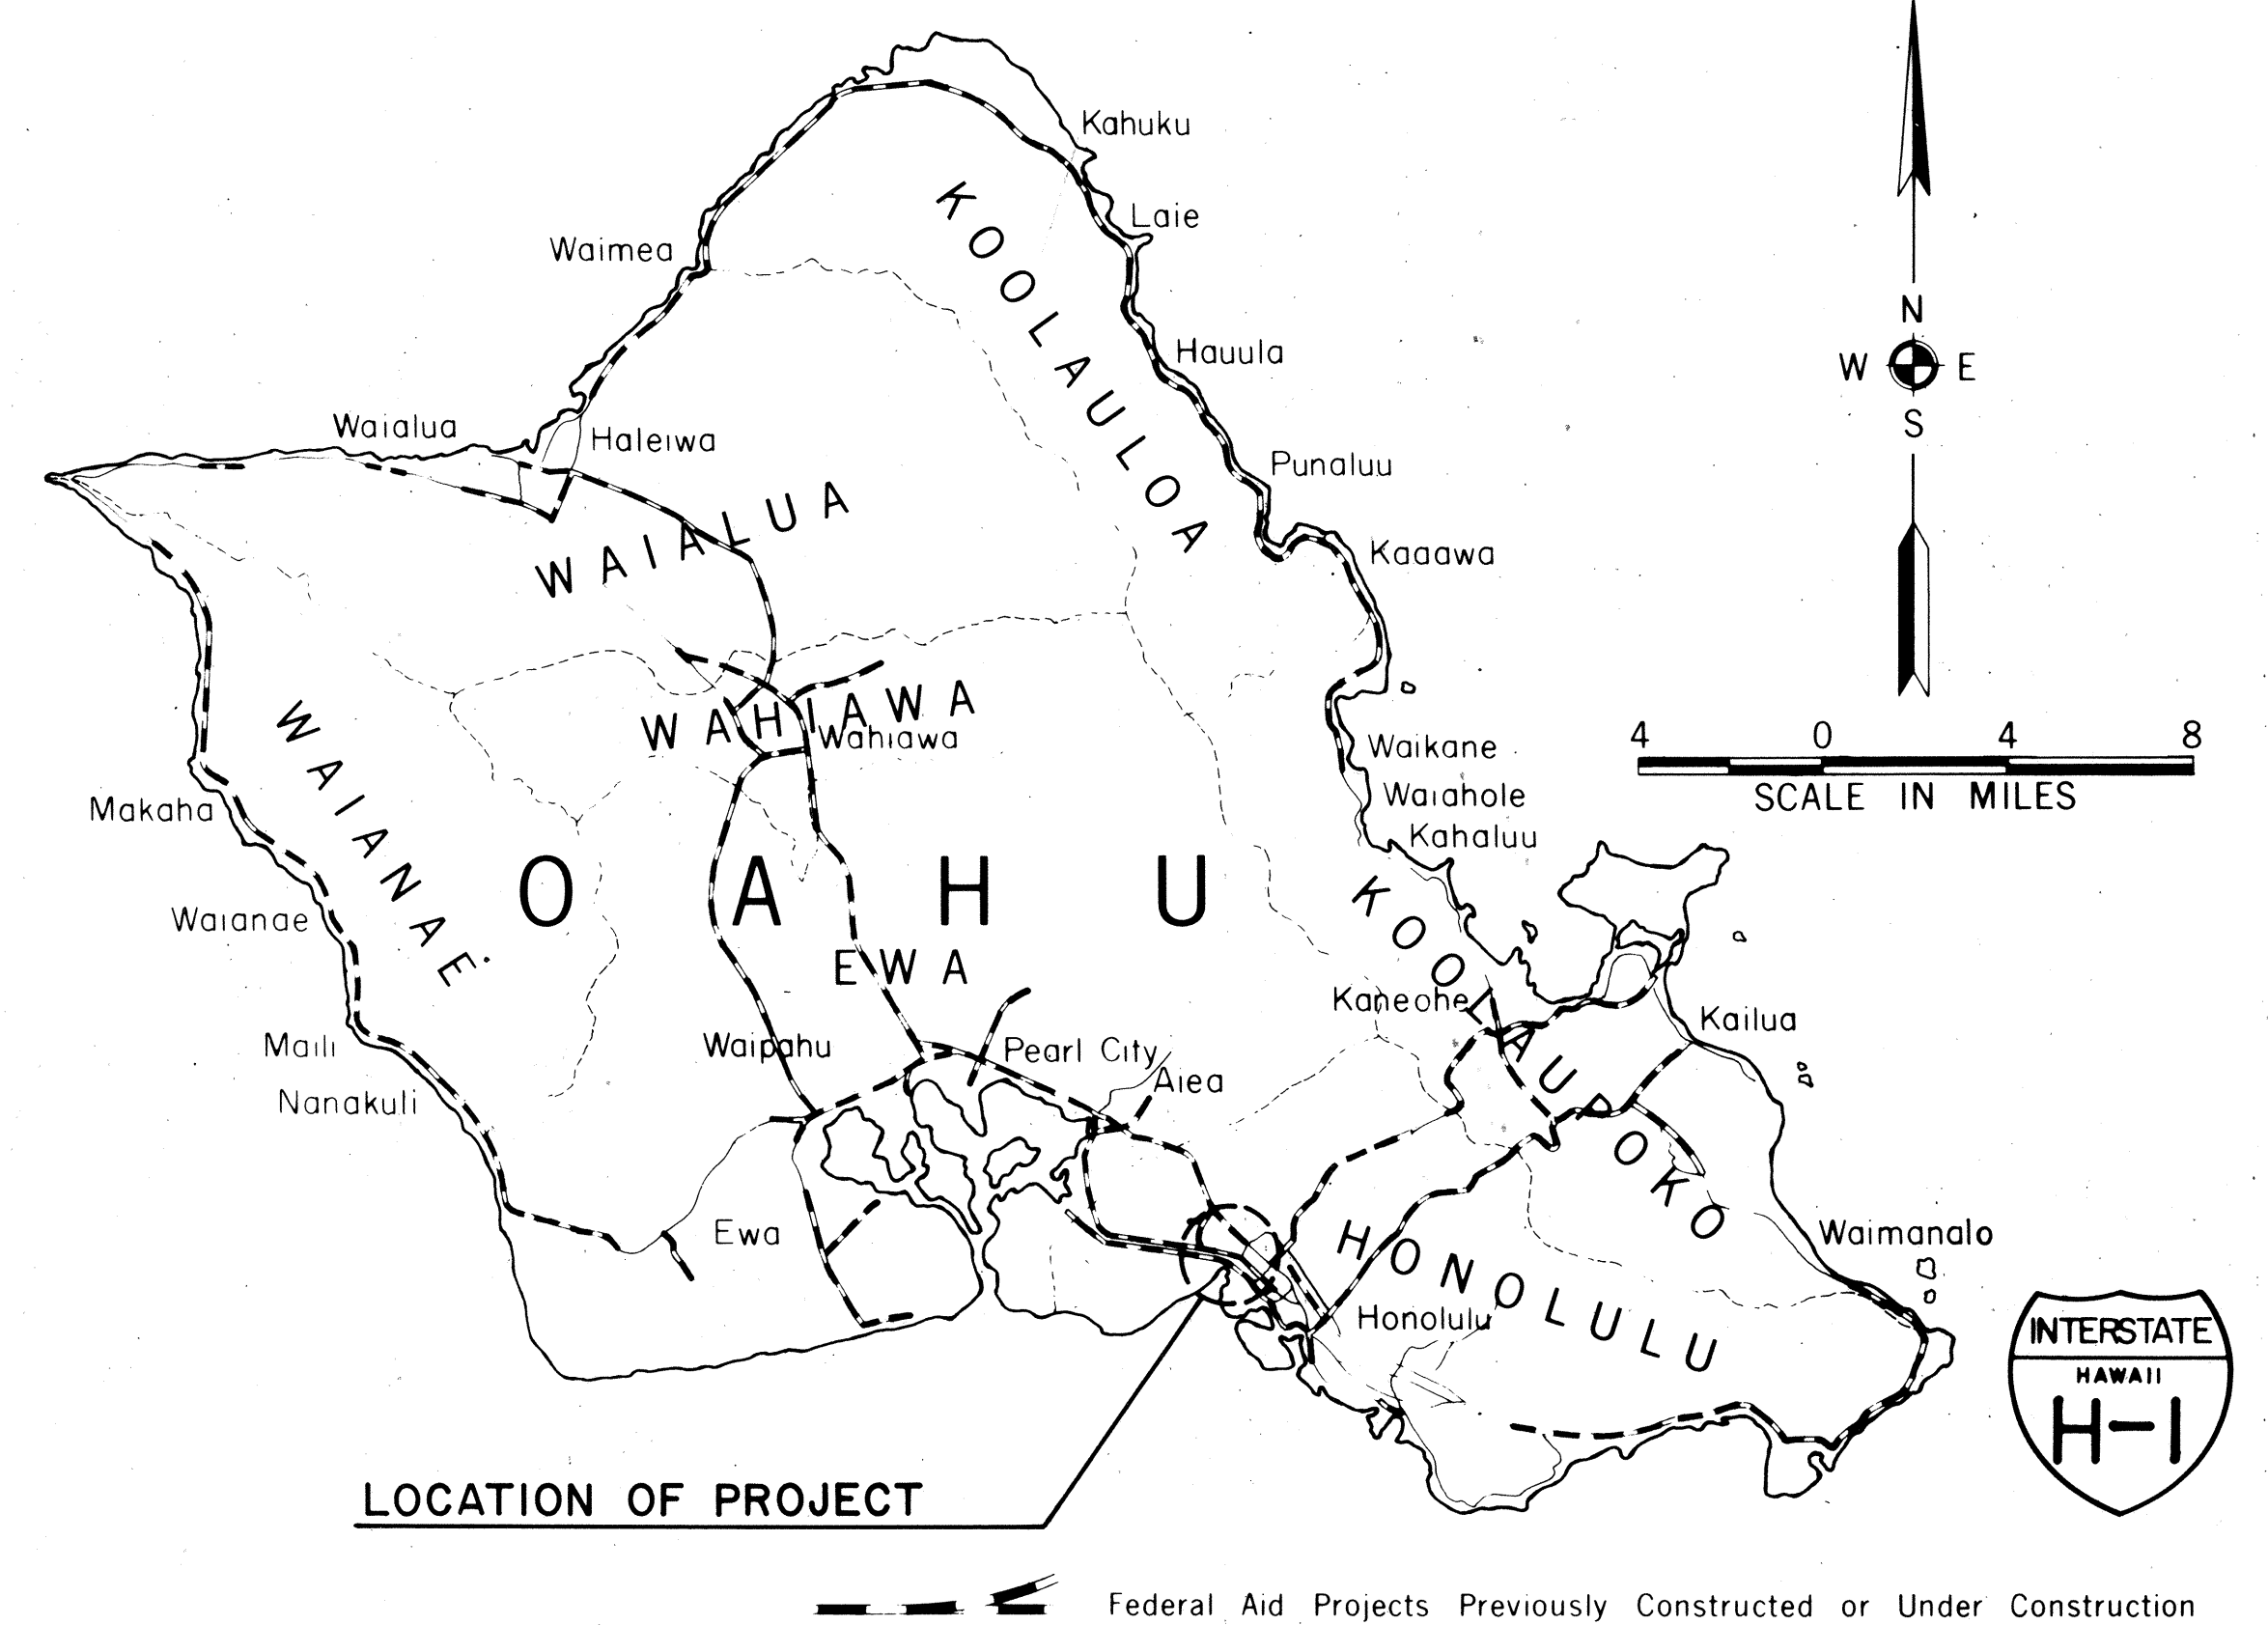

DESIGN CLASSIFICATION

DESIGN ADT (1994)..... 98,000
DHV..... 10,800
D..... 60/40
T..... 5%
V..... 60 MPH

CHANGES MADE DURING CONSTRUCTION HAVE BEEN INCORPORATED ON THESE PLANS EXCEPT CHANGES IN THE ORIGINAL THEORETICAL QUANTITIES. FOR ACTUAL QUANTITIES, REFER TO PROJECT LEDGER AND/OR COMPUTATION BOOK.

David R. Winkler
Acting RESIDENT ENGINEER
6/20/84
DATE

DEPARTMENT OF TRANSPORTATION
FEDERAL HIGHWAY ADMINISTRATION
APPROVED:
[Signature]
DIVISION ADMINISTRATOR
7-16-81
DATE

DEPARTMENT OF TRANSPORTATION
STATE OF HAWAII
APPROVED:
James R. Carras
DIR. OF TRANSPORTATION
7/5/81
DATE