
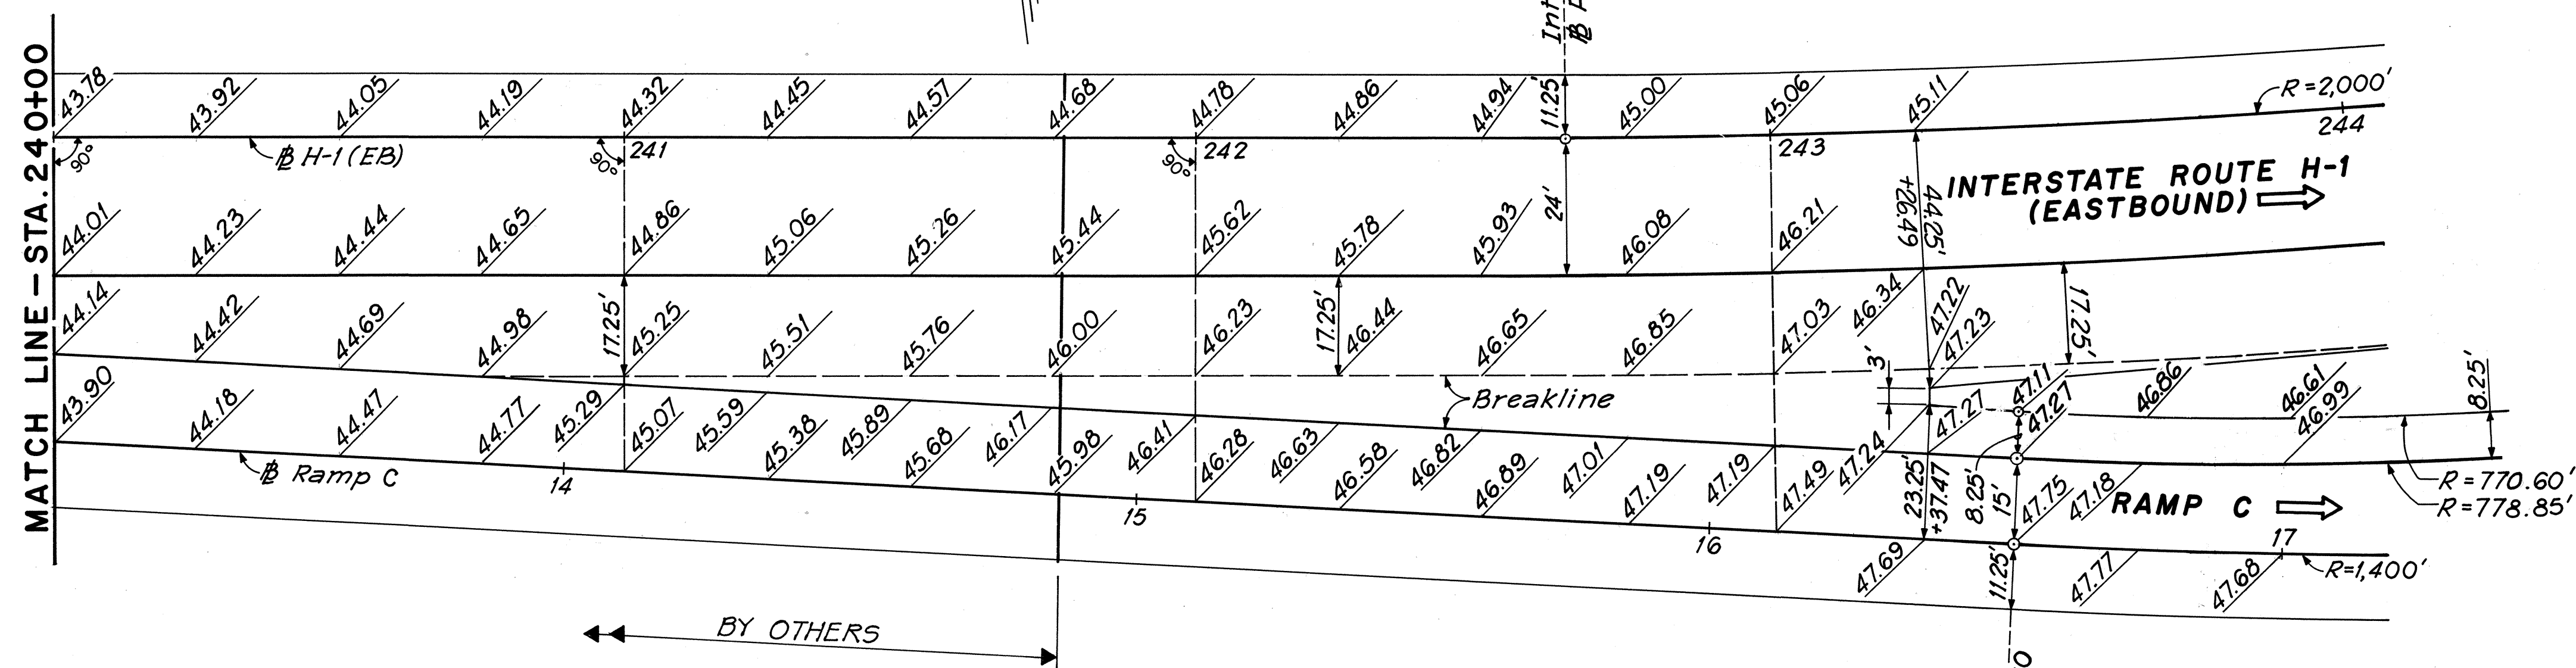


FED. ROAD DIST. NO.	STATE	FED. AID PROJ. NO.	FISCAL YEAR	SHEET NO.	TOTAL SHEETS
HAWAII	HAW.	I-HI-1(86)17	1981	7	207


LEGEND

44.32' Finish Deck Elevation

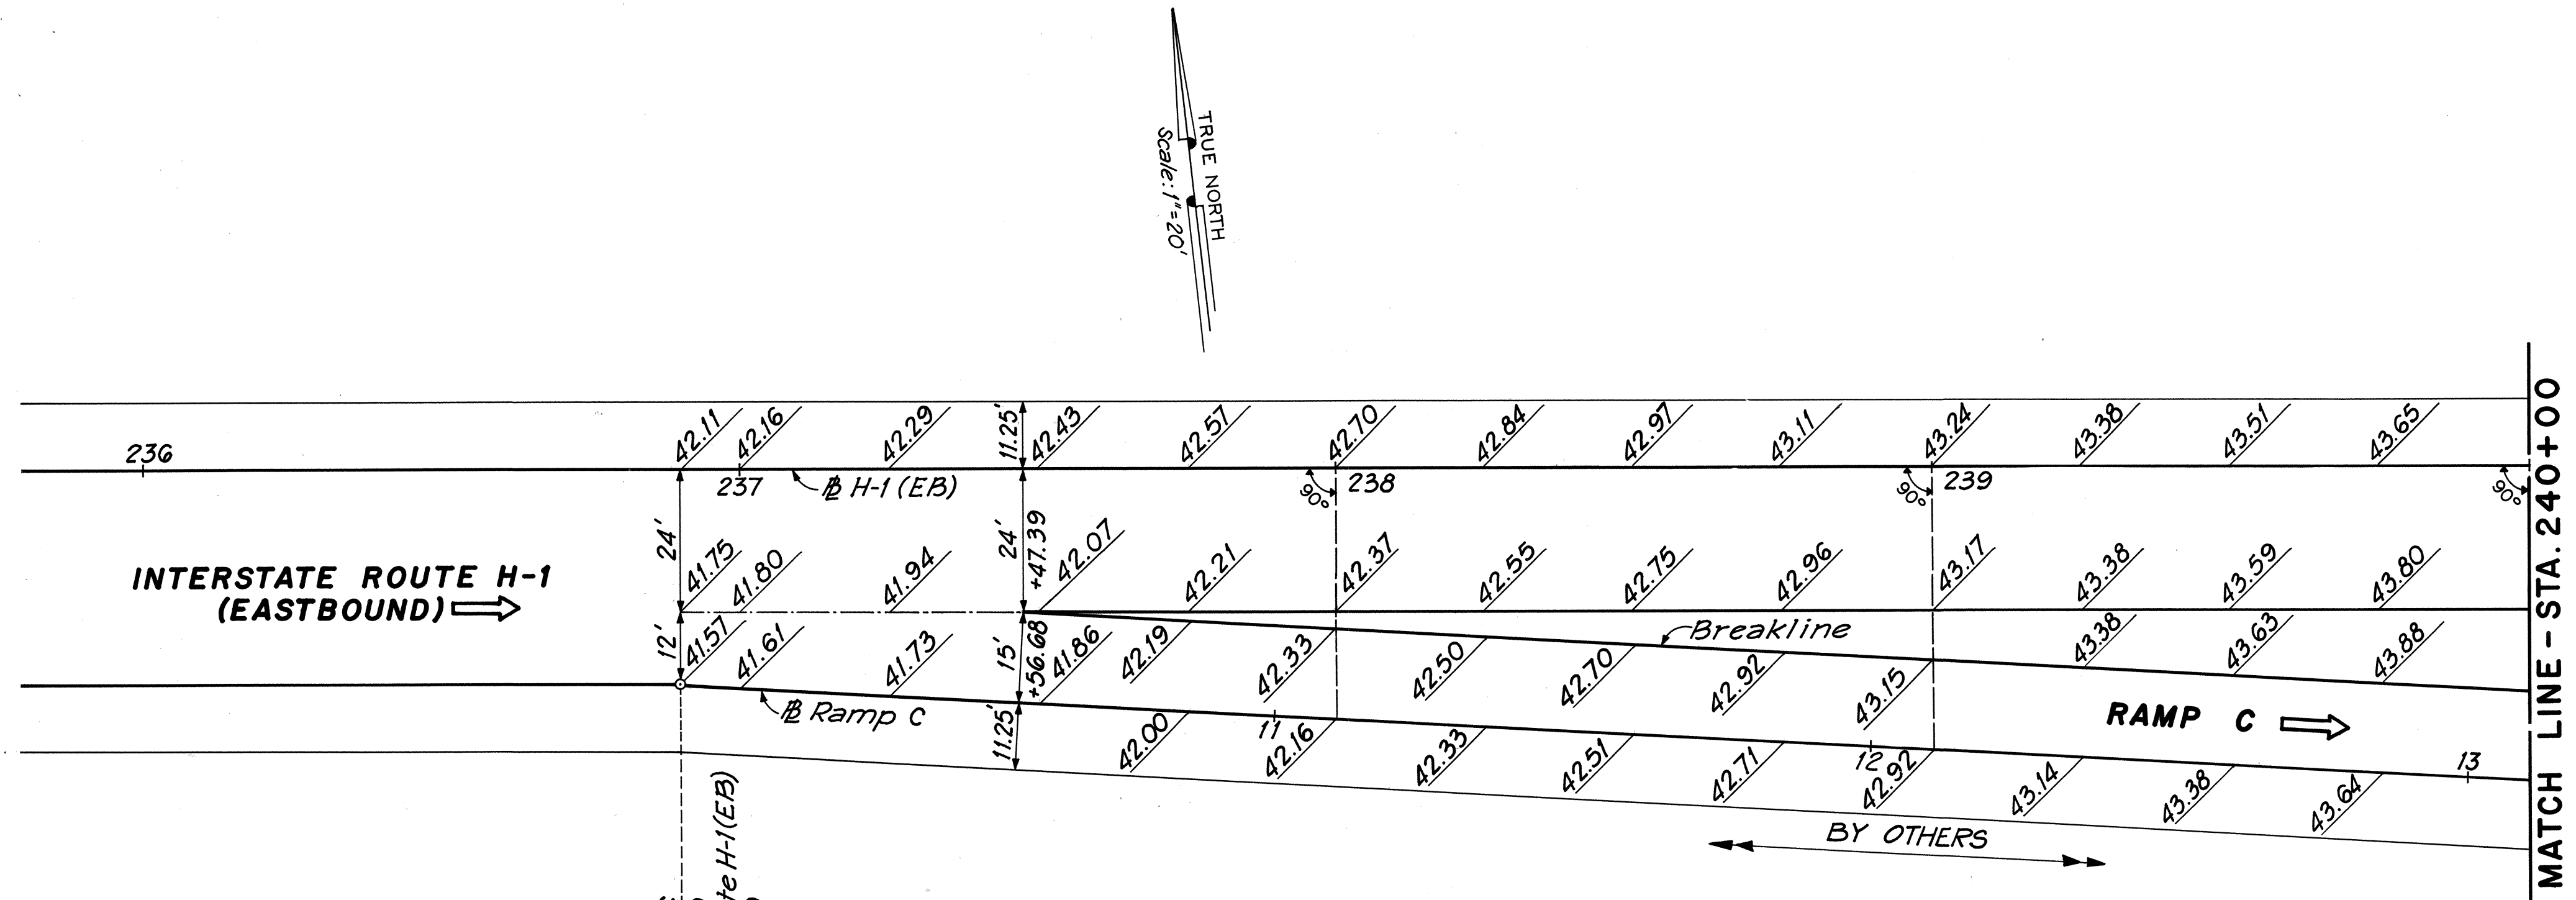

RAMP C & INTERSTATE ROUTE H-1 (EB)

SCALE: 1" = 20'

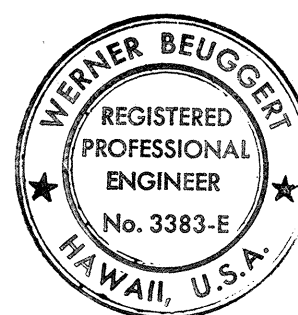

THIS WORK WAS PREPARED BY ME OR UNDER MY SUPERVISION.

Werner Beigger

STATE OF HAWAII
DEPARTMENT OF TRANSPORTATION
HIGHWAYS DIVISION

RAMP TERMINAL DETAIL

INTERSTATE ROUTE H-1
PROJECT NO. I-HI-1 (86):17

SCALE: 1" = 20' DATE: 6/15/81

SHEET No. A-4 OF 14 SHEETS

SURVEY PLOTTED BY	DATE
DRAWN BY	
TRACED BY	
NOTED BY	
CHECKED BY	
ORIGINAL PLAN	
NOTE BOOK	
No.	



ORIGINAL PLAN	SURVEY PLOTTED BY _____		DATE _____
	DRAWN BY _____		_____"
	TRACED BY _____		_____"
	DESIGNED BY _____		_____"
	QUANTITIES BY _____		_____"
NOTE BOOK	CHECKED BY _____		_____"
	No. _____		_____"



FED. ROAD DIST. NO.	STATE	FED. AID PROJ. NO.	FISCAL YEAR	SHEET NO.	TOTAL SHEETS
HAWAII	HAW.	I-41-1(86)17	1981	9	207

LEGEND


5.68
Future Finish Grade Elevation
(Finish Grade for this Contract
is 2 1/2" or 2 3/4" lower; see
Typical Sections)

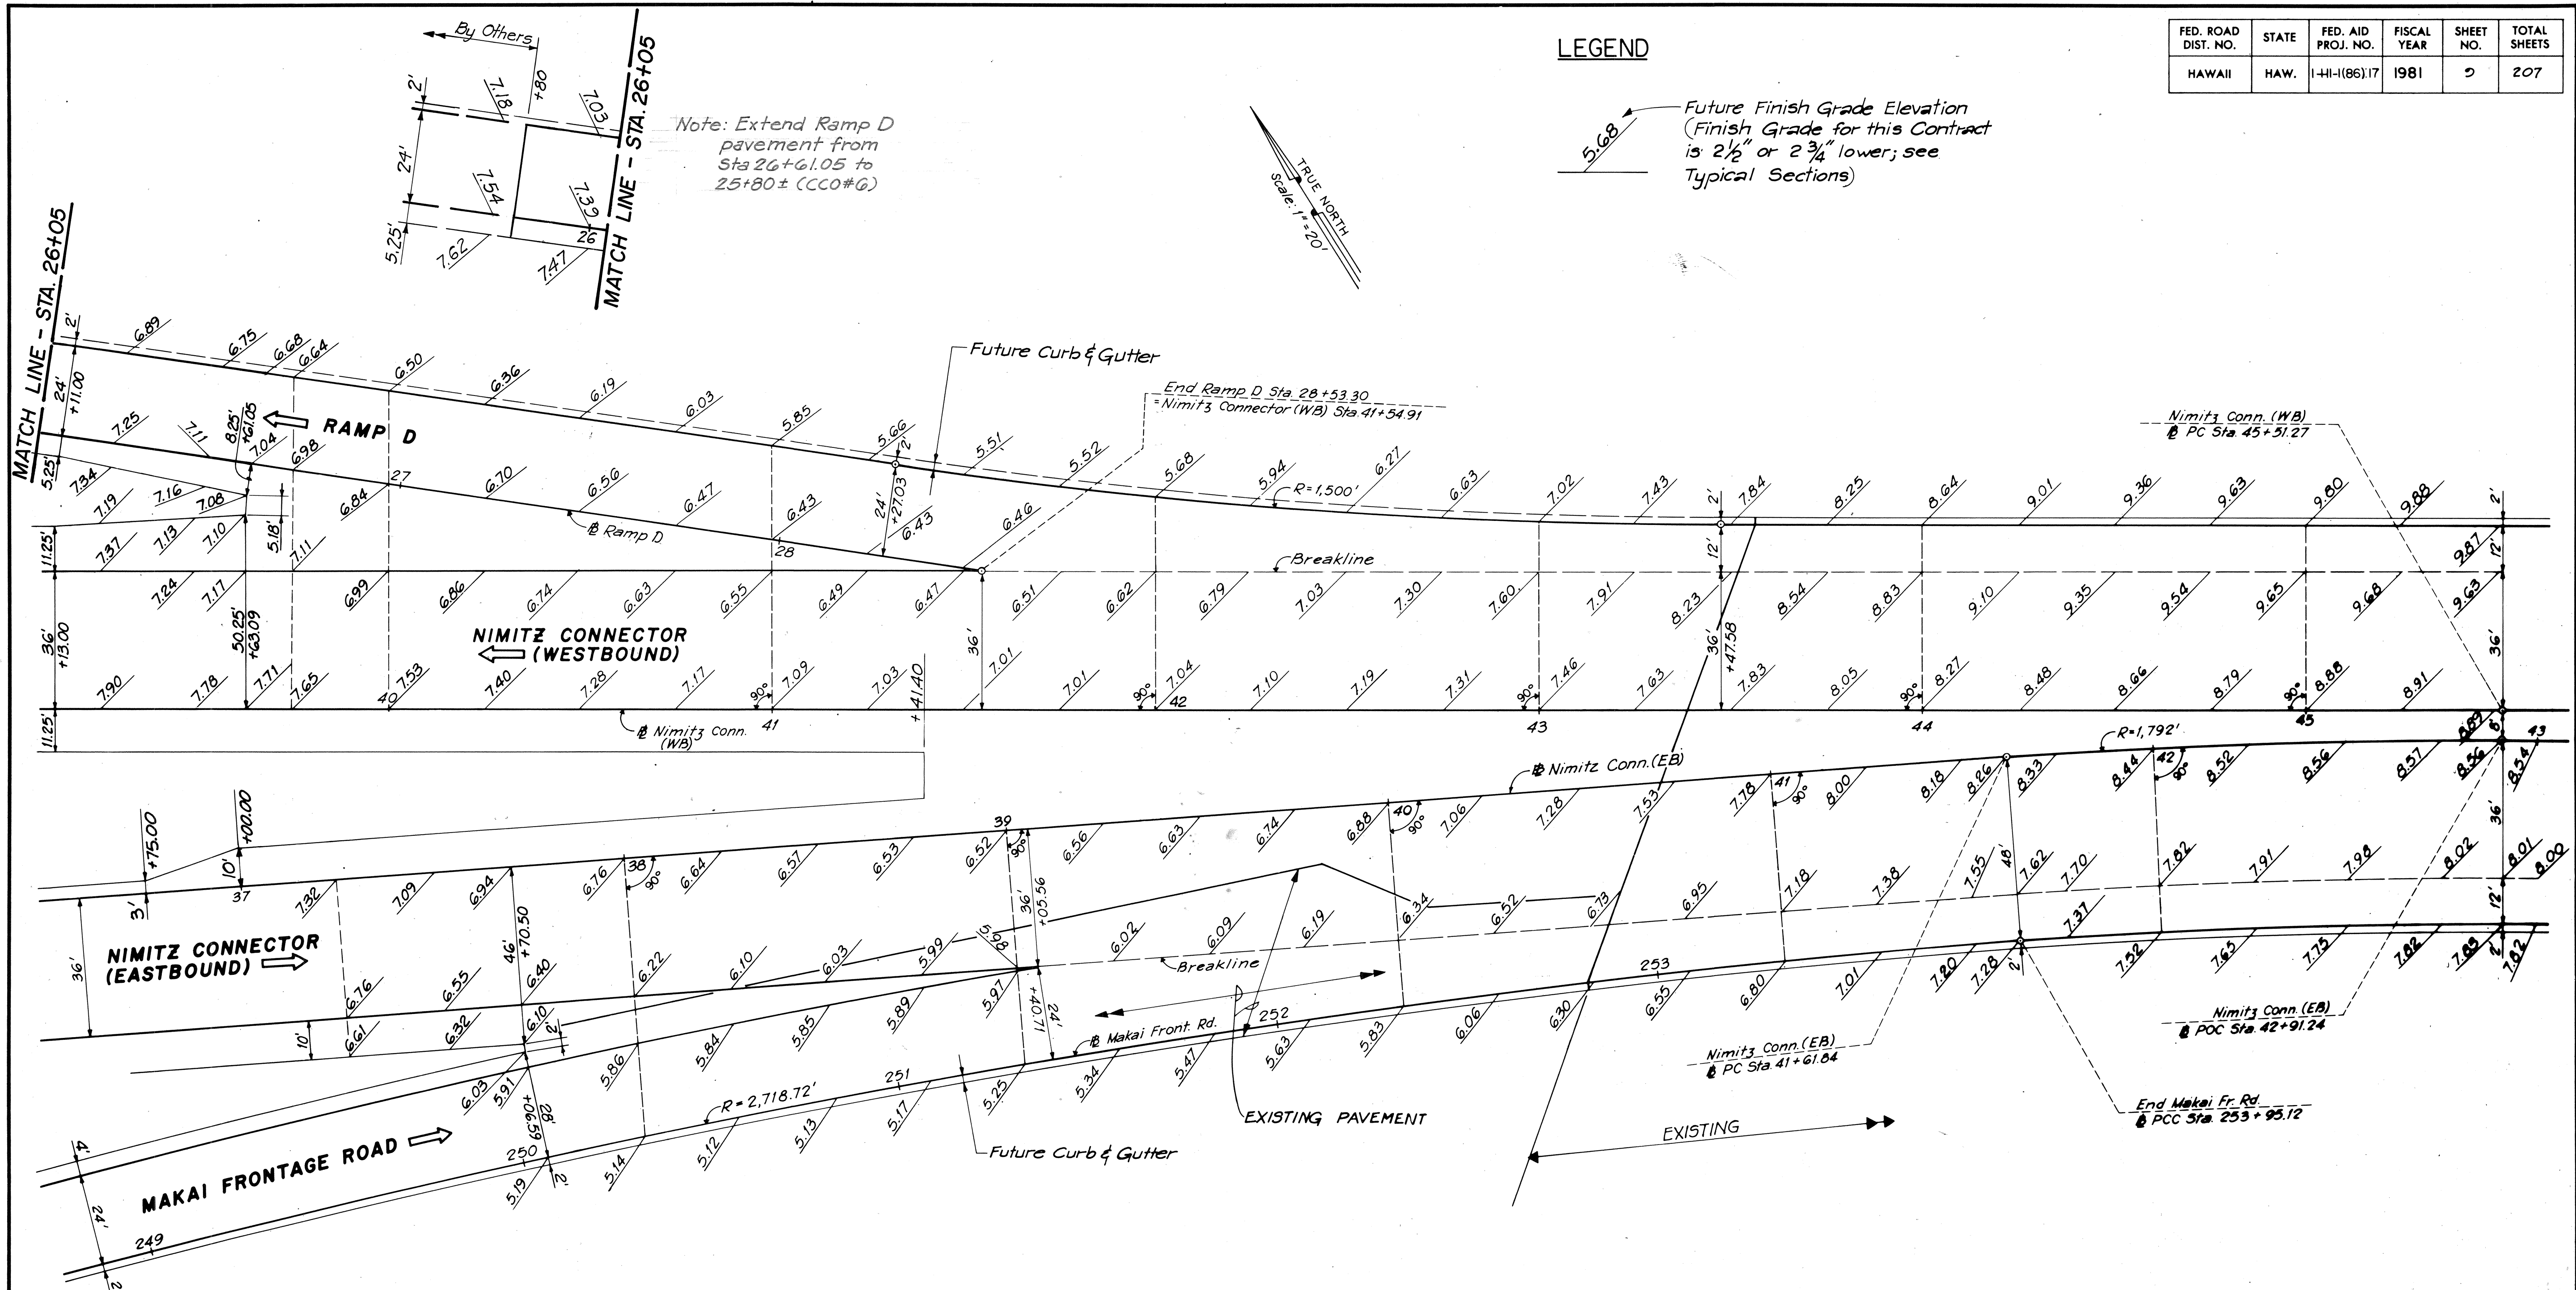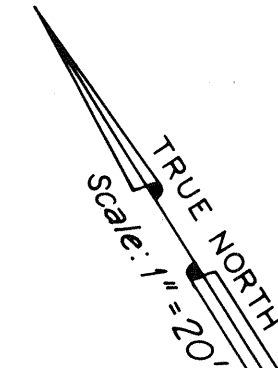

RAMP D & NIMITZ CONNECTOR (WB) and NIMITZ CONNECTOR (EB) & MAKAI FRONTAGE ROAD

SCALE: 1" = 20'

8/10/83	Extended Ramp D Pavement
DATE	REVISION
STATE OF HAWAII DEPARTMENT OF TRANSPORTATION HIGHWAYS DIVISION	
RAMP TERMINAL DETAIL	
INTERSTATE ROUTE H-1 PROJECT NO. I-H1-1 (86) 17	
SCALE: 1" = 20'	DATE: 6/15/81
SHEET No. A-6 OF 14 SHEETS	

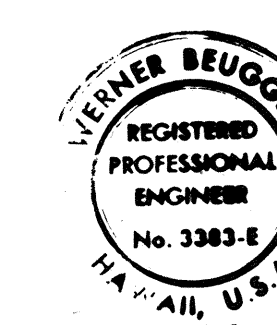

THIS WORK WAS PREPARED BY
OR UNDER MY SUPERVISION.
Werner Beugnot

SURVEY PLOTTED BY	DATE
DESIGNED BY	
NOTED BY	
CHECKED BY	
ORIGINAL PLAN	
NOTE BOOK	