



INDEX TO DRAWINGS	
SHEET NO.	DESCRIPTION
1	TITLE SHEET
2	CONSTRUCTION PHASING
3	TYPICAL ROADWAY SECTIONS
4-6	ALIGNMENT PLANS
7-9	RAMP TERMINAL DETAILS
10-17	ROADWAY PROFILES AND SUPERELEVATION DIAGRAMS
18	DETOUR CONSTRUCTION PLAN
19	ROADWAY CONSTRUCTION PLAN
20-25	ROADWAY CONSTRUCTION DETAILS
26-31	DRAINAGE, GRADING AND SOIL CONSOLIDATION PLANS & DETAILS
32	EROSION CONTROL NOTES AND DETAILS
33-37	SIGNING AND PAVEMENT MARKING PLANS
38-50	SIGNING AND PAVEMENT MARKING DETAILS
51-60	HIGHWAY LIGHTING AND TRAFFIC SIGNAL PLANS AND DETAILS
61	EXISTING UTILITY PLAN
62-75	BORING LOCATION PLAN AND LOGS
76-113	H-1(E.B.) NIMITZ CONN. (WB), RAMP C AND HOV RAMP STRUCTURES
114-173	NIMITZ CONN. (E.B.), HOV RAMP, RAMP A AND RAMP B STRUCTURES
174-189	STRUCTURAL STANDARD DETAILS
(190)	(DELETED)
191	CROSS SECTION KEY SHEET
192-207	CROSS SECTIONS

① C.O. 36S-1, C.O. 36S-2 ARE SUPPLEMENT SHEETS TO THE CONTRACT PLANS TOTAL = 209 SHEETS.

 STATE OF HAWAII
 DEPARTMENT OF TRANSPORTATION
 HIGHWAYS DIVISION
 HONOLULU, HAWAII
 "AS-BUILT"
 PLANS FOR
 CONSTRUCTION OF A PORTION OF
 INTERSTATE ROUTE H-1
 KEEHI INTERCHANGE

FEDERAL AID INTERSTATE PROJECT NO. I-HI-1(86):17

DISTRICT OF HONOLULU
ISLAND OF OAHU

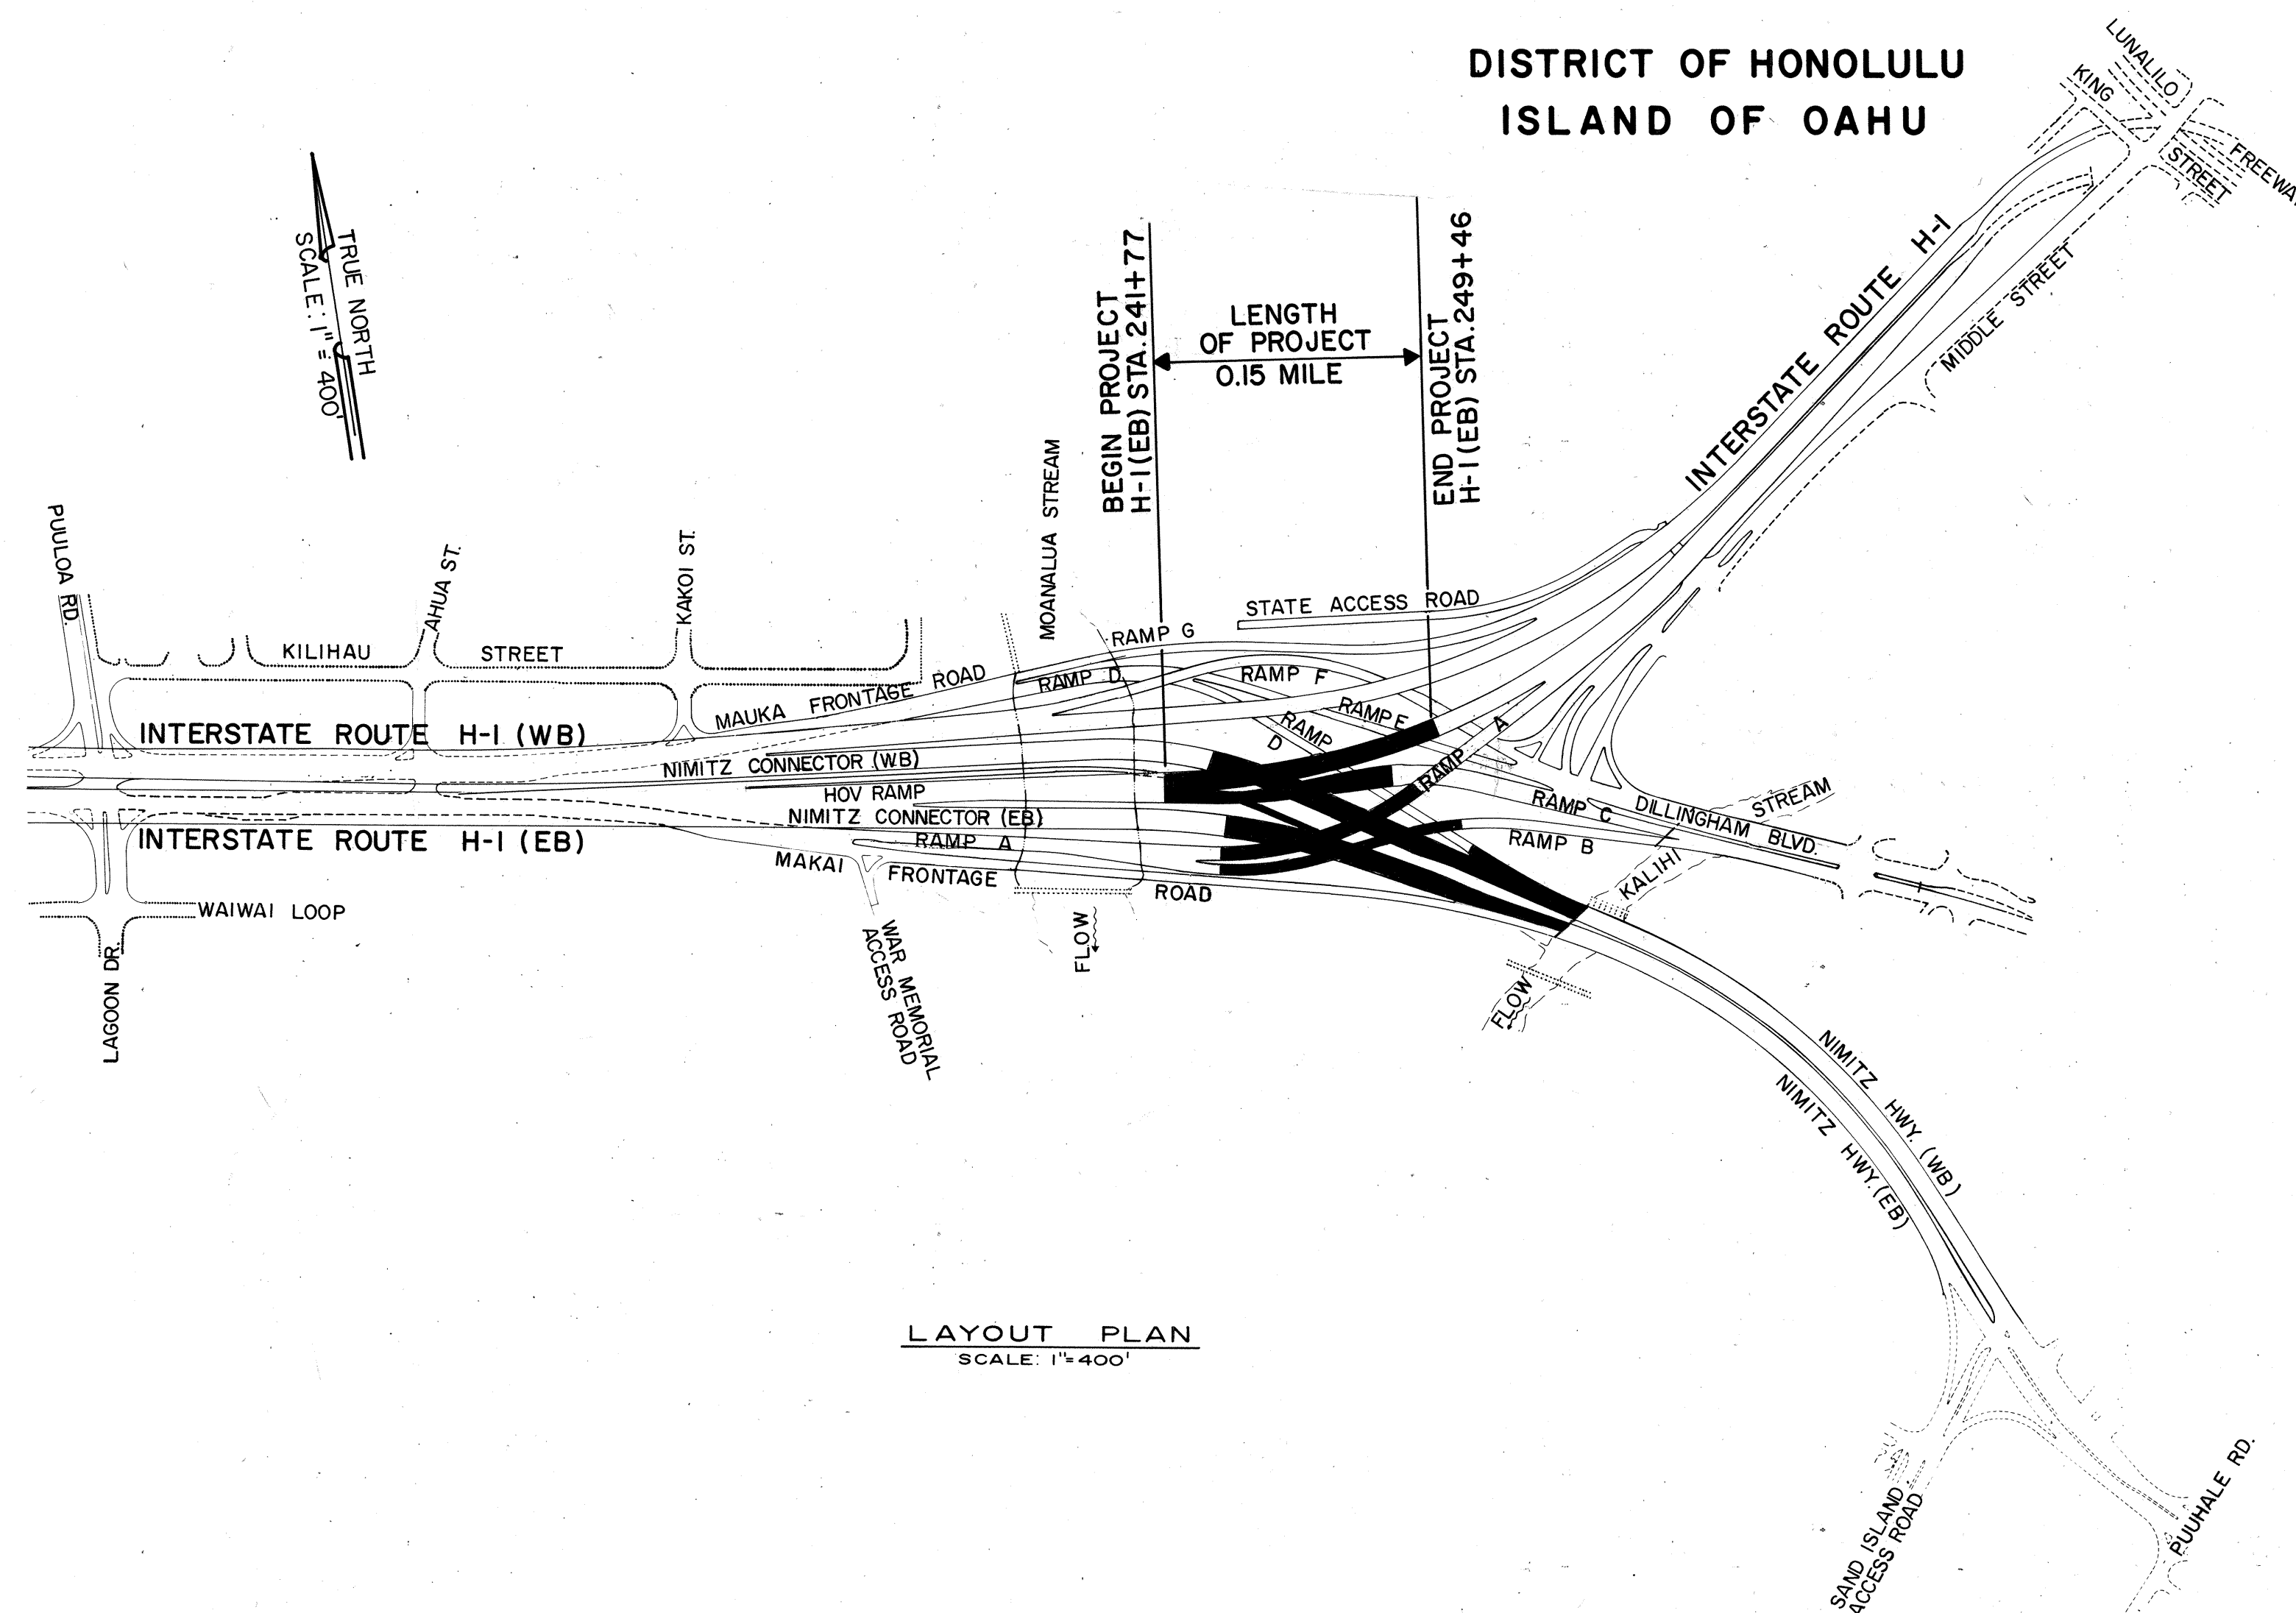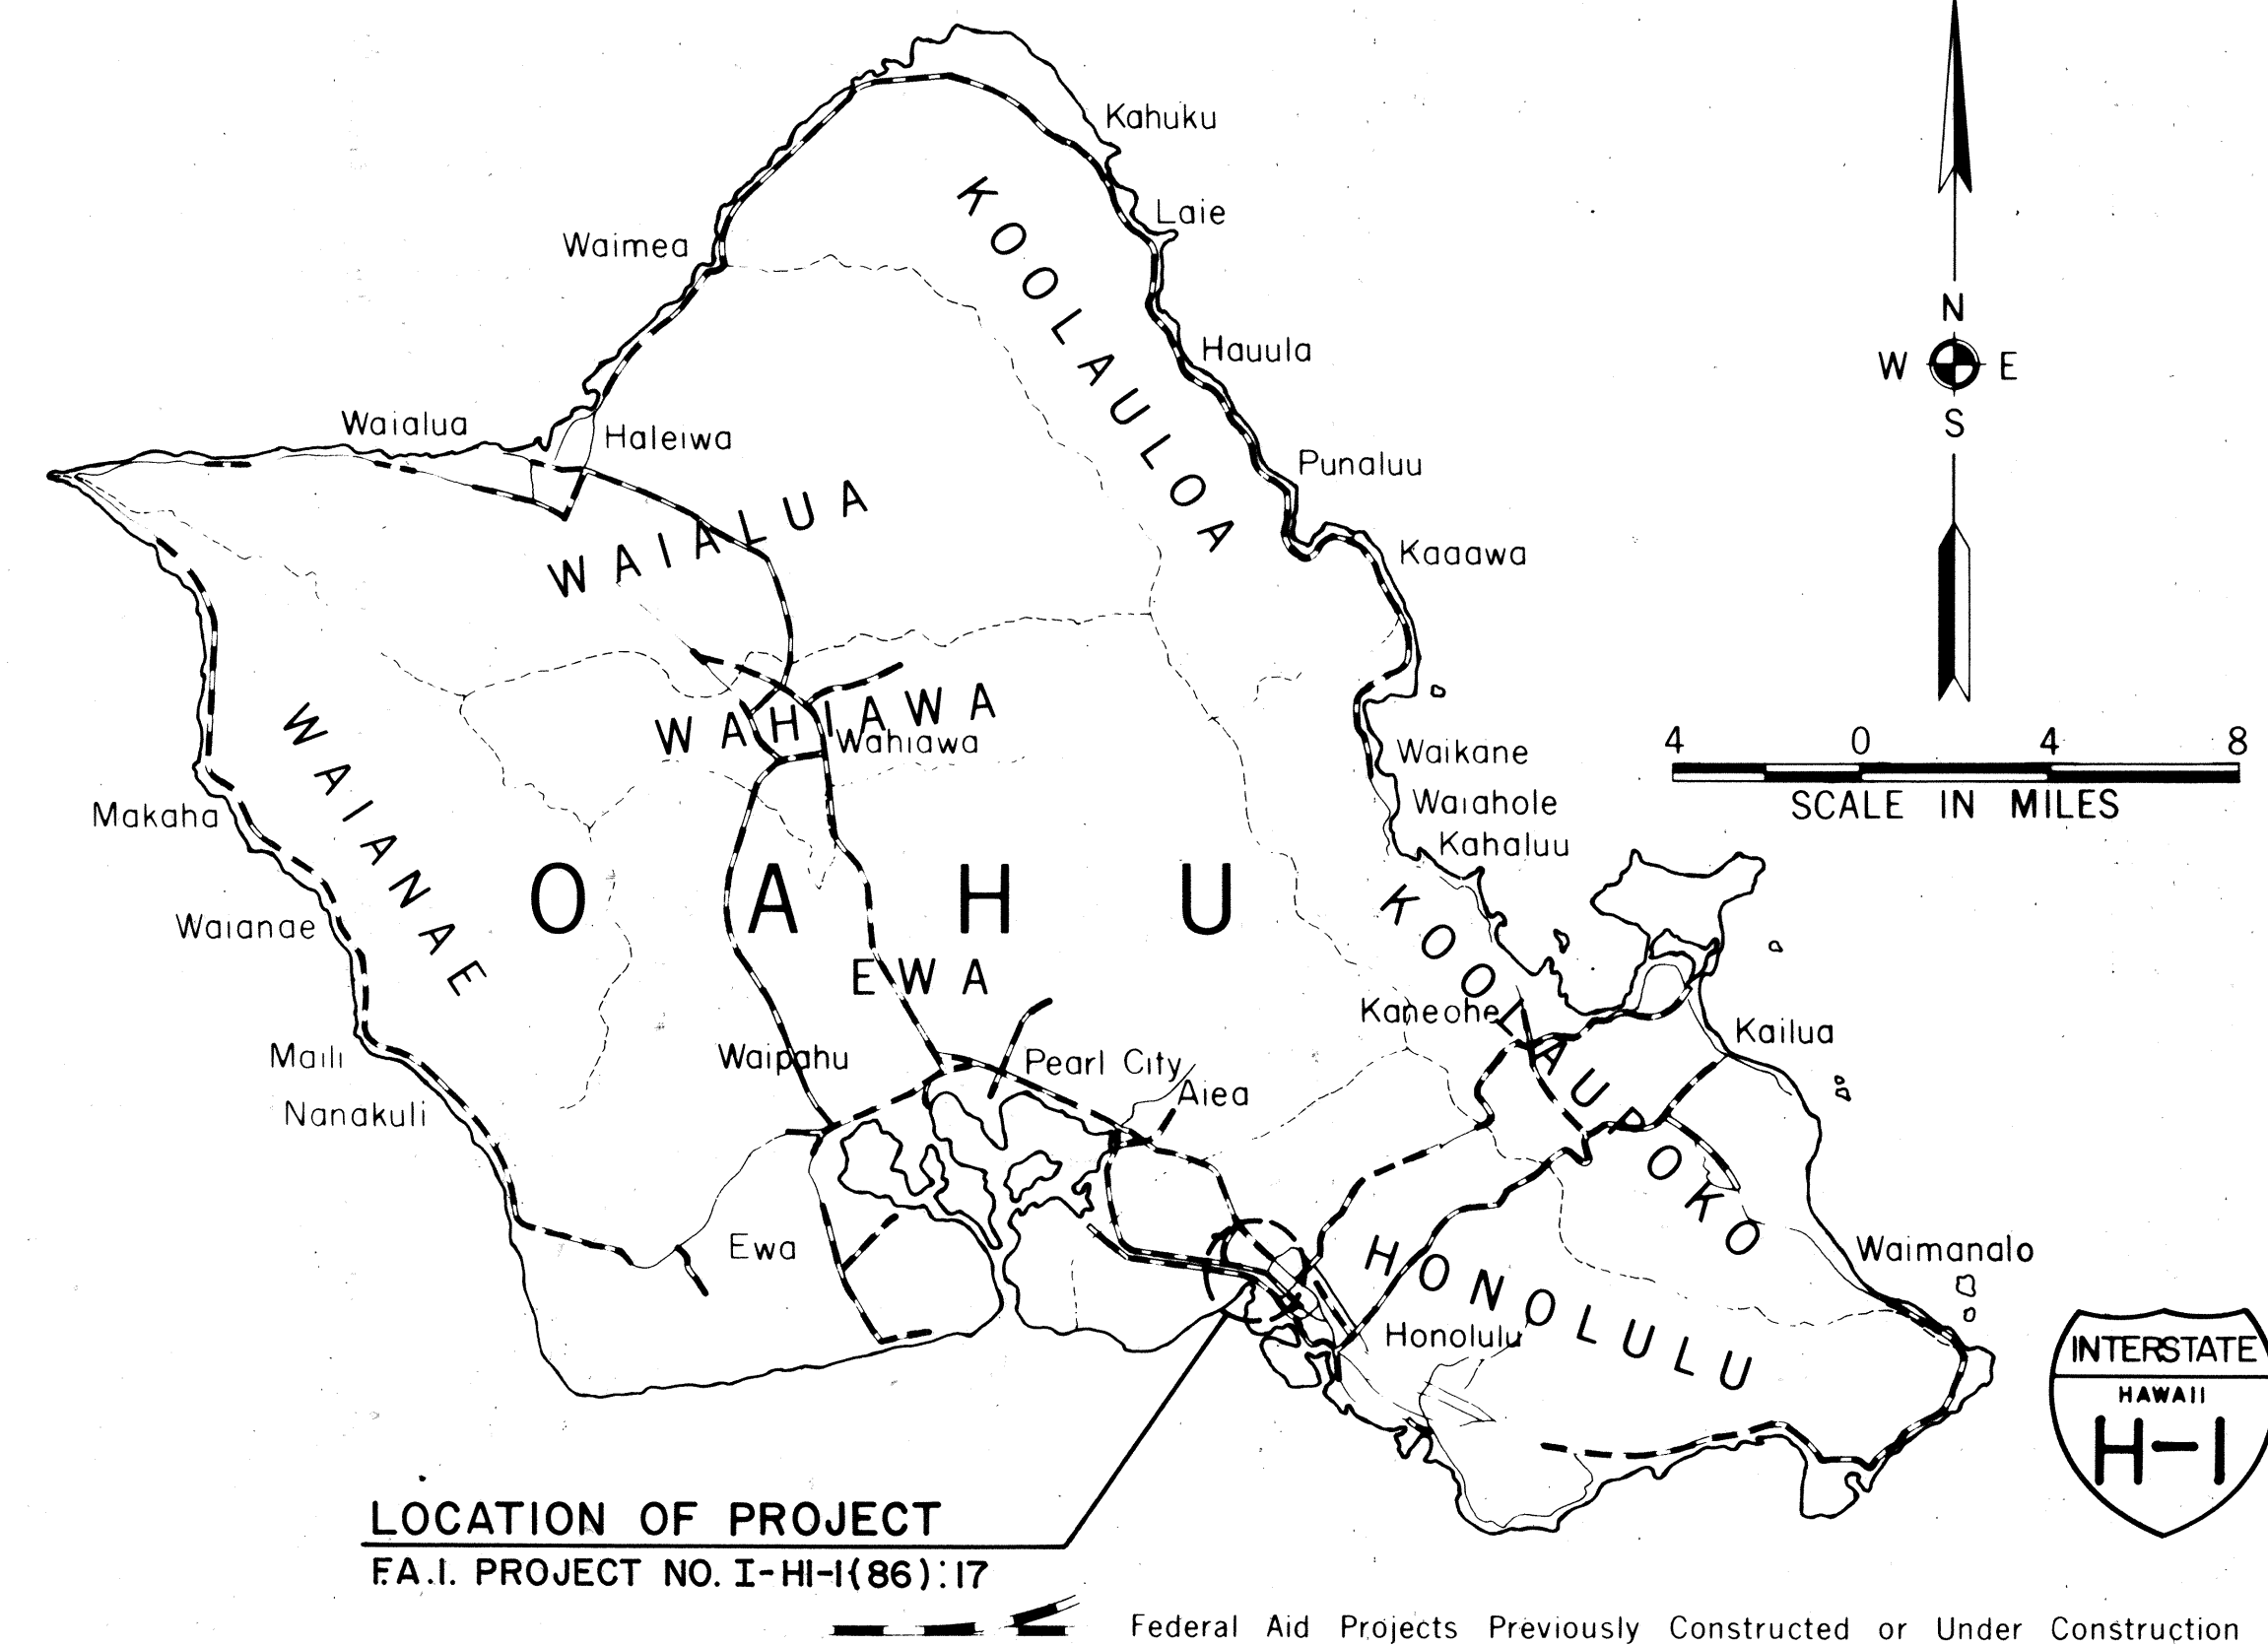

DESIGN CLASSIFICATION

DESIGN ADT (1994).....98,000
 DHV.....10,800
 D.....60/40
 T.....5 %
 V.....60 MPH

CHANGES MADE DURING CONSTRUCTION HAVE BEEN INCORPORATED ON THESE PLANS EXCEPT CHANGES IN THE ORIGINAL THEORETICAL QUANTITIES. FOR ACTUAL QUANTITIES, REFER TO PROJECT LEDGER AND/OR COMPUTATION BOOK.

Michael Dimiga
RESIDENT ENGINEER

12/12/88
DATE

DEPARTMENT OF TRANSPORTATION
FEDERAL HIGHWAY ADMINISTRATION

APPROVED: *[Signature]*
DIVISION ADMINISTRATOR DATE 9.24.81

DEPARTMENT OF TRANSPORTATION
STATE OF HAWAII

APPROVED: *James R. Carras*
DIR. OF TRANSPORTATION DATE 9/24/81

6/15/81 DATE
 521-3051 PHONE
 PAUL WOLF BY
 P S & E
 DESIGNED BY
 PARSONS BRINCKERHOFF-
 HIROTA ASSOCIATES