



FED. ROAD DIST. NO.	STATE	FED. AID PROJ. NO.	FISCAL YEAR	SHEET NO.	TOTAL SHEETS
HAWAII	HAW.	HH(86)17	1981	3	207

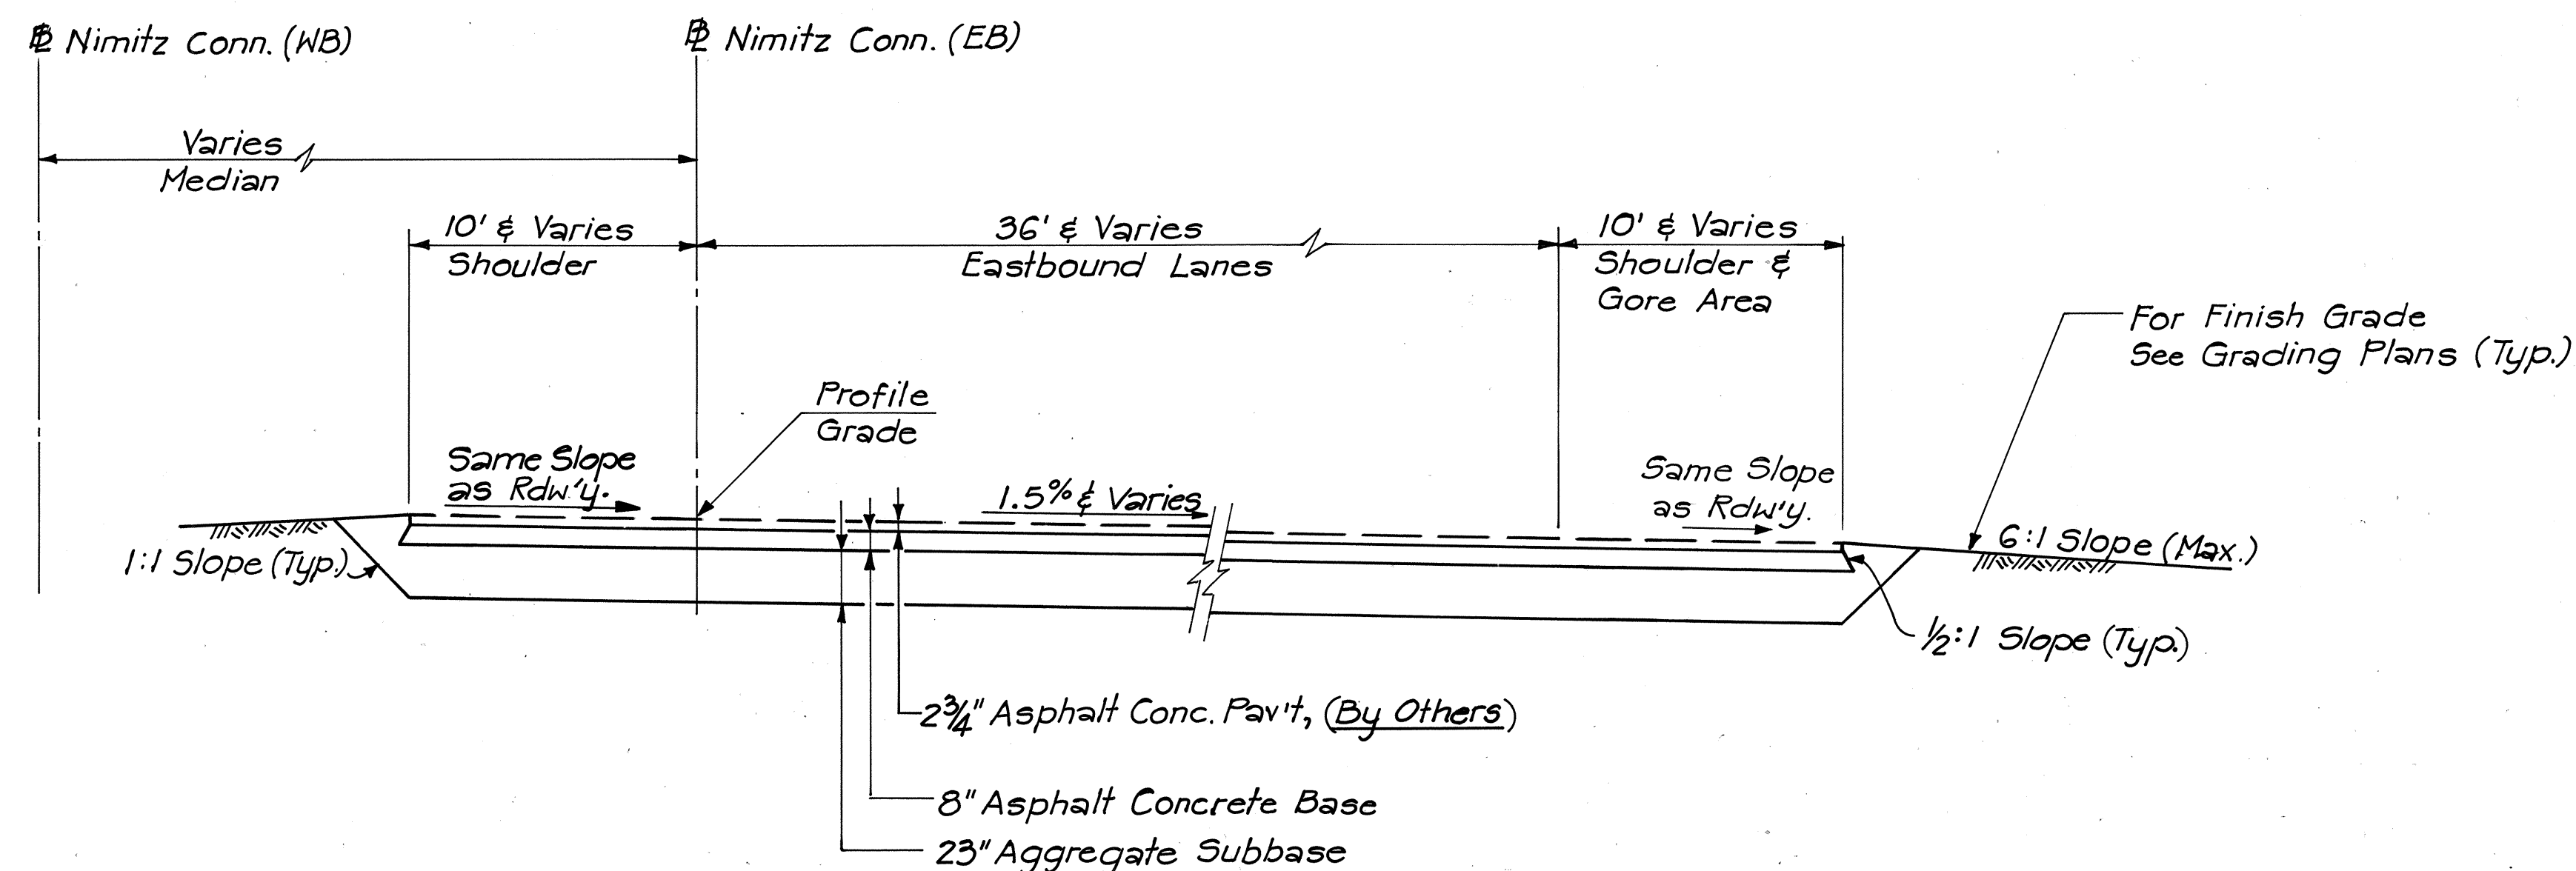

NOTE: Pavement Structure for Nimitz Conn. (WB) Roadway is identical to the one shown for Nimitz Conn. (EB) Roadway.


TYPICAL SECTION - NIMITZ CONNECTORS

Scale: 1" = 5'

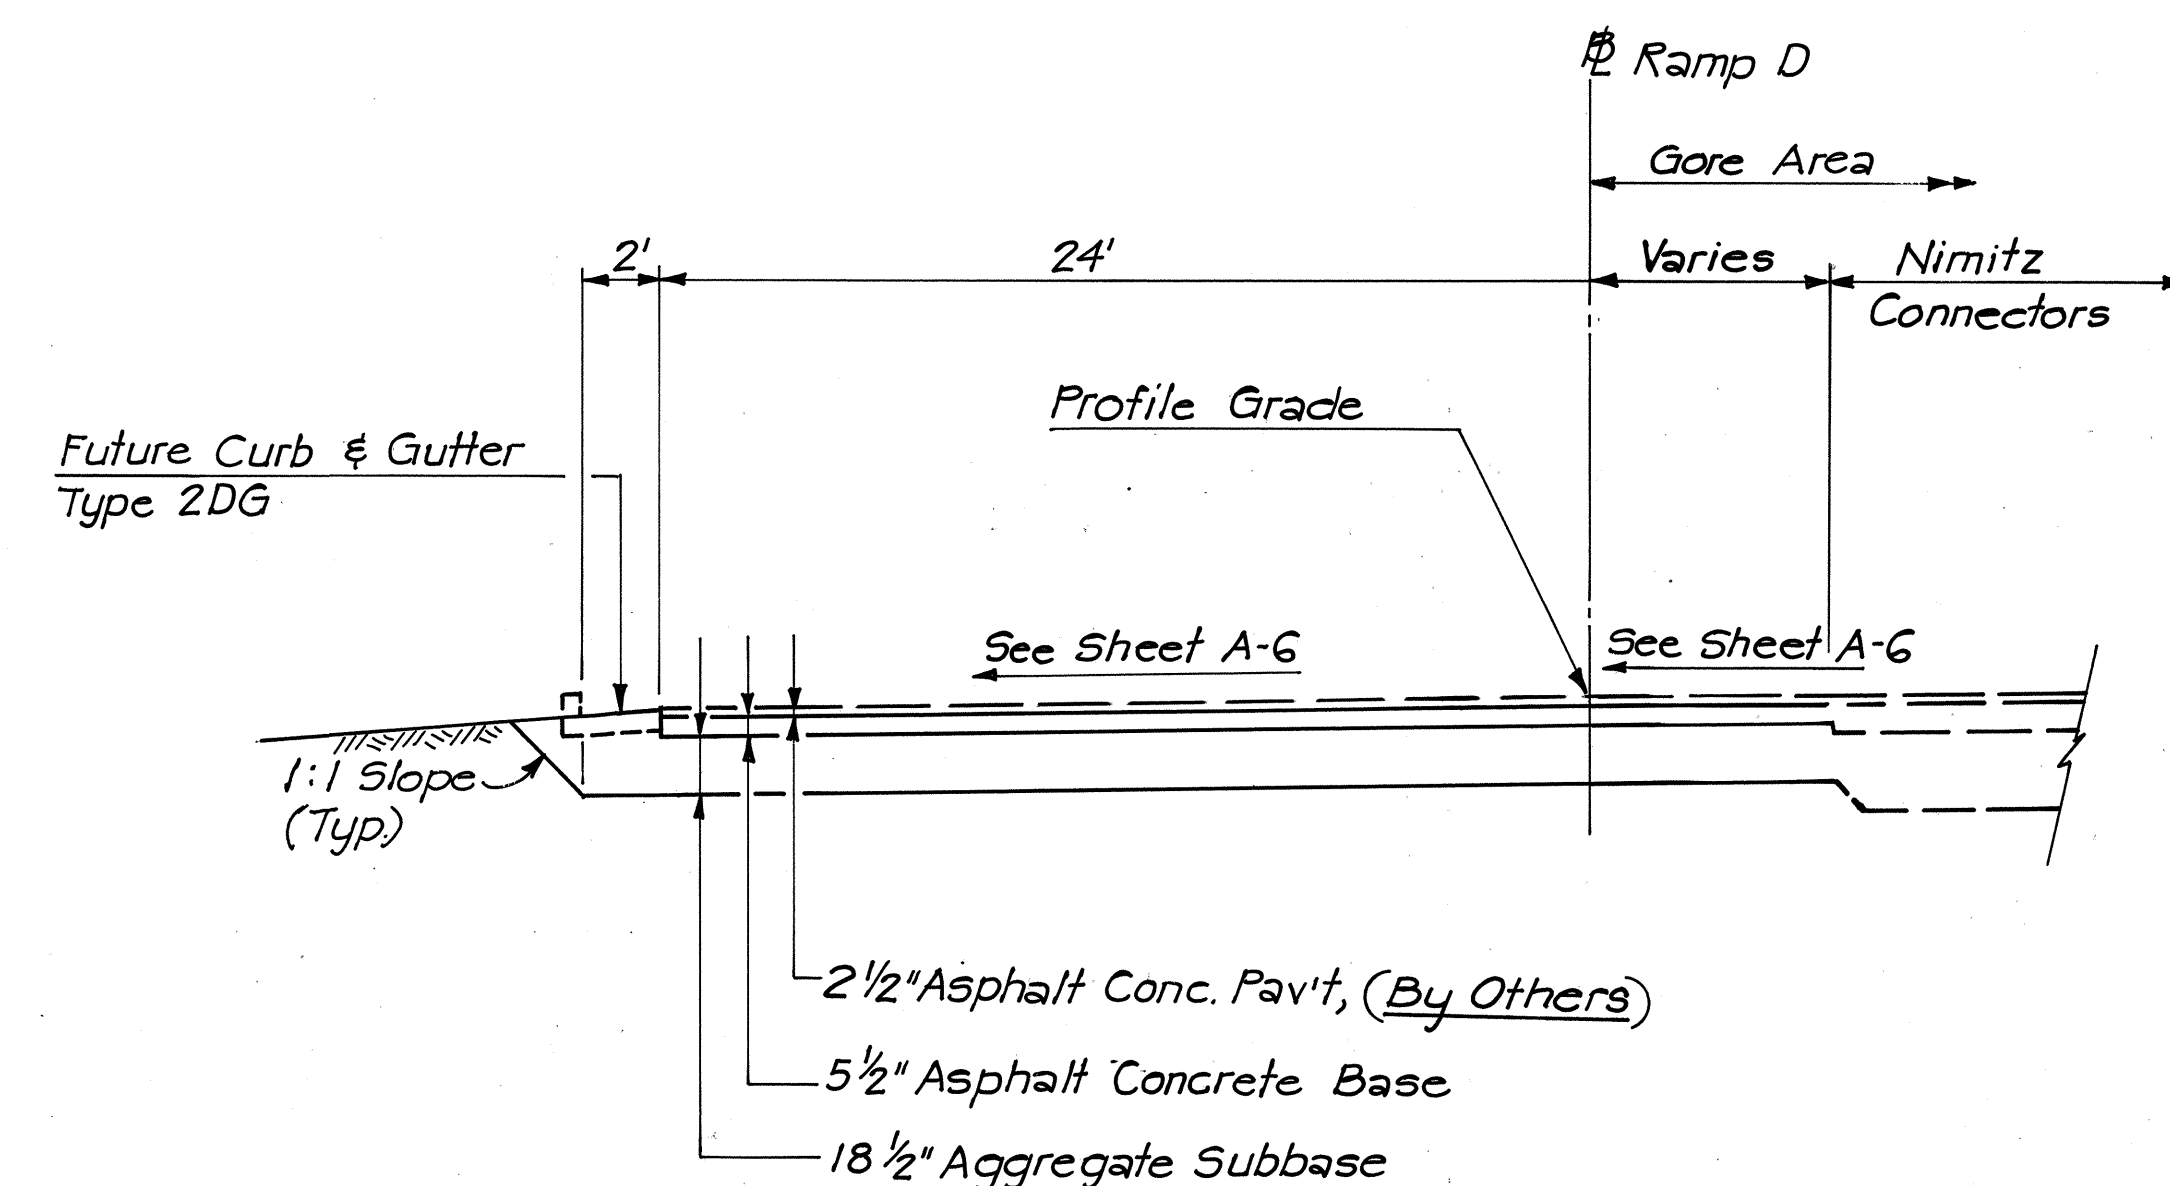


TYPICAL SECTION - RAMP D

Scale: 1" = 5'

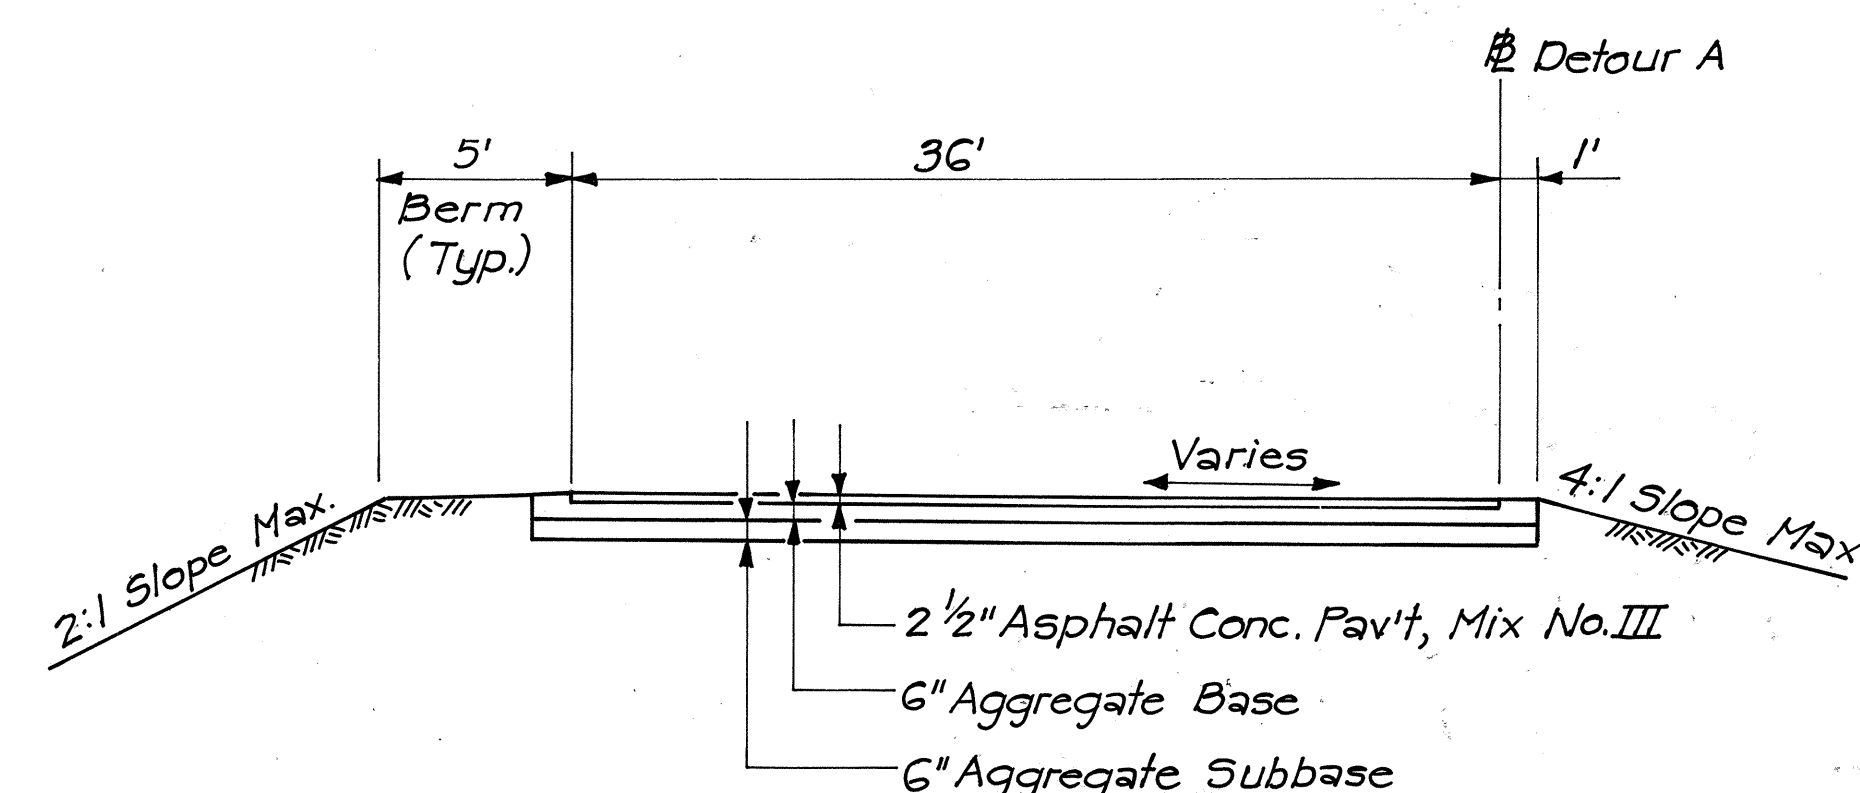

TYPICAL SECTION - DETOUR A & B


Scale: 1" = 5'

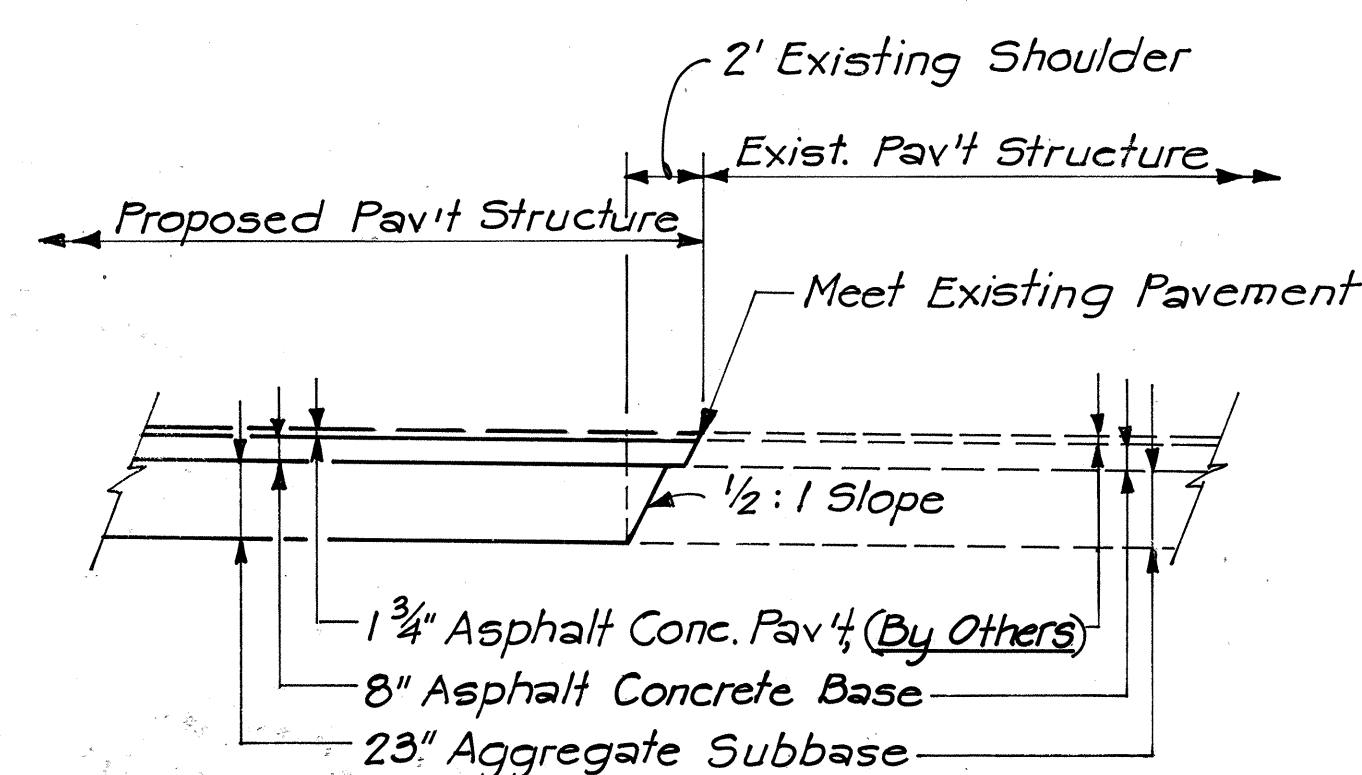

RIGHT EDGE DETAIL - NIMITZ CONN.(EB)


FROM STA. 250+07 TO STA. 252+95

Scale: 1" = 5'

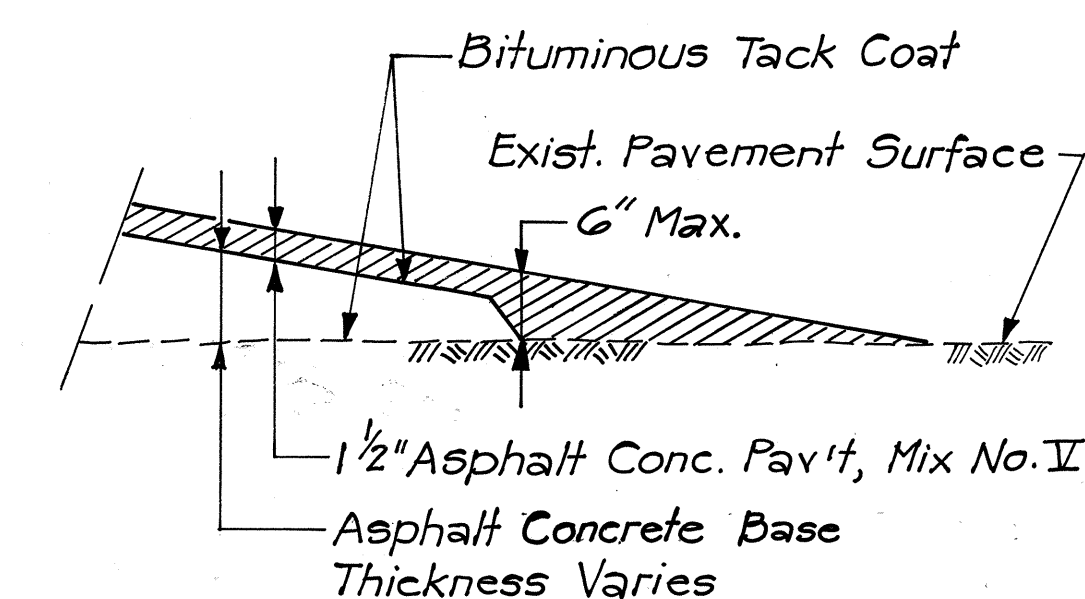


TYPICAL SECTION SMOOTH RIDING CONNECTION

N.T.S.

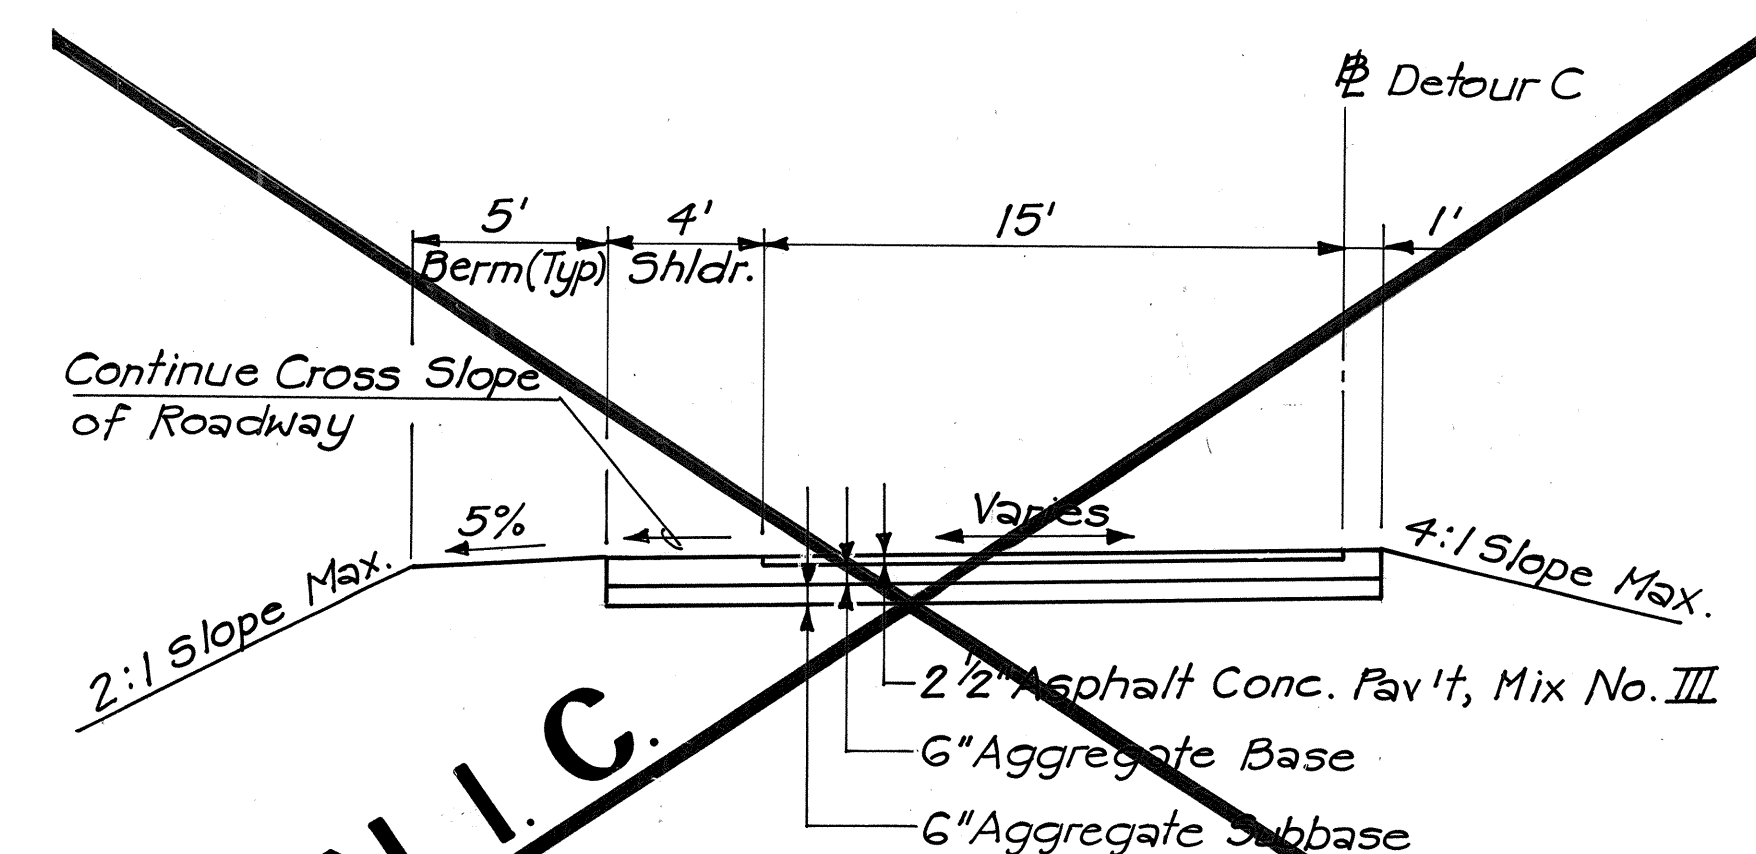

TYPICAL SECTION - DETOUR C

Scale: 1" = 5'

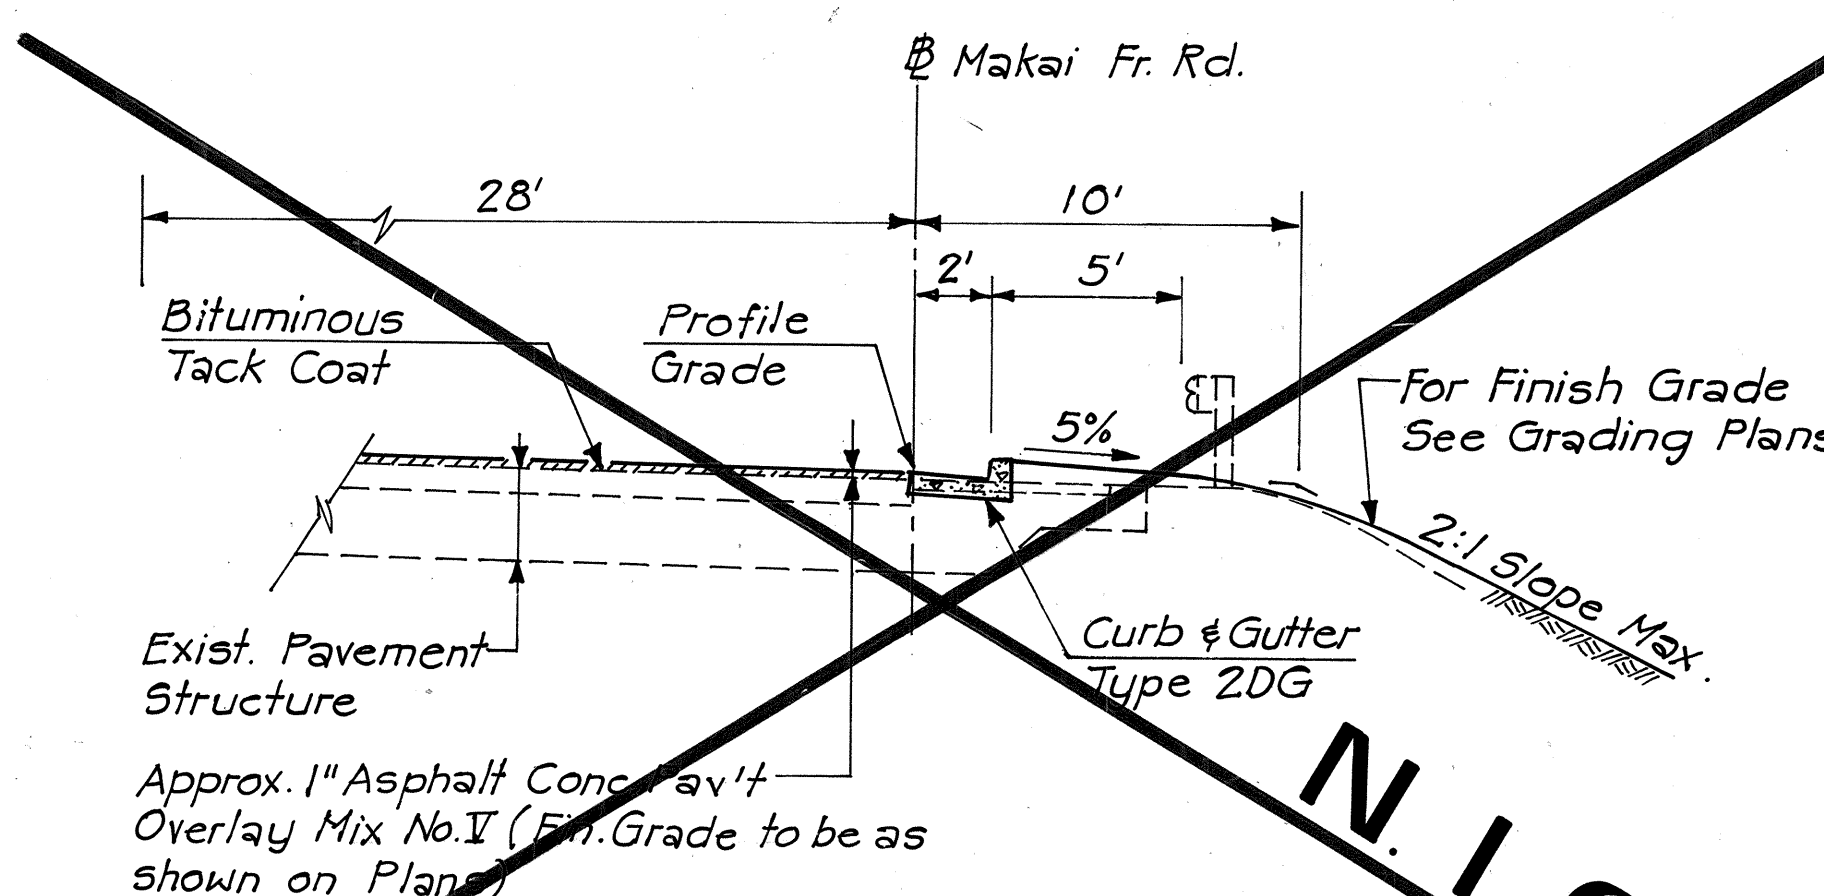


TYPICAL SECTION - MAKAI FRONTAGE ROAD

Scale: 1" = 5'

N.I.C.

N.I.C.

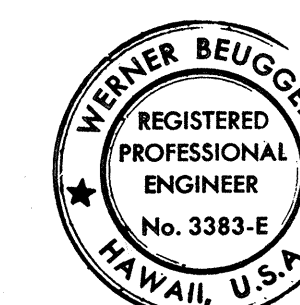

THIS WORK WAS PREPARED BY ME OR UNDER MY SUPERVISION.
Werner Beugget

STATE OF HAWAII
DEPARTMENT OF TRANSPORTATION
HIGHWAYS DIVISION

TYPICAL SECTIONS

INTERSTATE ROUTE H-1
PROJECT NO. 1-HI-1 (86) :17

SCALE: AS SHOWN DATE: 6/15/81
SHEET No. TS-1 OF 1 SHEETS