<u></u>		
	INDEX TO DRAWINGS	
SHEET NO.	DESCRIPTION	1
	TITLE SHEET	
2	TYPICAL SECTIONS & GEN. NOTES	
. 3	DETAIL PLAN OF ROADWAY	(a)
, 4	PAVEMENT GRADE PLAN	
5 - 10	MISCELLANEOUS, TYPICAL & STANDARD ROADWAY DETAILS	
. 11-15	DRAINAGE DETAILS	
16 - 19	RETAINING WALL DETAILS	(b)
20 - 22	UTILITY PLANS	
23 - 38	SIGNING, STRIPING, LIGHTING & TRAFFIC SIGNAL PLANS AND DETAILS	(c)
39	CROSS SECTIONS	(d)

		_
•		

SUPPLEMENTARY SHEETS TO THIS PROJECT ARE SHEET NOS .:

(a) C.O.3S-1

548-2456 PHONE

RONALD TSUZUKI P. S. & E. BY


RONALD TSUZUKI DESIGNED BY

- (b) 19RS-1, C.O. 19S-2 & C.O. 19S-3
- (c) ADD. 36 S-I
- (d) C.O.39 S-1

TOTAL SHEET COUNT AFTER "AS-BUILT" POSTINGS : 45 SHEETS



STATE OF HAWAII

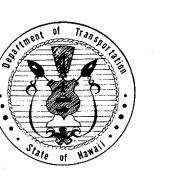


DEPARTMENT OF TRANSPORTATION HIGHWAYS DIVISION "AS - BUILT" PLANS FOR

INTERSTATE ROUTE H-I SAFETY IMPROVEMENTS AT THE PUNAHOU STREET OFF-RAMP

FEDERAL AID INTERSTATE PROJ. NO. IR-HI-I(160)

DISTRICT OF HONOLULU ISLAND OF OAHU

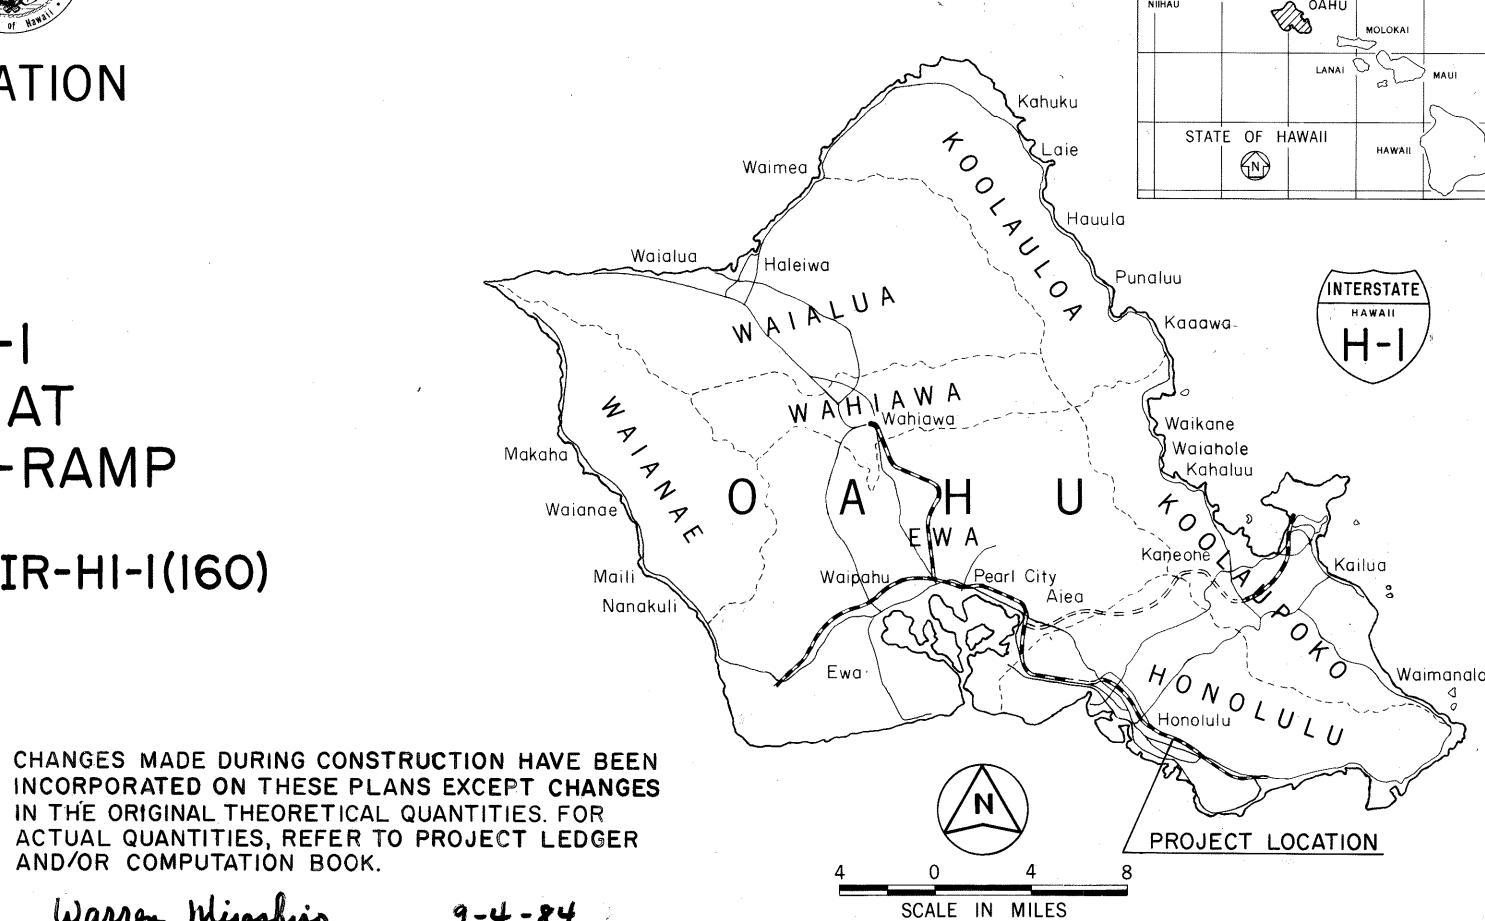

FED. ROAD DIST. NO.

FED. AID PROJ. NO.


IR-HI-I(160) 1982

RESIDENT ENGINEER

AND/OR COMPUTATION BOOK.

9-4-84

FEDERAL AID INTERSTATE PROJECTS PREVIOUSLY CONSTRUCTED OR UNDER CONSTRUCTION

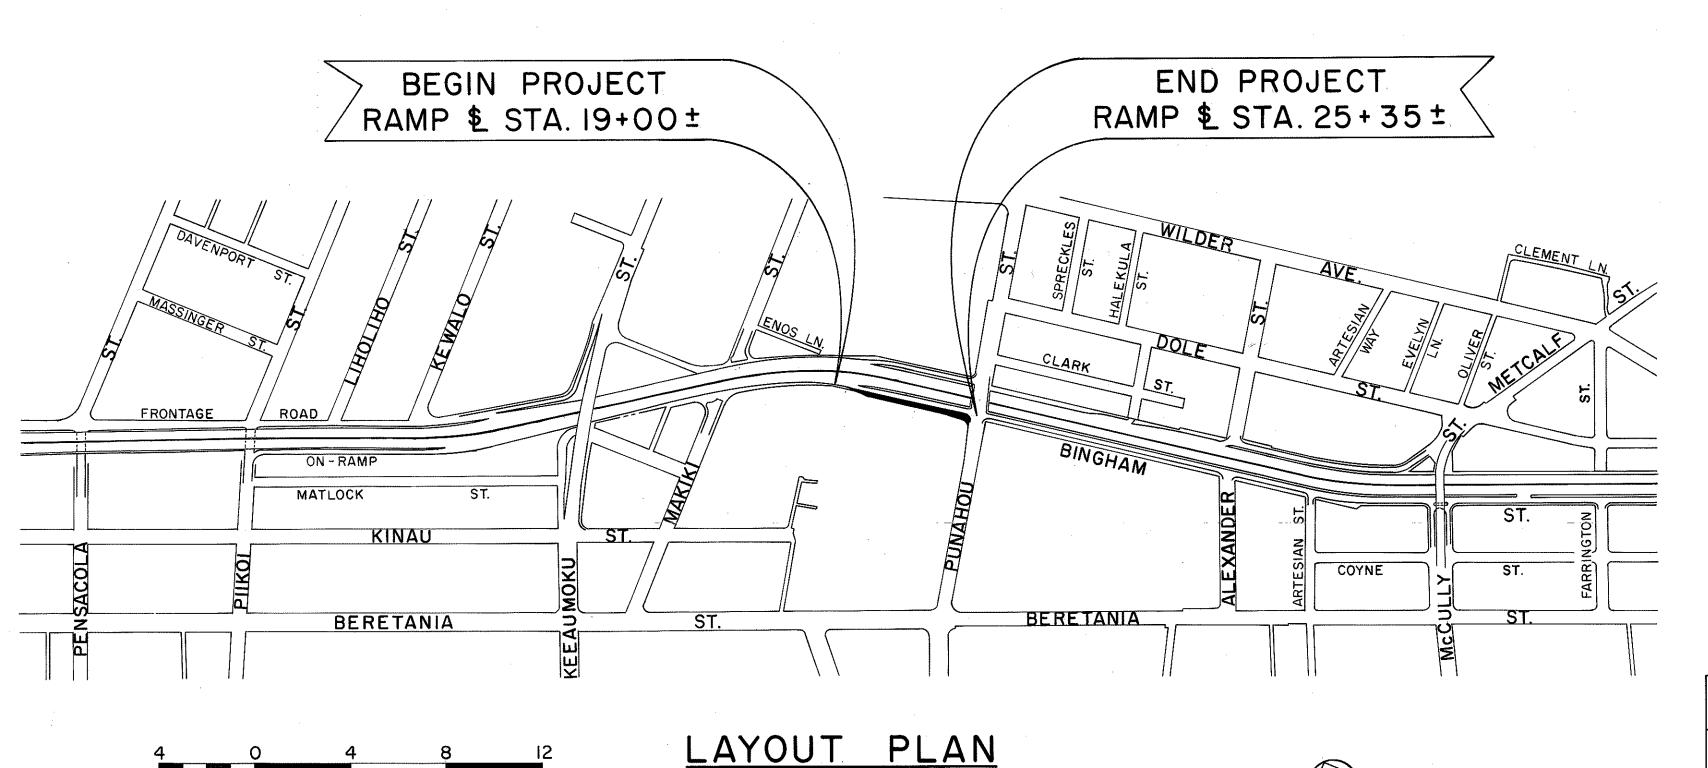

LENGTH OF PROJECT = 0.120 MILES OR 0.194 KILOMETERS

DESIGN DESIGNATION

CURRENT ADT (1982)....21,294 DESIGN ADT (2002) 27,755

DEPARTMENT OF TRANSPORTATION FEDERAL HIGHWAY ADMINISTRATION APPROVED:

Mellethur LODIVISION ADMINISTRATOR

DEPARTMENT OF TRANSPORTATION STATE OF HAWAII APPROVED: