
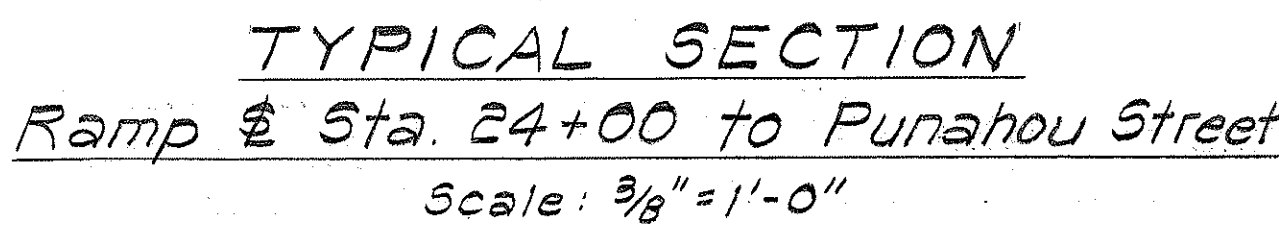


GENERAL NOTES:

- STATE OF HAWAII
DEPARTMENT OF TRANSPORTATION
LAND TRANSPORTATION FACILITIES DIVISION
- TYPICAL SECTION & GENERAL NOTES
- INTERSTATE ROUTE HI-1
SAFETY IMPROVEMENTS AT
THE PUNAHOU STREET OFF-RAMP
F.A.I. Proj. No. IR-HI-1(160)
- Scale: As Shown Date: May, 1982
- SHEET NO. 1 OF 1 SHEETS

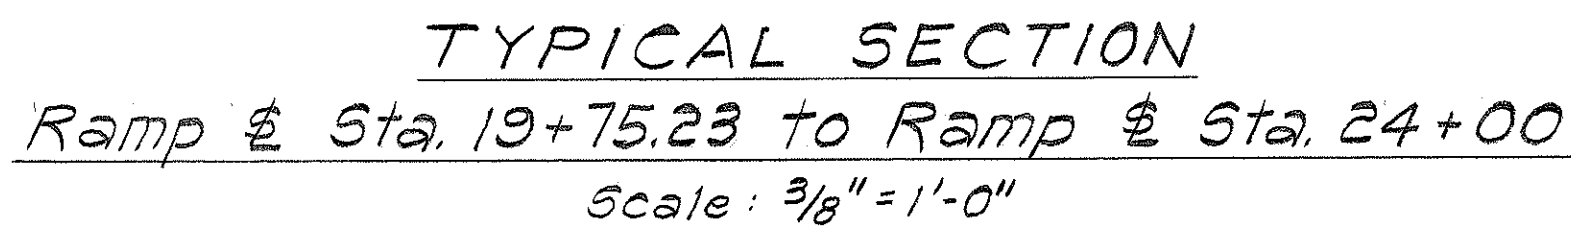

ORIGINAL PLAN	SURVEY PLOTTED BY _____	DATE _____
NOTE BOOK	DRAWN BY _____	" "
	TRACED BY _____	" "
	DESIGNED BY _____	" "
	QUANTITIES BY _____	" "
No. _____	CHECKED BY _____	" "