


ORIGINAL PLAN	SURVEY PLOTTED BY	DATE
	SY	DEC 66
	DRAWN BY	"
	DESIGNED BY	DEC 66
	QUANTITIES BY	"
	CHECKED BY	FEB 67
No. _____		

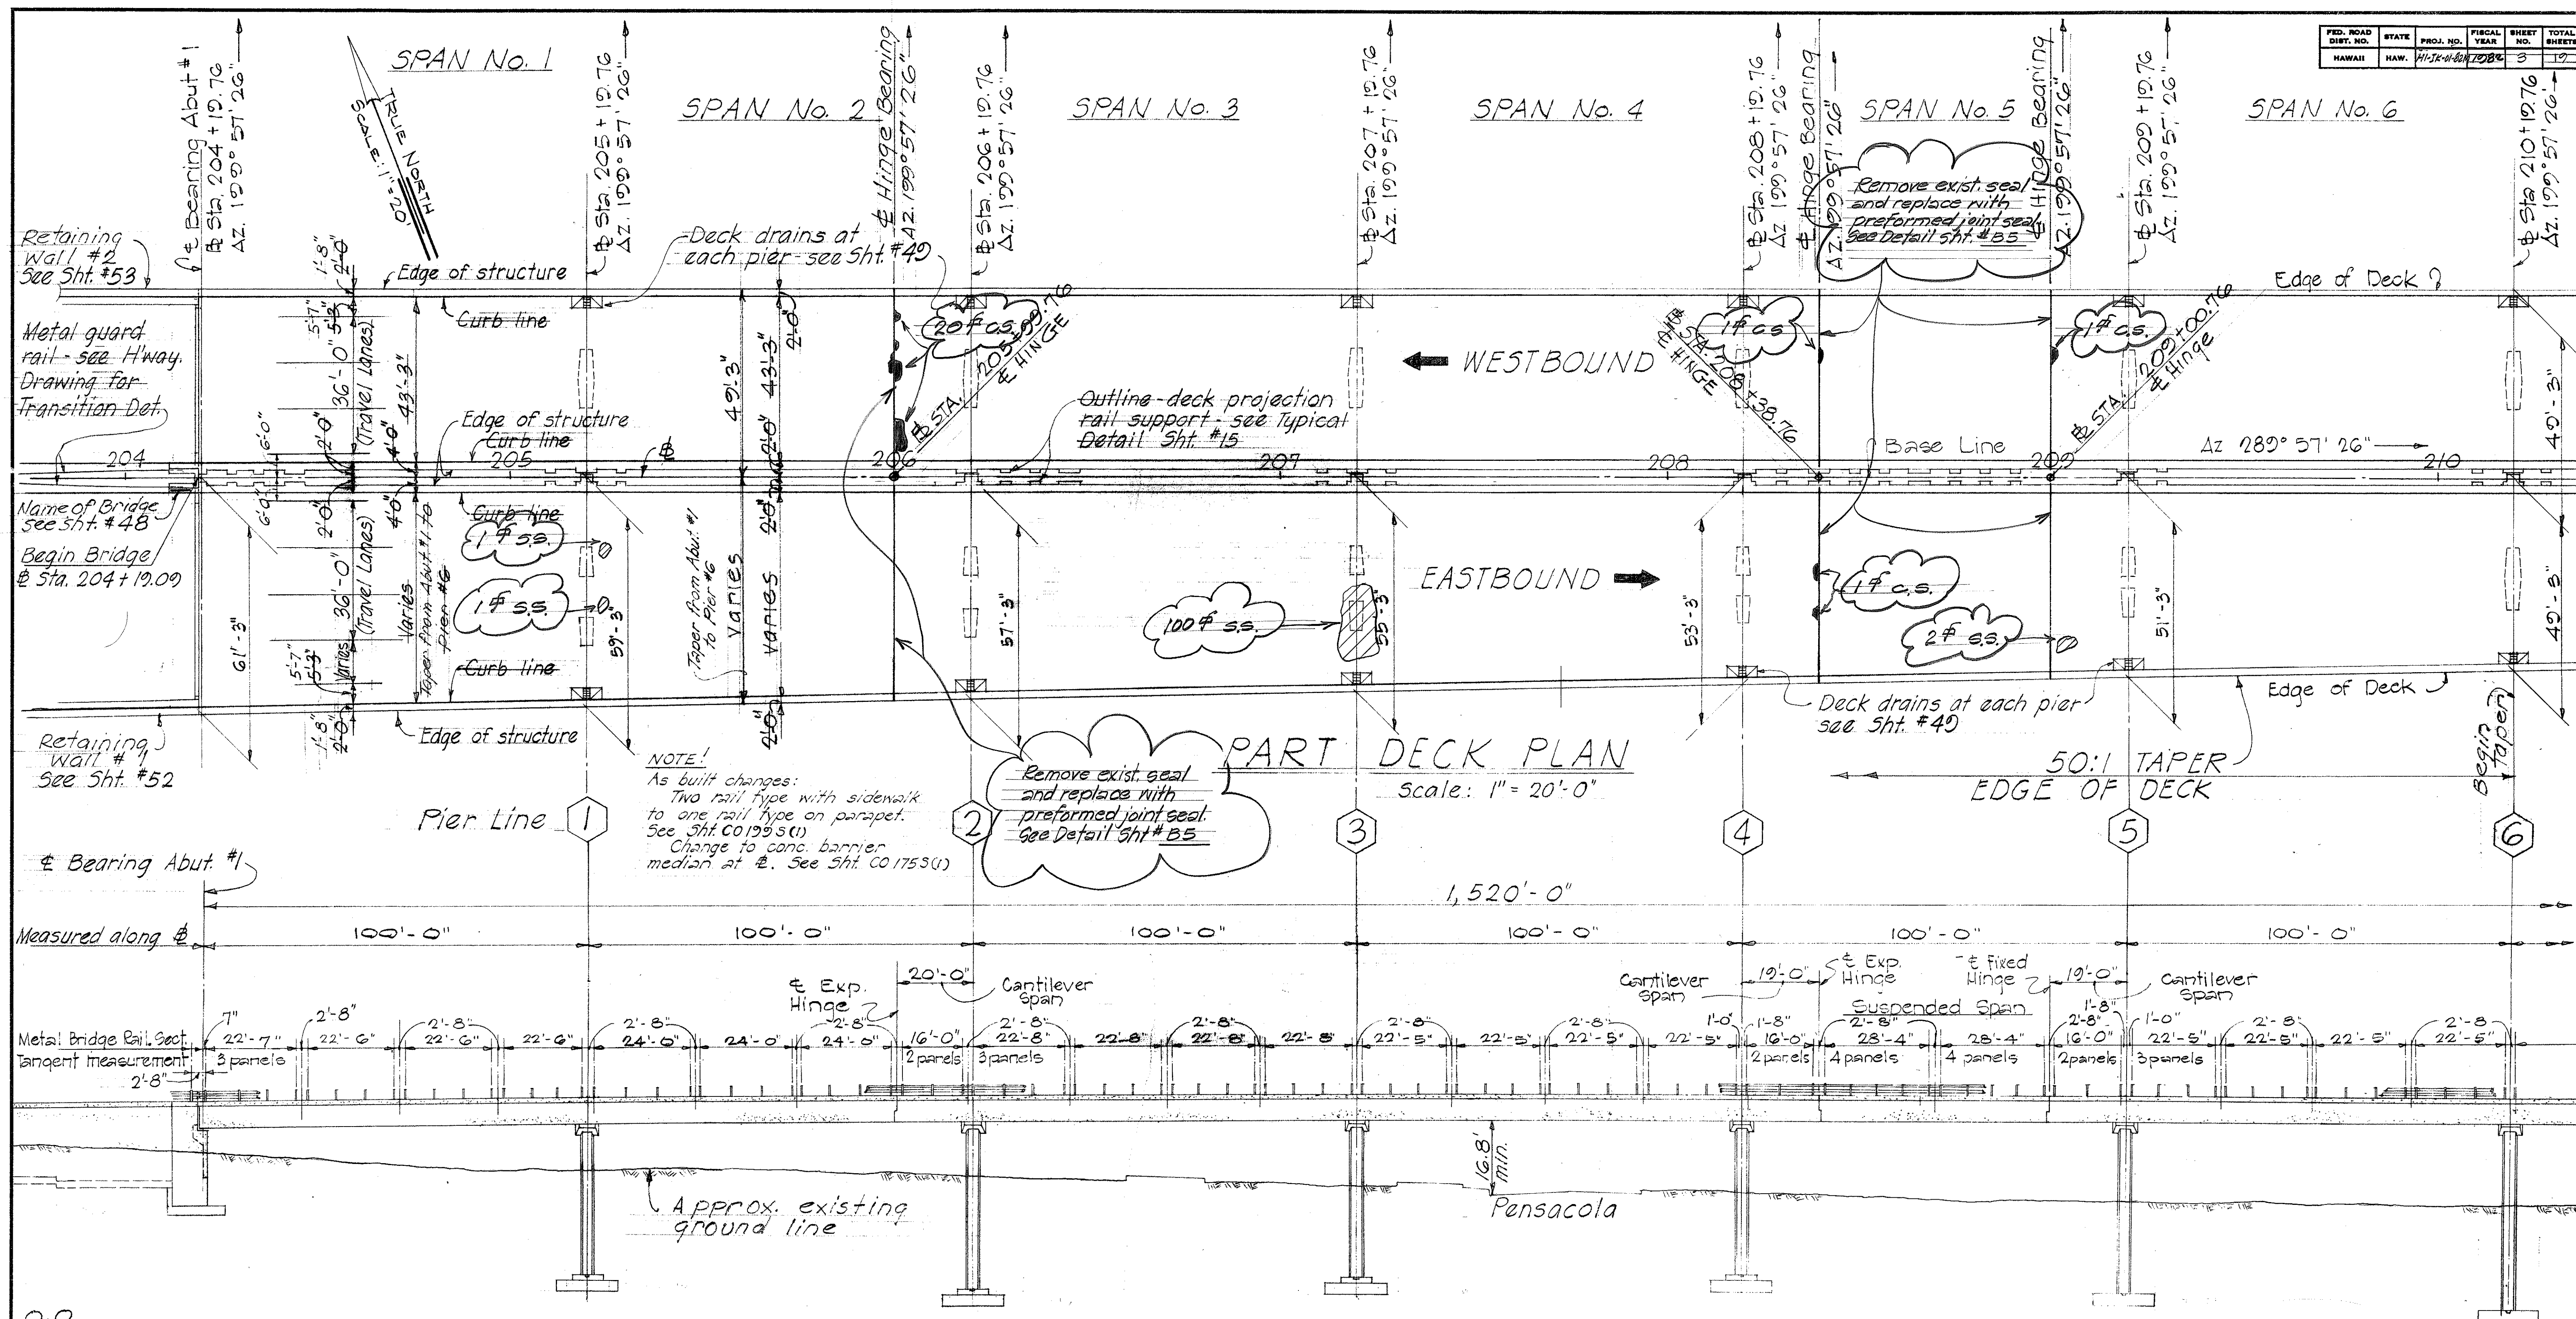

NOTES:

Top of concrete deck to follow finish roadway grades except as otherwise noted on plans.
Superstructure slabs & girders to be constructed on curve where occurs.

PART ELEVATION

~~STATE OF HAWAII~~
~~DEPARTMENT OF TRANSPORTATION~~
~~HIGHWAYS DIVISION~~

REPAIRS TO
PIIKOI VIADUCT

INTERSTATE HIGHWAY (LUNDILLO FREEWAY)
Proj. No. HI-1K-01-82M

SHEET No. 02 OF 10 SHEETS


**STATE OF HAWAII
DEPARTMENT OF TRANSPORTATION
HIGHWAYS DIVISION**

VICTORIA TO KEEAUMOKU VIADUCT
PART LAYOUT PLAN


Sta. 204 + 19.09 to Sta. 219 + 40.43
Interstate Route H-1, Lunalilo Freeway

SHEET No. OF SHEETS

FED. ROAD DIST. NO.	STATE	PROJ. NO.	FISCAL YEAR	SHEET NO.	TOTAL SHEETS
HAWAII	HAW.	HI-IR-01-82M	1982	4	19

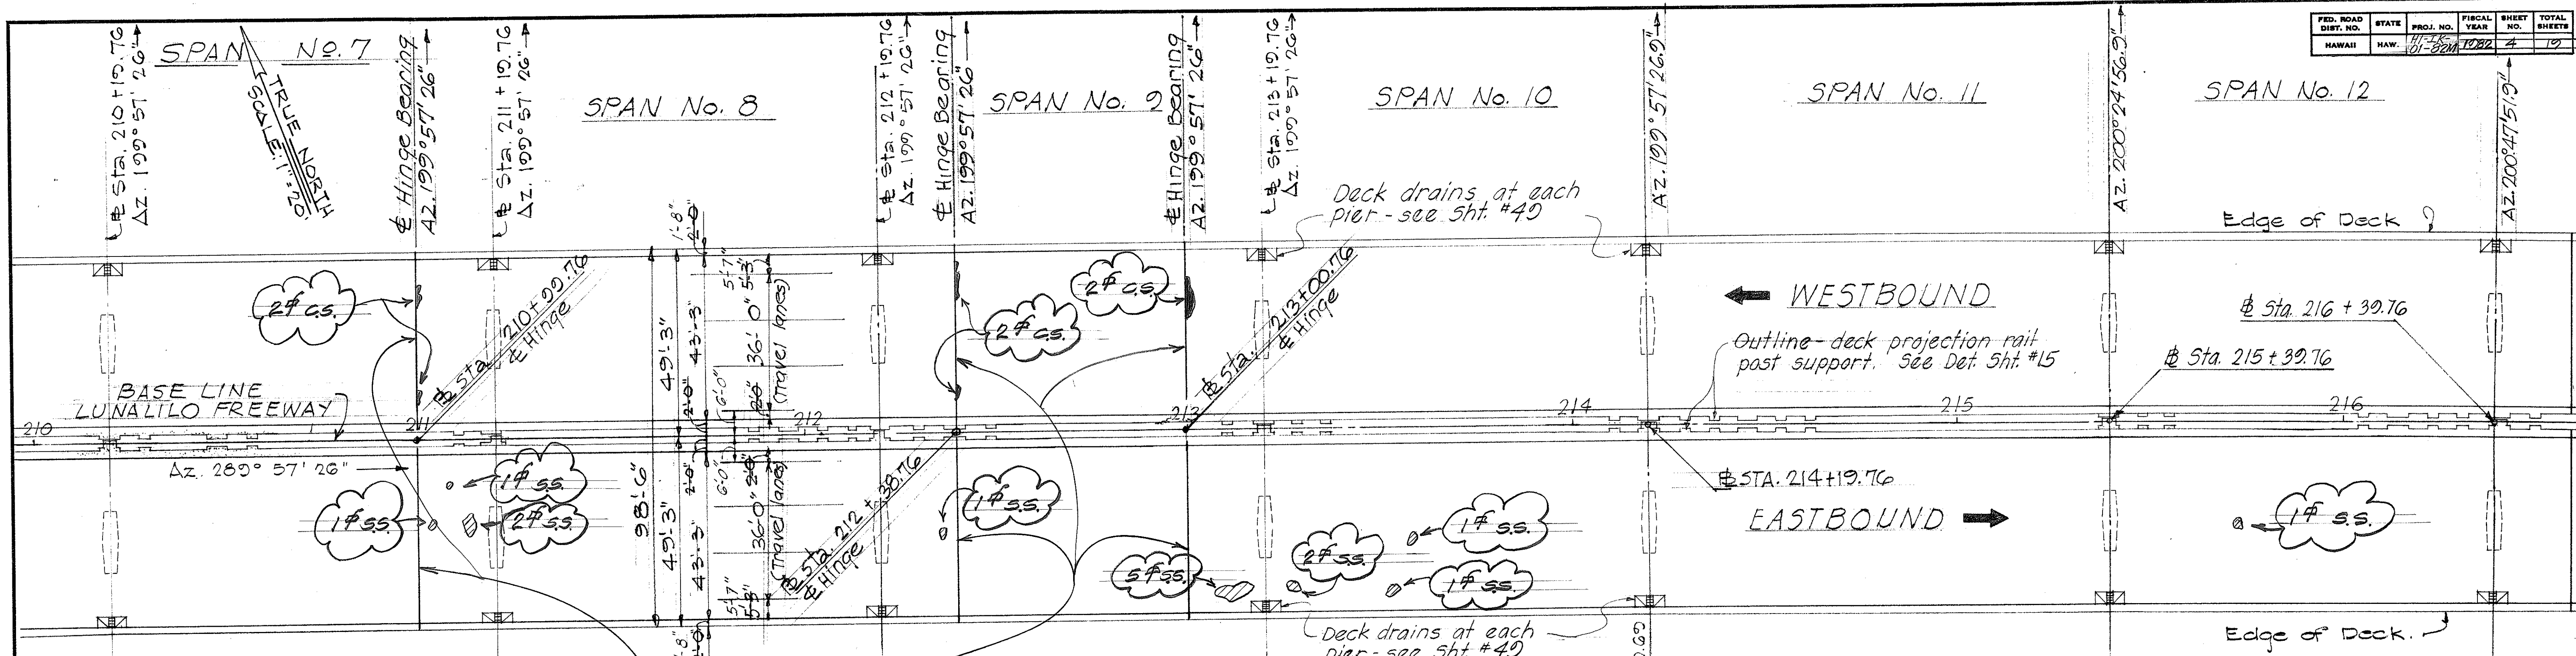

PART DECK PLAN
Scale: 1" = 20'-0"

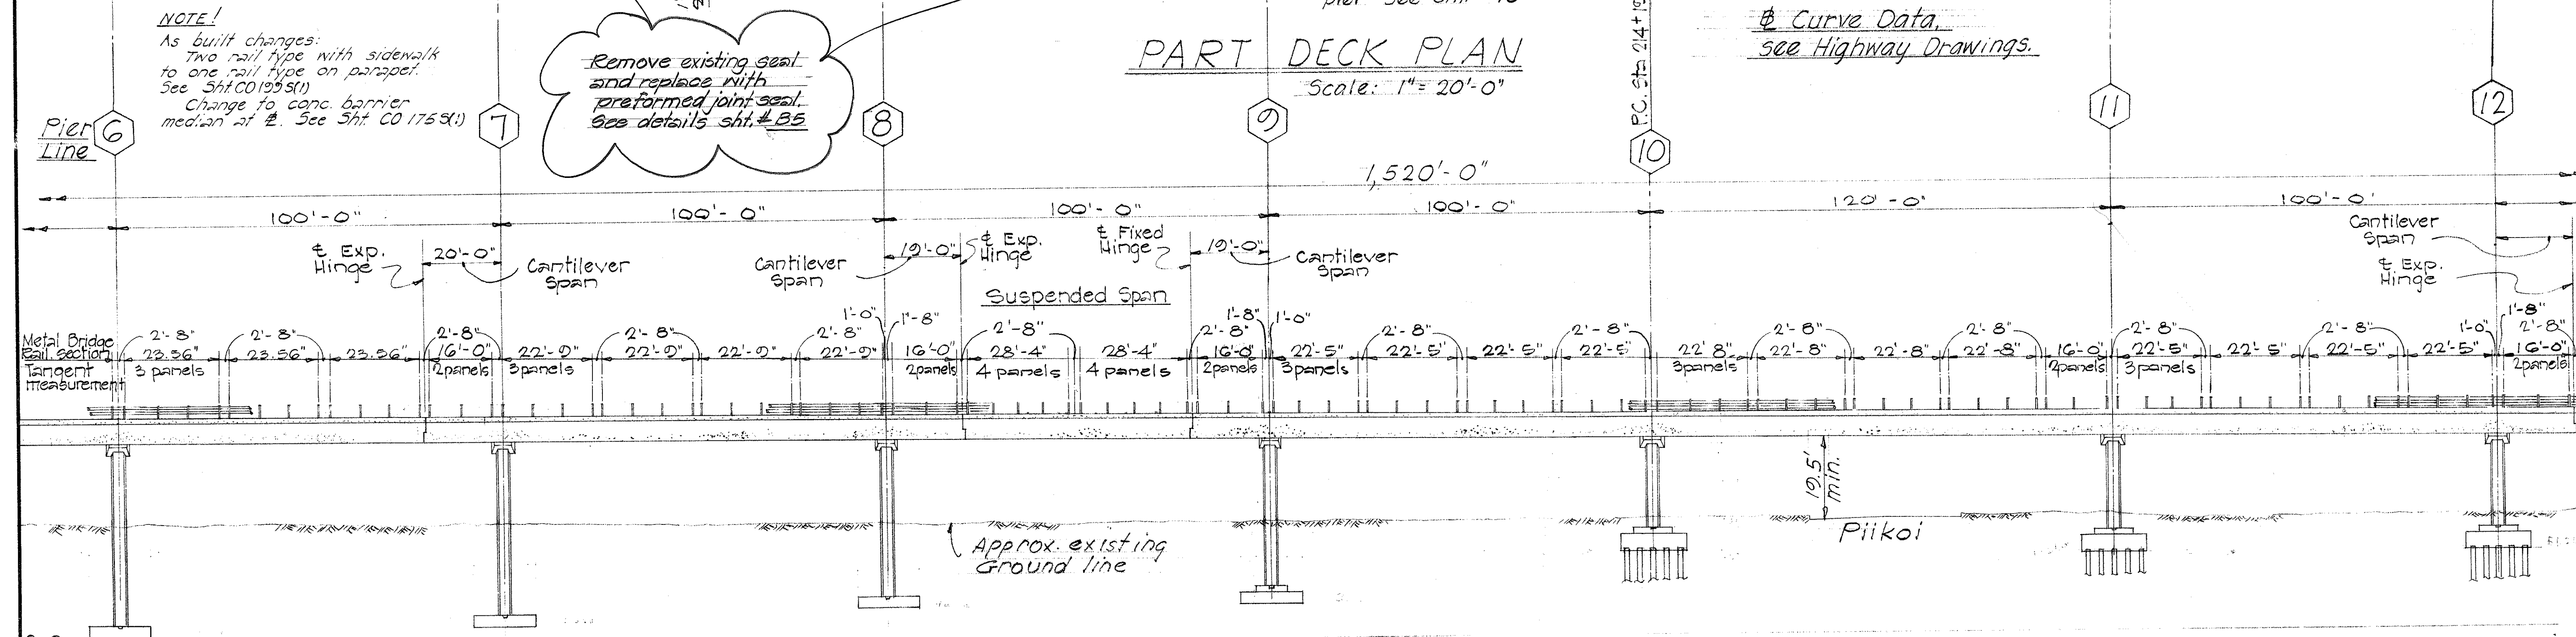

PART ELEVATION SCALE: 1" = 20'-0"


NOTES:
Top of concrete deck to follow finish roadway grades except as otherwise noted on plans.
Superstructure slabs & girders to be constructed on curve where occurs.

ORIGINAL PLAN	DATE
DESIGNED BY	5/1
TRACED BY	5/1
DESIGNED BY	5/1
TRACED BY	5/1
DESIGNED BY	5/1
TRACED BY	5/1

STATE OF HAWAII
DEPARTMENT OF TRANSPORTATION
HIGHWAYS DIVISION
REPAIRS TO PIKOI VIADUCT
INTERSTATE HIGHWAY (LUNALILO FREEWAY)
Proj. No. HI-IR-01-82M
Date: June, 1982
SHEET No. 03 OF 10 SHEETS

STATE OF HAWAII
DEPARTMENT OF TRANSPORTATION
HIGHWAYS DIVISION
VICTORIA TO KEEAUMOKU VIADUCT
PART LAYOUT PLAN
Sta. 204 + 19.09 to Sta. 219 + 40.43
Interstate Route H-1, Lunalilo Freeway
SHEET No. OF SHEETS


FED. ROAD DIST. NO.	STATE	PROJ. NO.	FISCAL YEAR	SHEET NO.	TOTAL SHEETS
HAWAII	HAW.	H1-1K- 01-82M	1982	5	19

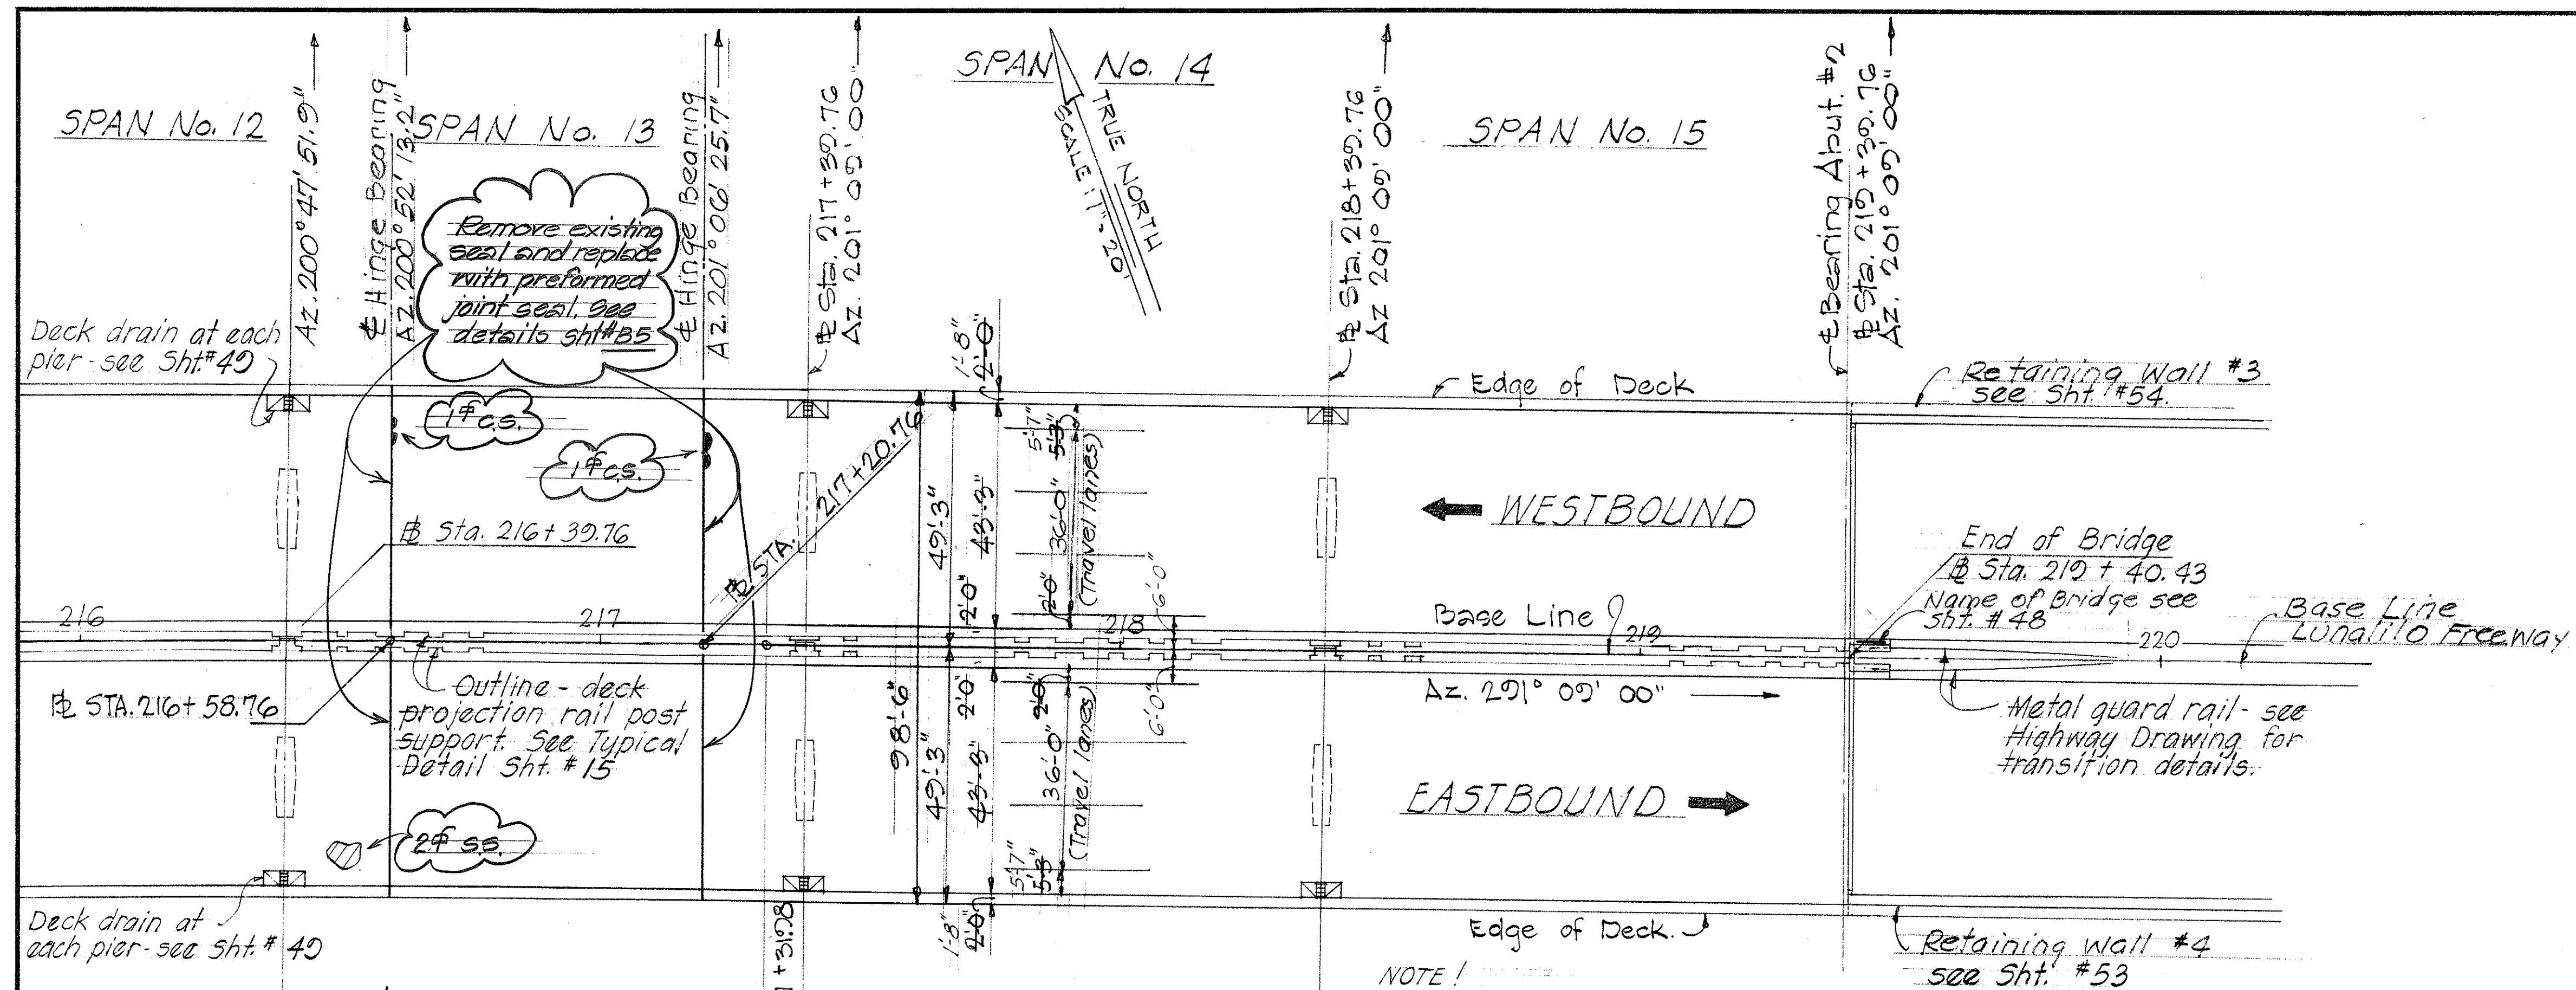

NOTE!
As built changes:
Two rail type with sidewalk
to one rail type on parapet.
See Sht. CO 175.5(1).
Change to conc. barrier
median at #. See Sht. CO 175.5(1).

NOTES:

Top of concrete deck to follow finish roadway grades, except as otherwise noted on plans.
Superstructure slabs & girders to be constructed on curve where occurs.

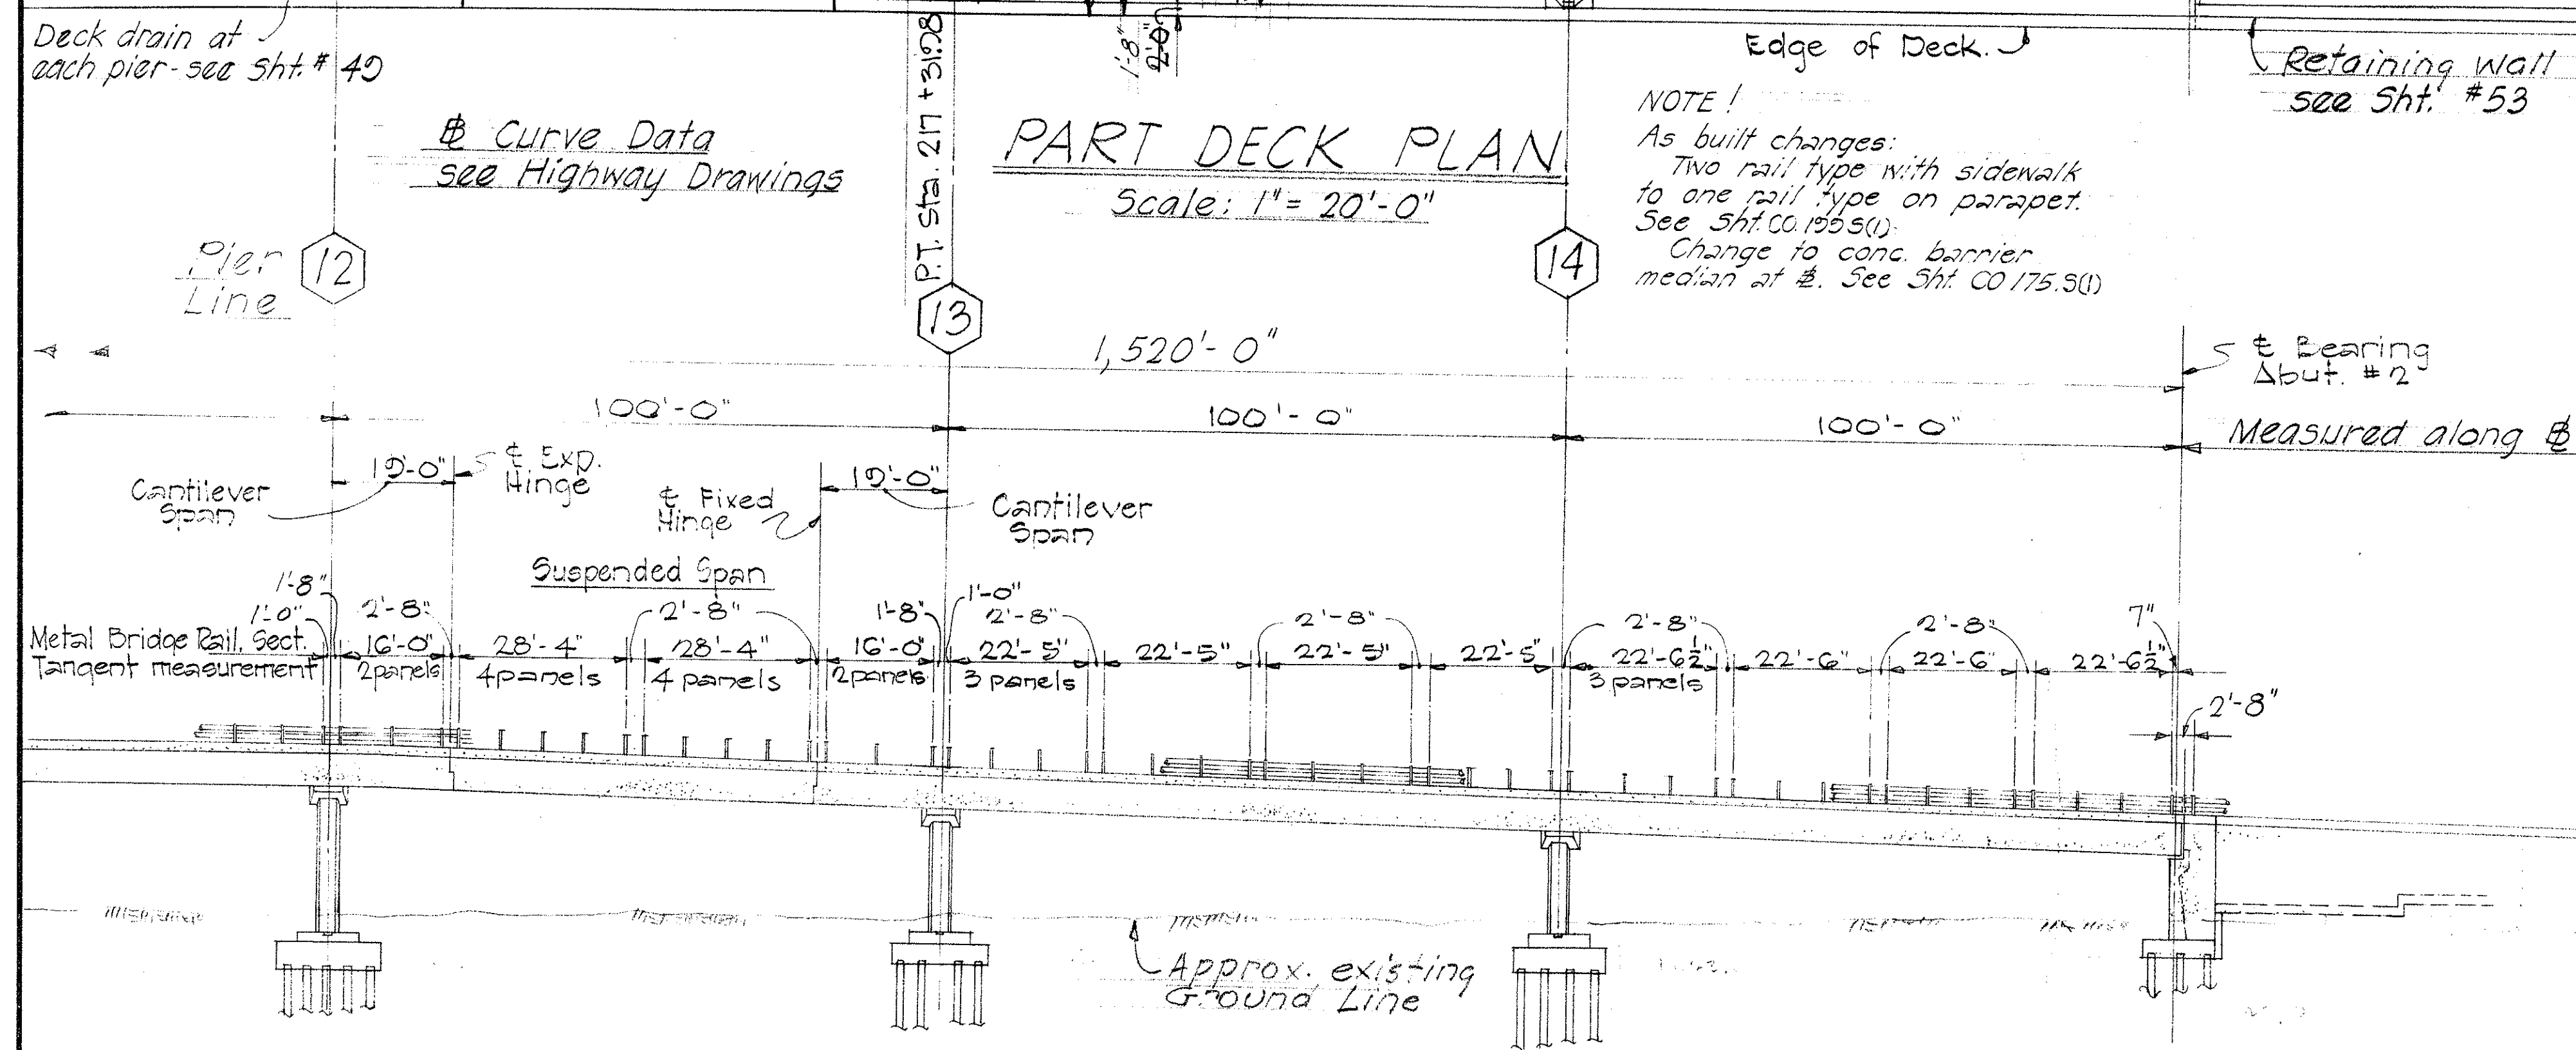

PART ELEVATION

Scale: 1" = 20'-0"

ORIGINAL PLAN	SURVEY PLOTTED BY: <u>SY</u>	DATE: <u>DEC 66</u>
	DRAWN BY: _____	" " " " " "
	TRACED BY: _____	" " " " " "
	DESIGNED BY: <u>DO VC LC</u>	" " " " " "
NOTE BOOK	QUANTITIES BY: _____	" " " " " "
	CHECKED BY: _____	" " " " " "
No. _____	CHECKED BY: <u>PK</u>	" " " " " "
		DATE: <u>FEB 67</u>

PRINTED ON NO. 1000H CLEARPRINT

STATE OF HAWAII
DEPARTMENT OF TRANSPORTATION
HIGHWAYS DIVISION

REPAIRS TO
PIIKOI VIADUCT

INTERSTATE HIGHWAY (LUALILU FREEWAY)
Proj. No. HI-1K-01-82M
Date: June 1982

SHEET No. B4 OF 10 SHEETS

STATE OF HAWAII
DEPARTMENT OF TRANSPORTATION
HIGHWAYS DIVISION

VICTORIA TO KEEAUMOKU VIADUCT
PART LAYOUT PLAN

Sta. 204 + 19.09 to Sta. 219 + 40.43
Interstate Route H-1, Lunalilo Freeway

SHEET No. OF SHEETS

