




FED. ROAD DIST. NO.	STATE	FED. AID PROJ. NO.	FISCAL YEAR	SHEET NO.	TOTAL SHEETS
HAWAII	HAW.	I-HI-1 (178)	1982	17	105

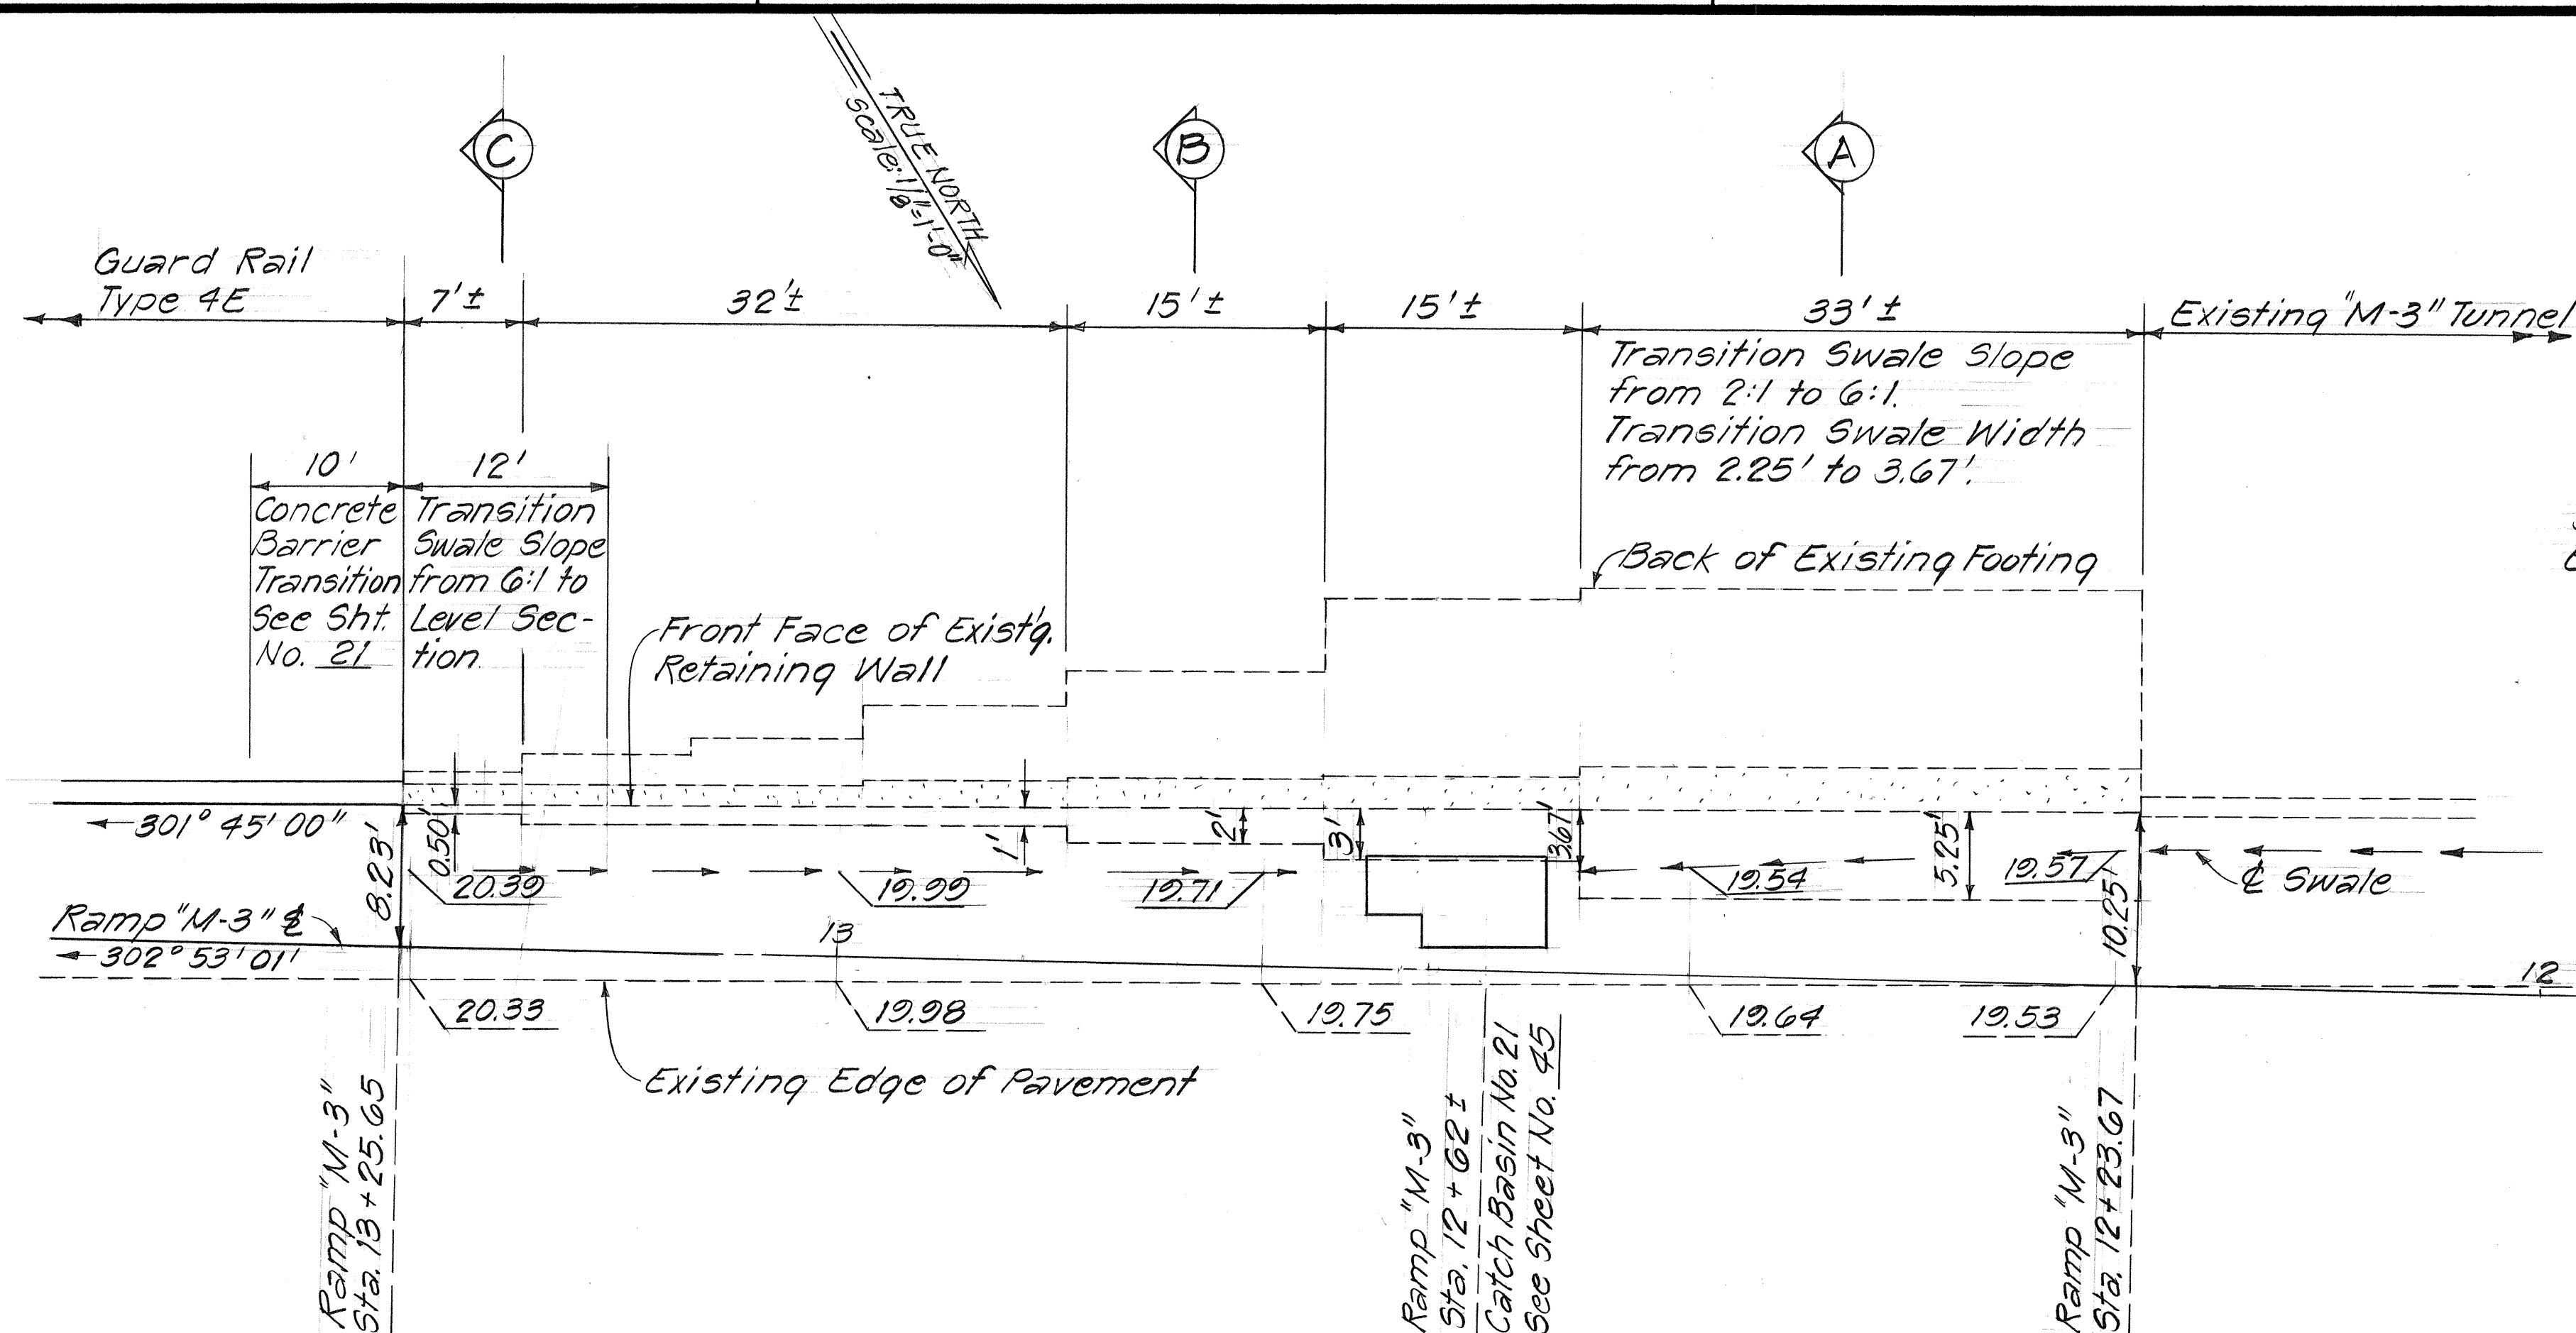


DETAIL PAVING PLAN AT EXISTING RETAINING WALL
RAMP "M-3" STA. 12+23.67 TO RAMP "M-3" STA. 13+25.65
 Scale: 1/8" = 1'-0"

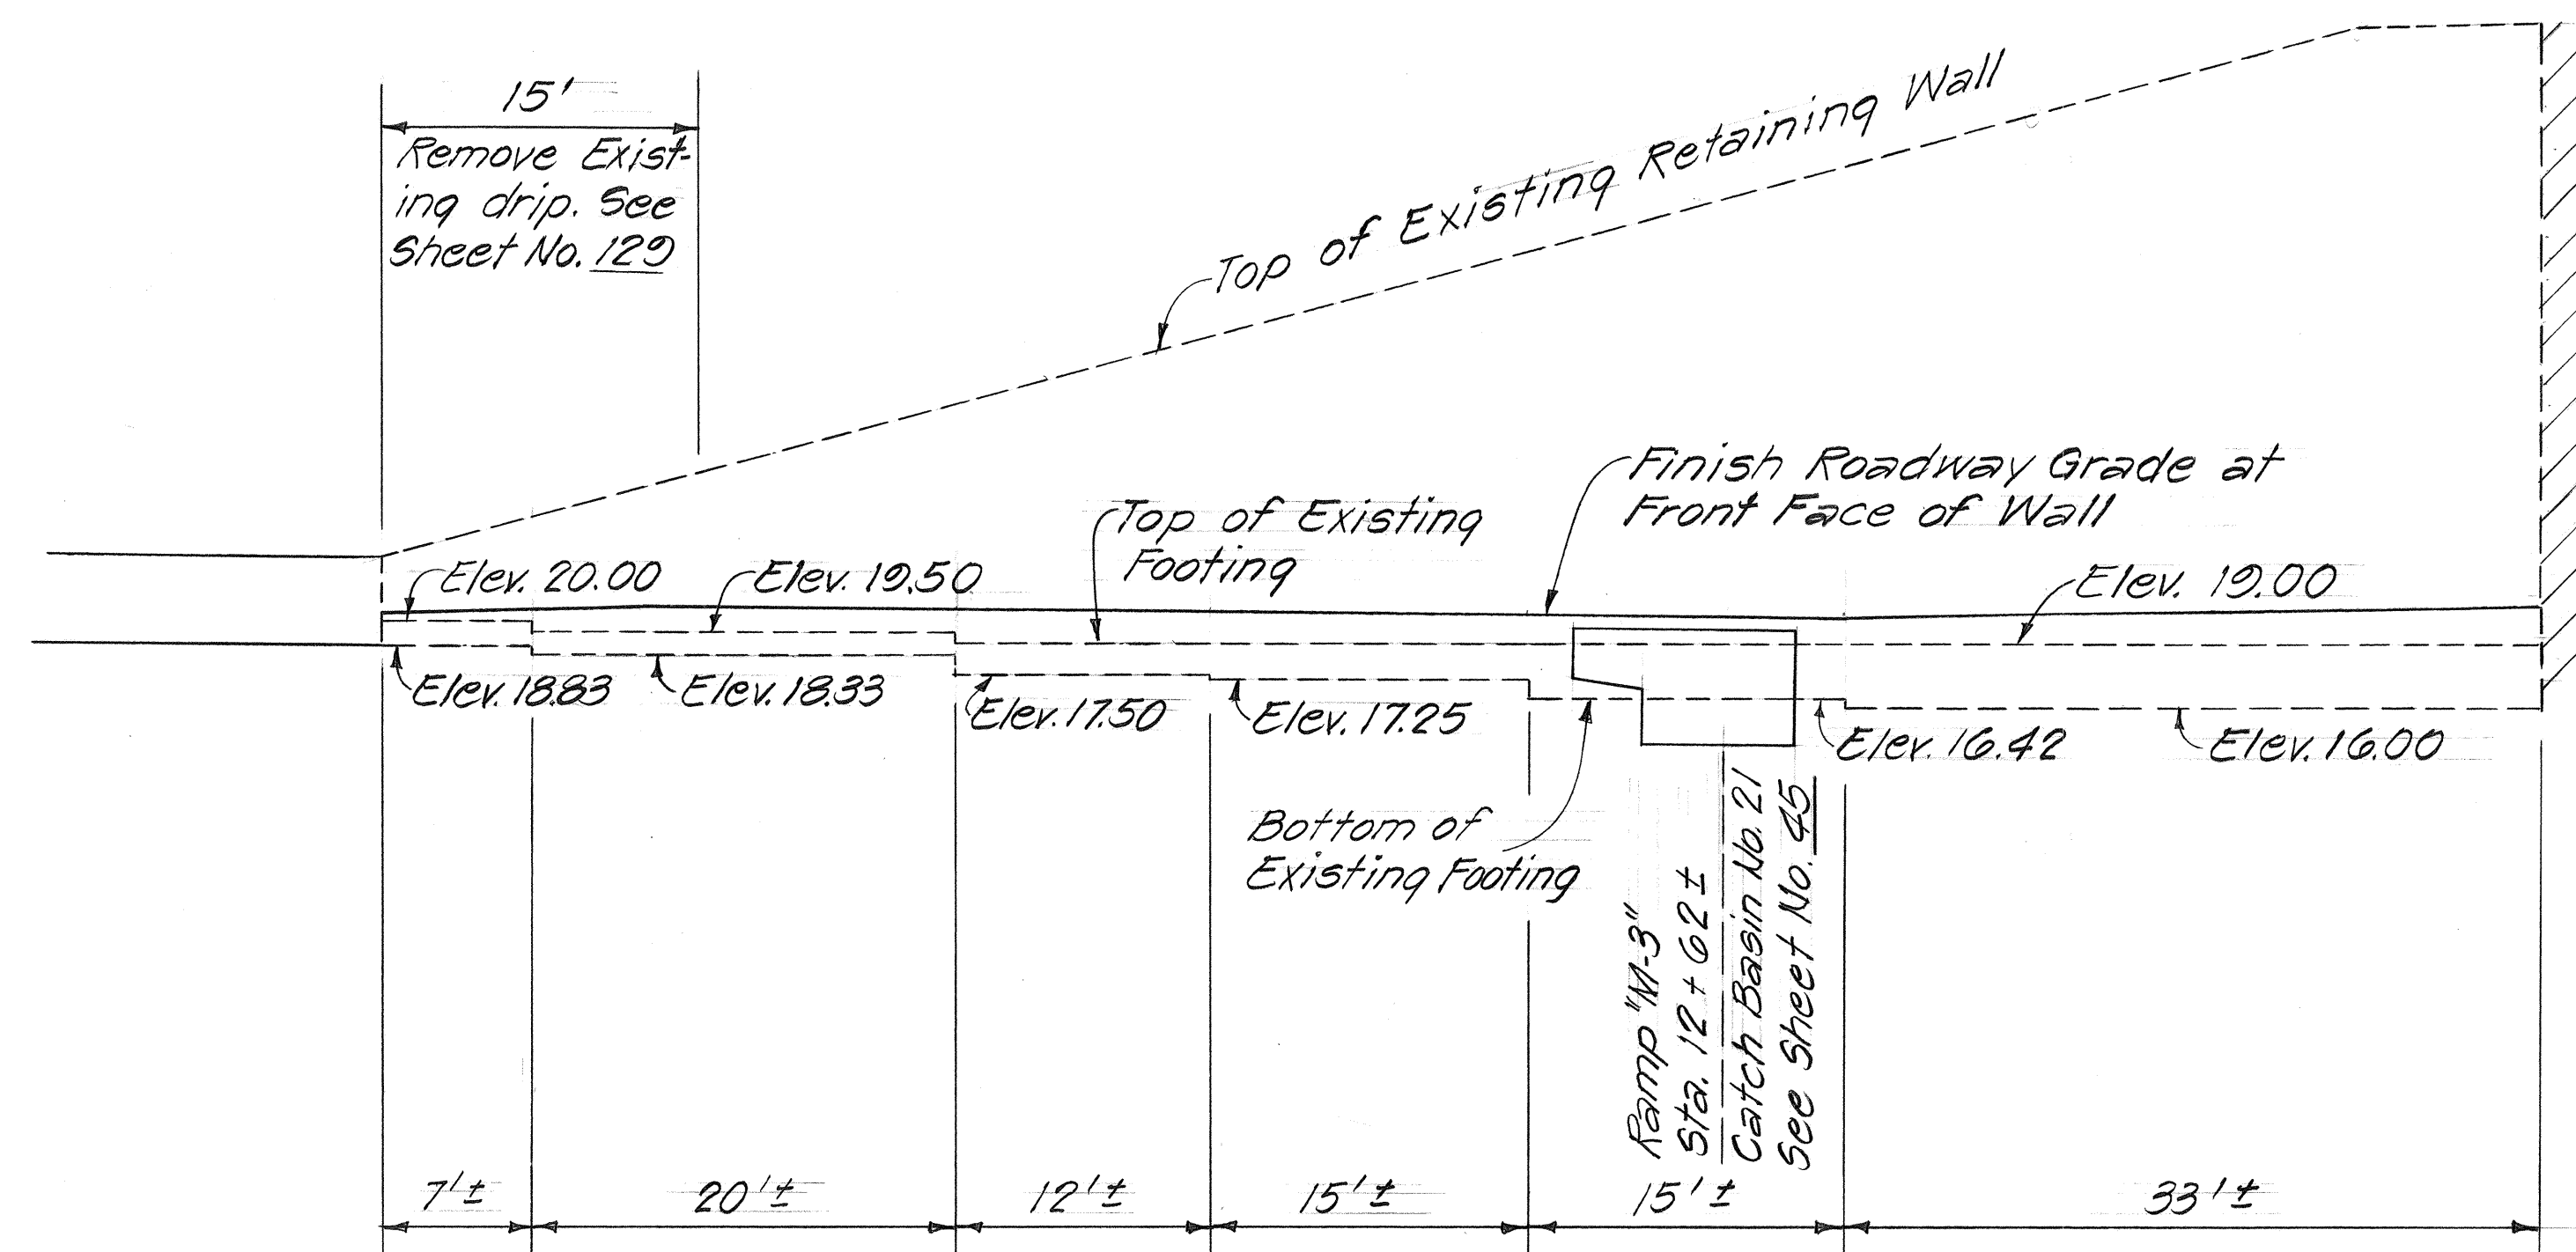


ELEVATION
 Scale: 1/8" = 1'-0"

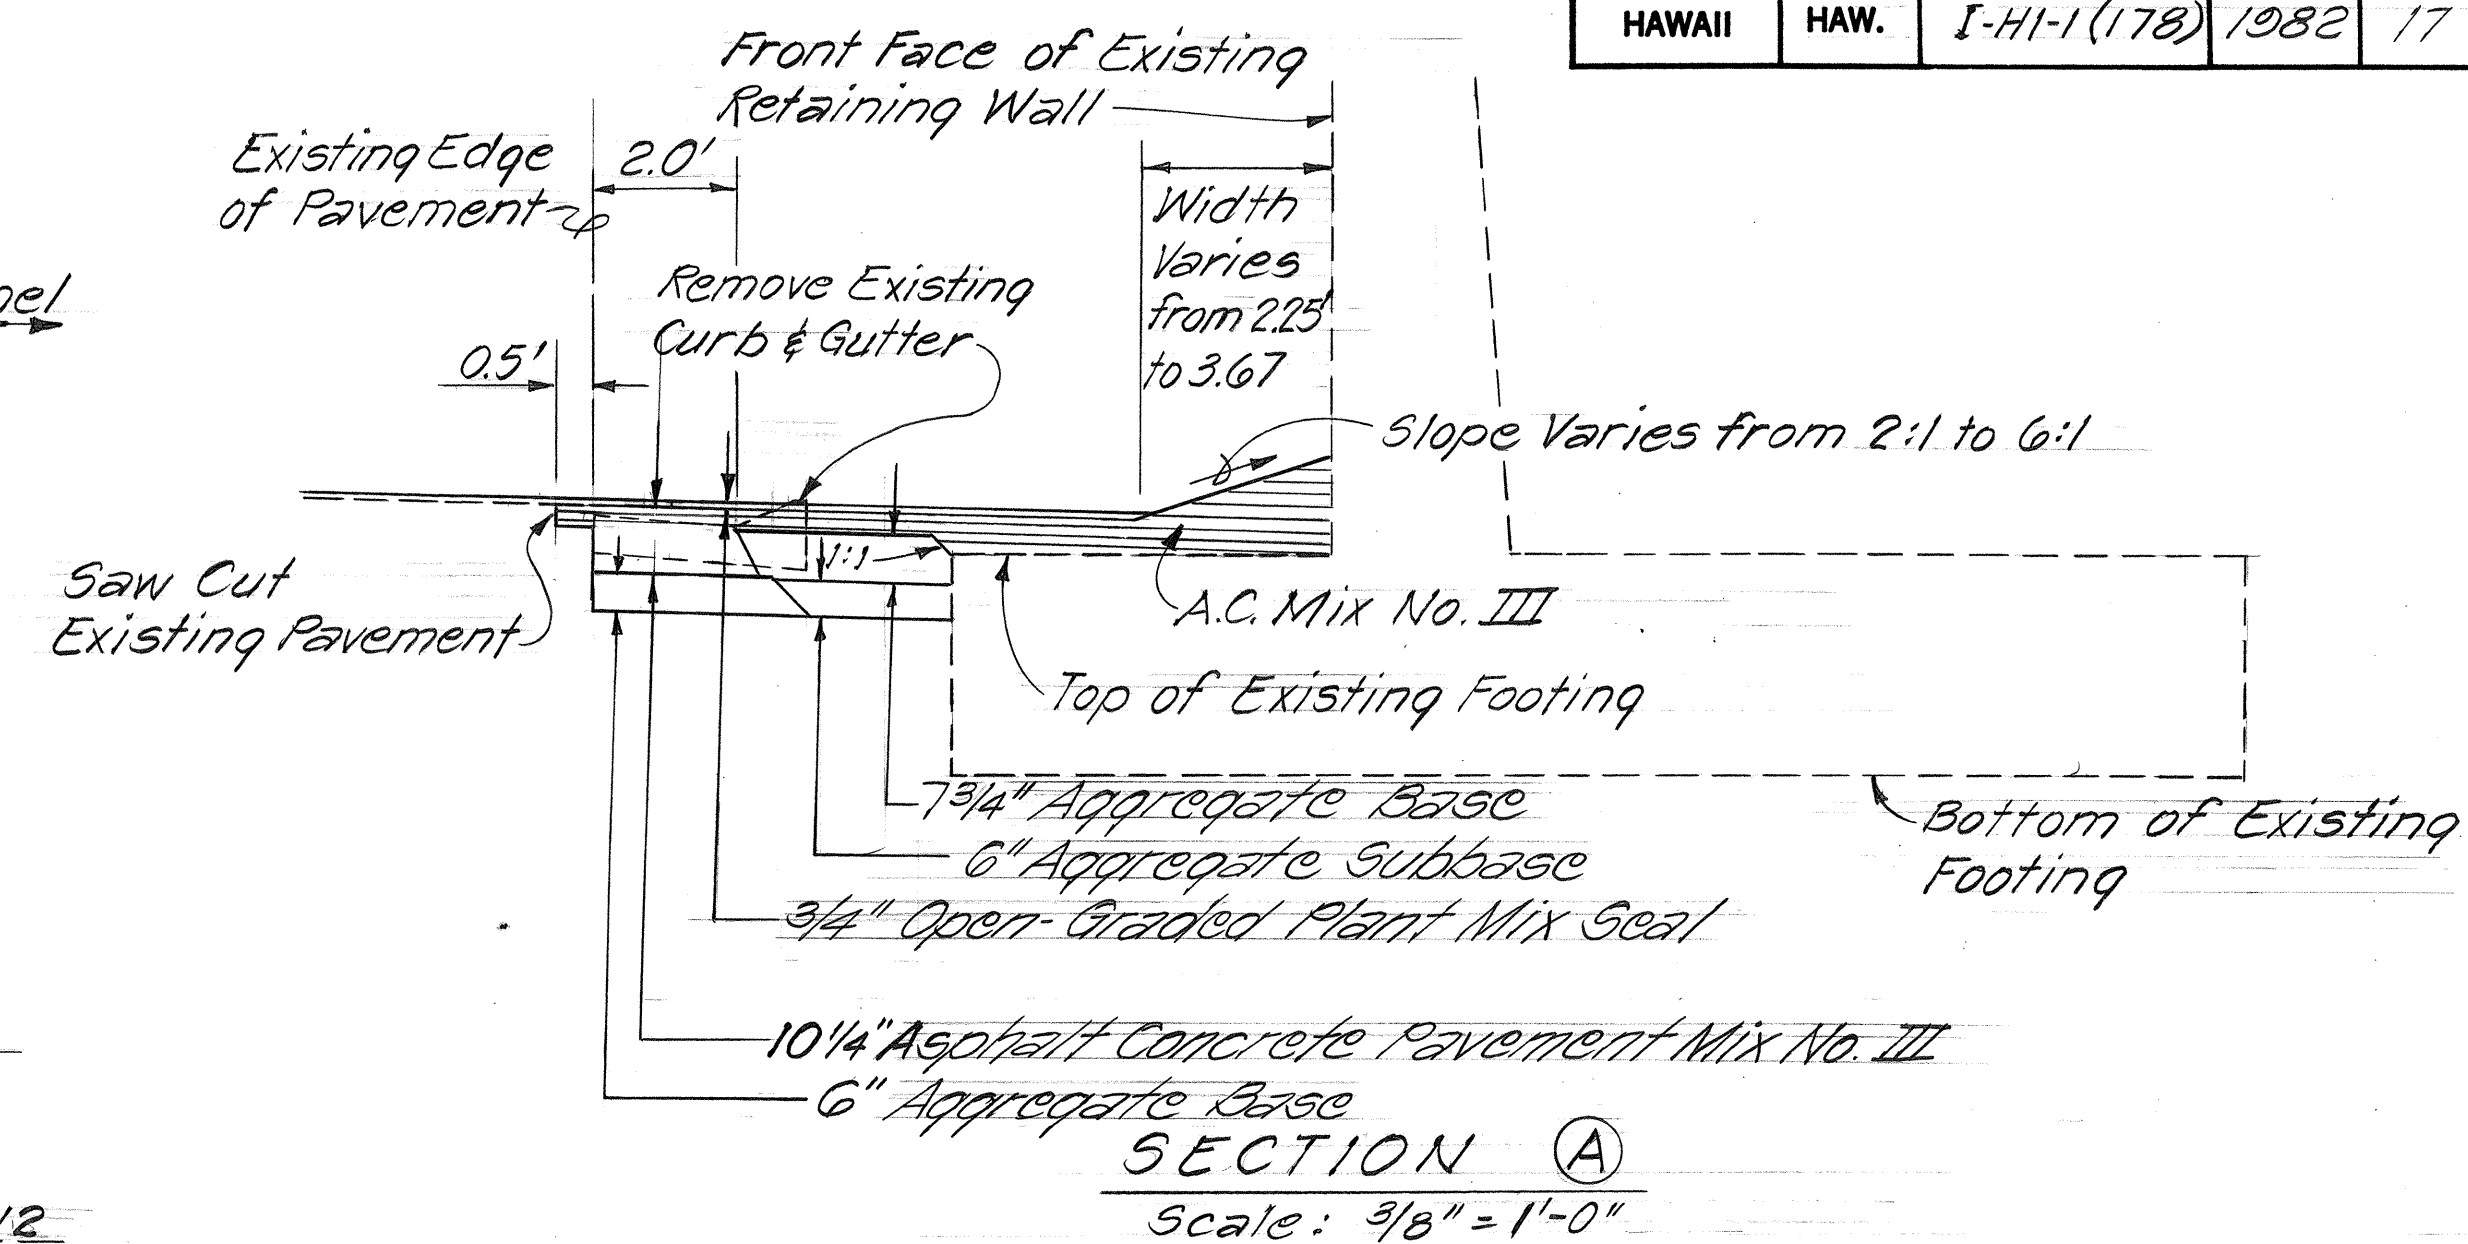

SECTION A
 Scale: 3/8" = 1'-0"

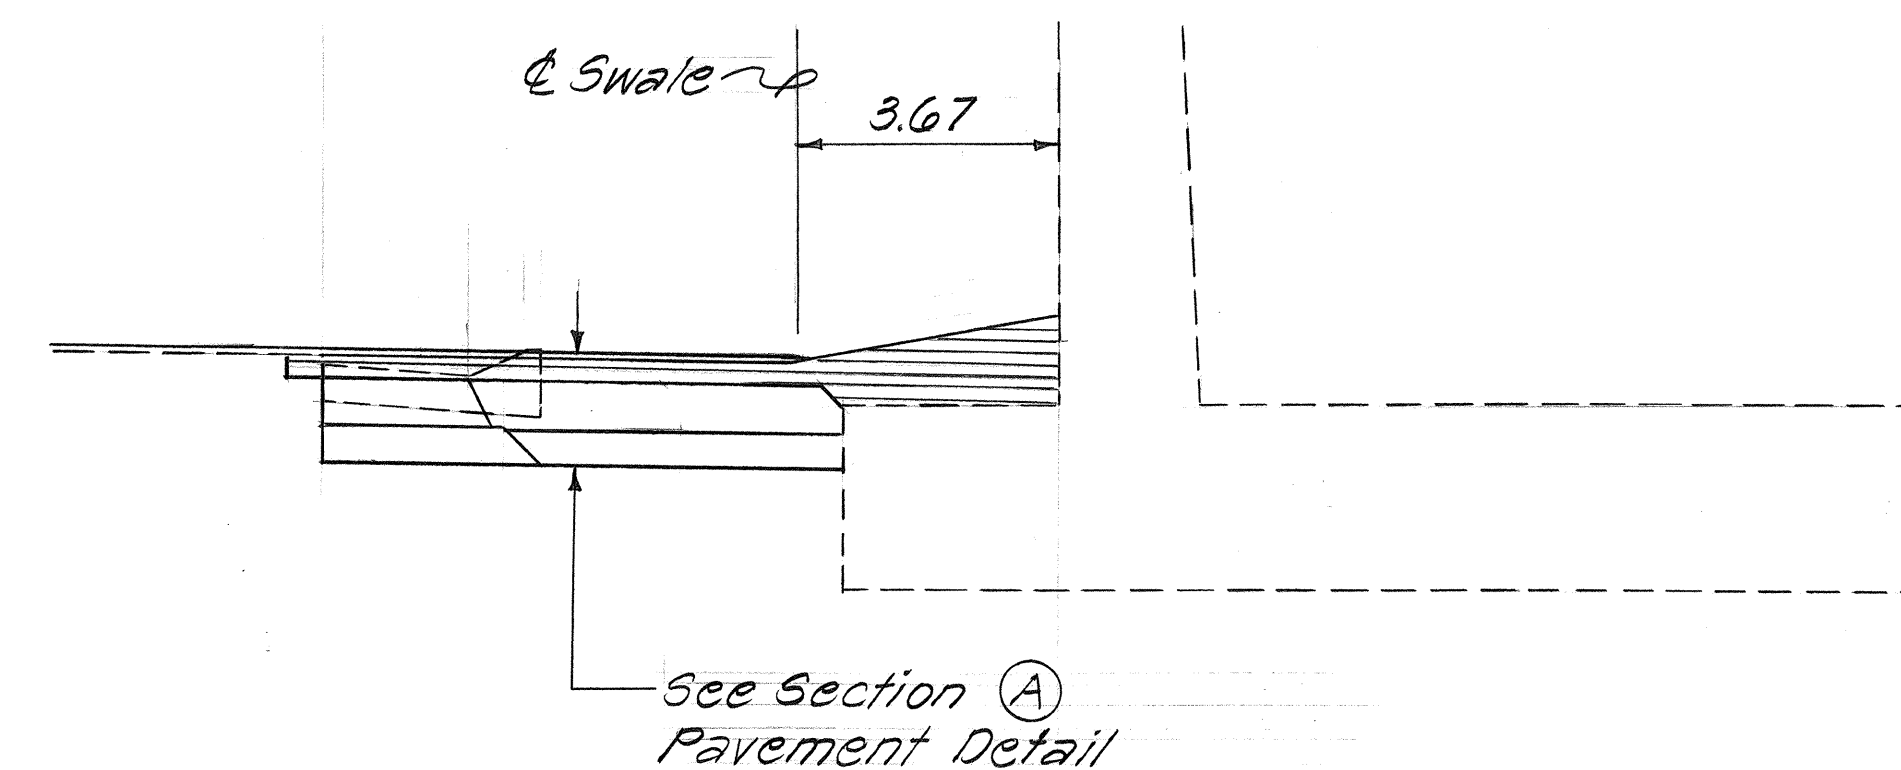

SECTION B
 Scale: 3/8" = 1'-0"

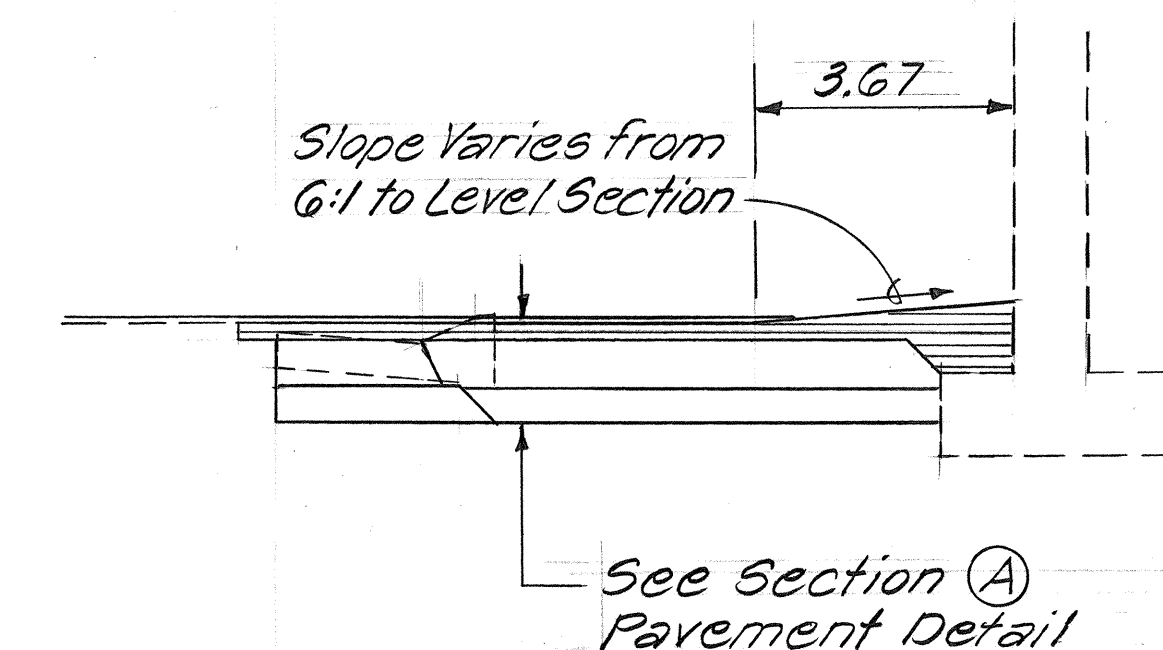

SECTION C
 Scale: 3/8" = 1'-0"

STATE OF HAWAII
 DEPARTMENT OF TRANSPORTATION
 LAND TRANSPORTATION FACILITIES DIVISION

DETAIL PAVING PLAN
 INTERSTATE H-1 IMPROVEMENTS
 MIDDLE STREET TO KALIHI INTERCHANGE
 EASTBOUND LANES
 F.A.I. PROJECT NO. I-HI-1(178)
 Scale: As Shown

SHEET NO. OF SHEETS

ORIGINAL PLAN	SURVEY PLOTTED BY	DATE
NOTE BOOK	DRAWN BY	
	DESIGNED BY	
	QUANTITIES BY	
	CHECKED BY	