

INDEX TO DRAWINGS

GENERAL STRUCTURAL NOTES

FED. ROAD DIST. NO.	STATE	FED. AID PROJ. NO.	FISCAL YEAR	SHEET NO.	TOTAL SHEETS
HAWAII	HAW.	I - HI-1(178)	1982	118	165

SHEET NO.	DESCRIPTION
1	INDEX TO DRAWINGS - GENERAL NOTES
2	LAYOUT PLAN - LONGITUDINAL DECK SECTION - BRIDGE ESTIMATED QUANTITIES
3	ABUTMENT (RIGID FRAME)
4	ABUTMENT ①
5	ABUTMENT ② - NEW WING WALL #4
6	TYPICAL ABUTMENT ① & ② SECTIONS
7	RIGID FRAME - DECK REINF. PLAN & SECTION
8	NORMAL DECK SECTIONS - DECK FRAMING PLAN
9	BEAM "A" & "B", CONC. SEATS, CREEP BLOCK & HINGE DETAILS
10	RETAINING WALL NO. 1 & NO. 2 - LIGHT STANDARD FOR RET. WALL #1
11	RETAINING WALL "M-3" - ESTIMATED QUANTITIES
12	DRIP MODIFICATION @ RAMP "M-3" WALL - TYP. RET. WALL @ GRATED DROP INTAKE
13	RETAINING WALL "K-4" - ESTIMATED QUANTITIES
14	RETAINING WALL "A" - CRM WALL "C" - ESTIMATED QUANTITIES
TD-1	TYPICAL DETAILS - PRESTRESSED GIRDERS TYPE PG IV
TD-2	TYPICAL DETAILS - CONC. BRIDGE RAIL (TRAFFIC TYPE)
TD-3	TYPICAL DETAILS - RETAINING WALL TYPE T-1
TD-4	TYPICAL DETAILS - RETAINING WALL TYPE L-2
TD-5	TYPICAL DETAILS - RETAINING WALL TYPE L-2 - LIGHT STANDARD FOR WALL "M-3" & "K-4"
DB-100	STANDARD DETAILS - NOTES & MISCELLANEOUS DETAILS
DB-207-1	DELETED
DB-207-2	STANDARD DETAILS - RETAINING WALL TYPE T-1

DESIGN SPECIFICATIONS:

AASHTO, Standard Specifications for Highway Bridges (12th edition), including Interim Specifications Bridges, 1978, 1979, 1980 & 1981.

DESIGN LIVE LOAD:

HS-20-44

ALLOWABLE DESIGN STRESSES:

- Reinforced concrete: $f_c = 0.40 f'_c$
- Reinforcing steel: $f_s = 20,000$ psi
- Prestressed concrete: see Typical Detail Sht. #TD1

MATERIALS:

- Reinforced concrete - 4,500 psi (see sht. #2)
 - Class BD (for bridge deck on girders)
 - Class A (all others)
- Reinforcing steel - ASTM A615, Grade 40
- Prestressed concrete - see sht. #TD1
- Admixture in concrete - see Special Provisions

CONSTRUCTION METHODS:

- Refer to Standard Specifications for Road and Bridge Construction (Hawaii 1976) and Special Provisions.
- Refer to Standard Detailed Drawings for additional details not covered by details and typical drawings.
- The Contractor shall verify all grades and dimensions before commencing with any work.
- Except as otherwise noted, all vertical dimensions are measured on the plumb.
- All footings shall be excavated and poured neat against undisturbed ground. In case of over-excavation, the space between the footing and the ground shall be filled with concrete of Class D minimum quality as directed by the Engineer, at the Contractor's expense.
- Excavation for all footings and stems shall be accomplished by maintaining as near a vertical cut as possible, and it shall be the Contractor's responsibility to maintain the stability of the existing roadway prism & adjacent ground thruout the course of work.
- All items designated for removal shall be removed in such a manner as to preclude any damage to the existing structure. Large impacting or vibratory types of equipment will not be permitted in the removal operation, nor in drilling holes for dowels. Small vibratory tools, approved by the Engineer, will be permitted.
- All existing reinforcing that can be incorporated in the new work shall be cleaned and utilized as required in the new work, as directed by the Engineer.
- All existing reinforcing that cannot be incorporated in the new work shall be removed to a minimum depth of 1" beneath finish grade and the resultant depression patched with mortar.
- Unless noted otherwise, all concrete areas left exposed due to the removal of existing concrete shall be ground smooth and grooved to extend the existing roadway grade.
- See Special Provisions for concrete finish. Girder concrete seats and creep blocks shall be poured monolithically with the abutments.
- In general, new finish grade and concrete deck shall be constructed to follow the existing roadway vertical and horizontal curves and grades.
- The 15" sewer line located on Richard Lane shall be exposed and jacketed to the extent of limits shown in the plan, before commencing with the excavation of Abutment #1 footing.
- Backfill behind Abutment #2 of the Kalihi Stream Bridge shall be completely in place before the placement of the girders. Backfill behind the abutment of the rigid frame structure shall not be placed until the concrete in the rigid frame deck has attained a strength of 4,500 psi.
- The Contractor shall shore the existing exterior girder and the exterior portion of the rigid frame slab for contributory dead load and construction loads to minimize deflection. Method of shoring, including calculations and shop drawings, shall be approved by the Engineer.
- All costs involved in maintaining the integrity of the roadway and shoring or bracing shall be incidental to the respective concrete or to concrete in footing, whichever the case may be, and will not be paid for separately.
- The Contractor shall be solely responsible for the protection of the adjacent property, utilities, and existing and new structures from damage due to construction and shall repair any damage at his own expense to the satisfaction of the Engineer. He shall conduct his work in such a manner and provide such temporary shoring or other measures as may be necessary to insure the safety of all concerned.
- The Contractor shall make provisions to close lane adjacent to new deck during concrete pour. The deck pour shall be scheduled to occur during non-peak traffic hours as determined by the Engineer. The lane may be opened after the concrete has attained initial set.

GENERAL NOTES: (cont.)

- The Contractor shall verify the locations of all existing utilities and notify their respective owners before commencing with the work.
- Refer to the "General Water Notes" for work pertaining to water systems (see sht. #18)
- All sewer construction shall be performed in accordance with the City's Standard Specifications, dated May 1975 and the latest Department of Public Works Standard Details, August 1976, current City practices and revised ordinances of Honolulu, 1978, as amended.
- The Contractor shall notify the Division of Wastewater Management 7 days prior to the commencement of work and submit 4 sets of approved construction plans.

SYMBOLS:

- Detail or section designation
 Sht. no. section is cut or detail located  Sht. no. detail is drawn on
- ①, ② - Indicates & bearing at Abut.

REFERENCE PLANS

PLAN SHEET NO.	DESCRIPTION
EB1 to EB4	EXIST. BRIDGE - KALIHI STREAM BRIDGE

GENERAL NOTES:

- All bearing pads and premolded joint fillers shall be incidental to concrete. All items noted incidental will not be paid for separately.
- Concrete jackets and reinforcement for conduits outside of the structure will be paid for under Separate Items.

STATE OF HAWAII
 DEPARTMENT OF TRANSPORTATION
 LAND TRANSPORTATION FACILITIES DIVISION
KALIHI STREAM BRIDGE WIDENING
 INDEX TO DRAWINGS,
 GENERAL NOTES
 INTERSTATE H-1 IMPROVEMENTS
 MIDDLE STREET TO KALIHI INTERCHANGE
 EASTBOUND LANES
 F.A.I. PROJ. NO. I - HI-1(178)
 Scale: As Shown Date: April 1982
 SHEET NO. 1 OF 14 SHEETS

DATE	_____
SURVEY PLOTTED BY	_____
DRAWN BY	_____
TRACED BY	_____
DESIGNED BY	_____
QUANTITIES BY	_____
CHECKED BY	_____
ORIGINAL PLAN	_____
NOTE BOOK	_____
No.	_____

FED. ROAD DIST. NO.	STATE	FED. AID PROJ. NO.	FISCAL YEAR	SHEET NO.	TOTAL SHEETS
HAWAII	HAW.	I-HI-1(178)	1982	119	165


CURVE DATA	
Δ	38°06'20"
R	4,000.00'
T	1,381.43'
Lc	2,660.27'

ESTIMATED QUANTITIES


BRIDGE WIDENING

ITEM NO.	ITEM	UNIT	QUANTITY
202.0440	REMOVAL OF PORTION OF KALIHI STREAM BRIDGE	L.S.	43 C.Y.
206.6100	STRUCTURAL EXCAVATION FOR KALIHI STREAM BRIDGE	C.Y.	148 C.Y.
206.7201	STRUCTURAL BACKFILL FOR BR. ABUTS & W.W. #4	C.Y.	87 C.Y.
206.8200	FILTER MATERIAL FOR STRUCTURES	C.Y.	9 C.Y.
503.1090	CONCRETE IN KALIHI STREAM BRIDGE	L.S.	97 C.Y.
503.1091	CONCRETE IN FOOTINGS FOR KALIHI STREAM BRIDGE	L.S.	27 C.Y.
503.1095	DRILLED HOLES FOR 3/4" EXPANSION SHIELD	EA.	47 EA.
503.1096	2" ϕ DRILLED HOLES FOR DOWELS	EA.	84 EA.
504.4100	TYPE IV PRESTRESSED CONCRETE GIRDERS	L.S.	173 L.F.
507.5010	CONCRETE BRIDGE RAILING	L.F.	147 L.F.
602.0900	REINFORCING STEEL IN KALIHI STREAM BRIDGE	L.S.	16,570 LBS.
203.0300	ROCK EMBANKMENT AT KALIHI STREAM BRIDGE	C.Y.	36 C.Y.
401.0300	A.C. PAVEMENT, MIX NO. III	TON	19 TONS
407.1000	EMULSIFIED ASPHALT FOR BITUMINOUS TACK COAT	GAL.	53 GAL.
508.0100	CEMENT RUBBLE MASONRY	C.Y.	13 C.Y.

- NOTES:
- Item no. 202.0440 includes, but is not limited to, rail & parapet, sidewalk, abutment, retaining wall, & footing.
 - Item nos. 401.0300 & 407.1000 will be paid under Highway Item.
 - Item no. 508.0100 includes the reconstruction of the stream wall.

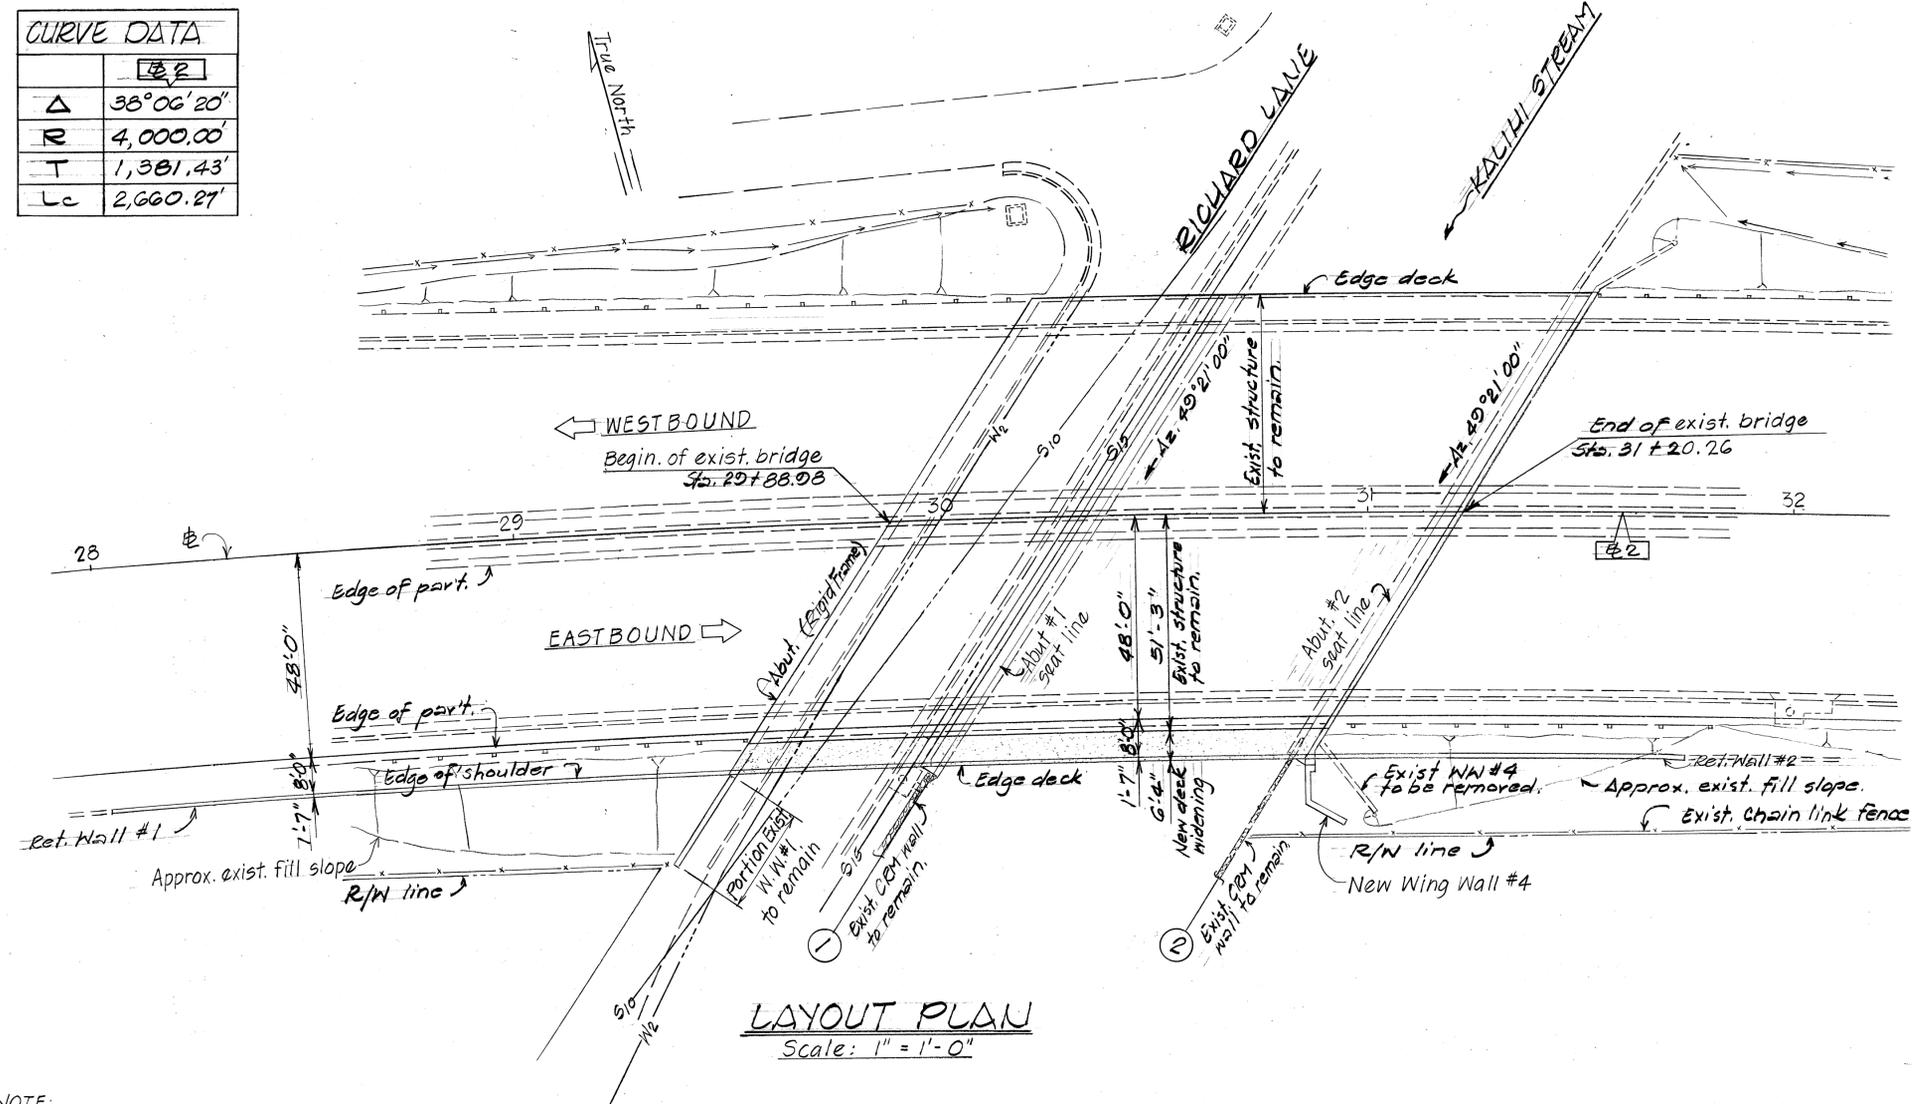

NOTE:
 Indicates concrete of 28 day compressive strength of 4,500 psi

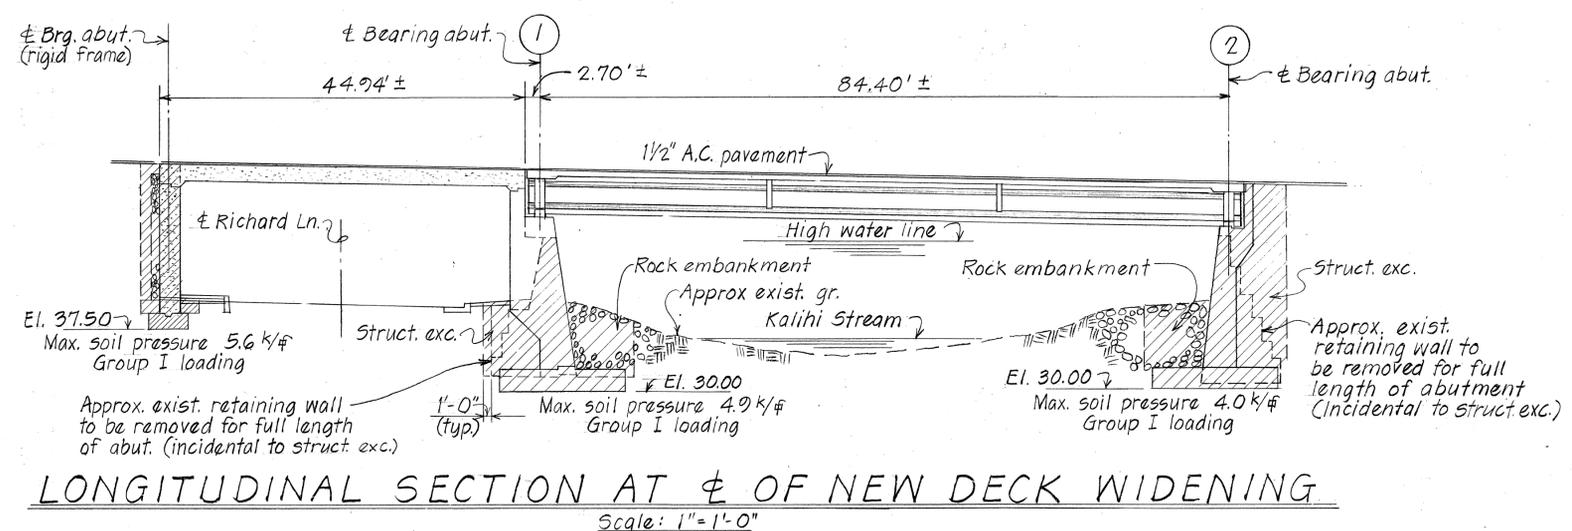


STATE OF HAWAII
DEPARTMENT OF TRANSPORTATION
LAND TRANSPORTATION FACILITIES DIVISION
KALIHI STREAM BRIDGE WIDENING
LAYOUT PLAN & LONGITUDINAL SECTION
INTERSTATE H-1 IMPROVEMENTS
MIDDLE STREET TO KALIHI INTERCHANGE
EASTBOUND LANES
F.A.I. PROJ. NO. I-HI-1(178)
Scale: As Shown Date: April 1982


SHEET No. 2 OF 14 SHEETS

SURVEY PLOTTED BY	DATE
DESIGNED BY	APR 82
DESIGNED BY	APR 82
QUANTITIES BY	APR 82
CHECKED BY	APR 82
NO.	


FED. ROAD DIST. NO.	STATE	FED. AID PROJ. NO.	FISCAL YEAR	SHEET NO.	TOTAL SHEETS
HAWAII	HAW.	I-HI-1(178)	1982	120	165

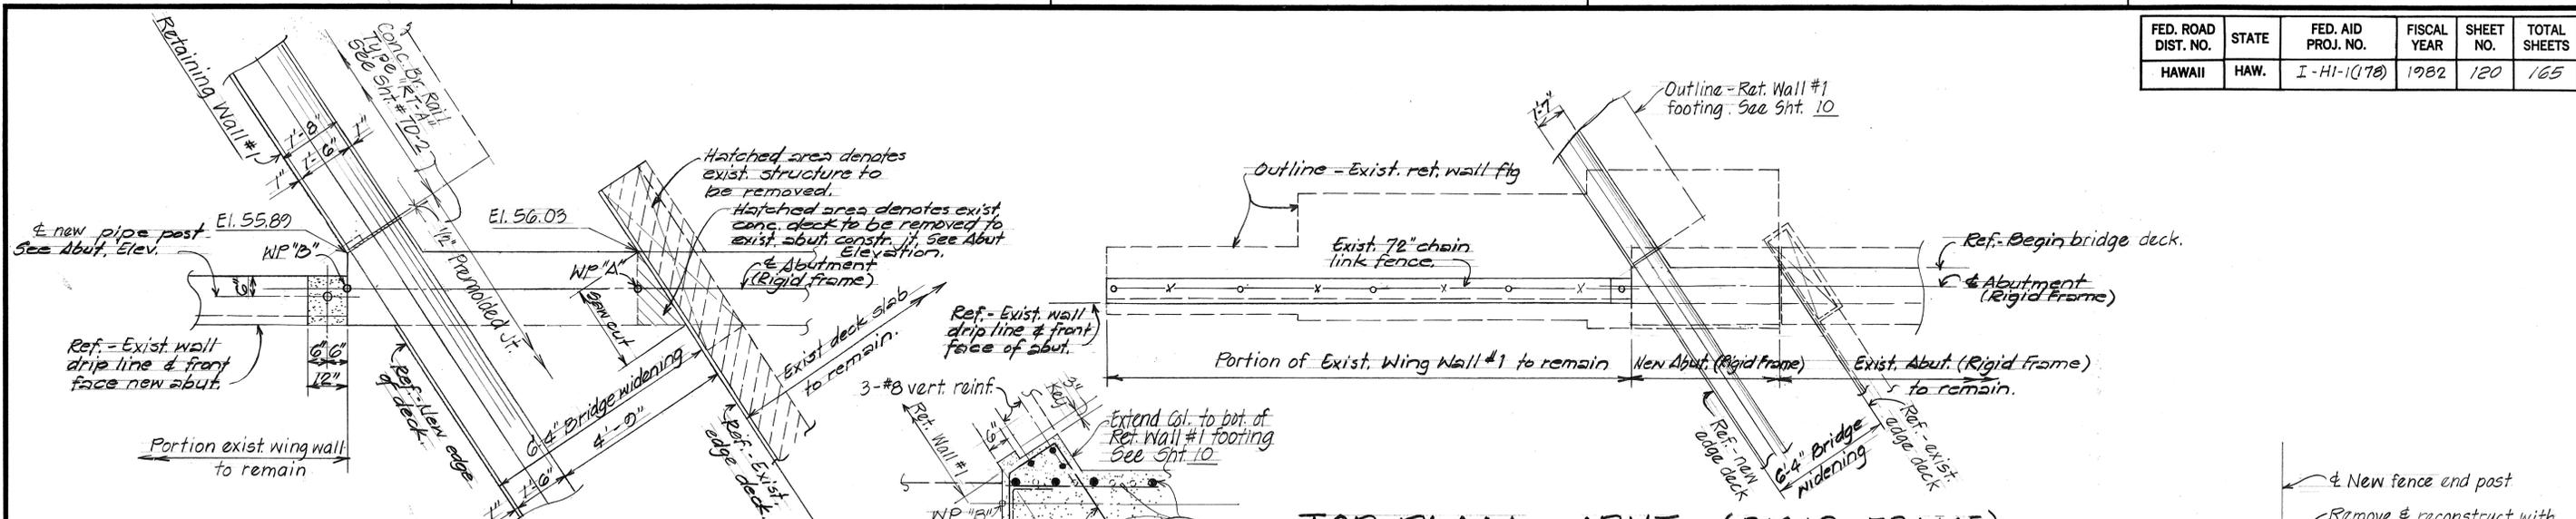


TOP PLAN - ABUT. (RIGID FRAME)
Scale: 1/4" = 1'-0"

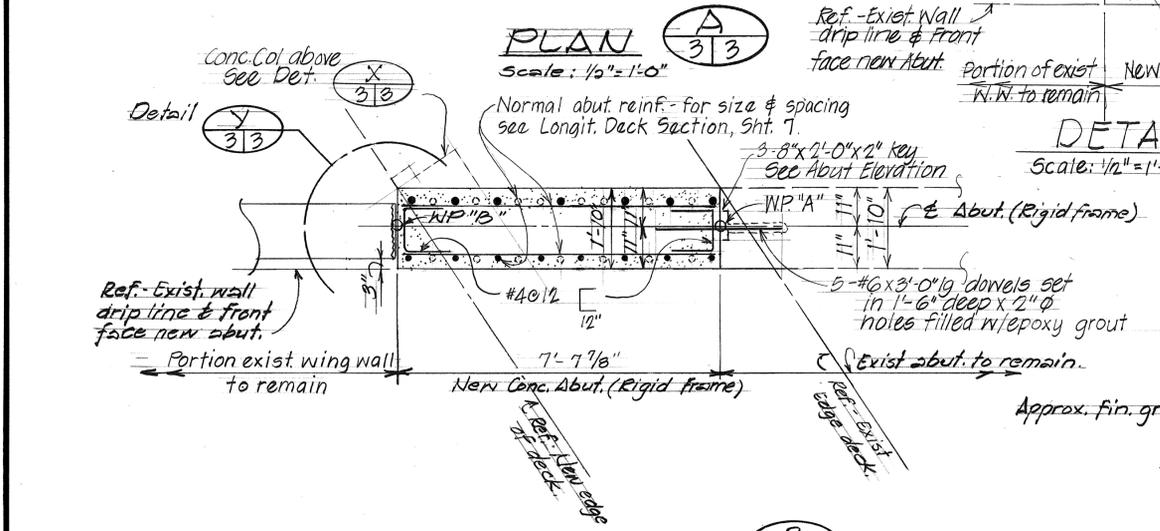

SECTION B-3
Scale: 1/2" = 1'-0"

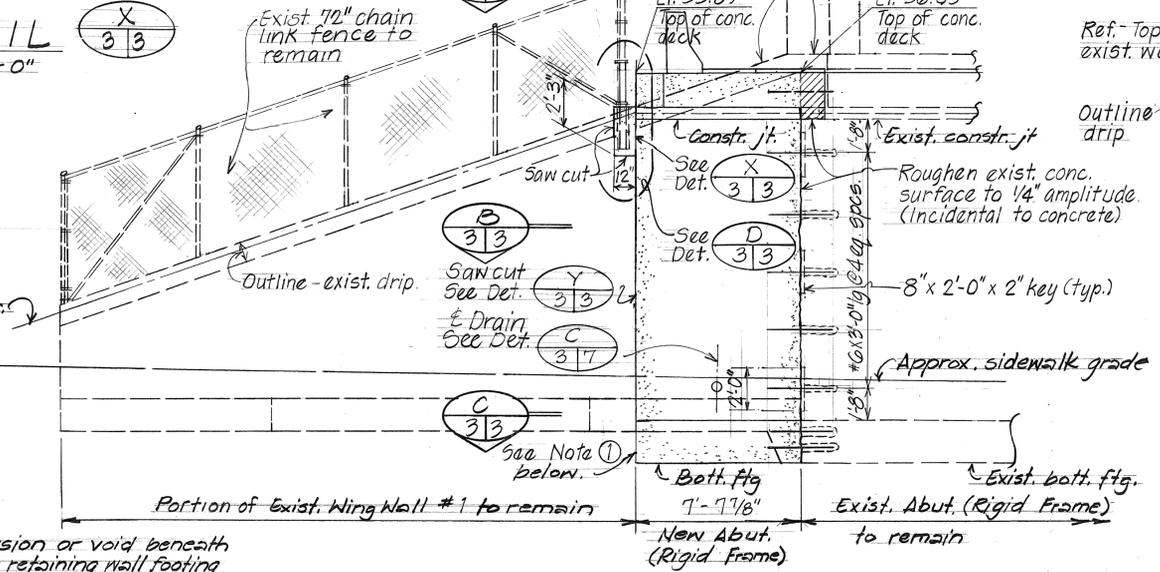


ELEVATION - ABUT. (RIGID FRAME)
Scale: 1/4" = 1'-0"

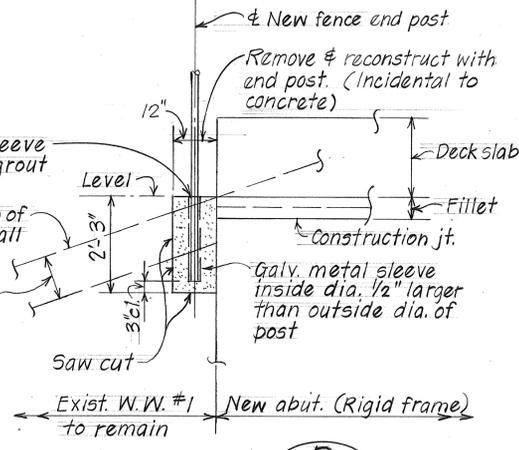


DETAIL D-3/3
Scale: 1/2" = 1'-0"

NOTE:
① Any depression or void beneath the existing retaining wall footing caused by the adjacent excavation shall be filled with a minimum of Class "D" concrete, to a true vertical plane at the Contractor's expense.

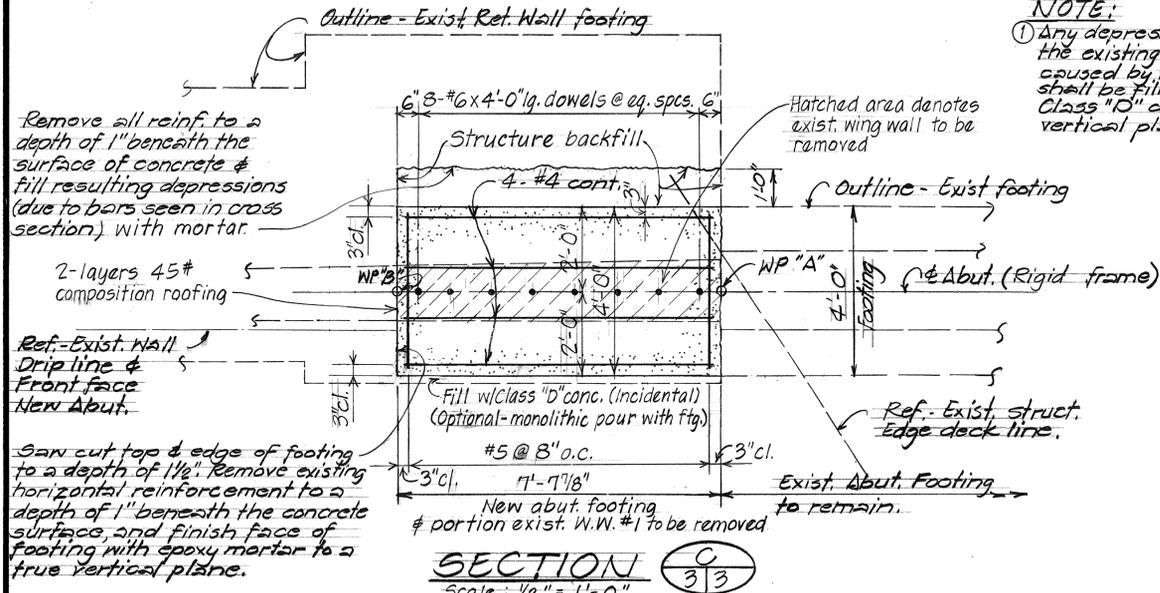

SECTION C-3
Scale: 1/2" = 1'-0"

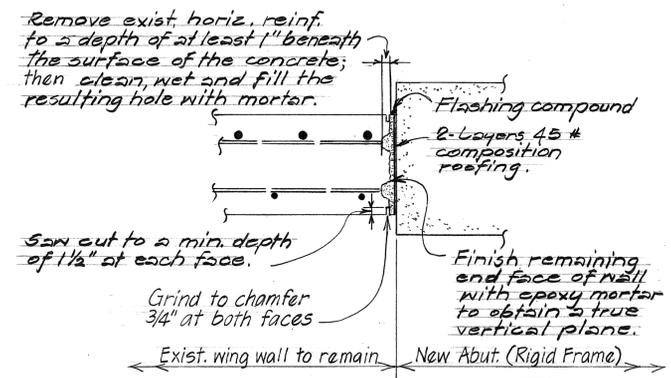


DETAIL Y-3/3
Not to Scale

DATE	2/17/82
SURVEY PLOTTED BY	S.Y.
DESIGNED BY	M.M.Y.
NOTE BOOK	QUANTITIES BY
CHECKED BY	APR. 82

STATE OF HAWAII
DEPARTMENT OF TRANSPORTATION
LAND TRANSPORTATION FACILITIES DIVISION
KALIHI STREAM BRIDGE WIDENING
ABUTMENT - RIGID FRAME
INTERSTATE HI IMPROVEMENTS
MIDDLE STREET TO KALIHI INTERCHANGE
EASTBOUND LANES
F.A.I. PROJECT NO. I-HI-1(178)
Scale: As shown Date: April 1982
SHEET NO. 3 OF 14 SHEETS


FED. ROAD DIST. NO.	STATE	FED. AID PROJ. NO.	FISCAL YEAR	SHEET NO.	TOTAL SHEETS
HAWAII	HAW.	I-HI-1(178)	1982	121	165

NOTE: 1. Bridge deck & superstructure not shown.
2. For conc. seat & creep block details see Sht. 2.

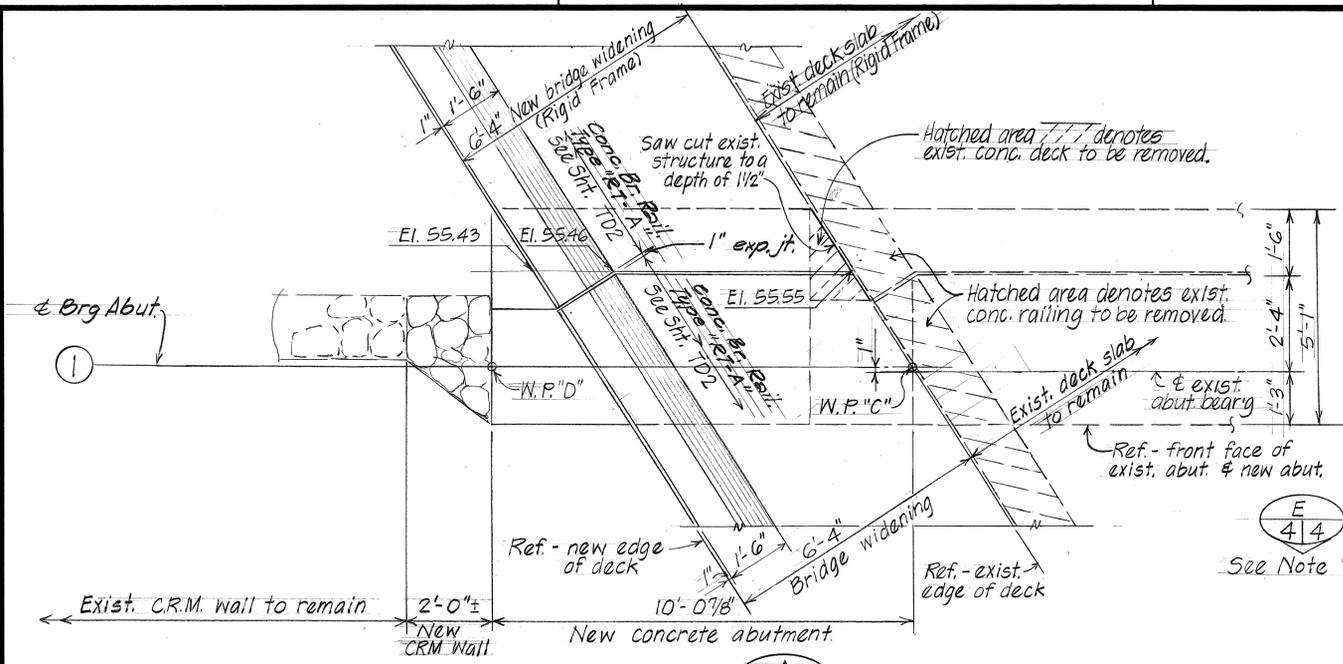


SECTION A-4-4 Scale: 1/2" = 1'-0"


Hatched area denotes exist. structure to be removed to top of new abut. shelf. Exist. reinf. at permanently exposed surfaces shall be removed to a depth of 1" and resulting hole filled w/ mortar.

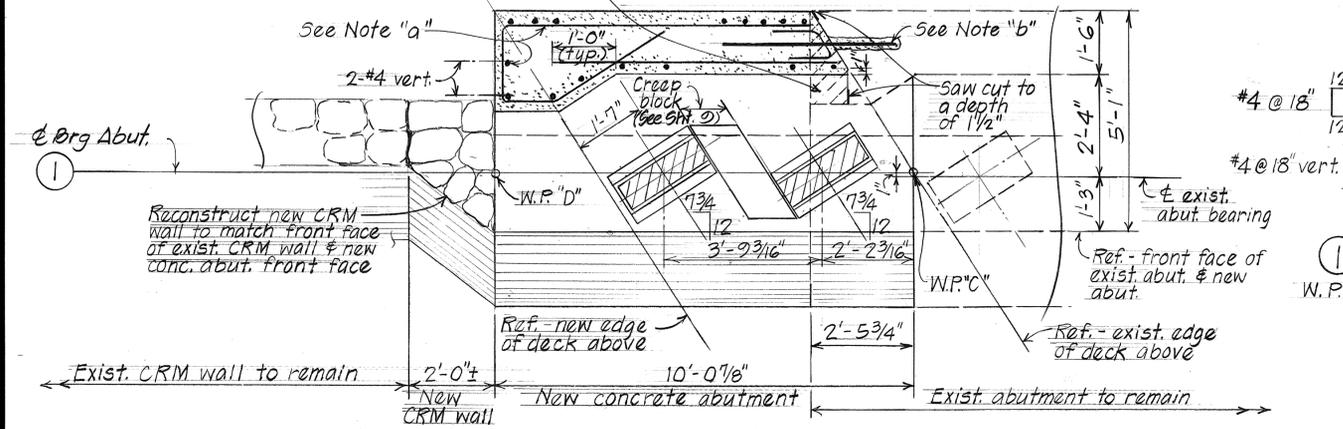


SECTION B-4-4 Scale: 1/2" = 1'-0"

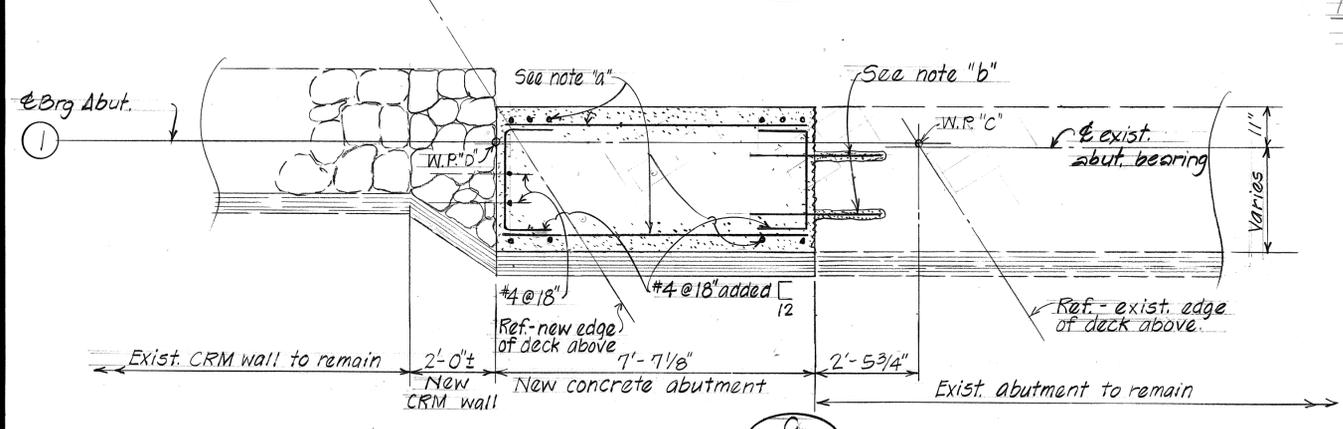

SECTION C-4-4 Scale: 1/2" = 1'-0"

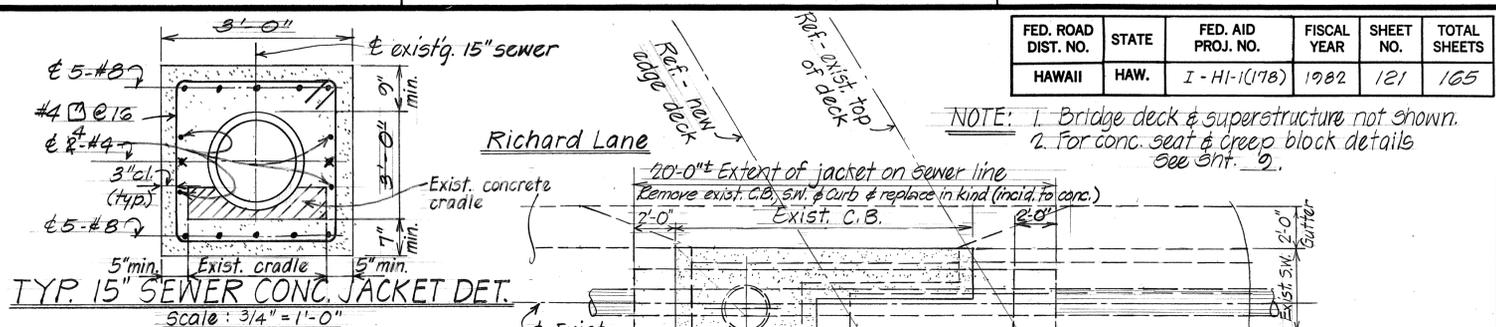


NOTE: See General Notes before construction of concrete jacket at sewer line.

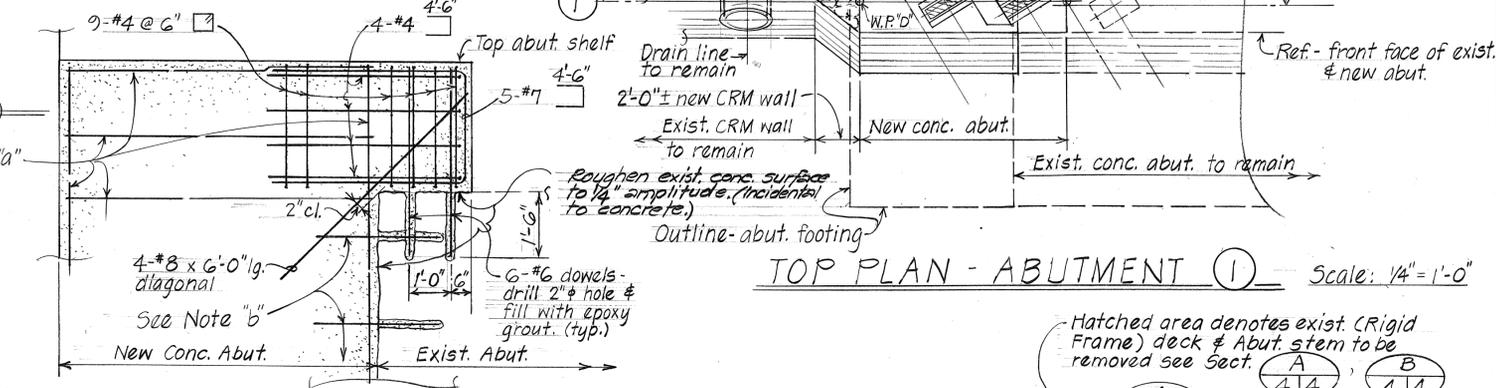

TOP PLAN - ABUTMENT 1 Scale: 1/4" = 1'-0"




DETAIL D-4-4 Scale: 1/2" = 1'-0"

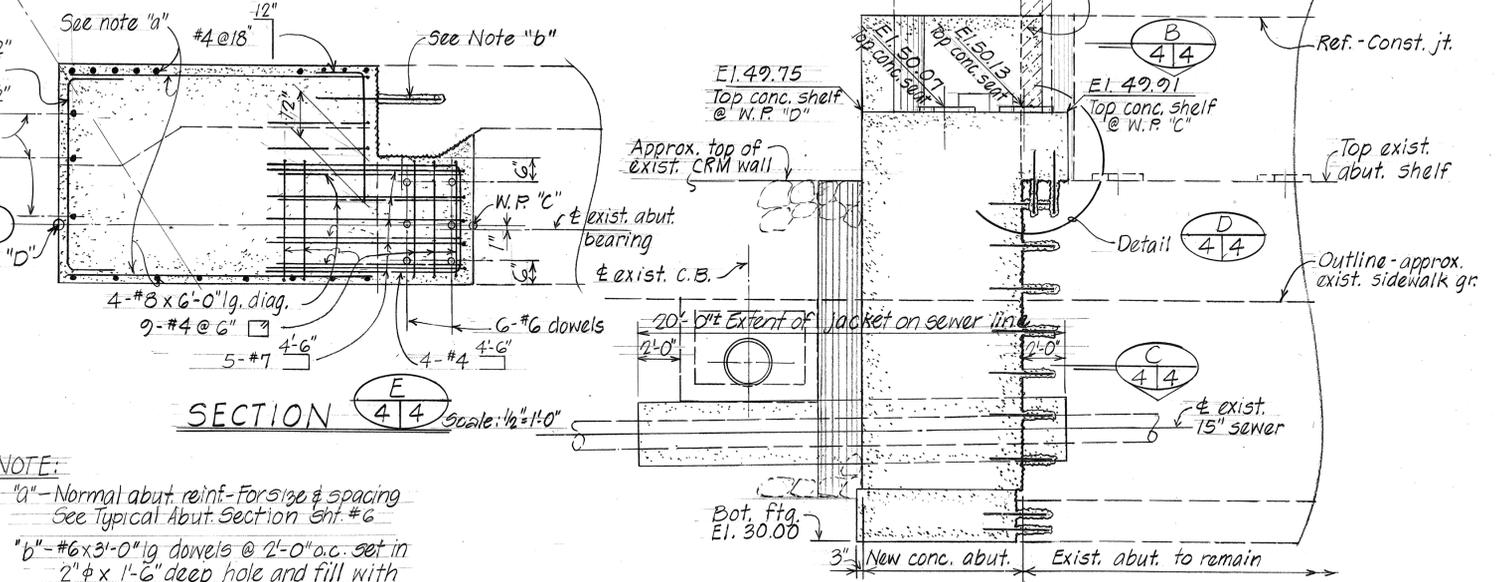

SECTION E-4-4 Scale: 1/2" = 1'-0"

NOTE:
"a" - Normal abut. reinf. - For size & spacing See Typical Abut. Section Sht. #6
"b" - #6 x 3'-0" lg. dowels @ 2'-0" o.c. set in 2" x 1'-6" deep hole and fill with epoxy grout.

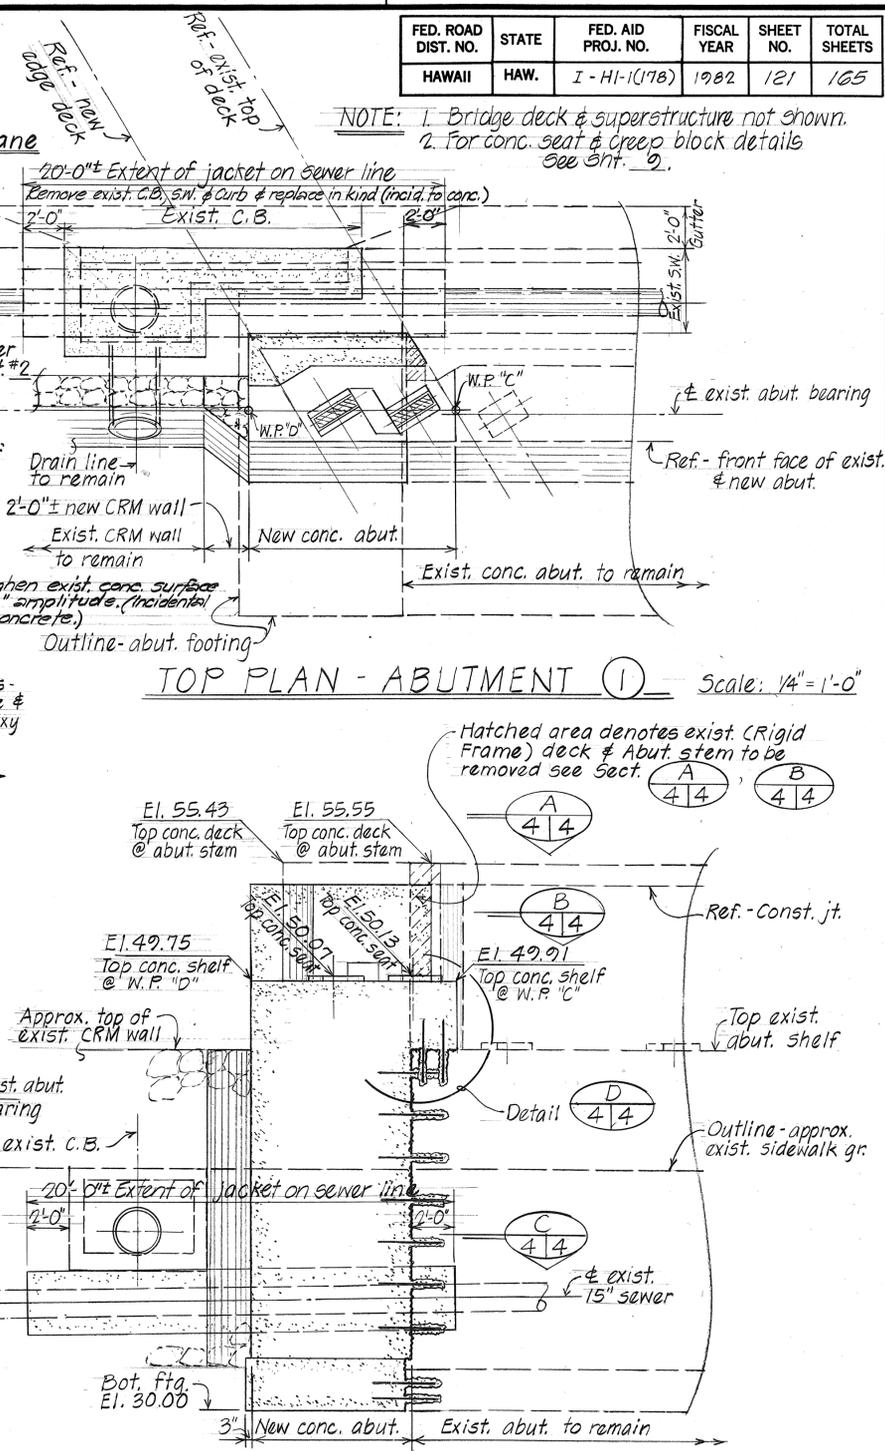


ELEVATION - ABUTMENT 1 Scale: 1/4" = 1'-0"

DATE	Mar 82
SURVEY PLOTTED BY	S.Y.
DESIGNED BY	M.M.Y.
NOTE BOOK	
QUANTITIES BY	
CHECKED BY	Apr 82


APPROVED: _____ Date 5/4/82
Kama K. Hanks
CHIEF, WASTEWATER MANAGEMENT

STATE OF HAWAII
DEPARTMENT OF TRANSPORTATION
LAND TRANSPORTATION FACILITIES DIVISION
KALIHI STREAM BRIDGE WIDENING
ABUTMENT 1
INTERSTATE H-1 IMPROVEMENTS
MIDDLE STREET TO KALIHI INTERCHANGE
EASTBOUND LANES
F.A.I. PROJ. NO. I-HI-1(178)
Scale: As shown Date: April 1982
SHEET No. 4 OF 14 SHEETS


FED. ROAD DIST. NO.	STATE	FED. AID PROJ. NO.	FISCAL YEAR	SHEET NO.	TOTAL SHEETS
HAWAII	HAW.	I-HI-1(178)	1982	122	165

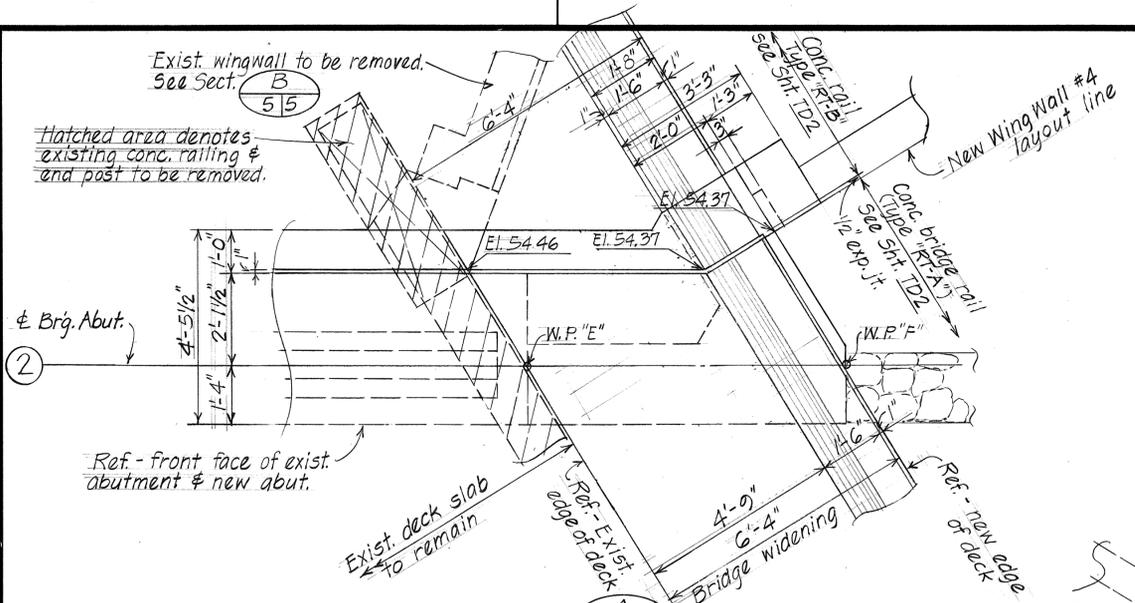


SECTION A 5/5
Scale: 1/2" = 1'-0"

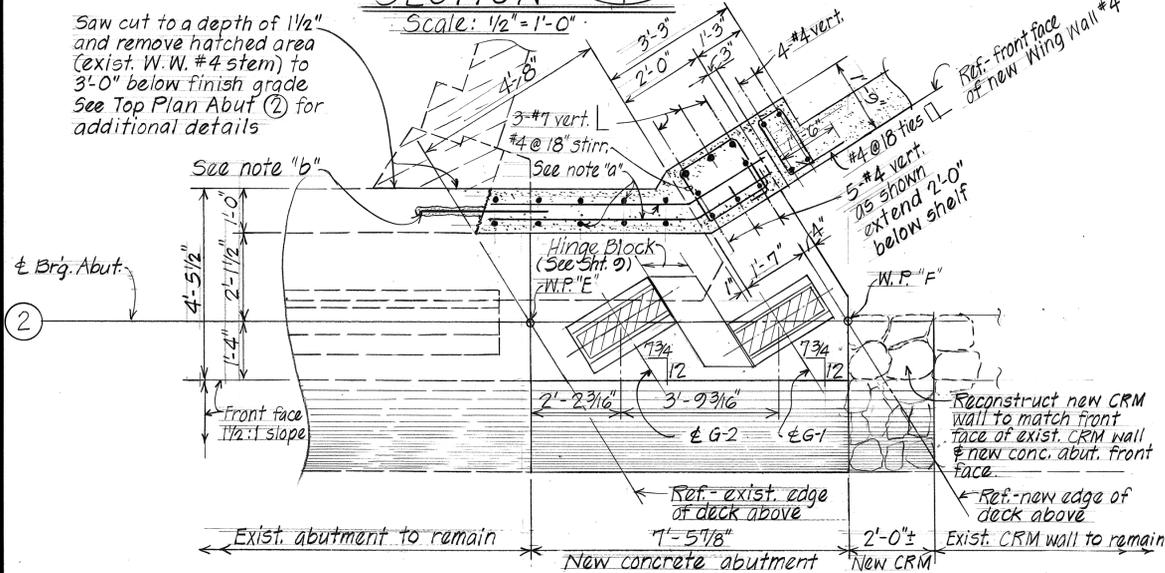

SECTION B 5/5
Scale: 1/2" = 1'-0"

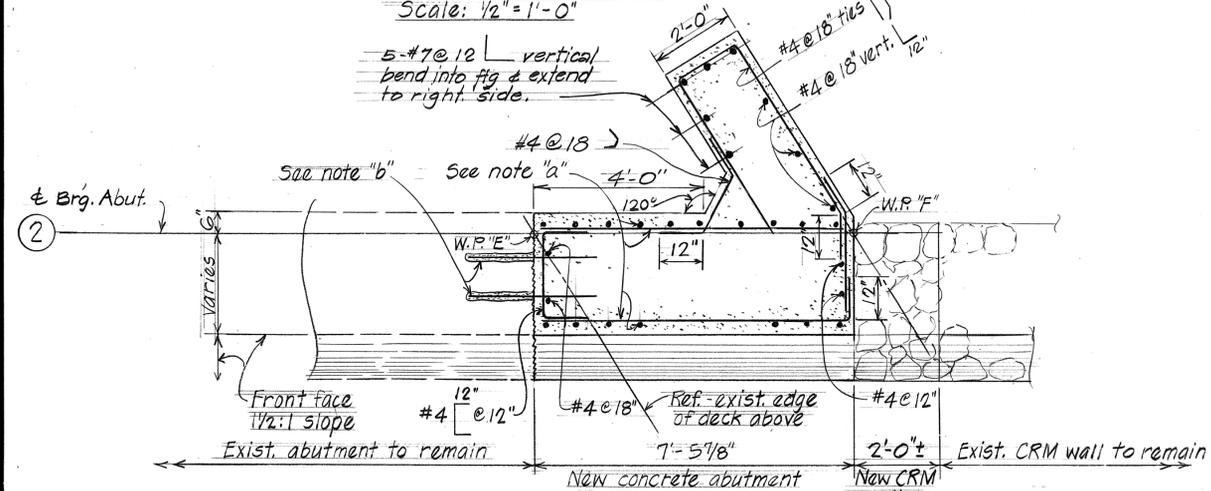


SECTION C 5/5
Scale: 1/2" = 1'-0"

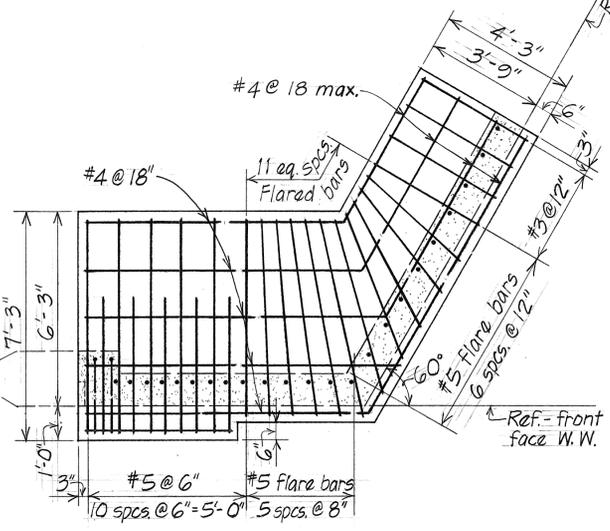


SECTION D 5/5
(TOP FOOTING REINF. - NEW WING WALL #4)
Scale: 3/8" = 1'-0"

NOTE:
"a" Normal abut. reinf. - For size & spacing see Typical Abut. Section Sht. #6
"b" #6 x 3'-0" lg. dowels @ 2'-0" o.c. set in 2"Ø x 1'-6" deep hole and fill with epoxy grout.

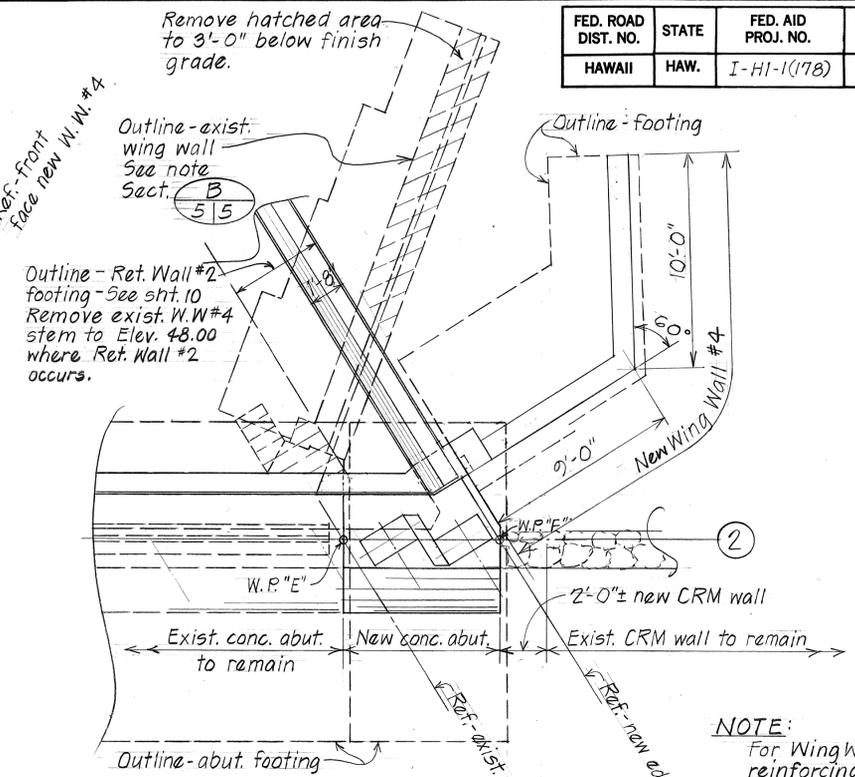

TOP PLAN - ABUTMENT (2)
Scale: 1/4" = 1'-0"

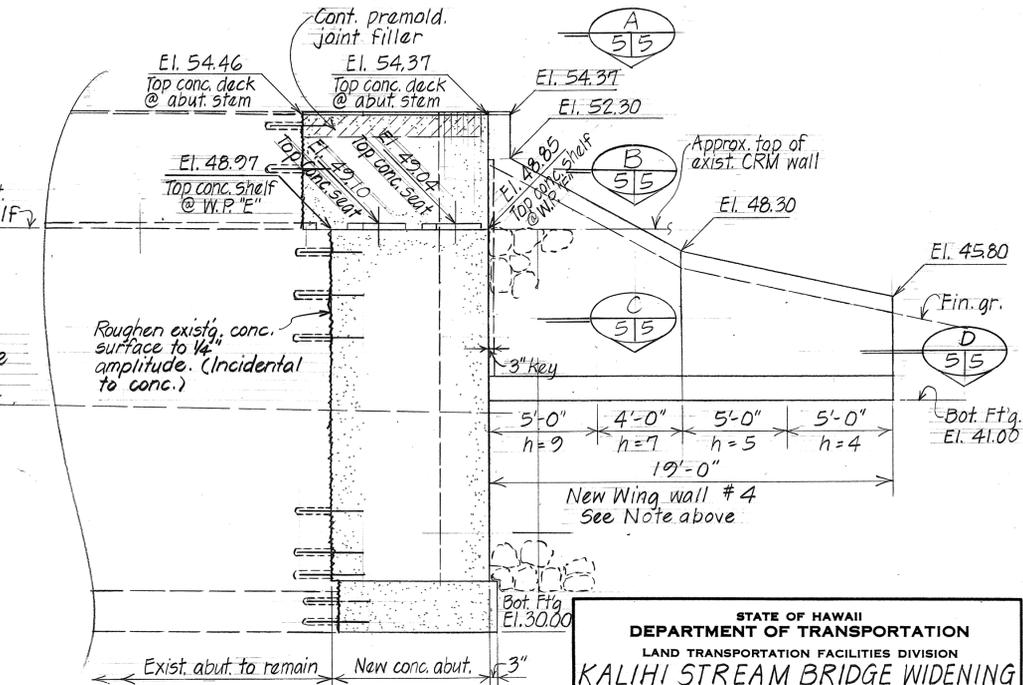


DEVELOPED ELEV. - ABUTMENT (2)
Scale: 1/4" = 1'-0"


STATE OF HAWAII
DEPARTMENT OF TRANSPORTATION
LAND TRANSPORTATION FACILITIES DIVISION
KALIHI STREAM BRIDGE WIDENING
ABUTMENT (2), NEW W.W. #4
INTERSTATE H-1 IMPROVEMENTS
MIDDLE STREET TO KALIHI INTERCHANGE
EASTBOUND LANES
F.A.I. PROJ. NO. I-HI-1(178)
Scale: As shown. Date: April 1982
SHEET NO. 5 OF 14 SHEETS

SURVEY PLOTTED BY	DATE
DRAWN BY	
TRACED BY	
NOTE BOOK	
CHECKED BY	

FED. ROAD DIST. NO.	STATE	FED. AID PROJ. NO.	FISCAL YEAR	SHEET NO.	TOTAL SHEETS
HAWAII	HAW.	I-HI-1(178)	1982	123	165

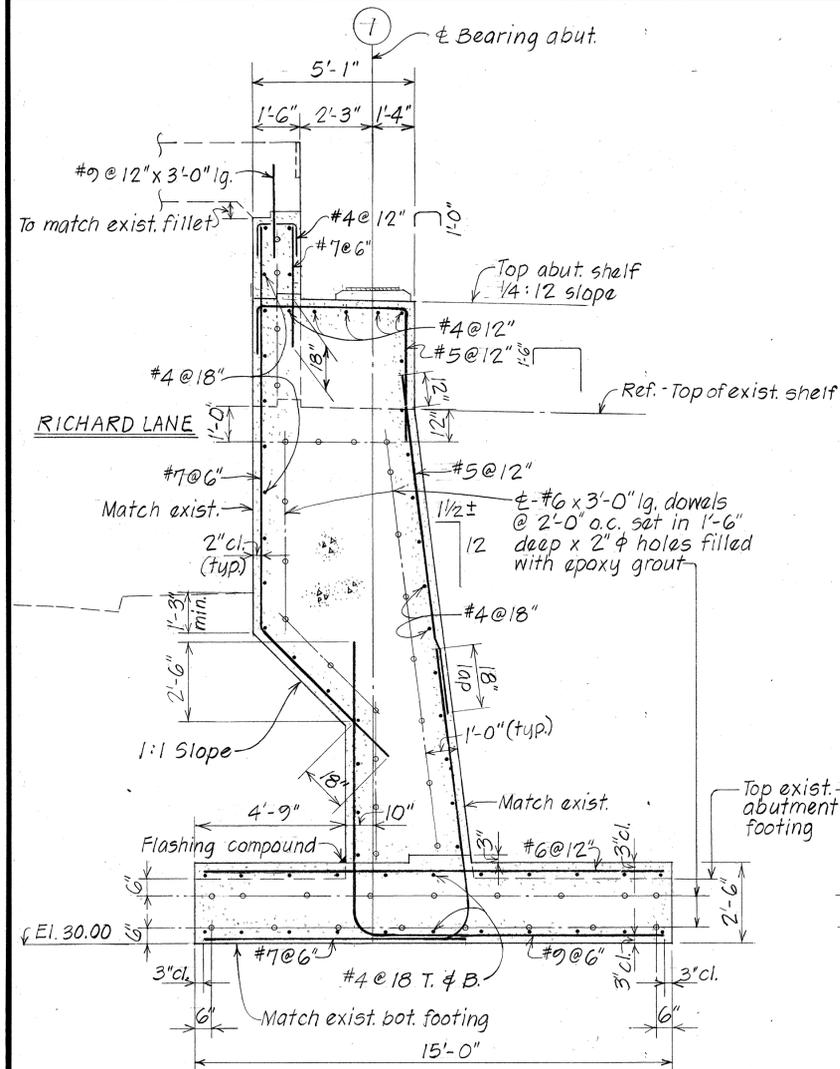

TYP. SECTION - ABUTMENT #1
Scale: 3/8" = 1'-0"

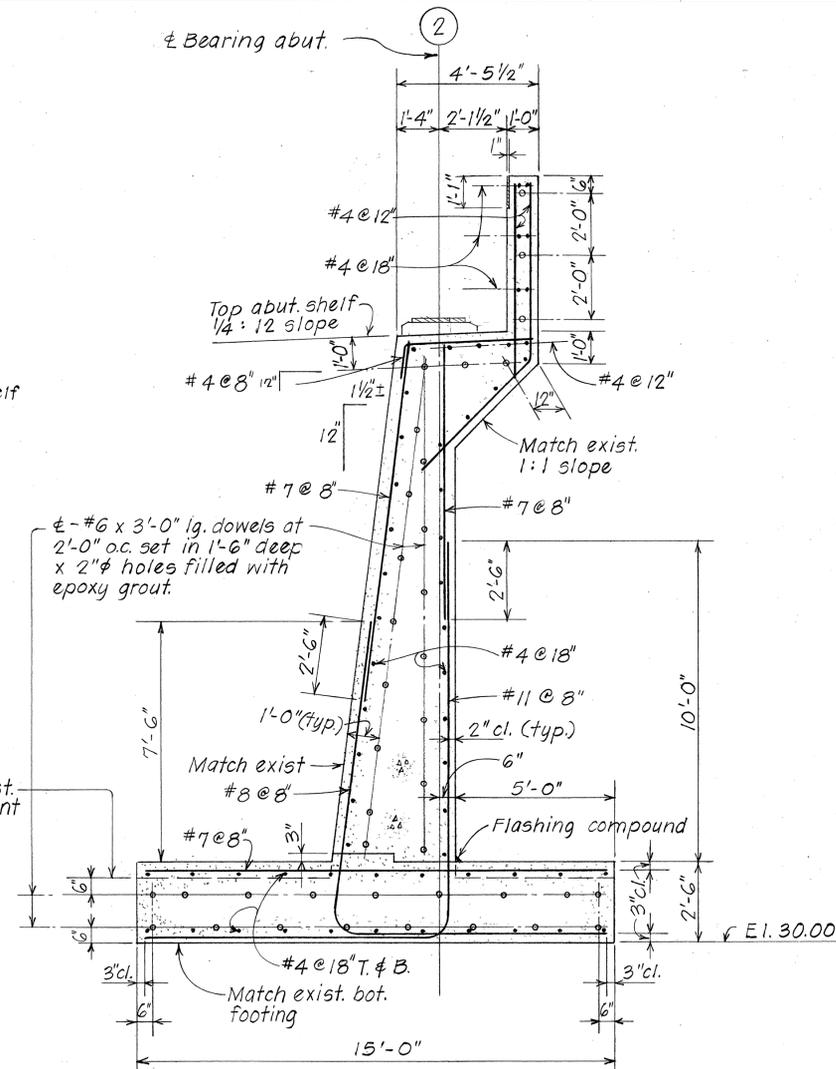


TYP. SECTION - ABUTMENT #2
Scale: 3/8" = 1'-0"

ORIGINAL PLAN	DATE
NO. 1	10/1/82
NO. 2	10/1/82
NO. 3	10/1/82
NO. 50	10/1/82


STATE OF HAWAII
DEPARTMENT OF TRANSPORTATION
LAND TRANSPORTATION FACILITIES DIVISION
KALIHI STREAM BRIDGE WIDENING
TYPICAL ABUT. ① & ② SECTIONS
INTERSTATE H-1 IMPROVEMENTS
MIDDLE STREET TO KALIHI INTERCHANGE
EASTBOUND LANES
F.A.I. PROJ. NO. I-HI-1(178)
Scale: As Shown Date: April 1982
SHEET No. 6 OF 14 SHEETS

FED. ROAD DIST. NO.	STATE	FED. AID PROJ. NO.	FISCAL YEAR	SHEET NO.	TOTAL SHEETS
HAWAII	HAW.	I-HI-1(178)	1982	124	165

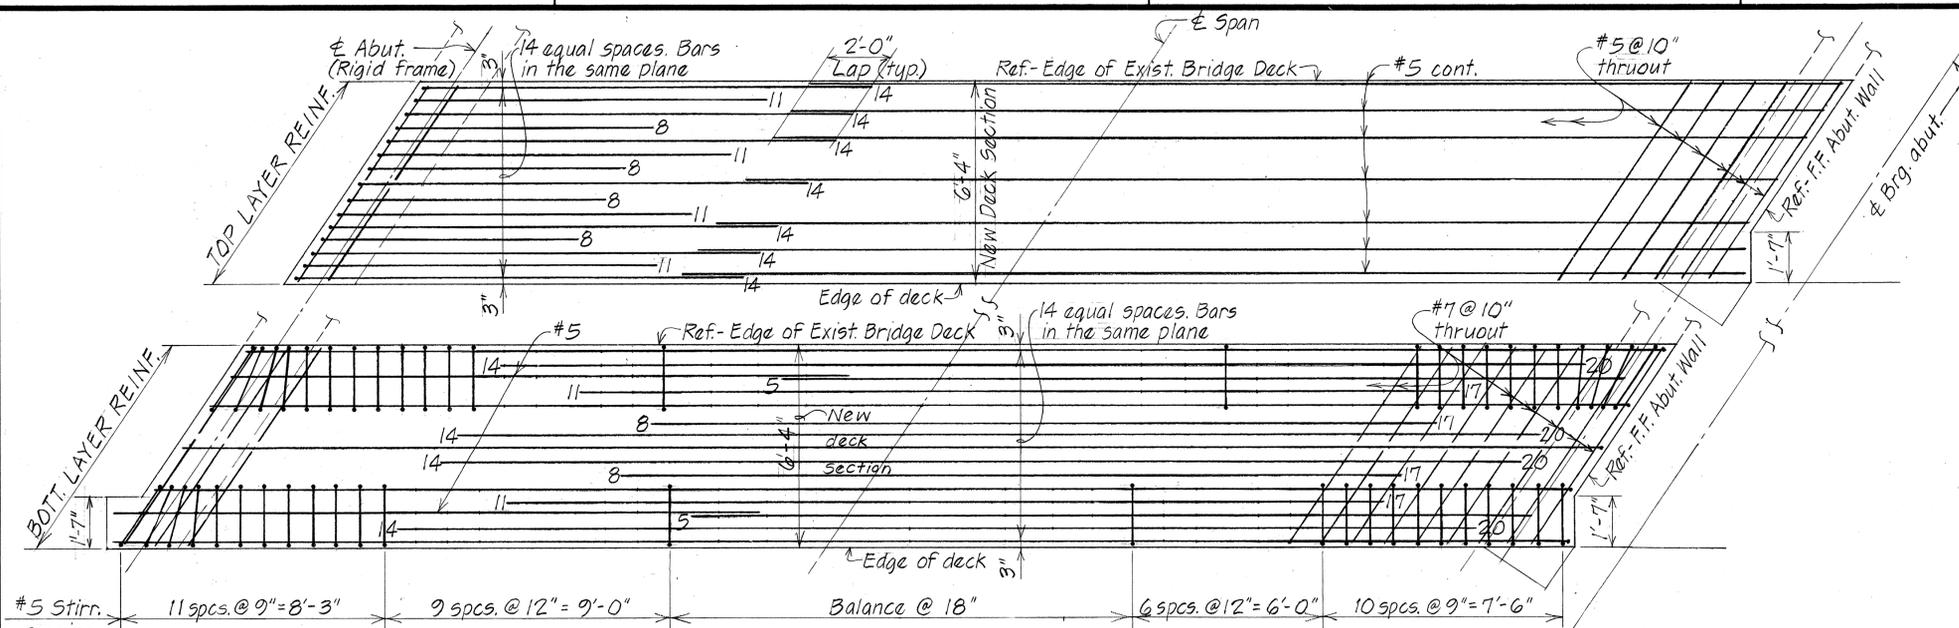


DECK - LONGIT. REINFORCING PLAN
Scale: 3/8" = 1'-0"

NOTES:
1. All bars #11 except as otherwise noted.
2. Numbers at end of bar denote distances from reference point shown below.

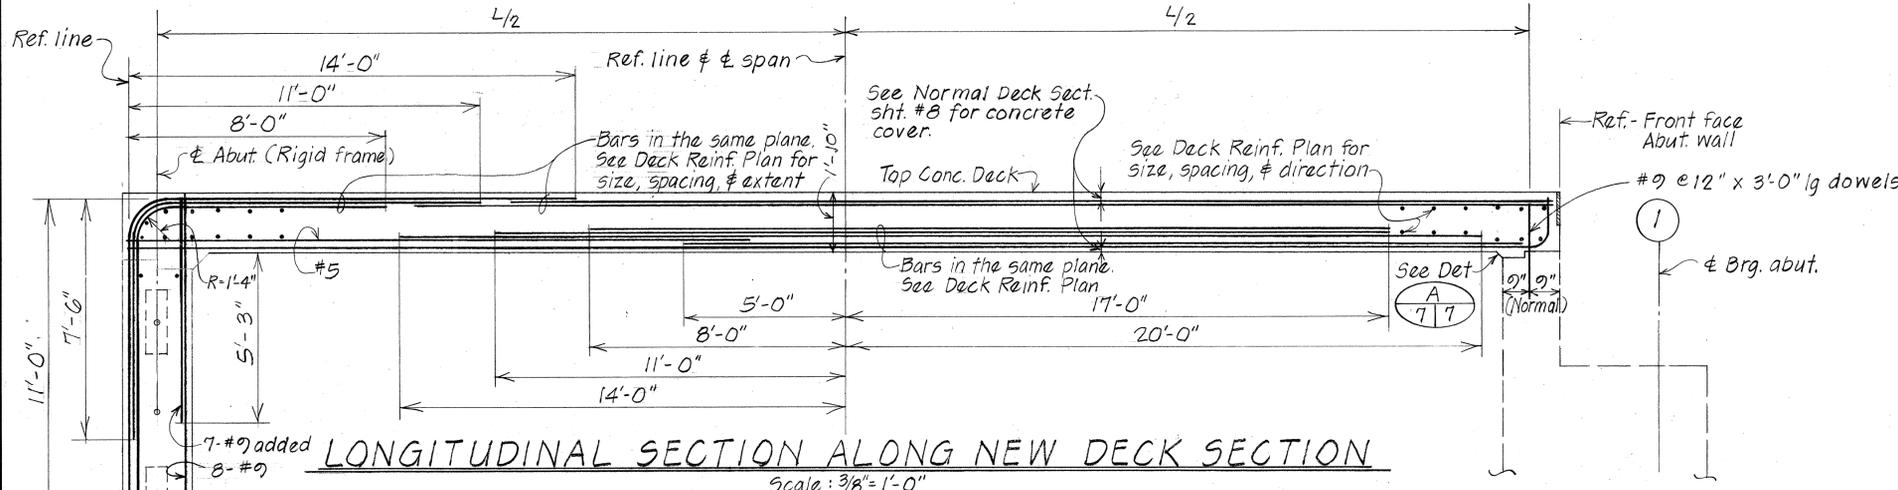


LONGITUDINAL SECTION ALONG NEW DECK SECTION
Scale: 3/8" = 1'-0"

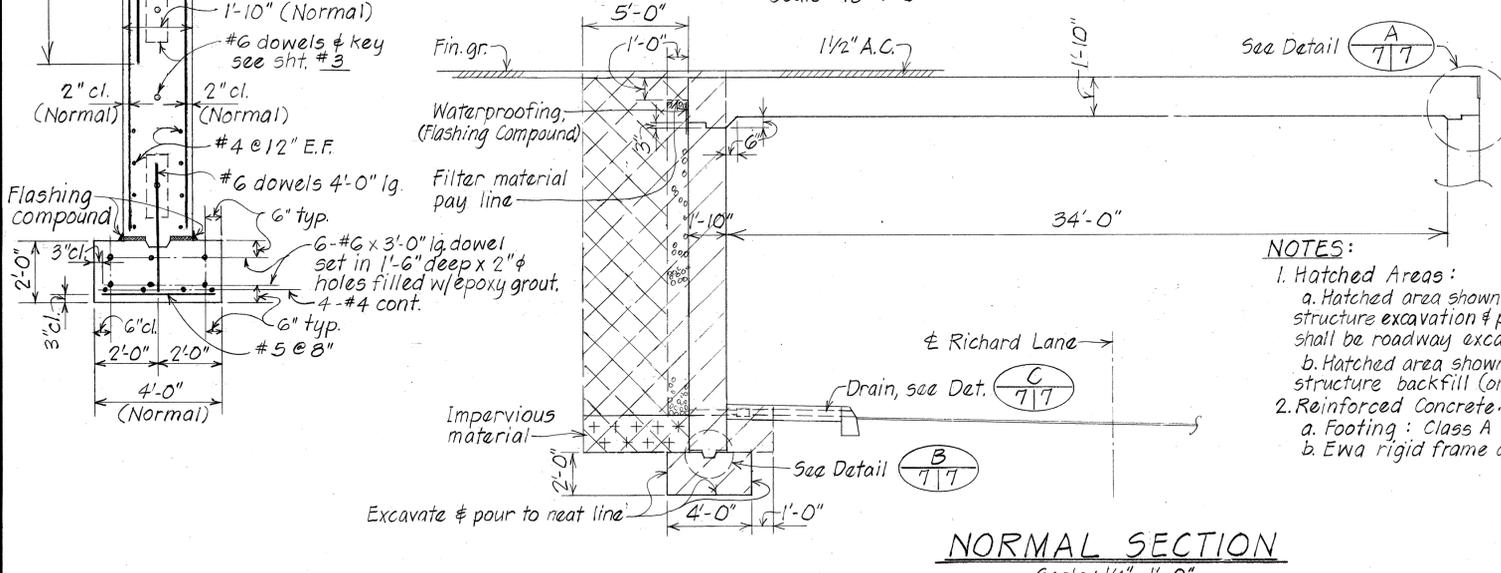


NORMAL SECTION
Scale: 1/4" = 1'-0"


NOTES:
1. Hatched Areas:
a. Hatched area shown thus // denotes limits of structure excavation & payline. All other excavation shall be roadway excavation.
b. Hatched area shown thus / denotes limits of structure backfill (or ordinary backfill).
2. Reinforced Concrete:
a. Footing: Class A
b. Ewa rigid frame abut. & deck: 4,500 psi at 28 days.

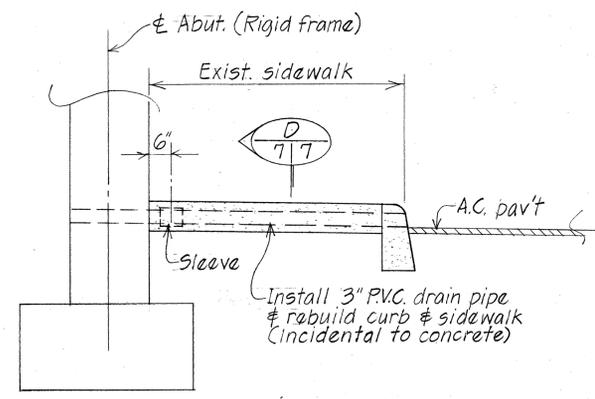

DETAIL C
Scale: 1/2" = 1'-0"

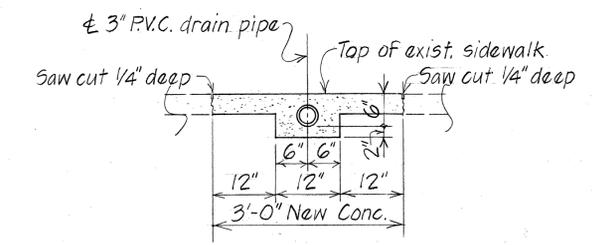

SECTION D
Scale: 3/4" = 1'-0"

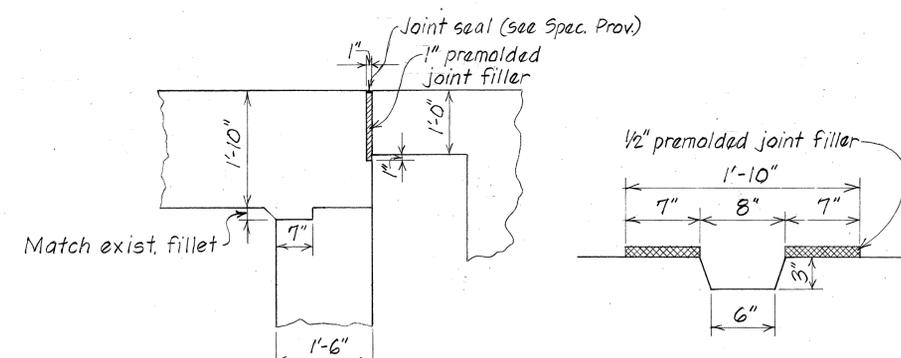


DETAIL A
Scale: 3/4" = 1'-0"

DETAIL B
Scale: 1/2" = 1'-0"

SURVEY PLOTTED BY	DATE
DRAWN BY	DATE
CHECKED BY	DATE
NOTE BOOK	


STATE OF HAWAII
DEPARTMENT OF TRANSPORTATION
LAND TRANSPORTATION FACILITIES DIVISION
KALIHI STREAM BRIDGE WIDENING
RIGID FRAME - DECK REINF. PLAN, DECK SECTION
INTERSTATE H-1 IMPROVEMENTS
MIDDLE STREET TO KALIHI INTERCHANGE
EASTBOUND LANES
F.A.I. PROJ. NO. I-HI-1(178)
Scale: As Shown Date: April 1982
SHEET NO. 7 OF 14 SHEETS

FED. ROAD DIST. NO.	STATE	FED. AID PROJ. NO.	FISCAL YEAR	SHEET NO.	TOTAL SHEETS
HAWAII	HAW.	I-HI-1(178)	1982	125	165

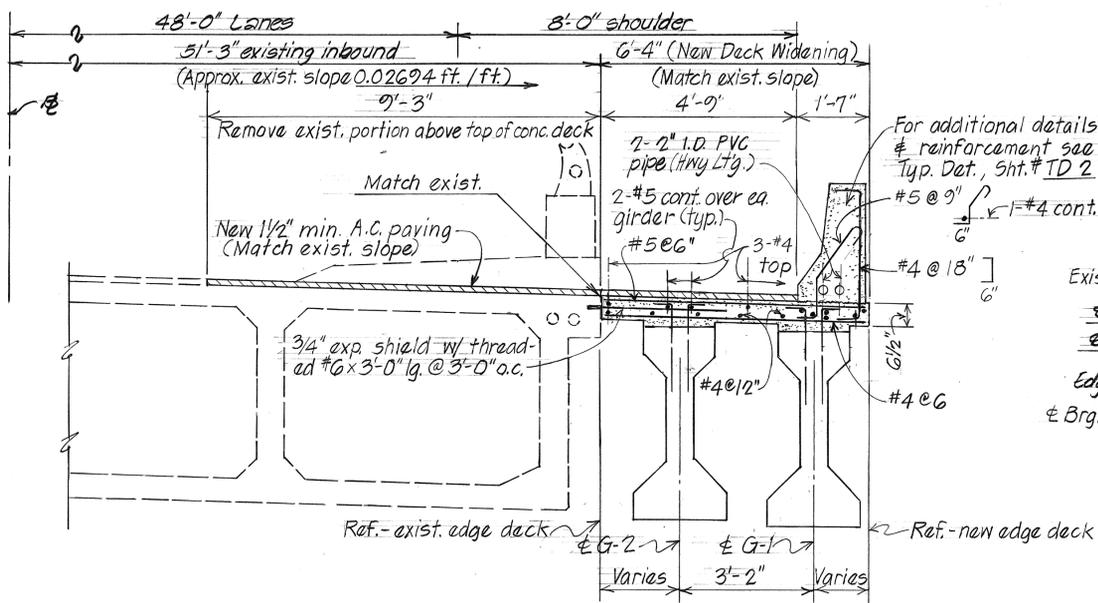

NORMAL DECK SECTION
Scale: 1/2" = 1'-0"

- NOTES:**
1. All longit. #4 bars shall be placed in accord with the roadway curvature.
 2. All transverse bars shall be placed radially.

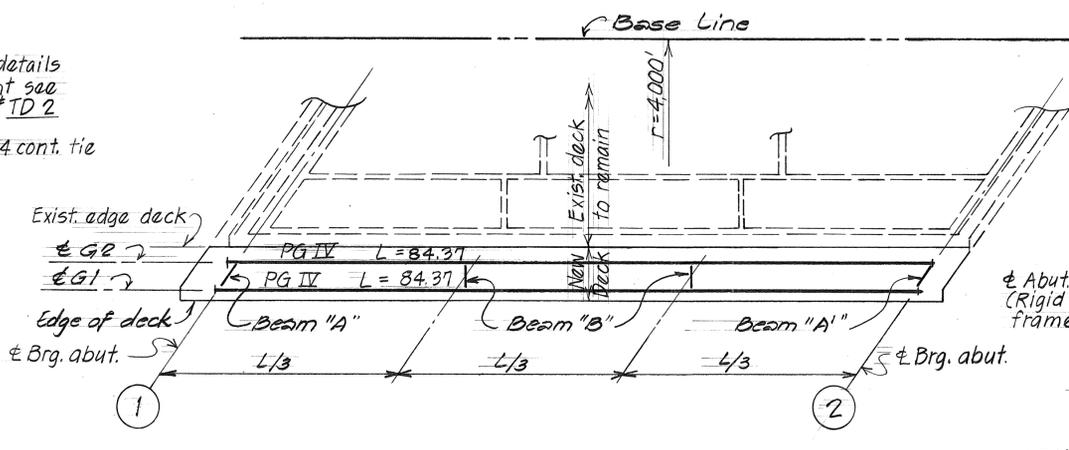


DECK FRAMING PLAN
Scale: 1" = 10'-0"


- NOTE:**
1. Locate Bm "B" at 1/3 span as indicated on Plan
 2. Girder dimension L = horizontal measurement between & brg. abut. The Contractor shall determine total length of girder. (See Construction Method note no. 3 on sht. 1)

NEW EDGE OF DECK CAMBER DIAGRAM


1. For use in determining screed grades during deck pour at new edge of deck.
2. Match grades at existing edge of deck.

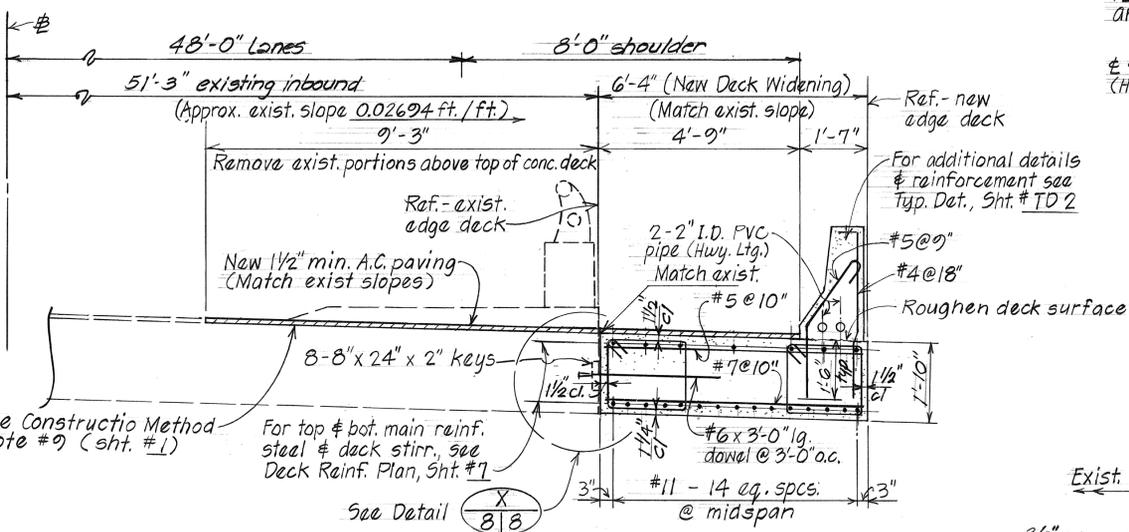


NORMAL DECK SECTION (AT RIGID FRAME)
Scale: 1/2" = 1'-0"

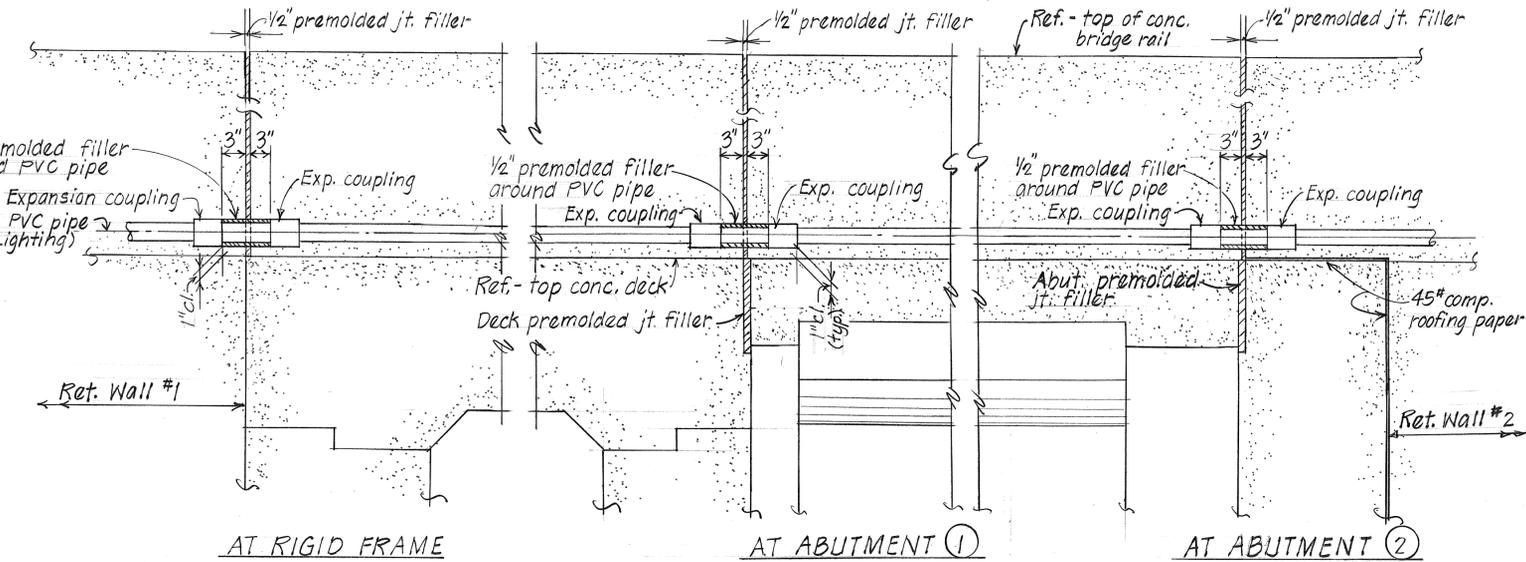

TYPICAL HIGHWAY LIGHTING DUCT DETAIL AT BRIDGE DECK SECTION
Scale: 1" = 1'-0"

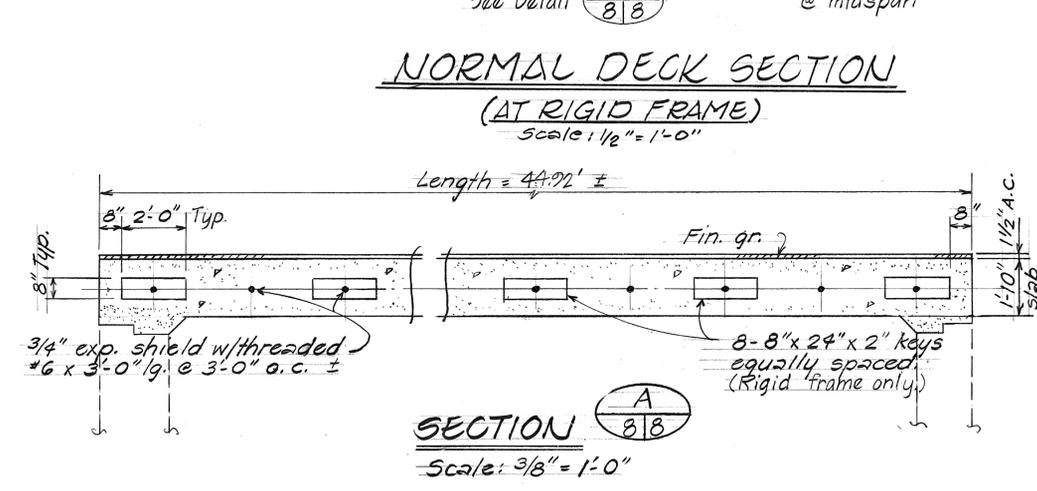

SECTION A/B
Scale: 3/8" = 1'-0"

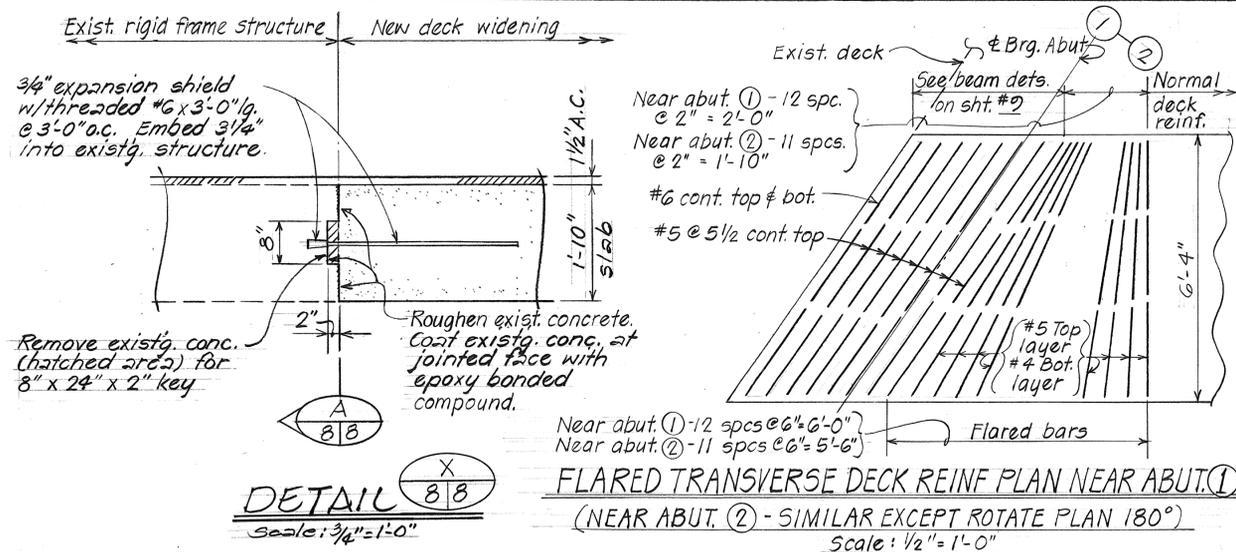









DETAIL A/B
Scale: 3/4" = 1'-0"

FLARED TRANSVERSE DECK REINF PLAN NEAR ABUT. 1
(NEAR ABUT. 2 - SIMILAR EXCEPT ROTATE PLAN 180°)
Scale: 1/2" = 1'-0"

SURVEY PLOTTED BY	DATE
DRAWN BY S. L. G. U.	12/82
DESIGNED BY M. M. Y.	12/82
QUANTITIES BY	
CHECKED BY	4/83
NO.	

STATE OF HAWAII
DEPARTMENT OF TRANSPORTATION
LAND TRANSPORTATION FACILITIES DIVISION
KALIHI STREAM BRIDGE WIDENING
NORMAL DECK SECTION
DECK FRAMING PLAN
INTERSTATE HI IMPROVEMENTS
MIDDLE STREET TO KALIHI INTERCHANGE
EASTBOUND LANES
F.A.I. PROJ. NO. I-HI-1(178)
Scale: As shown Date: April 1982
SHEET NO. 8 OF 14 SHEETS

FED. ROAD DIST. NO.	STATE	FED. AID PROJ. NO.	FISCAL YEAR	SHEET NO.	TOTAL SHEETS
HAWAII	HAW.	I-HI-1(178)	1982	126	165

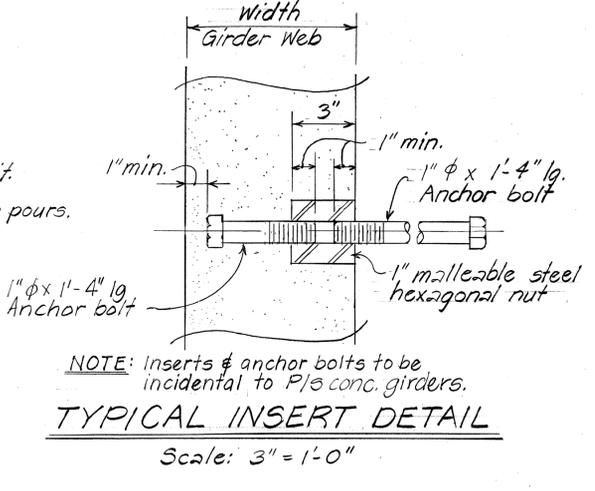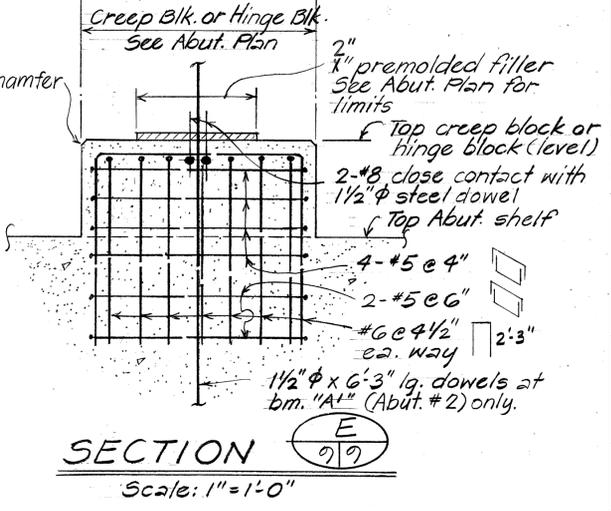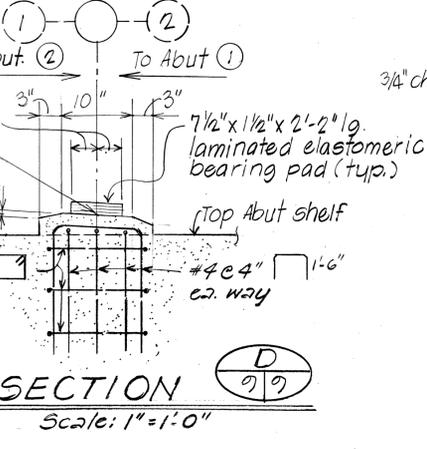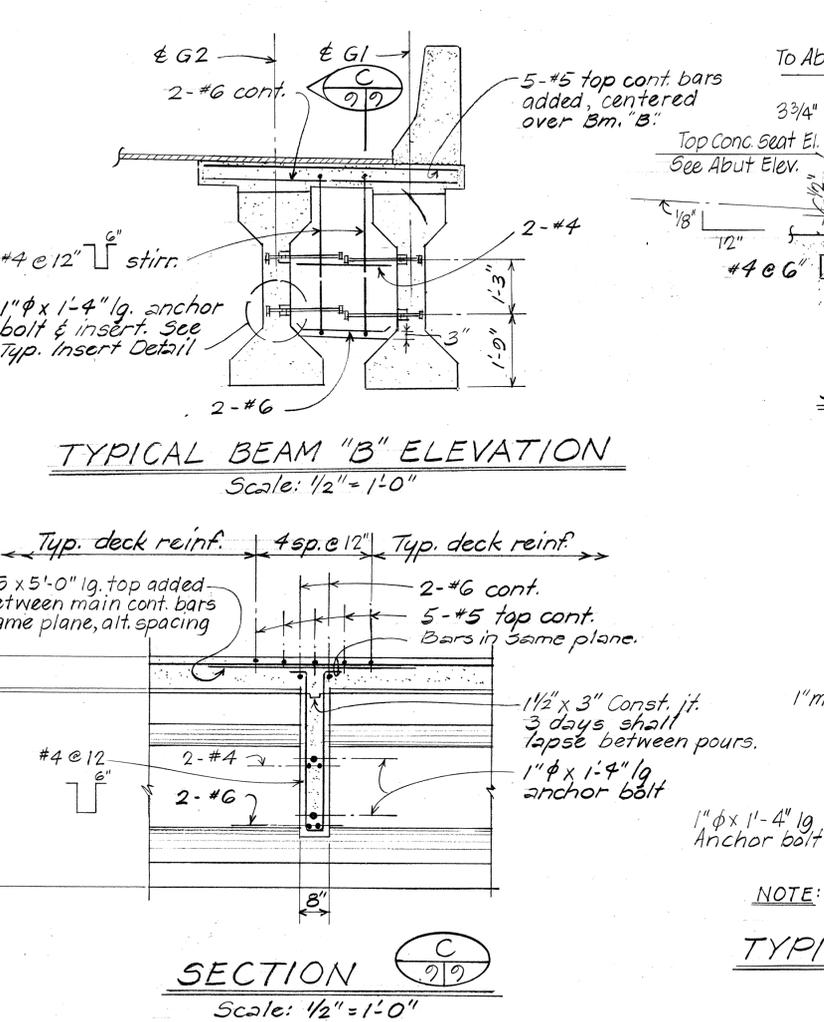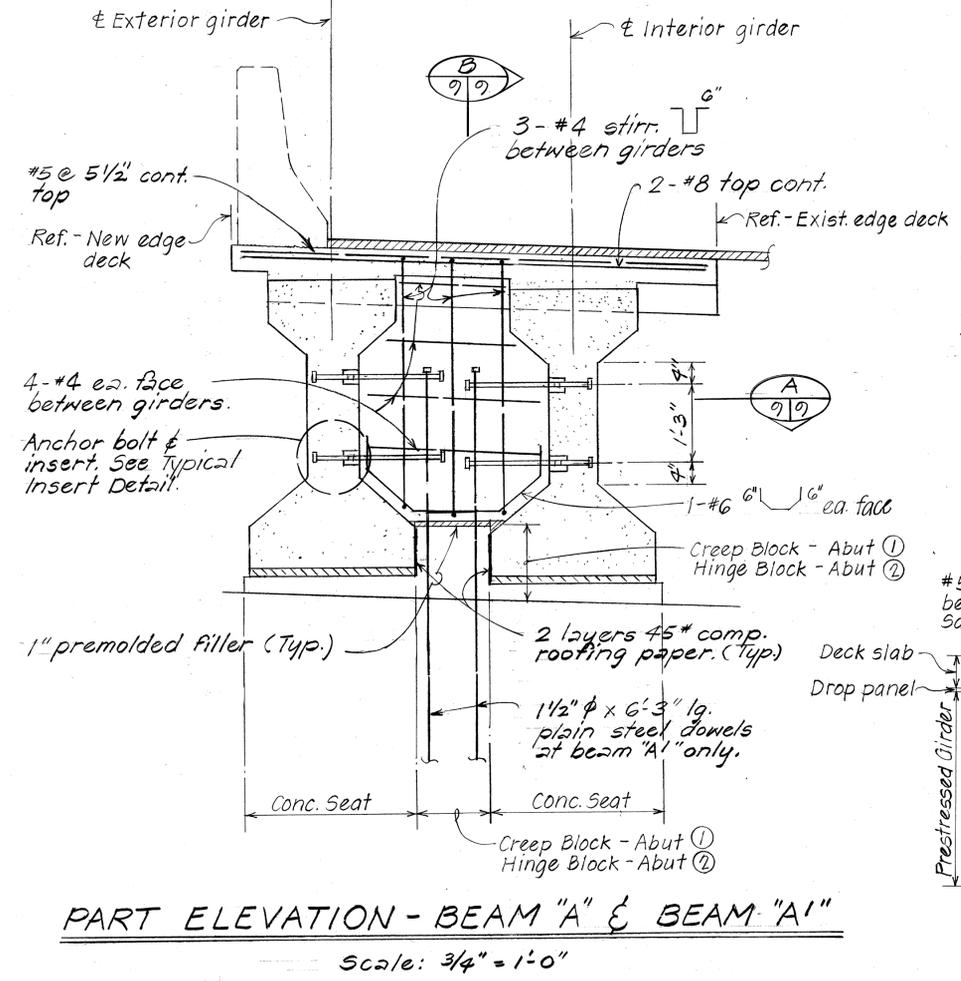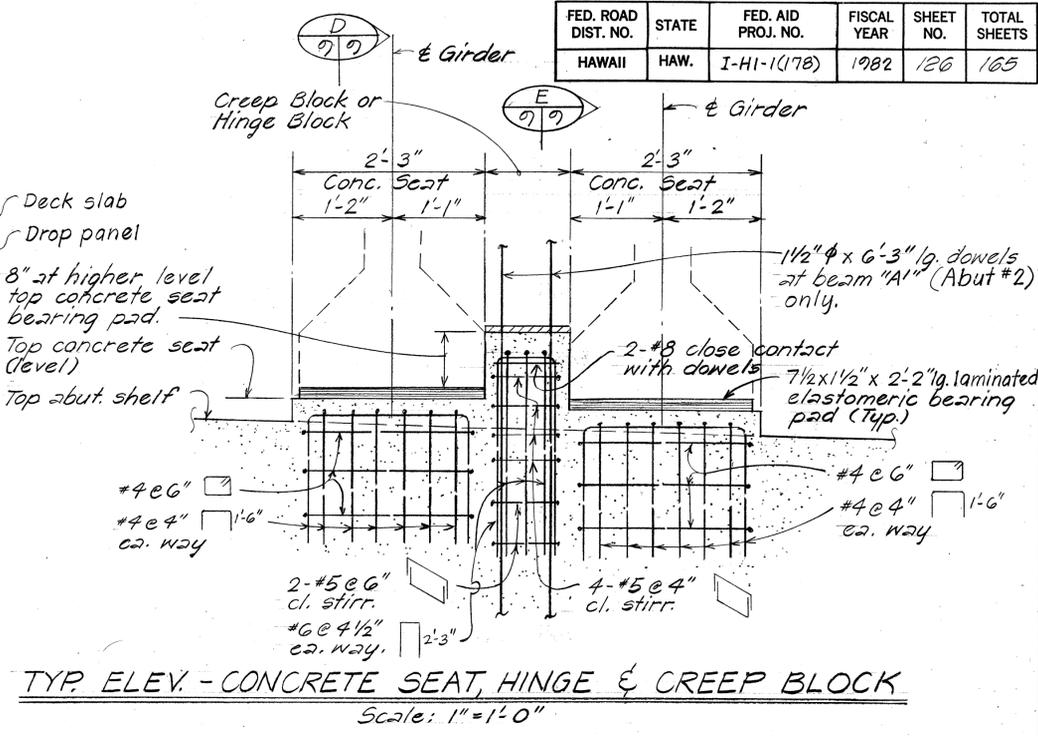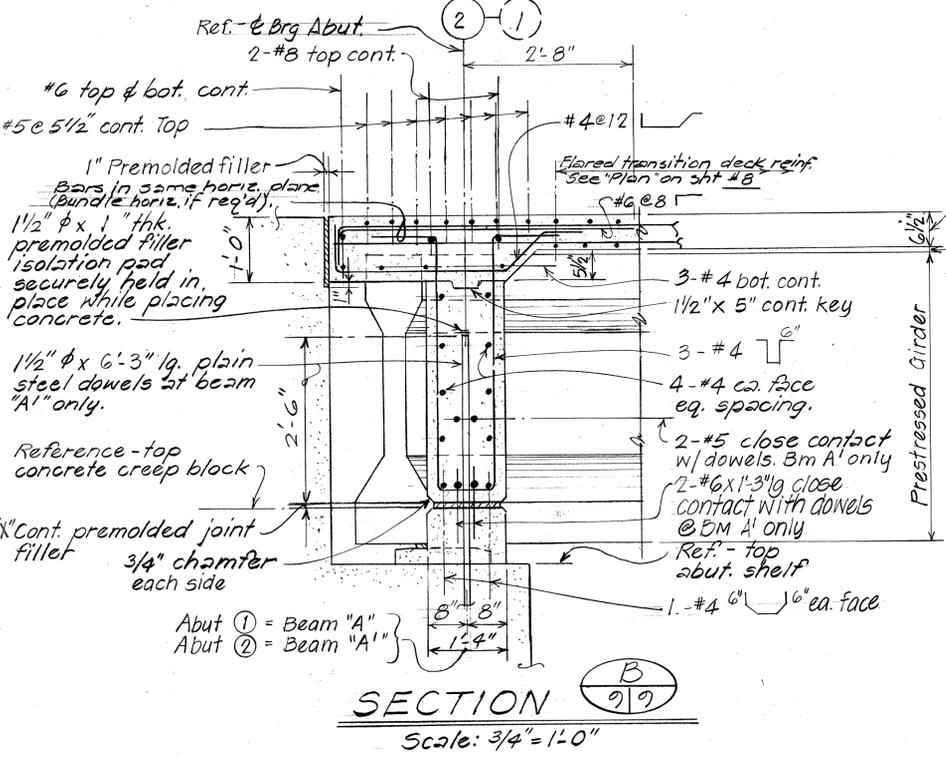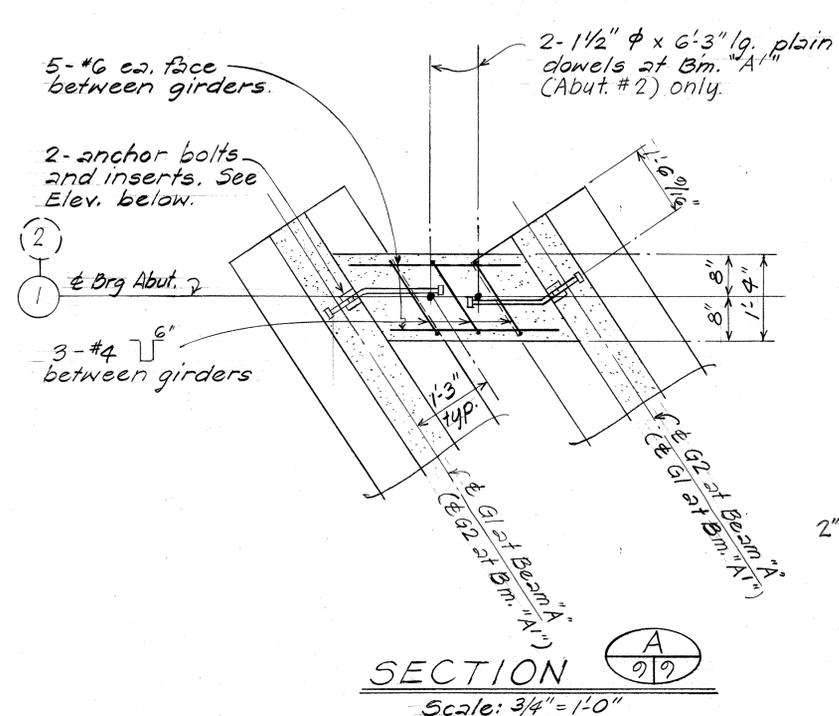


NOTE: Inserts & anchor bolts to be incidental to P/S conc. girders.

DATE	1/10/82
SURVEY PLOTTED BY	M.A.C. B.
DRAWN BY	T.K.M.
DESIGNED BY	M.M.Y.
QUANTITIES BY	
CHECKED BY	A.P.C.
ORIGINAL PLAN	
NOTE BOOK	
No.	

STATE OF HAWAII
DEPARTMENT OF TRANSPORTATION
LAND TRANSPORTATION FACILITIES DIVISION
KALIHI STREAM BRIDGE WIDENING
BEAM "A", "A1" & "B" DETAILS
INTERSTATE H-1 IMPROVEMENTS
MIDDLE STREET TO KALIHI INTERCHANGE
EASTBOUND LANES
F.A.I. PROJ. NO. I-HI-1(178)
Scale: As Shown Date: April 1982
SHEET NO. 9 OF 14 SHEETS

FED. ROAD DIST. NO.	STATE	FED. AID PROJ. NO.	FISCAL YEAR	SHEET NO.	TOTAL SHEETS
HAWAII	HAW.	I-HI-1(178)	1982	127	165


NOTE:
Except as otherwise noted all longitudinal dimensions are measured horizontal & along front face of ret. wall.

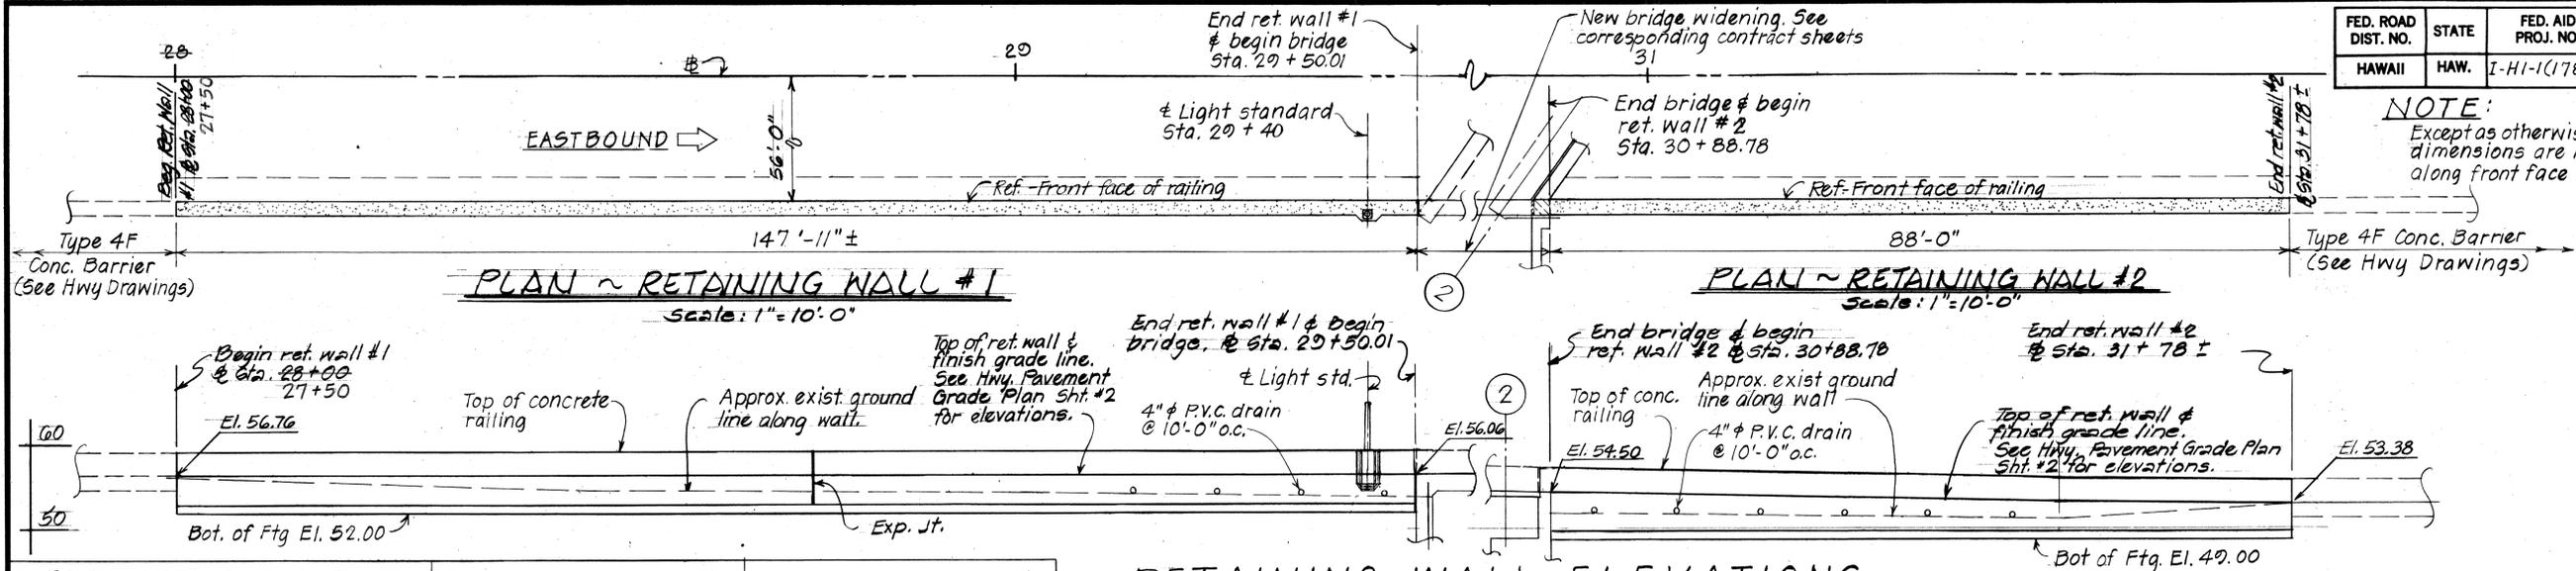

ESTIMATED QUANTITIES		RETAINING WALL #1		RETAINING WALL #2		
ITEM	ITEM NO.	UNIT	QUANTITY	ITEM NO.	UNIT	QUANTITY
*Concrete Bridge Railing	507.5010	L.F.	150 L.F.	507.5010	L.F.	91 L.F.
Structure Excavation for Retaining Wall	206.5000	C.Y.	115 C.Y.	206.5000	C.Y.	73 C.Y.
Structure Backfill for Retaining Wall	206.7250	C.Y.	41 C.Y.	206.7250	C.Y.	31 C.Y.
Filter Material for Retaining Wall	206.8200	C.Y.	3 C.Y.	206.8200	C.Y.	2 C.Y.
Concrete in Retaining Wall	503.1054	LumpSum	51 C.Y.	503.1055	LumpSum	32 C.Y.
Reinforcing steel in Retaining Wall	602.0054	LumpSum	4770 LBS.	602.0055	LumpSum	2700 LBS.

RETAINING WALL ELEVATIONS


Scale: 1" = 1'-0"

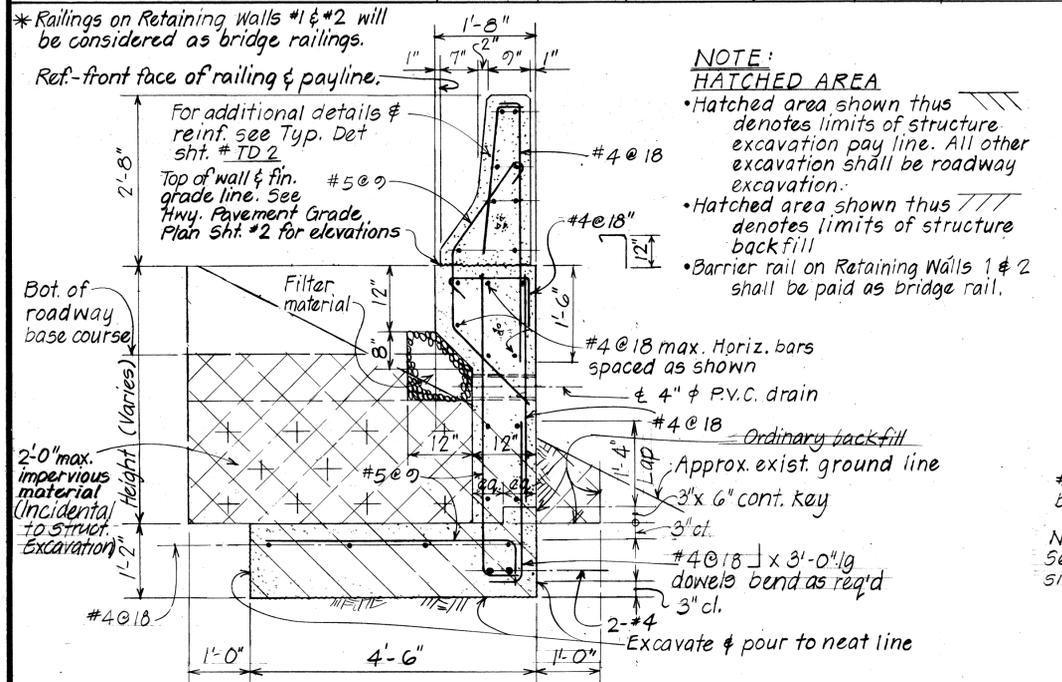

TYP. SECTION - RET. WALLS 1 & 2

Scale: 3/4" = 1'-0"

- REFERENCE:**
- Expansion joint details similar to that shown on Standard Details - Retaining Wall Type T-1 sht. DB-207-2
 - For contraction joint location and detail, see Sht. DB-207-2.

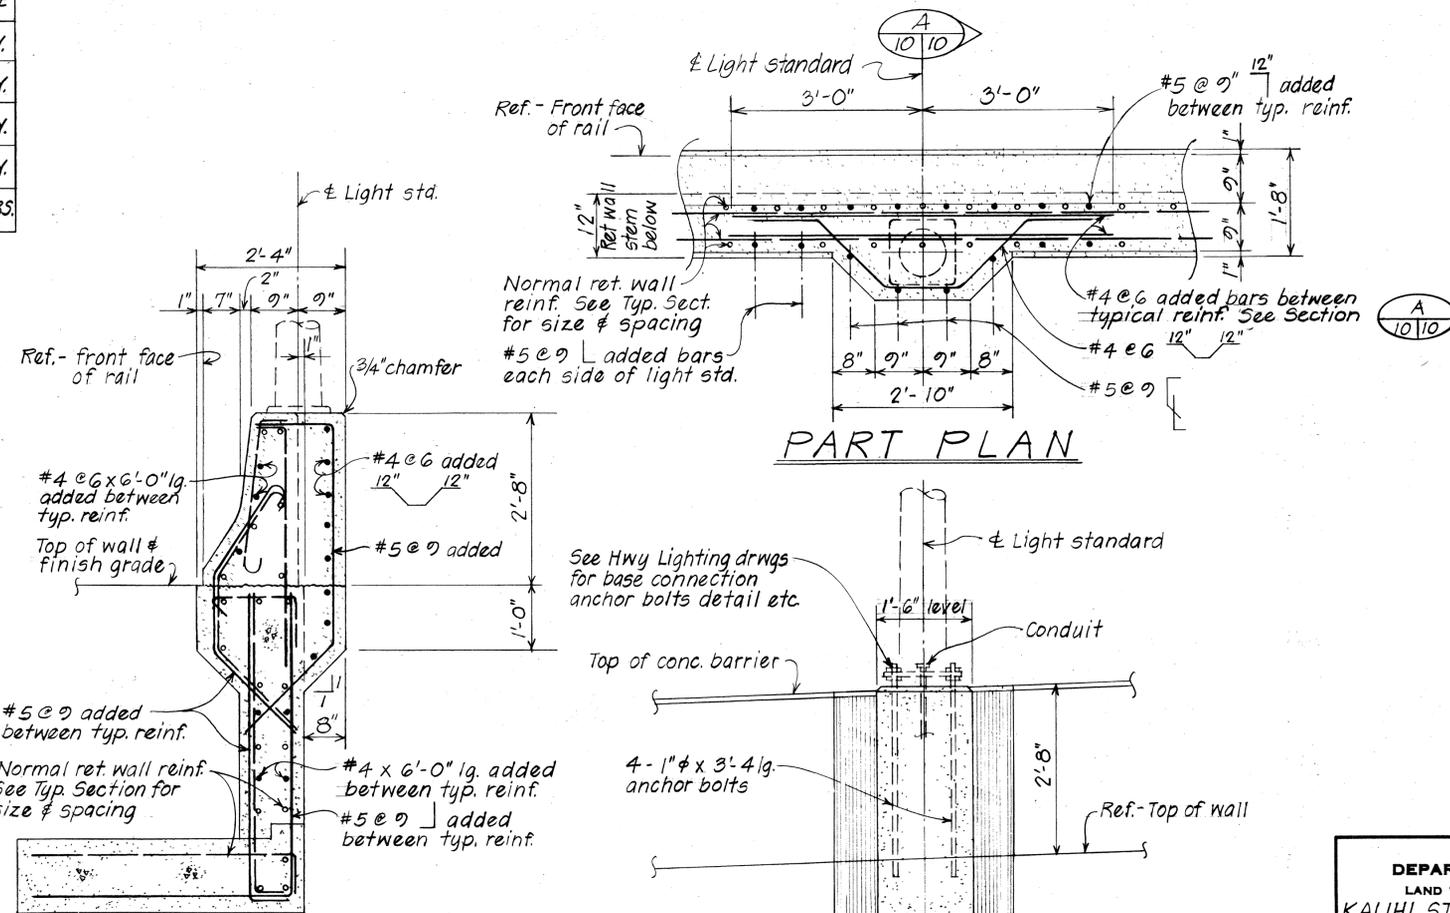

SECTION A-10/10

TYPICAL LIGHT STANDARD AT RETAINING WALL #1


Scale: 3/4" = 1'-0"

SURVEY PLOTTED BY: DATE: MAR. 22
 DRAWN BY: S.Y., L.H.A.
 TRACED BY: T.S.
 NOTE BOOK NUMBER: 1407-20
 CHECKED BY: APR. 22

STATE OF HAWAII
 DEPARTMENT OF TRANSPORTATION
 LAND TRANSPORTATION FACILITIES DIVISION
KALIHI STREAM BRIDGE WIDENING
 RETAINING WALL #1 & #2
 INTERSTATE H-1 IMPROVEMENTS
 MIDDLE STREET TO KALIHI INTERCHANGE
 EASTBOUND LANES
 F.A.I. PROJ. NO. I-HI-1(178)
 Scale: As Shown Date: April 1982
 SHEET NO. 10 OF 14 SHEETS

FED. ROAD DIST. NO.	STATE	FED. AID PROJ. NO.	FISCAL YEAR	SHEET NO.	TOTAL SHEETS
HAWAII	HAW.	I-41-1(178)	1982	128	165

CURVE DATA			
	M-3B	M-3M	M-3N
Δ	5°35'04"	6°20'36"	9°40'39"
R	406.79'	1467.0'	1125.79'
T	19.84'	81.29'	101.23'
Lc	39.65'	162.42'	201.07'

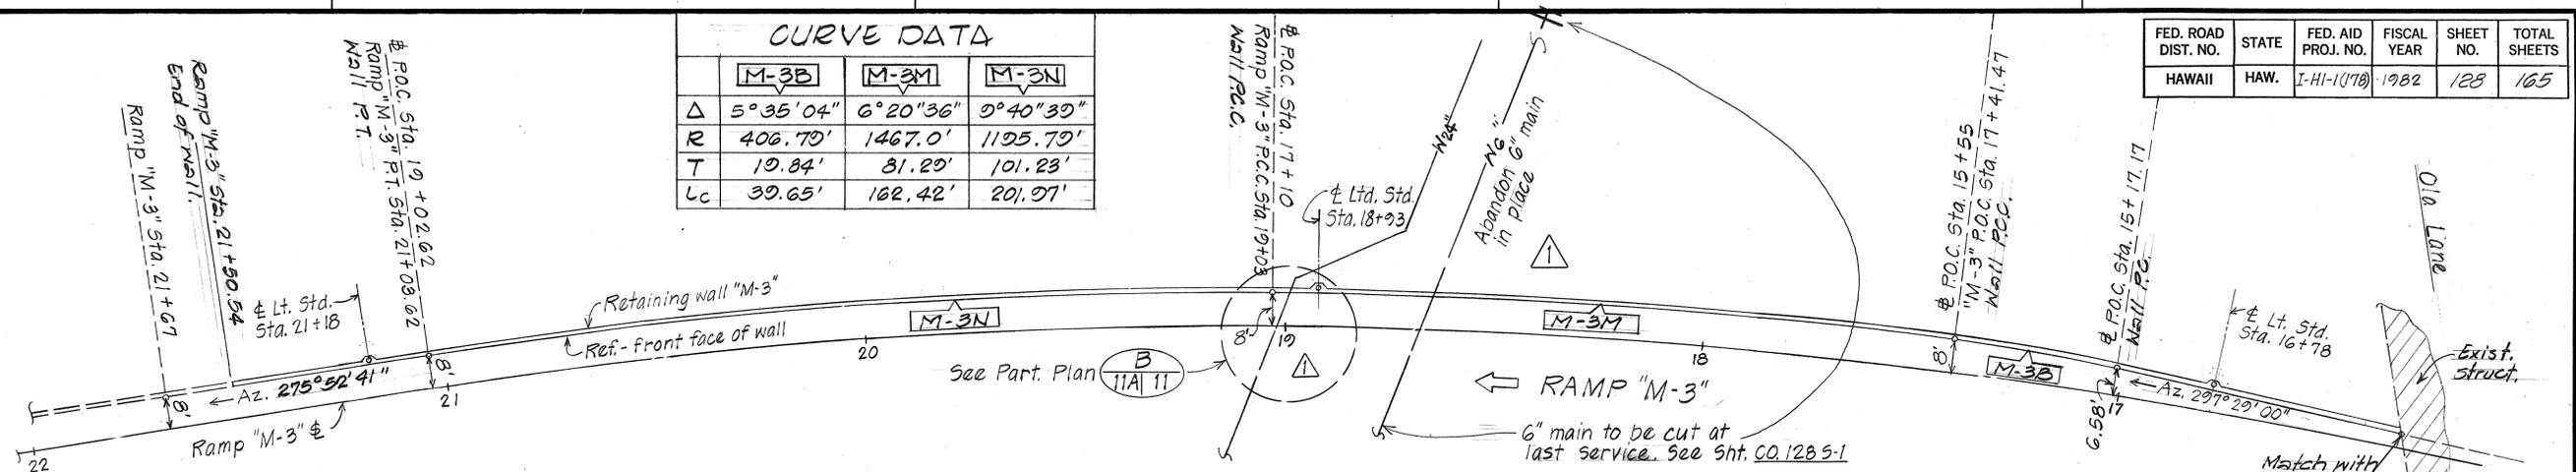


PLAN - RETAINING WALL "M-3"

Scale: 1" = 20'-0"

Reference

1. For retaining wall dimensions & reinf. see typical detail Type L-2 wall, Sht. 10-4.
2. Except as noted otherwise, all longitudinal dimensions are measured horizontal & along front face of retaining wall.
3. Expansion joints and footing step-up details similar to that shown on Sht. DB-207-2 Standard Details - Ret. Wall Type T-1.
4. For contraction jt. location & det. see Sht. DB-207-2.

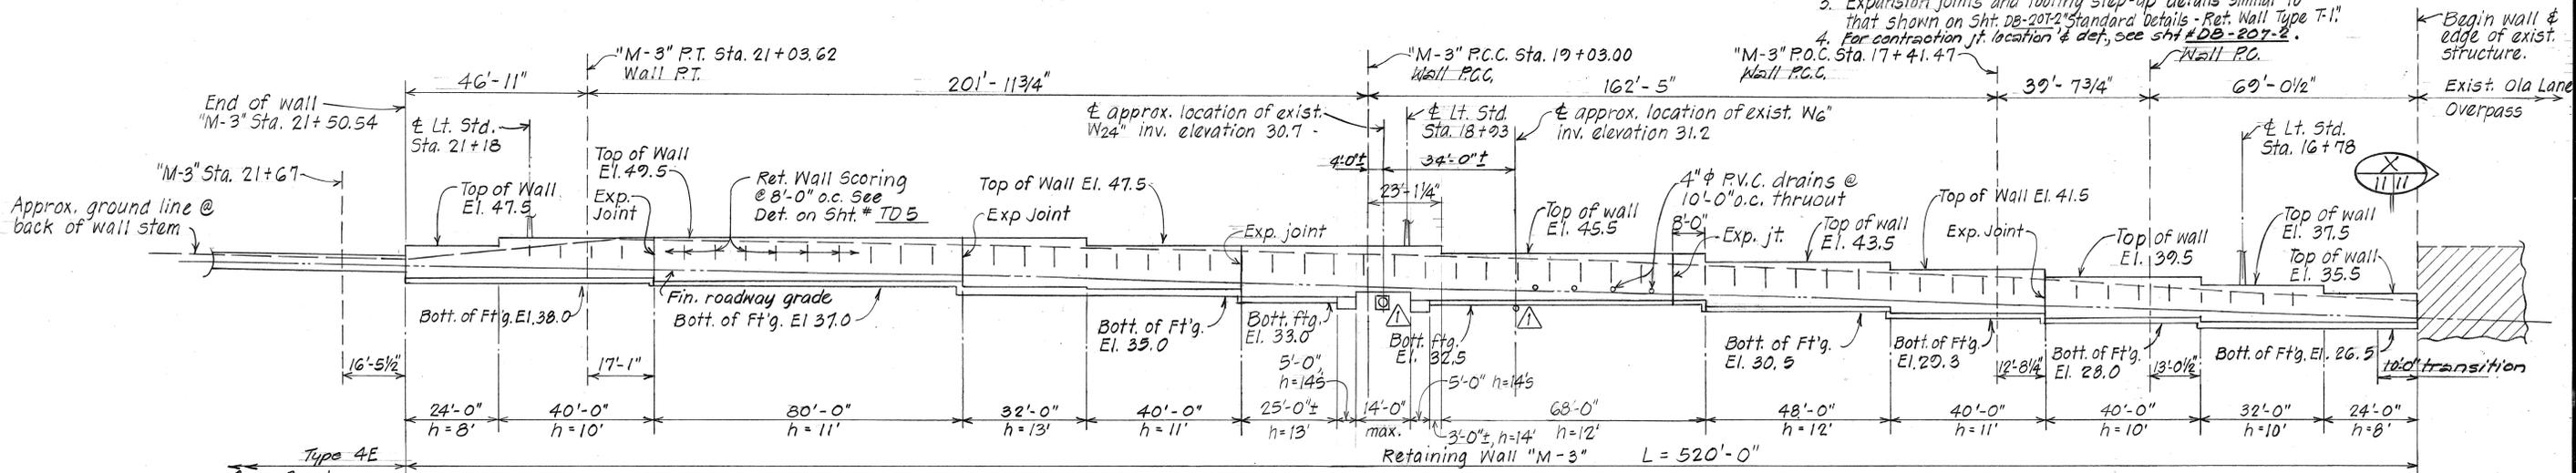


ELEVATION - RETAINING WALL "M-3"

Scale: 1" = 20'-0"

**ESTIMATED QUANTITIES
RETAINING WALL "M-3"**

ITEM NO.	ITEM	UNIT	QUANTITY
206.5000	Structure Excavation for Retaining Wall	C.Y.	493.0Y
206.7250	Structure Backfill for Retaining Wall	C.Y.	316.0Y
206.8200	Filter Material for Retaining Wall	C.Y.	115.0Y
503.1051	Concrete in Retaining Wall	Lump Sum	490.0Y
602.0051	Reinforcing Steel in Retaining Wall	Lump Sum	42,100.0LBS

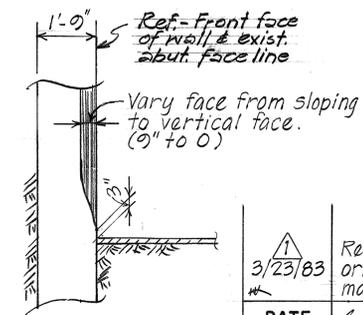

SECTION X-1111
not to scale

DATE 3/23/83
Revised footing, 24" water line opening, original quantities, and deleted water main details.

DATE 4-5-83 REVISION (Rev.)
APPROVED: R. Nagata
CHIEF, PLANNING & ENGINEERING, BWS Co

STATE OF HAWAII
DEPARTMENT OF TRANSPORTATION
LAND TRANSPORTATION FACILITIES DIVISION

RETAINING WALL M-3

INTERSTATE HI IMPROVEMENTS
MIDDLE STREET TO KALIHI INTERCHANGE
EASTBOUND LANES


F.A.I. PROJECT NO. I-41-1(178)
Scale: As Noted Date: April 1982

SHEET No. 11 OF 14 SHEETS


SURVEY PLOTTED BY	DATE
DRAWN BY	DATE
TRACED BY	DATE
CHECKED BY	DATE
NOTE BOOK	
No.	

FED. ROAD DIST. NO.	STATE	FED. AID PROJ. NO.	FISCAL YEAR	SHEET NO.	TOTAL SHEETS
HAWAII	HAW.	IHI-1(178)	1983	1285-1	165


SERVICE NUMBER	METER NUMBER	ADDRESS
①	410-44163	17315957 T 06
②	410-44184	21957263 T 04
③	704-11352	7305483 T 06
④	410-60700	20898013 T 03
⑤	410-60721	20366841 T 02
⑥	410-60742	20889180 T 03
⑦	410-60637	4331624 T 02
⑧	410-60658	22419835 T 02
⑨	410-60679	79033201 CN 03
⑩	0/F	

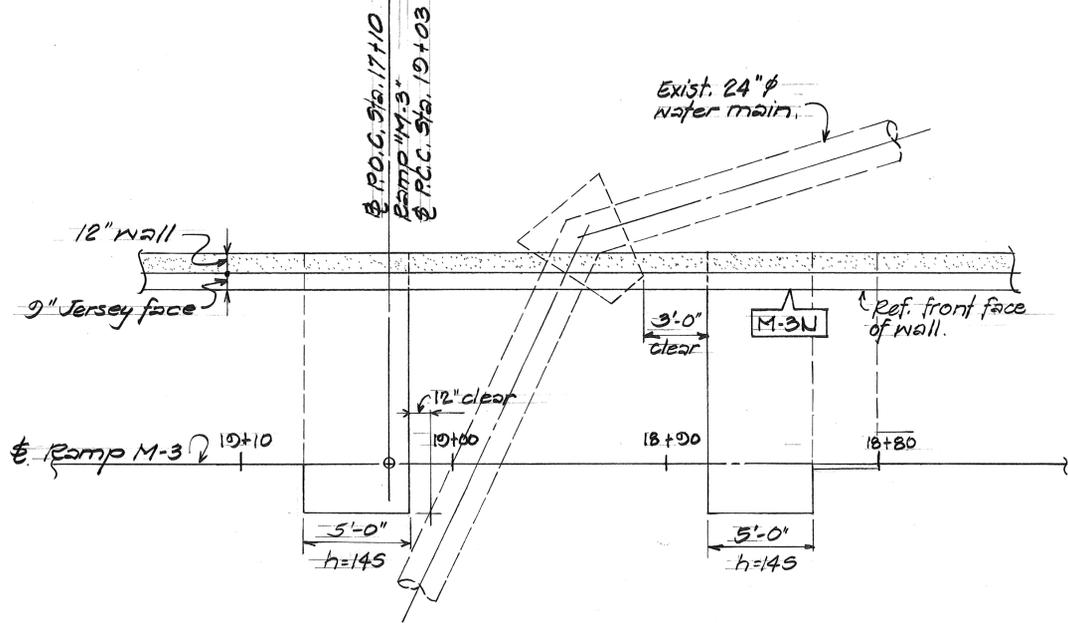


PART PLAN
Scale: 1/4"=1'-0"
① A II

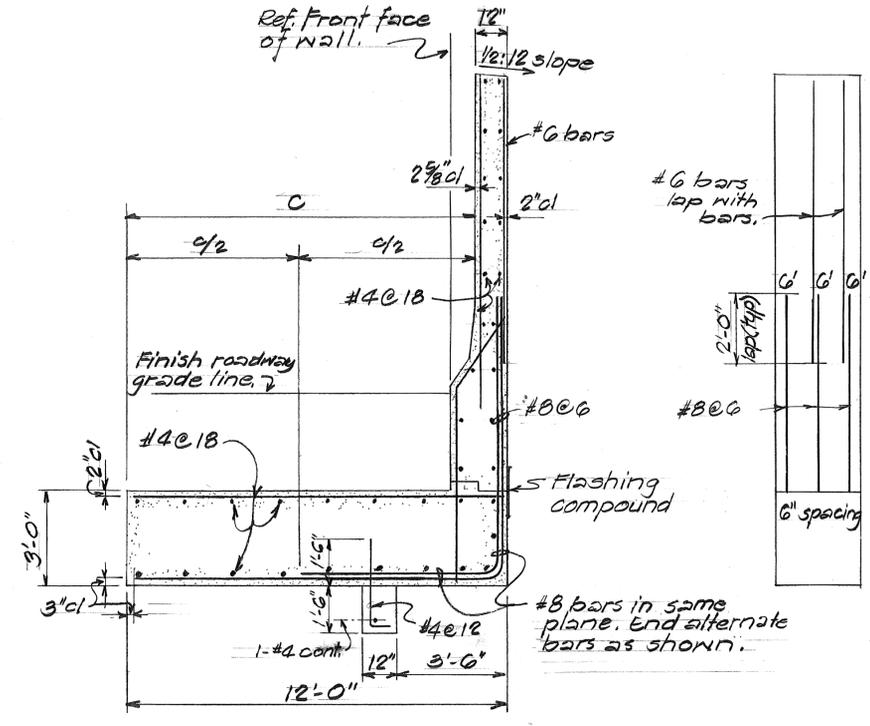


TYPICAL TYPE "L-2" h=145 WALL
Scale: 3/8"=1'-0"

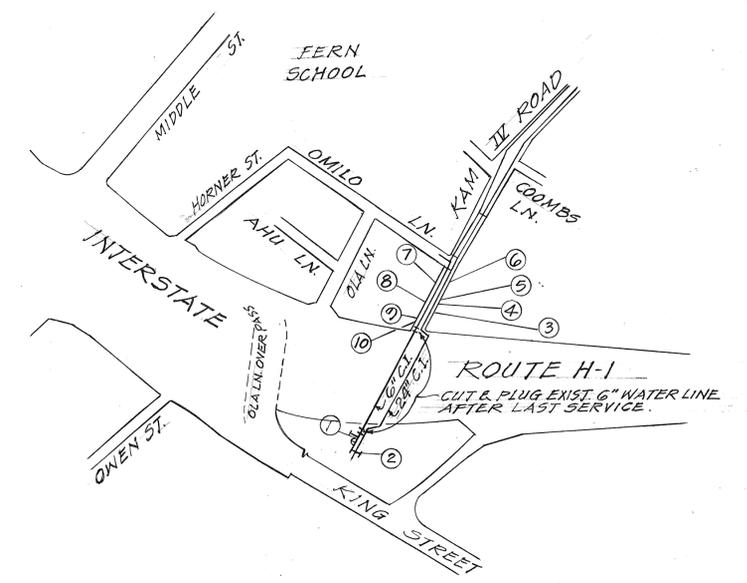

PLAN
6-INCH WATER
@ STA. 17+00±
Not to Scale

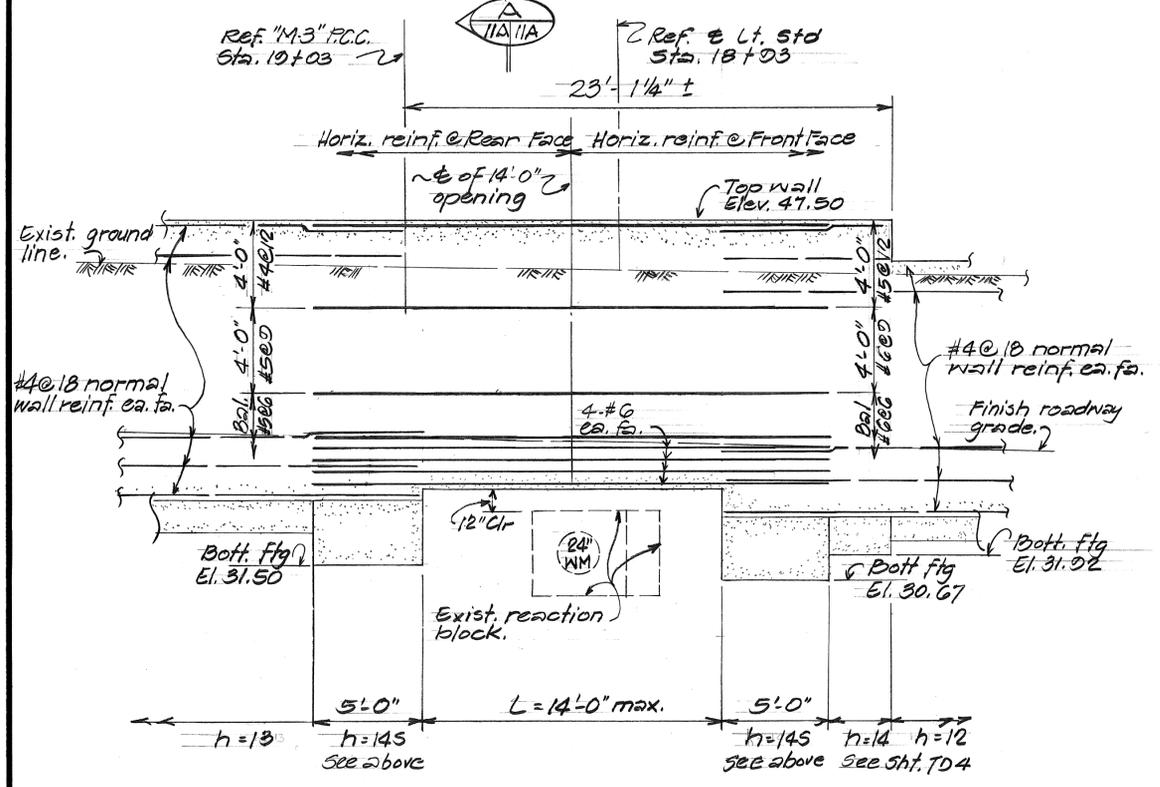

DETAIL OF OPENING IN RETAINING WALL @ 24" WATER MAIN
Scale: 1/4"=1'-0"

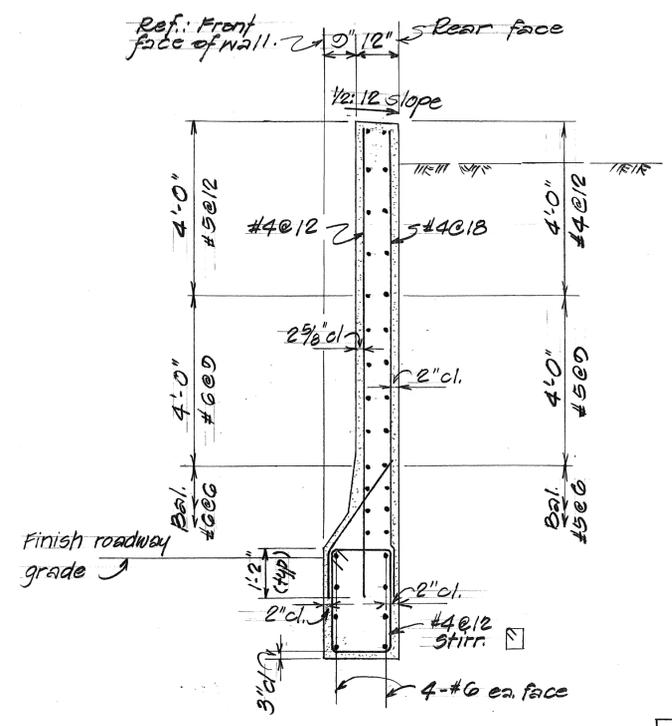


SECTION
Scale: 1/8"=1'-0"
A A

DATE	
SURVEY PLOTTED BY	
DRAWN BY	
TRACED BY	
QUANTITIES BY	
CHECKED BY	
NO.	


APPROVED: _____ Date 4-5-83
R. Uagato
CHIEF, PLANNING & ENGINEERING, BWS #

STATE OF HAWAII
DEPARTMENT OF TRANSPORTATION
LAND TRANSPORTATION FACILITIES DIVISION
RETAINING WALL M-3
INTERSTATE H-1 IMPROVEMENTS
MIDDLE STREET TO KALIHI INTERCHANGE
EASTBOUND LANES
F.A.I. PROJECT NO. I-HI-1(178)
Scale: As Noted Date: Mar. 1983
SHEET No. 11A OF 14 SHEETS

FED. ROAD DIST. NO.	STATE	FED. AID PROJ. NO.	FISCAL YEAR	SHEET NO.	TOTAL SHEETS
HAWAII	HAW.	I-HI-1(178)	1982	129	165

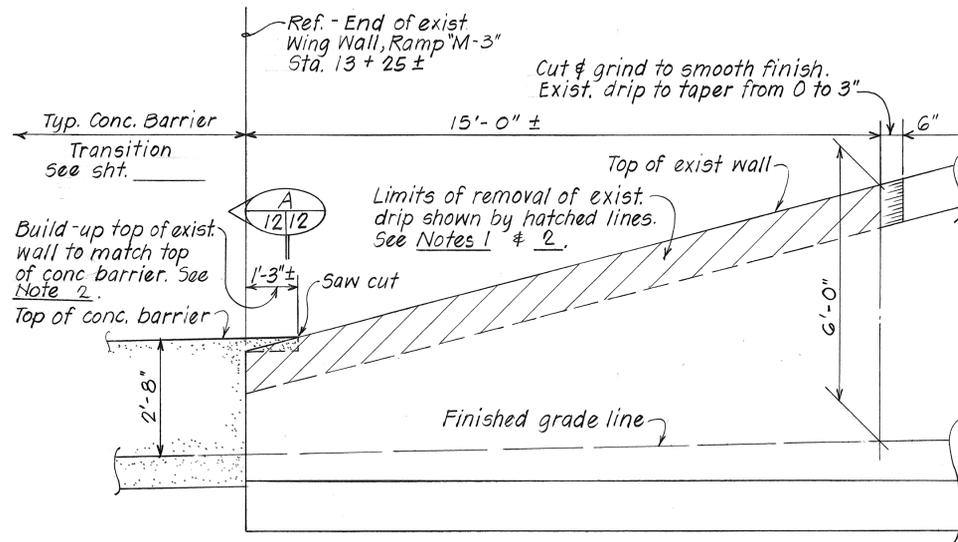


ELEVATION
DRIP MODIFICATION ON EXIST. WING WALL
AT RAMP "M-3" STA. 13+25 ±
 Scale: 1/2" = 1'-0"

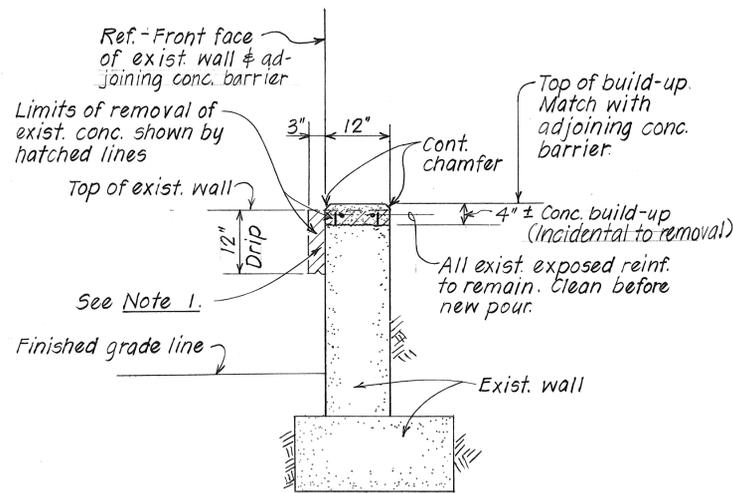


SECTION (A)
 Scale: 3/4" = 1'-0"


- NOTE:**
1. Saw cut and remove existing drip. Grind smooth to finish flush with existing wall face and top. At spalled areas apply neat coat of epoxy and restore with mortar. Work shall be incidental to concrete.
 2. Build-up at end of wall shall be incidental to removal and will not be paid for separately.

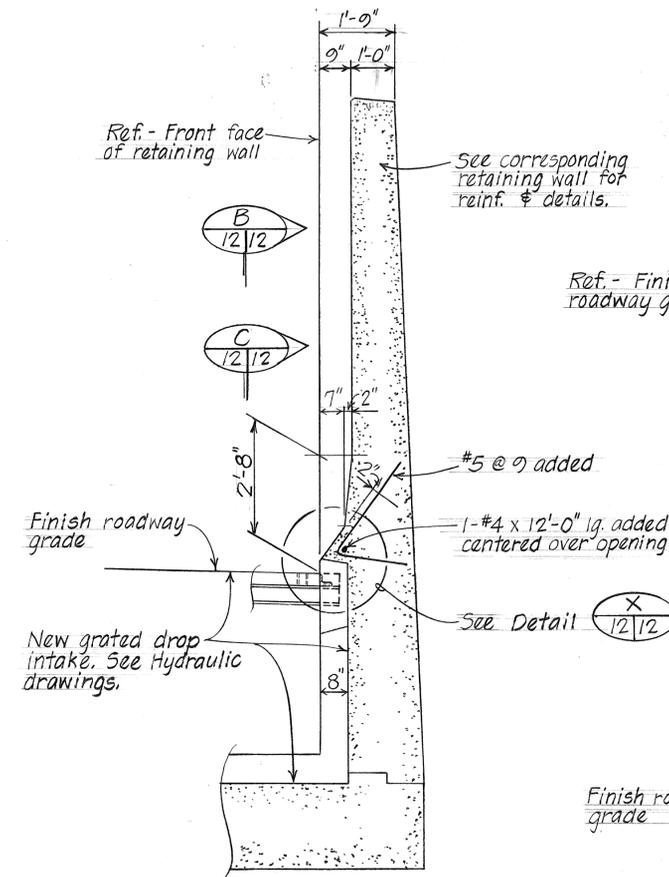


TYPICAL RETAINING WALL
AT GRATED DROP INTAKE
AT RAMP K-4 STA. 4+23.37 ±
AT RAMP K-4 STA. 2+22.3 ±
 Scale: 1/2" = 1'-0"

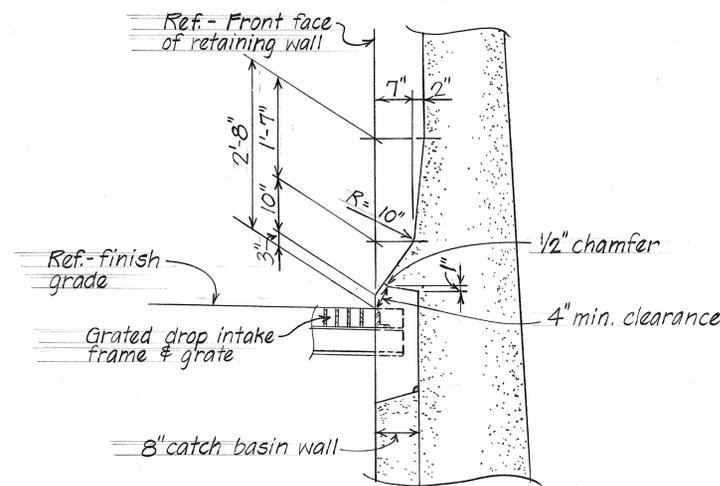

DETAIL (X)
 Scale: 3/4" = 1'-0"

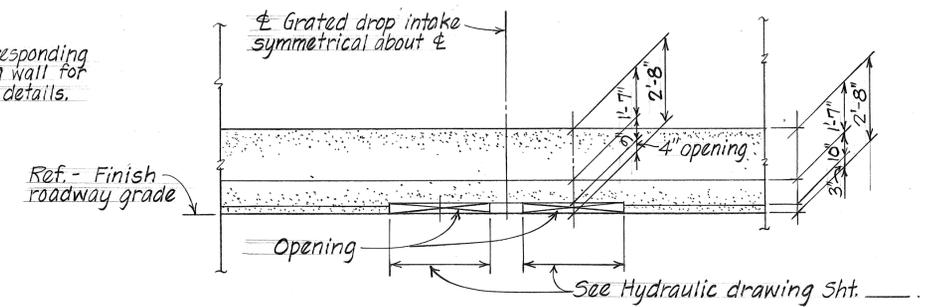

ELEVATION (B)
(SHOWING WALL OPENING)
 Scale: 3/8" = 1'-0"

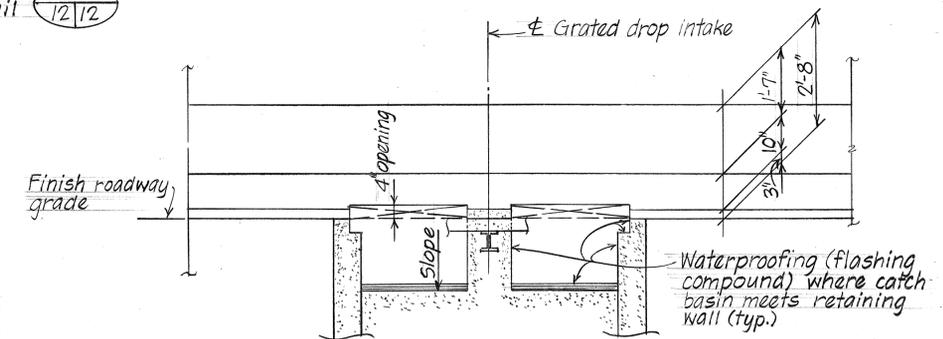


ELEVATION (C)
(SHOWING WATERPROOFING)
 Scale: 1/2" = 1'-0"

SURVEY PLOTTED BY	DATE
DRAWN BY L.M.A.	MAR 82
TRACED BY	
DESIGNED BY I.S.	MAR 82
CHECKED BY	APR 82
ORIGINAL PLAN	
NOTE BOOK	
No.	

STATE OF HAWAII
 DEPARTMENT OF TRANSPORTATION
 LAND TRANSPORTATION FACILITIES DIVISION
DRIP MODIFICATION @ RAMP "M-3" WALL
TYP. RET. WALL @ GRATED DROP INTAKE
 INTERSTATE H-1 IMPROVEMENTS
 MIDDLE STREET TO KALIHI INTERCHANGE
 EASTBOUND LANES
 F.A.I. PROJ. NO. I-HI-1(178)
 Scale: As Shown Date: April 1982
 SHEET NO. 12 OF 14 SHEETS


FED. ROAD DIST. NO.	STATE	FED. AID PROJ. NO.	FISCAL YEAR	SHEET NO.	TOTAL SHEETS
HAWAII	HAW.	I-HI-1(178)	1982	130	165

CURVE DATA		
	K-4D	K-4C
Δ	6°45'22"	1°44'13"
R	830.30'	650.68'
T	40.01'	10.00'
Lc	97.91'	20.00'

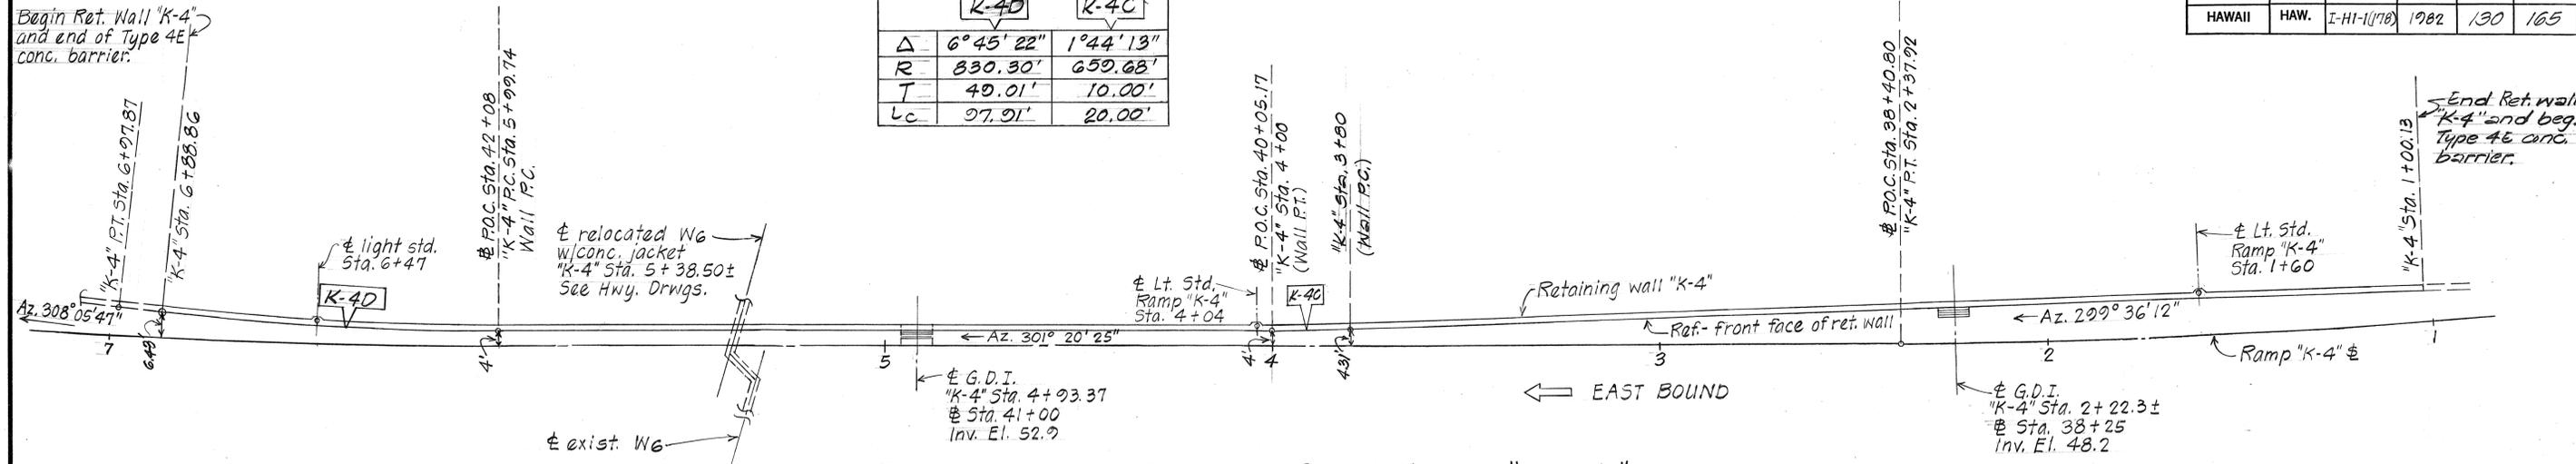

PLAN - RETAINING WALL "K-4"
Scale: 1" = 20'-0"



- REFERENCE:
- For Retaining Wall dimensions & reinf. see Typ. Details Type L-2 wall, Sht. TD-4
 - Except as noted otherwise, all longitudinal dimensions are measured horizontal & along front face of Ret. Wall.
 - Expansion joints & footing step-up details similar to that shown on Sht. DB-201-2, "Standard Details - Ret. Wall Type T-1"
 - For contraction jt. location & def. see Sht. DB-201-2

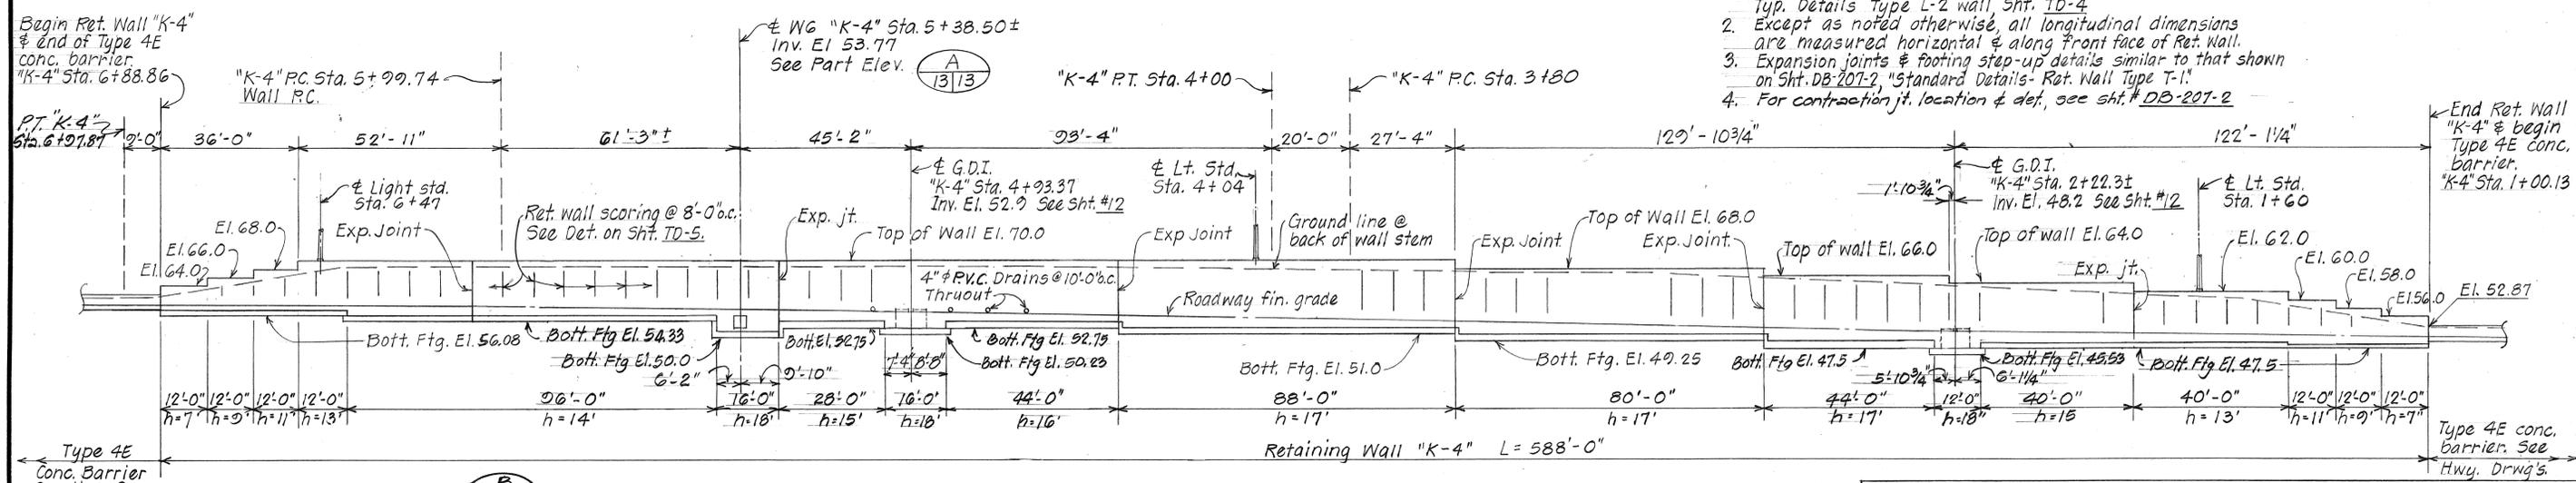

ELEVATION - RETAINING WALL "K-4"
Scale: 1" = 20'-0"

ESTIMATED QUANTITIES RETAINING WALL "K-4"			
ITEM NO.	ITEM	UNIT	QUANTITY
206.5000	Structure Excavation for Retaining Wall	C.Y.	844 C.Y.
206.7250	Structure Backfill for Retaining Wall	C.Y.	332 C.Y.
206.8200	Filter Material for Retaining Wall	C.Y.	208 C.Y.
503.1051	Concrete in Retaining Wall	LumpSum	935 C.Y.
602.0051	Reinforcing Steel in Retaining Wall	LumpSum	60,000 LBS


DATE: MAR 82
 DRAWN BY: L.M.A. S.Y.
 TRACED BY: M.L.Z.B.
 DESIGNED BY: L.S.
 CHECKED BY: M.L.Z.B.
 No. APR 82

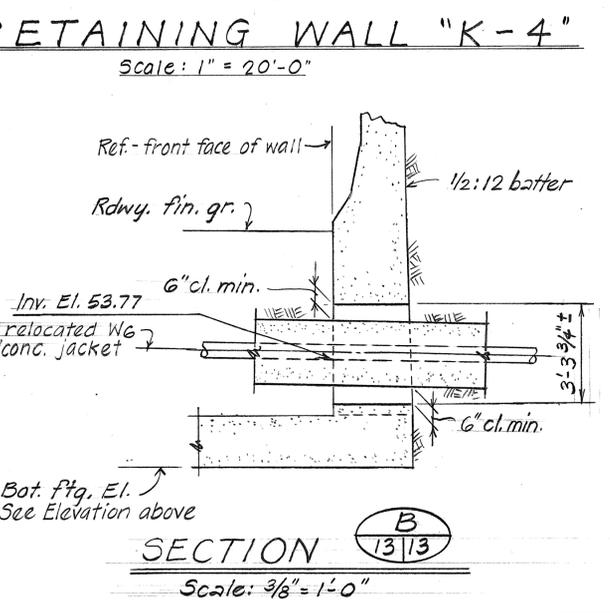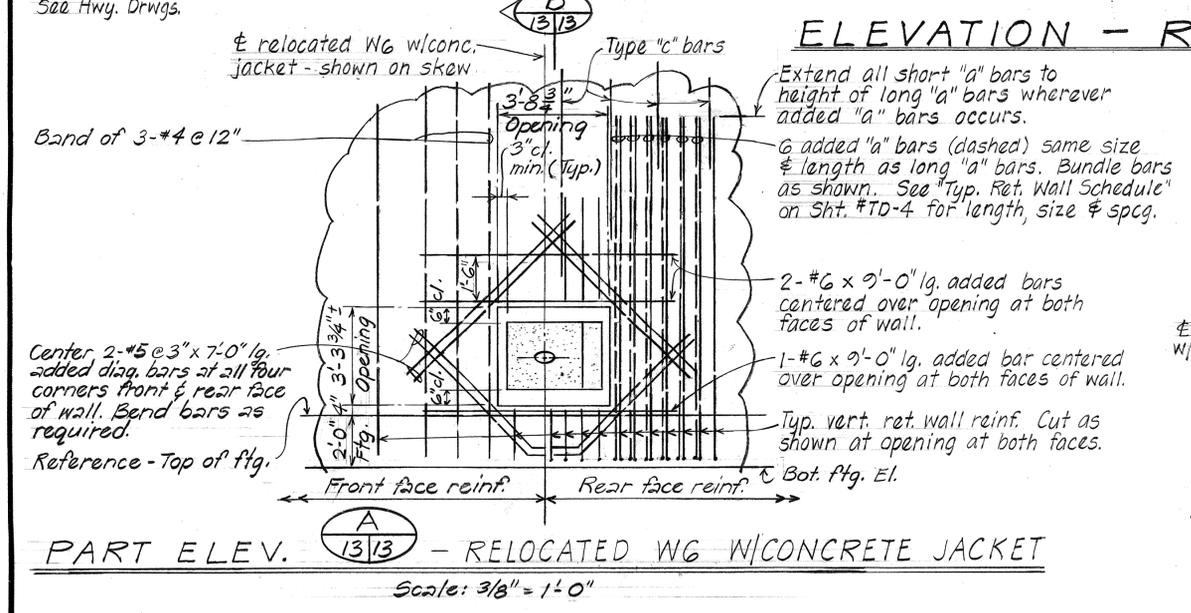


APPROVED: Date 4-30-82
 R. Nagato
 for CHIEF, PLANNING & ENGINEERING, BWS

STATE OF HAWAII
 DEPARTMENT OF TRANSPORTATION
 LAND TRANSPORTATION FACILITIES DIVISION
RETAINING WALL "K-4"
 INTERSTATE HI IMPROVEMENTS
 MIDDLE STREET TO KALIHI INTERCHANGE
 EASTBOUND LANES
 F.A.I. PROJECT NO. I-HI-1(178)
 Scale: As shown Date: April 1982
 SHEET NO. 13 OF 14 SHEETS


FED. ROAD DIST. NO.	STATE	FED. AID PROJ. NO.	FISCAL YEAR	SHEET NO.	TOTAL SHEETS
HAWAII	HAW.	I-HI-1(178)	1982	131	165

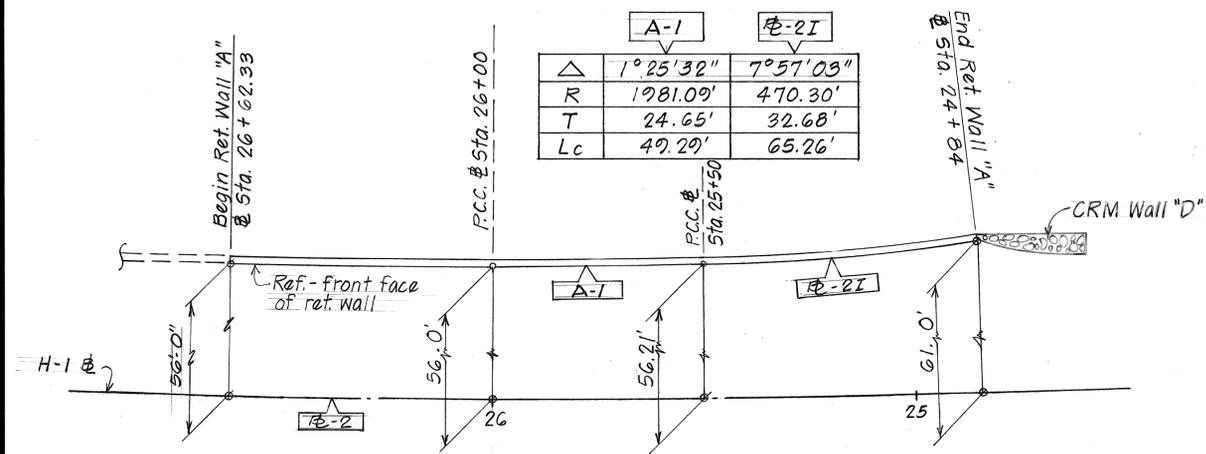


PLAN - RETAINING WALL "A"
Scale: 1" = 20'

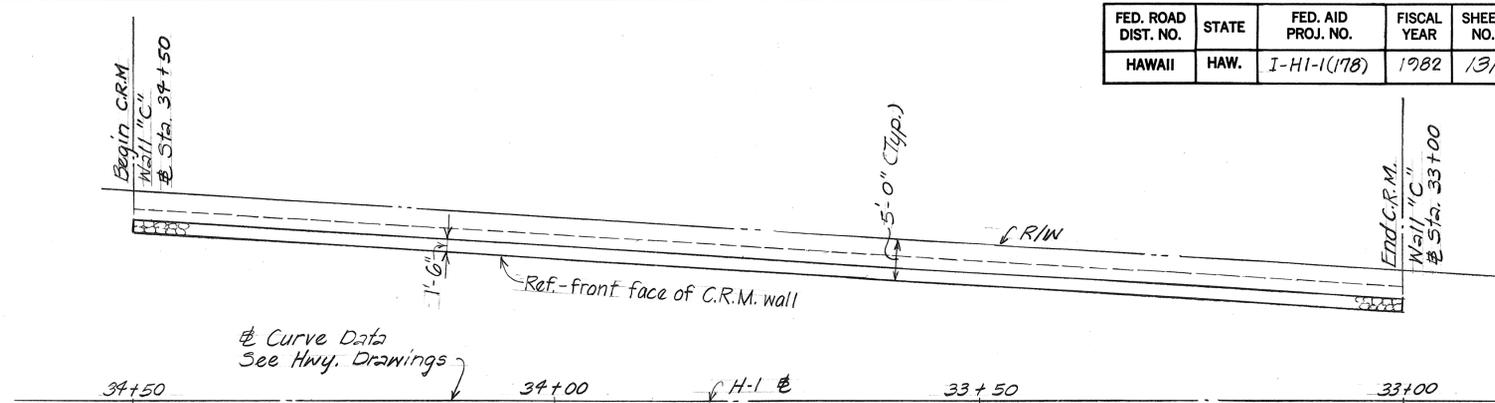

PLAN - C.R.M. WALL "C"
Scale: 1" = 10'-0"

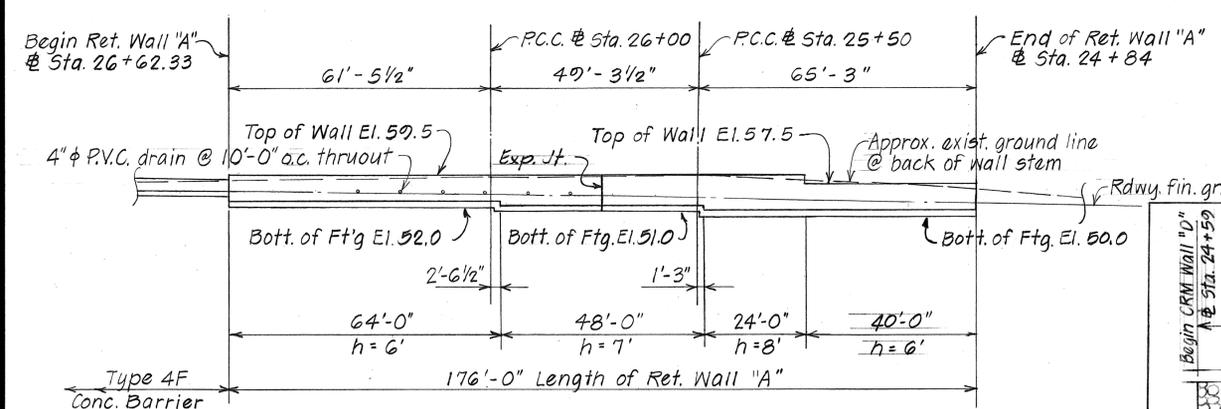


ELEVATION - RETAINING WALL "A"
Scale: 1" = 20'-0"

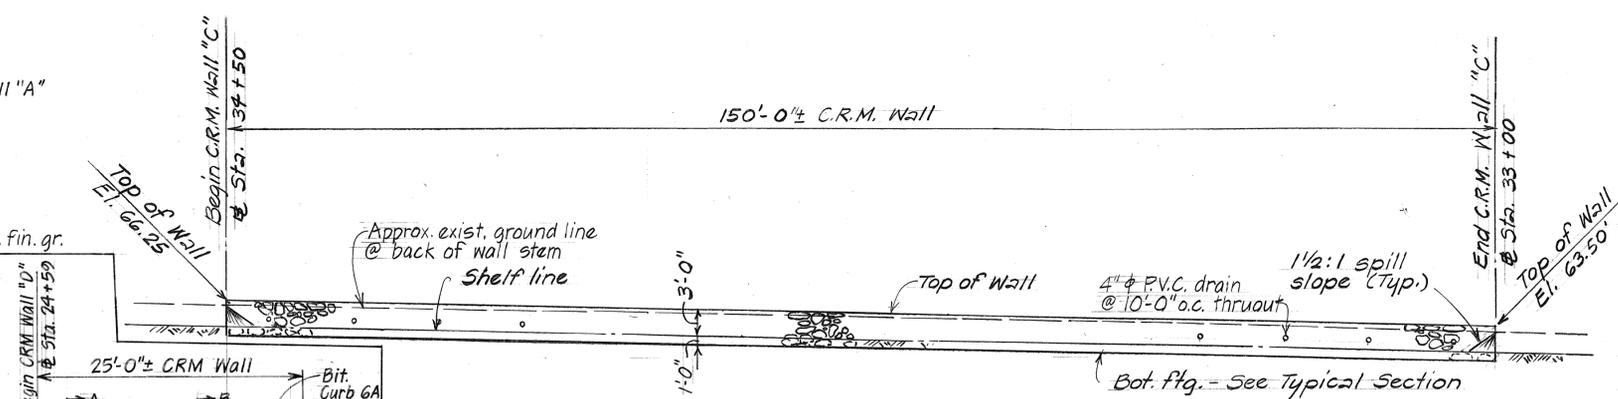

ELEVATION - C.R.M. WALL "C"
Scale: 1" = 10'-0"


- REFERENCE:**
- For retaining wall dimensions & reinforcement see Typical Detail - Type L-2 Wall, Sht. TD4.
 - Except as noted otherwise all longitudinal dimensions are measured horizontal & along front face of wall.
 - Expansion joint & footing step-up details are similar to those shown on Sht. #TD3 "Typical Details - Ret. Wall Type T-1".
 - For contraction joint location and detail, see Sht. DB-207-2.

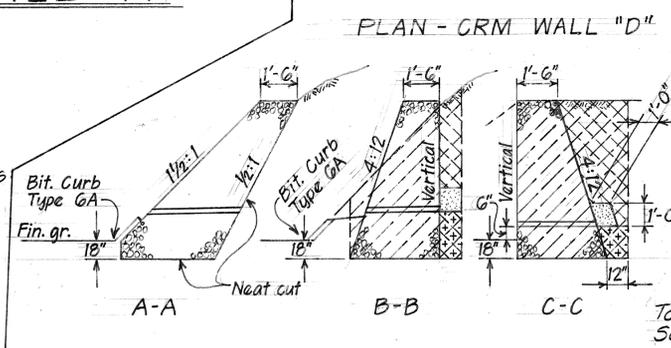

PLAN - C.R.M. WALL "D"

NOTE:
Provide filter & impervious materials thruout the wall length.
Impervious material as selected by the Engineer shall be made as impervious as possible by pneumatic tamping or other approved method.
Hatched area shown thus denotes limits of struct. excavation payline.
Hatched area shown thus denotes limits of ordinary backfill.
Dashed lines shown thus indicate limits of roadway excavation.

RETAINING WALL "A"				C.R.M. WALL "C"			
ITEM NO.	ITEM	UNIT	QUANTITY	ITEM NO.	ITEM	UNIT	QUANTITY
206.5000	Structure Excavation for Retaining Wall	C.Y.	63 C.Y.	206.5000	Structure Excavation for Wall	C.Y.	80 C.Y.
206.7250	Structure Backfill for Retaining Wall	C.Y.	33 C.Y.	206.7250	Structure Backfill for Wall	C.Y.	28 C.Y.
206.8200	Filter Material for Retaining Wall	C.Y.	29 C.Y.	206.8200	Filter Material for Wall	C.Y.	6 C.Y.
503.1051	Concrete in Retaining Wall	LumpSum	96 C.Y.	508.0100	Cement Rubble Masonry	C.Y.	48 C.Y.
602.0051	Reinforcing Steel in Retaining Wall	LumpSum	6000 Lbs.				

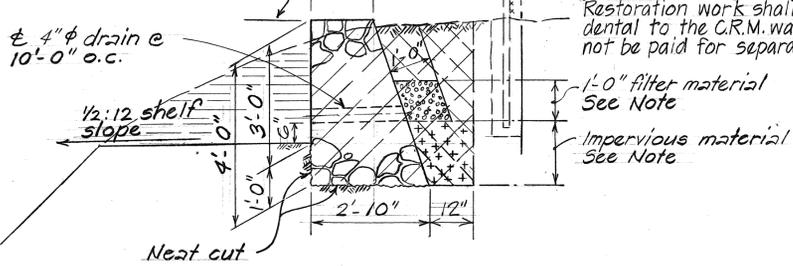

TYPICAL SECTION - C.R.M. WALL
Scale: 1/2" = 1'-0"

STATE OF HAWAII
DEPARTMENT OF TRANSPORTATION
LAND TRANSPORTATION FACILITIES DIVISION

RETAINING WALL "A"
C.R.M. WALL "C"


INTERSTATE H-1 IMPROVEMENTS
MIDDLE STREET TO KALIHI INTERCHANGE
EASTBOUND LANES
F.A.I. PROJ. NO. I-HI-1(178)

Scale: As Shown Date: April 1982



SHEET NO. 14 OF 14 SHEETS

SURVEY PLOTTED BY: L.M.A. DATE: MAR. 83
 DESIGNED BY: T.S. MAR. 82
 CHECKED BY: APR. 82
 ORIGINAL PLAN NO. NO.

FED. ROAD DIST. NO.	STATE	FED. AID PROJ. NO.	FISCAL YEAR	SHEET NO.	TOTAL SHEETS
HAWAII	HAW.	I-HI-1(178)	1982	732	765

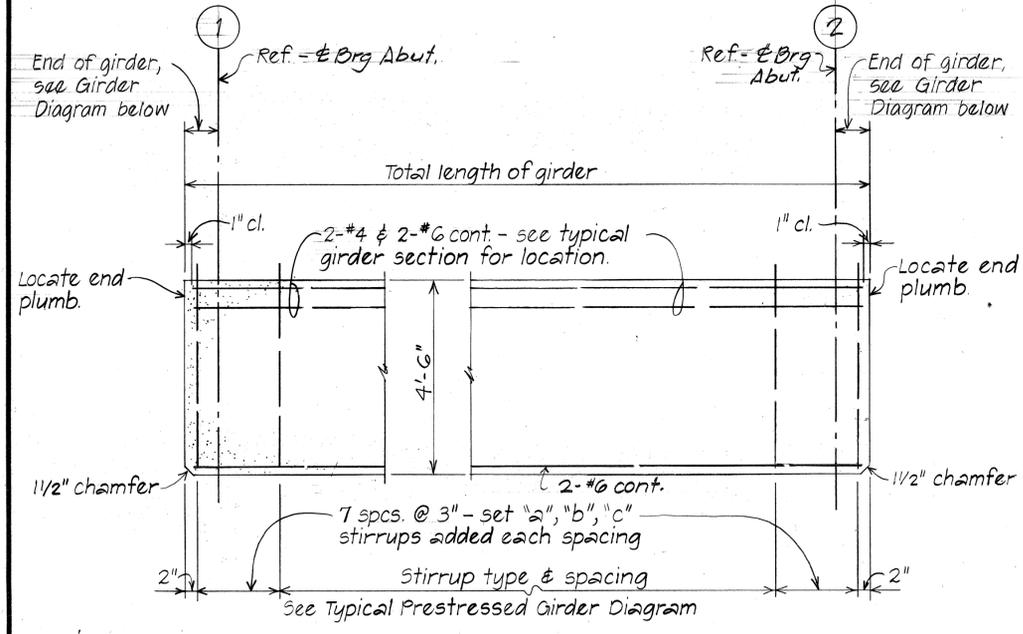

ELEVATION ~ TYPE PG-IV GIRDER END DETAILS
No Scale

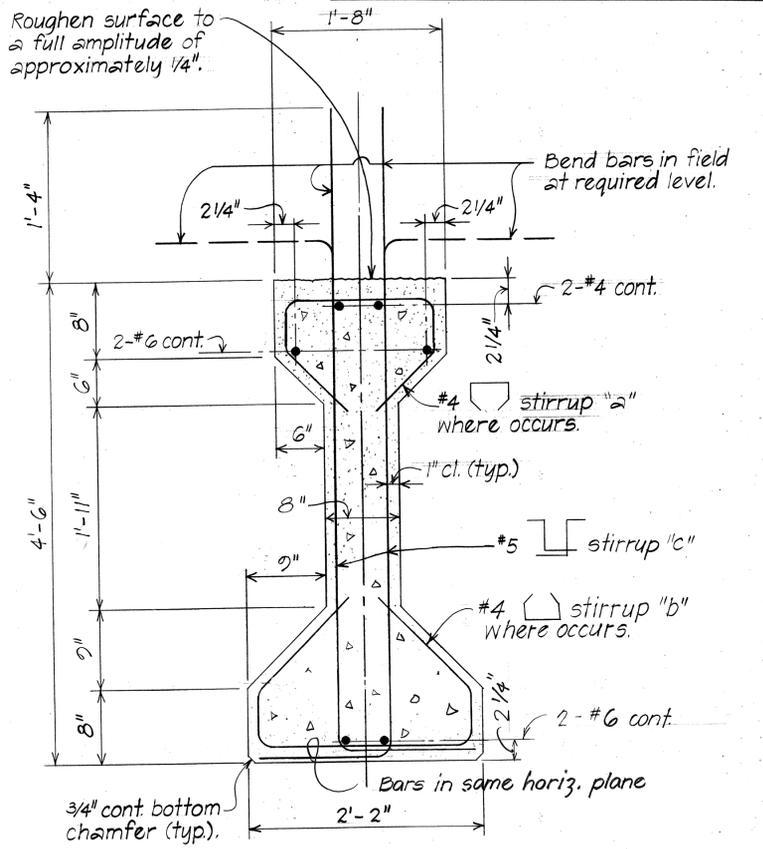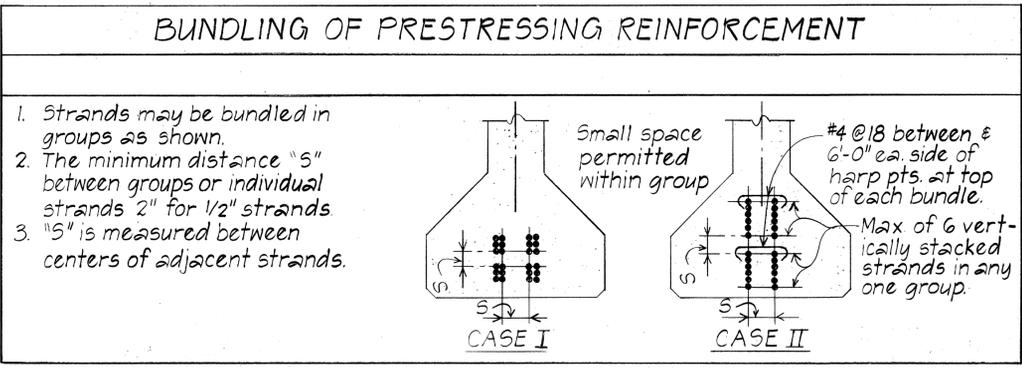

TYPICAL PRESTRESSED CONCRETE GIRDER TYPE PG-IV
No Scale

GENERAL NOTES

1. All strand patterns shall be approved by the Engineer.
2. Forms must be removed and the beams inspected before strands are cut.
3. For additional holes and inserts in prestressed girders for beam connections refer to corresponding beam details. See sht. #2.
4. For additional prestressed girder details not covered by these drawings refer to corresponding detail plans.
5. The calculated camber includes the effect of the initial prestress force and the weight of the girder upon removal from the stressing bed. Calculated camber values shown do not account for any camber growth of the girder. The actual camber at time of deck pour shall not exceed the calculated camber by more than 100%. Calculated midspan camber = 1.0 inch. Contractor shall submit record of cambers to the Engineer. This record shall include cambers at time of detensioning, delivery and deck pour.

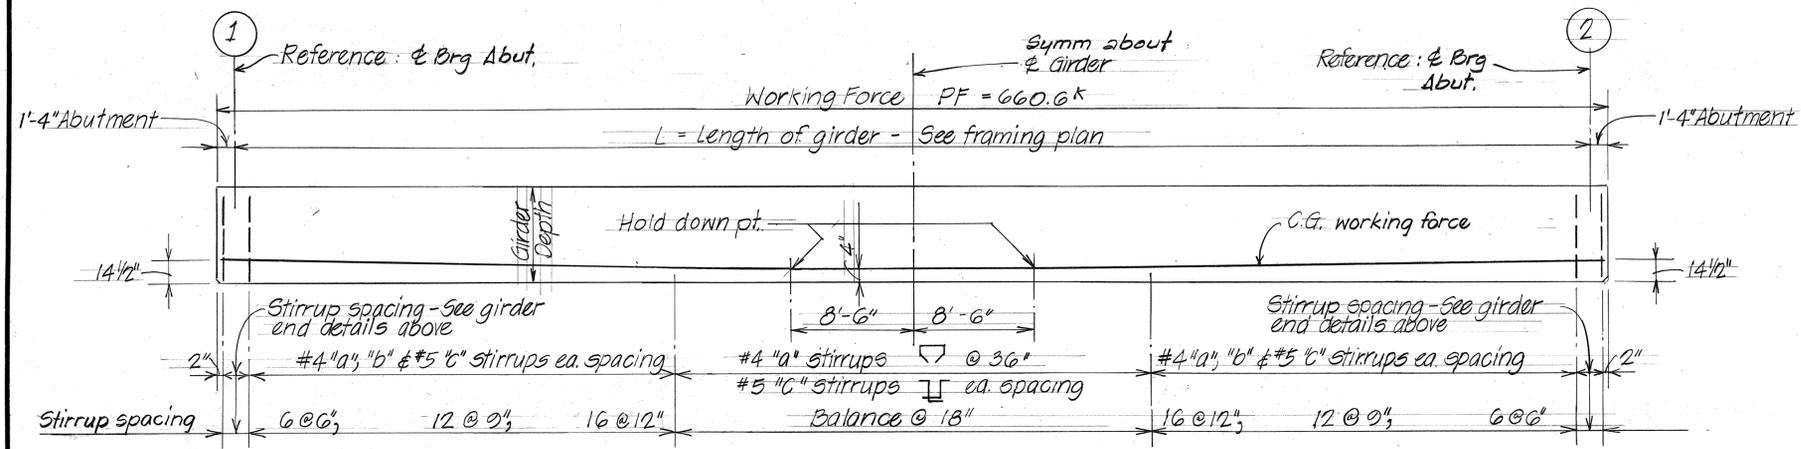


DIAGRAM - TYPICAL PRESTRESSED GIRDER DETAIL TYPE PG IV

PRESTRESSED CONCRETE GIRDERS:
 $f'_c = 5500$ psi @ 28 days
 $f_{ci} = 4,000$ psi @ transfer

PRESTRESSED STRANDS:
 A. 1/2" ϕ 270 ksi, 7 wire stressed-relieved strands (ASTM A416)
 Total losses other than friction = 45,000 psi
 B. Allowable stresses in strands shall be in accordance with Design Specifications. (See General Structure Notes)

DATE	
SURVEY PLOTTED BY	
DRAWN BY	E.K.
CHECKED BY	D.C.G.
QUANTITIES BY	
NOTE BOOK	
No.	

STATE OF HAWAII
DEPARTMENT OF TRANSPORTATION
LAND TRANSPORTATION FACILITIES DIVISION


TYPICAL DETAILS
PRESTRESSED GIRDER
(TYPE PG-IV)

F.A.I. PROJ. NO. I-HI-1(178)





Scale: As noted Date: April 1978

SHEET No. TD1 OF 75 SHEETS

FED. ROAD DIST. NO.	STATE	FED. AID PROJ. NO.	FISCAL YEAR	SHEET NO.	TOTAL SHEETS
HAWAII	HAW.	I-HI-1(178)	1982	133	165

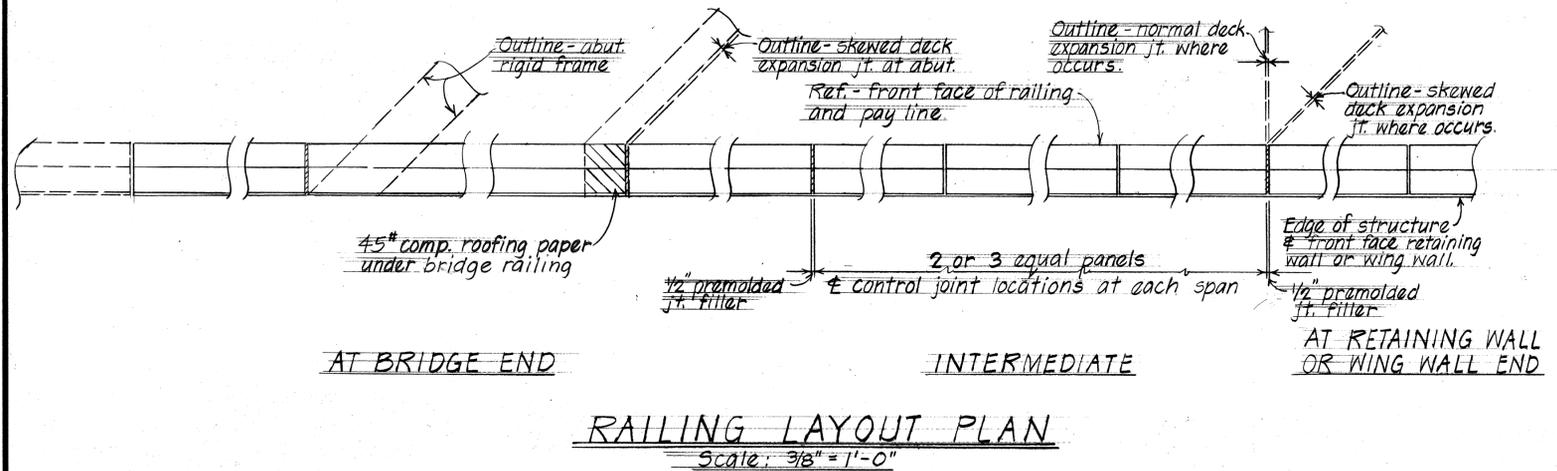



** Railing section shall be constructed on deck slope with 2 or 3 equal panels at each deck span and 32'-0" max. length each panel. Locate control joints at interior panel points (typical). Concrete railing to receive Class 2 rubbed finish. See specifications.

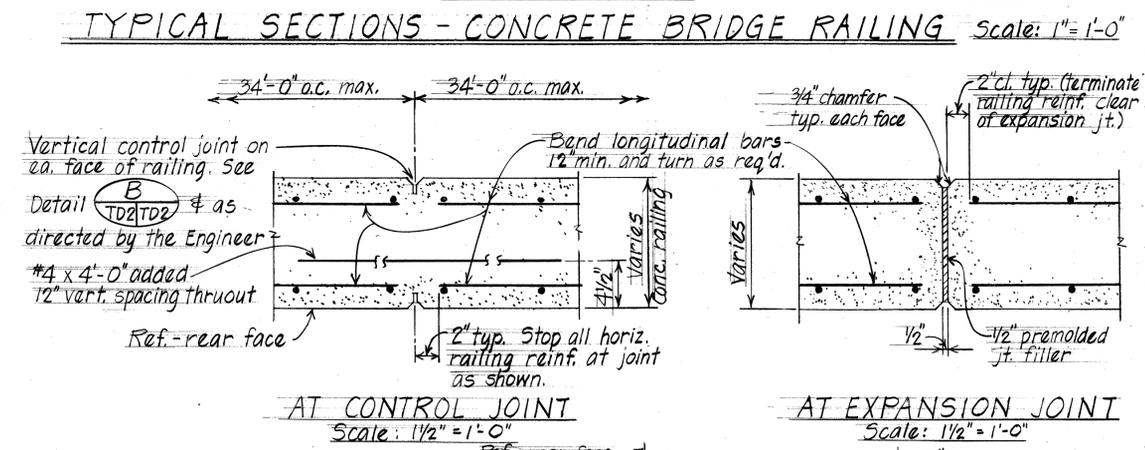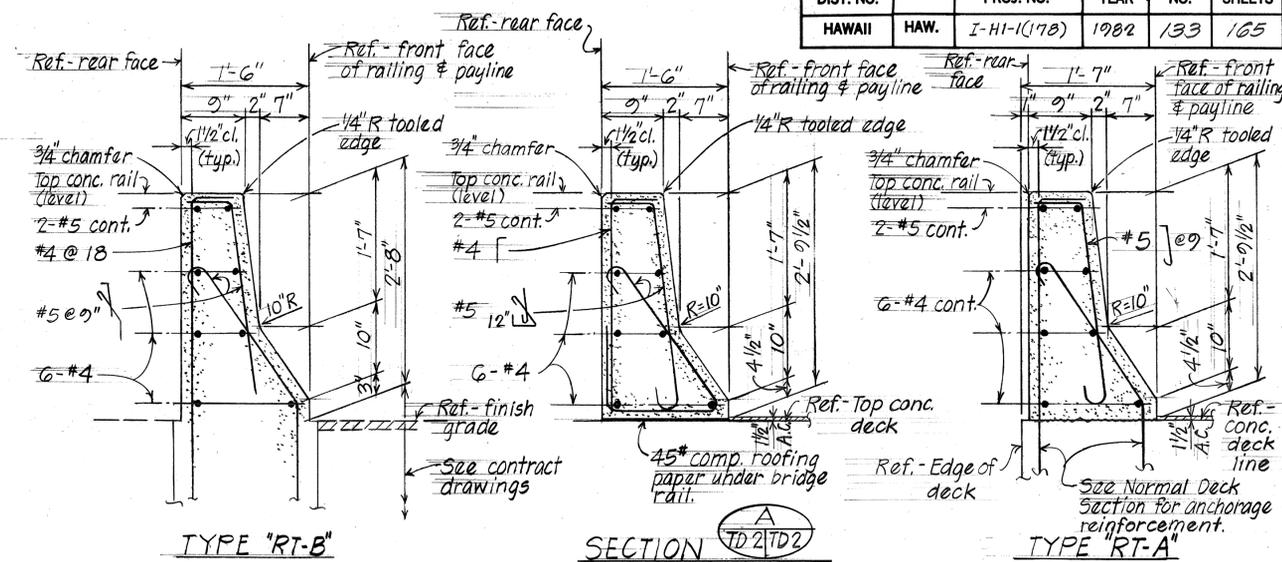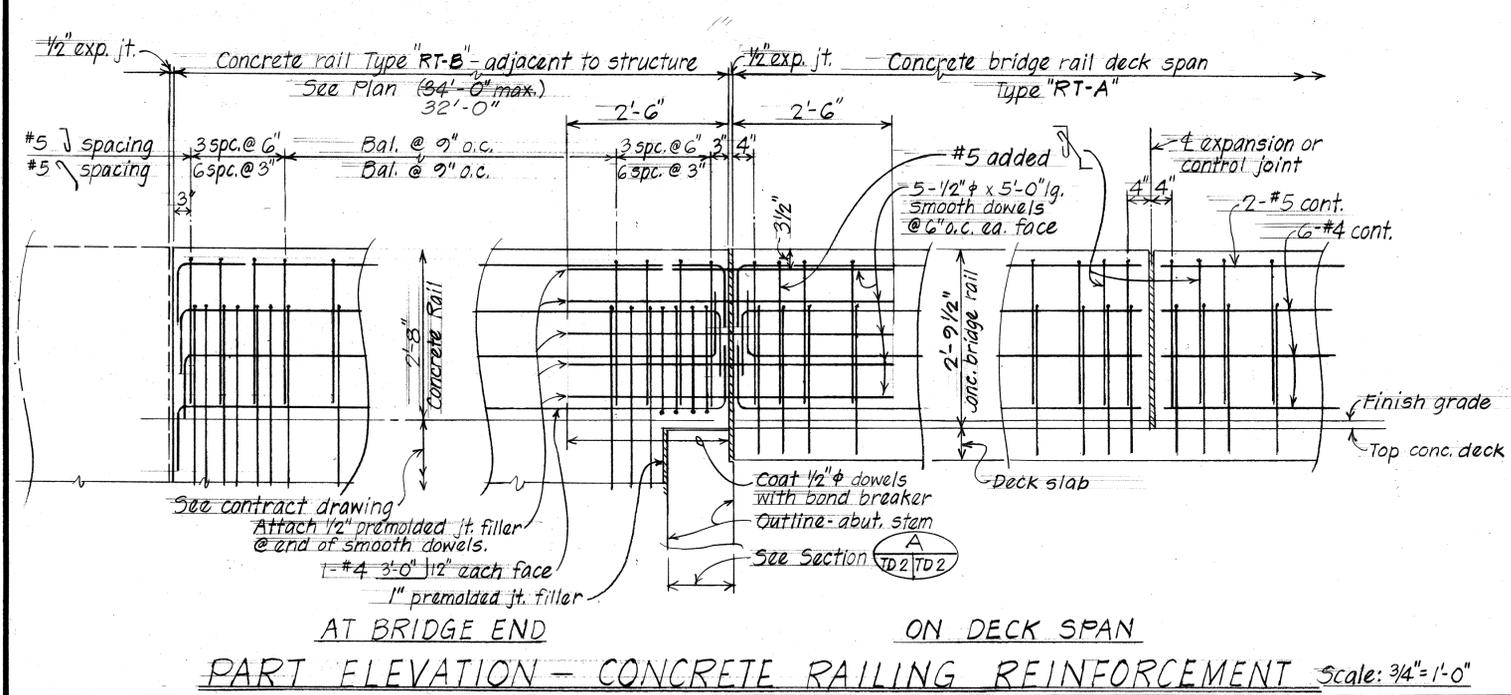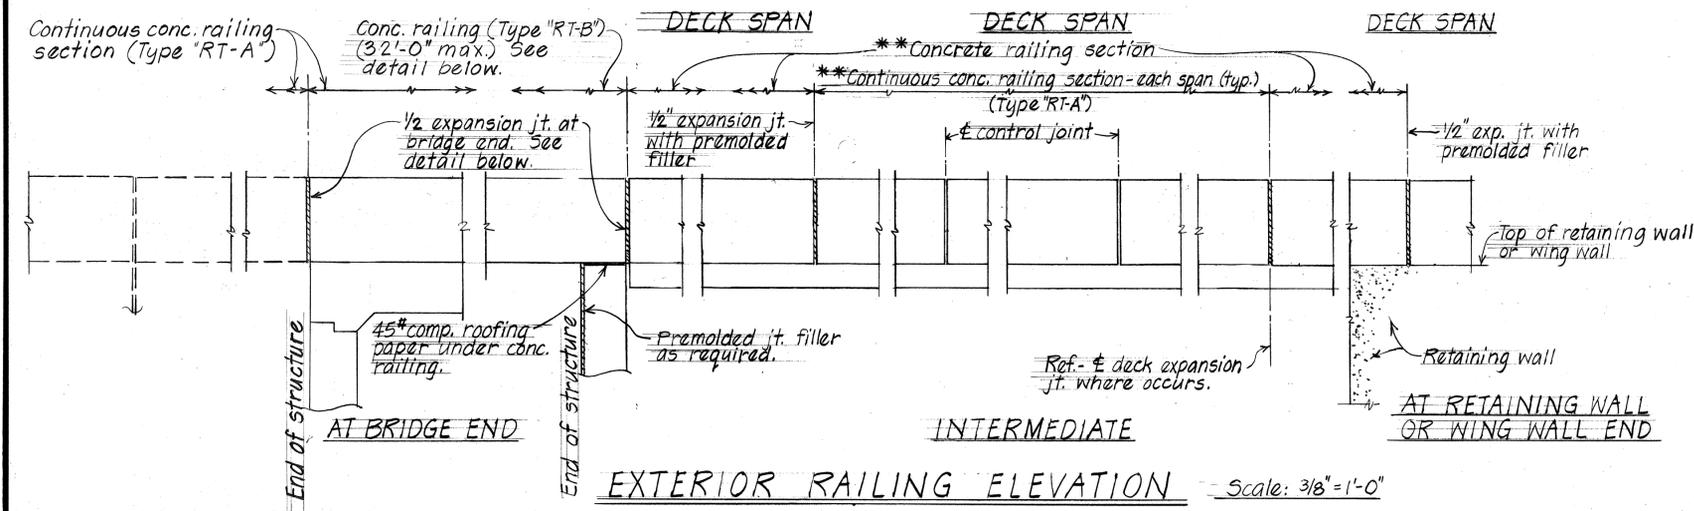

SURVEY PLOTTED BY	DATE
DRAWN BY	
DESIGNED BY	
QUANTITIES BY	
CHECKED BY	
ORIGINAL PLAN NO.	
NOTE BOOK NO.	
CHECKED BY	


STATE OF HAWAII
DEPARTMENT OF TRANSPORTATION
LAND TRANSPORTATION FACILITIES DIVISION
TYPICAL DETAILS
CONCRETE BRIDGE RAILING
TRAFFIC TYPE
F.A.I. PROJ. NO. I-HI-1(178)
Scale: As Shown Date: April 1982
SHEET NO. TD2 OF TD5 SHEETS

MAXIMUM h	4'	5'	6'	7'	8'	9'	10'						
a	0.50'	0.50'	0.50'	0.50'	1.00'	1.00'	1.00'						
t (min)	14"	14"	14"	14"	14"	14"	14"						
L	4.25'	5.00'	5.50'	6.00'	6.75'	7.25'	7.75'						
Batter	0.0	0.0	0.0	0.0	0.0	0.0	0.0						
"a" bars	#3@12	#4@12	#4@9	#4@8	#5@8	#5@6	#6@7						
"b" bars	#3@12	#5@12	#4@9	#5@8	#5@8	#5@6	#6@7						
"c" bars	—	—	—	—	#4	#4	#5						

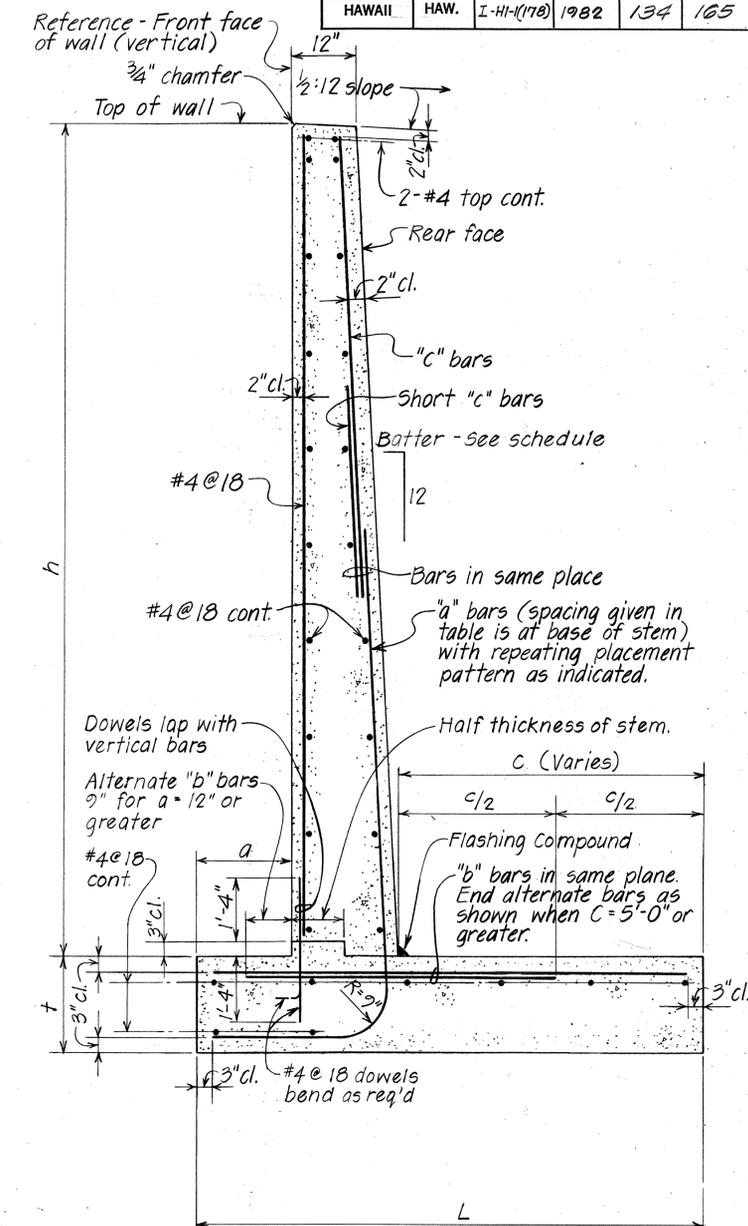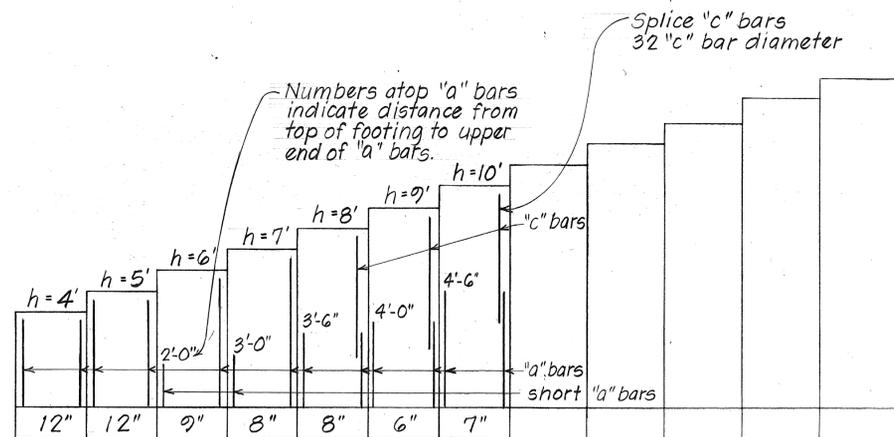

NOTE:
HATCHED AREA
 • Hatched area shown thus denotes limits of structure excavation payline. All other excavation shall be roadway excavation.
 • Hatched area shown thus denotes limits of structure backfill (or ordinary backfill).

IMPERVIOUS MATERIAL
 • Impervious material as selected by the Engineer shall be incidental to structure excavation. When "y" is 2'-0" or less, all backfill below weep hole level shall be impervious material.
 • The subgrade upon which filter material is to be placed shall be made as impervious as possible by pneumatic tamping or other approved methods.
 • Impervious material shall be incidental to roadway excavation or imported borrow when used in embankment area.

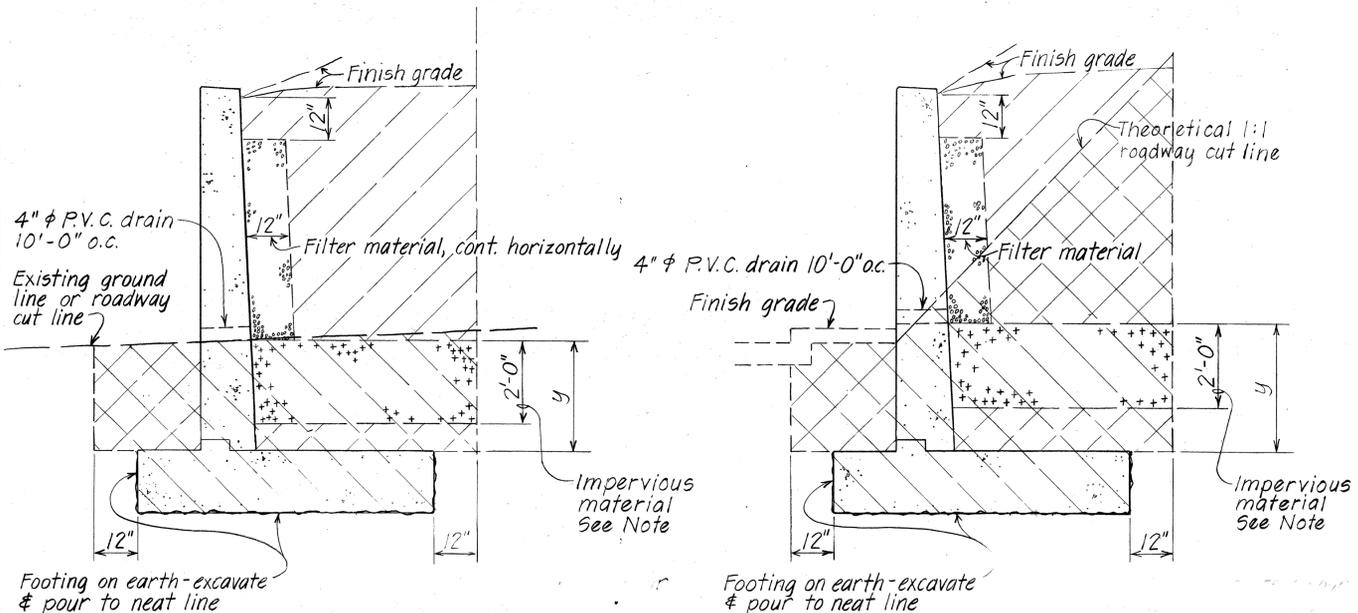

STRUCTURE EXCAVATION & DRAINAGE DETAILS
 Not to scale

STATE OF HAWAII
 DEPARTMENT OF TRANSPORTATION
 LAND TRANSPORTATION FACILITIES DIVISION
TYPICAL DETAILS
RETAINING WALL TYPE T-1
 F.A.I. PROJ. NO. I-HI-1(178)
 Scale: As Shown Date: April 1982
 SHEET NO. TD3 OF TD5 SHEETS


ORIGINAL SURVEY PLOTTED BY: _____ DATE: _____
 PLAN DRAWN BY: _____
 TRACED BY: _____
 NOTE BOOK DESIGNED BY: _____
 QUANTITIES BY: _____
 CHECKED BY: _____
 No. _____

FED. ROAD DIST. NO.	STATE	FED. AID PROJ. NO.	FISCAL YEAR	SHEET NO.	TOTAL SHEETS
HAWAII	HAW.	I-HI-1(178)	1982	135	165


TYPE "L-2" WALL SCHEDULE OF DIMENSIONS AND REINFORCING STEEL

Maximum h	4'	5'	6'	7'	8'	9'	10'	11'	12'	13'	14'	15'	16'	17'	18'	19'	20'
t	14"	14"	14"	14"	14"	14"	14"	14"	14"	18"	21"	21"	21"	24"	24"	24"	27"
L	2.5'	3.0'	3.5'	4.25'	5.0'	6.0'	6.75'	7.75'	8.25'	9.75'	10.0'	10.5'	11.25'	12.5'	13.75'	16.0'	16.75'
D	12"	12"	12"	12"	12"	12"	12"	12"	18"	18"	18"	18"	18"	18"	18"	18"	18"
"B"	0	0	0	0	0	0	0	0	0	0	.5	.5	.5	.5	.5	.5	.5
"a" bars	#3@12	#3@12	#4@12	#4@12	#4@9	#5@9	#5@8	#6@8	#6@6	#6@5	#6@6	#6@5	#7@6	#7@6	#8@6	#8@5	#8@5
"c" bars	—	—	—	—	—	—	—	—	—	#5	#5	#5	#5	#6	#6	#7	#7


Reference:
 • For additional footing & exp joint details- See Std Details - Retaining Wall Type T-1 Sht. DB-207-2

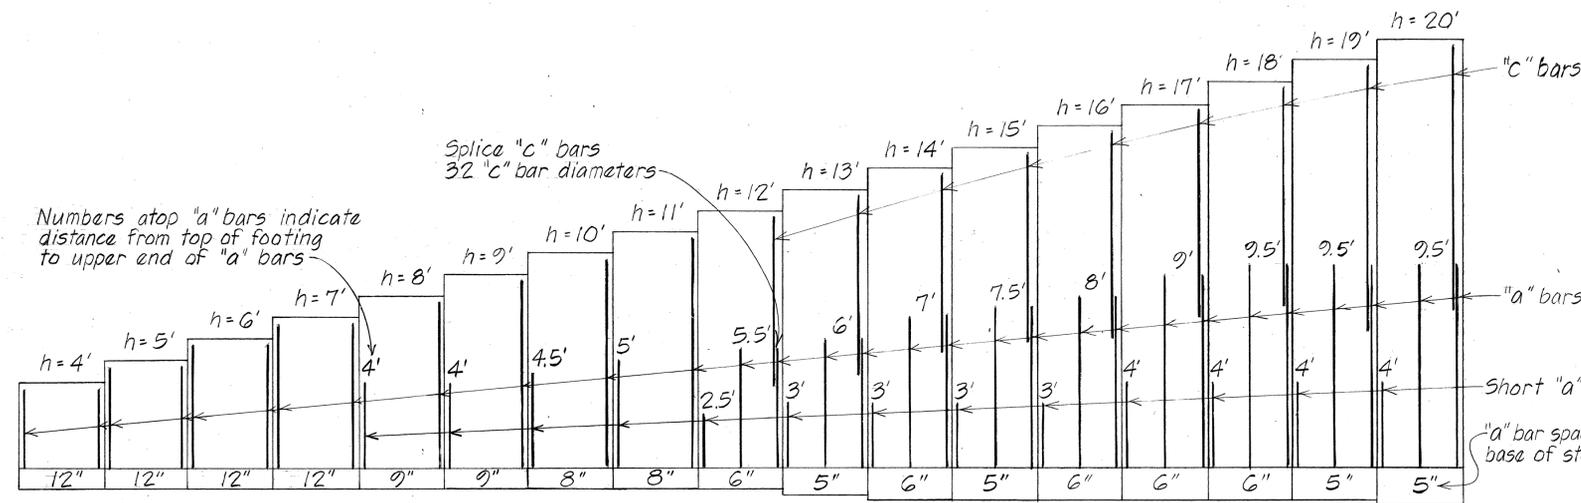

VERTICAL REINFORCING STEEL ARRANGEMENT
 Not to scale.

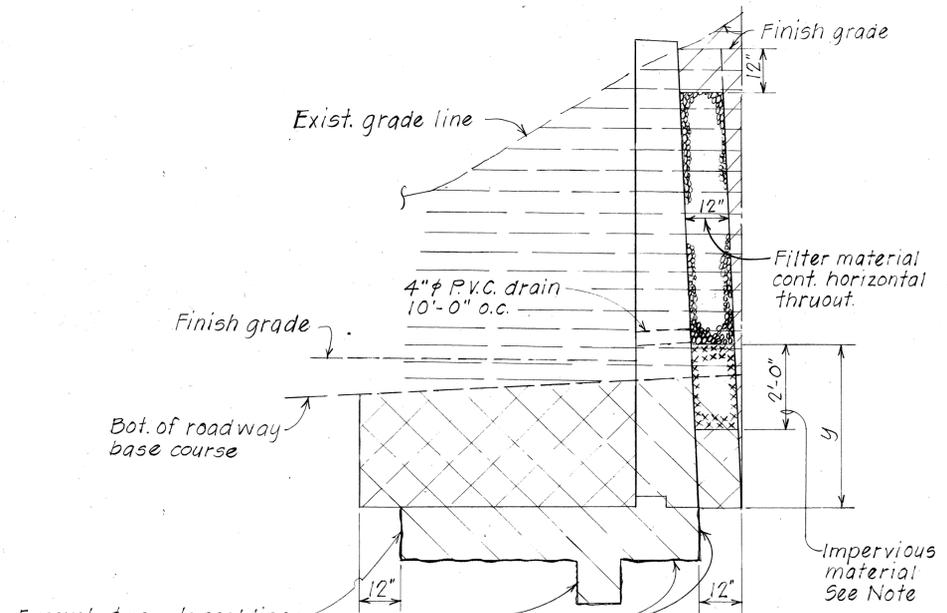

STRUCTURE EXCAVATION & DRAINAGE DETAIL
 Not to scale.

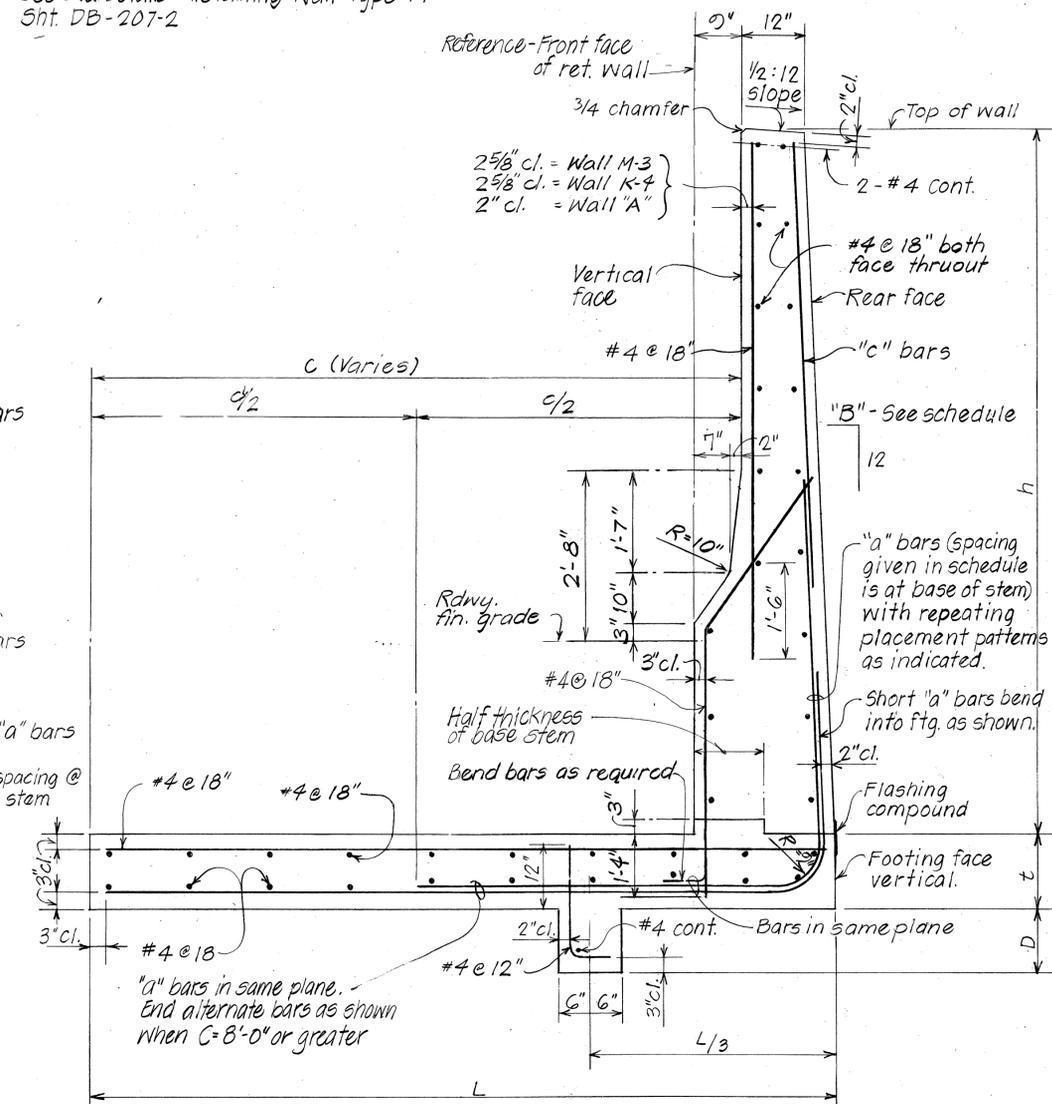

TYPICAL SECTION - TYPE "L-2" WALL Not to scale

NOTES:

- MARKED AREAS**
- Dashed lines shown thus denotes limits of roadway excavation.
 - Hatched area shown thus denotes limits of structure excavation payline. All other excavation shall be roadway excavation.
 - Hatched area shown thus denotes limits of structure backfill (or ordinary backfill).

IMPERVIOUS MATERIAL

- Impervious material as selected by the Engineer shall be incidental to structure excavation. When "y" is 2'-0" or less, all backfill below weep hole level shall be impervious material.
- The subgrade upon which filter material is to be placed shall be made as impervious as possible by pneumatic tamping or other approved methods.
- Impervious material shall be incidental to roadway excavation or imported borrow when used in embankment area.


DATE: _____
 SURVEY PLOTTED BY: _____
 DRAWN BY: _____
 TRACED BY: _____
 NOTE BOOK: _____
 DESIGNED BY: _____
 QUANTITIES BY: _____
 CHECKED BY: _____
 No. _____

STATE OF HAWAII
 DEPARTMENT OF TRANSPORTATION
 LAND TRANSPORTATION FACILITIES DIVISION


TYPICAL DETAILS
TYPE "L-2" WALL

F.A.I. PROJ. NO. I-HI-1(178)
 Scale: As Shown Date: April 1982
 SHEET NO. TC4 OF TD 5 SHEETS


FED. ROAD DIST. NO.	STATE	FED. AID PROJ. NO.	FISCAL YEAR	SHEET NO.	TOTAL SHEETS
HAWAII	HAW.	I-HI-1(178)	1982	136	165

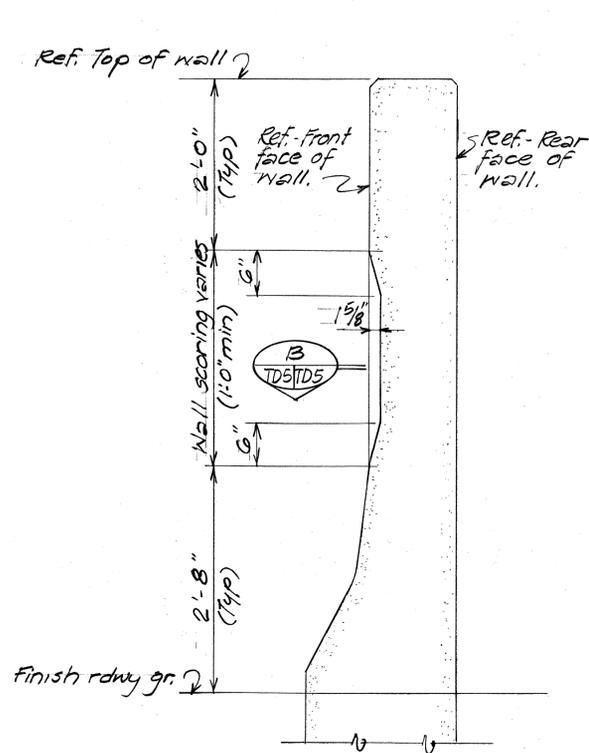


SECTION A
Scale: 1"=1'-0"

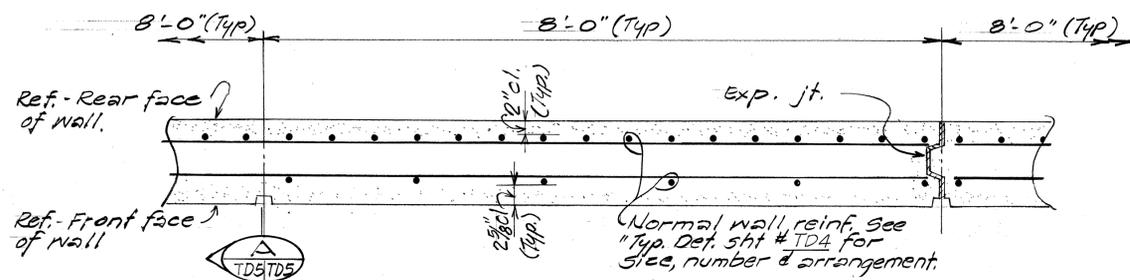


PART PLAN
Scale: 1"=1'-0"

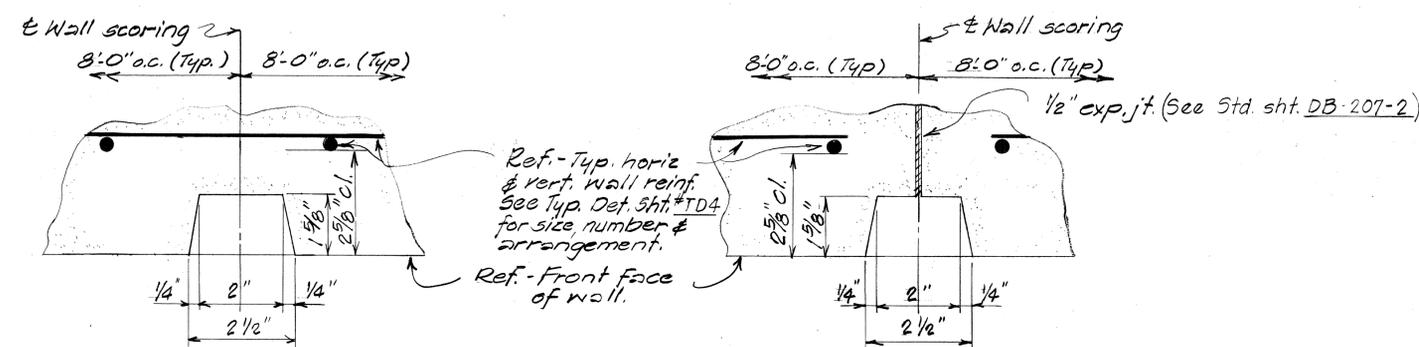


SECTION B
Scale: 6"=1'-0"

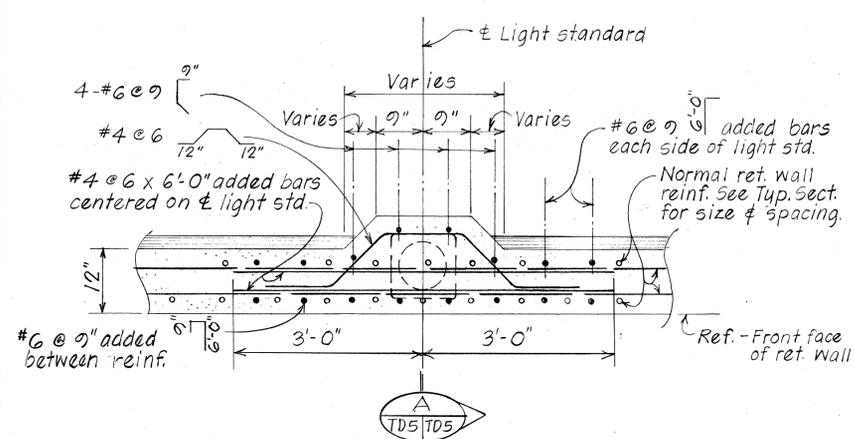

PART PLAN

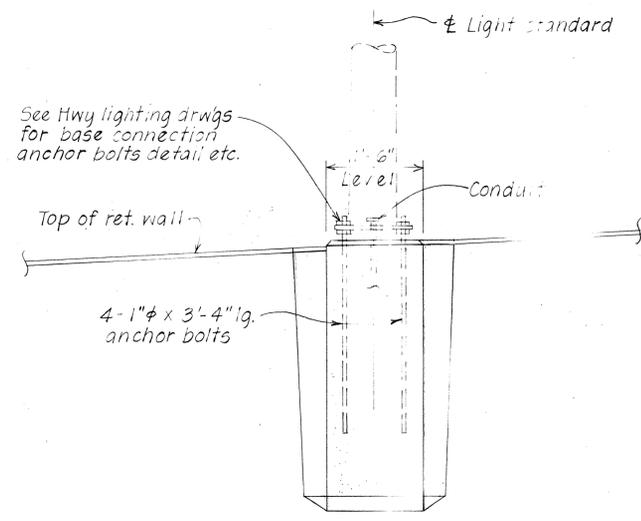

ELEVATION

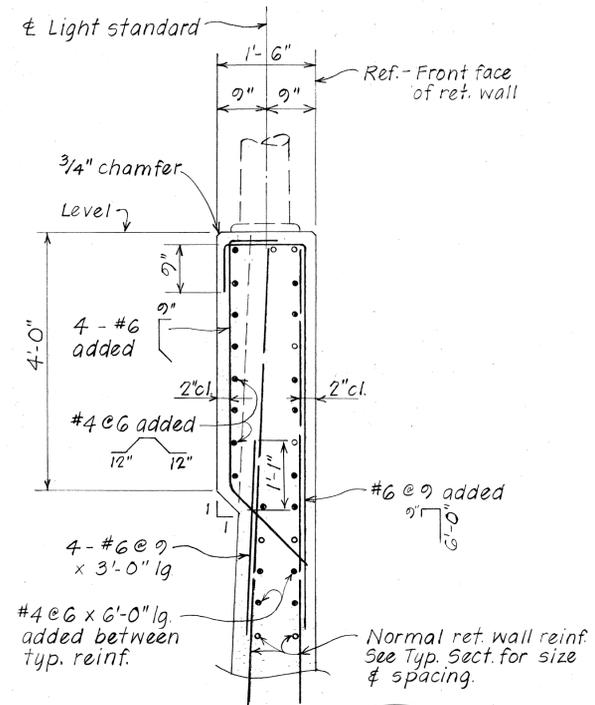

SECTION A

TYP. LIGHT STANDARD DETAILS - AT RET. WALLS "M-3" & "K-4"

Scale: 3/4"=1'-0"

SURVEY PLOTTED BY	DATE
DRAWN BY	Apr. 82
TRACED BY	Mar. 82
DESIGNED BY	T. S.
CHECKED BY	Apr. 82
ORIGINAL PLAN	No.
NOTE BOOK	No.

STATE OF HAWAII
DEPARTMENT OF TRANSPORTATION
LAND TRANSPORTATION FACILITIES DIVISION

TYPICAL DETAILS
WALL SCORING



F.A.I. PROJECT NO. I-HI-1(178)
Scale: As Shown Date: Apr. 1982
SHEET NO. 136 OF 165 SHEETS

GENERAL NOTES

- 1- All concrete shall be Class A unless otherwise noted.
- 2- Reinforcing shall be detailed in accordance with A.C.I. Manual of Standard Practice for Detailing Reinforced Concrete Highway Structures unless otherwise noted.
- 3- Clearance for reinforcing bars shall be as follows, unless otherwise noted:
 - a - 1/2" for stirrups of beams & pier caps.
 - b - 2" for ties of columns.
 - c - 2" for formed walls.
 - d - 3" for footings.
- 4- Minimum spacing between parallel bars shall be 2 1/2 times the diameter of bars, but in no case shall the clear distance between the bars be less than 1 1/2 times the maximum size of the coarse aggregate.
- 5- All dimensions relating to reinforcing are to centers of bars unless otherwise noted.
- 6- Reinforcing bars shall be securely tied at all intersections & lap splices & shall be held in place during pouring to maintain their proper locations as shown on plans.
- 7- Vertical column bars shall be arranged in such a manner as to miss pier cap bars above as directed by the Engineer.
- 8- Except as otherwise noted on drawings, all exterior corners & re-entrant angles in concrete work shall be chamfered 3/4" x 3/4".
- 9- Concrete seats receiving steel plates, lead plates or neoprene pads shall be poured monolithically with supporting structures & top of concrete seats shall be finished with a steel trowel to a smooth level surface at the elevation shown on the plans.
- 10- Elastomeric Pads: Bottom of bridge bearing pads shall be secured against displacement with adhesives approved by the Engineer. Pads shall be incidental to concrete and will not be paid for separately.
- 11- Forms for all exposed surfaces of separation structures and surfaces of retaining walls visible from a traveled way or from a populated area shall be plywood except that metal forms may be permitted provided a surface finish satisfactory to the Engineer can be obtained and the use of such forms is approved in writing by the Engineer. Forms for round columns shall be made of materials that will give a smooth finish and true dimensions as given in the plans. Forms for prestressed concrete members shall be other metal or plywood.
- 12- Gothic letters and figures approximating dimensions shown will be acceptable if approved by the Engineer.
- 13- The contractor shall verify the location of all existing utility lines and notify the respective owners before commencing work of excavation or driving of piles.
- 14- Standard Detail Drawings refer to all structures in general, except for modifications as may be required for special conditions. For such modifications refer to the corresponding detailed drawings.




TYPICAL CONCRETE GROOVE DETAIL

DRIP DETAIL

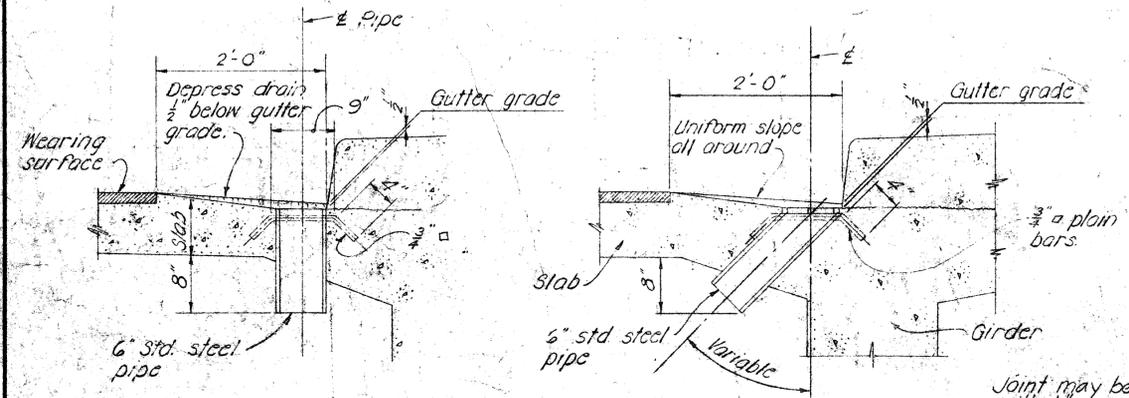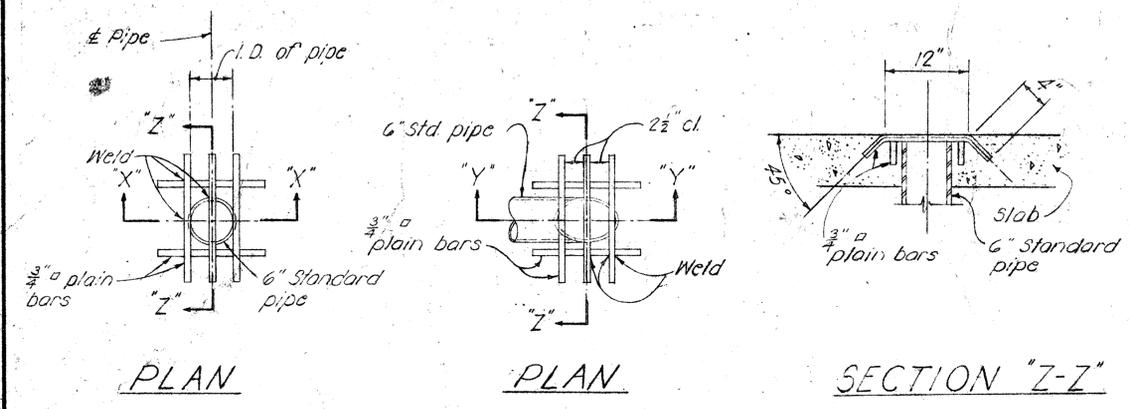

NOTE: Metal drains shall be considered incidental to Class A Concrete in both concrete and steel bridges and will not be paid for separately. Assembly of grillage and pipe shall be hot-dip galvanized after all welding is completed.




TYPICAL DRAINAGE DETAILS

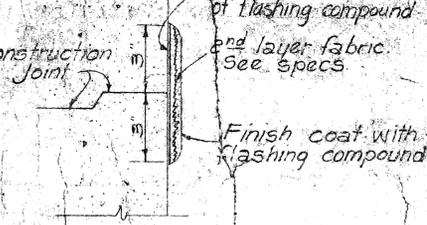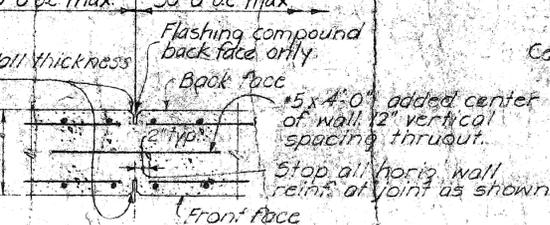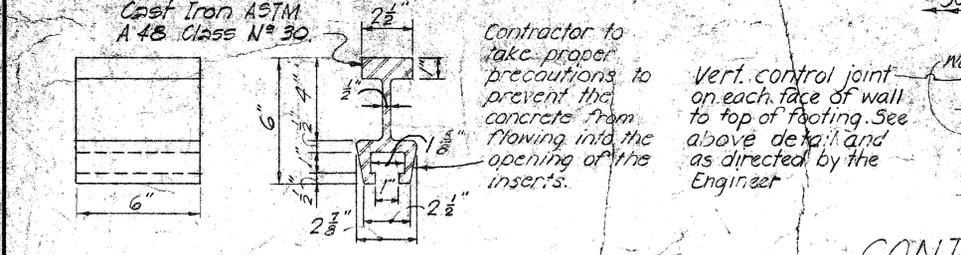

INSERT DETAIL

CONTROL JOINT DETAILS

TYP. FLASHING COMPOUND WATERPROOFING DETAIL

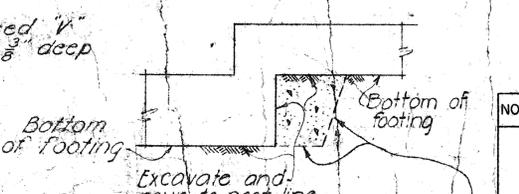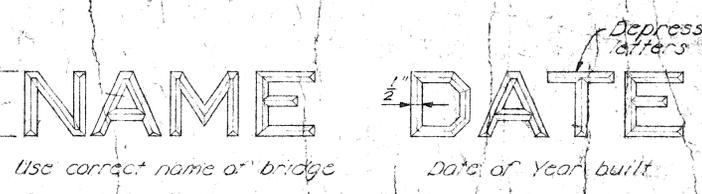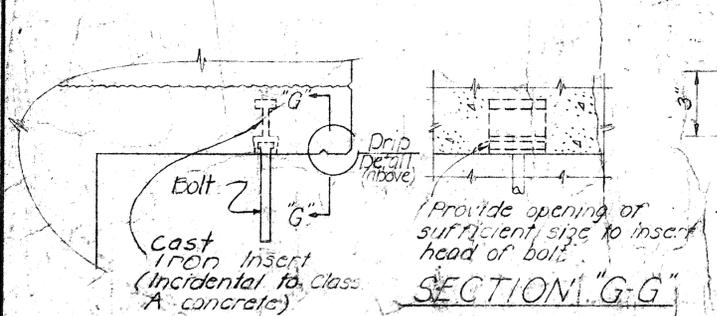

DETAIL OF PIPE HANGERS & INSERTS

TYPICAL DETAIL OF LETTERS & FIGURES AT CONCRETE END POST

TYPICAL EXCAVATION FOR CONTINUOUS FOOTING STEP-UP

APPROVAL RECOMMENDED:
Paul T. Umasuta 1-23-79
 BRIDGE DESIGN ENGINEER DATE

APPROVED
Paul T. Umasuta 1-28-79
 ASSISTANT CHIEF, ENGINEERING DATE

NO.	REVISION	APPROVED BY	DATE

STATE OF HAWAII
 DEPARTMENT OF TRANSPORTATION
 HIGHWAYS DIVISION


STANDARD DETAILS

NOTES AND MISCELLANEOUS
 DETAILS


Date: October, 1982

NOTE:
Spacing of joints
Expansion = 06'-0" max.
Contraction = 32'-0" max.


For alternate contraction joint and control joint details - See Standard Details Sht. #DB-100

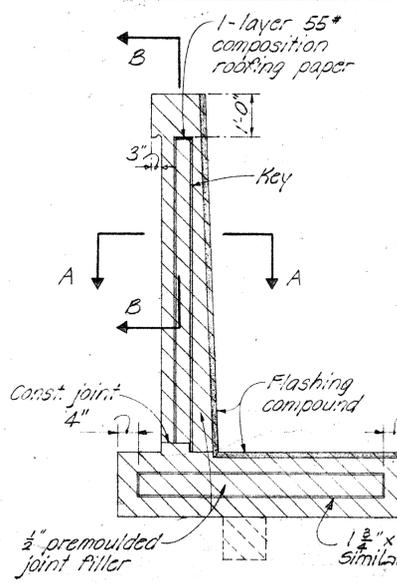


JOINT ELEVATION

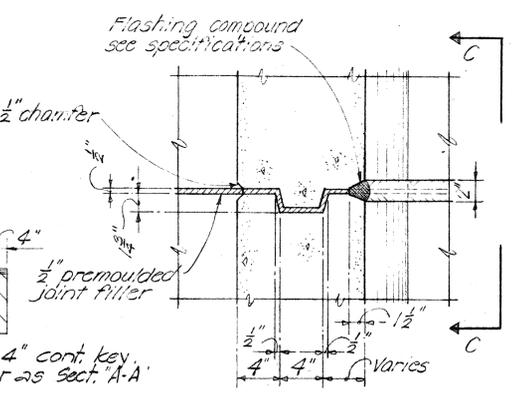


SECTION A-A

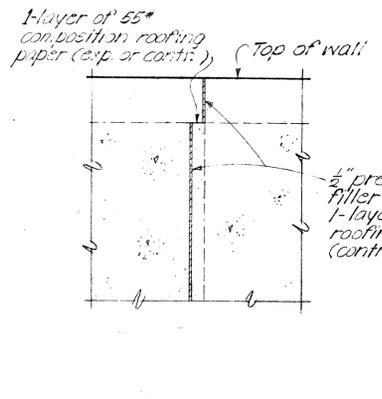


SECTION B-B

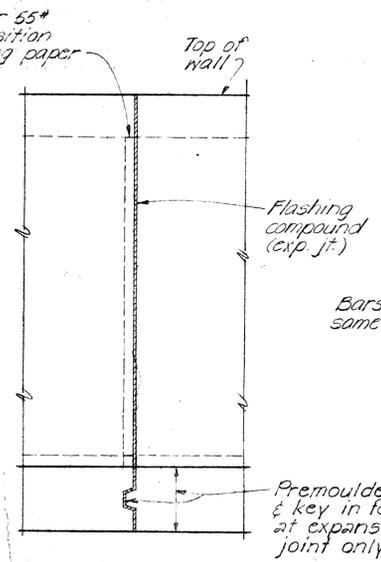

SECTION C-C

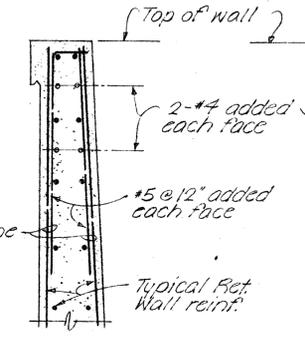


SECTION D-D

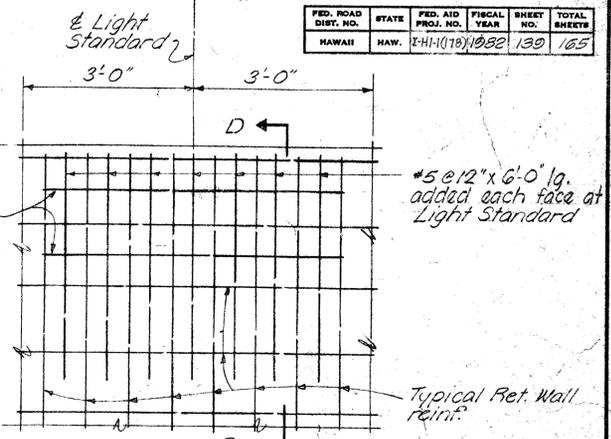


ELEVATION

TYPICAL ADDED REINFORCEMENT AT LIGHT STANDARD BASE No Scale

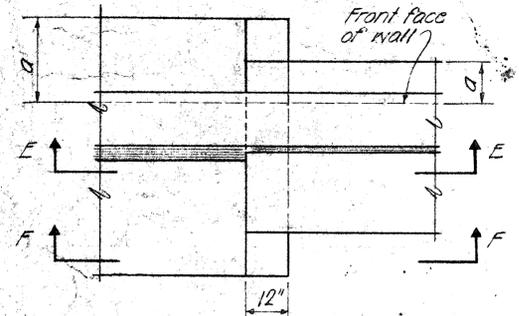


PLAN

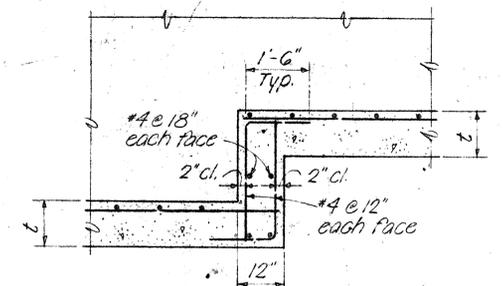


SECTION E-E

AT CONTINUOUS FOOTING

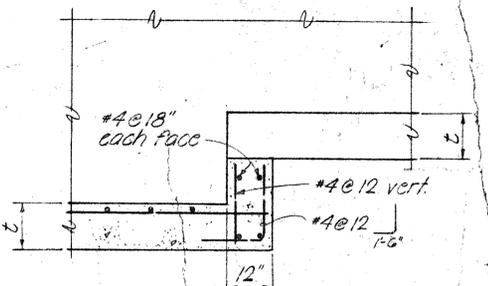


SECTION F-F

TYPICAL FOOTING STEP-UP DETAILS No Scale

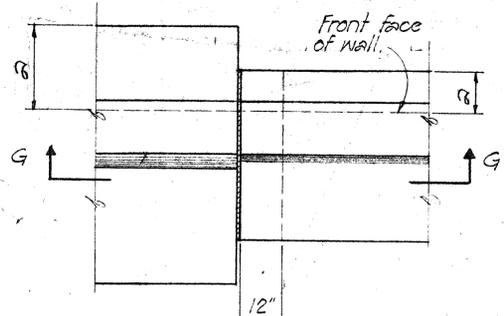


PLAN

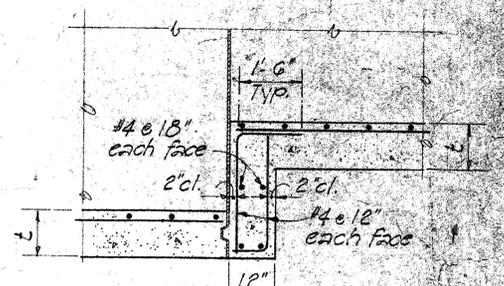


SECTION G-G

AT EXPANSION JOINT

NOTE
Hatched areas denote limits of structural excavation pay line. All other excavation shall be roadway excavation except as otherwise noted.

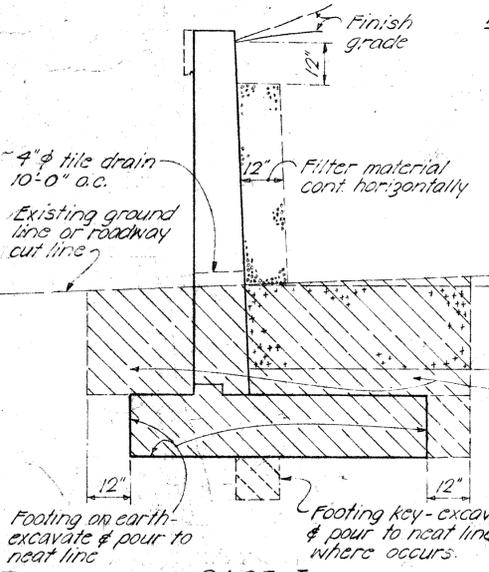

CASE I

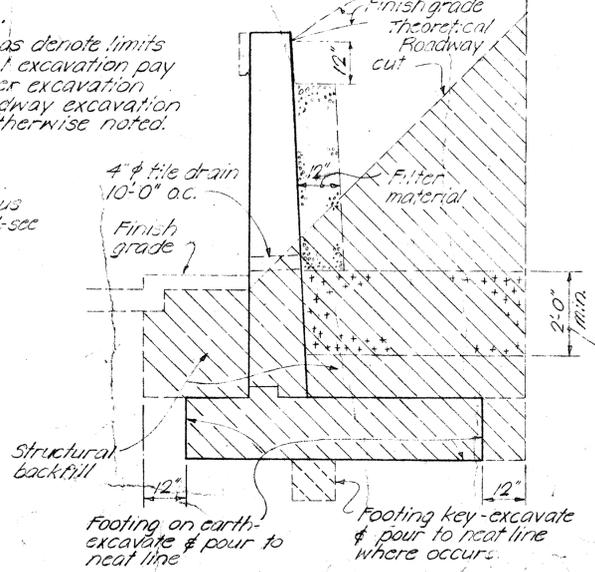

CASE II

STRUCTURAL EXCAVATION & DRAINAGE DETAILS No Scale

APPROVAL RECOMMENDED:
Paul T. Yamashita 1-23-70
BRIDGE DESIGN ENGINEER DATE

APPROVED
Paul T. Yamashita 1-28-70
For ASSISTANT CHIEF, ENGINEERING DATE

NO.	REVISION	APPROVED BY	DATE
1	Change note spacing of joints.	H.T.	2.4.72

STATE OF HAWAII
DEPARTMENT OF TRANSPORTATION
HIGHWAYS DIVISION



STANDARD DETAILS
RETAINING WALL TYPE T-1

F.A.I. PROJ. NO. I-HI-1(178)



SCALE AS NOTED DATE APRIL 1982

SHEET No. 2 OF 2 SHEETS DB-207-2




DATE
SURVEY PLOTTED BY
DESIGNED BY
CHECKED BY
QUANTITIES BY
NOTE BOOK
ORIGINAL PLAN

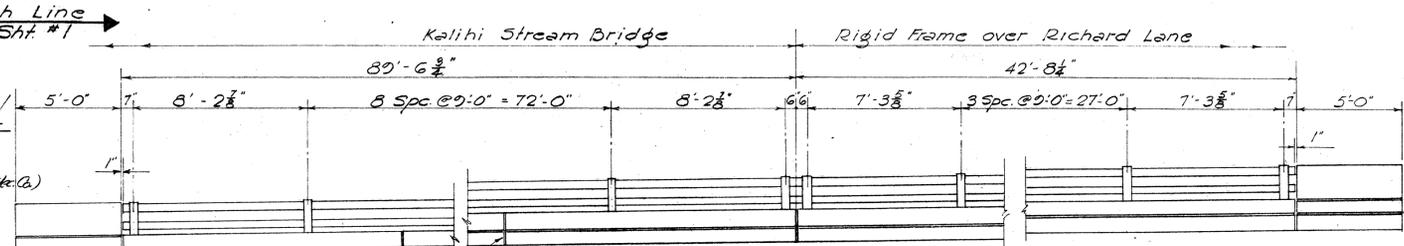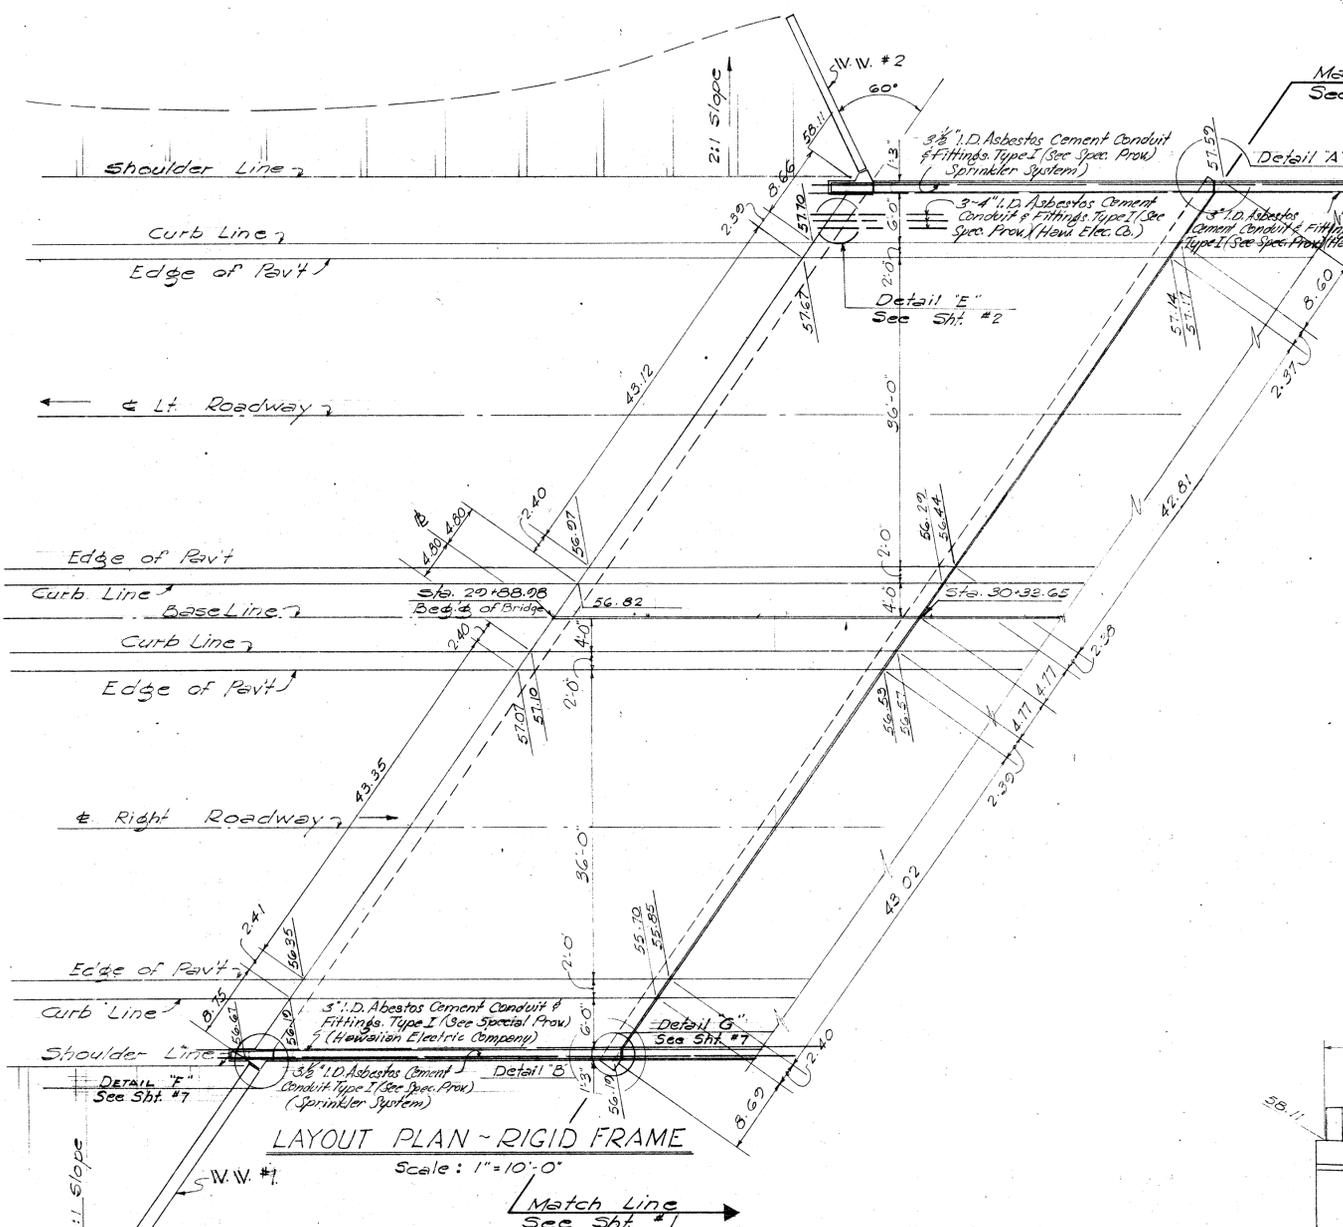

NOTE!!
For additional information see Std. Aluminum Railing Detail.

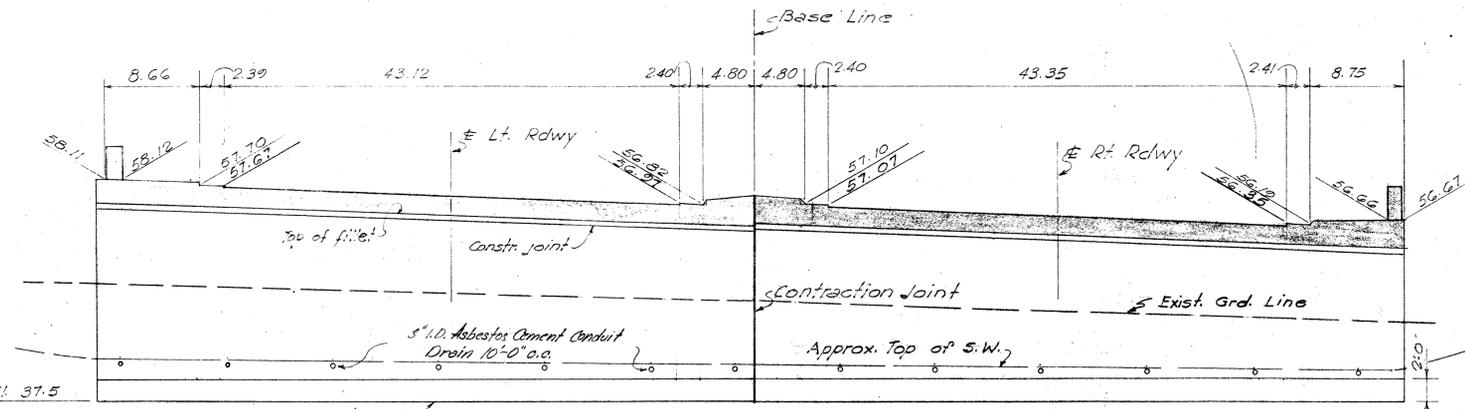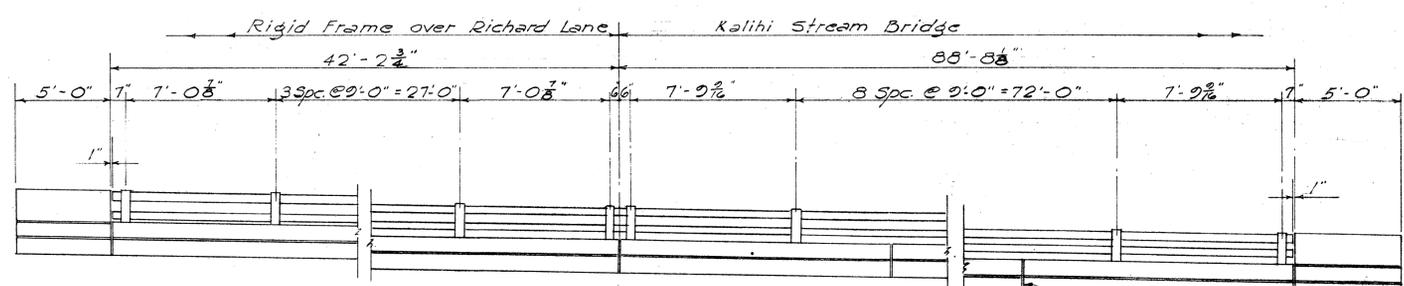

EXISTING KALIHI STREAM BR. For information only (Reduction not to scale)

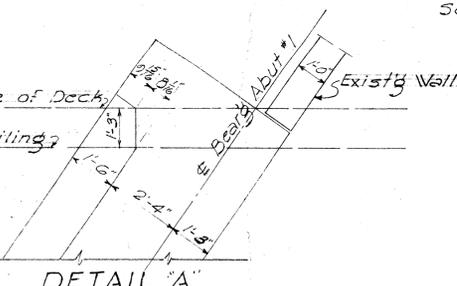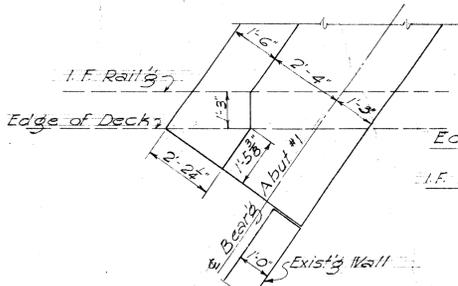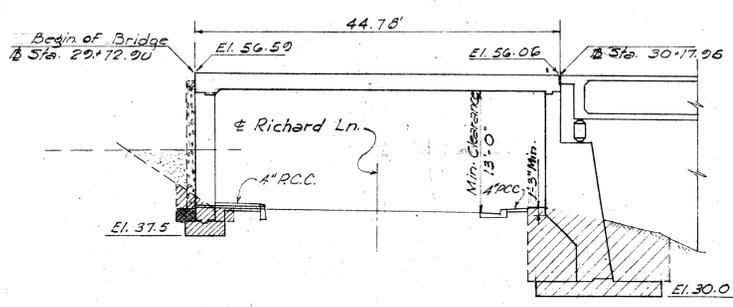



DATE: _____
SURVEY PROVIDED BY: _____
DESIGNED BY: _____
DRAWN BY: _____
CHECKED BY: _____
QUANTITIES CHECKED BY: _____
ORIGINAL PLAN NOTE BOOK No. _____

HAWAII STATE HIGHWAY DEPARTMENT
STATE OF HAWAII

KALIHI STREAM BRIDGE


PLAN-RIGID FRAME

LUNALILO FREEWAY BU-072-1(2) UNIT 4

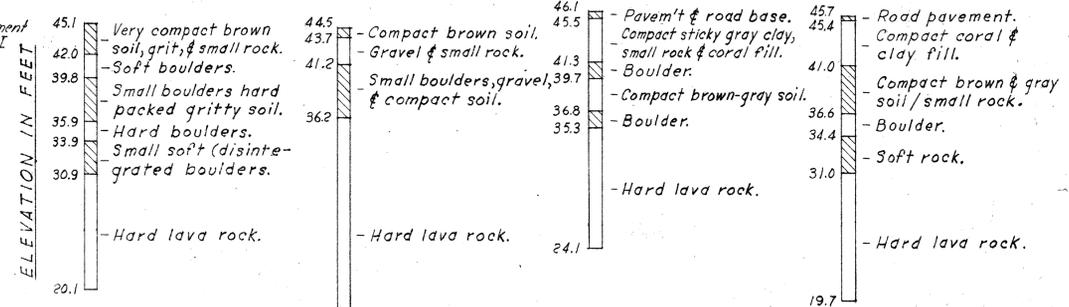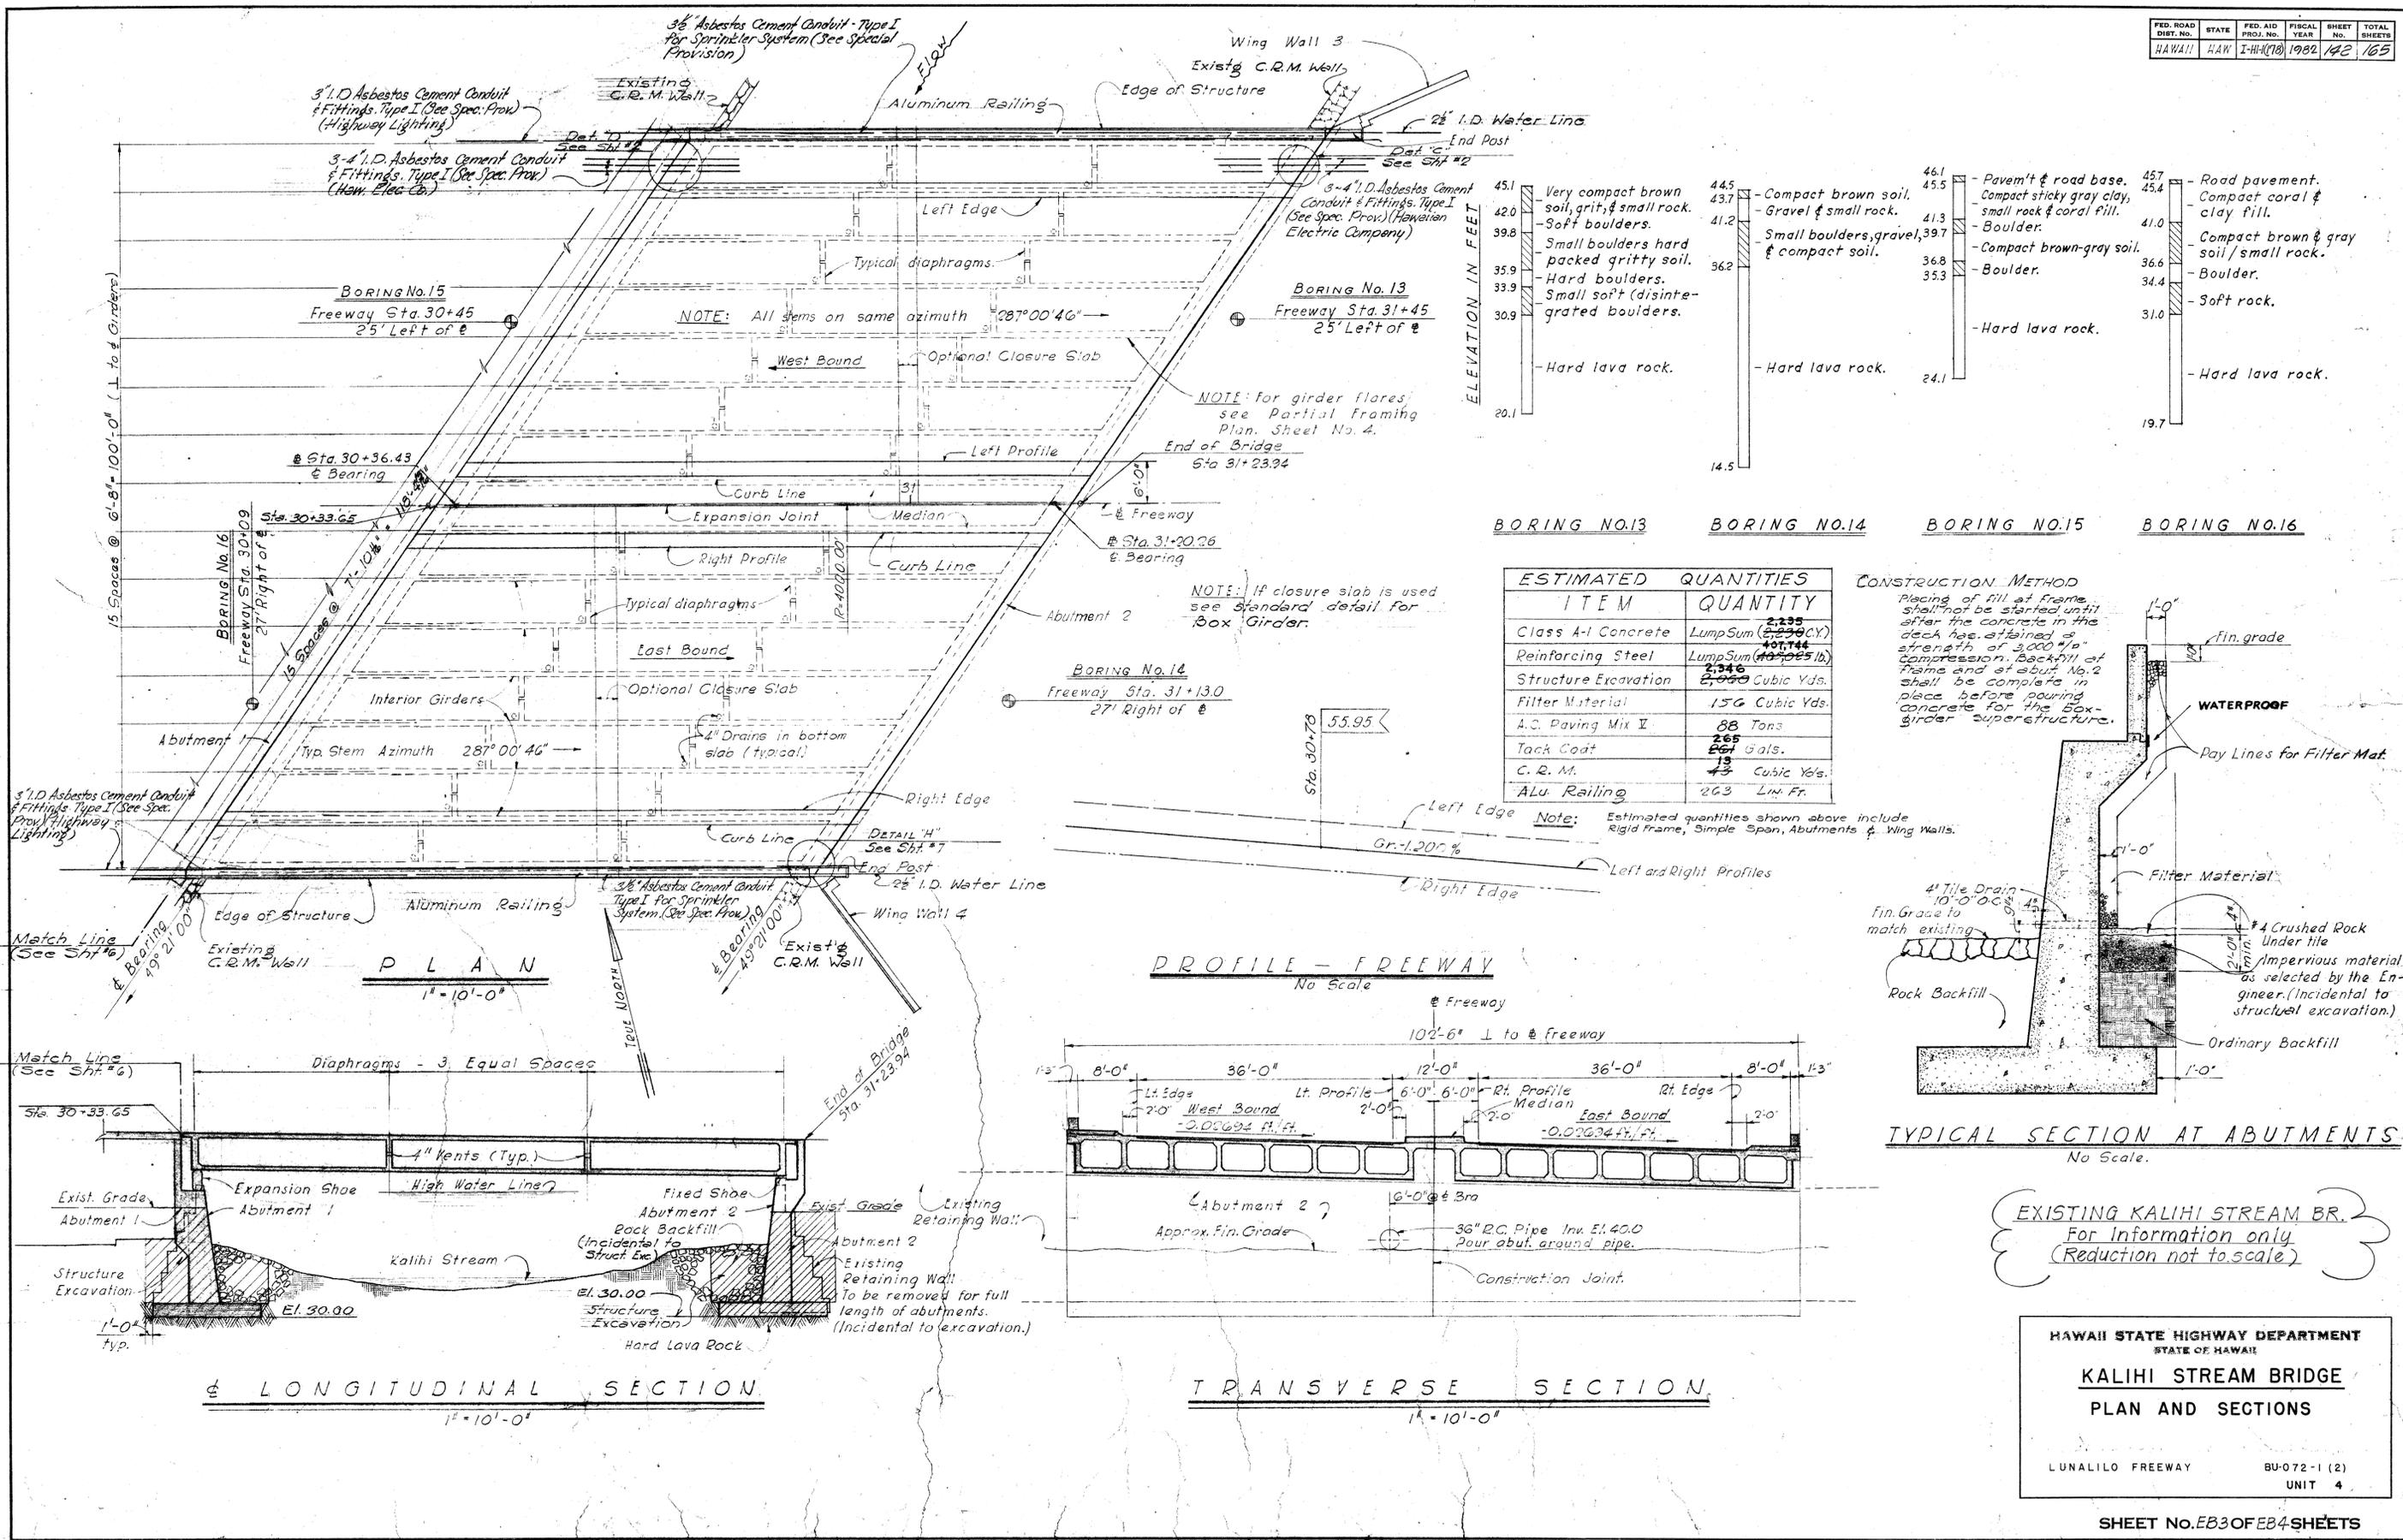

ESTIMATED QUANTITIES	
ITEM	QUANTITY
Class A-1 Concrete	Lump Sum (2,235 CY)
Reinforcing Steel	Lump Sum (401,744 lbs)
Structure Excavation	2,345 Cubic Yds.
Filter Material	156 Cubic Yds.
A.C. Paving Mix V	88 Tons
Tack Coat	265 Gals.
C. R. M.	13 Cubic Yds.
Alu. Railing	263 Lin. Ft.

CONSTRUCTION METHOD
 Placing of fill at frame shall not be started until after the concrete in the deck has attained a strength of 3,000 p.s.i. Compression. Backfill of frame and of abut. No. 2 shall be complete in place before pouring concrete for the Box-girder superstructure.

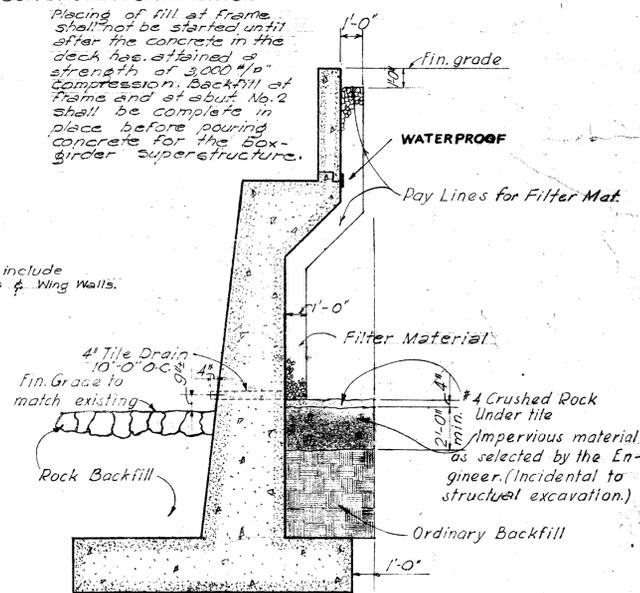

Note: Estimated quantities shown above include rigid frame, simple span, abutments & wing walls.

EXISTING KALIHI STREAM BR.
 For information only
 (Reduction not to scale)

HAWAII STATE HIGHWAY DEPARTMENT
 STATE OF HAWAII
KALIHI STREAM BRIDGE
 PLAN AND SECTIONS
 LUNALILO FREEWAY BU-072-1 (2) UNIT 4

SURVEY PLOTTED BY: LUN
 DATE: 12/19/82
 DRAWN BY: GUSTAFSON
 CHECKED BY: SWILSON
 QUANTITIES CHECKED BY: WILSON
 NOTE BOOK NO. 142
 CHECKED BY: WILSON

