


FED. ROAD DIST. NO.	STATE	FED. AID PROJ. NO.	FISCAL YEAR	SHEET NO.	TOTAL SHEETS
HAWAII	HAW.	I-HI-1(176)	1982	7	20

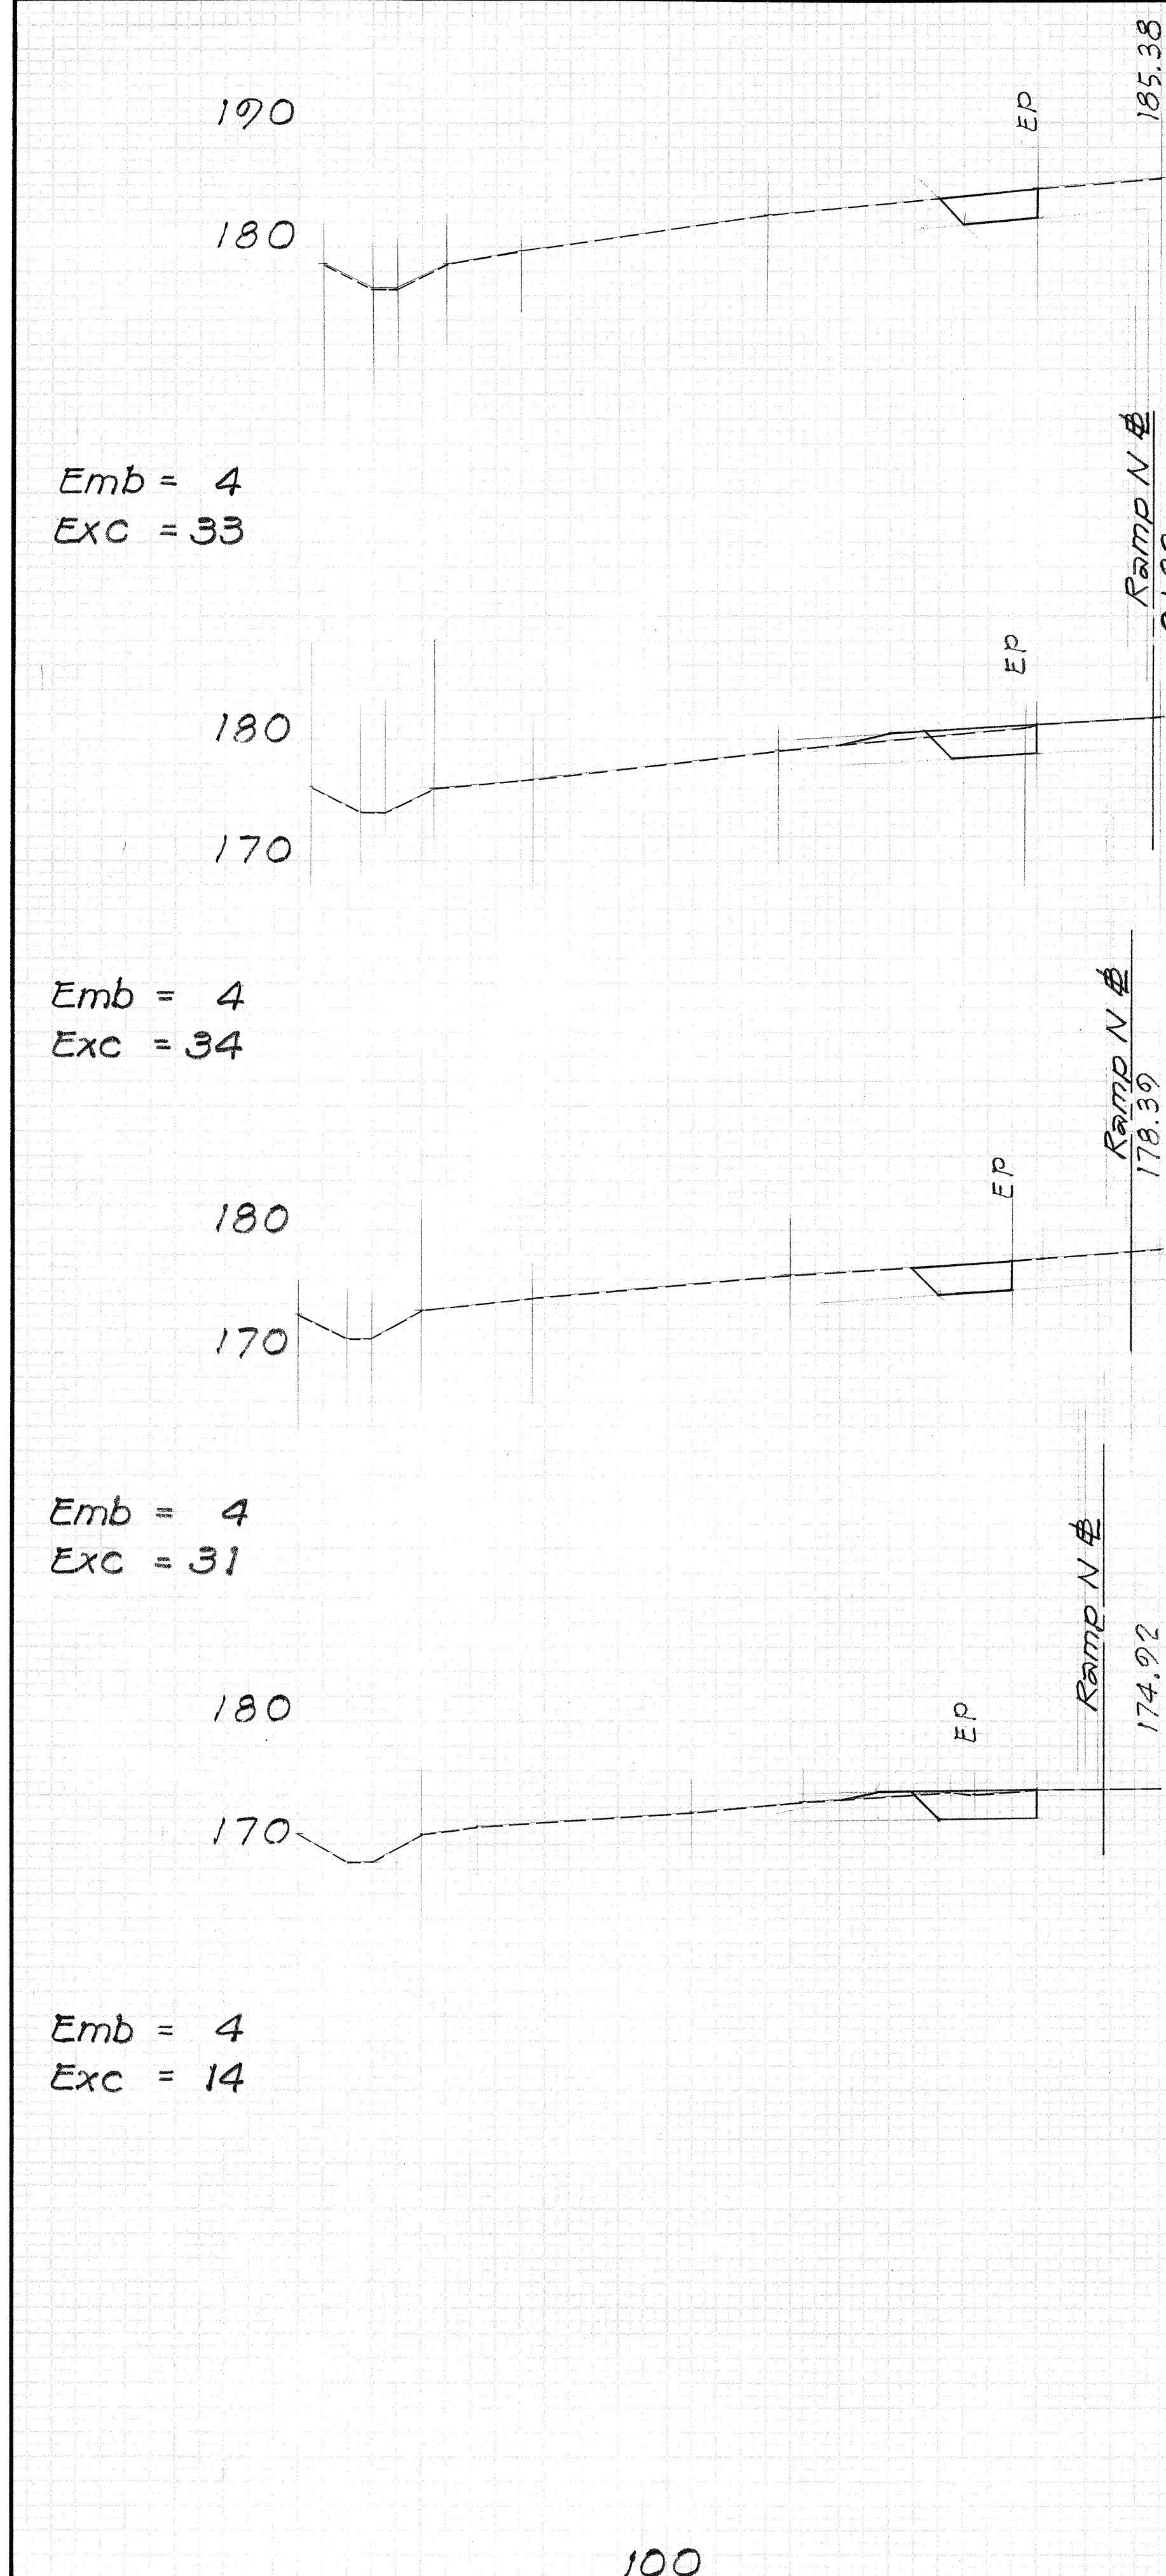

F = 0
C = 17

Emb = 4
Exc = 33

F = 4
C = 19

Emb = 4
Exc = 34


F = 0
C = 18

Emb = 4
Exc = 31

F = 4
C = 15

Emb = 4
Exc = 14

F = 0
C = 0

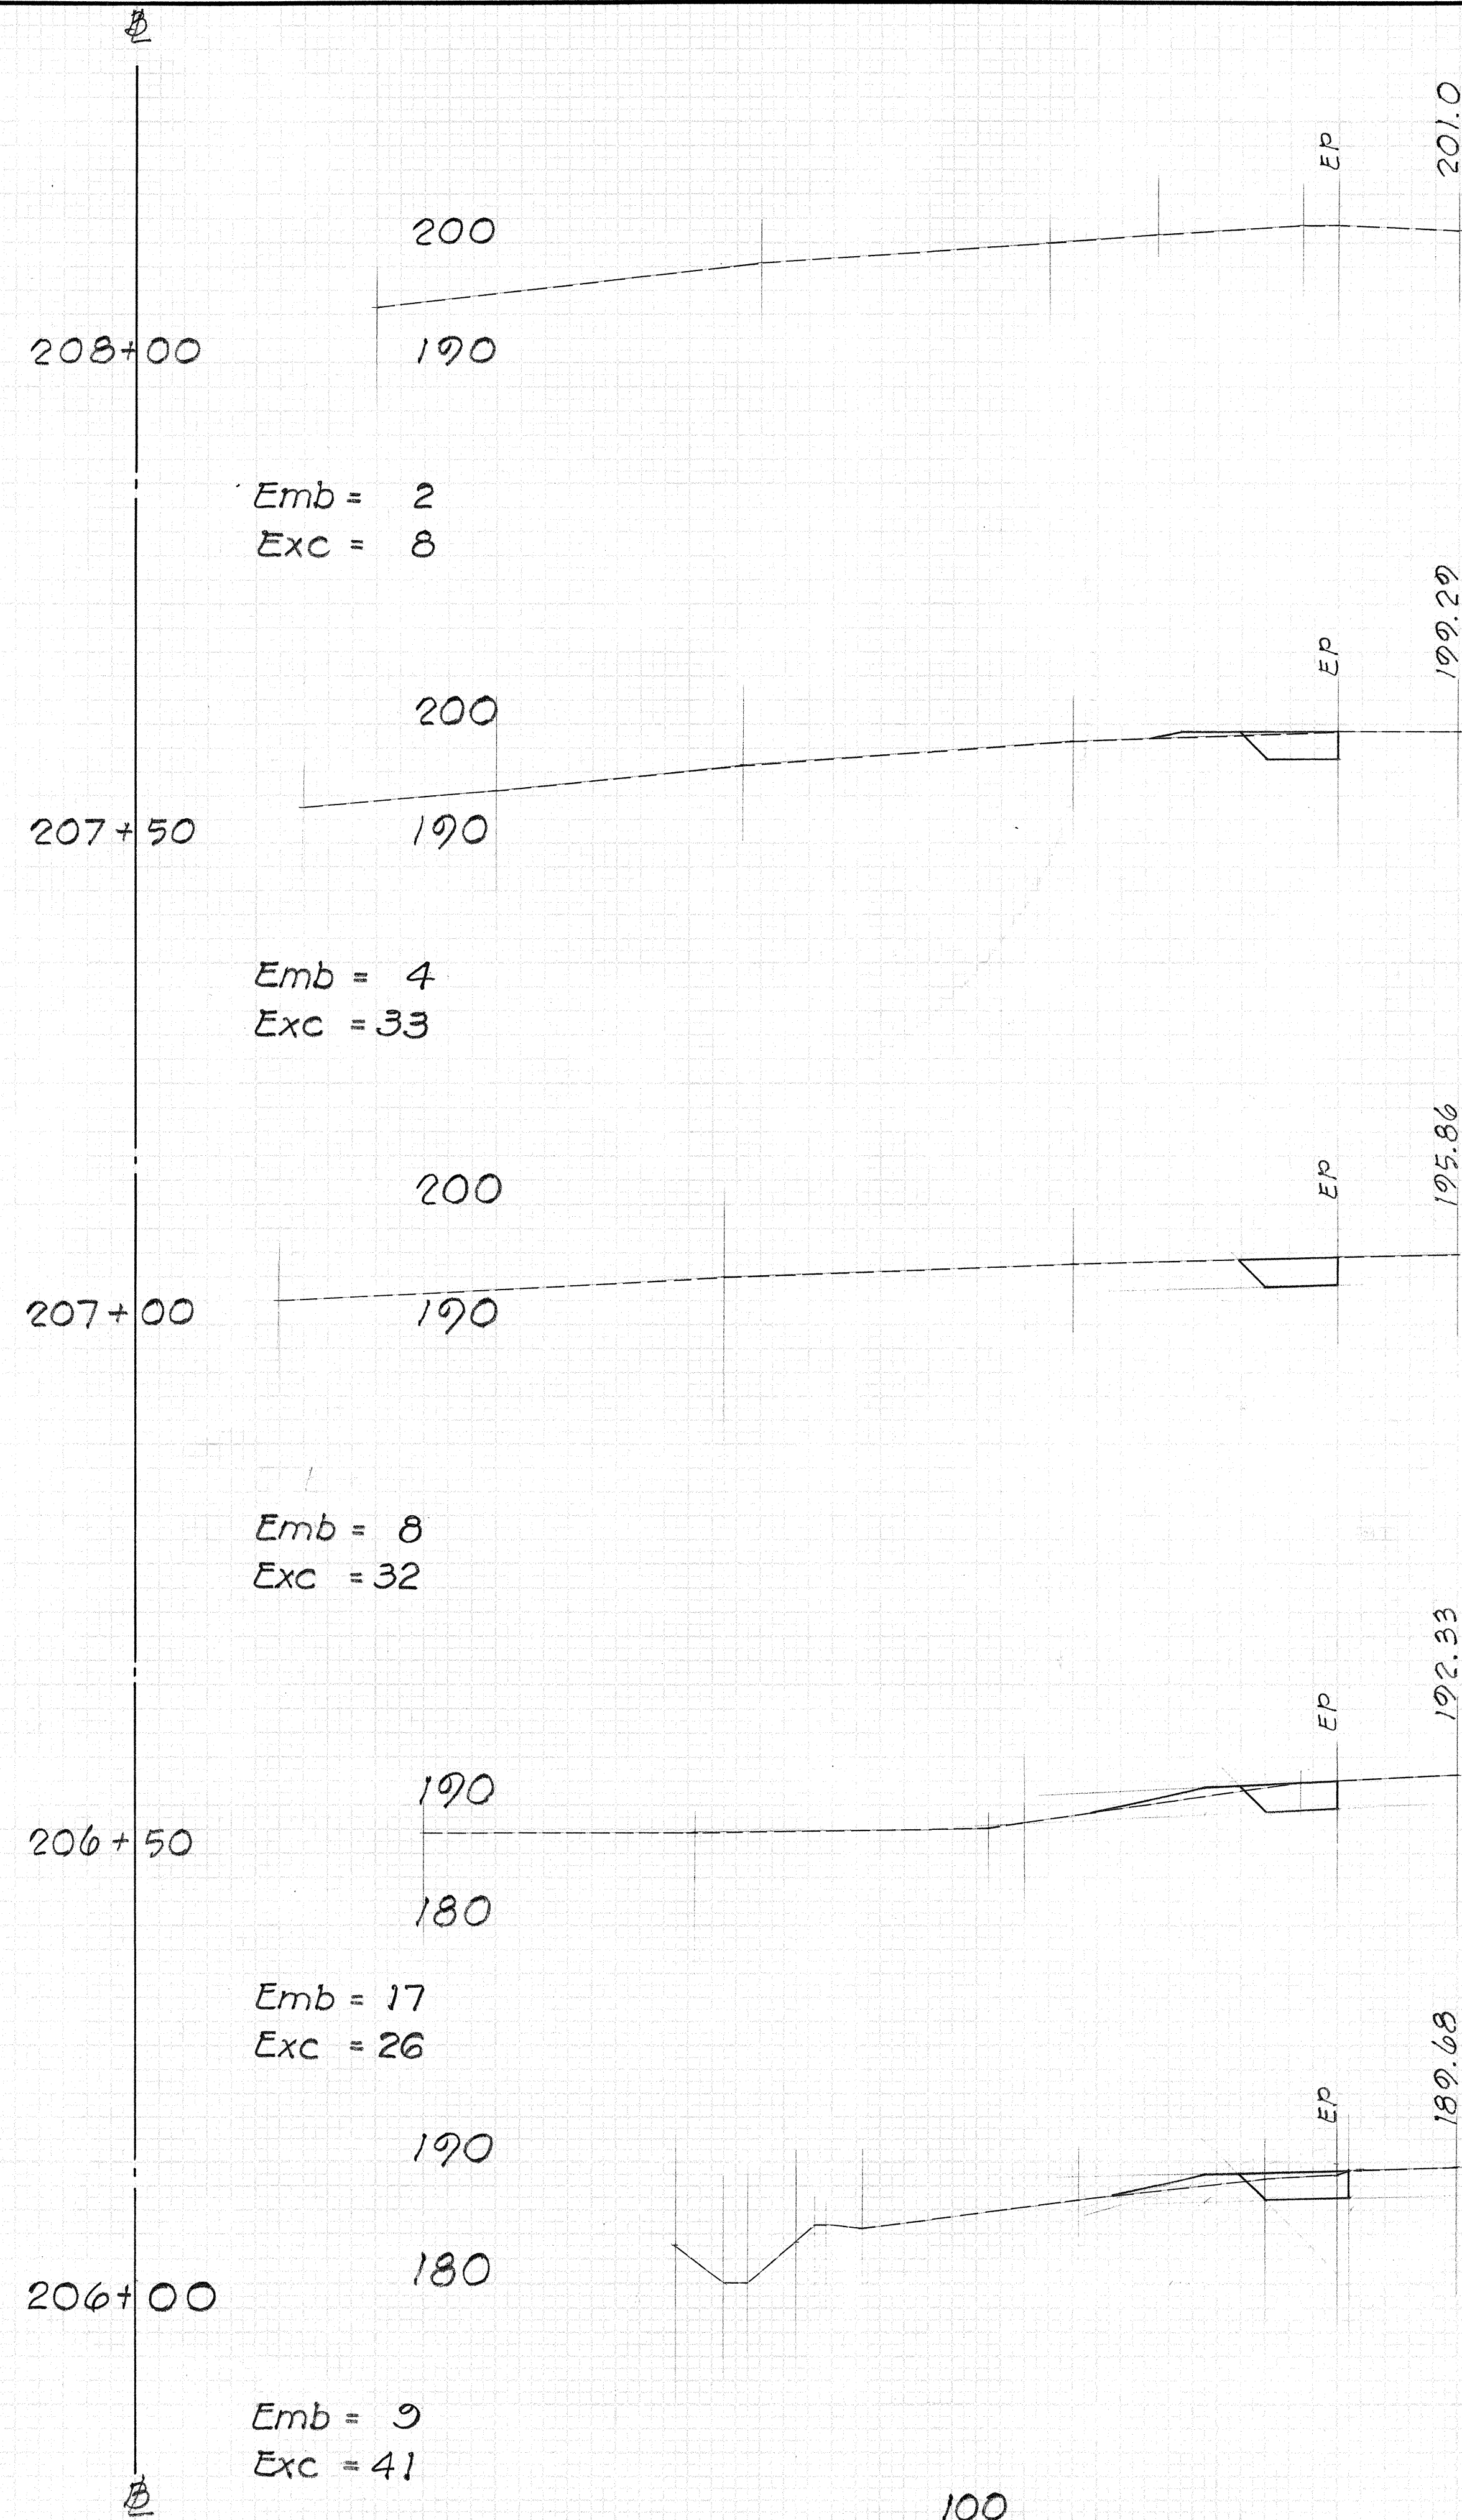

F = 0
C = 0

Emb = 2
Exc = 8

F = 4
C = 18

Emb = 4
Exc = 33

F = 0
C = 18

Emb = 8
Exc = 32

F = 9
C = 17

Emb = 17
Exc = 26

F = 10
C = 19

Emb = 9
Exc = 41

208+00 (Ahead) =
208+61.35 (Back)

210+25
(Back)

210+00
(Back)

209+50
(Back)

209+00
(Back)