
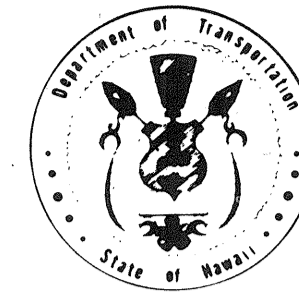


INDEX TO DRAWINGS	
SHEET NO.	DESCRIPTION
1	TITLE SHEET
2	CONSTRUCTION PHASING FOR PROJECT I-HI-1(86):17
3-6	TRAFFIC PATTERNS A, B & C
7	INDEX OF BRIDGE DRAWINGS & ESTIMATED QUANTITIES
8-31	H-1 (E.B.), NIMITZ CONN. (W.B.), RAMP C AND HOV RAMP STRUCTURES
32-62	NIMITZ CONN. (E.B.), HOV RAMP, RAMP A AND RAMP B STRUCTURES
63	STRUCTURAL STANDARD DETAILS

FED. ROAD DIST. NO.	STATE	FED. AID PROJ. NO.	FISCAL YEAR	SHEET NO.	TOTAL SHEETS
HAWAII	HAW.	I-HI-1(179):17	1982	1	63

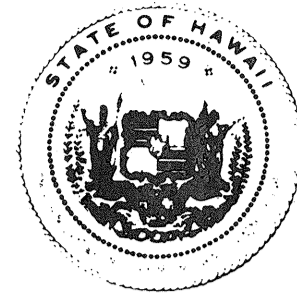


STATE OF HAWAII  
 DEPARTMENT OF TRANSPORTATION  
 HIGHWAYS DIVISION  
 HONOLULU, HAWAII

"AS BUILT" PLANS FOR  
 MANUFACTURE AND DELIVERY OF PRESTRESSED CONCRETE GIRDERS  
 FOR A PORTION OF  
 INTERSTATE ROUTE H-1  
 KEEHI INTERCHANGE

FEDERAL AID INTERSTATE PROJECT NO. I-HI-1 (179):17

DISTRICT OF HONOLULU  
 ISLAND OF OAHU

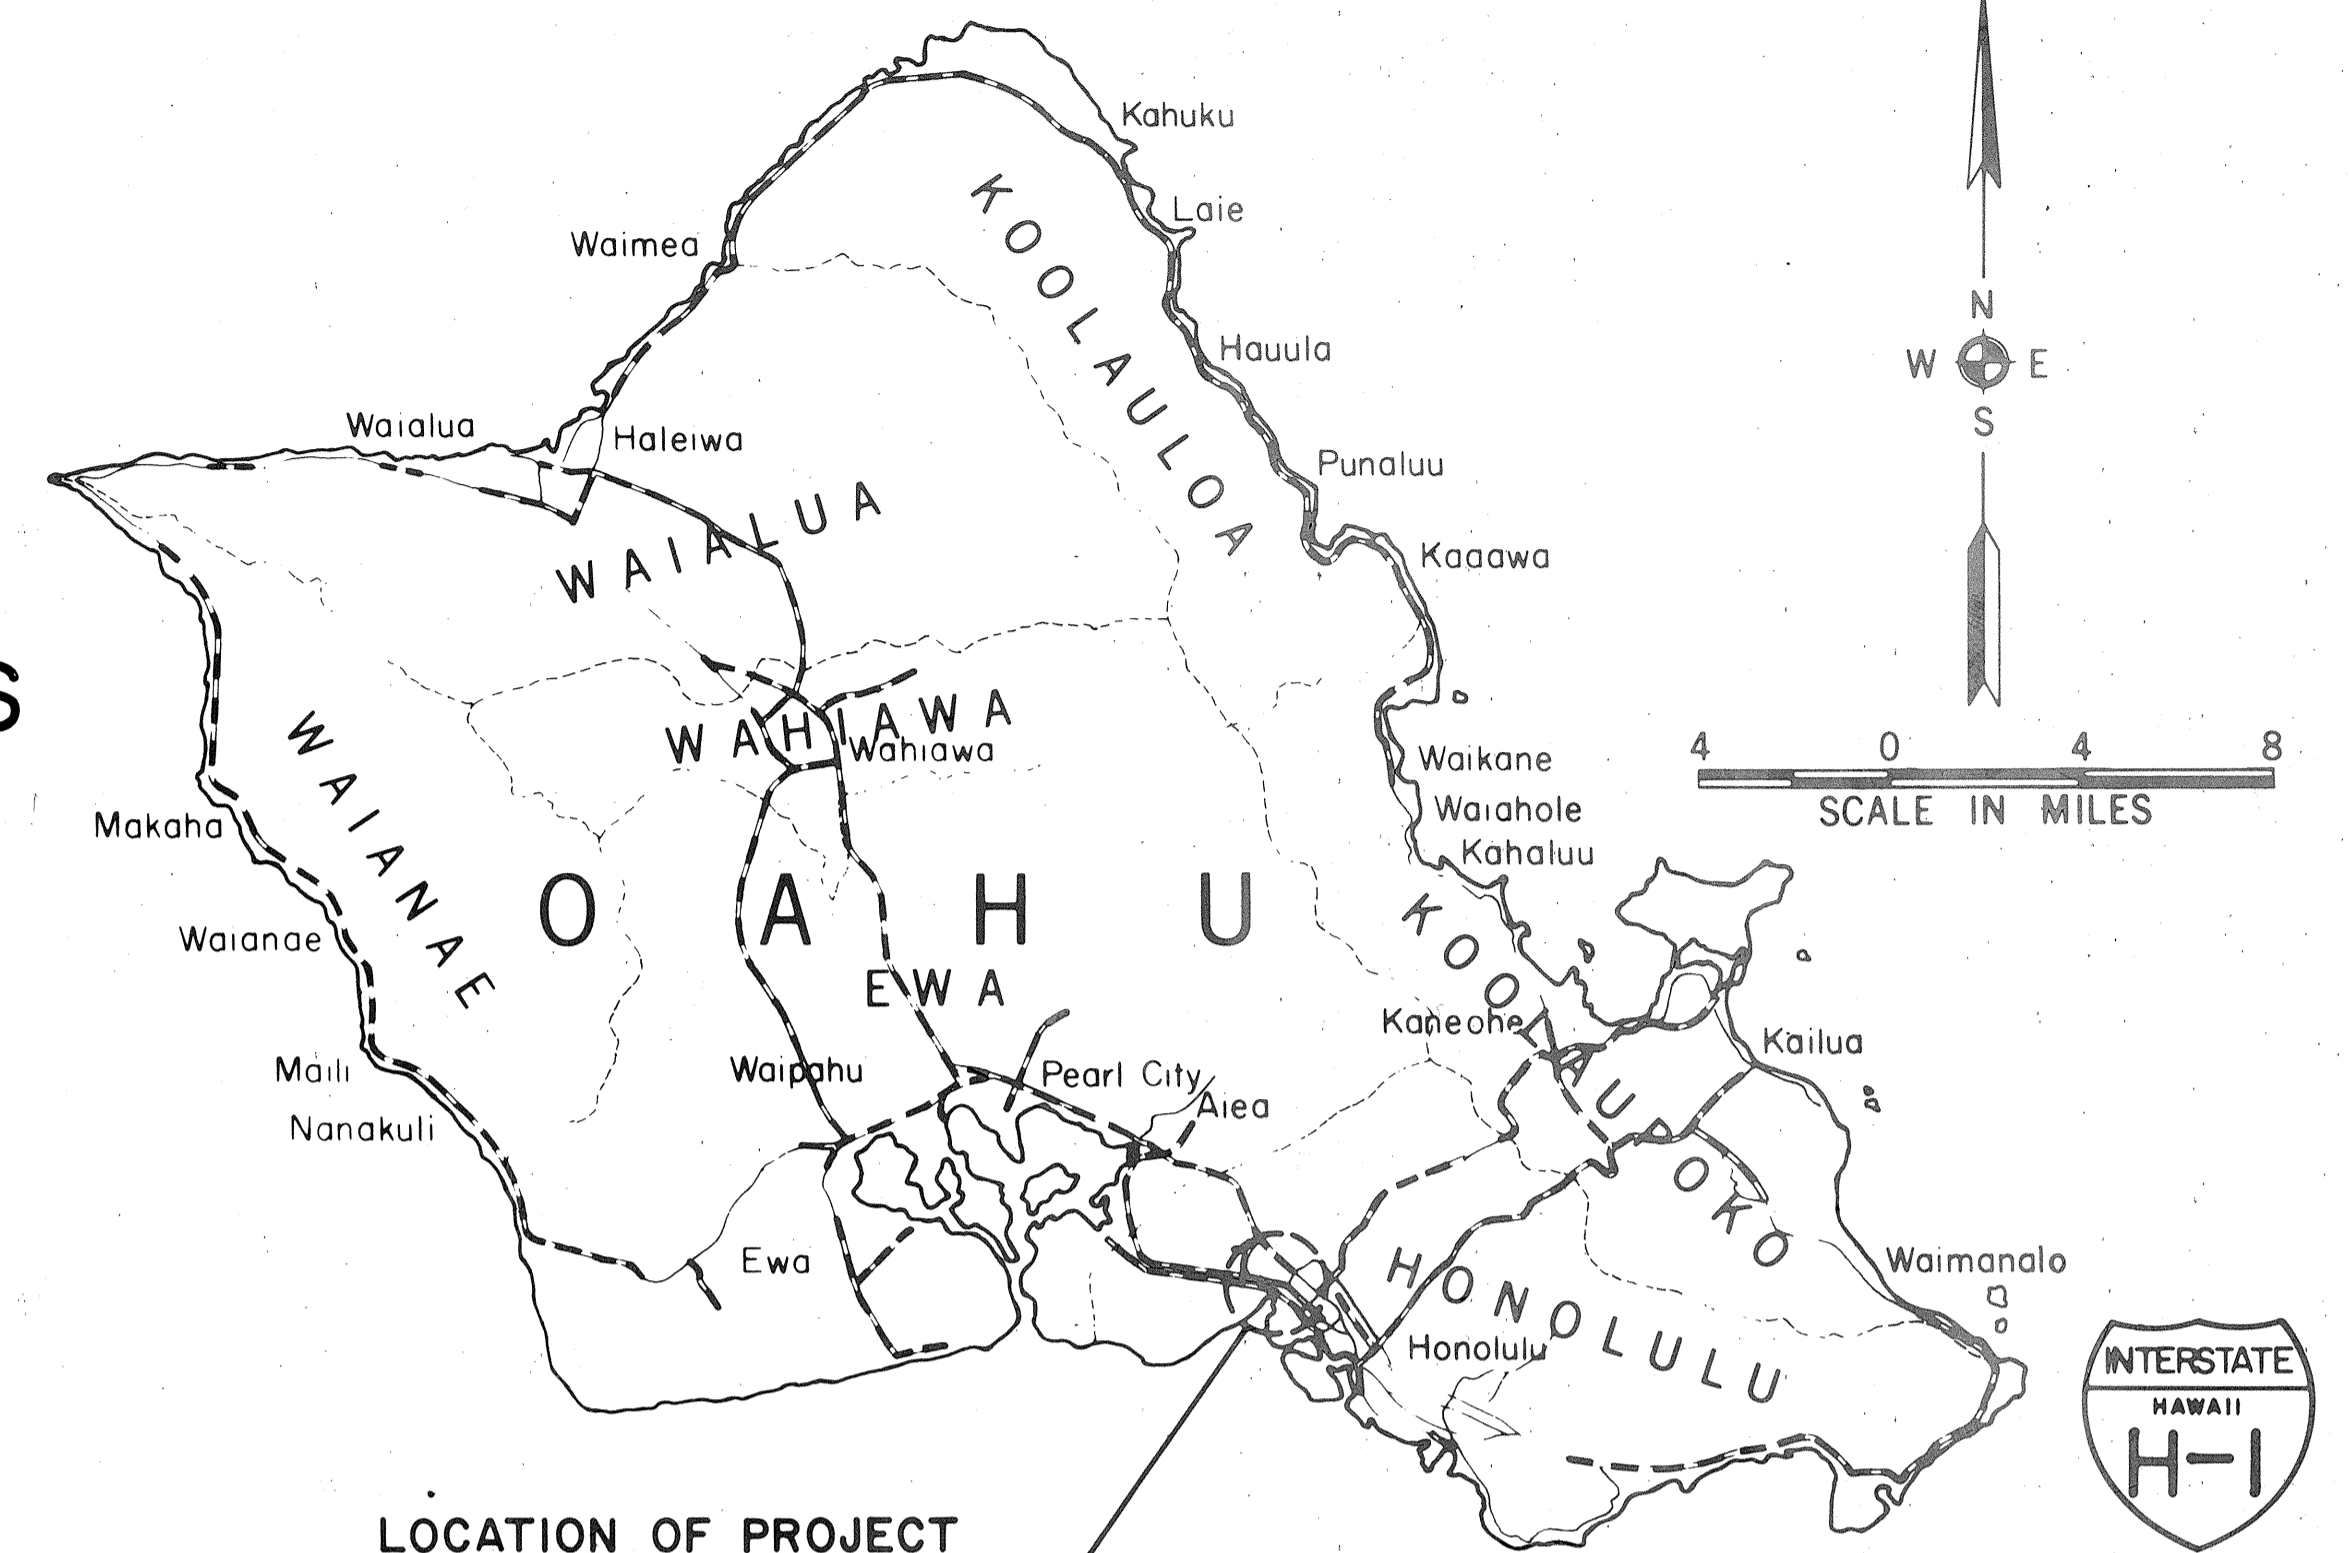

LOCATION OF PROJECT  
 F.A.I. PROJECT NO. I-HI-1(86):17


Federal Aid Projects Previously Constructed or Under Construction

CHANGES MADE DURING CONSTRUCTION HAVE BEEN INCORPORATED ON THESE PLANS EXCEPT CHANGES IN THE ORIGINAL THEORETICAL QUANTITIES. FOR ACTUAL QUANTITIES, REFER TO PROJECT LEDGER AND/OR COMPUTATION BOOK.

*Michael Dimiega*  
 RESIDENT ENGINEER      4/25/87  
 DATE

DESIGN CLASSIFICATION

DESIGN ADT (1994).....98,000  
 DHV.....10,800  
 D.....60/40  
 T.....5%  
 V.....60 MPH

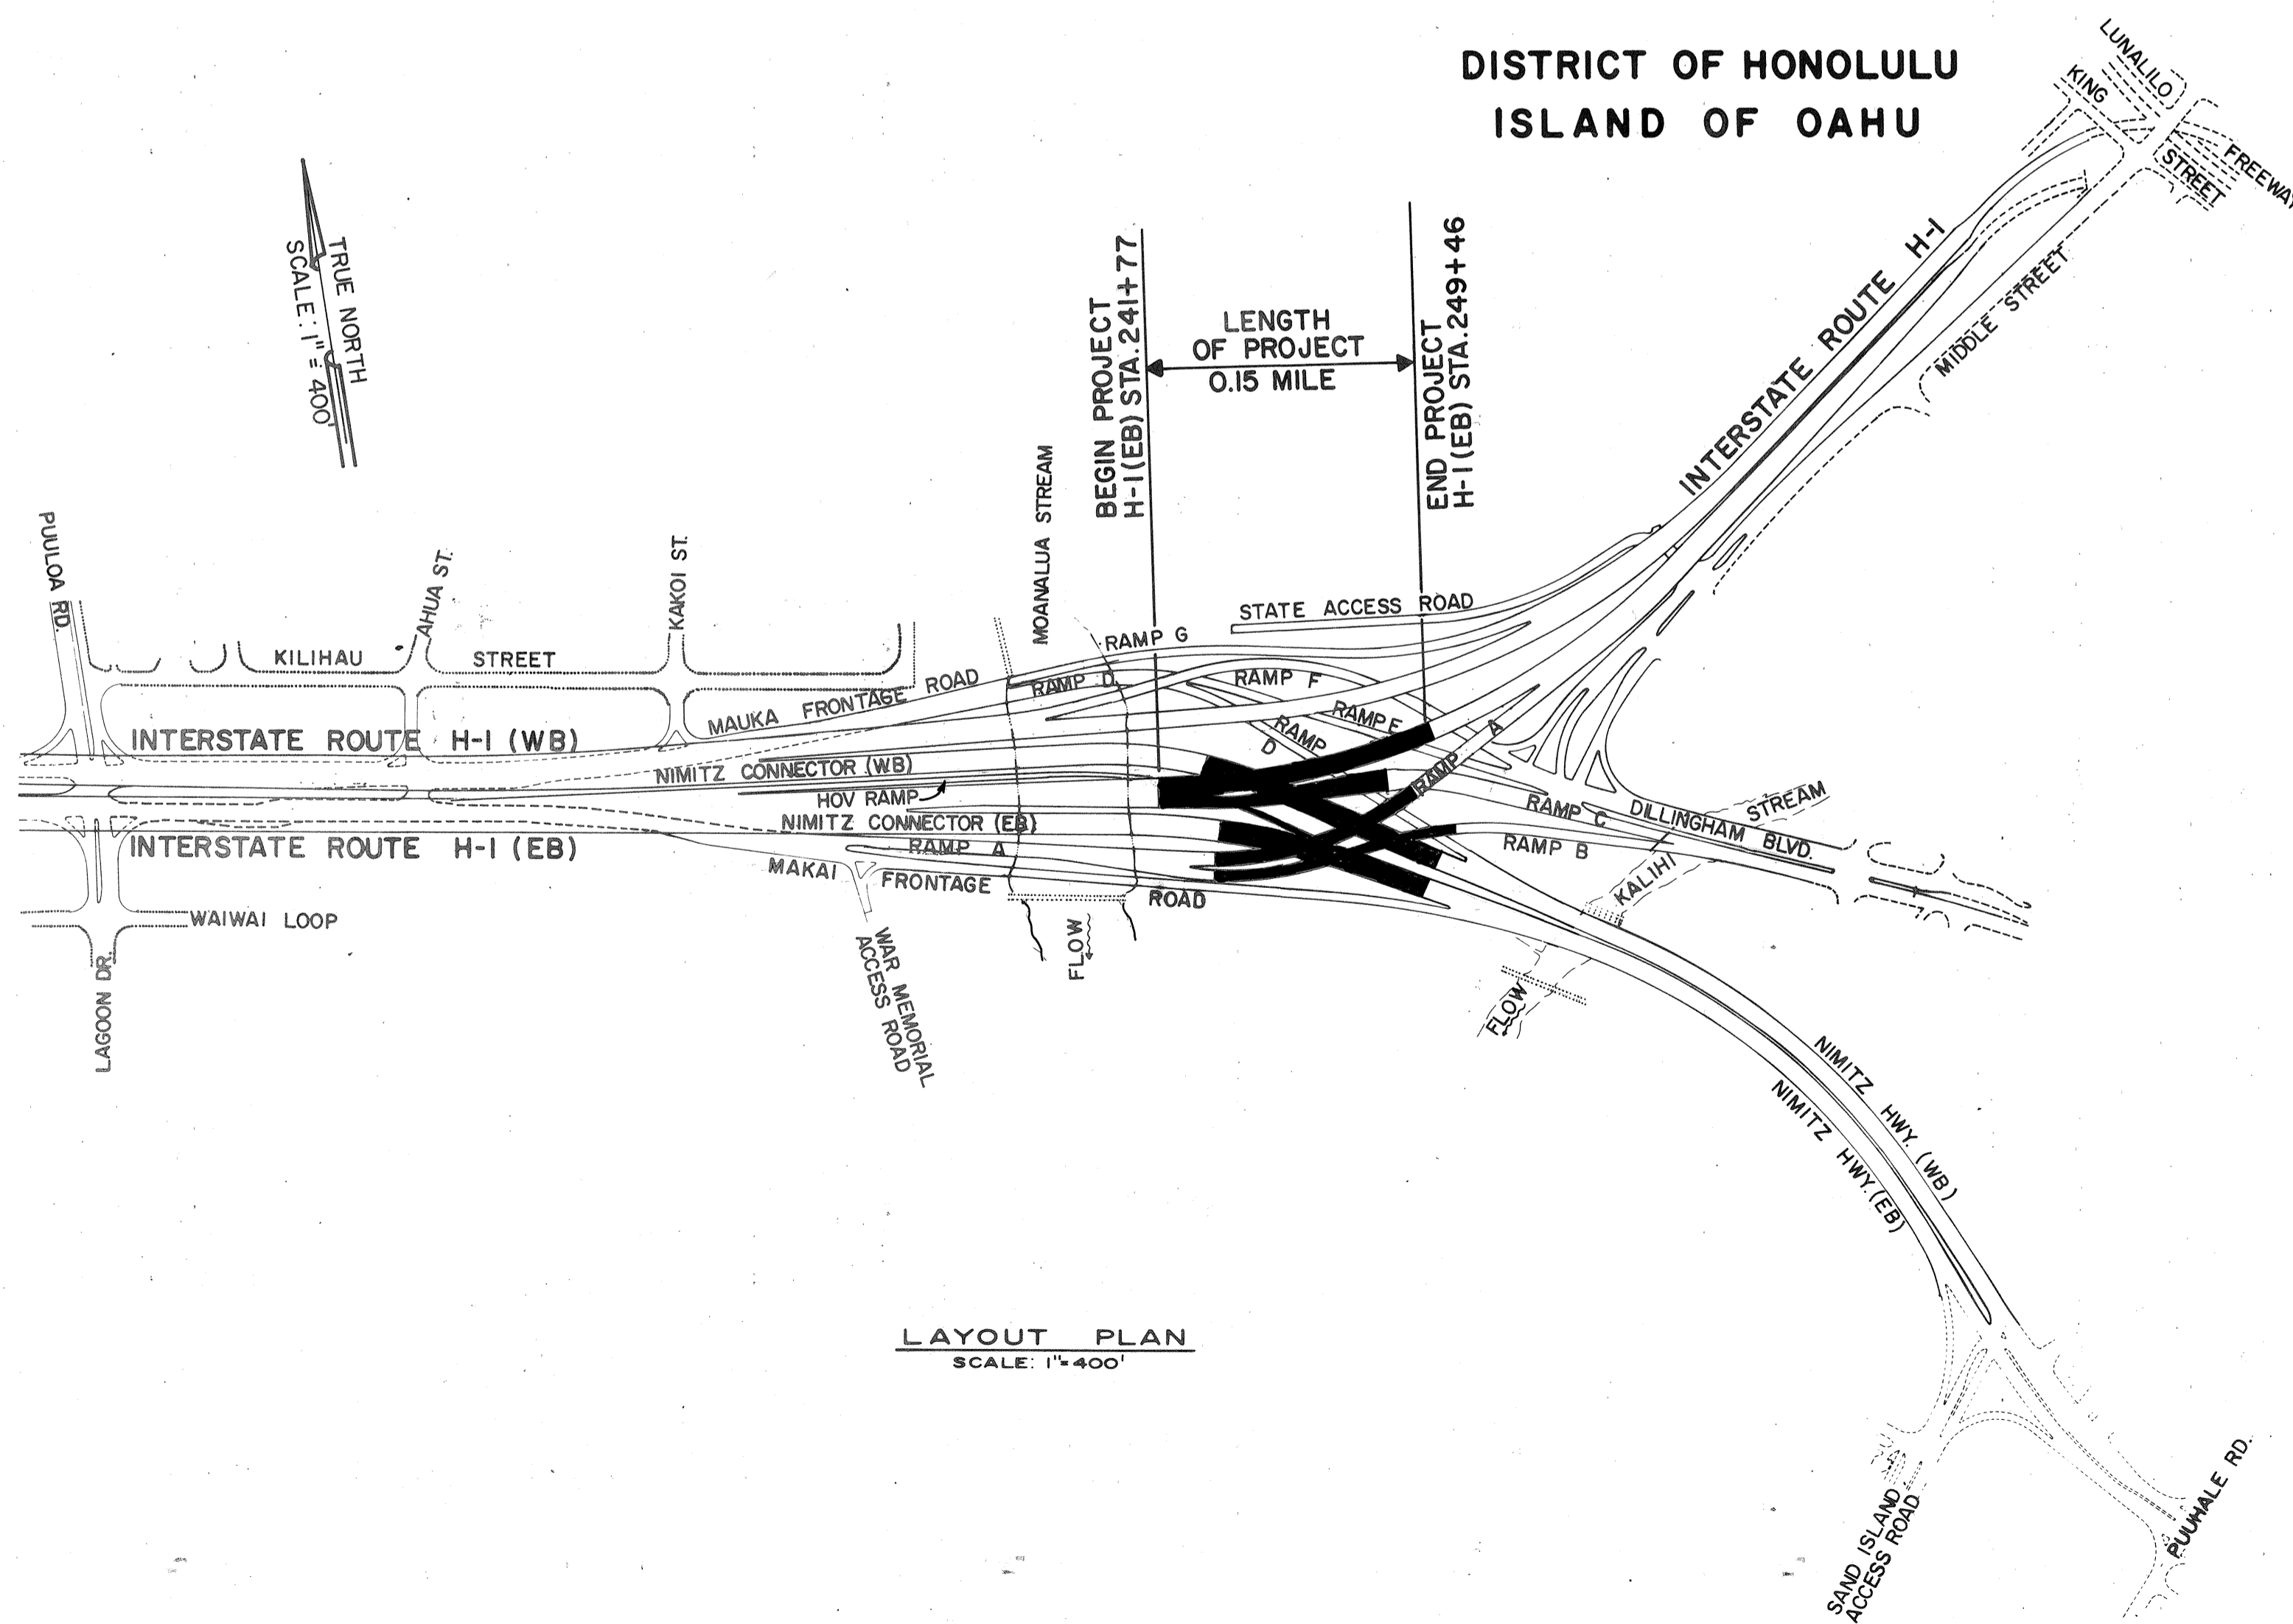

LAYOUT PLAN  
 SCALE: 1"=400'

PAUL WOLF      6/15/82      DATE  
 P S & E BY  
 PARSONS BRINCKERHOFF-      521-3051      PHONE  
 HIROTA ASSOCIATES  
 DESIGNED BY

DEPARTMENT OF TRANSPORTATION  
 FEDERAL HIGHWAY ADMINISTRATION  
 APPROVED: *Ulrich*      8/23/82  
 DIVISION ADMINISTRATOR      DATE

DEPARTMENT OF TRANSPORTATION  
 STATE OF HAWAII  
 APPROVED: *[Signature]*      7/29/82  
 DIR. OF TRANSPORTATION      DATE