

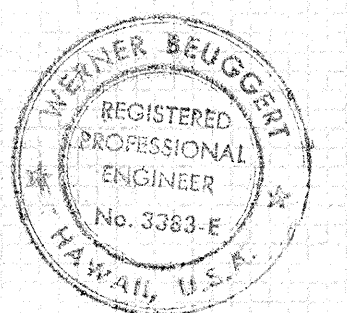


FED. ROAD DIST. NO.	STATE	FED. AID PROJ. NO.	FISCAL YEAR	SHEET NO.	TOTAL SHEETS
HAWAII	HAW.	I-HI-1(168):17	1982	143	145

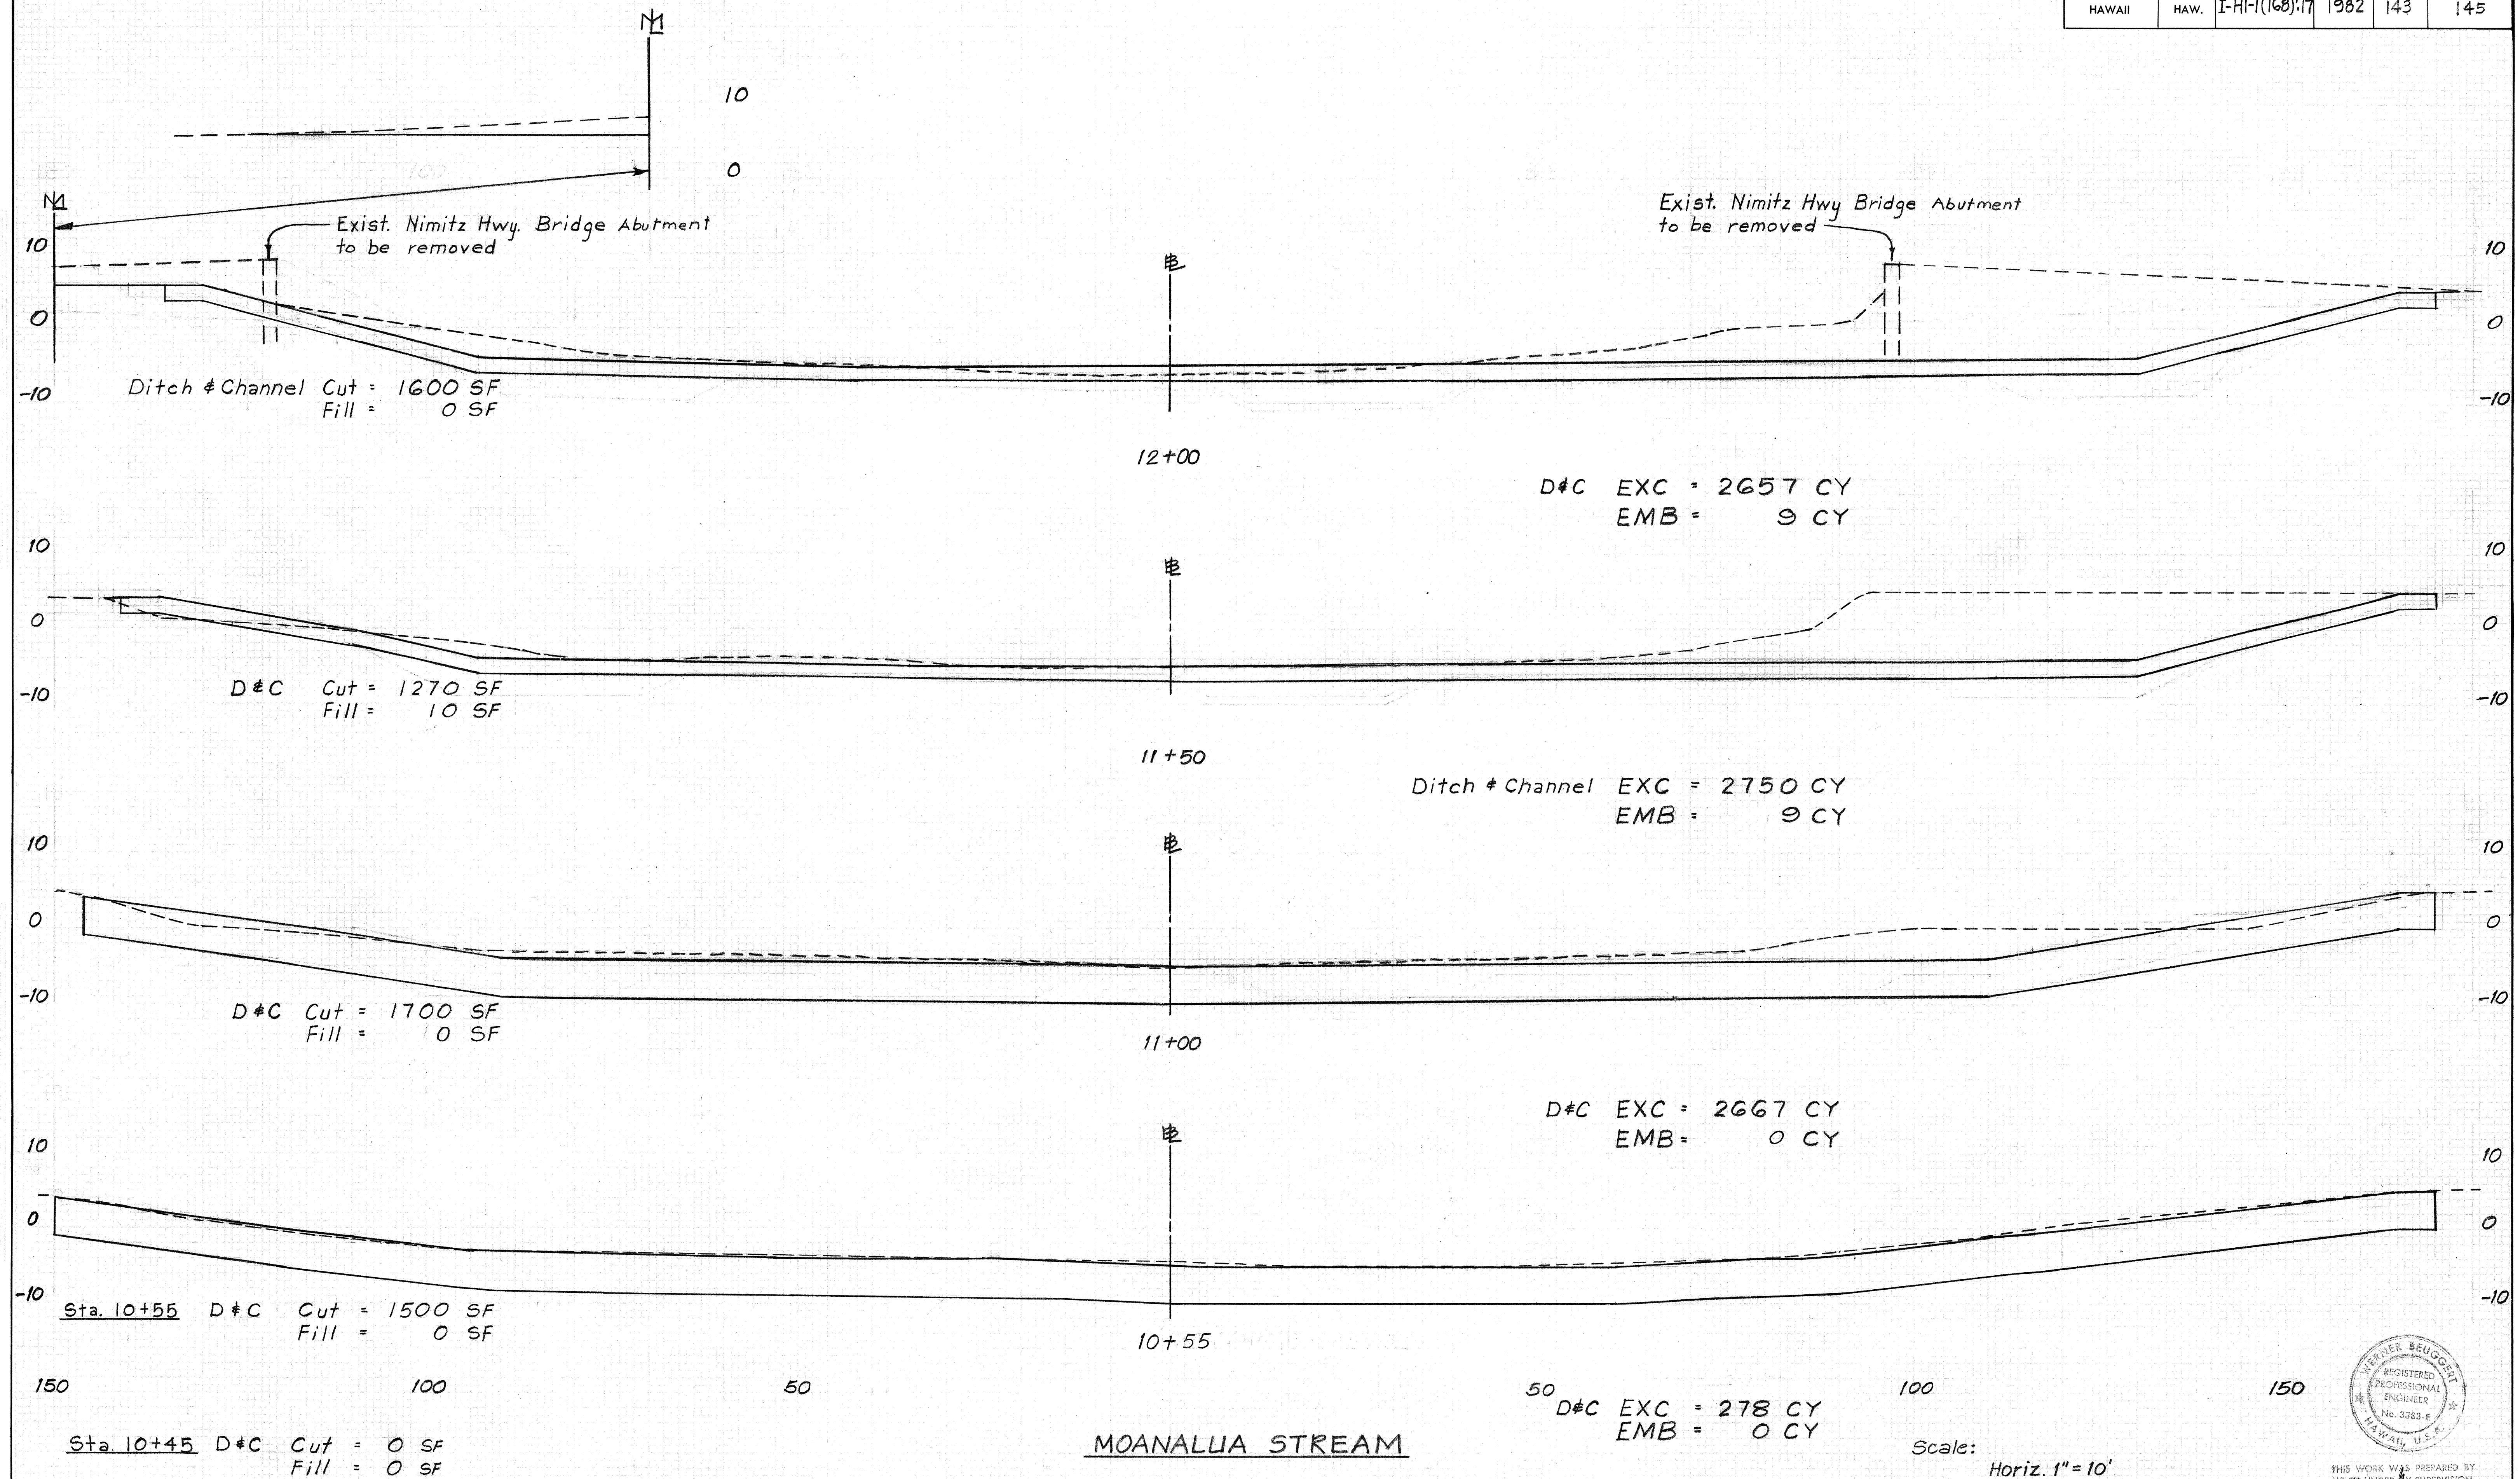


THIS WORK WAS PREPARED BY
ME UNDER MY SUPERVISION.
Mervyn Beugnot



FED. ROAD DIST. NO.	STATE	FED. AID PROJ. NO.	FISCAL YEAR	SHEET NO.	TOTAL SHEETS
HAWAII	HAW.	I-HI-1(168)17	1982	144	145

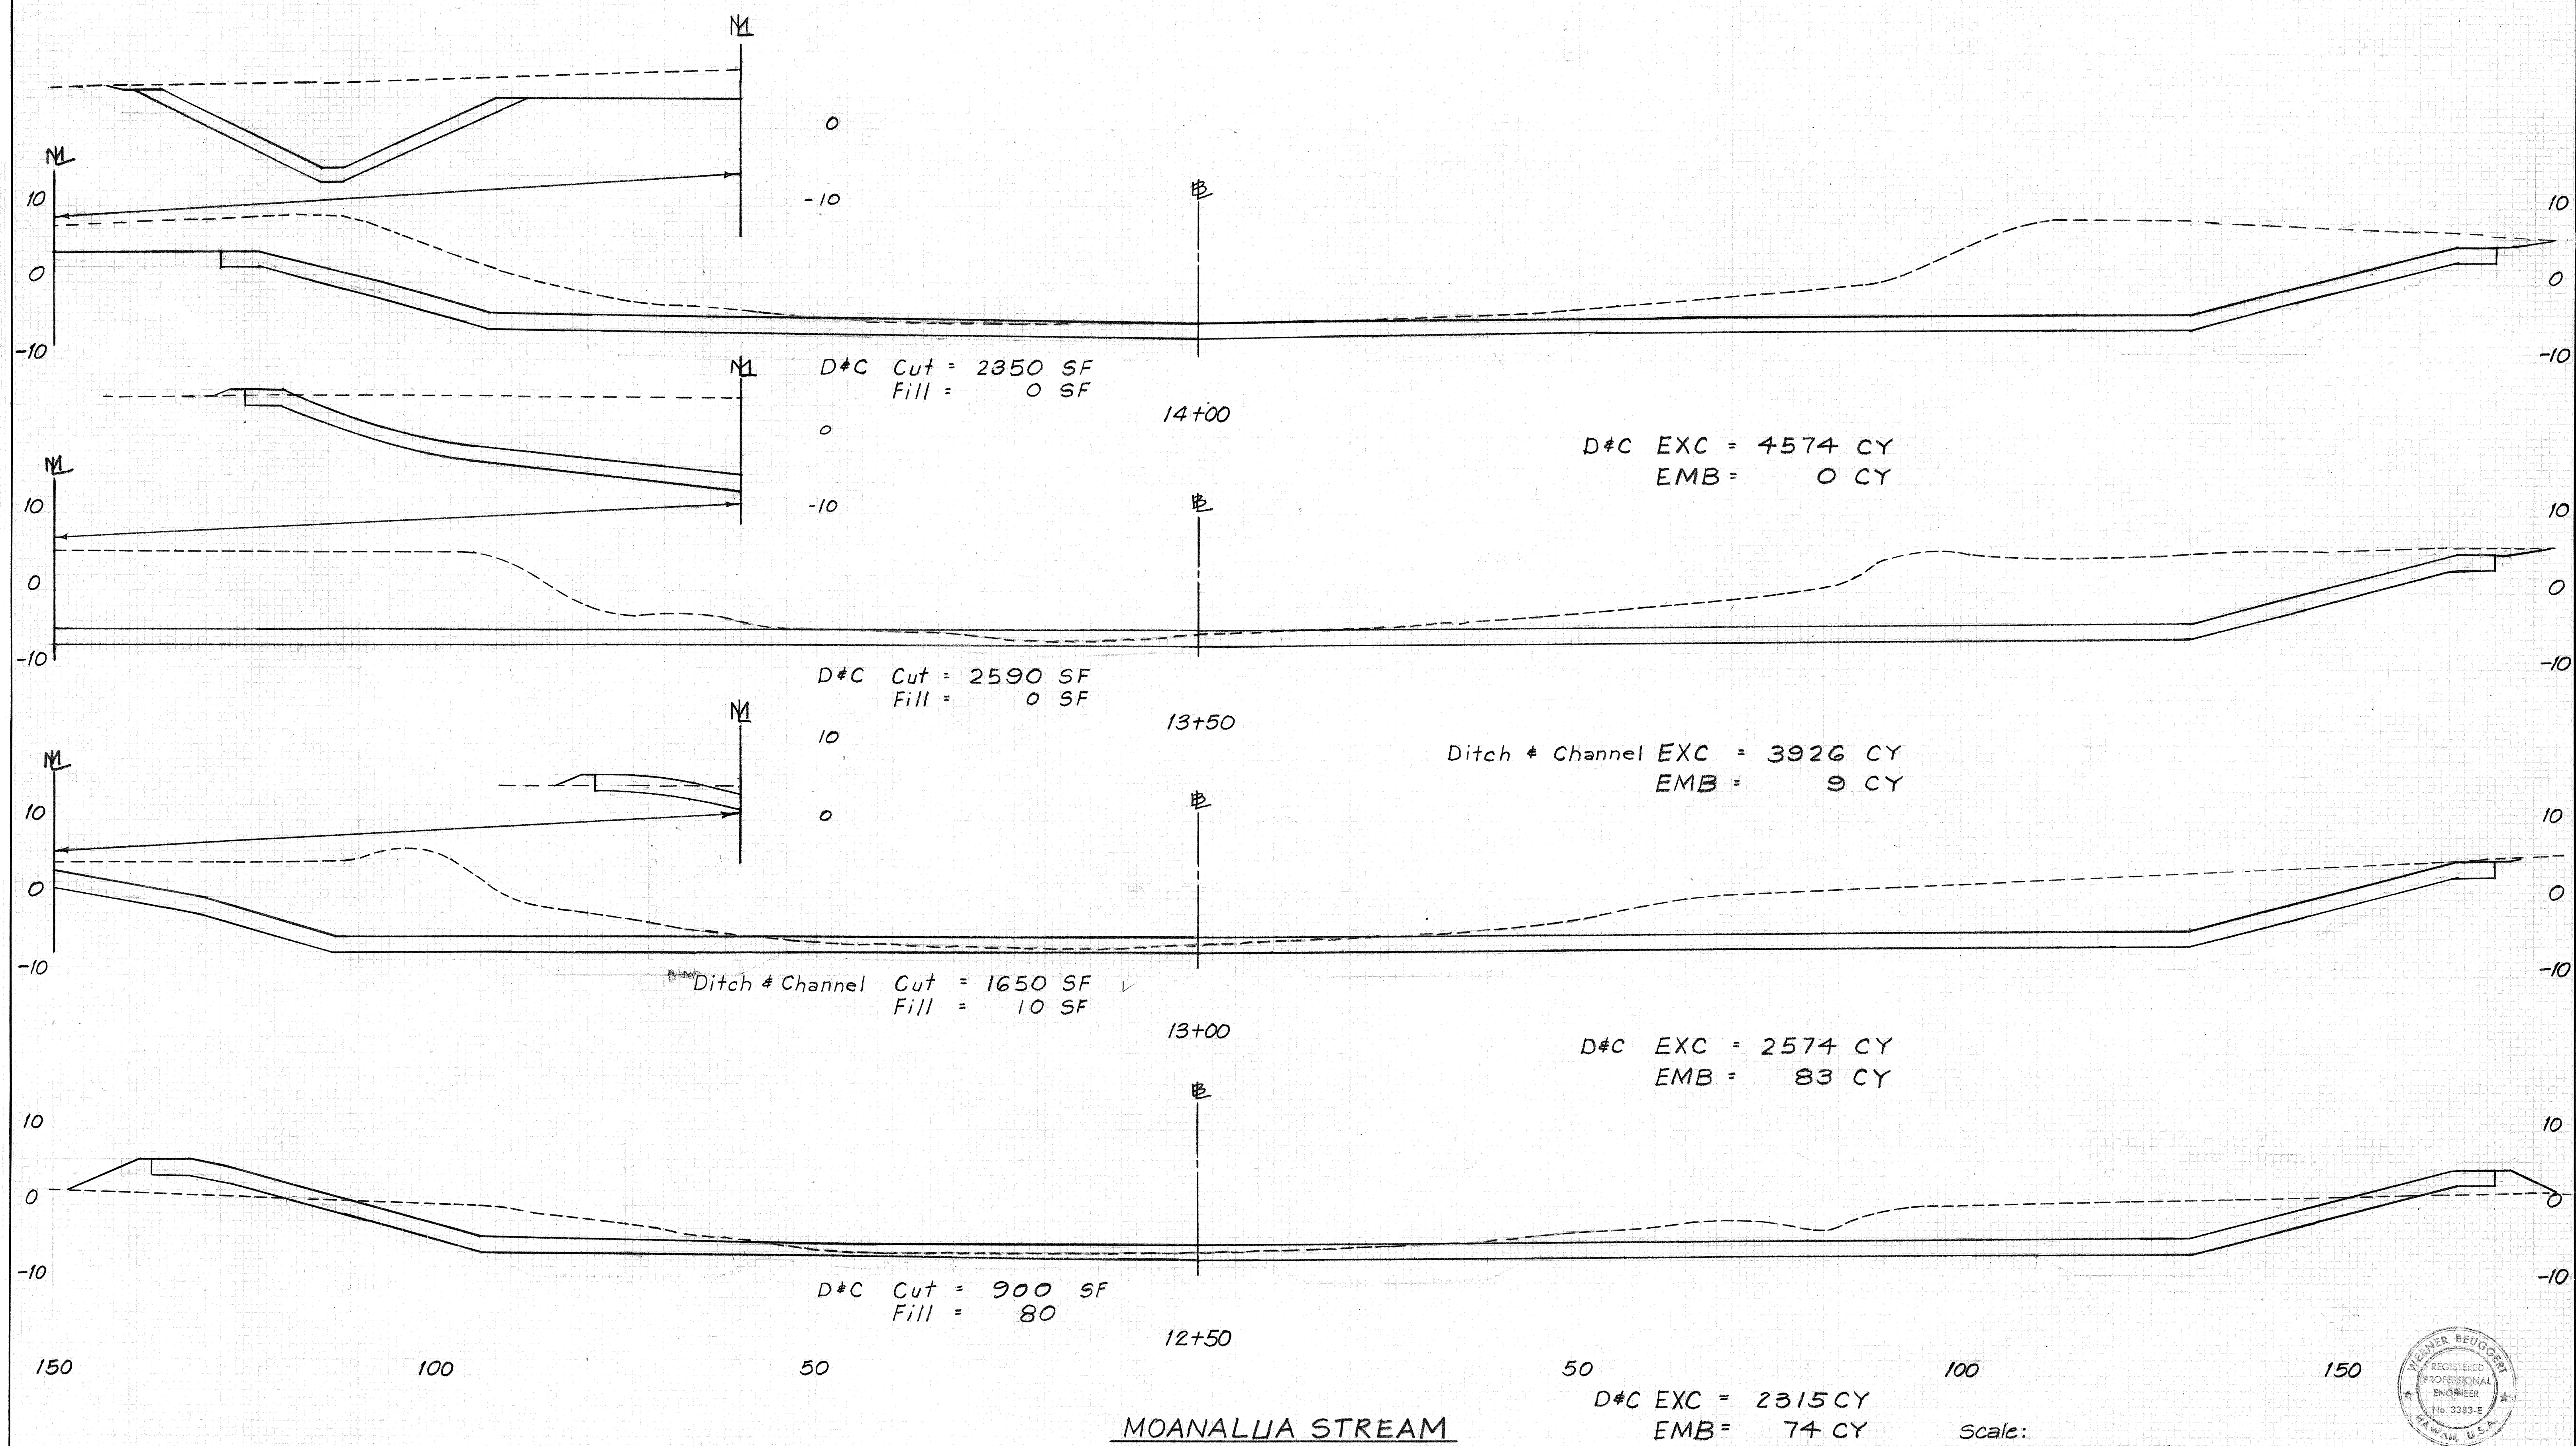

Scale: Horiz. 1"=10'
Vert. 1"=10'

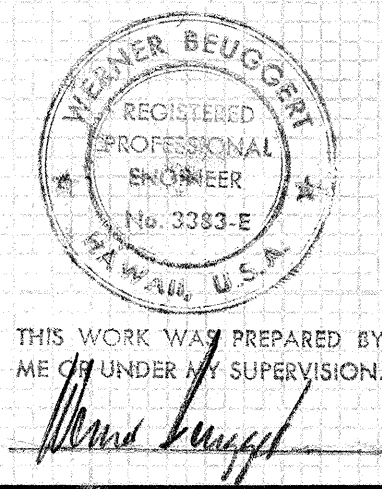

FED. ROAD DIST. NO.	STATE	FED. AID PROJ. NO.	FISCAL YEAR	SHEET NO.	TOTAL SHEETS
HAWAII	HAW.	I-HI-1 (168) 17	1982	145	145

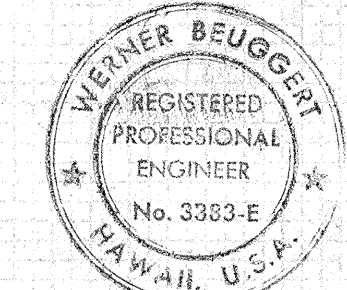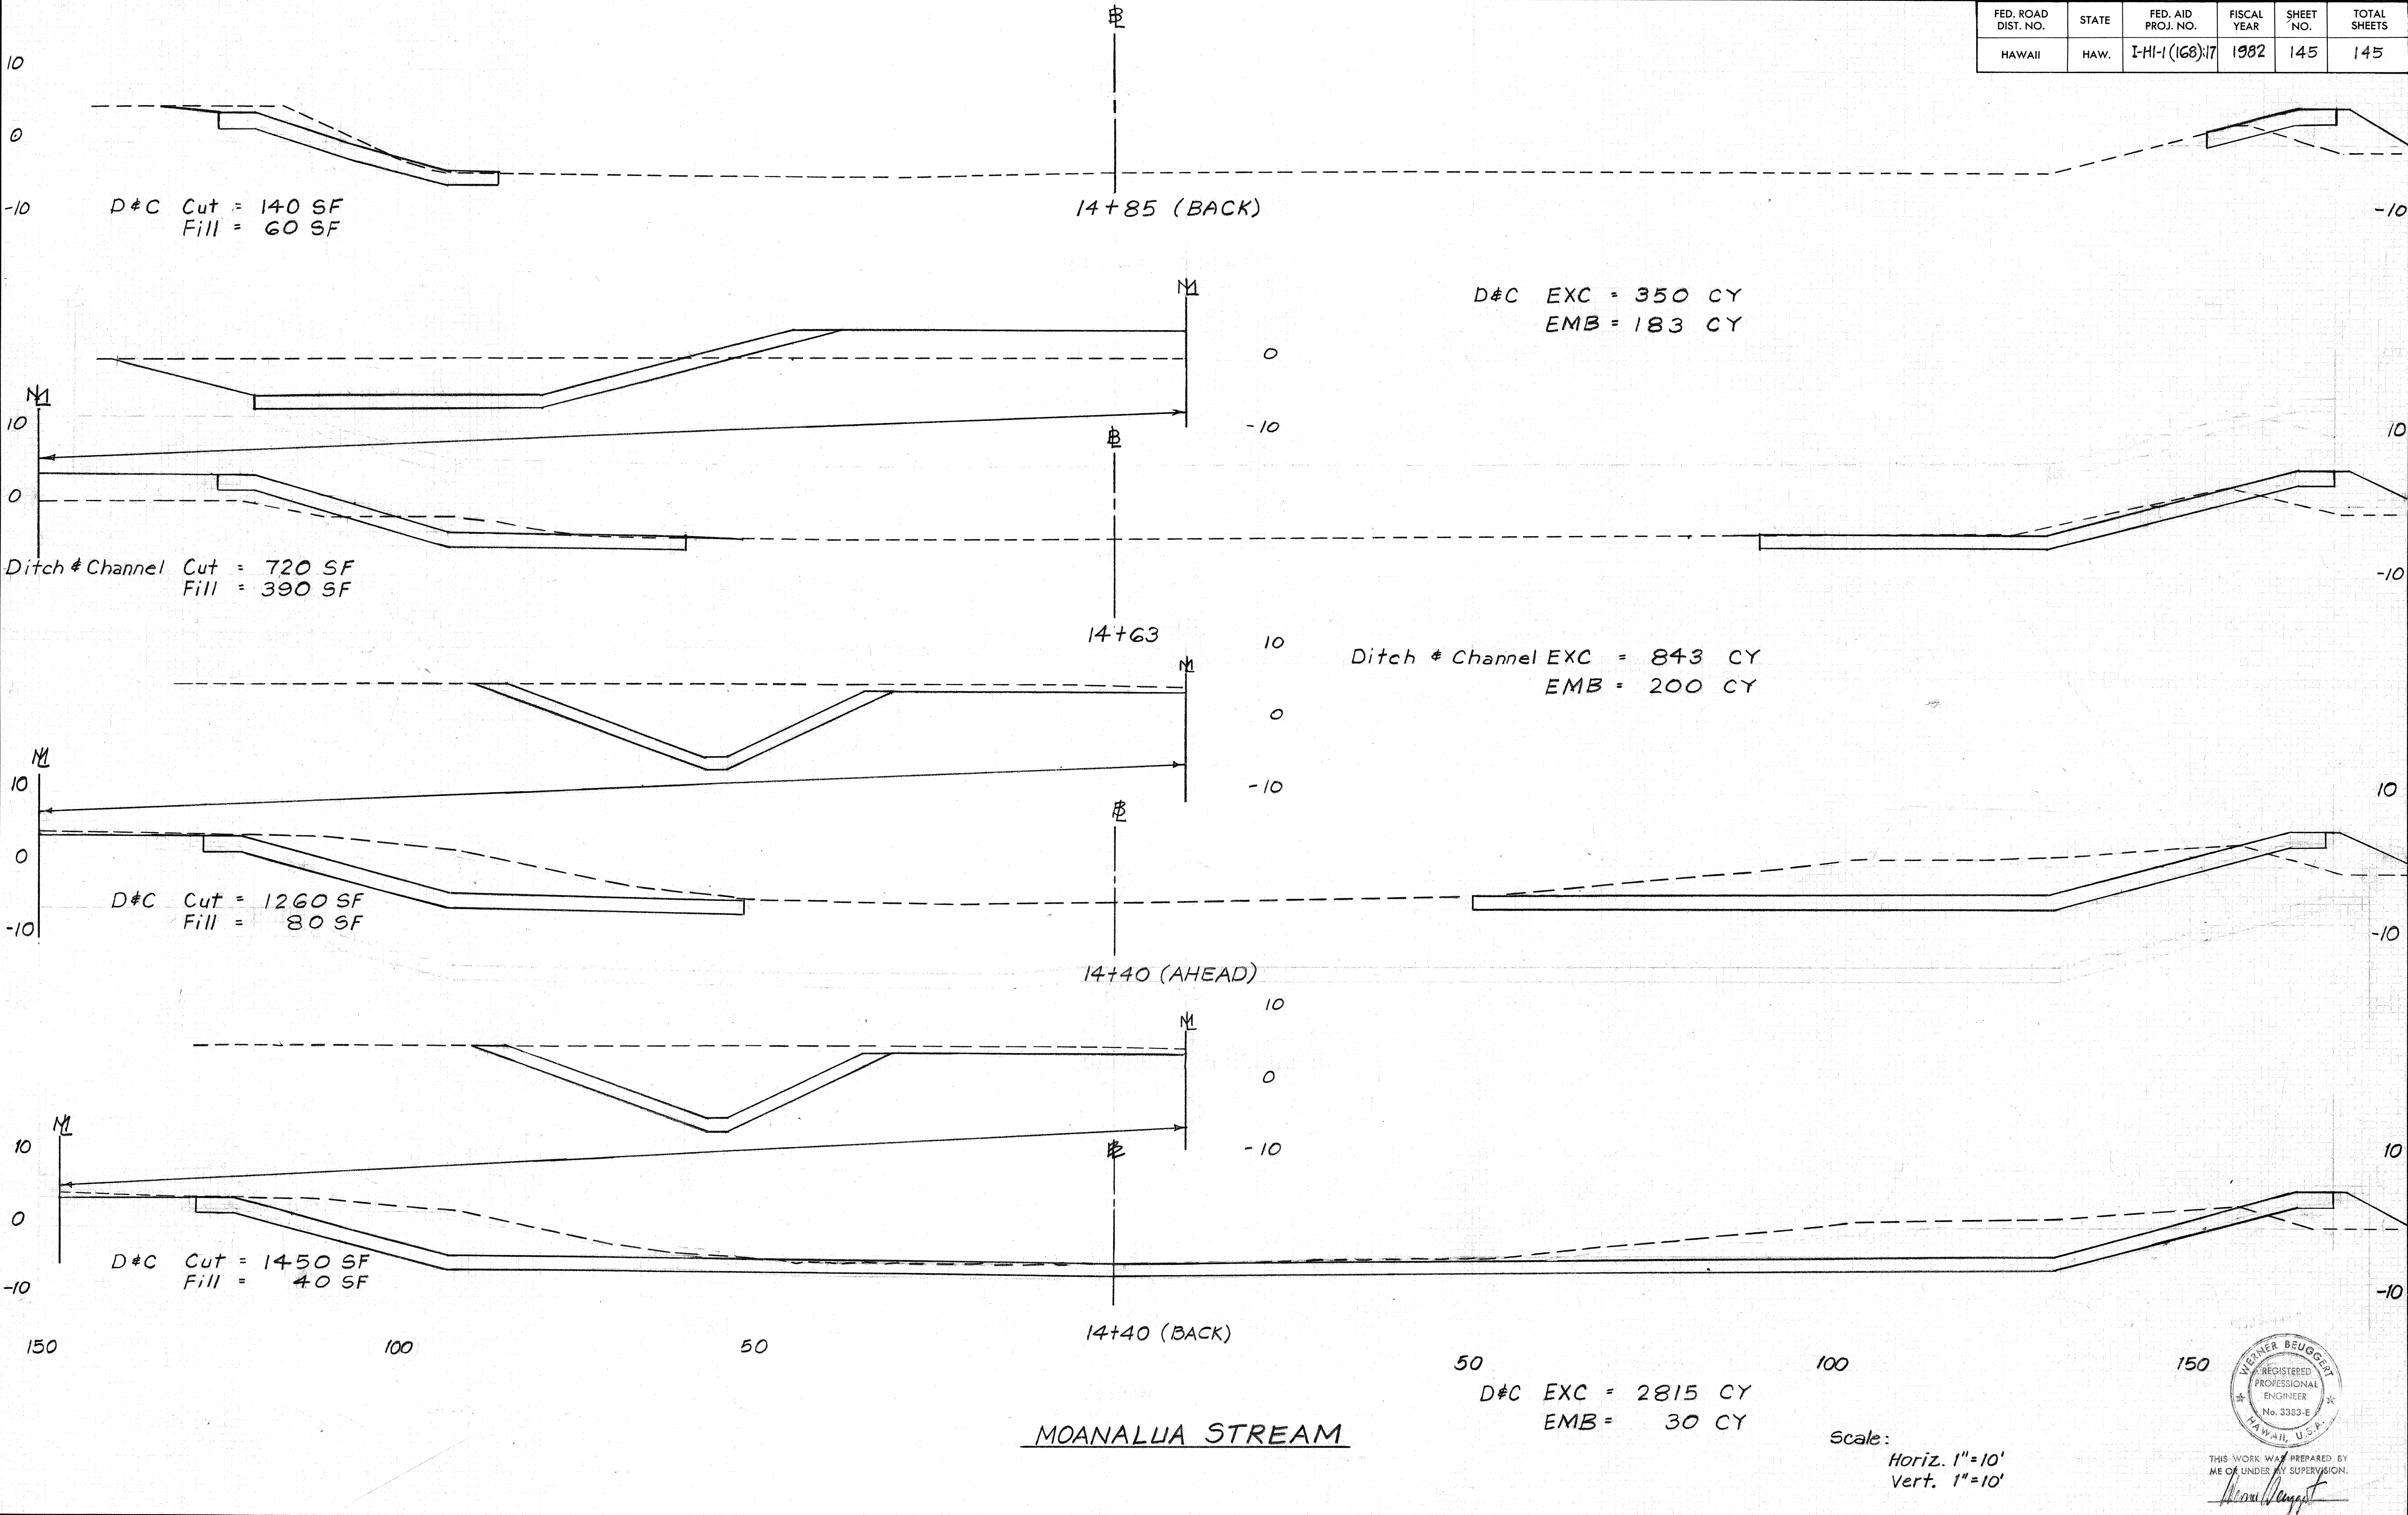

THIS WORK WAS PREPARED BY ME OR UNDER MY SUPERVISION.

Werner Bruggert