


| FED. ROAD<br>DIST. NO. | STATE | FED. AID<br>PROJ. NO. | FISCAL<br>YEAR | SHEET<br>NO. | TOTAL<br>SHEETS |
|------------------------|-------|-----------------------|----------------|--------------|-----------------|
| HAWAII                 | HAW.  | I-HI-1(168)17         | 1982           | 44           | 145             |

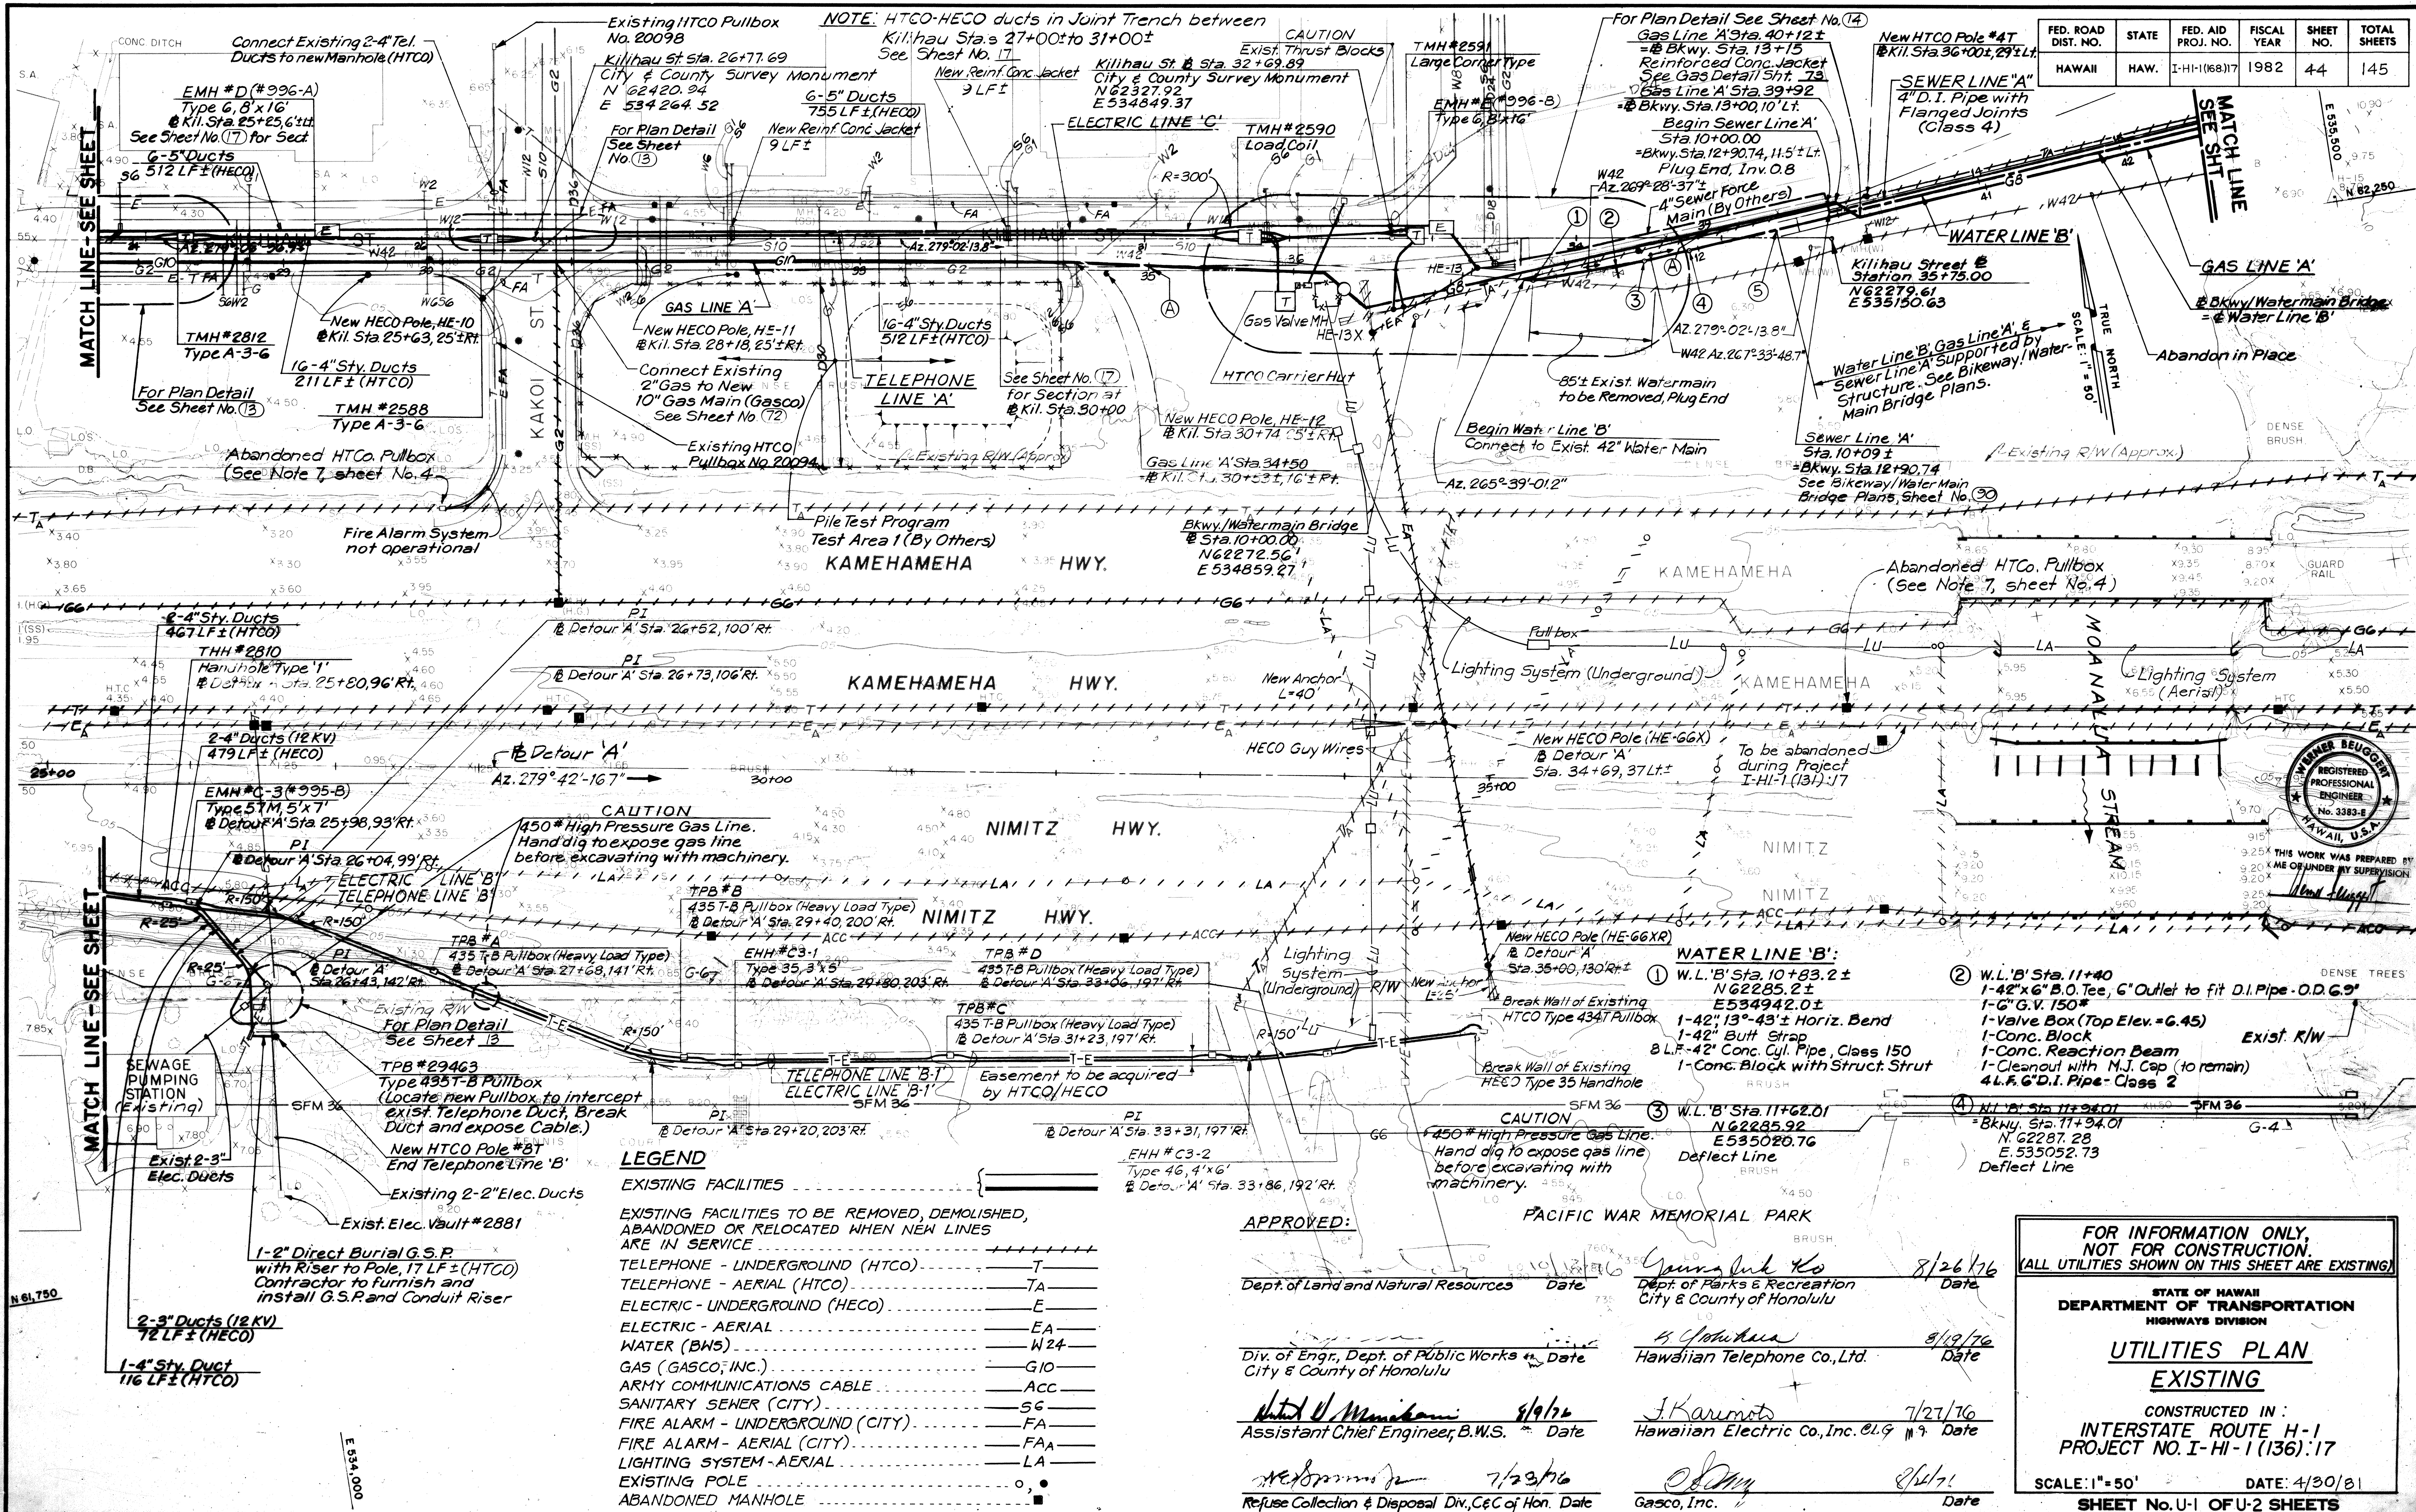

| FED. ROAD DIST. NO. | STATE | FED. AID PROJ. NO. | FISCAL YEAR | SHEET NO. | TOTAL SHEETS |
|---------------------|-------|--------------------|-------------|-----------|--------------|
| HAWAII              | HAW.  | I-HI-1(168):17     | 1982        | 45        | 145          |

### GENERAL UTILITY NOTES

- The Contractor shall be liable for damage to any existing utility and structure.
- The existence and location of underground and overhead utilities, appurtenances & structures as shown on the Plans are based on existing records of varying degrees of accuracy and completeness. They are not guaranteed as to the location shown or that other obstacles may not be encountered in the course of work. The Contractor shall assume that existing utilities may exist although not shown.
- The Contractor shall verify with the respective utility companies whether the existing utilities shown on the Plans are in service or not in service. For updated existing contours and existing drainlines, see grading plans.

### LEGEND

- EXISTING FACILITIES**

EXISTING FACILITIES WHICH HAVE BEEN REMOVED, DEMOLISHED, ABANDONED OR RELOCATED

TELEPHONE-UNDERGROUND (HTCO) ----- T

TELEPHONE-AERIAL (HTCO) ----- TA

ELECTRIC-UNDERGROUND (HECO) ----- E

ELECTRIC-AERIAL ----- EA

WATER (B.W.S.) ----- W24

GAS (GASCO, INC.) ----- G10

ARMY COMMUNICATIONS CABLE (HTCO) ----- ACC

SANITARY SEWER (CITY) ----- S6

LIGHTING SYSTEM ----- L

TRAFFIC SIGNAL CABLE ----- TSC

EXISTING POLE ----- +

ABANDONED MANHOLE ----- 13

|                   |       |
|-------------------|-------|
| DATE              | _____ |
| SURVEY PLOTTED BY | _____ |
| PLAN              | _____ |
| DESIGNED BY       | _____ |
| QUANTITIES BY     | _____ |
| CHECKED BY        | _____ |
| ORIGINAL          | _____ |
| NOTE BOOK         | _____ |

FOR INFORMATION ONLY,  
NOT FOR CONSTRUCTION.

STATE OF HAWAII  
DEPARTMENT OF TRANSPORTATION  
LAND TRANSPORTATION FACILITIES DIVISION

**UTILITIES PLAN  
EXISTING**

INTERSTATE ROUTE H-1  
PROJECT NO. I-HI-1 (168):17

SCALE: 1" = 50'      DATE: 4/30/81

SHEET No. U-2 OF U-2 SHEETS