

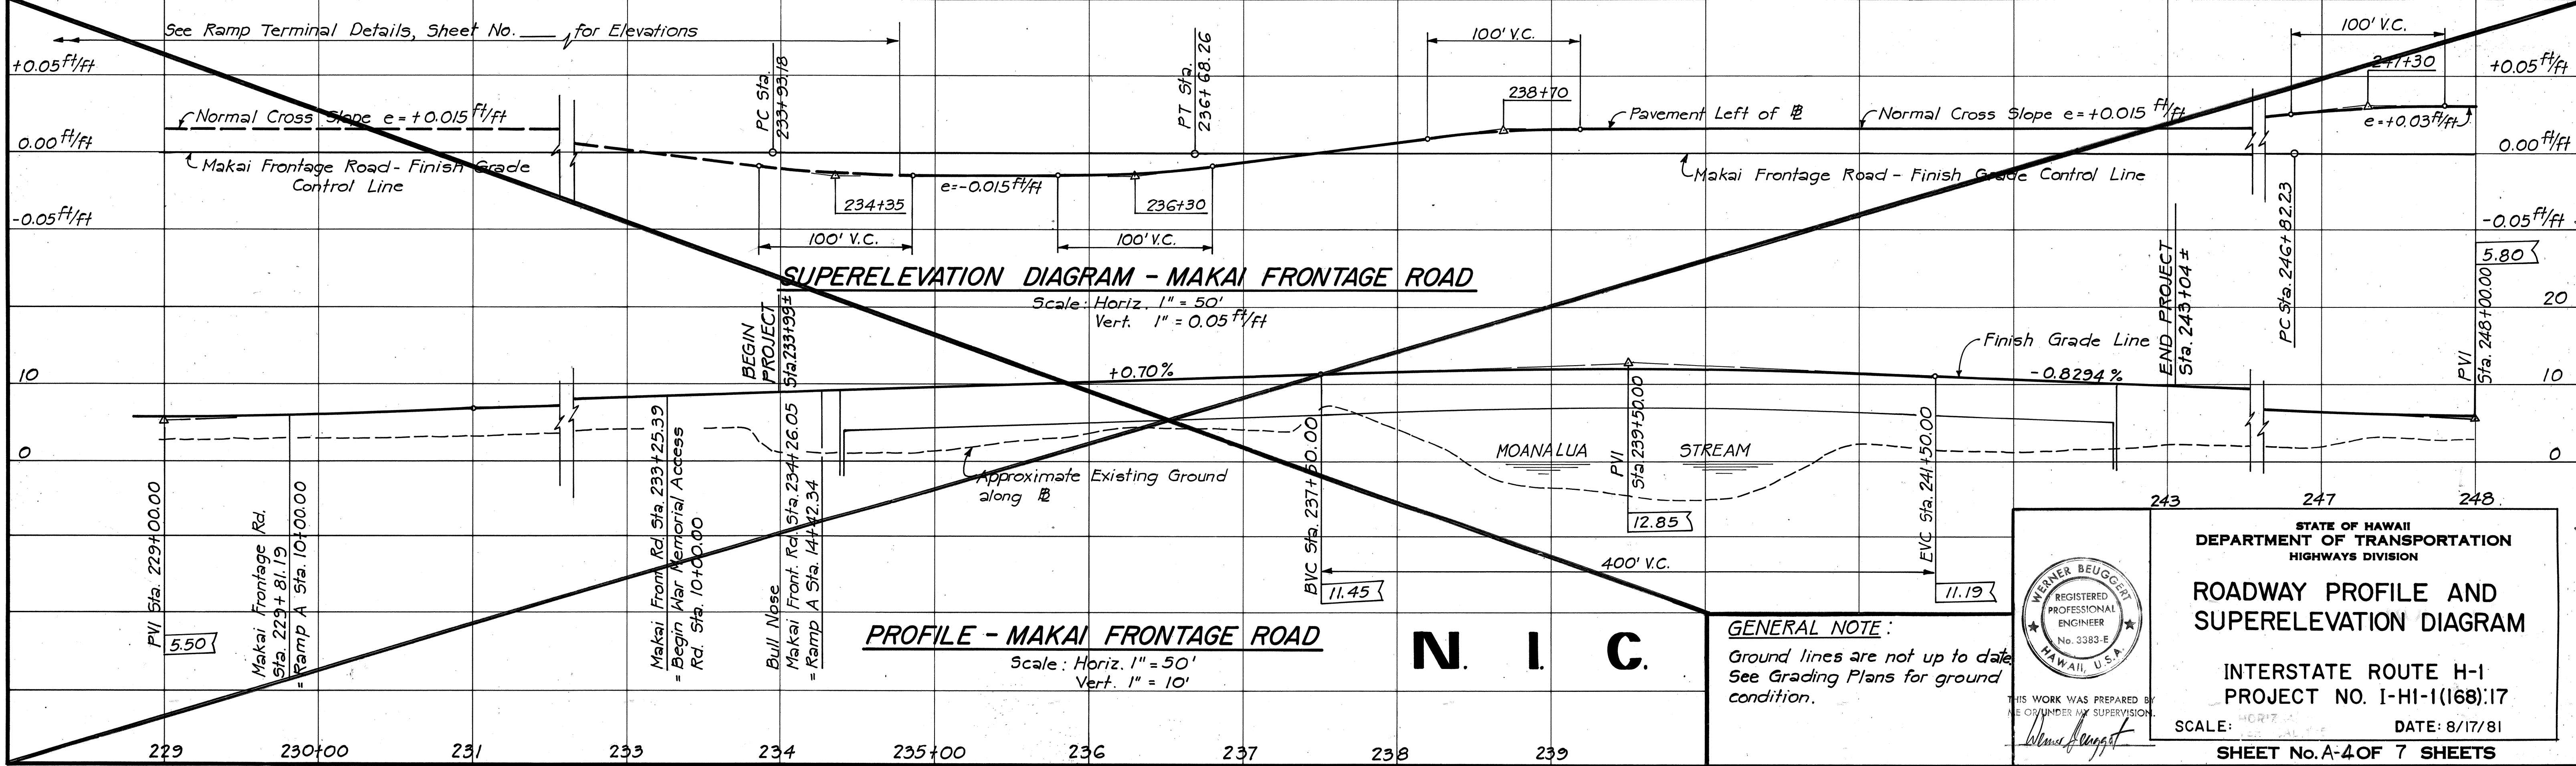
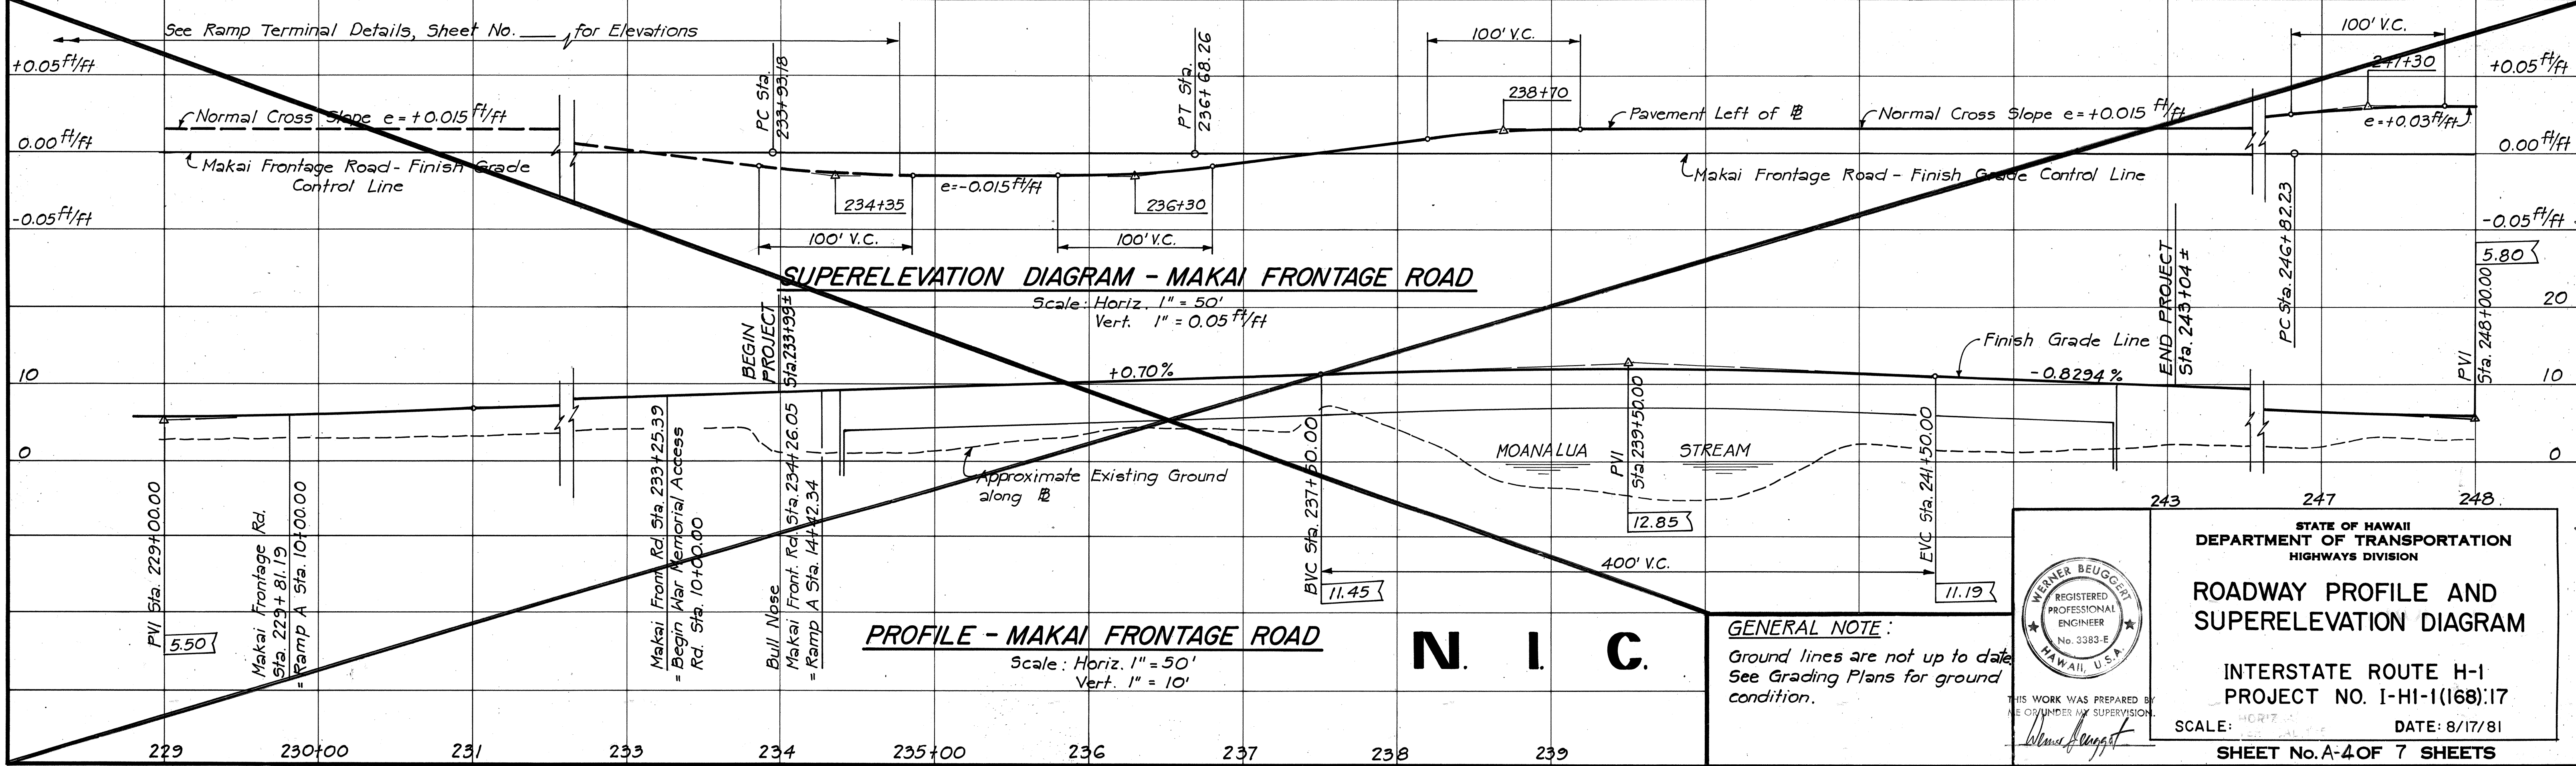
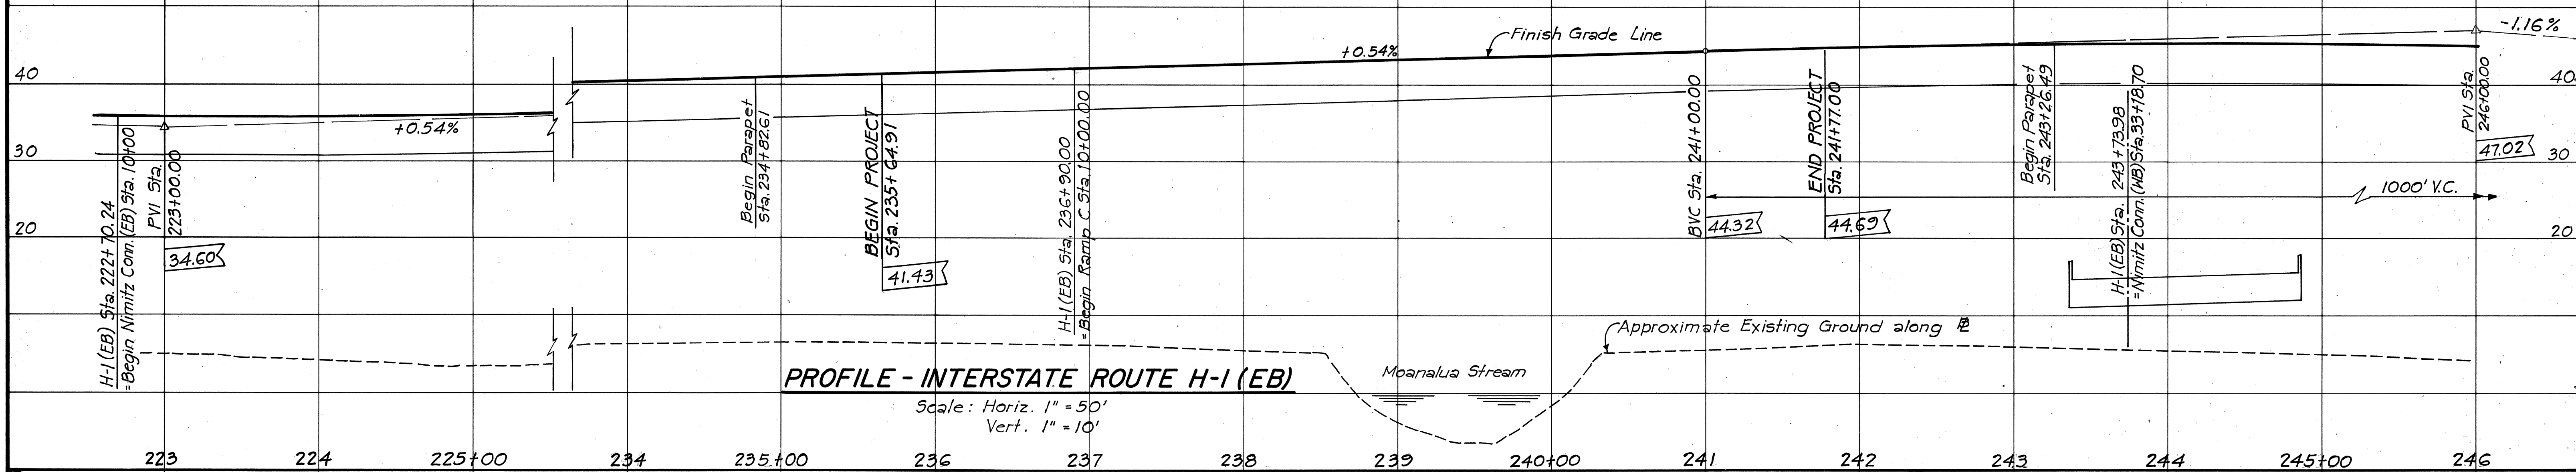


FED. ROAD DIST. NO.	STATE	FED. AID PROJ. NO.	FISCAL YEAR	SHEET NO.	TOTAL SHEETS
HAWAII	HAW.	I-HI-1(168):17	1982	6	145

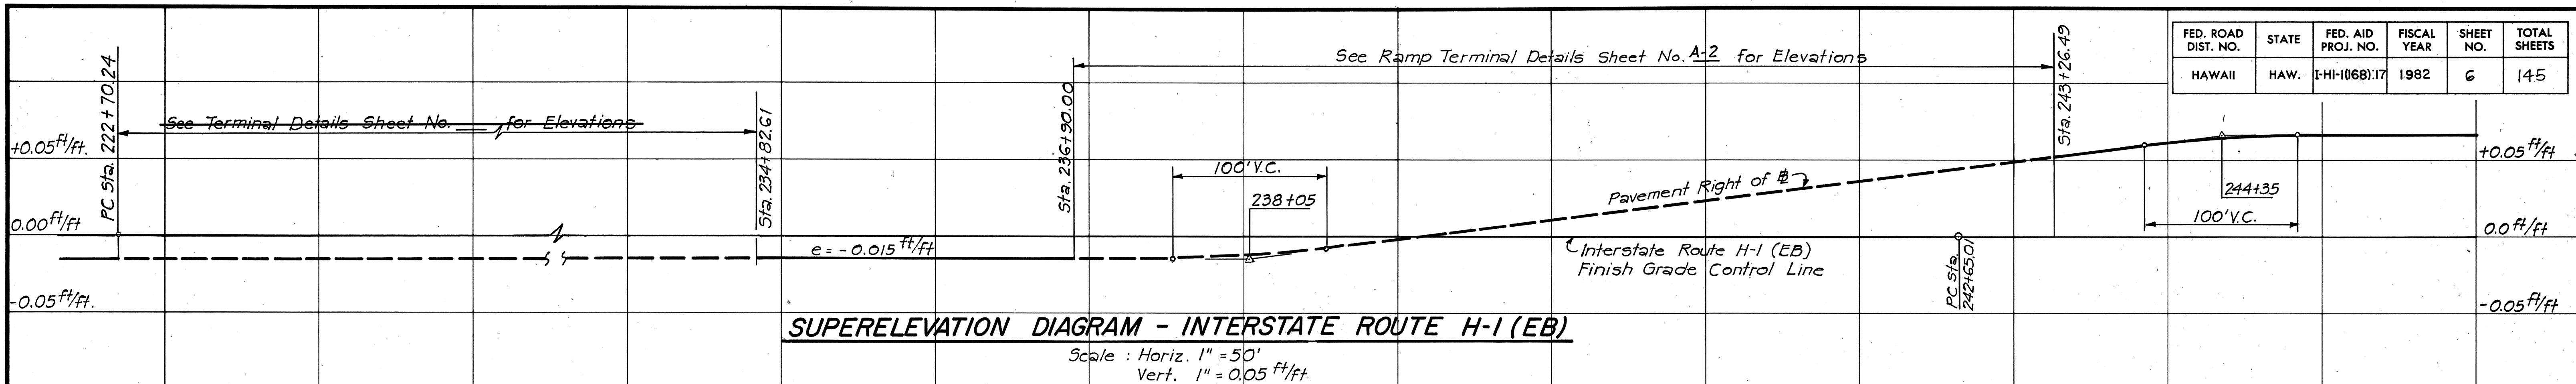

N. I. C.

GENERAL NOTE:
Ground lines are not up to date.
See Grading Plans for ground condition.

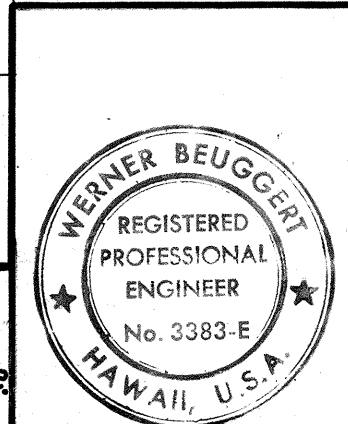

STATE OF HAWAII
DEPARTMENT OF TRANSPORTATION
HIGHWAYS DIVISION

**ROADWAY PROFILE AND
SUPERELEVATION DIAGRAM**

INTERSTATE ROUTE H-1
PROJECT NO. I-HI-1(168):17

SCALE: HORIZ. 1" = 50'
DATE: 8/17/81

SHEET No. A-4 OF 7 SHEETS

ORIGINAL	DATE
PLAN	
NOTES	
BOOK	
NO.	

FED. ROAD DIST. NO.	STATE	FED. AID PROJ. NO.	FISCAL YEAR	SHEET NO.	TOTAL SHEETS
HAWAII	HAW.	I-HI-1(168):17	1982	7	145

SUPERELEVATION DIAGRAM - NIMITZ CONNECTOR (EB)

Scale: Horiz. 1"=50'
Vert. 1"=0.05 ft/ft

See Ramp Terminal Details Sheet No. For Elevations

See Ramp Terminal Details Sheet No. For Elevations

Nimitz Connector (EB)
Finish Grade Control Line
Normal Cross Slope $e = -0.015$ ft/ft
Pavement Right of $\pm$

MATCH LINE

PROFILE - NIMITZ CONNECTOR (EB)

Scale: Horiz. 1"=50'
Vert. 1"=10'

Approximate Existing Ground Along $\pm$

GENERAL NOTE:

Ground lines are not up to date. See Grading Plans for ground condition.

SUPERELEVATION DIAGRAM - NIMITZ CONNECTOR (EB)

Scale: Horiz. 1"=50'
Vert. 1"=0.05 ft/ft

Nimitz Connector (EB) - Finish Grade Control Line

Pavement Right of $\pm$
 $e = -0.060$ ft/ft

MATCH LINE


Finish Grade Line

Approximate Existing Ground Along $\pm$

PROFILE - NIMITZ CONNECTOR (EB)

Scale: Horiz. 1"=50'
Vert. 1"=10'

Moanalua Stream

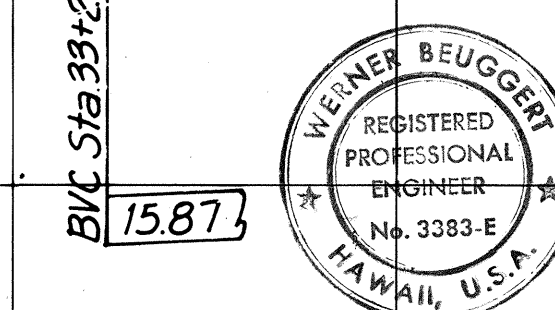


THIS WORK WAS PREPARED BY
ME OR UNDER MY SUPERVISION.
Werner Beugert

STATE OF HAWAII
DEPARTMENT OF TRANSPORTATION
HIGHWAYS DIVISION
**ROADWAY PROFILE AND
SUPERELEVATION DIAGRAM**

INTERSTATE ROUTE H-1
PROJECT NO. I-HI-1(168):17
SCALE: AS SHOWN DATE: 8/17/81
SHEET No. A-5 OF 7 SHEETS


FED. ROAD DIST. NO.	STATE	FED. AID PROJ. NO.	FISCAL YEAR	SHEET NO.	TOTAL SHEETS
HAWAII	HAW.	I-HI-1(168):17	1982	8	145

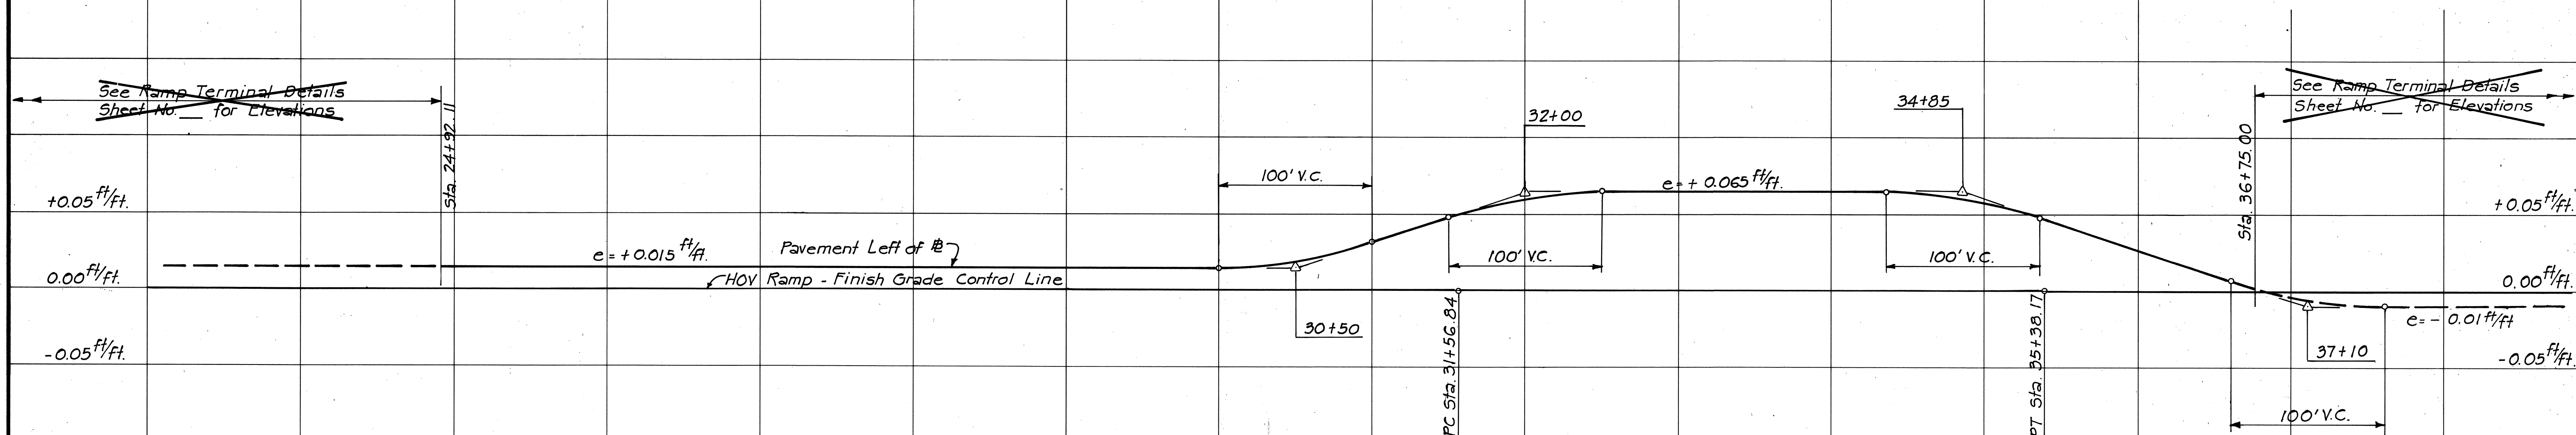

SUPERELEVATION DIAGRAM - H.O.V. RAMP


Scale: Horiz. 1" = 50'
Vert. 1" = 0.05 ft/ft.

GENERAL NOTE:
Ground lines are not up to date.
See Grading Plans for ground condition.

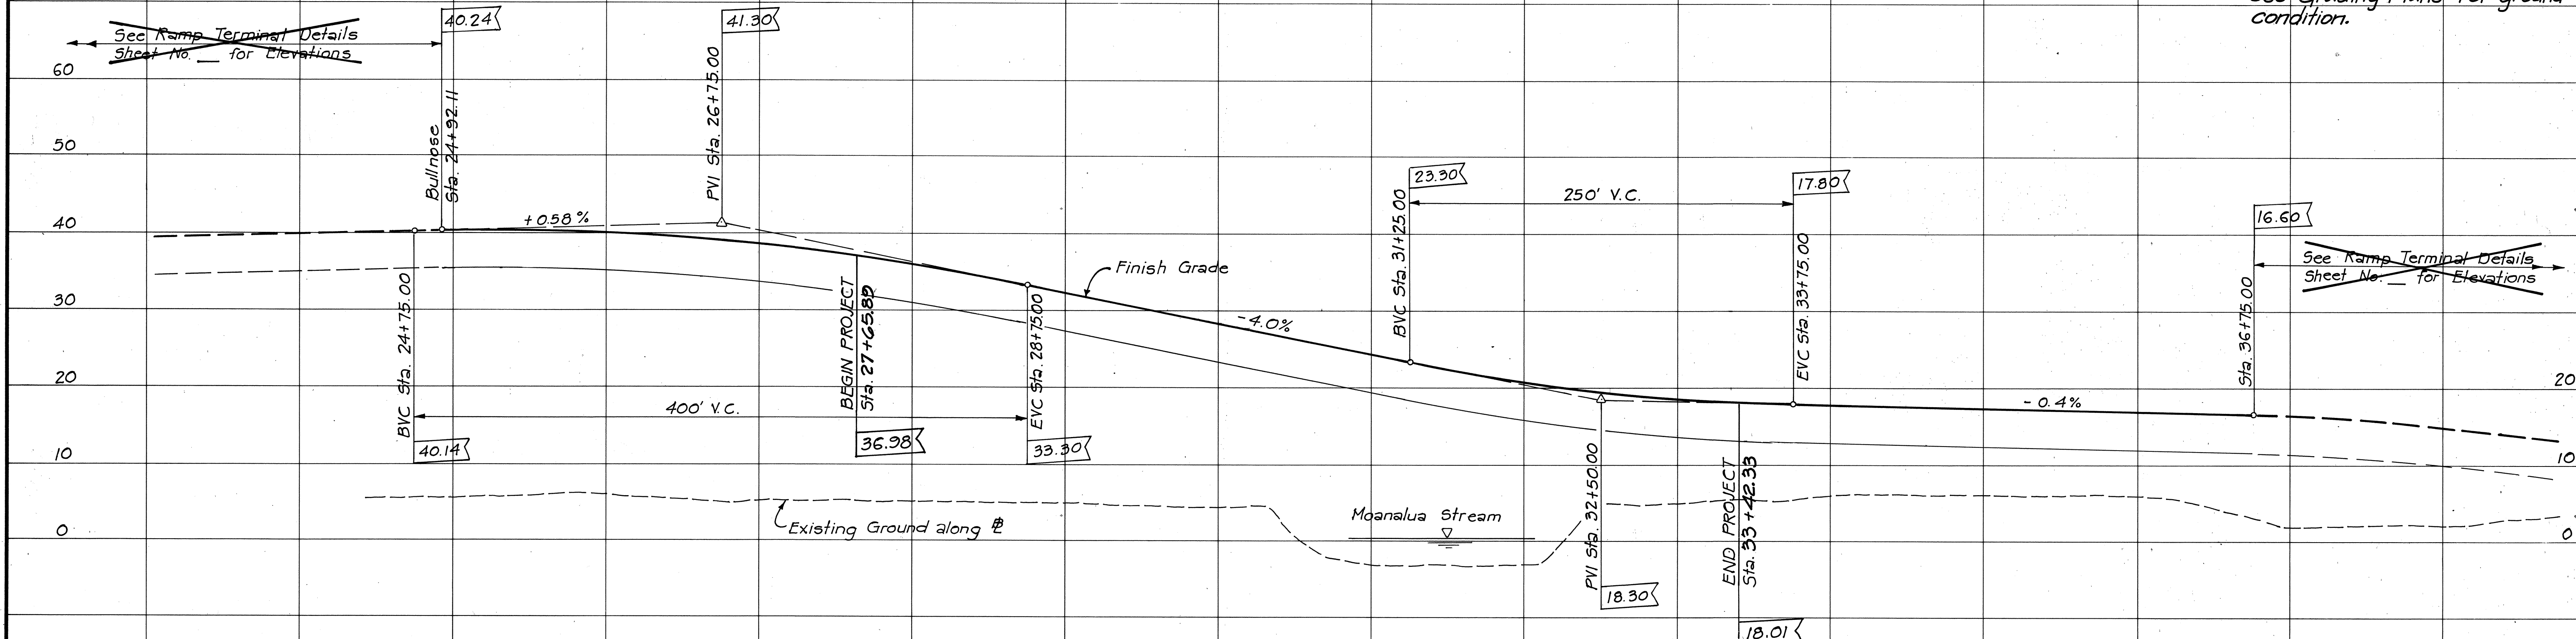

PROFILE - H.O.V. RAMP

Scale: Horiz. 1" = 50'
Vert. 1" = 10'

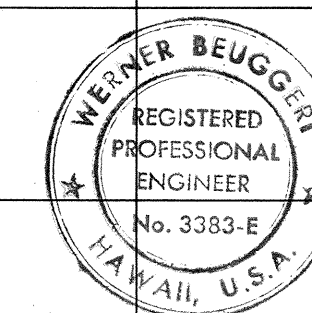



THIS WORK WAS PREPARED BY
ME OR UNDER MY SUPERVISION.
Werner Beugert

STATE OF HAWAII
DEPARTMENT OF TRANSPORTATION
HIGHWAYS DIVISION
**H.O.V. RAMP PROFILE &
SUPERELEVATION DIAGRAM**


INTERSTATE ROUTE H-1
PROJECT NO. I-HI-1 (168):17

SCALE: AS SHOWN DATE: 8/17/81
SHEET No. A-6 OF 7 SHEETS

FED. ROAD DIST. NO.	STATE	FED. AID PROJ. NO.	FISCAL YEAR	SHEET NO.	TOTAL SHEETS
HAWAII	HAW.	I-HI-1(168):17	1982	9	145

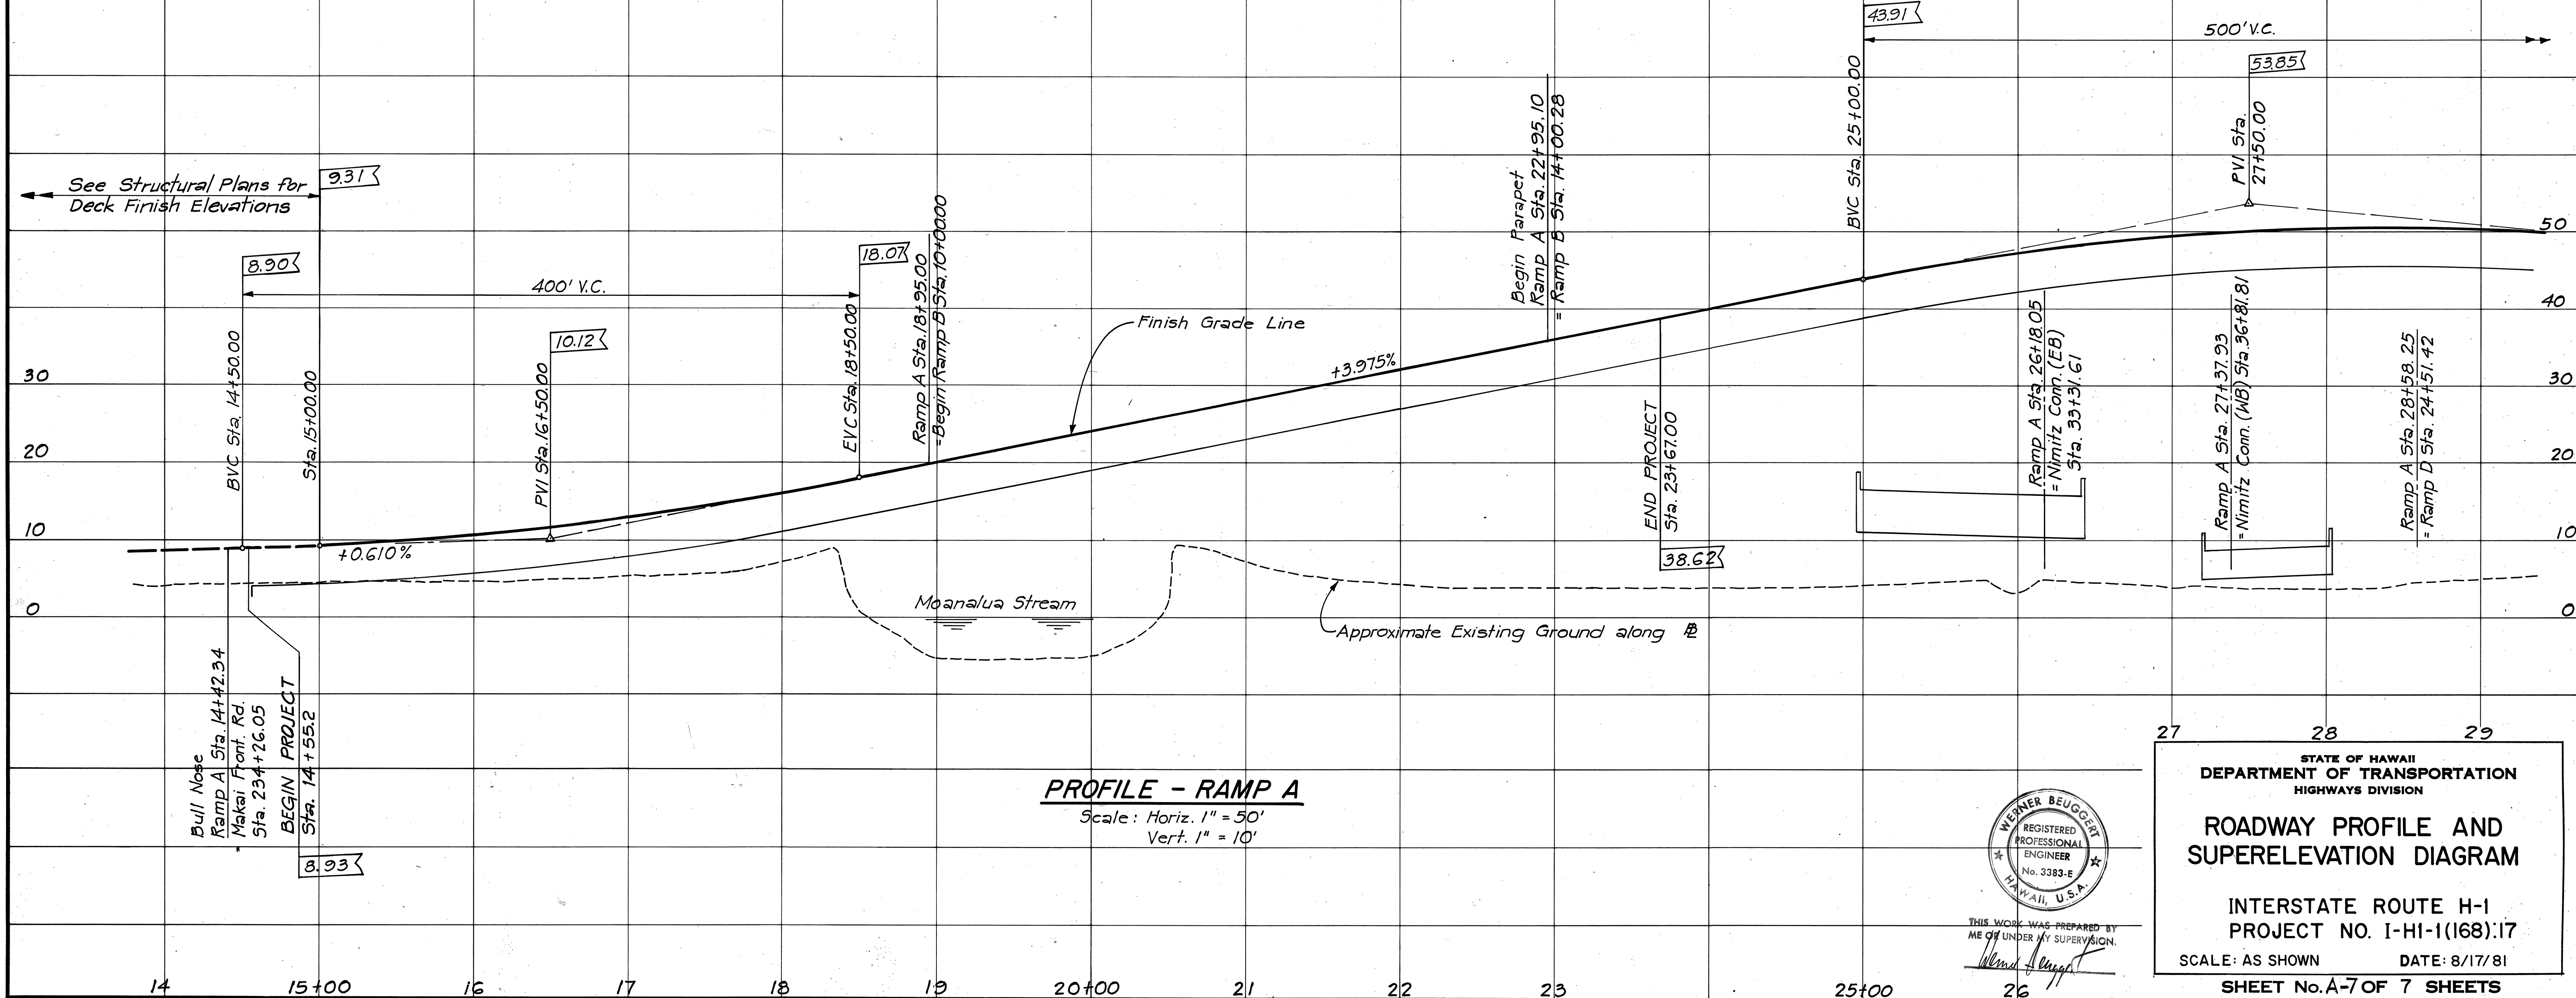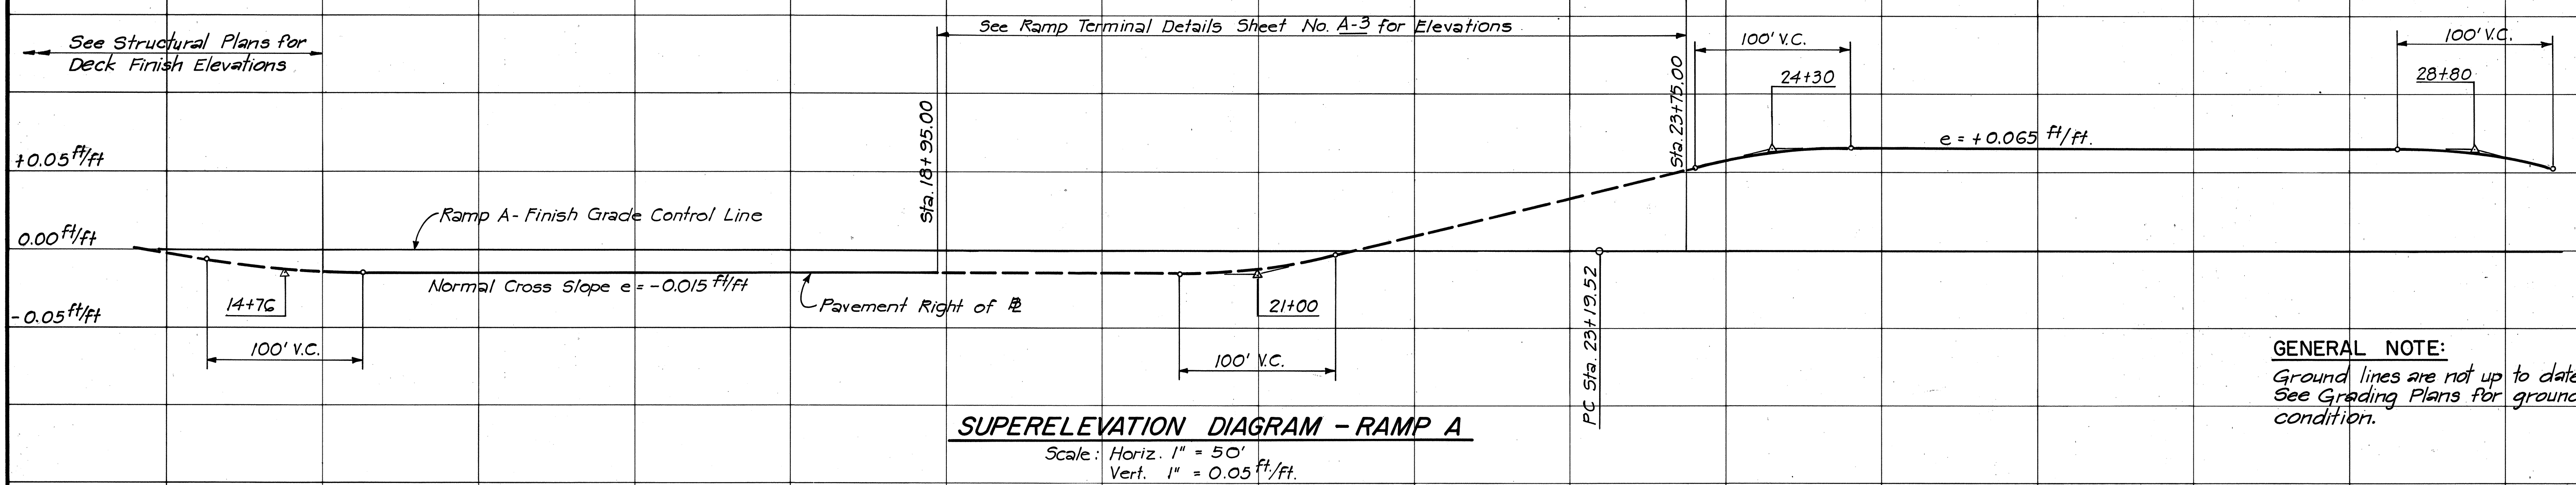

ORIGINAL PLAN	SURVEY PLOTTED BY _____ DATE _____
NOTE BOOK	DRAWN BY _____
	TRACED BY _____
	DESIGNED BY _____
	QUANTITIES BY _____
No. _____	CHECKED BY _____

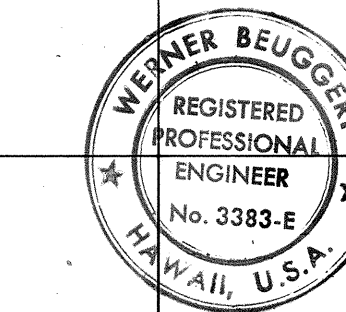

THIS WORK WAS PREPARED BY
ME OR UNDER MY SUPERVISION.

**STATE OF HAWAII
DEPARTMENT OF TRANSPORTATION
HIGHWAYS DIVISION**

ROADWAY PROFILE AND SUPERELEVATION DIAGRAM

INTERSTATE ROUTE H-1
PROJECT NO. I-HI-1(168):17

SCALE: AS SHOWN DATE: 8/17/81

SHEET No. A-7 OF 7 SHEETS