


| FED. ROAD<br>DIST. NO. | STATE | FED. AID<br>PROJ. NO. | FISCAL<br>YEAR | SHEET<br>NO. | TOTAL<br>SHEETS |
|------------------------|-------|-----------------------|----------------|--------------|-----------------|
| HAWAII                 | HAW.  | HH-16817              | 1982           | 60           | 145             |

[illegible][illegible]

|               |                   |      |
|---------------|-------------------|------|
| ORIGINAL PLAN | SURVEY PLOTTED BY | DATE |
|               | DRAWN BY          |      |
|               | TRACED BY         |      |
| NOTE BOOK     | DESIGNED BY       |      |
|               | QUANTITIES BY     |      |
| No.           | CHECKED BY        |      |

**PRESTRESSED CONCRETE  
GIRDERS WILL BE  
FURNISHED BY OTHERS**

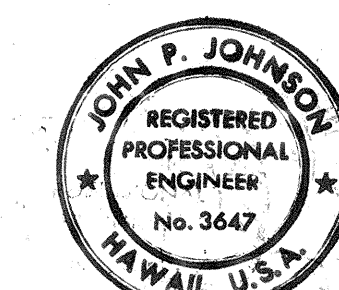

THIS WORK WAS PREPARED BY  
ME OR UNDER MY SUPERVISION.

John P. Johnson

STATE OF HAWAII  
DEPARTMENT OF TRANSPORTATION  
HIGHWAYS DIVISION  
H-1 VIADUCT (E.B.), RAMP C & HOV RAMP

## INDEX OF DRAWINGS AND ESTIMATED QUANTITIES

KEEHI INTERCHANGE  
F.A.I. PROJ. NO.I-HI-I (168):17


DATE: 8/17/81

**SHEET No.T-1 OF T-23 SHEETS**




| FED. ROAD DIST. NO. | STATE | FED. AID PROJ. NO. | FISCAL YEAR | SHEET NO. | TOTAL SHEETS |
|---------------------|-------|--------------------|-------------|-----------|--------------|
| HAWAII              | HAW.  | 1-H1(168)-17       | 1982        | 61        | 145          |

- NOTES:**
- For Scupper Details, see Sheet Nos. SD-8 & SD-9.
  - For Footing Location Plan, see Sheet Nos. T-5 & T-6.
  - For Transverse Joint Details, see Sheet Nos. SD-6 & SD-7.
  - For General Notes, see Sheet No. SD-1.
  - See Electrical Plans for locations and number of conduit.
  - Location of Scuppers shown on plans is approximate. In order to clear the obstructions or to facilitate the construction of the Viaduct, the location of scuppers may be adjusted by 2 to 3 feet, but total number of Scuppers in each span shall remain the same as shown on plans.

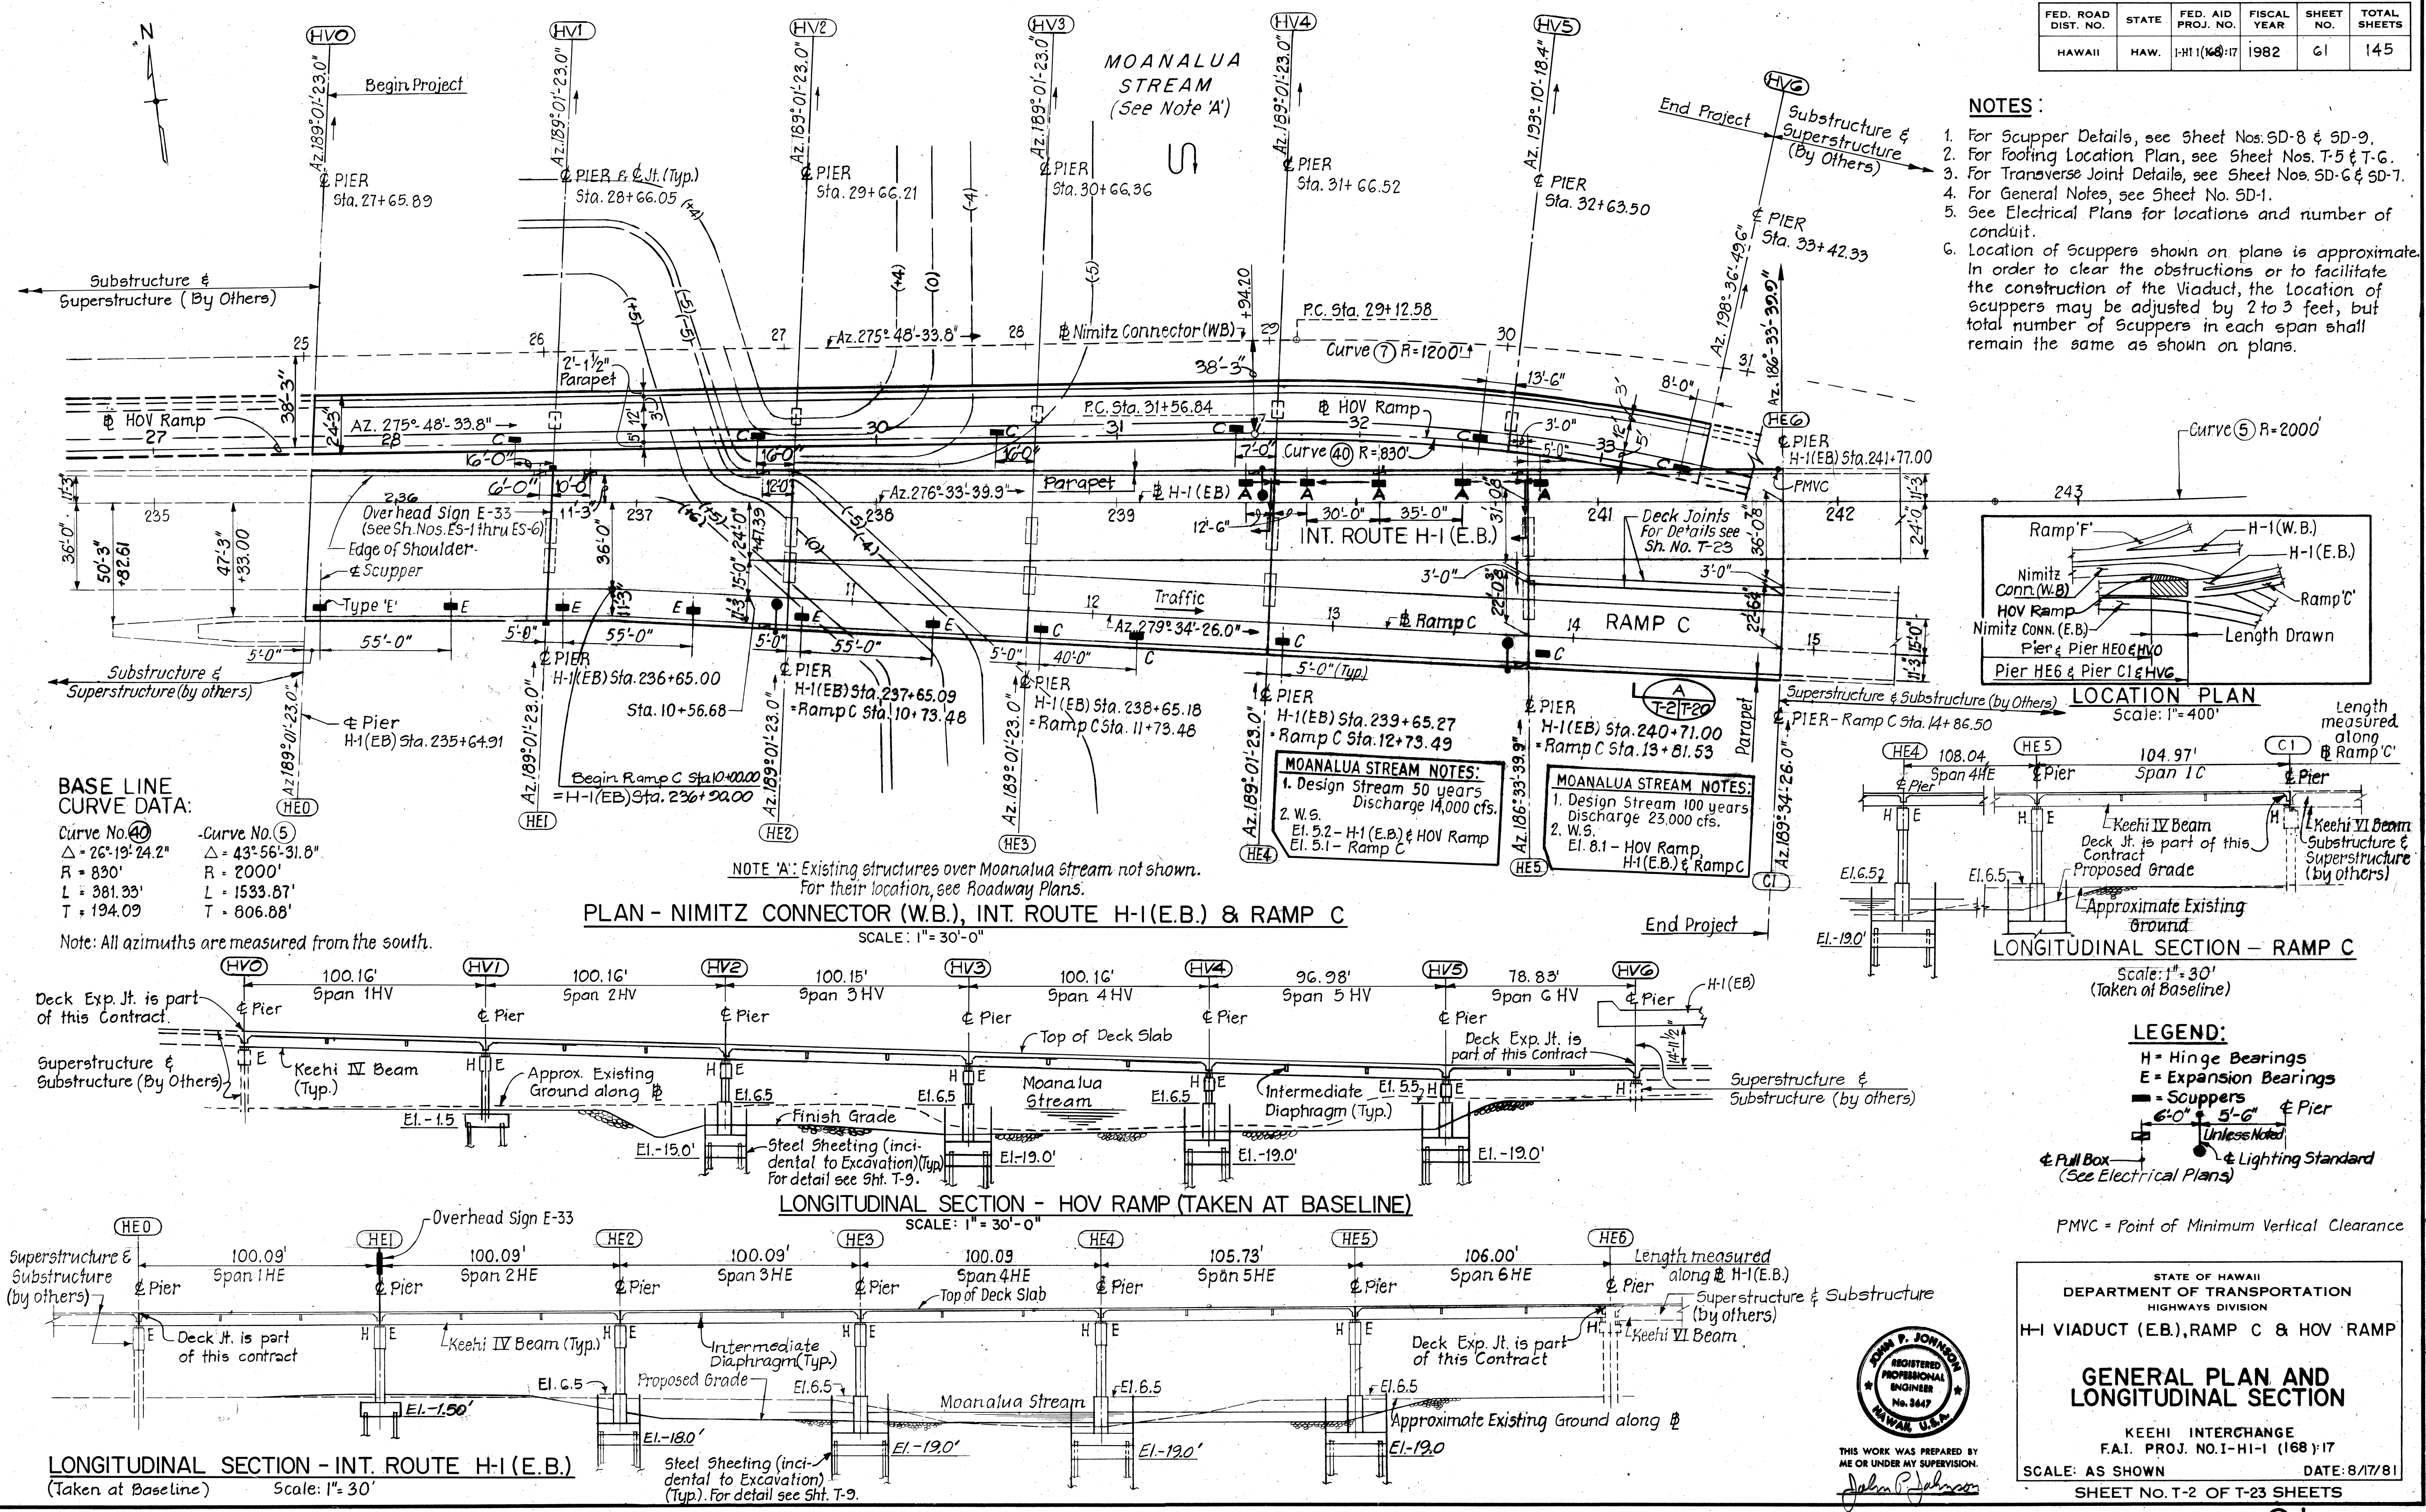

DATE: \_\_\_\_\_  
 SURVEY PLANS BY: \_\_\_\_\_  
 DRAWN BY: \_\_\_\_\_  
 TRACED BY: \_\_\_\_\_  
 NOTE BOOK: \_\_\_\_\_  
 CHECKED BY: \_\_\_\_\_

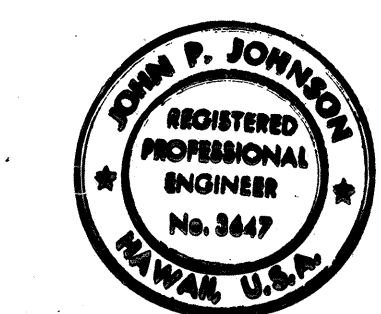


THIS WORK WAS PREPARED BY ME OR UNDER MY SUPERVISION.  
 John P. Johnson

STATE OF HAWAII  
 DEPARTMENT OF TRANSPORTATION  
 HIGHWAYS DIVISION  
**H-1 VIADUCT (E.B.), RAMP C & HOV RAMP**  
**GENERAL PLAN AND LONGITUDINAL SECTION**  
 KEEHI INTERCHANGE  
 F.A.I. PROJ. NO. 1-H1-1 (168)-17  
 SCALE: AS SHOWN  
 DATE: 8/17/81  
 SHEET NO. T-2 OF T-23 SHEETS



| FED. ROAD DIST. NO. | STATE | FED. AID PROJ. NO. | FISCAL YEAR | SHEET NO. | TOTAL SHEETS |
|---------------------|-------|--------------------|-------------|-----------|--------------|
| HAWAII              | HAW.  | 1-HI-1(168)-17     | 1982        | 62        | 145          |

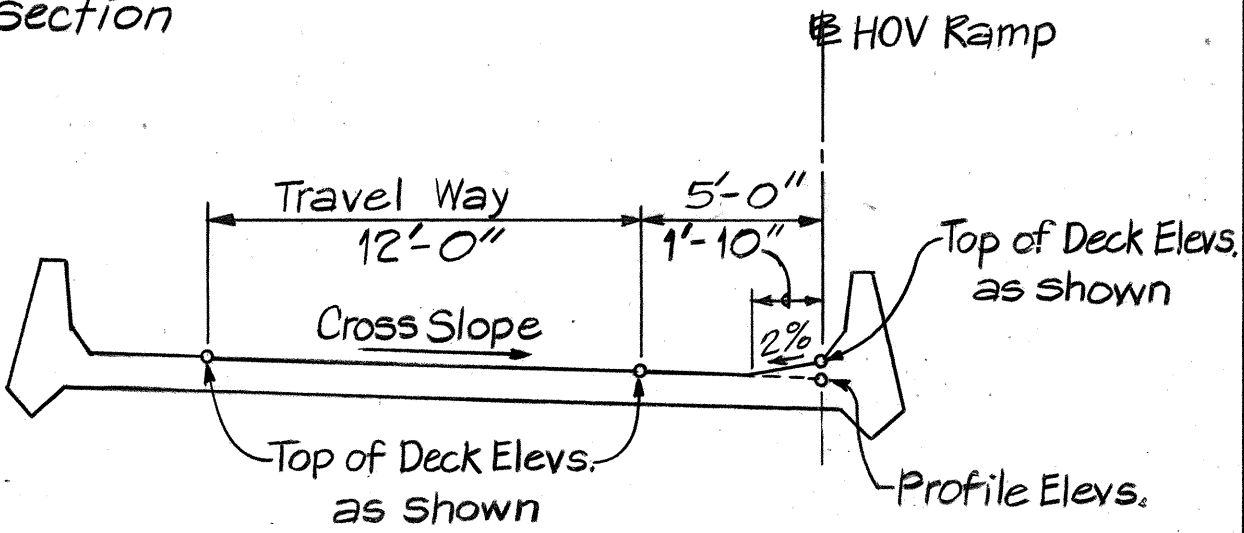

HOV RAMP DECK SECTION  
N.T.S.

- NOTES:
- Deck Elevations are shown at 10'-0" intervals in transition areas, and at 25'-0" intervals in non-transition areas.
  - For Scupper Locations, see Sh. No. T-2.


STATE OF HAWAII  
DEPARTMENT OF TRANSPORTATION  
HIGHWAYS DIVISION  
H-1 VIADUCT (E.B.), RAMP C & HOV RAMP

DECK ELEVATIONS  
SHEET 1 OF 2  
KEEHI INTERCHANGE  
F.A.I. PROJ. NO. 1-HI-1(168)-17  
SCALE: 1"=20'-0" DATE: 8/17/81  
SHEET NO. T-3 OF T-23 SHEETS

JOHN P. JOHNSON  
REGISTERED PROFESSIONAL ENGINEER  
No. 3647  
HAWAII, U.S.A.

THIS WORK WAS PREPARED BY ME OR UNDER MY SUPERVISION.

*John P. Johnson*

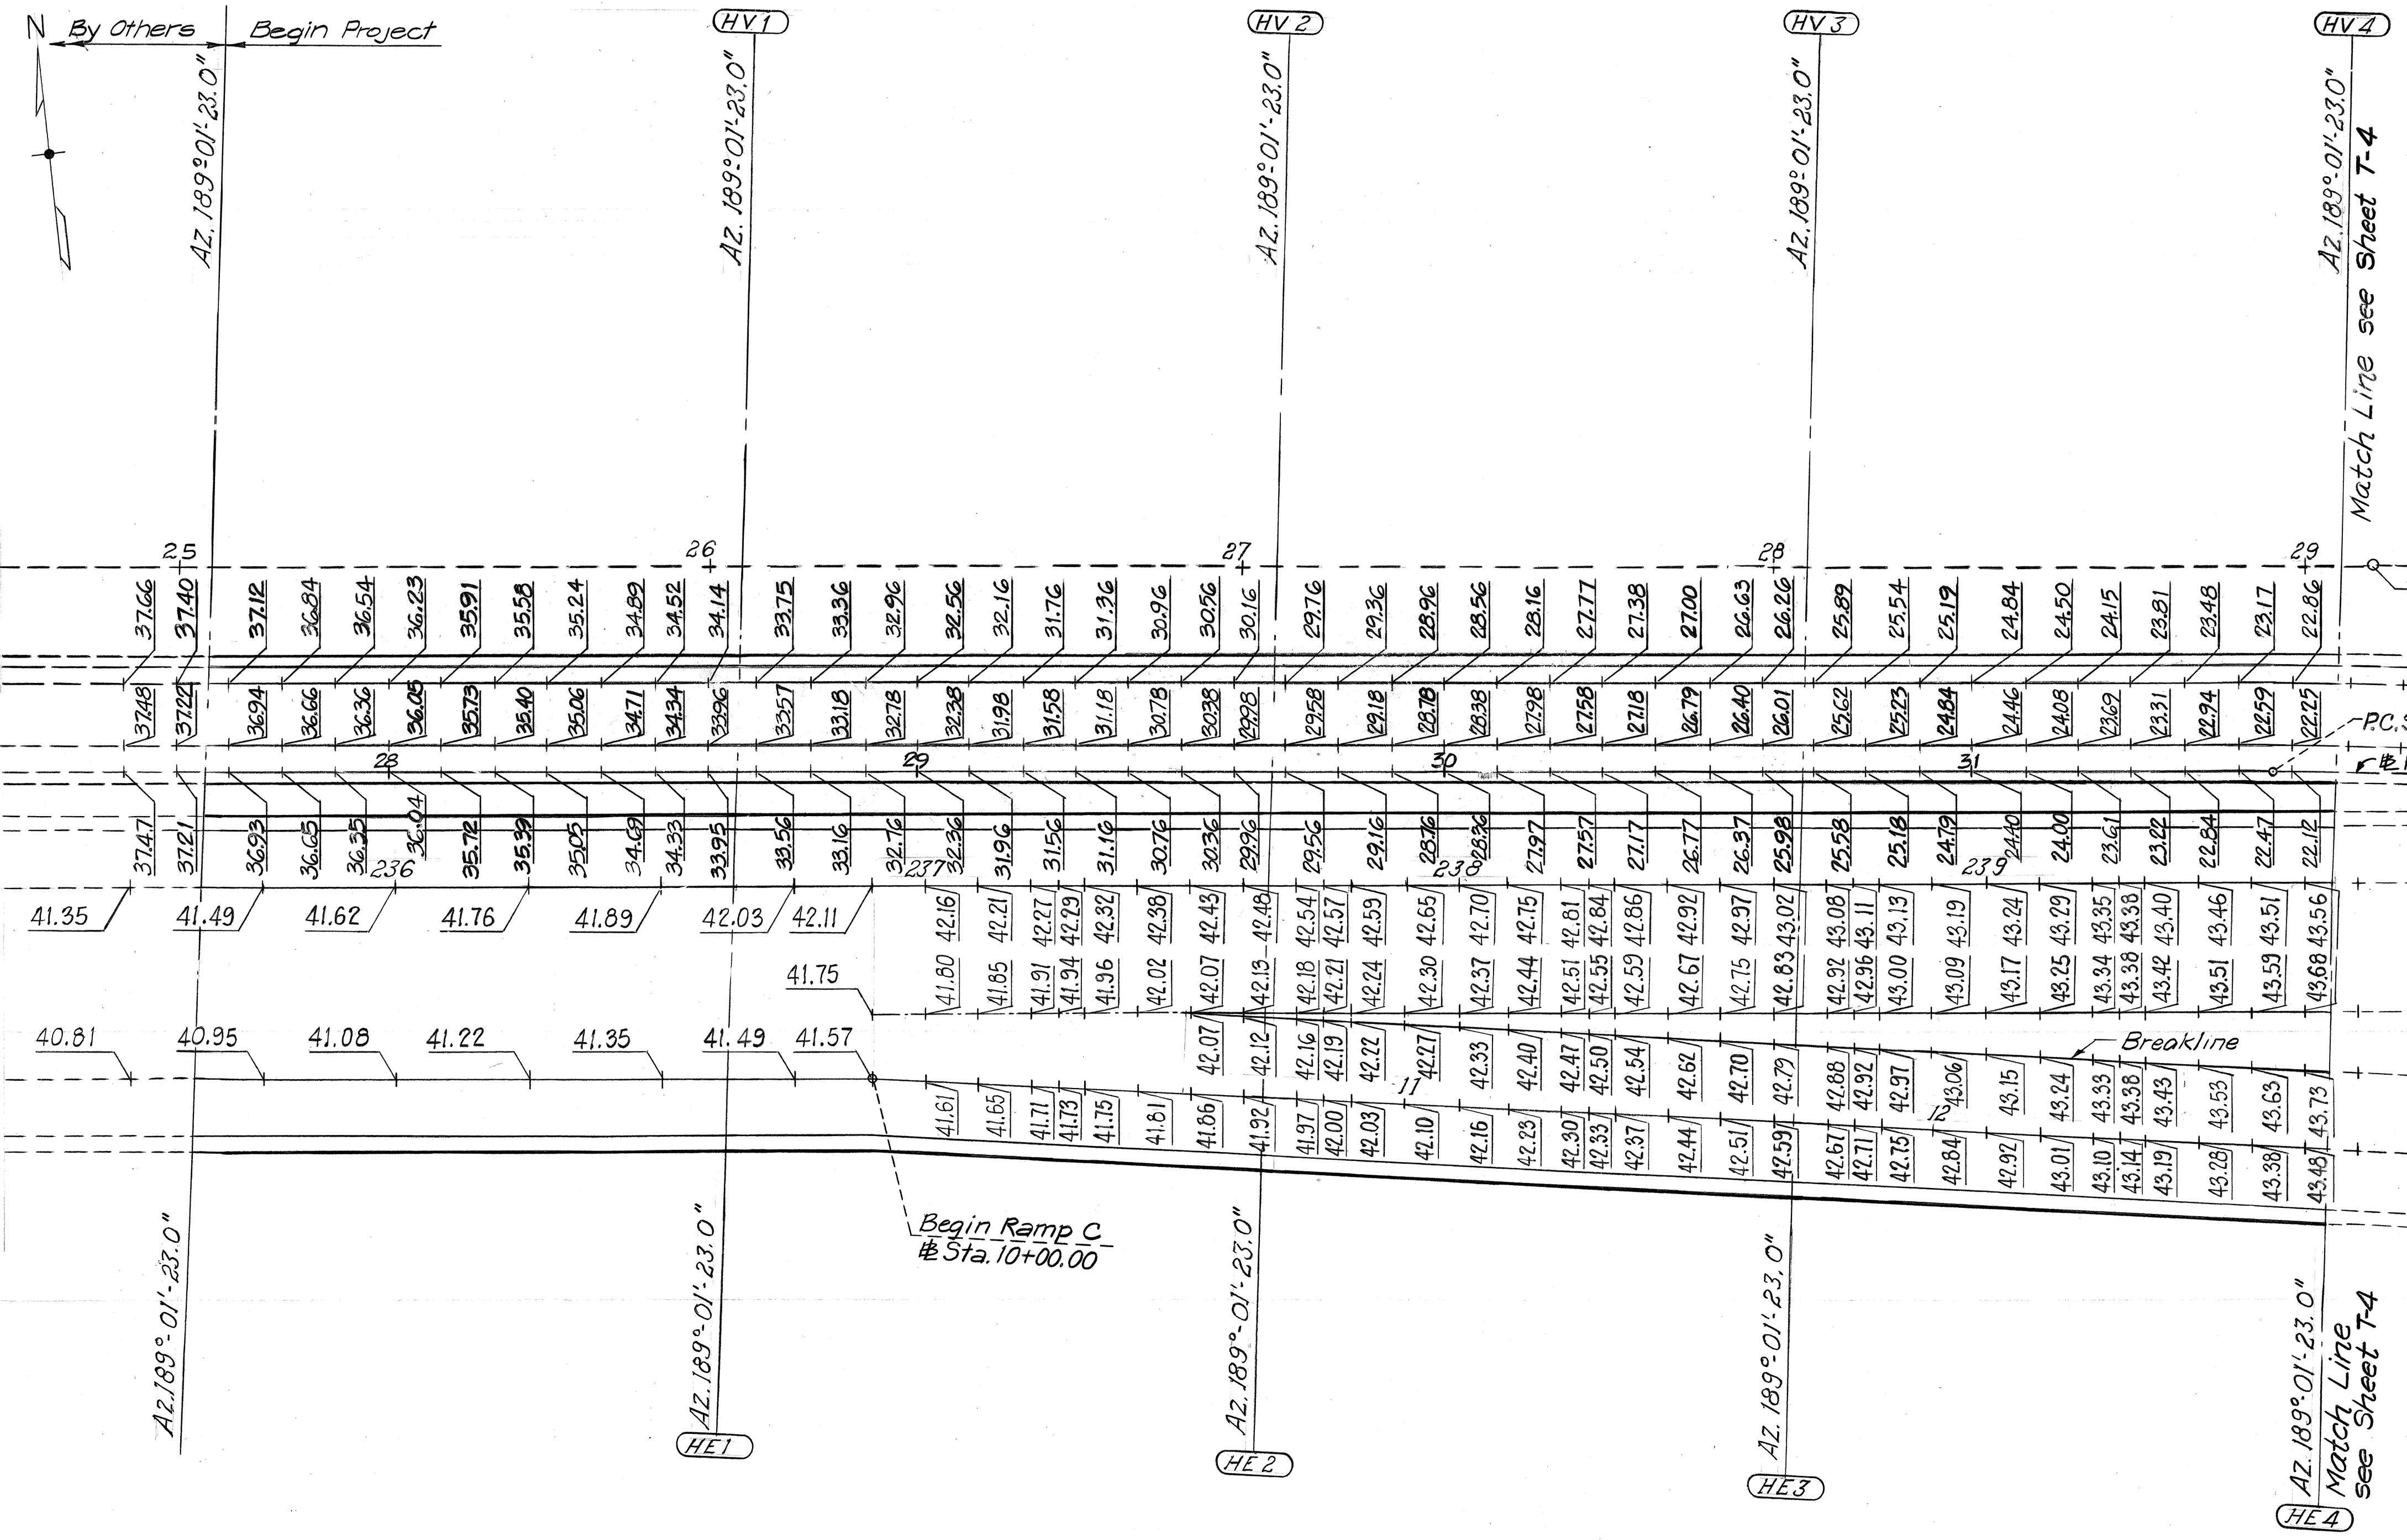

PLAN

ORIGINAL PLAN  
NOTE BOOK  
NO.

SURVEY PLOTTED BY  
DRAWN BY  
DESIGNED BY  
QUANTITIES BY  
CHECKED BY



DATE  
BY  
DATE  
BY  
DATE  
BY

*J. Johnson*

CREW/GILSTAD




| FED. ROAD DIST. NO. | STATE | FED. AID PROJ. NO. | FISCAL YEAR | SHEET NO. | TOTAL SHEETS |
|---------------------|-------|--------------------|-------------|-----------|--------------|
| HAWAII              | HAW.  | 1-HI-1(168)-17     | 1982        | 63        | 145          |

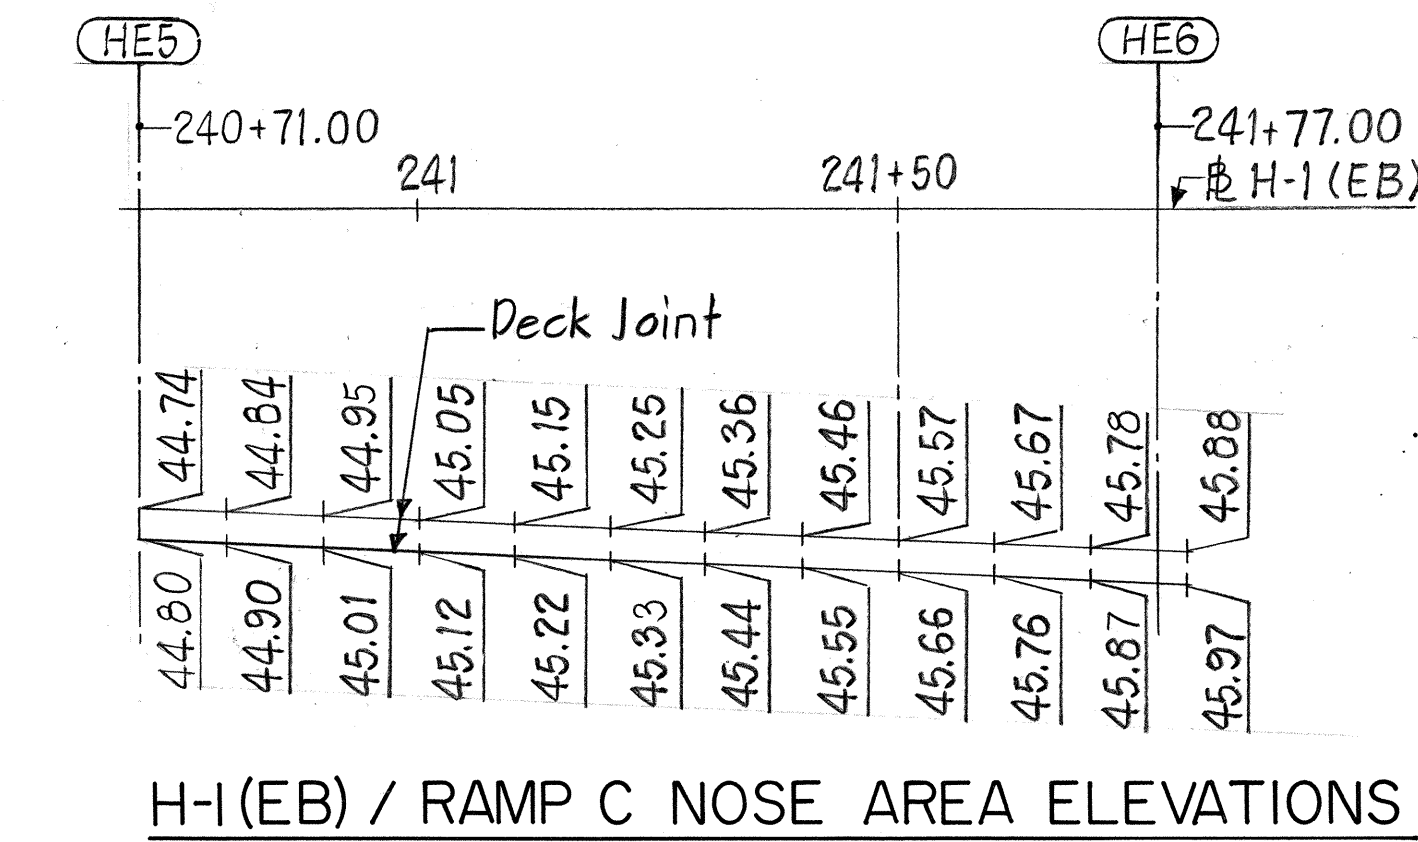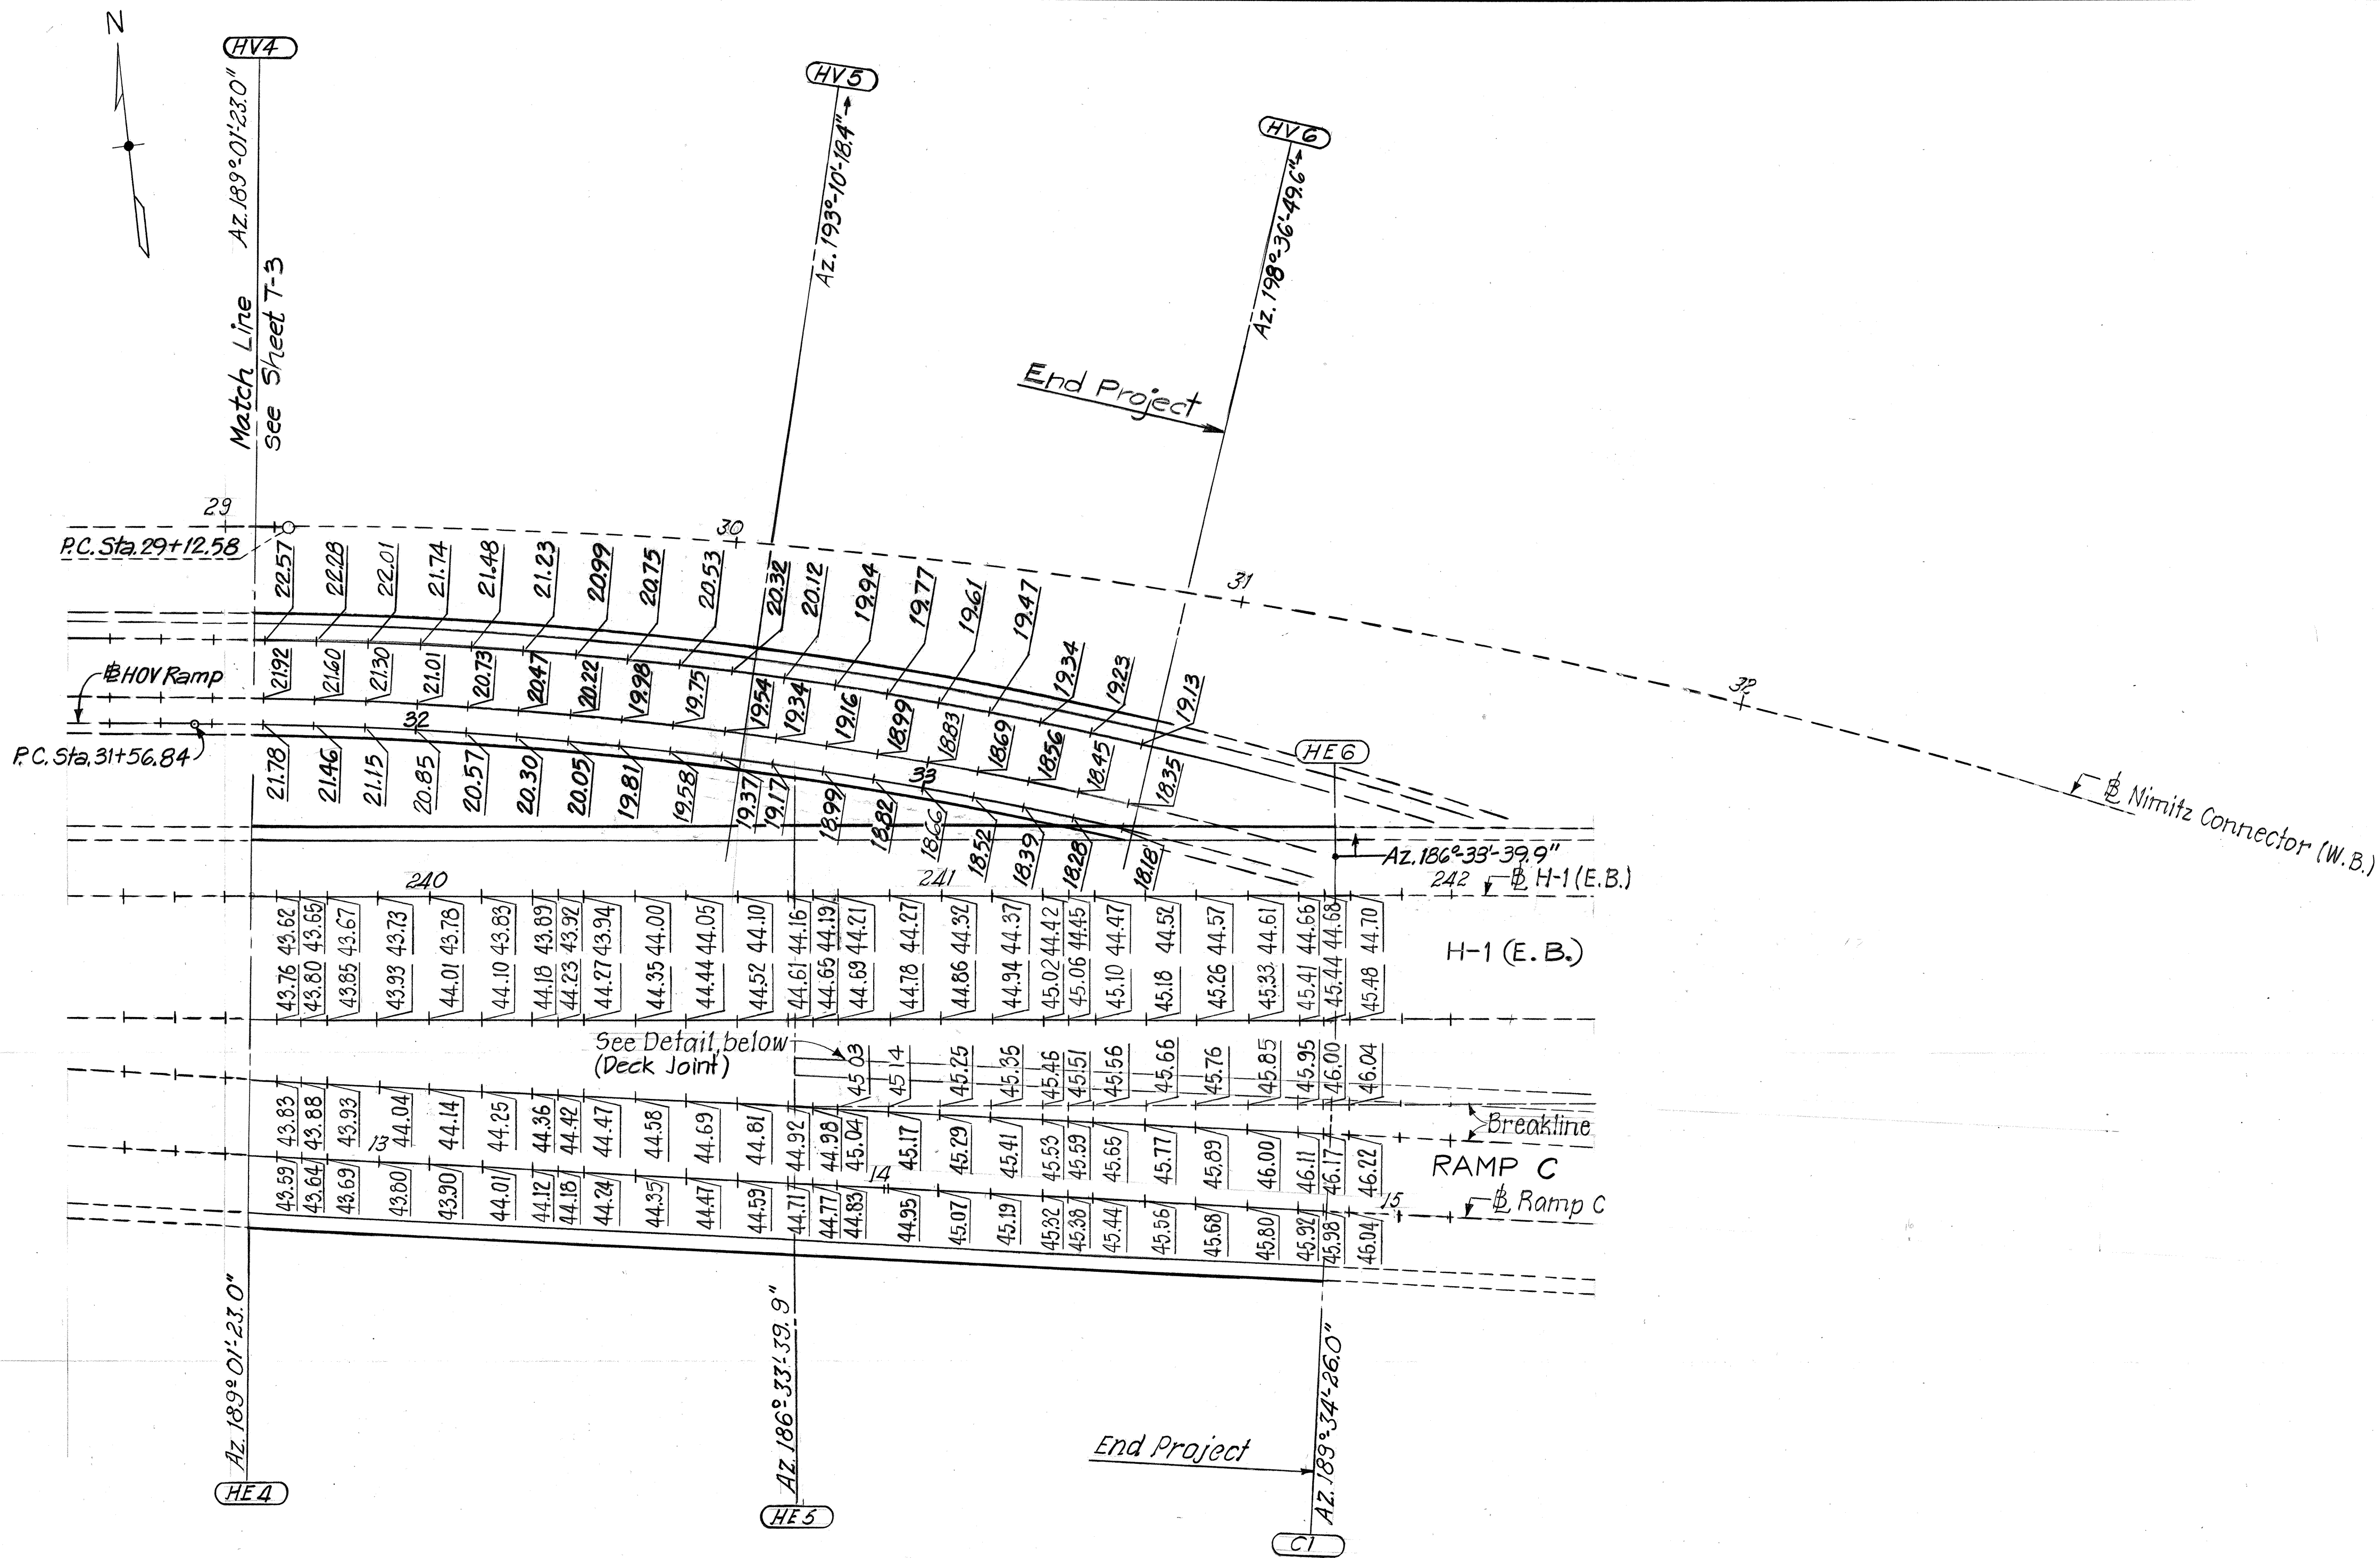

PLAN

NOTE:  
For Notes and HOV Ramp Deck Section  
see Sheet No. T-3.

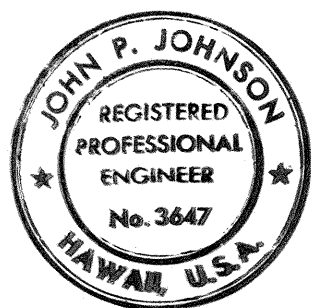

THIS WORK WAS PREPARED BY  
ME OR UNDER MY SUPERVISION.  
*John P. Johnson*

STATE OF HAWAII  
DEPARTMENT OF TRANSPORTATION  
HIGHWAYS DIVISION  
H-1 VIADUCT (E.B.), RAMP C & HOV RAMP  
  
DECK ELEVATIONS  
SHEET 2 OF 2  
  
KEEHI INTERCHANGE  
F.A.I. PROJ. NO. 1-HI-1 (168)-17  
SCALE: 1" = 20'-0" DATE: 8/17/81  
SHEET NO. T- 4 OF T-23 SHEETS

|                   |      |
|-------------------|------|
| SURVEY PLOTTED BY | DATE |
| DESIGNED BY       |      |
| TRACED BY         |      |
| QUANTITIES BY     |      |
| CHECKED BY        |      |
| NO.               |      |






| FED. ROAD DIST. NO. | STATE | FED. AID PROJ. NO. | FISCAL YEAR | SHEET NO. | TOTAL SHEETS |
|---------------------|-------|--------------------|-------------|-----------|--------------|
| HAWAII              | HAW.  | 1-HI-1(168)-17     | 1982        | 64        | 145          |

# LEGEND

- (+) Precast, Prestressed Concrete Piles, 16 1/2" octagonal, Type A.  
Design Capacity See Sheet No. SD-1.  
(For Details see Shs. No. SD-10 thru SD-12)
- PCE: Pile Cut-off Elevation.
- PTE: Estimated Pile Tip Elev.
- BCE: Elevation of Lower Limit of Bitumen coating.


## NOTES:

- For Table of Pile Load Test (By Others) and Applicable Footings, see Sheet SD-11.
- Work this drawing with sheet No. T-6.
- Contractor shall verify location of Existing Utilities before excavation starts.
- For Excavation payment limits, see sheet No. T-9.
- Use Outfall Type 2 for piers HE4 and HE5. The Invert Elevations of Outfall are +6.50. See Outfall Detail F/SD-9 with the exception of omitting 5'x5'x6" crushed rock pad.
- See Tables on Sheet T-6 for Type of Footing, Thickness of Footing and Number of Piles.

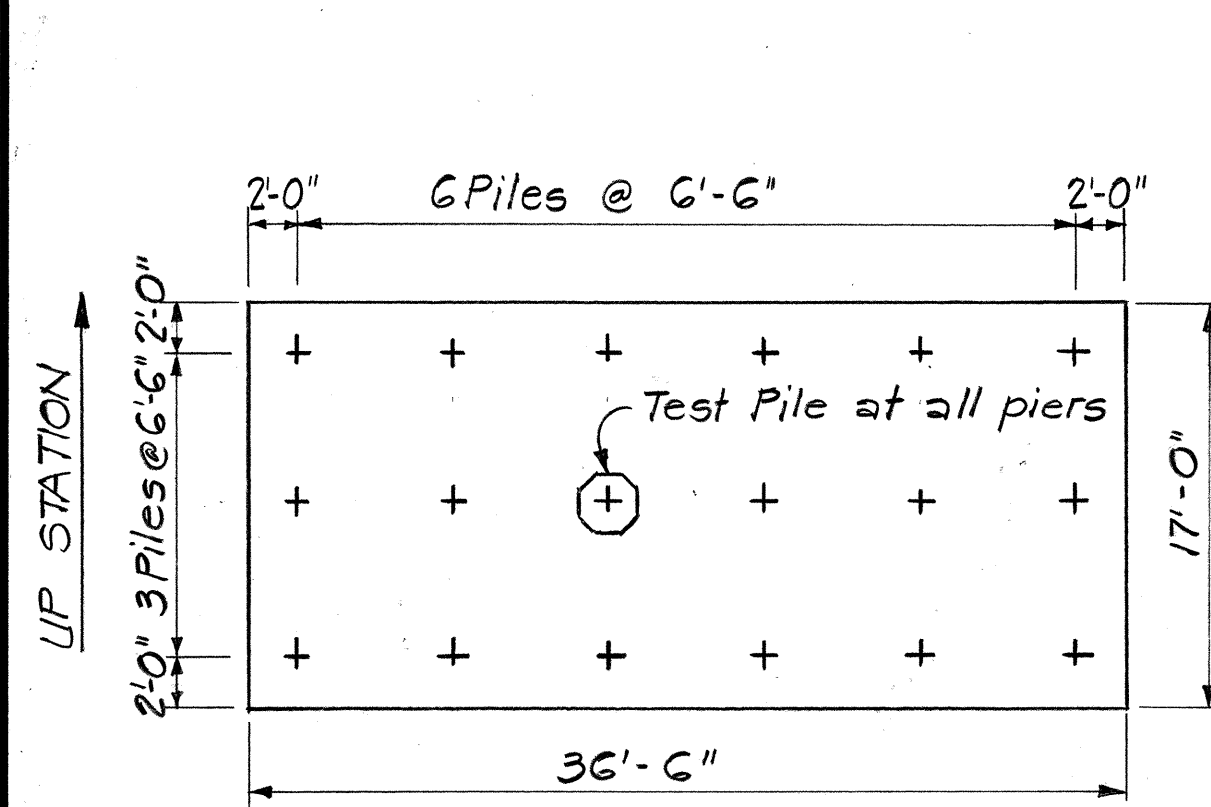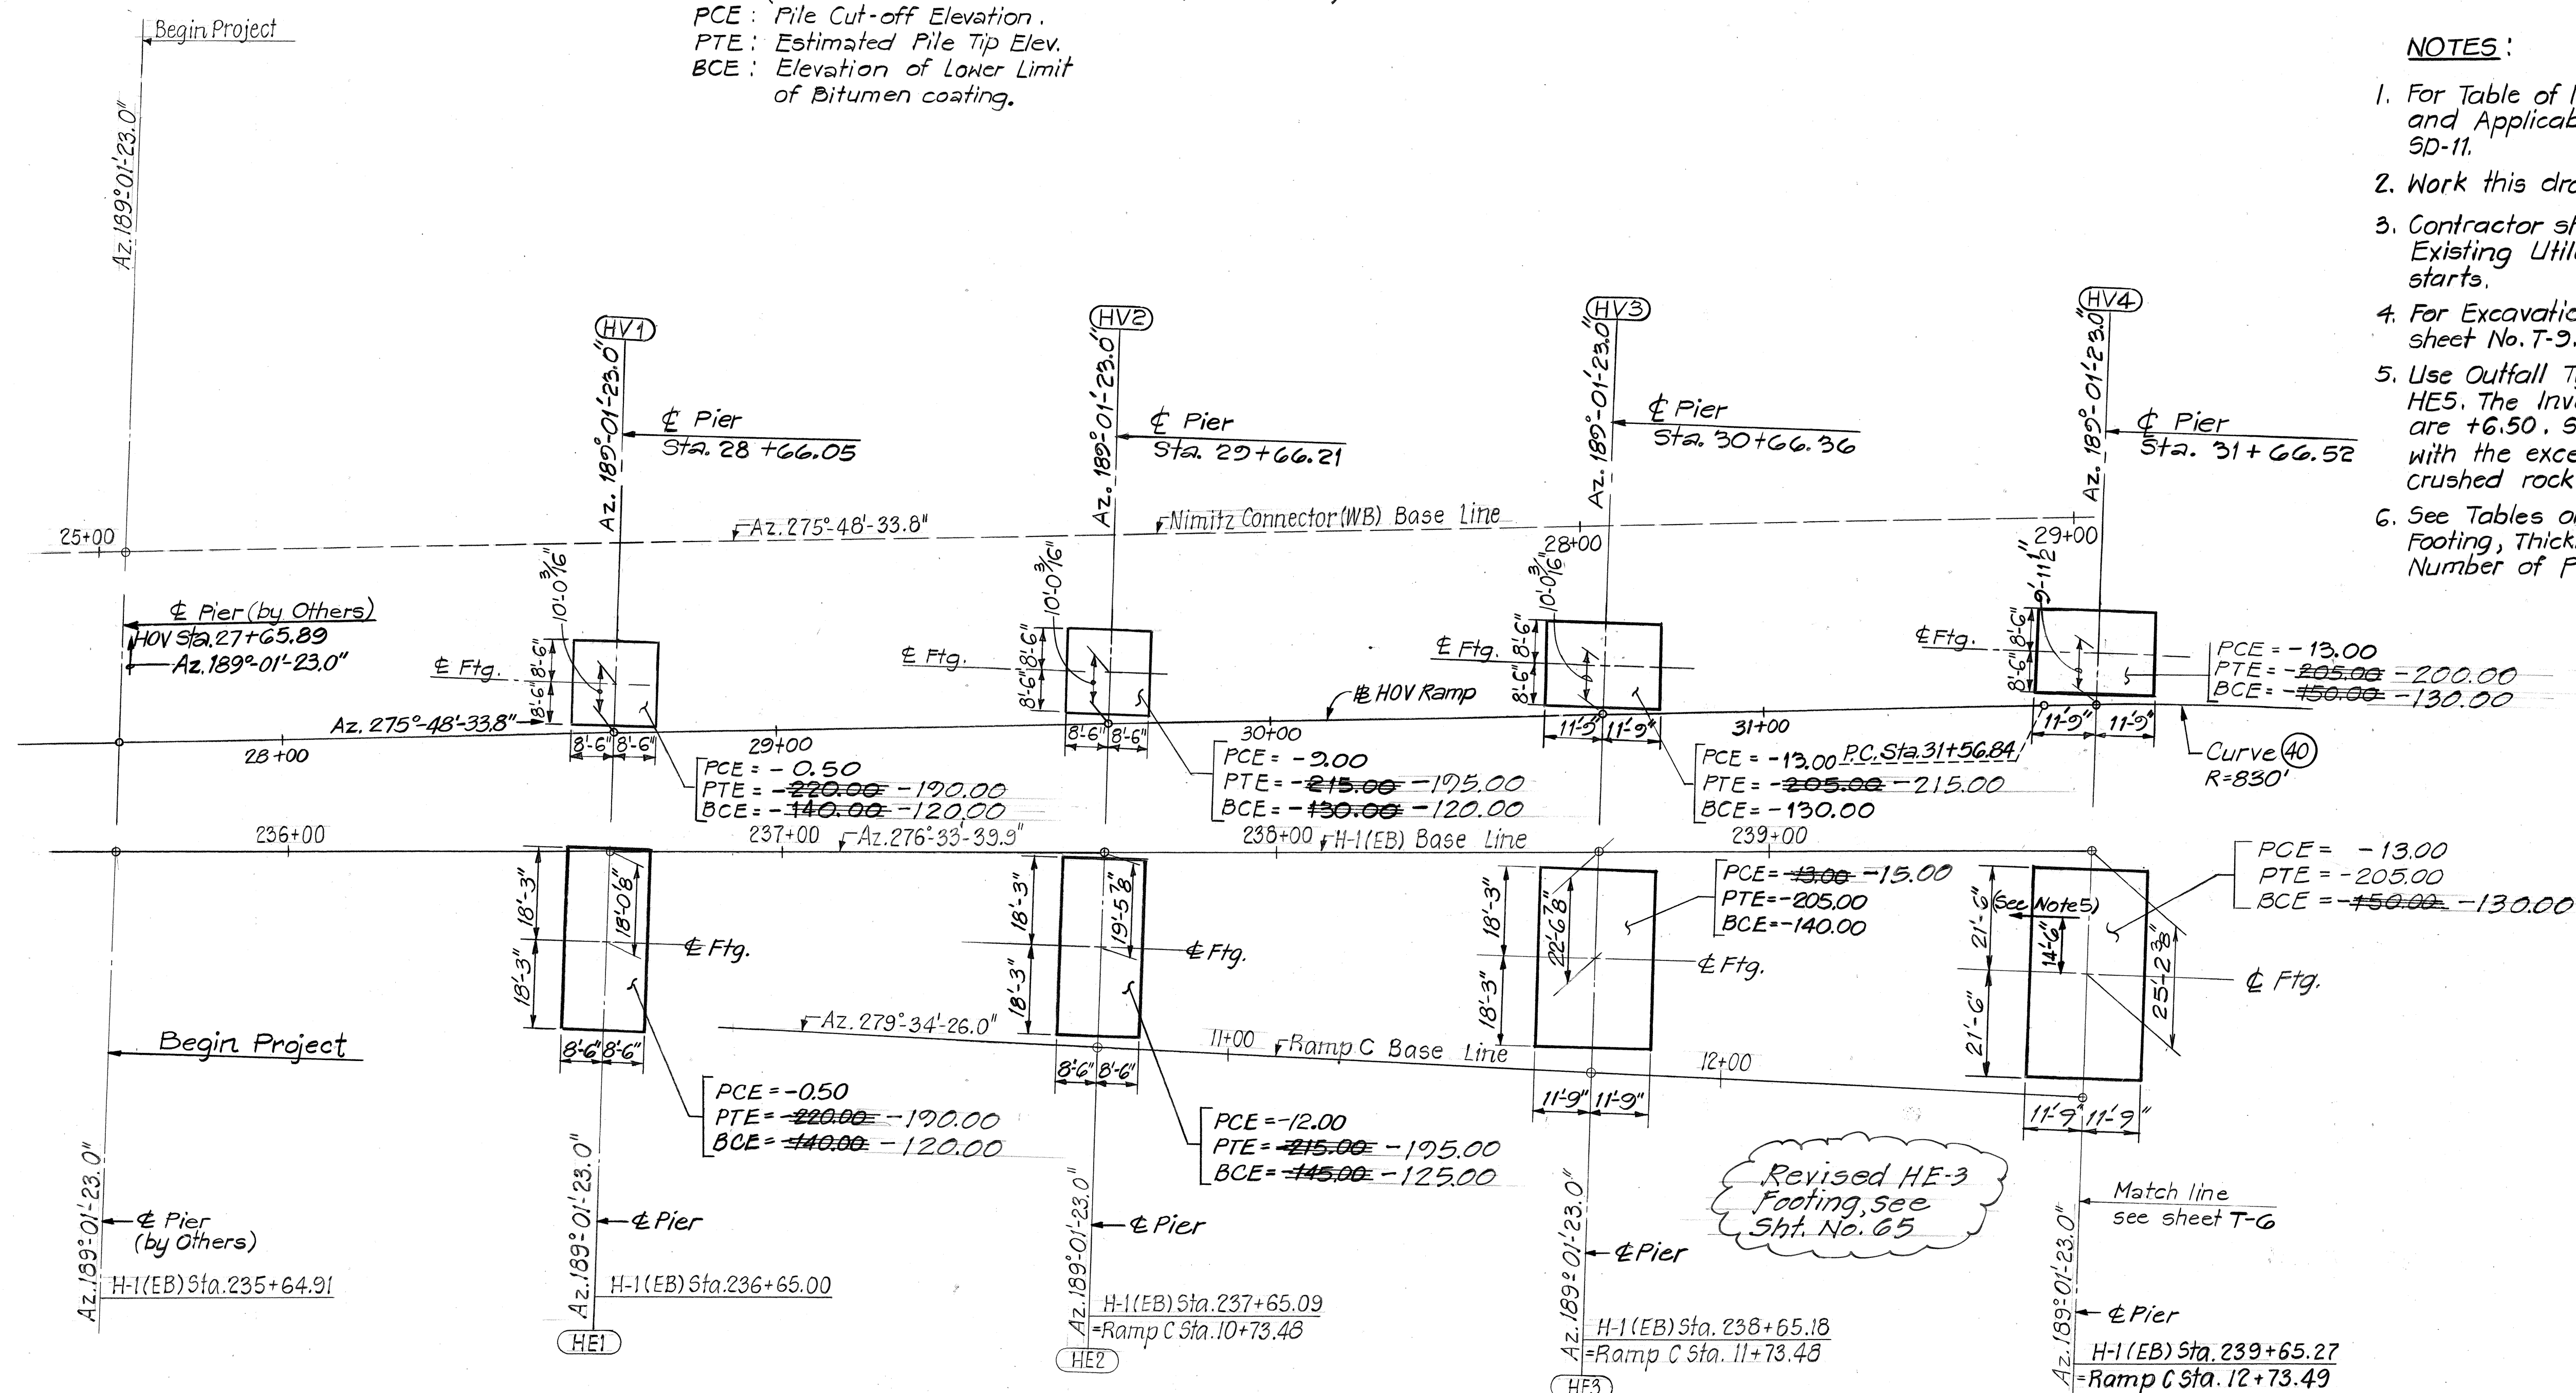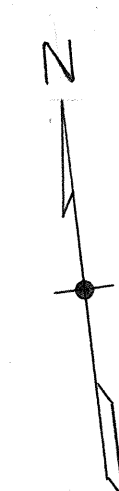


TYPE A


PILE PLAN TYPES (See Table on Sheet T-6)  
N.T.S.

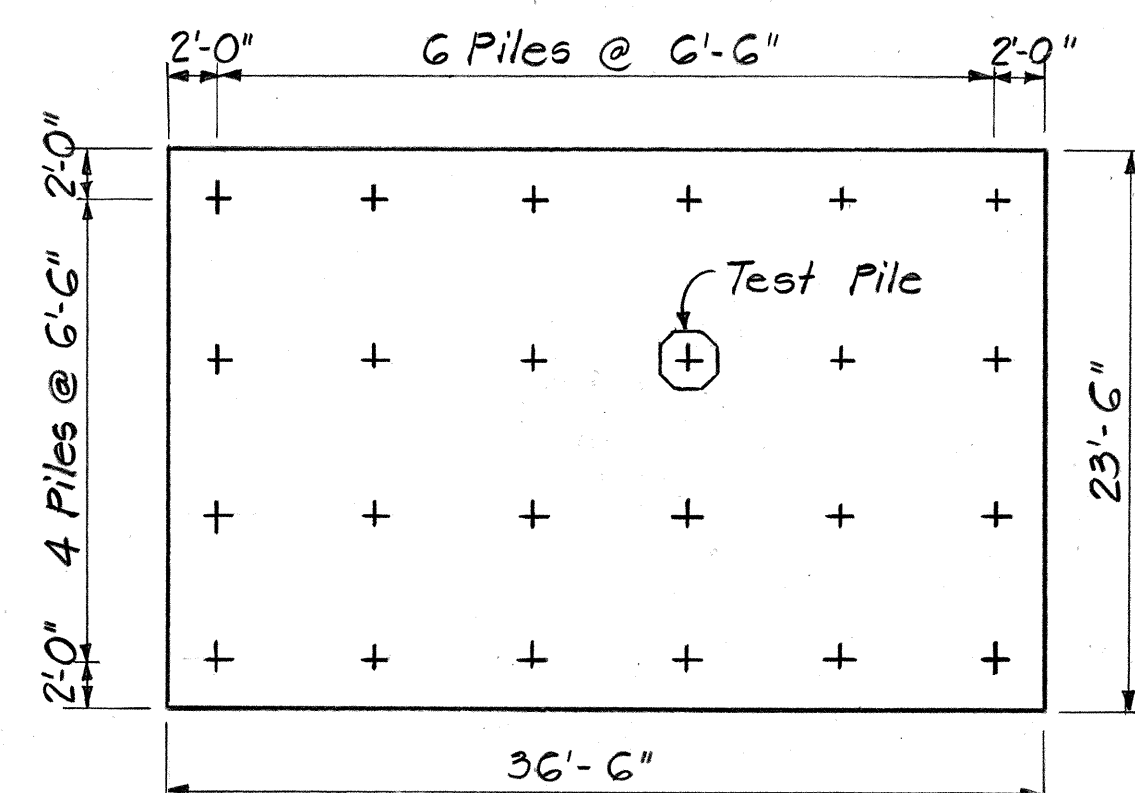

TYPE B

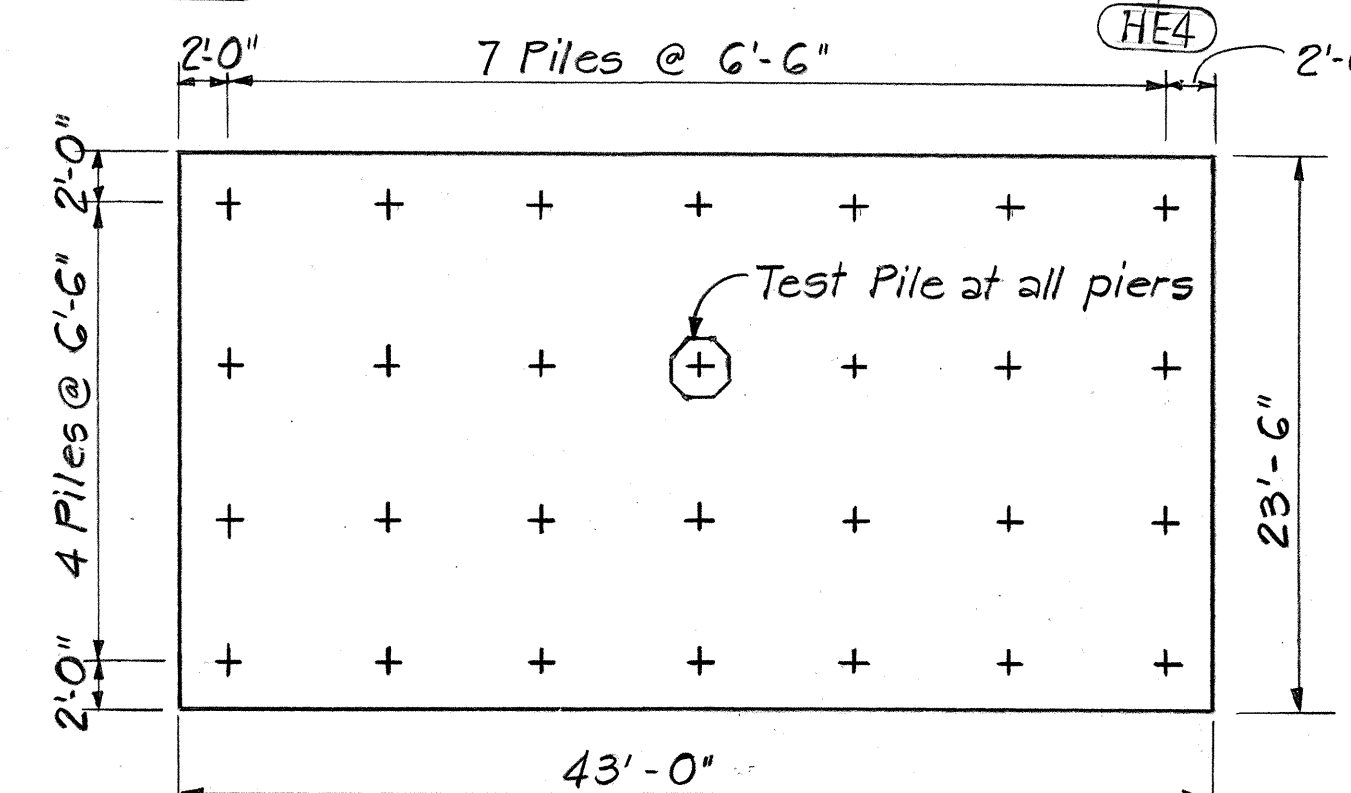

TYPE C

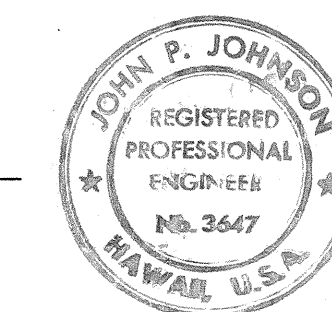

THIS WORK WAS PREPARED BY  
ME OR UNDER MY SUPERVISION.  
John P. Johnson


STATE OF HAWAII  
DEPARTMENT OF TRANSPORTATION  
HIGHWAYS DIVISION  
H-1 VIADUCT (E.B.), RAMP C & HOV RAMP

**FOOTING LOCATION PLAN**  
SHEET 1 OF 2


KEEHI INTERCHANGE  
F.A.I. PROJ. NO. 1-HI-1(168)-17  
SCALE: 1"=20'-0" DATE: 8/17/81

SHEET NO. T-5 OF T-23 SHEETS



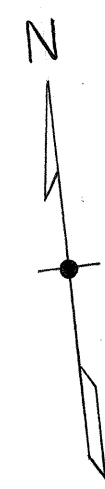

This tracing/detail prepared during "As-Built" posting

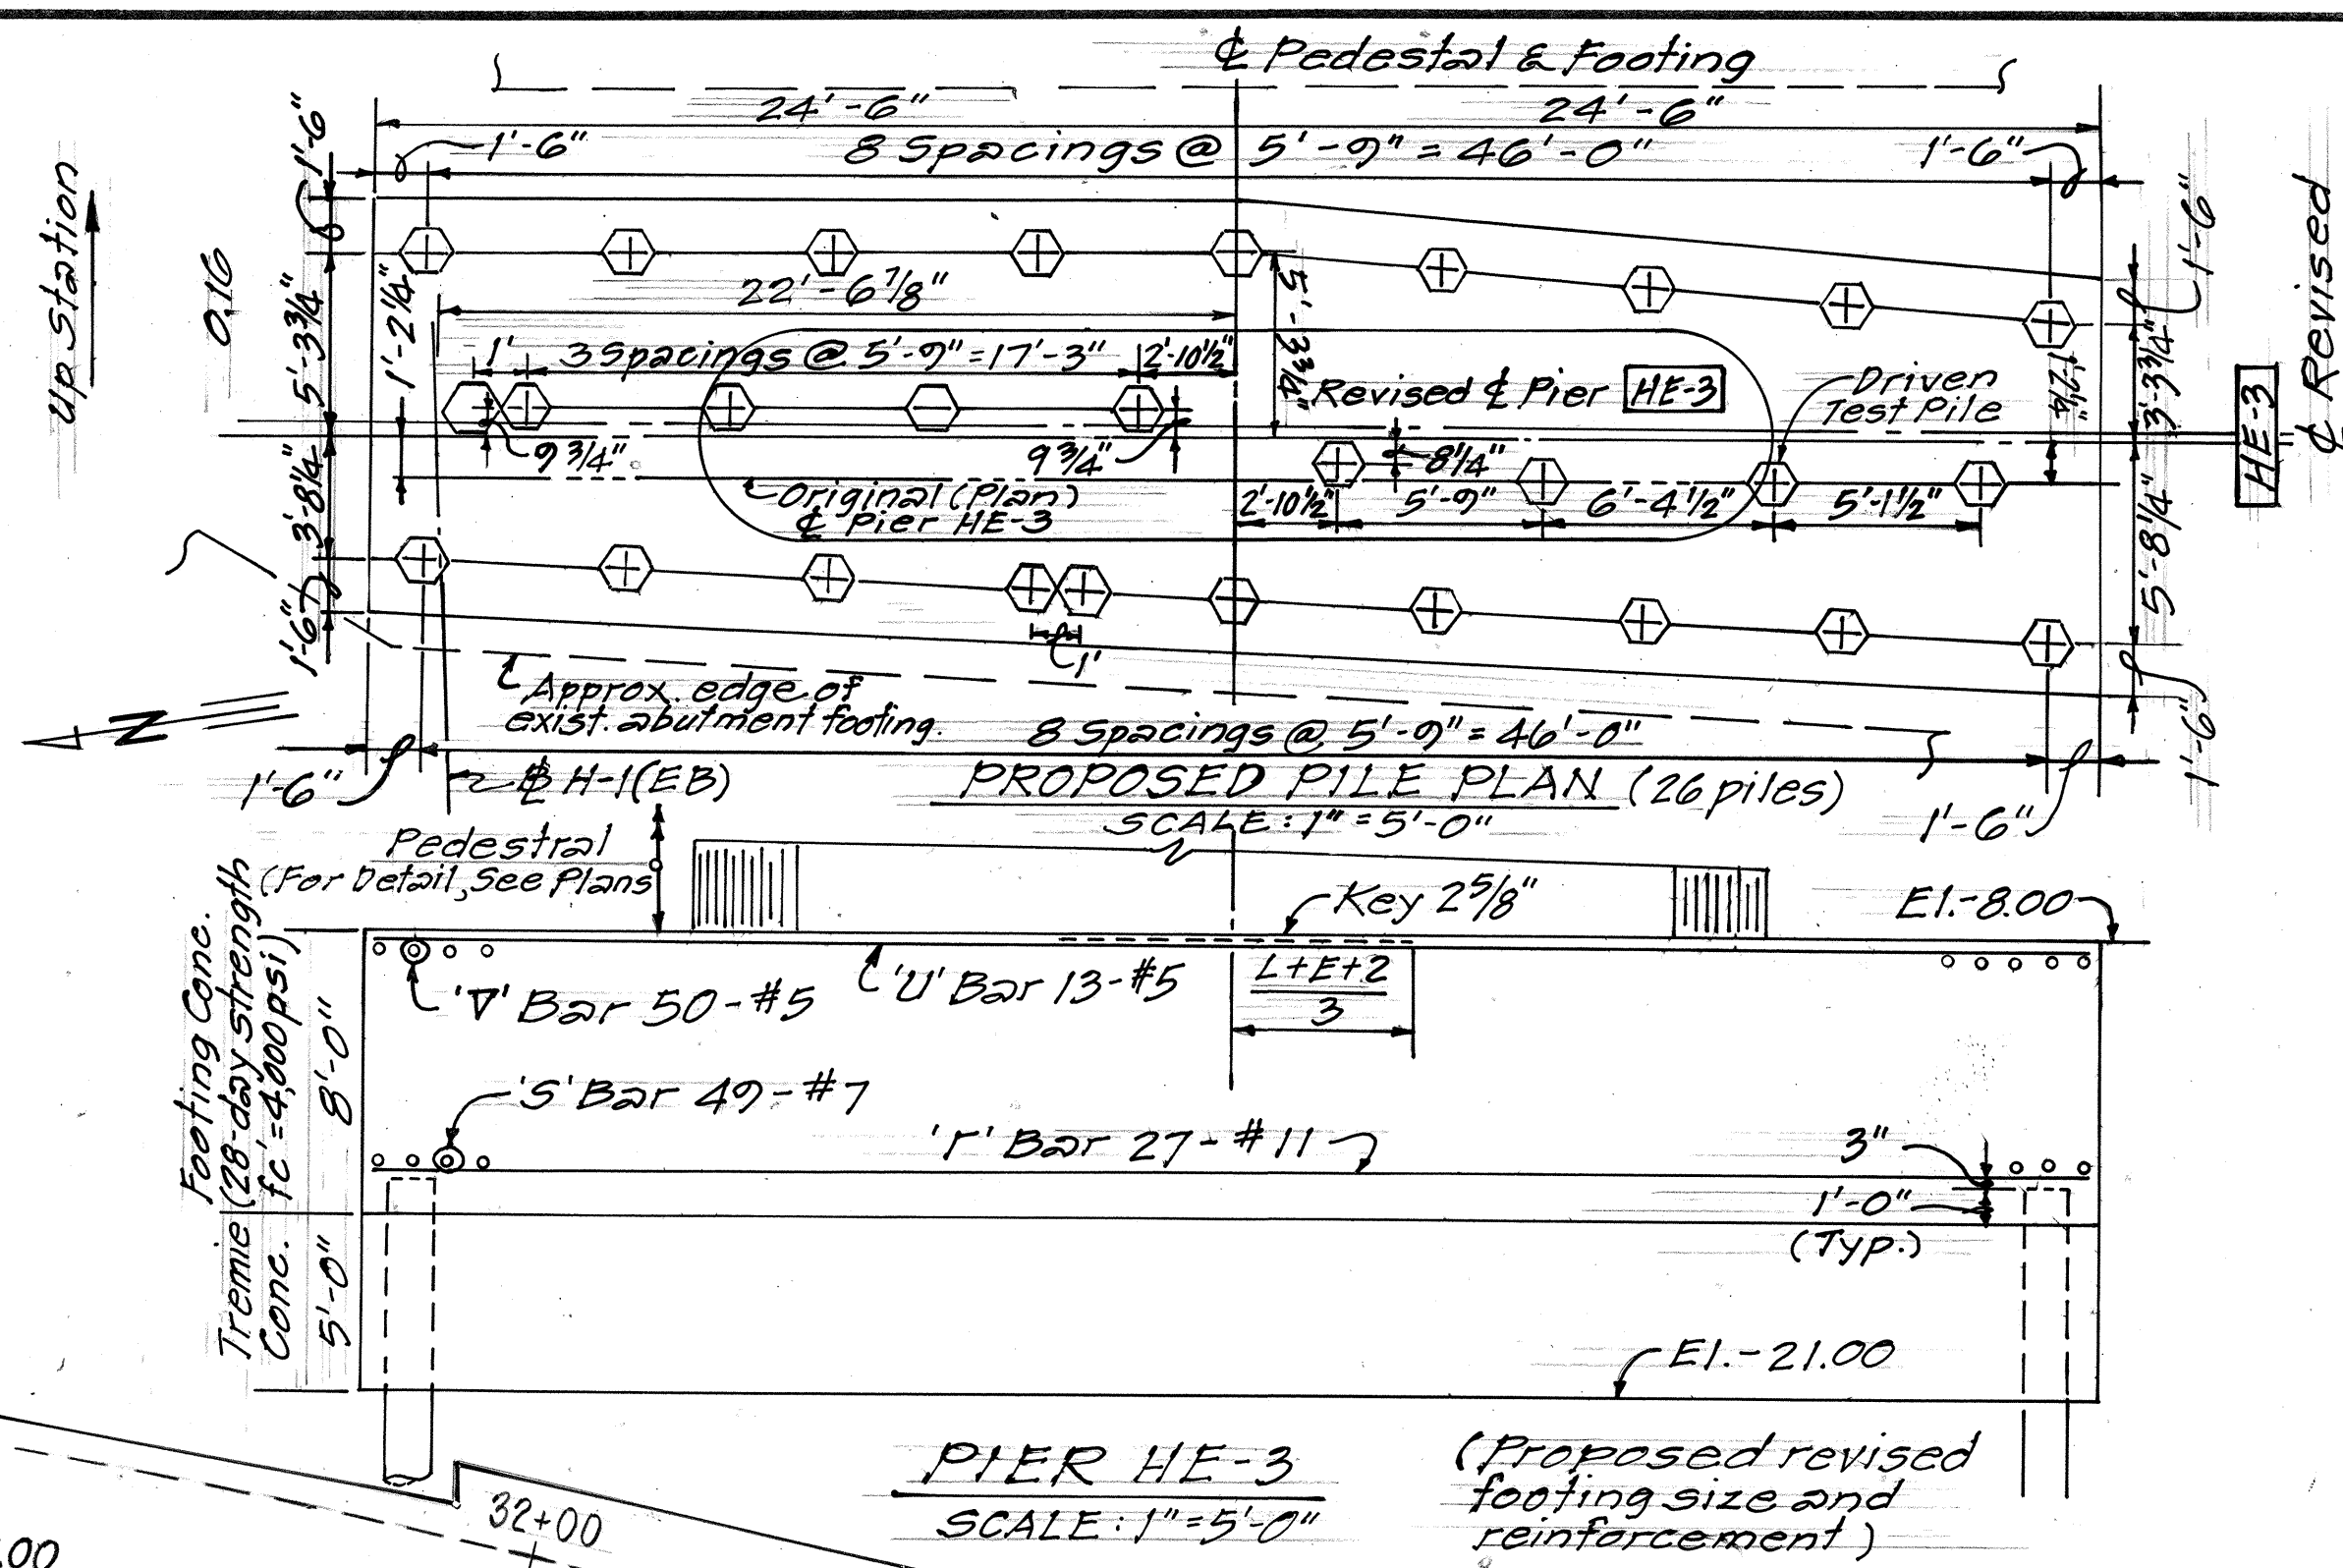



| FED. ROAD DIST. NO. | STATE | FED. AID PROJ. NO. | FISCAL YEAR | SHEET NO. | TOTAL SHEETS |
|---------------------|-------|--------------------|-------------|-----------|--------------|
| HAWAII              | HAW.  | 1-HI-1(168):17     | 1982        | 65        | 145          |

| PIER TYPE I & OTHER |               |                      |              |
|---------------------|---------------|----------------------|--------------|
| PIER                | FOOTING TYPES | THICKNESS OF FOOTING | NO. OF PILES |
| HV1                 | E             | 5'-0"                | 9            |
|                     |               |                      |              |
|                     |               |                      |              |
| PIER TYPE II |               |                      |              |
|--------------|---------------|----------------------|--------------|
| PIER         | FOOTING TYPES | THICKNESS OF FOOTING | NO. OF PILES |
| HE1          | A             | 5'-6"                | 18           |
|              |               |                      |              |
|              |               |                      |              |
| PIER TYPE III |               |                      |              |
|---------------|---------------|----------------------|--------------|
|               | FOOTING TYPES | THICKNESS OF FOOTING | NO. OF PILES |
| HE2           | A             | 6'-0"                | 18           |
| HE3           | B             | 5'-0"                | 24           |
| HE4, HE5      | C             | 5'-0"                | 28           |
| HV3THRU HV5   | D             | 5'-0"                | 12           |
| HV2           | E             | 5'-6"                | 9            |

- NOTES:
1. Work this drawing with sheet No. T-5.
  2. For Legend & Notes see sheet No. T-5.

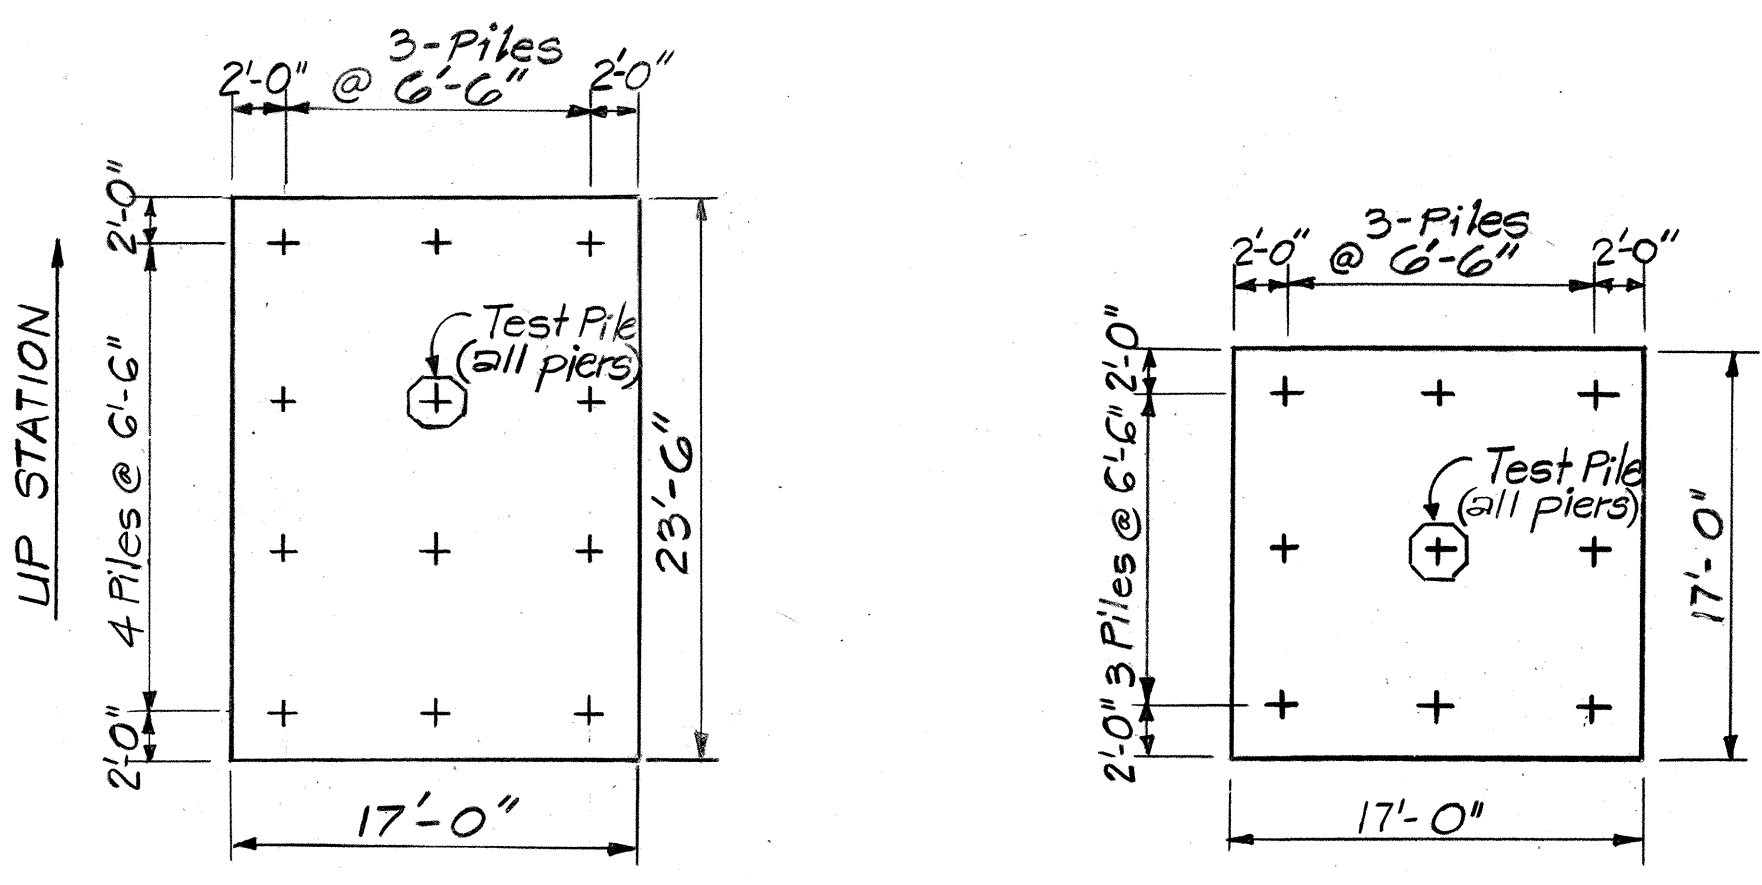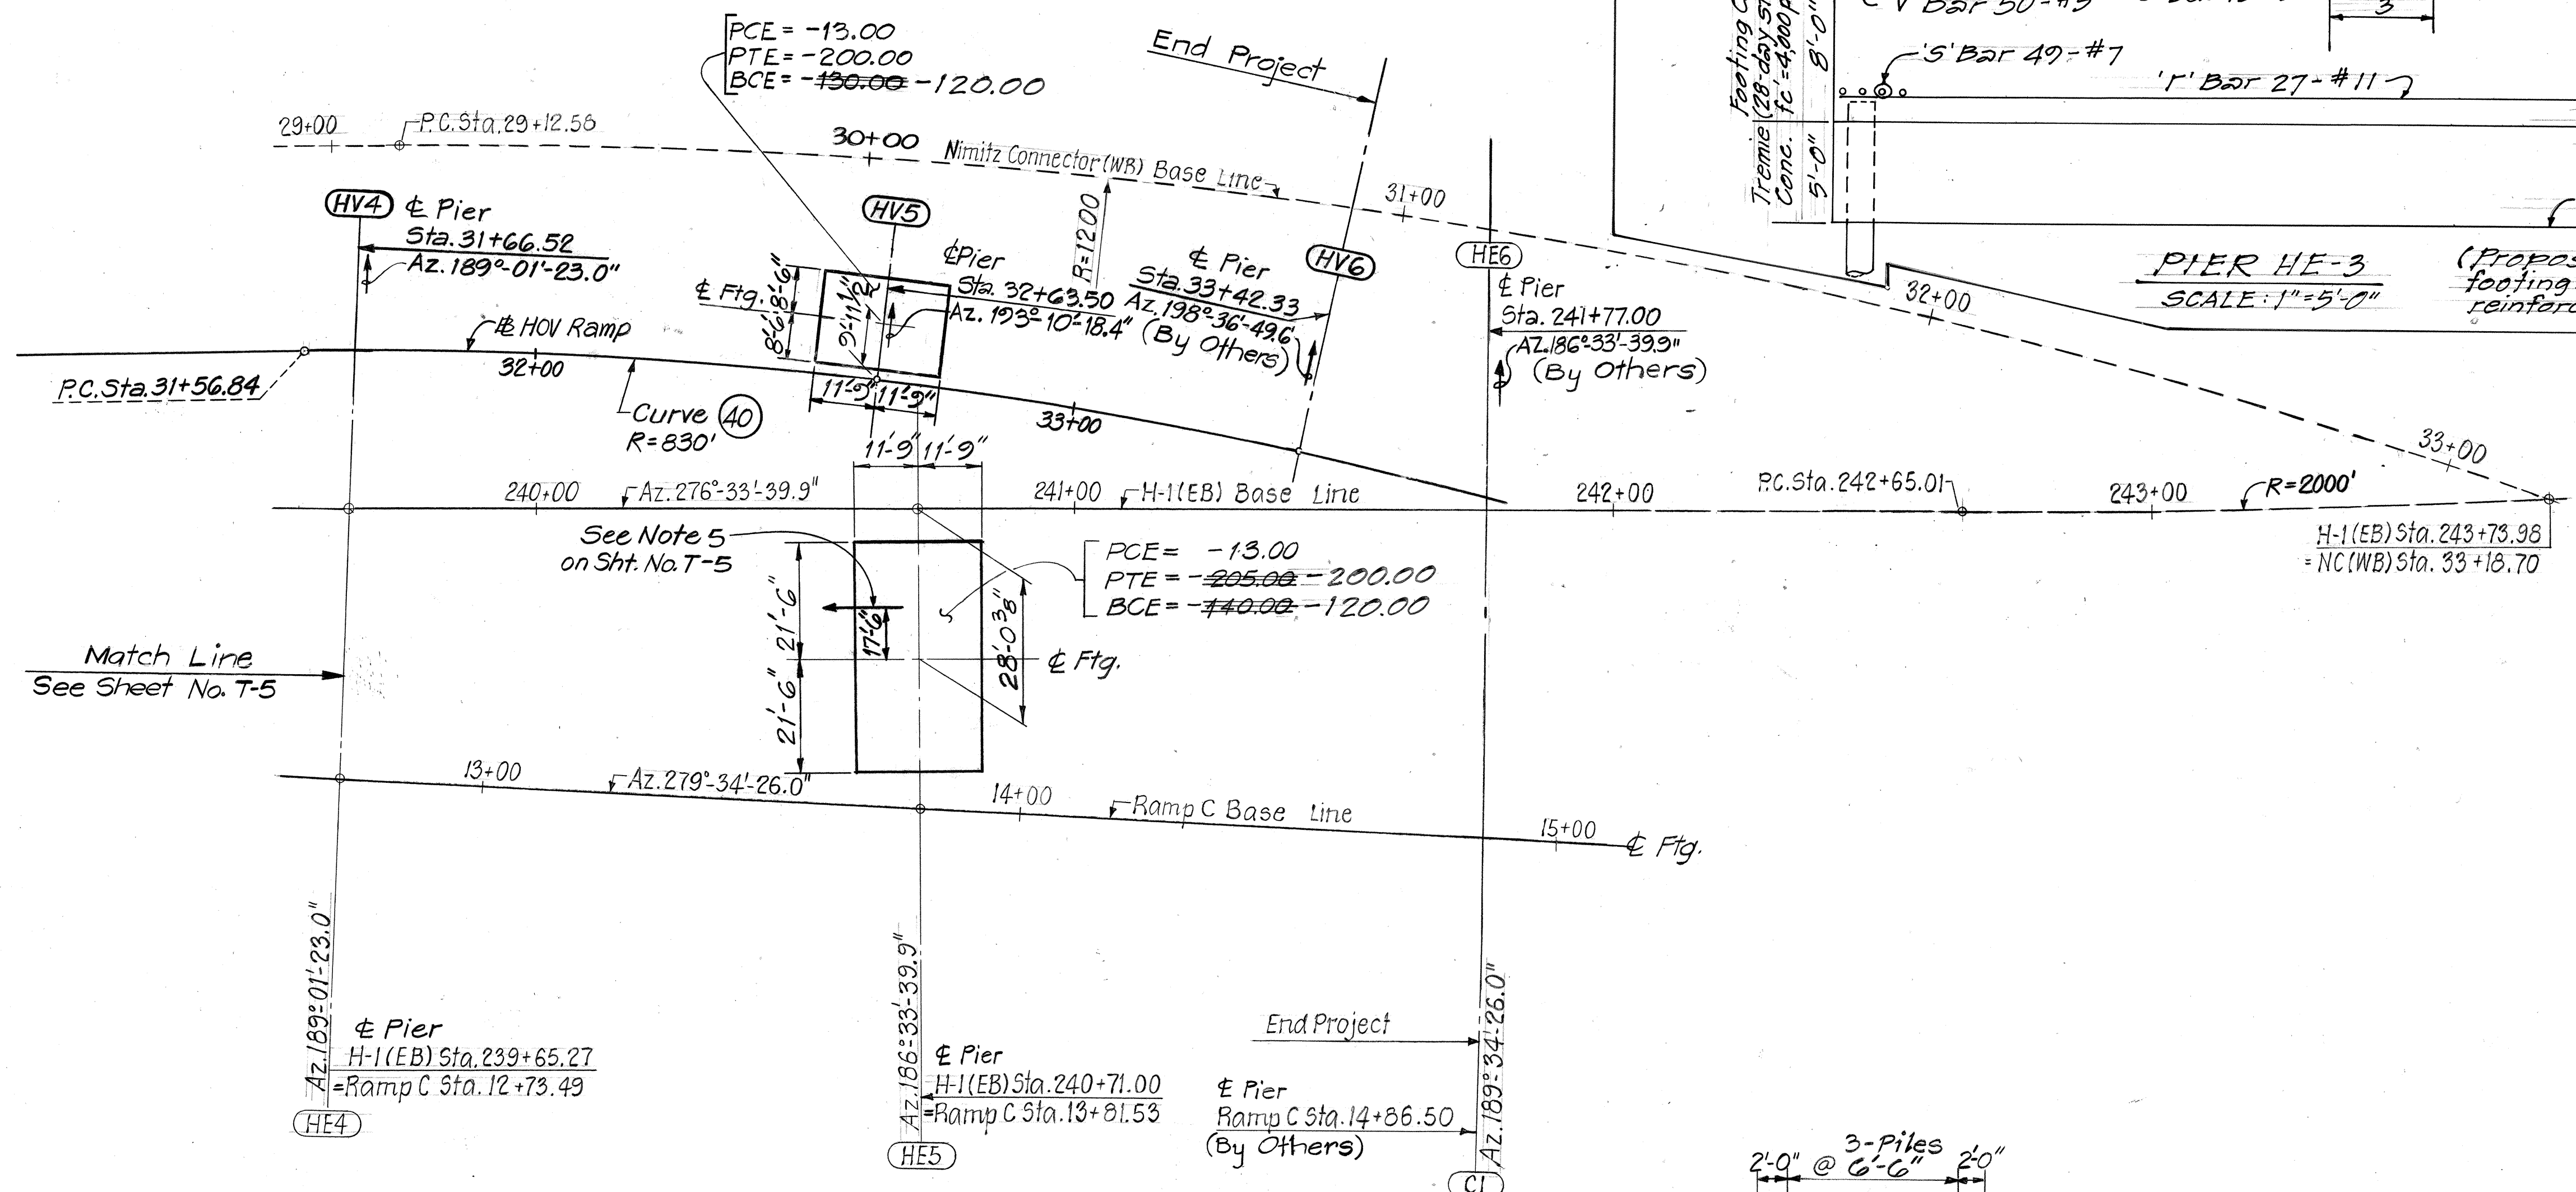

PILE PLAN TYPES (See Table Above)

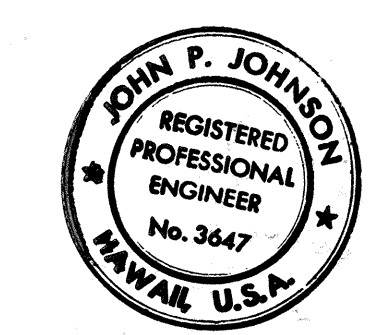

THIS WORK WAS PREPARED BY ME OR UNDER MY SUPERVISION.  
John P. Johnson

STATE OF HAWAII  
DEPARTMENT OF TRANSPORTATION  
HIGHWAYS DIVISION  
H-1 VIADUCT (E.B.), RAMP C & HOV RAMP

FOOTING LOCATION PLAN  
SHEET 2 OF 2


KEEHI INTERCHANGE  
F.A.I. PROJ. NO. 1-HI-1(168):17  
SCALE: 1"=20'-0"      DATE: 8/17/81

SHEET NO. T-6 OF T-23 SHEETS


|                   |      |
|-------------------|------|
| SURVEY PLOTTED BY | DATE |
| DRAWN BY          |      |
| DESIGNED BY       |      |
| CHECKED BY        |      |
| NO.               |      |









| FED. ROAD DIST. NO. | STATE | FED. AID PROJ. NO. | FISCAL YEAR | SHEET NO. | TOTAL SHEETS |
|---------------------|-------|--------------------|-------------|-----------|--------------|
| HAWAII              | HAW.  | J-HI-1(168)17      | 1982        | 66        | 145          |

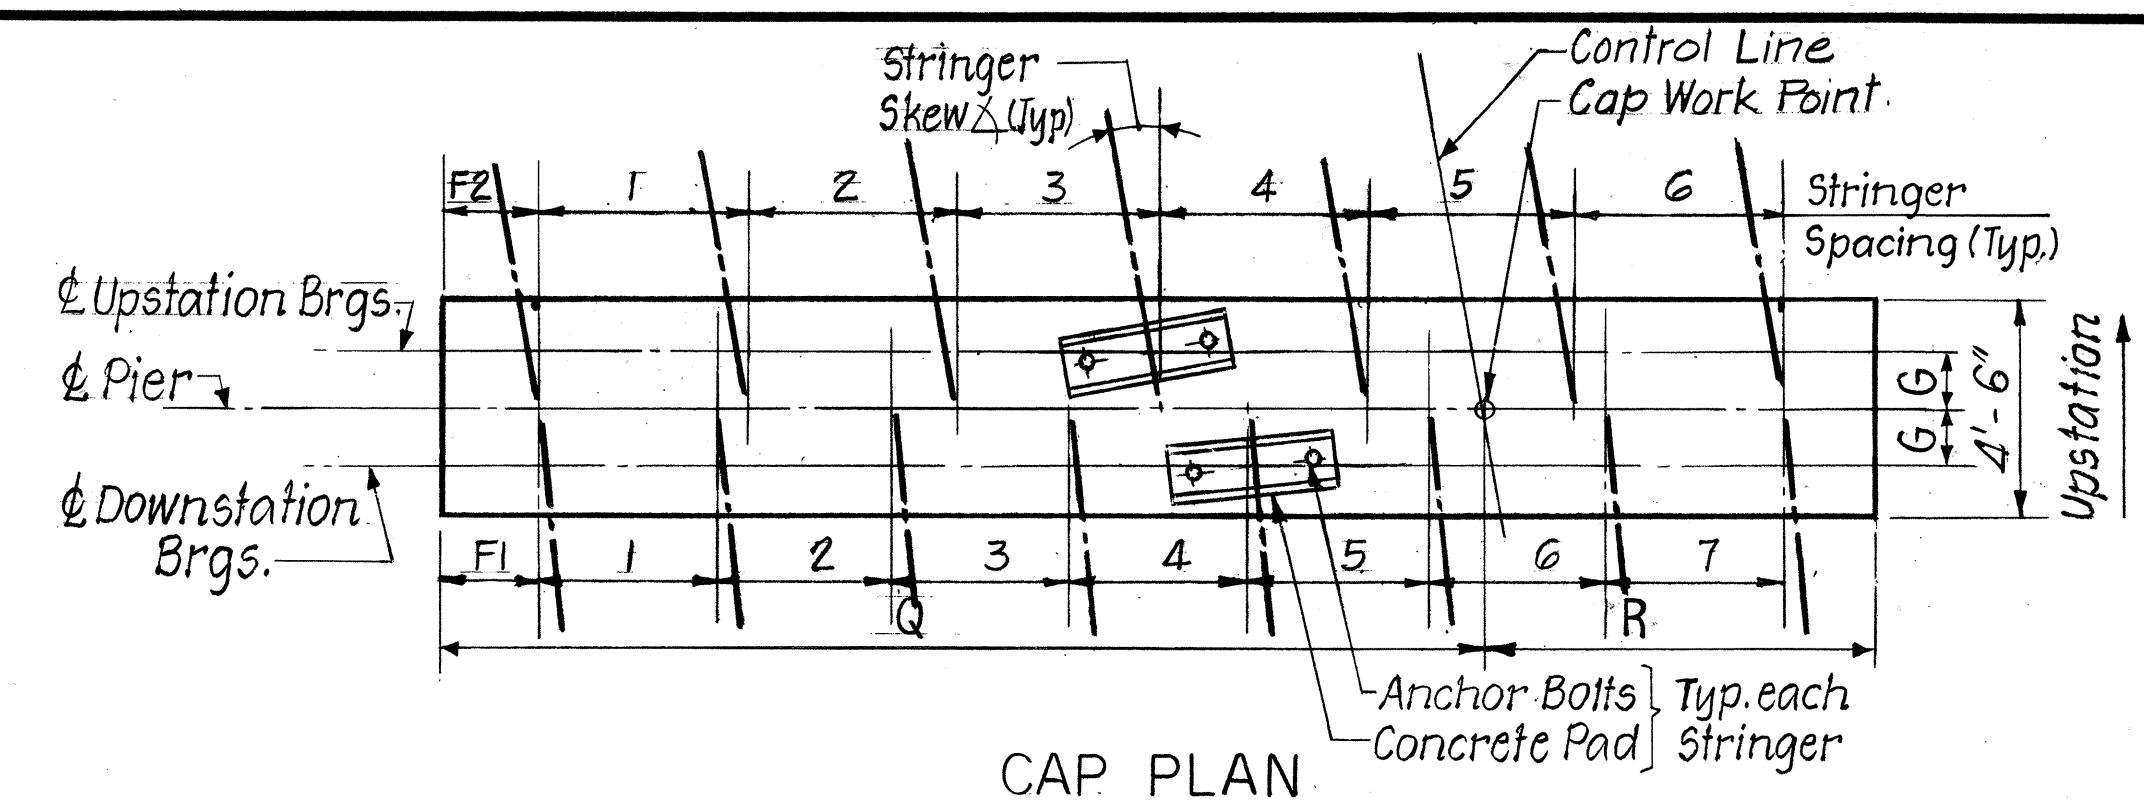





CAP PLAN

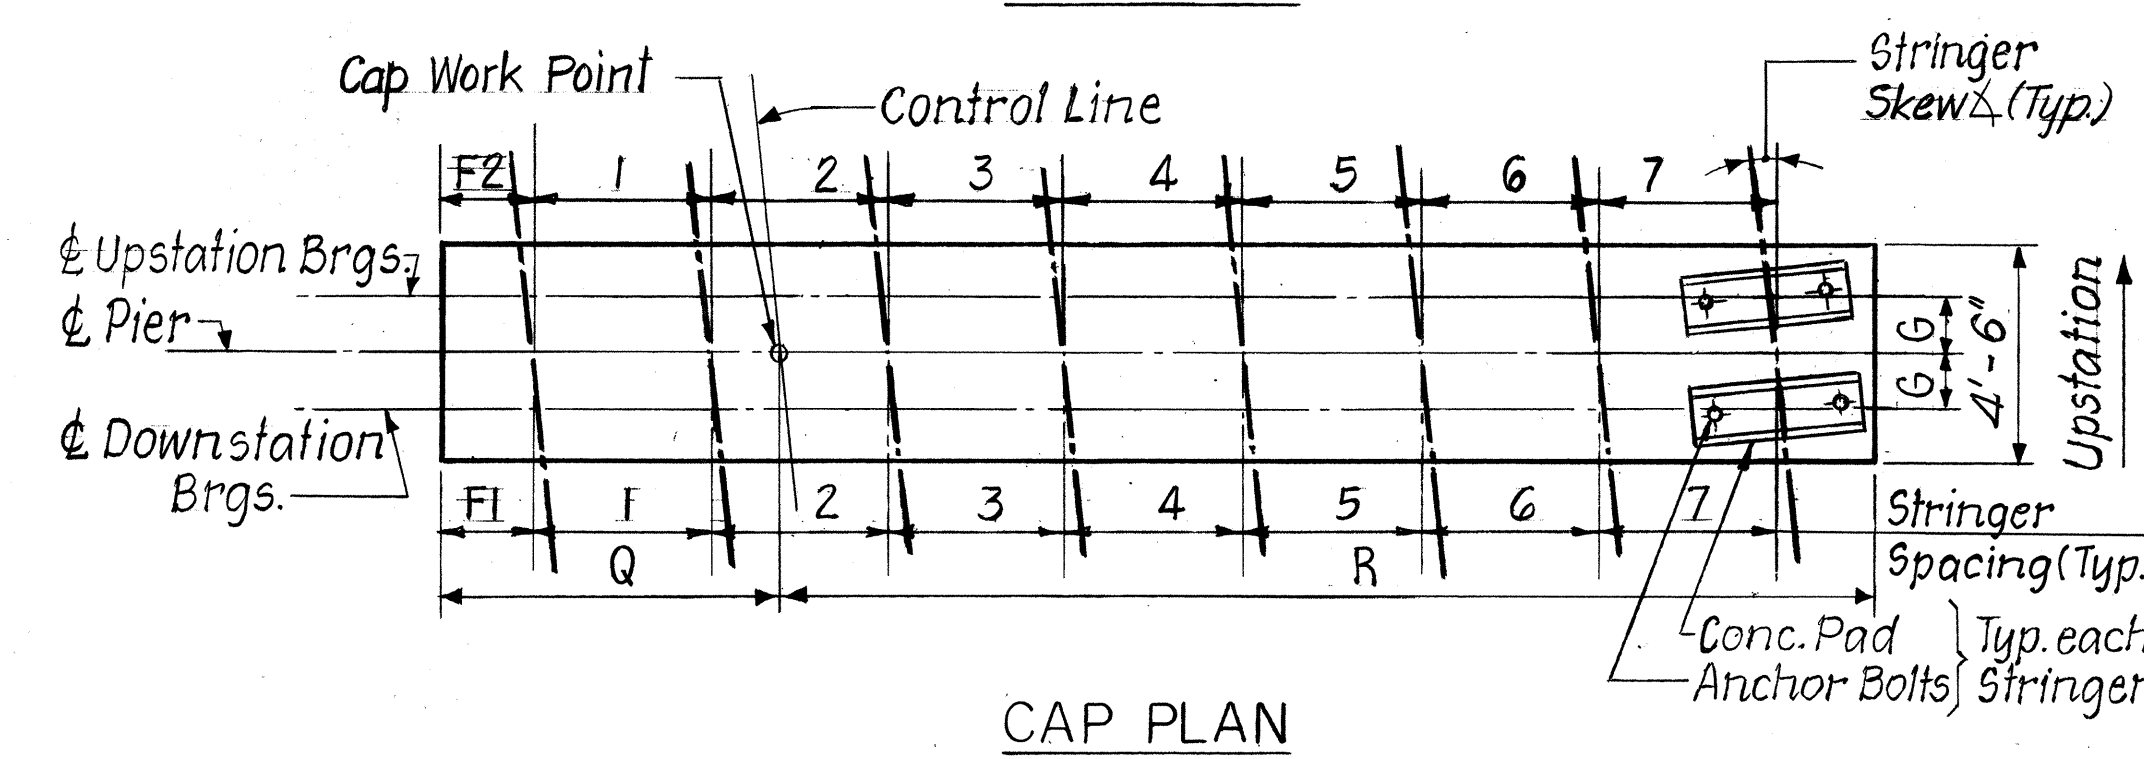

CAP PLAN

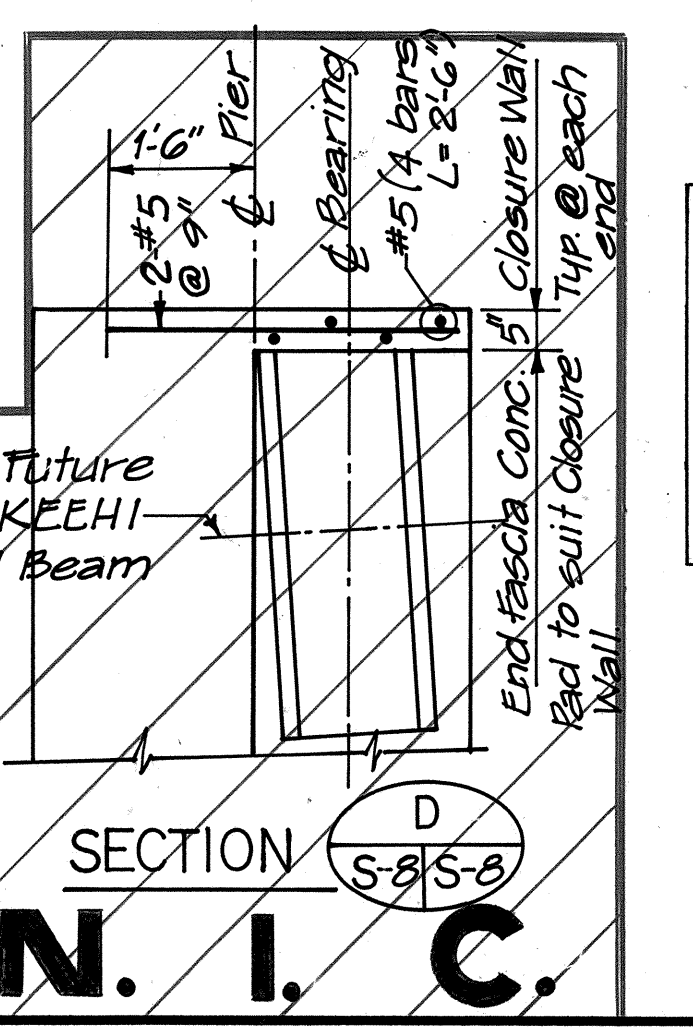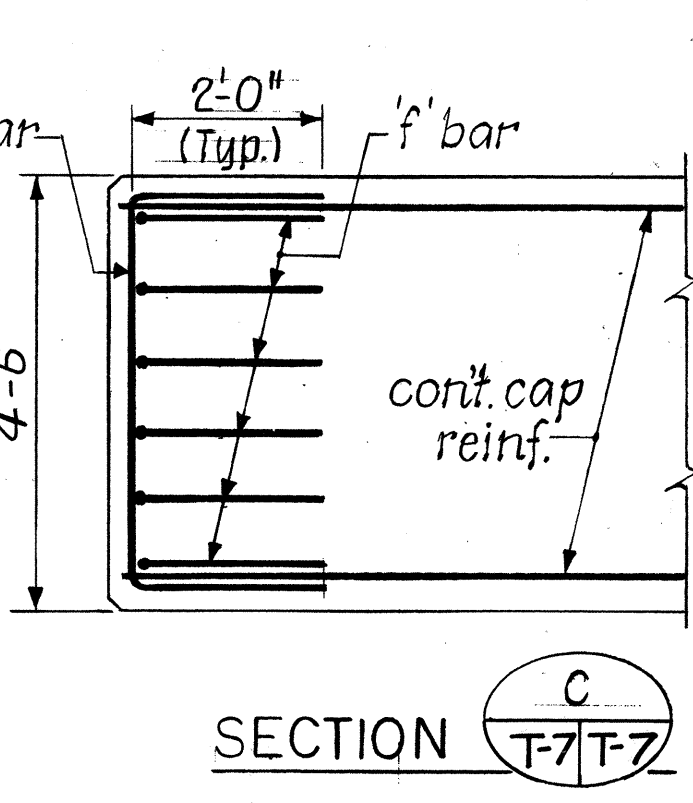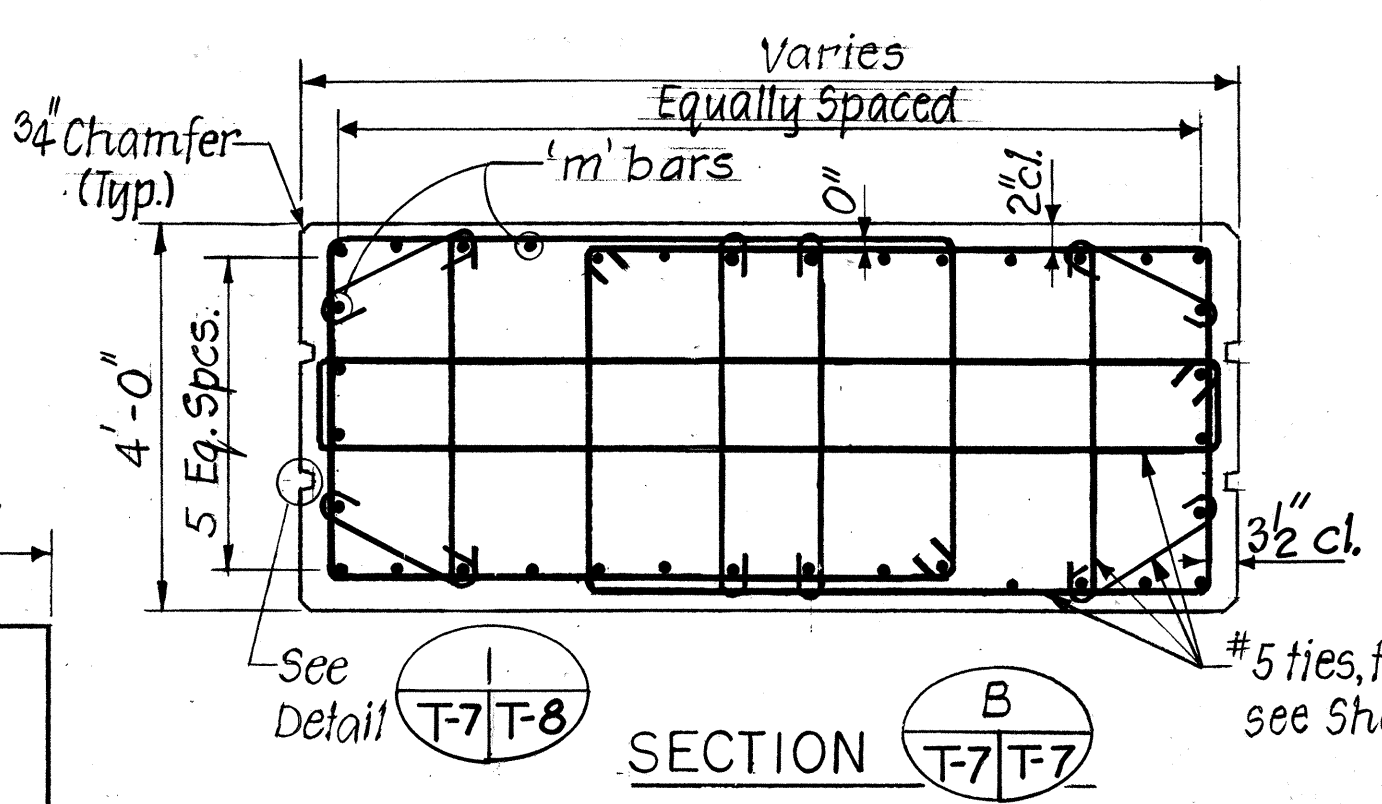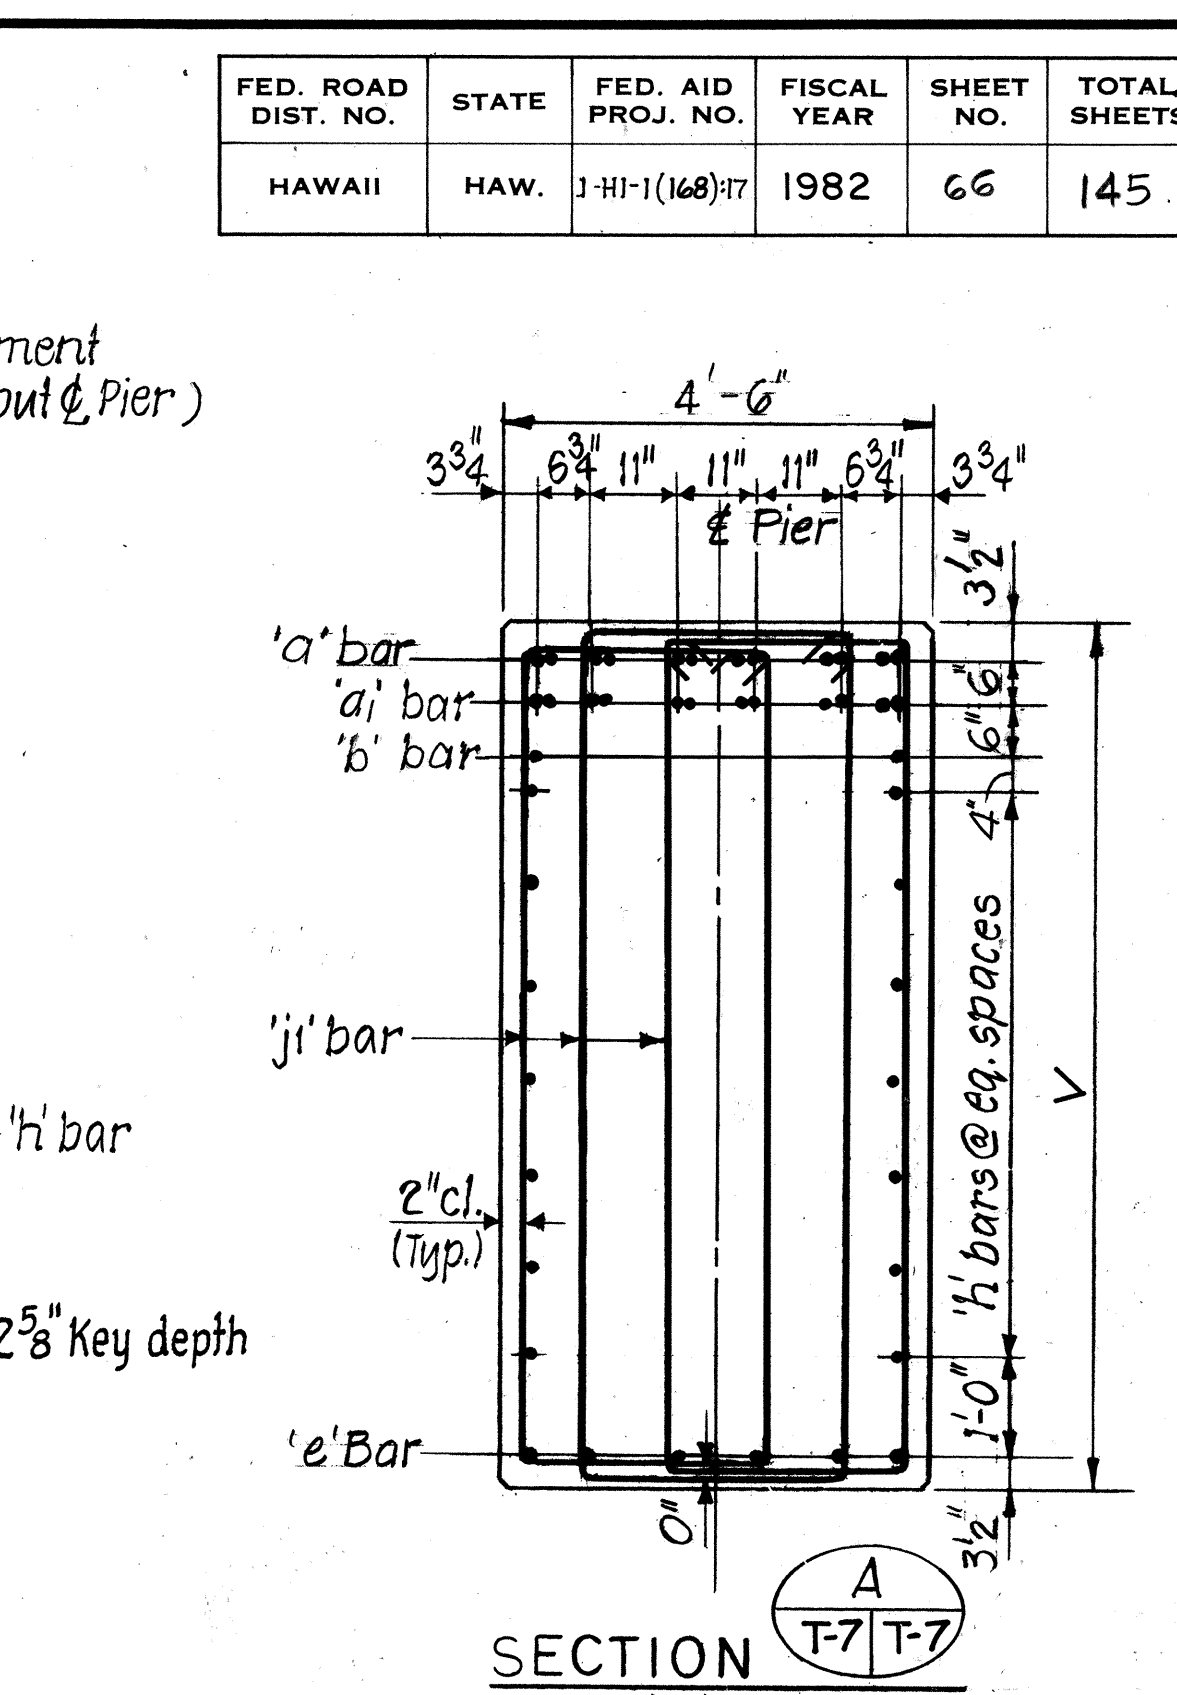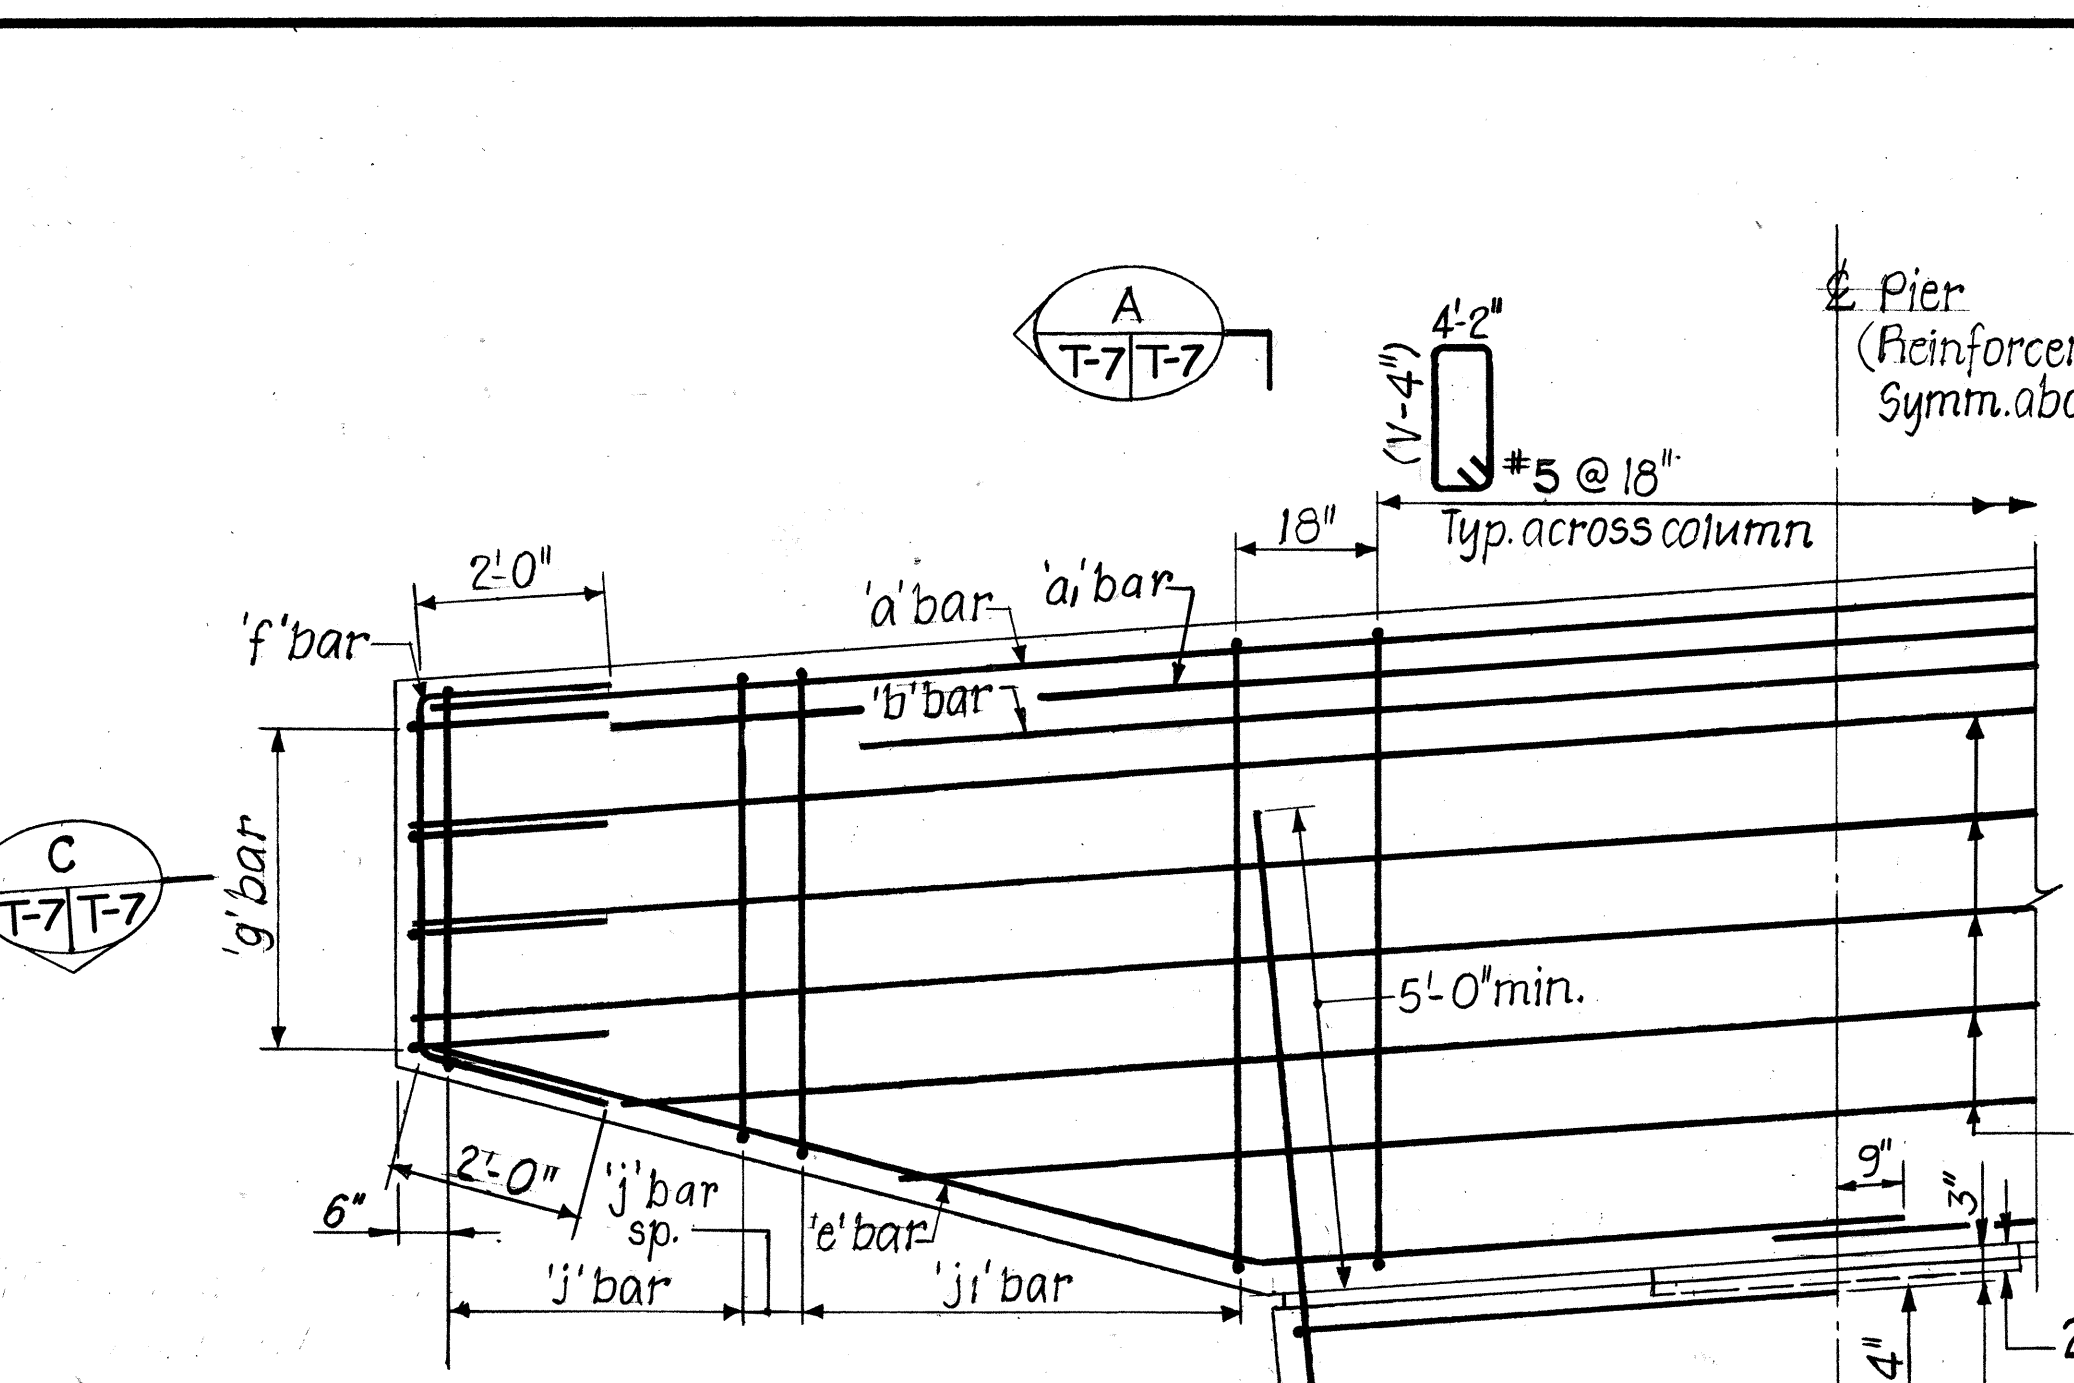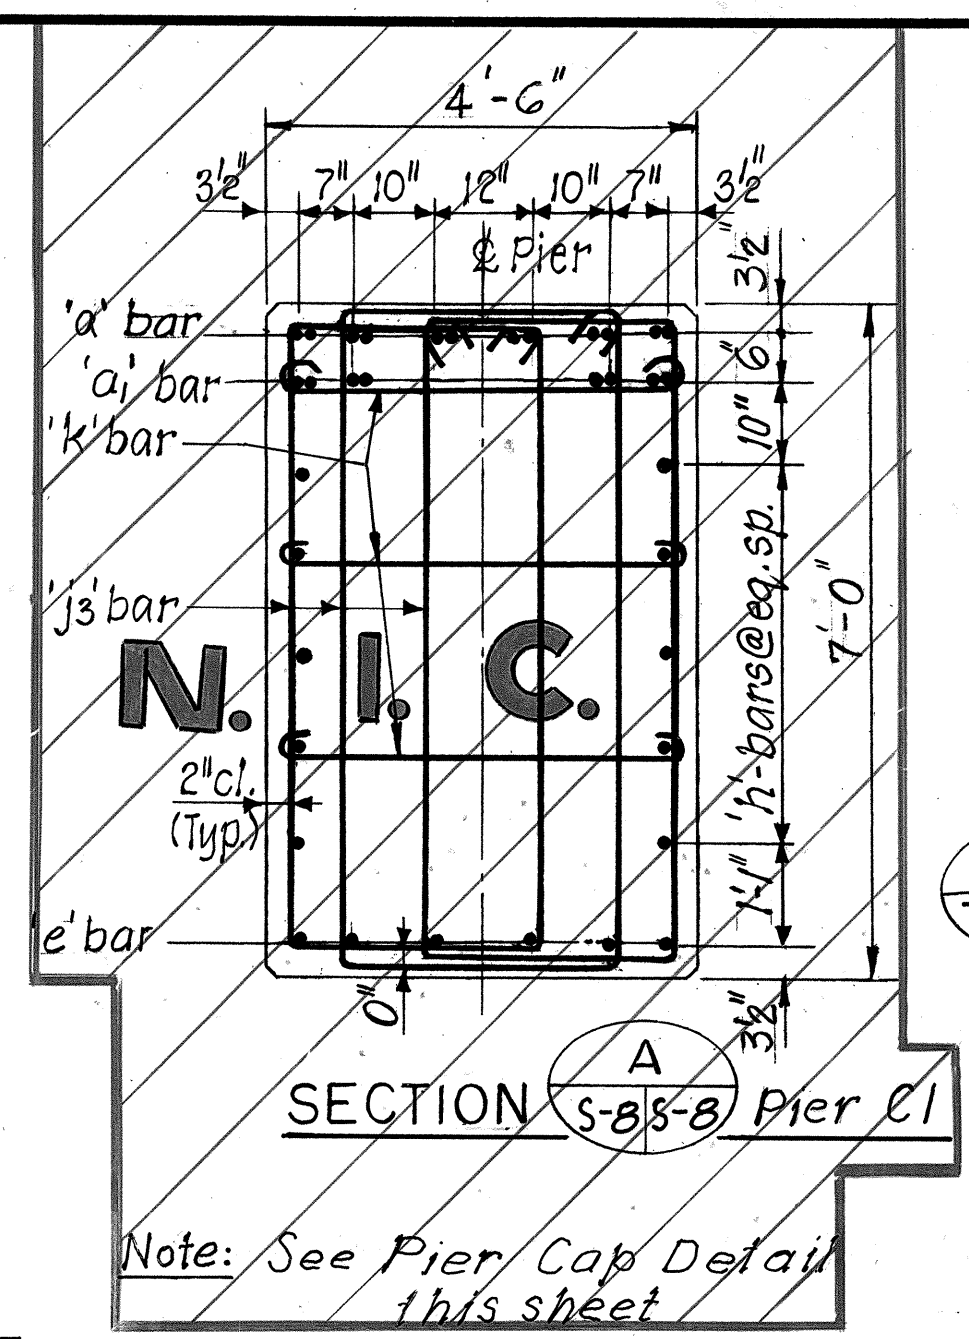

- NOTES:**
- Concrete Above Footings  
Ult. Strength (28 days)  $f'_c$  4000 psi  
Extr. Fiber in Compression 1600 psi  
See Concrete Strength Sketch this sheet.
  - Reinforcement Steel, see Schedule Sheet No. T-12 & T-13.
  - Pier geometry, see tables Sheet Nos. T-10 & T-11.
  - For Concrete Pad and Anchor Bolt details, see Sheet No. T-14.
  - For footing details, see Sheet Nos. T-5 & T-6.
  - For Reinforcement of Footing & Pedestal of Piers HE2 Thru HE5, HV2 Thru HV5, see Sheet No. T-9.
  - For Payment Limits see Sheet No. T-9.
  - All Costs for formwork support shall be incidental to Concrete Cost.

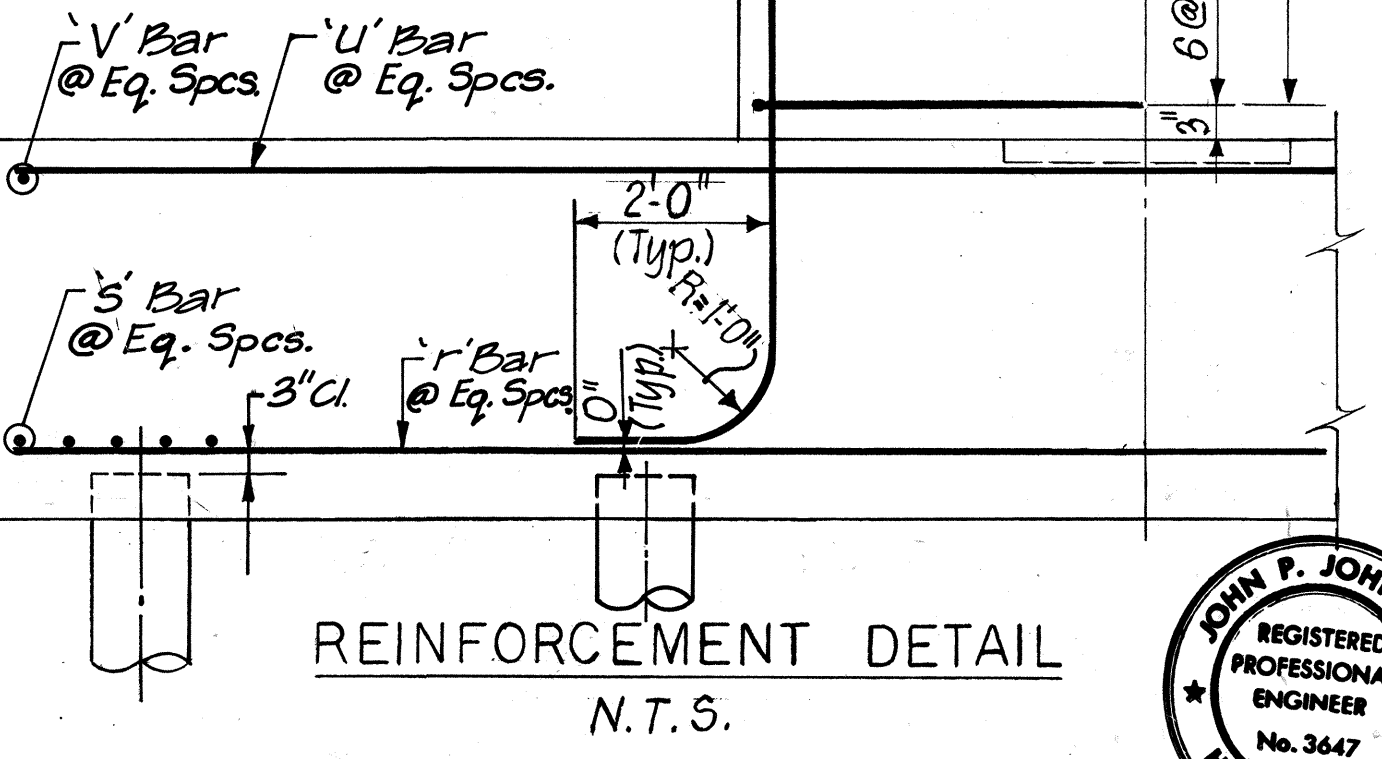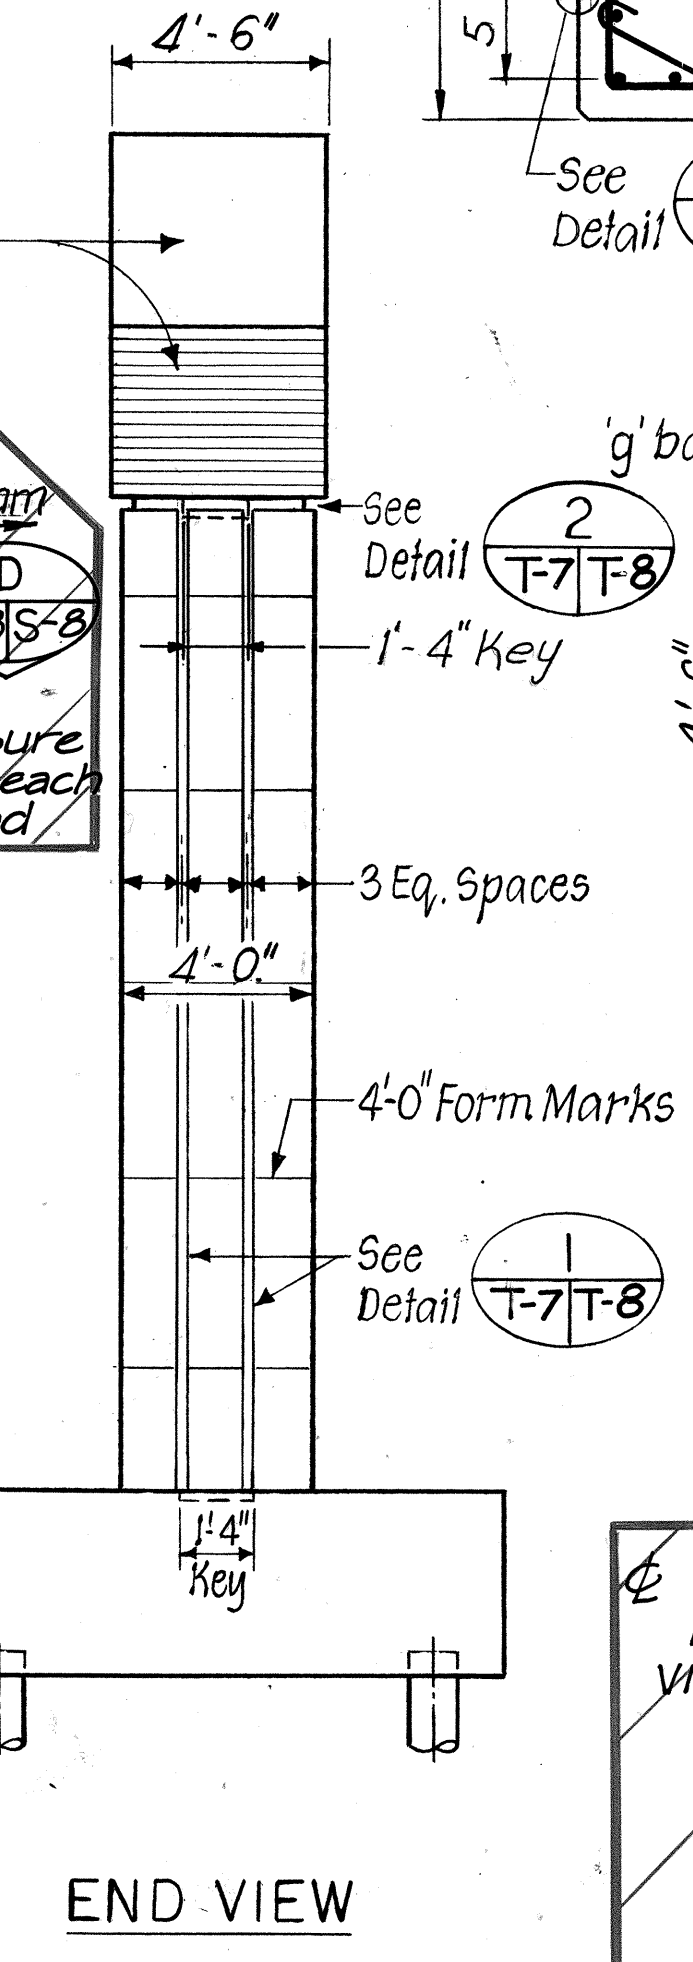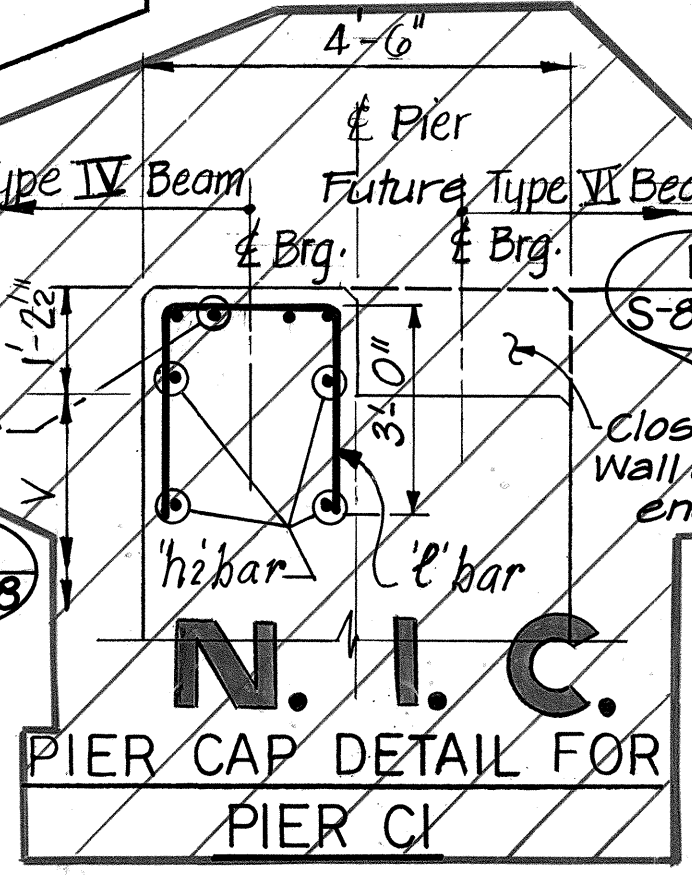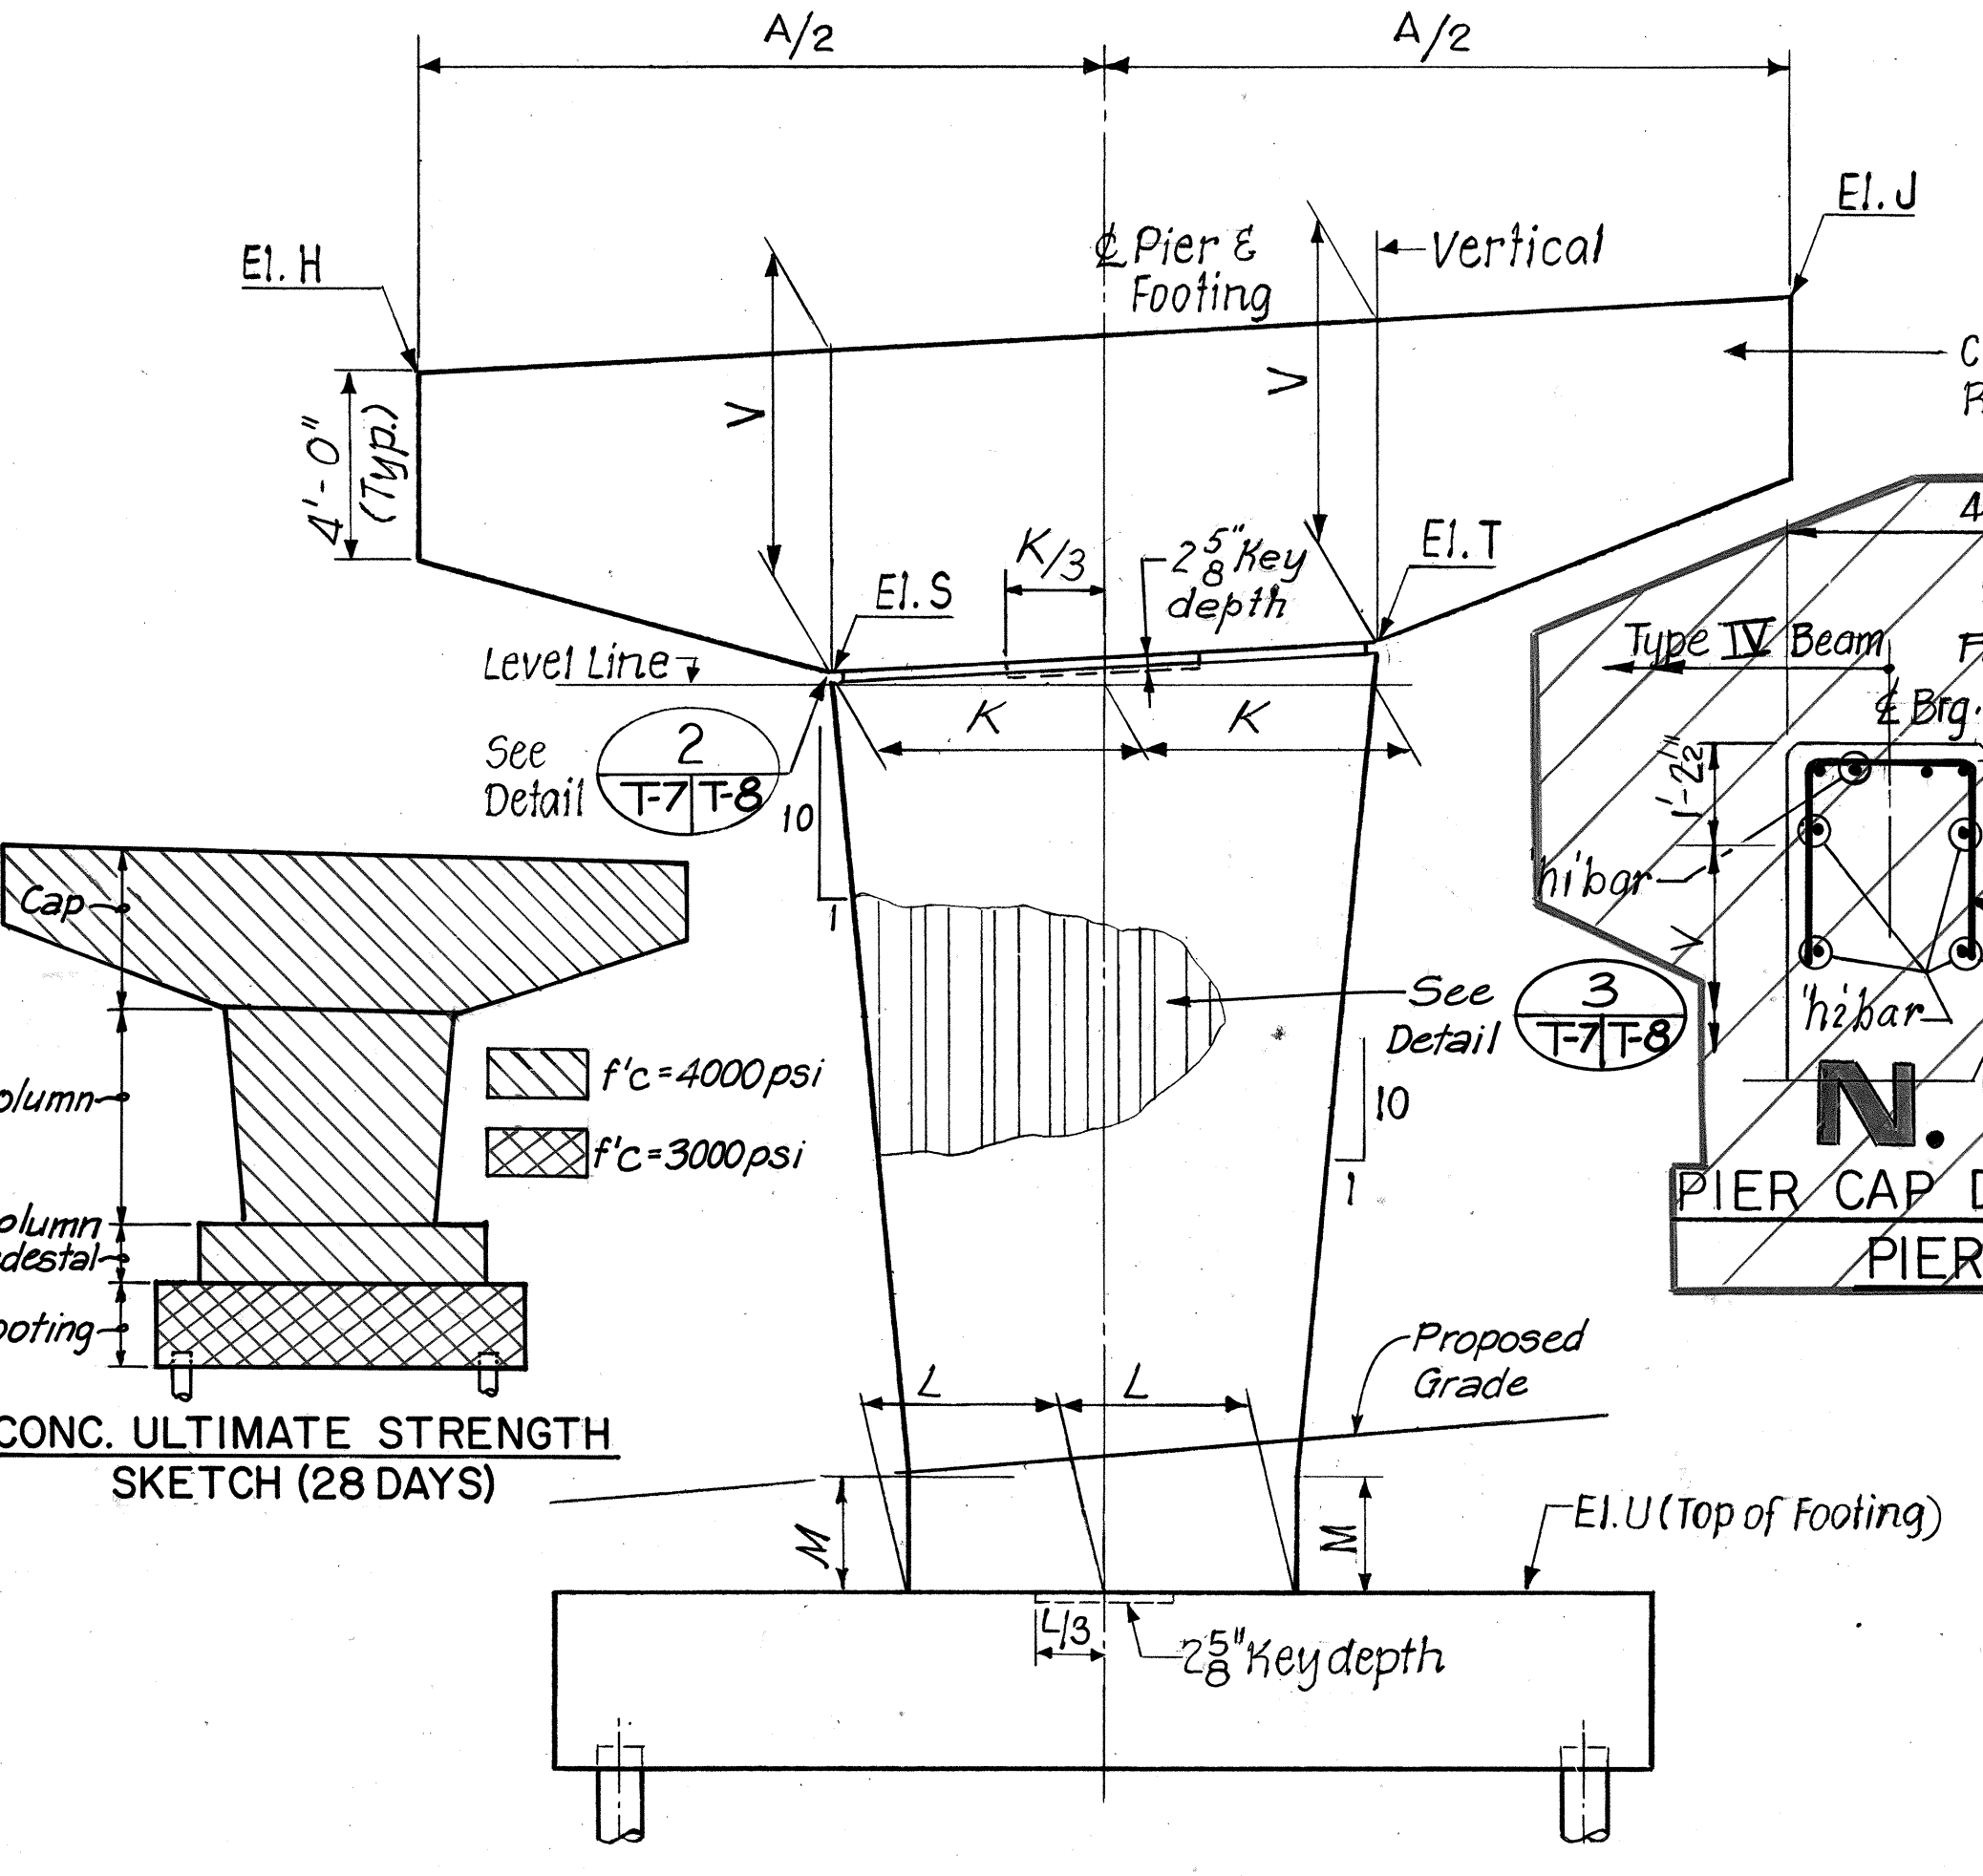

THIS WORK WAS PREPARED BY ME OR UNDER MY SUPERVISION.  
John P. Johnson

STATE OF HAWAII  
DEPARTMENT OF TRANSPORTATION  
HIGHWAYS DIVISION  
H-1 VIADUCT (E.B.), RAMP C & HOV RAMP

**DETAILS OF TYPE I PIER**

KEEHI INTERCHANGE  
F.A.I. PROJ. NO. 1-HI-1 (168)17  
SCALE: N.T.S. DATE: 8/17/81


SHEET NO. T-7 OF T-23 SHEETS










| FED. ROAD DIST. NO. | STATE | FED. AID PROJ. NO. | FISCAL YEAR | SHEET NO. | TOTAL SHEETS |
|---------------------|-------|--------------------|-------------|-----------|--------------|
| HAWAII              | HAW.  | 1-HI-1(168):17     | 1982        | 68        | 145          |

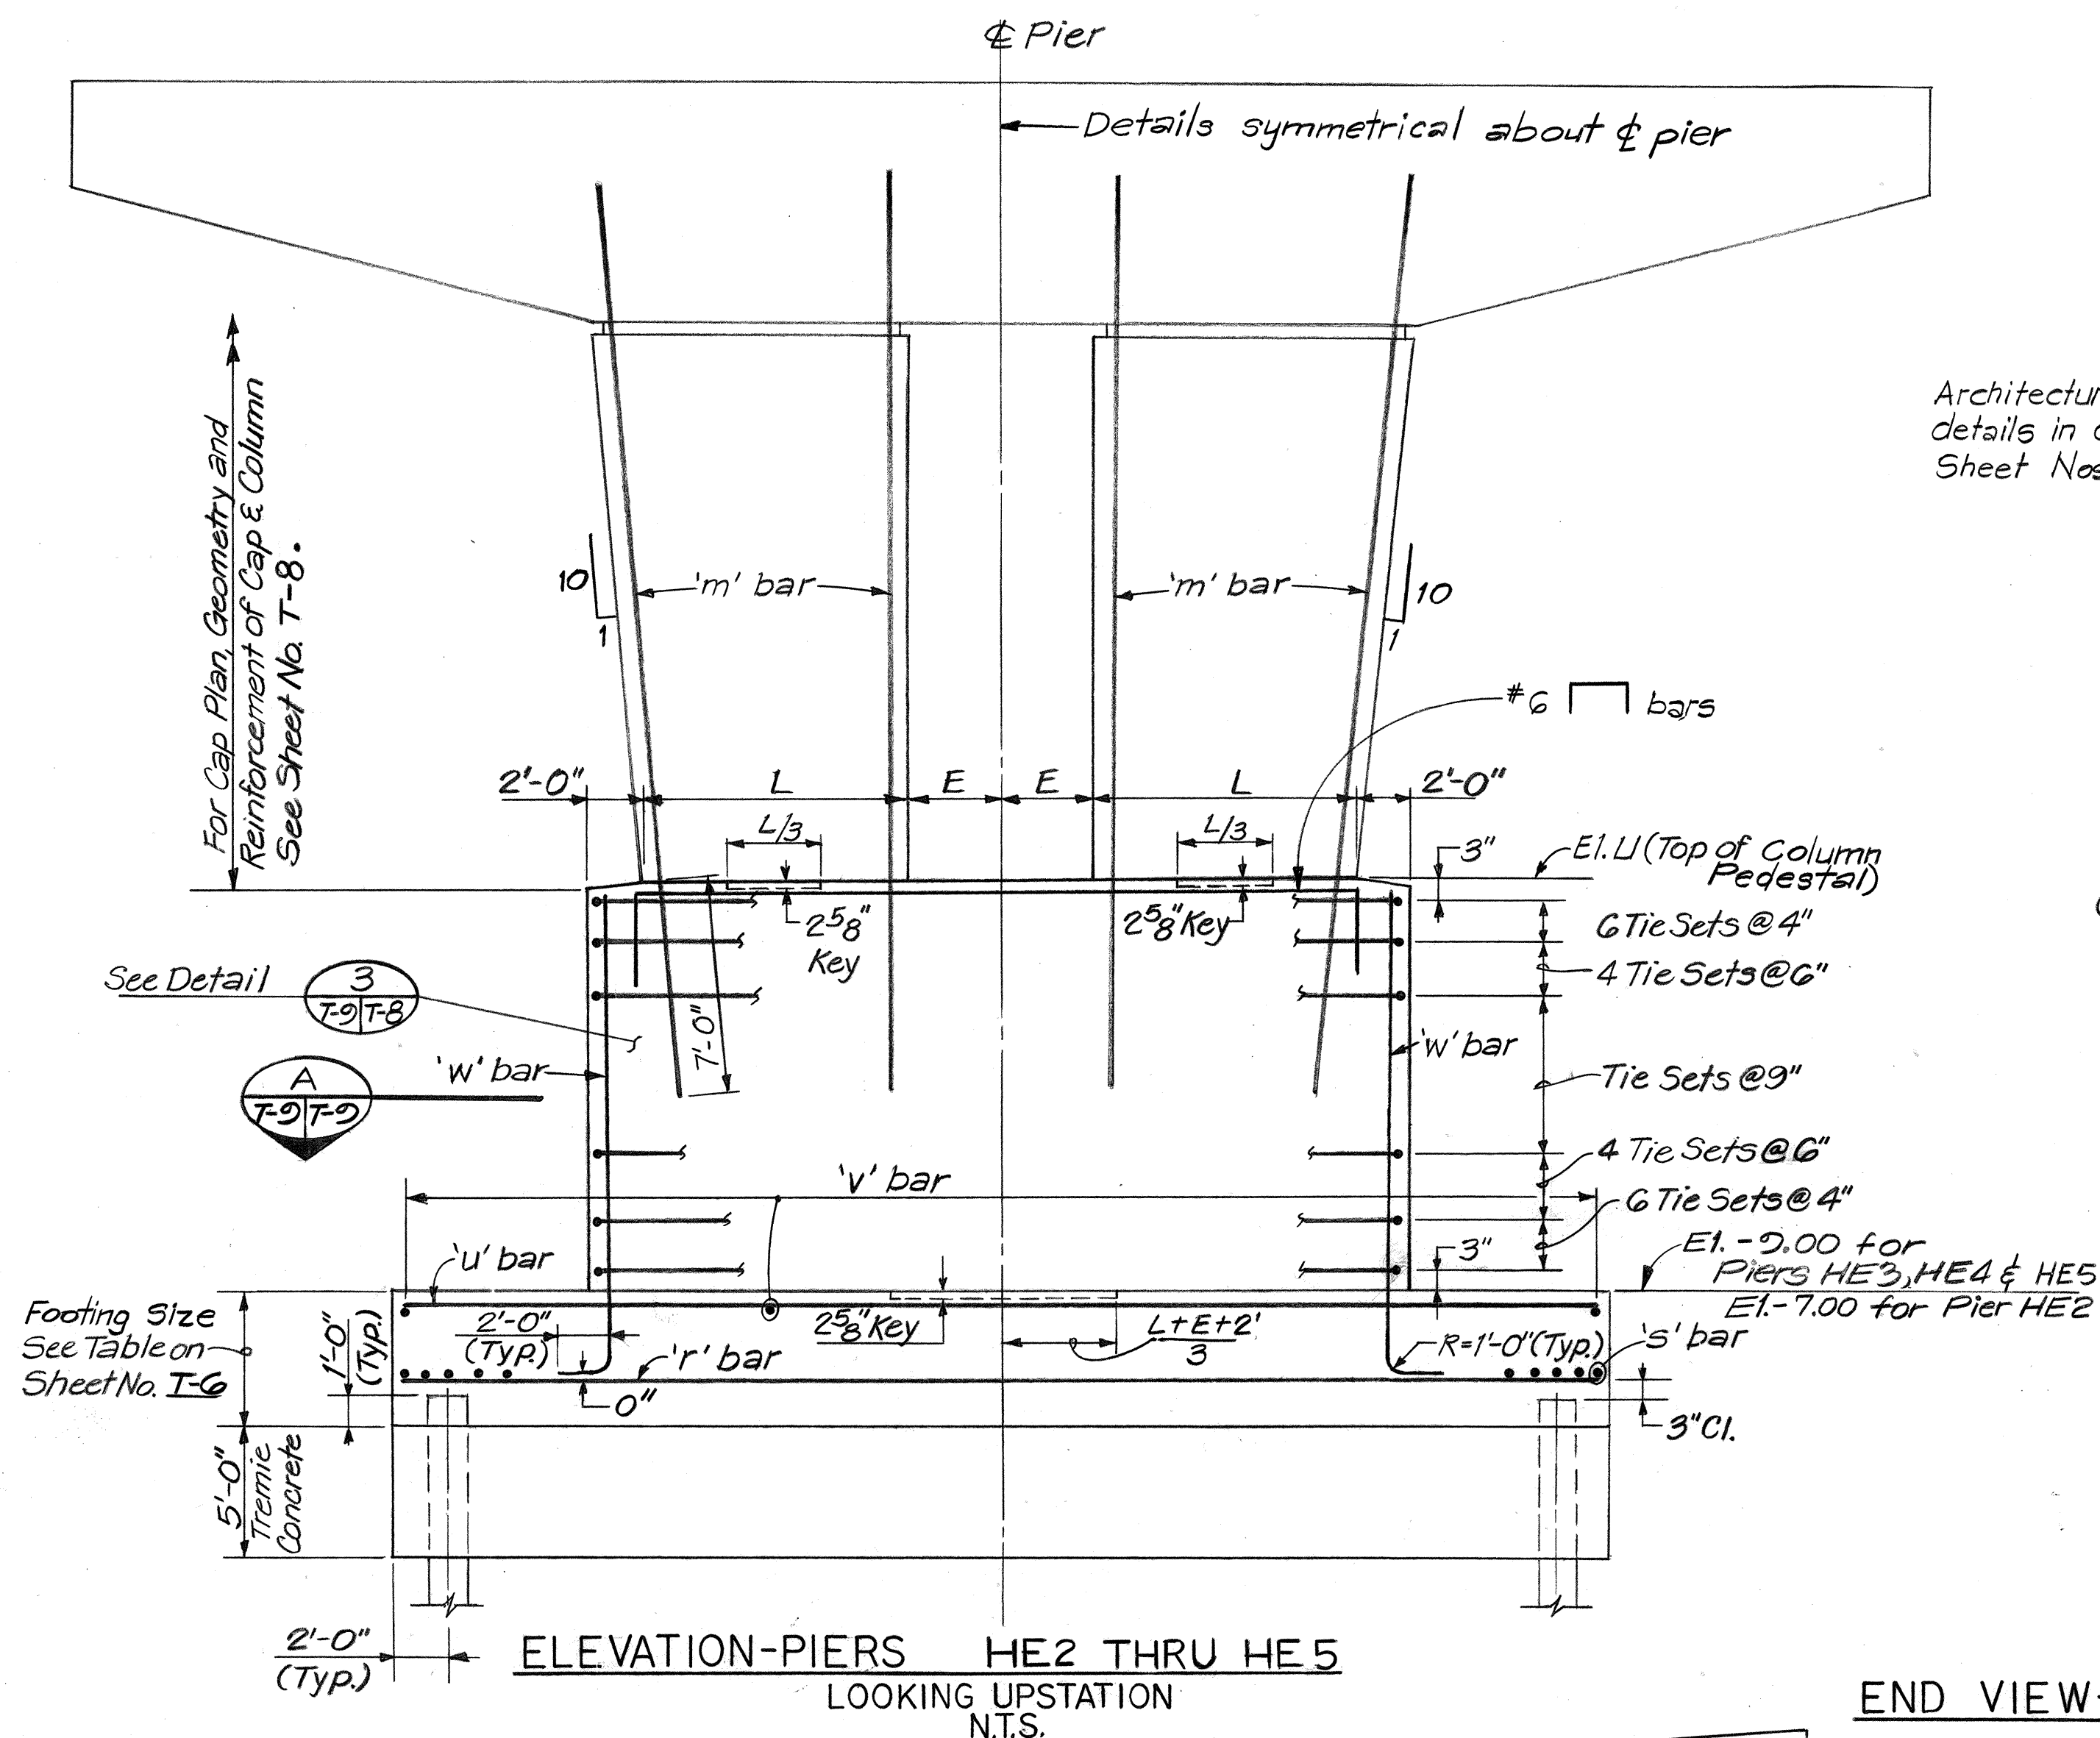

Architecture treatment details in column, See Sheet Nos. T-7 & T-8.

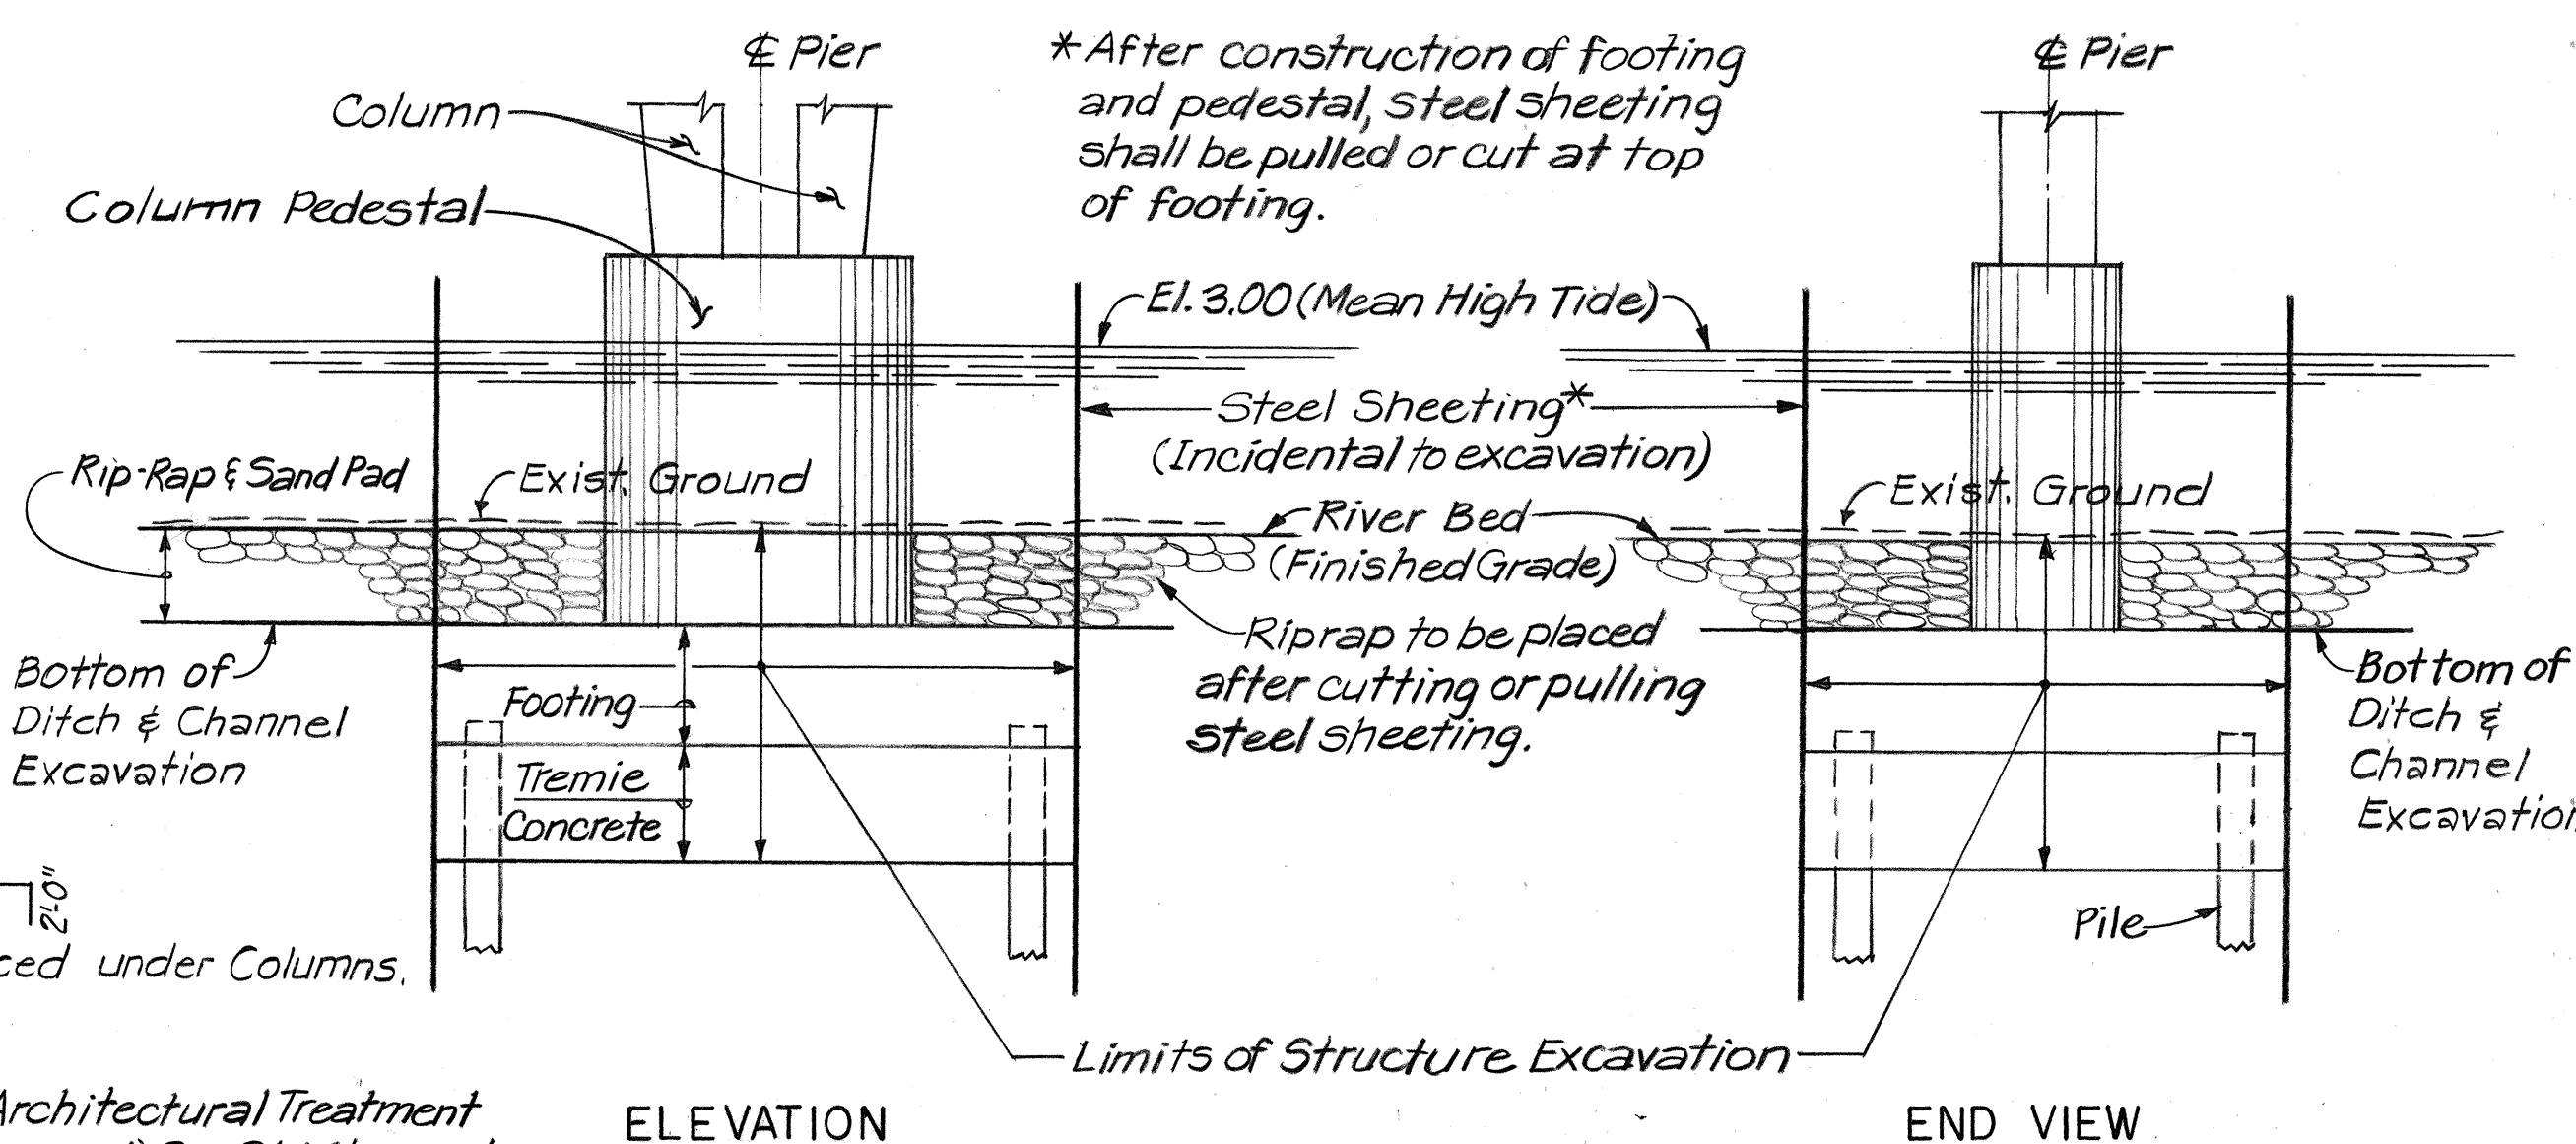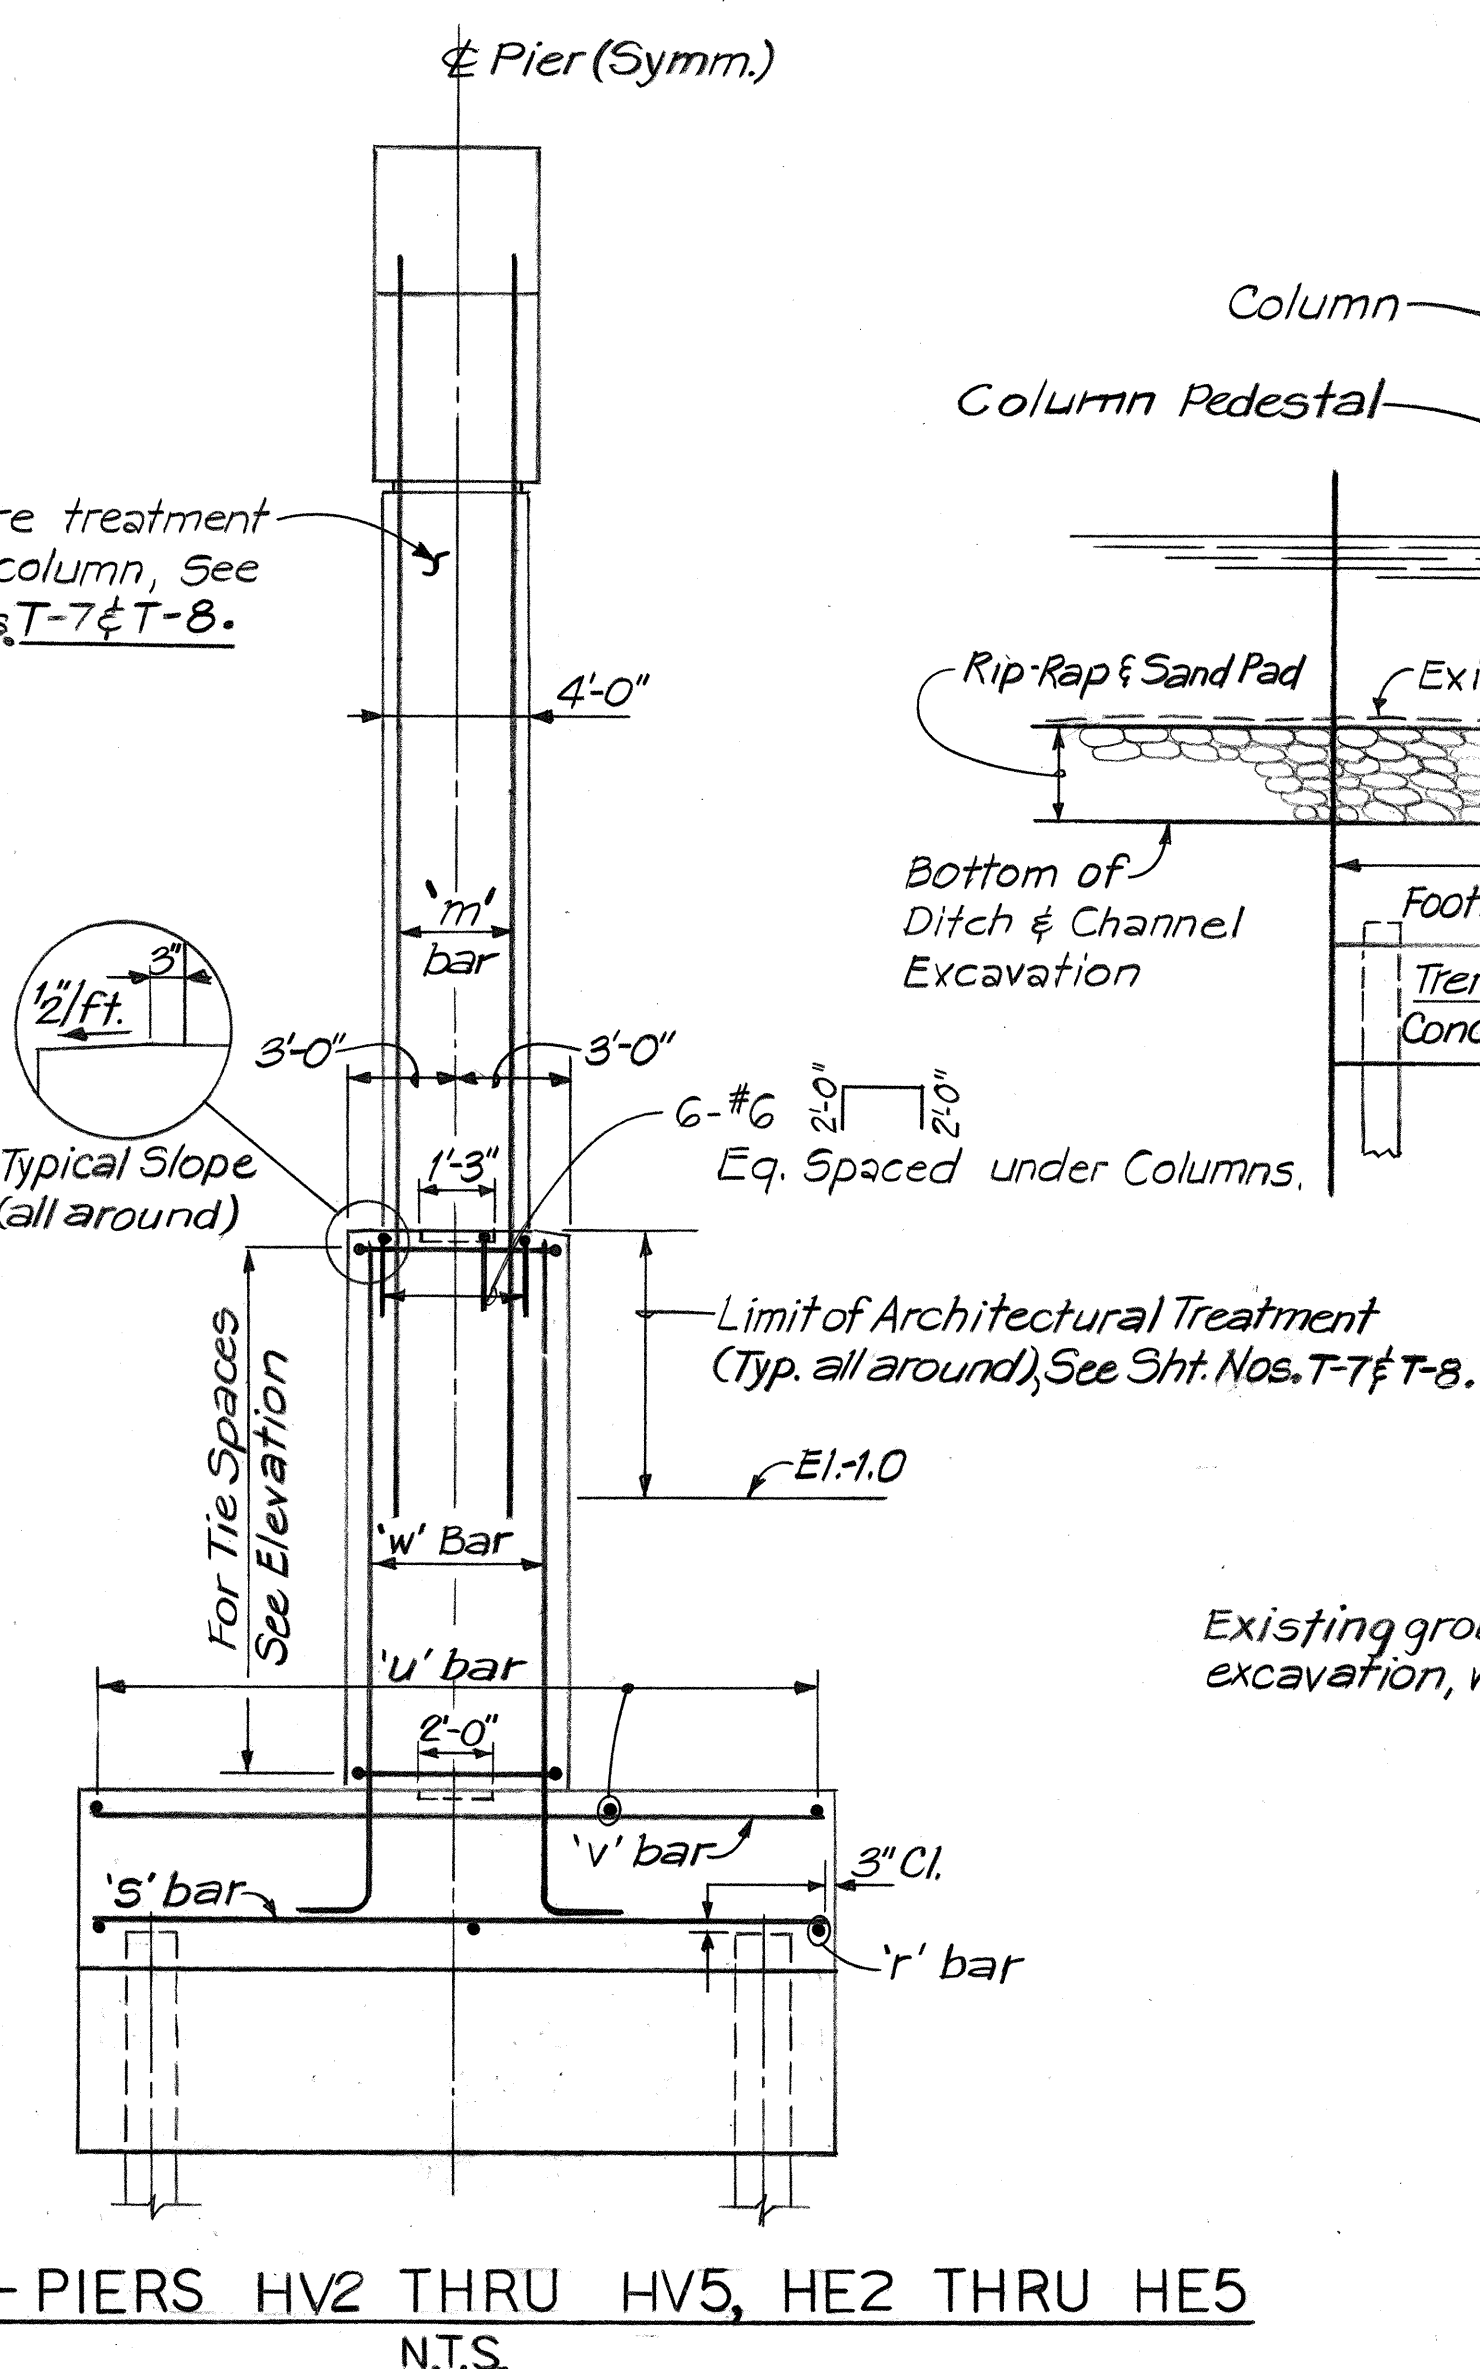



**PAYMENT LIMITS**  
(PIERS HE2 THRU HE5, HV2 THRU HV5 N.T.S.)

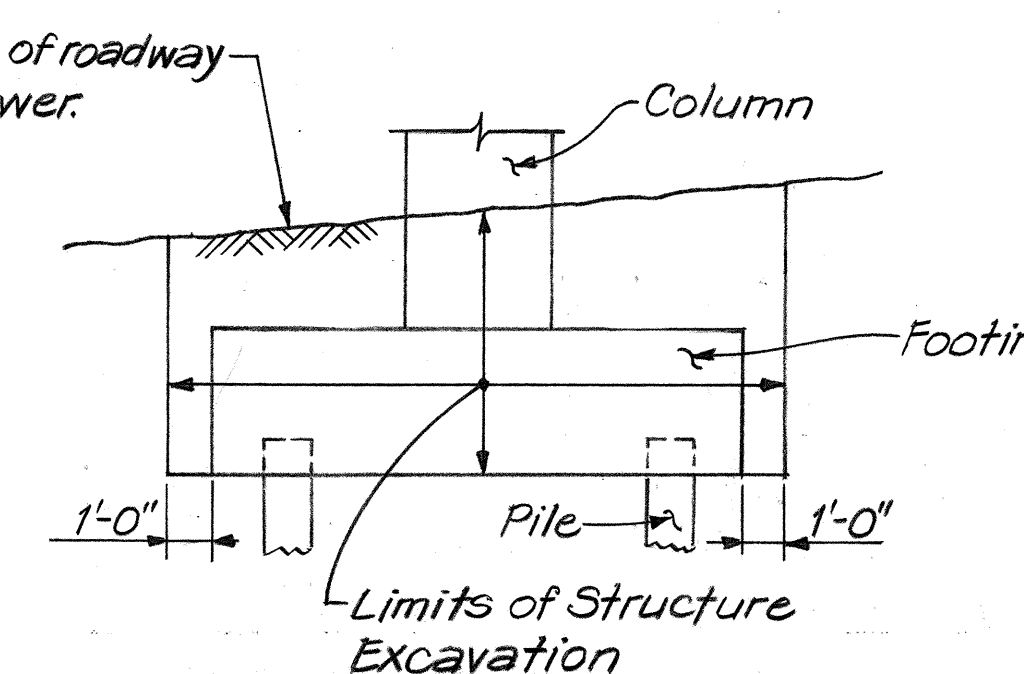


**PAYMENT LIMITS**  
PIERS HE1 & HE6 N.T.S.

#### NOTES:

1. For Notes, see Sheet No. T-7.
2. For footing location plan & footing details, see Sheet Nos. T-5 and T-6.

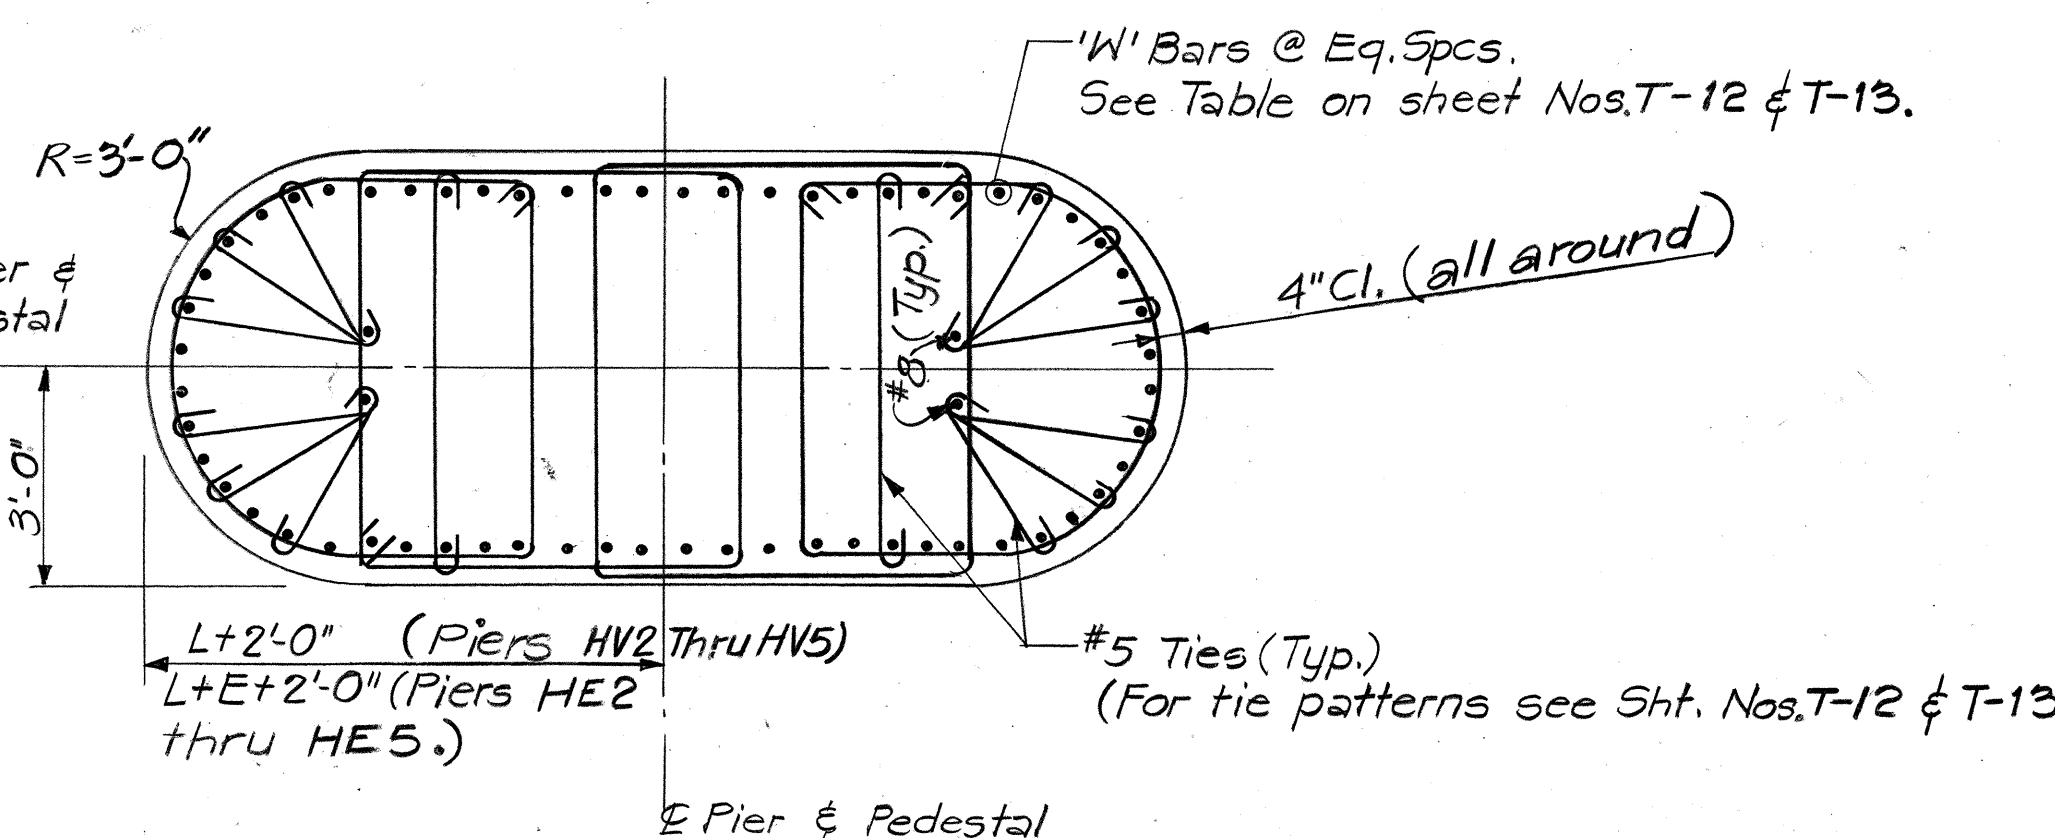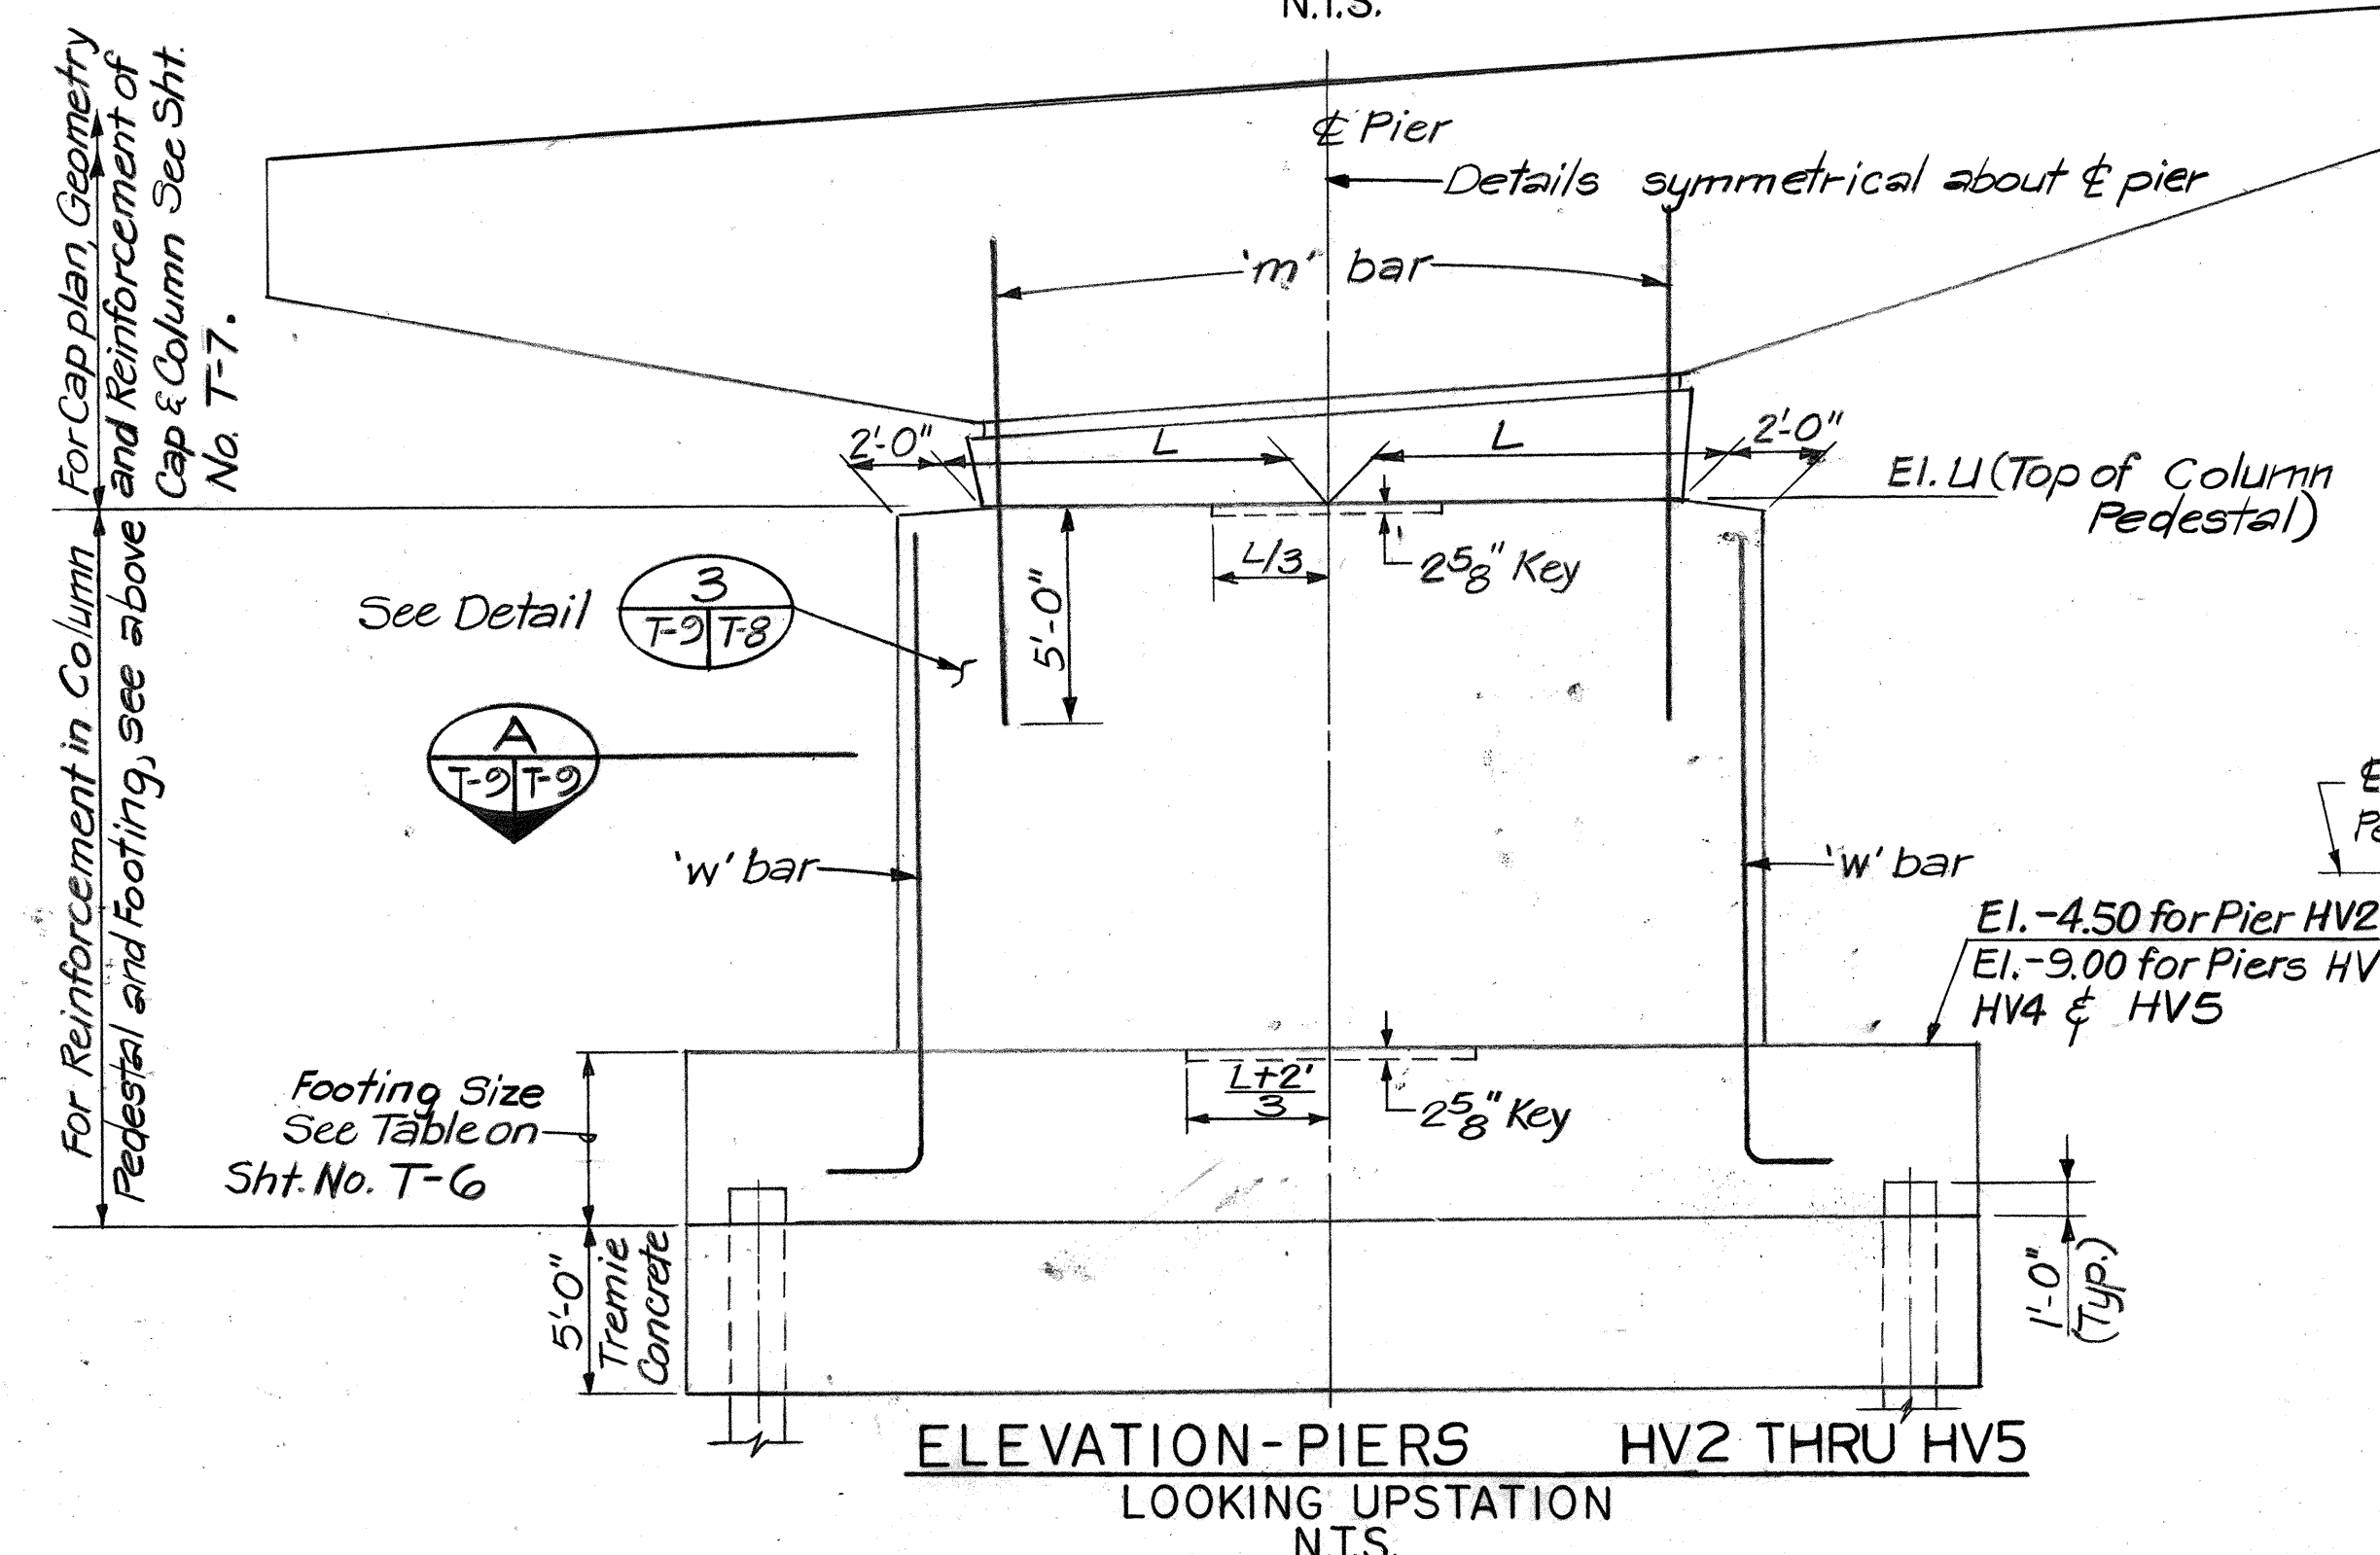

SECTION A  
N.T.S.

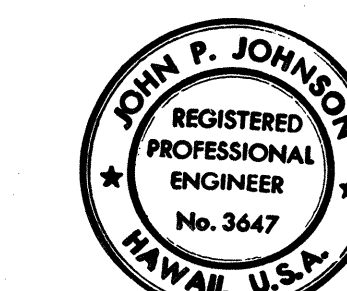

THIS WORK WAS PREPARED BY ME OR UNDER MY SUPERVISION.

John P. Johnson

STATE OF HAWAII  
DEPARTMENT OF TRANSPORTATION  
HIGHWAYS DIVISION  
H-1 VIADUCT (E.B.), RAMP C & HOV RAMP


**DETAILS OF TYPE III PIER**

KEEHI INTERCHANGE  
F.A.I. PROJ. NO. 1-HI-1(168):17  
SCALE: AS SHOWN DATE: 8/17/81  
SHEET NO. T-9 OF T-23 SHEETS



# TABLE OF PIER DIMENSIONS AND ELEVATIONS

| PIER NAME                                             |                               | HE1                    | HE2                    | HE3                     | HE4                    | HE5                    | HE6                   | C1                 | HE0                |
|-------------------------------------------------------|-------------------------------|------------------------|------------------------|-------------------------|------------------------|------------------------|-----------------------|--------------------|--------------------|
| PIER TYPE                                             |                               | II                     | III                    | III                     | III                    | III                    | (BY OTHERS)           | (BY OTHERS)        | (BY OTHERS)        |
| WORK POINT STA. OF & PIER                             |                               | 236 + 65.00            | 237 + 65.09            | 238 + 65.18             | 239 + 65.27            | 240 + 71.00            | 241 + 77.00           | 14 + 86.50         | 235 + 64.91        |
| SOUTH AZIMUTH OF & PIER                               |                               | 189° - 01' - 23.0"     | 189° - 01' - 23.0"     | 189° - 01' - 23.0"      | 189° - 01' - 23.0"     | 186° - 33' - 39.9"     | 186° - 33' - 39.9"    | 189° - 34' - 26.0" | 189° - 01' - 23.0" |
| CAP                                                   | LENGTH OF CAP "A"             | 70'-6 1/2"             | 64'-7"                 | 70'-9"                  | 76'-0"                 | 81'-7 3/4"             |                       |                    |                    |
|                                                       | DIST. & BRGS. TO & PIER "G"   | 11"                    | 11"                    | 11"                     | 11"                    | 11"                    |                       |                    |                    |
|                                                       | DEPTH "V"                     | 9'-0"                  | 9'-0"                  | 9'-6"                   | 9'-6"                  | 9'-6"                  |                       |                    |                    |
|                                                       | DIMENSION "F1" DIMENSION "F2" | 6'-5 1/2" 6'-5 1/2"    | 2'-0" 2'-0"            | 2'-0" 2'-0"             | 2'-0" 2'-0"            | 2'-0" 2'-0"            |                       |                    |                    |
|                                                       | DISTANCE "Q" DISTANCE "R"     | 17'-3 1/8" 53'-33 3/8" | 12'-9 5/8" 51'-93 3/8" | 12'-9 5/8" 57'-113 3/8" | 12'-9 5/8" 63'-23 3/8" | 12'-9 1/2" 68'-10 1/4" |                       |                    |                    |
| COLUMN                                                | ELEVATION "H" ELEVATION "J"   | 35.92 34.85            | 36.39 35.46            | 36.85 36.14             | 37.23 37.01            | 37.61 38.24            |                       |                    |                    |
|                                                       | DIMENSION "K" DIMENSION "E"   | 11'-0" 1'-3 1/4"       | 11'-0" 1'-3 1/2"       | 12'-0" 3'-4 1/2"        | 14'-0" 4'-0"           | 16'-0" 4'-10"          |                       |                    |                    |
|                                                       | BOTTOM WIDTH "L"              | 8'-11"                 | 9'-0"                  | 9'-11"                  | 11'-10"                | 13'-9"                 |                       |                    |                    |
|                                                       | DIMENSION "M" ELEVATION "U"   | 1'-4" 4.00             | - 6.50(P)              | - 6.50(P)               | - 6.50(P)              | - 6.50(P)              |                       |                    |                    |
|                                                       | ELEVATION "S" ELEVATION "T"   | 26.57 26.20            | 27.10 26.75            | 27.15 26.84             | 27.67 27.57            | 28.26 28.59            |                       |                    |                    |
| STRINGER SPACING<br>DISTANCE MEASURED<br>ALONG & PIER | DOWN STA. 1 UP STA. 1         | 6'-3 5/8" 6'-3 5/8"    | 6'-8 3/4" 6'-0 11/16"  | 6'-8 1/8" 6'-0 7/8"     | 6'-6 9/16" 5'-6 1/2"   | 5'-11 5/8" 5'-8 3/16"  | 6'-4 7/8" 6'-4 5/16"  |                    | 6'-3 5/8"          |
|                                                       | DOWN STA. 2 UP STA. 2         |                        | 6'-8 13/16" 6'-8 1/8"  | 6'-8 1/8" 6'-0 13/16"   | 5'-6 1/16" 5'-6 1/16"  | 5'-8 3/16" 5'-8 1/4"   | 6'-3 3/16" 6'-3 1/8"  |                    |                    |
|                                                       | DOWN STA. 3 UP STA. 3         |                        | 6'-8 3/4" 6'-8 3/4"    | 6'-8 1/8" 6'-0 13/16"   | 5'-6 1/16" 5'-6 1/16"  | 5'-8 3/16" 5'-8 1/4"   | 6'-3 3/16" 6'-3 1/8"  |                    |                    |
|                                                       | DOWN STA. 4 UP STA. 4         |                        | 6'-8 3/4" 6'-8 3/4"    | 6'-8 1/8" 6'-0 13/16"   | 5'-6 1/16" 5'-6 1/16"  | 5'-8 3/16" 5'-8 1/4"   | 6'-3 3/16" 6'-3 1/8"  |                    |                    |
|                                                       | DOWN STA. 5 UP STA. 5         |                        | 6'-8 3/4" 6'-8 3/4"    | 6'-8 1/8" 6'-0 13/16"   | 5'-6 1/16" 5'-6 1/16"  | 5'-8 3/16" 5'-8 1/4"   | 6'-3 3/16" 6'-3 1/8"  |                    |                    |
|                                                       | DOWN STA. 6 UP STA. 6         |                        | 6'-8 3/4" 6'-8 3/4"    | 6'-8 1/8" 6'-0 13/16"   | 5'-6 1/16" 5'-6 1/16"  | 5'-8 3/16" 5'-8 1/4"   | 6'-3 3/16" 6'-3 1/8"  |                    |                    |
|                                                       | DOWN STA. 7 UP STA. 7         |                        | 6'-8 3/4" 6'-8 3/4"    | 6'-8 1/8" 6'-0 13/16"   | 5'-6 1/16" 5'-6 1/16"  | 5'-8 3/16" 5'-8 1/4"   | 6'-3 3/16" 6'-3 1/8"  |                    |                    |
|                                                       | DOWN STA. 8 UP STA. 8         |                        | 6'-8 3/4" 6'-8 3/4"    | 6'-8 1/8" 6'-0 13/16"   | 5'-6 1/16" 5'-6 1/16"  | 5'-8 3/16" 5'-8 1/4"   | 6'-3 3/16" 6'-3 1/8"  |                    |                    |
|                                                       | DOWN STA. 9 UP STA. 9         | 6'-3 5/8" 6'-3 5/8"    | 6'-8 3/4" 6'-0 11/16"  | 6'-8 1/8" 6'-0 13/16"   | 5'-6 1/16" 5'-6 1/16"  | 5'-8 3/16" 5'-8 1/4"   | 6'-4 15/16" 6'-4 7/8" |                    | 6'-3 5/8"          |
|                                                       | DOWN STA. 10 UP STA. 10       |                        | 6'-8 3/4" 6'-0 11/16"  | 6'-8 1/8" 6'-0 13/16"   | 5'-6 1/16" 5'-6 1/16"  | 5'-8 3/16" 5'-8 1/4"   | 6'-4 15/16" 6'-4 7/8" |                    |                    |
|                                                       | DOWN STA. 11 UP STA. 11       |                        | 6'-8 3/4" 6'-0 11/16"  | 6'-8 1/8" 6'-0 13/16"   | 5'-6 1/16" 5'-6 1/16"  | 5'-8 3/16" 5'-8 1/4"   | 6'-4 15/16" 6'-4 7/8" |                    |                    |
|                                                       | DOWN STA. 12 UP STA. 12       |                        | 6'-8 3/4" 6'-0 11/16"  | 6'-8 1/8" 6'-0 13/16"   | 5'-6 1/16" 5'-6 1/16"  | 5'-8 3/16" 5'-8 1/4"   | 6'-4 15/16" 6'-4 7/8" |                    |                    |
|                                                       | DOWN STA. 13 UP STA. 13       |                        | 6'-8 3/4" 6'-0 11/16"  | 6'-8 1/8" 6'-0 13/16"   | 5'-6 1/16" 5'-6 1/16"  | 5'-8 3/16" 5'-8 1/4"   | 6'-4 15/16" 6'-4 7/8" |                    |                    |
|                                                       | DOWN STA. 14 UP STA. 14       |                        | 6'-8 3/4" 6'-0 11/16"  | 6'-8 1/8" 6'-0 13/16"   | 5'-6 1/16" 5'-6 1/16"  | 5'-8 3/16" 5'-8 1/4"   | 6'-4 15/16" 6'-4 7/8" |                    |                    |
| DOWN STATION & BRGS.                                  | 1 STRINGER BRG. TYPE          | IHE1 3H                | 2HE1 3H                | 3HE1 3H                 | 4HE1 3H                | 5HE1 3H                | 6HE1 3H               | IC1                |                    |
|                                                       | STR. SKEW X PAD ELEV.         | -1/2" 36.14            | -1/2" 36.68            | -1/2" 37.14             | -1/2" 37.52            | 0" 37.93               | 0" 38.26              | +1/16" 39.97       |                    |
|                                                       | 2 STRINGER BRG. TYPE          | IHE2 2H                | 2HE2 2H                | 3HE2 2H                 | 4HE2 2H                | 5HE2 2H                | 6HE2 2H               | IC2                |                    |
|                                                       | STR. SKEW X PAD ELEV.         | -1/2" 36.05            | -7/16" 36.58           | -7/16" 37.09            | -7/16" 37.56           | +1/16" 38.04           | +1/16" 38.46          | +1/16" 40.13       |                    |
|                                                       | 3 STRINGER BRG. TYPE          | IHE3 2H                | 2HE3 2H                | 3HE3 2H                 | 4HE3 2H                | 5HE3 2H                | 6HE3 2H               | IC3                |                    |
|                                                       | STR. SKEW X PAD ELEV.         | -1/2" 35.95            | -7/16" 36.48           | -3/8" 37.04             | -3/8" 37.59            | +1/8" 38.15            | +3/16" 38.66          | +1/16" 40.05       |                    |
|                                                       | 4 STRINGER BRG. TYPE          | IHE4 2H                | 2HE4 2H                | 3HE4 2H                 | 4HE4 2H                | 5HE4 2H                | 6HE4 2H               | IC4                |                    |
|                                                       | STR. SKEW X PAD ELEV.         | -1/2" 35.85            | -3/8" 36.37            | -5/16" 36.99            | -3/8" 37.62            | +1/8" 38.26            | +4" 38.87             | 0" 39.97           |                    |
|                                                       | 5 STRINGER BRG. TYPE          | IHE5 2H                | 2HE5 2H                | 3HE5 2H                 | 4HE5 2H                | 5HE5 2H                | 6HE5 2H               | IC5                |                    |
|                                                       | STR. SKEW X PAD ELEV.         | -1/2" 35.76            | -5/16" 36.27           | -4" 36.99               | -5/16" 37.65           | +3/16" 38.37           | +3/16" 39.07          | 0" 39.89           |                    |
|                                                       | 6 STRINGER BRG. TYPE          | IHE6 2H                | 2HE6 2H                | 3HE6 2H                 | 4HE6 2H                | 5HE6 2H                | 6HE6 2H               | IC6                |                    |
|                                                       | STR. SKEW X PAD ELEV.         | -1/2" 35.66            | -4" 36.17              | -1/4" 36.89             | -1/4" 37.68            | +1/4" 38.48            | +1/16" 39.27          | 0" 39.81           |                    |
|                                                       | 7 STRINGER BRG. TYPE          | IHE7 2H                | 2HE7 2H                | 3HE7 2H                 | 4HE7 2H                | 5HE7 2H                | 6HE7 2H               |                    |                    |
|                                                       | STR. SKEW X PAD ELEV.         | -1/2" 35.57            | -3/16" 36.08           | -1/16" 36.84            | -3/16" 37.72           | +5/16" 38.59           | +1/2" 39.48           |                    |                    |
|                                                       | 8 STRINGER BRG. TYPE          | IHE8 2H                | 2HE8 2H                | 3HE8 2H                 | 4HE8 2H                | 5HE8 2H                | 6HE8 2H               |                    |                    |
|                                                       | STR. SKEW X PAD ELEV.         | -1/2" 35.47            | -1/8" 35.99            | 0" 36.75                | -1/8" 37.75            | +3/8" 38.71            | +9/16" 39.68          |                    |                    |
|                                                       | 9 STRINGER BRG. TYPE          | IHE9 2H                | 2HE9 2H                | 3HE9 2H                 | 4HE9 2H                | 5HE9 2H                |                       |                    |                    |
|                                                       | STR. SKEW X PAD ELEV.         | -1/2" 35.37            | -1/8" 35.90            | +1/16" 36.66            | -1/16" 37.64           | +3/8" 38.82            |                       |                    |                    |
|                                                       | 10 STRINGER BRG. TYPE         | IHE10 3H               | 2HE10 3H               | 3HE10 2H                | 4HE10 2H               | 5HE10 2H               |                       |                    |                    |
|                                                       | STR. SKEW X PAD ELEV.         | -1/2" 35.28            | -1/16" 35.81           | +1/8" 36.57             | 0" 37.53               | +7/16" 38.86           |                       |                    |                    |
|                                                       | 11 STRINGER BRG. TYPE         |                        | 3HE11 3H               | 4HE11 2H                | 5HE11 2H               |                        |                       |                    |                    |
|                                                       | STR. SKEW X PAD ELEV.         |                        | +1/4" 36.74            | +1/16" 37.42            | +1/2" 38.78            |                        |                       |                    |                    |
|                                                       | 12 STRINGER BRG. TYPE         |                        |                        | 4HE12 3H                | 5HE12 2H               |                        |                       |                    |                    |
|                                                       | STR. SKEW X PAD ELEV.         |                        |                        | +1/8" 37.31             | +3/16" 38.70           |                        |                       |                    |                    |
|                                                       | 13 STRINGER BRG. TYPE         |                        |                        |                         | 5HE13 2H               |                        |                       |                    |                    |
|                                                       | STR. SKEW X PAD ELEV.         |                        |                        |                         | +3/16" 38.61           |                        |                       |                    |                    |
|                                                       | 14 STRINGER BRG. TYPE         |                        |                        |                         | 5HE14 3H               |                        |                       |                    |                    |
|                                                       | STR. SKEW X PAD ELEV.         |                        |                        |                         | +5/8" 38.53            |                        |                       |                    |                    |
| UP STATION & BRGS.                                    | 1 STRINGER BRG. TYPE          | 2HE1 3E                | 3HE1 3E                | 4HE1 3E                 | 5HE1 3E                | 6HE1 3E                | 7HE1 1E               | 2C1 1E             | IHE1 -1/2" 35.65   |
|                                                       | STR. SKEW X PAD ELEV.         | -1/2" 36.15            | -1/2" 36.69            | -1/2" 37.15             | -1/2" 37.53            | 0" 37.93               | +1/16" 38.77          | -1/16" 38.77       |                    |
|                                                       | 2 STRINGER BRG. TYPE          | 2HE2 2E                | 3HE2 2E                | 4HE2 2E                 | 5HE2 2E                | 6HE2 2E                | 7HE2 1E               | 2C2 1E             | IHE2 -1/2" 35.56   |
|                                                       | STR. SKEW X PAD ELEV.         | -7/16" 36.05           | -7/16" 36.60           | -7/16" 37.11            | -7/16" 37.56           | +1/16" 38.04           | +1/8" 38.28           | -1/16" 38.94       |                    |
|                                                       | 3 STRINGER BRG. TYPE          | 2HE3 2E                | 3HE3 2E                | 4HE3 2E                 | 5HE3 2E                | 6HE3 2E                | 7HE3 1E               | 2C3 1E             | IHE3 -1/2" 35.46   |
|                                                       | STR. SKEW X PAD ELEV.         | -7/16" 35.96           | -3/8" 36.51            | -3/8" 37.06             | -7/16" 37.59           | +3/16" 38.15           | +3/16" 38.48          | -1/16" 38.86       |                    |
|                                                       | 4 STRINGER BRG. TYPE          | 2HE4 2E                | 3HE4 2E                | 4HE4 2E                 | 5HE4 2E                | 6HE4 2E                | 7HE4 1E               | 2C4 1E             | IHE4 -1/2" 35.36   |
|                                                       | STR. SKEW X PAD ELEV.         | -3/8" 35.86            | -5/16" 36.42           | -3/8" 37.02             | -3/8" 37.62            | +1/4" 38.26            | +5/16" 38.69          | 0" 38.78           |                    |
|                                                       | 5 STRINGER BRG. TYPE          | 2HE5 2E                | 3HE5 2E                | 4HE5 2E                 | 5HE5 2E                | 6HE5 2E                | 7HE5 1E               | 2C5 1E             | IHE5 -1/2" 35.27   |
|                                                       | STR. SKEW X PAD ELEV.         | -5/16" 35.77           | -4" 36.32              | -5/16" 36.97            | -5/16" 37.65           | +5/16" 38.36           | +3/8" 38.90           | 0" 38.70           |                    |
|                                                       | 6 STRINGER BRG. TYPE          | 2HE6 2E                | 3HE6 2E                | 4HE6 2E                 | 5HE6 2E                | 6HE6 2E                | 7HE6 1E               | 2C6 1E             | IHE6 -1/2" 35.17   |
|                                                       | STR. SKEW X PAD ELEV.         | -1/4" 35.67            | -1/8" 36.23            | -1/4" 36.92             | -1/4" 37.67            | +1/16" 38.47           | +7/16" 38.11          | 0" 38.62           |                    |
|                                                       | 7 STRINGER BRG. TYPE          | 2HE7 2E                | 3HE7 2E                | 4HE7 2E                 | 5HE7 2E                | 6HE7 2E                | 7HE7 1E               |                    | IHE7 -1/2" 35.08   |
|                                                       | STR. SKEW X PAD ELEV.         | -3/16" 35.58           | -1/16" 36.14           | -3/16" 36.78            | -1/4" 37.70            | +1/2" 38.58            | +1/2" 38.31           |                    |                    |
|                                                       | 8 STRINGER BRG. TYPE          | 2HE8 2E                | 3HE8 2E                | 4HE8 2E                 | 5HE8 2E                | 6HE8 2E                | 7HE8 1E               |                    | IHE8 -1/2" 34.98   |
|                                                       | STR. SKEW X PAD ELEV.         | -1/8" 35.48            | 0" 36.06               | -1/8" 36.62             | -3/16" 37.73           | 1/16" 38.69            | +9/16" 38.52          |                    |                    |
|                                                       | 9 STRINGER BRG. TYPE          | 2HE9 2E                | 3HE9 2E                | 4HE9 2E                 | 5HE9 2E                | 6HE9 2E                |                       |                    | IHE9 -1/2" 34.89   |
|                                                       | STR. SKEW X PAD ELEV.         | -1/8" 35.38            | +1/16" 35.98           | -1/16" 36.74            | -1/8" 37.76            | +9/16" 38.82           |                       |                    |                    |
|                                                       | 10 STRINGER BRG. TYPE         | 2HE10 3E               | 3HE10 2E               | 4HE10 2E                | 5HE10 2E               | 6HE10 2E               |                       |                    | IHE10 -1/2" 34.79  |
|                                                       | STR. SKEW X PAD ELEV.         | -1/16" 35.29           | +1/8" 35.90            | 0" 36.66                | -1/16" 37.71           | +9/16" 38.90           |                       |                    |                    |
|                                                       | 11 STRINGER BRG. TYPE         |                        | 3HE11 3E               | 4HE11 2E                | 5HE11 2E               | 6HE11 2E               |                       |                    |                    |
|                                                       | STR. SKEW X PAD ELEV.         |                        | +1/4" 35.81            | +1/16" 36.57            | 0" 37.61               | +5/8" 38.81            |                       |                    |                    |
|                                                       | 12 STRINGER BRG. TYPE         |                        |                        | 4HE12 3E                |                        |                        |                       |                    |                    |
|                                                       | STR. SKEW X PAD ELEV.         |                        |                        | +1/8" 36.48             | Continued at right     | Continued at right     |                       |                    |                    |

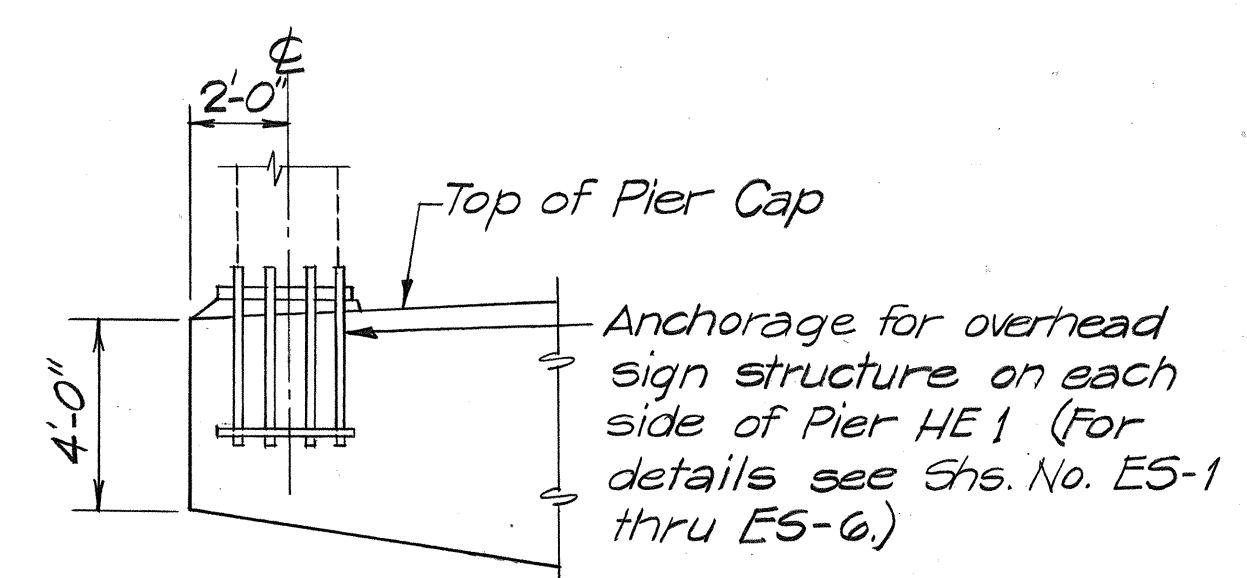


## ANCHORAGE FOR OVERHEAD SIGN E-33 ON PIER HE1

| CONTINUATION OF PIER HE4 UPSTA. & BRGS. |                       |              |  |
|-----------------------------------------|-----------------------|--------------|--|
| 12                                      | STRINGER BRG. TYPE    | 5HE12 2E     |  |
|                                         | STR. SKEW X PAD ELEV. | 0" 37.52     |  |
| 13                                      | STRINGER BRG. TYPE    | 5HE13 2E     |  |
|                                         | STR. SKEW X PAD ELEV. | +1/16" 37.43 |  |
| 14                                      | STRINGER BRG. TYPE    | 5HE14 3E     |  |
|                                         | STR. SKEW X PAD ELEV. | +1/8" 37.33  |  |

| CONTINUATION OF PIER HE5 UPSTA. & BRGS. |                       |             |  |
|-----------------------------------------|-----------------------|-------------|--|
| 12                                      | STRINGER BRG. TYPE    | IC4 2E      |  |
|                                         | STR. SKEW X PAD ELEV. | +5/8" 38.72 |  |
| 13                                      | STRINGER BRG. TYPE    | IC5 2E      |  |
|                                         | STR. SKEW X PAD ELEV. | +5/8" 38.64 |  |
| 14                                      | STRINGER BRG. TYPE    | IC6 3E      |  |
|                                         | STR. SKEW X PAD ELEV. | +5/8" 38.55 |  |

NOTE:  
For Notes and Definition of Str. Skew X,  
See Sheet No. T-11.

| 4/3/84 | Revised Pad Elevations at Pier HE3. |
|--------|-------------------------------------|
| DATE   | REVISION                            |

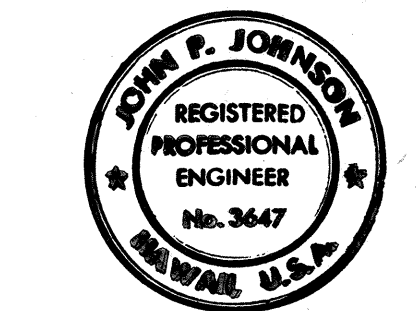

THIS WORK WAS PREPARED BY ME OR UNDER MY SUPERVISION.  
John P. Johnson

STATE OF HAWAII  
DEPARTMENT OF TRANSPORTATION  
HIGHWAYS DIVISION  
H-1 VIADUCT (E.B.), RAMP C & HOV RAMP  
  

### PIER GEOMETRY TABLE


SHEET 2 OF 3  
KEEHI INTERCHANGE  
F.A.I. PROJ. NO. I-HI-1 (168)-17  
SCALE: DATE: 8/17/81  
SHEET NO. T-10 OF T-23 SHEETS



# TABLE OF PIER DIMENSIONS AND ELEVATIONS

| FED. ROAD DIST. NO. | STATE | FED. AID PROJ. NO. | FISCAL YEAR | SHEET NO. | TOTAL SHEETS |
|---------------------|-------|--------------------|-------------|-----------|--------------|
| HAWAII              | HAW.  | I-HI-1 (168) 17    | 1982        | 70        | 145          |


| PIER NAME                                       |                               | HV1                   |             | HV2            |             | HV3            |             | HV4            |           | HV5            |           | HVG            |            | HVO            |           |  |  |  |
|-------------------------------------------------|-------------------------------|-----------------------|-------------|----------------|-------------|----------------|-------------|----------------|-----------|----------------|-----------|----------------|------------|----------------|-----------|--|--|--|
| PIER TYPE                                       |                               | I                     |             | III            |             | III            |             | III            |           | III            |           | (BY OTHERS)    |            | (BY OTHERS)    |           |  |  |  |
| WORK POINT STA. OF & PIER                       |                               | 28+66.05              |             | 29+66.21       |             | 30+66.36       |             | 31+66.52       |           | 32+63.50       |           | 33+42.33       |            | 27+65.89       |           |  |  |  |
| SOUTH AZIMUTH OF & PIER                         |                               | 189°-01'-23.0"        |             | 189°-01'-23.0" |             | 189°-01'-23.0" |             | 189°-01'-23.0" |           | 193°-01'-18.4" |           | 198°-36'-49.6" |            | 189°-01'-23.0" |           |  |  |  |
| CAP                                             | LENGTH OF CAP "A"             | 23'-4"                |             | 23'-4"         |             | 23'-4"         |             | 23'-4"         |           | 23'-4"         |           | 23'-4"         |            |                |           |  |  |  |
|                                                 | DIST. & BRGS. TO & PIER "G"   | 11"                   |             | 11"            |             | 11"            |             | 11"            |           | 11"            |           | 11"            |            |                |           |  |  |  |
|                                                 | DEPTH "V"                     | 6'-0"                 |             | 6'-0"          |             | 6'-0"          |             | 6'-0"          |           | 6'-0"          |           | 6'-0"          |            |                |           |  |  |  |
|                                                 | DIMENSION "F1" DIMENSION "F2" | 2'-0 5/16"            | 2'-0 5/16"  | 2'-0 5/16"     | 2'-0 5/16"  | 2'-0 5/16"     | 2'-0 5/16"  | 2'-0 3/8"      | 2'-0 3/8" | 2'-0 3/8"      | 2'-0 3/8" | 2'-0 3/8"      | 2'-0 3/8"  |                |           |  |  |  |
| COLUMN                                          | DISTANCE "Q" DISTANCE "R"     | 21'-8 3/16"           | 1'-7 13/16" | 21'-8 3/16"    | 1'-7 13/16" | 21'-8 3/16"    | 1'-7 13/16" | 21'-7 1/2"     | 1'-8 1/2" | 21'-7 1/2"     | 1'-8 1/2" | 13'-8 1/2"     | 12'-3 3/8" |                |           |  |  |  |
|                                                 | ELEVATION "H" ELEVATION "J"   | 27.58                 | 27.28       | 23.58          | 23.28       | 19.56          | 19.07       | 16.16          | 14.23     | 13.84          | 12.33     |                |            |                |           |  |  |  |
|                                                 | DIMENSION "K" DIMENSION "E"   | 5'-2"                 | -           | 5'-2"          | -           | 5'-2"          | -           | 5'-2"          | -         | 5'-2"          | -         |                |            |                |           |  |  |  |
|                                                 | BOTTOM WIDTH "L"              | 3'-6"                 |             | 4'-1"          |             | 4'-6"          |             | 4'-11"         |           | 5'-0"          |           |                |            |                |           |  |  |  |
| STRINGER SPACING DISTANCE MEASURED ALONG & PIER | DIMENSION "M" ELEVATION "U"   | 1'-9"                 | 3.50        | 2'-0"          | (6.5) P     | -              | 6.5 (P)     | -              | 6.5 (P)   | -              | 5.5 (P)   |                |            |                |           |  |  |  |
|                                                 | ELEVATION "S" ELEVATION "T"   | 21.50                 | 21.36       | 17.50          | 17.37       | 13.43          | 13.22       | 9.82           | 9.40      | 7.42           | 6.75      |                |            |                |           |  |  |  |
|                                                 | DOWN STA. 1 UP STA. 1         | 6'-5 1/8"             | 6'-5 1/8"   | 6'-5 1/8"      | 6'-5 1/8"   | 6'-5 1/8"      | 6'-5 1/8"   | 5'-11"         | 5'-11"    | 5'-11"         | 5'-11"    | 6'-1"          |            |                | 6'-5 1/8" |  |  |  |
|                                                 | DOWN STA. 2 UP STA. 2         |                       |             |                |             |                |             |                |           |                |           |                |            |                |           |  |  |  |
| DOWN STATION & BRGS.                            | DOWN STA. 3 UP STA. 3         |                       |             |                |             |                |             |                |           |                |           |                |            |                |           |  |  |  |
|                                                 | DOWN STA. 4 UP STA. 4         | 6'-5 1/8"             | 6'-5 1/8"   | 6'-5 1/8"      | 6'-5 1/8"   | 6'-5 1/8"      | 6'-5 1/8"   | 5'-11"         | 5'-11"    | 5'-11"         | 5'-11"    | 6'-1"          |            |                | 6'-5 1/8" |  |  |  |
|                                                 | DOWN STA. 5 UP STA. 5         |                       |             |                |             |                |             |                |           |                |           |                |            |                |           |  |  |  |
|                                                 | DOWN STA. 6 UP STA. 6         |                       |             |                |             |                |             |                |           |                |           |                |            |                |           |  |  |  |
|                                                 | DOWN STA. 7 UP STA. 7         |                       |             |                |             |                |             |                |           |                |           |                |            |                |           |  |  |  |
|                                                 | DOWN STA. 8 UP STA. 8         |                       |             |                |             |                |             |                |           |                |           |                |            |                |           |  |  |  |
|                                                 | DOWN STA. 9 UP STA. 9         |                       |             |                |             |                |             |                |           |                |           |                |            |                |           |  |  |  |
|                                                 | DOWN STA. 10 UP STA. 10       |                       |             |                |             |                |             |                |           |                |           |                |            |                |           |  |  |  |
|                                                 | DOWN STA. 11 UP STA. 11       |                       |             |                |             |                |             |                |           |                |           |                |            |                |           |  |  |  |
|                                                 | DOWN STA. 12 UP STA. 12       |                       |             |                |             |                |             |                |           |                |           |                |            |                |           |  |  |  |
|                                                 | DOWN STA. 13 UP STA. 13       |                       |             |                |             |                |             |                |           |                |           |                |            |                |           |  |  |  |
|                                                 | DOWN STA. 14 UP STA. 14       |                       |             |                |             |                |             |                |           |                |           |                |            |                |           |  |  |  |
|                                                 | UP STATION & BRGS.            | 1 STRINGER BRG. TYPE  | 1HV1        | 3H             | 2HV1        | 3H             | 3HV1        | 3H             | 4HV1      | 3H             | 5HV1      | 3H             | 6HV1       | 3H             |           |  |  |  |
|                                                 |                               | STR. SKEW X PAD ELEV. | -1 1/16"    | 28.07          | -1 1/16"    | 23.94          | -1 1/16"    | 20.08          | -1 1/16"  | 16.63          | -1 1/16"  | 14.11          | -9 1/16"   | 13.17          |           |  |  |  |
| 2 STRINGER BRG. TYPE                            |                               | 1HV2                  | 2H          | 2HV2           | 2H          | 3HV2           | 2H          | 4HV2           | 2H        | 5HV2           | 2H        | 6HV2           | 2H         |                |           |  |  |  |
| STR. SKEW X PAD ELEV.                           |                               | -1 1/16"              | 27.98       | -1 1/16"       | 23.86       | -1 1/16"       | 19.95       | -3 1/16"       | 16.33     | -1 1/16"       | 13.72     | -9 1/16"       | 12.78      |                |           |  |  |  |
| 3 STRINGER BRG. TYPE                            |                               | 1HV3                  | 2H          | 2HV3           | 2H          | 3HV3           | 2H          | 4HV3           | 2H        | 5HV3           | 2H        | 6HV3           | 2H         |                |           |  |  |  |
| STR. SKEW X PAD ELEV.                           |                               | -1 1/16"              | 27.90       | -1 1/16"       | 23.78       | -1 1/16"       | 19.82       | -13 1/16"      | 16.02     | -1 1/16"       | 13.34     | -12"           | 12.38      |                |           |  |  |  |
| 4 STRINGER BRG. TYPE                            |                               | 1HV4                  | 3H          | 2HV4           | 3H          | 3HV4           | 3H          | 4HV4           | 3H        | 5HV4           | 3H        | 6HV4           | 3H         |                |           |  |  |  |
| STR. SKEW X PAD ELEV.                           |                               | -1 1/16"              | 27.82       | -1 1/16"       | 23.69       | -1 1/16"       | 19.69       | -7 8"          | 15.71     | -1 1/16"       | 12.26     | -12"           | 11.22      |                |           |  |  |  |
| 5 STRINGER BRG. TYPE                            |                               |                       |             |                |             |                |             |                |           |                |           |                |            |                |           |  |  |  |
| STR. SKEW X PAD ELEV.                           |                               |                       |             |                |             |                |             |                |           |                |           |                |            |                |           |  |  |  |
| 6 STRINGER BRG. TYPE                            |                               |                       |             |                |             |                |             |                |           |                |           |                |            |                |           |  |  |  |
| STR. SKEW X PAD ELEV.                           |                               |                       |             |                |             |                |             |                |           |                |           |                |            |                |           |  |  |  |
| 7 STRINGER BRG. TYPE                            |                               |                       |             |                |             |                |             |                |           |                |           |                |            |                |           |  |  |  |
| STR. SKEW X PAD ELEV.                           |                               |                       |             |                |             |                |             |                |           |                |           |                |            |                |           |  |  |  |
| 8 STRINGER BRG. TYPE                            |                               |                       |             |                |             |                |             |                |           |                |           |                |            |                |           |  |  |  |
| STR. SKEW X PAD ELEV.                           |                               |                       |             |                |             |                |             |                |           |                |           |                |            |                |           |  |  |  |
| 9 STRINGER BRG. TYPE                            |                               |                       |             |                |             |                |             |                |           |                |           |                |            |                |           |  |  |  |
| STR. SKEW X PAD ELEV.                           |                               |                       |             |                |             |                |             |                |           |                |           |                |            |                |           |  |  |  |
| 10 STRINGER BRG. TYPE                           |                               |                       |             |                |             |                |             |                |           |                |           |                |            |                |           |  |  |  |
| STR. SKEW X PAD ELEV.                           |                               |                       |             |                |             |                |             |                |           |                |           |                |            |                |           |  |  |  |
| 11 STRINGER BRG. TYPE                           |                               |                       |             |                |             |                |             |                |           |                |           |                |            |                |           |  |  |  |
| STR. SKEW X PAD ELEV.                           |                               |                       |             |                |             |                |             |                |           |                |           |                |            |                |           |  |  |  |
| 12 STRINGER BRG. TYPE                           |                               |                       |             |                |             |                |             |                |           |                |           |                |            |                |           |  |  |  |
| STR. SKEW X PAD ELEV.                           |                               |                       |             |                |             |                |             |                |           |                |           |                |            |                |           |  |  |  |
| 13 STRINGER BRG. TYPE                           |                               |                       |             |                |             |                |             |                |           |                |           |                |            |                |           |  |  |  |
| STR. SKEW X PAD ELEV.                           |                               |                       |             |                |             |                |             |                |           |                |           |                |            |                |           |  |  |  |
| 14 STRINGER BRG. TYPE                           |                               |                       |             |                |             |                |             |                |           |                |           |                |            |                |           |  |  |  |
| STR. SKEW X PAD ELEV.                           |                               |                       |             |                |             |                |             |                |           |                |           |                |            |                |           |  |  |  |
| UP STATION & BRGS.                              | 1 STRINGER BRG. TYPE          | 2HV1                  | 3E          | 3HV1           | 3E          | 4HV1           | 3E          | 5HV1           | 3E        | 6HV1           | 3E        | 7HV1           | 3E         | 1HV1           |           |  |  |  |
|                                                 | STR. SKEW X PAD ELEV.         | -1 1/16"              | 27.87       | -1 1/16"       | 23.87       | -1 1/16"       | 19.84       | +3 1/16"       | 16.43     | +9 1/16"       | 14.28     | +9 1/16"       | 13.22      | -1 1/16"       | 31.35     |  |  |  |
|                                                 | 2 STRINGER BRG. TYPE          | 2HV2                  | 2E          | 3HV2           | 2E          | 4HV2           | 2E          | 5HV2           | 2E        | 6HV2           | 2E        | 7HV2           | 2E         | 1HV2           |           |  |  |  |
|                                                 | STR. SKEW X PAD ELEV.         | -1 1/16"              | 27.79       | -1 1/16"       | 23.78       | -3 1/16"       | 19.70       | +3 1/16"       | 16.12     | +5 8"          | 13.90     | +9 1/16"       | 12.83      | -1 1/16"       | 31.26     |  |  |  |
|                                                 | 3 STRINGER BRG. TYPE          | 2HV3                  | 2E          | 3HV3           | 2E          | 4HV3           | 2E          | 5HV3           | 2E        | 6HV3           | 2E        | 7HV3           | 2E         | 1HV3           |           |  |  |  |
|                                                 | STR. SKEW X PAD ELEV.         | -1 1/16"              | 27.71       | -1 1/16"       | 23.70       | -13 1/16"      | 19.57       | +3 1/16"       | 15.81     | +5 8"          | 13.51     | +9 1/16"       | 12.43      | -1 1/16"       | 31.17     |  |  |  |
|                                                 | 4 STRINGER BRG. TYPE          | 2HV4                  | 3E          | 3HV4           | 3E          | 4HV4           | 3E          | 5HV4           | 3E        | 6HV4           | 3E        | 7HV4           | 3E         | 1HV4           |           |  |  |  |
|                                                 | STR. SKEW X PAD ELEV.         | -1 1/16"              | 27.62       | -1 1/16"       | 23.62       | -7 8"          | 19.44       | +3 1/16"       | 15.50     | +5 8"          | 13.13     | +9 1/16"       | 12.03      | -1 1/16"       | 31.09     |  |  |  |
|                                                 | 5 STRINGER BRG. TYPE          |                       |             |                |             |                |             |                |           |                |           |                |            |                |           |  |  |  |
|                                                 | STR. SKEW X PAD ELEV.         |                       |             |                |             |                |             |                |           |                |           |                |            |                |           |  |  |  |
|                                                 | 6 STRINGER BRG. TYPE          |                       |             |                |             |                |             |                |           |                |           |                |            |                |           |  |  |  |
|                                                 | STR. SKEW X PAD ELEV.         |                       |             |                |             |                |             |                |           |                |           |                |            |                |           |  |  |  |
| 7 STRINGER BRG. TYPE                            |                               |                       |             |                |             |                |             |                |           |                |           |                |            |                |           |  |  |  |
| STR. SKEW X PAD ELEV.                           |                               |                       |             |                |             |                |             |                |           |                |           |                |            |                |           |  |  |  |
| 8 STRINGER BRG. TYPE                            |                               |                       |             |                |             |                |             |                |           |                |           |                |            |                |           |  |  |  |
| STR. SKEW X PAD ELEV.                           |                               |                       |             |                |             |                |             |                |           |                |           |                |            |                |           |  |  |  |
| 9 STRINGER BRG. TYPE                            |                               |                       |             |                |             |                |             |                |           |                |           |                |            |                |           |  |  |  |
| STR. SKEW X PAD ELEV.                           |                               |                       |             |                |             |                |             |                |           |                |           |                |            |                |           |  |  |  |
| 10 STRINGER BRG. TYPE                           |                               |                       |             |                |             |                |             |                |           |                |           |                |            |                |           |  |  |  |
| STR. SKEW X PAD ELEV.                           |                               |                       |             |                |             |                |             |                |           |                |           |                |            |                |           |  |  |  |
| 11 STRINGER BRG. TYPE                           |                               |                       |             |                |             |                |             |                |           |                |           |                |            |                |           |  |  |  |
| STR. SKEW X PAD ELEV.                           |                               |                       |             |                |             |                |             |                |           |                |           |                |            |                |           |  |  |  |
| 12 STRINGER BRG. TYPE                           |                               |                       |             |                |             |                |             |                |           |                |           |                |            |                |           |  |  |  |
| STR. SKEW X PAD ELEV.                           |                               |                       |             |                |             |                |             |                |           |                |           |                |            |                |           |  |  |  |

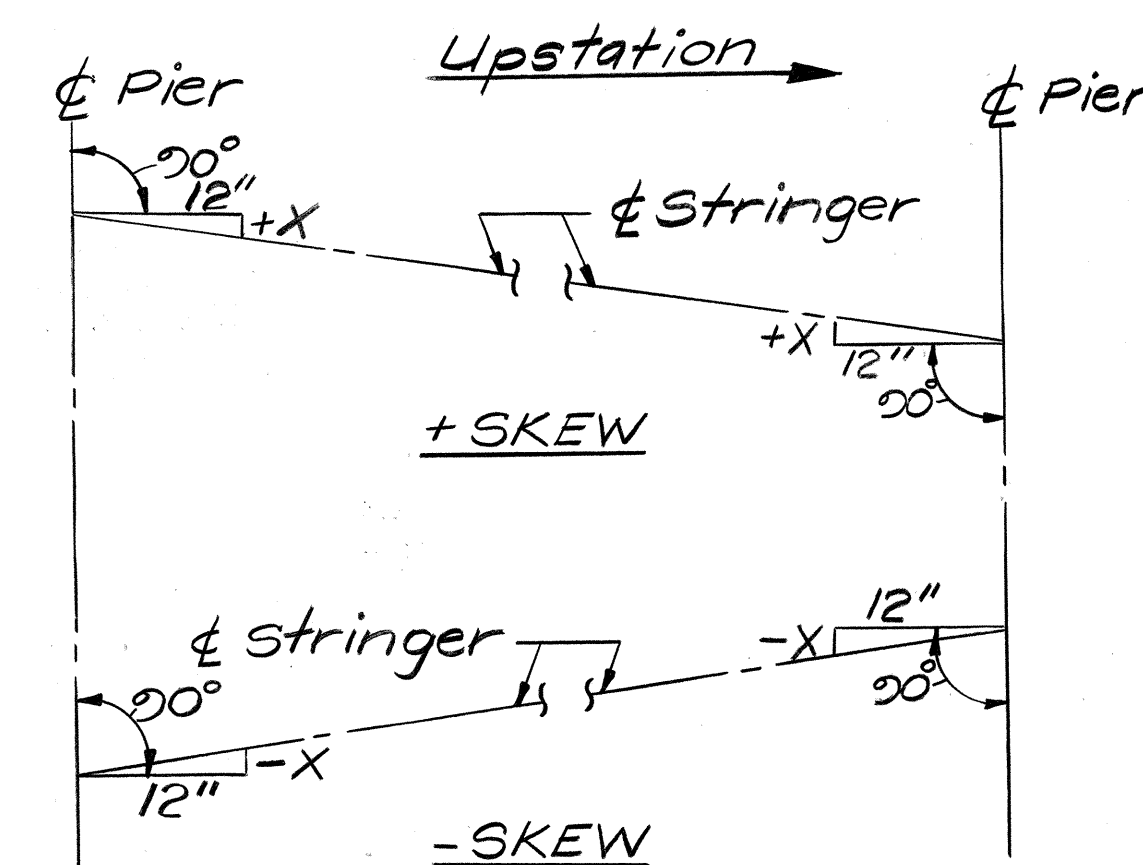

## STRINGER SKEW X

### NOTES:

- (P) indicates that Elevation is given at top of column pedestal. For details, see Sheet No. T-9.
- The words 'Beam' and 'stringer' are used interchangeably.
- Pad Elevations shown in Table are Concrete Seat Elevations.

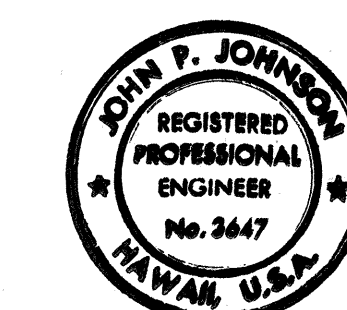

THIS WORK WAS PREPARED BY ME OR UNDER MY SUPERVISION.

John P. Johnson

STATE OF HAWAII  
DEPARTMENT OF TRANSPORTATION  
HIGHWAYS DIVISION  
H-1 VIADUCT (E.B.) RAMP C & HOV RAMP

PIER GEOMETRY TABLE  
SHEET 3 OF 3

KEEHI INTERCHANGE  
F.A.I. PROJ. NO. I-HI-1 (168) 17

SCALE: \_\_\_\_\_ DATE: 8/17/81

SHEET NO. T-II OF T-23 SHEETS








| FED. ROAD DIST. NO. | STATE | FED. AID PROJ. NO. | FISCAL YEAR | SHEET NO. | TOTAL SHEETS |
|---------------------|-------|--------------------|-------------|-----------|--------------|
| HAWAII              | HAW.  | 1-HI-1(168):17     | 1982        | 72        | 145          |


REINFORCEMENT SCHEDULE

| PIER NAME         |       | HVI  |     |      |        | HV2  |     |      |        | HV3  |     |      |        | HV4  |     |      |        | HV5  |     |      |        |      |     |      |        |
|-------------------|-------|------|-----|------|--------|------|-----|------|--------|------|-----|------|--------|------|-----|------|--------|------|-----|------|--------|------|-----|------|--------|
| DESCRIPTION       |       | SIZE | NO. | SPG. | LENGTH | SIZE | NO. | SPG. | LENGTH | SIZE | NO. | SPG. | LENGTH | SIZE | NO. | SPG. | LENGTH | SIZE | NO. | SPG. | LENGTH | SIZE | NO. | SPG. | LENGTH |
| CAP<br>MAIN BARS  | a Bar | 9    | 12* | —    | —      | 9    | 12* | —    | —      | 9    | 12* | —    | —      | 9    | 12* | —    | —      | 9    | 12* | —    | —      |      |     |      |        |
|                   | a1 "  |      |     |                   | b "   |      |     |                   | d "   |      |     | CAP-OTHER BARS    | e "   | 5    | 12  | —    | —      | 5    | 12  | —    | —      | 5    | 12  | —    | —      | 5    | 12  | —    | —      | 5    | 12  | —    | —      |      |     |      |        |
|                   | f "   | 5    | 12  | —    | —      | 5    | 12  | —    | —      | 5    | 12  | —    | —      | 5    | 12  | —    | —      | 5    | 12  | —    | —      |      |     |      |        |
|                   | g "   | 5    | 8   | —    | —      | 5    | 8   | —    | —      | 5    | 8   | —    | —      | 5    | 8   | —    | —      | 5    | 8   | —    | —      |      |     |      |        |
|                   | h "   | 5    | 12  | —    | —      | 5    | 12  | —    | —      | 5    | 12  | —    | —      | 5    | 12  | —    | —      | 5    | 12  | —    | —      |      |     |      |        |
|                   | h1 "  |      |     |                   | h2 "  |      |     |                   | j "   |      |     |                   | j1 "  | 5    | 42  | 12"  | —      | 5    | 42  | 12"  | —      | 5    | 42  | 12"  | —      | 5    | 42  | 12"  | —      | 5    | 42  | 12"  | —      |      |     |      |        |
|                   | j2 "  |      |     |                   | j3 "  |      |     | COL.<br>REIN.     | l "   |      |     |                   | m "   | 11   | 26  | —    | —      | 8    | 38  | —    | —      | 8    | 46  | —    | —      | 8    | 46  | —    | —      | 6    | 46  | —    |        |      |     |      |        |
| FOOTING REIN.     | q "   |      |     |                   | r "   | 9    | 23  | —    |        | 5    | 18  | —    |        | 5    | 24  | —    |        | 5    | 24  | —    |        | 5    | 24  | —    |        |      |     |      |        |
|                   | s "   | 9    | 32  | —    |        | 9    | 24  | —    |        | 10   | 32  | —    |        | 10   | 32  | —    |        | 10   | 32  | —    |        |      |     |      |        |
|                   | t "   |      |     |                   | u "   | 5    | 18  | —    |        | 5    | 18  | —    |        | 5    | 24  | —    |        | 5    | 24  | —    |        | 5    | 24  | —    |        |      |     |      |        |
| PEDESTAL<br>REIN. | v "   | 5    | 18  | —    |        | 5    | 18  | —    |        | 5    | 18  | —    |        | 5    | 18  | —    |        | 5    | 18  | —    |        |      |     |      |        |
|                   | w "   |      |     |      |        | 8    | 60  | —    | —      | 8    | 60  | —    | —      | 8    | 60  | —    | —      | 8    | 60  | —    |        |      |     |      |        |


NOTE:  
For Notes see Sheet No. T-12.  
\* Indicates bars to be placed in bundles of two. (---)

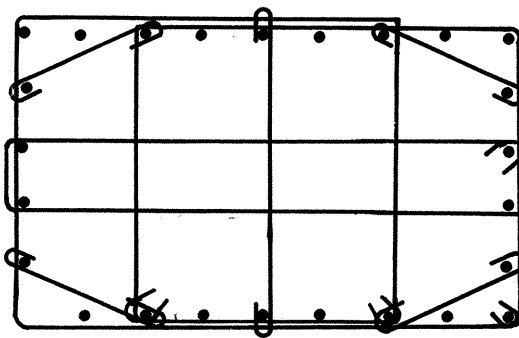

26 BARS

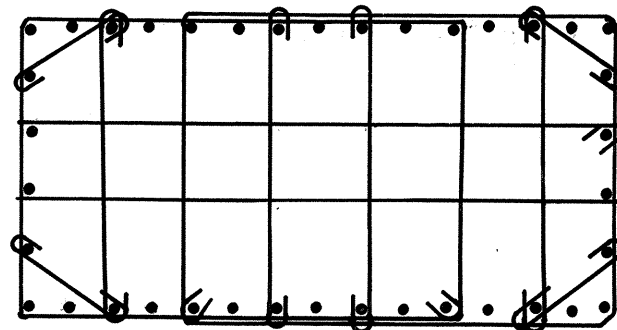


38 BARS

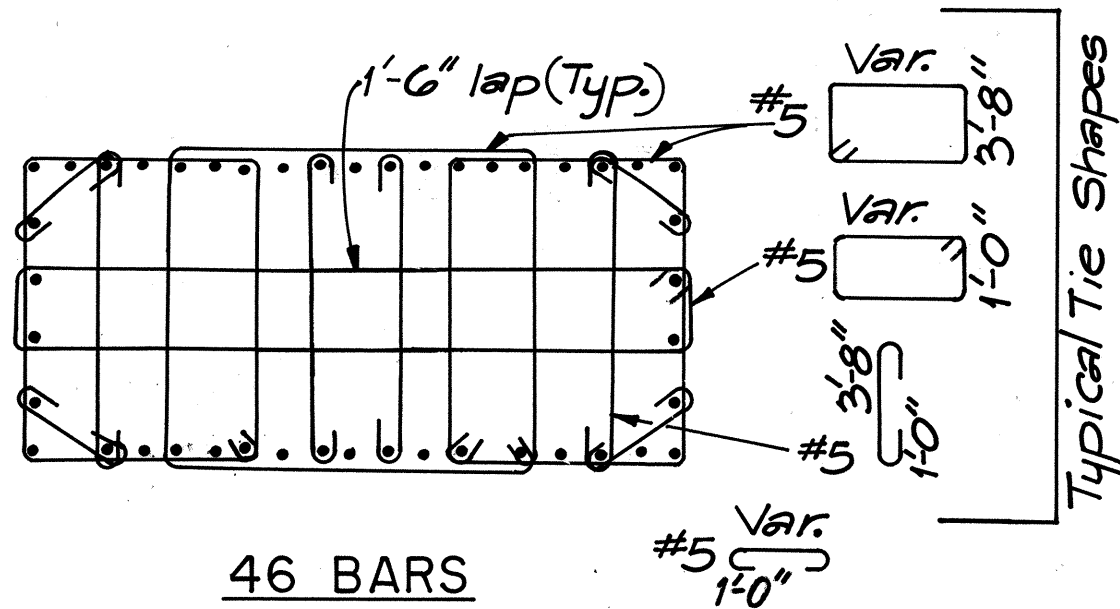


46 BARS

COLUMN TIE PATTERNS  
N.T.S.

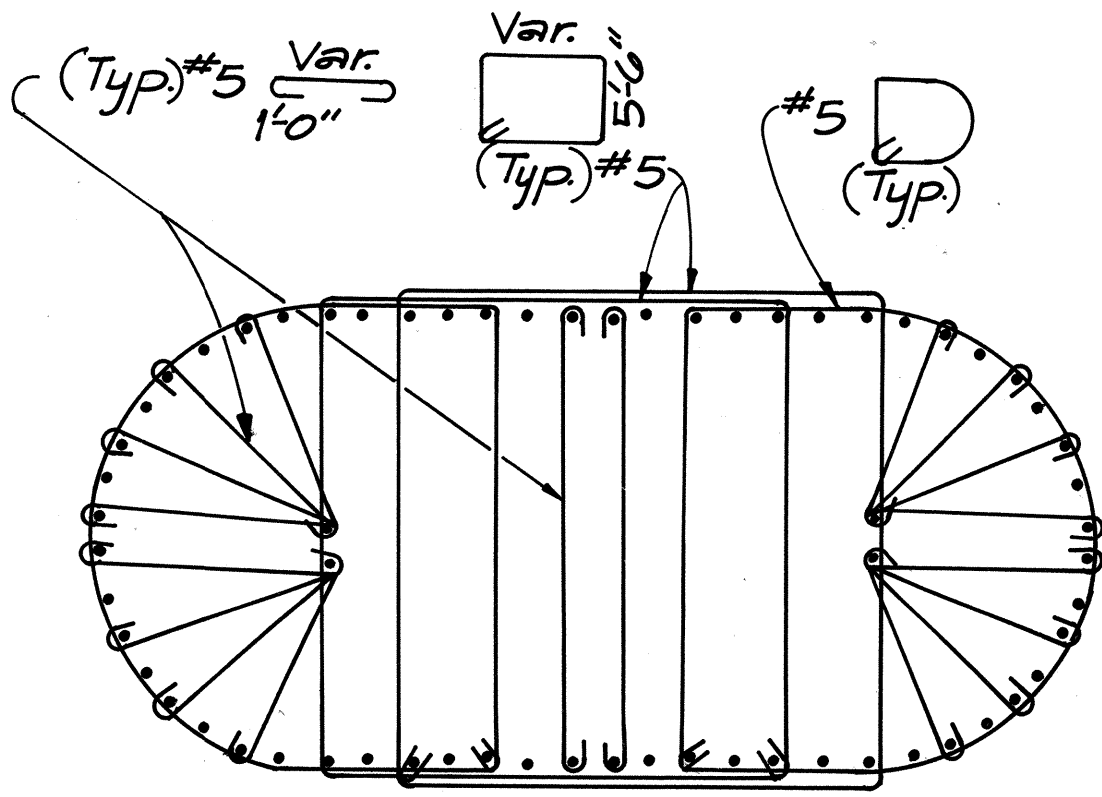

60 BARS

PEDESTAL TIE PATTERNS  
N.T.S.

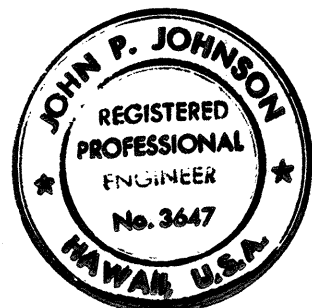

THIS WORK WAS PREPARED BY  
ME OR UNDER MY SUPERVISION.  
John P. Johnson

STATE OF HAWAII  
DEPARTMENT OF TRANSPORTATION  
LAND TRANSPORTATION FACILITIES DIVISION  
H-1 VIADUCT (E.B.), RAMP C & HOV RAMP

PIER REINFORCEMENT  
SCHEDULE  
SHEET 2 OF 2  
KEEHI INTERCHANGE  
F.A.I. PROJ. NO. 1-HI-1 (168):17



SCALE: — DATE: 8/17/81  
SHEET NO. T-13 OF T-23 SHEETS








| FED. ROAD DIST. NO. | STATE | FED. AID PROJ. NO. | FISCAL YEAR | SHEET NO. | TOTAL SHEETS |
|---------------------|-------|--------------------|-------------|-----------|--------------|
| HAWAII              | HAW.  | J-HI-1(168)-17     | 1982        | 74        | 145          |

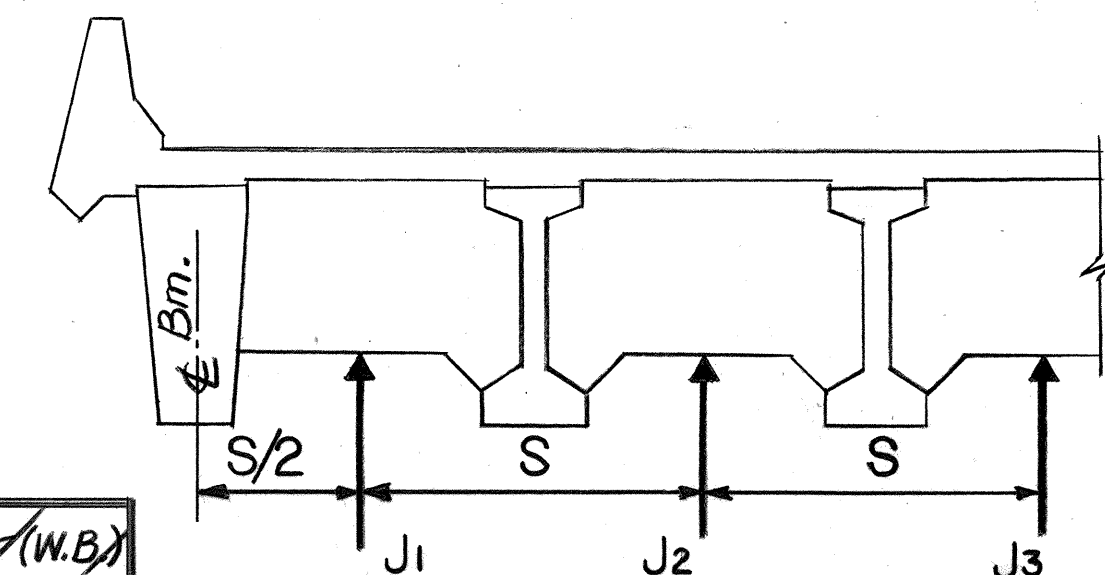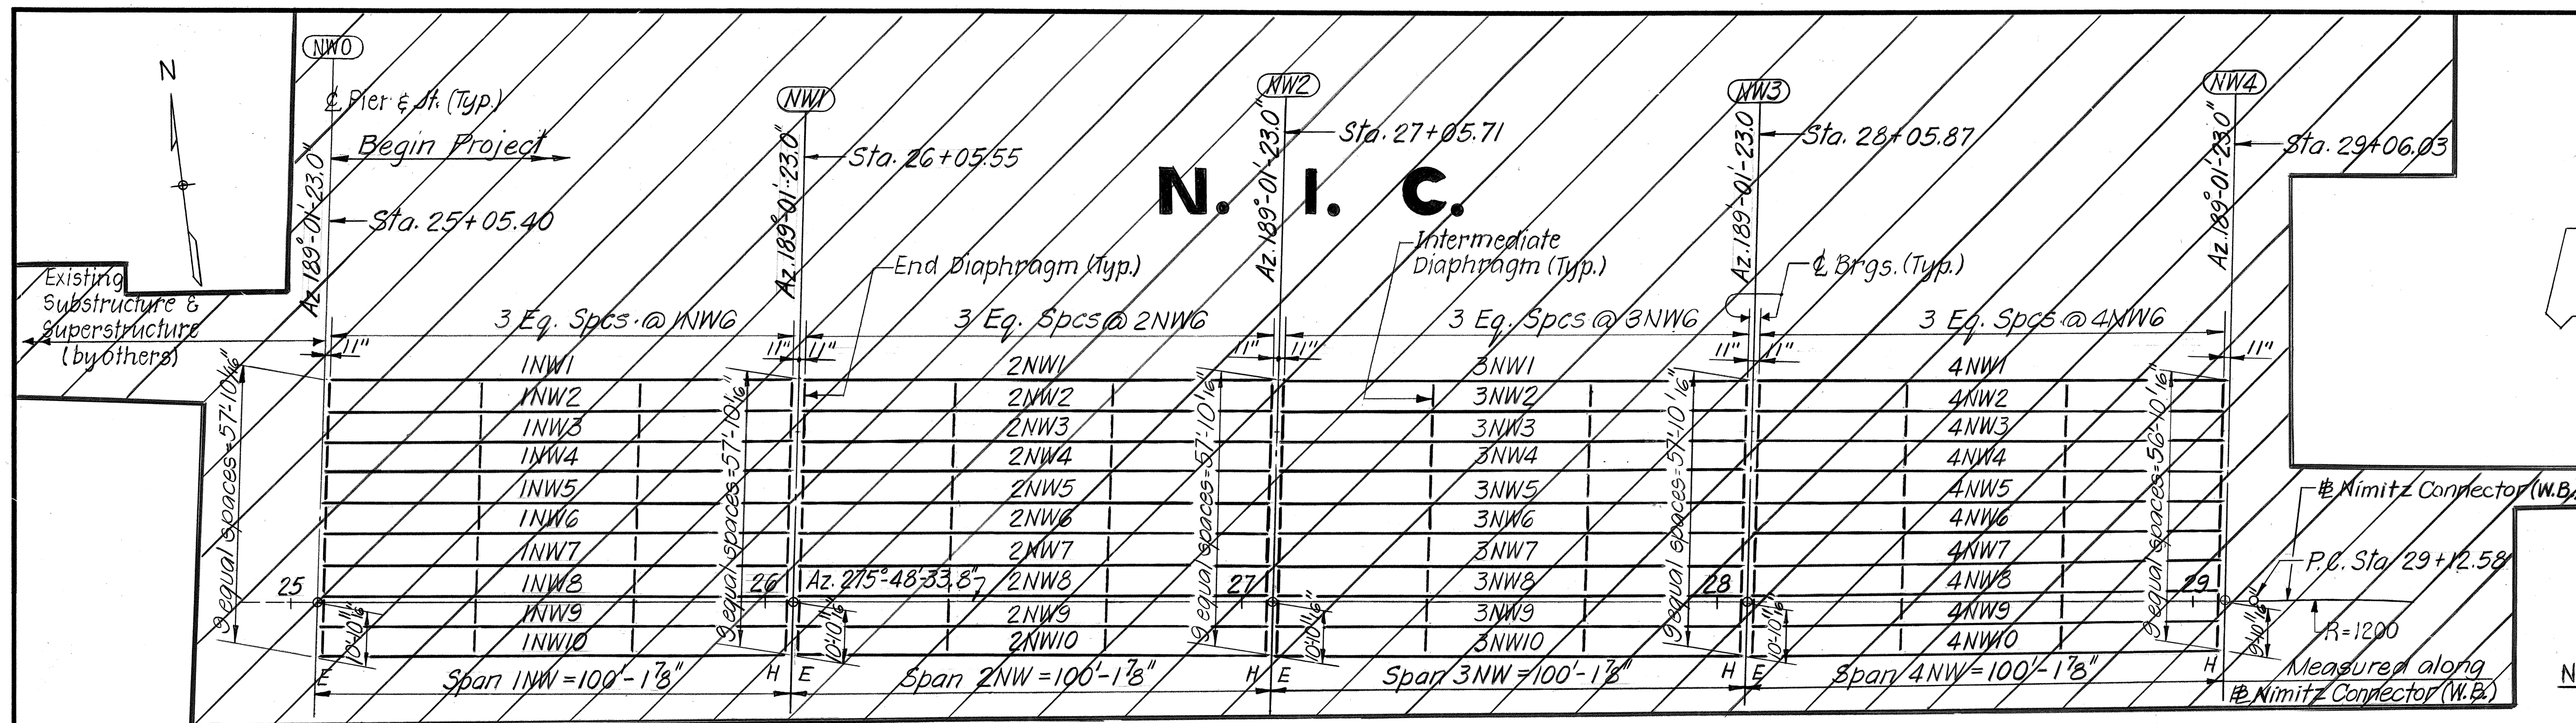

TYPICAL FUTURE JACKING DIAGRAM  
N.T.S. (NOT IN CONTRACT)

LEGEND: J=Jacking Force  
S=Beam Spacing

Note: Place jacks under the end diaphragms as shown above for any lifting of the superstructure.


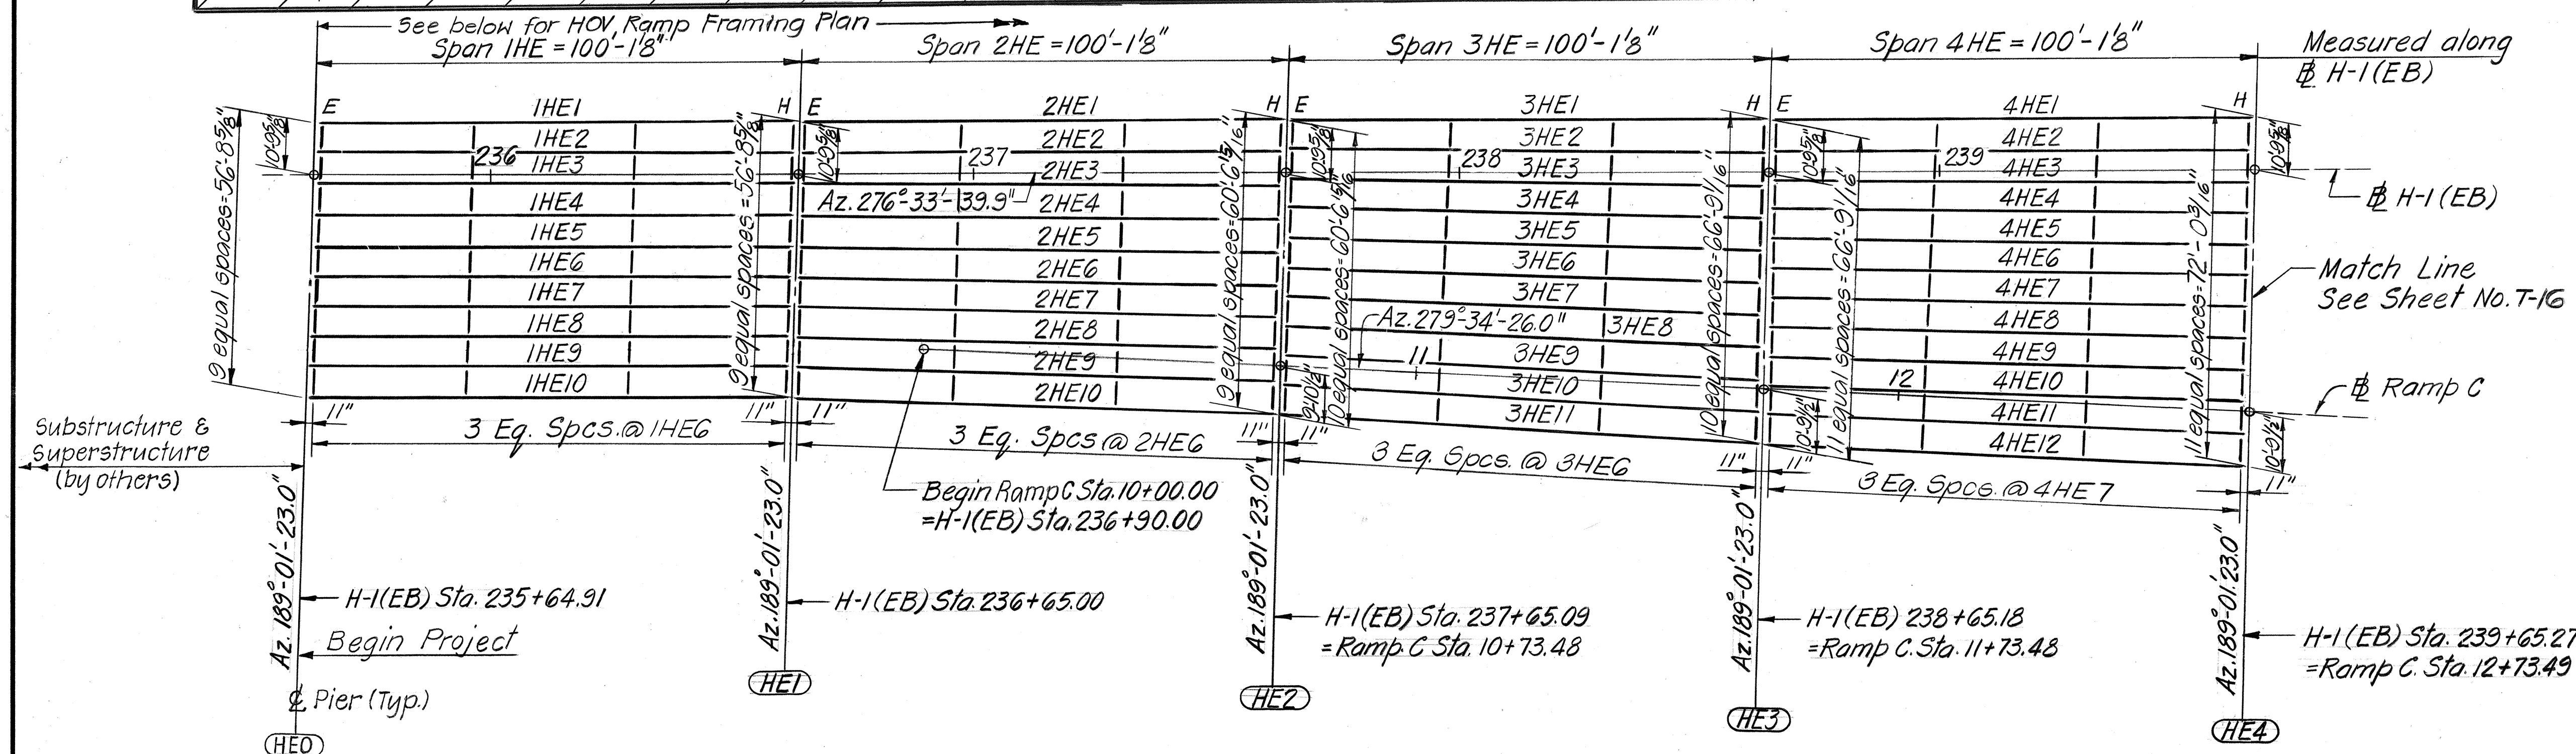


NOTES:

1. All Azimuths are measured from the South.
2. The  $\phi$ s of the Bearings are parallel to the  $\phi$ s of the Piers.
3. Diaphragms shall be parallel to downstation Pier unless noted.

LEGEND:

H=Hinge Bearings  
E=Expansion Bearings

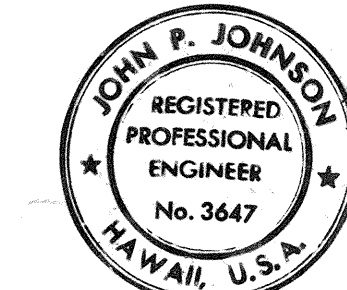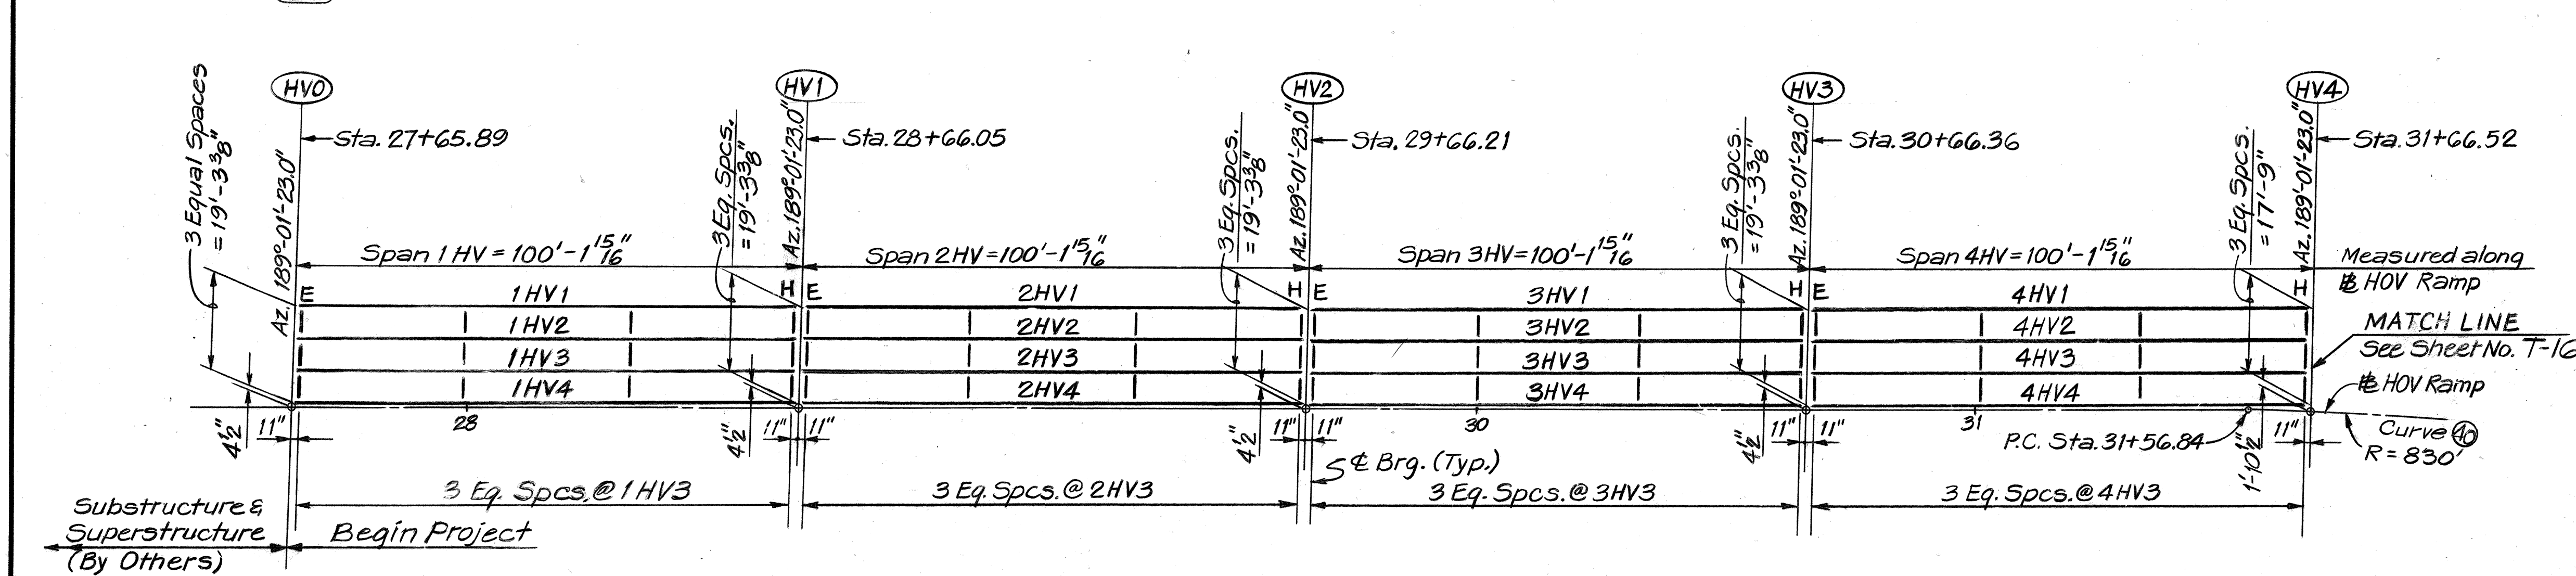

THIS WORK WAS PREPARED BY ME OR UNDER MY SUPERVISION.  
John P. Johnson


STATE OF HAWAII  
DEPARTMENT OF TRANSPORTATION  
HIGHWAYS DIVISION  
H-I VIADUCT (E.B.), RAMP C & HOV RAMP

**FRAMING PLAN**  
SHEET 1 OF 2


KEEHI INTERCHANGE  
F.A.I. PROJ. NO. I-HI-1(168)-17  
SCALE: 1"=20'-0" DATE: 8/17/81  
SHEET NO. T-15 OF T-23 SHEETS



| FED. ROAD DIST. NO. | STATE | FED. AID PROJ. NO. | FISCAL YEAR | SHEET NO. | TOTAL SHEETS |
|---------------------|-------|--------------------|-------------|-----------|--------------|
| HAWAII              | HAW.  | 1-HI-1(168)-17     | 1982        | 75        | 145          |

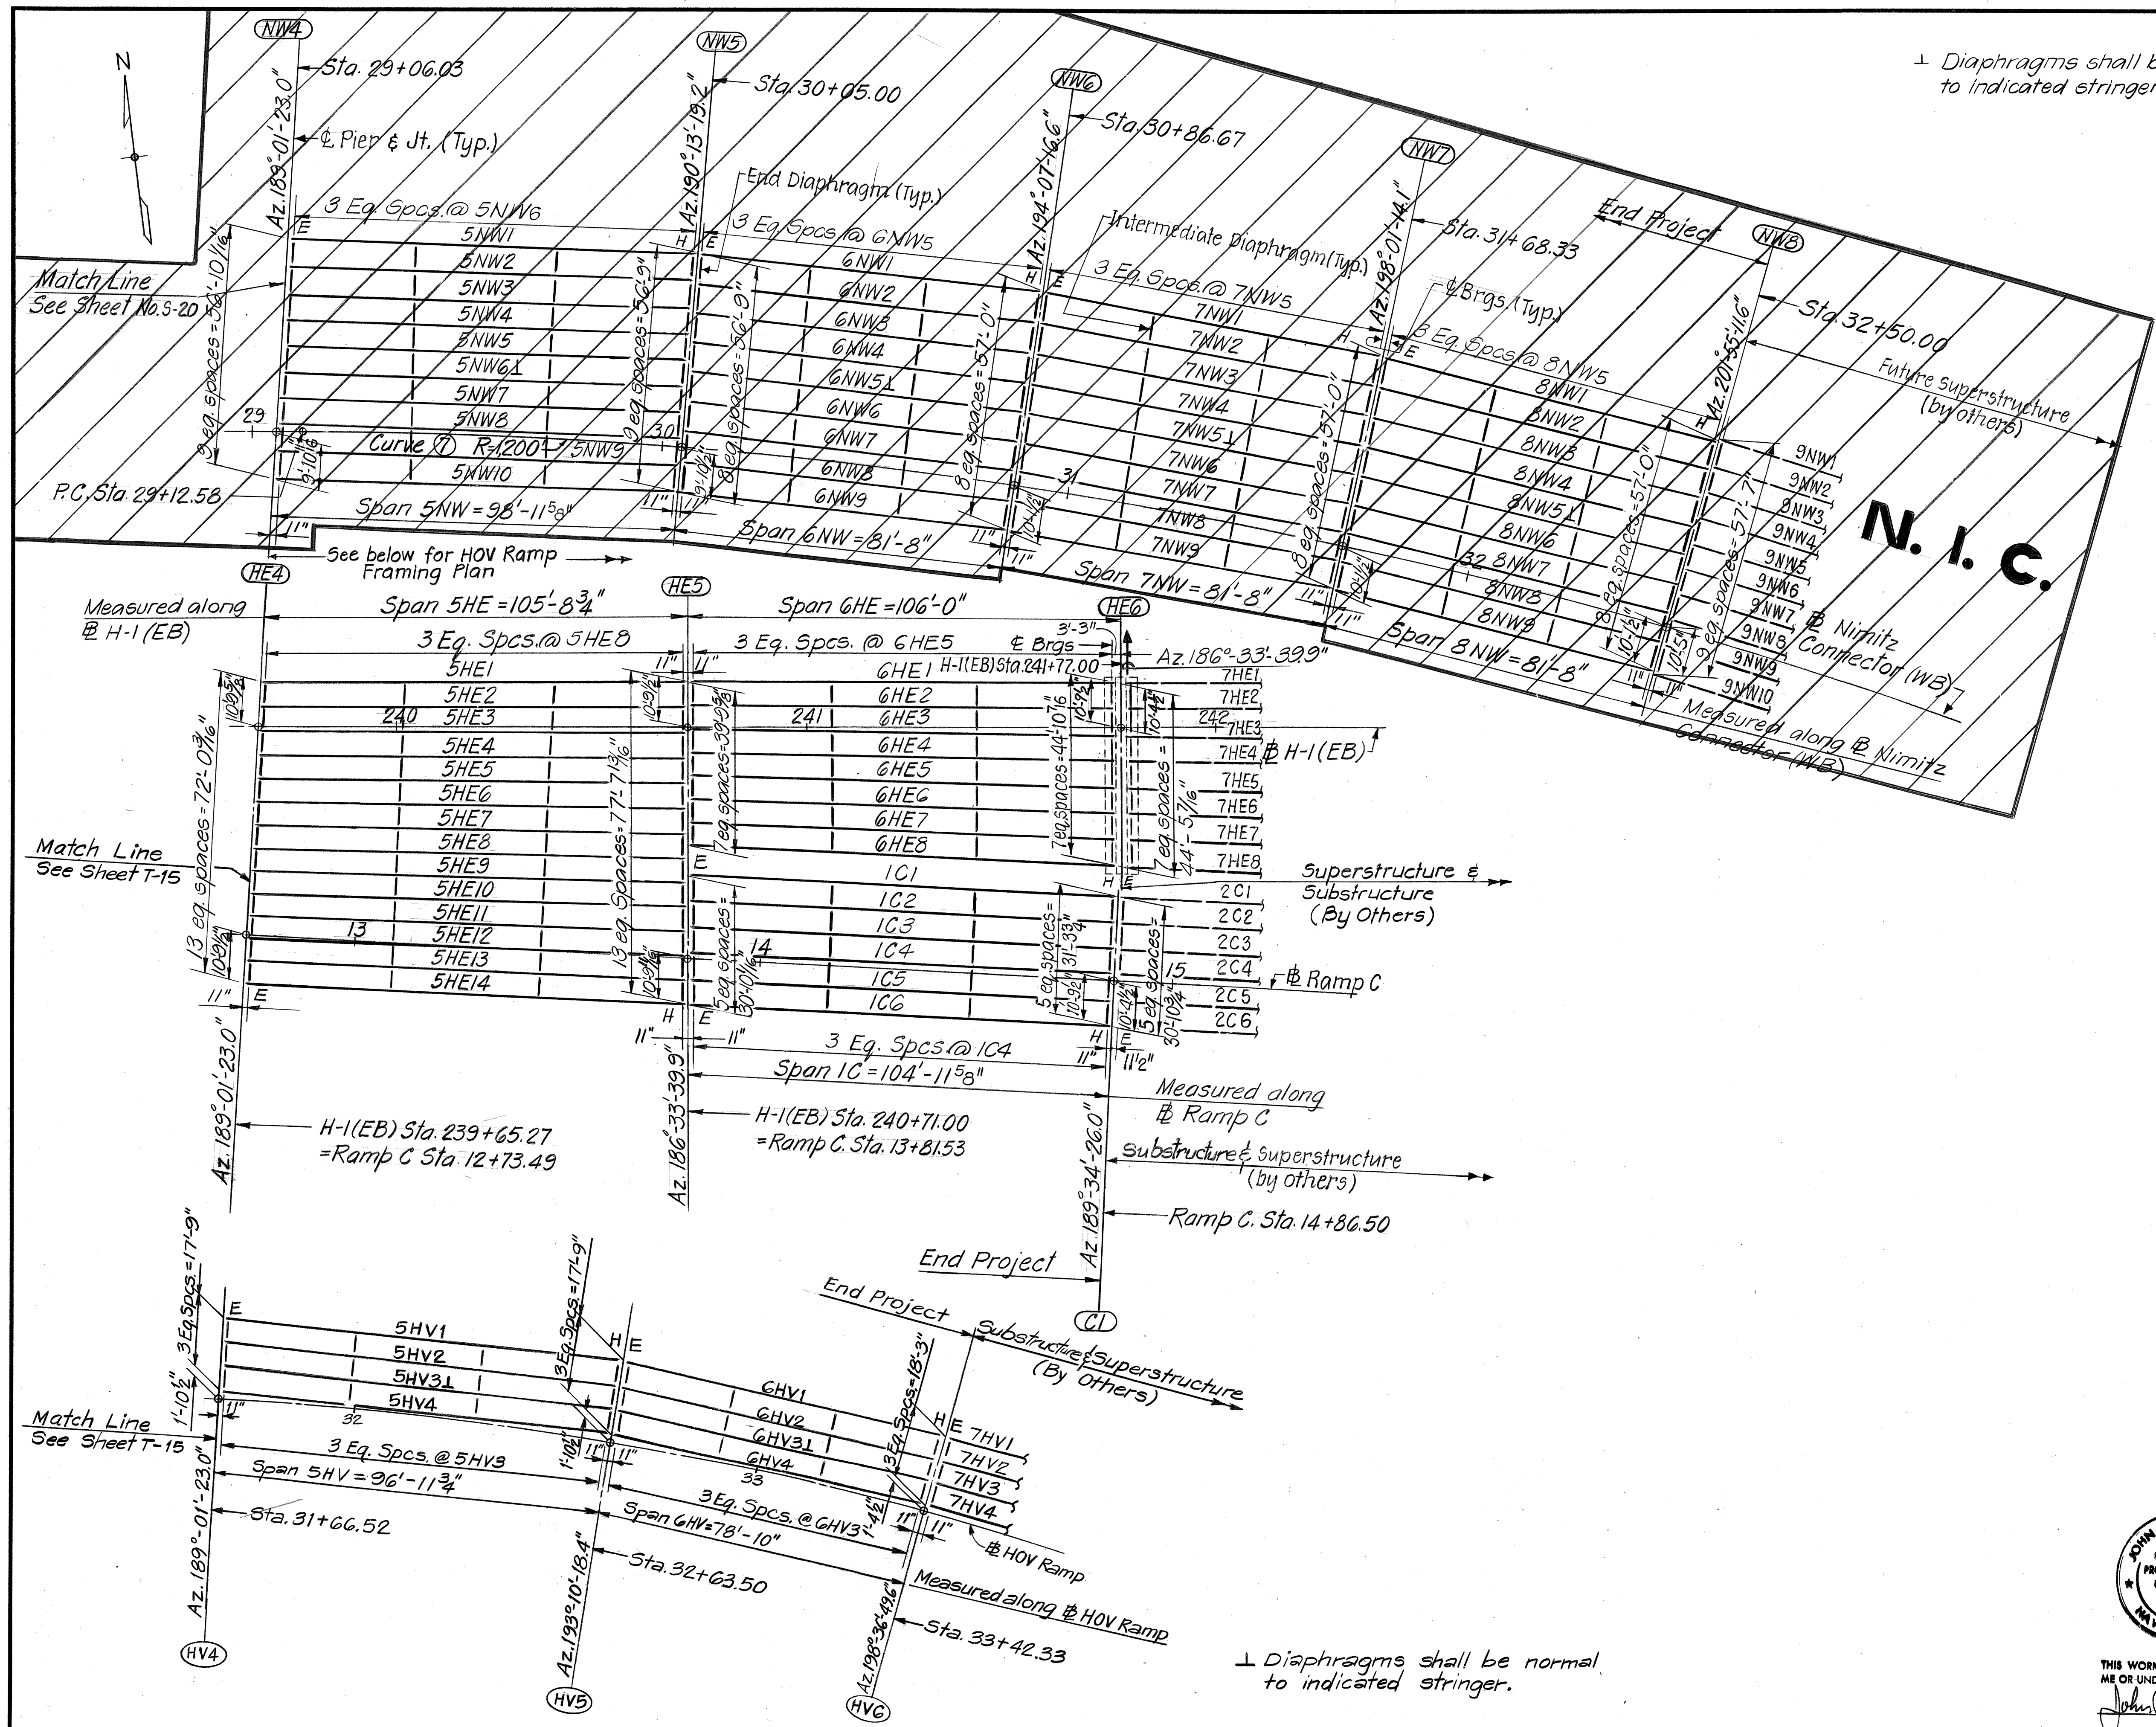

- NOTES:
1. For Notes & Legend see Sheet No. T-15.
  2. For Future Jacking Diagram see Sheet No. T-15.

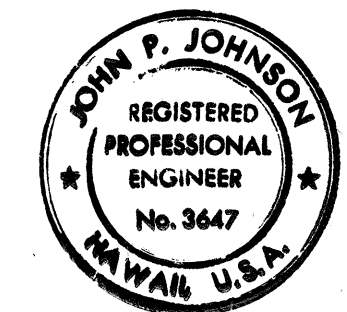

THIS WORK WAS PREPARED BY ME OR UNDER MY SUPERVISION.  
 John P. Johnson

STATE OF HAWAII  
 DEPARTMENT OF TRANSPORTATION  
 HIGHWAYS DIVISION  
 H-1 VIADUCT (E.B.), RAMP C & HOV RAMP

**FRAMING PLAN**  
 SHEET 2 OF 2

KEEHI INTERCHANGE  
 F.A.I. PROJ. NO. 1-HI-1 (168)-17  
 SCALE: 1" = 20'-0" DATE: 8/17/81  
 SHEET NO. T-16 OF T-23 SHEETS



| FED. ROAD DIST. NO. | STATE | FED. AID PROJ. NO. | FISCAL YEAR | SHEET NO. | TOTAL SHEETS |
|---------------------|-------|--------------------|-------------|-----------|--------------|
| HAWAII              | HAW.  | 1-HI-1(168)-17     | 1982        | 76        | 145          |

| BEAM MARK | LGTH. C TO C BRG. | t1  | t2  | BEVEL | BEAM TYPE | BEAM MARK | LGTH. C TO C BRG. | t1  | t2  | BEVEL | BEAM TYPE | BEAM MARK | LGTH. C TO C BRG. | t1  | t2  | BEVEL | BEAM TYPE | BEAM MARK | LGTH. C TO C BRG. | t1 | t2 | BEVEL | BEAM TYPE | BEAM MARK | LGTH. C TO C BRG. | t1 | t2 | BEVEL | BEAM TYPE |
|-----------|-------------------|-----|-----|-------|-----------|-----------|-------------------|-----|-----|-------|-----------|-----------|-------------------|-----|-----|-------|-----------|-----------|-------------------|----|----|-------|-----------|-----------|-------------------|----|----|-------|-----------|
| 1NW1      | 98.32             | 14" | 14" | -3/12 | IVF-A     | 1HE1      | 98.26             | 14" | 14" | +1/12 | IVF-A     | 1HV1      | 98.32             | 14" | 14" | -3/12 | IVF-A     |           |                   |    |    |       |           |           |                   |    |    |       |           |
| 2         |                   |     |     | -3/12 | IV-A      | 2         |                   |     |     | +1/12 | IV-A      | 2         | 98.32             |     |     | -3/12 | IV-A      |           |                   |    |    |       |           |           |                   |    |    |       |           |
| 3         |                   |     |     | -3/12 | IV-A      | 3         |                   |     |     |       |           | 3         | 98.32             |     |     | -3/12 | IV-A      |           |                   |    |    |       |           |           |                   |    |    |       |           |
| 4         |                   |     |     | -3/12 | IV-A      | 4         |                   |     |     |       |           | 4         | 98.32             |     |     | -3/12 | IVF-A     |           |                   |    |    |       |           |           |                   |    |    |       |           |
| 5         |                   |     |     | -3/12 | IV-A      | 5         |                   |     |     |       |           | 5         | 98.32             |     |     | -3/12 | IVF-A     |           |                   |    |    |       |           |           |                   |    |    |       |           |
| 6         |                   |     |     | -3/12 | IV-A      | 6         |                   |     |     |       |           | 6         | 98.32             |     |     | -3/12 | IV-A      |           |                   |    |    |       |           |           |                   |    |    |       |           |
| 7         |                   |     |     | -3/12 | IV-A      | 7         |                   |     |     |       |           | 7         | 98.32             |     |     | -3/12 | IV-A      |           |                   |    |    |       |           |           |                   |    |    |       |           |
| 8         |                   |     |     | -3/12 | IV-A      | 8         |                   |     |     |       |           | 8         | 98.32             |     |     | -3/12 | IV-A      |           |                   |    |    |       |           |           |                   |    |    |       |           |
| 9         |                   |     |     | -3/12 | IV-A      | 9         |                   |     |     |       |           | 9         | 98.32             |     |     | -3/12 | IVF-A     |           |                   |    |    |       |           |           |                   |    |    |       |           |
| 10        |                   |     |     | -3/12 | IVF-A     | 10        |                   |     |     |       |           | 10        | 98.32             |     |     | -3/12 | IVF-A     |           |                   |    |    |       |           |           |                   |    |    |       |           |
| 11        |                   |     |     | -3/12 | IVF-A     | 11        |                   |     |     |       |           | 11        | 98.32             |     |     | -3/12 | IVF-A     |           |                   |    |    |       |           |           |                   |    |    |       |           |
| 12        |                   |     |     | -3/12 | IVF-A     | 12        |                   |     |     |       |           | 12        | 98.32             |     |     | -3/12 | IVF-A     |           |                   |    |    |       |           |           |                   |    |    |       |           |
| 75        |                   |     |     | -3/12 | IVF-A     | 75        |                   |     |     |       |           | 75        | 98.32             |     |     | -3/12 | IVF-A     |           |                   |    |    |       |           |           |                   |    |    |       |           |
| 76        |                   |     |     | -3/12 | IVF-A     | 76        |                   |     |     |       |           | 76        | 98.32             |     |     | -     |           |           |                   |    |    |       |           |           |                   |    |    |       |           |



| FED. ROAD DIST. NO. | STATE | FED. AID PROJ. NO. | FISCAL YEAR | SHEET NO. | TOTAL SHEETS |
|---------------------|-------|--------------------|-------------|-----------|--------------|
| HAWAII              | HAW.  | 1-HI-1(168)-17     | 1982        | 77        | 145          |

## NOTES FOR PRESTRESSED BEAMS

### PRETENSIONING

- Concrete shall have a minimum 28 day compressive strength of 6,000 psi.
- Pretensioned strands shall be 7 wire  $\frac{1}{2}$ " stress-relieved steel strands (area = 0.153 in<sup>2</sup>) with an ultimate strength of 270 ksi. For properties see State Standard Specifications. Initial strand stress (before any losses): 199 ksi; Initial loss = 20,000 psi. Total loss due to creep, shrinkage, elastic shortening and relaxation of steel = 45,000 psi.
- Non-prestressed reinforcing steel shall be Grade 40 unless otherwise noted. For properties see State Standard Specifications.
- The calculated camber includes the effect of the initial prestress force and the weight of the beam after removal from bed. Negative values shown for calculated camber indicate a net upward deflection. Calculated camber values shown do not account for any camber growth of the beam. The actual camber shall not exceed the calculated camber shown on the plans by more than 100% at time of installation.
- The dead load deflection includes the combined effects of the weight of slab, haunch & diaphragm.
- Strand pattern shall be symmetrical about the longitudinal  $\pm$  of the beam.
- Strand release sequence shall not induce any lateral deflection of the beam.
- Contractor shall submit his proposed strand pattern and releasing sequence to the Engineer for approval.
- During curing care shall be taken to avoid any lateral deflection of the beam due to improper orientation.
- Lifting devices shall be placed as close as possible to the center line of bearings of the beam. Details and locations of lifting devices shall be submitted to the Engineer for approval. Such approval does not relieve the Contractor of his responsibilities if beam is damaged due to failure of the lifting device.
- See Framing Plans for locations of diaphragms & beam mark numbers. For beam types and lengths see beam type schedule. Lengths shown do not include effect of elastic shortening.
- In lieu of the 7 wire  $\frac{1}{2}$ " dia. stress-relieved steel strands (area 0.153 in<sup>2</sup>) with an ultimate strength of 270 ksi, the Contractor at his option may use 7 wire  $\frac{1}{4}$ " dia. stress-relieved steel strands (area 0.115 in<sup>2</sup>) with an ultimate strength of 270 ksi. For properties of  $\frac{1}{4}$ " dia. strand see special provisions. However, the working force and its center of gravity, as stated, shall not be revised, unless approved by the Engineer.

### POST-TENSIONING


(Contractor's Option for Long Beams)

- The ultimate 28-day compressive strength of concrete shall be a minimum of 6000 psi.
- Post-tensioning steel shall consist of either  $\frac{1}{2}$ "  $\phi$ , 270 ksi S1R multistrand tendons or high strength alloy steel bars. Sheathing shall be galvanized rigid duct (coef. of friction  $\mu = 0.25$  and wobble coef.  $K = 0.0002$ ) for strands and galvanized metal sheathing ( $\mu = 0.15$  and  $K = 0.0002$ ) for bars.
- Loss due to creep, shrinkage, elastic shortening and relaxation of steel to be assumed = 35,000 psi.
- Contractor shall submit the post-tensioned beam design including elongation, jacking and deflection computation to Engineer for approval. Estimate of losses (apart from that listed above) peculiar to post-tensioning shall be part of the calculations.
- Contractor shall submit the tendon pattern and profile, sequence of stressing and anchorage details to Engineer for approval. Tendons location and post-tensioning shall be symmetrical about the longitudinal  $\pm$  of the beam.
- Pretensioning notes 3, 9, 10 and 11 also apply to post-tensioning.


### BUNDLING OF PRESTRESSING REINFORCEMENT

#### ARRANGEMENT AND CLEARANCE FOR PRETENSIONED STRANDS

- Strands may be bundled in groups as shown.
- The minimum distance "a" between groups or individual strands is 2" for  $\frac{1}{2}$ " strands.
- "a" is measured between centers of adjacent strands.

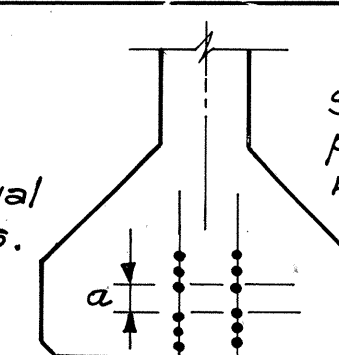


CASE I

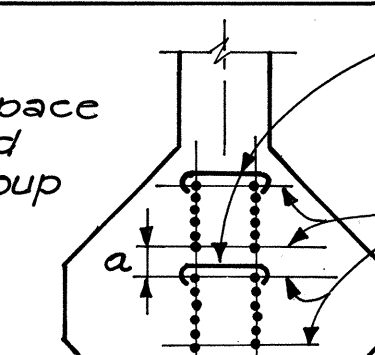

CASE II

#### ARRANGEMENT AND CLEARANCE FOR POST TENSIONED STRANDS

- Horizontal clearance between units equals 2" minimum.
- Units may be bundled vertically in groups of 3 maximum.
- Vertical clearance between bundled units equal 3" minimum.
- Approval of the Engineer is required for deviation.

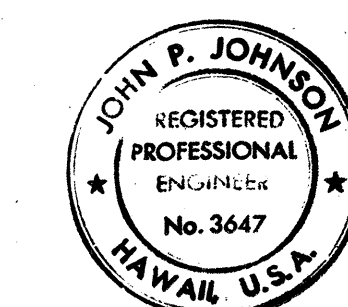

THIS WORK WAS PREPARED BY ME OR UNDER MY SUPERVISION.



John P. Johnson

STATE OF HAWAII  
DEPARTMENT OF TRANSPORTATION  
HIGHWAYS DIVISION  
H-1 VIADUCT (E.B.), RAMP C & HOV RAMP


### PRESTRESS BEAM DETAILS SHEET 1 OF 2

KEEHI INTERCHANGE  
F.A.I. PROJECT NO. 1-HI-1(168)-17  
SCALE: AS SHOWN DATE: 8/17/81

SHEET NO. T-18 OF T-23 SHEETS

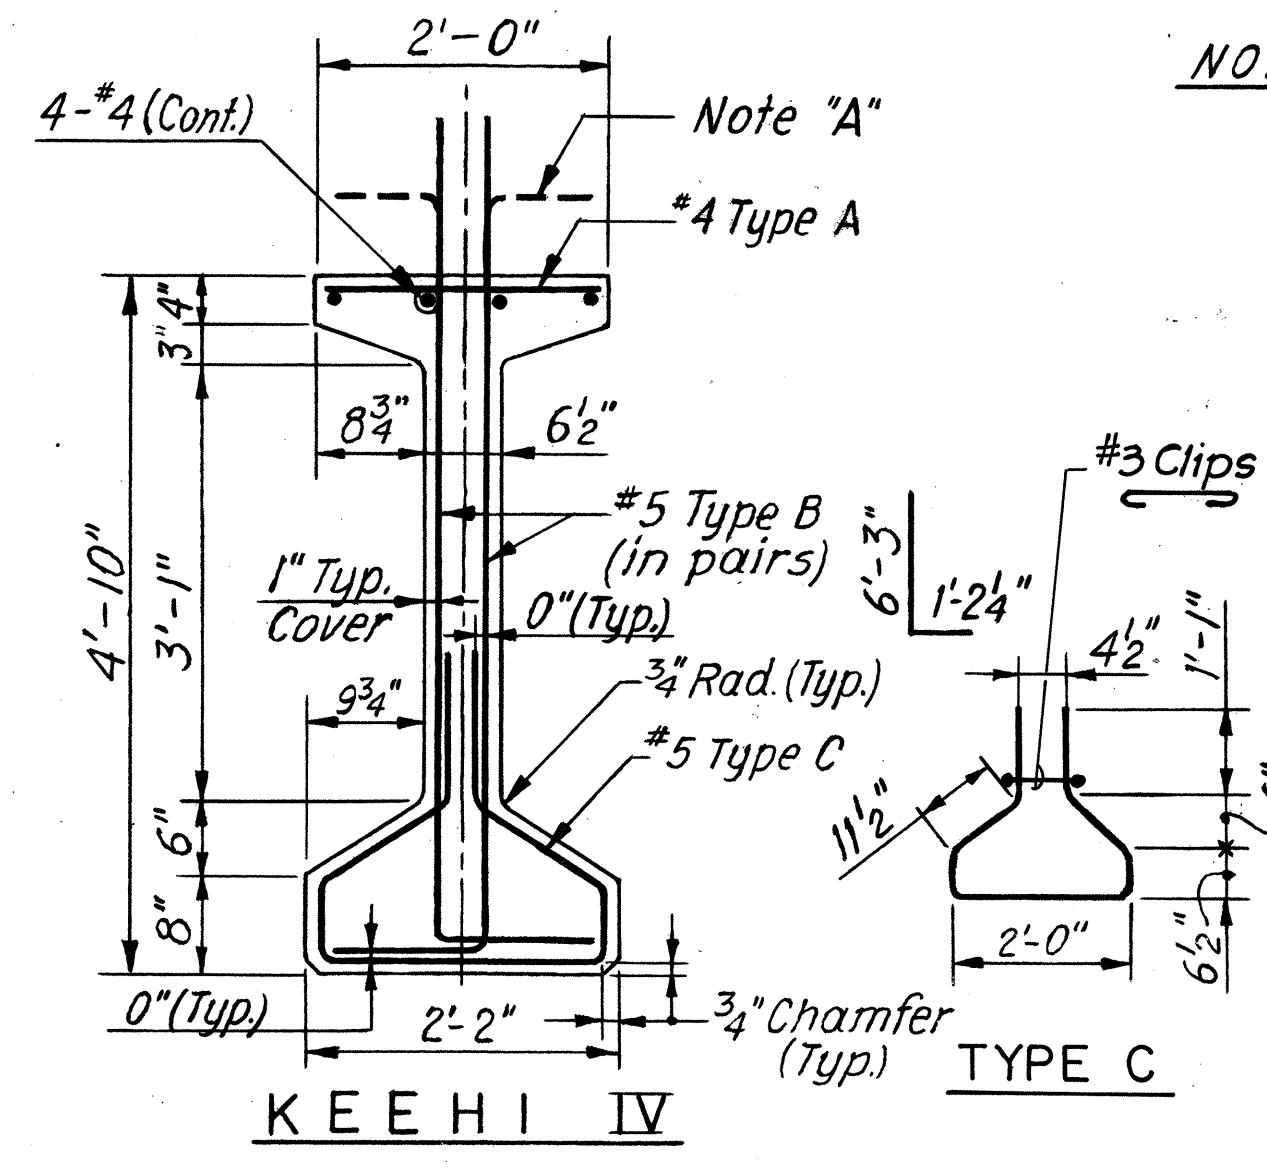
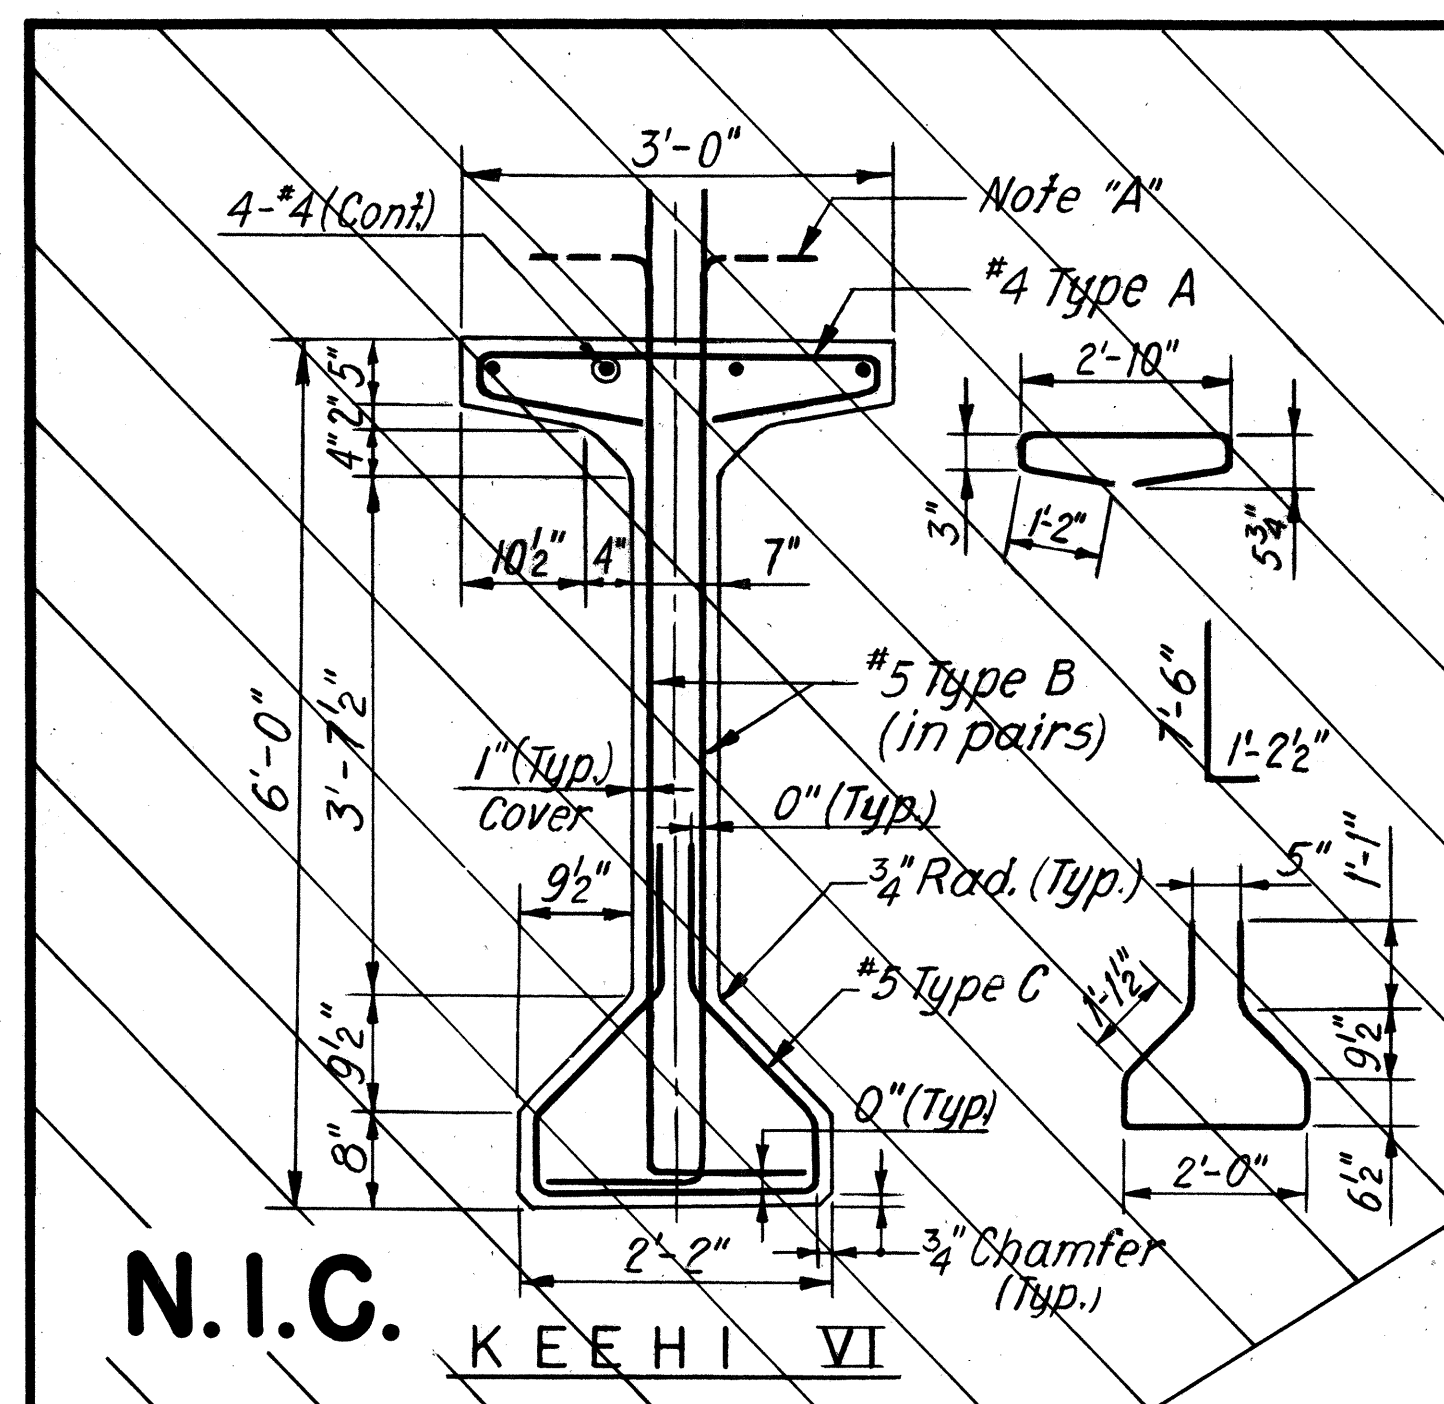


NOTE "A": Bend bars in field  $1\frac{1}{2}$ " below top of deck. All reinforcing dimensions are out to out.

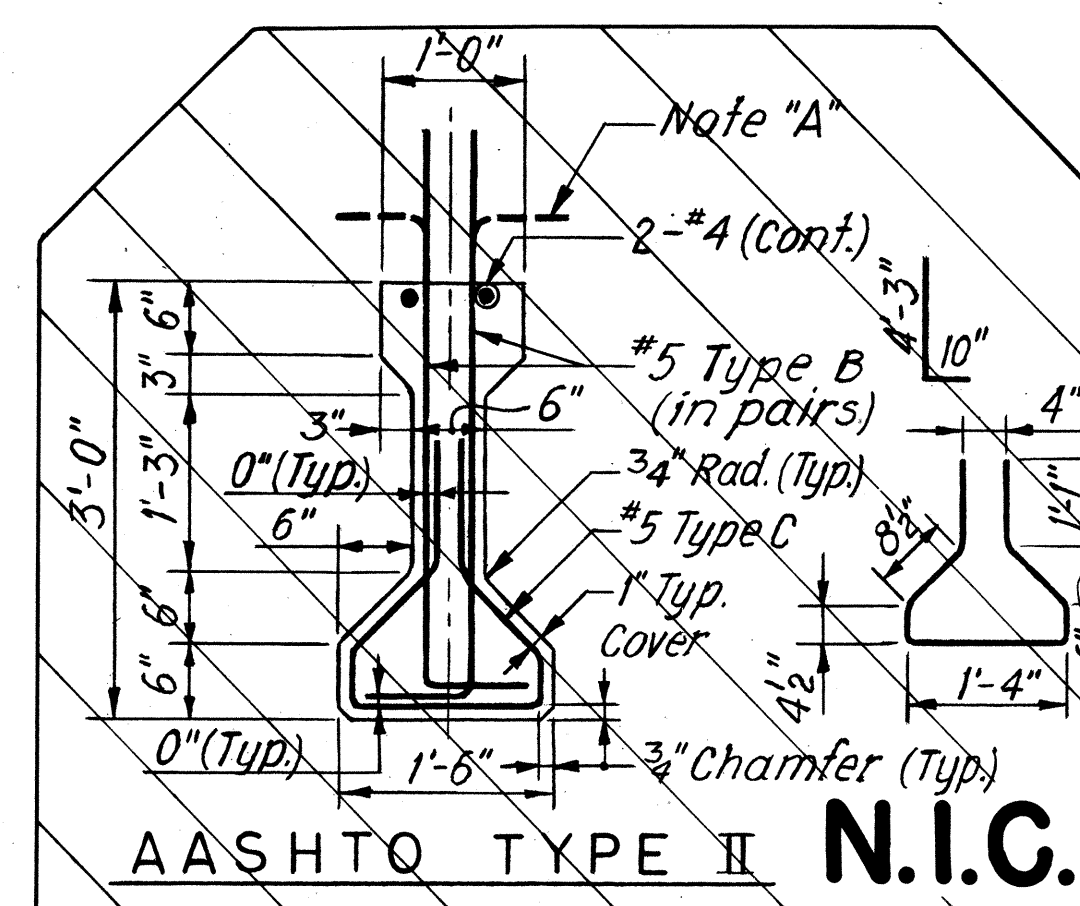


### TYPICAL BEAM SECTION

Scale  $\frac{3}{4}$ " = 1'-0"

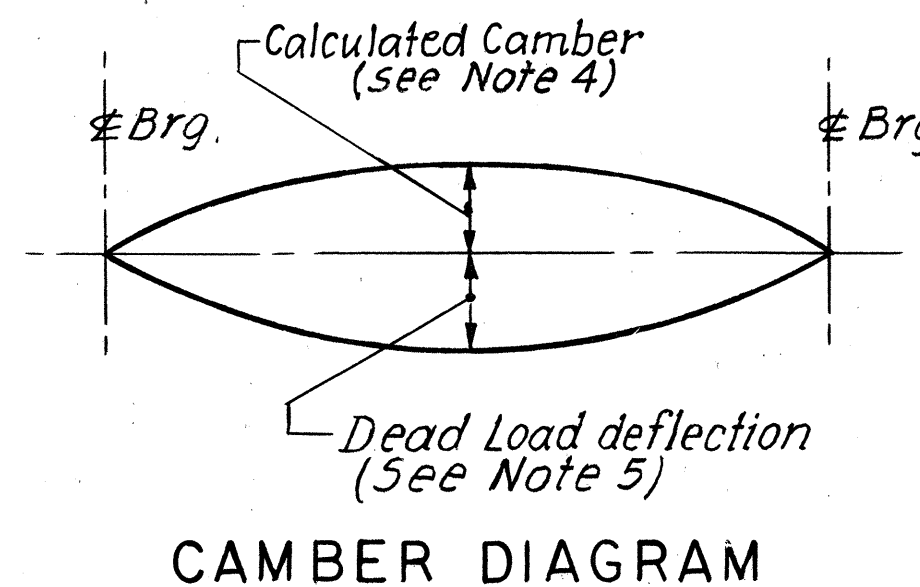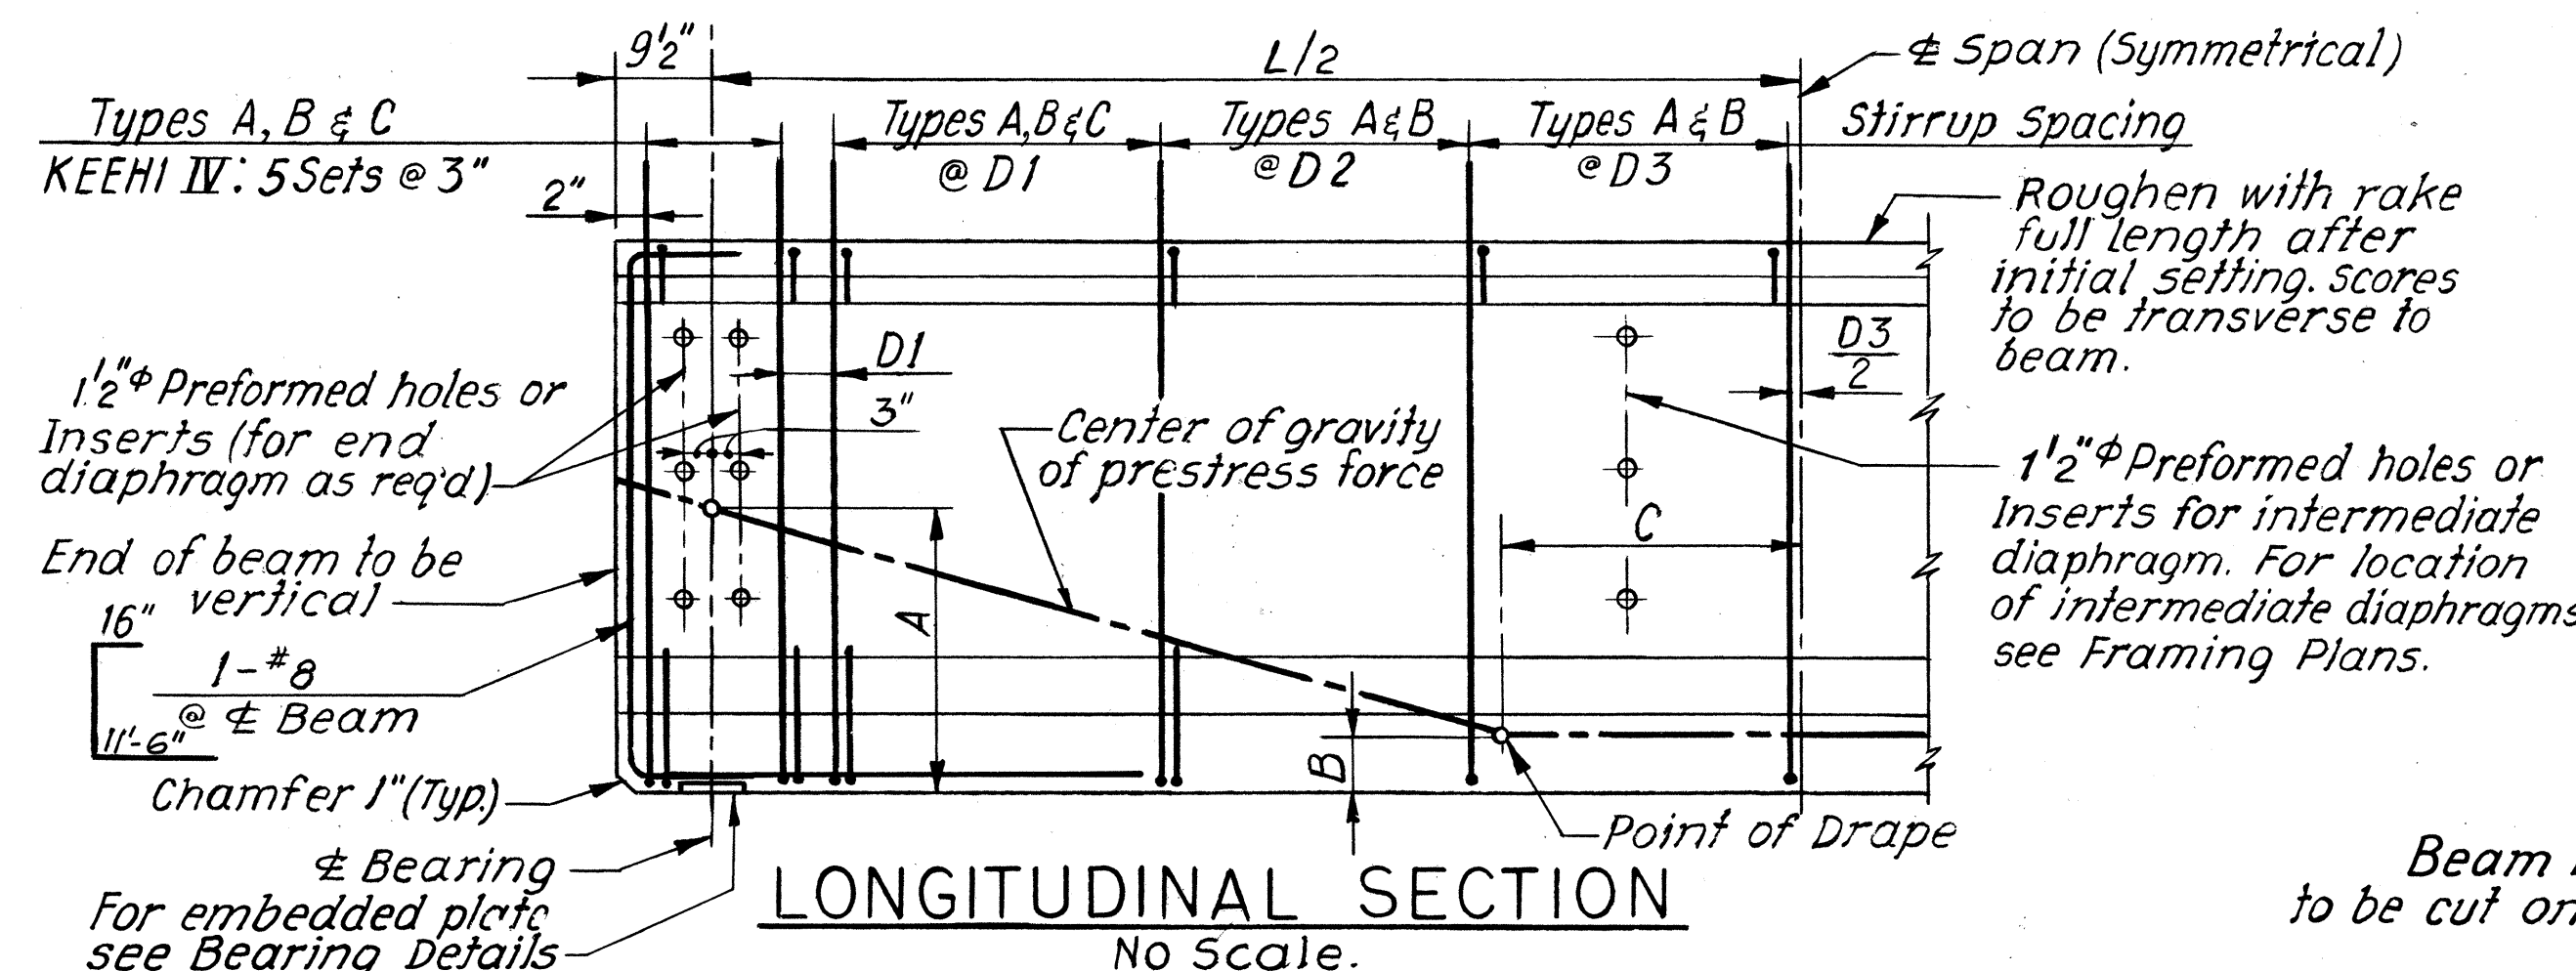

### CAMBER DIAGRAM

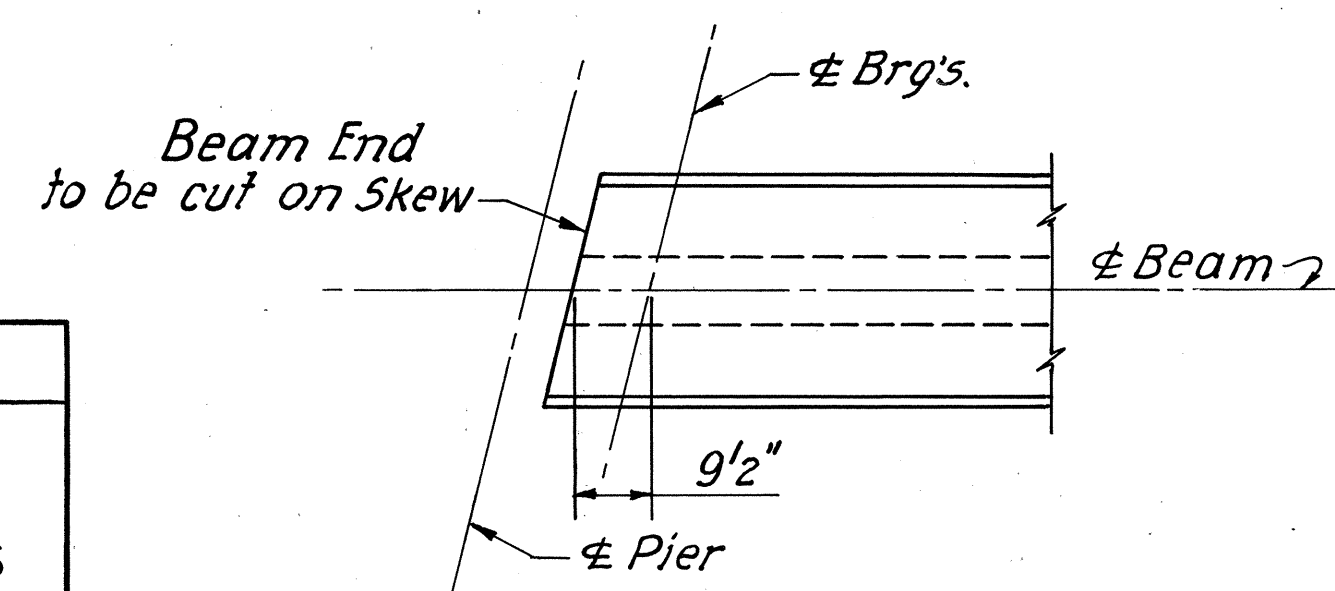

### BEAM END PLAN


No Scale

### BEAM SCHEDULE

| BEAM TYPE | INITIAL* PRESTRESS FORCE (KIPS) | WORKING FORCE (KIPS) | CALCULATED CAMBER SEE NOTE 4 | DEAD LOAD DEFLECTION SEE NOTE 5 | LOCATION OF CENTER OF GRAVITY OF PRESTRESS FORCE |        |                         | STIRRUPS                     |                              |            | REMARKS |
|-----------|---------------------------------|----------------------|------------------------------|---------------------------------|--------------------------------------------------|--------|-------------------------|------------------------------|------------------------------|------------|---------|
|           |                                 |                      |                              |                                 | DIST A                                           | DIST B | DIST. TO PT. OF DRAPE C | NO. OF STIRRUPS @ SPACING D1 | NO. OF STIRRUPS @ SPACING D2 | SPACING D3 |         |
| IV-A      | 1279                            | 990                  | -1'2"                        | 1"                              | 1'-4 1/2"                                        | 4 1/4" | 10'-0"                  | 11 @ 12"                     | 10 @ 18"                     | 18"        | 4700    |
| IV-M      | 1400                            | 1084                 | -1'2"                        | 1 3/8"                          | 1'-5 3/4"                                        | 5 3/4" | 11'-0"                  | 15 @ 9"                      | 16 @ 12"                     | 18"        | 5000    |
| IV-H      | 852                             | 660                  | -5/8"                        | 1/2"                            | 1'-6"                                            | 5"     | 8'-0"                   | 12 @ 10"                     | 8 @ 18"                      | 18"        | 4700    |

\* Before any losses

PRESTRESSED CONCRETE  
GIRDERS WILL BE  
FURNISHED BY OTHERS

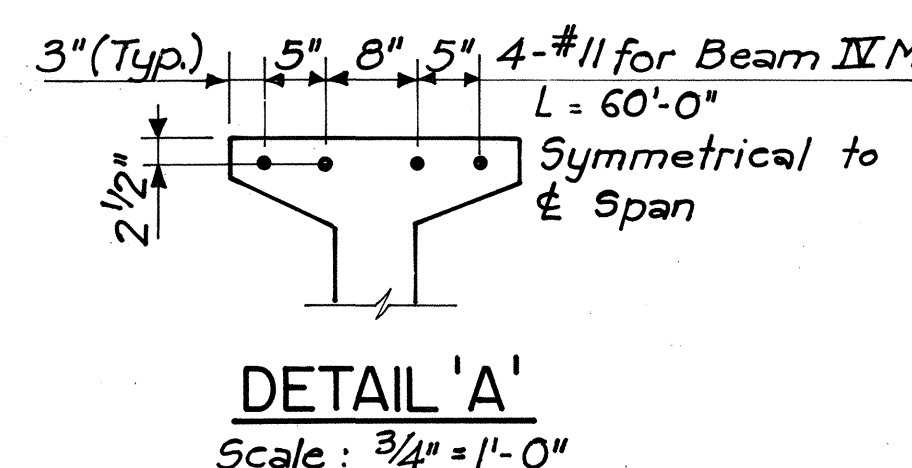










### DETAIL 'A'

Scale:  $\frac{3}{4}$ " = 1'-0"

DATE: \_\_\_\_\_  
DRAWN BY: M. J. JOHNSON  
DESIGNED BY: H. B. JOHNSON  
CHECKED BY: H. B. JOHNSON  
NOTE BOOK  
NO. \_\_\_\_\_



| FED. ROAD DIST. NO. | STATE | FED. AID PROJ. NO. | FISCAL YEAR | SHEET NO. | TOTAL SHEETS |
|---------------------|-------|--------------------|-------------|-----------|--------------|
| HAWAII              | HAW.  | 1-HI-1(168)17      | 1982        | 78        | 145          |

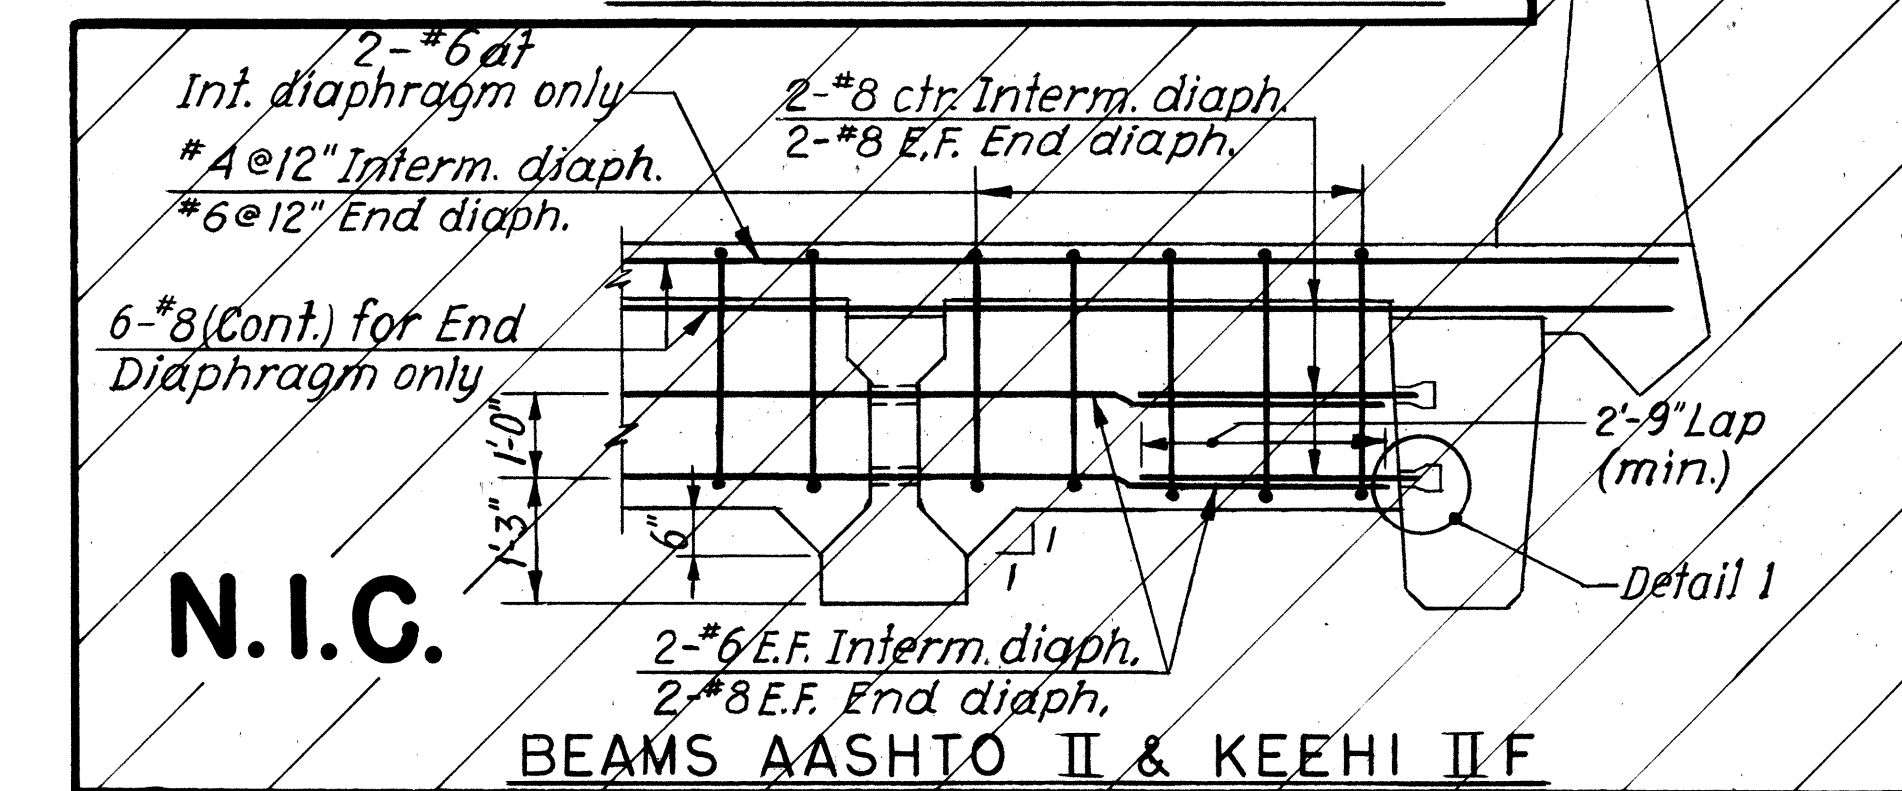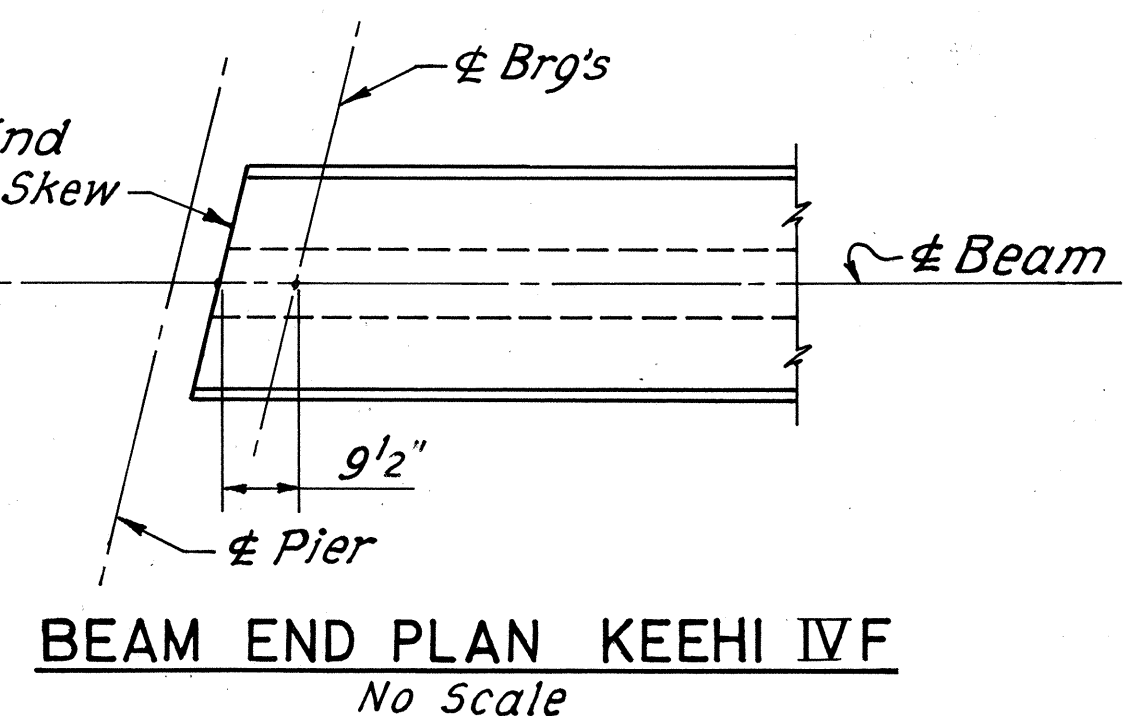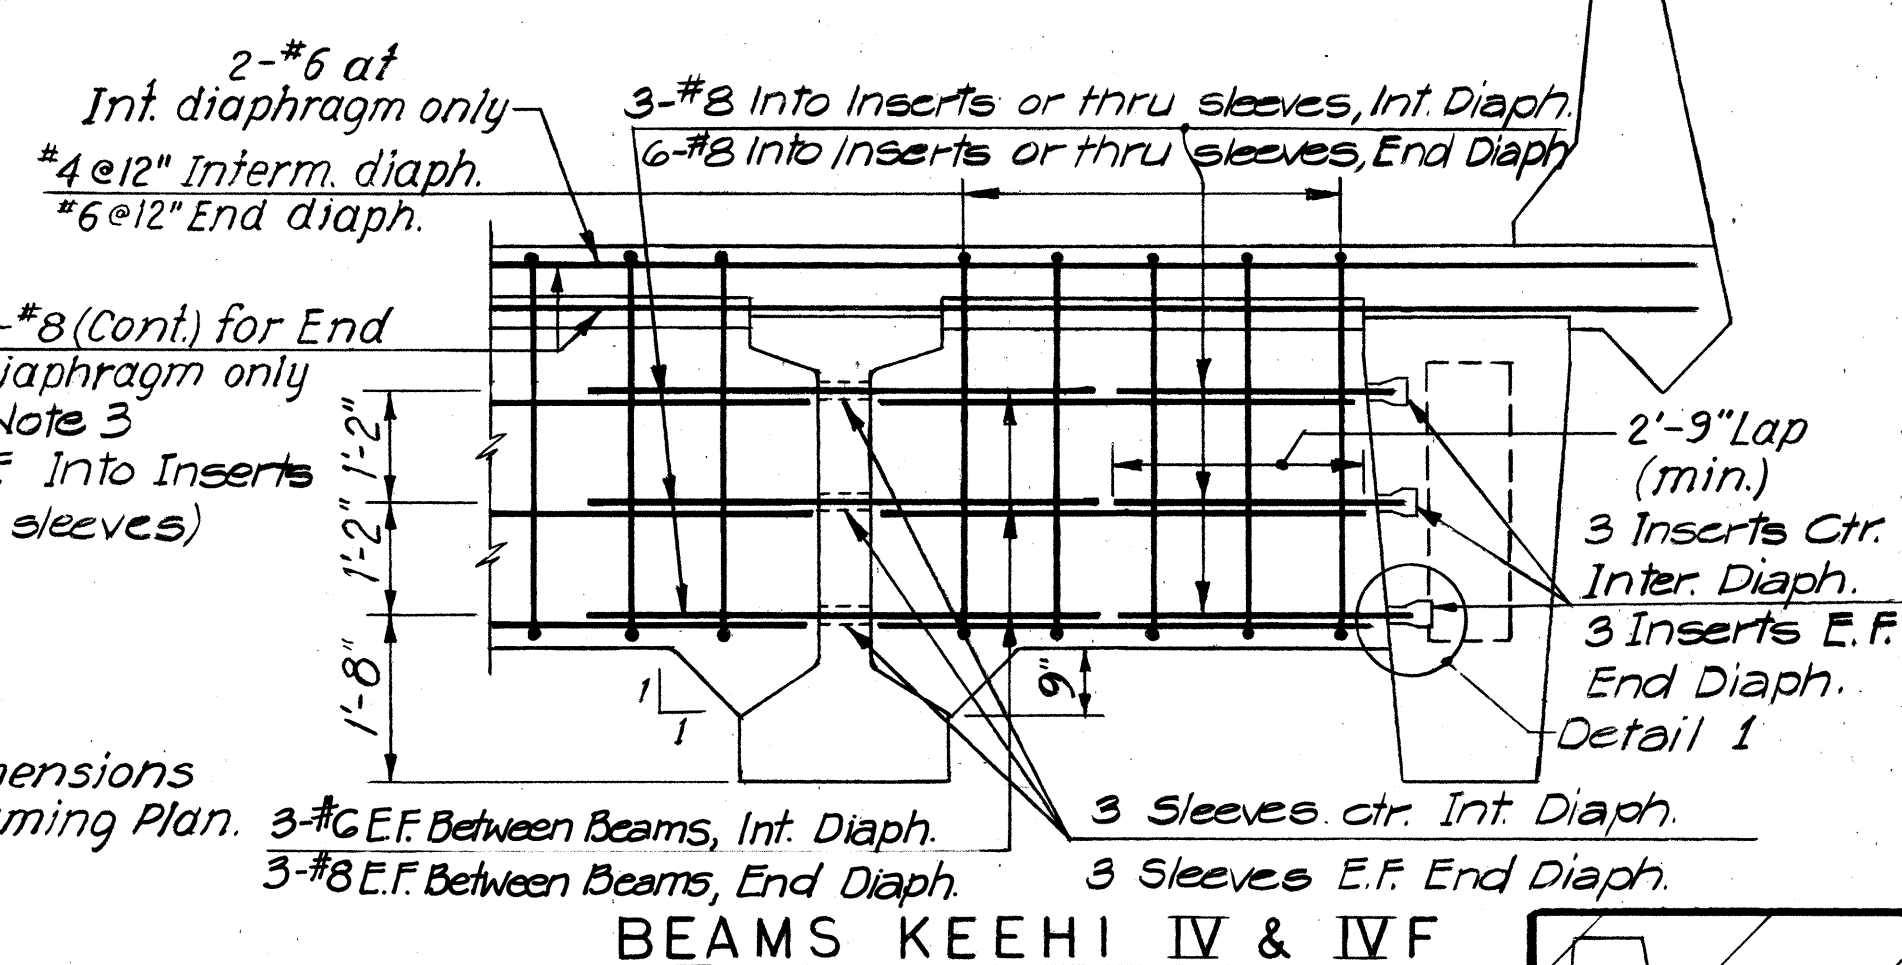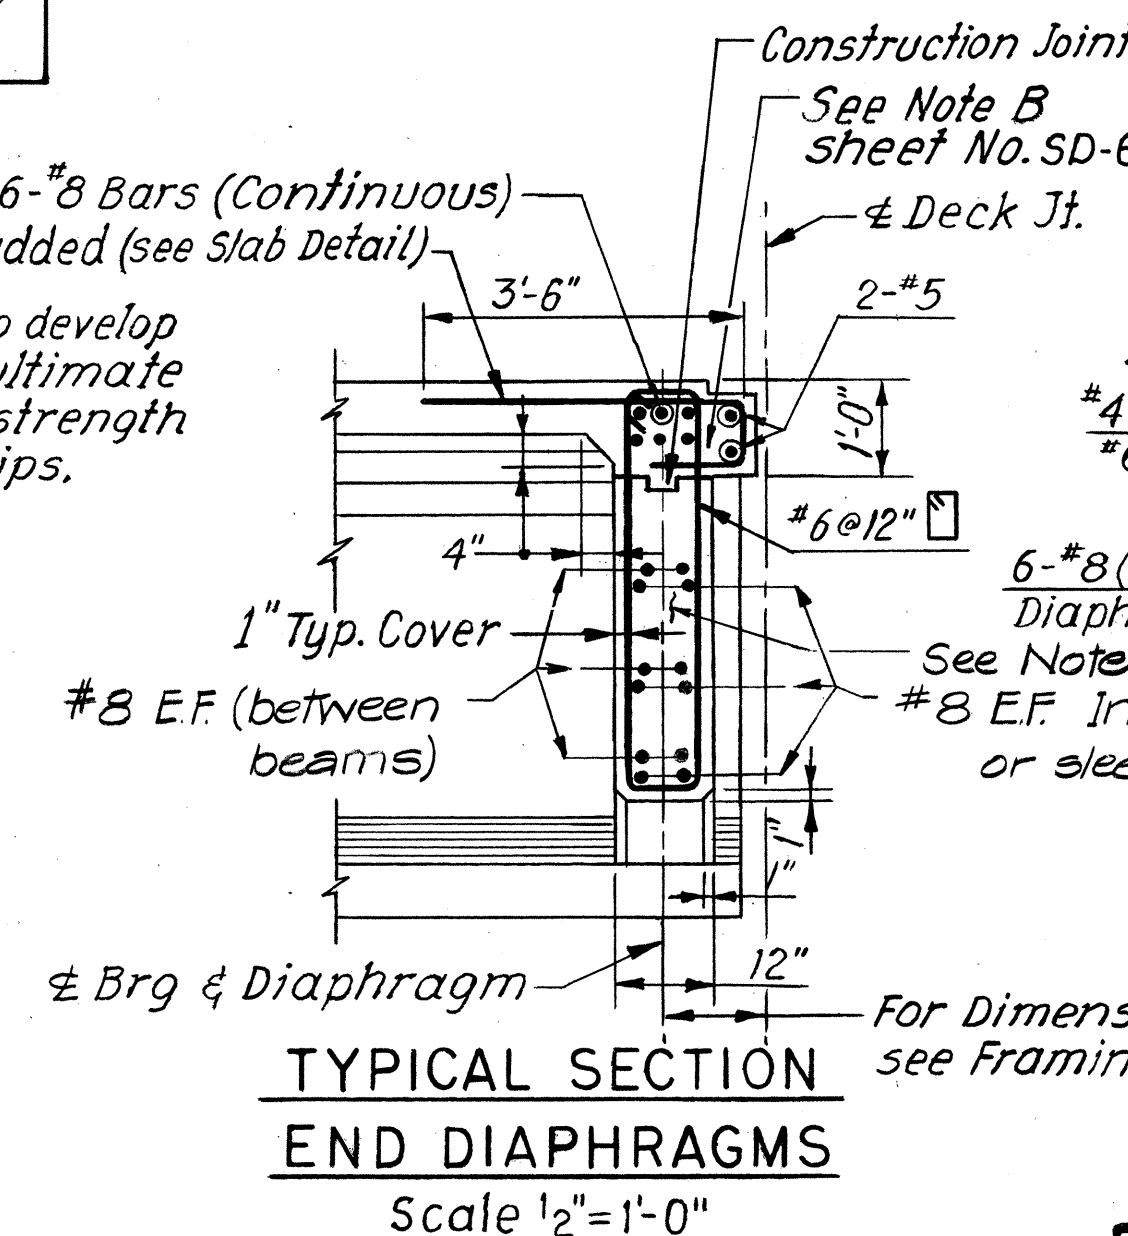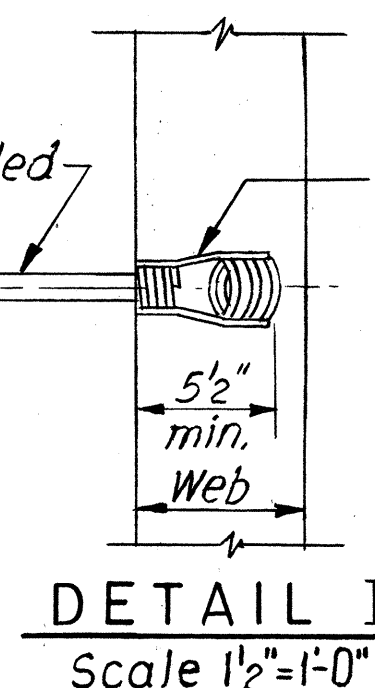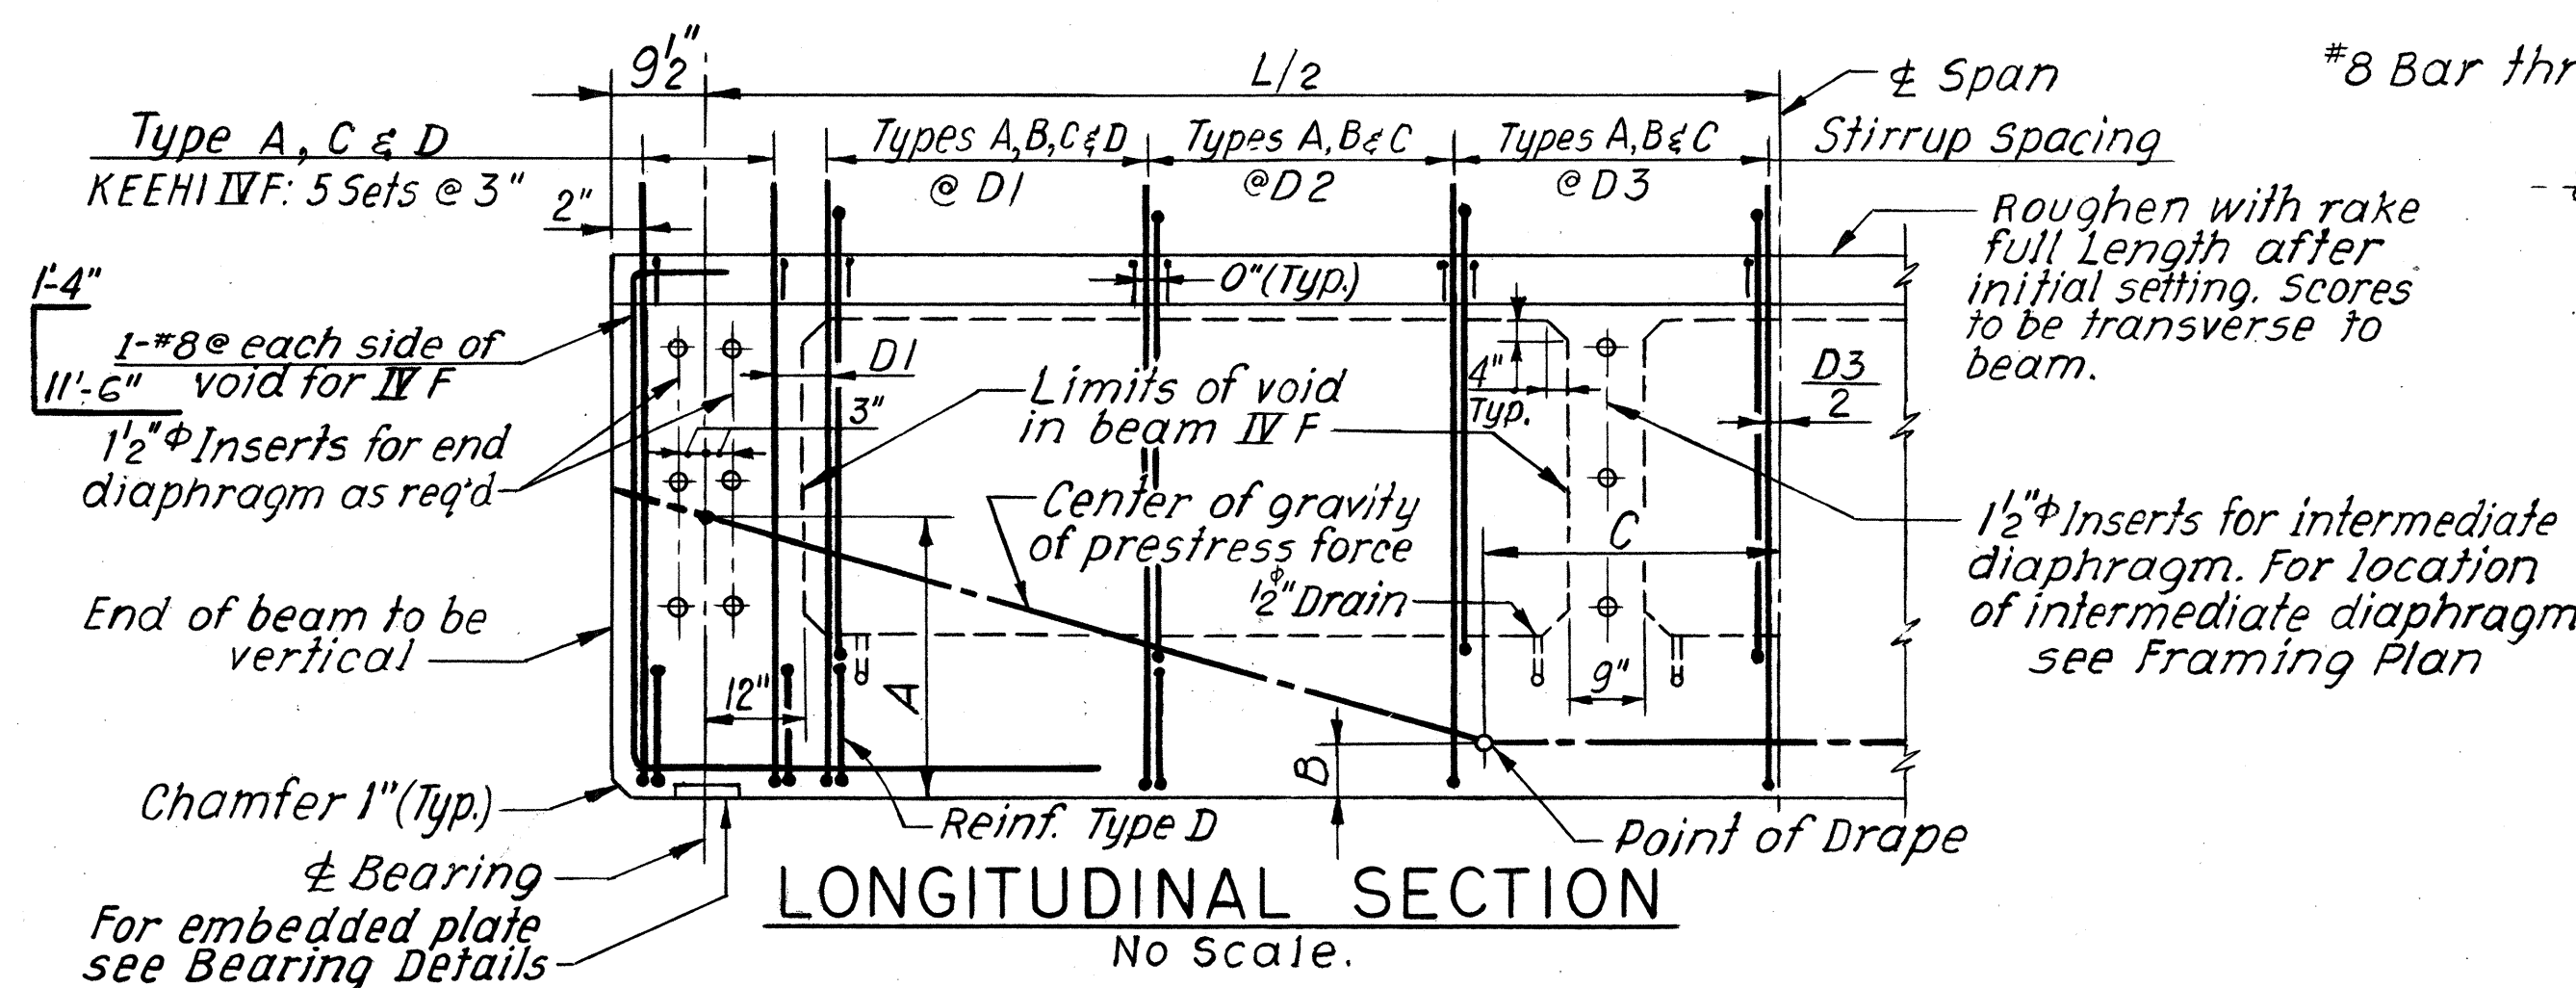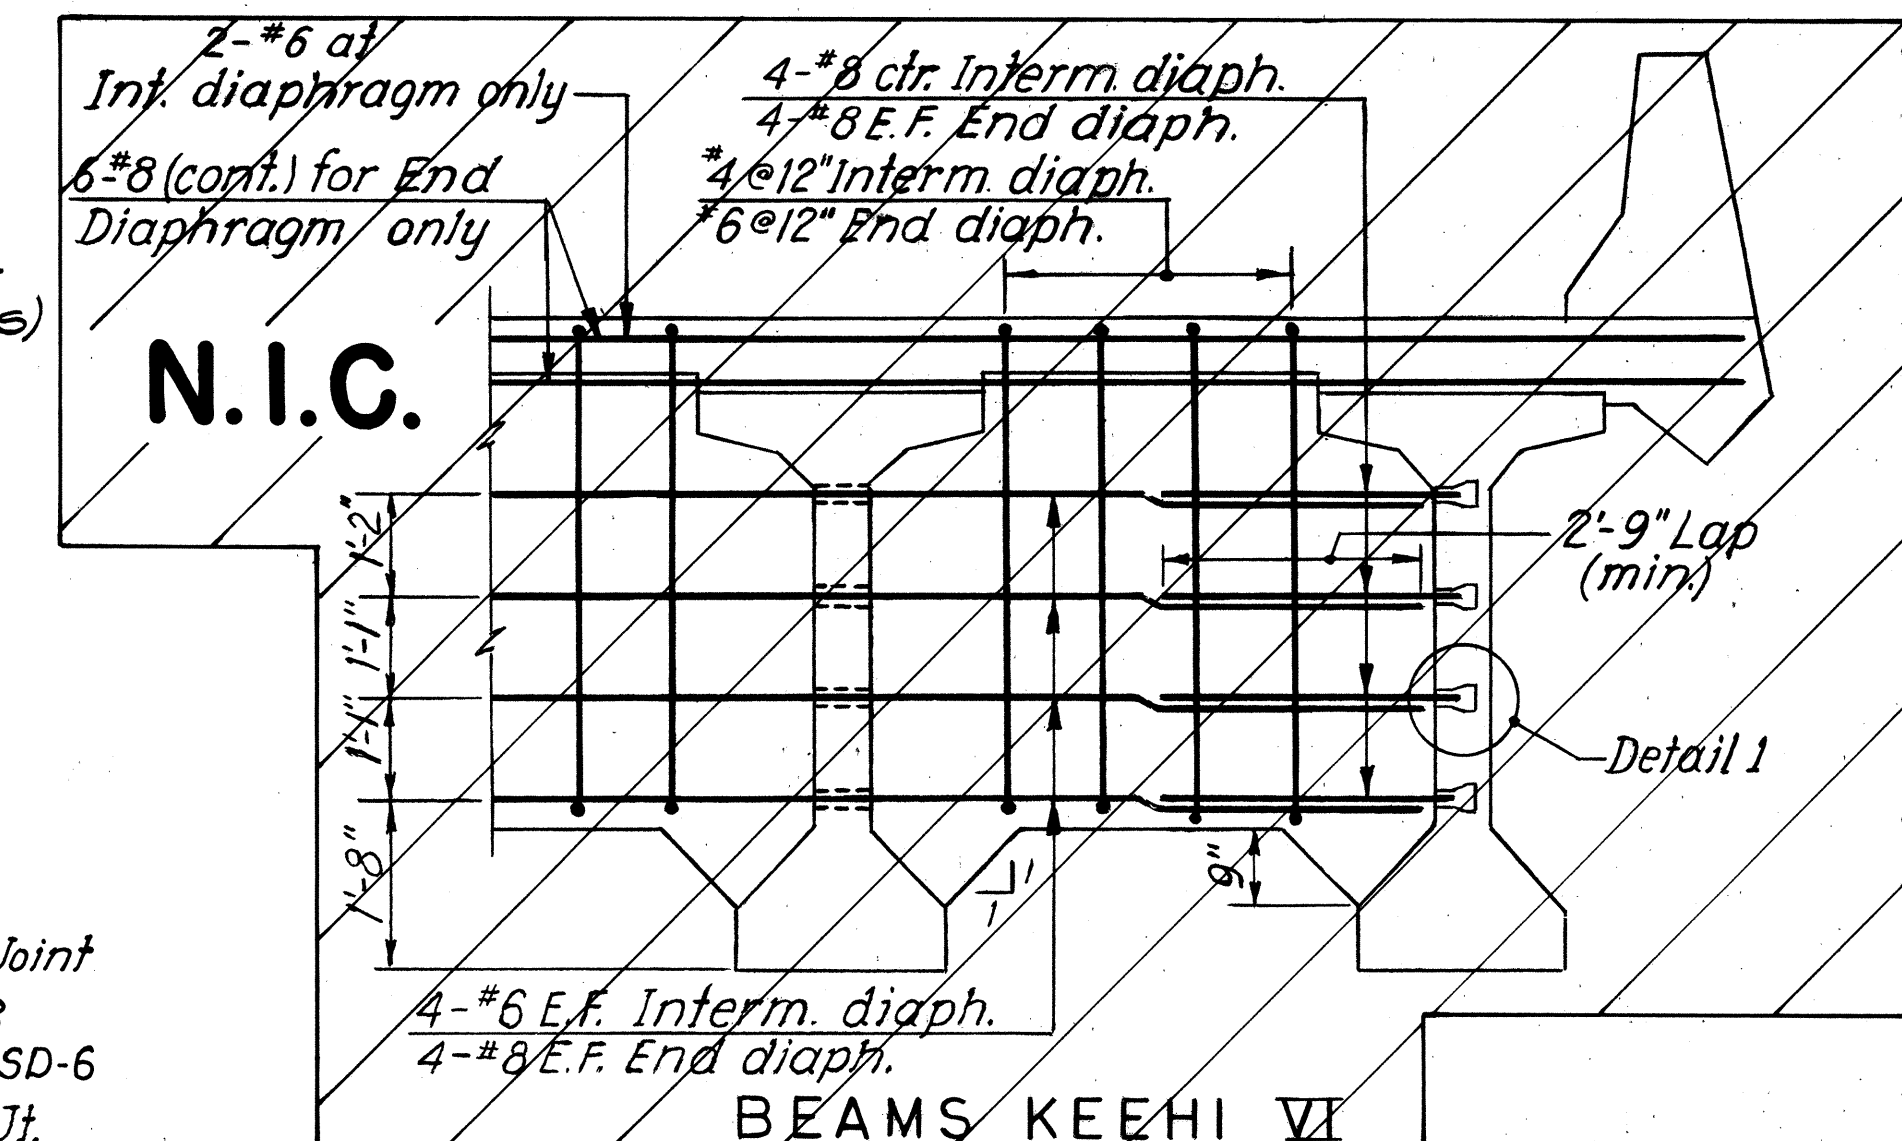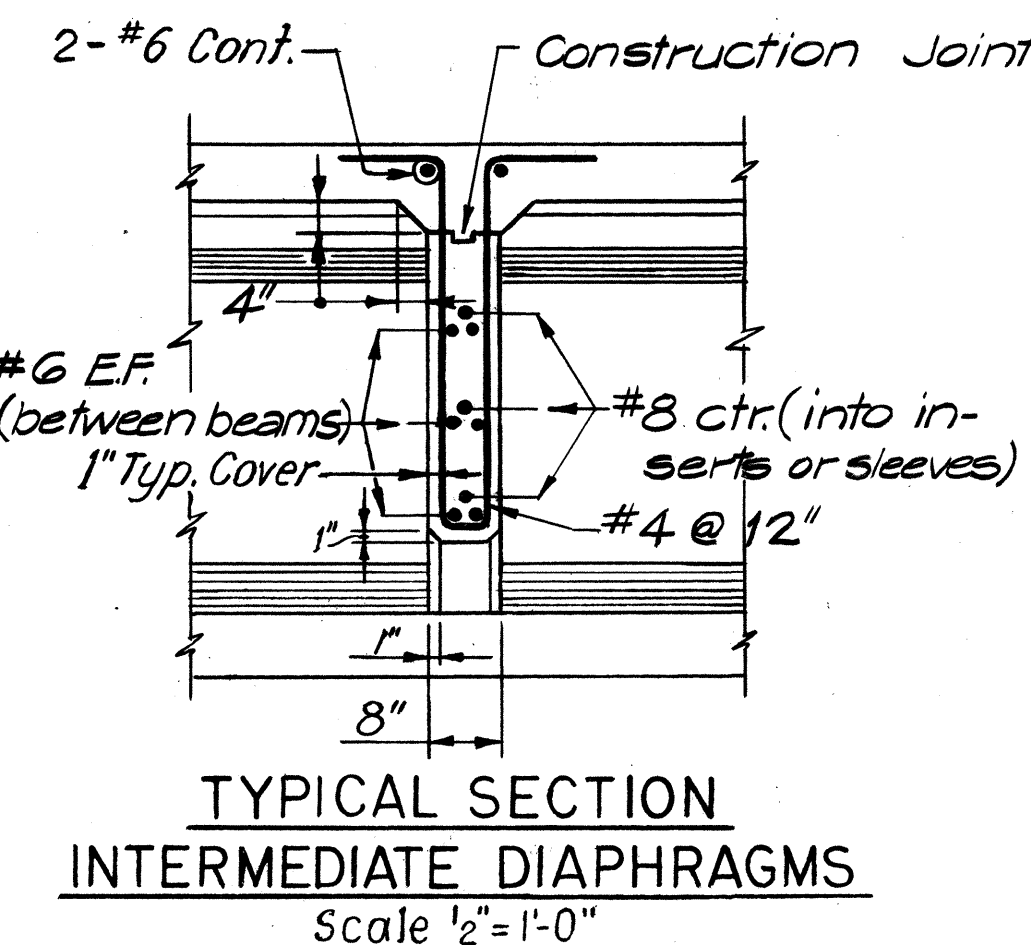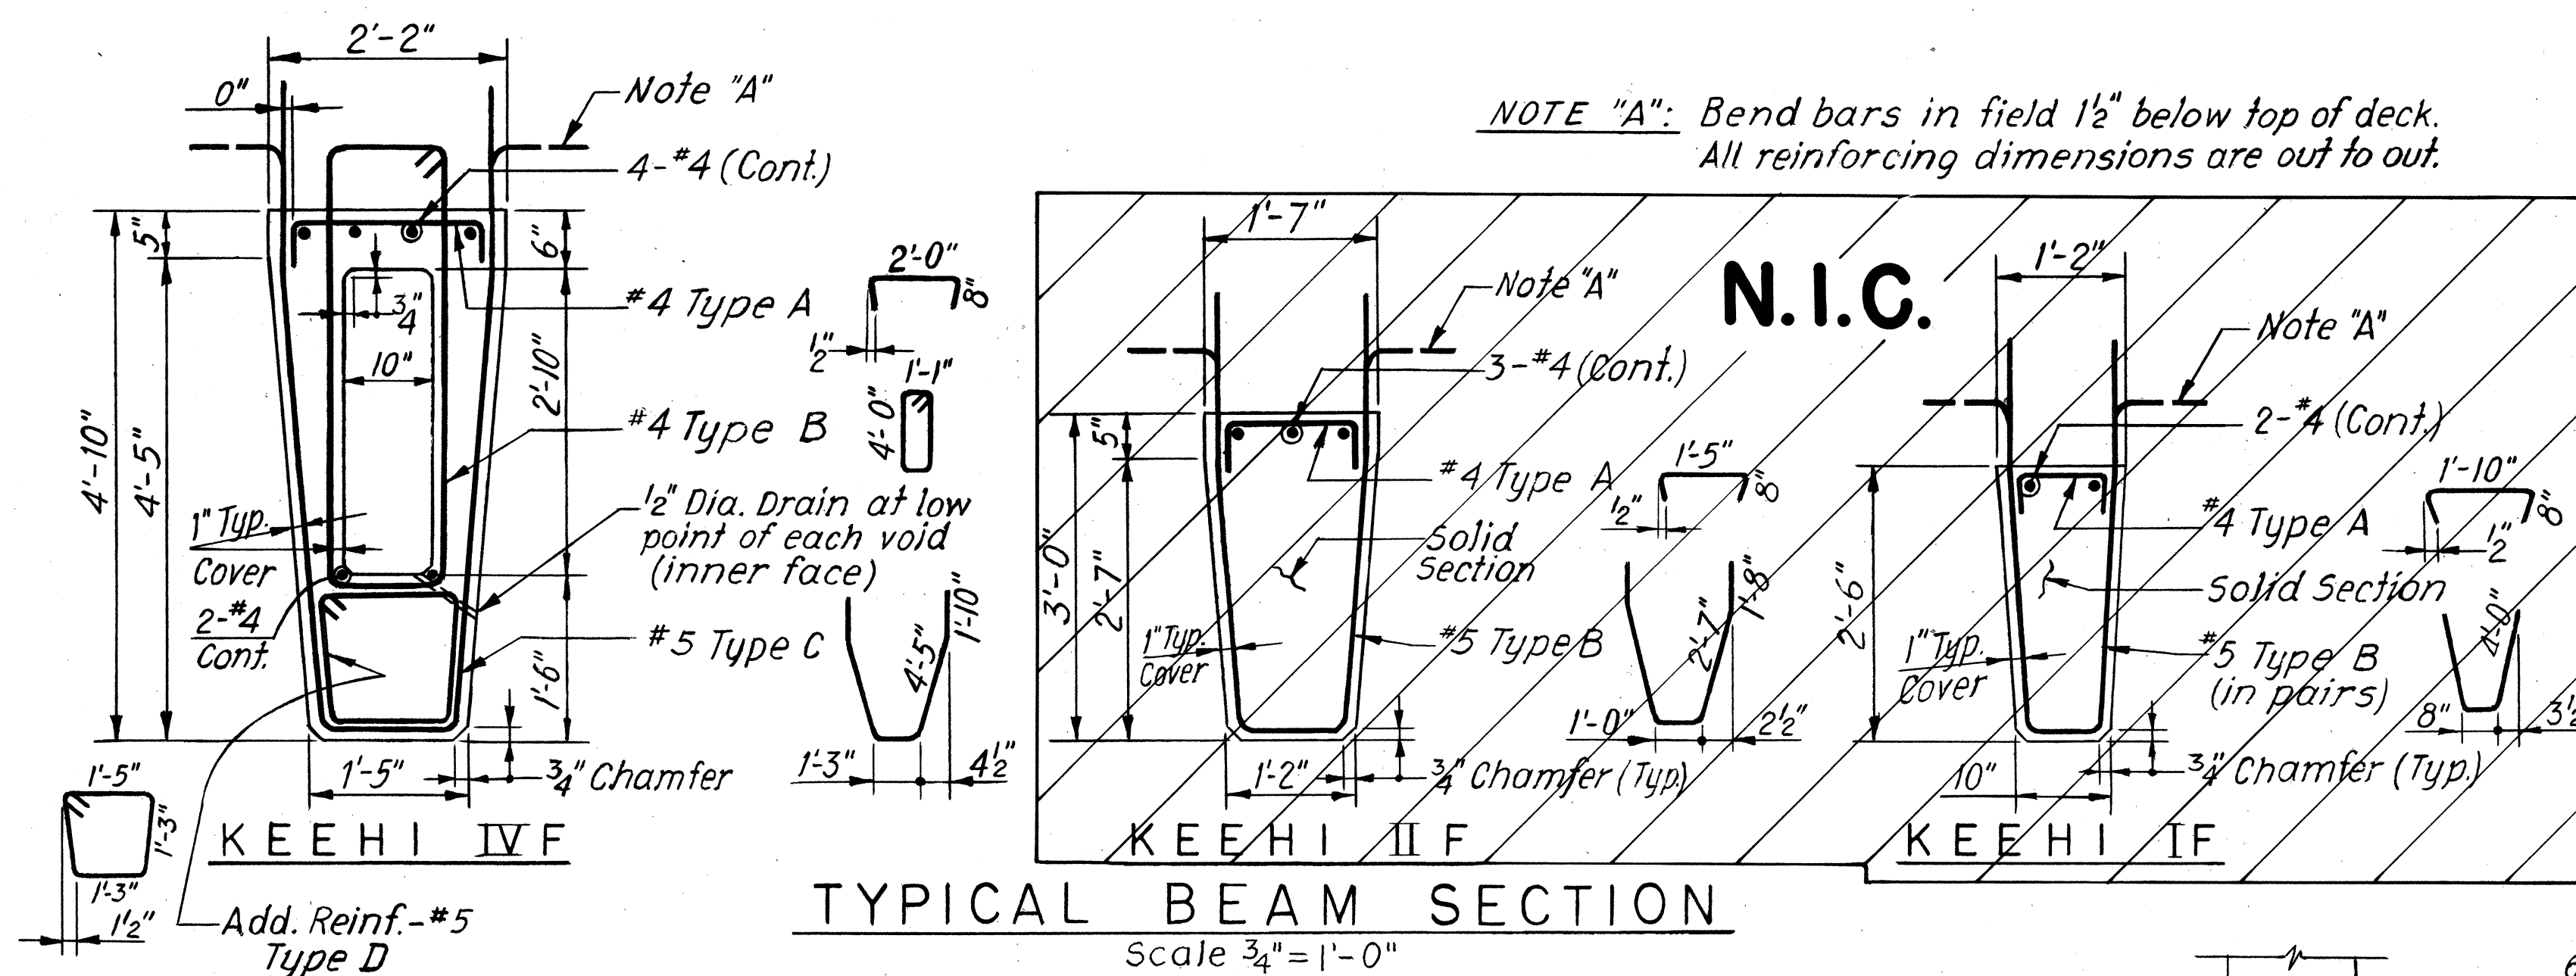


| BEAM TYPE | INITIAL * PRESTRESS FORCE (KIPS) | WORKING FORCE (KIPS) | CALCULATED CAMBER SEE NOTE 4 | DEAD LOAD DEFLECTION SEE NOTE 5 | LOCATION OF CENTER OF GRAVITY OF PRESTRESS FORCE |                   |                         | STIRRUPS                     |                              |            | REQUIRED MIN. ULT. CONC. STRENGTH BEFORE RELEASE OF STRANDS (P.S.I.) | REMARKS        |
|-----------|----------------------------------|----------------------|------------------------------|---------------------------------|--------------------------------------------------|-------------------|-------------------------|------------------------------|------------------------------|------------|----------------------------------------------------------------------|----------------|
|           |                                  |                      |                              |                                 | DIST. A                                          | DIST. B           | DIST. TO PT. OF DRAPE C | NO. OF STIRRUPS @ SPACING D1 | NO. OF STIRRUPS @ SPACING D2 | SPACING D3 |                                                                      |                |
| IVF-A     | 1461                             | 1131                 | -1 $\frac{1}{2}$ "           | 1 $\frac{1}{4}$ "               | 1'-8"                                            | 8"                | 10'-0"                  | 11@12"                       | 11@18"                       | 18"        | 4700                                                                 |                |
| IVF-D     | 1096                             | 848                  | -1"                          | 5/8"                            | 1'-7 $\frac{1}{4}$ "                             | 6 $\frac{1}{2}$ " | 9'-0"                   | 9@14"                        | 9@18"                        | 18"        | 4500                                                                 |                |
| IVF-L     | 1644                             | 1272                 | -1 $\frac{3}{4}$ "           | 1 $\frac{1}{2}$ "               | 1'-10 $\frac{1}{2}$ "                            | 7 $\frac{3}{4}$ " | 11'-0"                  | 12@12"                       | 12@18"                       | 18"        | 5100                                                                 |                |
| IVF-C     | 1522                             | 1178                 | -1 $\frac{3}{4}$ "           | 1 $\frac{1}{2}$ "               | 1'-9"                                            | 7"                | 10'-0"                  | 11@12"                       | 11@18"                       | 18"        | 5100                                                                 | See Detail 'B' |

#### NOTES:


- For Prestress Notes and Camber Diagram see 5h. No. T-18
- Intermediate and End Diaphragms shall be Class A Concrete.
- Apply Epoxy Bonding Compound to contact area on all fascia Beams before placing diaphragm concrete. Epoxy Bonding Compound incidental to concrete in Bridges.
- Bars in sleeves shall be grouted in place before pouring the diaphragms.
- Inserts and Sleeves are incidental to prestressed concrete beam.

\* Before any losses

NOTES, Cont'd.:  
6. Diaphragm bars thru sleeves or threaded into inserts shall be paid under "Reinforcing in Bridges, \_\_\_\_".

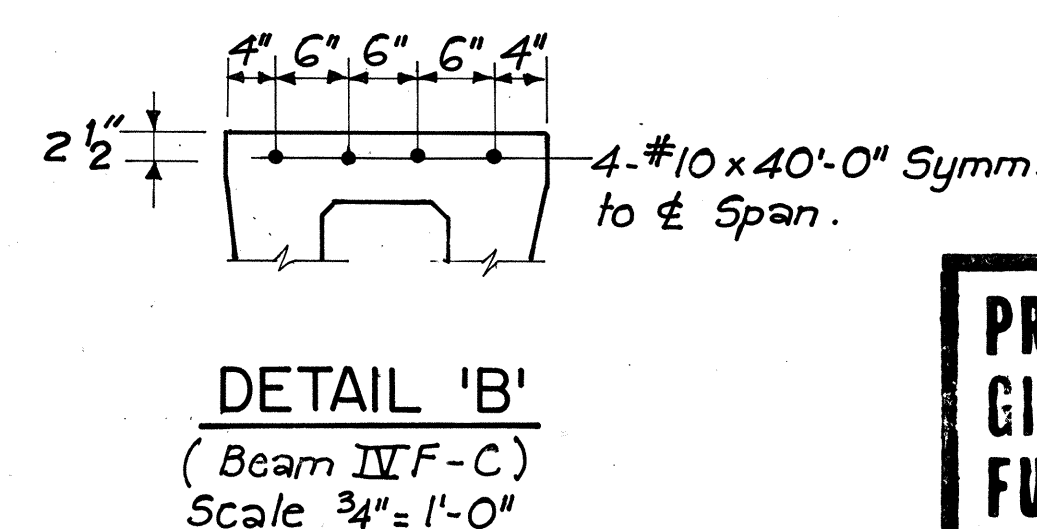

**PRESTRESSED CONCRETE GIRDERS WILL BE FURNISHED BY OTHERS**

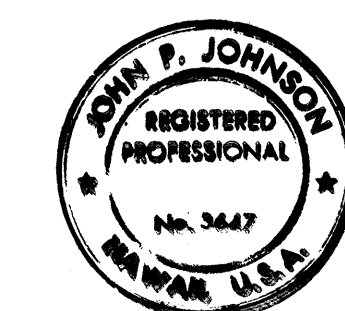

THIS WORK WAS PREPARED BY ME OR UNDER MY SUPERVISION.  
John P. Johnson

STATE OF HAWAII  
DEPARTMENT OF TRANSPORTATION  
HIGHWAYS DIVISION  
H-1 VIADUCT (E.B.), RAMP C & HOV RAMP


**PRESTRESS BEAM DETAILS**  
SHEET 2 OF 2

KEEHI INTERCHANGE  
F.A.I. PROJECT NO. 1-HI-1(168)17  
SCALE: AS SHOWN  
DATE: 8/17/81

SHEET NO. T-19 OF T-23 SHEETS



| FED. ROAD DIST. NO. | STATE | FED. AID PROJ. NO. | FISCAL YEAR | SHEET NO. | TOTAL SHEETS |
|---------------------|-------|--------------------|-------------|-----------|--------------|
| HAWAII              | HAW.  | FHH-1(168)-17      | 1982        | 79        | 145          |

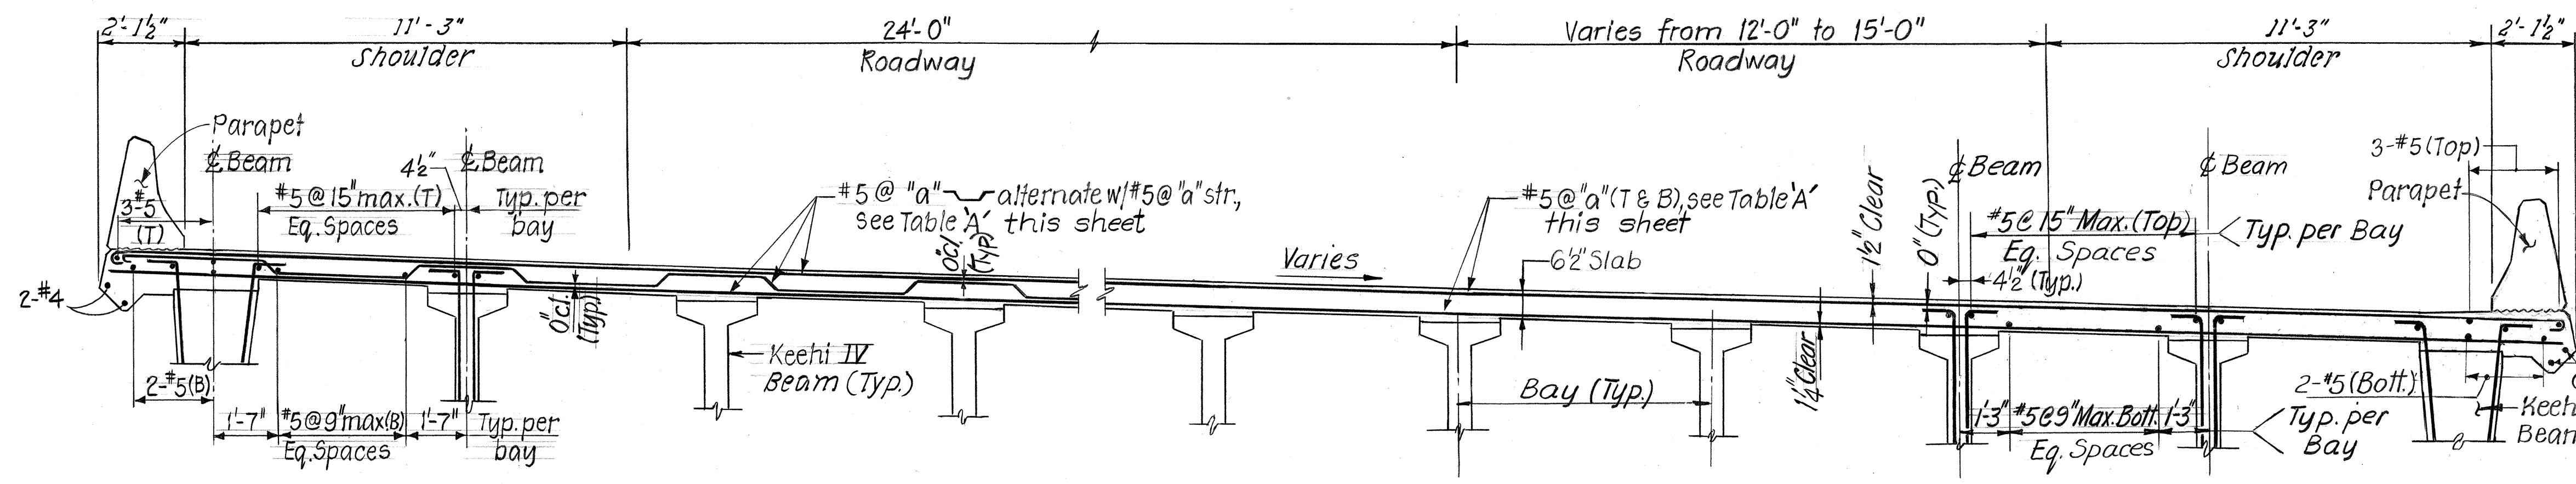


TYPICAL FOR SPANS: 1HE


TYPICAL DECK SECTION

For H-1 (E.B.) up to Sta. 237+65.09 only  
Scale: 3/8" = 1'-0"

TYPICAL FOR SPANS: 2HE

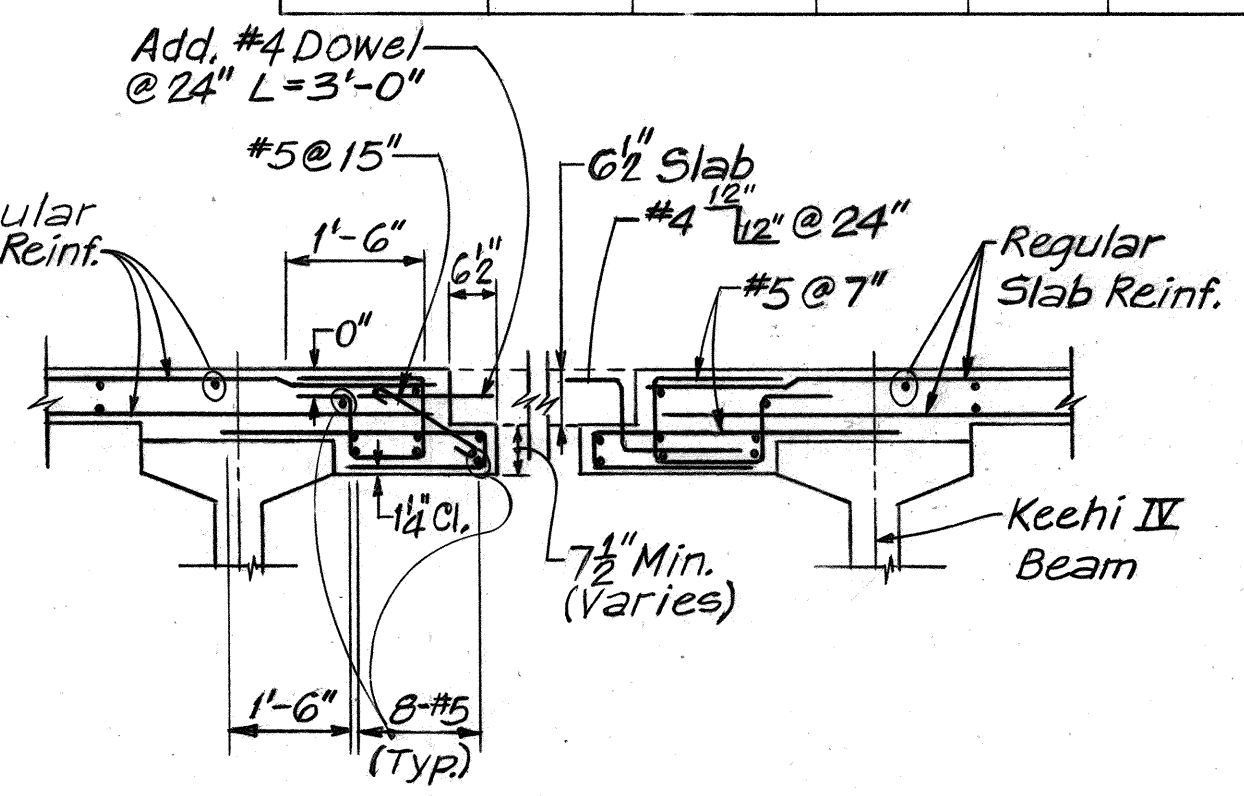

DETAIL 1  
Scale: 1/2" = 1'-0"

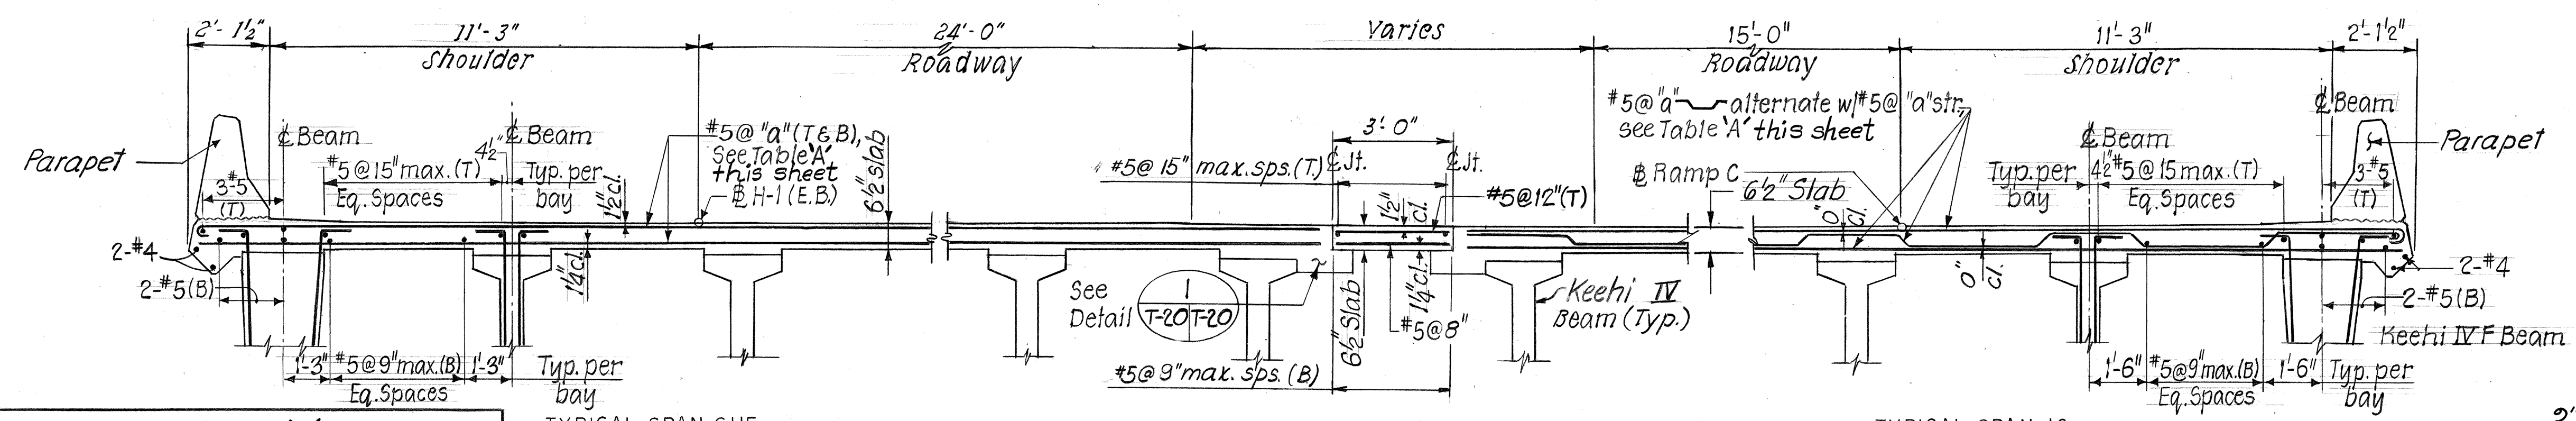


| TABLE 'A'                   |              |
|-----------------------------|--------------|
| SPACING REINF. BARS IN SLAB |              |
| SPACING "a" (max)           | SPAN         |
| 7"                          | 2HE thru 4HE |
| 7 1/2"                      | 5HE, 6HE     |
| 14"                         | 1HE, 1C      |

TYPICAL SPAN 6HE


TYPICAL SPAN 1C

SECTION A  
Looking Up-station  
Scale: 3/8" = 1'-0"

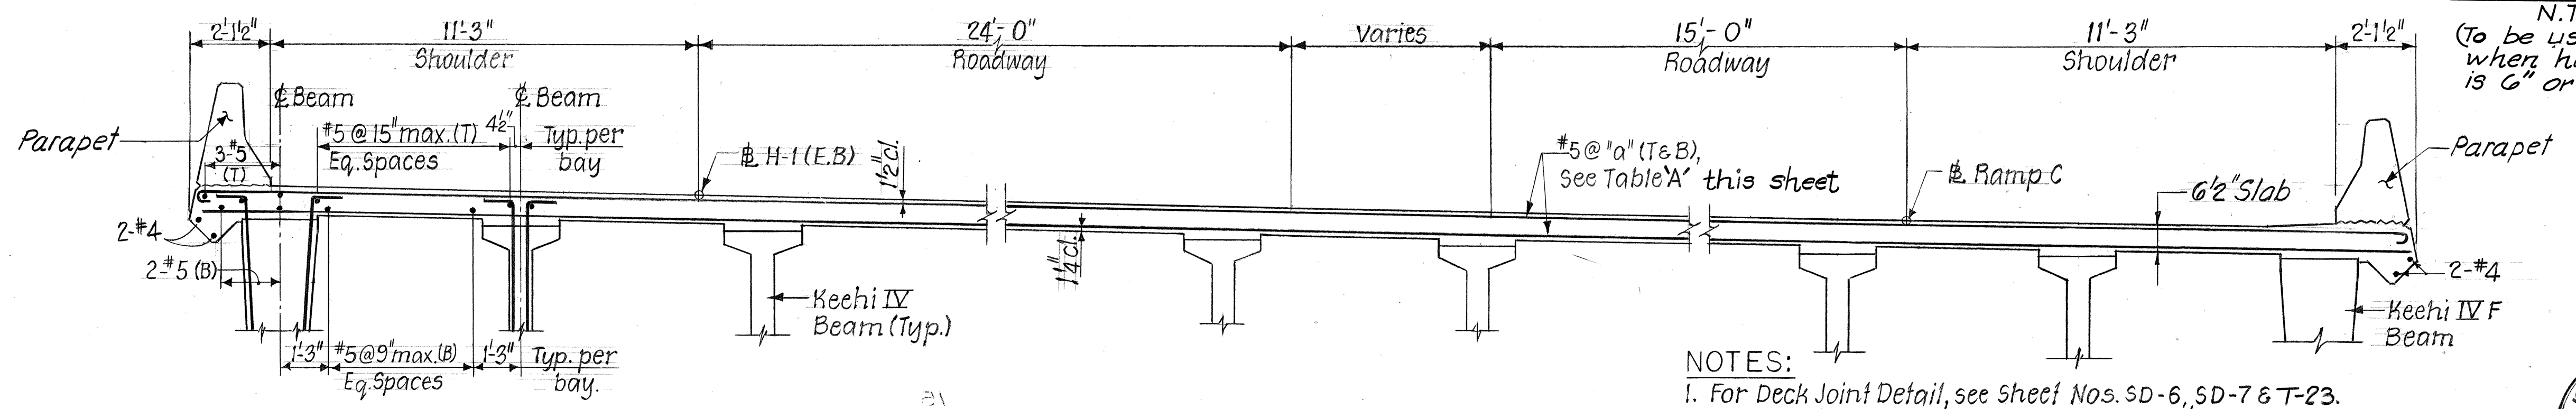

TYPICAL DECK SECTION

For Spans 3HE, 4HE and 5HE  
Looking Up-Station  
Scale: 3/8" = 1'-0"

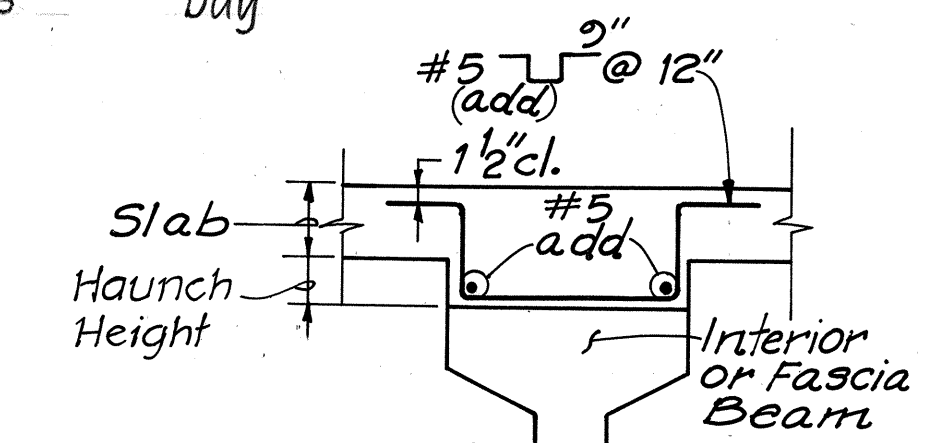


DETAIL 'A'

(To be used only when haunch height is 6" or more)

STANDARD PARAPET DETAIL  
Scale: 1" = 1'-0"  
(For Parapet Reinf., see Sheet No. SD-2)

NOTE A:  
The entire surface of the joint shall be thoroughly cleaned of surface laitance, curing compound and other material foreign to the concrete. Clean aggregate shall be exposed by abrasive blast cleaning after the curing period or immediately before placing concrete at the joint.

- NOTES:
1. For Deck Joint Detail, see Sheet Nos. SD-6, SD-7 & T-23.
  2. For Framing Plans, see Sheet Nos. T-15 & T-16.
  3. Where bar length would exceed 60 feet, bars shall be spliced in alternate locations.
  4. For additional reinforcement at intermediate and end diaphragms, see Sheet No. T-17.
  5. For additional reinforcement at scuppers, see Sheet No. SD-9.
  6. For allowable stresses of Class A and Class BD Concrete see Sheet No. SD-1.
  7. Deck Slab shall be Class BD Concrete.

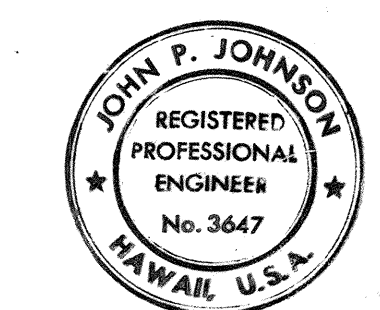

THIS WORK WAS PREPARED BY ME OR UNDER MY SUPERVISION.  
John P. Johnson


STATE OF HAWAII  
DEPARTMENT OF TRANSPORTATION  
HIGHWAYS DIVISION  
H-1 VIADUCT (E.B.), RAMP C & HOV RAMP

DECK REINFORCEMENT  
SHEET 1 OF 2  
KECHI INTERCHANGE  
F.A.I. PROJ. NO. 1-HI-1 (168)-17  
SCALE: AS SHOWN  
DATE: 8/17/81  
SHEET NO. T-20 OF T-23 SHEETS


DATE: \_\_\_\_\_  
SURVEY PLOTTED BY: \_\_\_\_\_  
DRAWN BY: \_\_\_\_\_  
DESIGNED BY: \_\_\_\_\_  
CHECKED BY: \_\_\_\_\_  
ORIGINAL PLAN: \_\_\_\_\_  
NOTE BOOK: \_\_\_\_\_



| FED. ROAD DIST. NO. | STATE | FED. AID PROJ. NO. | FISCAL YEAR | SHEET NO. | TOTAL SHEETS |
|---------------------|-------|--------------------|-------------|-----------|--------------|
| HAWAII              | HAW.  | I-HI-1(168)-17     | 1982        | 80        | 145          |

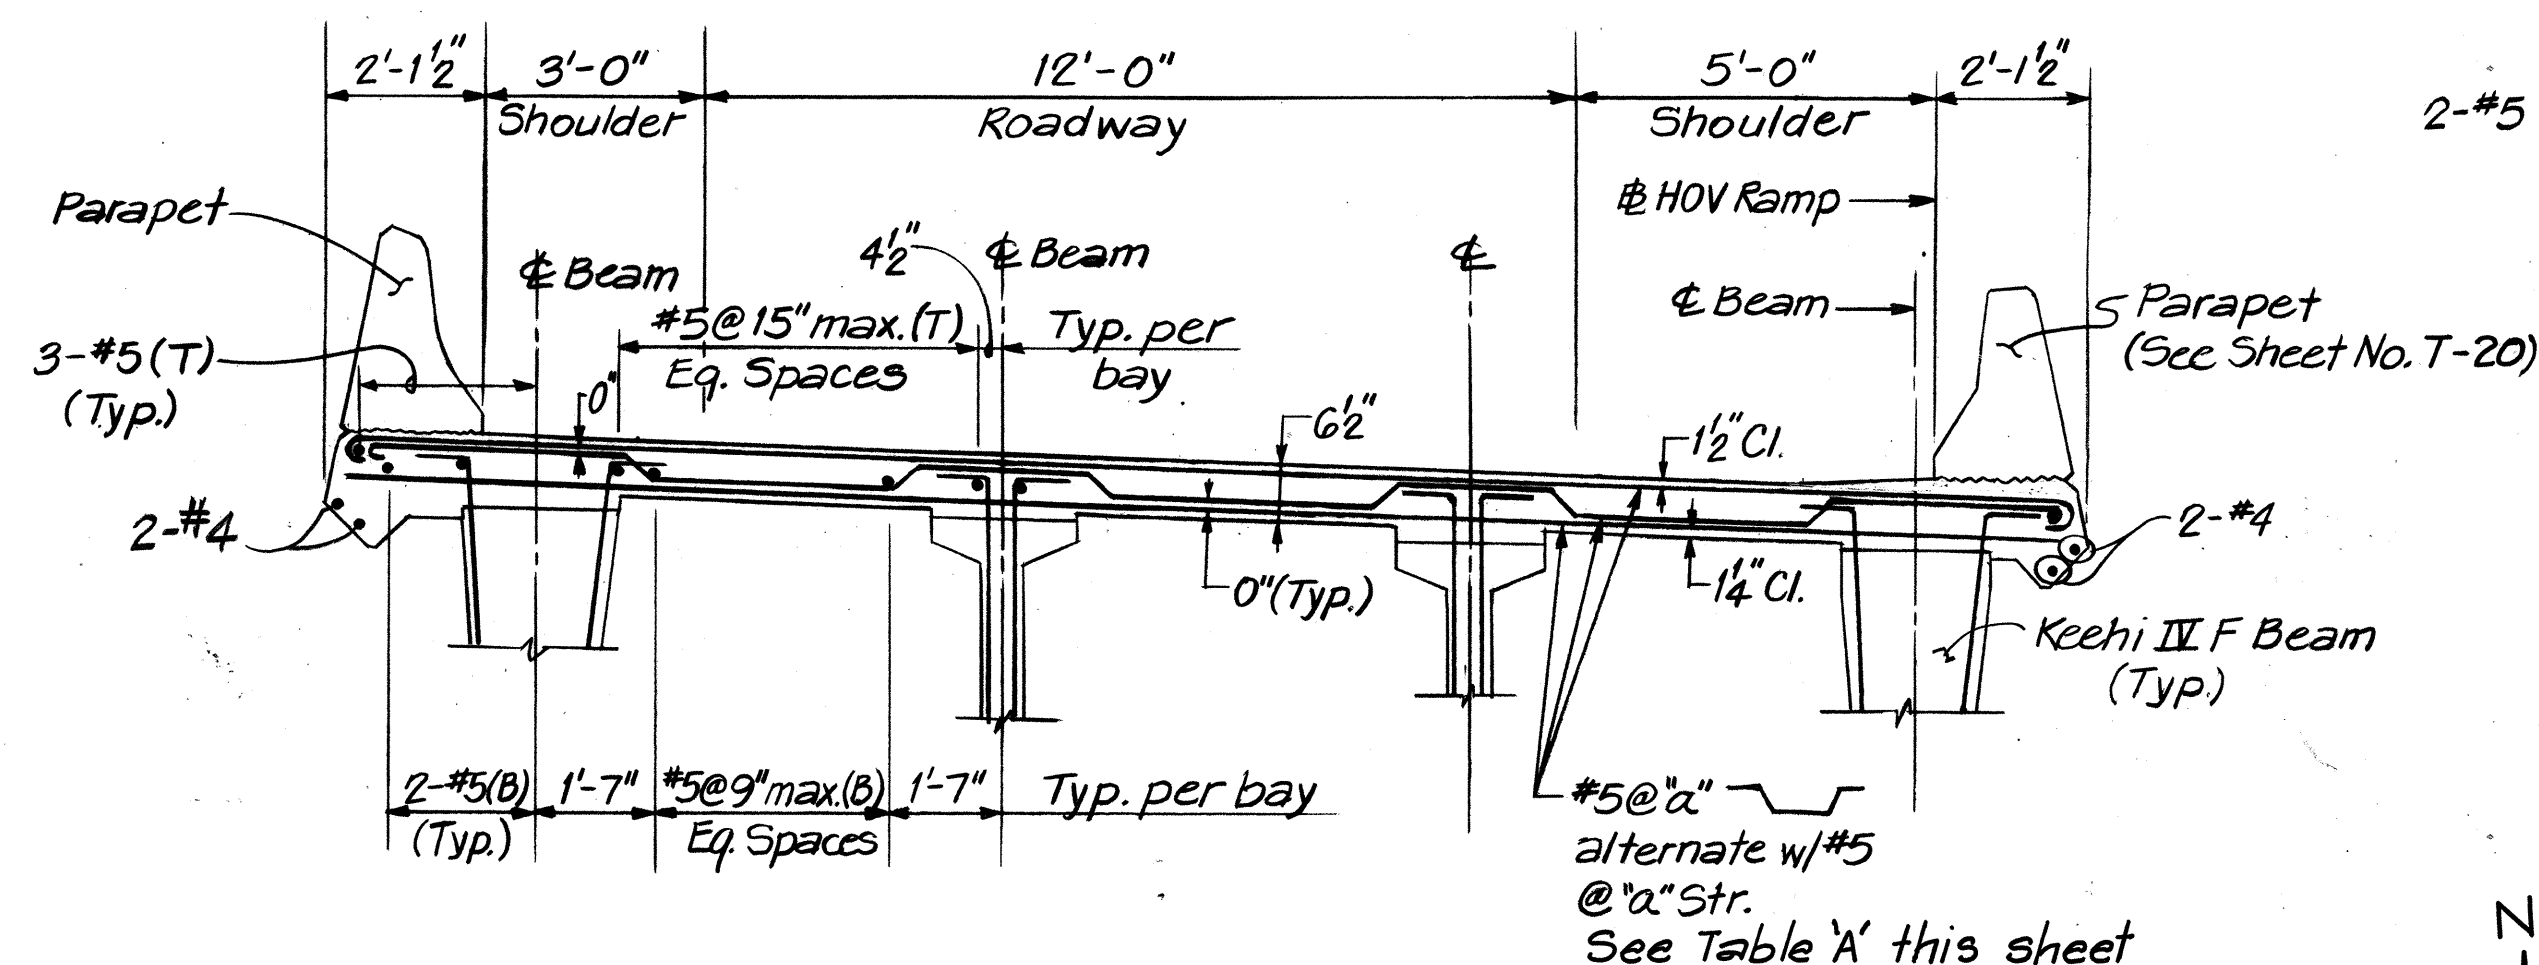


**TYPICAL DECK SECTION**  
FOR HOV RAMP SPANS 1HV, 2HV, 3HV, 5HV & 6HV  
SCALE: 3/8" = 1'-0"

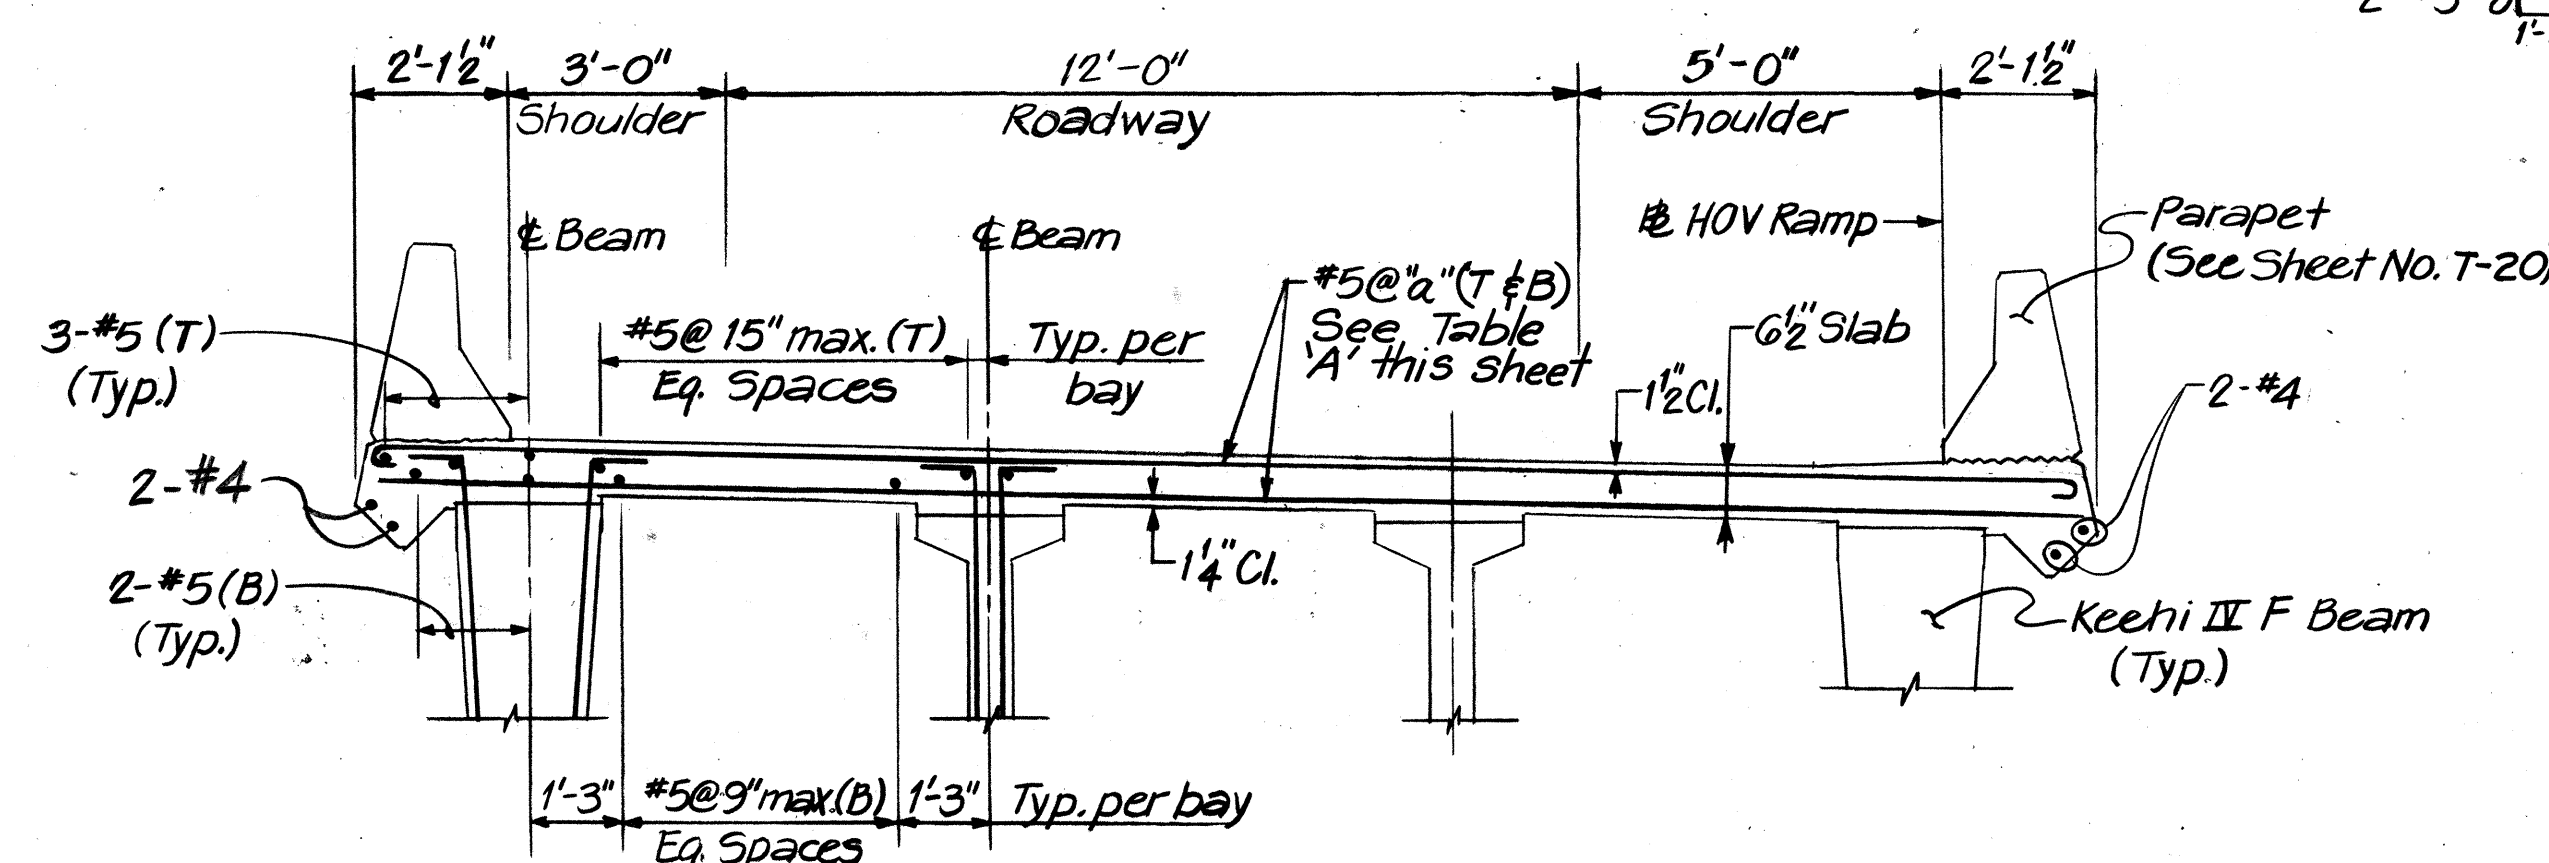


**TYPICAL DECK SECTION**  
FOR HOV RAMP SPAN 4HV  
SCALE: 3/8" = 1'-0"

| TABLE 'A'                   |                        |
|-----------------------------|------------------------|
| SPACING REINF. BARS IN SLAB |                        |
| SPACING @ (max)             | SPAN                   |
| 7"                          | 4HV                    |
| 14"                         | 1HV THRU 3HV, 5HV, 6HV |

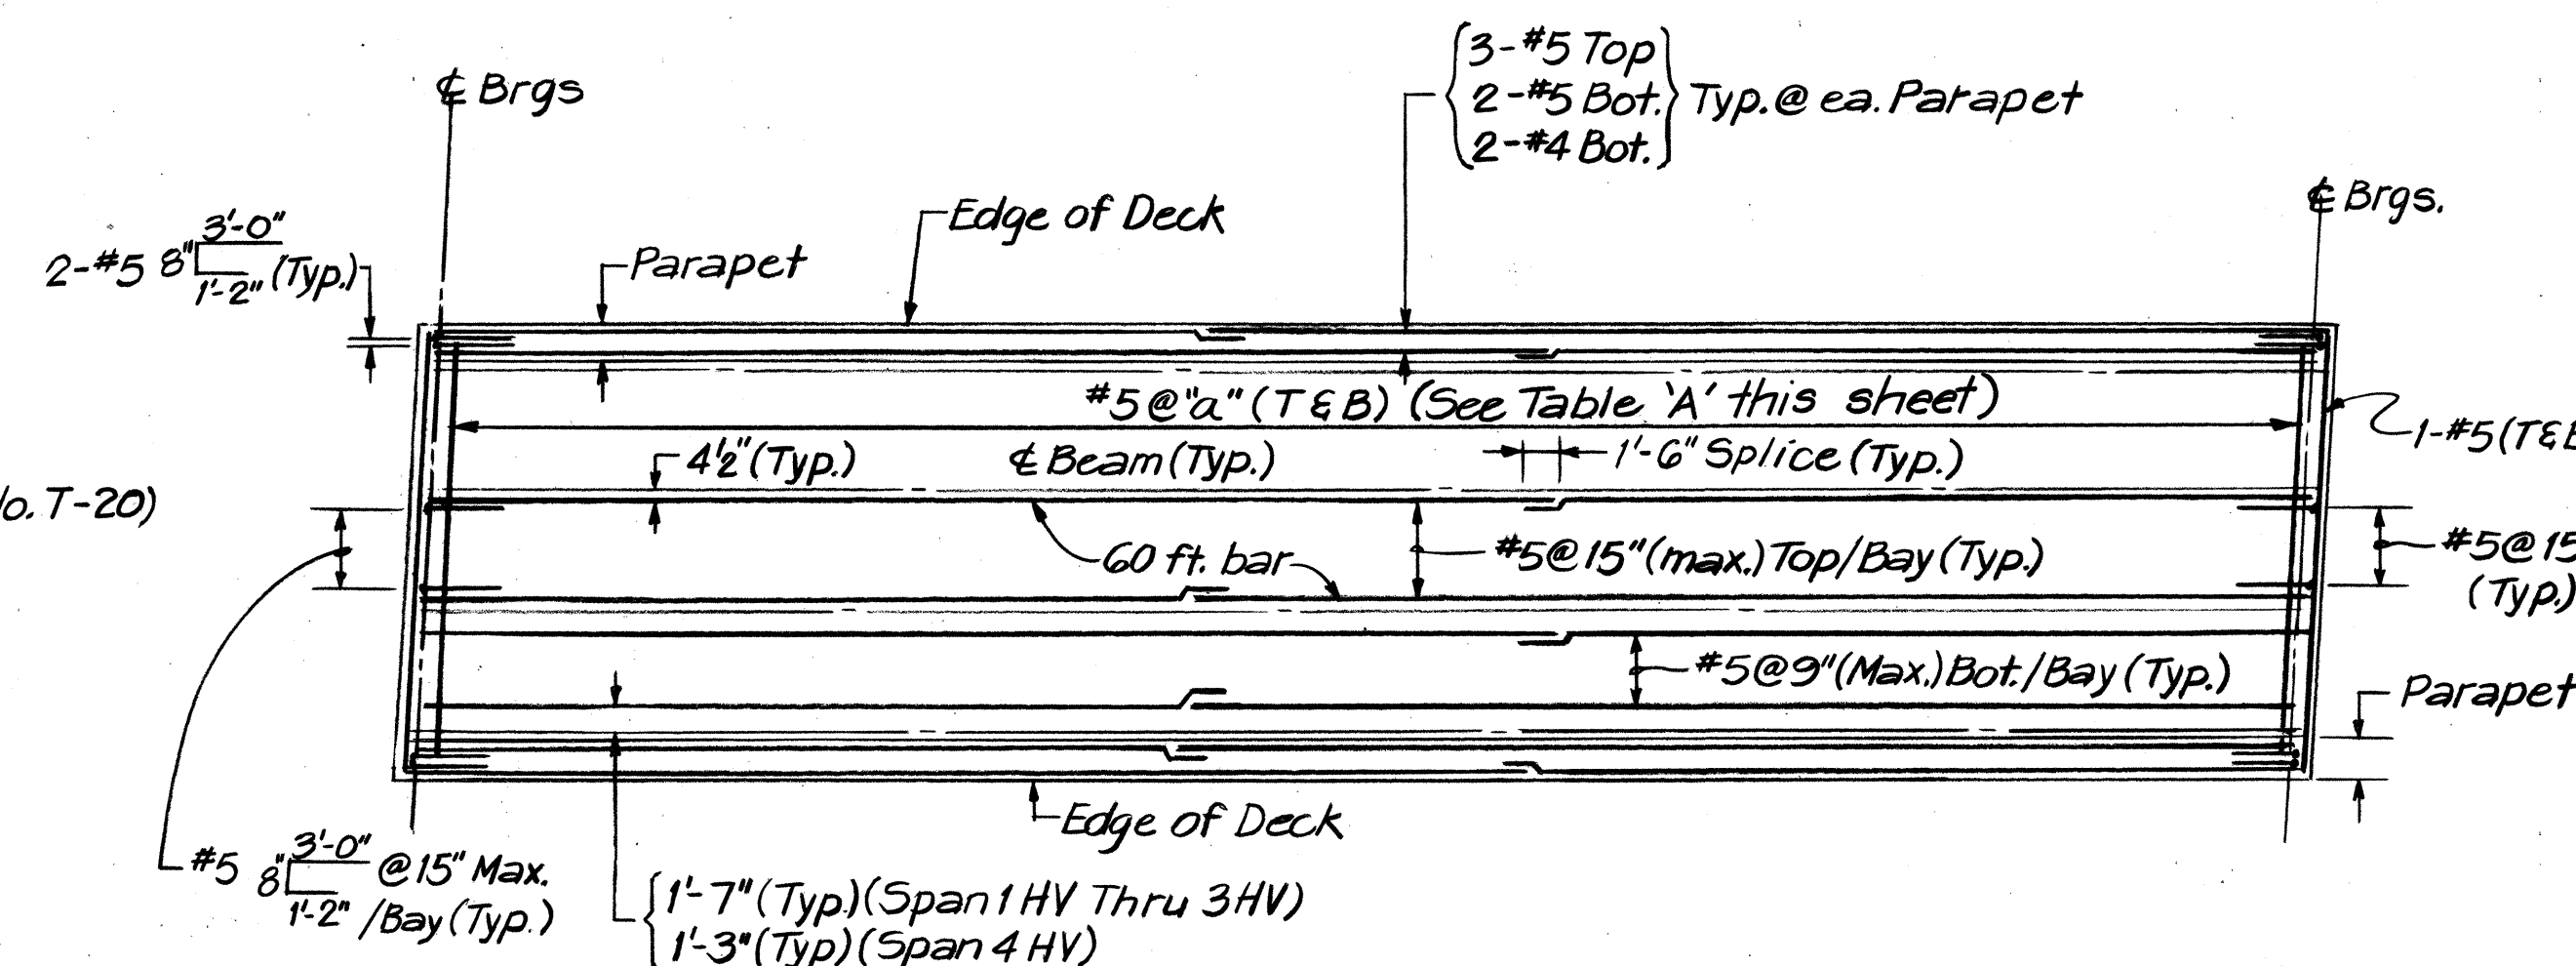


**TYPICAL REINFORCED DECK SLAB**  
(FOR SPANS 1HV THRU 4HV)  
SCALE: 1" = 10'

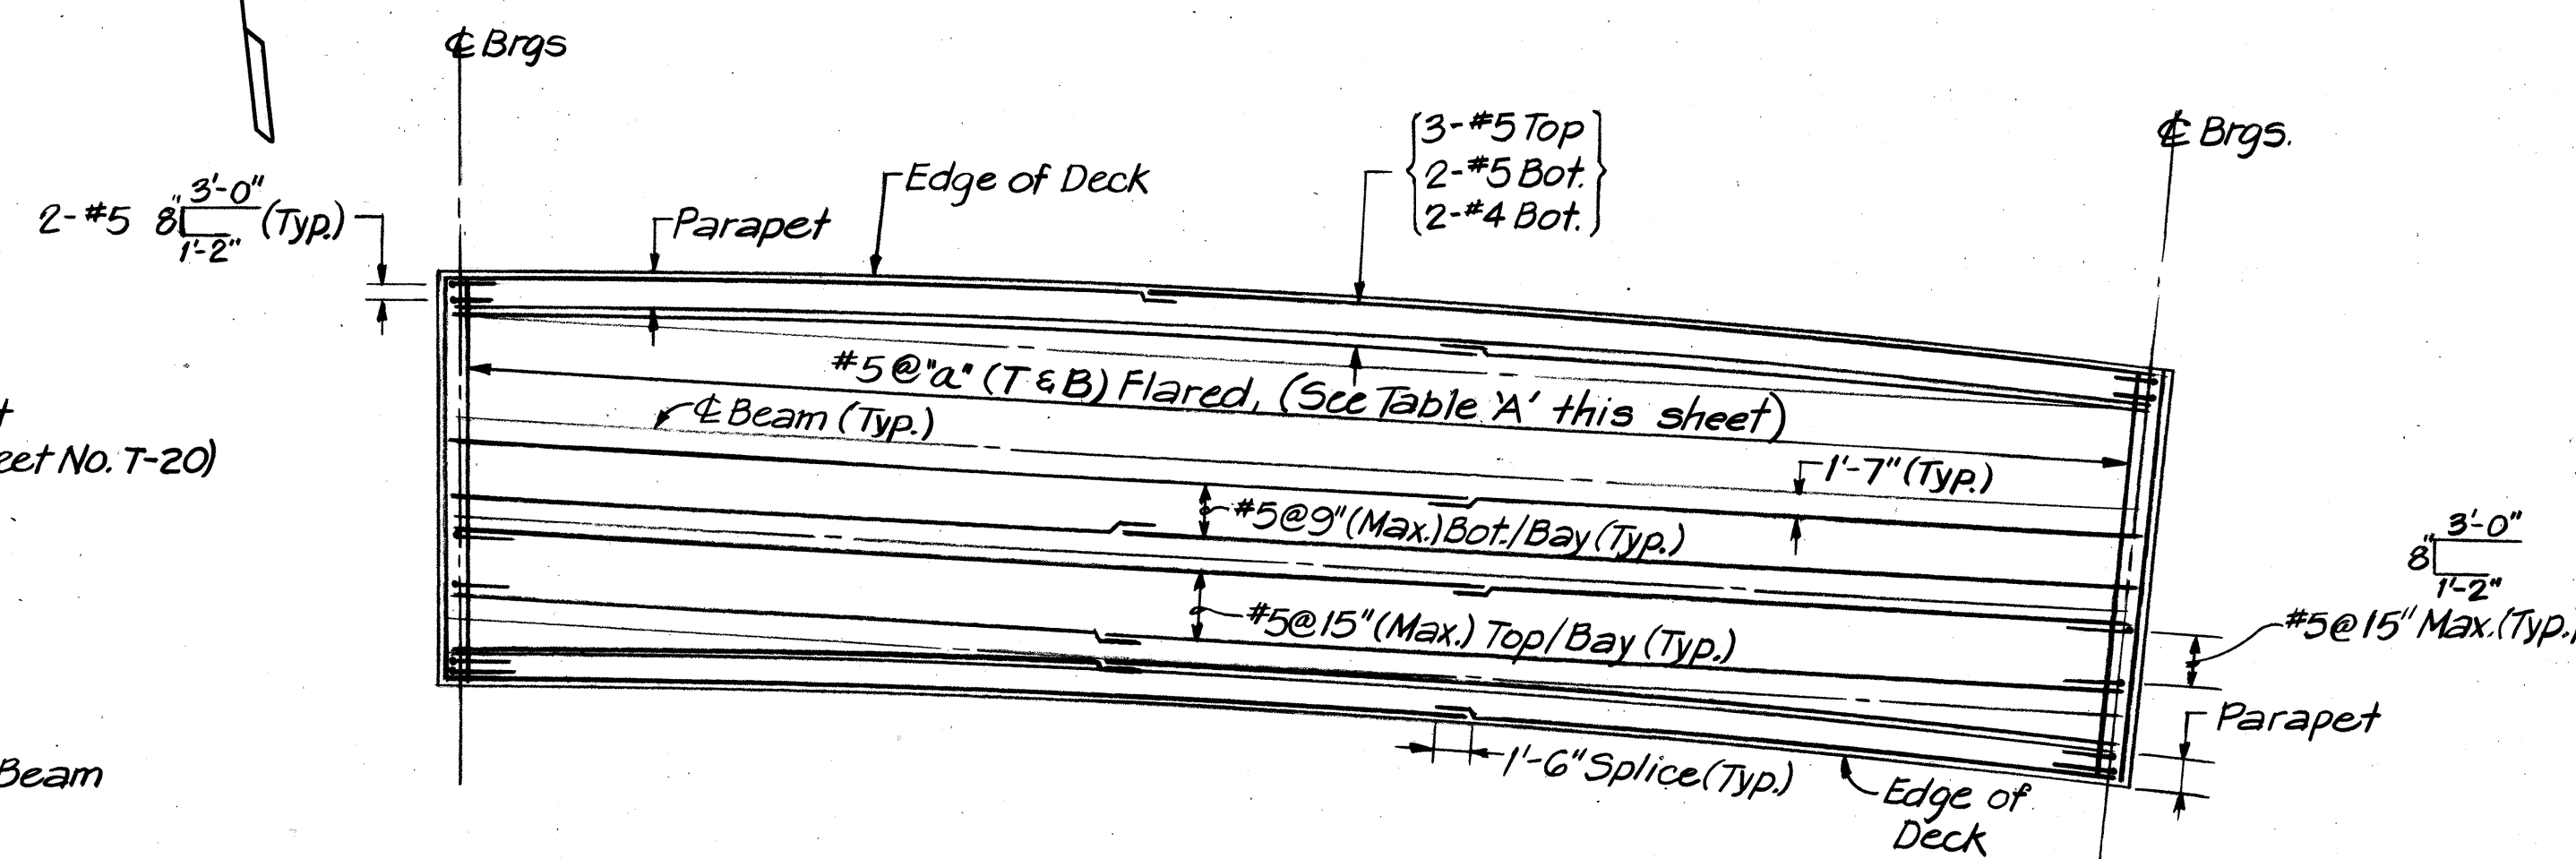

**TYPICAL REINFORCED DECK SLAB**  
(FOR SPANS 5HV, 6HV)  
SCALE: 1" = 10'

- NOTES:**
1. For allowable stresses of Class A & Class BD Concrete see Sheet No. SD-1.
  2. For General Plan and Elevation, see Sheet No. T-2.
  3. For Framing Plan, see Sheet Nos. T-15 & T-16.
  4. For Deck Joint Details, see Sheet Nos. SD-6, SD-7.
  5. For Standard Parapet Detail, Reinforcement & Deck Cross Slope for Drainage, see Sheet No. SD-2.
  6. All longitudinal reinforcing to be parallel to beams except in flared bays.
  7. Alternate all splices in longitudinal and transverse directions where the total length of reinforcing bars exceed 60'-0".
  8. For additional reinforcement at End and Intermediate Diaphragms, see Sheet No. T-19.
  9. For location of scuppers, see Sheet No. T-2.
  10. For add. reinf. at scuppers, see Sheet No. SD-9.
  11. Deck Slab shall be Class BD Concrete.

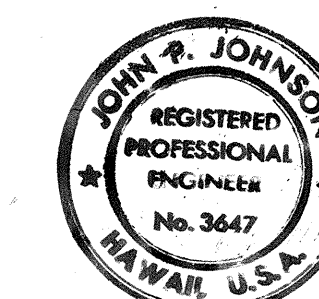

THIS WORK WAS PREPARED BY  
ME OR UNDER MY SUPERVISION.

John P. Johnson


STATE OF HAWAII  
DEPARTMENT OF TRANSPORTATION  
LAND TRANSPORTATION FACILITIES DIVISION  
H-1 VIADUCT (E.B.), RAMP C & HOV RAMP

**DECK REINFORCEMENT**  
SHEET 2 OF 2


KEEHI INTERCHANGE  
F.A.I. PROJECT NO. I-HI-1(168)-17  
SCALE: AS SHOWN DATE: 8/17/81  
SHEET NO. T-21 OF T-23 SHEETS




| FED. ROAD DIST. NO. | STATE | FED. AID PROJ. NO. | FISCAL YEAR | SHEET NO. | TOTAL SHEETS |
|---------------------|-------|--------------------|-------------|-----------|--------------|
| HAWAII              | HAW.  | 1-HI-1(168)-17     | 1982        | 81        | 145          |

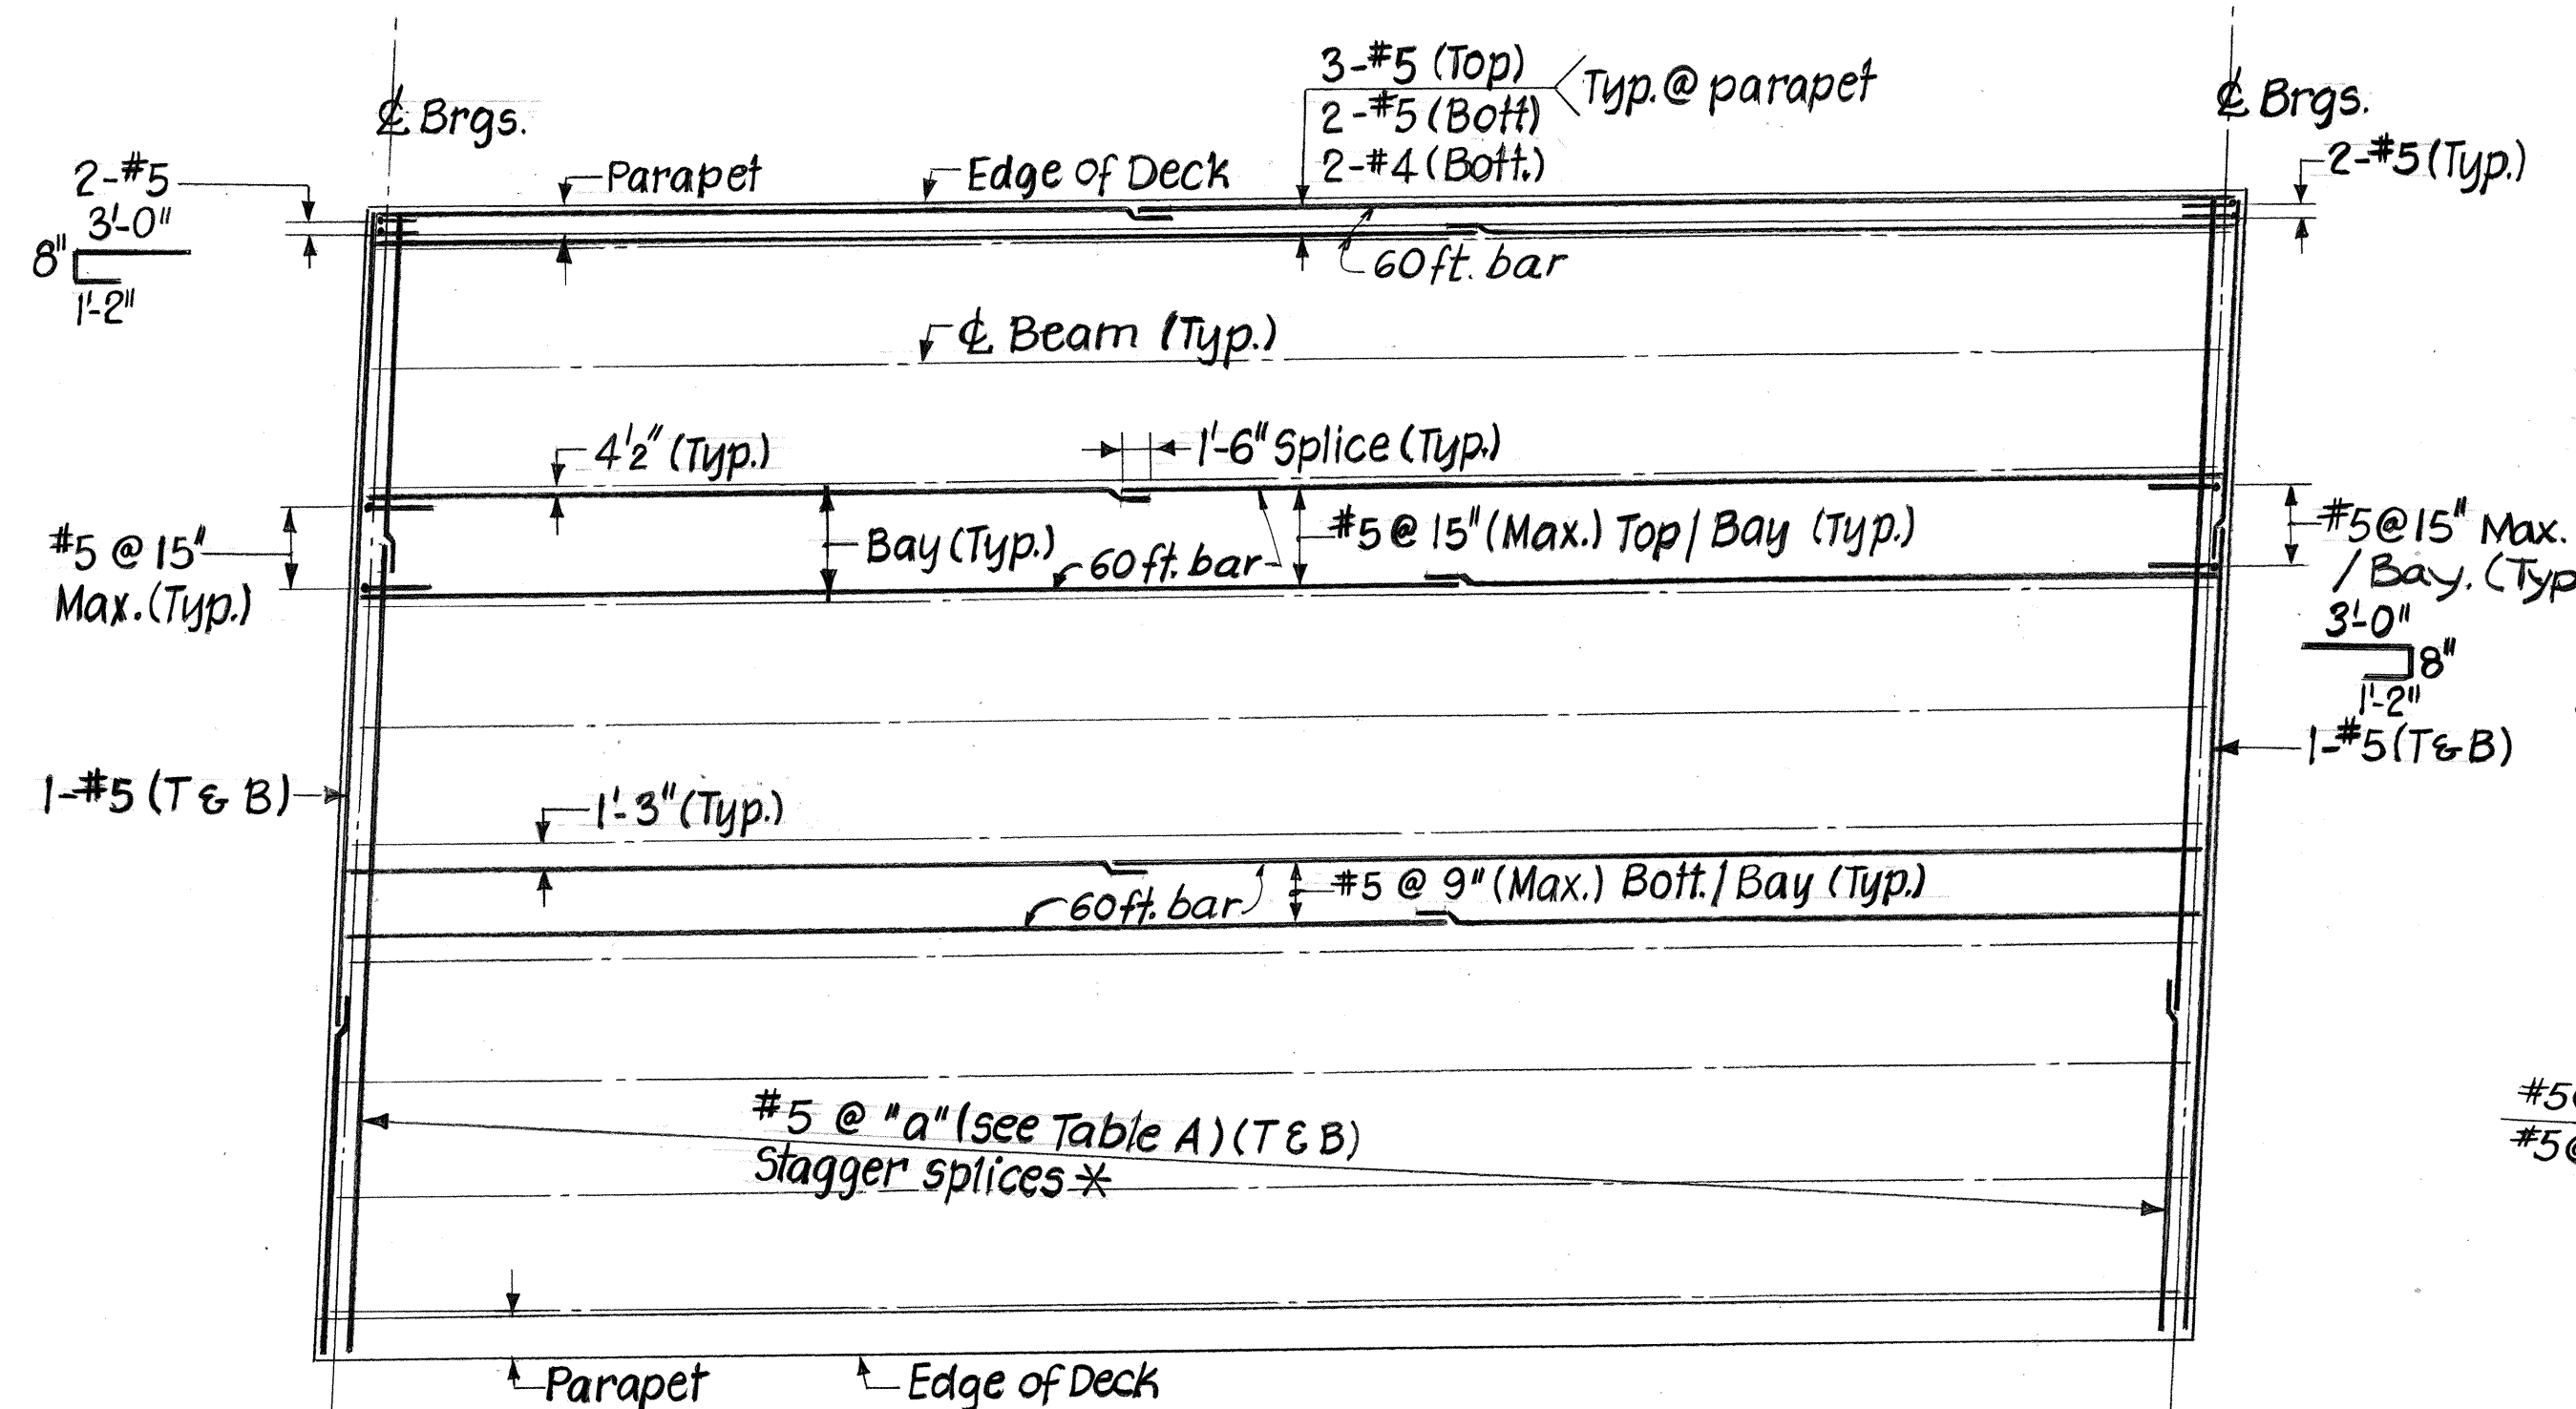


TYPICAL REINFORCED DECK SLAB FOR SPAN 1HE  
Scale: 1" = 10'

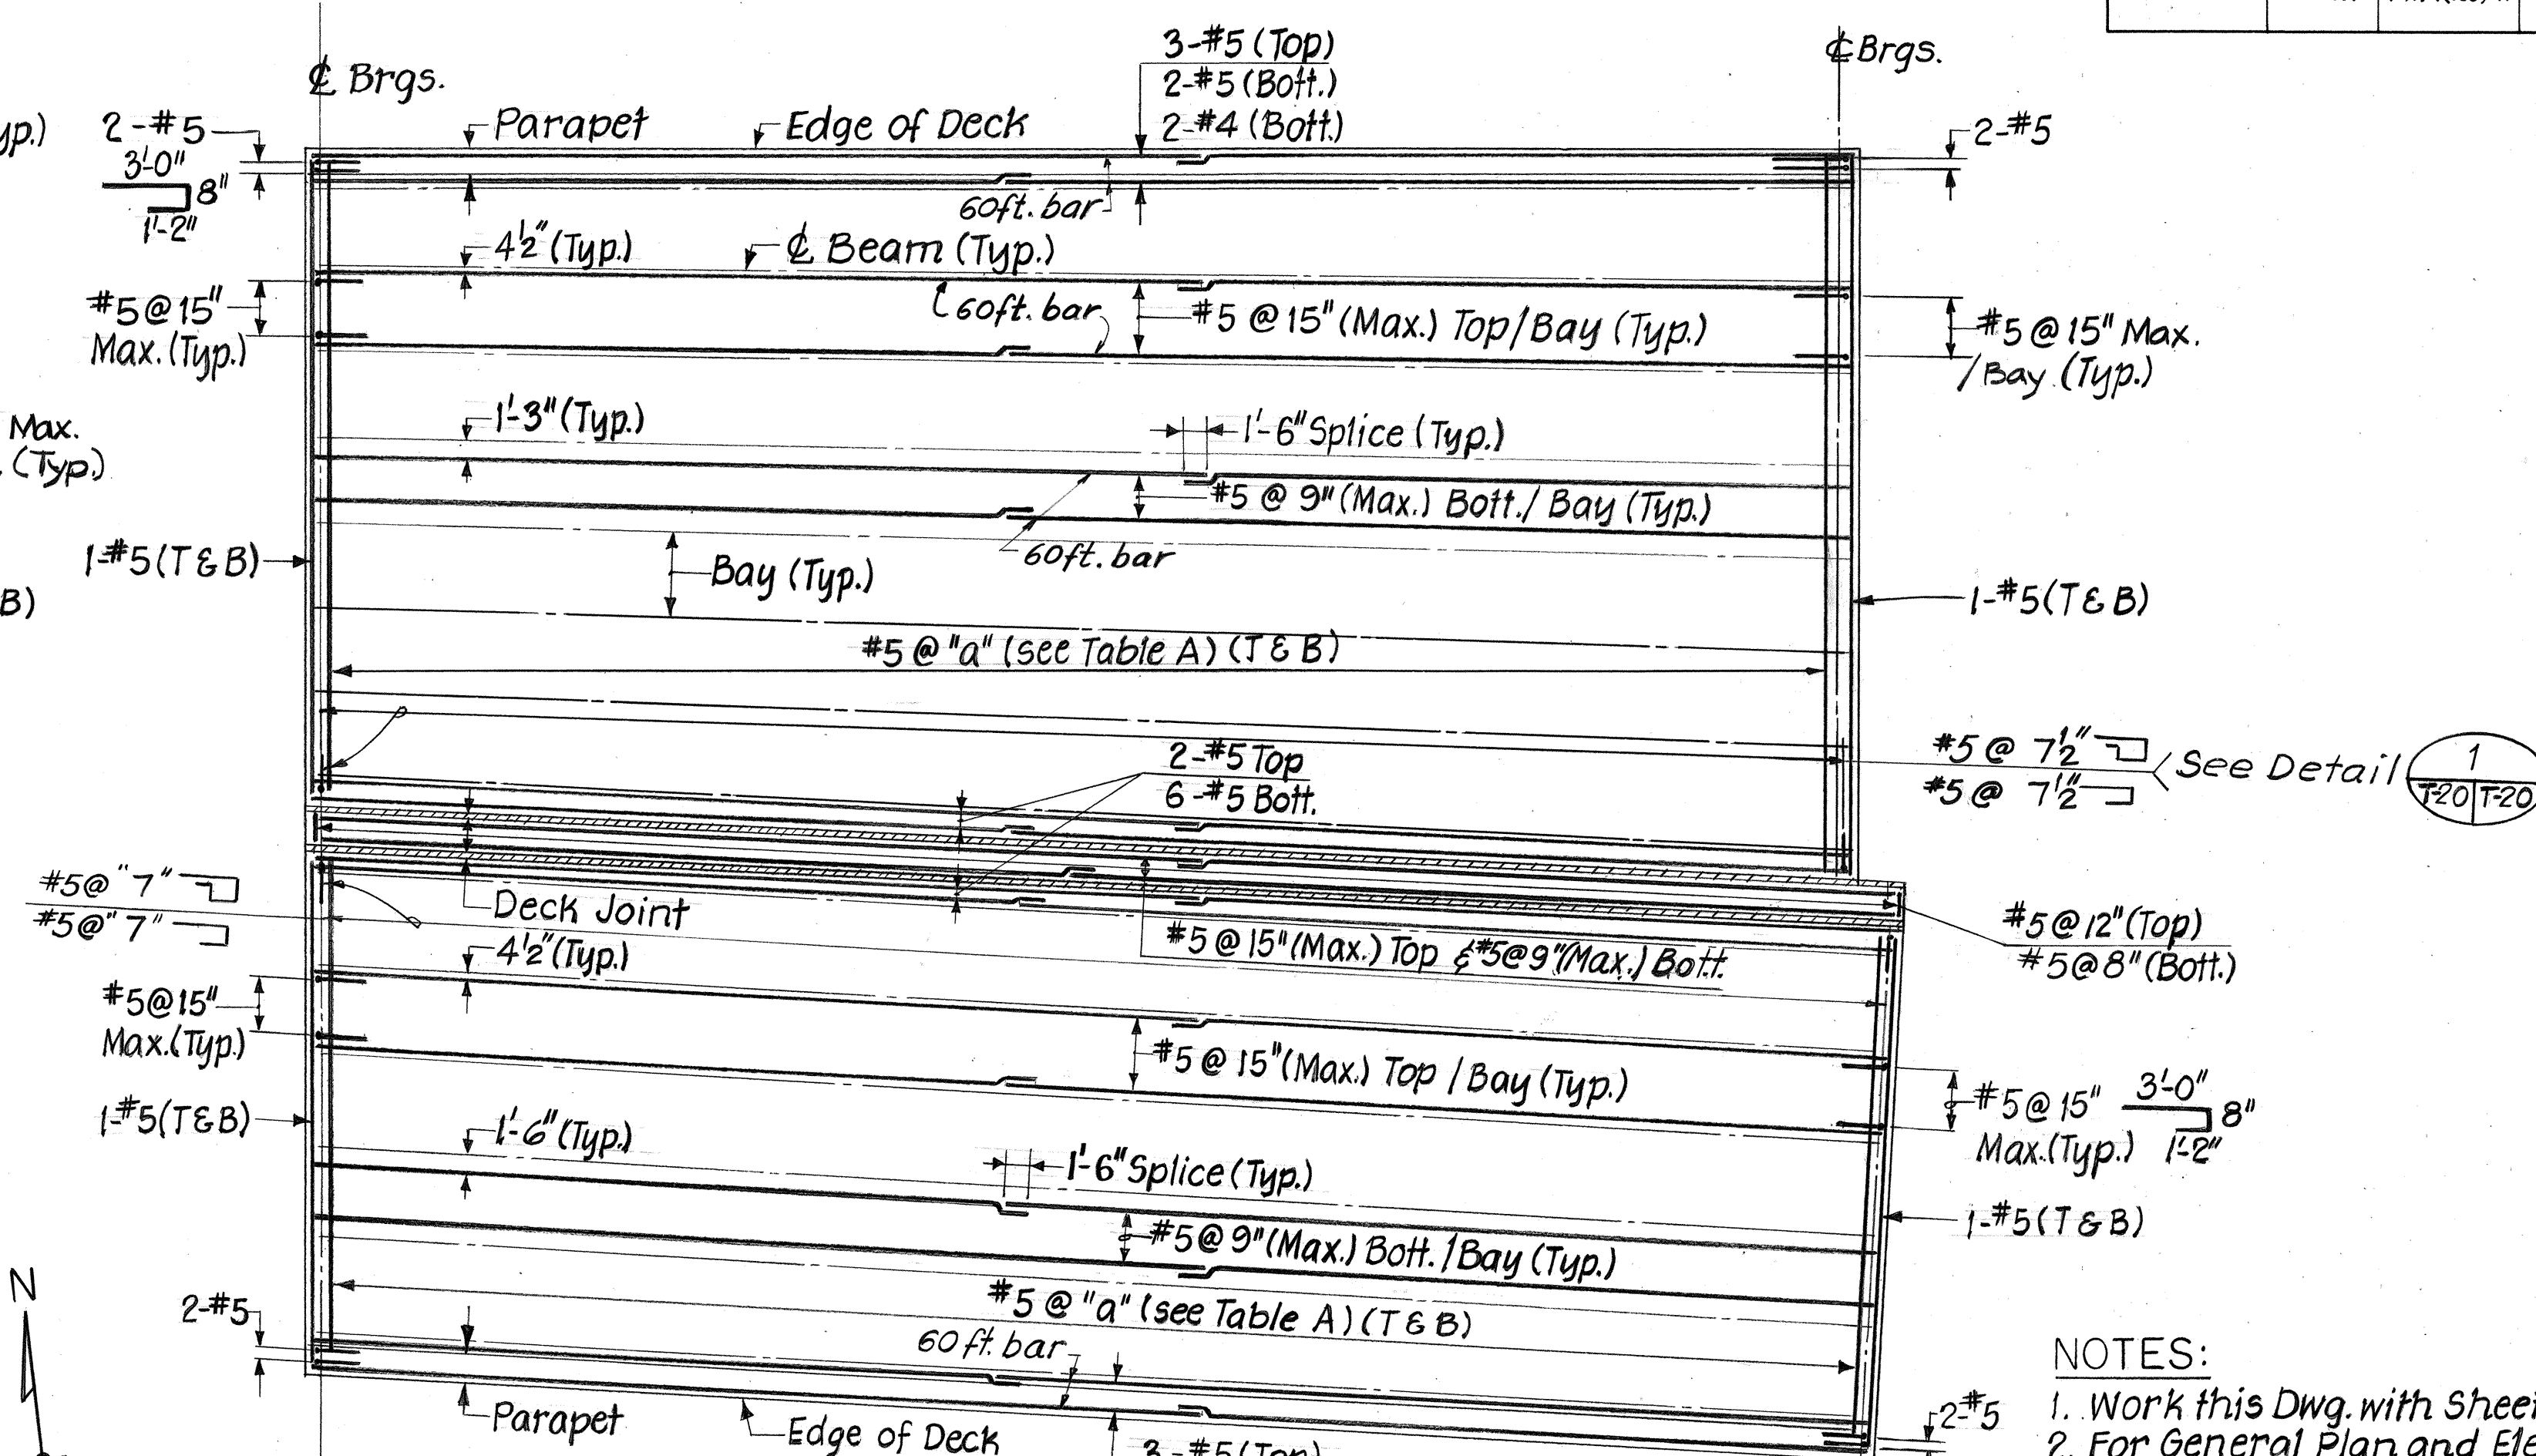

TYPICAL REINFORCED DECK SLAB FOR SPANS 6HE & 1C  
Scale: 1" = 10'

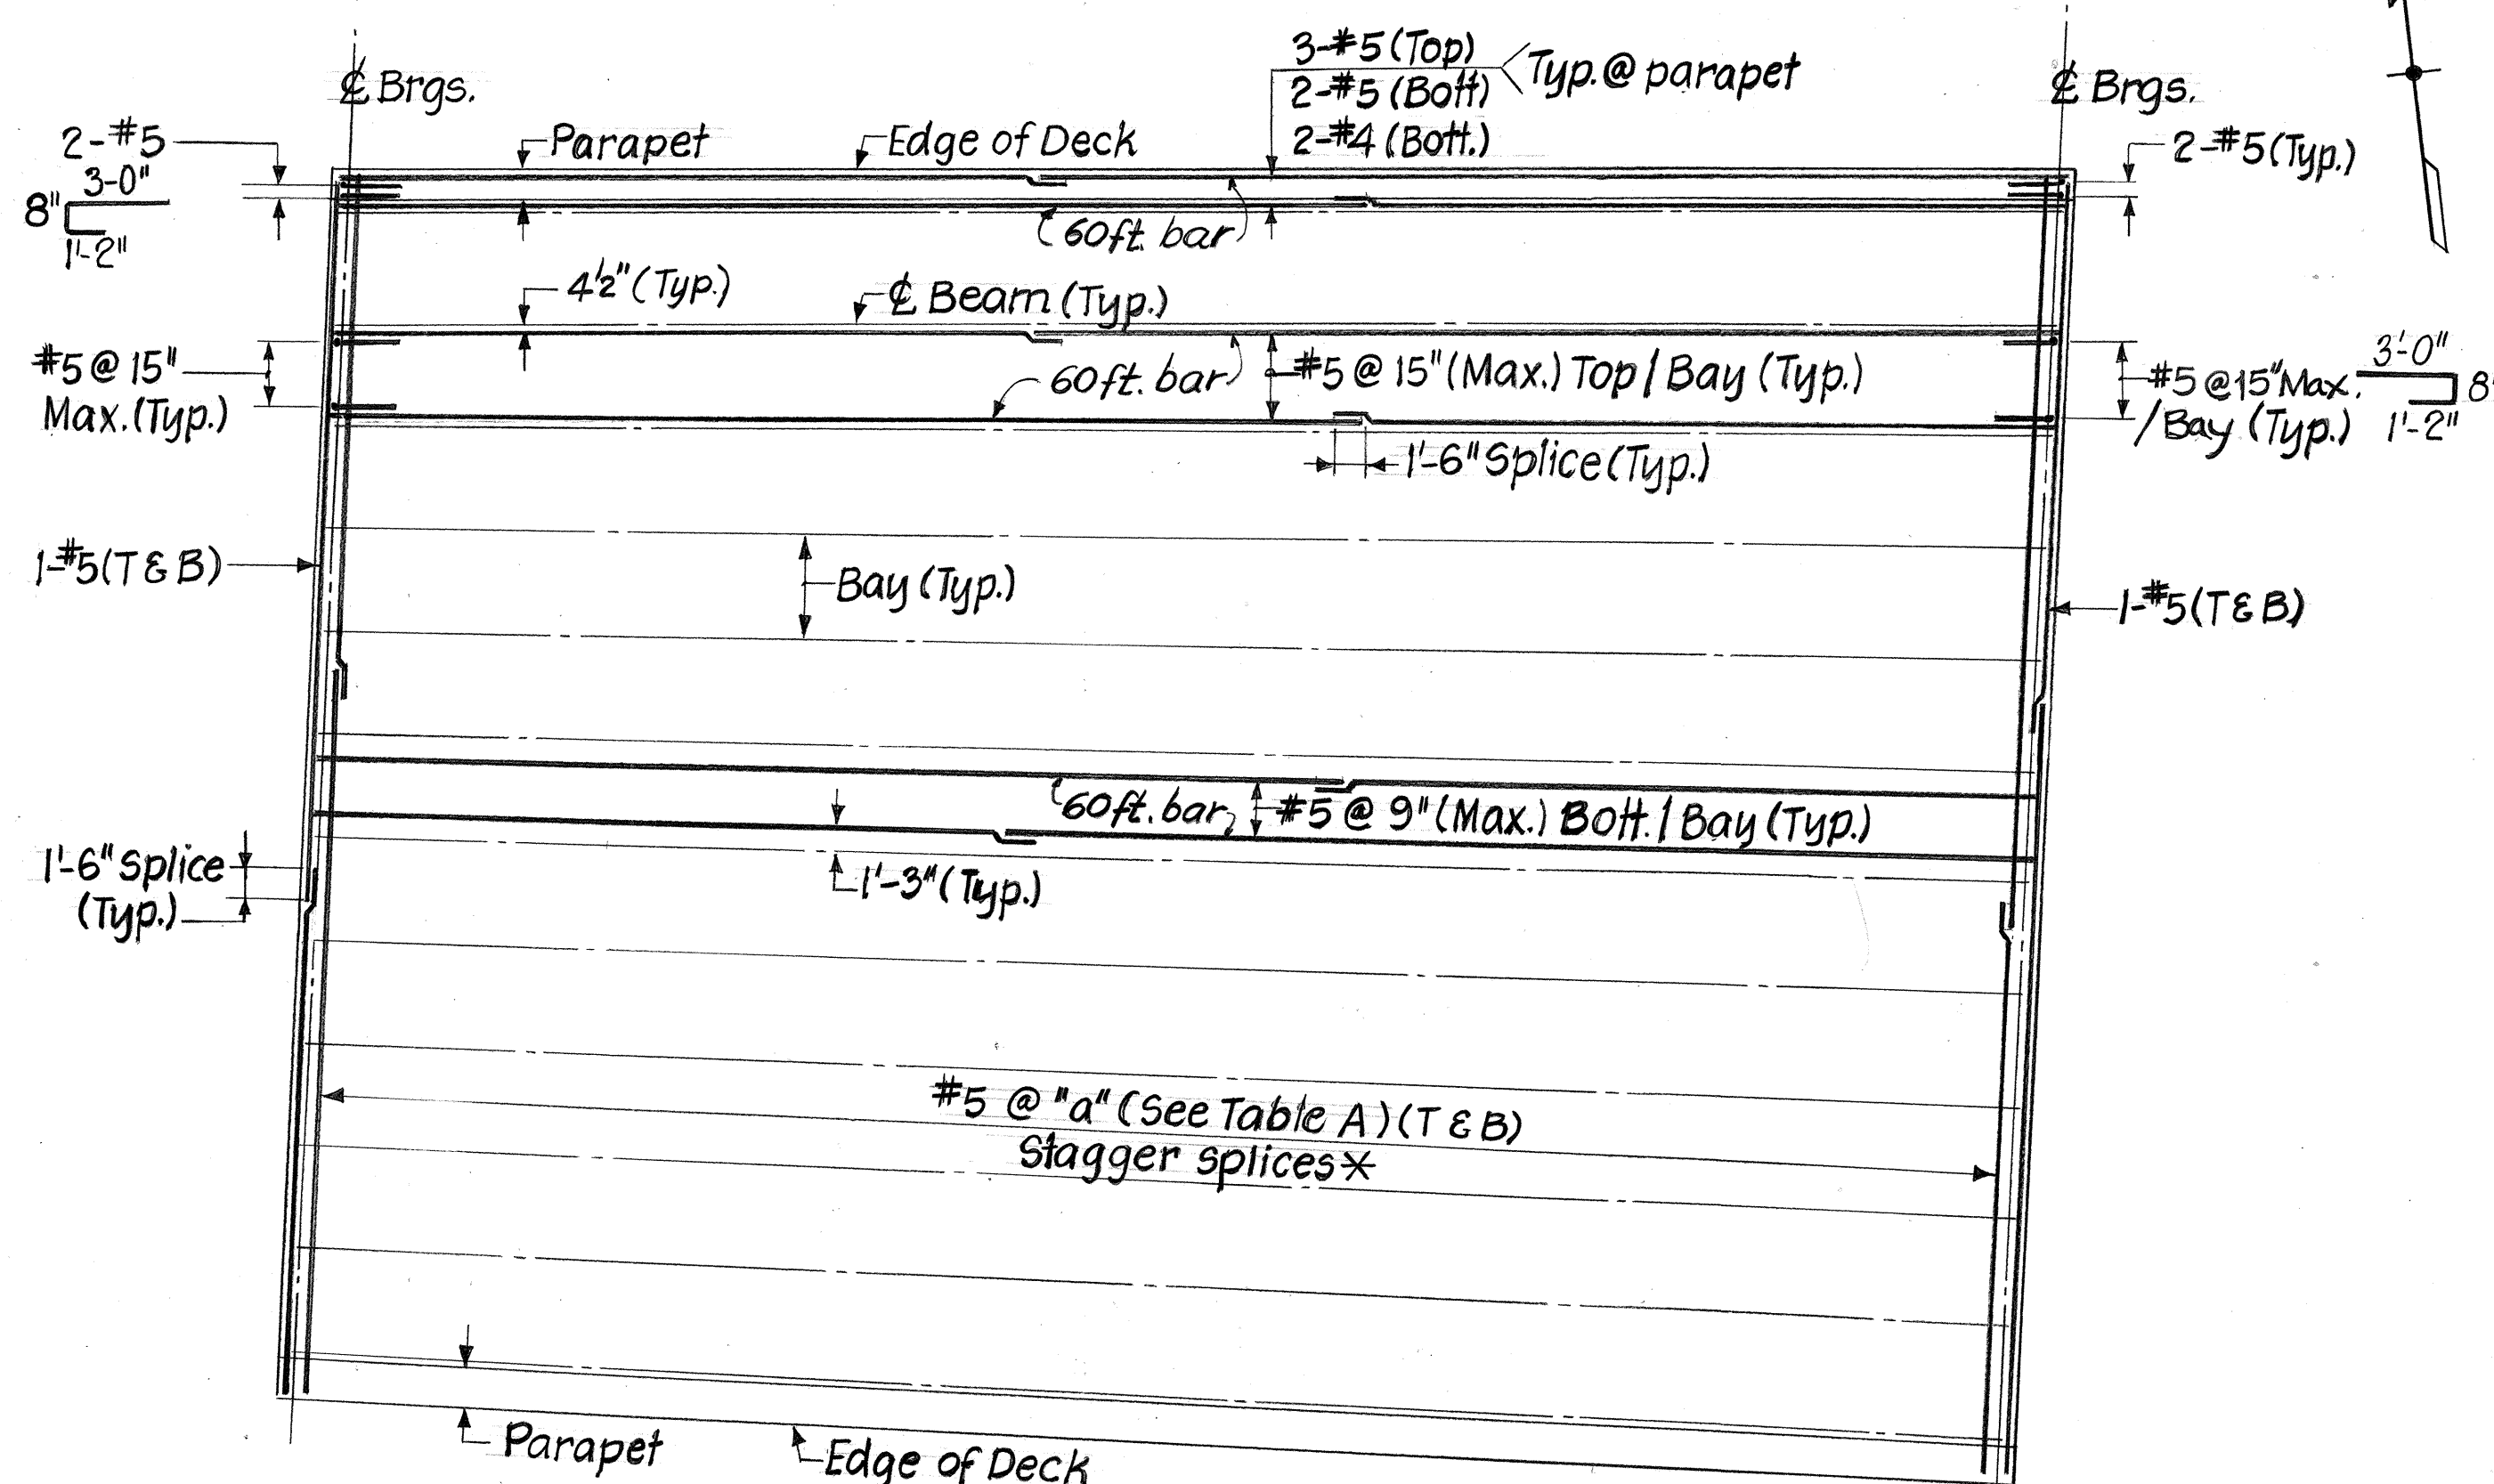


TYPICAL REINFORCED DECK SLAB FOR SPANS 2HE THRU 5HE  
Scale: 1" = 10'

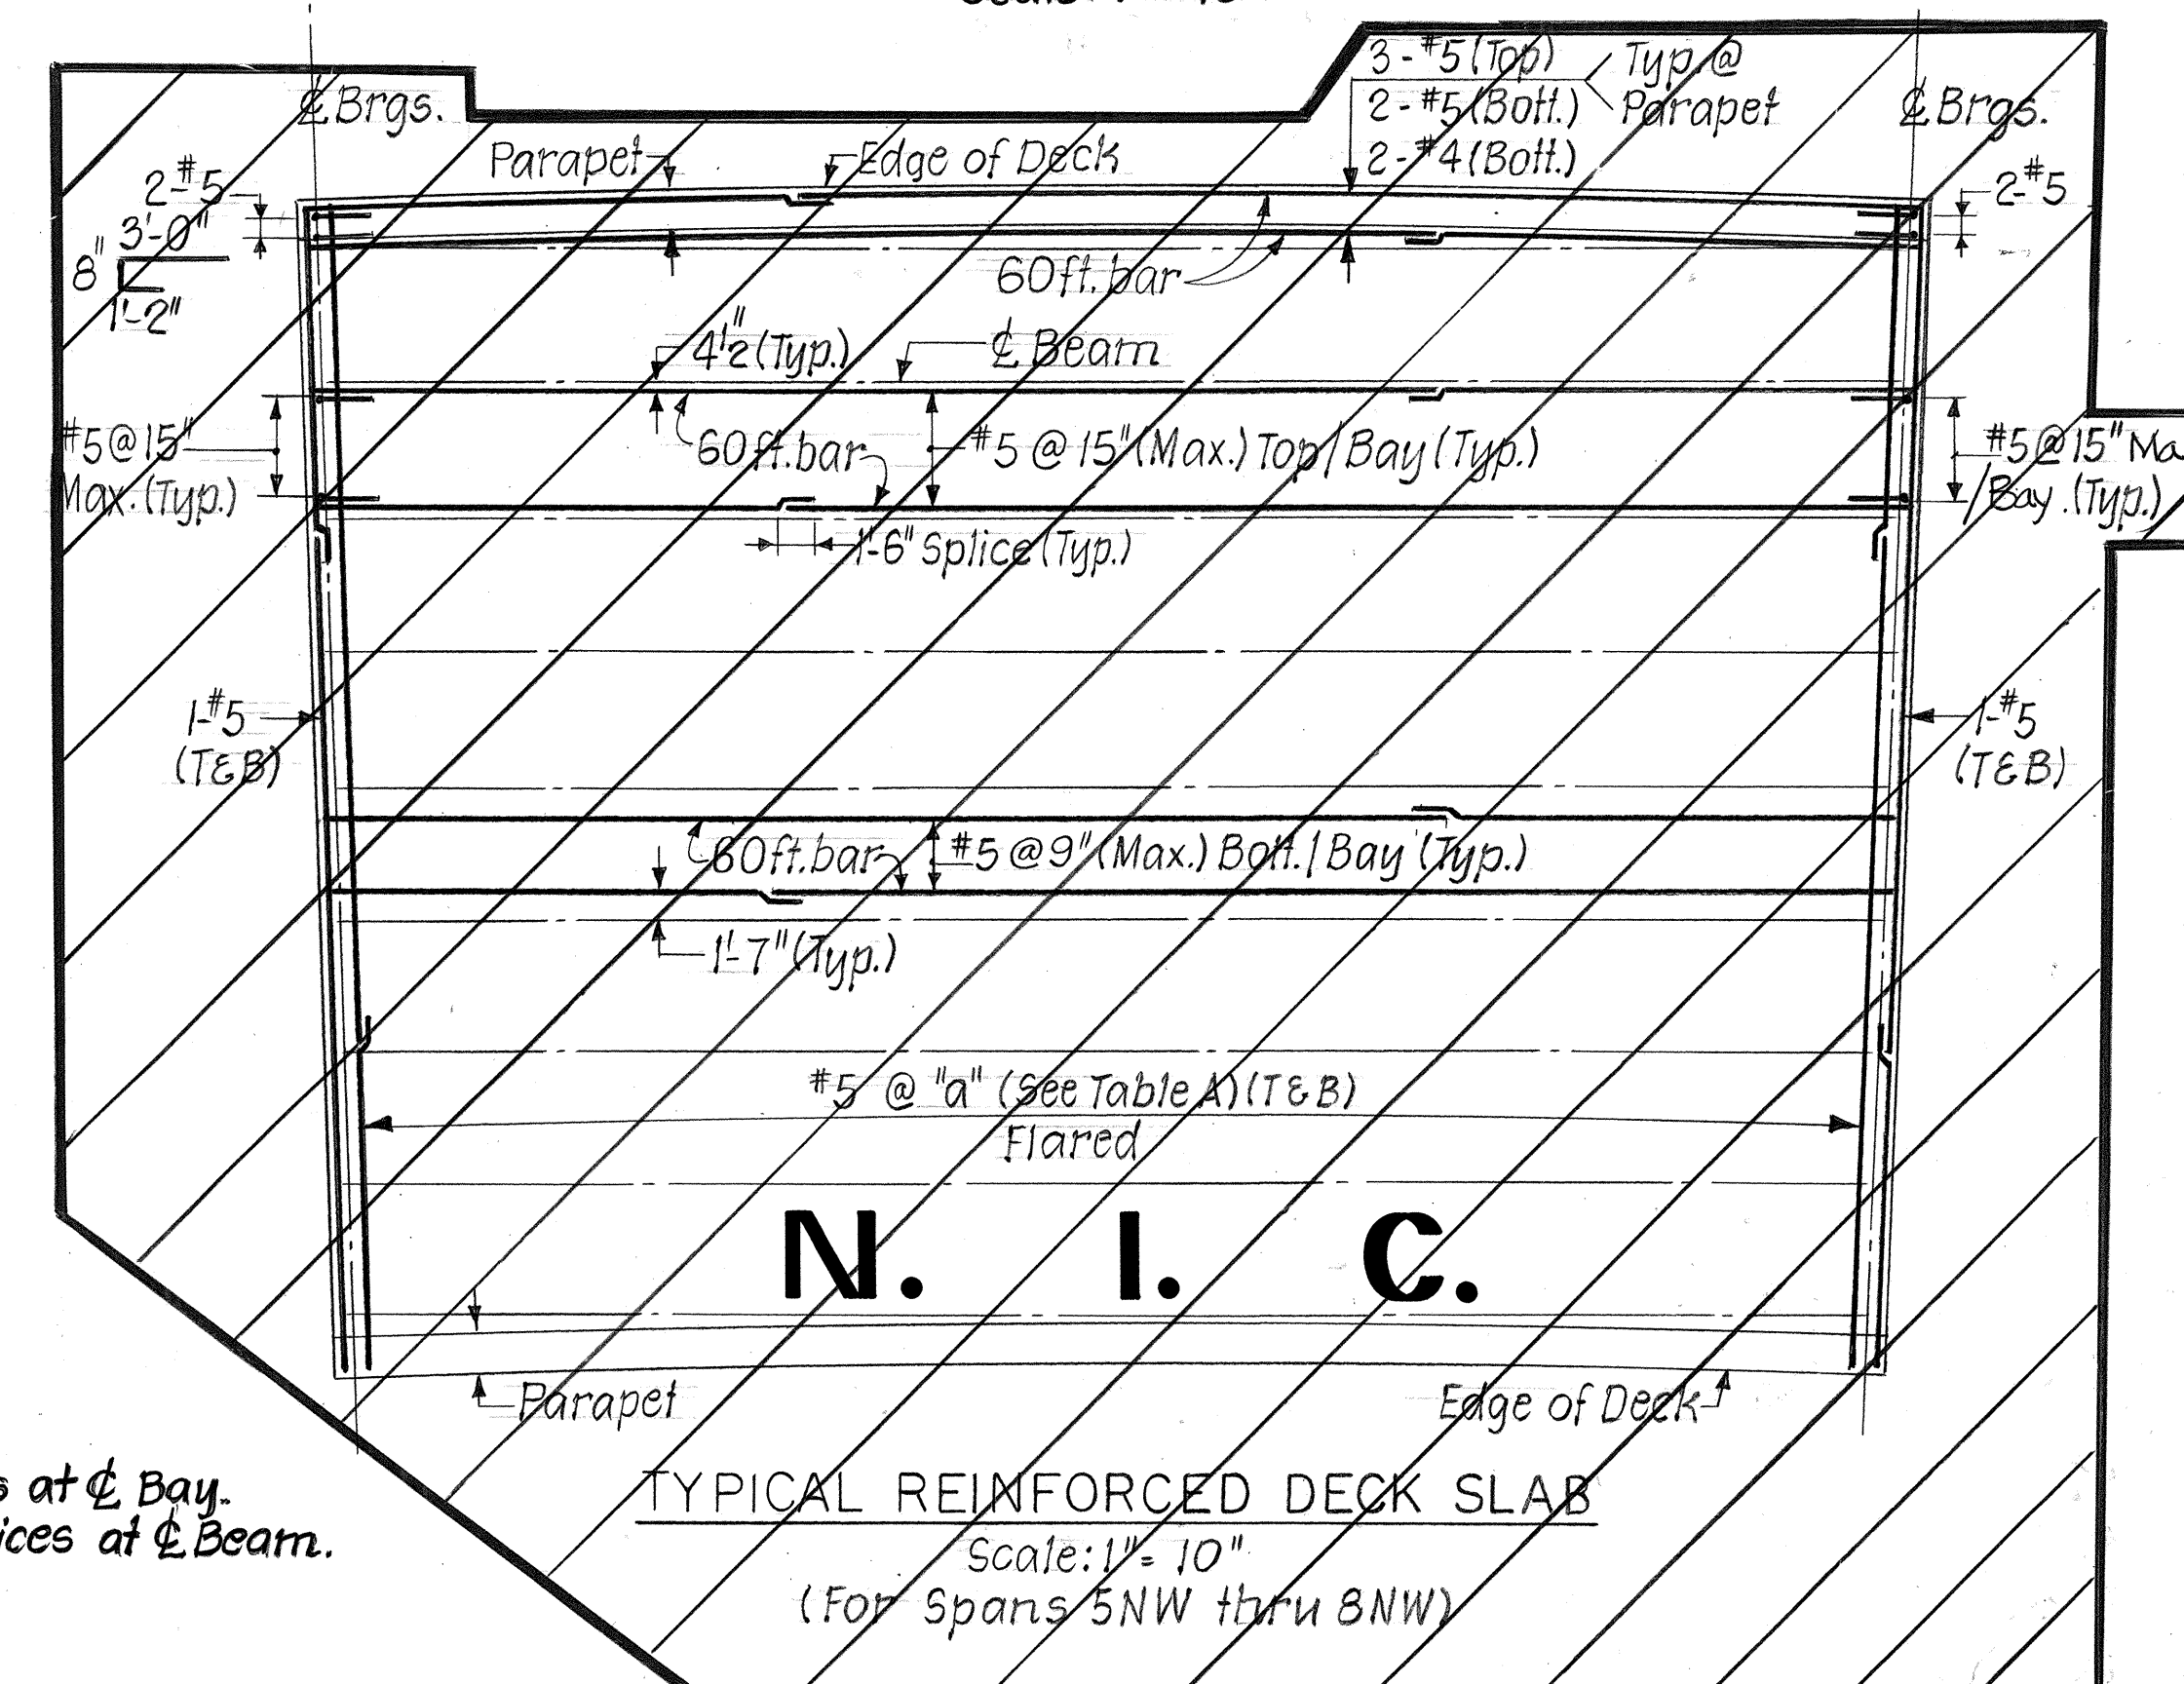

TYPICAL REINFORCED DECK SLAB  
Scale: 1" = 10'  
(For Spans 5NW thru 8NW)

- NOTES:
1. Work this Dwg. with Sheet No. T-20.
  2. For General Plan and Elevation, see Sheet No. T-2.
  3. For Framing Plan, see Sheet Nos. T-15 & T-16.
  4. For Deck Joint Details, see Sheet Nos. SD-6, SD-7 & T-23.
  5. For Standard Parapet Detail, Reinforcement & Deck Cross Slope for Drainage, see Sheet No. SD-2.
  6. All longitudinal reinforcing to be parallel to beams except in flared bays.
  7. Alternate all splices in longitudinal & transverse directions where the total length of reinforcing bars exceed 60'-0".
  8. For additional reinforcement at End & Intermediate Diaphragms, see Sheet No. T-19.
  9. For location of scuppers, see Sheet No. T-2.
  10. For add. reinf. at scuppers, see Sheet No. SD-9.



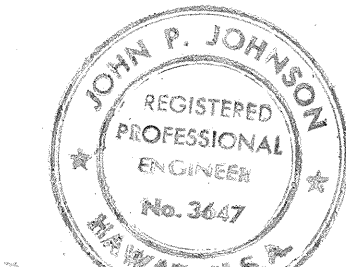


THIS WORK WAS PREPARED BY  
ME OR UNDER MY SUPERVISION.  
*John P. Johnson*

STATE OF HAWAII  
DEPARTMENT OF TRANSPORTATION  
HIGHWAYS DIVISION  
H-1 VIADUCT (E.B.), RAMP C & HOV RAMP  
  
**DECK REINFORCEMENT PLAN**  
  
KEEHI INTERCHANGE  
F.A.I. PROJ. NO. 1-HI-1 (168)-17  
SCALE: AS SHOWN DATE: 8/17/81  
SHEET NO. T-22 OF T-23 SHEETS



| FED. ROAD<br>DIST. NO. | STATE | FED. AID<br>PROJ. NO. | FISCAL<br>YEAR | SHEET<br>NO. | TOTAL<br>SHEETS |
|------------------------|-------|-----------------------|----------------|--------------|-----------------|
| HAWAII                 | HAW.  | E-HI-1168-17          | 1982           | 82           | 145             |

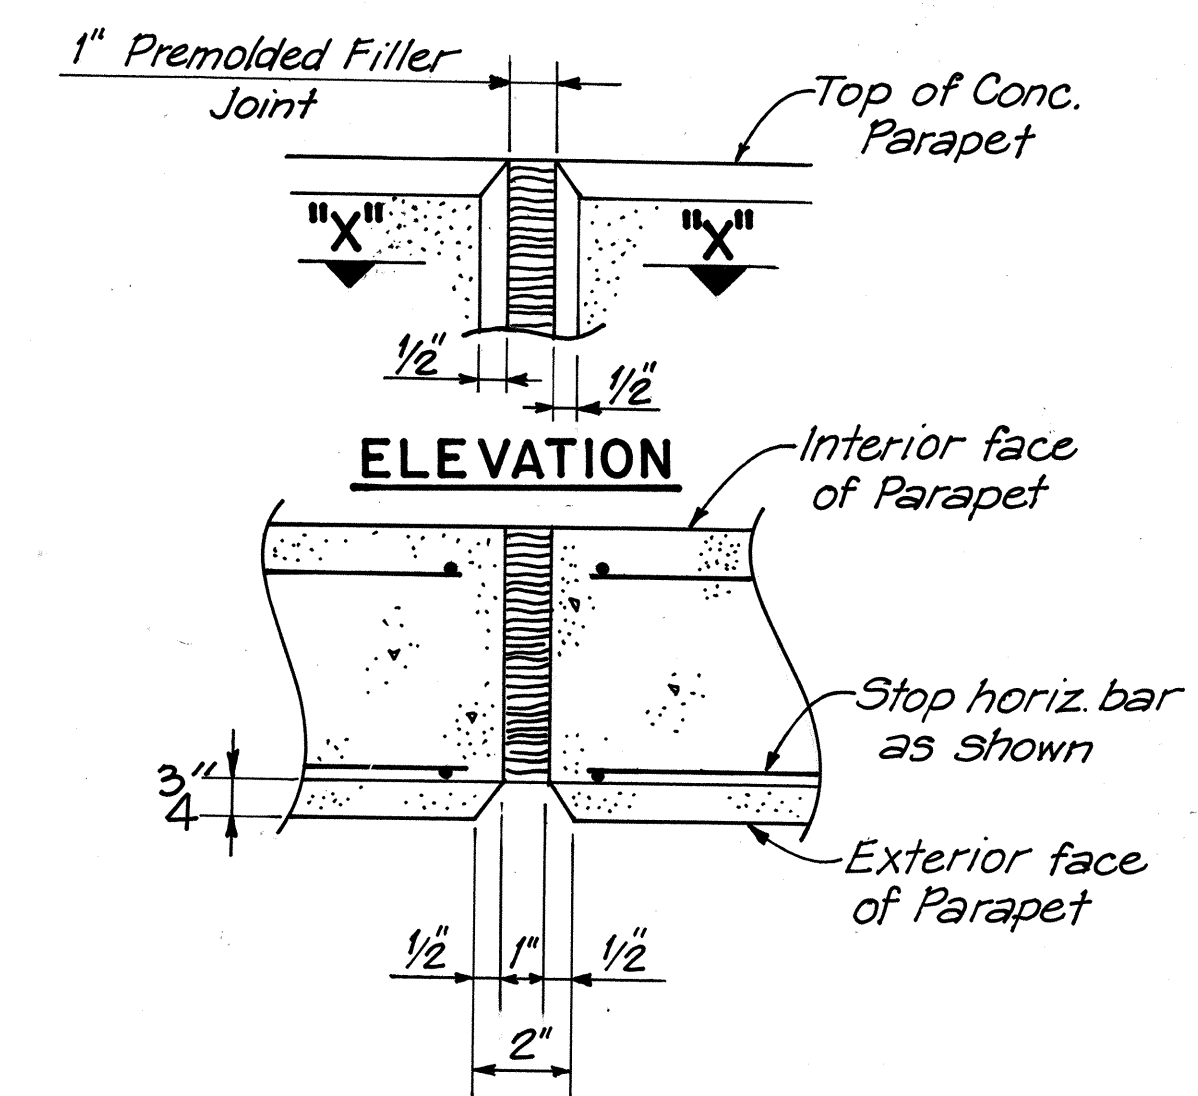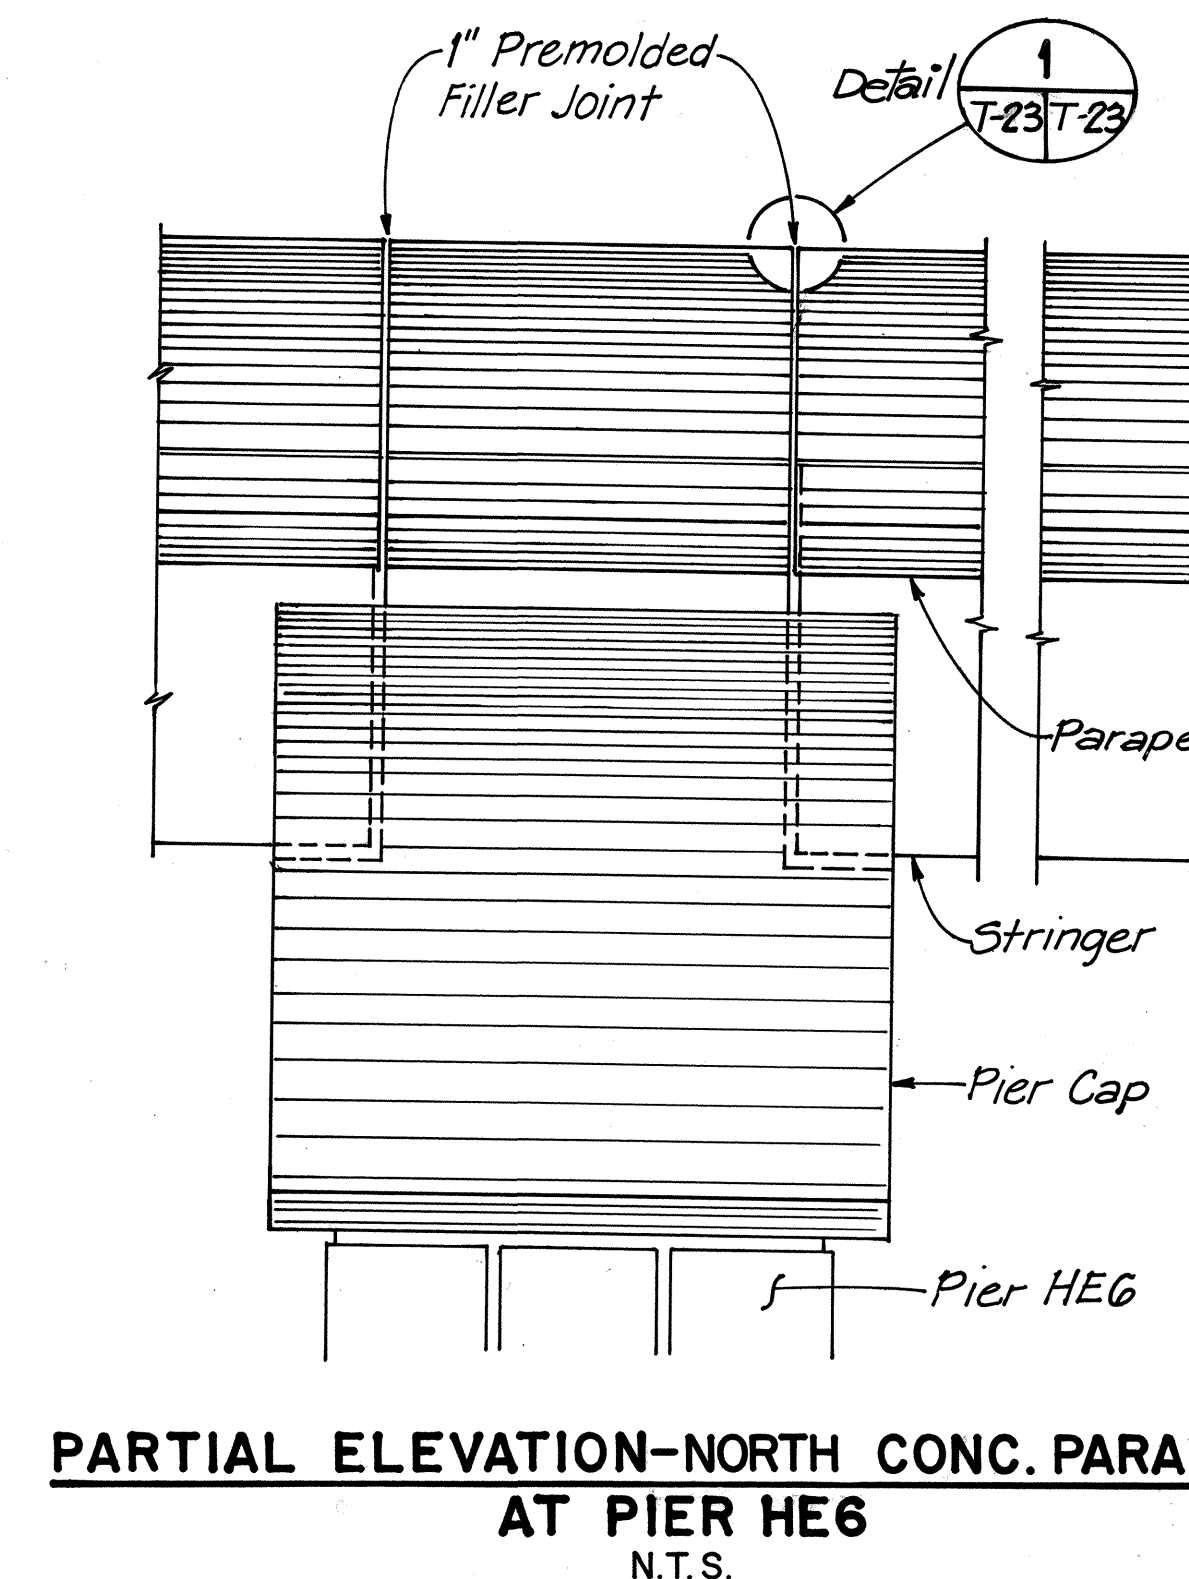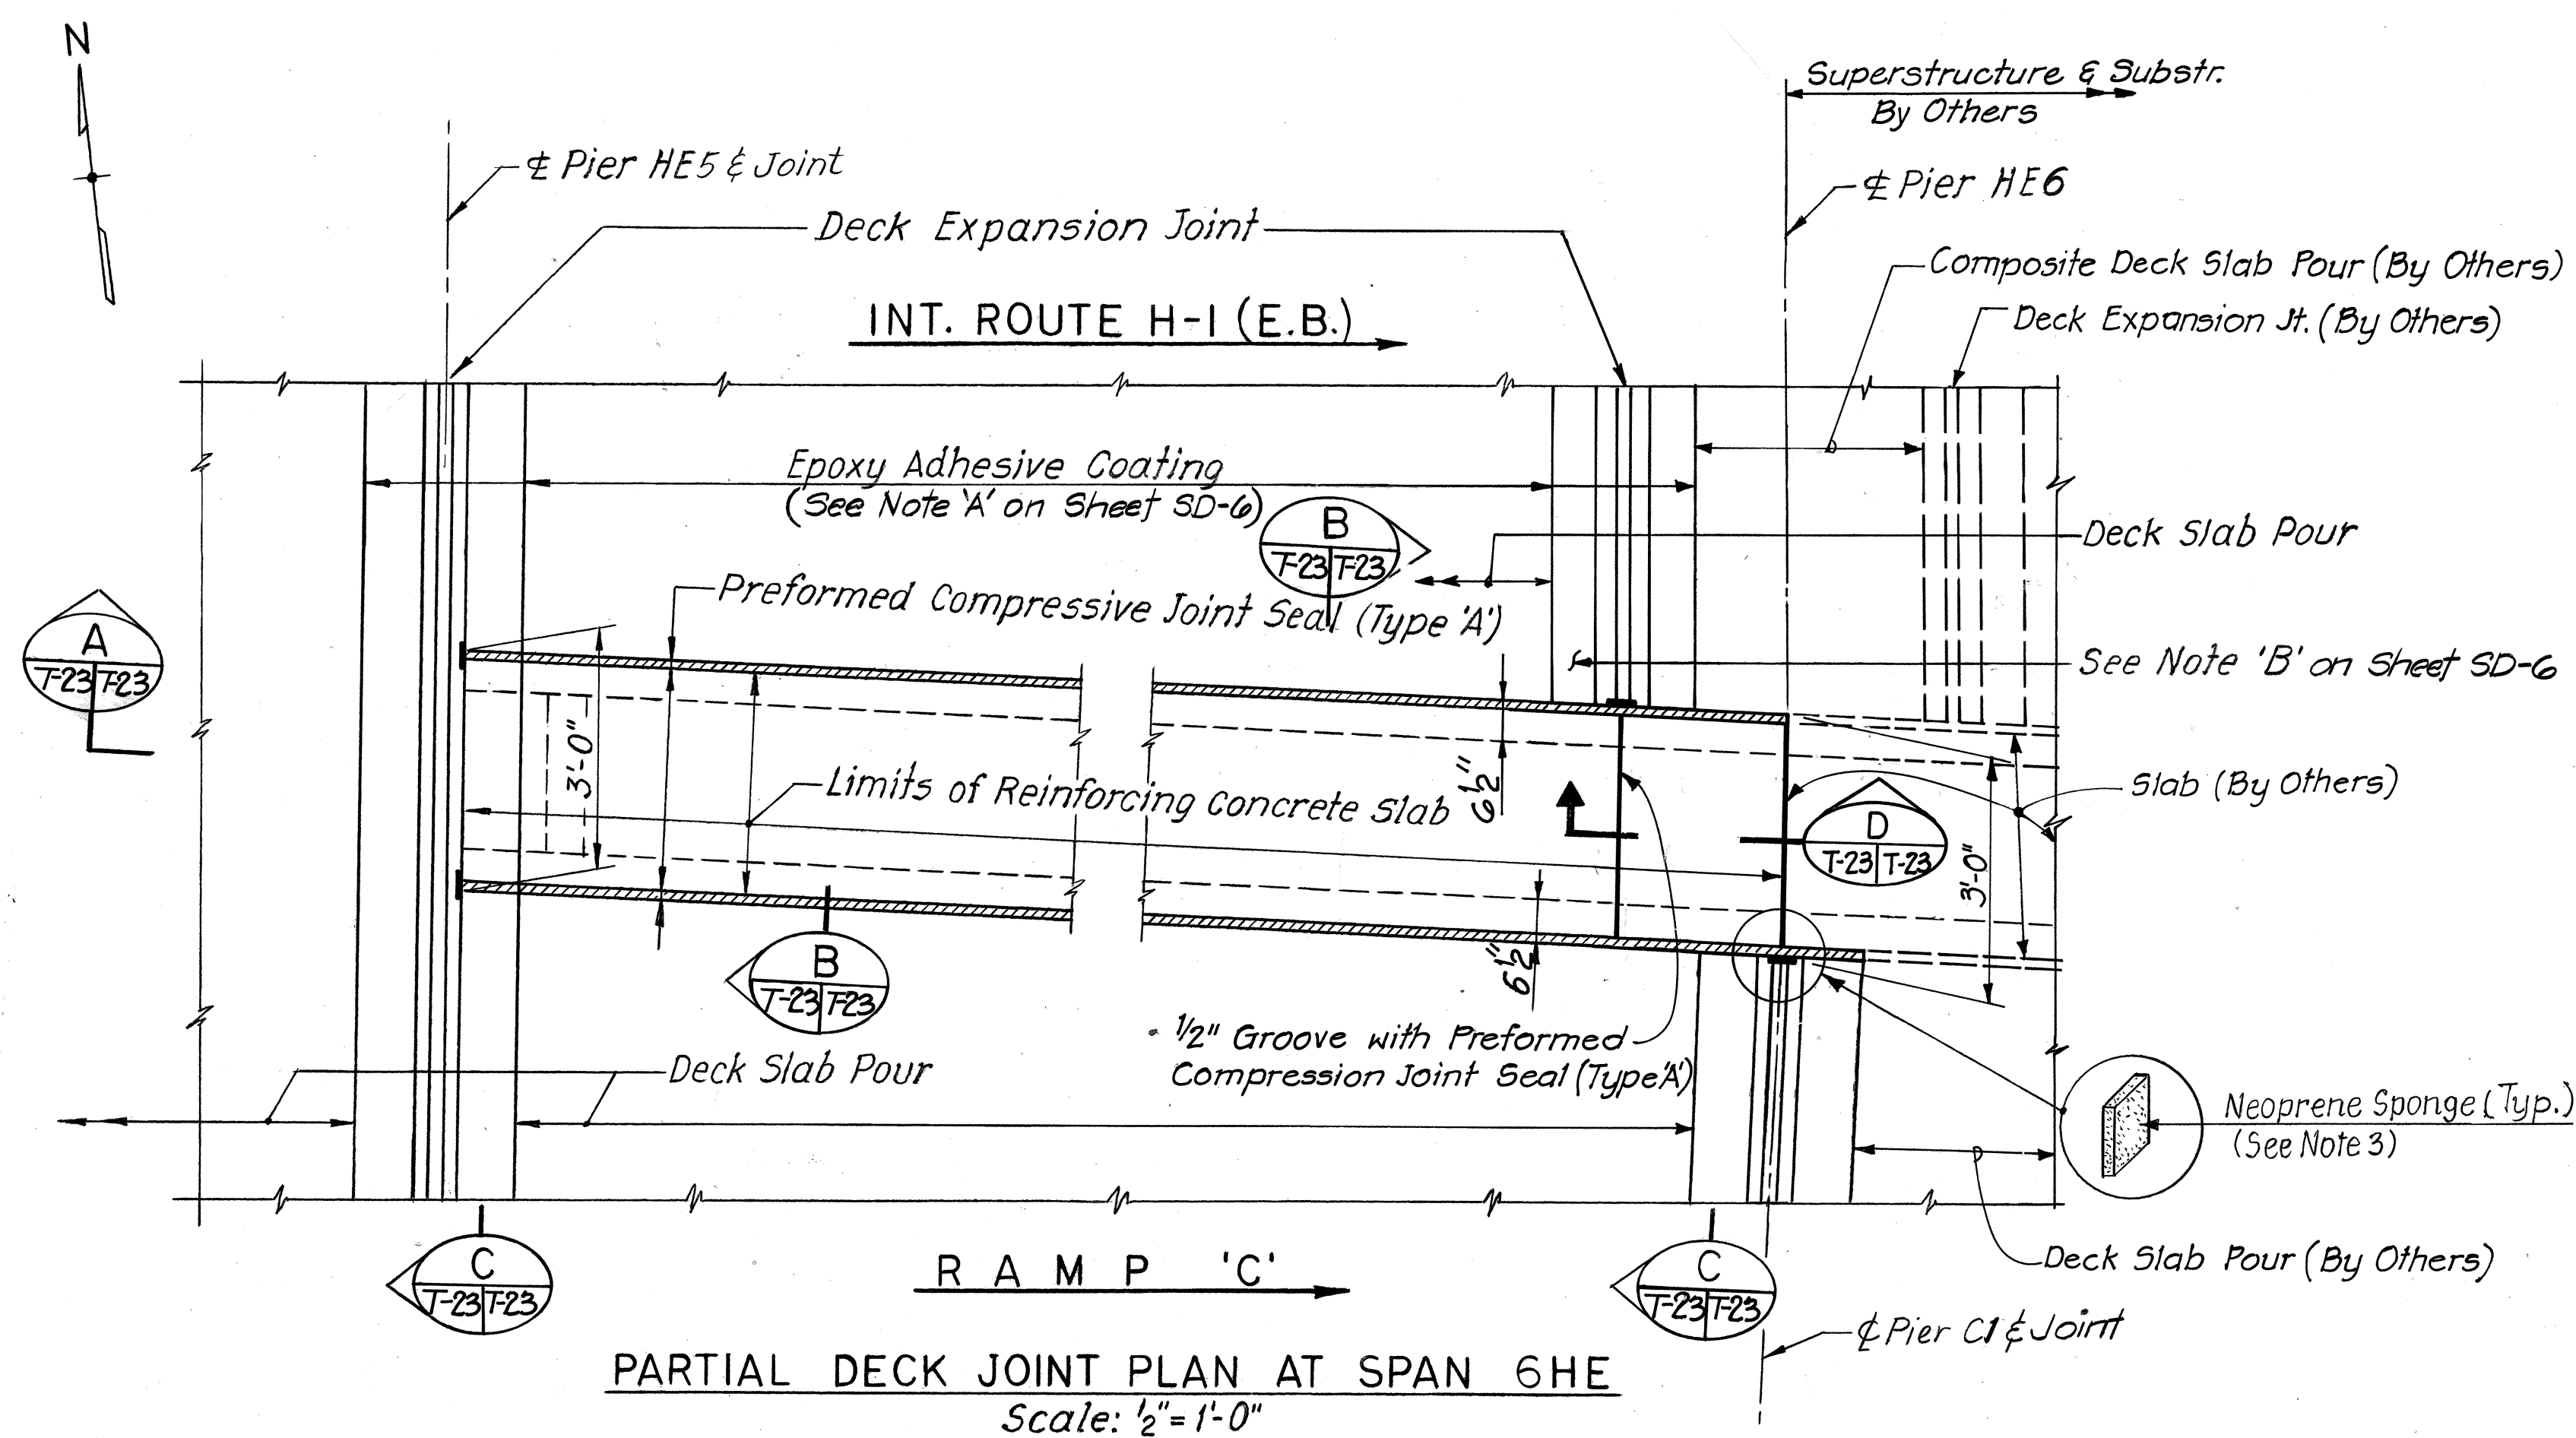



**SECTION "X"-"X"**  
**TYP. 1" PREMOLDED FILLER JOINT**

**ET**

**DETAIL**

SCALE: 3" = 1'-0"

T-23 T-23

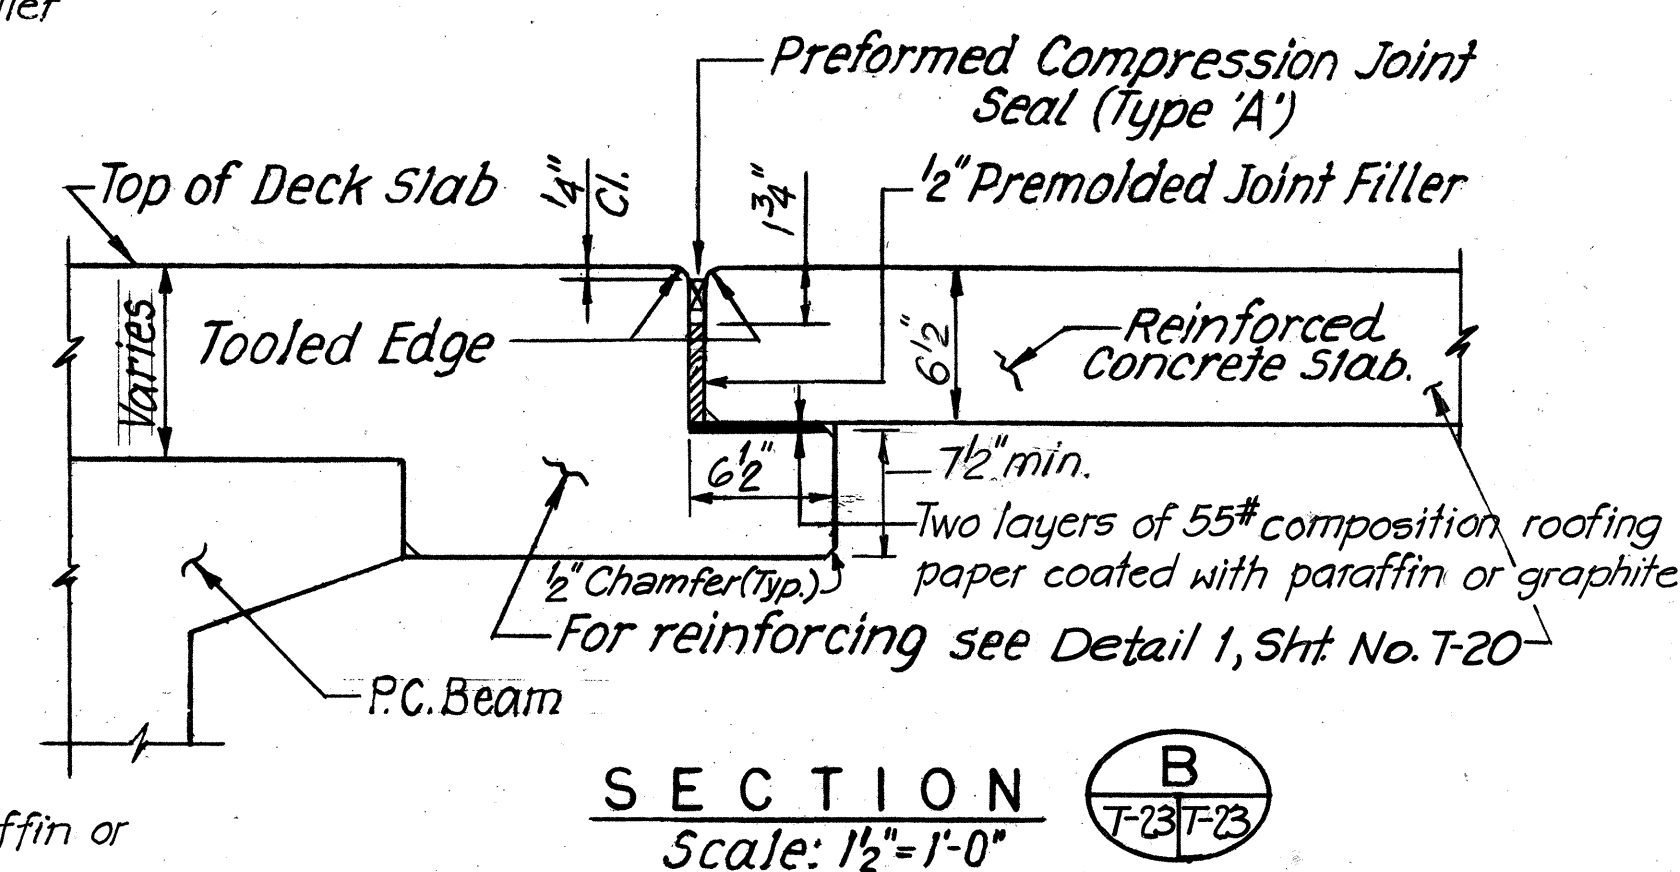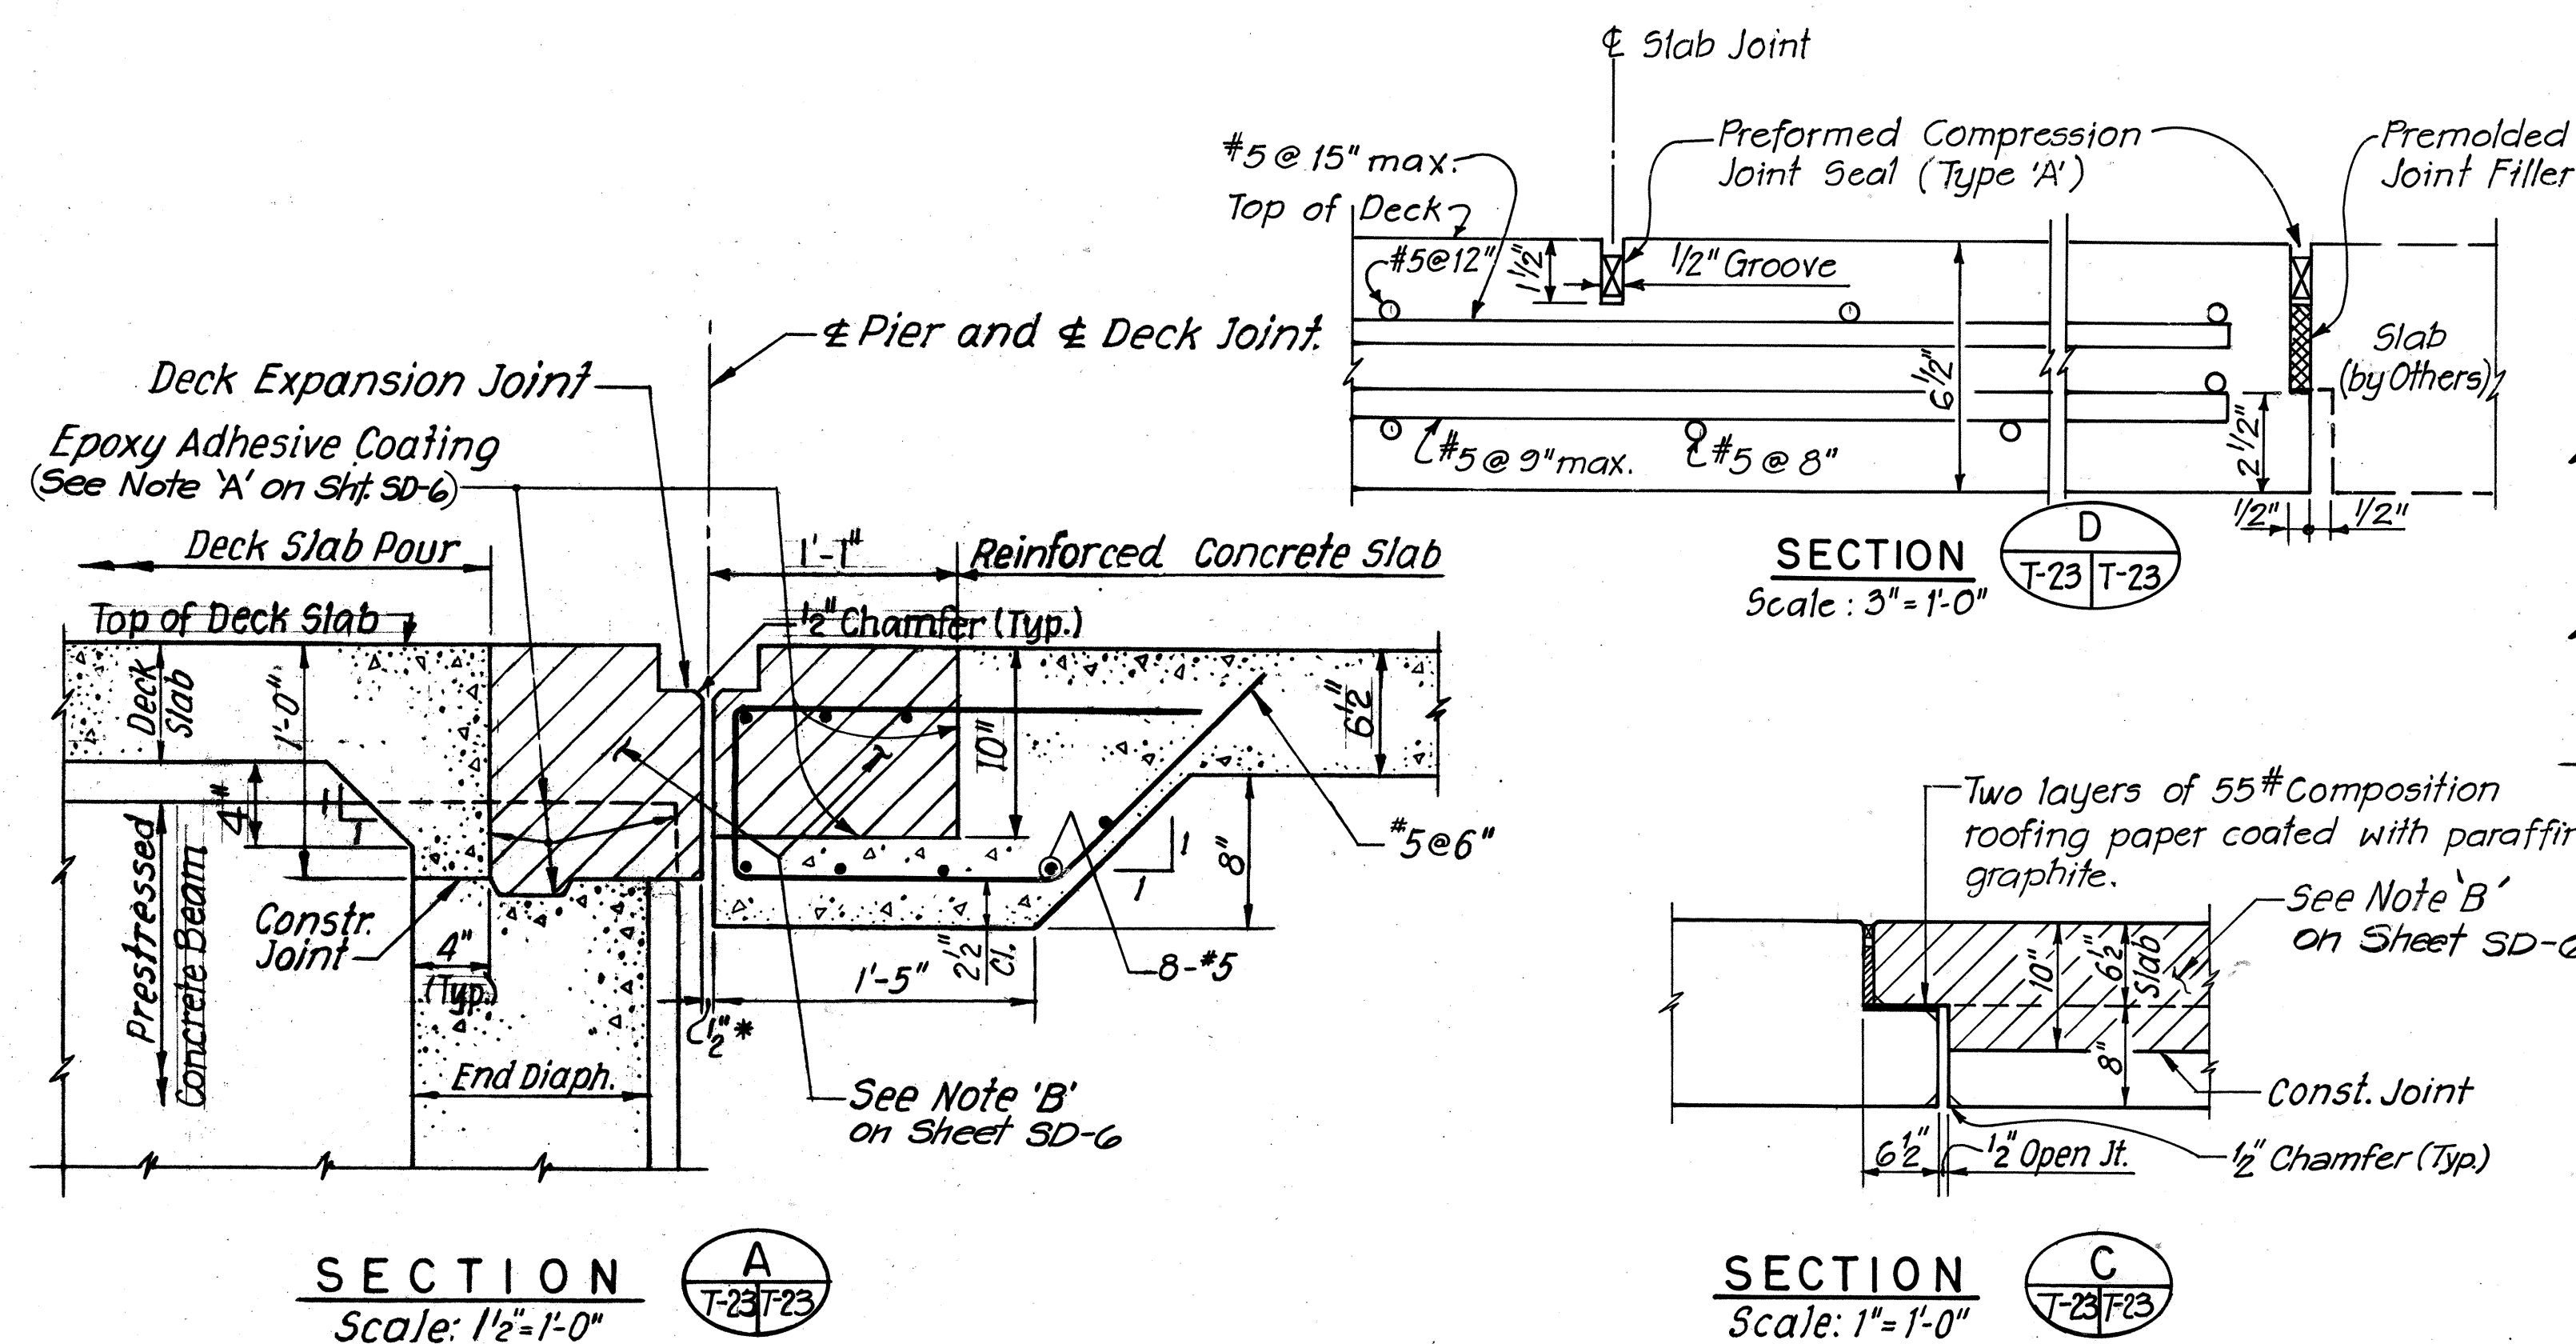

SECTION  
*Scale: 1 1/2" = 1'-0"*

(B)  
T-23 T-22

TYPE 'A' JOINT SEAL  
N.T.S.  
(Incidental to Concrete in Bridges)

- NOTES:

1. For typical deck Joint details at piers, and for Notes A & B, see Sheet Nos: SD-6. & SD-7.
2. For location of longitudinal deck joints see Sheet No.T-2.
3. On all joint intersections of the preformed compression seal and deck expansion joint and break points shown on this Sheet, use Neoprene Sponge cut to the proper size. Glue sponge to the end of the seal with Cyanoacrylate Adhesive.

\* Joint opening at time of installation of joint.  
Joint to be formed by premolded filler.

THIS WORK WAS PREPARED BY  
ME OR UNDER MY SUPERVISION

*John R. Johnson*

STATE OF HAWAII  
DEPARTMENT OF TRANSPORTATION  
HIGHWAYS DIVISION  
H-1 VIADUCT (E.B.), RAMP C & HOV RAMP  
DECK JOINT DETAILS  
KEEHI INTERCHANGE  
F.A.I. PROJ. NO. 1-H1-1 (168): 17  
SCALE: AS SHOWN DATE: 8/17/81  
SHEET NO. T-23 OF T-23 SHEETS



I N D E X

|                     |       |                    |             |           |              |
|---------------------|-------|--------------------|-------------|-----------|--------------|
| FED. ROAD DIST. NO. | STATE | FED. AID PROJ. NO. | FISCAL YEAR | SHEET NO. | TOTAL SHEETS |
| HAWAII              | HAW.  | HI-1 (168) 17      | 1982        | 83        | 145          |


| SHEET NO. | DESCRIPTION                                                    |
|-----------|----------------------------------------------------------------|
| S-1       | INDEX TO DRAWINGS AND ESTIMATED QUANTITIES                     |
| S-2       | GENERAL LAYOUT PLAN AND LONGITUDINAL SECTION; NC (EB)          |
| S-3       | GENERAL LAYOUT PLAN AND LONGITUDINAL SECTION; RAMP A & B       |
| S-4       | PART. LAYOUT, FOUNDATION PLAN, GRID GRADE PLAN & LONGIT. SECT. |
| S-5       | GENERAL LAYOUT PLAN; RAMP A & B                                |
| S-6       | LONGITUDINAL SECTION; RAMP A & B                               |
| S-7       | NORMAL SECTION AND PARTIAL ELEVATION N.C. (EB)                 |
| S-8       | NORMAL SECTION AND PARTIAL ELEVATION RAMP A & B                |
| S-9       | NORMAL SECTION AND PARTIAL ELEVATION RAMP A & B                |
| S-10      | DECK FINISH GRID GRADE PLAN N.C. (EB)                          |
| S-11      | DECK FINISH GRID GRADE PLAN RAMP A & B                         |
| S-12      | FOUNDATION PLAN N.C. (EB)                                      |
| S-13      | FOUNDATION PLAN RAMP A & B                                     |
| S-14      | PIER NE-1, NE-2 AND NC (EB) #29 PLAN AND ELEVATIONS            |
| S-15      | PIER NE-3 THRU NE-5 PLAN AND ELEVATIONS                        |
| S-16      | PIER NE-6 THRU NE-8 PLAN AND ELEVATIONS                        |
| S-17      | PIER NE-1 THRU NE-8 PIER CAP REINFORCING DETAILS               |
| S-18      | PIER NE-1 THRU NE-8 COLUMN AND PEDESTAL REINF. DETAILS         |
| S-19      | PIER NE-1 THRU NE-8 PILE CAP DETAILS                           |
| S-20      | PIER A-1, A-2, A-3, A-4, A-1, A-II AND A-III DETAILS           |
| S-21      | PIER A-5 DETAIL                                                |
| S-22      | PIER A-5 DETAIL                                                |
| S-23      | PIER A-6 DETAIL                                                |
| S-24      | PIER A-6 DETAIL                                                |
| S-25      | PIER A-7 DETAIL                                                |
| S-26      | PIER A-7 DETAIL                                                |
| S-27      | PIER A-8 DETAIL                                                |
| S-28      | PIER A-8 DETAIL                                                |
| S-29      | PIER A-9 AND B-1 DETAIL                                        |
| S-30      | PIER A-9 AND B-1 DETAIL                                        |
| S-31      | PIER A-10 DETAIL                                               |
| S-32      | PIER A-10 DETAIL                                               |
| S-33      | PIER B-2 DETAIL                                                |
| S-34      | PILE CAP DETAILS                                               |
| S-35      | PILE CAP PAY LIMITS                                            |
| S-36      | TYPICAL CONCRETE SEAT AND COLUMN DETAIL                        |
| S-37      | DECK FRAMING PLAN N.C. (EB)                                    |

| SHEET NO. | DESCRIPTION                                          |
|-----------|------------------------------------------------------|
| S-38      | DECK FRAMING PLAN NC (EB)                            |
| S-39      | DECK FRAMING PLAN RAMP A & B                         |
| S-40      | DECK FRAMING PLAN RAMP A & B                         |
| S-41      | DECK FRAMING PLAN RAMP A & B                         |
| S-42      | DECK FRAMING PLAN RAMP A & B                         |
| S-43      | BEAM TYPE SCHEDULE                                   |
| S-44      | PRESTRESS BEAM DETAILS                               |
| S-45      | PRESTRESS BEAM DETAILS                               |
| S-46      | BEARING DETAILS                                      |
| S-47      | TYPICAL DECK SECTIONS AND DECK REINFORCING N.C. (EB) |
| S-48      | TYPICAL DECK SECTION RAMP A & B                      |
| S-49      | MISCELLANEOUS DETAILS RAMP A & B                     |
|           |                                                      |
|           |                                                      |
|           |                                                      |
|           |                                                      |


| ESTIMATED QUANTITIES |                                                                             |          |              |              |
|----------------------|-----------------------------------------------------------------------------|----------|--------------|--------------|
| ITEM NO.             | ITEM                                                                        | UNIT     | QUANTITIES   |              |
|                      |                                                                             |          | NC (EB)      | RAMP A & B   |
| 206 .6000            | STRUCTURE EXCAVATION FOR BRIDGES                                            | CU. YD.  | 2902         | 1940         |
| 206 .7000            | STRUCTURE BACKFILL                                                          | CU. YD.  | 1018         | —            |
| 503 .1930            | CONCRETE IN BRIDGES (EXCEPT FOOTING); NC (EB)                               | LUMP SUM | 2545 CU. YD. | —            |
| 503 .1940            | CONCRETE IN BRIDGES (EXCEPT FOOTING); RAMP A & B                            | LUMP SUM | —            | 2330 CU. YD. |
| 503 .1980            | CONCRETE IN BRIDGES FOOTING (INCL. PEDESTAL); NC (EB)                       | LUMP SUM | 1256 CU. YD. | —            |
| 503 .1990            | CONCRETE IN BRIDGES FOOTING (INCL. PEDESTAL); RAMP A & B                    | LUMP SUM | —            | 1280 CU. YD. |
| 503 .6020            | TREMIE CONCRETE; NC (EB)                                                    | LUMP SUM | 609 CU. YD.  | —            |
| 503 .6030            | TREMIE CONCRETE; RAMP A & B                                                 | LUMP SUM | —            | 340 CU. YD.  |
| 504 .0400            | ERECTING GIRDERS, NC (EB)                                                   | LUMP SUM | 80 EACH      | —            |
| 504 .0500            | ERECTING GIRDERS, RAMP A & B                                                | LUMP SUM | —            | 109 EACH     |
| 505 .0030            | STRAND SLIPPAGE MEASUREMENT OF PILES                                        | EACH     | 700          | 750          |
| 505 .0430            | PRECAST, PRESTRESSED CONC. PILES-FURNISHED (16 1/2" OCTAGONAL)              | LIN. FT. | 30,965       | 30,290       |
| 505 .0440            | PRECAST, PRESTRESSED CONC. PILES-FURNISHED (20" SQUARE)                     | LIN. FT. | —            | 2,970        |
| 505 .4300            | PRECAST, PRESTRESSED CONC. PILES-DRIVEN (16 1/2" OCTAGONAL)                 | LIN. FT. | 30,353       | 29,690       |
| 505 .4400            | PRECAST, PRESTRESSED CONC. PILES-DRIVEN (20" SQUARE)                        | LIN. FT. | —            | 2,790        |
| 505 .4800            | FURNISHING AND INSTALLING MALE OR FEMALE SPLICE COUPLING                    | EACH     | 765          | 815          |
| 505 .6100            | SLEEVED HOLE 30 INCH DIA.                                                   | LIN. FT. | 801          | 960          |
| 505 .6200            | SLEEVED HOLE 36 INCH DIA.                                                   | LIN. FT. | —            | 1620         |
| 505 .8100            | PILE DRIVING SHOE                                                           | EACH     | 153          | 163          |
| 505 .9203            | "BUILD-UPS" OF PILES; NC (EB)                                               | F. A.    | —            | —            |
| 505 .9204            | "BUILD-UPS" OF PILES; RAMP A & B                                            | F. A.    | —            | —            |
| 505 .9303            | RETAPPING OF PILES; NC (EB)                                                 | F. A.    | —            | —            |
| 505 .9304            | RETAPPING OF PILES; RAMP A & B                                              | F. A.    | —            | —            |
| 505 .9404            | PILE ACCEPTANCE TEST; NC (EB)                                               | F. A.    | —            | —            |
| 505 .9405            | PILE ACCEPTANCE TEST; RAMP A & B                                            | F. A.    | —            | —            |
| 507 .7100            | STANDARD PARAPET                                                            | LIN. FT. | 1612         | 1976         |
| 511 .0100            | DECK EXPANSION JOINT                                                        | LIN. FT. | 486          | 700          |
| 602 .1330            | REINFORCING STEEL IN BRIDGES; NC (EB)                                       | LUMP SUM | 832.503 lbs. | —            |
| 602 .1340            | REINFORCING STEEL IN BRIDGES; RAMP A & B                                    | LUMP SUM | —            | 773,100 lbs. |
| 604 .5000            | FURNISHING AND INSTALLING TYPE A-12 STEEL FRAME AND GRATE FOR DECK DRAINAGE | EACH     | 12           | 24           |
| 634 .0320            | EXPLORATORY WORK AT STRUCTURE FOOTING; NC (EB)                              | F. A.    | —            | —            |
| 634 .0330            | EXPLORATORY WORK AT STRUCTURE FOOTING; RAMP A & B                           | F. A.    | —            | —            |
| 660 .0100            | BITUMEN COATING                                                             | SQ. YD.  | 9020         | 11,700       |
| 675 .0100            | CUSHION BARRIER                                                             | EACH     | —            | 1            |

|                   |      |
|-------------------|------|
| SURVEY PLOTTED BY | DATE |
| PLAN              |      |
| DESIGNED BY       |      |
| NOTE BOOK         |      |
| QUANTITIES BY     |      |
| CHECKED BY        |      |
| No.               |      |

PRESTRESSED CONCRETE  
GIRDERS WILL BE  
FURNISHED BY OTHERS

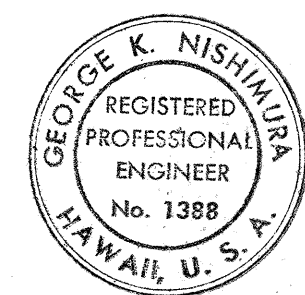

THIS WORK WAS PREPARED BY ME  
OR UNDER MY SUPERVISION


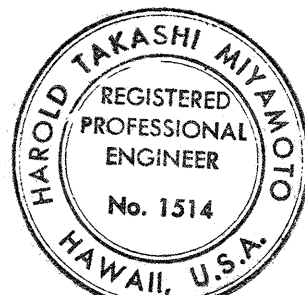


THIS WORK WAS PREPARED BY ME  
OR UNDER MY SUPERVISION

|                              |                |
|------------------------------|----------------|
| STATE OF HAWAII              |                |
| DEPARTMENT OF TRANSPORTATION |                |
| HIGHWAYS DIVISION            |                |
| <b>NIMITZ CONNECTOR (EB)</b> |                |
| <b>RAMP "A" AND RAMP "B"</b> |                |
| INDEX TO DRAWINGS            |                |
| AND ESTIMATED QUANTITIES     |                |
| KEEHI INTERCHANGE            |                |
| F&I PROJ. NO. HI-1 (168) 17  |                |
| SCALE:                       | DATE JULY 1981 |
| SHEET No. S-1 OF 49 SHEETS   |                |



| FED. ROAD DIST. NO. | STATE | FED. AID PROJ. NO. | FISCAL YEAR | SHEET NO. | TOTAL SHEETS |
|---------------------|-------|--------------------|-------------|-----------|--------------|
| HAWAII              | HAW.  | 1-H1-1(68)17       | 1982        | 84        | 145          |

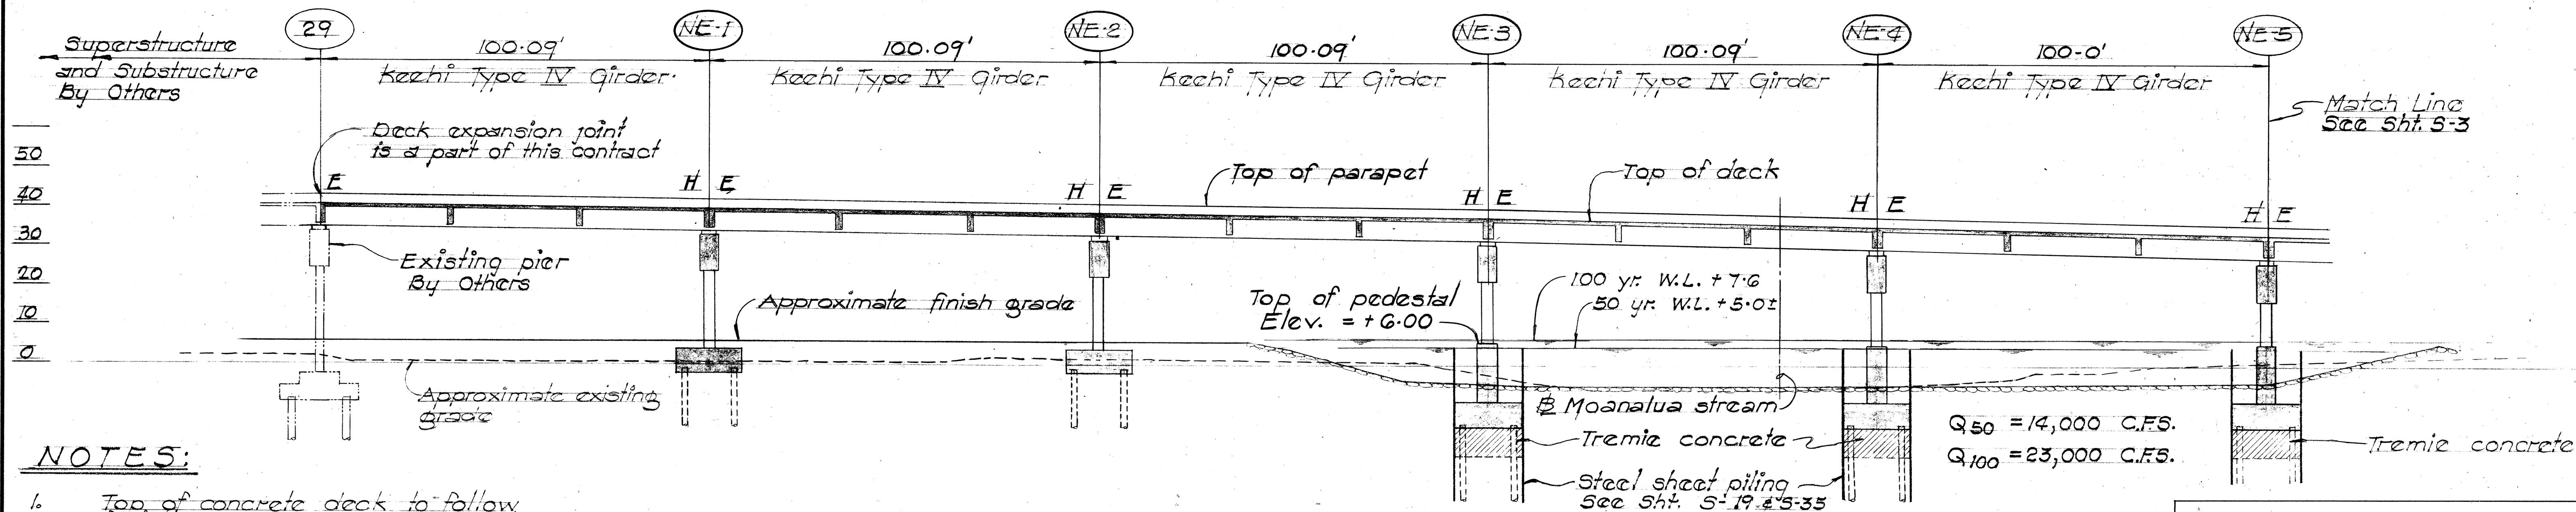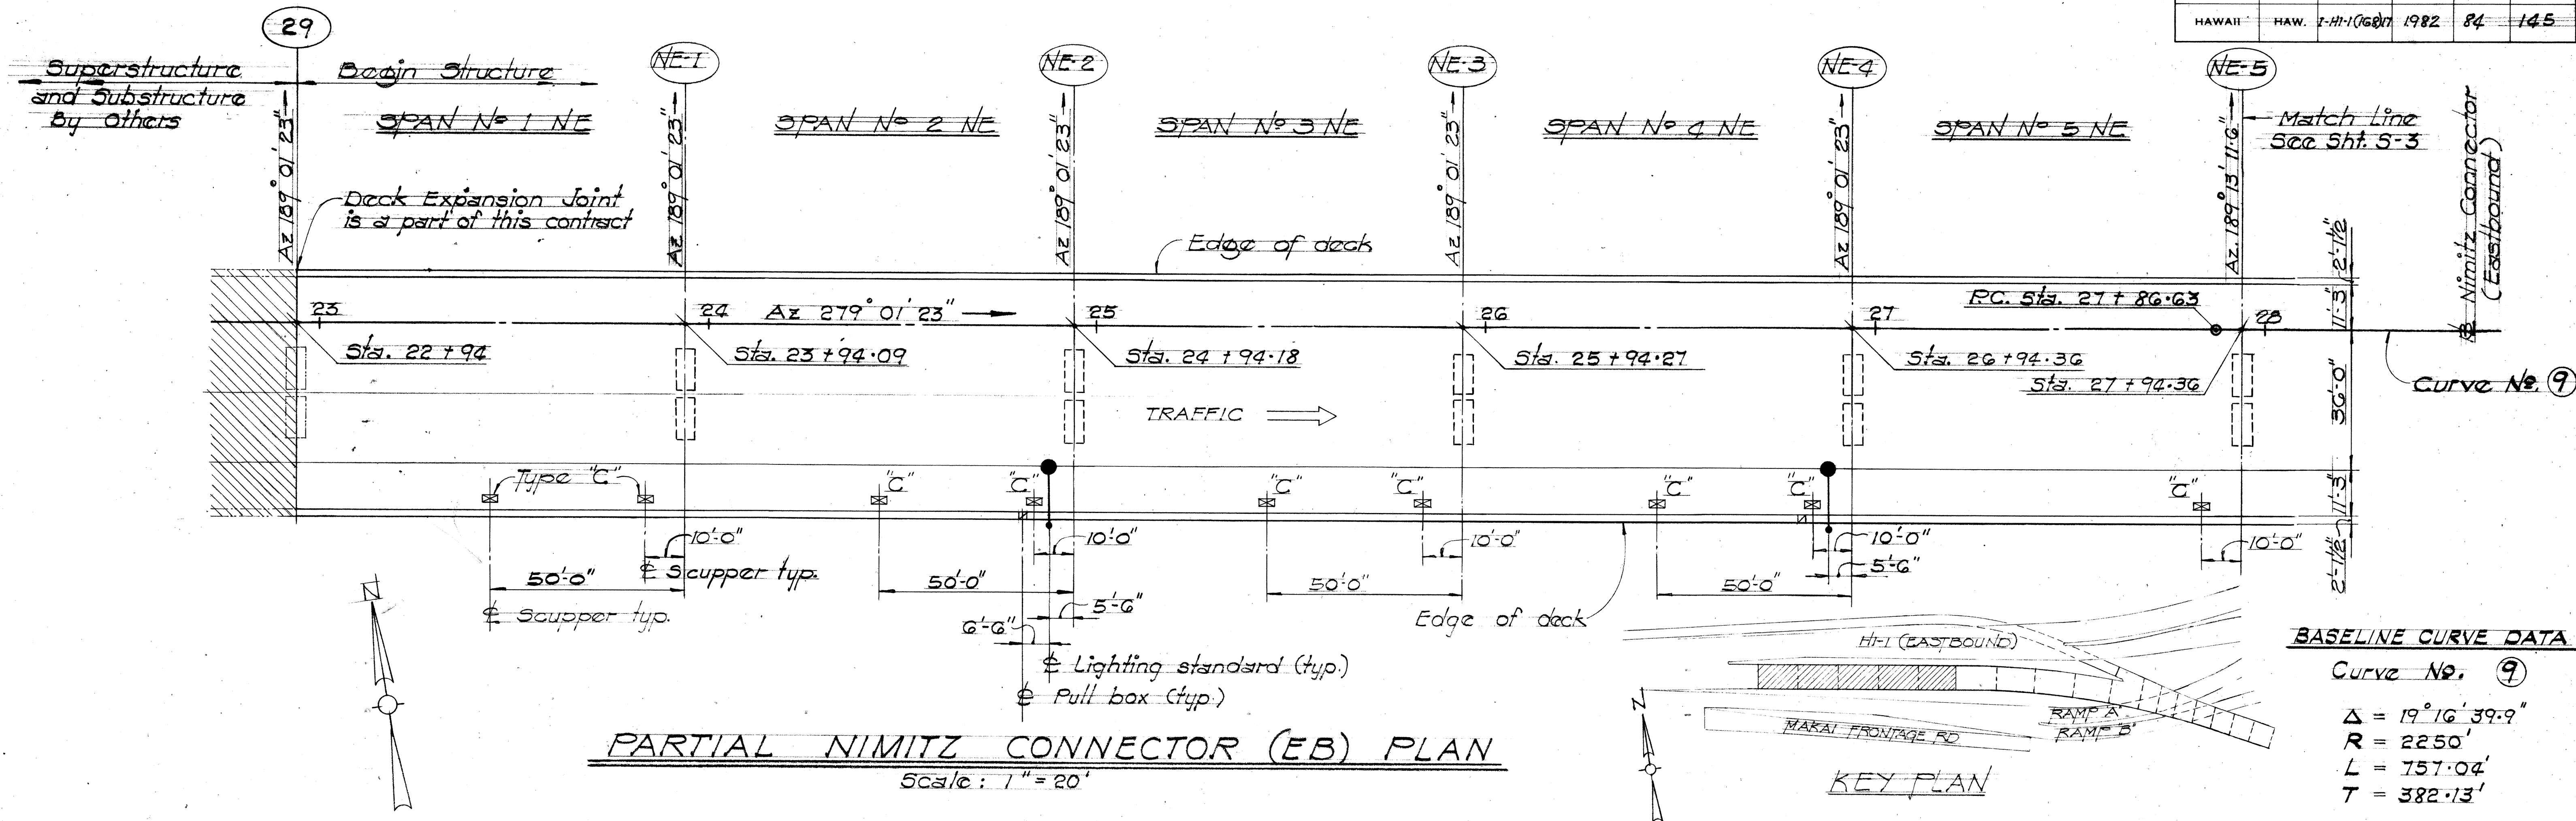


#### NOTES:

1. Top of concrete deck to follow finish roadway grades, except otherwise noted.
2. ☒ Denotes deck scuppers see details Sht. SD-8.
3. H Denotes Hinge Bearing.
4. E Denotes Expansion Bearing.
5. All azimuths are measured from South.

#### PARTIAL LONGITUDINAL SECTION B NIMITZ CONNECTOR (EB)

Scale: 1" = 20'

|                   |       |
|-------------------|-------|
| DATE              | _____ |
| SURVEY PLOTTED BY | _____ |
| DRAWN BY          | _____ |
| DESIGNED BY       | _____ |
| NOTE BOOK         | _____ |
| CHECKED BY        | _____ |
| NO.               | _____ |

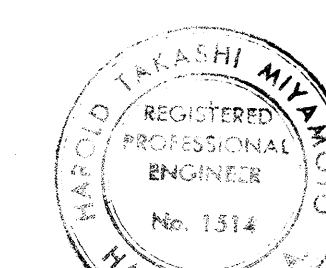

STATE OF HAWAII  
DEPARTMENT OF TRANSPORTATION  
HIGHWAYS DIVISION

**NIMITZ CONNECTOR (EB)**  
**RAMP "A" AND RAMP "B"**

GENERAL LAYOUT PLAN & LONGITUDINAL SECT.


KEEHI INTERCHANGE  
SAL PROJ. NO. 1-H1-1(68)17

SCALE: 1" = 20'-0" DATE: JULY 1981

SHEET NO. 5-2 OF 49 SHEETS




| FED. ROAD DIST. NO. | STATE | FED. AID PROJ. NO. | FISCAL YEAR | SHEET NO. | TOTAL SHEETS |
|---------------------|-------|--------------------|-------------|-----------|--------------|
| HAWAII              | HAW.  | I-HI-1(168)17      | 1982        | 85        | 145          |

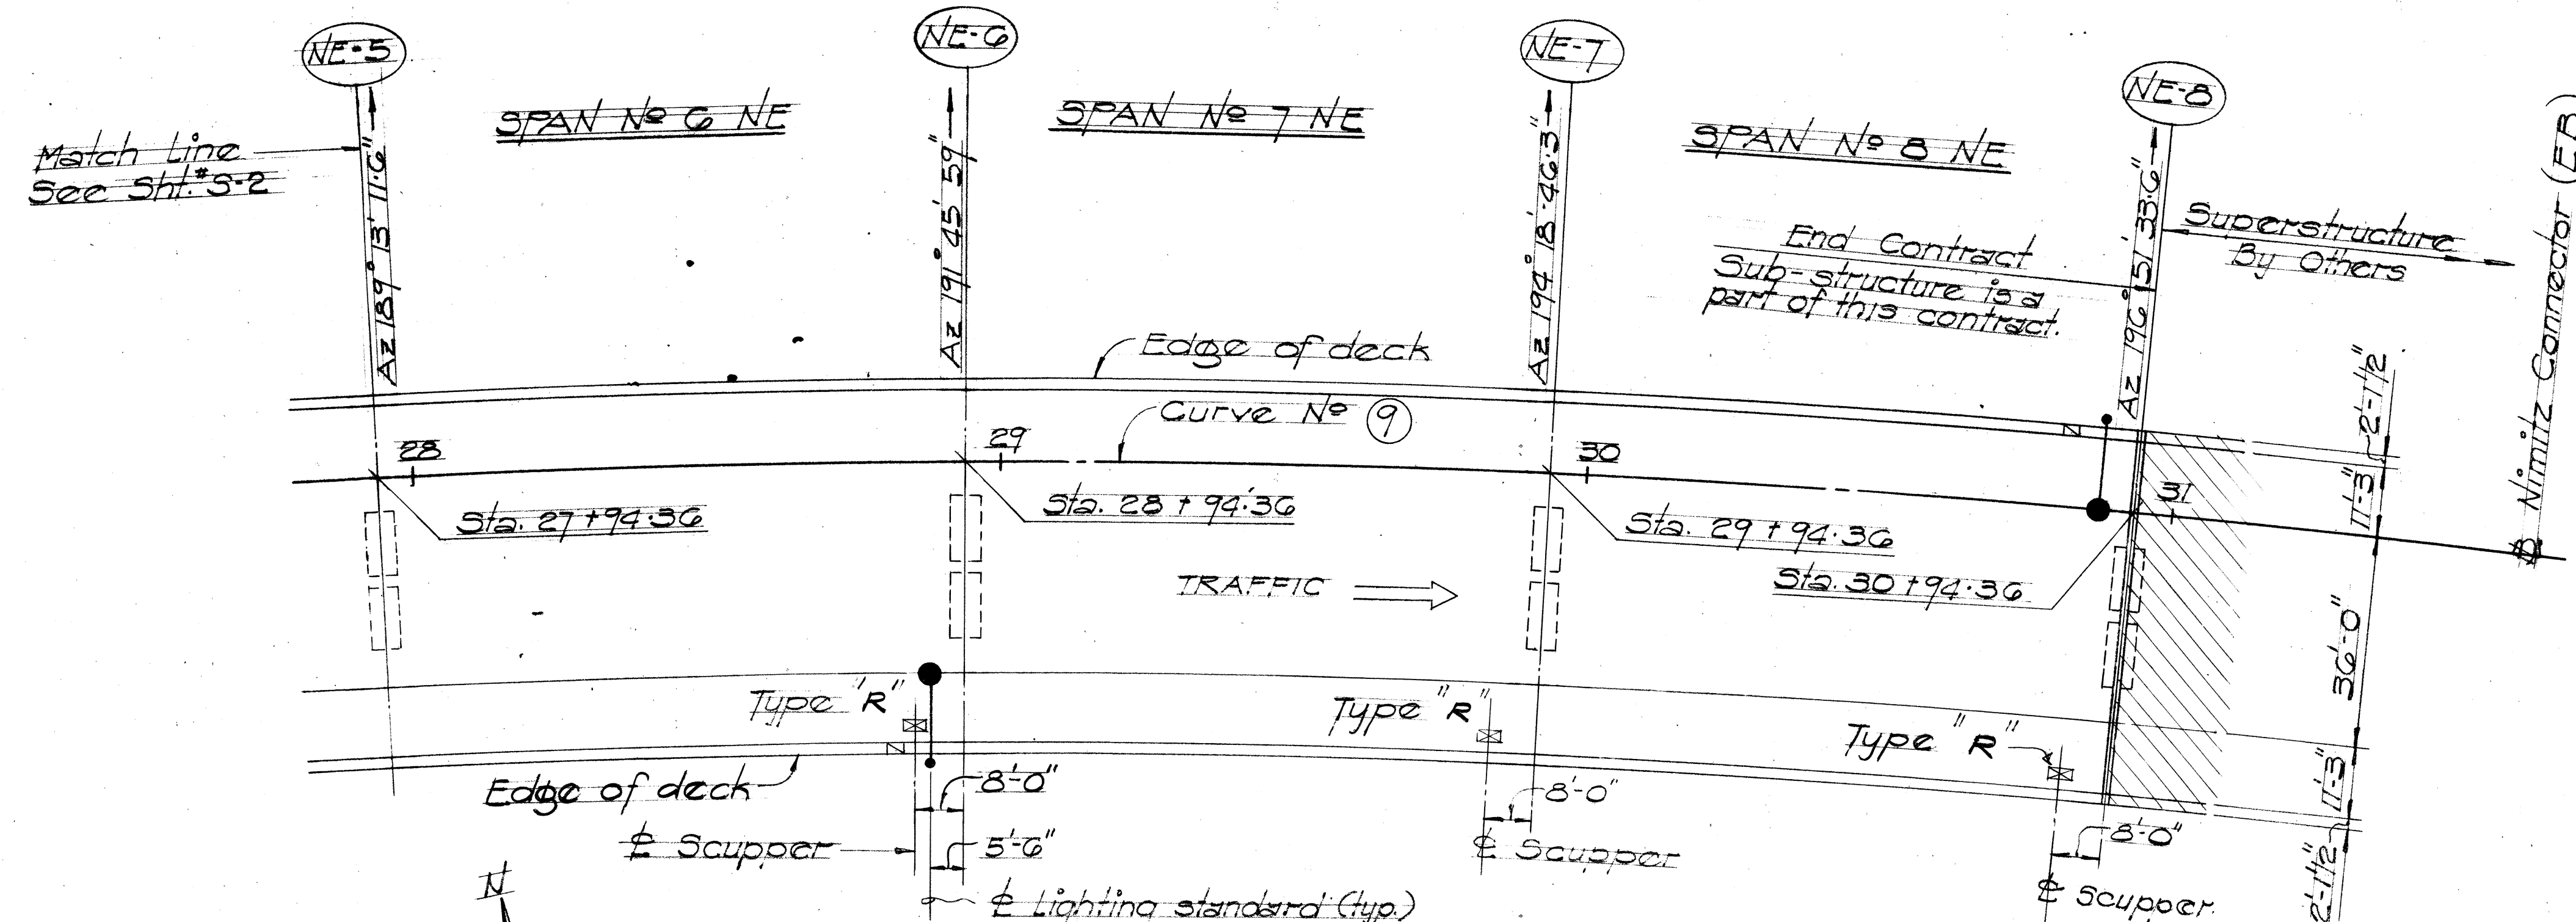


**PARTIAL NIMITZ CONNECTOR (EB) PLAN**  
Scale: 1" = 20'

**BASILINE CURVE DATA**  
Curve No 9  
 $\Delta = 19^{\circ}16'39.9"$   
 $R = 2250'$   
 $L = 757.04'$   
 $T = 382.13'$

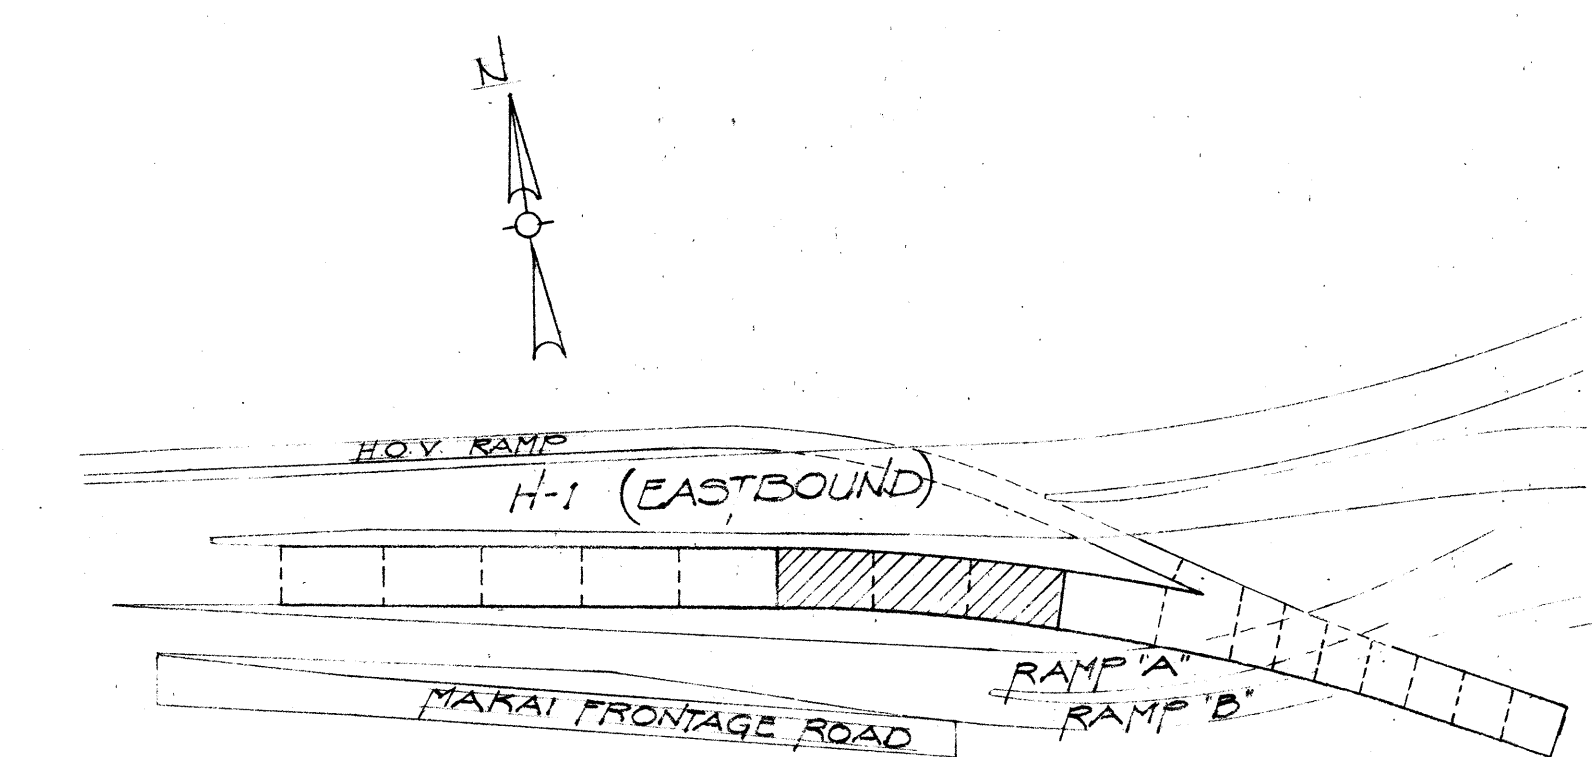

**KEY PLAN**

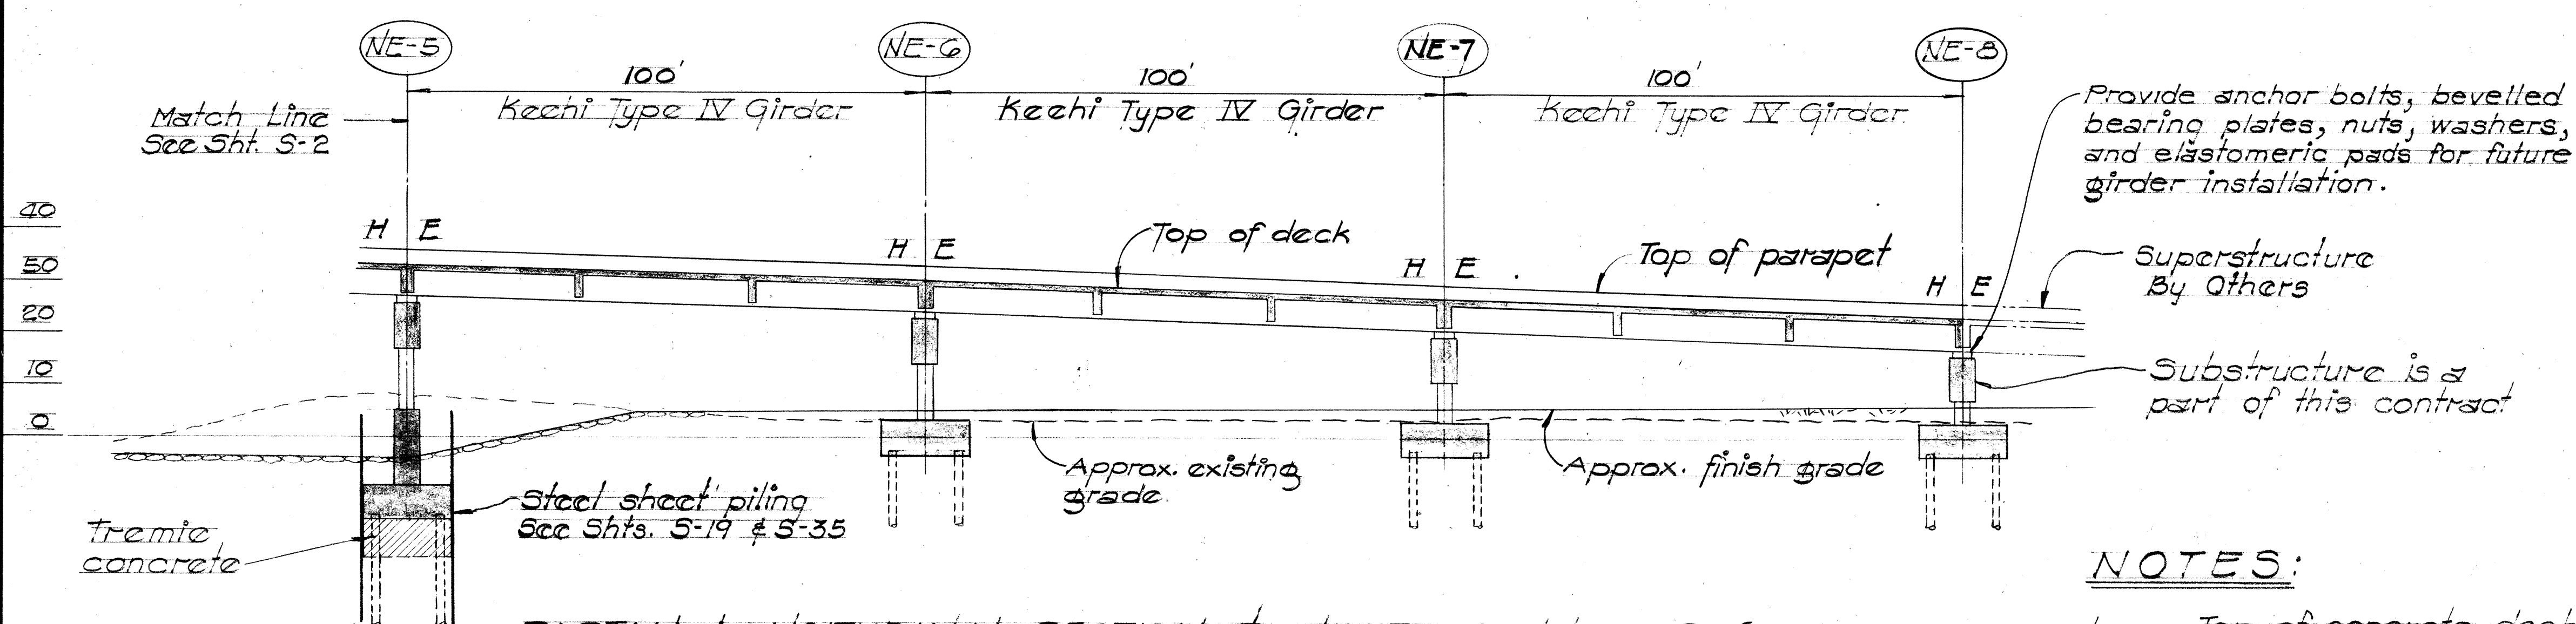


**PARTIAL LONGITUDINAL SECTION OF NIMITZ CONNECTOR (EB)**  
Scale: 1" = 20'

Provide anchor bolts, bevelled bearing plates, nuts, washers, and elastomeric pads for future girder installation.

Superstructure By Others  
Substructure is a part of this contract

- NOTES:**
1. Top of concrete deck to follow finish roadway grades, except otherwise noted.
  2.  $\boxtimes$  Denotes deck scuppers see detail Sht. S-36
  3. H Denotes Hinge Bearing
  4. E Denotes Expansion Bearing
  5. All azimuths are measured from south.

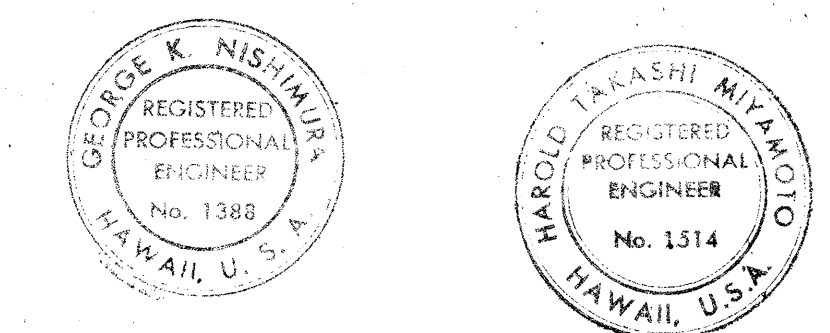


THIS WORK WAS PREPARED BY ME OR UNDER MY SUPERVISION  
*George K. Nishimura*  
THIS WORK WAS PREPARED BY ME OR UNDER MY SUPERVISION  
*Harold Takashi Miyamoto*


STATE OF HAWAII  
DEPARTMENT OF TRANSPORTATION  
HIGHWAYS DIVISION  
**NIMITZ CONNECTOR (EB),  
RAMP "A" AND RAMP "B"**  
GENERAL LAYOUT PLAN & LONGITUDINAL SECTION  
KEEHI INTERCHANGE  
FAT PROJ. NO. I-HI-1(168)17  
SCALE: 1" = 20'-0" DATE: JULY, 1981  
SHEET No. 5-3 OF 49 SHEETS



| FED. ROAD DIST. NO. | STATE | FED. AID PROJ. NO. | FISCAL YEAR | SHEET NO. | TOTAL SHEETS |
|---------------------|-------|--------------------|-------------|-----------|--------------|
| HAWAII              | HAW.  | 1-HI-1(168)17      | 1982        | 86        | 145          |

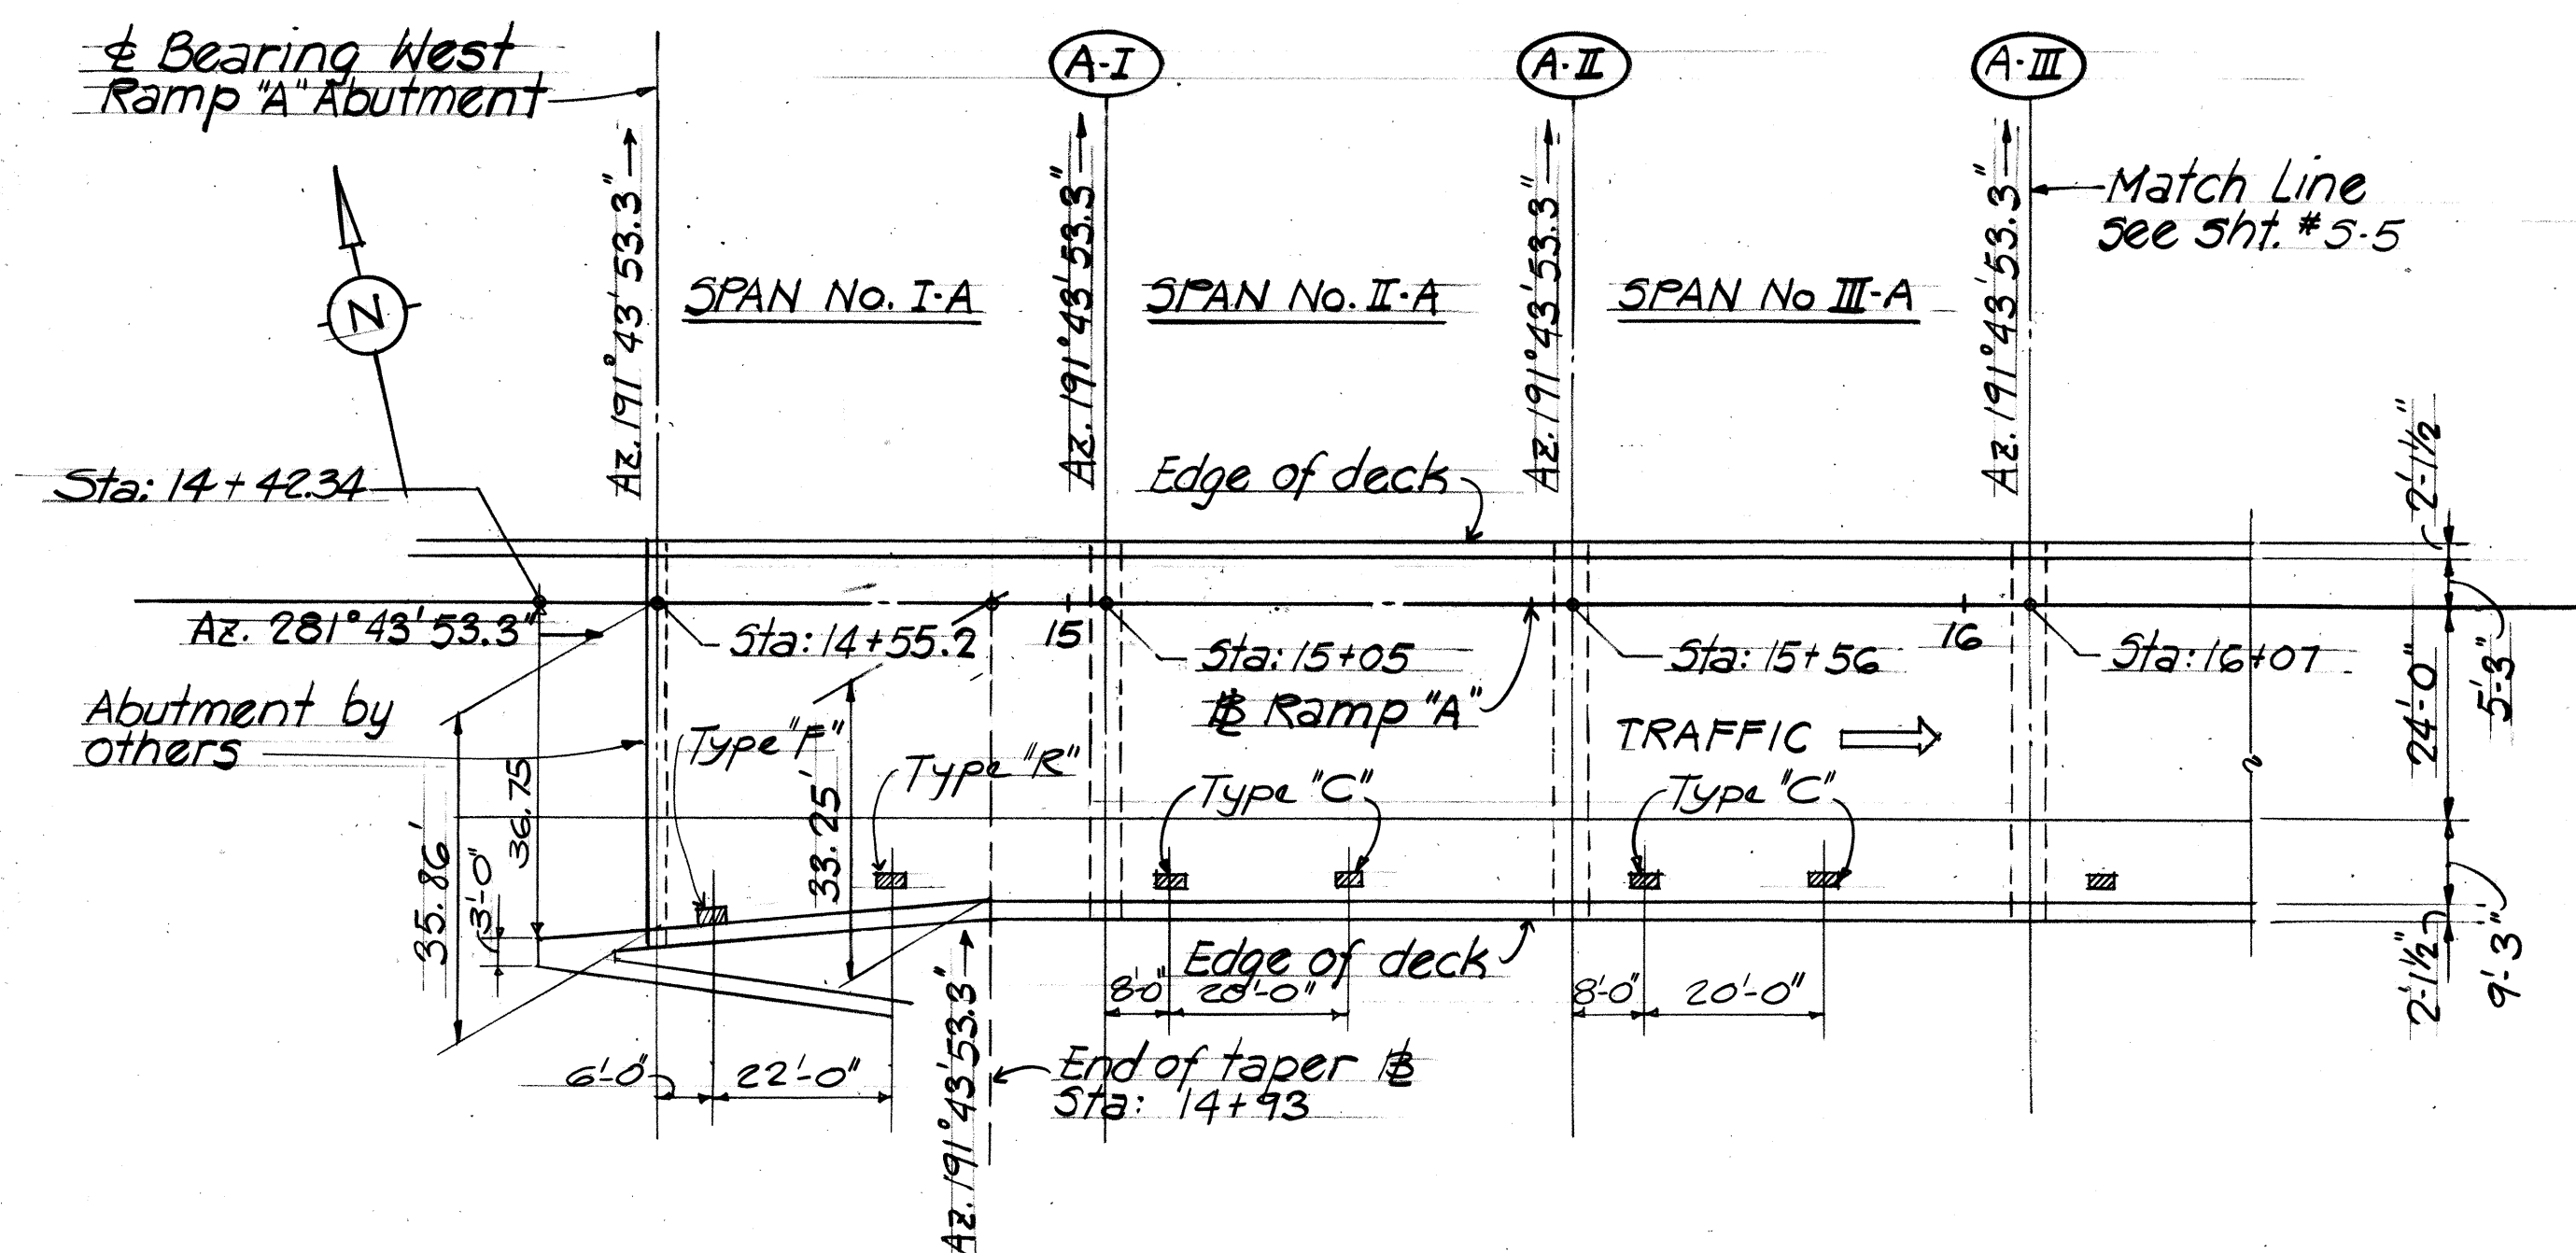


**PARTIAL LAYOUT PLAN RAMP "A"**  
Scale 1"=20'-0"

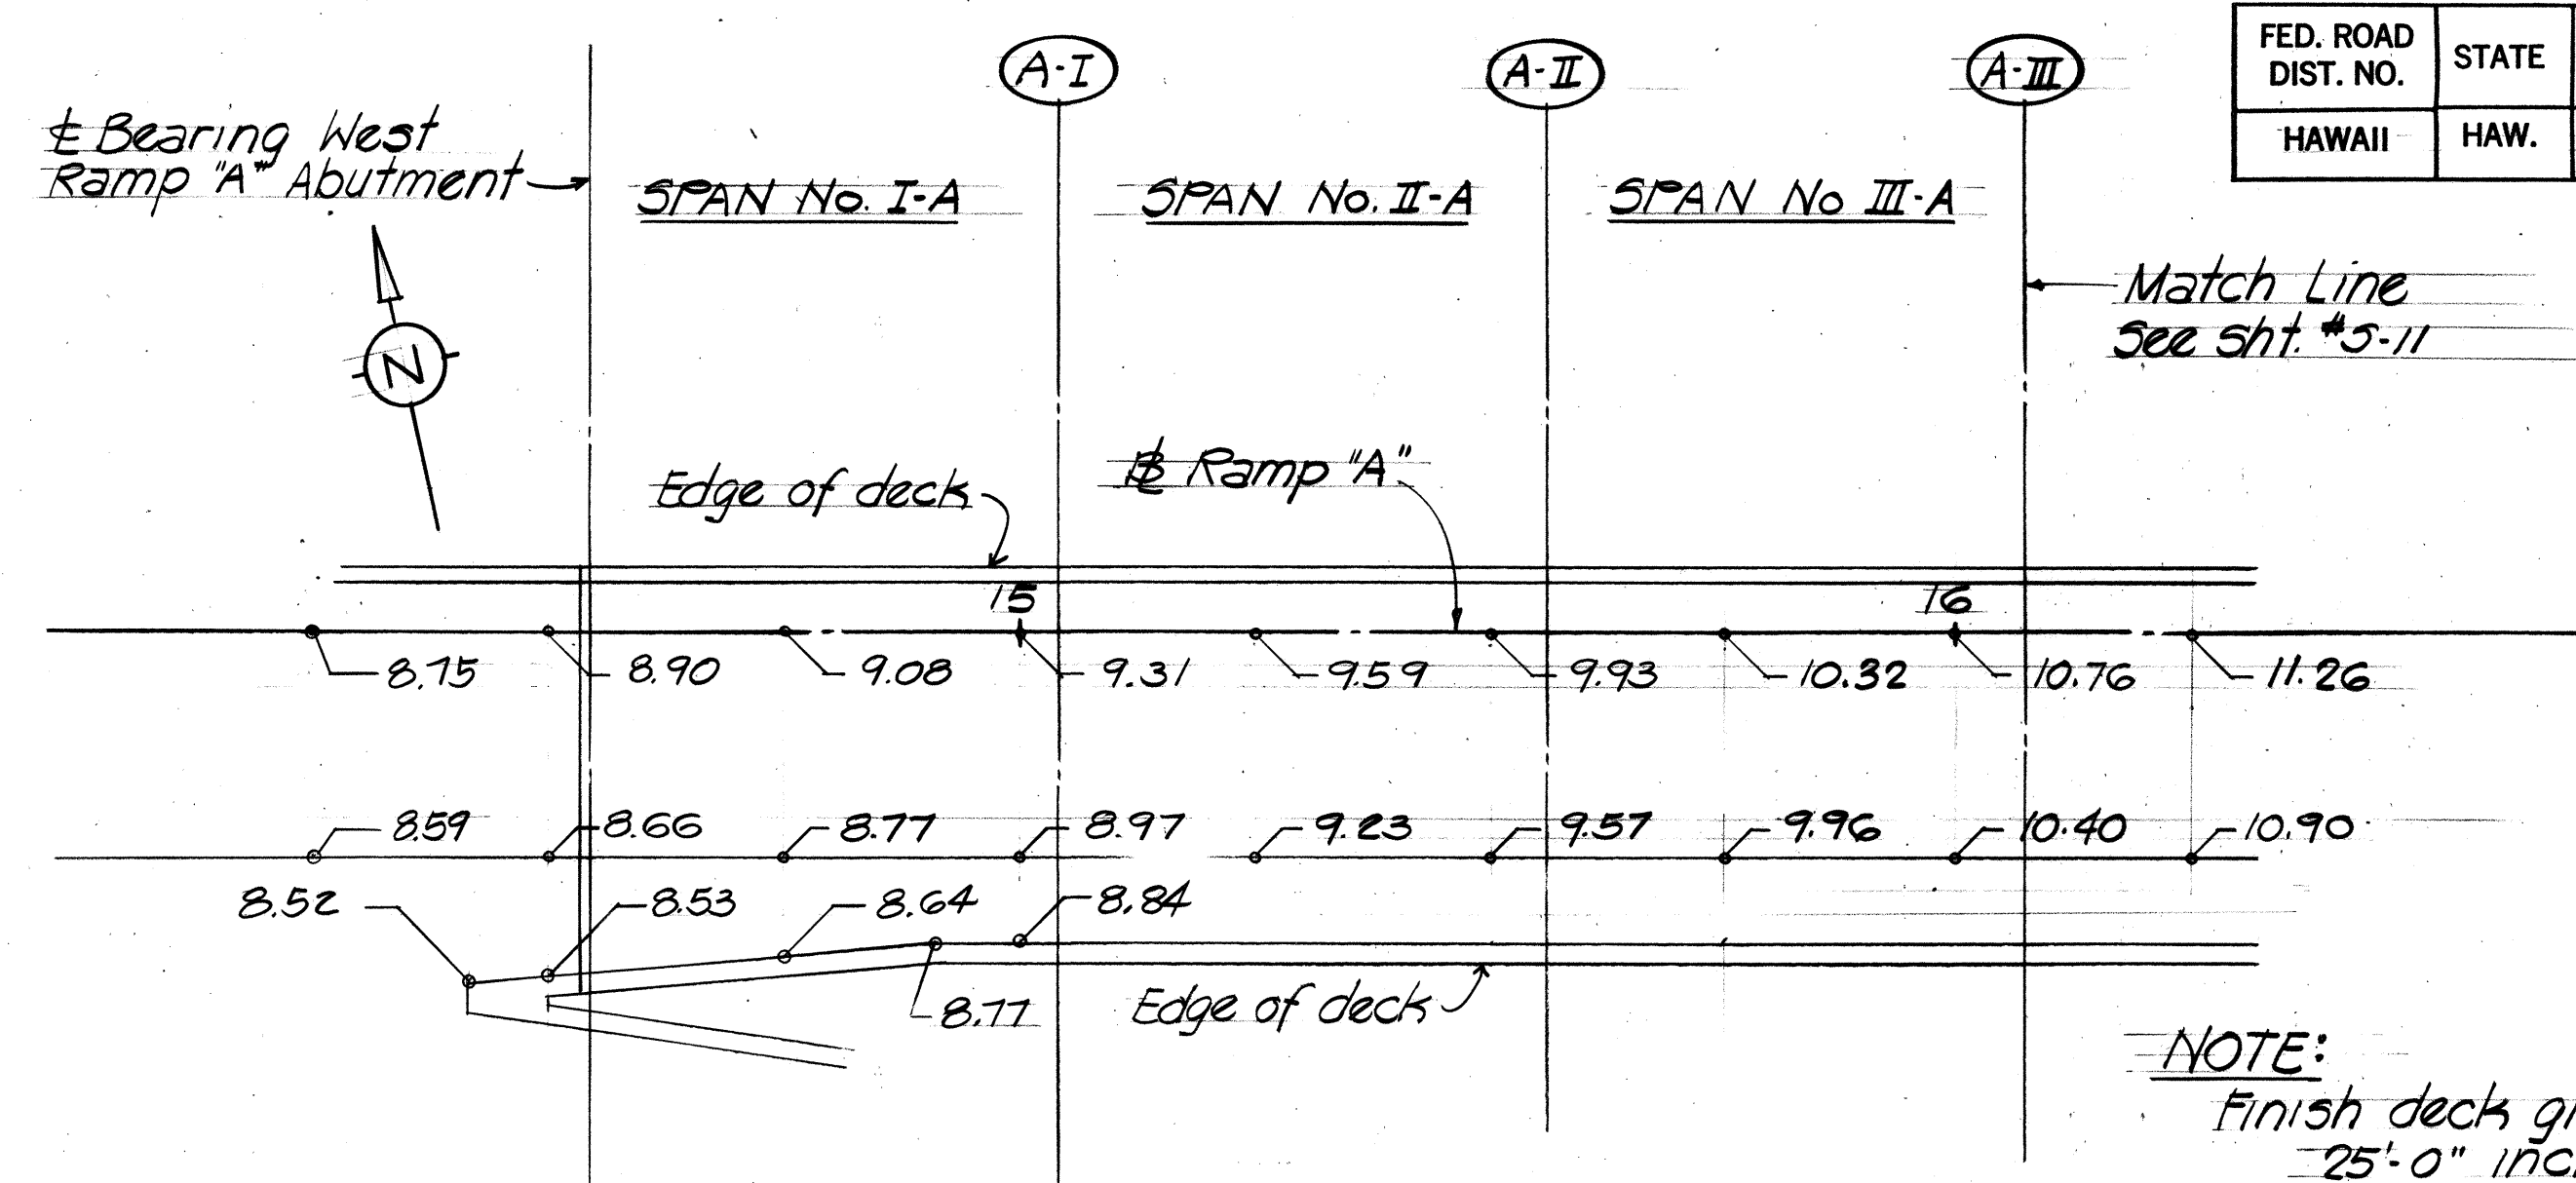

**NOTE:**  
Finish deck grades are given at 25'-0" increments.

**PARTIAL DECK FINISH GRID GRADE PLAN RAMP "A"**  
Scale 1"=20'-0"

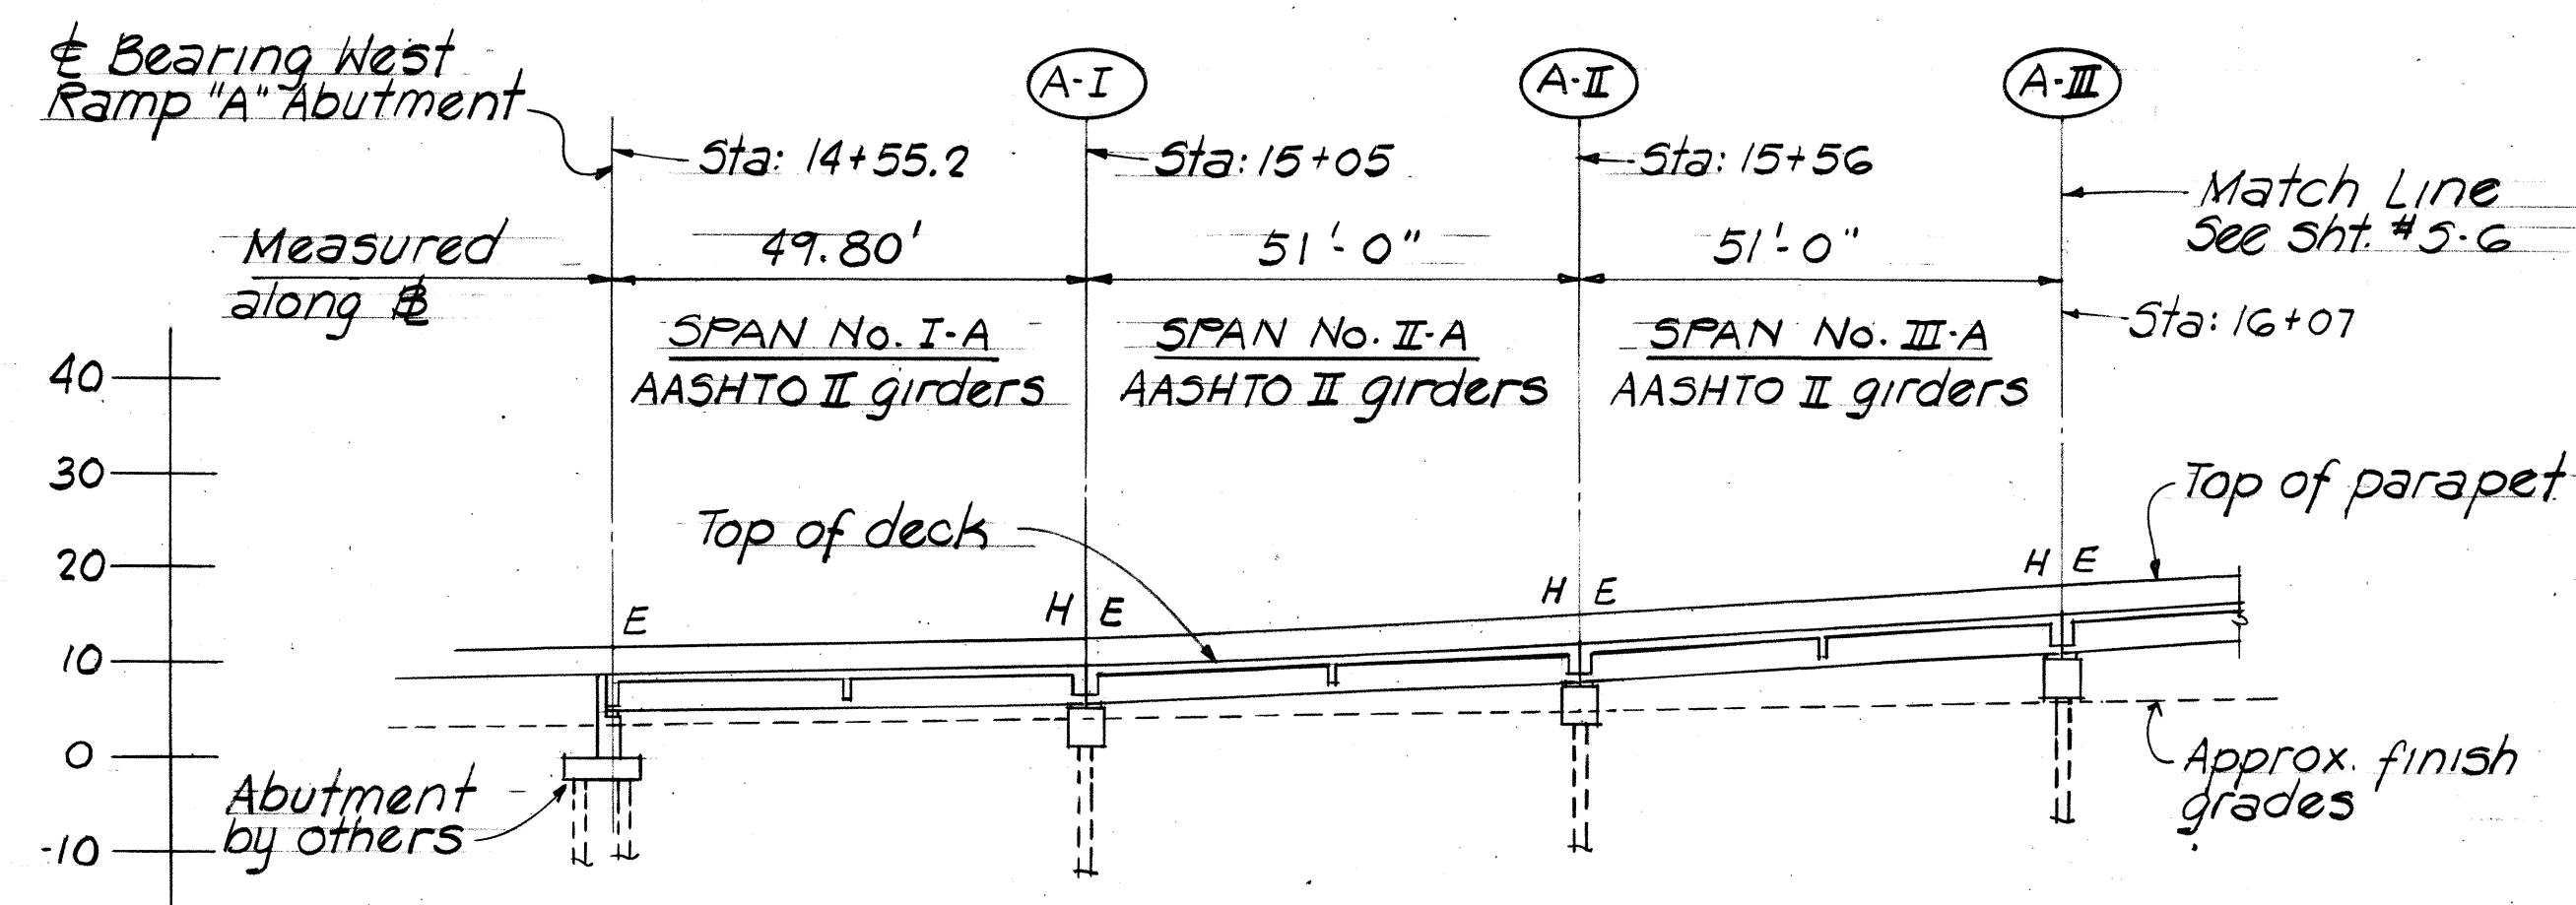


**PARTIAL LONGITUDINAL SECTION RAMP "A"**  
Scale 1"=20'-0"

**NOTES:**

- Top of concrete deck to follow finish roadway grade, except otherwise noted.
- Denotes deck scupper see detail shts. 5-36, 5-41, 5D-8 & 5D-9
- Electrical conduit are not shown on plans. See Electrical Drawings.
- H = Denotes Hinge Bearing
- E = Denotes Expansion Bearing
- Top of concrete deck to follow finish roadway grades.
- For limits of structural excavation and backfill pay limits see shts. 5-20 & 5-35

**NOTE:**

For Table of Pile Load Tests and Applicable Footings, See sht. no. 5D-11

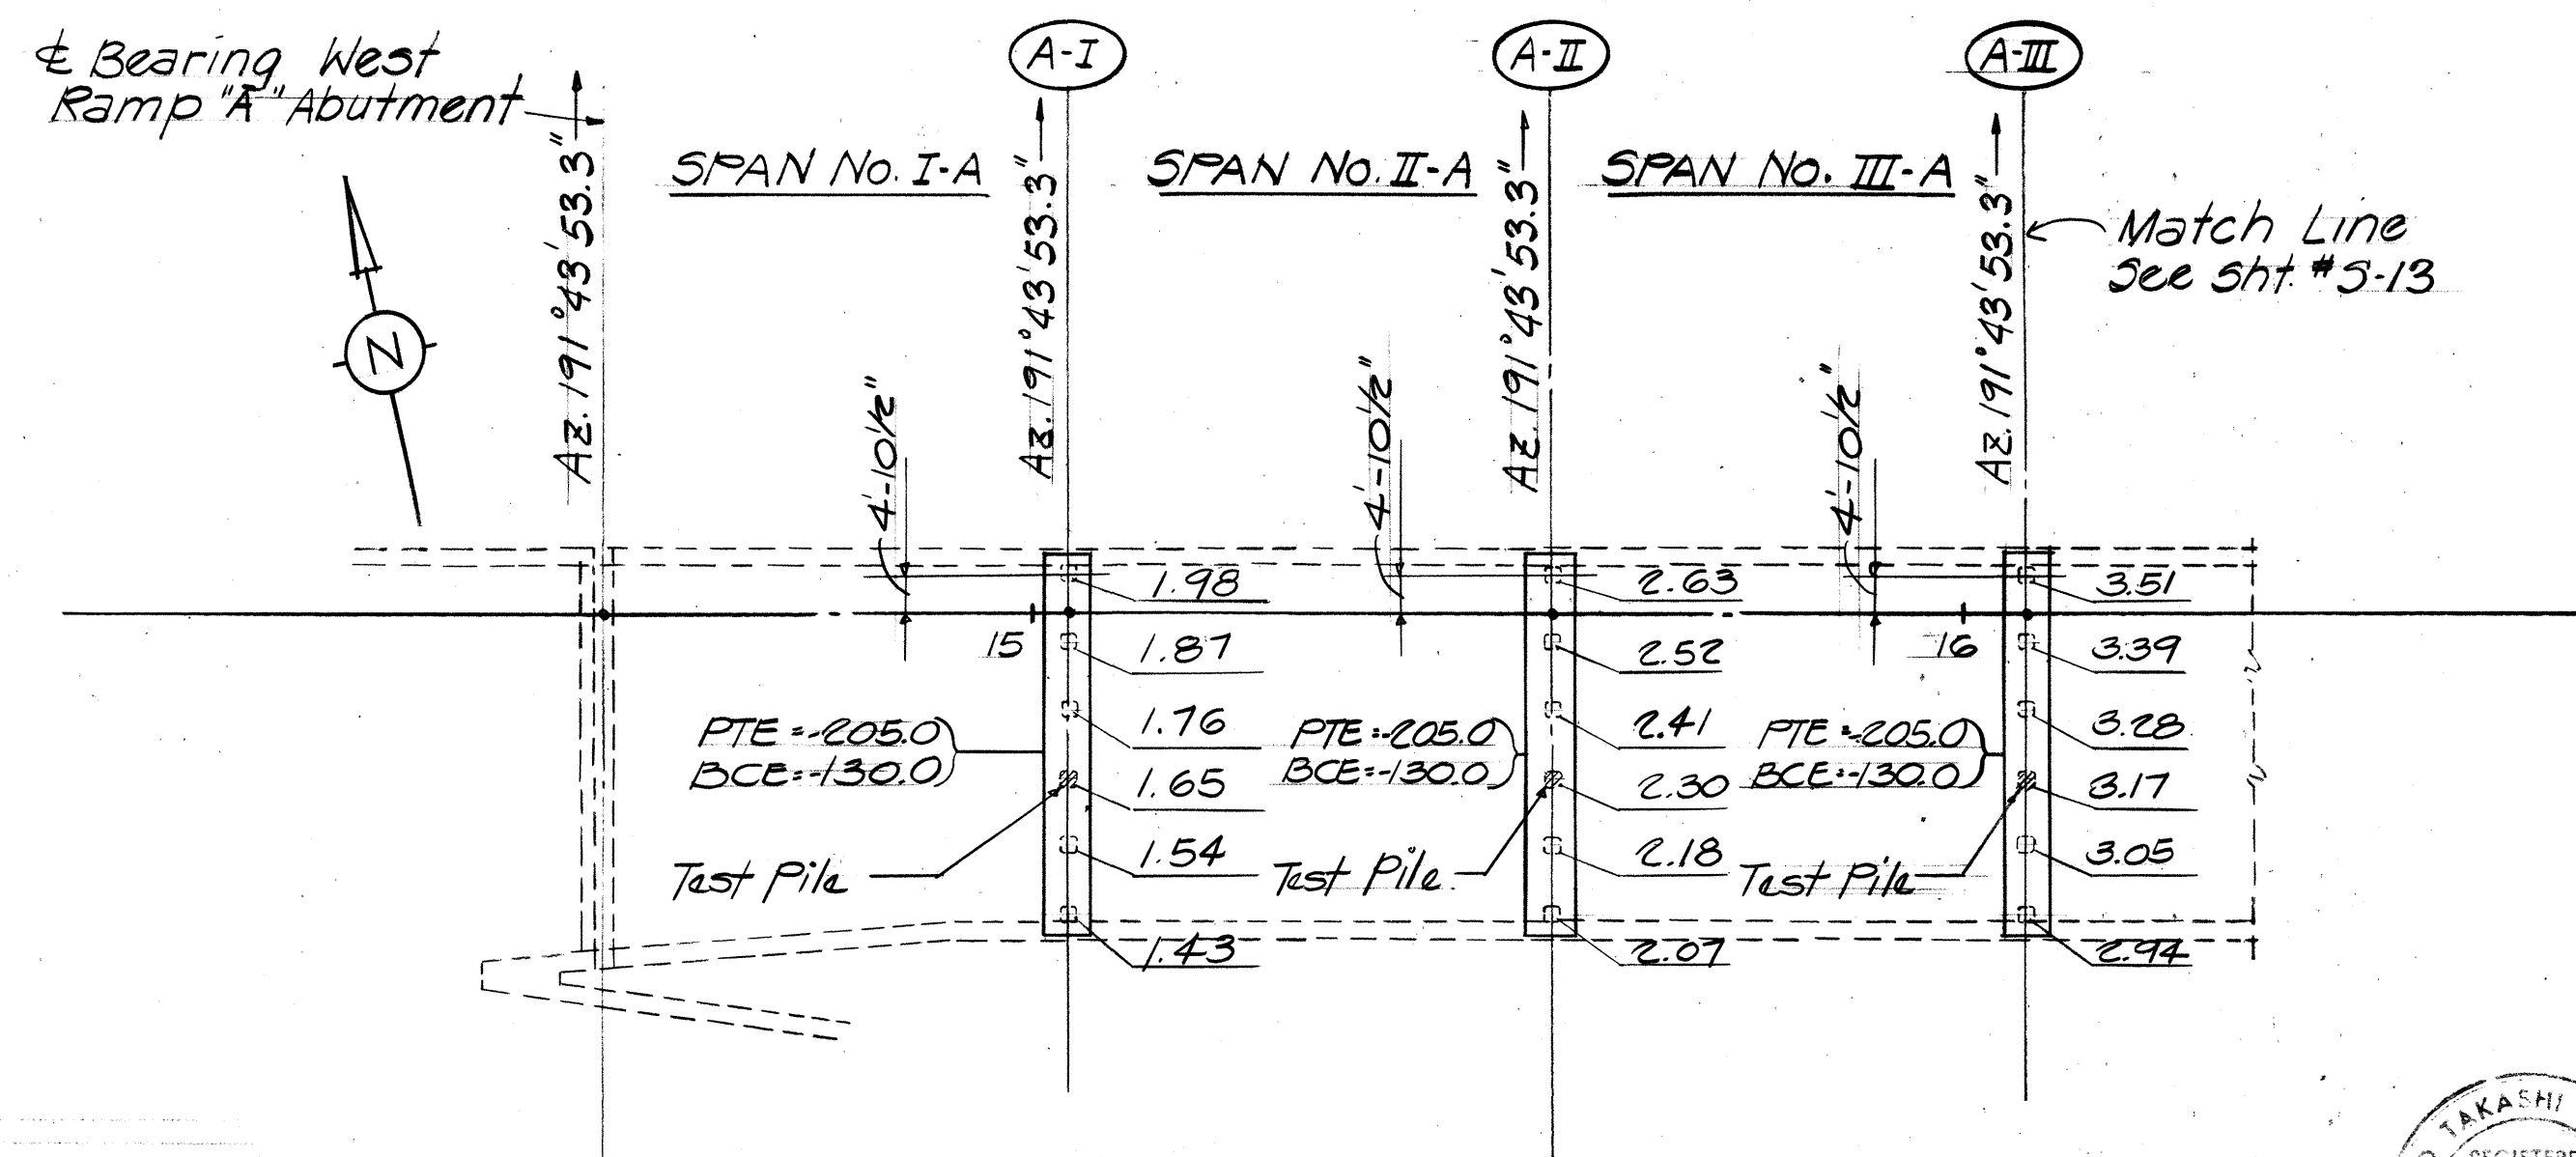


**PARTIAL FOUNDATION PLAN RAMP "A"**  
Scale 1"=20'-0"


**LEGEND**

- Precast Prestressed Concrete Piles, 16 1/2" octagonal, Type "A" Design Capacity 115 tons.
- Precast Prestressed Concrete Piles, 20" square, Type "B" Design Capacity 85 tons.

PTE = Estimated Pile Tip Elevation  
BCE = Elevation of Lower Limits of Bitumen Coating  
0.00 = Pile Cut-off Elevations at Piers A-I thru A-III

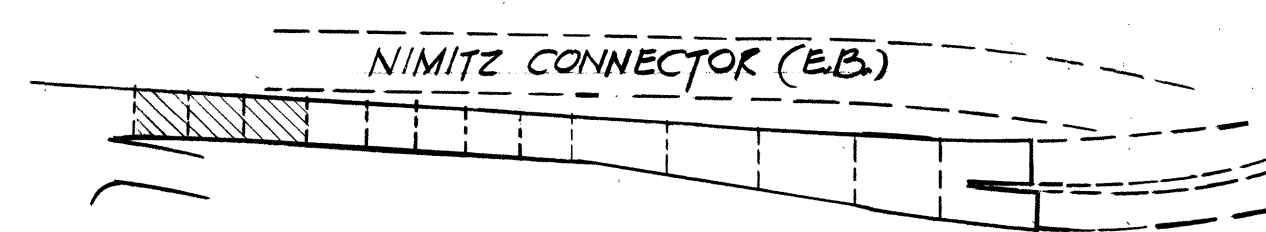

**KEY PLAN**

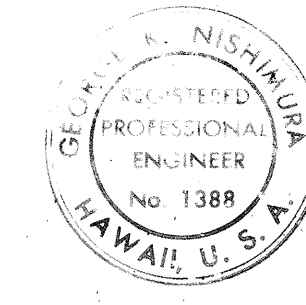

THIS WORK WAS PREPARED BY ME OR UNDER MY SUPERVISION

Signature: [Signature]

THIS WORK WAS PREPARED BY ME OR UNDER MY SUPERVISION


Signature: [Signature]

STATE OF HAWAII  
DEPARTMENT OF TRANSPORTATION  
LAND TRANSPORTATION FACILITIES DIVISION

**NIMITZ CONNECTOR (E.B.)  
RAMP "A" & RAMP "B"**  
PARTIAL LAYOUT, FOUNDATION, GRID GRADE PLANS, & LONGITUDINAL SECTION  
KEEHI INTERCHANGE  
F.A.I. PROJ. No. 1-HI-1 (168)17  
Scale: 1"=20'-0" Date: JULY, 1981  
SHEET No. 5-4 OF 49 SHEETS



|                  |                   |      |
|------------------|-------------------|------|
| ORIGINAL<br>PLAN | SURVEY PLOTTED BY | DATE |
|                  | DRAWN BY          |      |
|                  | TRACED BY         |      |
|                  | DESIGNED BY       |      |
|                  | QUANTITIES BY     |      |
|                  | CHECKED BY        |      |
| NOTE BOOK        |                   |      |
| No.              |                   |      |

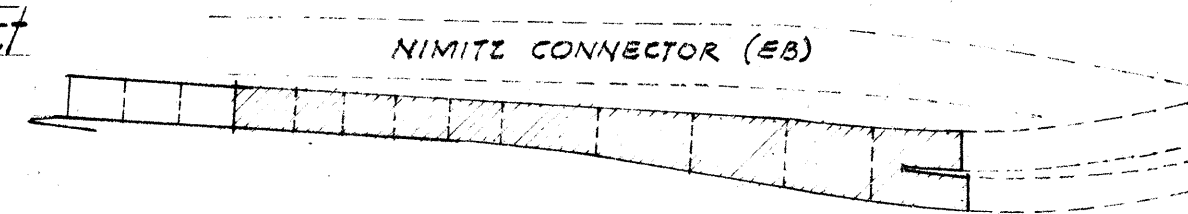

# KEY PLAN


KEEHI INTERCHANGE  
F.A.I. PROJECT NO. I HI-1 (108) 17  
Scale 1"=20'-0" Date: JULY, 1981

---

SHEET NO. 5-5 OF 49 SHEETS







| FED. ROAD DIST. NO. | STATE | FED. AID PROJ. NO. | FISCAL YEAR | SHEET NO. | TOTAL SHEETS |
|---------------------|-------|--------------------|-------------|-----------|--------------|
| HAWAII              | HAW.  | HI-1(108)17        | 1982        | 88        | 145          |

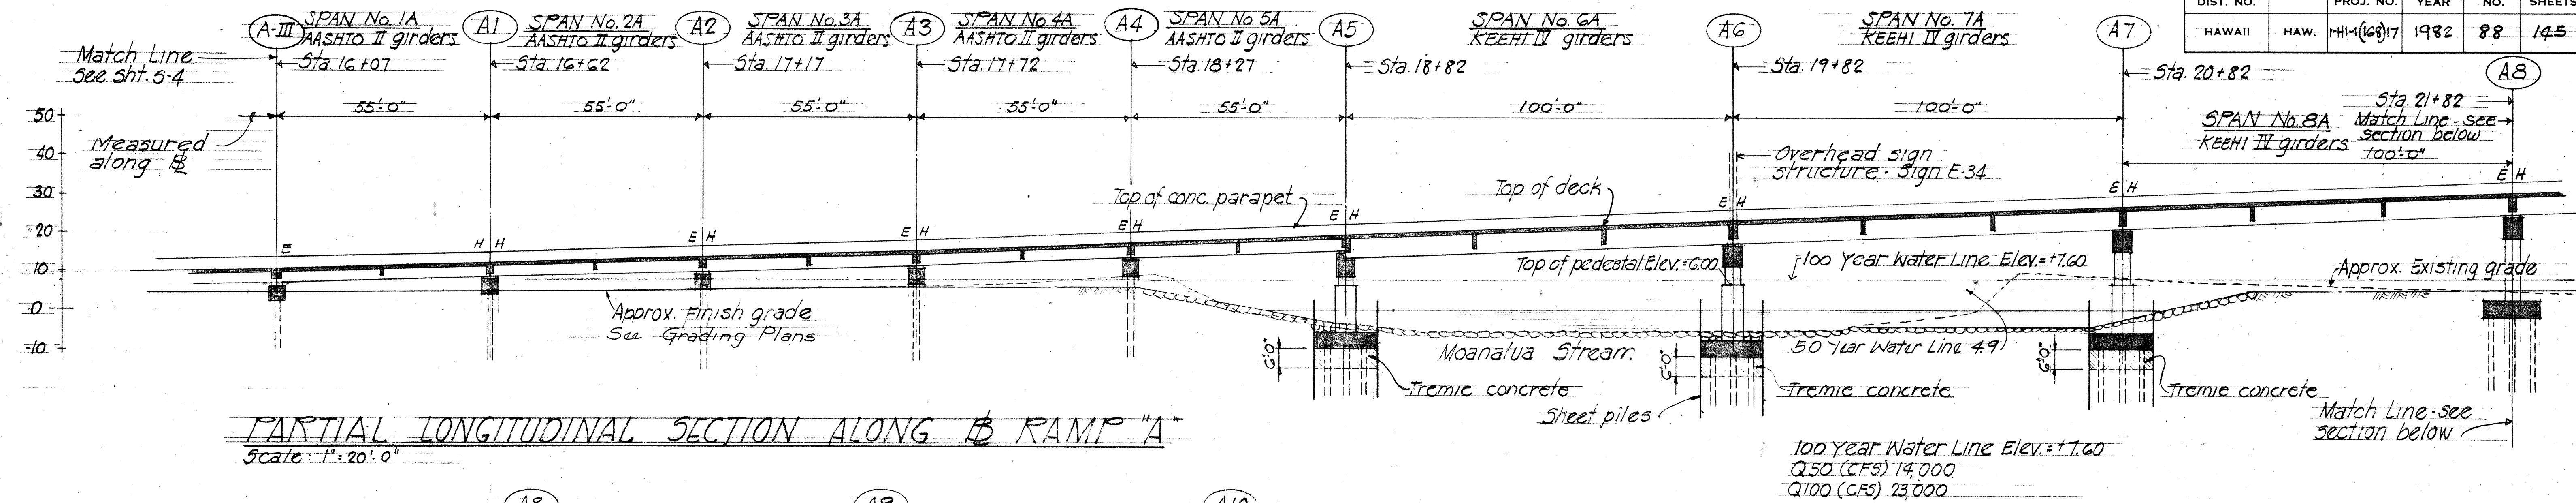

**NOTES:**

1. H = Denotes Hinge Bearing
2. E = Denotes Expansion Bearing
3. Top of concrete deck to follow finish roadway grades
4. For Limits of structural excavation and backfill pay limits see Sht. 5-20 & 5-35

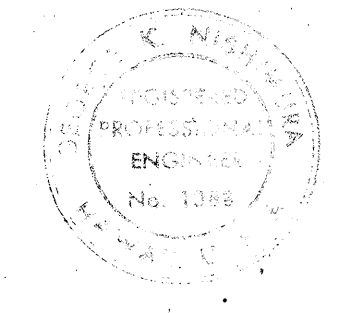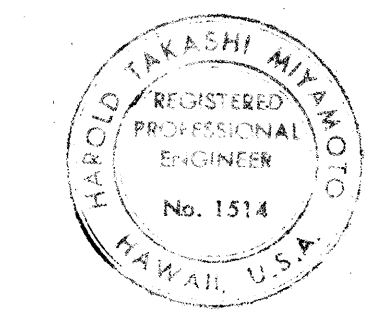
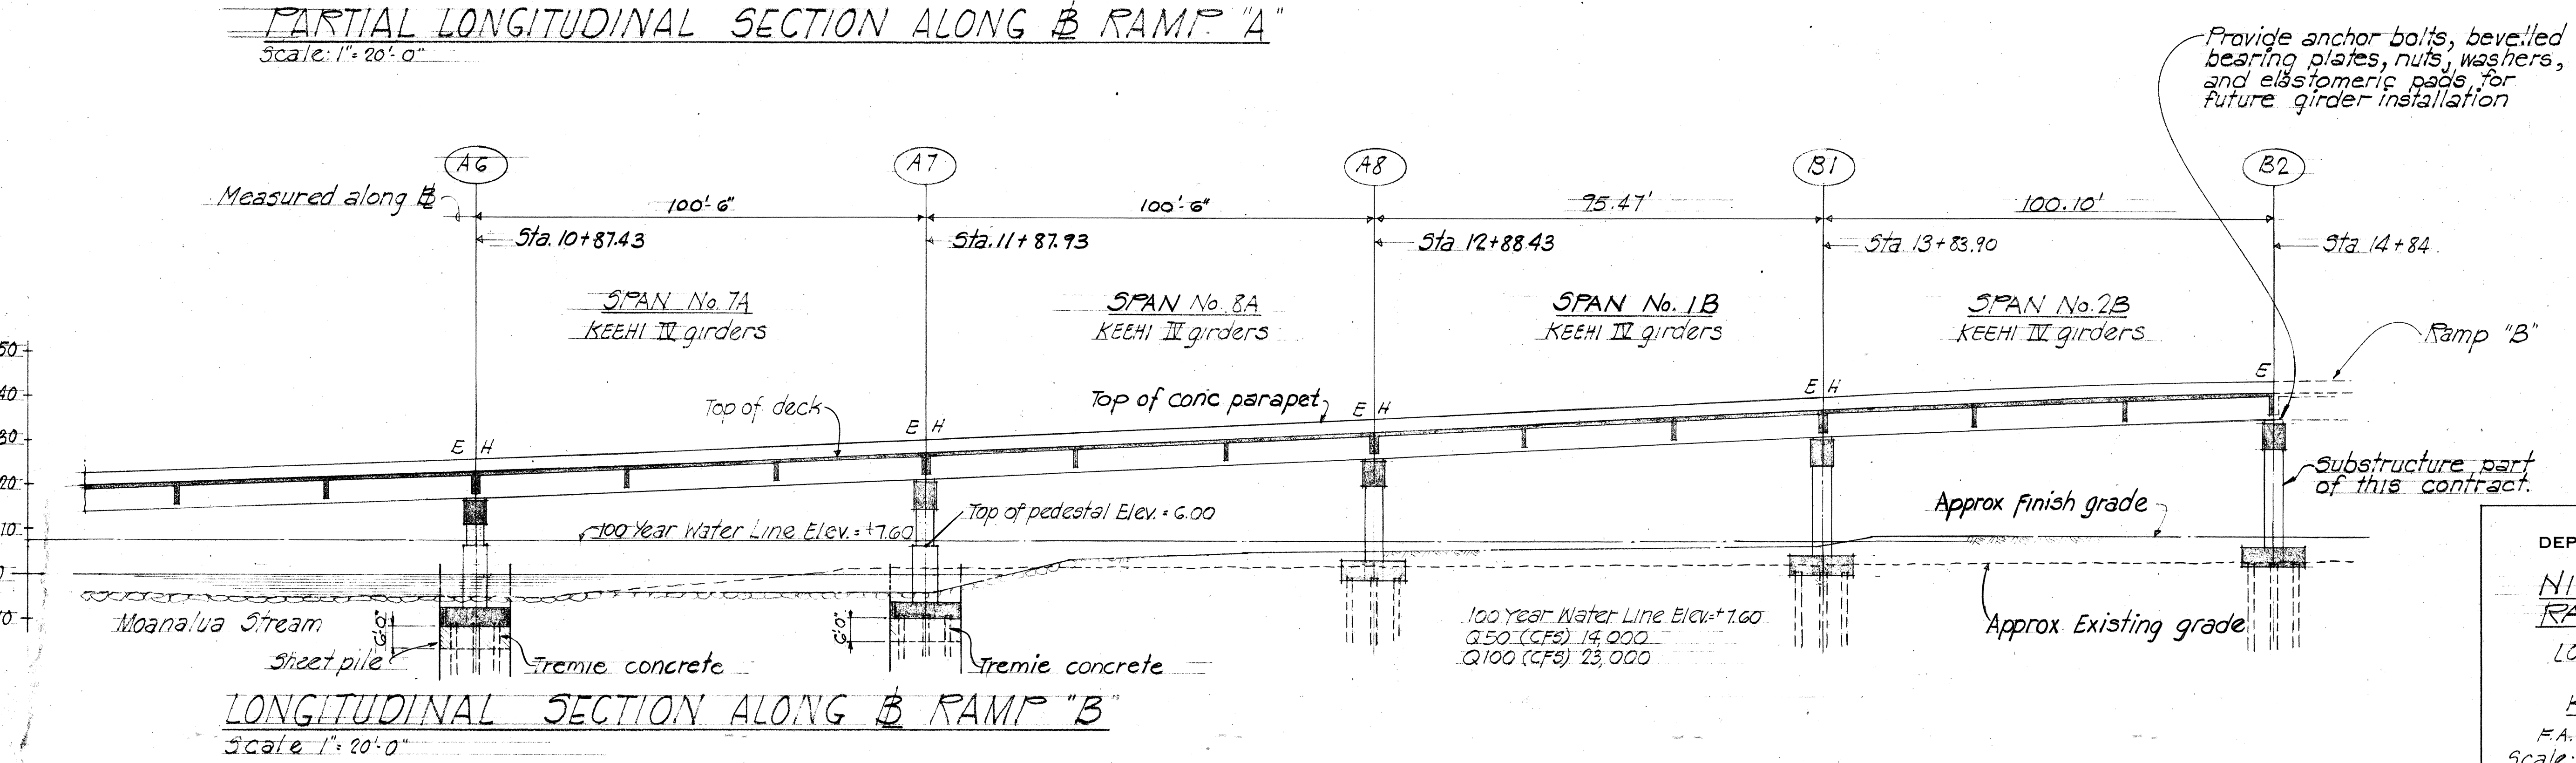
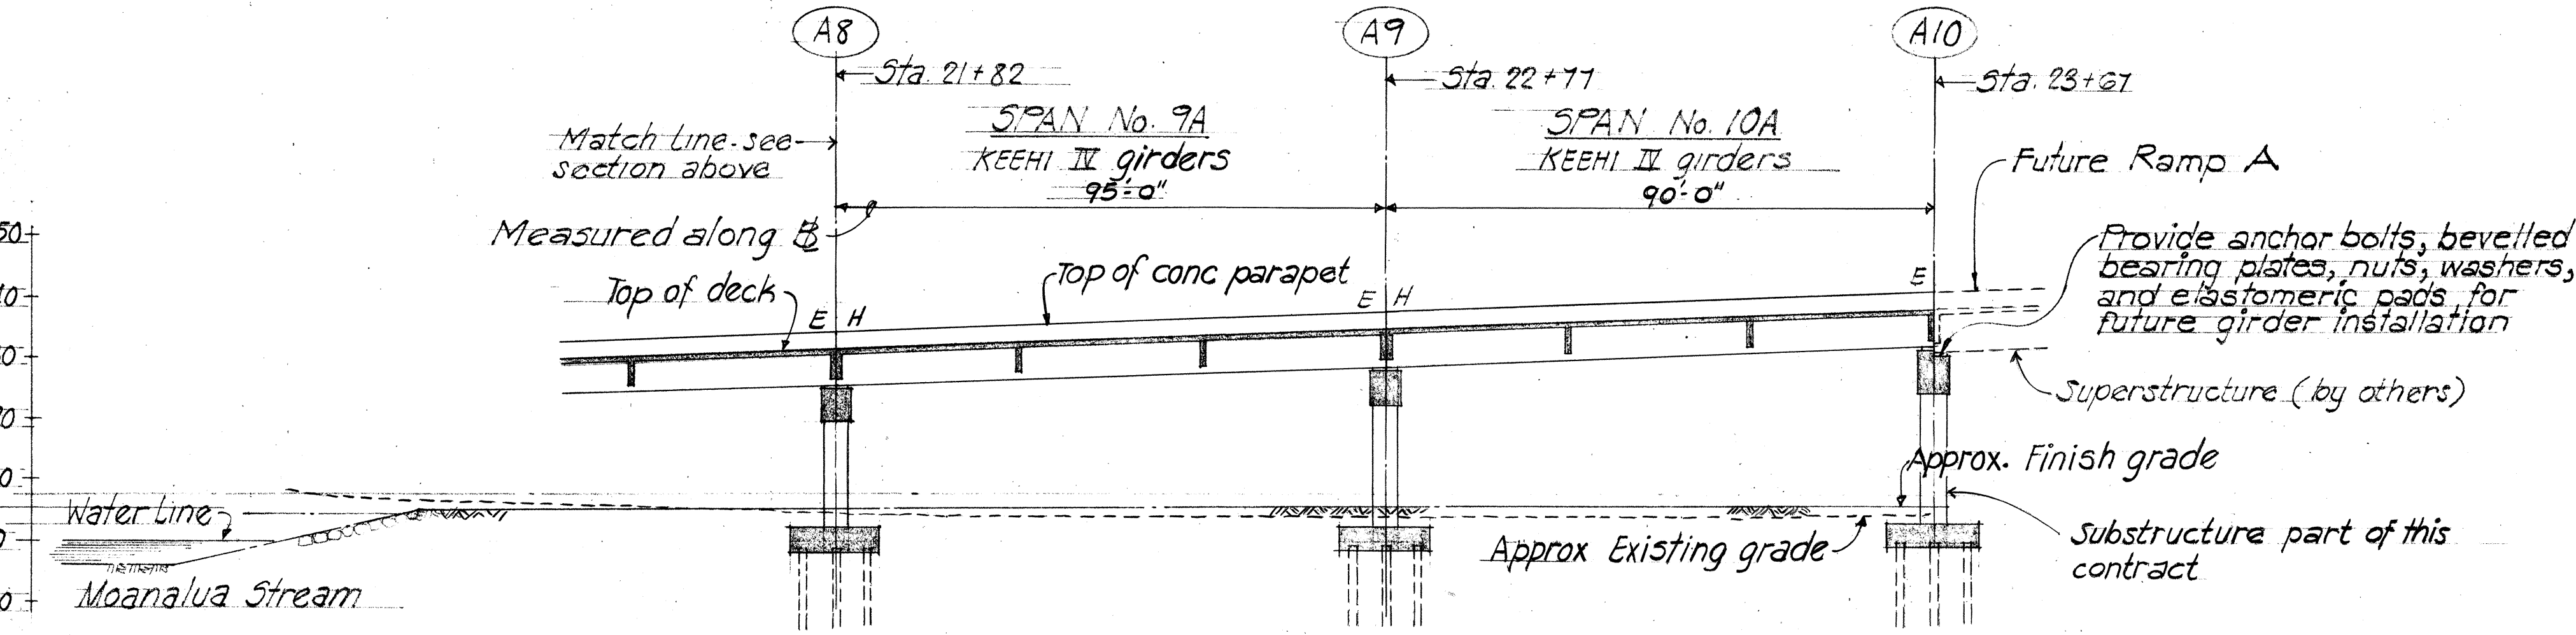


THIS WORK WAS PROVIDED BY ME OR UNDER MY SUPERVISION  
 THIS WORK WAS PROVIDED BY ME OR UNDER MY SUPERVISION

STATE OF HAWAII  
 DEPARTMENT OF TRANSPORTATION  
 HIGHWAYS DIVISION  
**NIMITZ CONNECTOR (E.B.)**  
**RAMP "A" & RAMP "B"**  
 LONGITUDINAL SECTIONS  
 KEEHI INTERCHANGE  
 F.A.I. PROJECT NO. I-HI-1 (108)17  
 Scale: 1" = 20'-0" Date: JULY, 1981  
 SHEET NO. 5-6 OF 49 SHEETS



| FED. ROAD DIST. NO. | STATE | FED. AID PROJ. NO. | FISCAL YEAR | SHEET NO. | TOTAL SHEETS |
|---------------------|-------|--------------------|-------------|-----------|--------------|
| HAWAII              | HAW.  | 1-H1-16817         | 1982        | 89        | 145          |

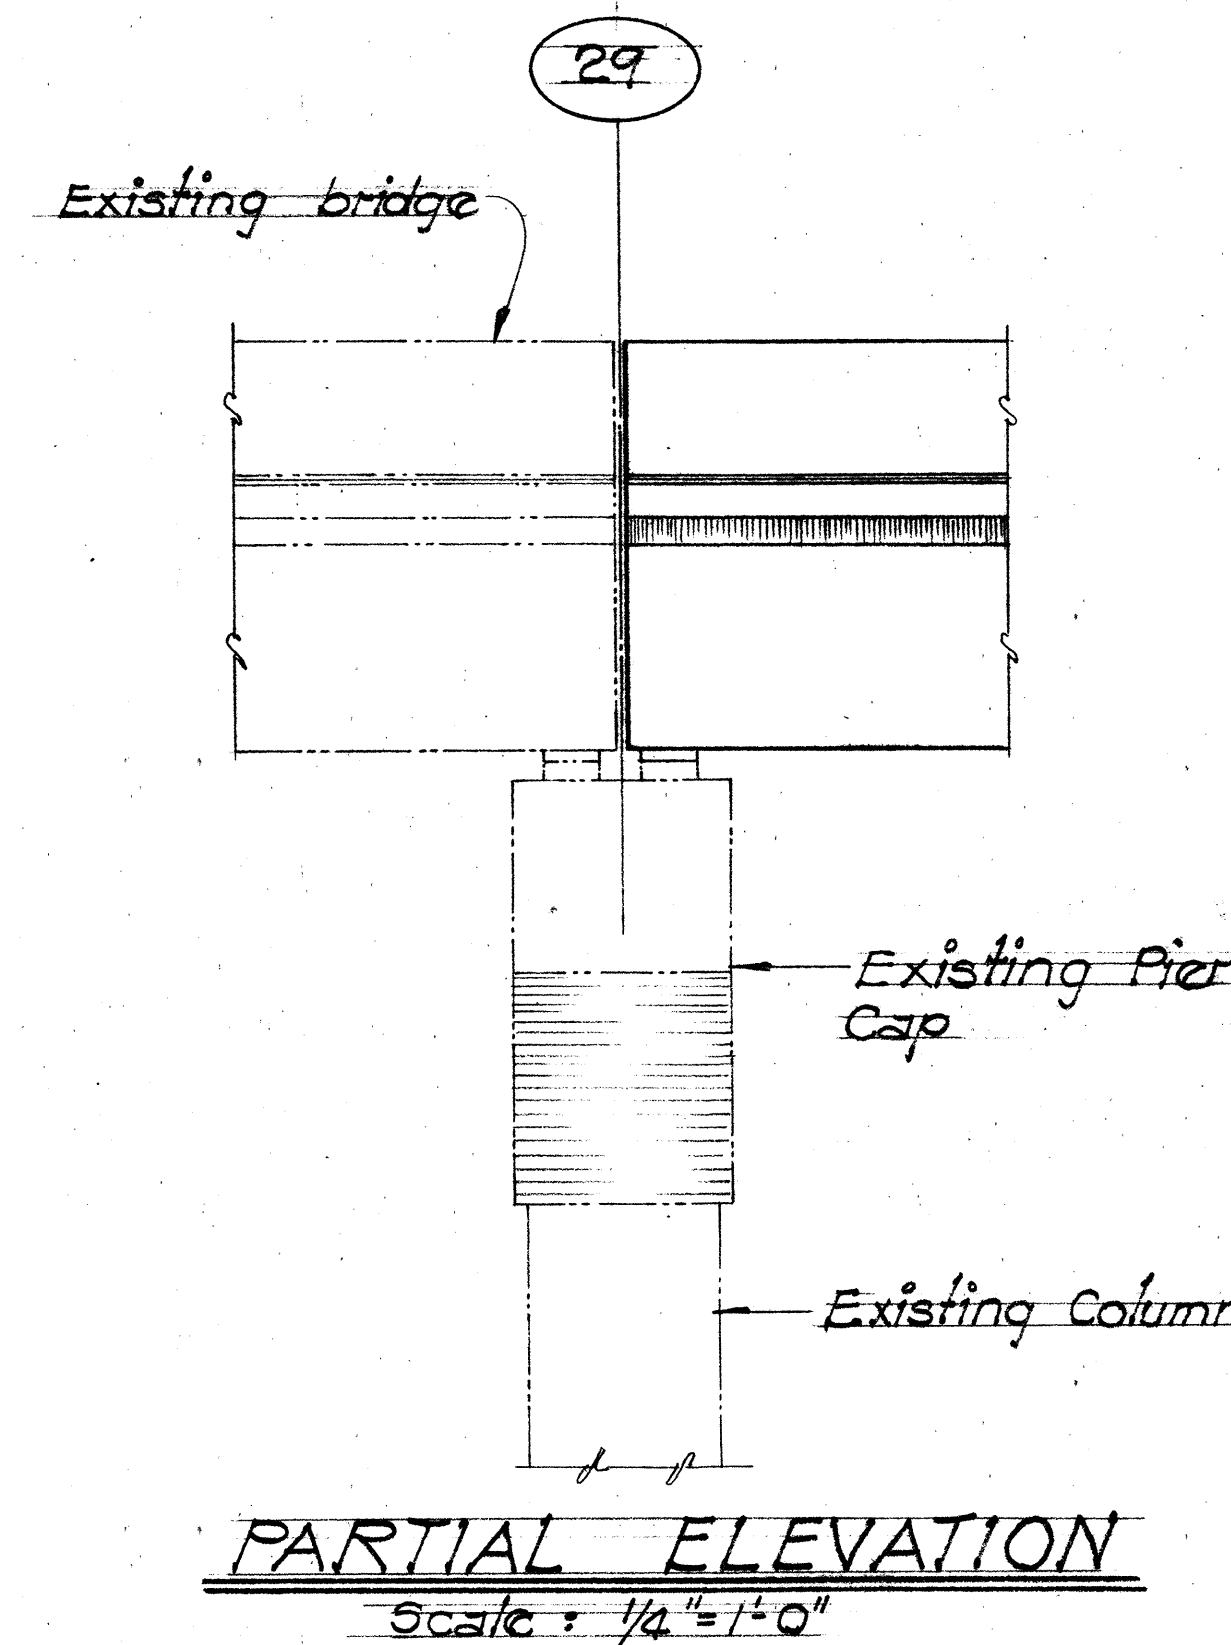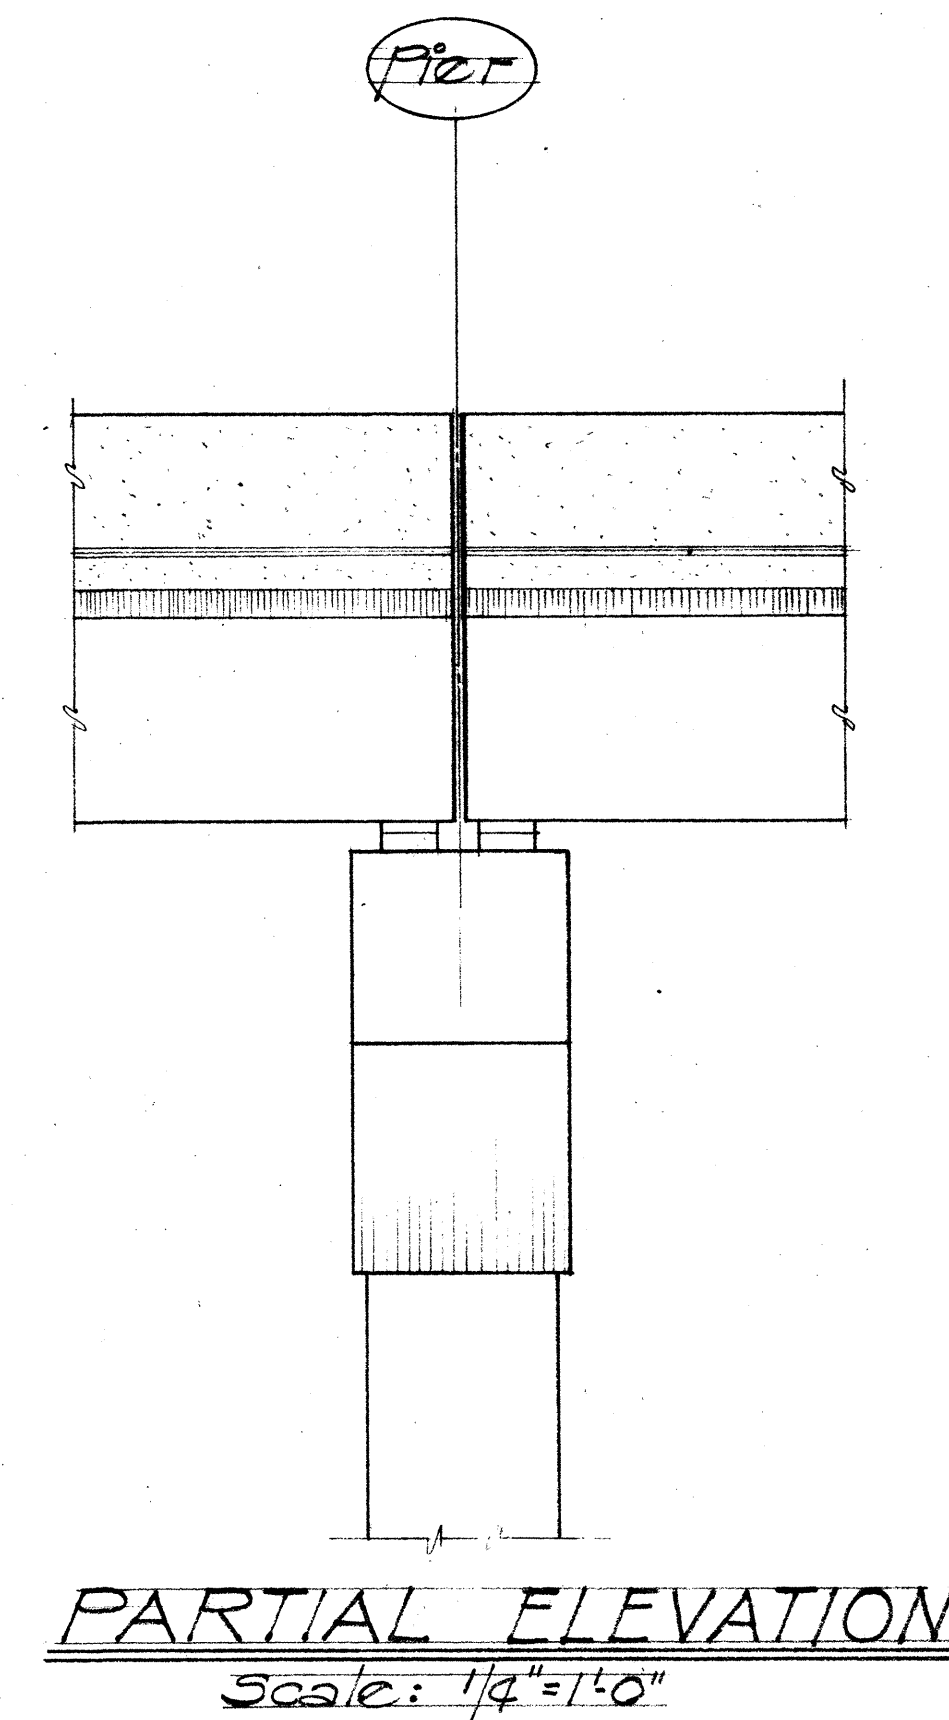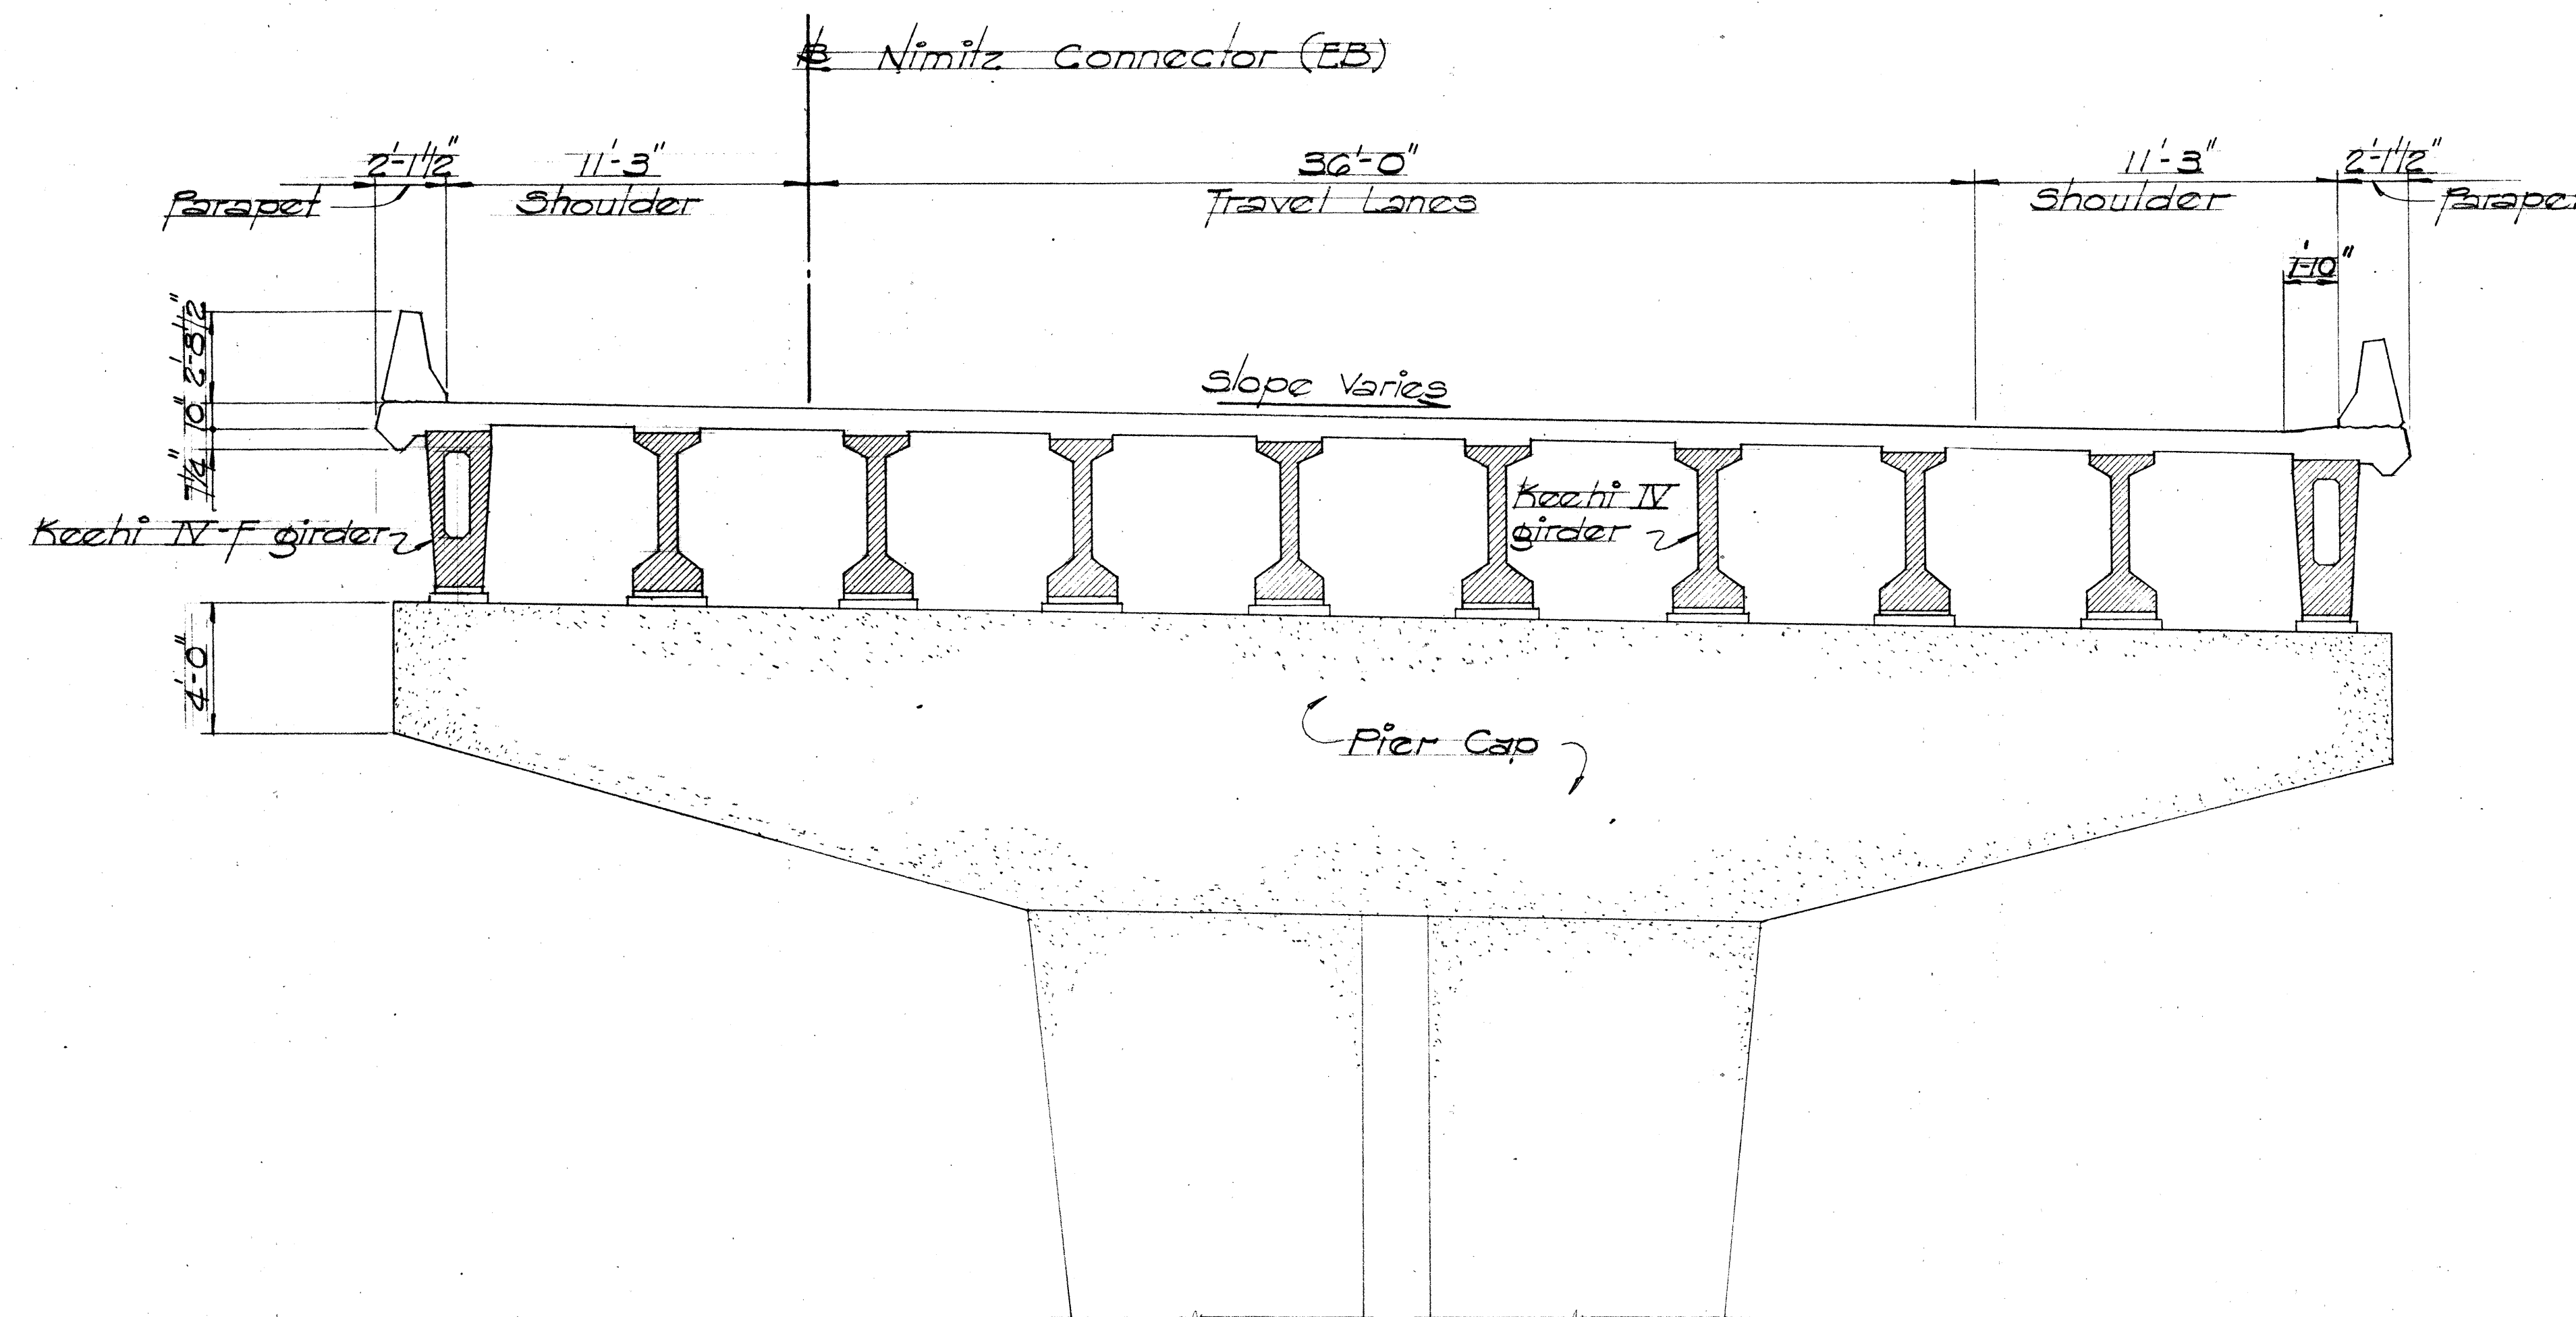


NORMAL SECTION NIMITZ CONNECTION (EB)  
Sta. 22+94 thru Sta. 30+94.36  
Scale: 1/4" = 1'-0"

|                   |  |
|-------------------|--|
| DATE              |  |
| SURVEY PLOTTED BY |  |
| DRAWN BY          |  |
| CHECKED BY        |  |
| NOTE BOOK         |  |
| NO.               |  |



THIS WORK WAS PREPARED BY ME  
OR UNDER MY SUPERVISION

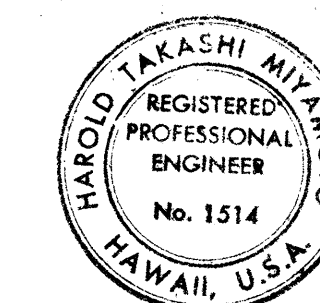

THIS WORK WAS PREPARED BY ME  
OR UNDER MY SUPERVISION

STATE OF HAWAII  
DEPARTMENT OF TRANSPORTATION  
HIGHWAYS DIVISION

NIMITZ CONNECTOR (EB)  
RAMP "A" AND RAMP "B"

NORMAL SECTION & PARTIAL ELEVATIONS


KEEHI INTERCHANGE  
F&M PROJ. NO. H-1-16817

SCALE: AS SHOWN DATE: JULY 1981

SHEET NO. 5-7 OF 49 SHEETS




| FED. ROAD DIST. NO. | STATE | FED. AID PROJ. NO. | FISCAL YEAR | SHEET NO. | TOTAL SHEETS |
|---------------------|-------|--------------------|-------------|-----------|--------------|
| HAWAII              | HAW.  | I-HI-1(168)17      | 1982        | 90        | 145          |

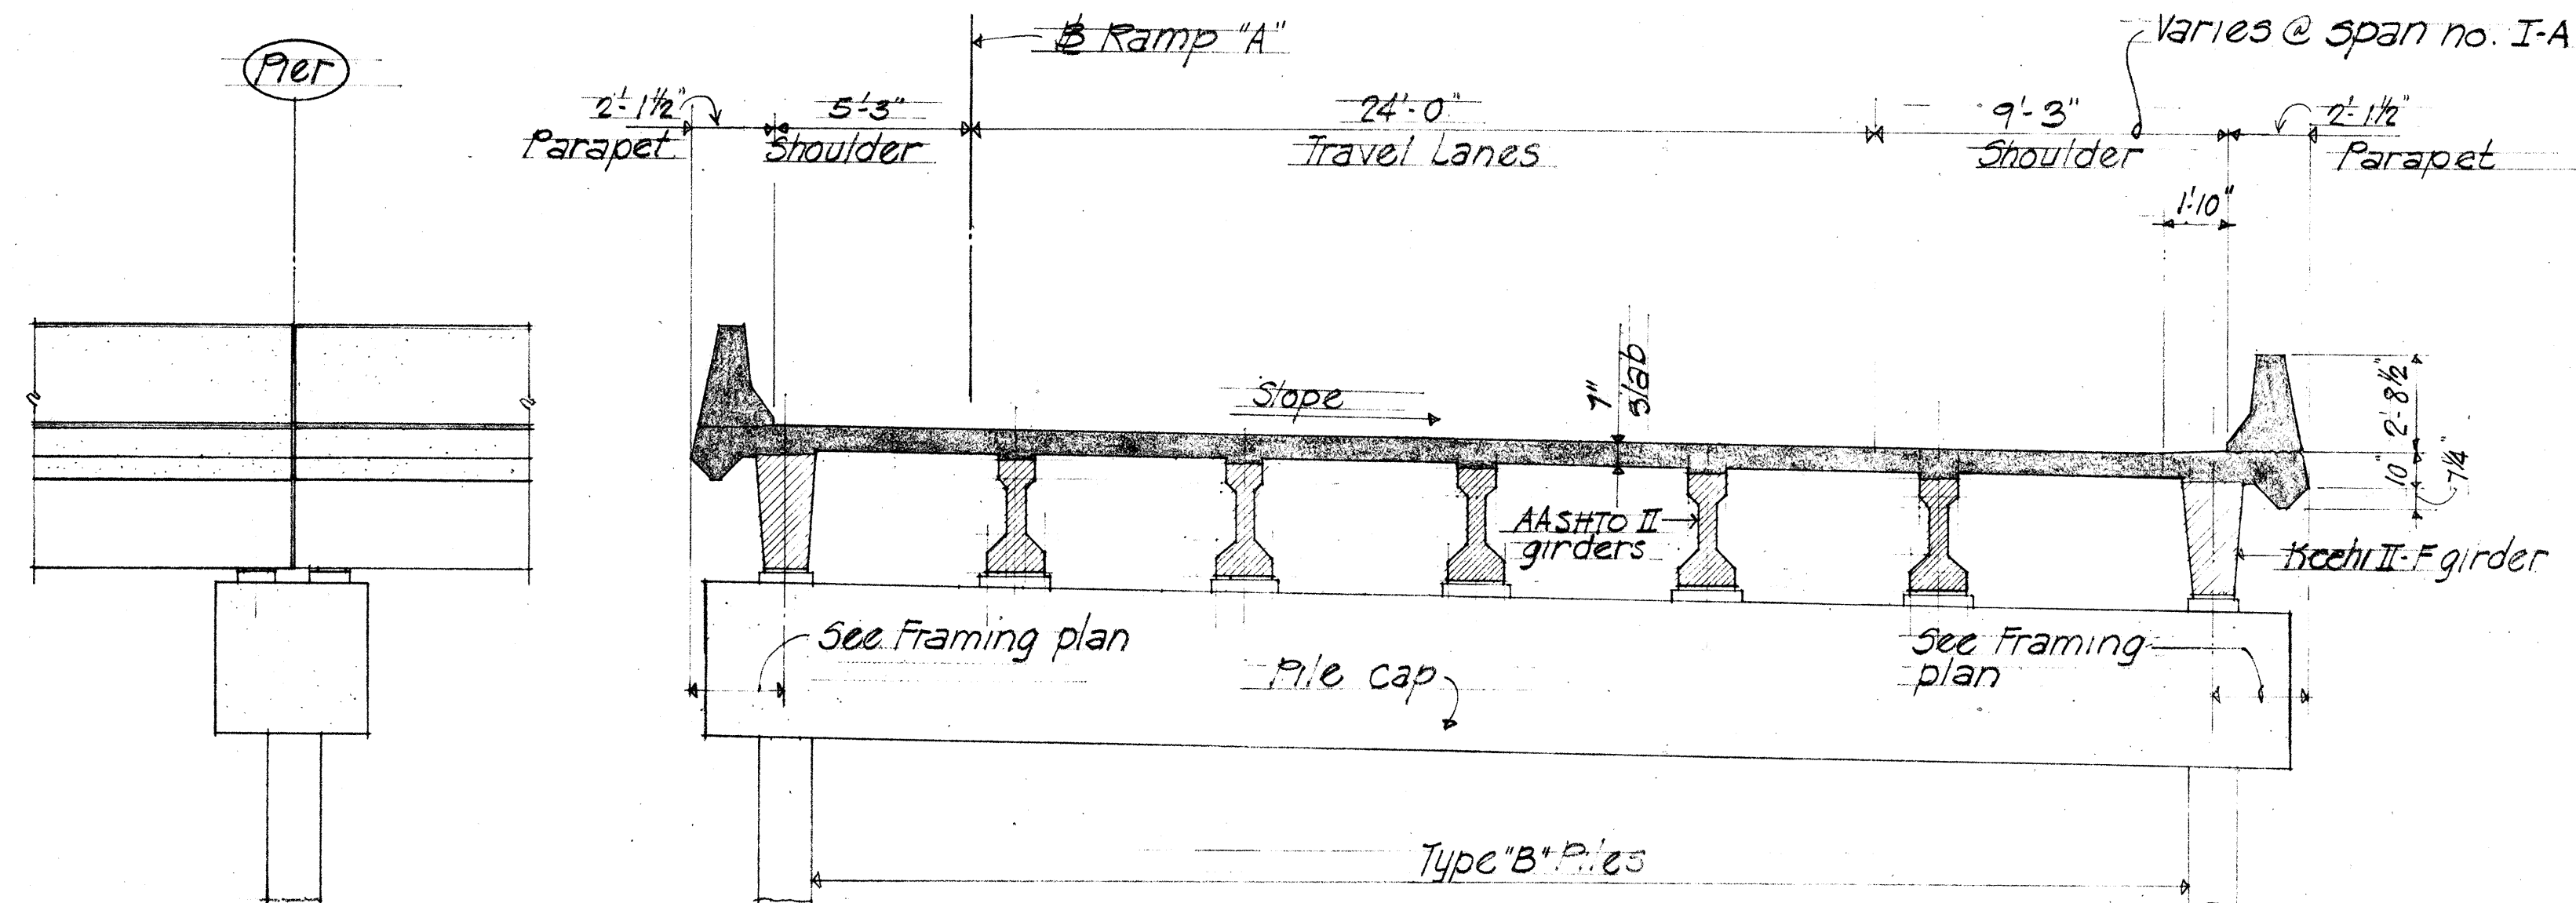


PARTIAL ELEVATION  
Scale 1/4"=1'-0"


NORMAL SECTION Sta. 14+55.2 thru Sta. 18+82  
Scale 1/4"=1'-0"

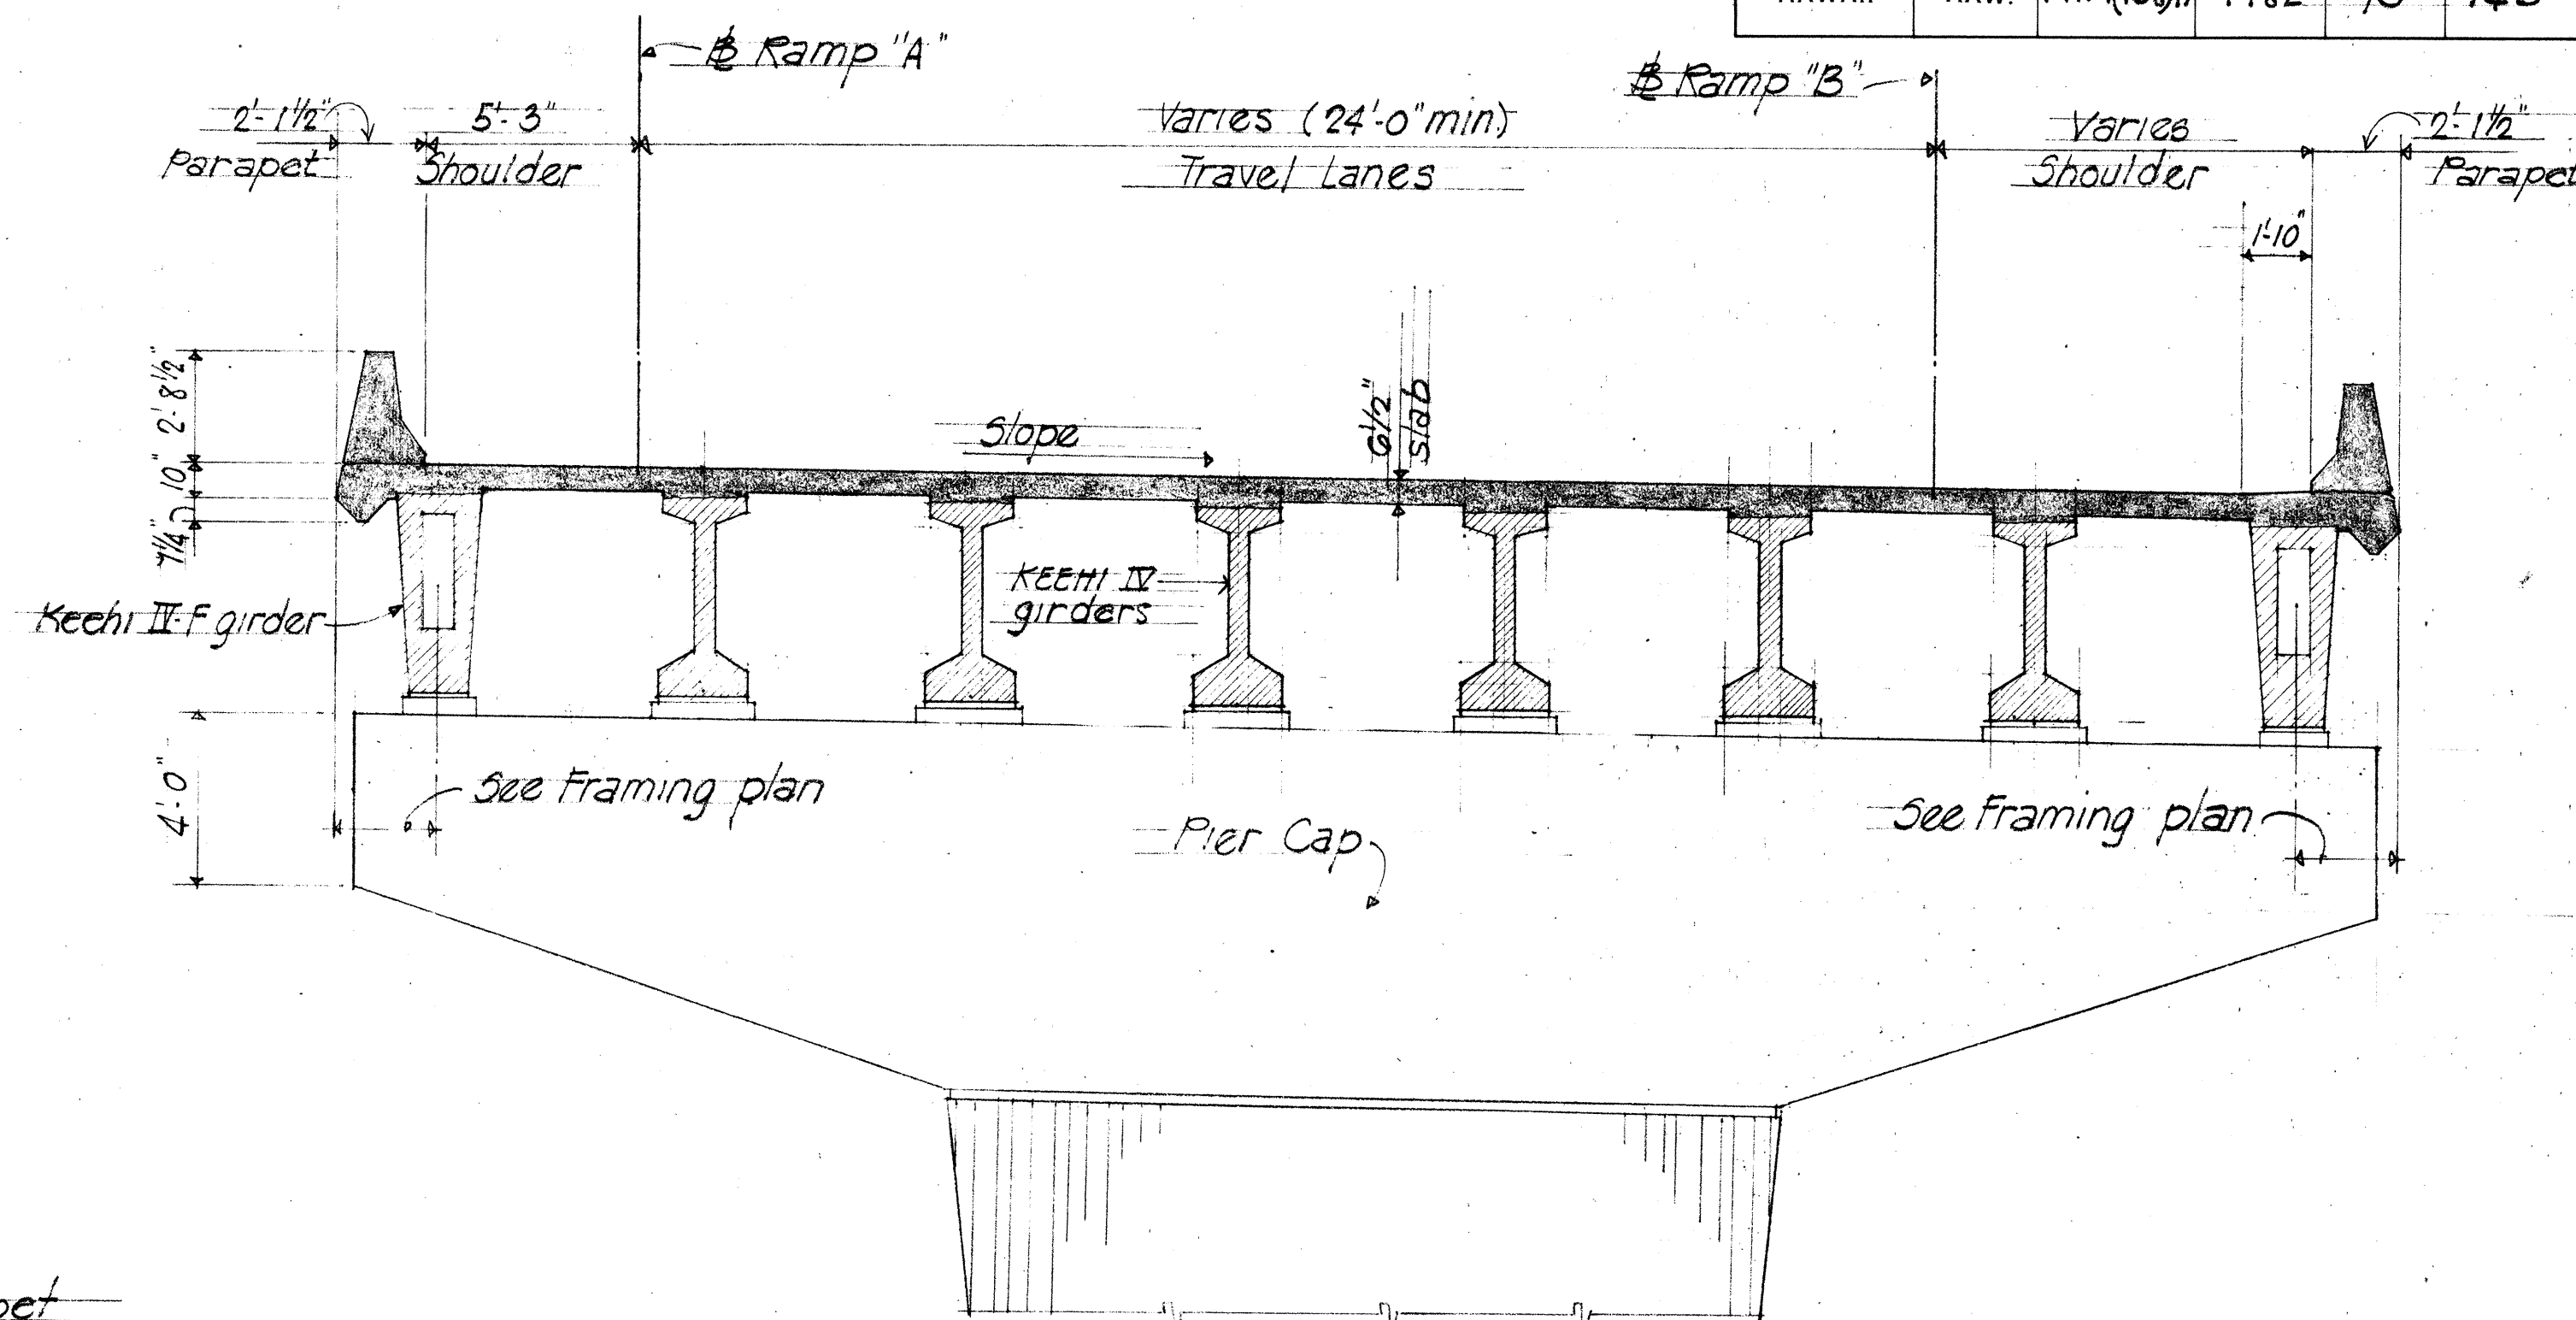


NORMAL SECTION Sta. 18+82 thru Sta. 20+45.75  
Scale 1/4"=1'-0"

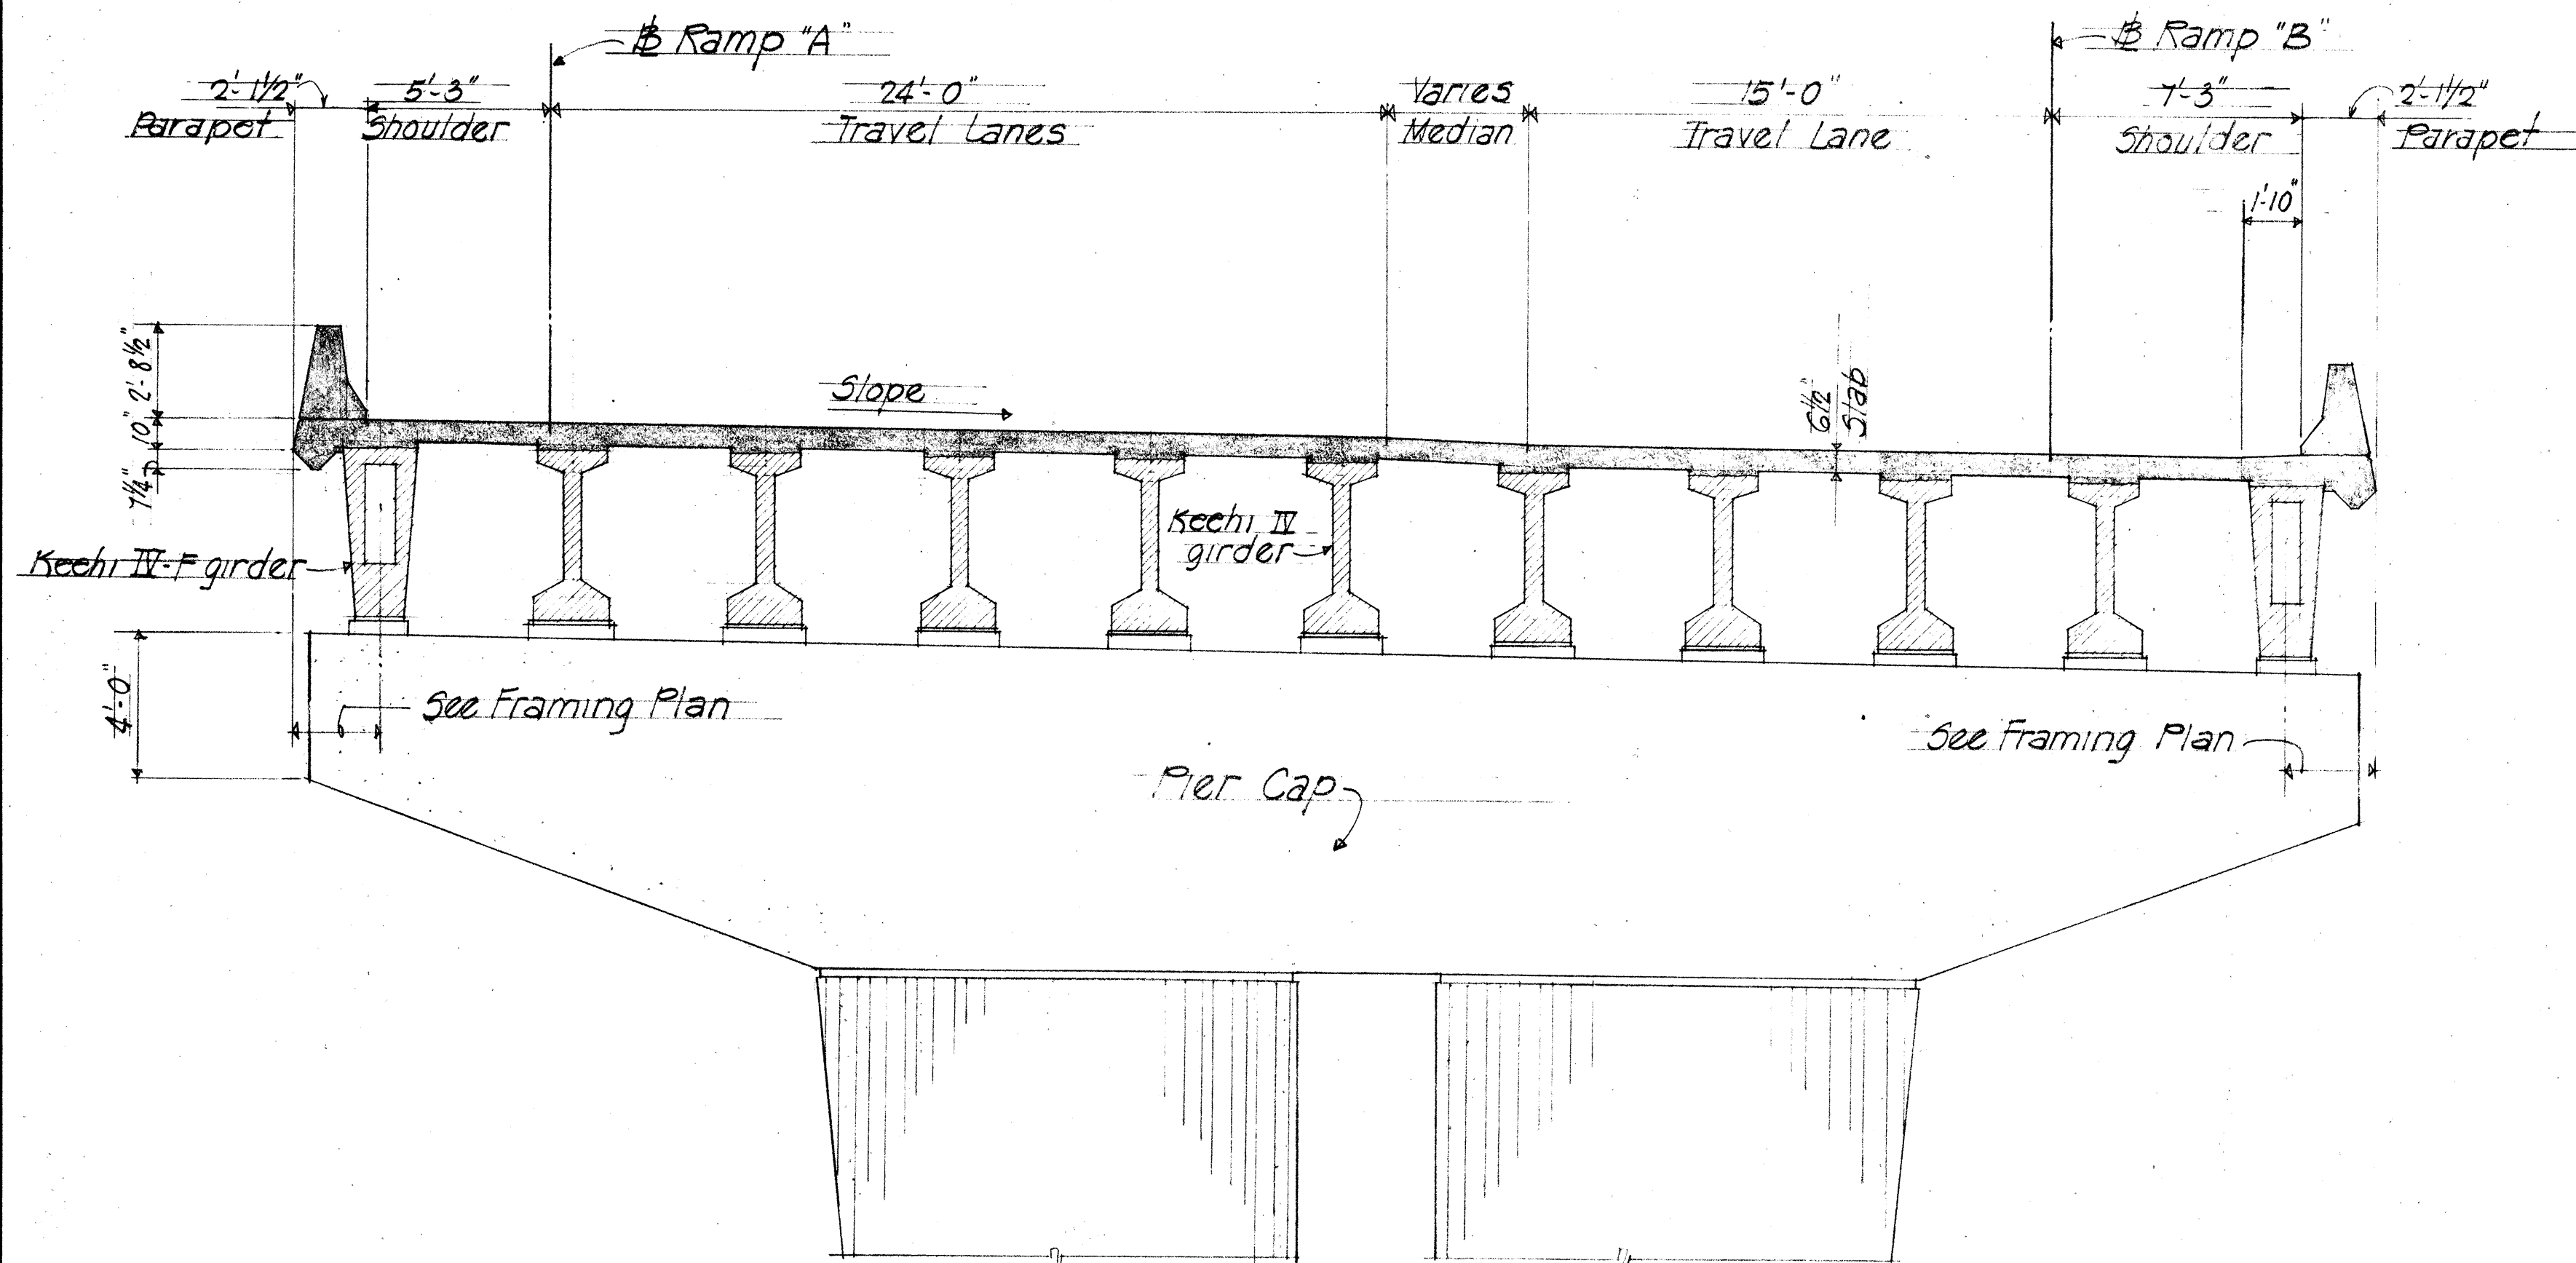

NORMAL SECTION Sta. 20+45.75 thru Sta. 22+17  
Scale 1/4"=1'-0"

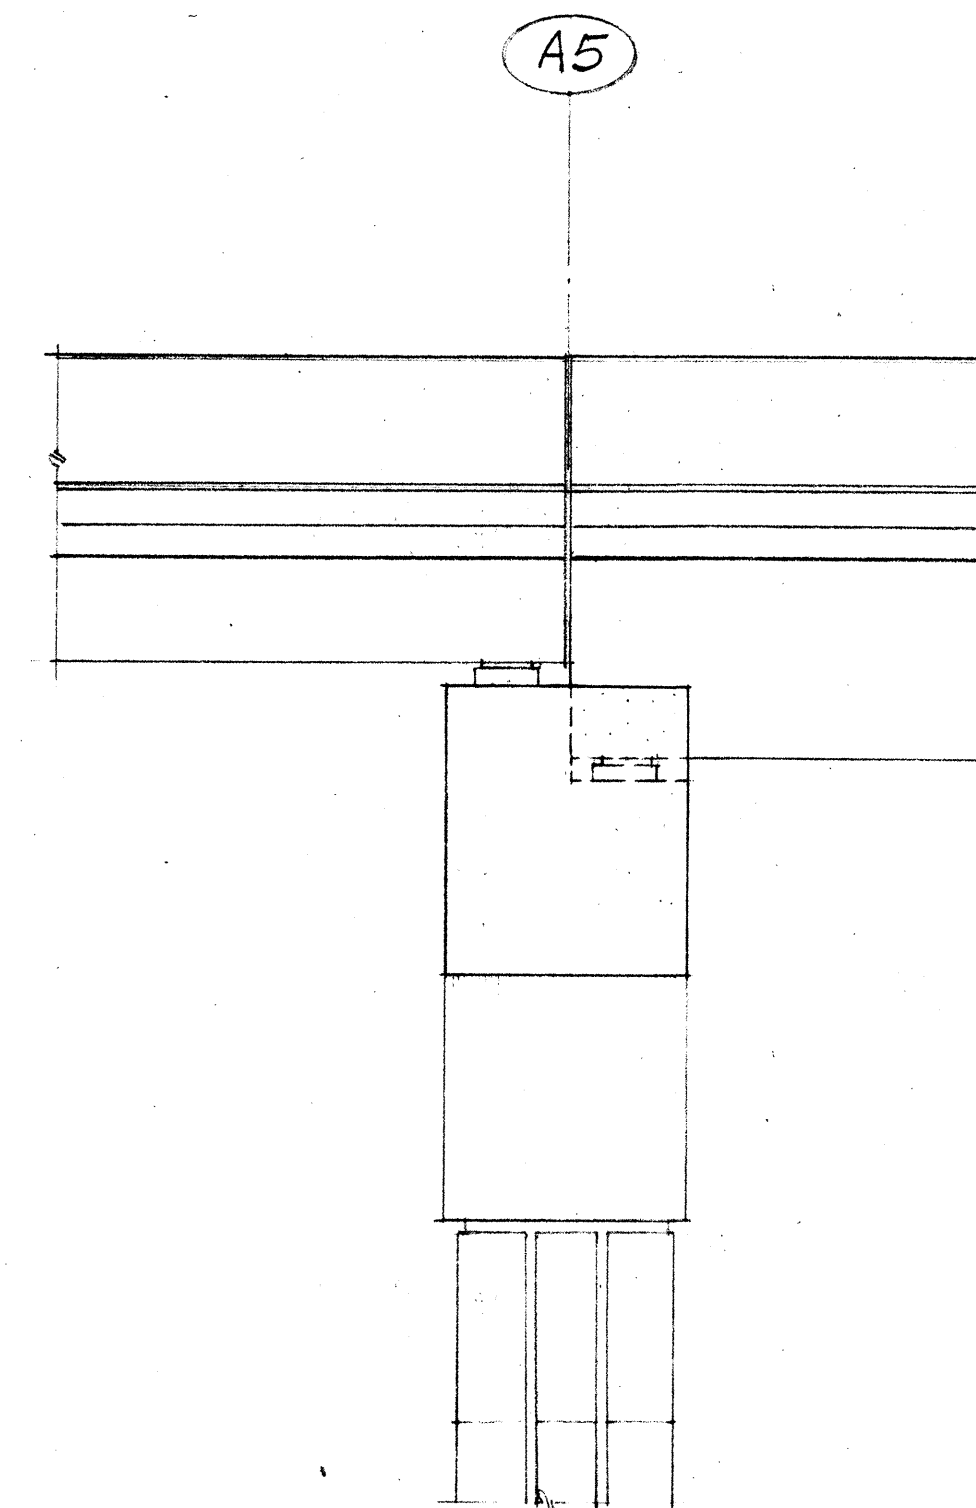

PARTIAL ELEVATION @ GIRDER TRANSITION  
Scale 1/4"=1'-0"

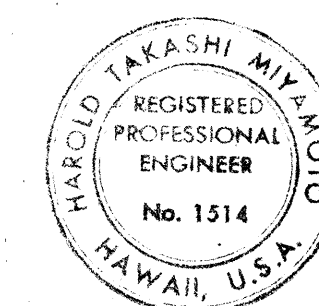


THIS WORK WAS PREPARED BY  
ME OR UNDER MY SUPERVISION  
THIS WORK WAS PREPARED BY  
ME OR UNDER MY SUPERVISION

STATE OF HAWAII  
DEPARTMENT OF TRANSPORTATION  
HIGHWAYS DIVISION  
NIMITZ CONNECTOR (E.B.)  
RAMP "A" & RAMP "B"  
NORMAL SECTION & PARTIAL ELEVATION  
KEEHI INTERCHANGE  
F.A.I. PROJECT NO. I-HI-1 (168)17  
Scale 1/4"=1'-0" Date JULY, 1981  
SHEET No. 5-8 OF 49 SHEETS





| FED. ROAD DIST. NO. | STATE | FED. AID PROJ. NO. | FISCAL YEAR | SHEET NO. | TOTAL SHEETS |
|---------------------|-------|--------------------|-------------|-----------|--------------|
| HAWAII              | HAW.  | I-HI-1(68)17       | 1982        | 91        | 145          |

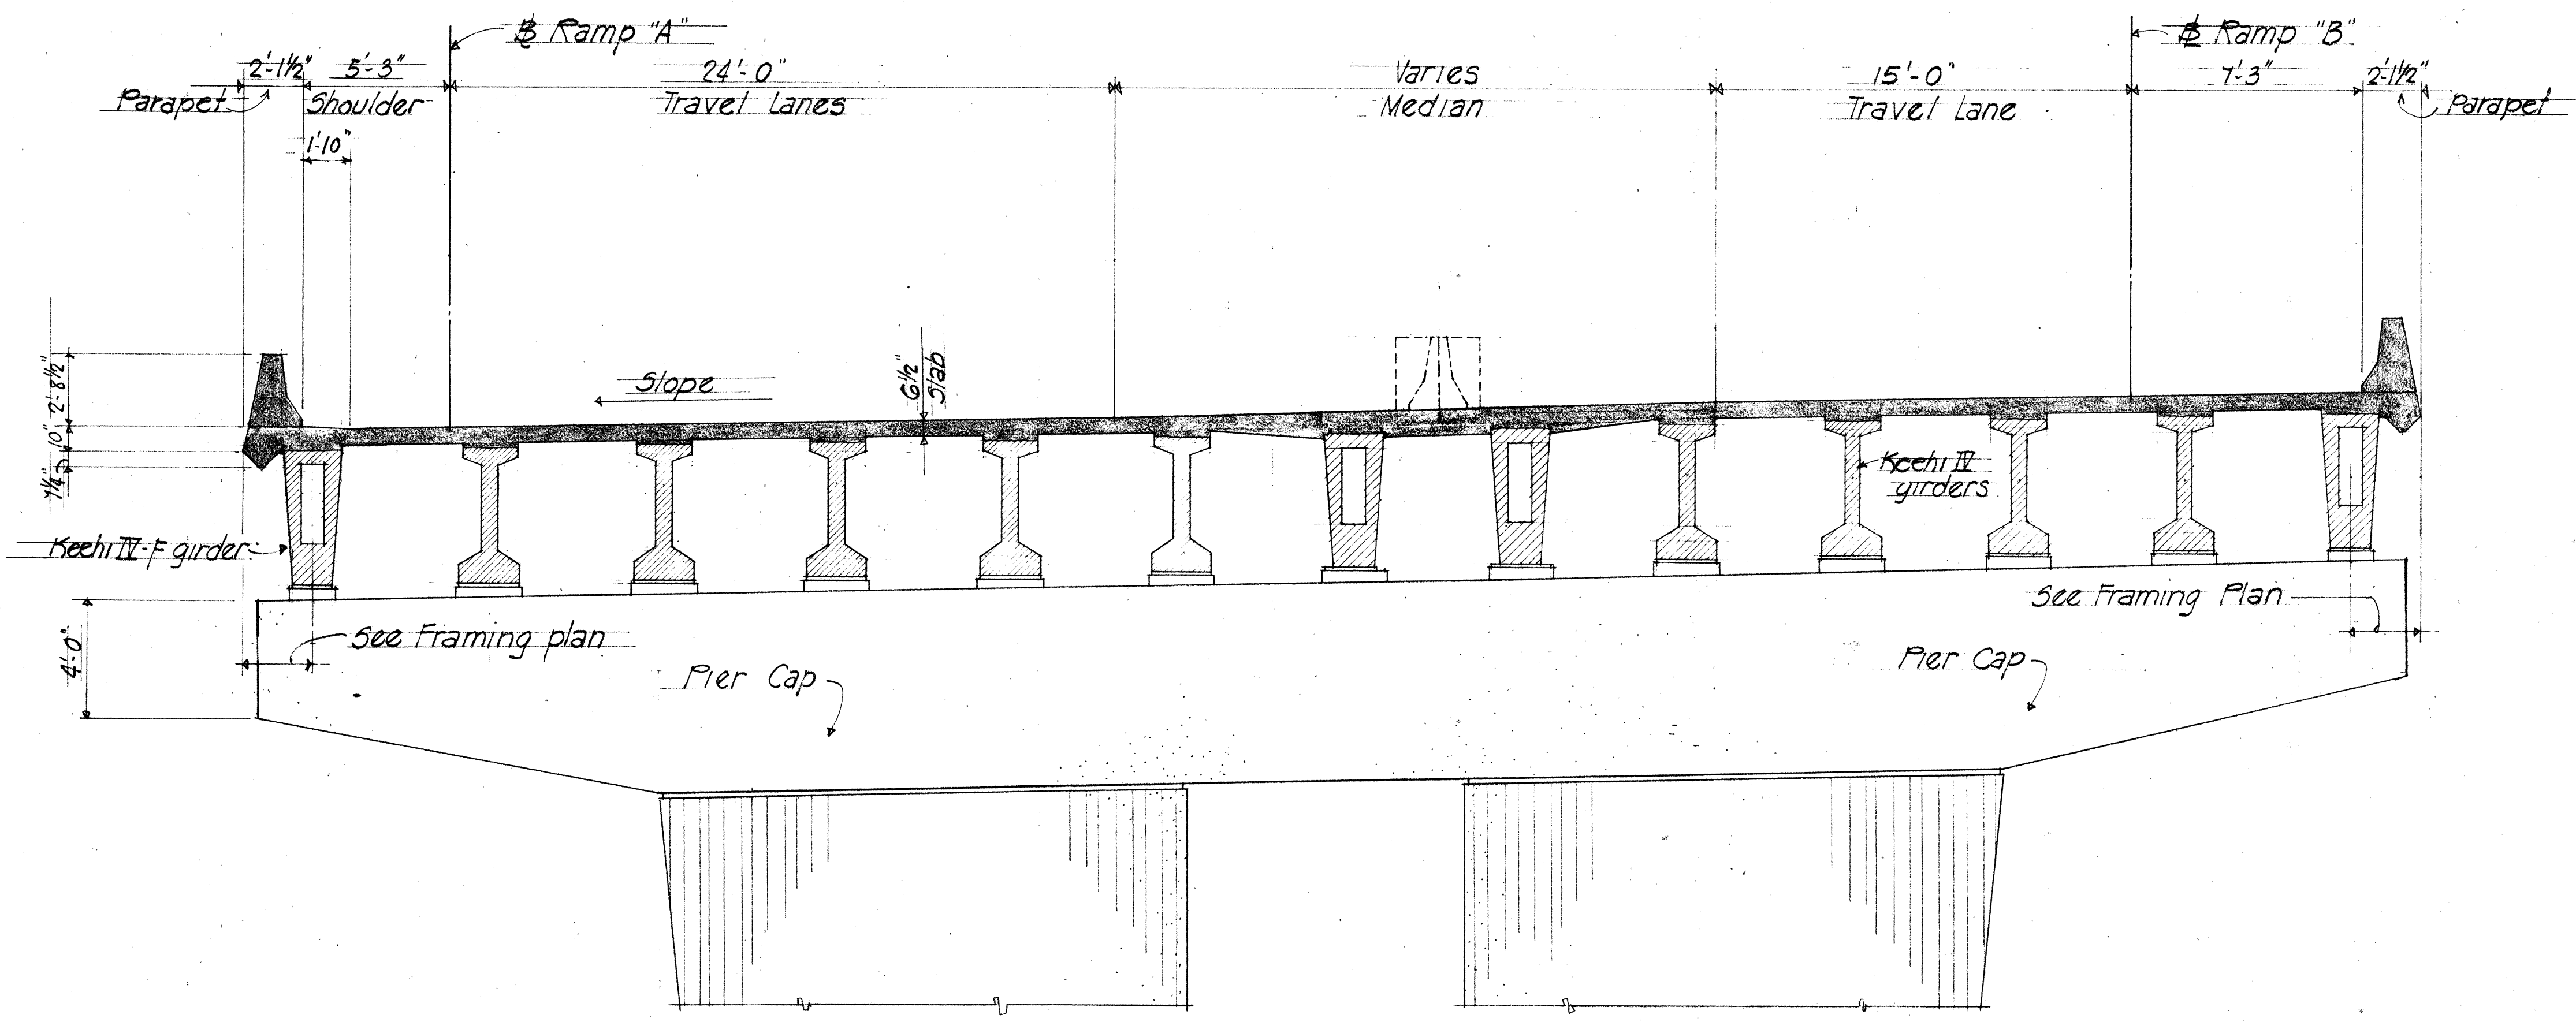


NORMAL SECTION - Sta. 22+77 (Ramp A) @ Exp. JT.  
 Scale: 1/4" = 1'-0"


PARTIAL ELEVATION @ PIERS  
 Scale: 1/4" = 1'-0"

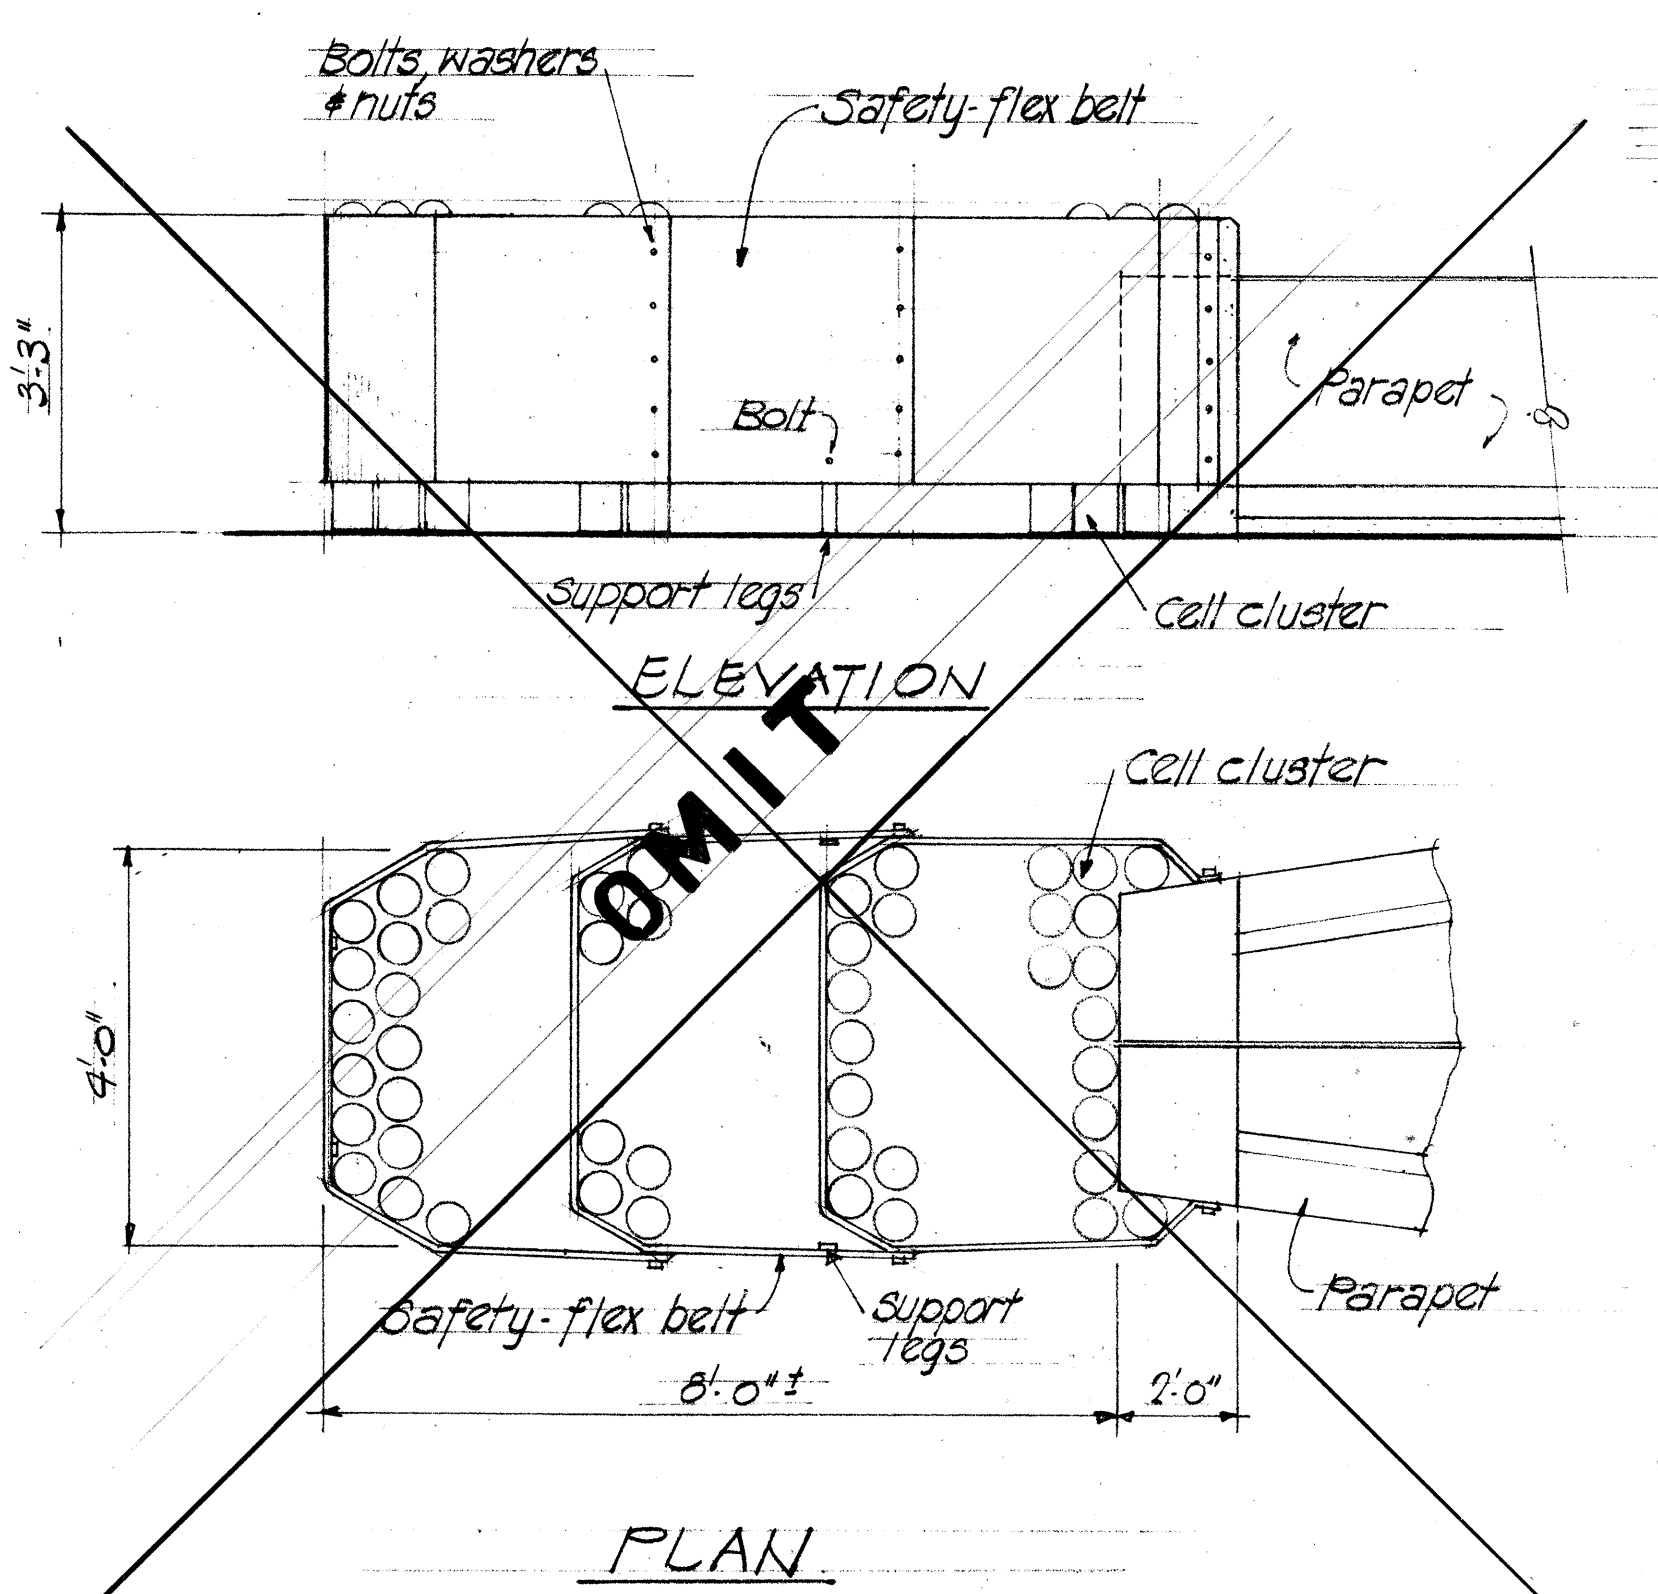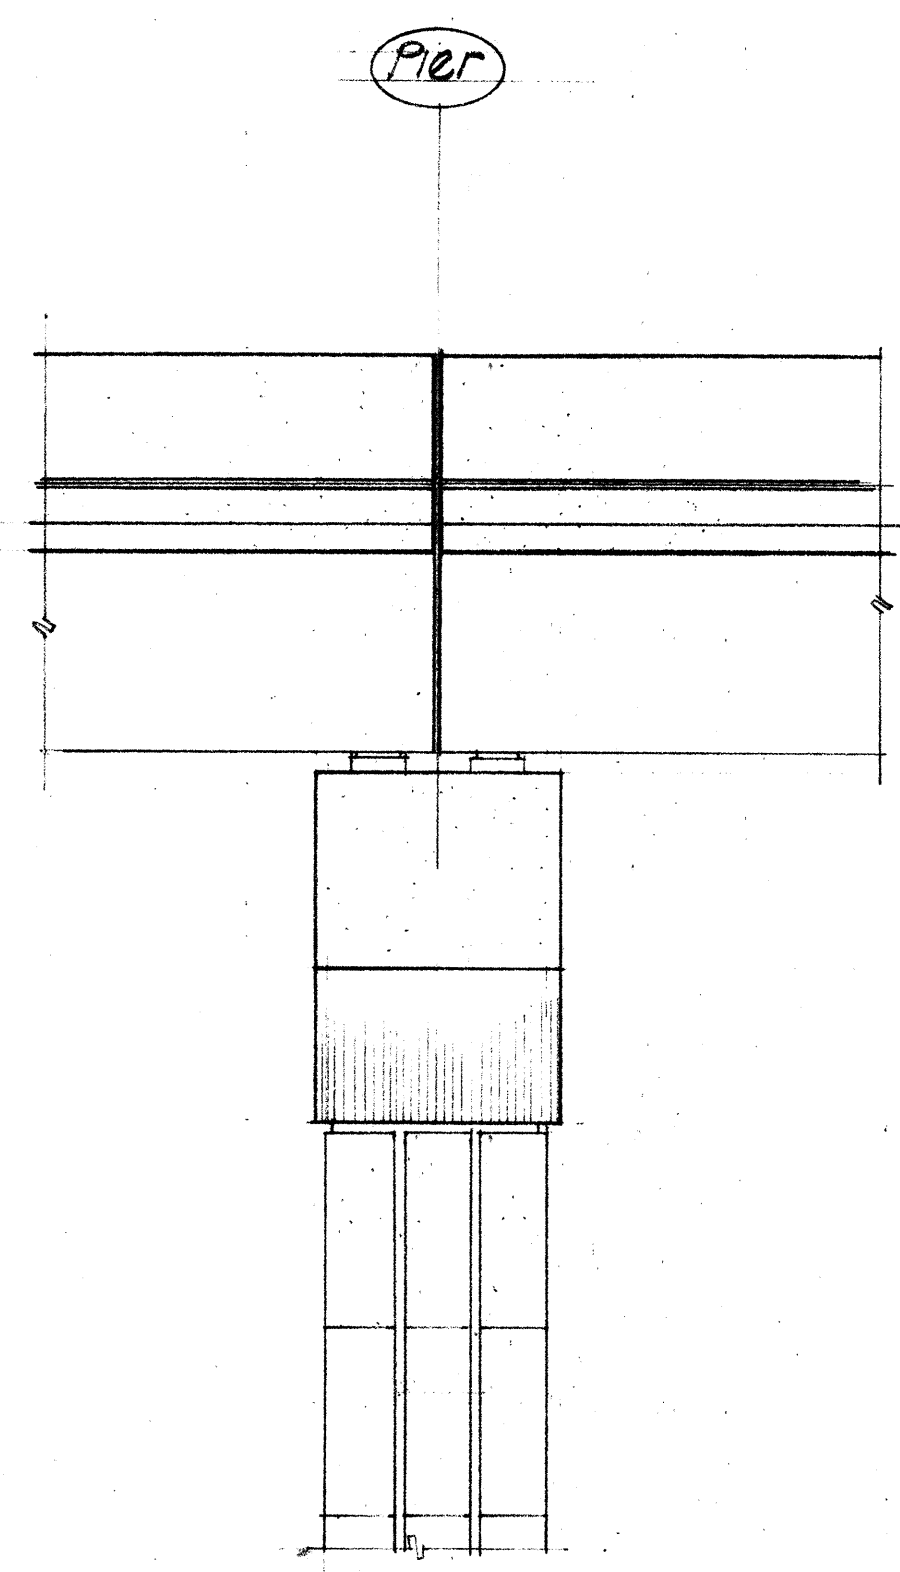

CUSHION BARRIER DETAIL (Cell cluster)  
 Scale: 1/2" = 1'-0"

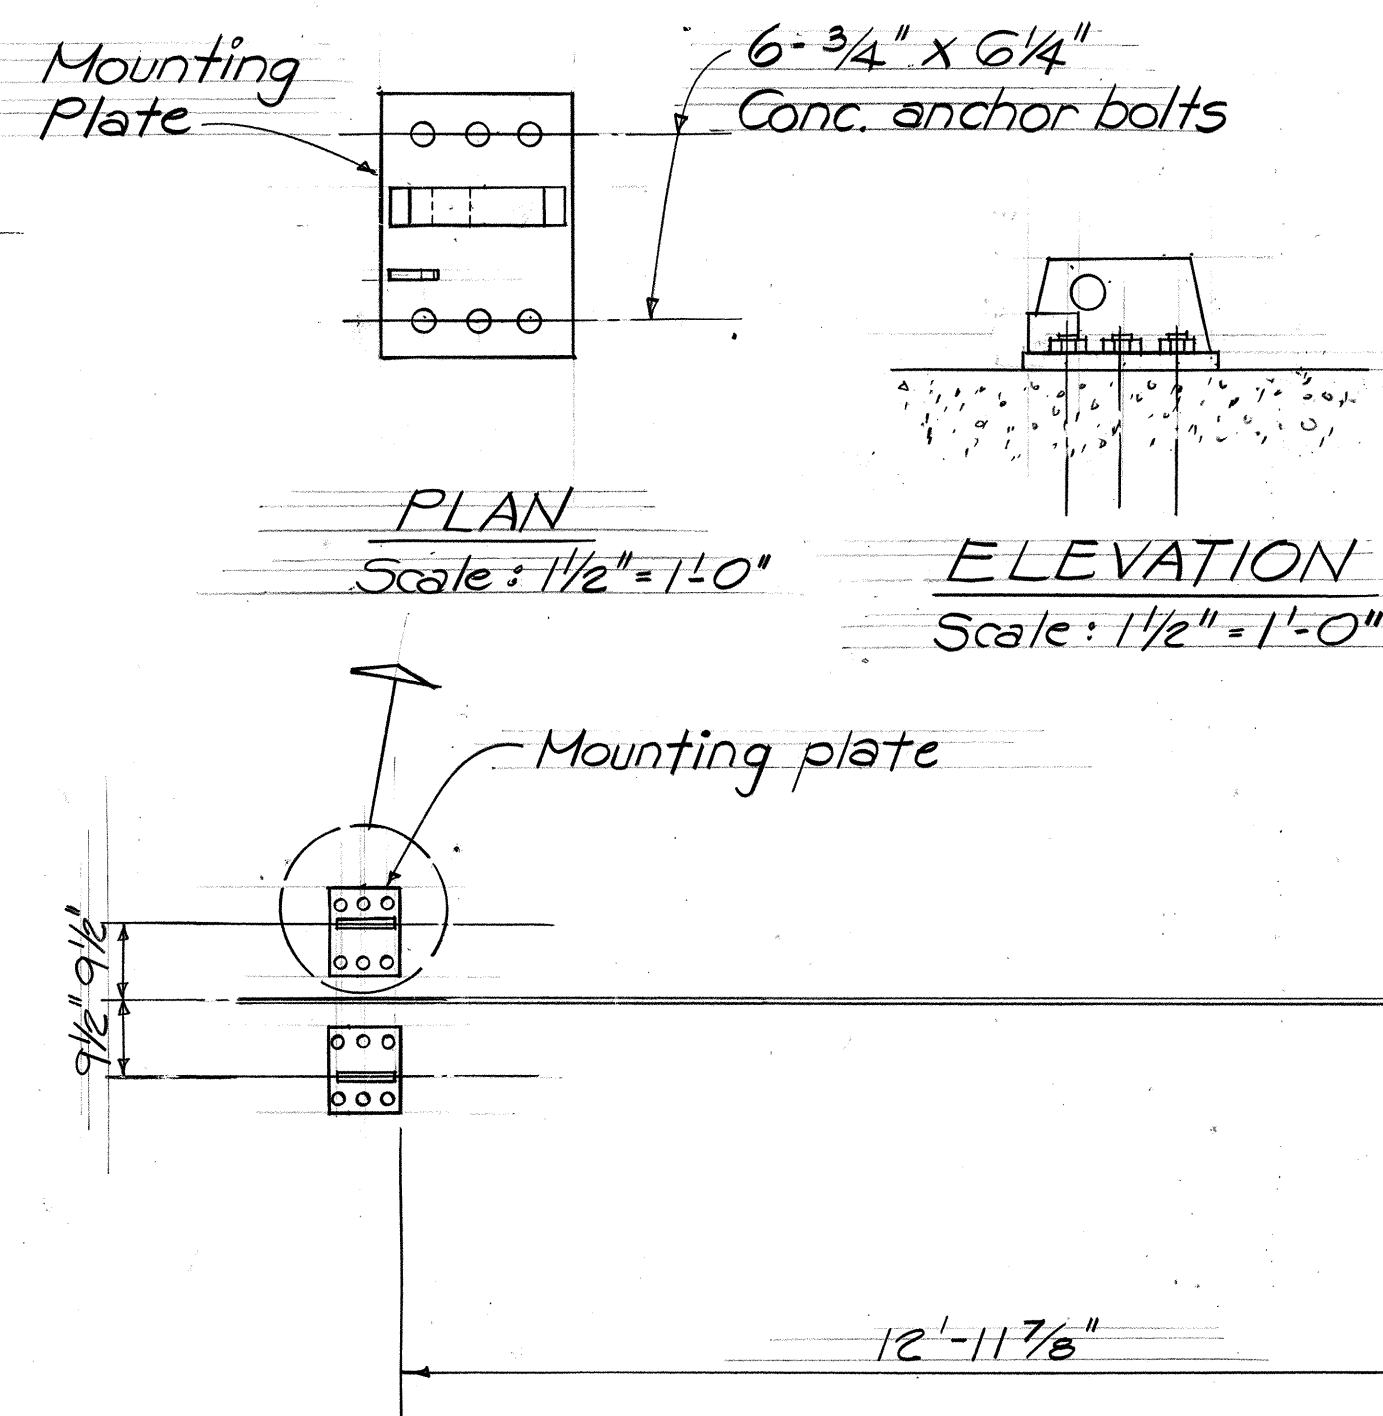



CUSHION BARRIER DETAIL  
 Scale: 1/2" = 1'-0"

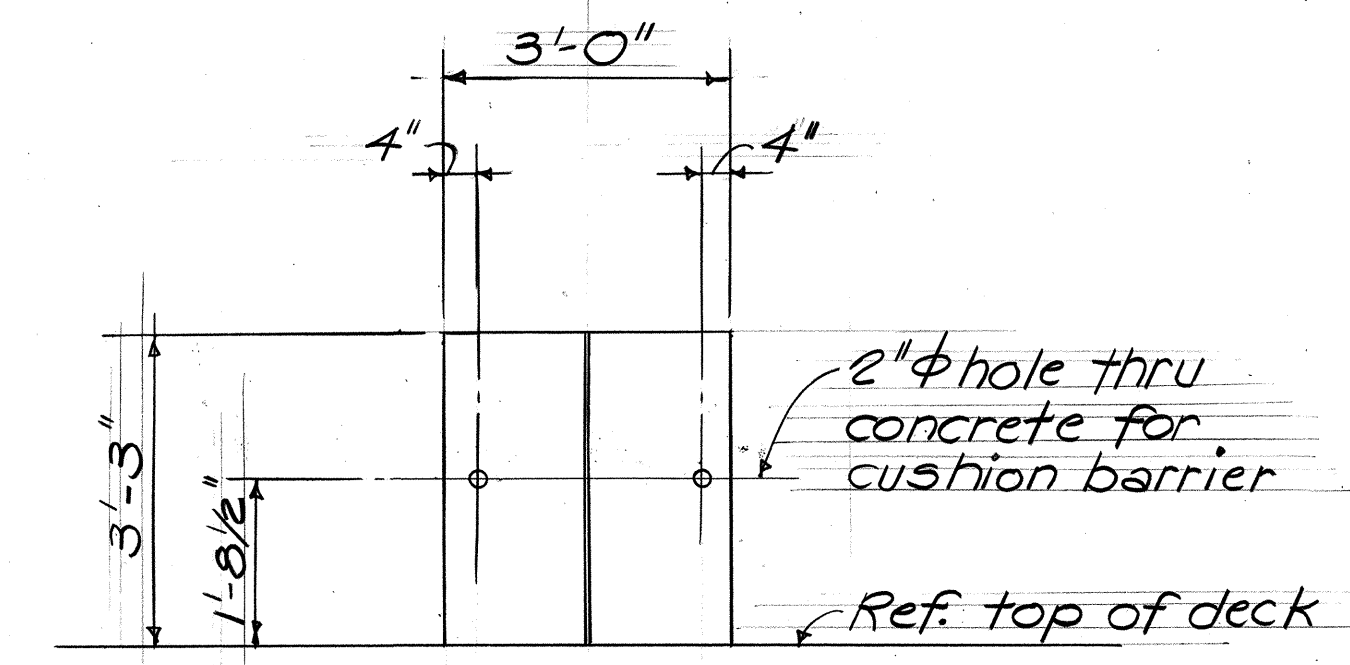

HEAD WALL ELEVATION  
 Scale: 1/2" = 1'-0"

Note: Install Narrow, 5-Bay Sandwich Unit, Model No. 111307555.

|                                                                                       |          |                                      |
|---------------------------------------------------------------------------------------|----------|--------------------------------------|
|  | 12/22/82 | Revise headwall for cushion barrier. |
| No.                                                                                   | Date     | Revision                             |

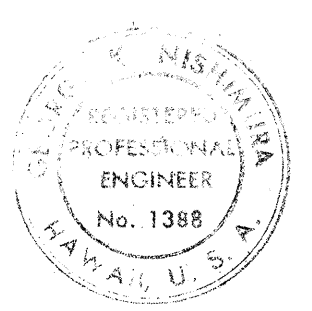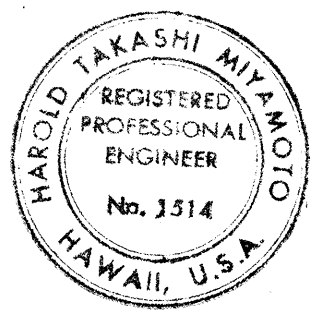


THIS WORK WAS PREPARED BY ME OR UNDER MY SUPERVISION  
 H. Takashi Miyamoto  
 THIS WORK WAS PREPARED BY ME OR UNDER MY SUPERVISION  
 Nimitz

STATE OF HAWAII  
 DEPARTMENT OF TRANSPORTATION  
 HIGHWAYS DIVISION  
**NIMITZ CONNECTOR (E.B.)**  
**RAMP "A" & RAMP "B"**  
**NORMAL SECTION & PARTIAL ELEVATION**  
**KEEHI INTERCHANGE**  
 F.A.I. PROJECT NO. I-HI-1(68)17  
 Scale: 1/4" = 1'-0" Date: JULY 1981  
 SHEET NO. 9 OF 49 SHEETS




| FED. ROAD DIST. NO. | STATE | FED. AID PROJ. NO. | FISCAL YEAR | SHEET NO. | TOTAL SHEETS |
|---------------------|-------|--------------------|-------------|-----------|--------------|
| HAWAII              | HAW.  | 1-H1-1(168)17      | 1982        | 92        | 145          |

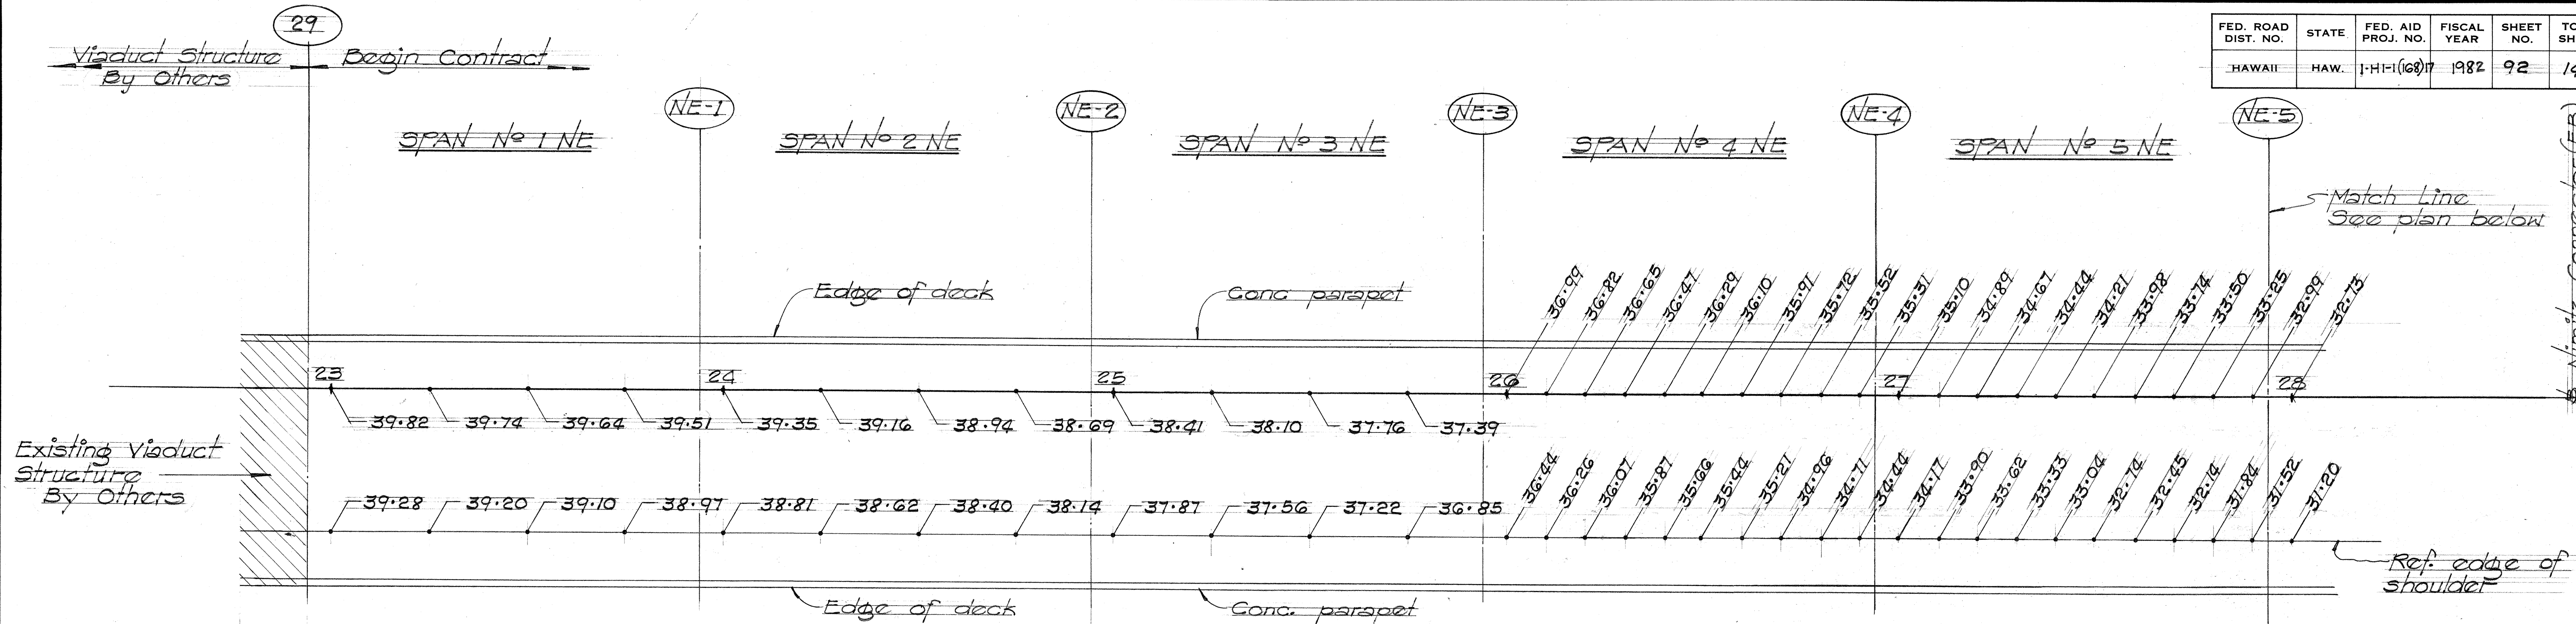


**NOTE:**

Deck elevations are shown at 10'-0" intervals in transition areas and 25'-0" in non-transition areas

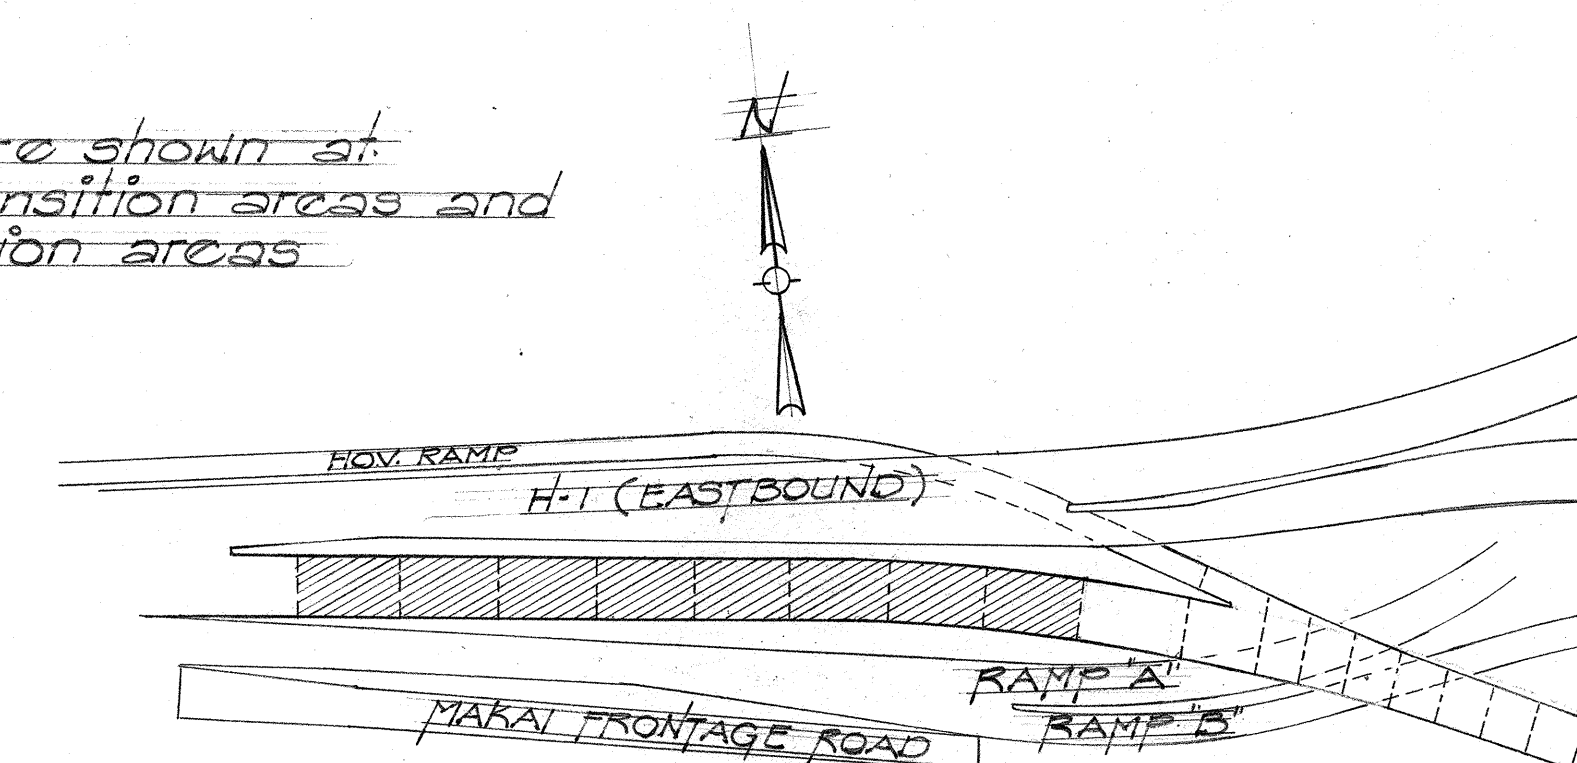


**KEY PLAN**

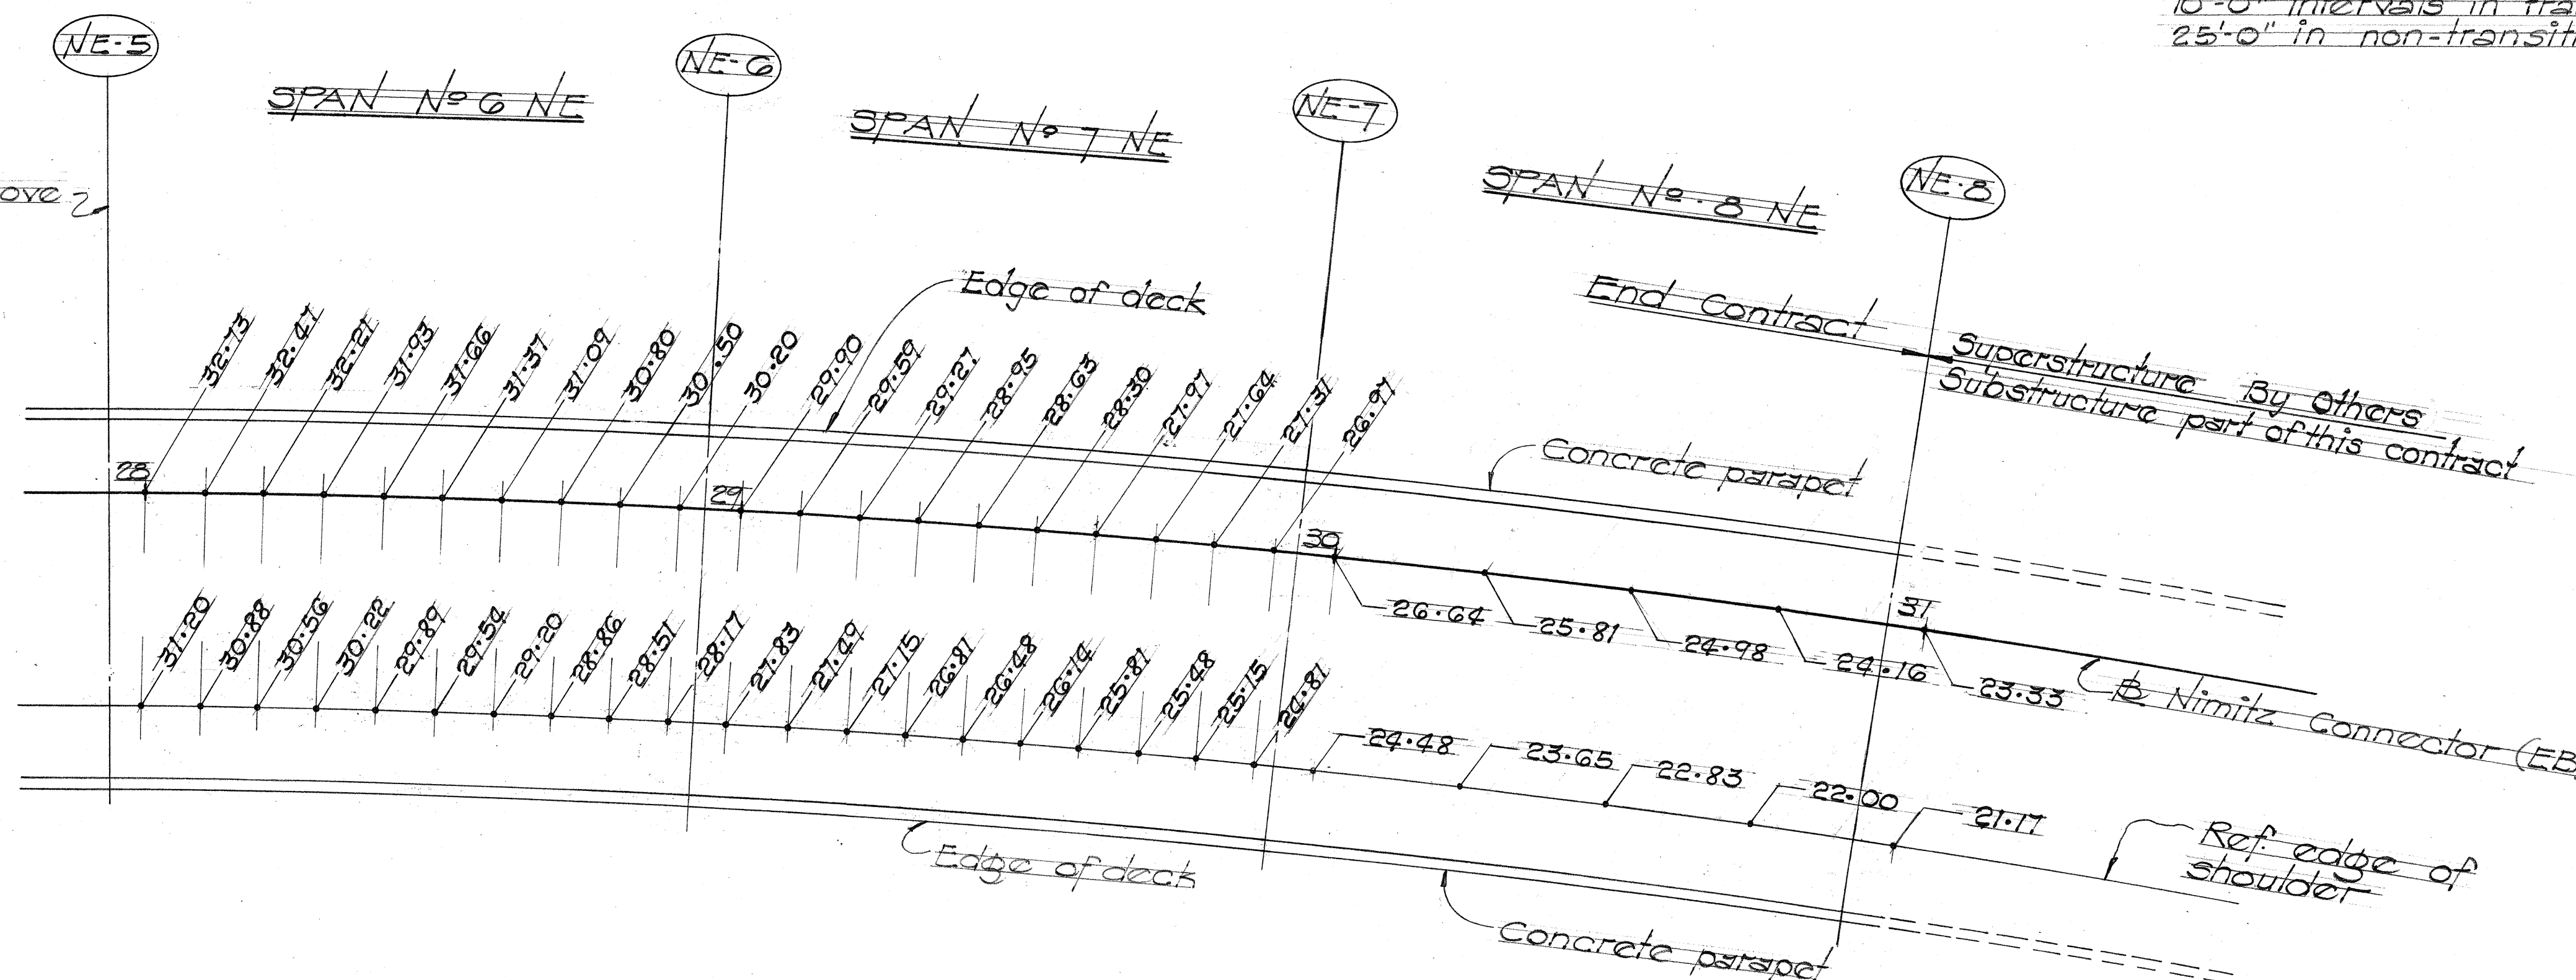

**DECK FINISH GRID GRADE PLAN NIMITZ CONNECTOR (EB)**

Scale: 1" = 20'-0"

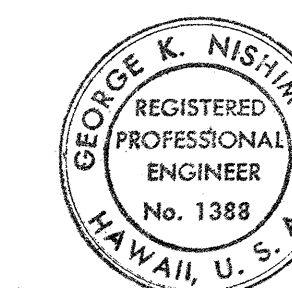

THIS WORK WAS PREPARED BY ME OR UNDER MY SUPERVISION

*George K. Nishimura*



THIS WORK WAS PREPARED BY ME OR UNDER MY SUPERVISION

*Takashi Miyamoto*

STATE OF HAWAII  
DEPARTMENT OF TRANSPORTATION  
HIGHWAYS DIVISION

**NIMITZ CONNECTOR (EB)**  
**RAMP "A" AND RAMP "B"**

DECK FINISH GRID GRADE PLAN



KEEHI INTERCHANGE  
EAL PROJ. NO. 1-H1-1(168)17

SCALE: 1" = 20'-0" DATE: JULY, 1981


SHEET NO. 5 OF 49 SHEETS




| FED. ROAD DIST. NO. | STATE | FED. AID PROJ. NO. | FISCAL YEAR | SHEET NO. | TOTAL SHEETS |
|---------------------|-------|--------------------|-------------|-----------|--------------|
| HAWAII              | HAW.  | HI-1 (169)17       | 1982        | 93        | 145          |

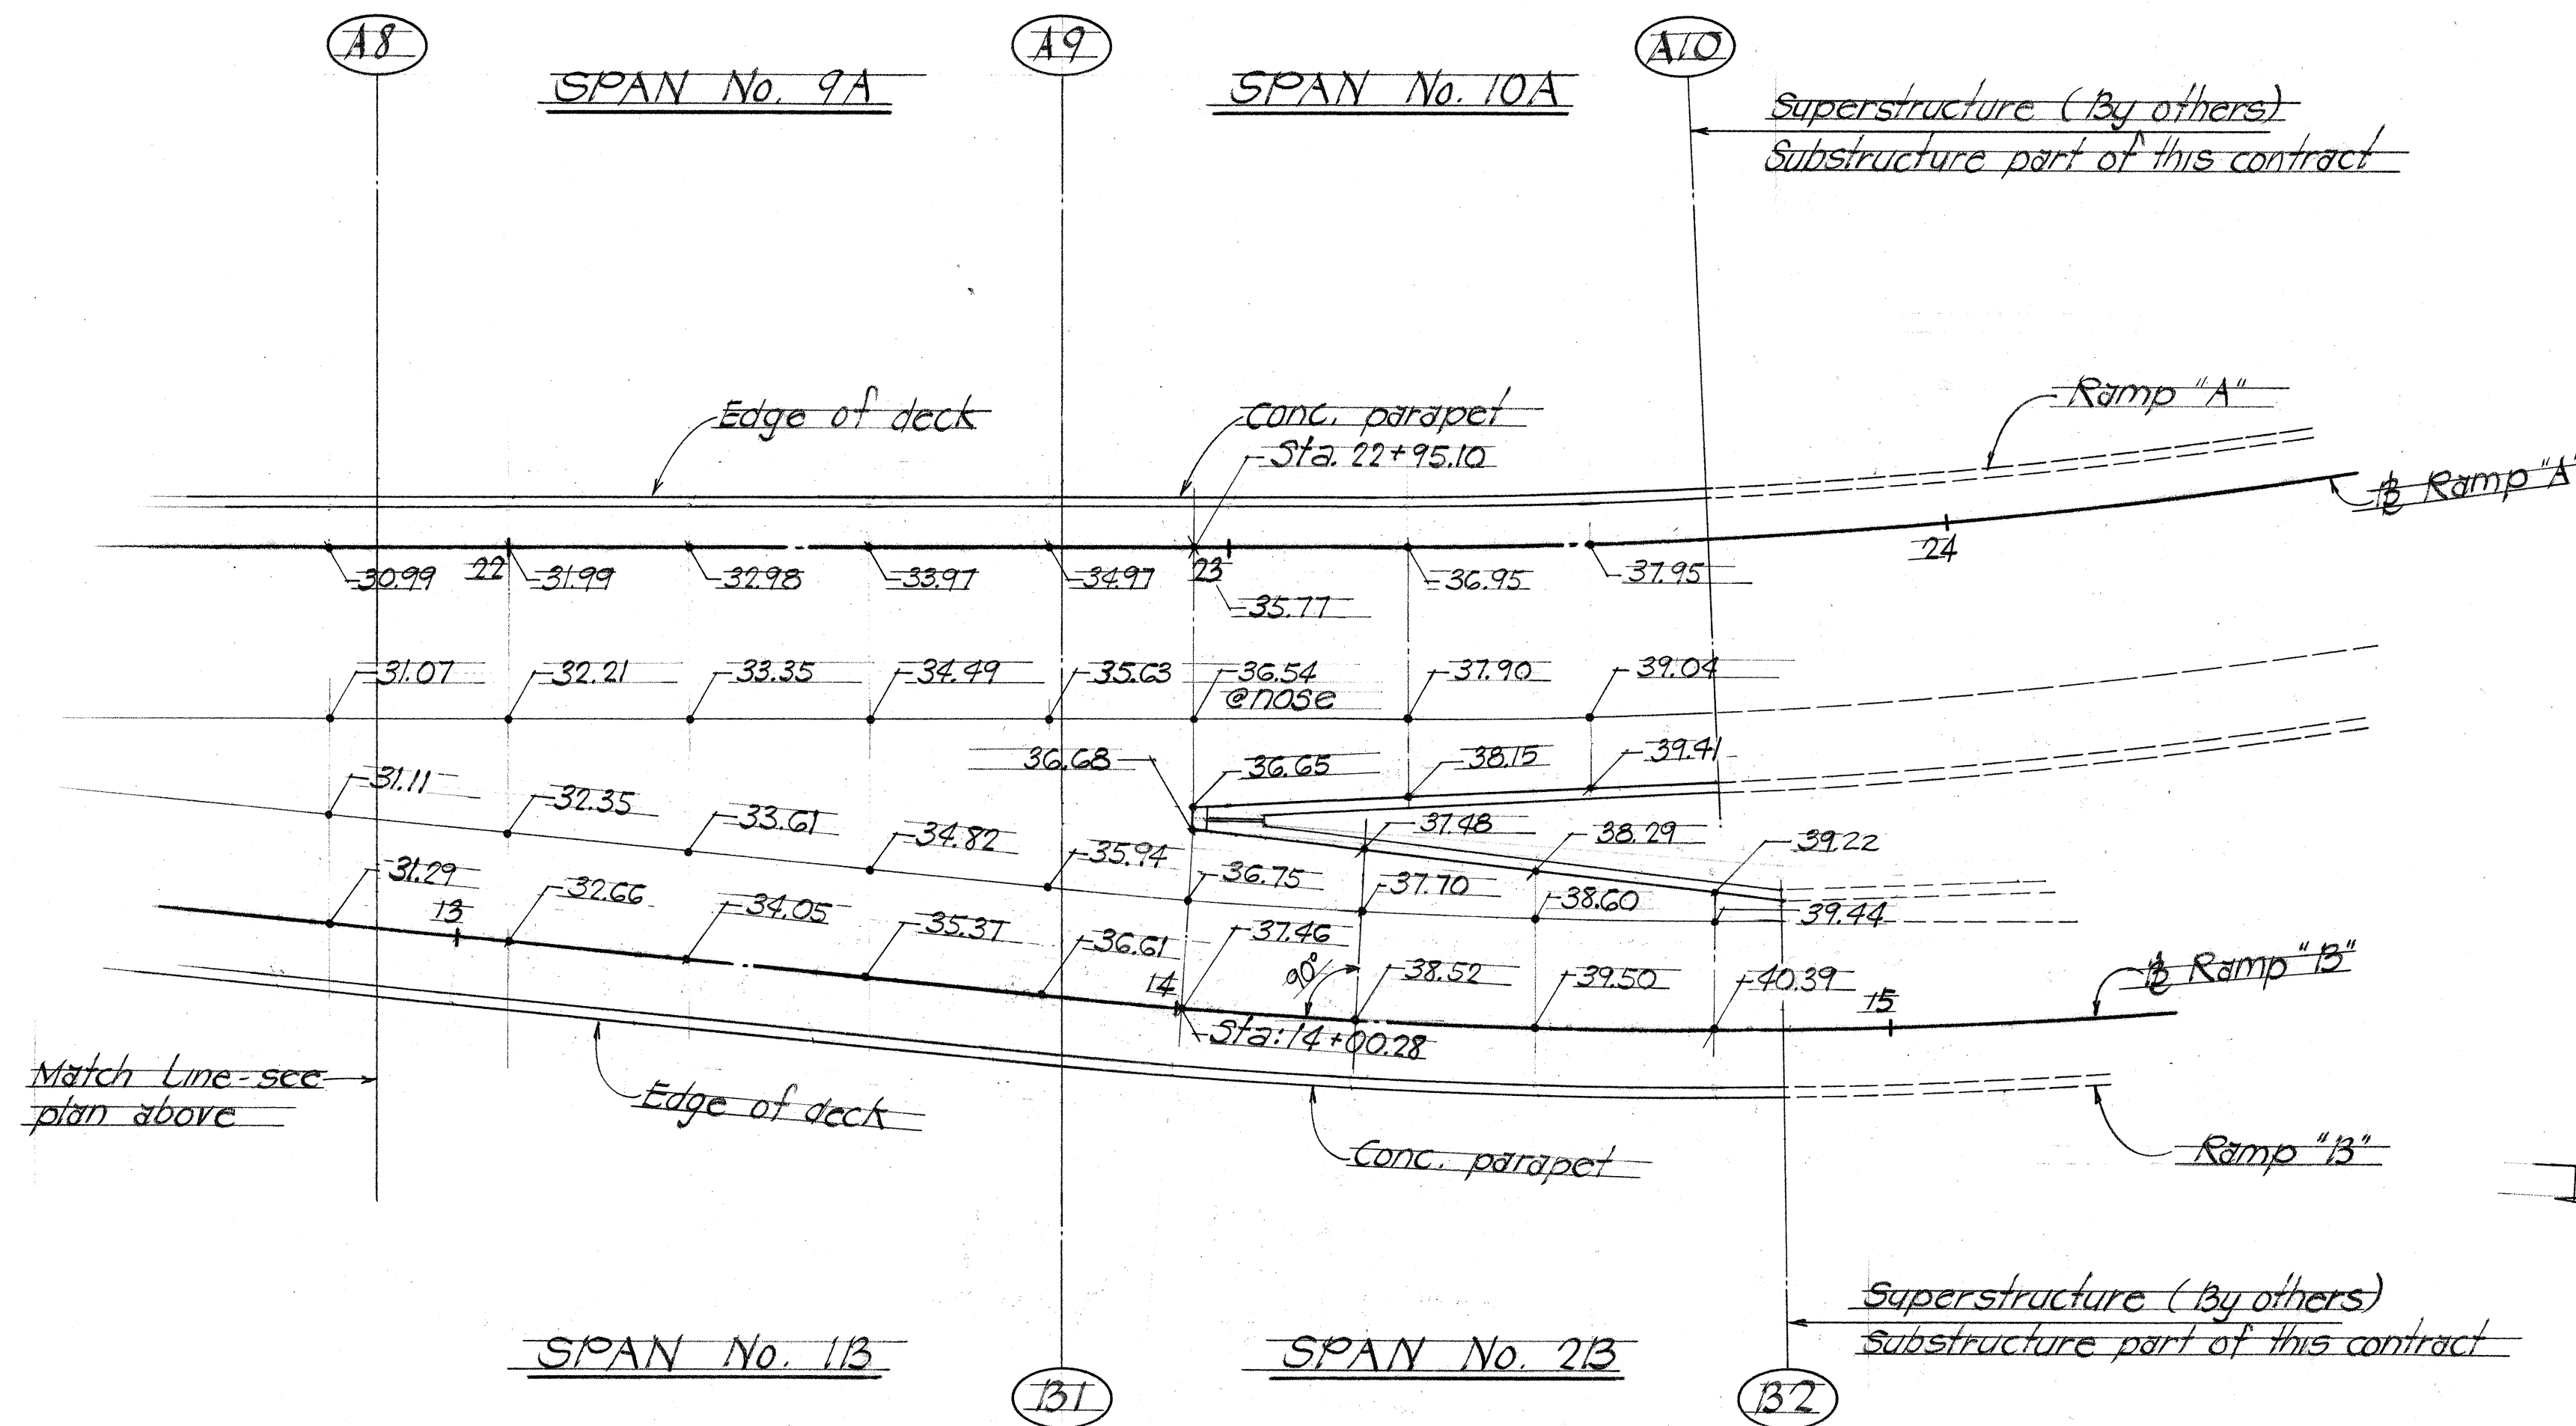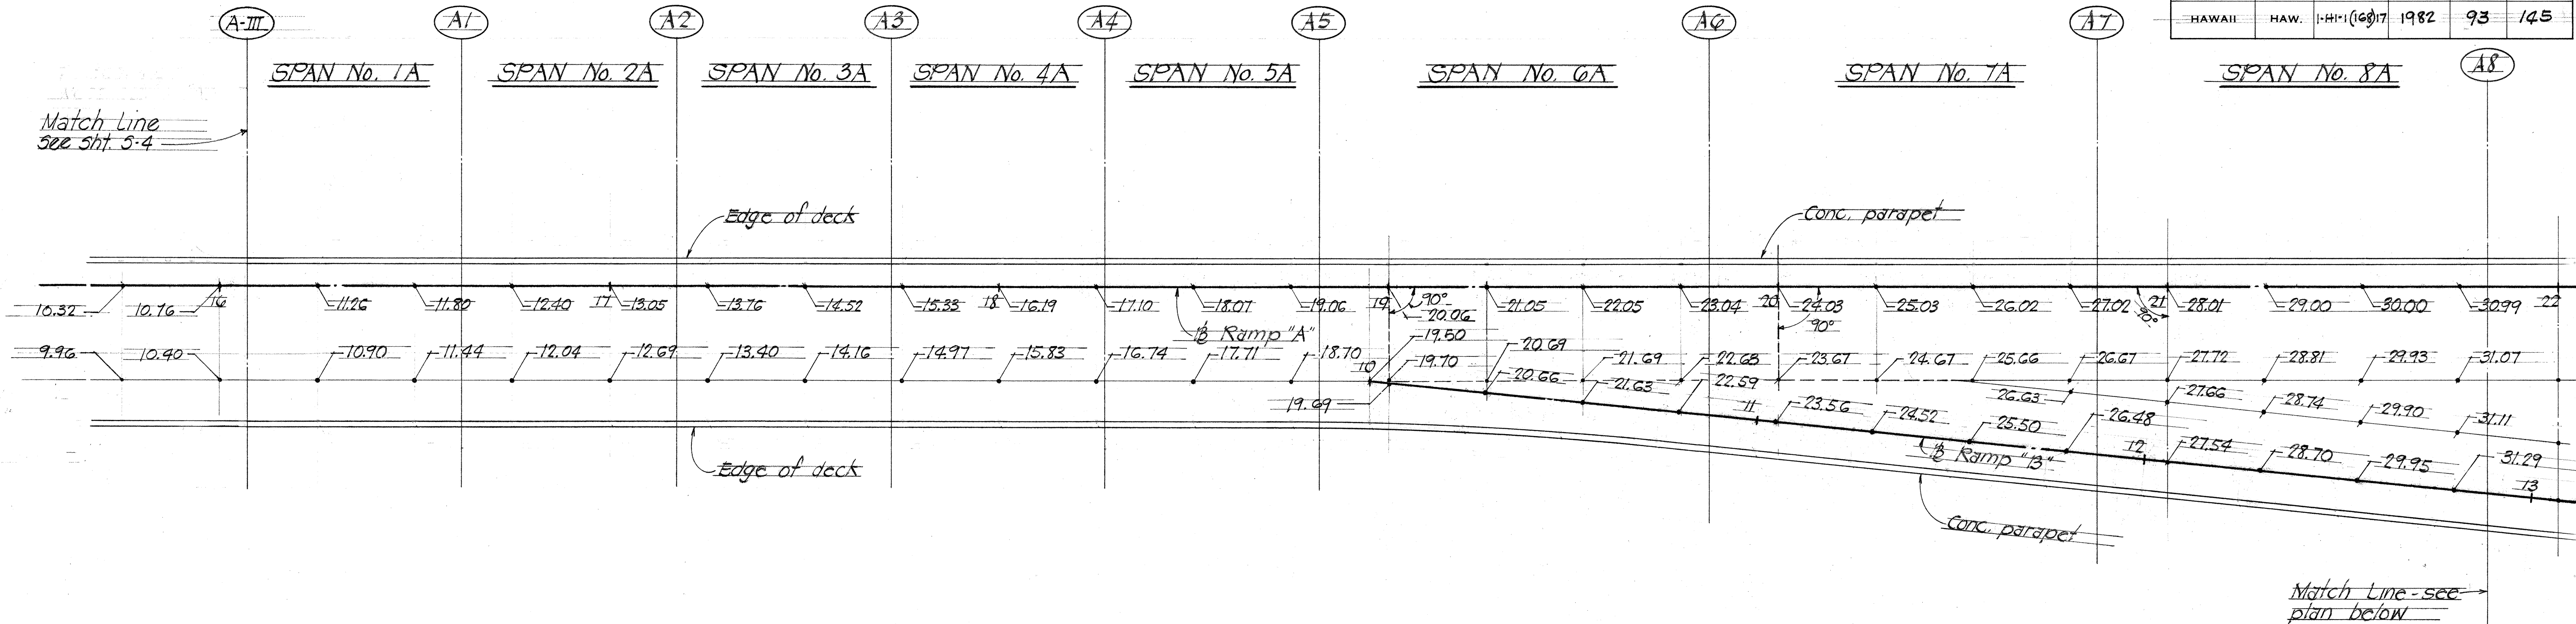

**NOTE:** Finish deck grades are given at 25'-0" increments.

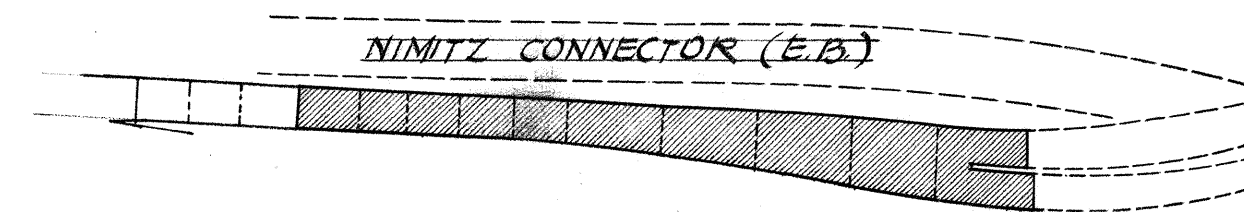

**KEY PLAN**

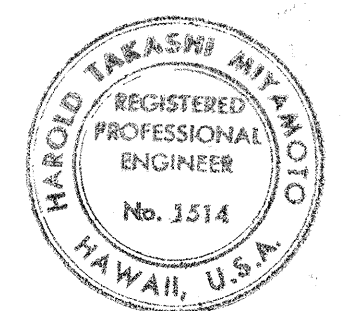

THIS WORK WAS PREPARED BY  
ME OR UNDER MY SUPERVISION

*Harold Takasago*

THIS WORK WAS PREPARED BY  
ME OR UNDER MY SUPERVISION


*George K. Nishimura*

STATE OF HAWAII  
DEPARTMENT OF TRANSPORTATION  
HIGHWAYS DIVISION  
**NIMITZ CONNECTOR (E.B.)**  
**RAMP "A" & RAMP "B"**  
PARTIAL FINISH GRID  
GRADE PLAN  
**KEEHI INTERCHANGE**  
F.A.I. PROJECT No. 1 HI-1  
Scale: 1" = 20'-0" Date: July, 1981  
SHEET No. 9-11 OF 49 SHEETS

**PARTIAL DECK FINISH GRID GRADE PLAN**  
Scale: 1" = 20'-0"



|                  |                         |            |
|------------------|-------------------------|------------|
| ORIGINAL<br>PLAN | SURVEY PLOTTED BY _____ | DATE _____ |
| NOTE BOOK        | DRAWN BY _____          | " "        |
|                  | TRACED BY _____         | " "        |
|                  | DESIGNED BY _____       | " "        |
|                  | QUANTITIES BY _____     | " "        |
| NO. _____        | CHECKED BY _____        | " "        |

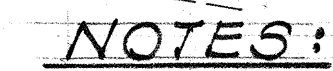



- 



SHEET NO. 5-12 OF 49 SHEETS



| FED. ROAD DIST. NO. | STATE | FED. AID PROJ. NO. | FISCAL YEAR | SHEET NO. | TOTAL SHEETS |
|---------------------|-------|--------------------|-------------|-----------|--------------|
| HAWAII              | HAW.  | 1-HI-1(168)17      | 1982        | 95        | 145          |

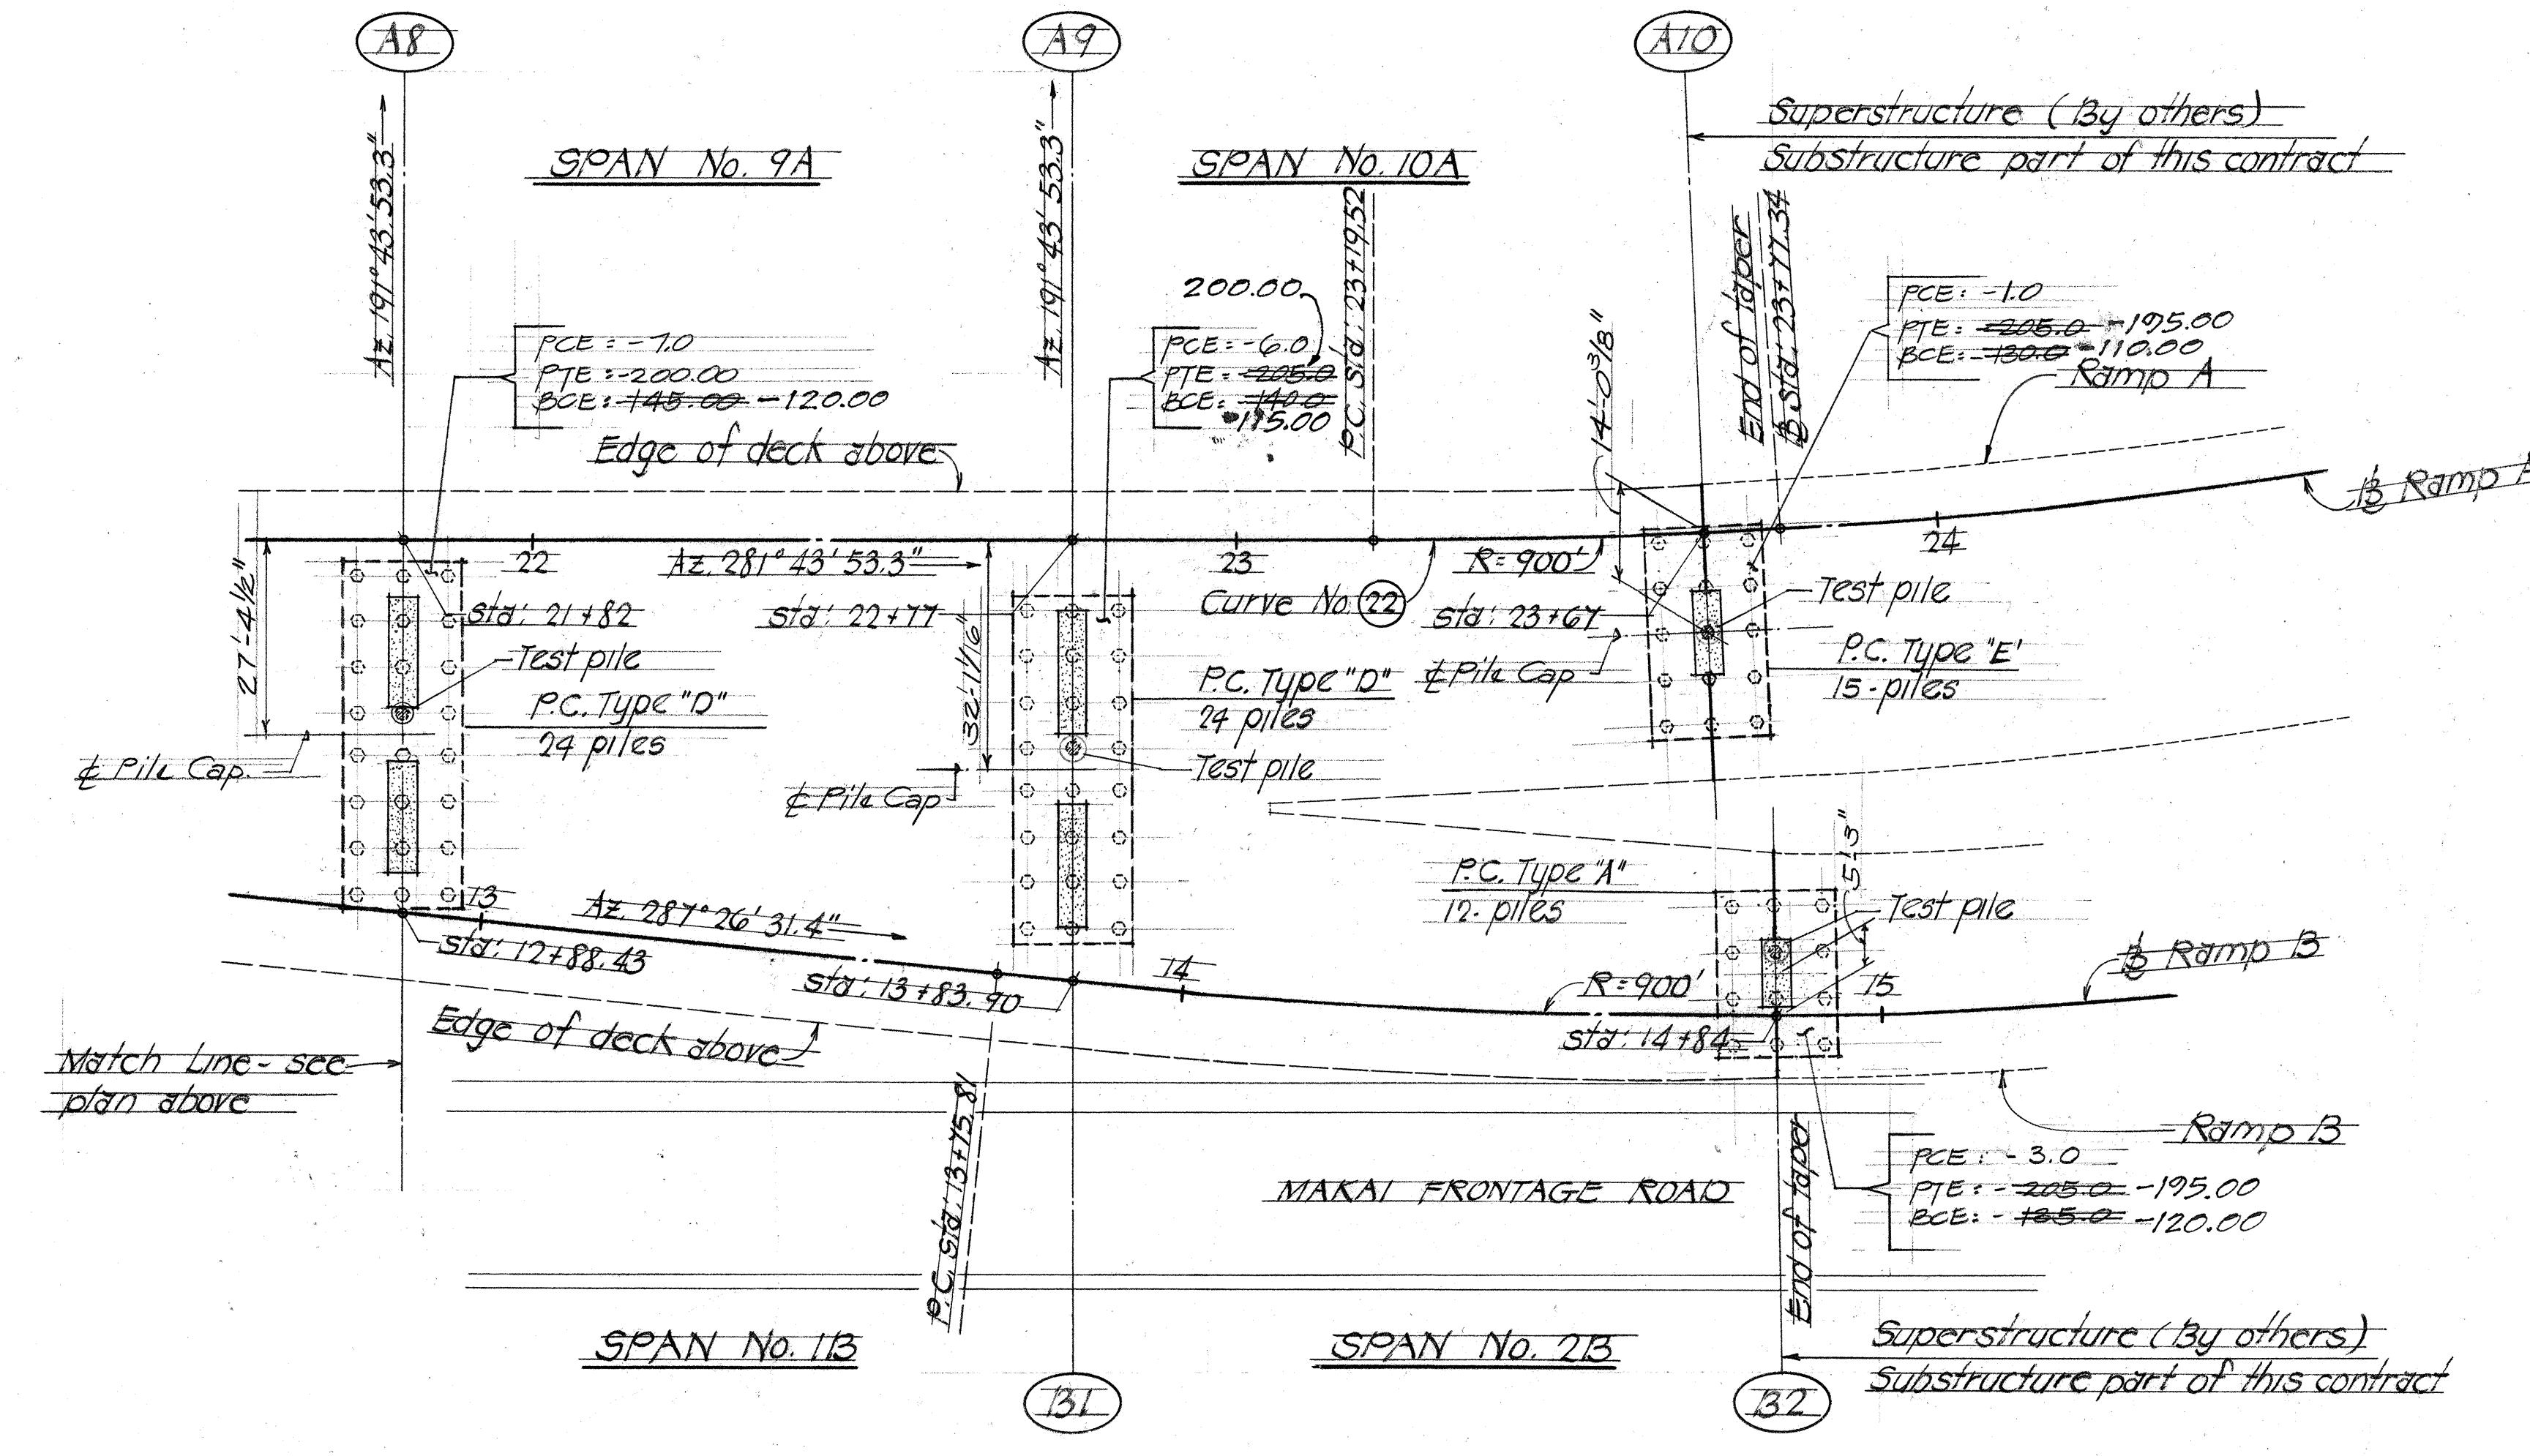
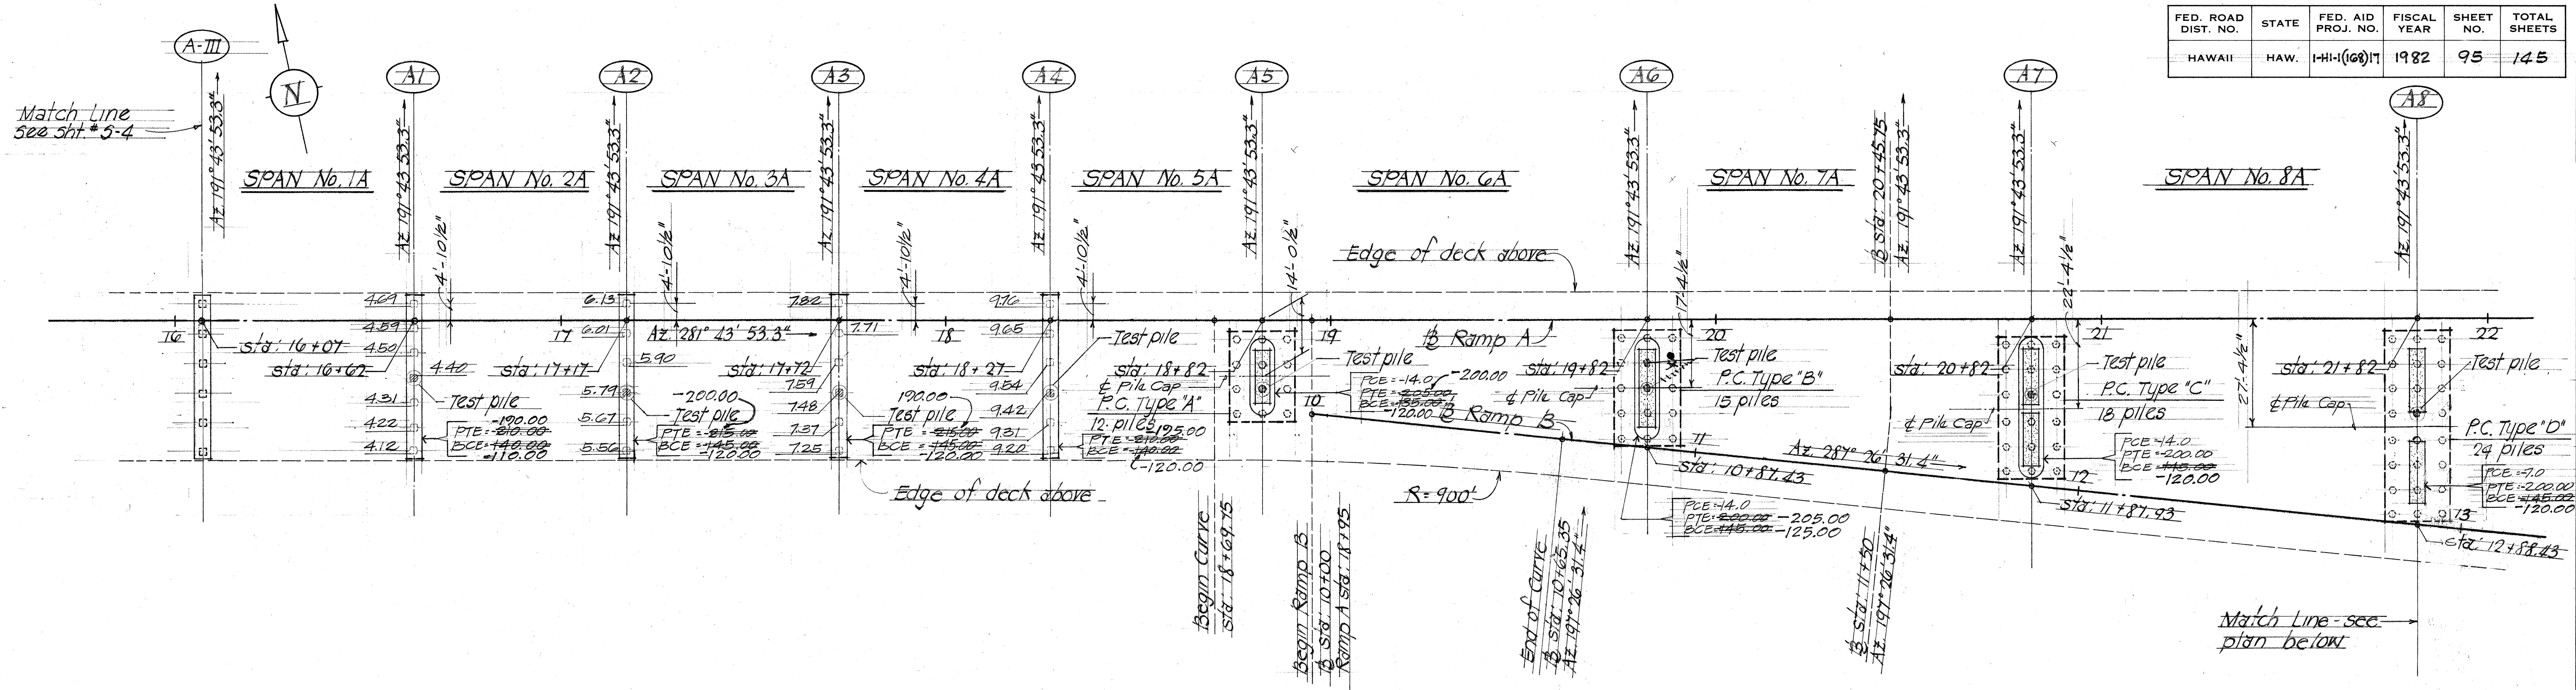


### LEGEND


- Precast Prestressed Concrete Piles, 16 1/2" octagonal, Type "A". Design capacity 115 tons.
  - Precast Prestressed Concrete Piles, 20" square, Type "B". Design capacity 85 tons.
  - PCE = Pile Cut-off Elevations.
  - PTE = Estimated Pile Tip Elevation.
  - BCE = Elevation of Lower Limits of Bitumen Coating.
  - 0.00 = Pile Cut-off Elevations at Piers A1 thru A4.
- See standard sheets for details

### NOTE:

For Table of Pile Load Test and Applicable Footing See sht. no. SD-11.

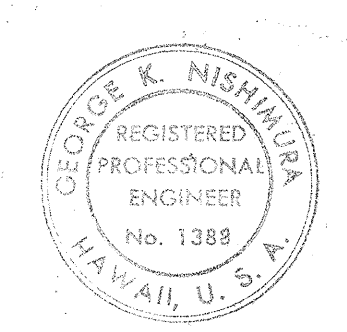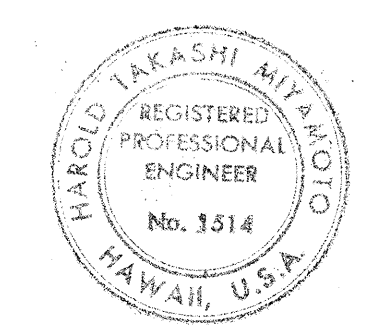

THIS WORK WAS PREPARED BY ME OR UNDER MY SUPERVISION  
*Harold Miyajima*  
 THIS WORK WAS PREPARED BY ME OR UNDER MY SUPERVISION  
*George Nishimura*

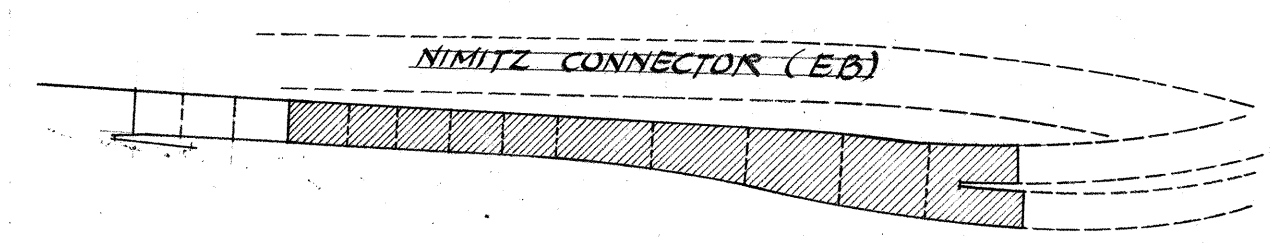

### KEY PLAN


### PARTIAL FOUNDATION PLAN - RAMP "A" & RAMP "B"

Scale 1" = 20'-0"

STATE OF HAWAII  
 DEPARTMENT OF TRANSPORTATION  
 HIGHWAYS DIVISION  
**NIMITZ CONNECTOR (E.B.)**  
**RAMP "A" & RAMP "B"**  
**PARTIAL FOUNDATION PLAN**  
**KEEHI INTERCHANGE**  
 F.A.T. PROJECT NO. I-HI-1 (168)17  
 Scale 1" = 20'-0" Date: JULY, 1981  
 SHEET NO. S-13 OF 49 SHEETS




| FED. ROAD DIST. NO. | STATE | FED. AID PROJ. NO. | FISCAL YEAR | SHEET NO. | TOTAL SHEETS |
|---------------------|-------|--------------------|-------------|-----------|--------------|
| HAWAII              | HAW.  | 1-HI-1(168)17      | 1982        | 96        | 145          |

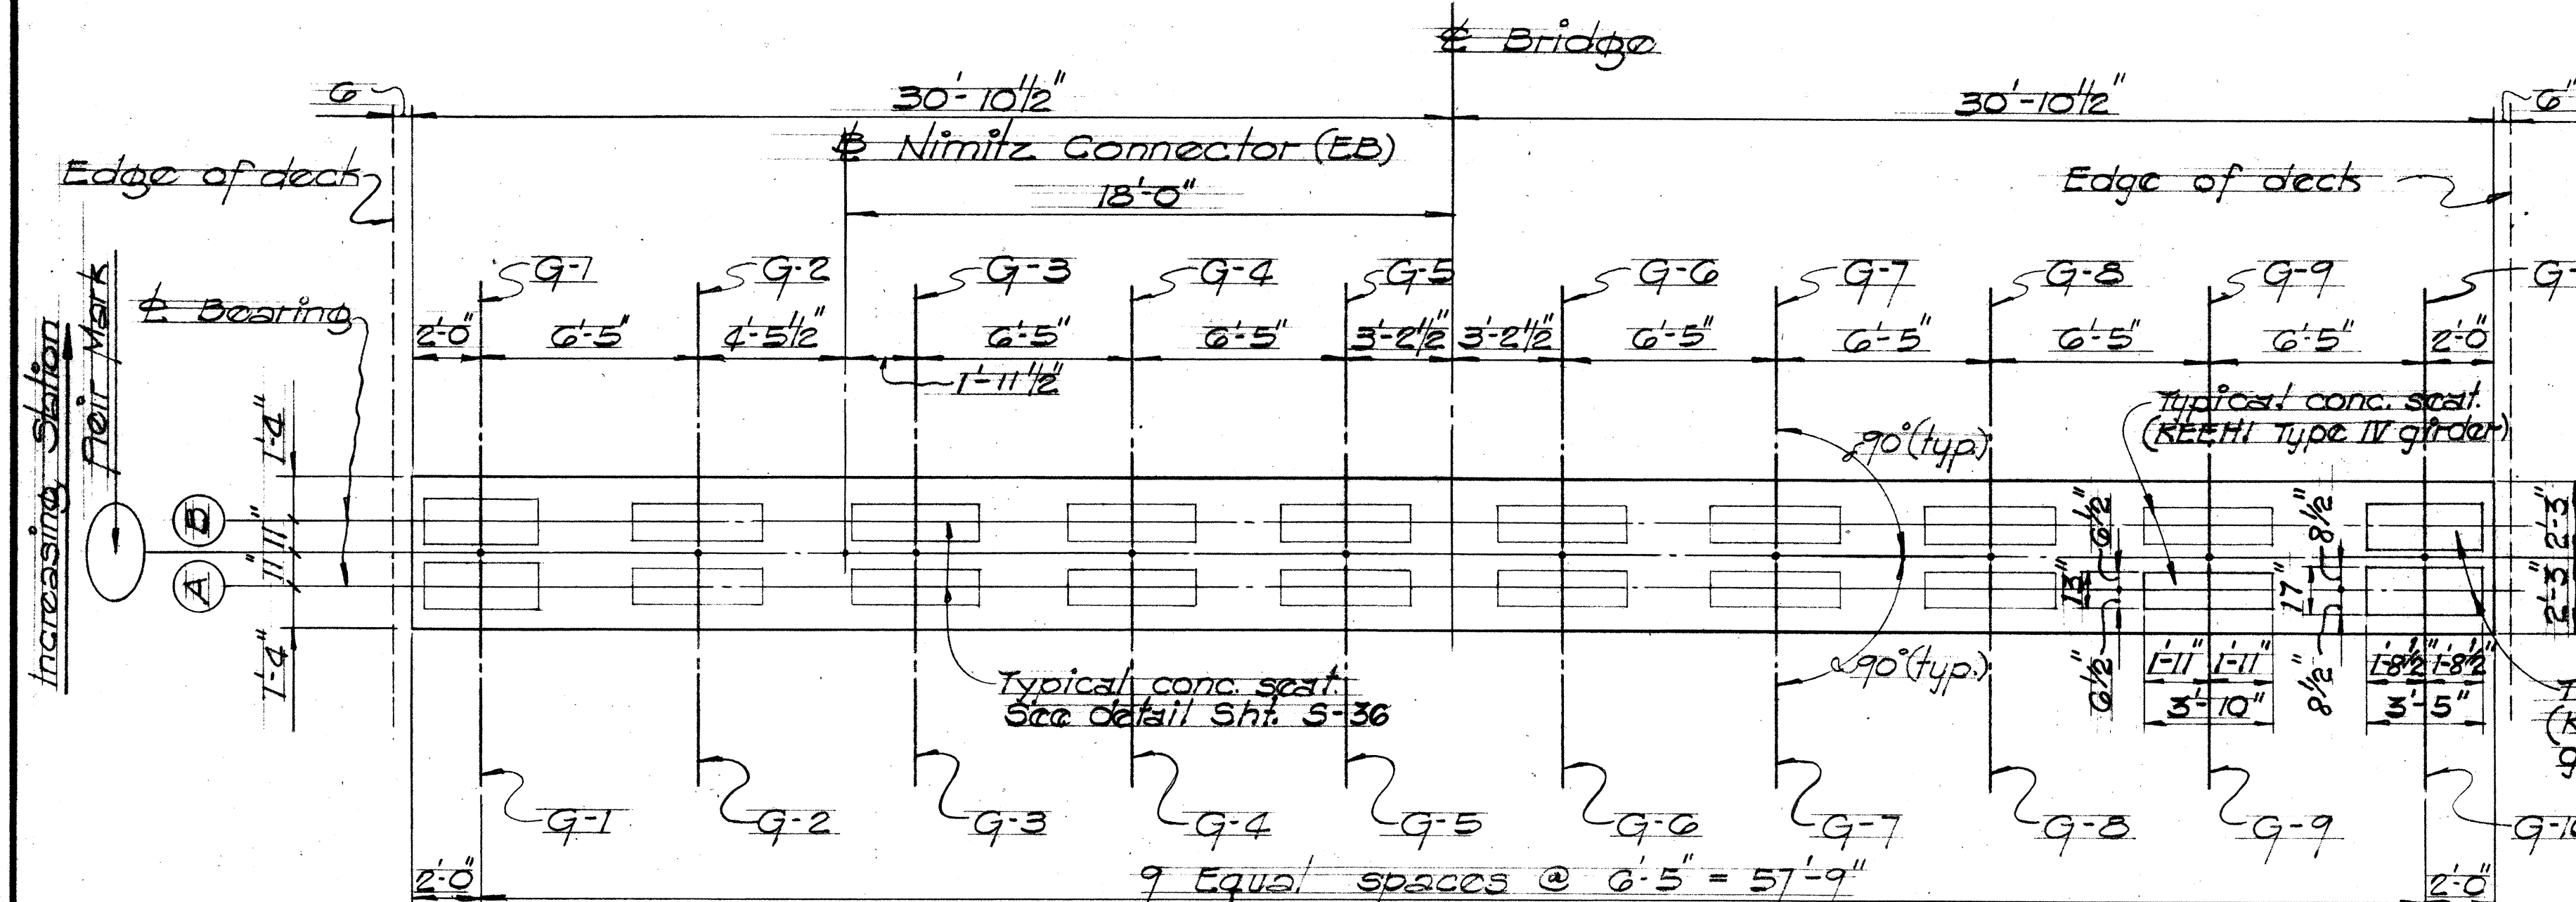


**PLAN ~ PIERS** (NE-1 & NE-2)  
Scale: 1/4" = 1'-0"


| PIER MARK | BRNG LINE | TOP OF SEAT ELEVATIONS |       |       |       |       |       |       |       |       |       | PIER CAP ELEVATION |       | TOP OF COL. ELEV. |       |       |       |
|-----------|-----------|------------------------|-------|-------|-------|-------|-------|-------|-------|-------|-------|--------------------|-------|-------------------|-------|-------|-------|
|           |           | G-1                    | G-2   | G-3   | G-4   | G-5   | G-6   | G-7   | G-8   | G-9   | G-10  | LEFT               | RIGHT | (A)               | (B)   | (C)   | (D)   |
| (NE-1)    | (B)       | 33.65                  | 33.57 | 33.47 | 33.38 | 33.28 | 33.18 | 33.09 | 32.99 | 32.89 | 32.79 | 33.31              | 32.38 | 24.01             | 23.86 | 23.83 | 23.68 |
|           | (A)       | 33.64                  | 33.56 | 33.46 | 33.36 | 33.27 | 33.17 | 33.08 | 32.98 | 32.88 | 32.77 |                    |       |                   |       |       |       |
| (NE-2)    | (B)       | 32.73                  | 32.64 | 32.55 | 32.45 | 32.35 | 32.26 | 32.16 | 32.06 | 31.97 | 31.86 | 32.39              | 31.46 | 23.09             | 22.94 | 22.91 | 22.76 |
|           | (A)       | 32.75                  | 32.67 | 32.57 | 32.48 | 32.38 | 32.28 | 32.19 | 32.09 | 32.00 | 31.89 |                    |       |                   |       |       |       |

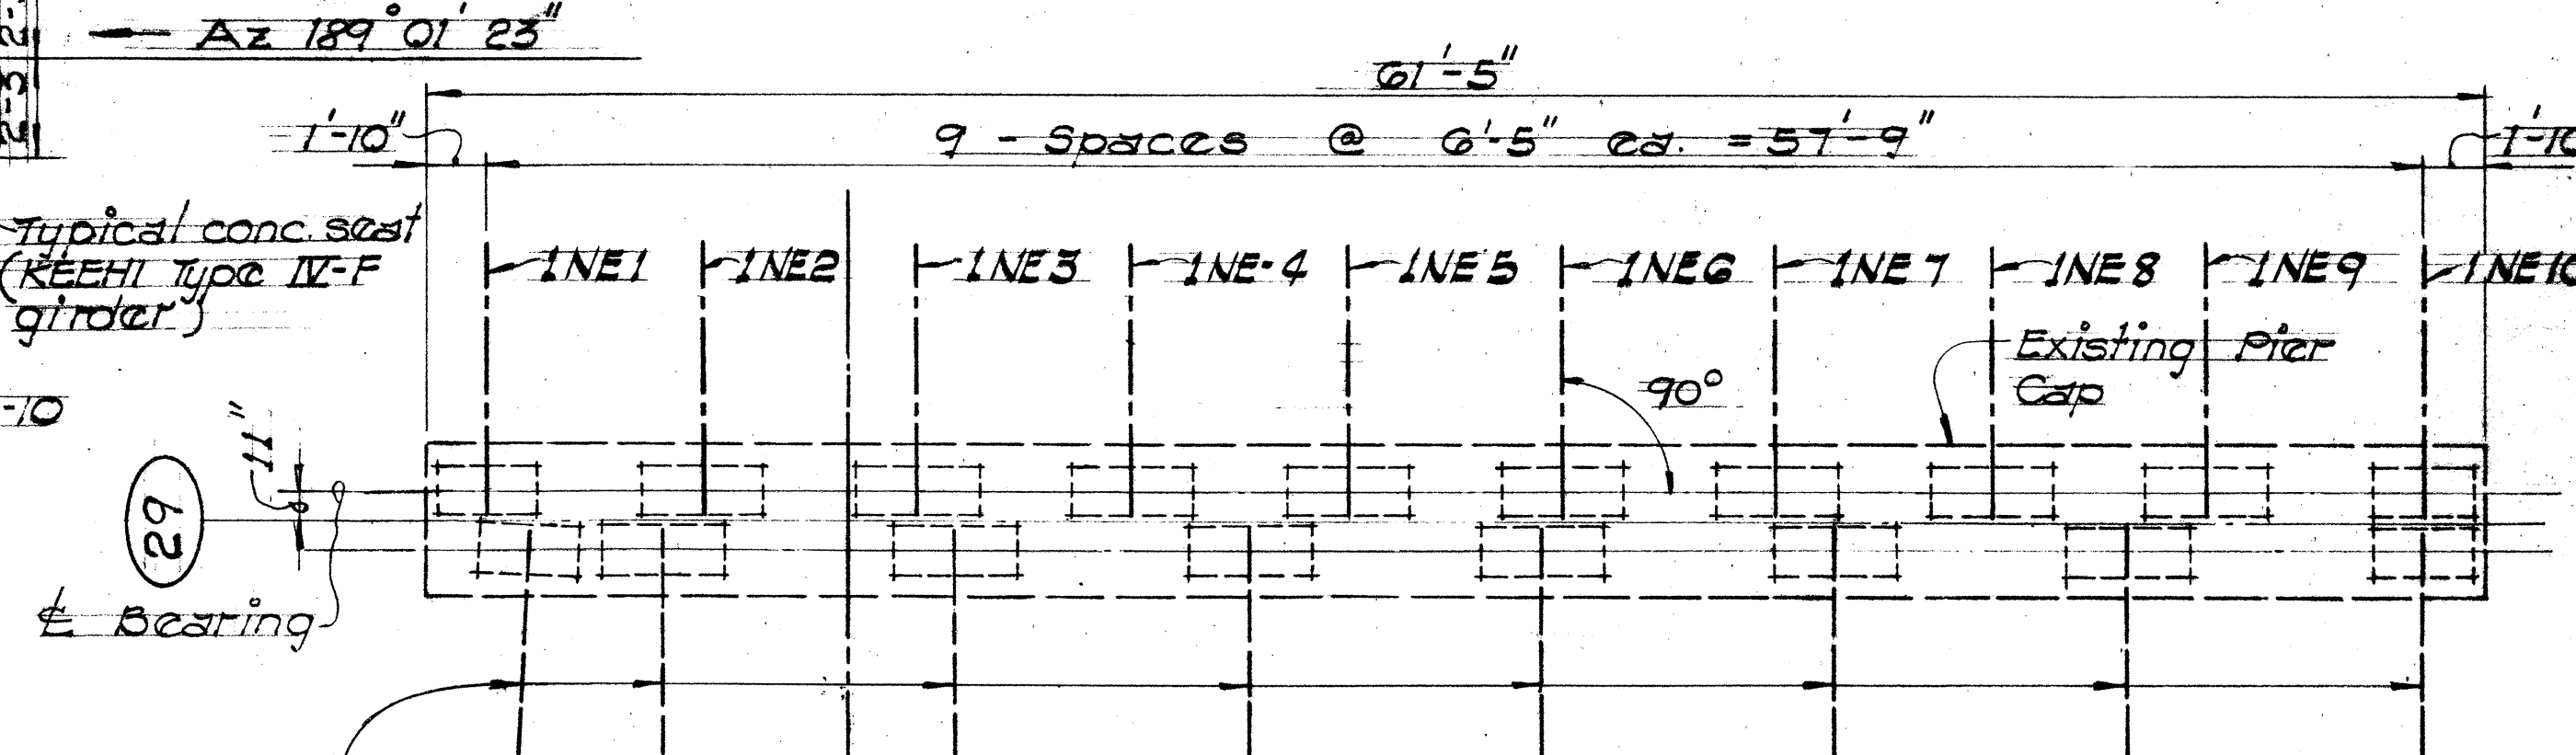

**PLAN ~ PIER** (29)  
Scale: 3/16" = 1'-0"


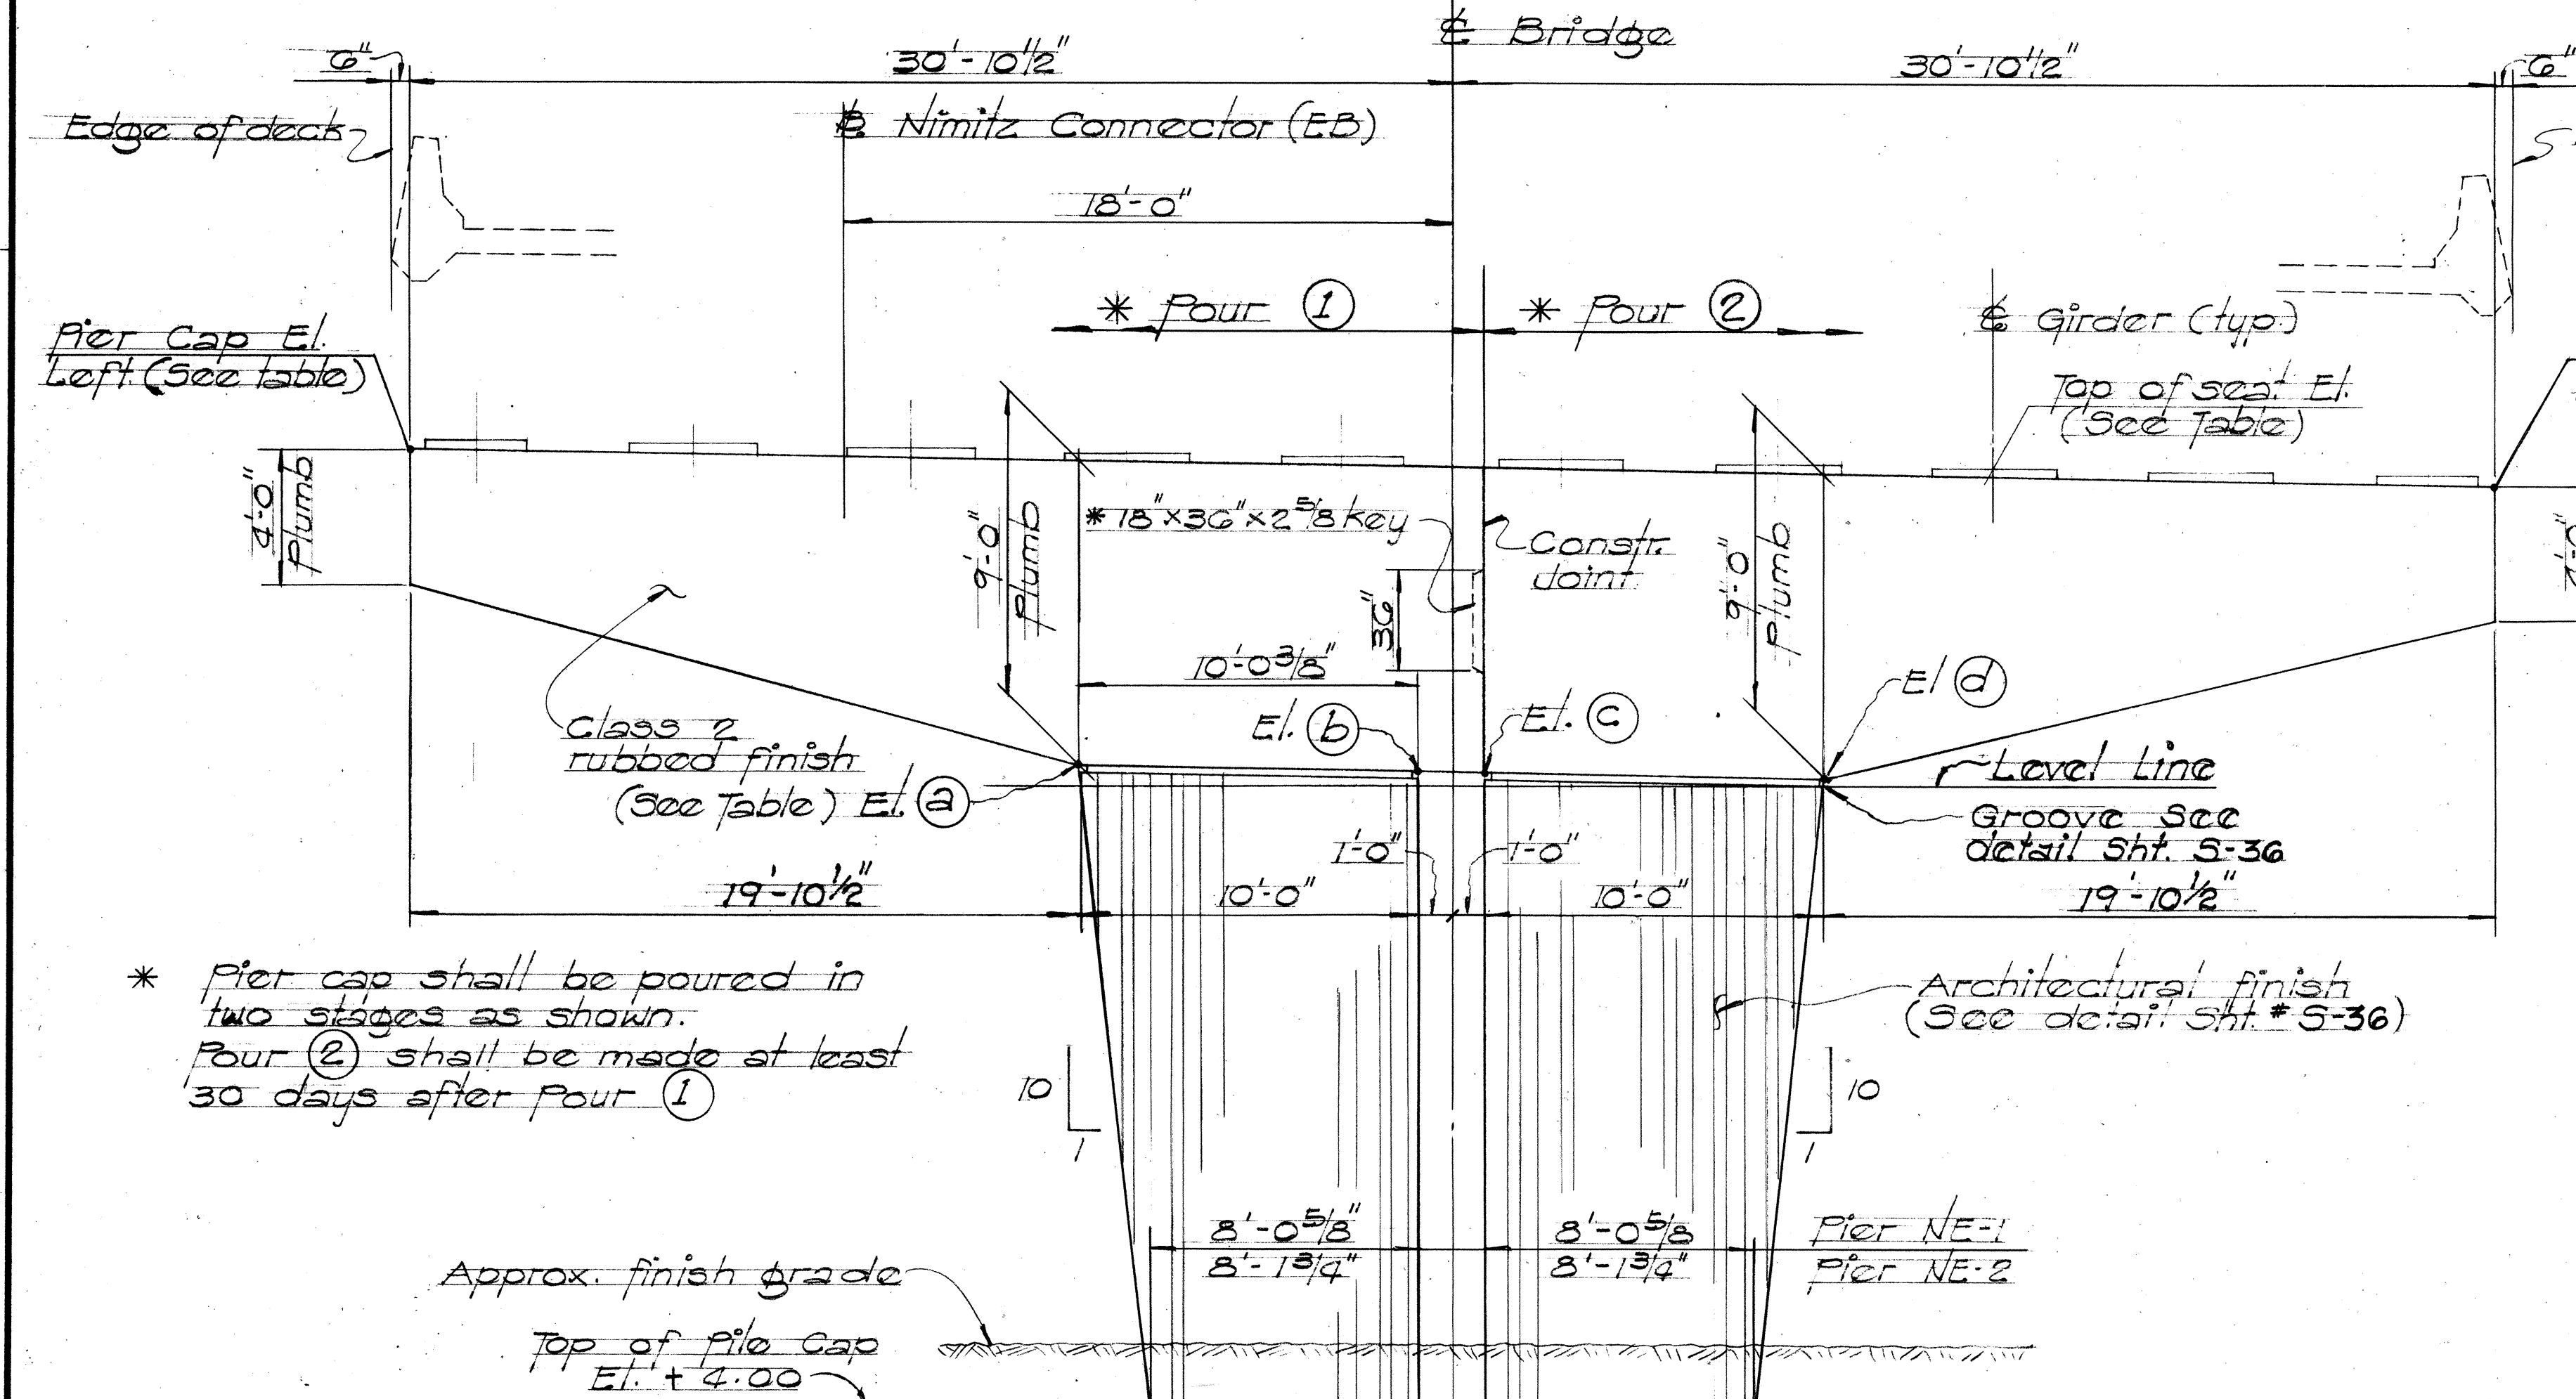


**ELEVATION ~ PIERS** (NE-1 & NE-2)  
TOWARDS INCREASING STATION  
Scale: 1/4" = 1'-0"

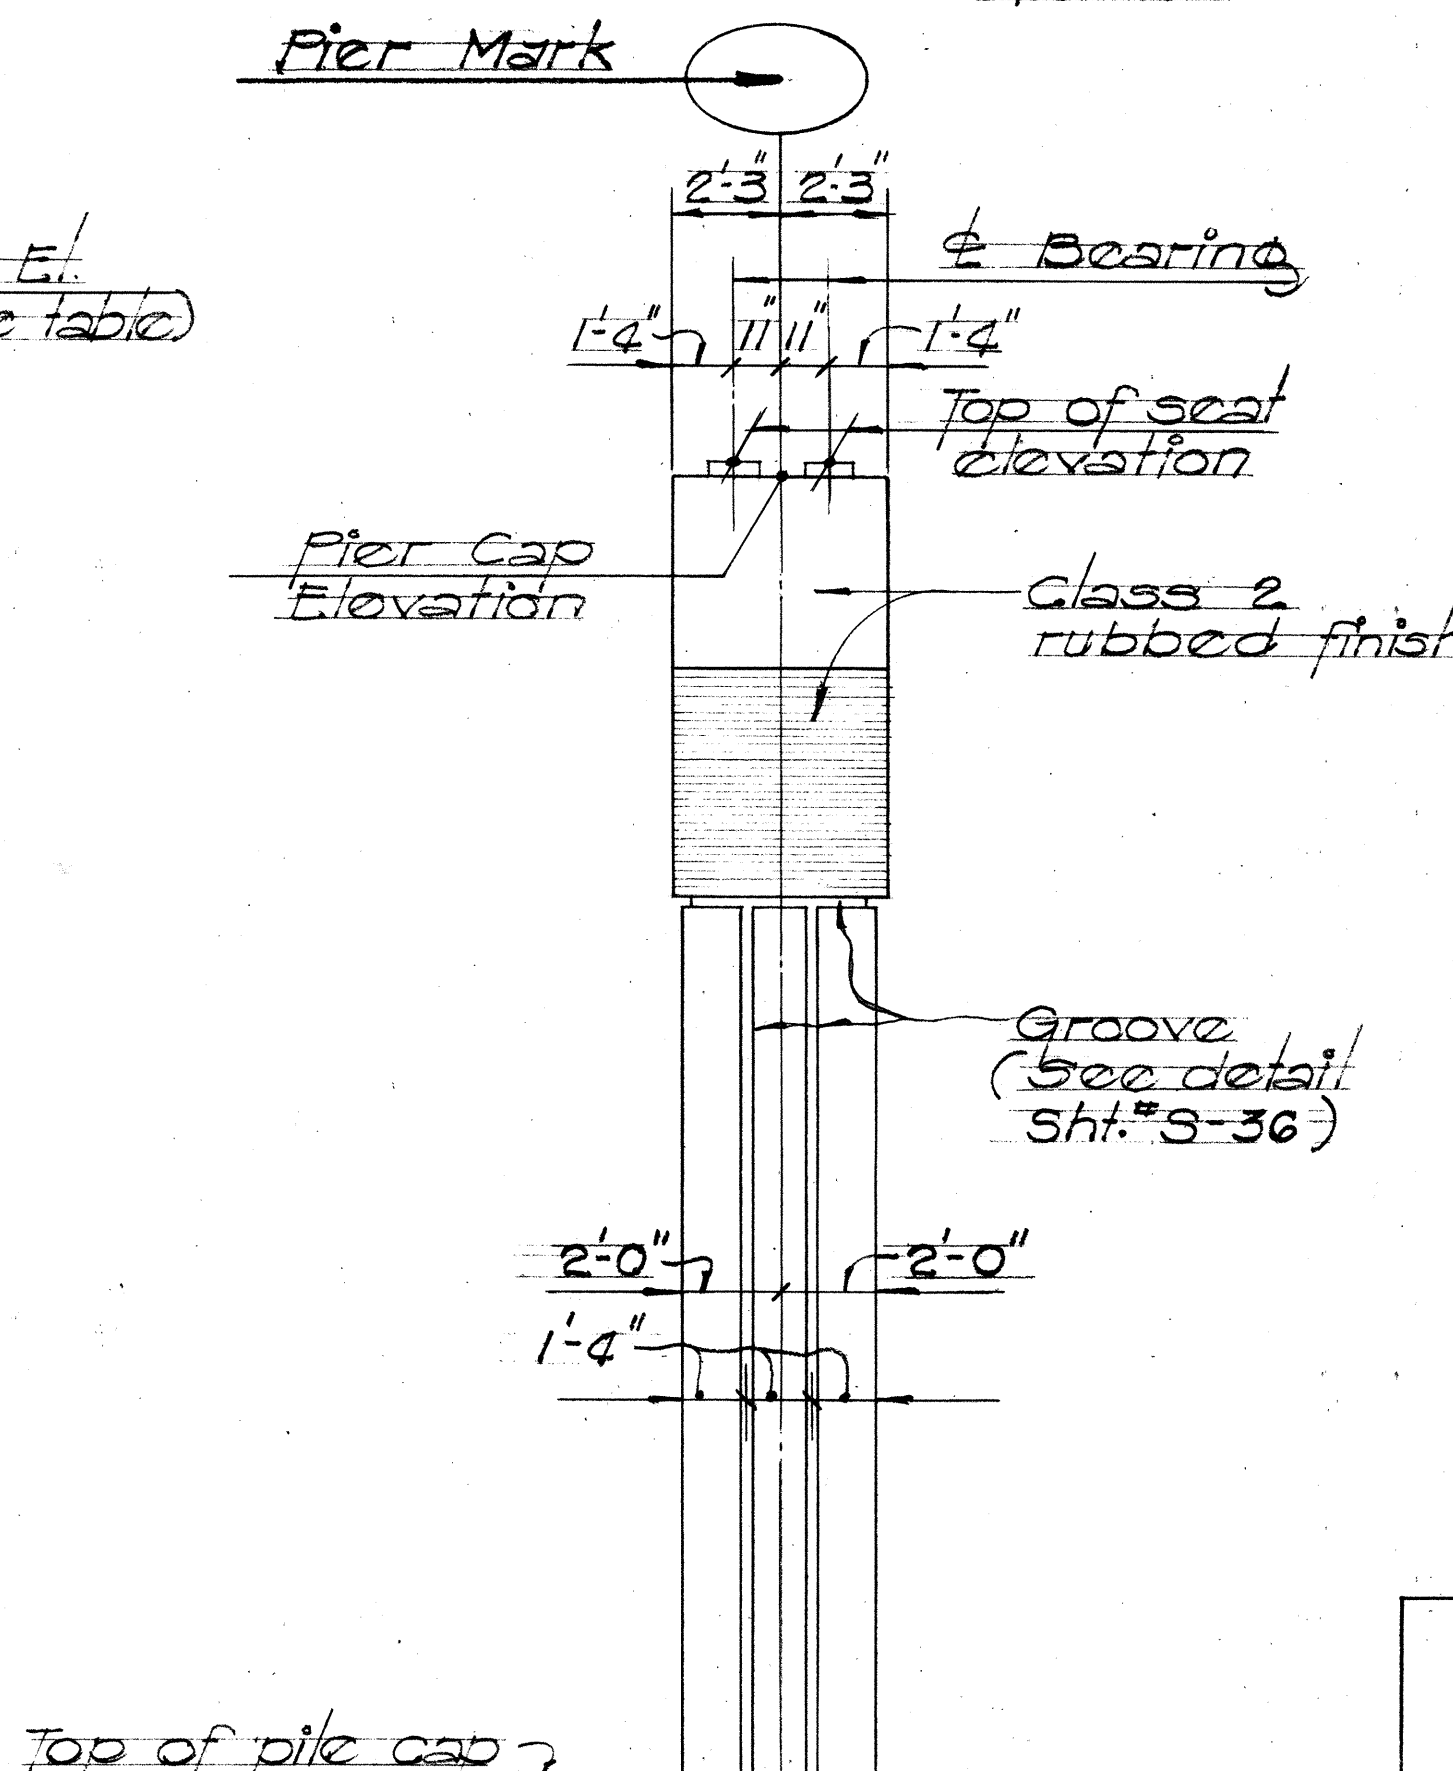

**END ELEVATION**  
Scale: 1/4" = 1'-0"

\* Pier cap shall be poured in two stages as shown. Pour (2) shall be made at least 30 days after Pour (1)

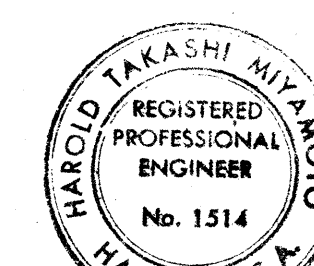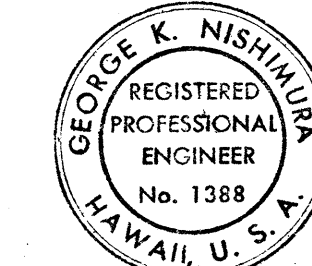


THIS WORK WAS PREPARED BY ME OR UNDER MY SUPERVISION

THIS WORK WAS PREPARED BY ME OR UNDER MY SUPERVISION

STATE OF HAWAII  
DEPARTMENT OF TRANSPORTATION  
HIGHWAYS DIVISION  
**NIMITZ CONNECTOR (EB)**  
**RAMP "A" AND RAMP "B"**  
PIERS NE-1, NE-2, PLAN & ELEVATION  
KEEHI INTERCHANGE  
FAL PROJ NO. 1-HI-1(168)17  
SCALE: AS SHOWN DATE: JULY, 1981  
SHEET No. 5-14 OF 49 SHEETS







| FED. ROAD DIST. NO. | STATE | FED. AID PROJ. NO. | FISCAL YEAR | SHEET NO. | TOTAL SHEETS |
|---------------------|-------|--------------------|-------------|-----------|--------------|
| HAWAII              | HAW.  | 1-HI-1(168)17      | 1982        | 97        | 105          |

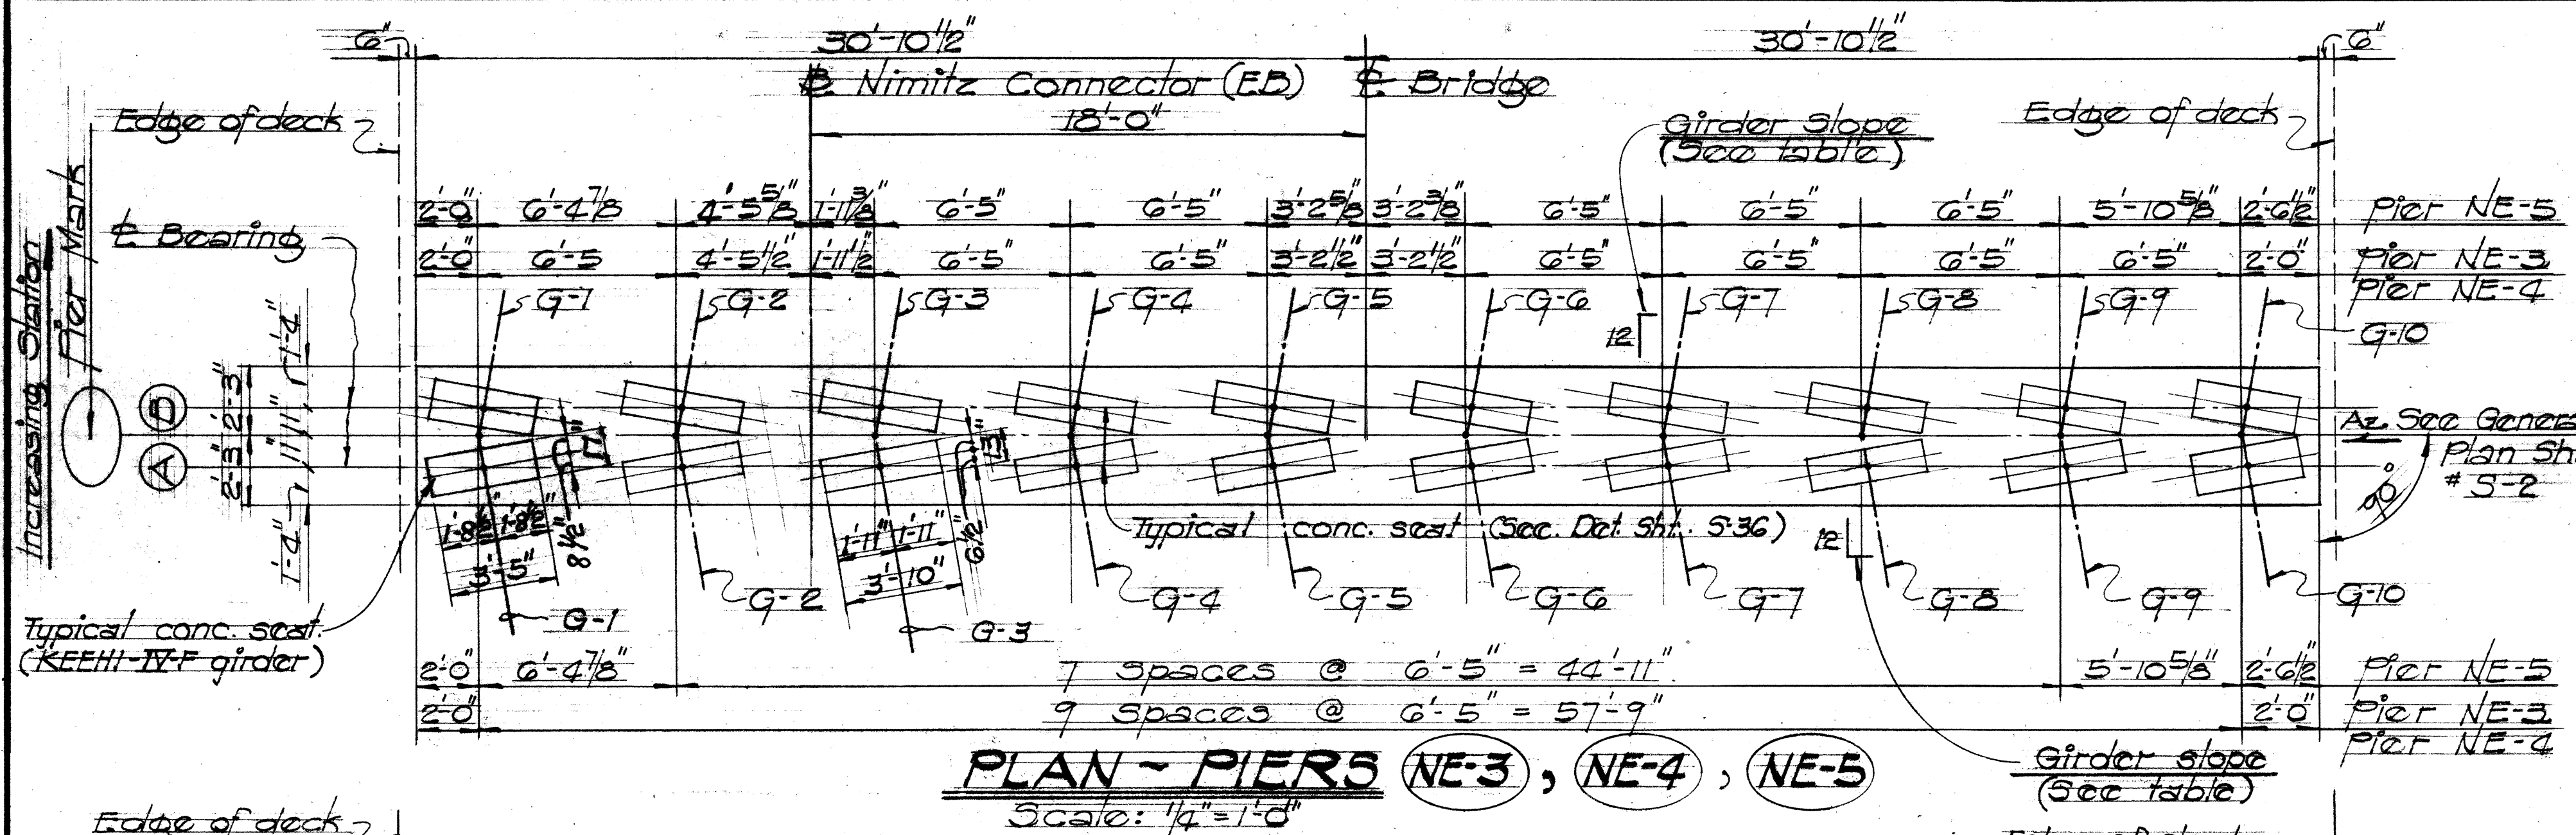

| PIER MARK | BRN/LINE | TOP OF SEAT ELEVATIONS |       |       |       |       |       |       |       |       |       | PIER CAP ELEV. |       | TOP OF COL. ELEV. |       |       |       |
|-----------|----------|------------------------|-------|-------|-------|-------|-------|-------|-------|-------|-------|----------------|-------|-------------------|-------|-------|-------|
|           |          | G-1                    | G-2   | G-3   | G-4   | G-5   | G-6   | G-7   | G-8   | G-9   | G-10  | LEFT           | RIGHT | (A)               | (B)   | (C)   | (D)   |
| NE-3      | (B)      | 31.33                  | 31.25 | 31.16 | 31.07 | 30.98 | 30.89 | 30.80 | 30.71 | 30.62 | 30.52 | 30.99          | 30.92 | 21.71             | 21.57 | 21.54 | 21.40 |
|           | (A)      | 31.37                  | 31.28 | 31.18 | 31.09 | 30.99 | 30.89 | 30.80 | 30.70 | 30.60 | 30.50 |                |       |                   |       |       |       |
| NE-4      | (B)      | 29.56                  | 29.41 | 29.25 | 29.09 | 28.93 | 28.77 | 28.61 | 28.45 | 28.29 | 28.11 | 29.22          | 29.62 | 19.72             | 19.47 | 19.43 | 19.18 |
|           | (A)      | 29.60                  | 29.46 | 29.31 | 29.15 | 29.00 | 28.85 | 28.70 | 28.55 | 28.39 | 28.23 |                |       |                   |       |       |       |
| NE-5      | (B)      | 27.36                  | 27.10 | 26.84 | 26.56 | 26.30 | 26.03 | 25.76 | 25.48 | 25.20 | 24.94 | 27.04          | 27.45 | 17.21             | 16.79 | 16.70 | 16.28 |
|           | (A)      | 27.44                  | 27.19 | 26.92 | 26.66 | 26.39 | 26.13 | 25.86 | 25.60 | 25.33 | 25.07 |                |       |                   |       |       |       |

| PIER MARK | BRN/LINE | GIRDER SLOPE |      |      |      |      |      |      |      |      |       |
|-----------|----------|--------------|------|------|------|------|------|------|------|------|-------|
|           |          | G-1          | G-2  | G-3  | G-4  | G-5  | G-6  | G-7  | G-8  | G-9  | G-10  |
| NE-3      | (B)      | 0            | 0    | 0    | 0    | 0    | 0    | 0    | 0    | 0    | 0     |
|           | (A)      | 0            | 0    | 0    | 0    | 0    | 0    | 0    | 0    | 0    | 0     |
| NE-4      | (B)      | 0            | 0    | 0    | 0    | 0    | 0    | 0    | 0    | 0    | -1/16 |
|           | (A)      | 0            | 0    | 0    | 0    | 0    | 0    | 0    | 0    | 0    | 0     |
| NE-5      | (B)      | 1/4          | 1/4  | 1/4  | 1/4  | 1/4  | 1/4  | 1/4  | 1/4  | 1/4  | 1/4   |
|           | (A)      | 1/16         | 1/16 | 1/16 | 1/16 | 1/16 | 1/16 | 1/16 | 1/16 | 1/16 | 1/8   |

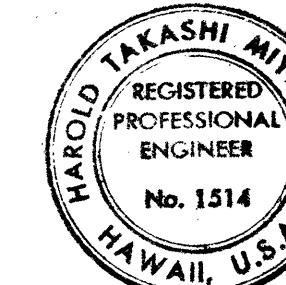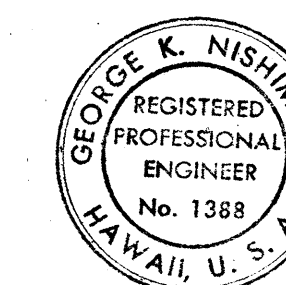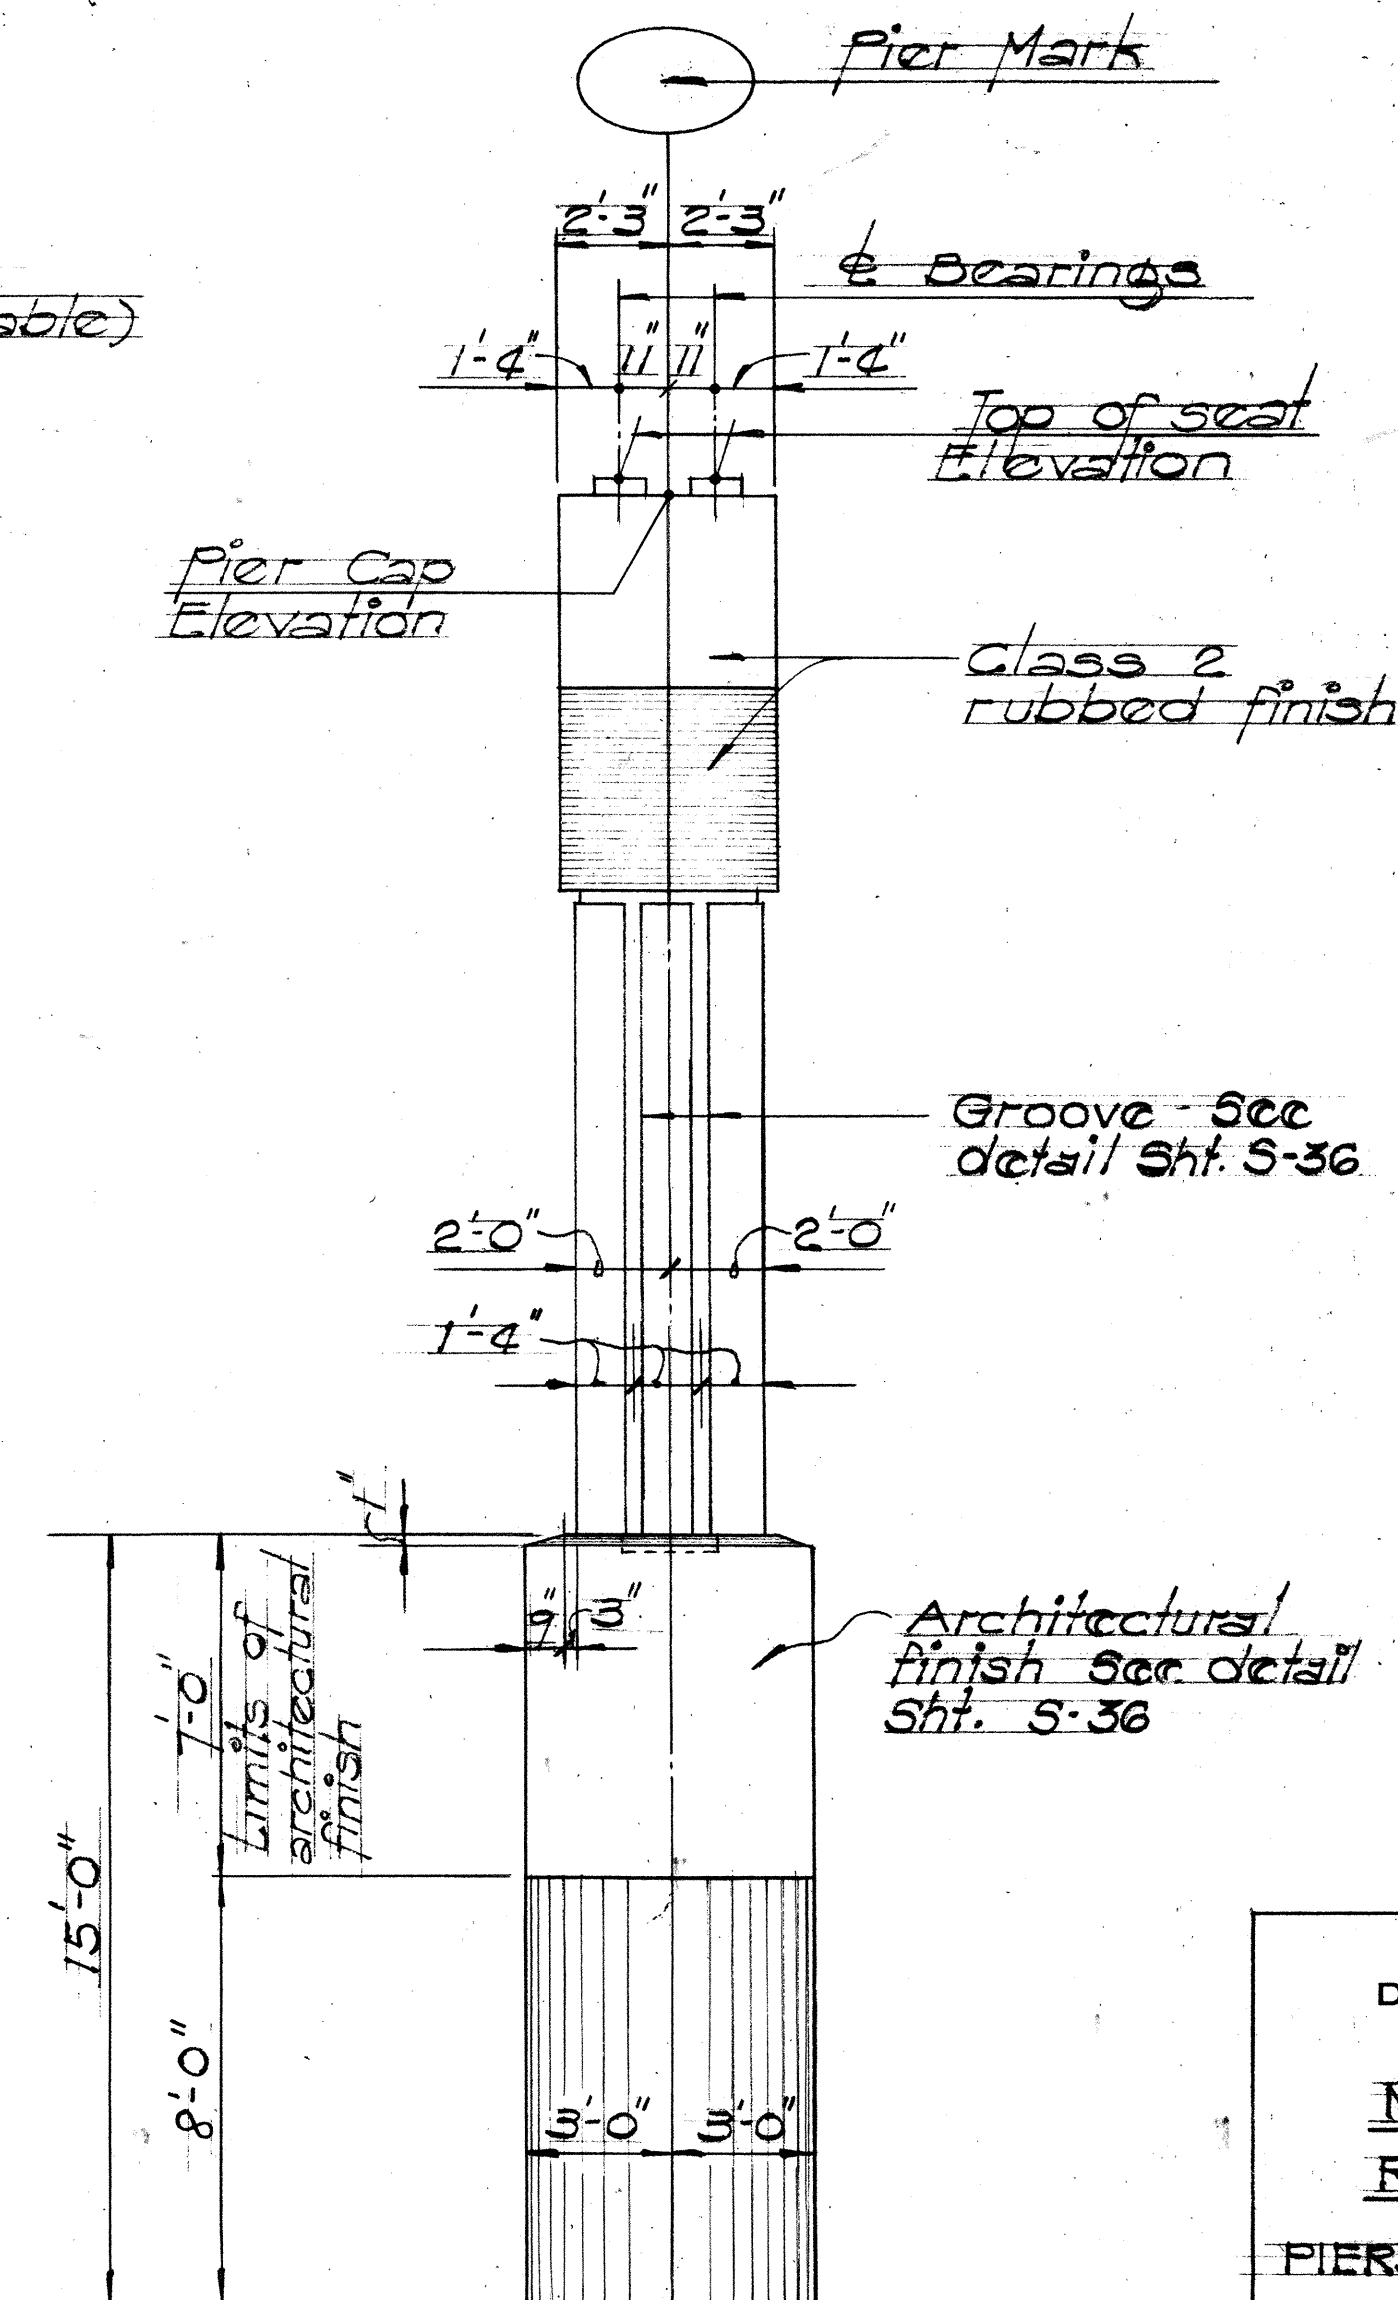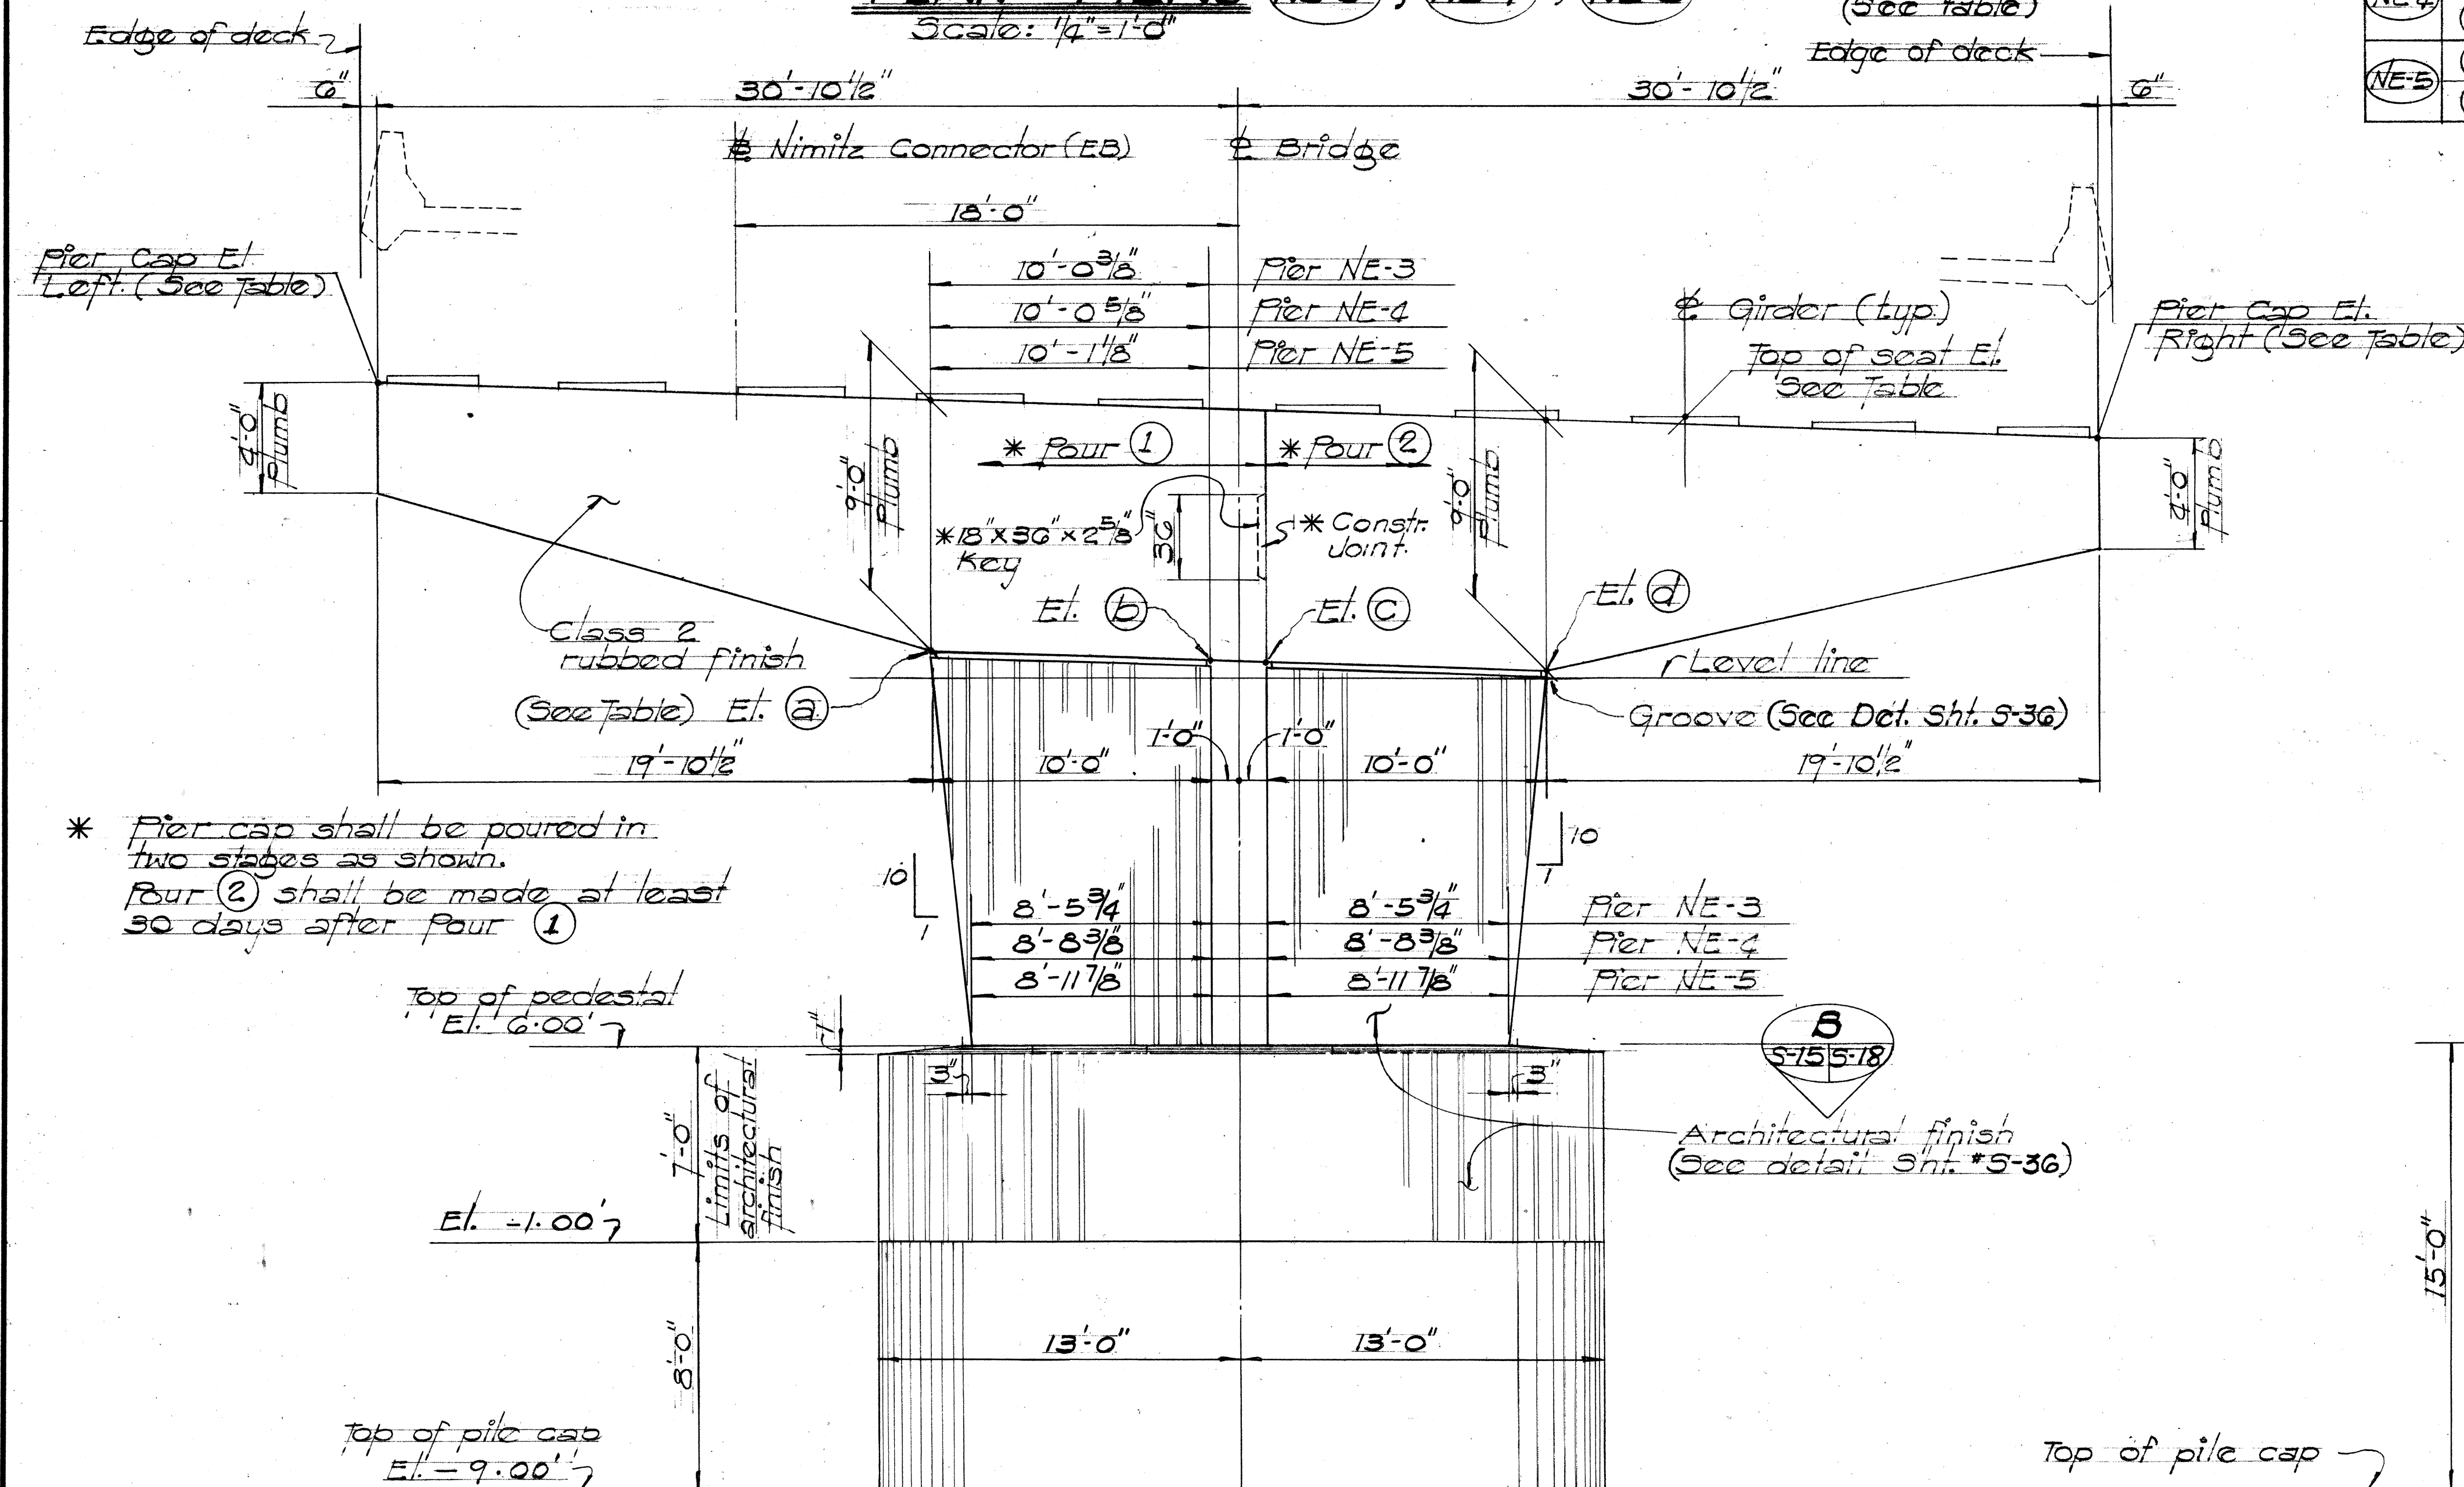

THIS WORK WAS PREPARED BY ME OR UNDER MY SUPERVISION  
 THIS WORK WAS PREPARED BY ME OR UNDER MY SUPERVISION

STATE OF HAWAII  
 DEPARTMENT OF TRANSPORTATION  
 HIGHWAYS DIVISION

NIMITZ CONNECTOR (EB)  
 RAMP "A" AND RAMP "B"

PIERS NE-3 THRU NE-5 PLAN & ELEV.


KEEHI INTERCHANGE  
 FAI PROJ. NO. 1-HI-1(168)17

SCALE: AS SHOWN DATE: JULY, 1981





SHEET NO. 5-15 OF 49 SHEETS



| FED. ROAD DIST. NO. | STATE | FED. AID PROJ. NO. | FISCAL YEAR | SHEET NO. | TOTAL SHEETS |
|---------------------|-------|--------------------|-------------|-----------|--------------|
| HAWAII              | HAW.  | 1-H-1(168)17       | 1982        | 98        | 145          |

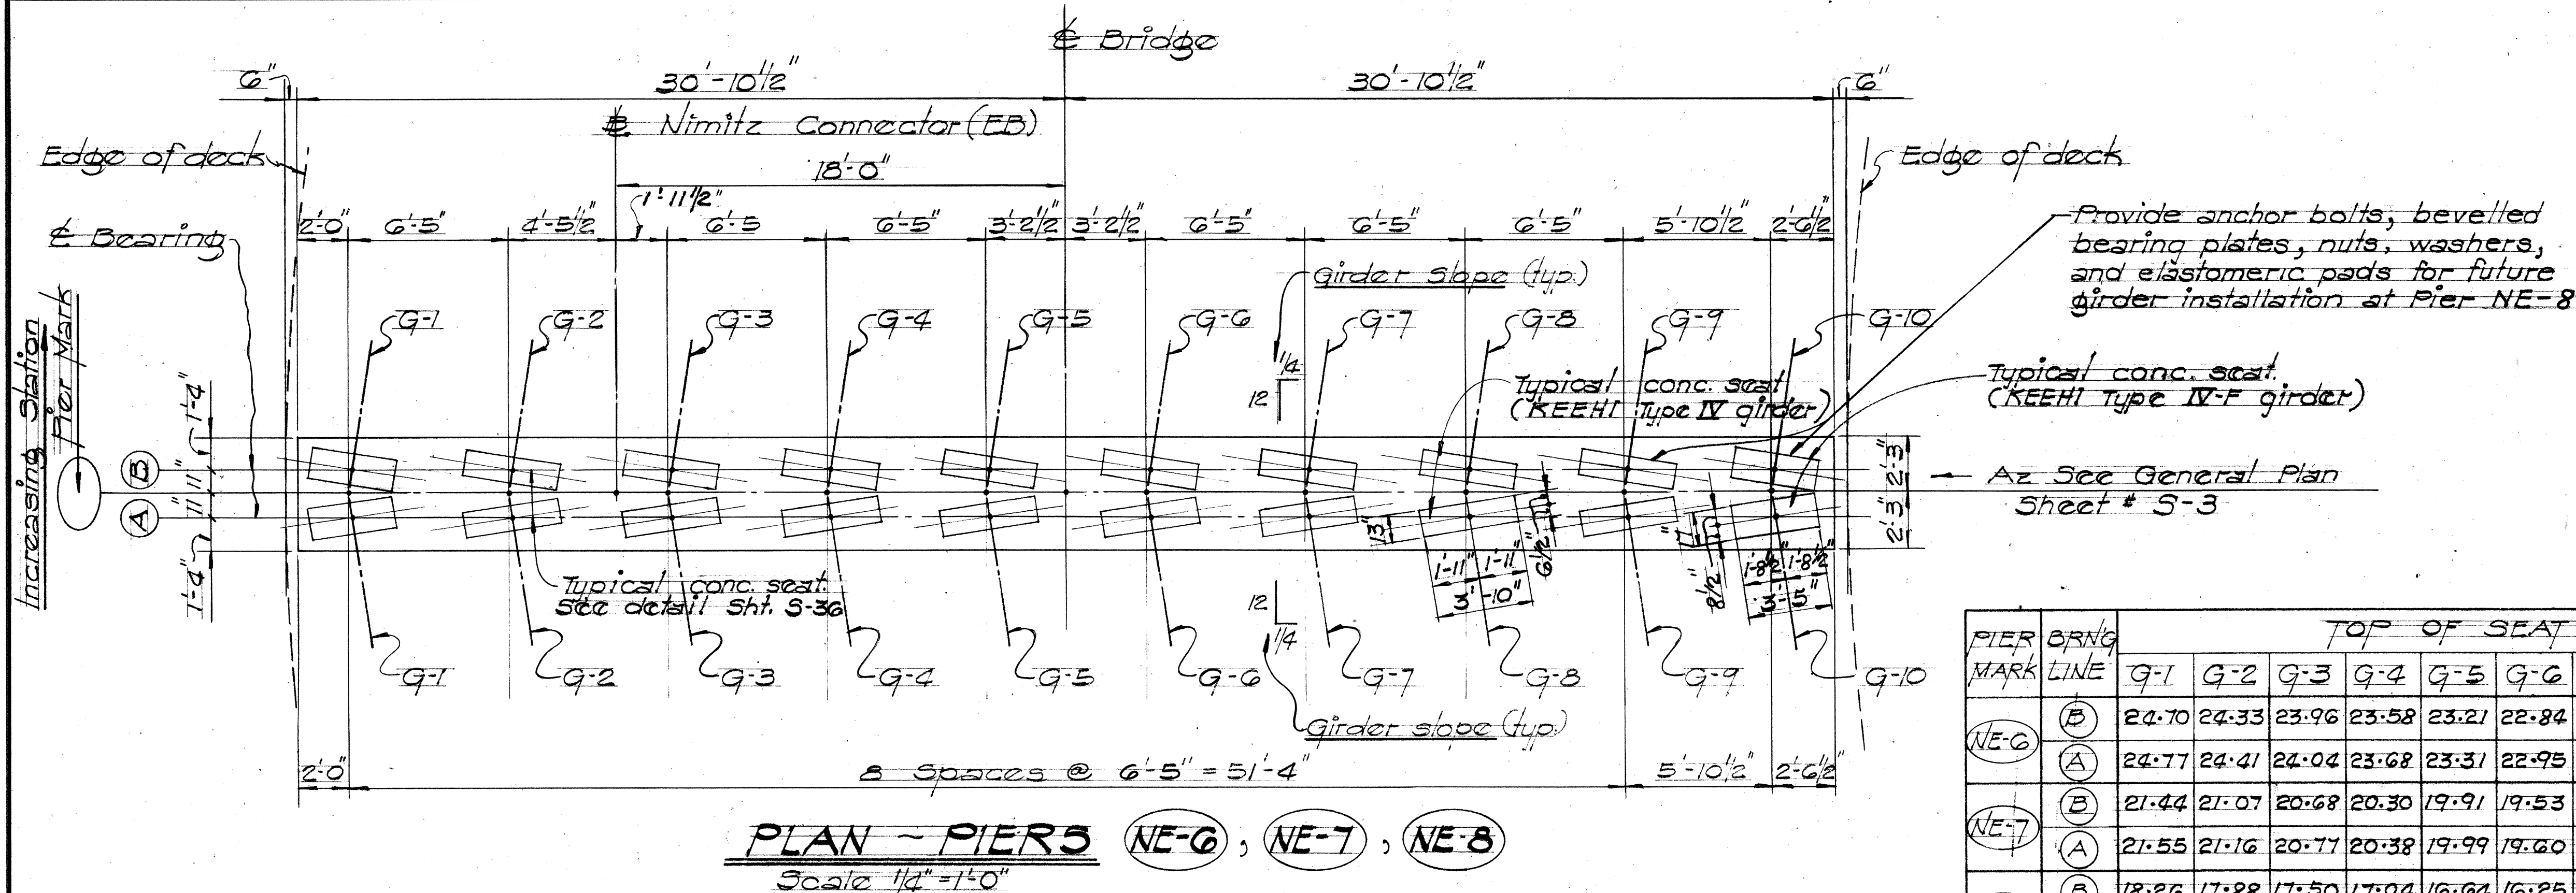

| PIER MARK | ORNG LINE | TOP OF SEAT ELEVATIONS |       |       |       |       |       |       |       |       |       | PIER CAP ELEVATIONS |       | TOP OF COL. ELEV. |       |       |       |
|-----------|-----------|------------------------|-------|-------|-------|-------|-------|-------|-------|-------|-------|---------------------|-------|-------------------|-------|-------|-------|
|           |           | G-1                    | G-2   | G-3   | G-4   | G-5   | G-6   | G-7   | G-8   | G-9   | G-10  | LEFT                | RIGHT | (A)               | (B)   | (C)   | (D)   |
| NE-6      | (B)       | 24.70                  | 24.33 | 23.96 | 23.58 | 23.21 | 22.84 | 22.46 | 22.09 | 21.71 | 21.36 | 24.37               | 20.78 | 14.21             | 13.63 | 13.52 | 12.94 |
|           | (A)       | 24.77                  | 24.41 | 24.04 | 23.68 | 23.31 | 22.95 | 22.58 | 22.20 | 21.83 | 21.48 |                     |       |                   |       |       |       |
| NE-7      | (B)       | 21.44                  | 21.07 | 20.68 | 20.30 | 19.91 | 19.53 | 19.14 | 18.76 | 18.37 | 18.01 | 21.72               | 17.42 | 10.93             | 10.33 | 10.21 | 9.61  |
|           | (A)       | 21.55                  | 21.16 | 20.77 | 20.38 | 19.99 | 19.60 | 19.20 | 18.81 | 18.41 | 18.04 |                     |       |                   |       |       |       |
| NE-8      | (B)       | 18.26                  | 17.88 | 17.50 | 17.04 | 16.64 | 16.25 | 15.87 | 15.48 | 15.10 | 14.70 | 17.86               | 14.10 | 7.65              | 7.04  | 6.92  | 6.31  |
|           | (A)       | 18.19                  | 17.81 | 17.43 | 17.05 | 16.66 | 16.28 | 15.89 | 15.51 | 15.12 | 14.76 |                     |       |                   |       |       |       |

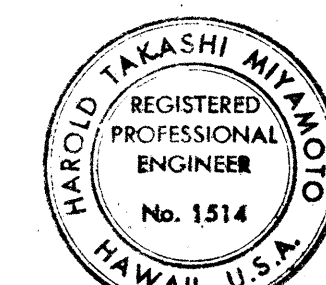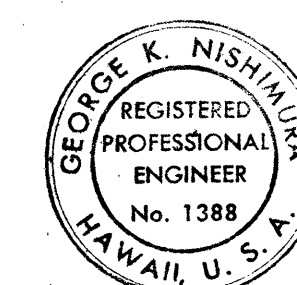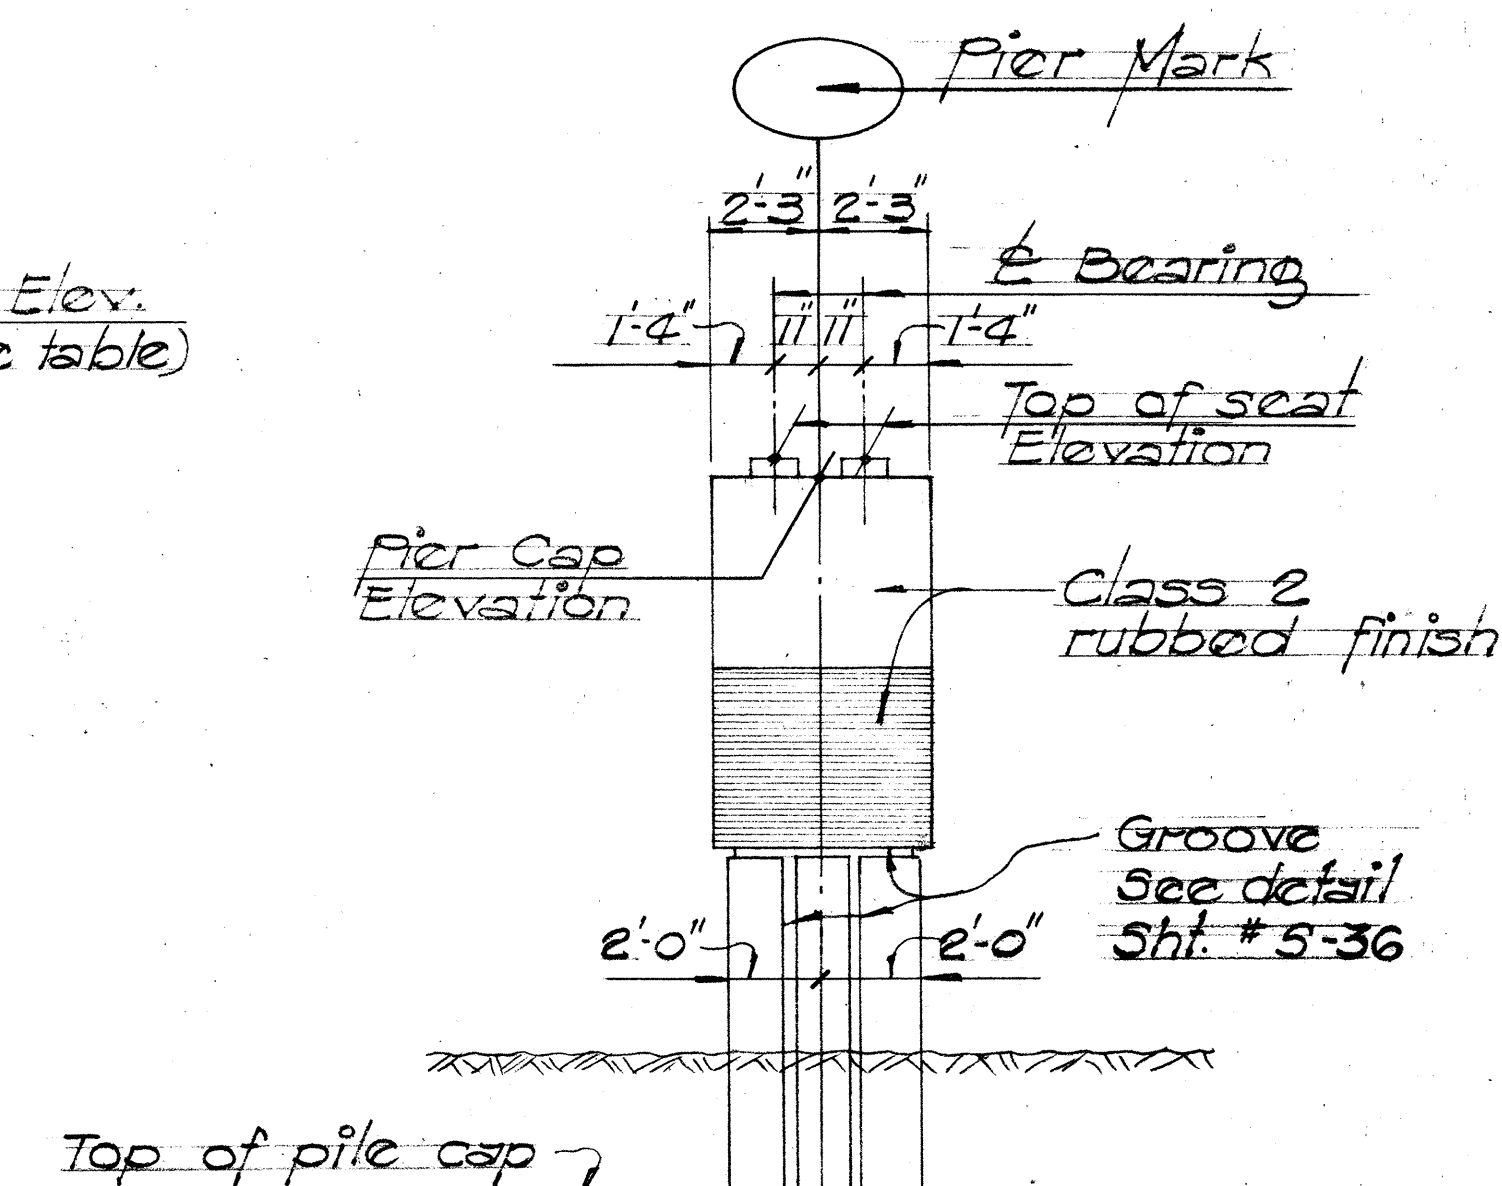
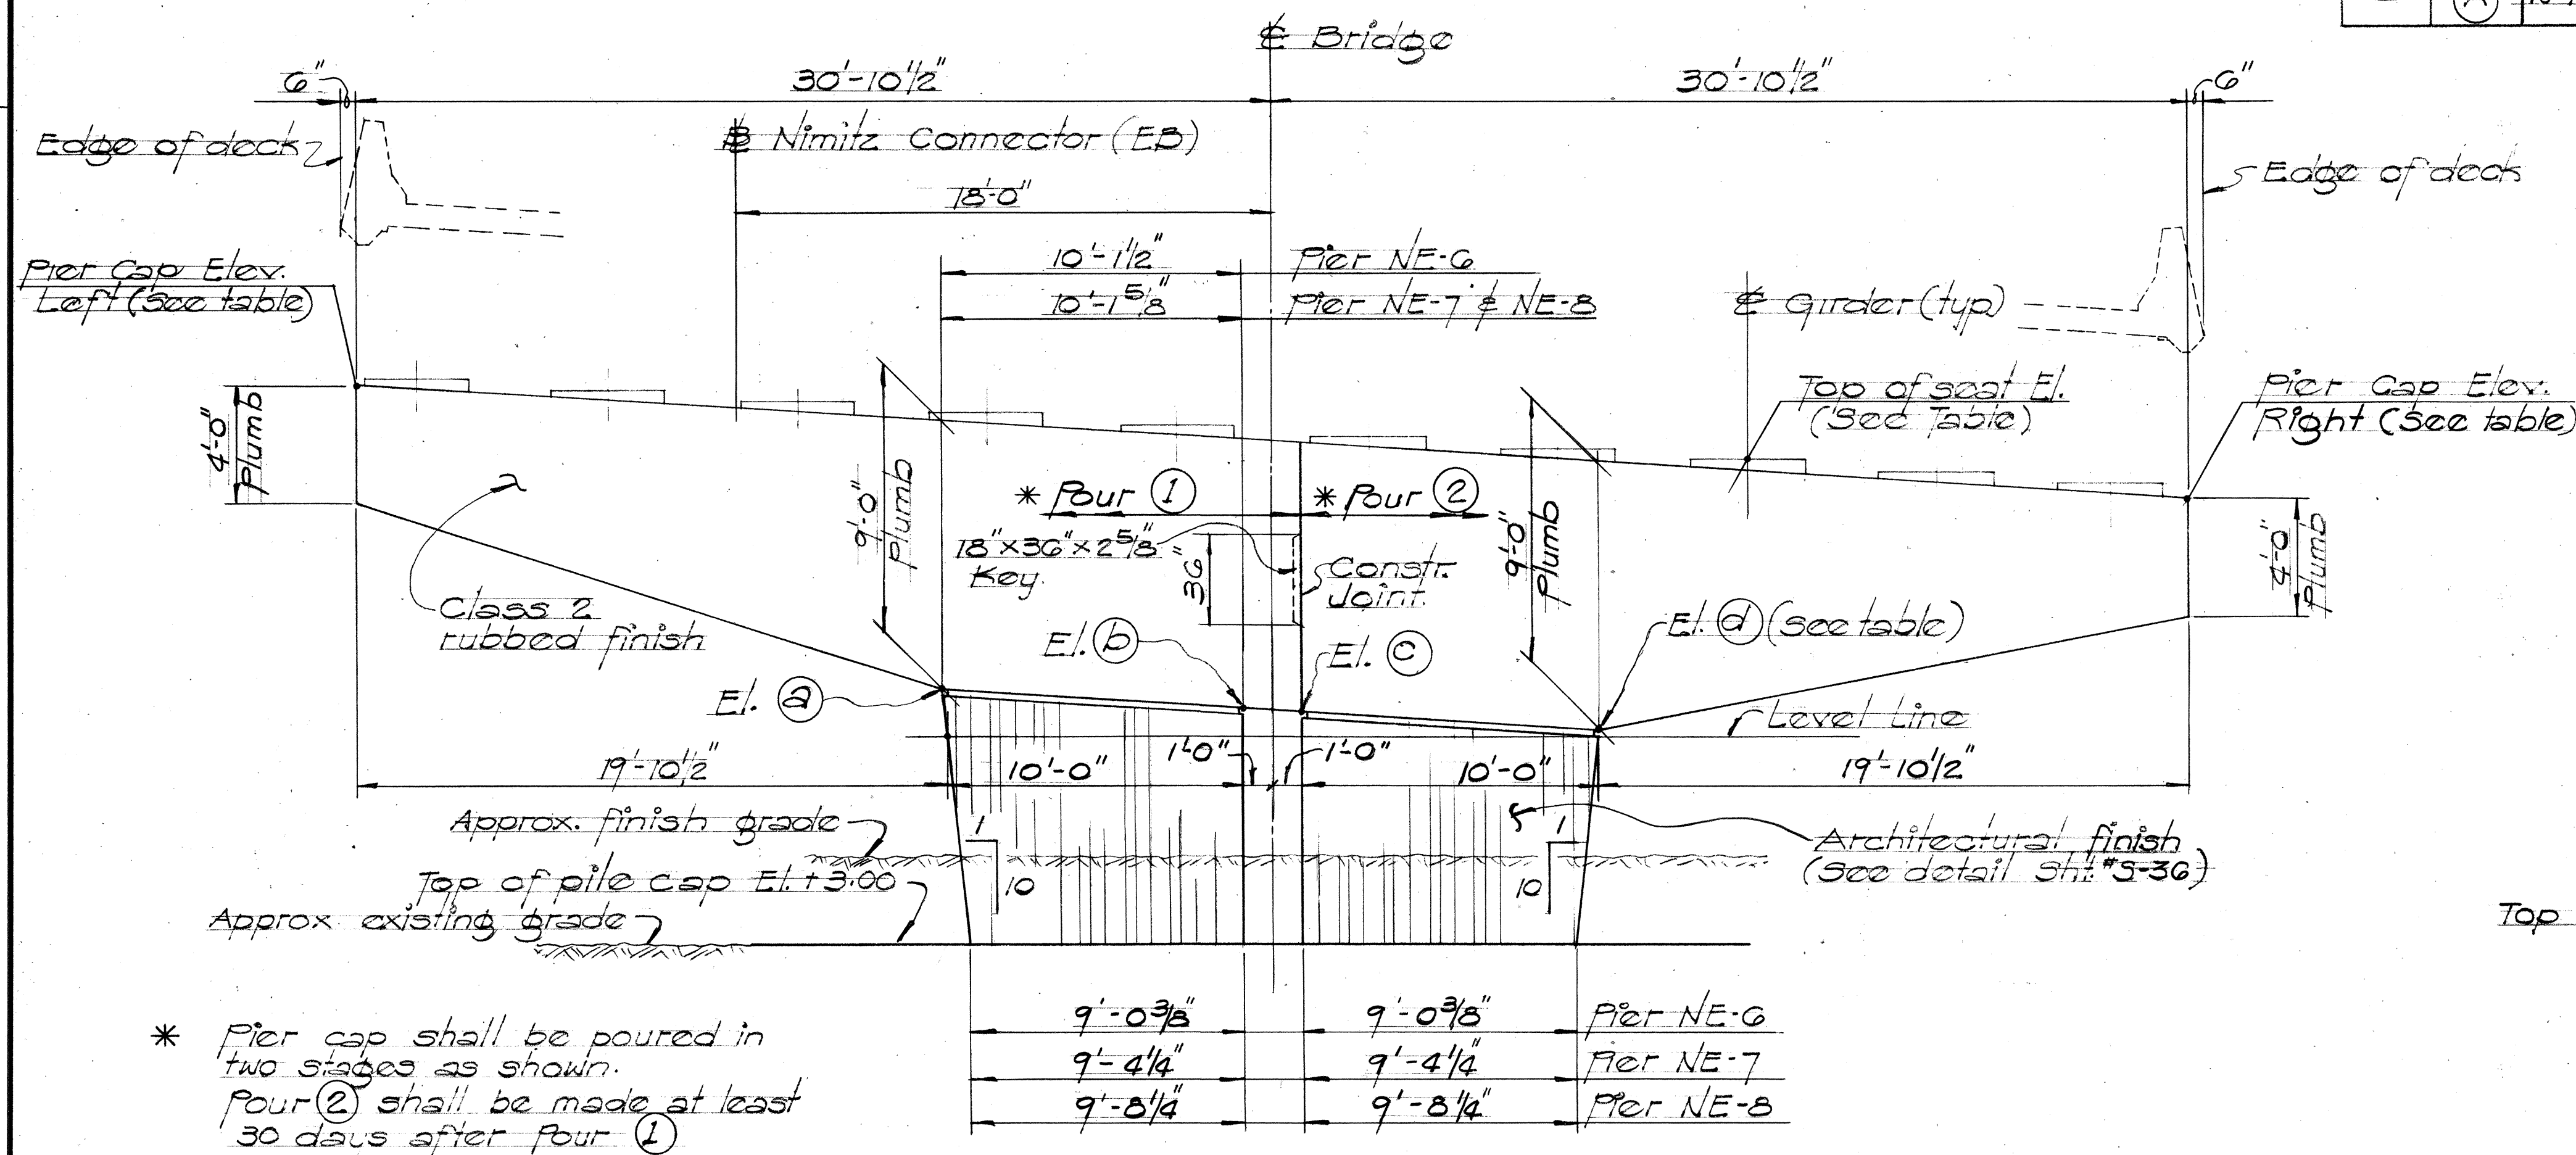


THIS WORK WAS PREPARED BY ME OR UNDER MY SUPERVISION  
 [Signature] [Signature]

STATE OF HAWAII  
 DEPARTMENT OF TRANSPORTATION  
 HIGHWAYS DIVISION  
**NIMITZ CONNECTOR (EB)**  
**RAMP "A" AND RAMP "B"**  
 PIERS NE-6 THRU NE-8 PLAN & ELEVATION  
 KEEHI INTERCHANGE  
 PAL PROJ. NO. 1-H-1(168)17  
 SCALE: AS SHOWN DATE: JULY, 1981  
 SHEET NO. 516 OF 49 SHEETS



| FED. ROAD<br>DIST. NO. | STATE | FED. AID<br>PROJ. NO. | FISCAL<br>YEAR | SHEET<br>NO. | TOTAL<br>SHEET |
|------------------------|-------|-----------------------|----------------|--------------|----------------|
| HAWAII                 | HAW.  | 1-H-1-(68)17          | 1982           | 99           | 145            |

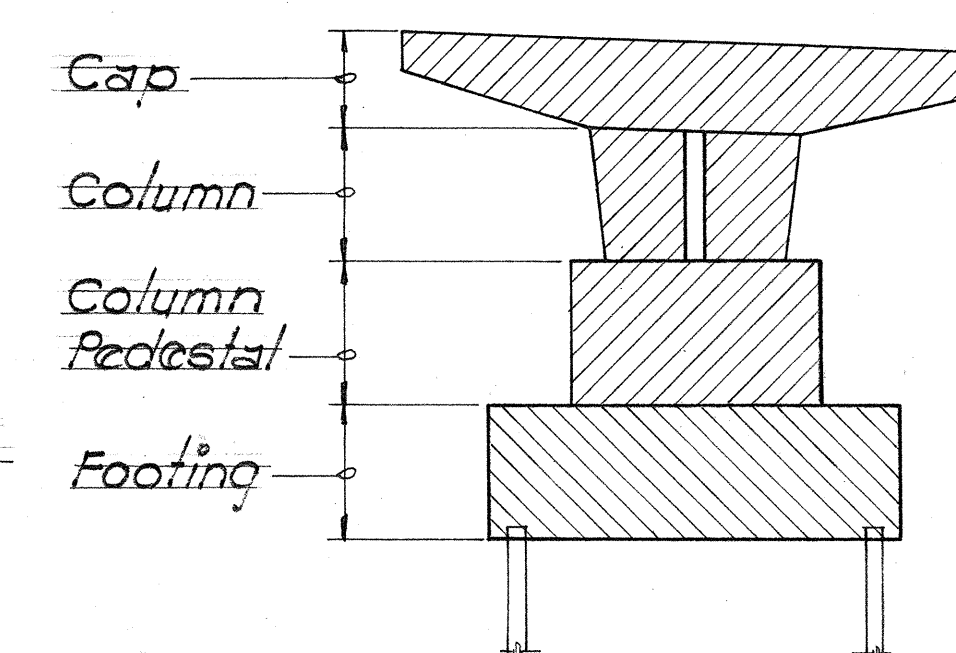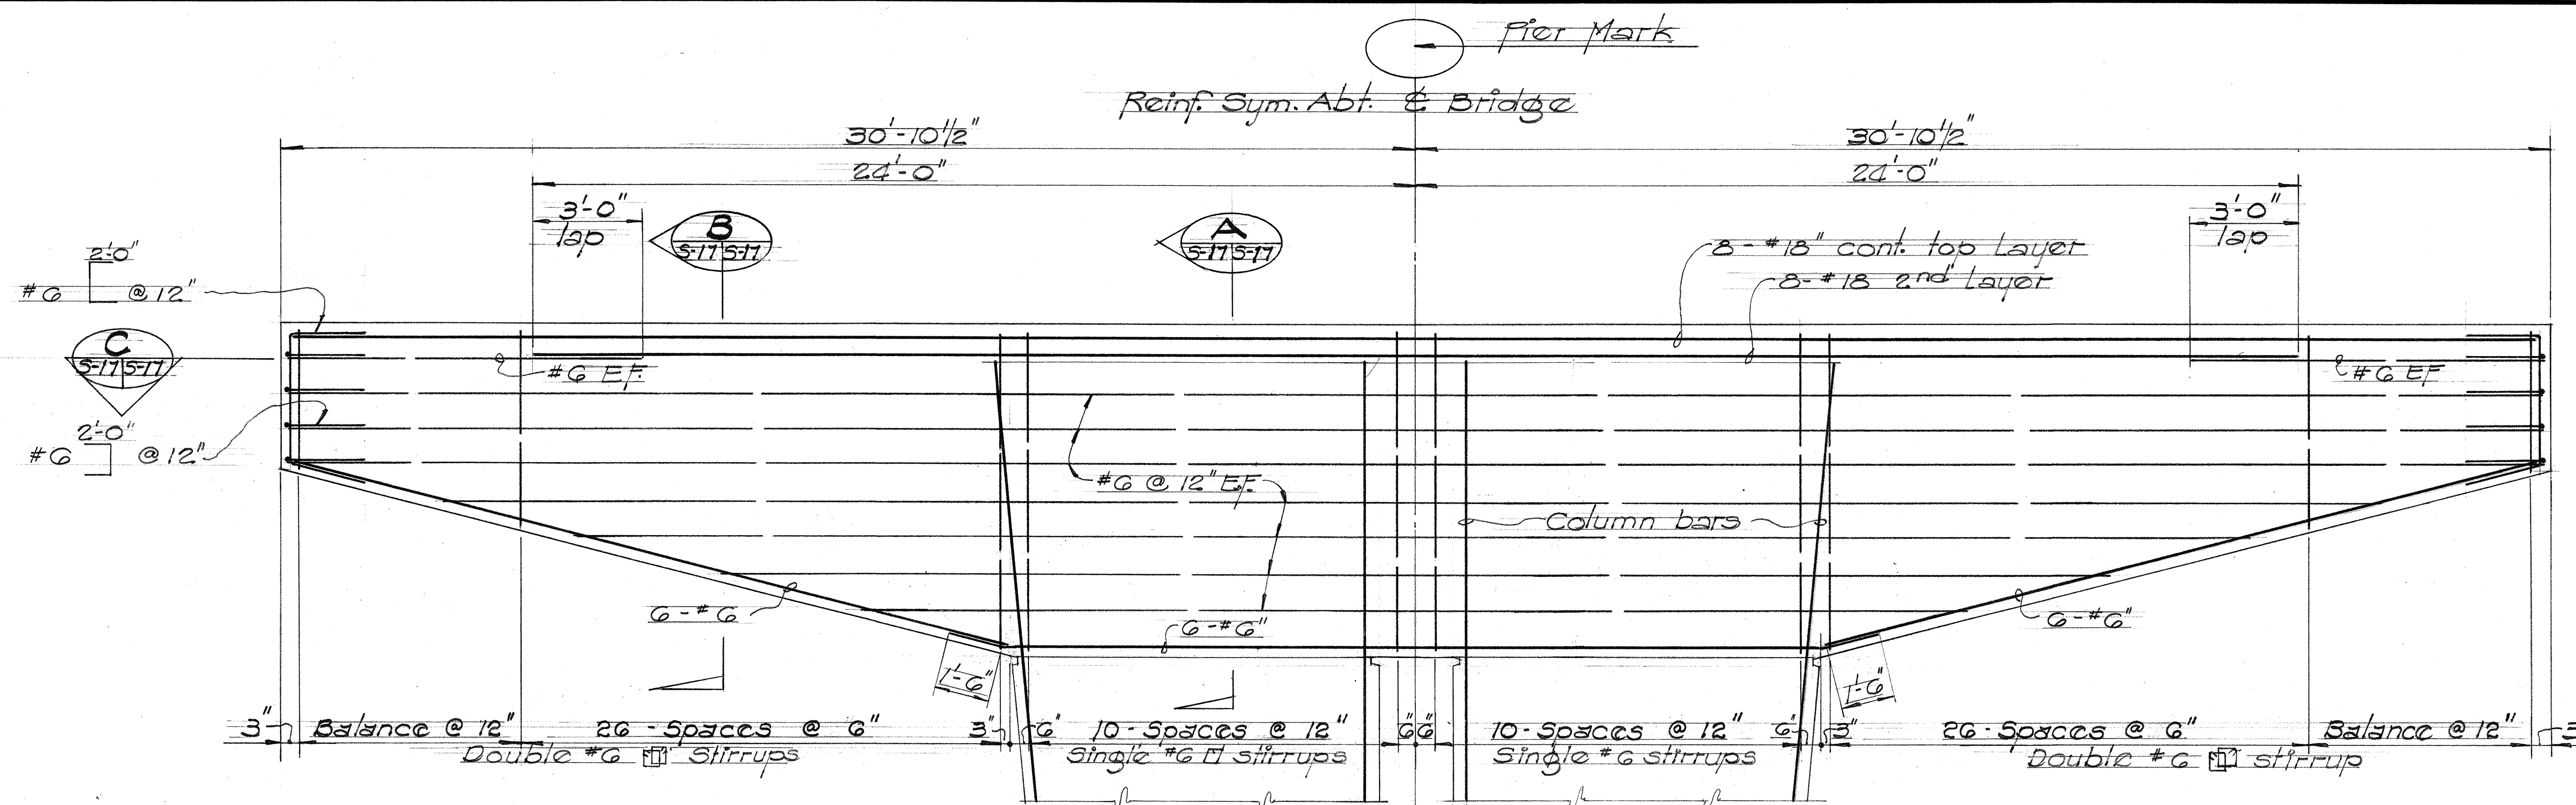


  $f'_c = 4000 \text{ psi}$   
  $f'_c = 3000 \text{ psi}$

# PIER CAPS

Scale  $3/8" = 1'-0"$

NE-1, NE-2, NE-3, NE-4, NE-5, NE-6, NE-7, NE-8

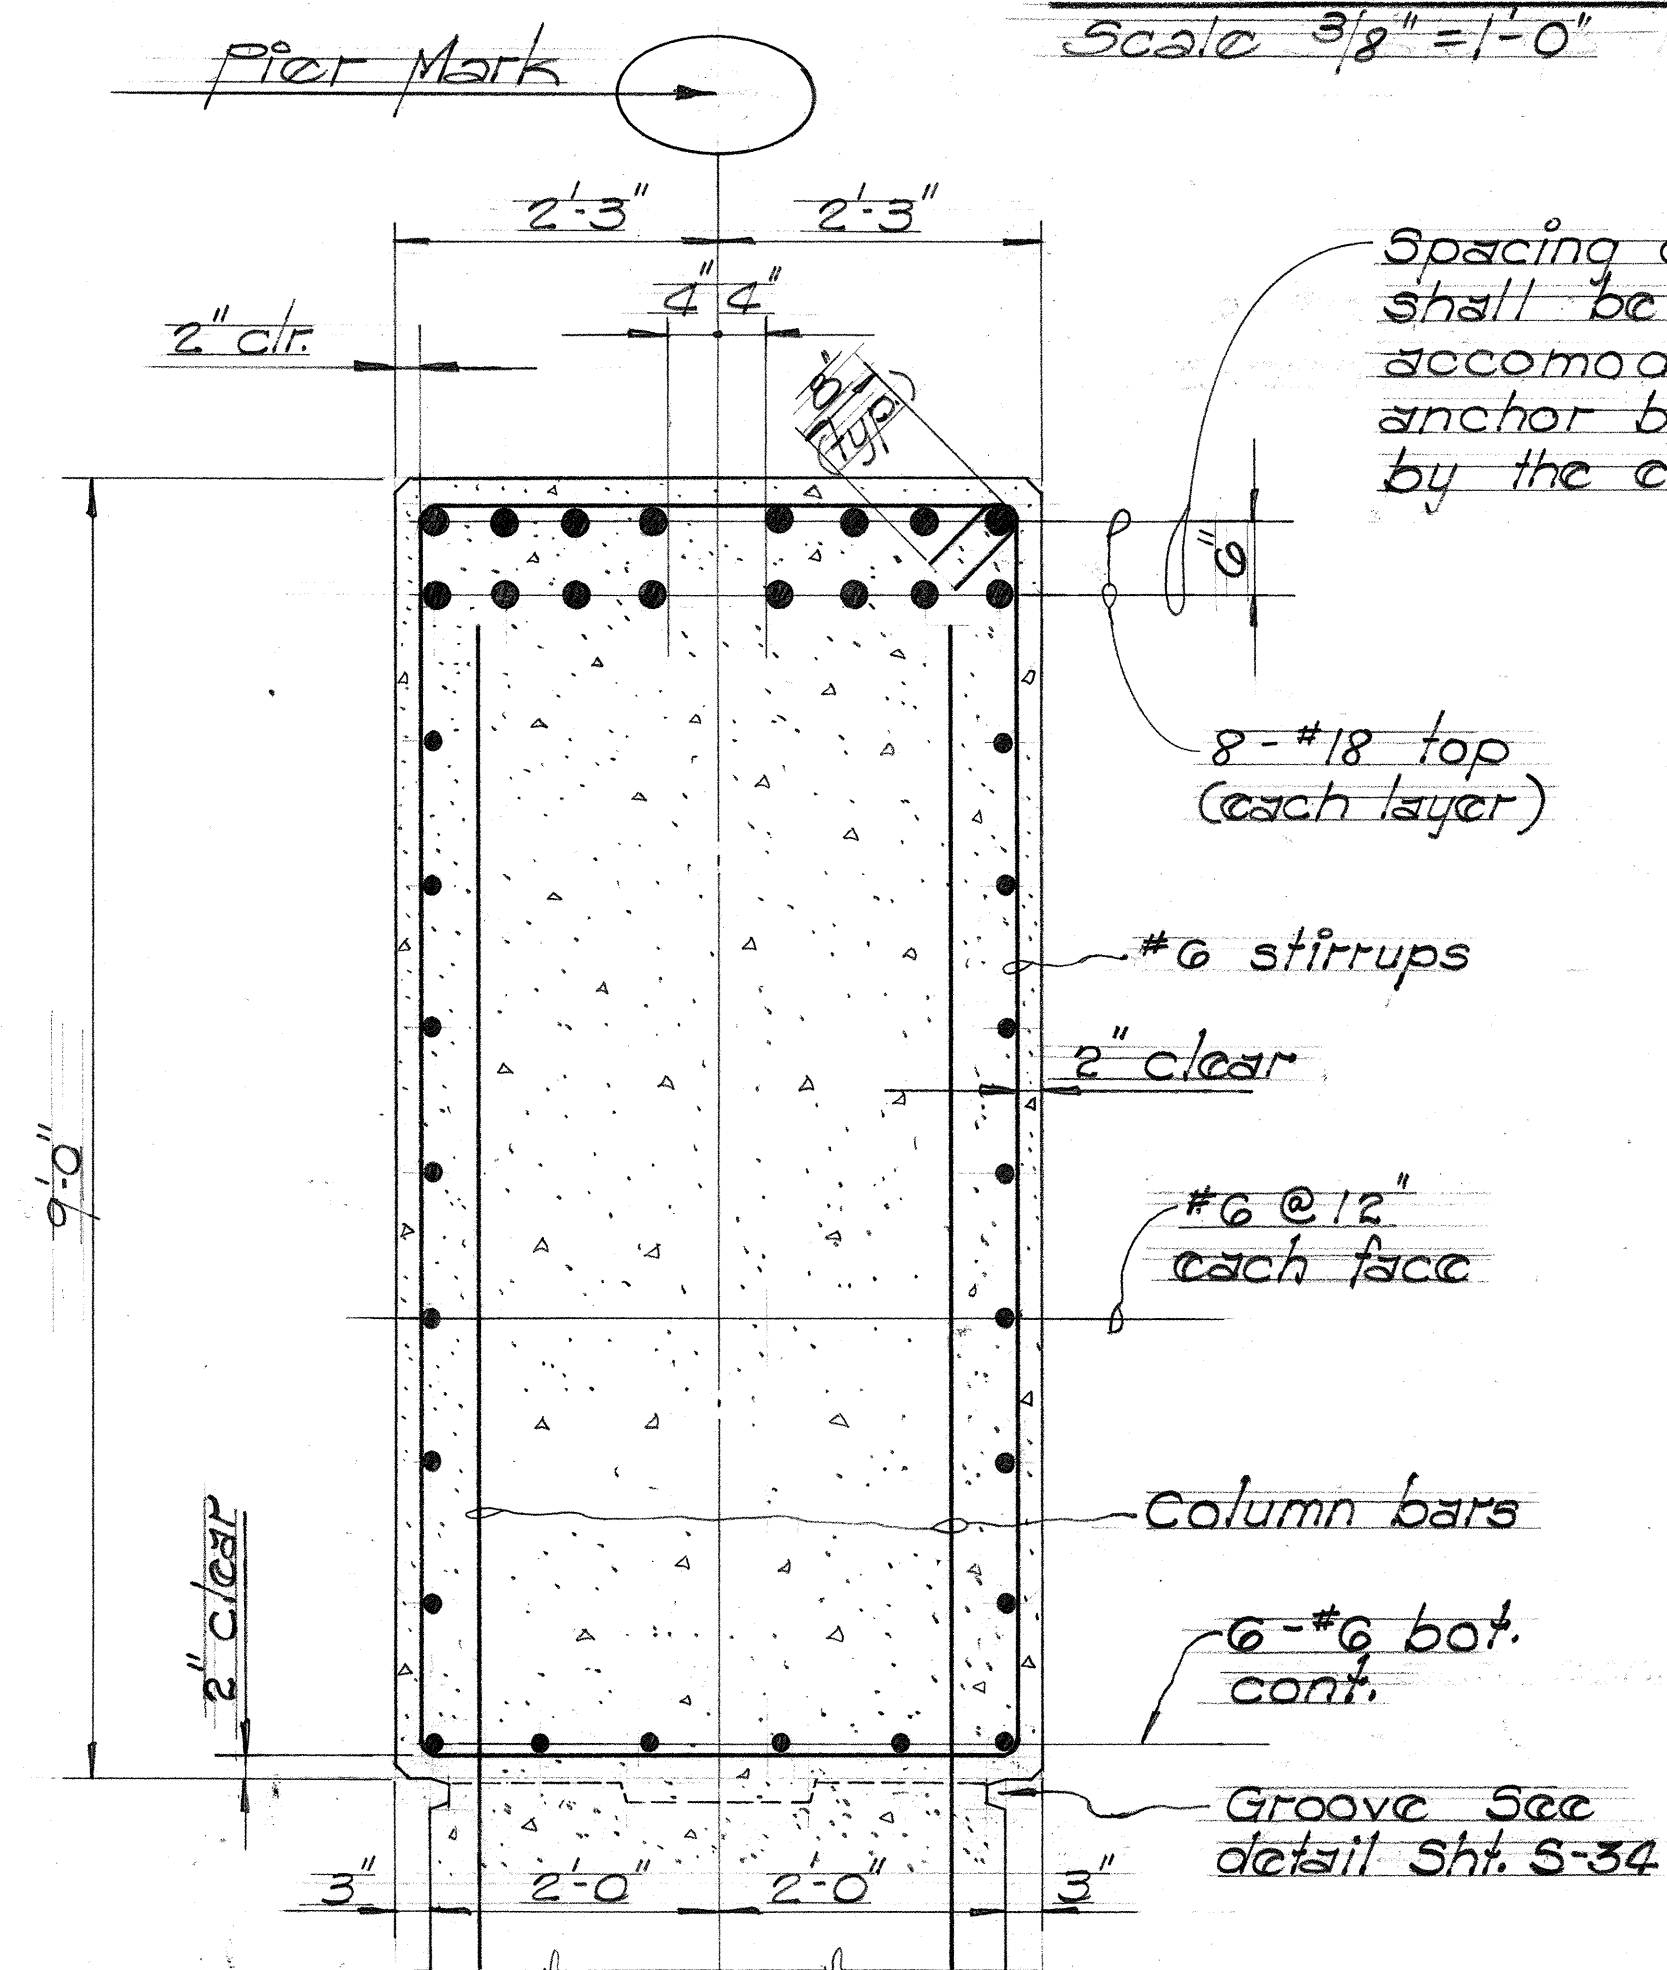

Spacing of reinforcing bars shall be spaced to accommodate bearing plate anchor bolts as approved by the engineer

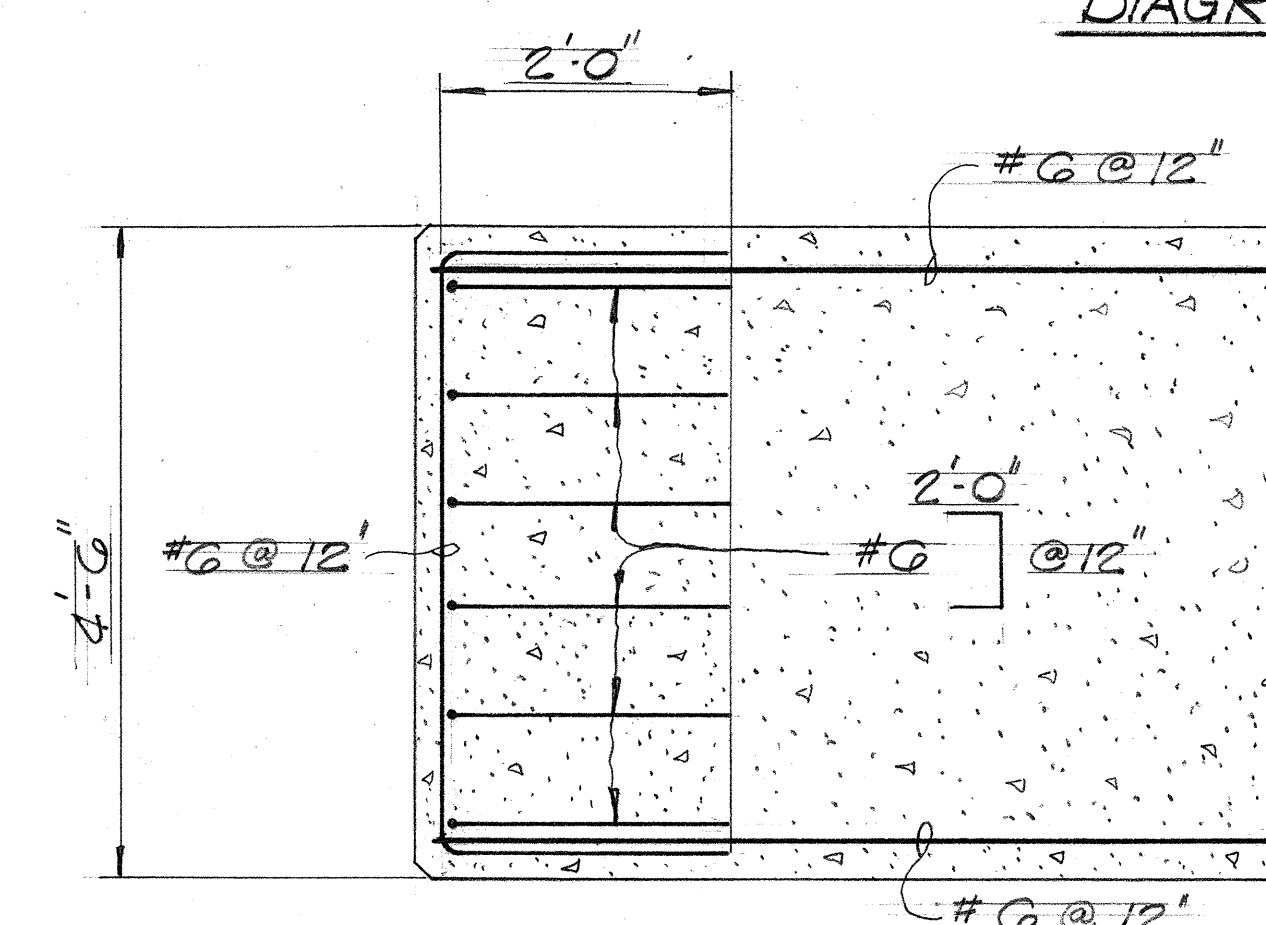
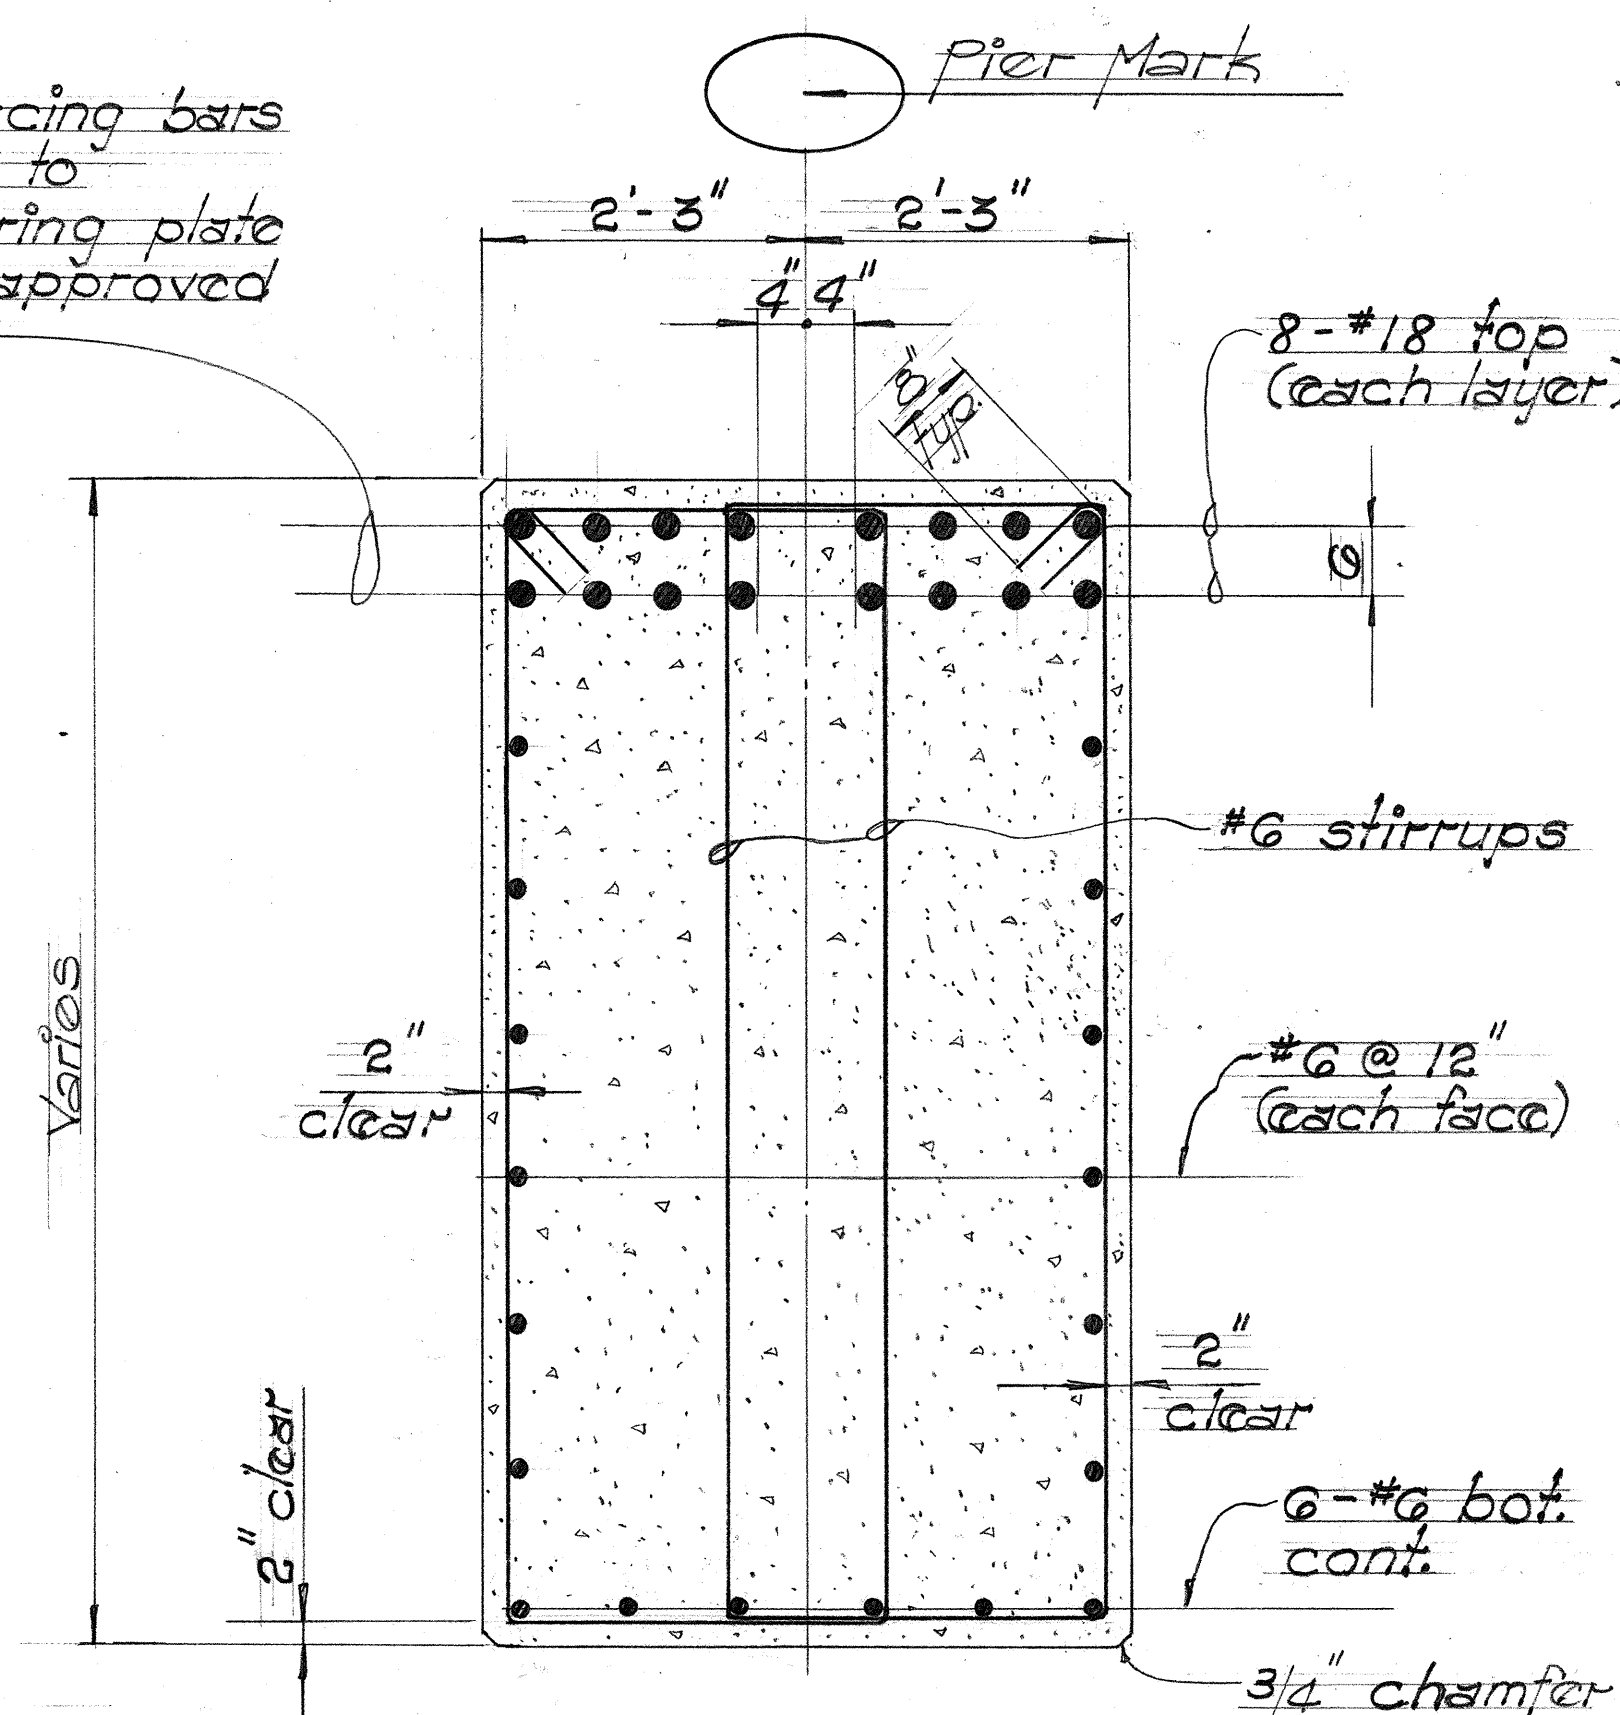


DIAGRAM CONC. STRENGTH D  
(AT 28 DAYS) 5-19-57

PIER CAP NOTES:

SECTION C  
5-17 5-17

Scale:  $3/4" = 1'-0"$

1. All reinforcing steel except stirrups shall be grade 60.
2. Concrete strength @ 28 days.  
 $f'_c = 4,000$  psi.  
See concrete strength diagram this sheet.

# SECTION



Scale:  $3/4" = 1'-0"$

A  
S-17 S-17

## SECTION

Scale:  $3/4" = 1'-0"$

5-17 5-17

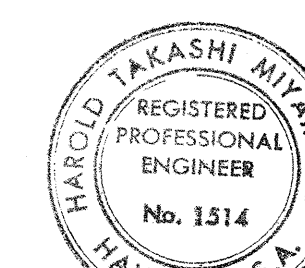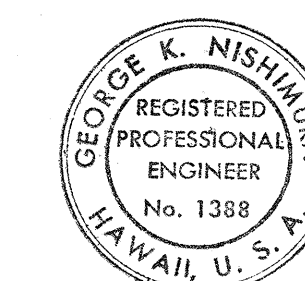

THIS WORK WAS PREPARED BY ME  
OR UNDER MY SUPERVISION.

THIS WORK WAS PREPARED BY                       
OR UNDER MY SUPERVISION                     

STATE OF HAWAII  
DEPARTMENT OF TRANSPORTATION  
HIGHWAYS DIVISION

NIMITZ CONNECTOR (EB)  
RAMP "A" AND RAMP "B"

PIER CAP REINFORCING DETAILS

KEELHI INTERCHANGE  
FAT PROJ NO THIT (168) 17

SCALE: AS SHOWN      DATE: JULY, 1981

SHEET No. 5-17 OF 49 SHEETS






| FED. ROAD DIST. NO. | STATE | FED. AID PROJ. NO. | FISCAL YEAR | SHEET NO. | TOTAL SHEETS |
|---------------------|-------|--------------------|-------------|-----------|--------------|
| HAWAII              | HAW.  | 1-H1-(168)17       | 1982        | 100       | 145          |

Column Reinf. Sym. Abt. & Bridge

Column Reinf. Sym. Abt. & Bridge

Col. Sym. Abt. & Bridge

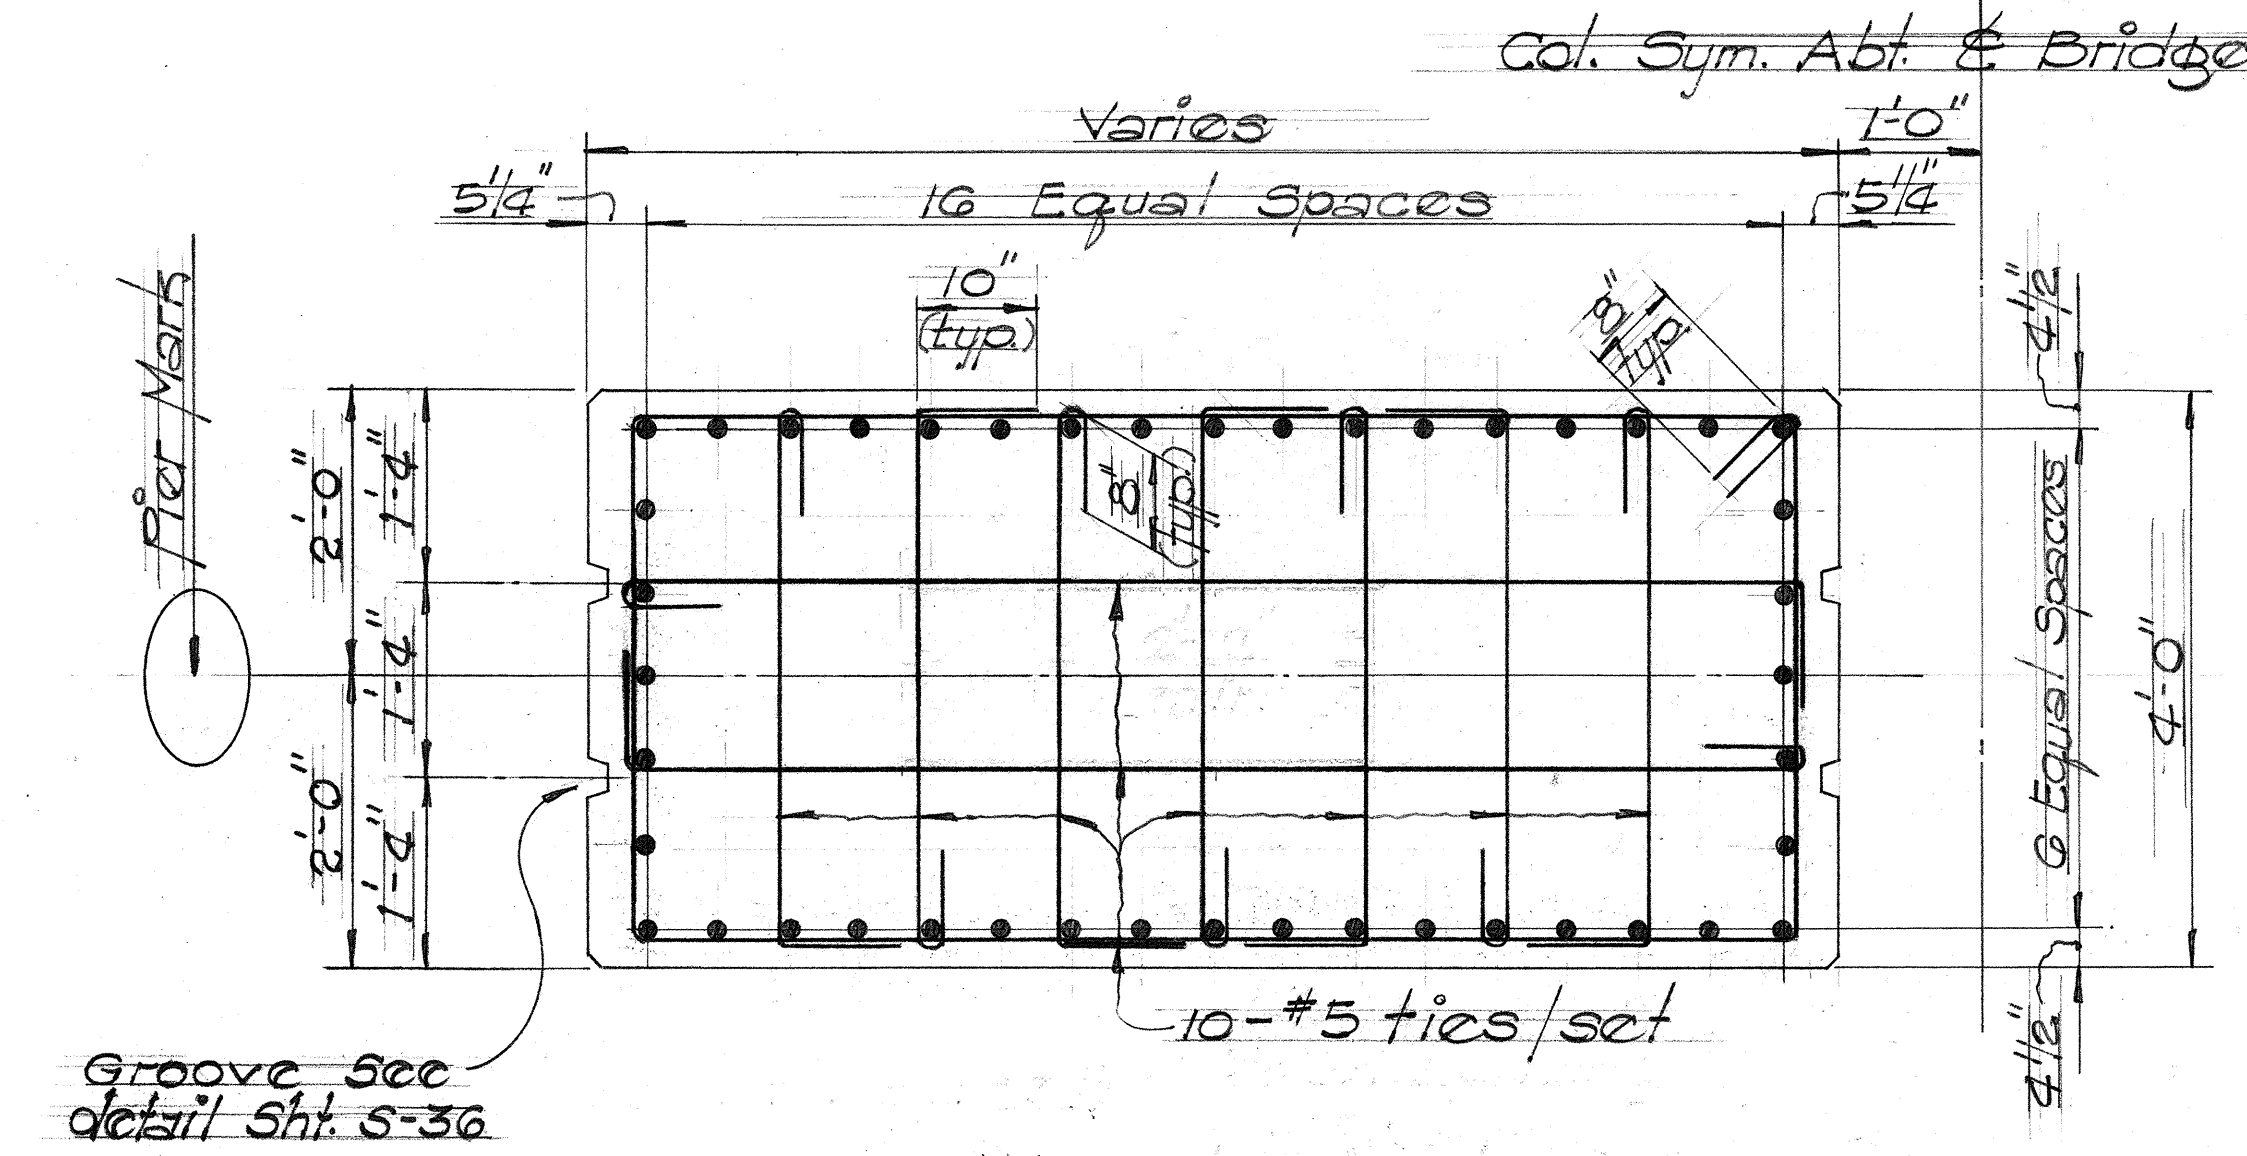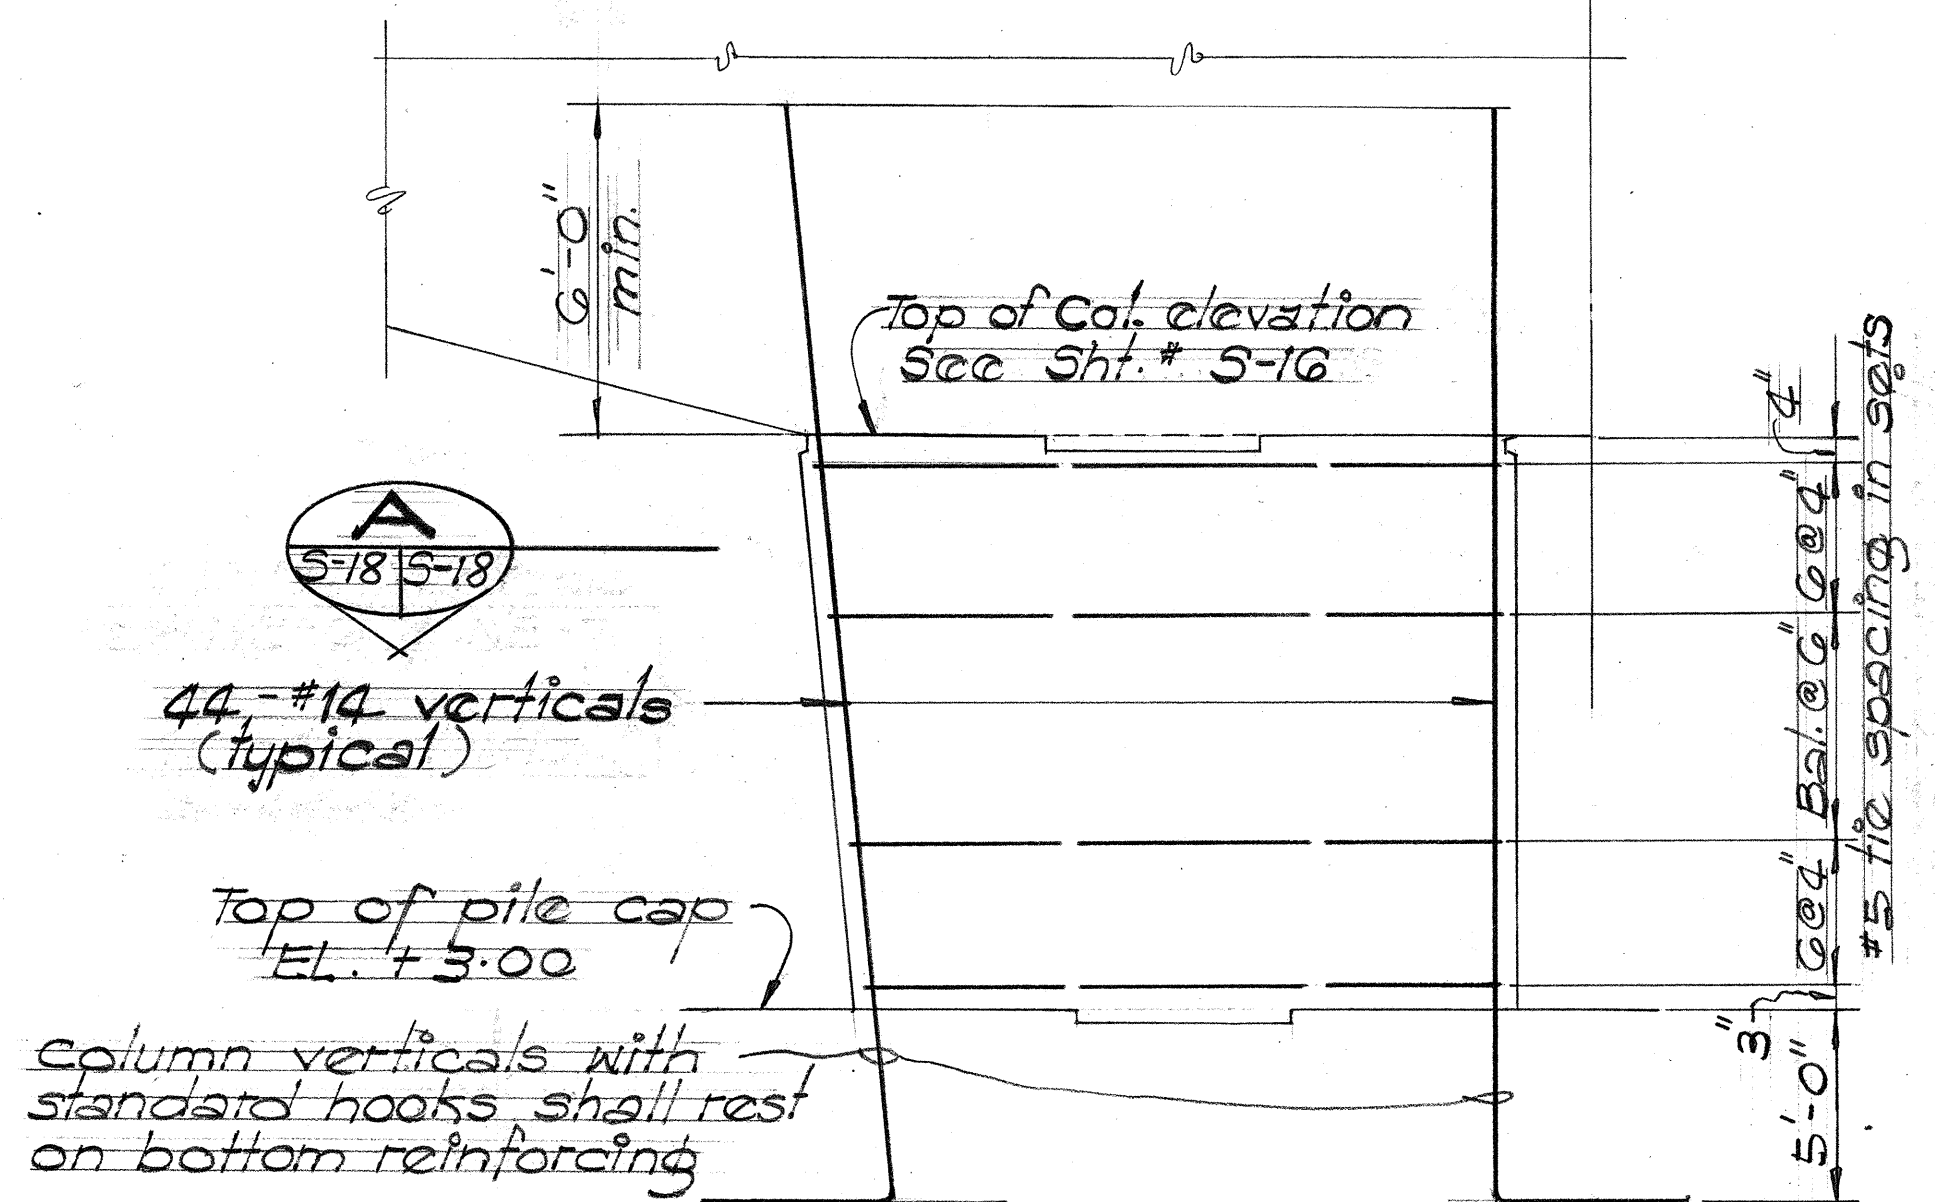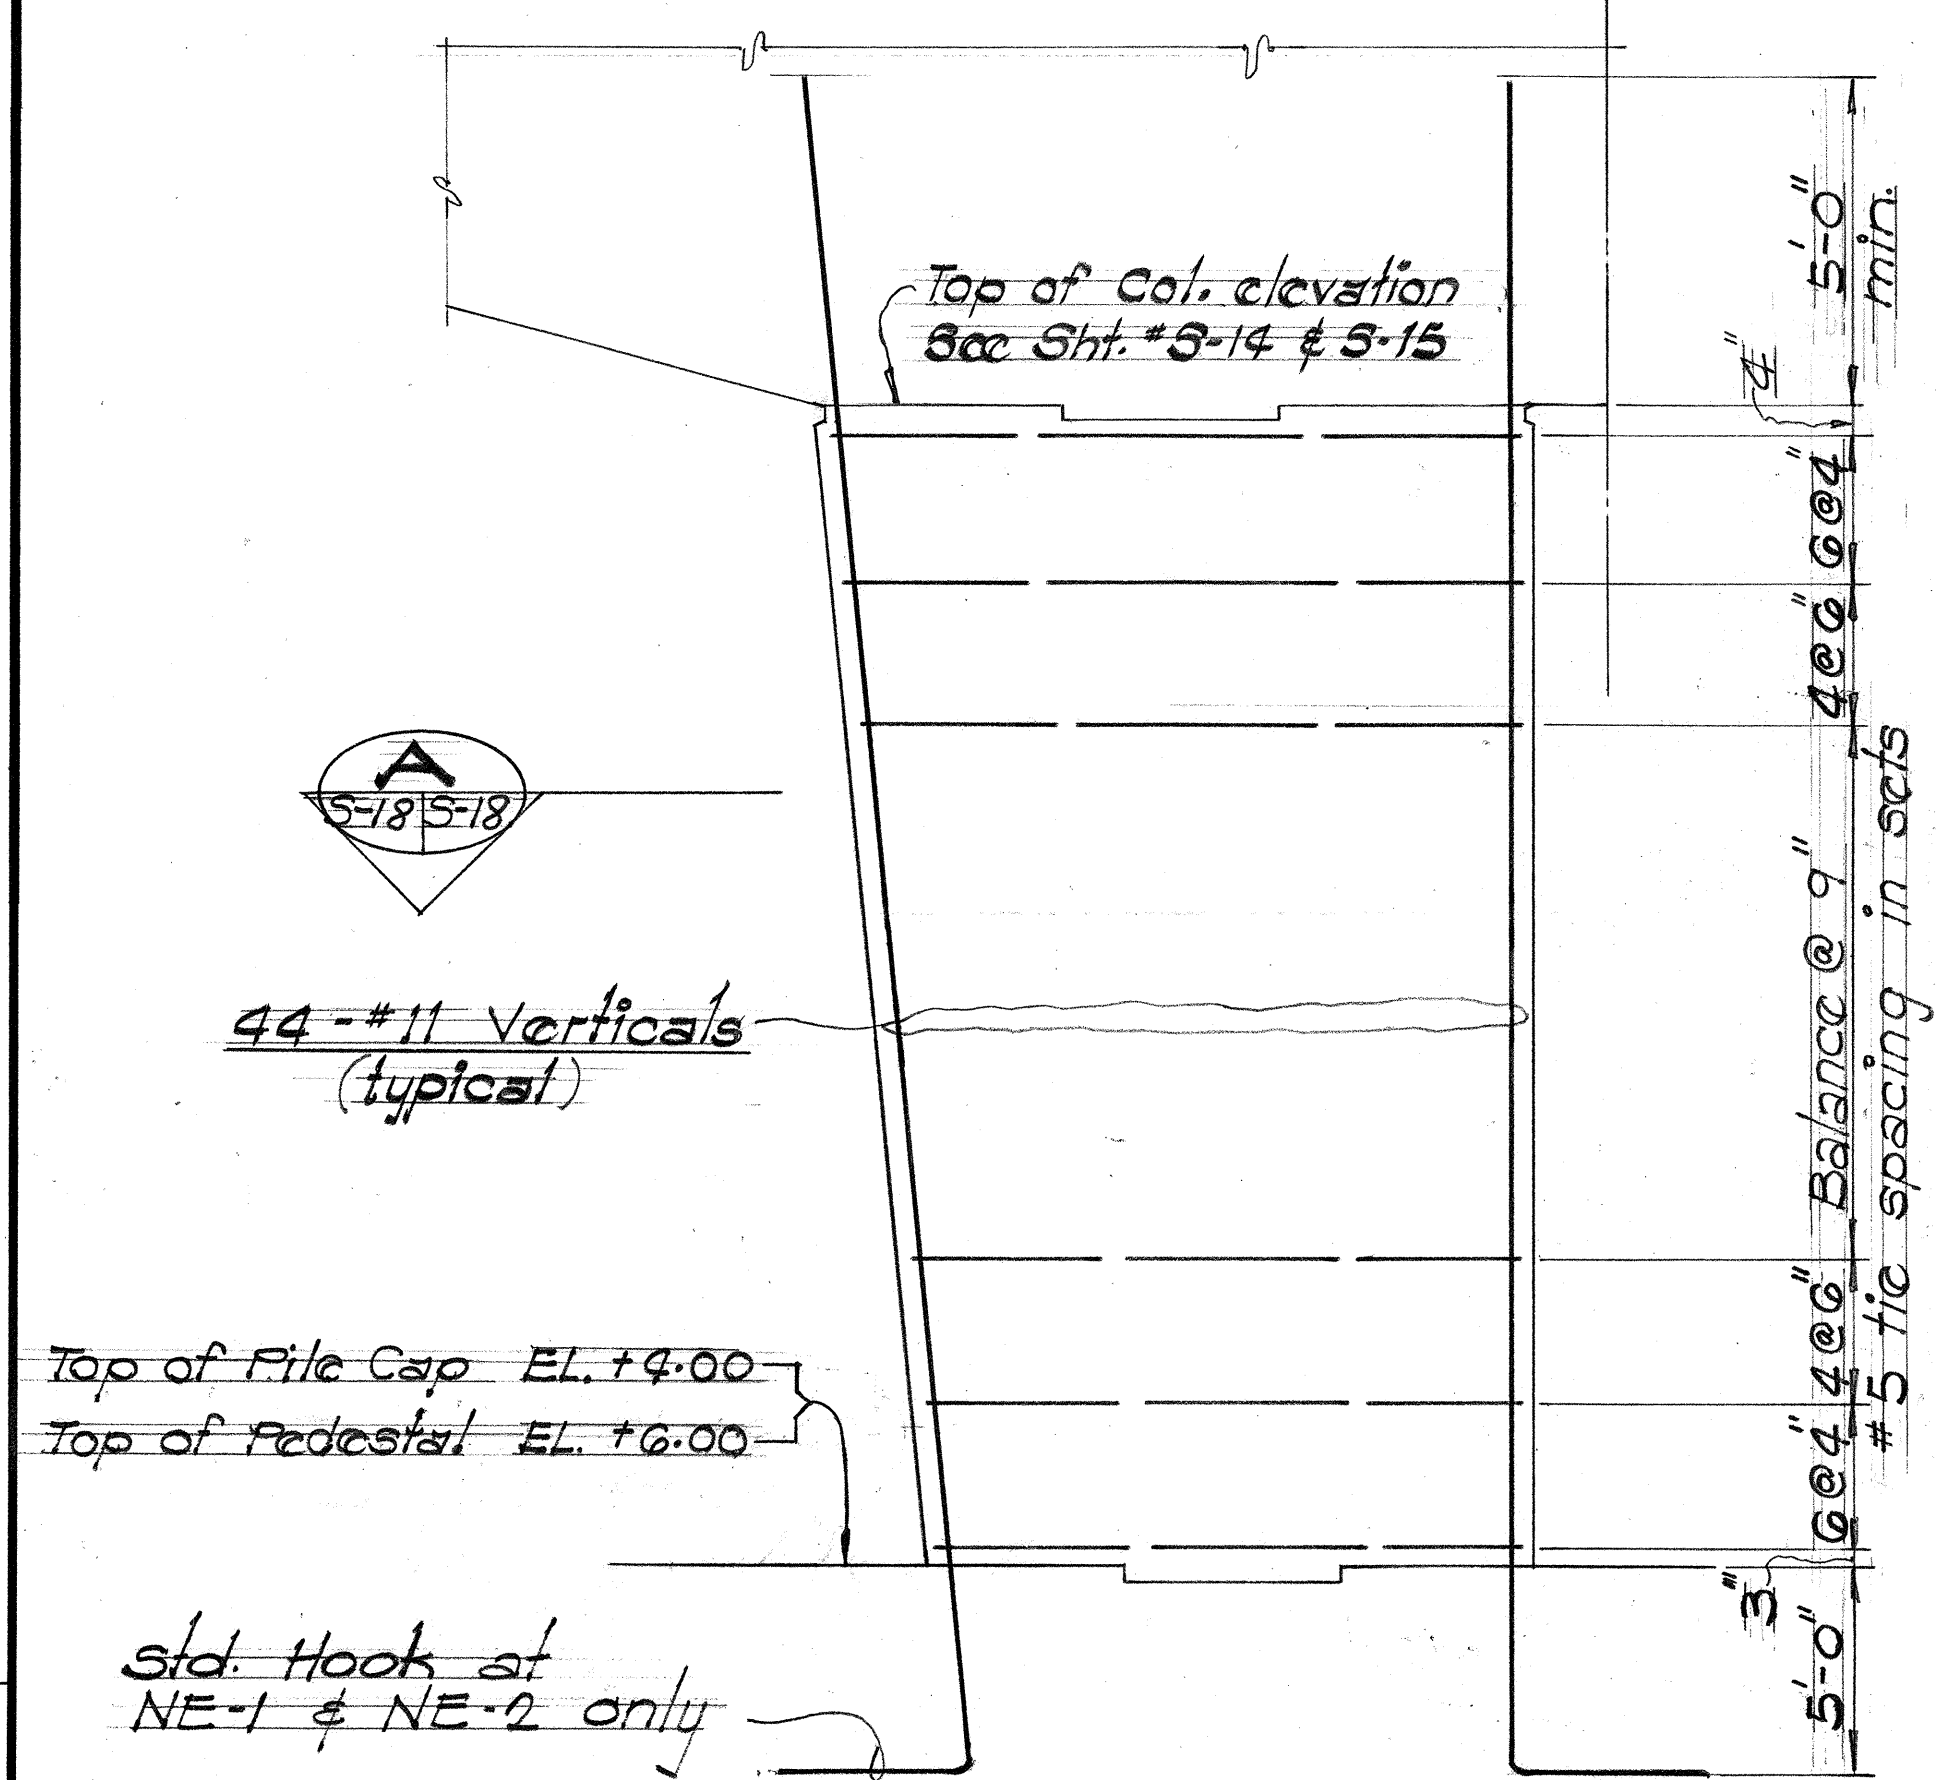

**COLUMN REINFORCING**

**PIERS NE-1, NE-2, NE-3, NE-4, NE-5**  
N.T.S.


**COLUMN REINFORCING**

**PIERS NE-6, NE-7, NE-8**  
N.T.S.

**COLUMN AND PEDESTAL NOTES:**

- All reinforcing steel except ties shall be grade 60.
- Concrete strength @ 28 days,  $f'_c = 4,000$  psi. See conc. strength diagram (S-18, S-19).

Reinf. Sym. Abt. & Bridge

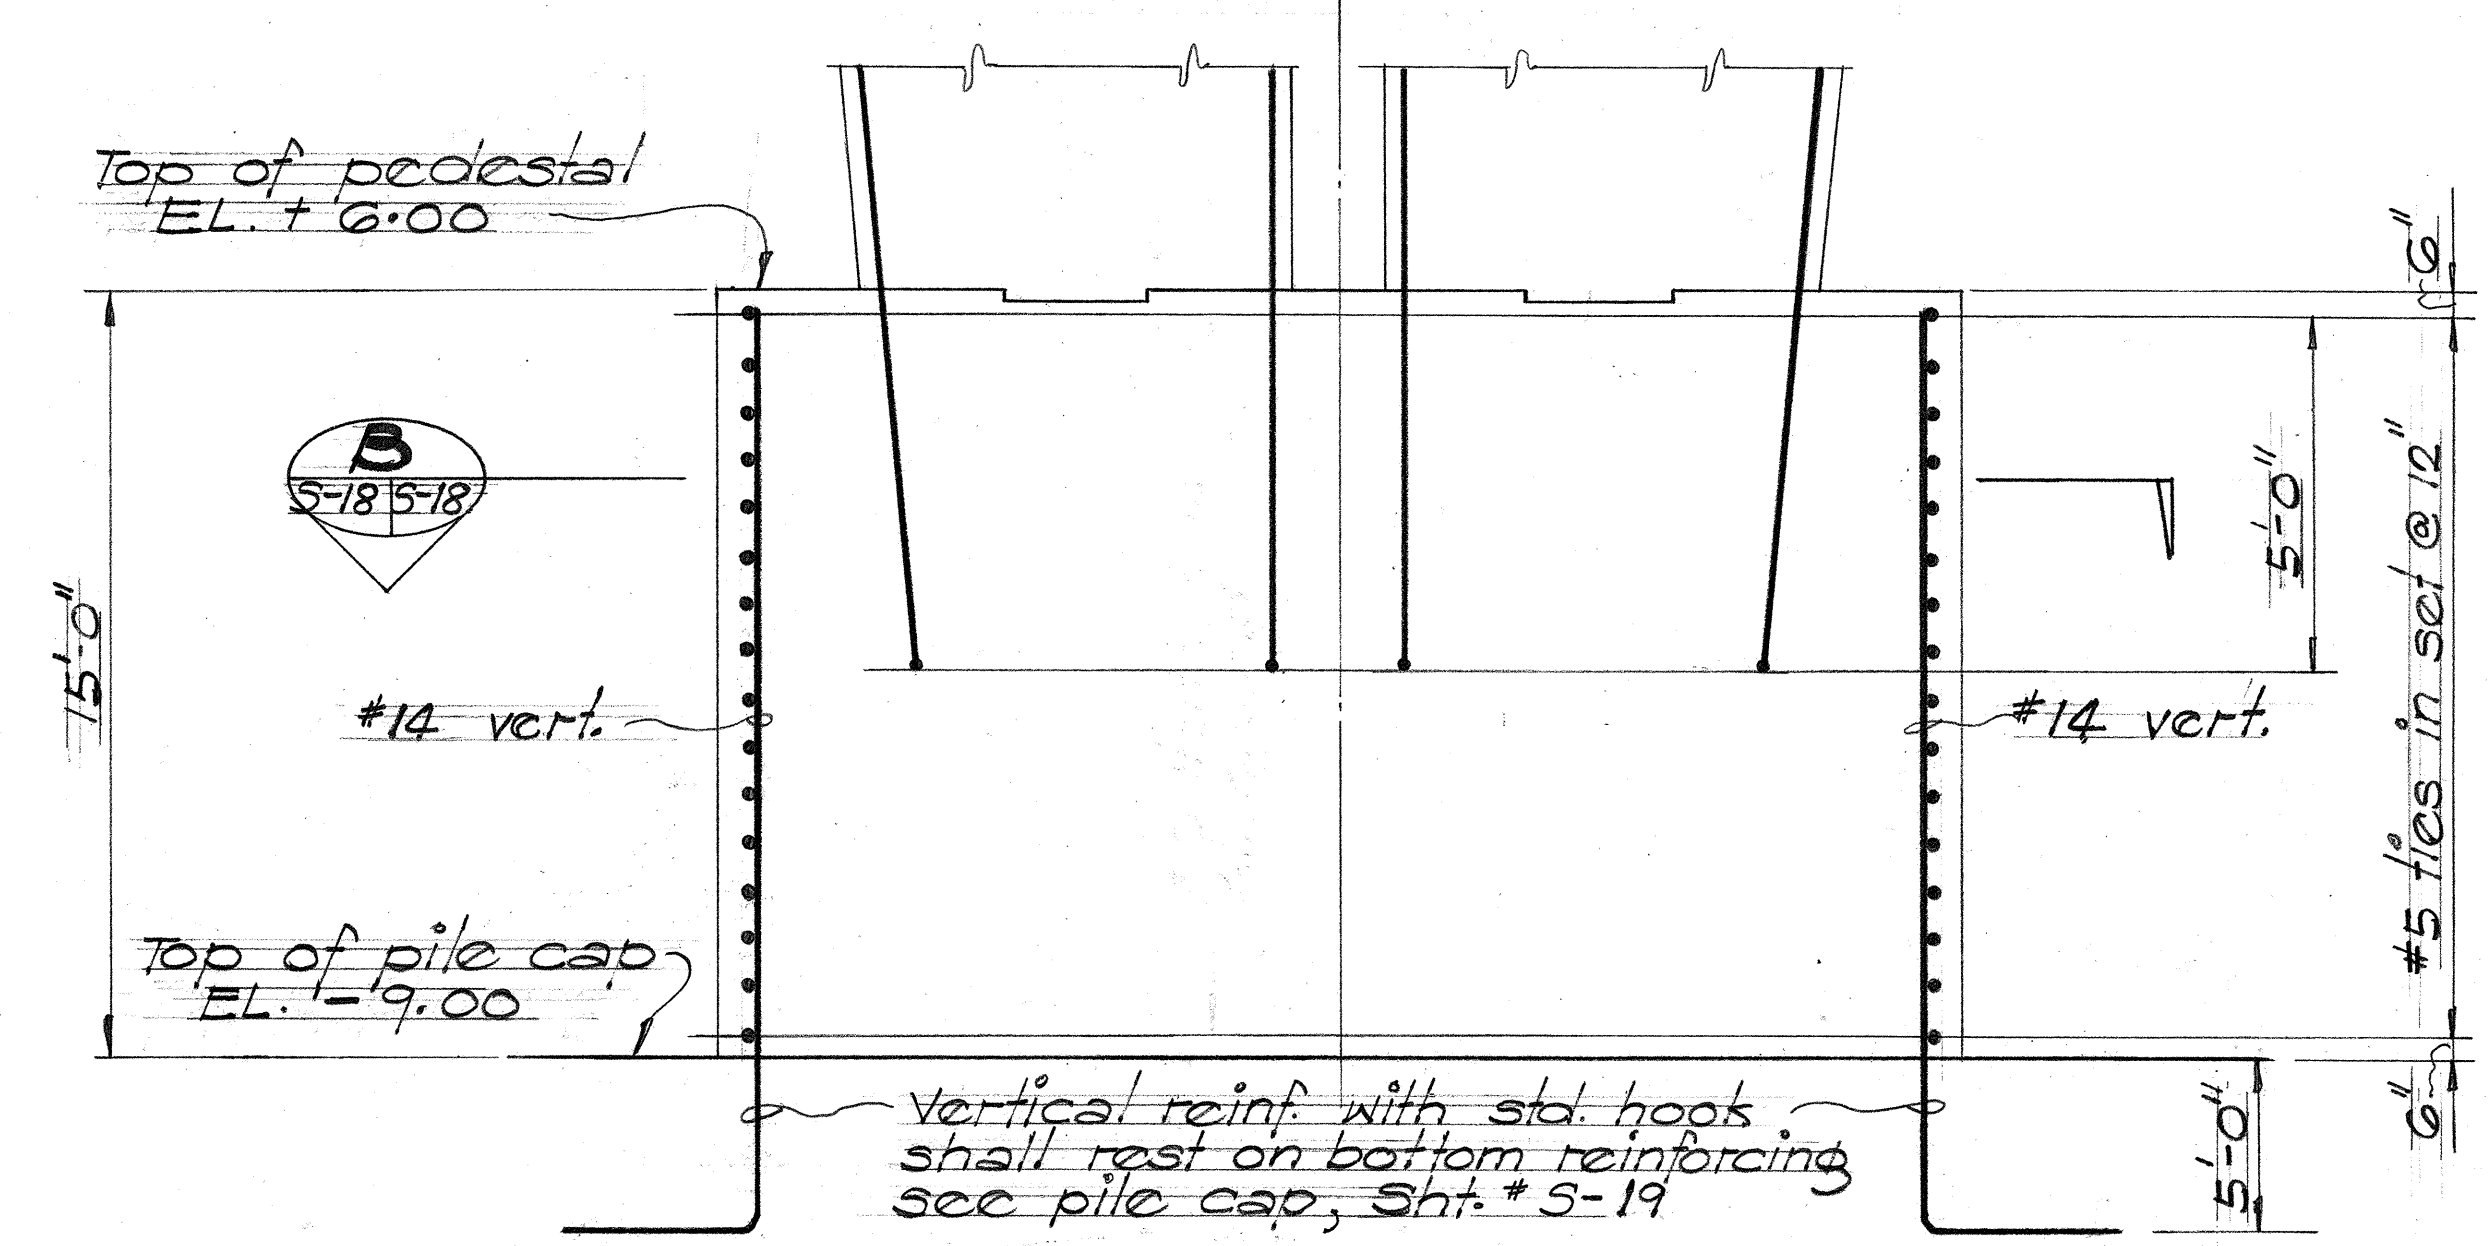

**PEDESTAL REINFORCING**

**PIERS NE-3, NE-4, NE-5**  
Scale: 1/4" = 1'-0"


**44 - VERTICALS**

**SECTION A**

Scale: 3/4" = 1'-0"

S-18, S-19

Pedestal Sym. Abt. & Bridge

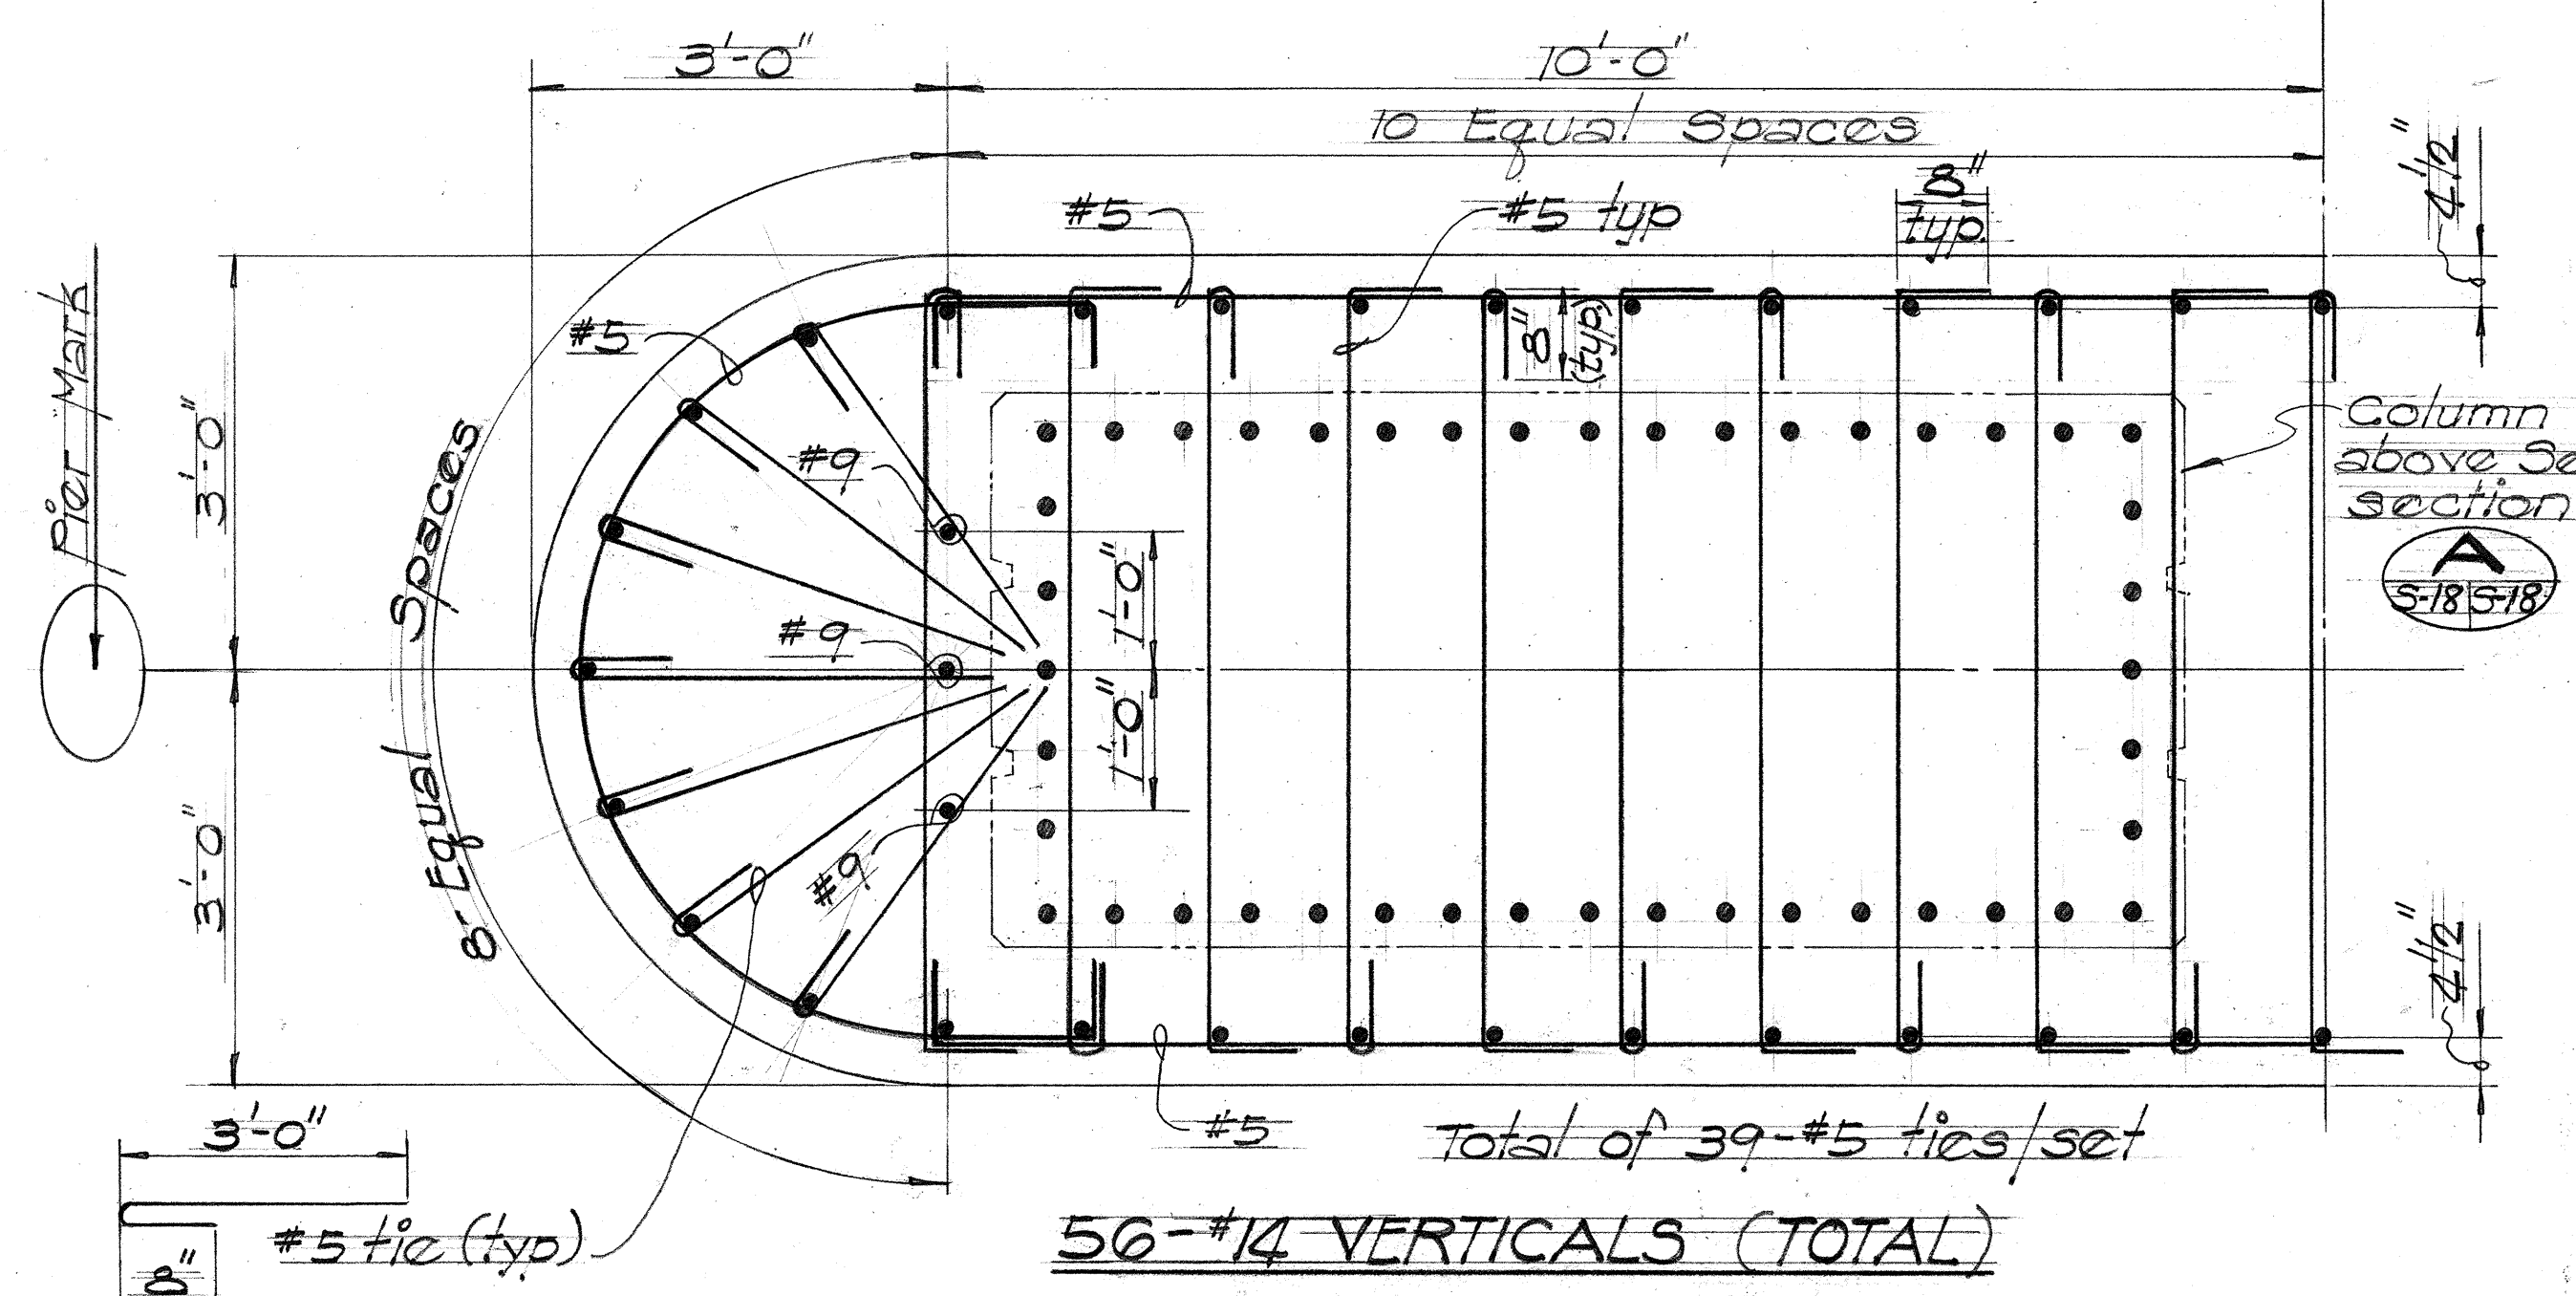


**56 - #14 VERTICALS (TOTAL)**

**SECTION B**

Scale: 3/4" = 1'-0"

S-15, S-18, S-19

|                   |      |
|-------------------|------|
| SURVEY PLOTTED BY | DATE |
| DRAWN BY          |      |
| DESIGNED BY       |      |
| NOTED BY          |      |
| CHECKED BY        |      |

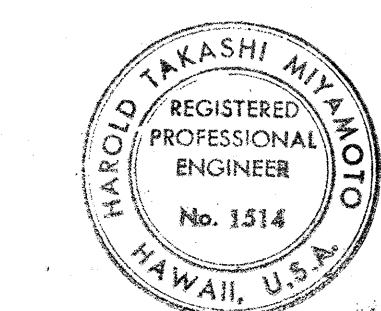



THIS WORK WAS PREPARED BY ME OR UNDER MY SUPERVISION

STATE OF HAWAII  
DEPARTMENT OF TRANSPORTATION  
HIGHWAYS DIVISION



**NIMITZ CONNECTOR (EB)**  
**RAMP "A" AND RAMP "B"**  
PIERS NE-1 THRU NE-8 COLUMN  
AND PEDESTAL REINFORCING DETAILS  
KEEHI INTERCHANGE  
FAI PROJ. NO. H11 (168) 17  
SCALE: AS SHOWN DATE: JULY, 1981  
SHEET NO. 18 OF 49 SHEETS



| FED. ROAD DIST. NO. | STATE | FED. AID PROJ. NO. | FISCAL YEAR | SHEET NO. | TOTAL SHEETS |
|---------------------|-------|--------------------|-------------|-----------|--------------|
| HAWAII              | HAW.  | 1-HI-1(168)17      | 1982        | 101       | 145          |

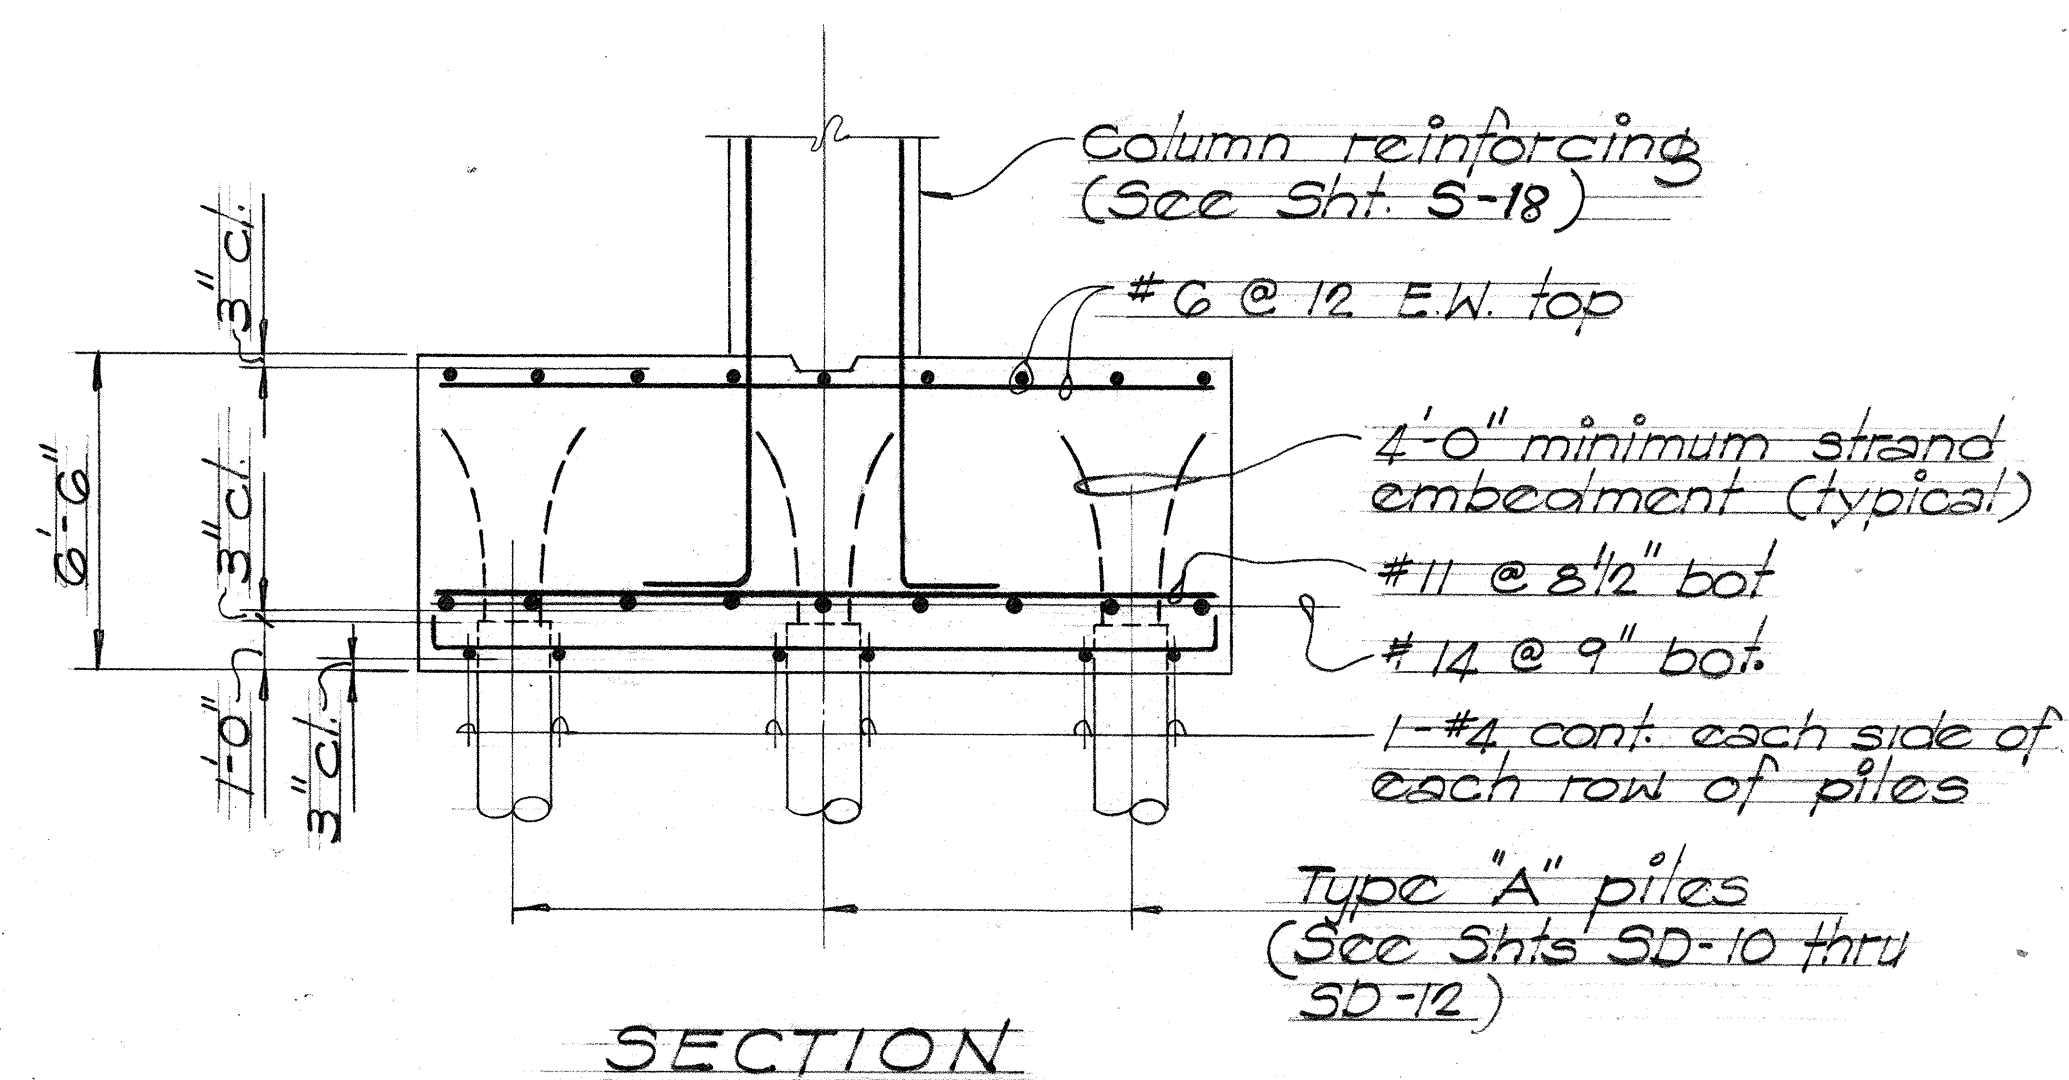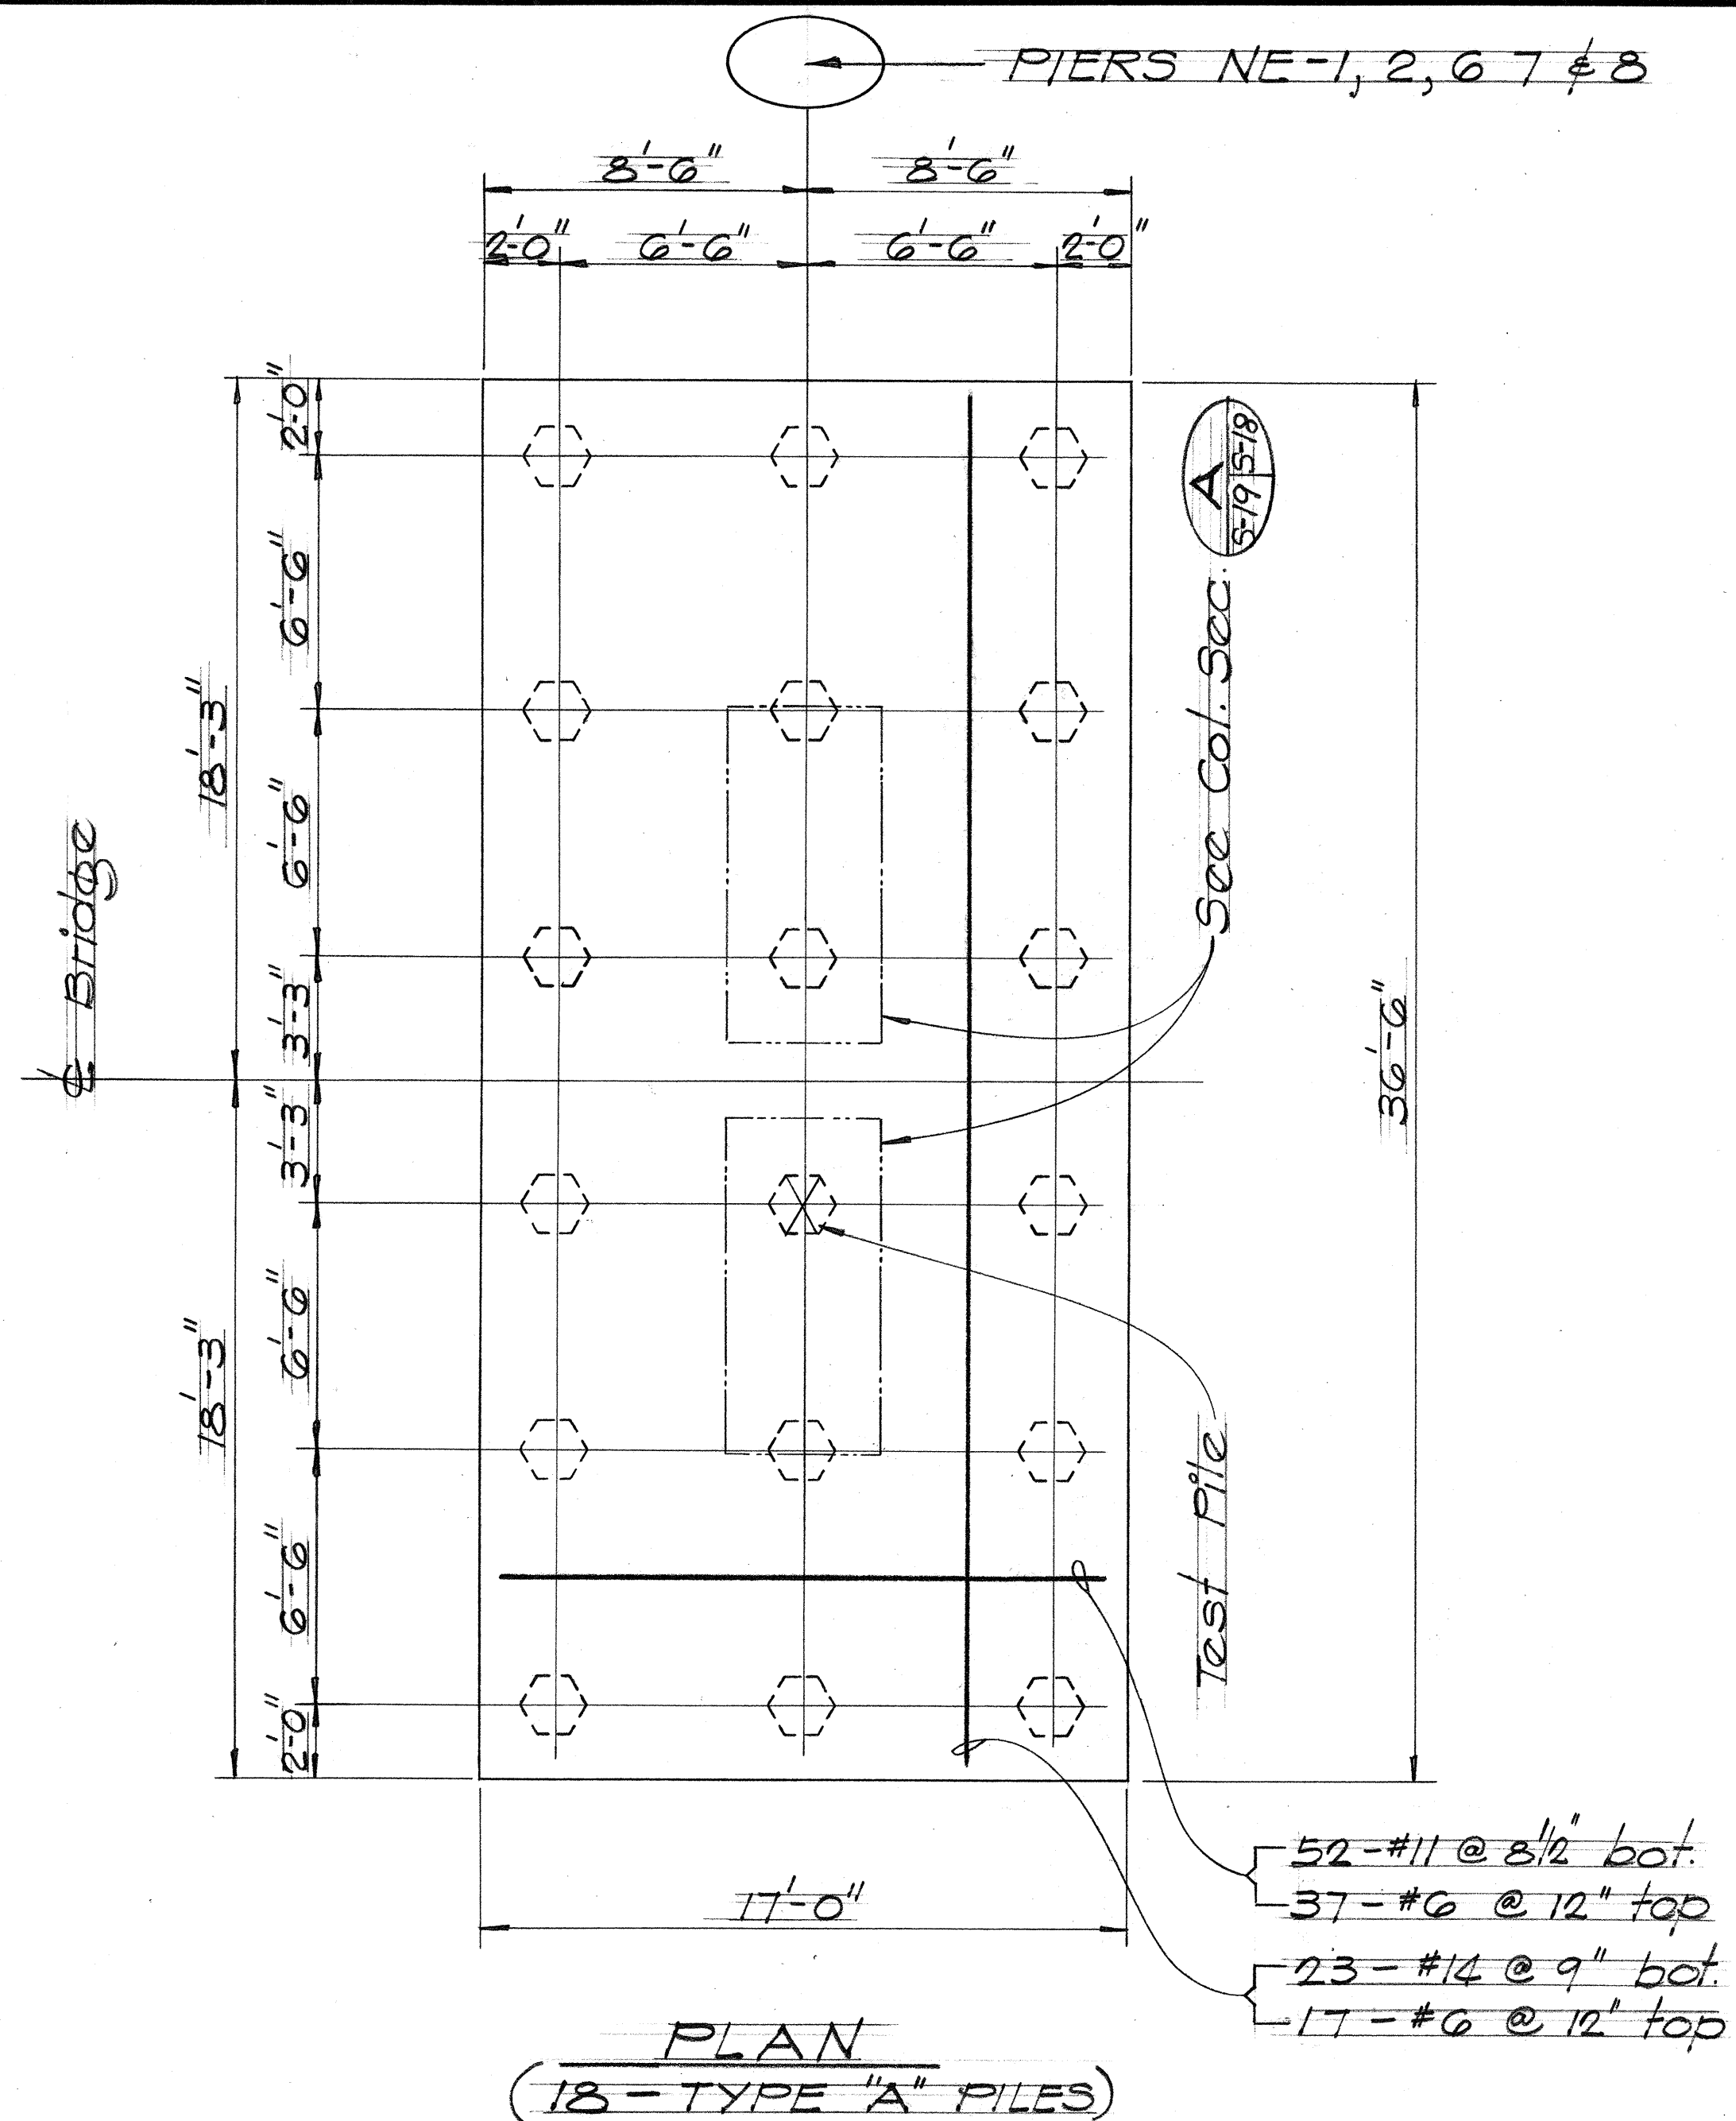


PILE CAPS NE-1 NE-2 NE-6 NE-7 NE-8  
Scale: 1/4" = 1'-0"

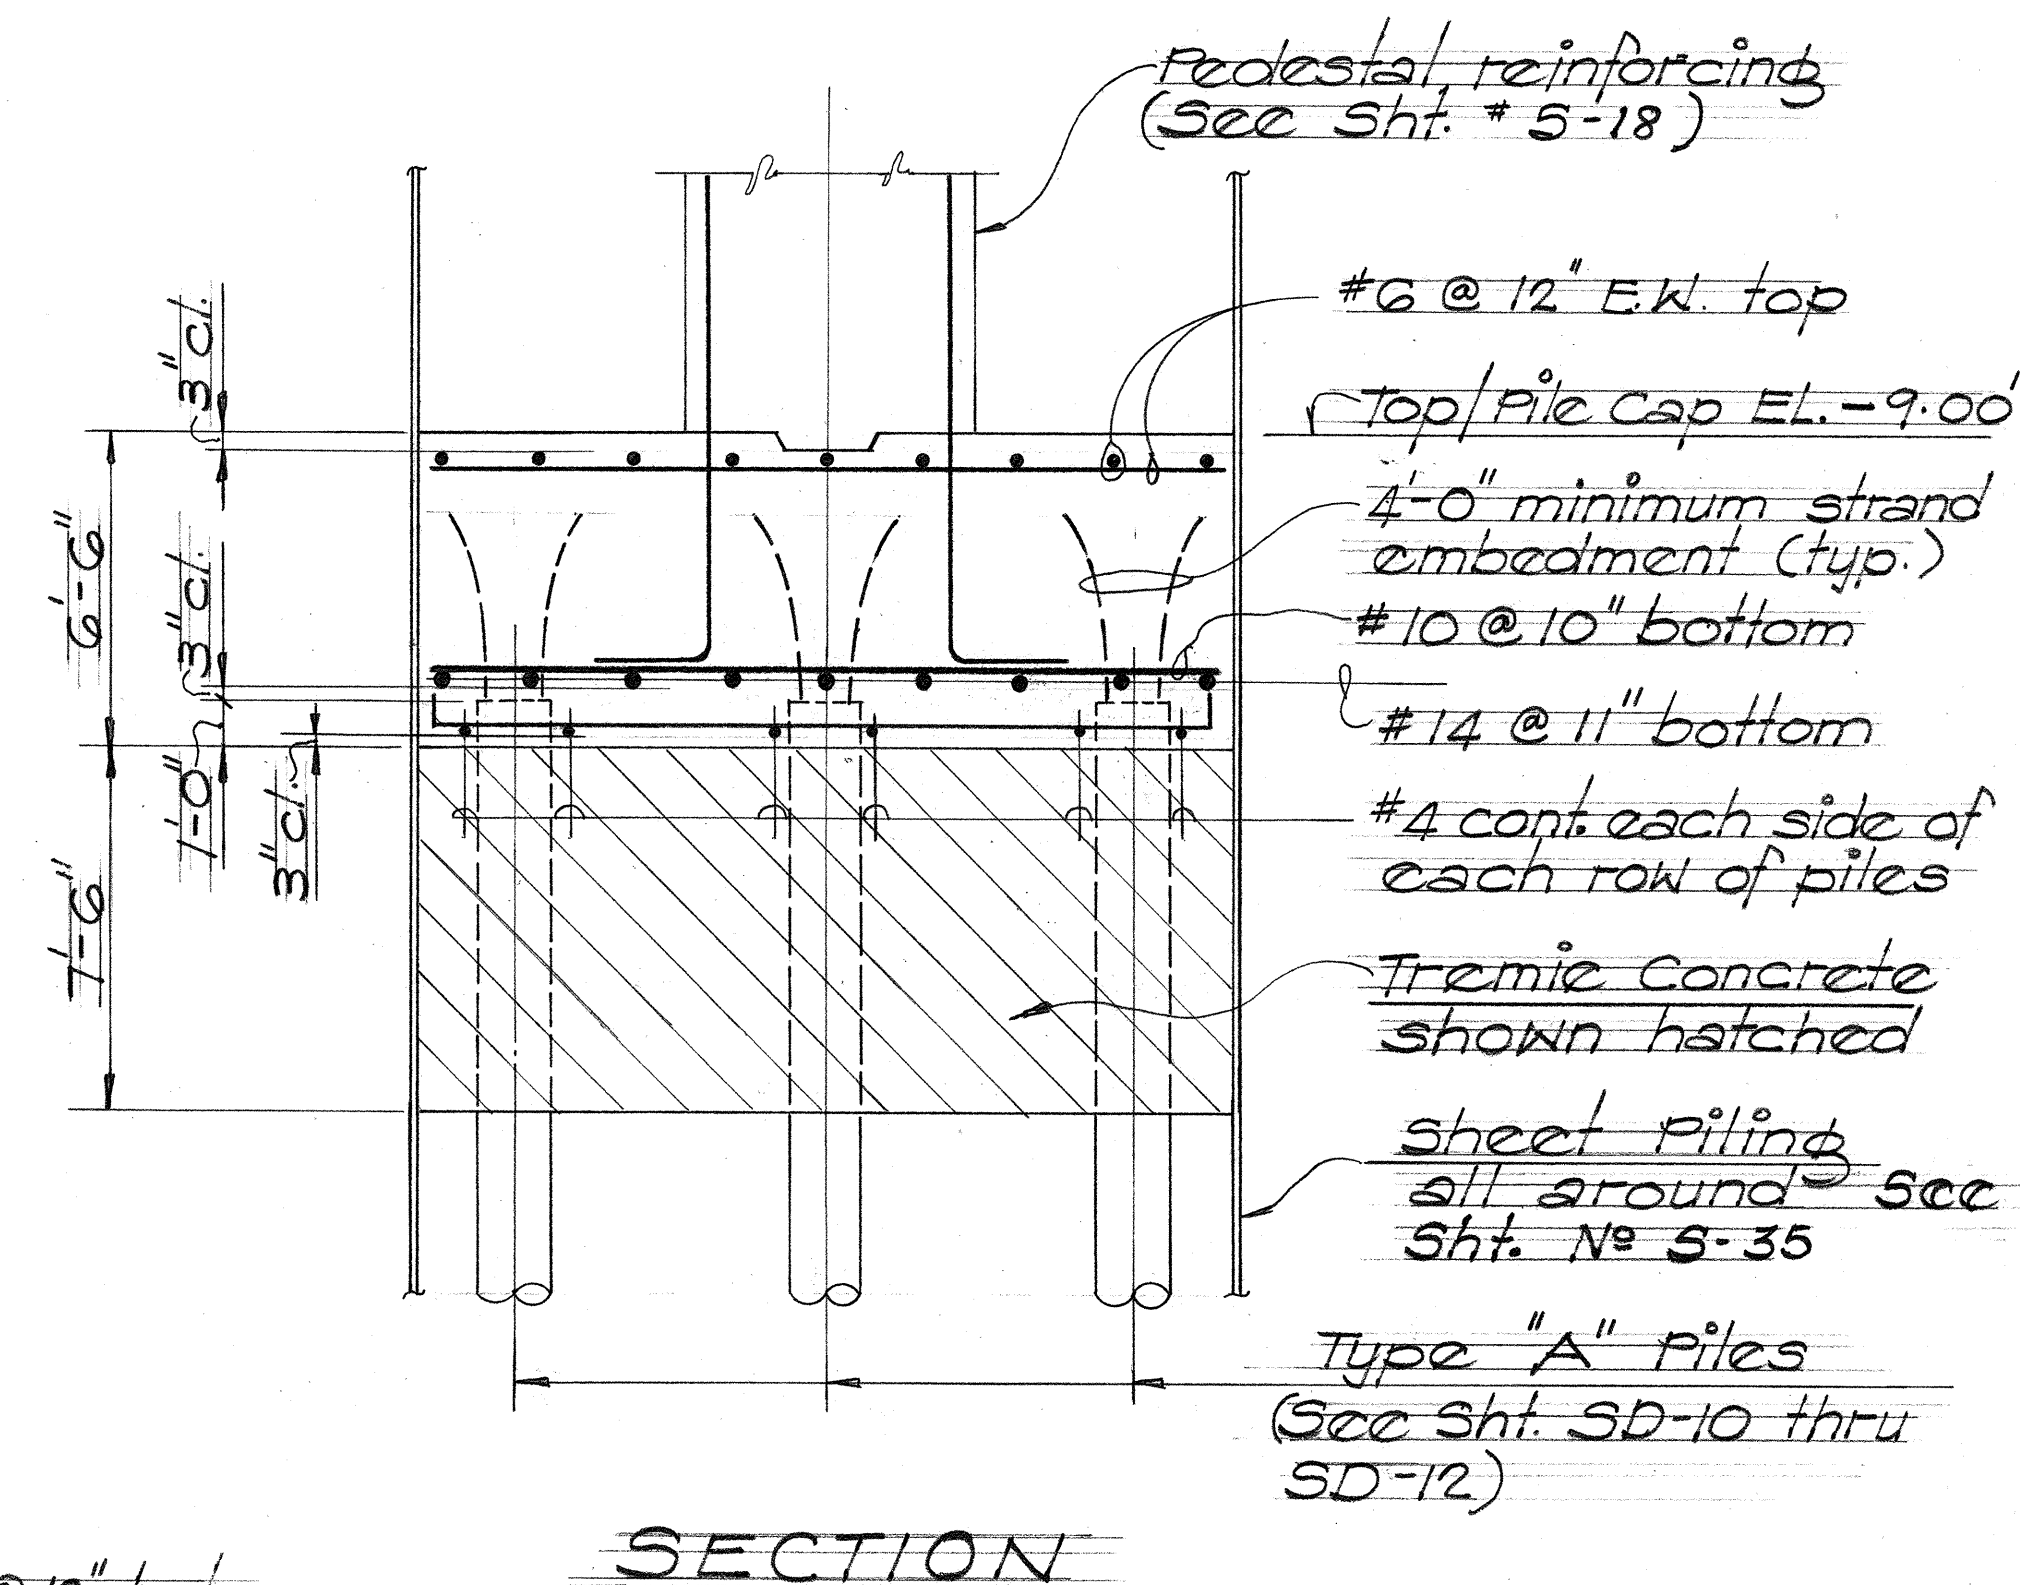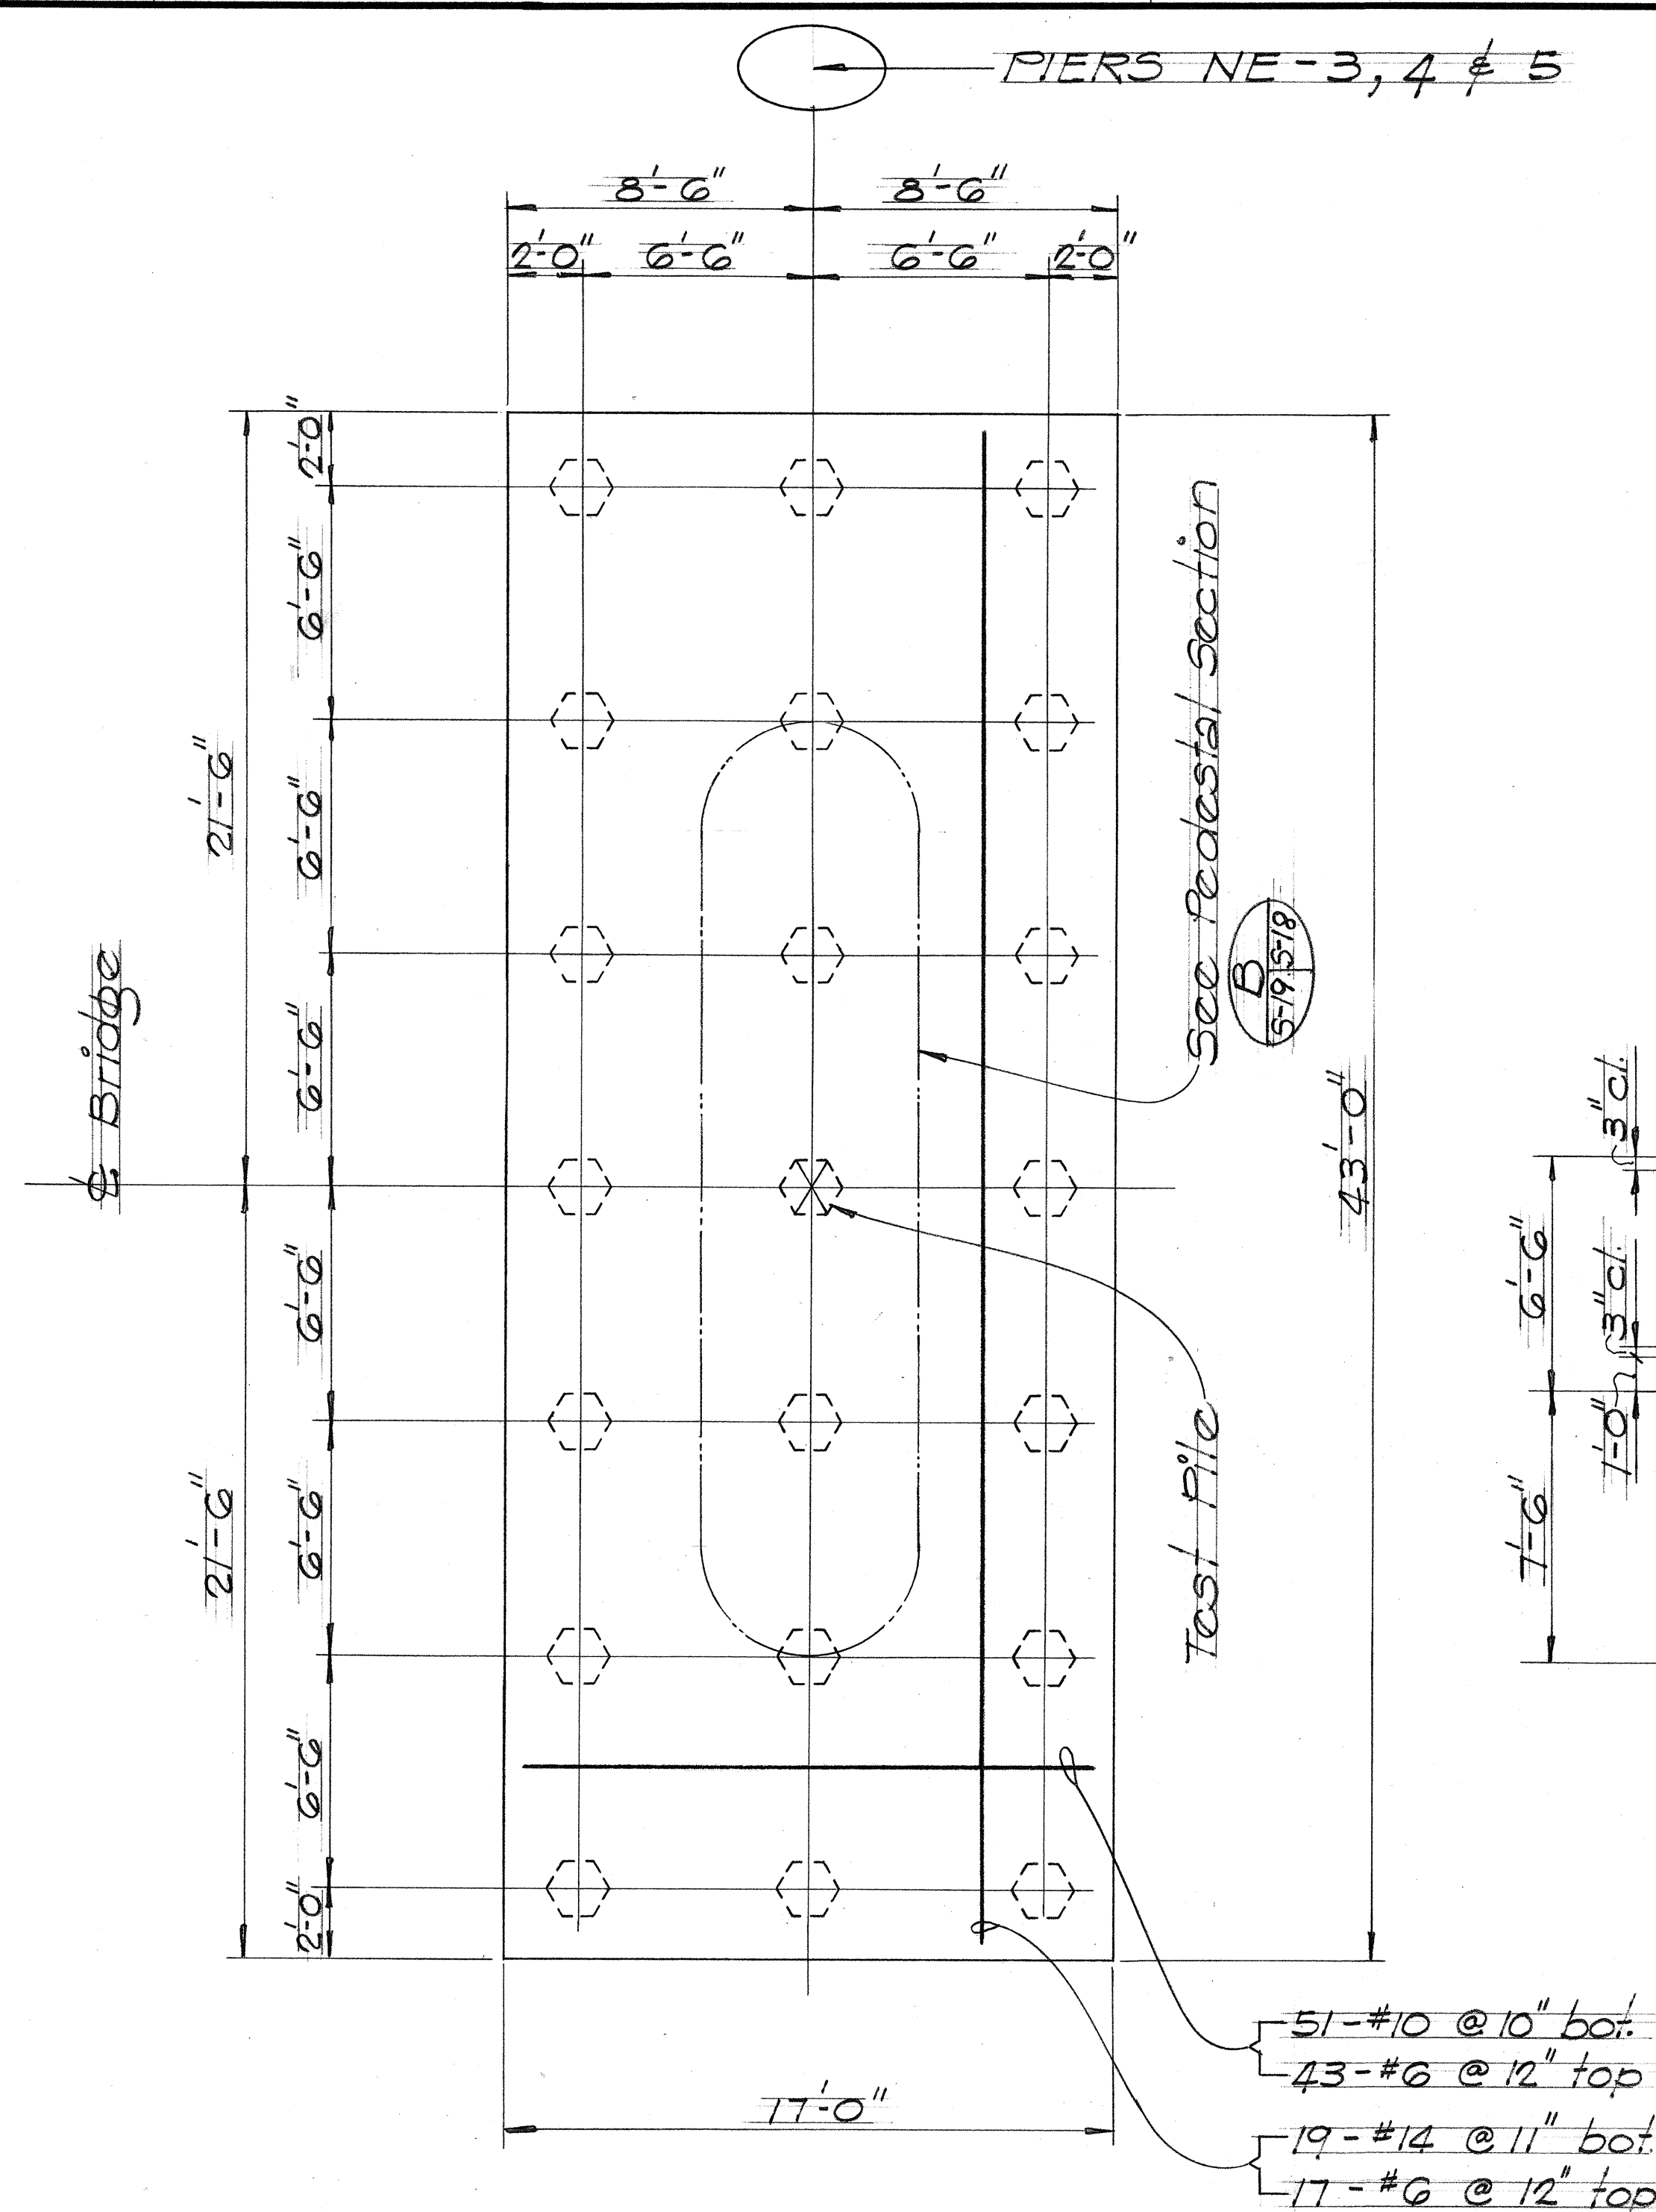

PILE CAPS NE-3 NE-4 NE-5  
Scale: 1/4" = 1'-0"


PILE CAP NOTES:

- Reinforcing steel shall be grade 60.
- Concrete strength @ 28 days,  $f'_c = 3,000$  psi.  
See conc. strength diagram D 5/9/5/17

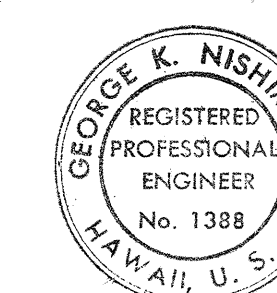

THIS WORK WAS PREPARED BY ME OR UNDER MY SUPERVISION

*George K. Nishimura*

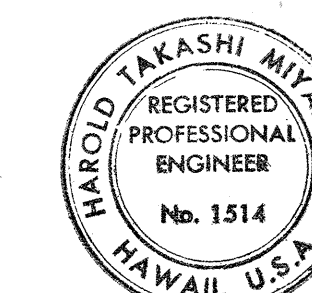


THIS WORK WAS PREPARED BY ME OR UNDER MY SUPERVISION

*Harold Takashi Miyamoto*


STATE OF HAWAII  
DEPARTMENT OF TRANSPORTATION  
HIGHWAYS DIVISION  
NIMITZ CONNECTOR (EB)  
RAMP "A" AND RAMP "B"  
NE-1 THRU NE-8 PILE CAP DETAILS  
KEEHI INTERCHANGE  
FAL PROJ. NO. 1-HI-1 (168) 17  
SCALE: AS SHOWN DATE: JULY, 1981  
SHEET NO. 5-19 OF 49 SHEETS




| FED. ROAD DIST. NO. | STATE | FED. AID PROJ. NO. | FISCAL YEAR | SHEET NO. | TOTAL SHEETS |
|---------------------|-------|--------------------|-------------|-----------|--------------|
| HAWAII              | HAW.  | 1-HI-1(68)17       | 1982        | 102       | 145          |

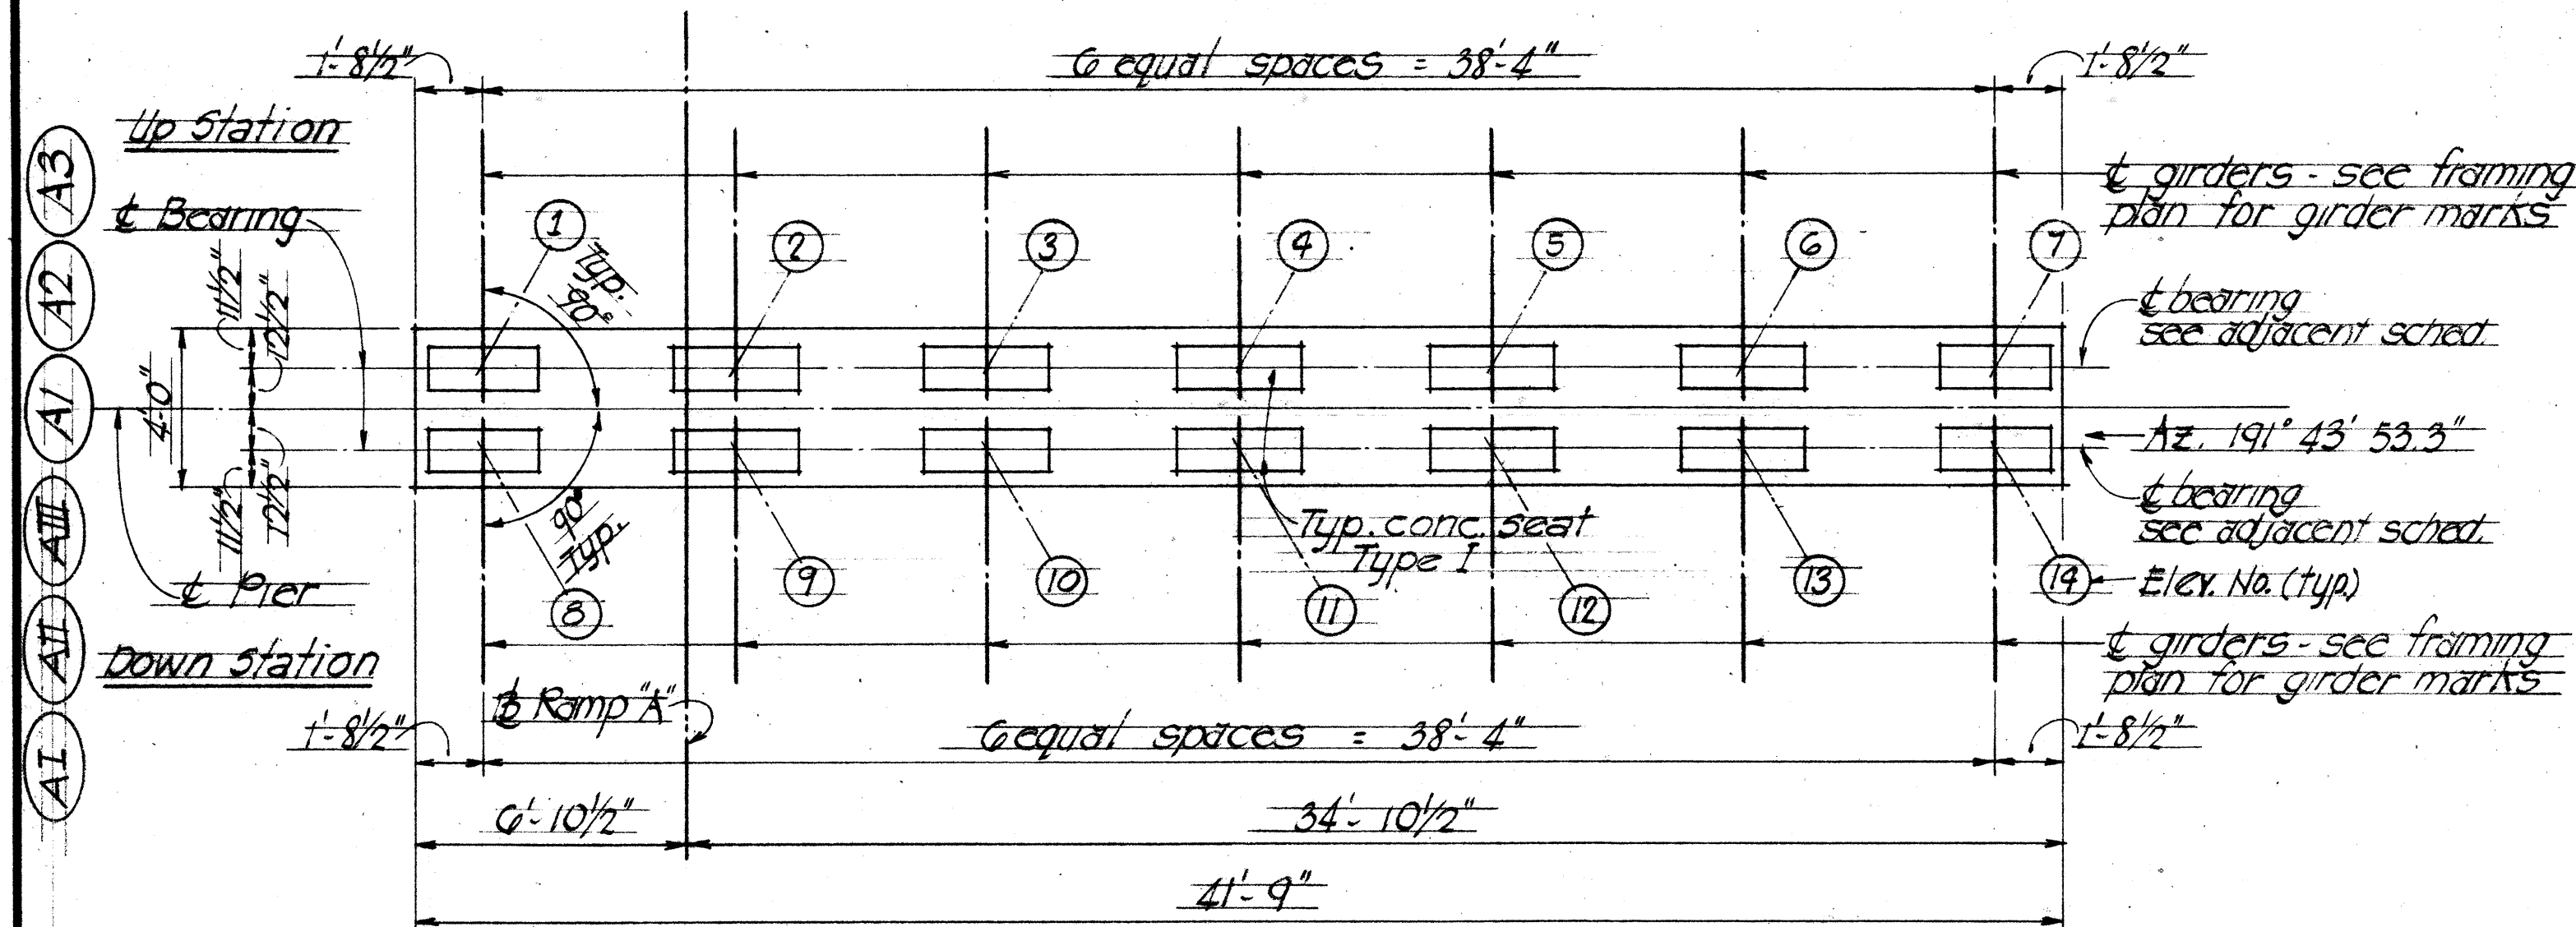

PLAN - PIERS A1, A2, A3, A-I, A-II & A-III  
Scale: 1/4" = 1'-0"

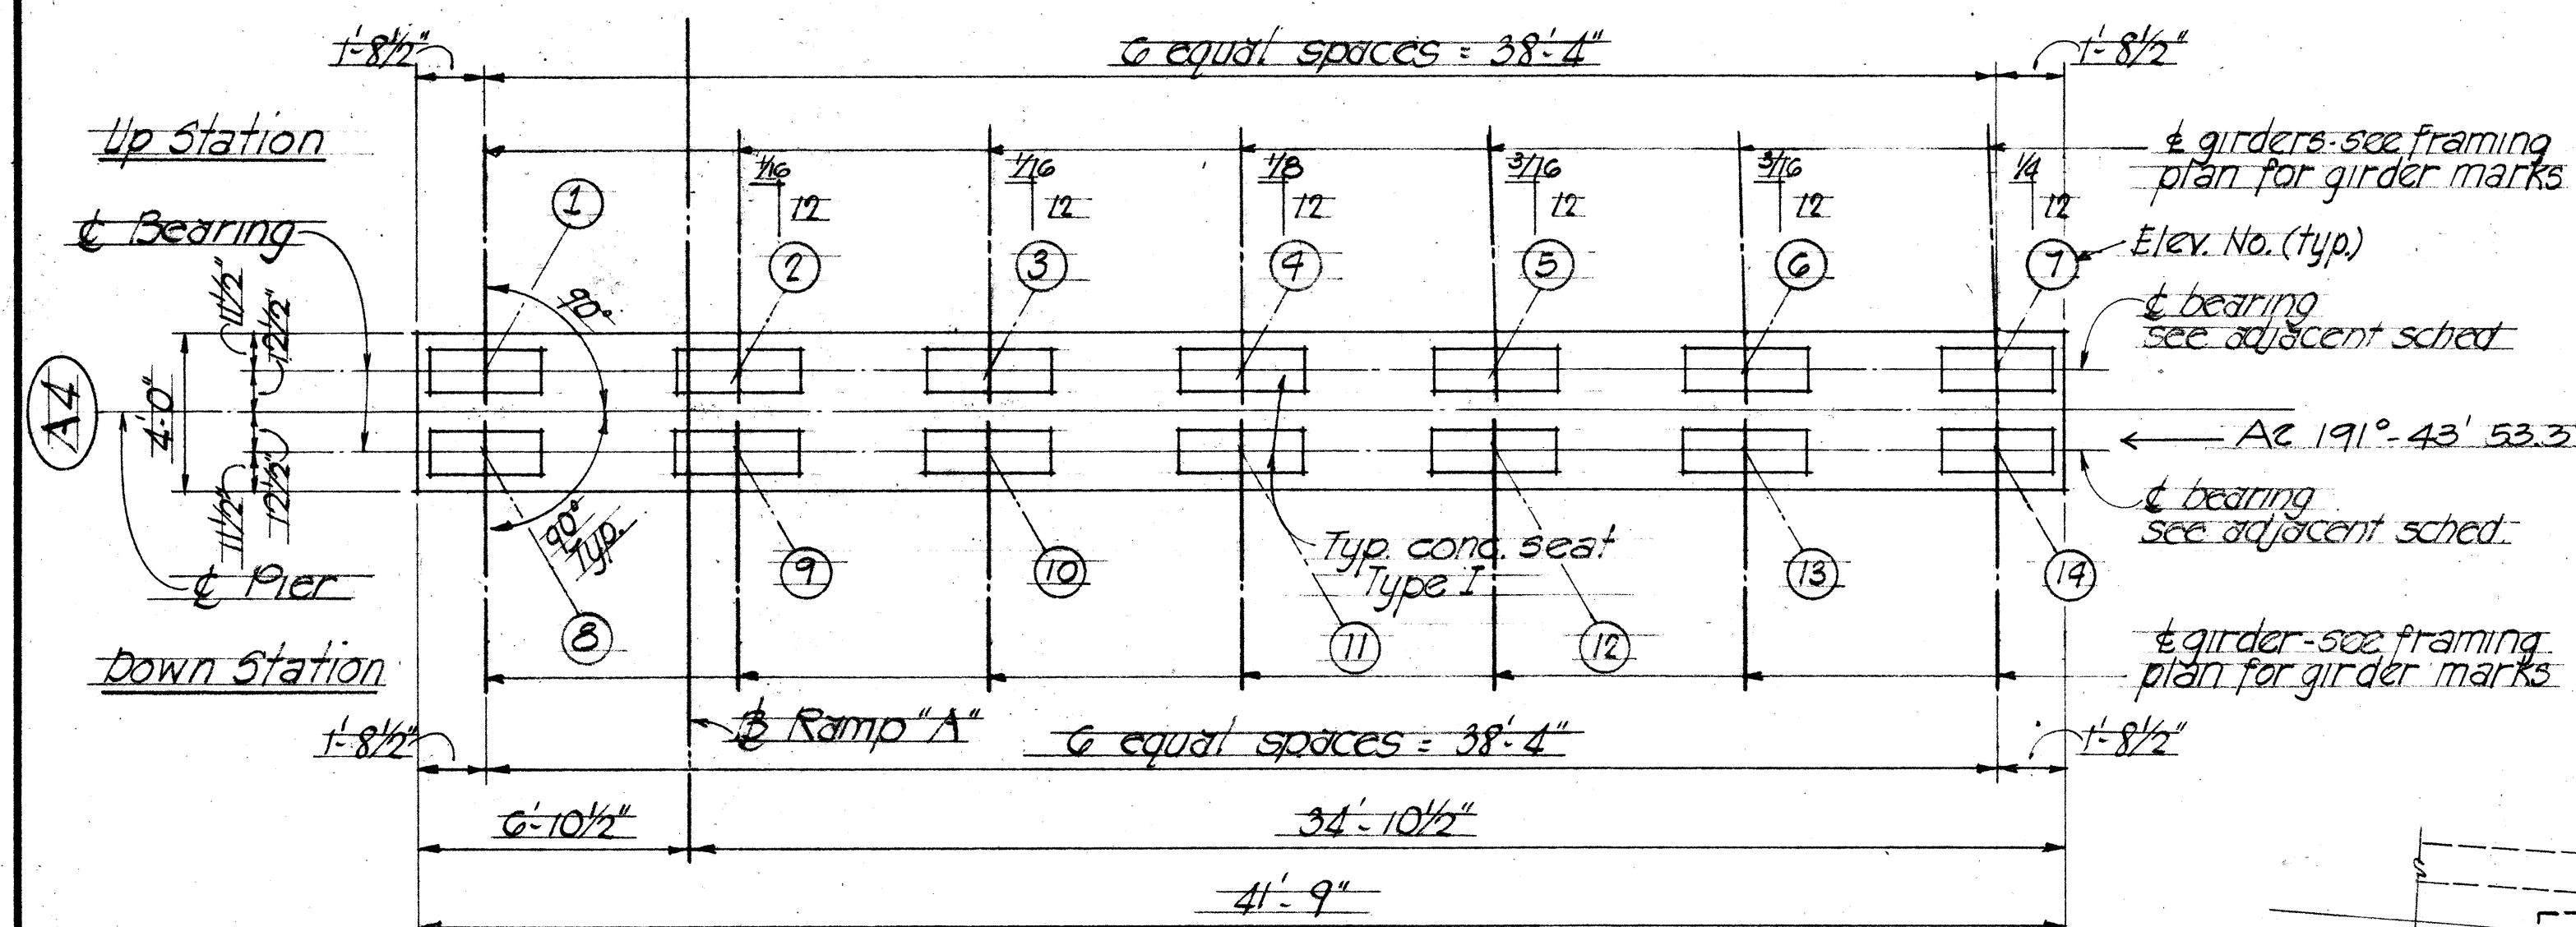


PLAN - PIER A4  
Scale: 1/4" = 1'-0"

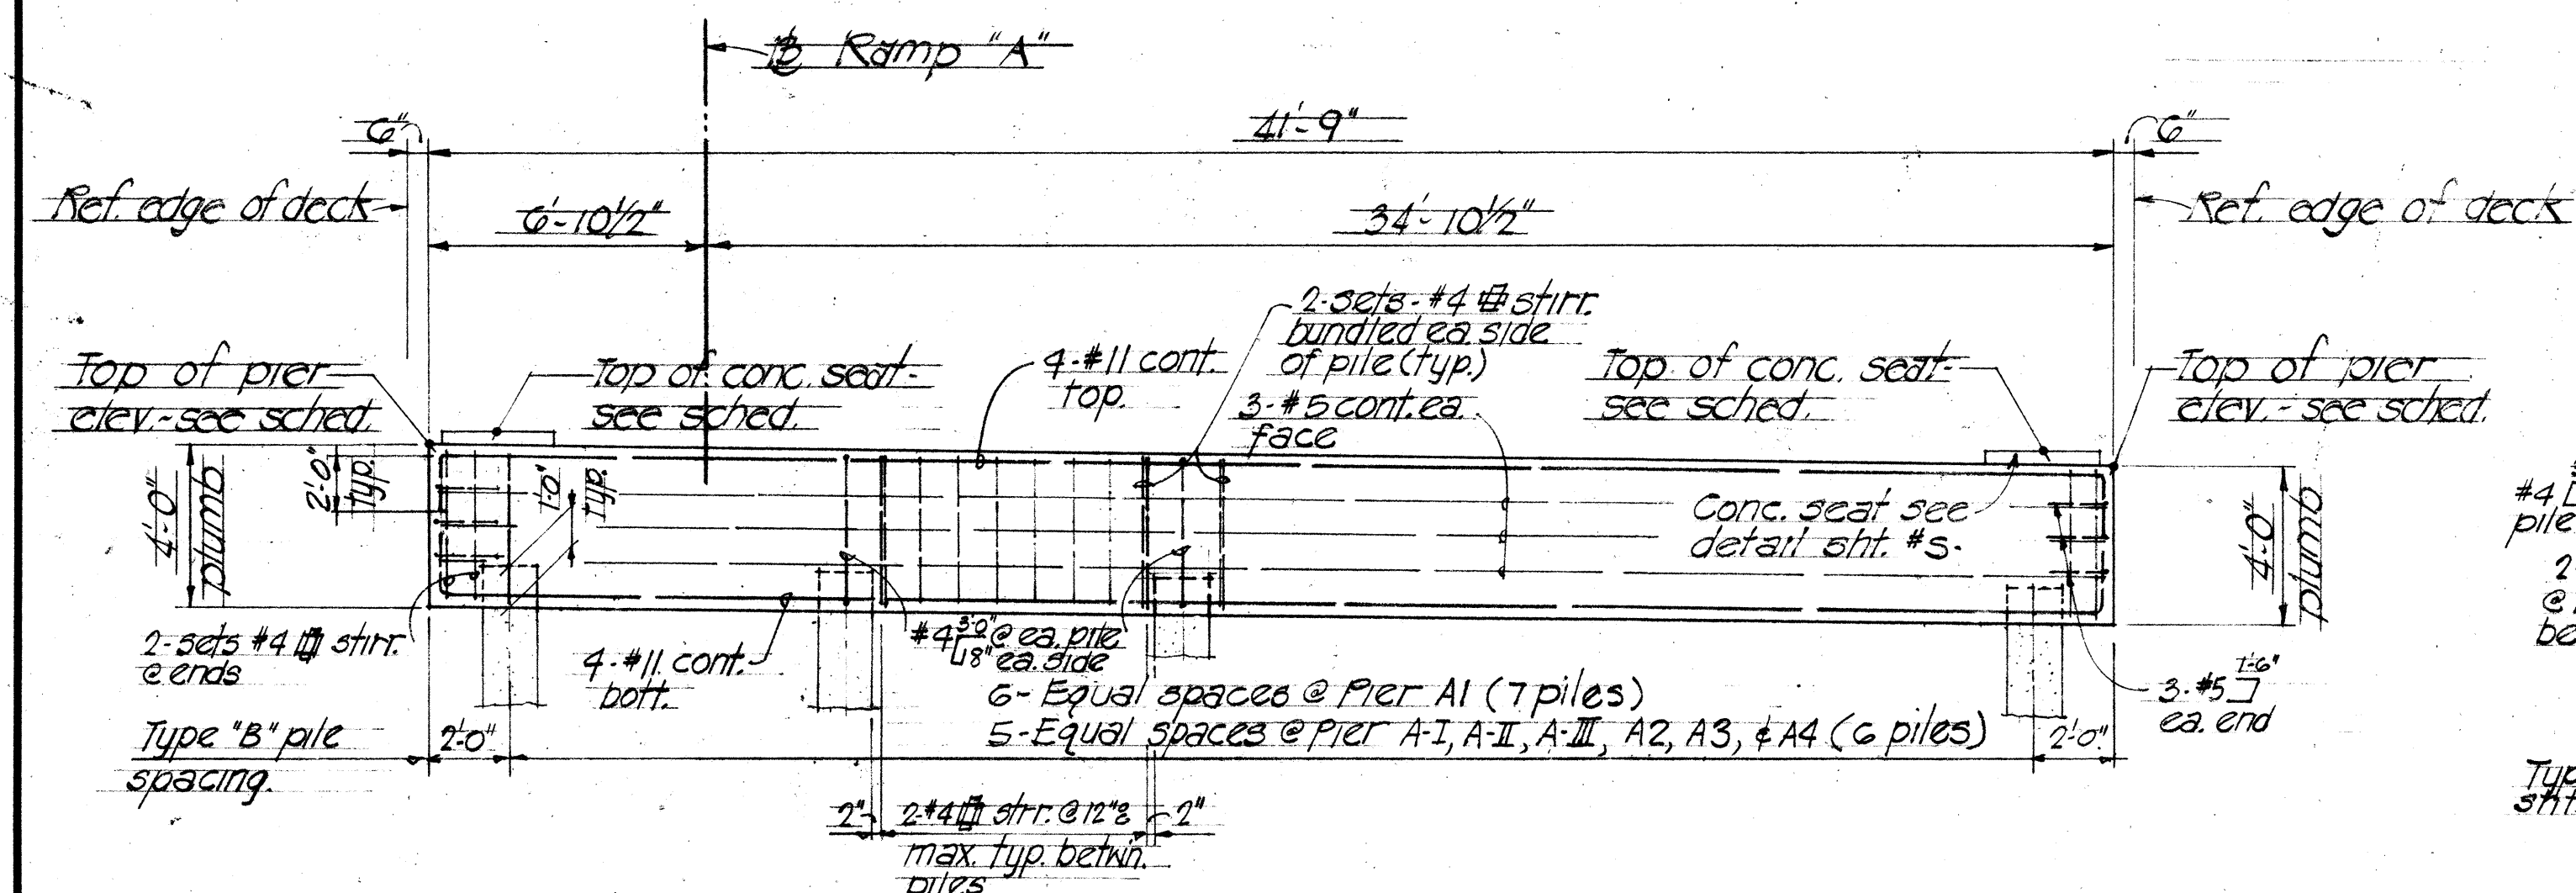


ELEVATION @ PIERS A1, A2, A3, A4, A-I, A-II & A-III  
Scale: 1/4" = 1'-0"

| CONCRETE SEAT ELEV. SCHEDULE |      |      |       |       |      |      |       |
|------------------------------|------|------|-------|-------|------|------|-------|
| Pier number                  | A1   | A2   | A3    | A4    | A-I  | A-II | A-III |
| t bearing Up station         |      |      |       |       |      |      |       |
| Elev. No. ①                  | 8.09 | 9.54 | 11.24 | 13.21 | 5.37 | 6.03 | 6.91  |
| ②                            | 8.00 | 9.45 | 11.15 | 13.13 | 5.28 | 5.94 | 6.80  |
| ③                            | 7.91 | 9.36 | 11.05 | 13.03 | 5.19 | 5.85 | 6.73  |
| ④                            | 7.81 | 9.26 | 10.96 | 12.93 | 5.10 | 5.75 | 6.63  |
| ⑤                            | 7.72 | 9.16 | 10.86 | 12.84 | 5.00 | 5.66 | 6.54  |
| ⑥                            | 7.62 | 9.07 | 10.77 | 12.74 | 4.91 | 5.56 | 6.44  |
| ⑦                            | 7.52 | 8.96 | 10.66 | 12.64 | 4.81 | 5.46 | 6.34  |
| t bearing Down station       |      |      |       |       |      |      |       |
| Elev. No. ⑧                  | 8.04 | 9.48 | 11.17 | 13.12 | 5.35 | 6.00 | 6.87  |
| ⑨                            | 7.95 | 9.39 | 11.09 | 13.03 | 5.26 | 5.91 | 6.78  |
| ⑩                            | 7.86 | 9.30 | 10.99 | 12.93 | 5.17 | 5.82 | 6.69  |
| ⑪                            | 7.76 | 9.20 | 10.89 | 12.84 | 5.07 | 5.72 | 6.59  |
| ⑫                            | 7.67 | 9.11 | 10.80 | 12.74 | 4.98 | 5.62 | 6.49  |
| ⑬                            | 7.57 | 9.01 | 10.70 | 12.65 | 4.89 | 5.53 | 6.40  |
| ⑭                            | 7.47 | 8.90 | 10.60 | 12.54 | 4.79 | 5.43 | 6.30  |

| TOP OF PIER CAP ELEV. SCHEDULE |      |      |       |       |      |      |       |
|--------------------------------|------|------|-------|-------|------|------|-------|
| Pier number                    | A1   | A2   | A3    | A4    | A-I  | A-II | A-III |
| Left top elevation             | 7.70 | 9.14 | 10.84 | 12.73 | 5.00 | 5.65 | 6.52  |
| Right top elevation            | 7.08 | 8.52 | 10.21 | 12.15 | 4.39 | 5.03 | 5.90  |

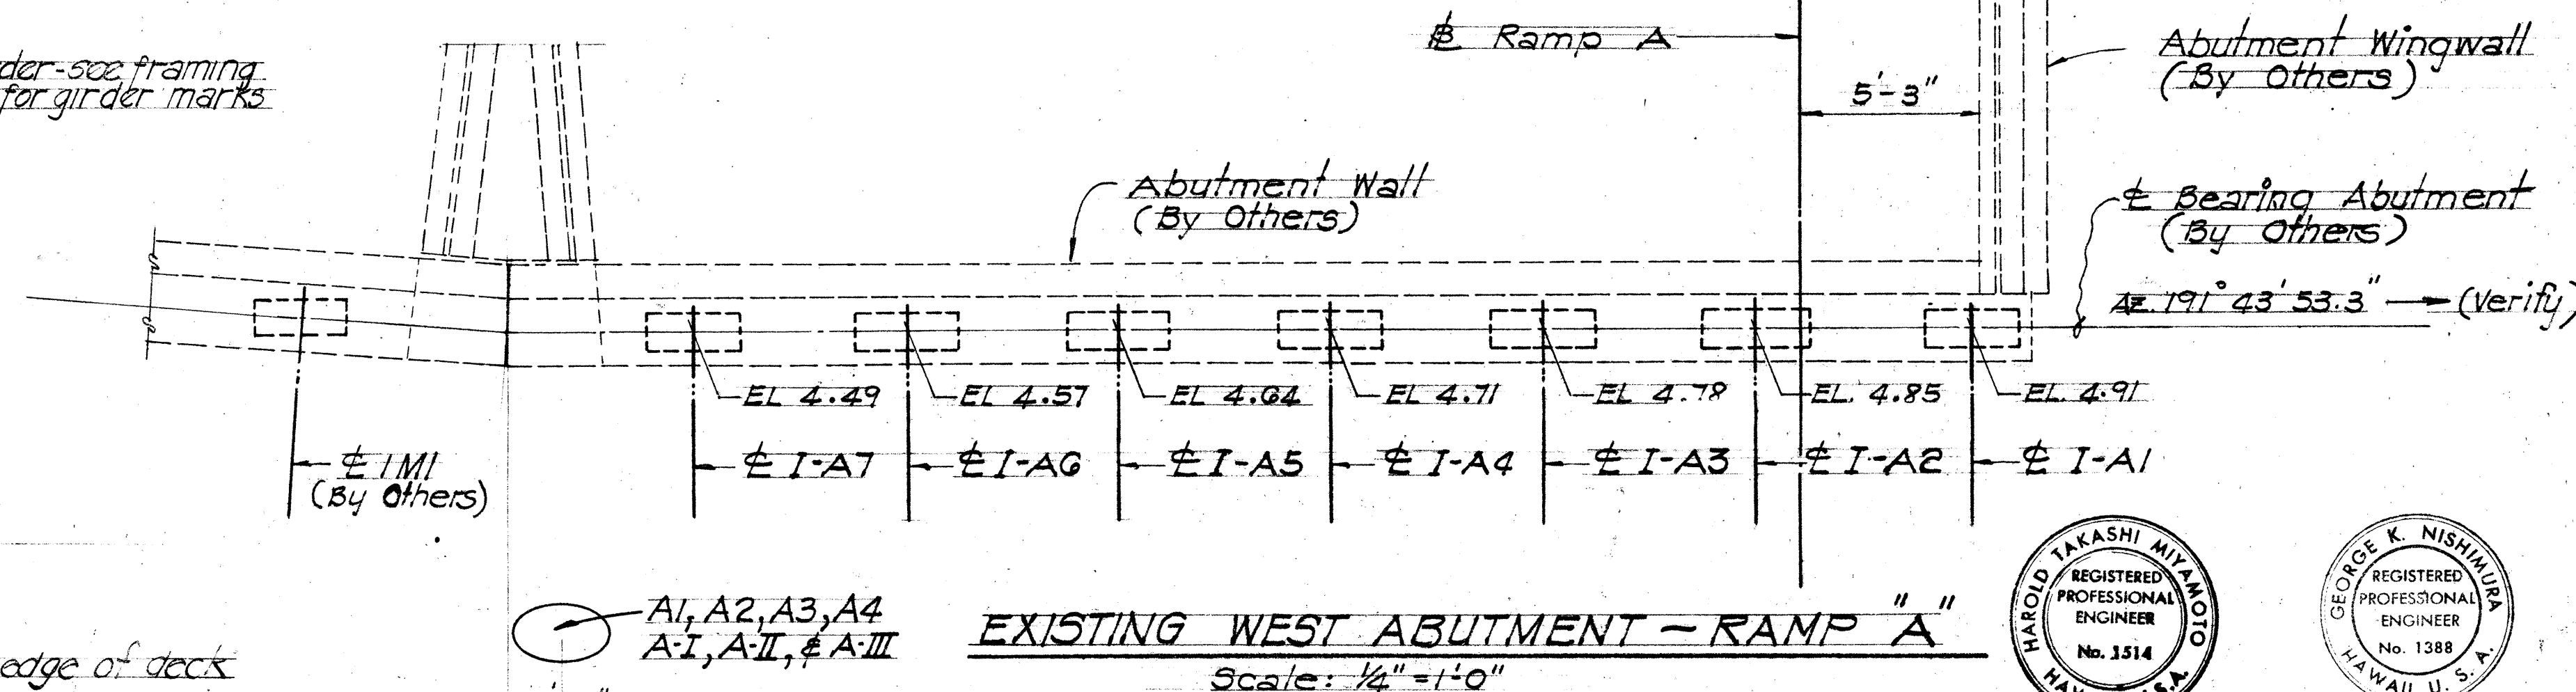


EXISTING WEST ABUTMENT - RAMP "A"  
Scale: 1/4" = 1'-0"

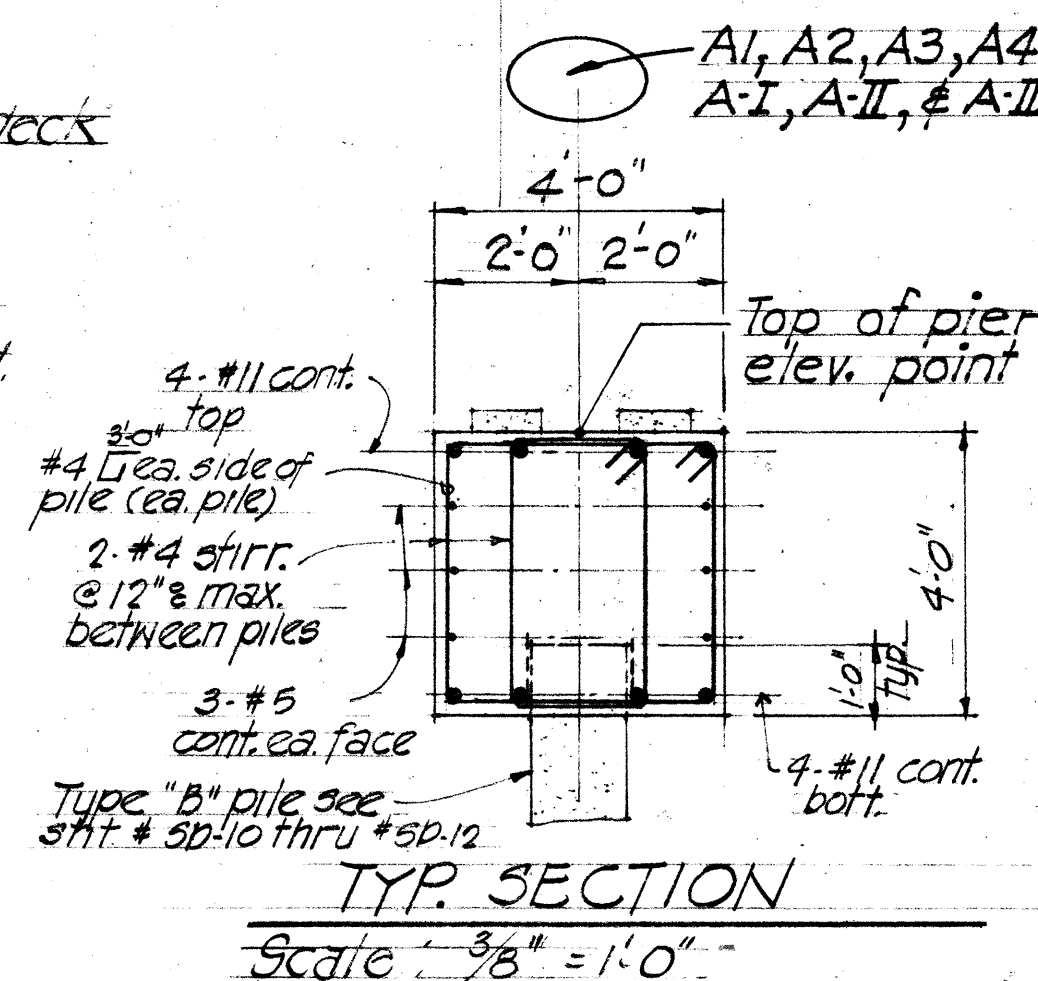


TYP. SECTION  
Scale: 3/8" = 1'-0"

NOTE:  
Adjust pier cap top main reinforcing spacing to clear bearing plate anchor bolts.

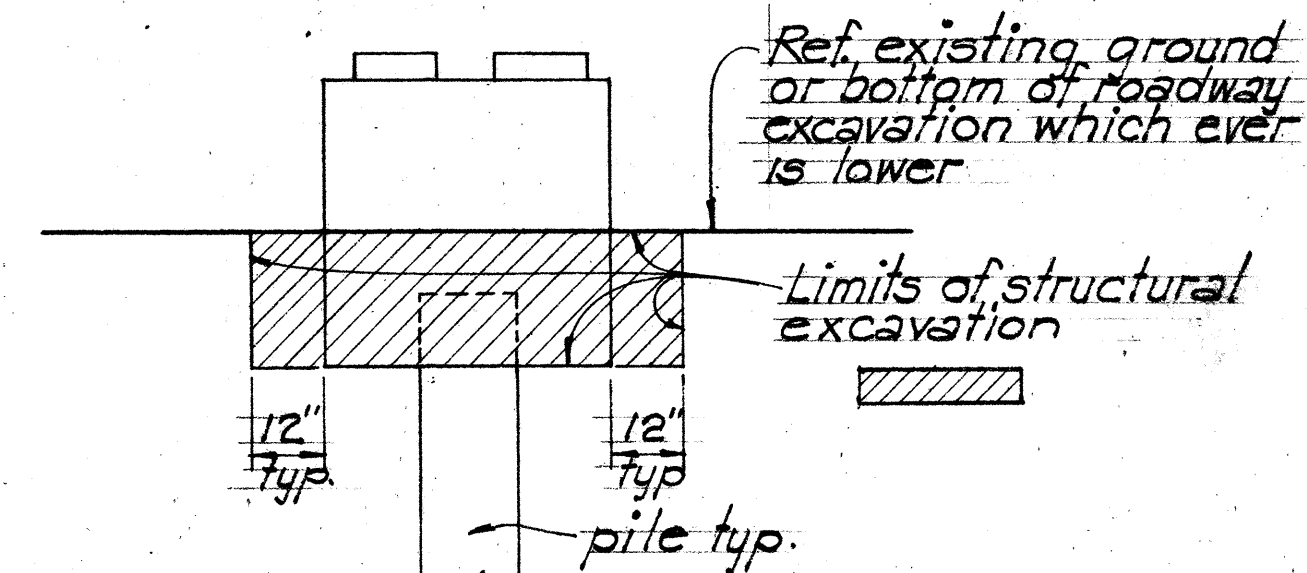

PAY LIMITS AT PIER BELOW GRADE  
Not to scale

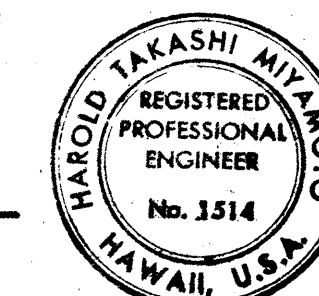

THIS WORK WAS PREPARED BY ME OR UNDER MY SUPERVISION

George K. Nishihira

THIS WORK WAS PREPARED BY ME OR UNDER MY SUPERVISION

George K. Nishihira


STATE OF HAWAII  
DEPARTMENT OF TRANSPORTATION  
HIGHWAYS DIVISION  
NIMITZ CONNECTOR (E.B.)  
RAMP "A" & RAMP "B"  
KEEHI INTERCHANGE  
F.A.I. PROJ. NO. 1-HI-1 (168)17  
Scale: As shown Date: JULY, 1981  
SHEET NO. 5-200F 49 SHEETS



| FED. ROAD DIST. NO. | STATE | FED. AID PROJ. NO. | FISCAL YEAR | SHEET NO. | TOTAL SHEETS |
|---------------------|-------|--------------------|-------------|-----------|--------------|
| HAWAII              | HAW.  | 1-HI-(168)17       | 1982        | 103       | 145          |


# NOTE

All #18 & #14 bars shall be grade 60.

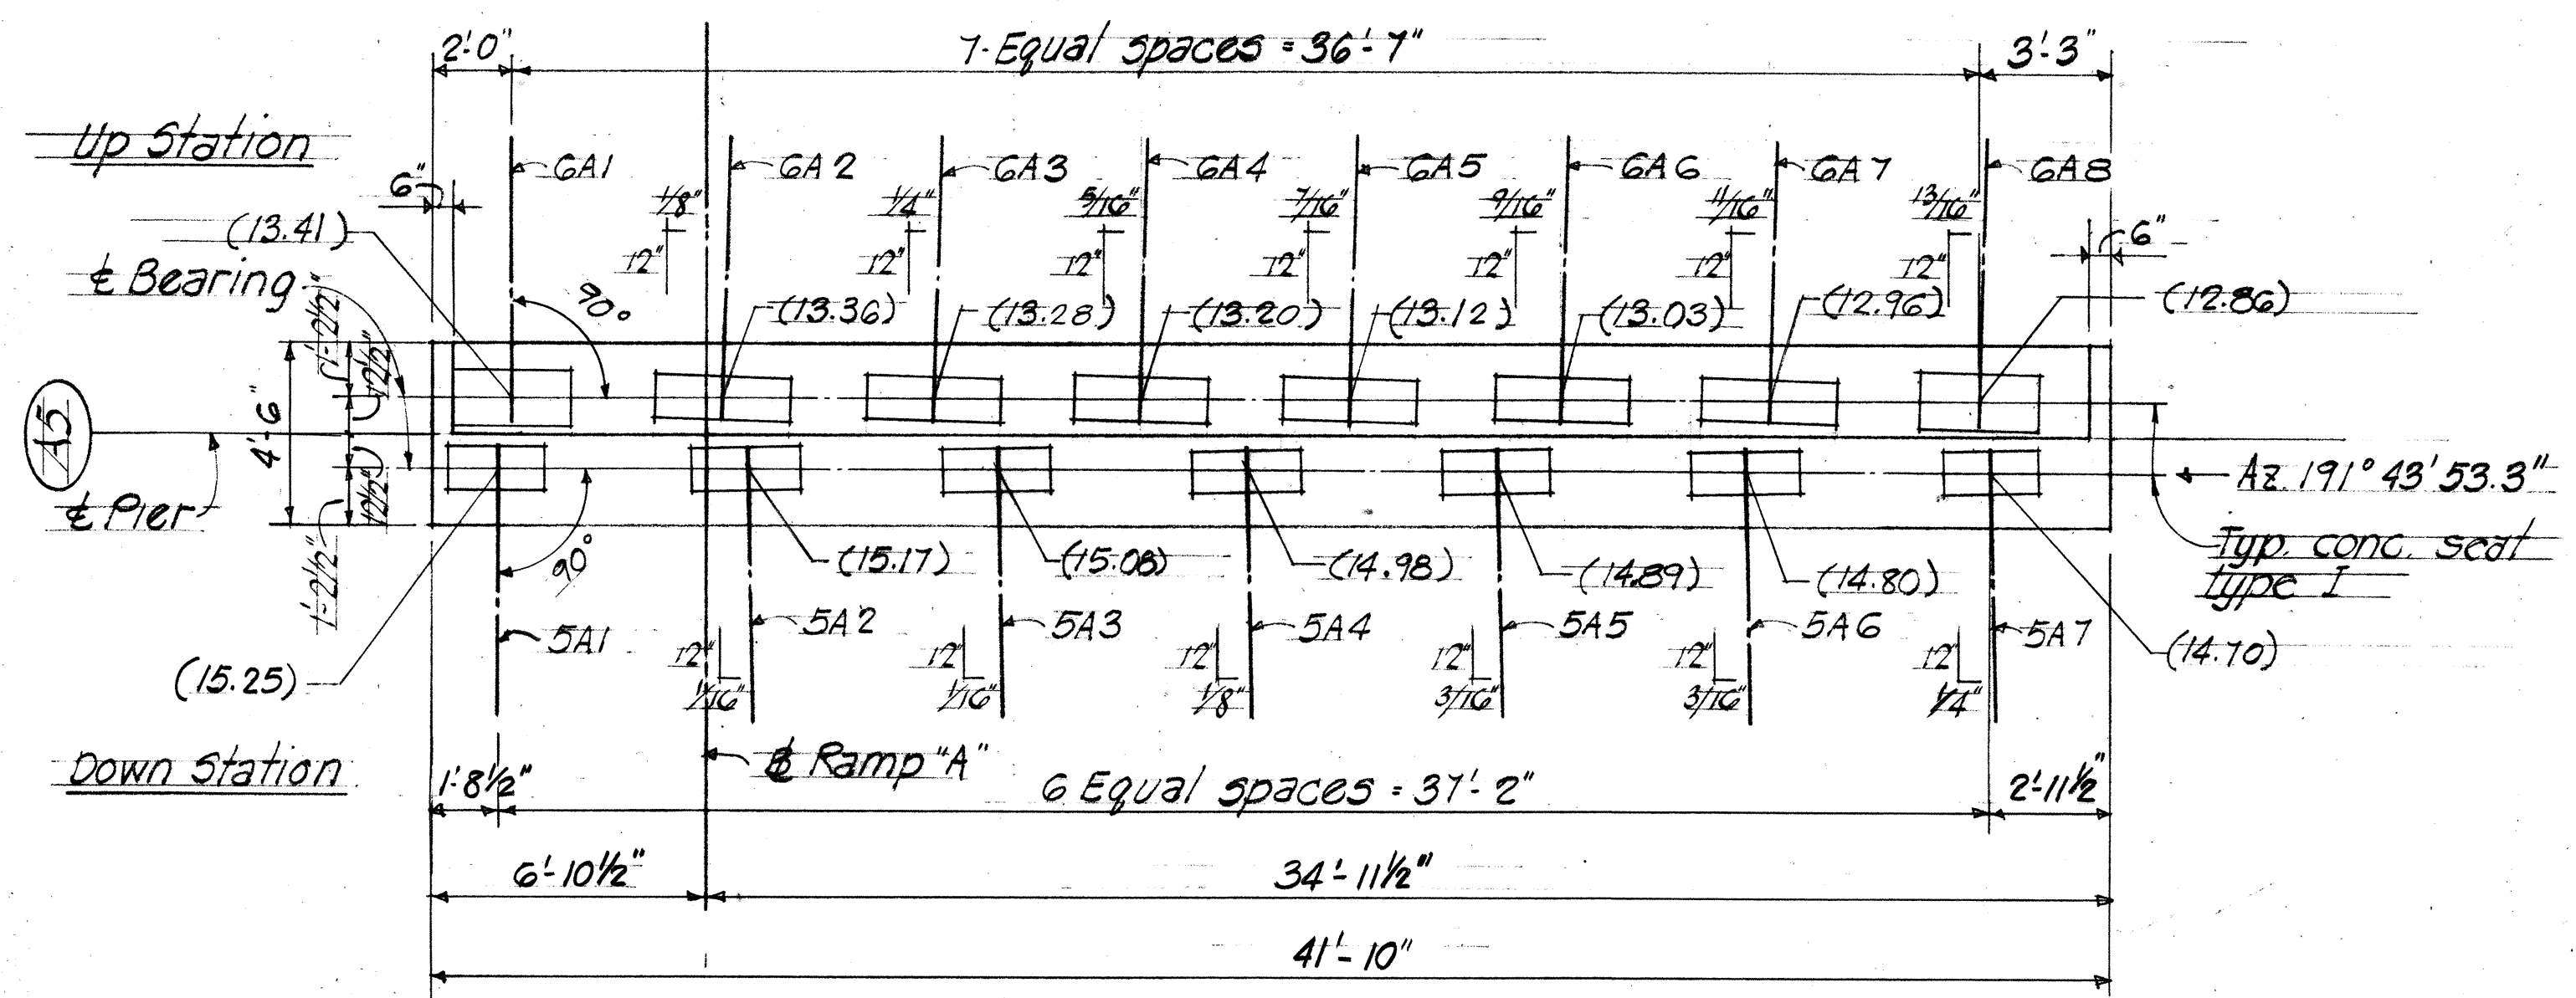


**PLAN ~ PIER A5**  
Scale 1/4"=1'-0"


NOTE:  
(00.00) Denotes top of concrete seat elevation.

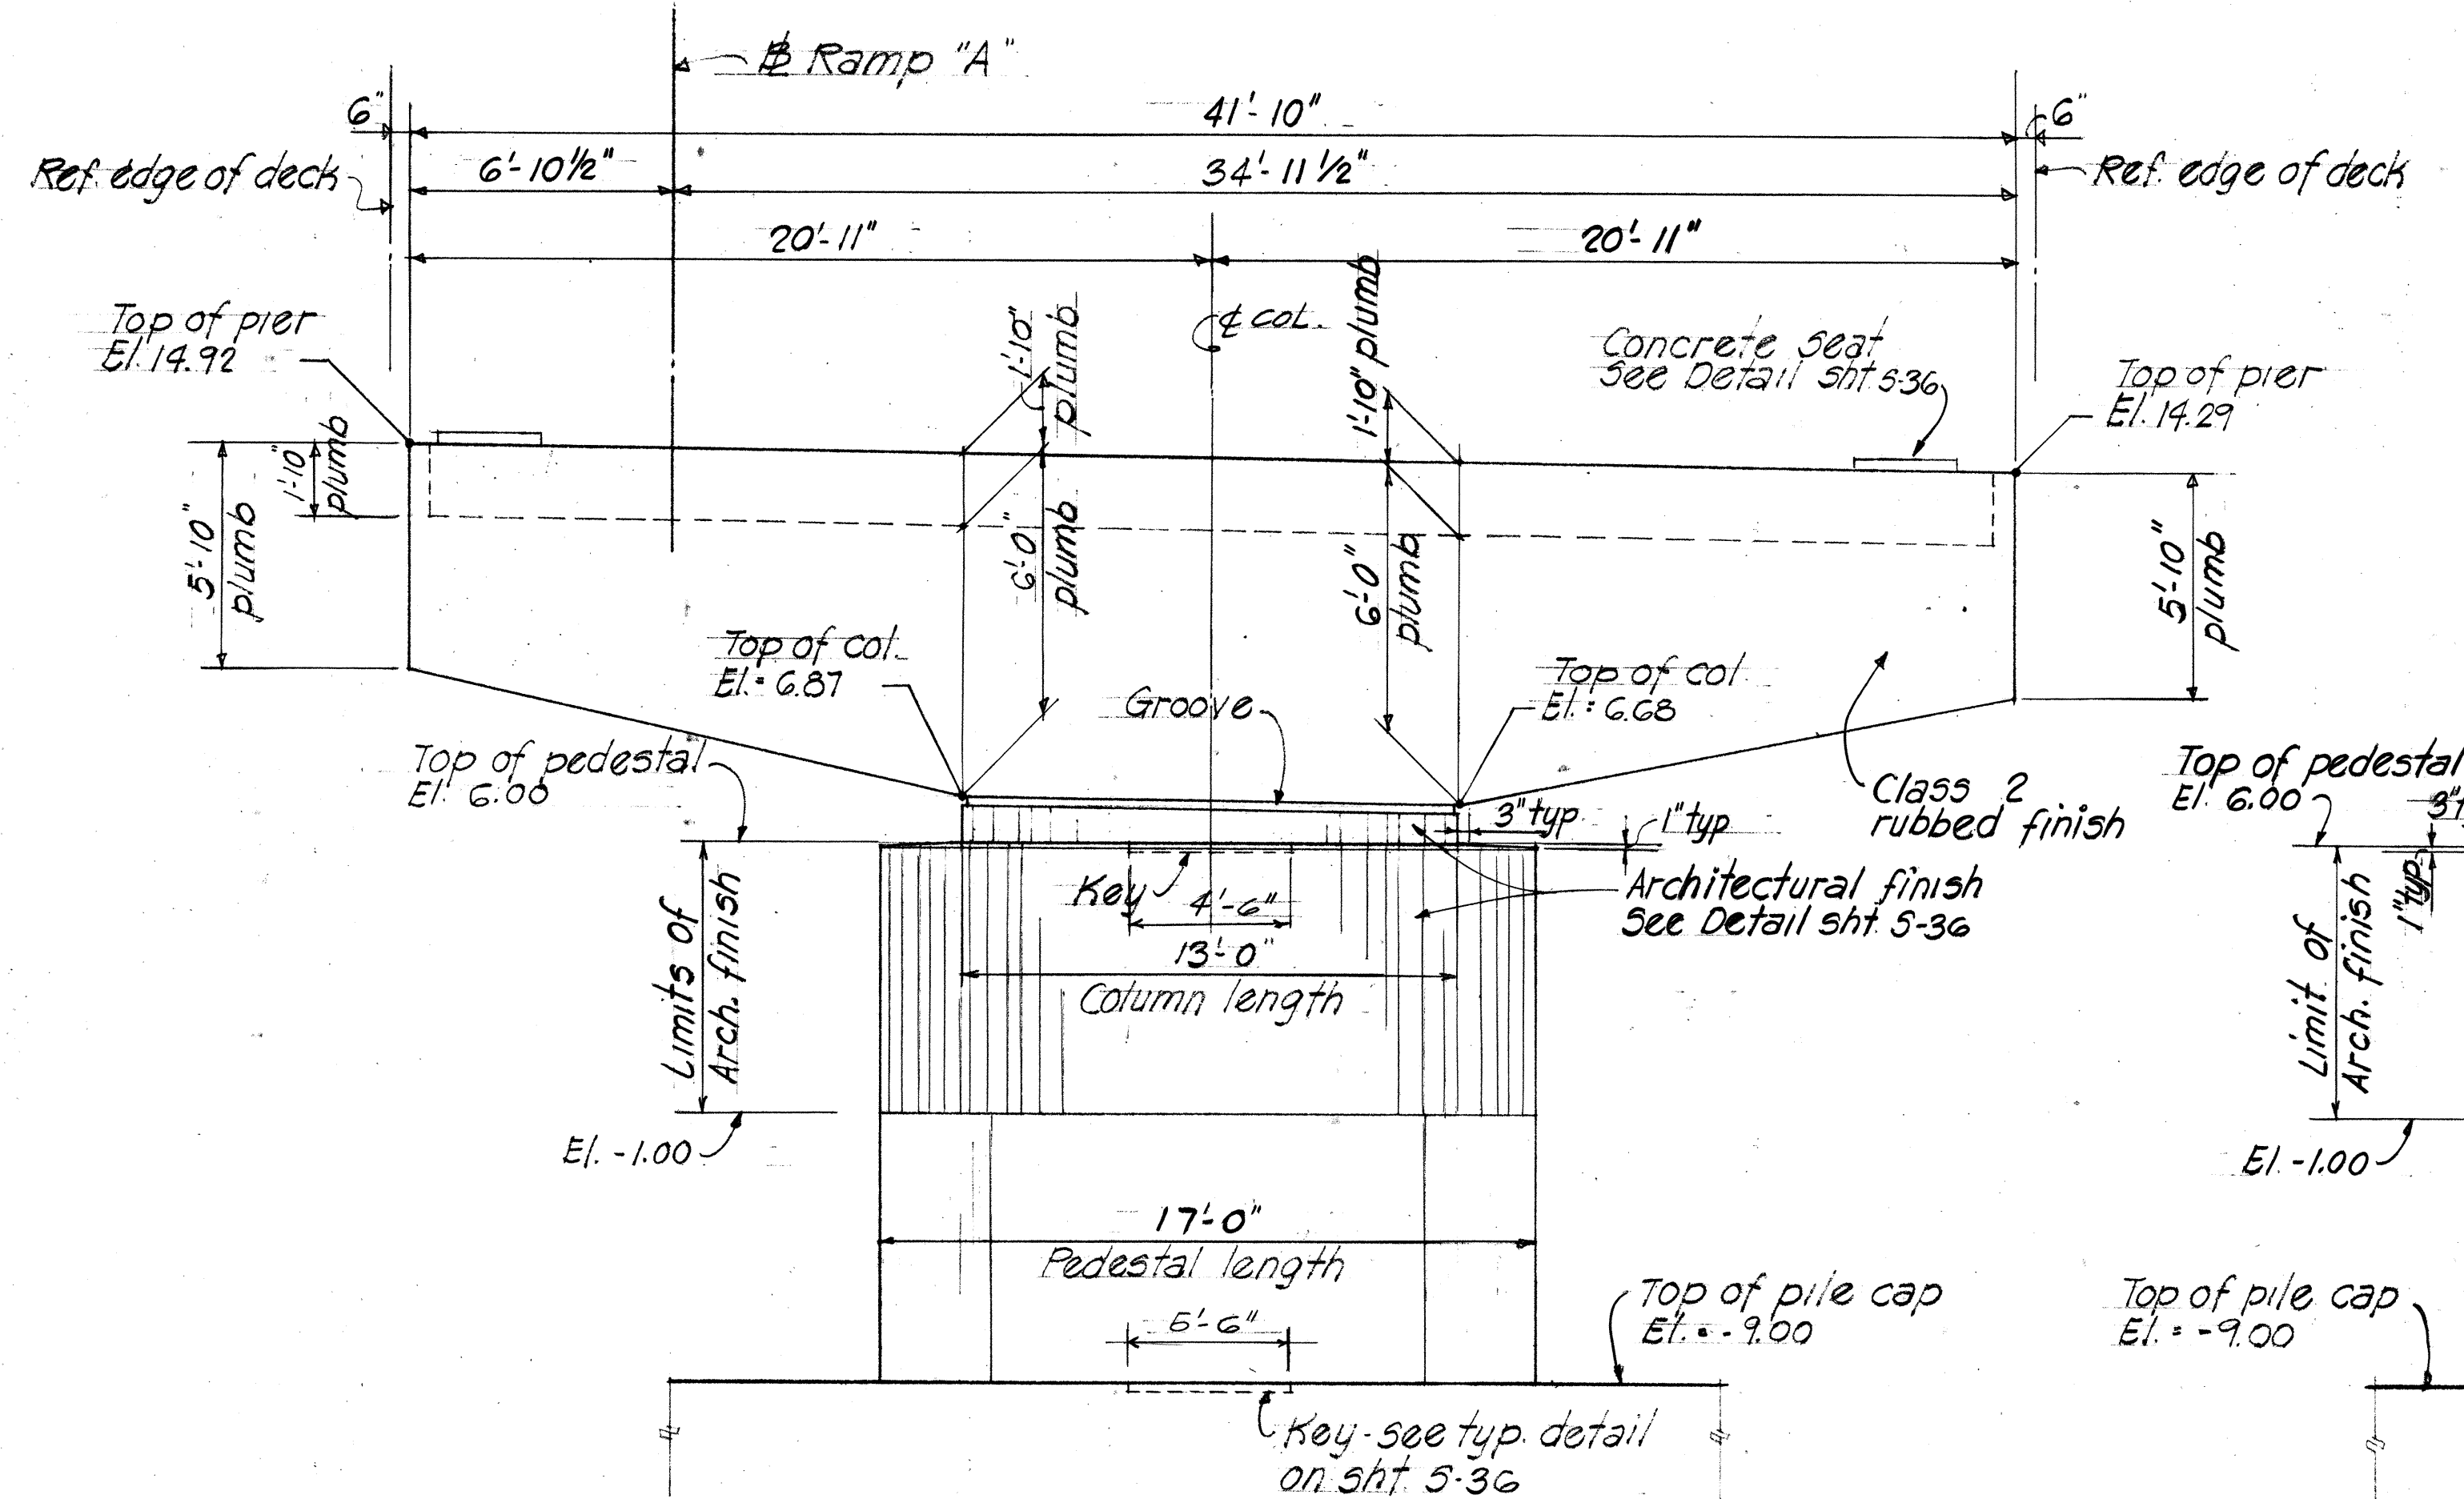

**ELEVATION ~ PIER A5**  
Scale 1/4"=1'-0"


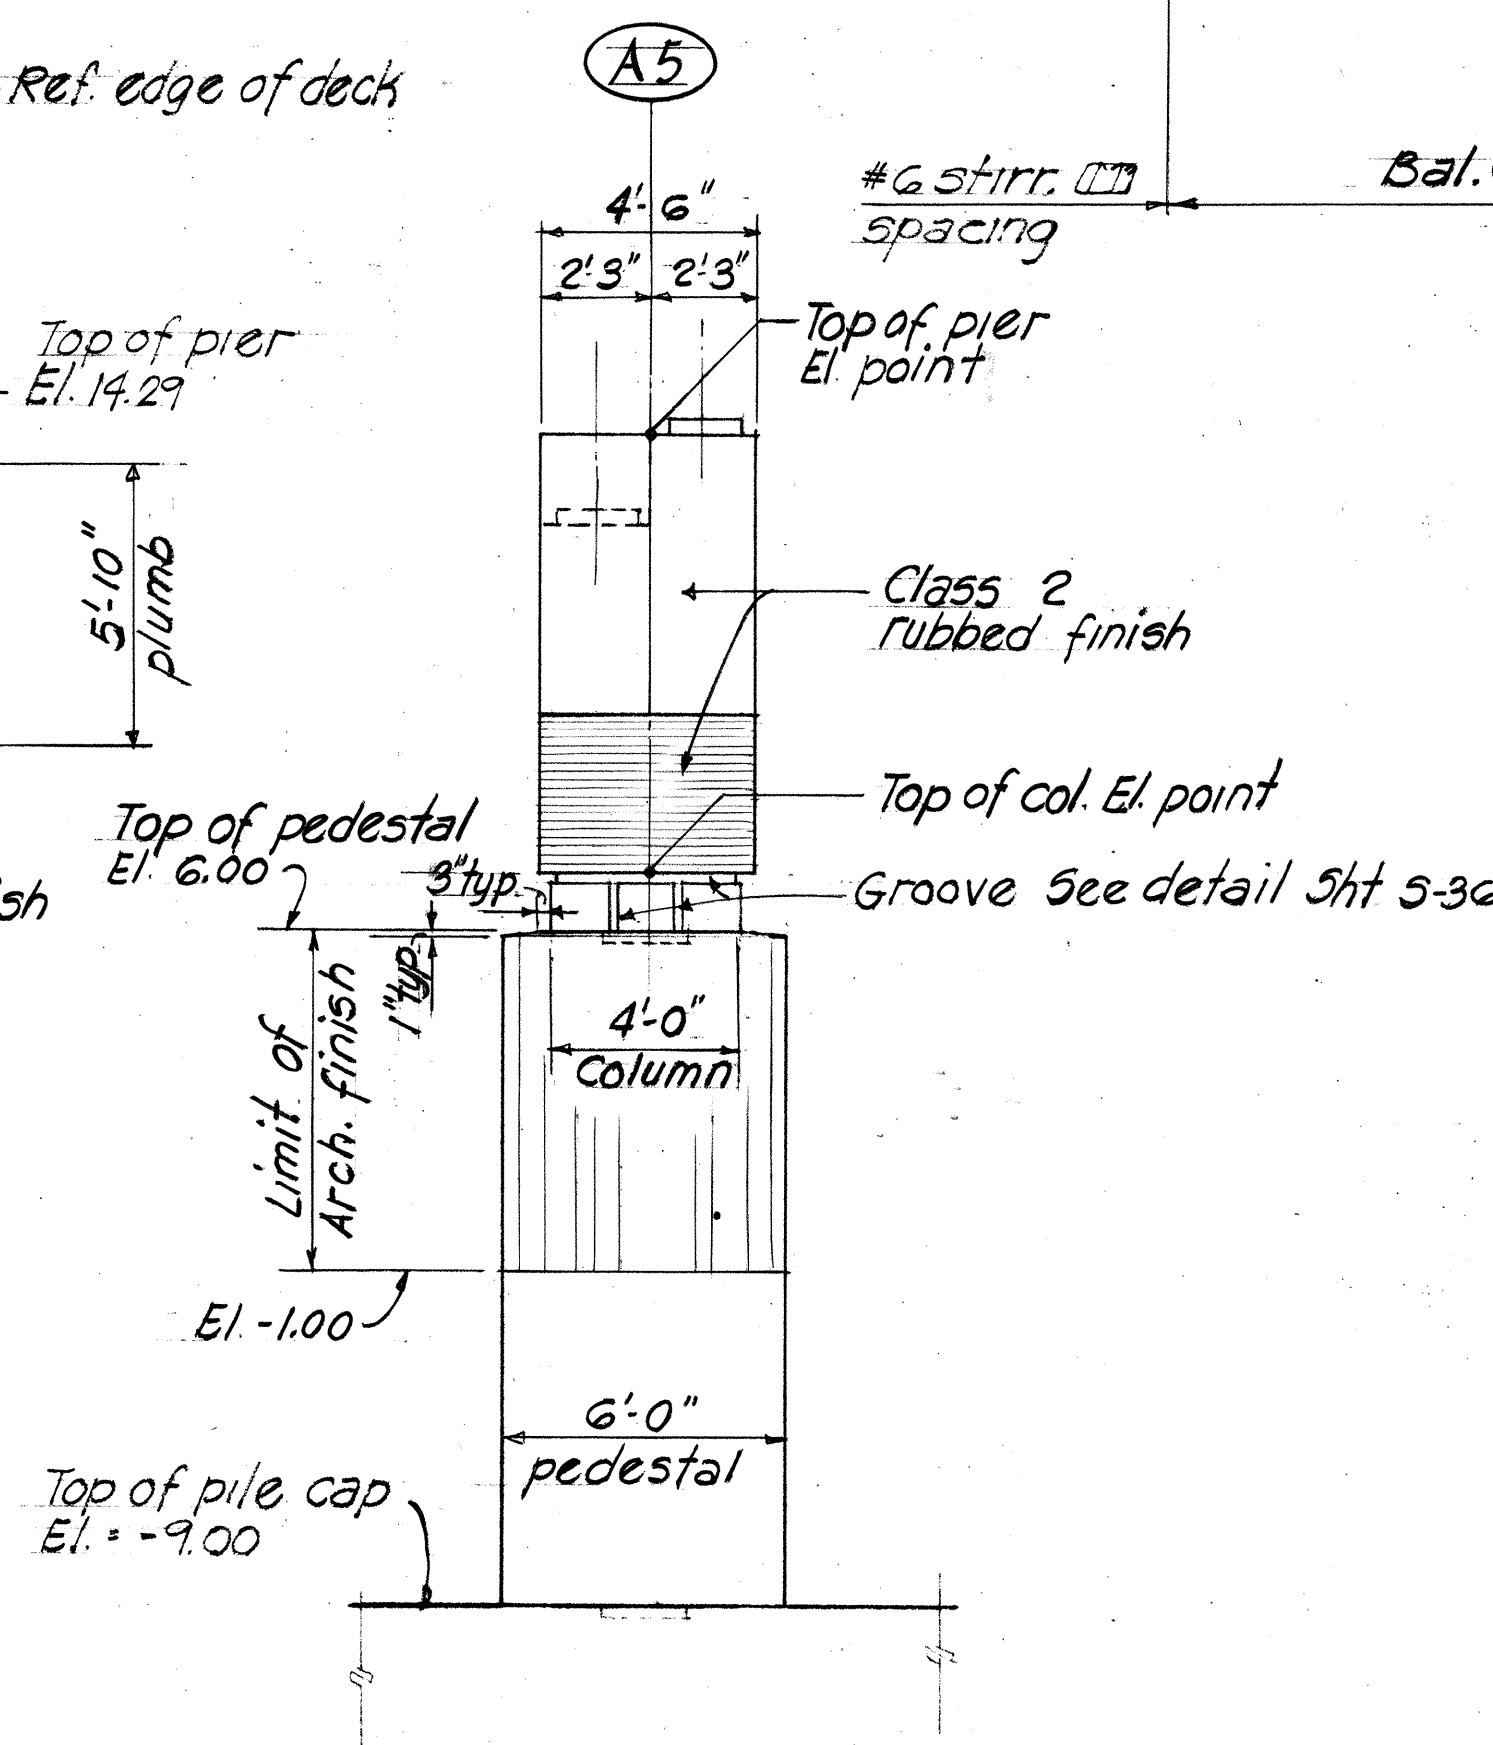


**END ELEVATION**  
Scale 1/4"=1'-0"

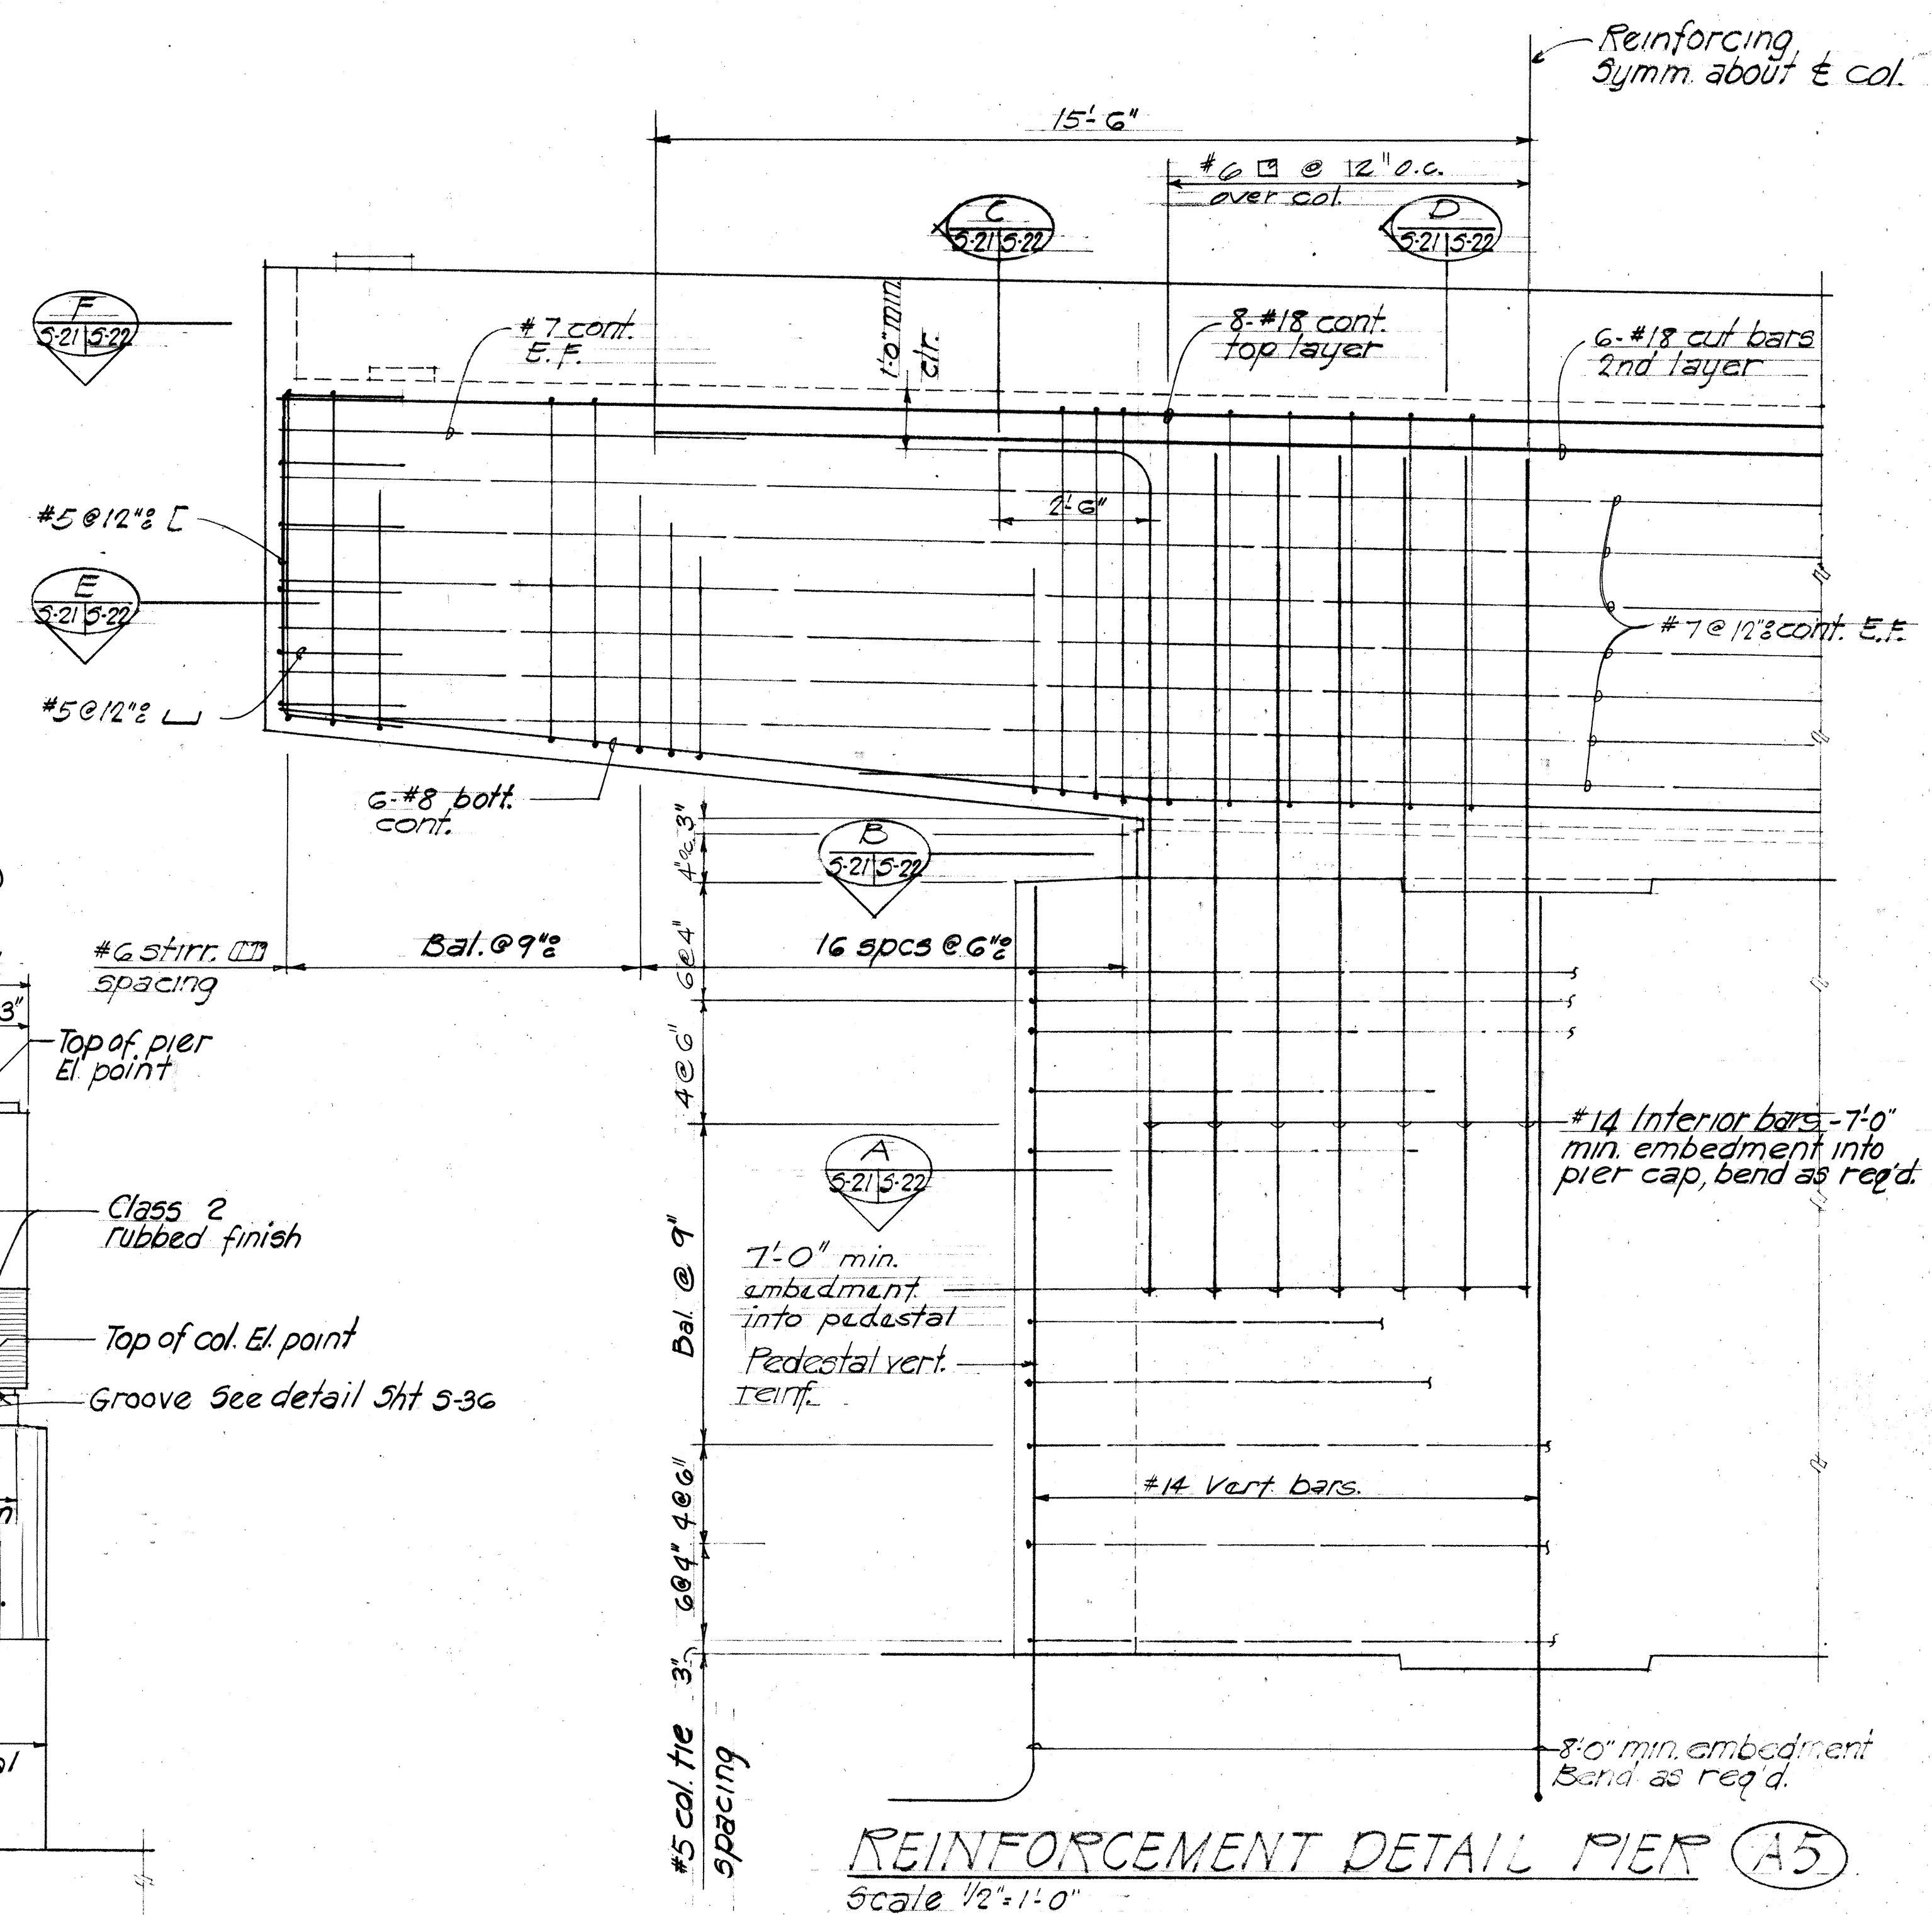

**REINFORCEMENT DETAIL PIER A5**  
Scale 1/2"=1'-0"

|                   |      |
|-------------------|------|
| SURVEY PLOTTED BY | DATE |
| DESIGNED BY       |      |
| NOTED BY          |      |
| CHECKED BY        |      |
| ORIGINAL PLAN     |      |
| NOTE BOOK         |      |
| NO.               |      |

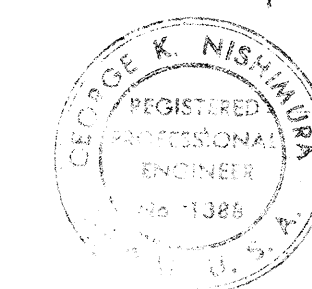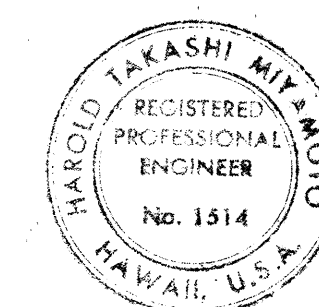



THIS WORK WAS PREPARED BY ME OR UNDER MY SUPERVISION

THIS WORK WAS PREPARED BY ME OR UNDER MY SUPERVISION





|                                |                  |
|--------------------------------|------------------|
| STATE OF HAWAII                |                  |
| DEPARTMENT OF TRANSPORTATION   |                  |
| HIGHWAYS DIVISION              |                  |
| NIMITZ CONNECTOR (E.B.)        |                  |
| RAMP "A" & RAMP "B"            |                  |
| PIER A5 DETAIL                 |                  |
| KEEHI INTERCHANGE              |                  |
| F.A.I. PROJ. NO. 1-HI-1(168)17 | Date: JULY, 1981 |
| SHEET NO. 5-21 OF 49 SHEETS    |                  |



| FED. ROAD DIST. NO. | STATE | FED. AID PROJ. NO. | FISCAL YEAR | SHEET NO. | TOTAL SHEETS |
|---------------------|-------|--------------------|-------------|-----------|--------------|
| HAWAII              | HAW.  | HI-1(168)17        | 1982        | 104       | 145          |

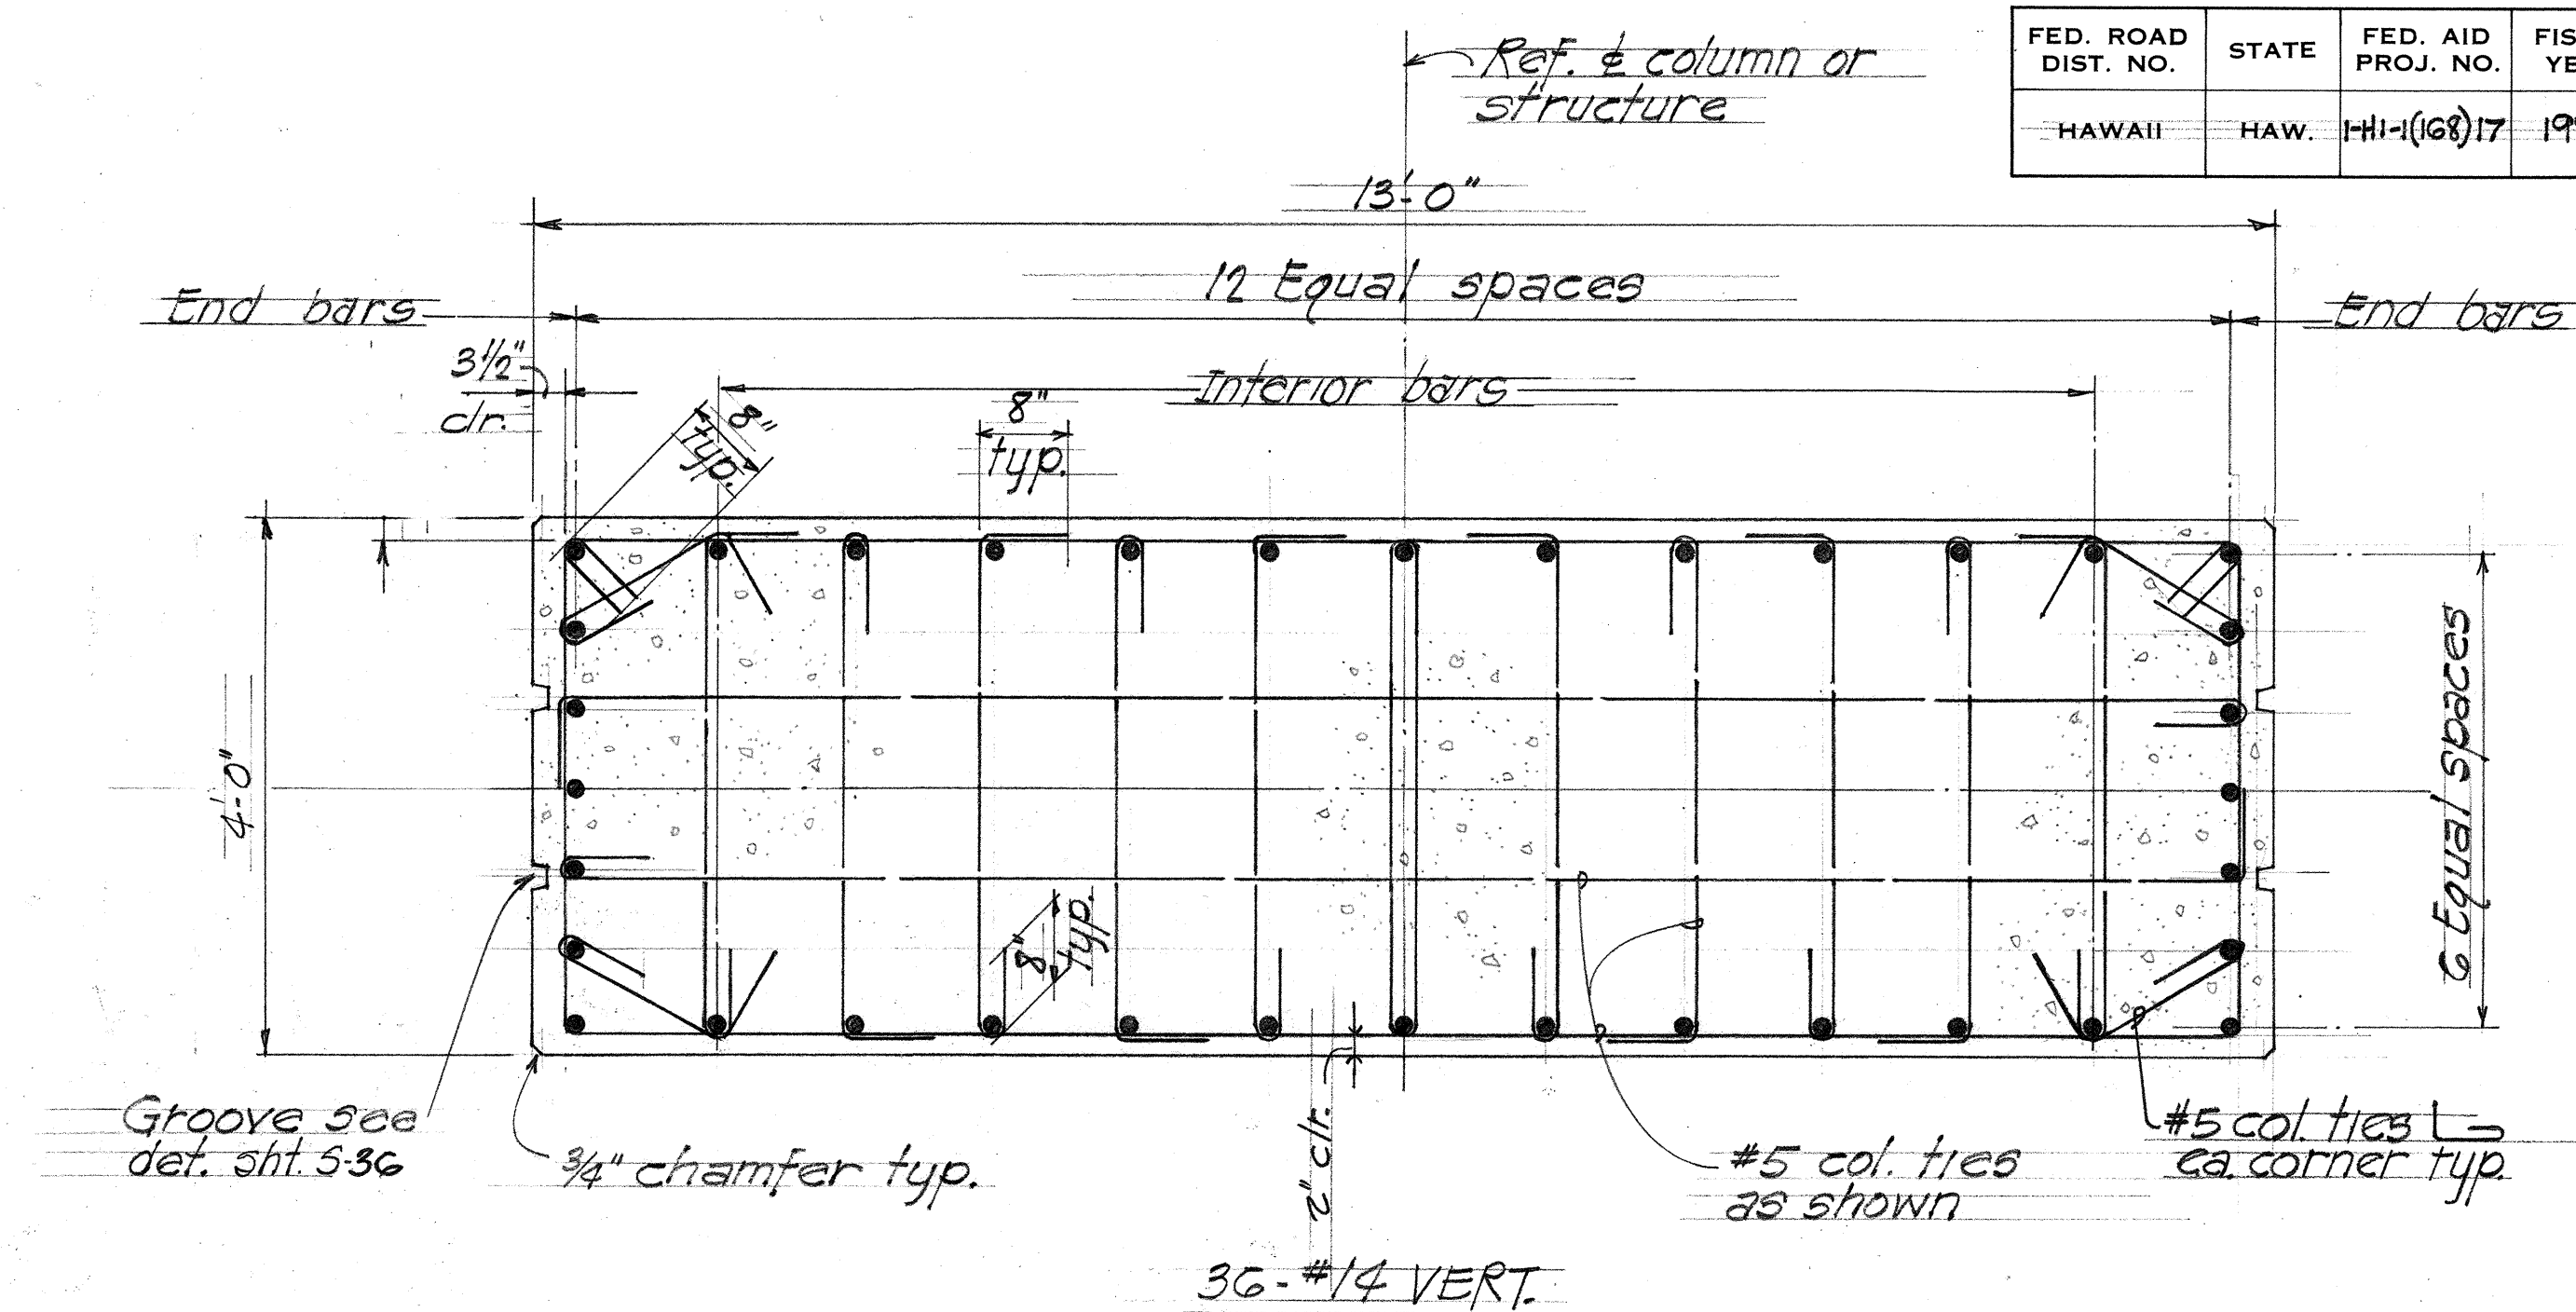
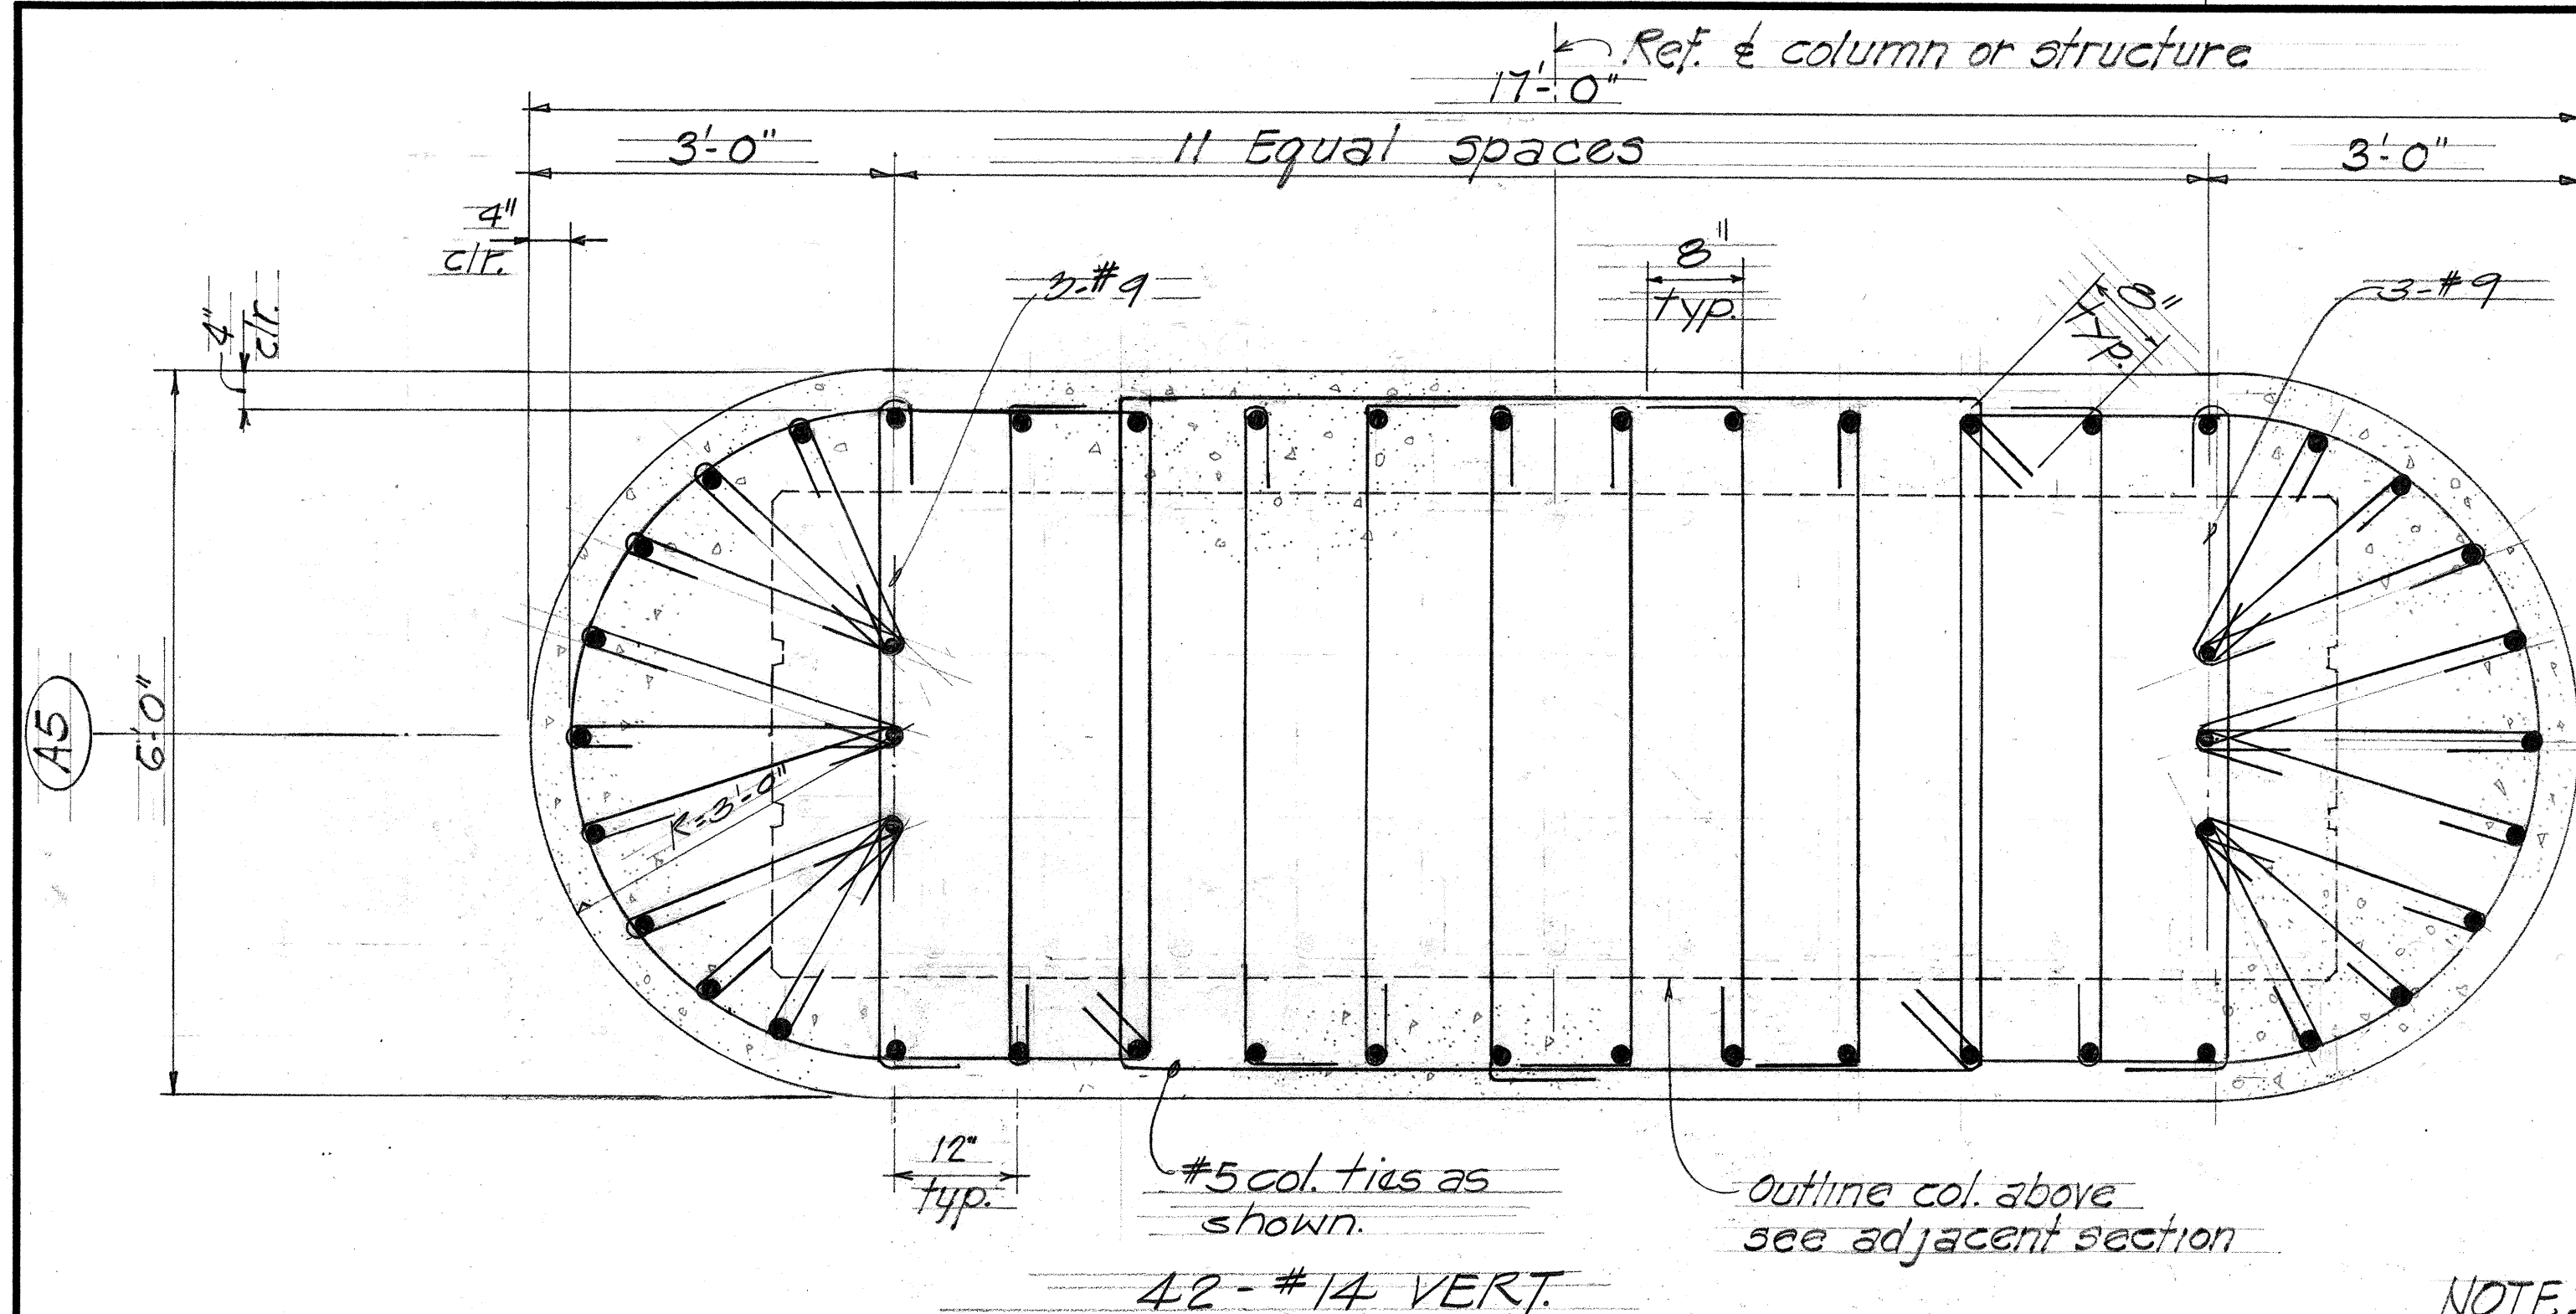


NOTE:  
All #18 & #14 bars shall be grade 60

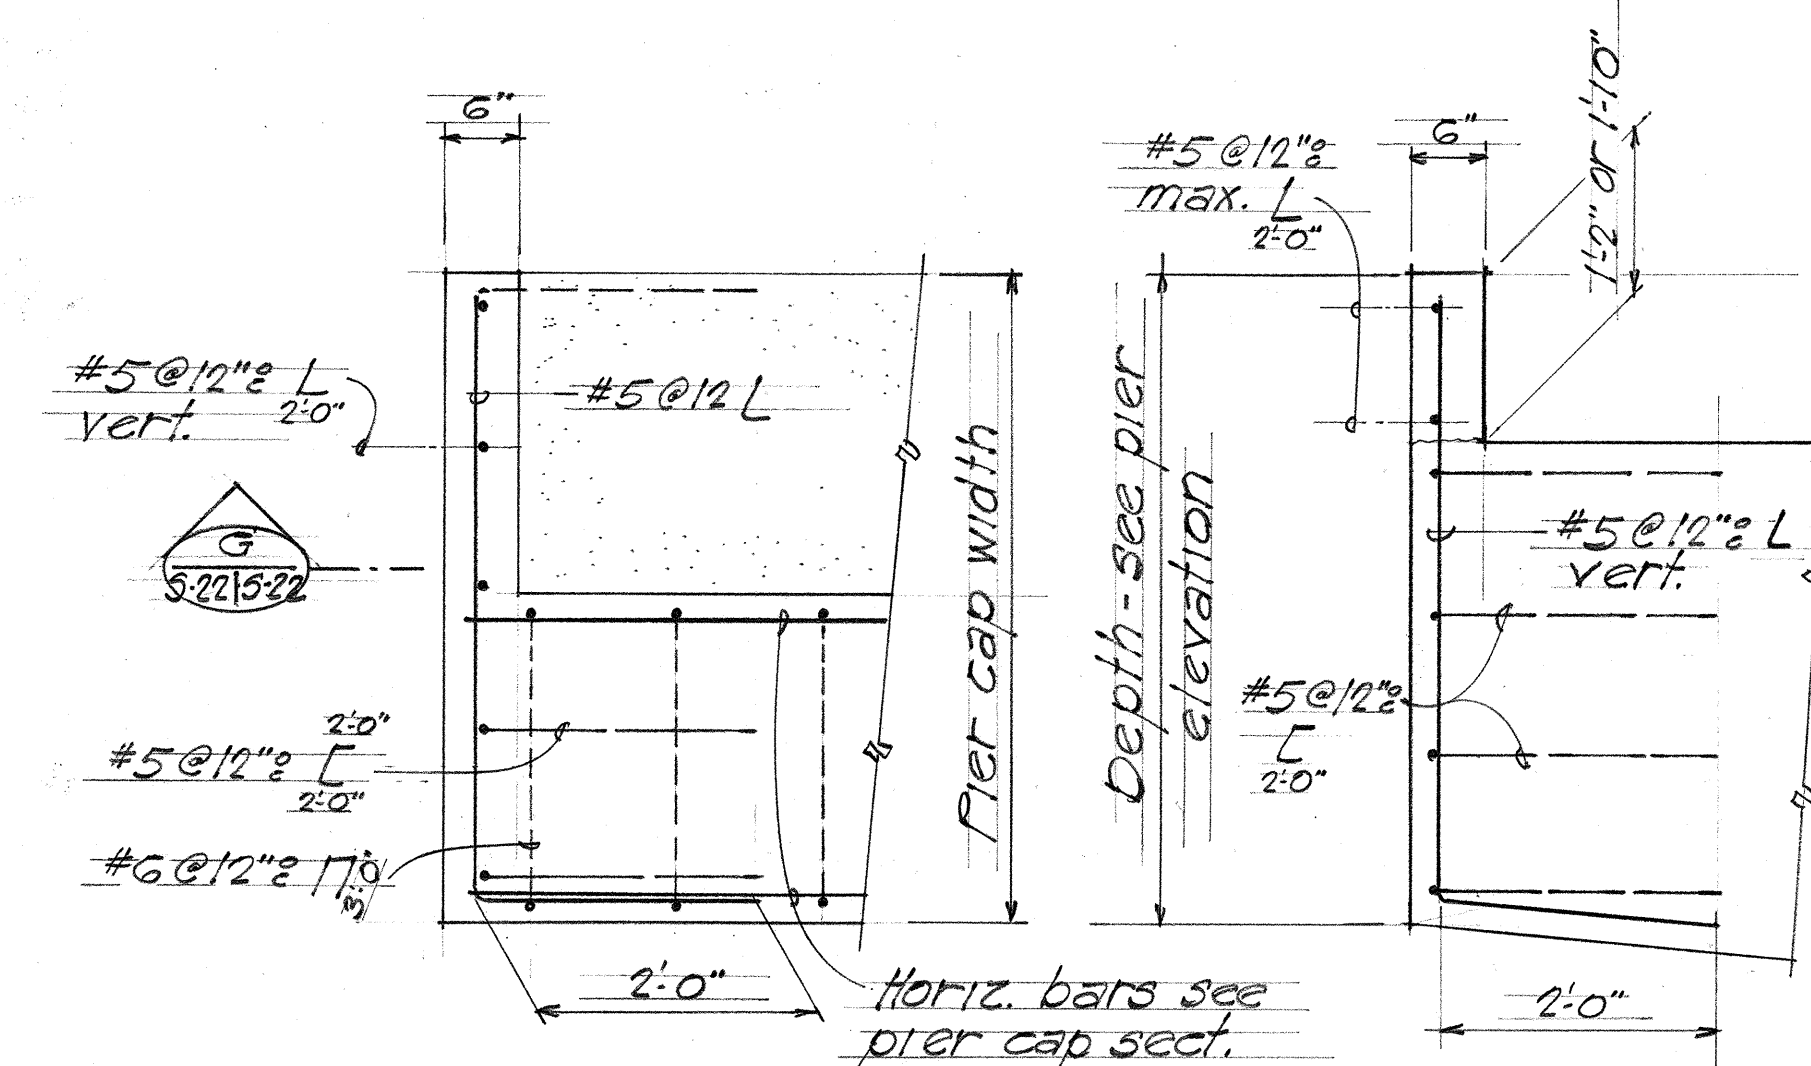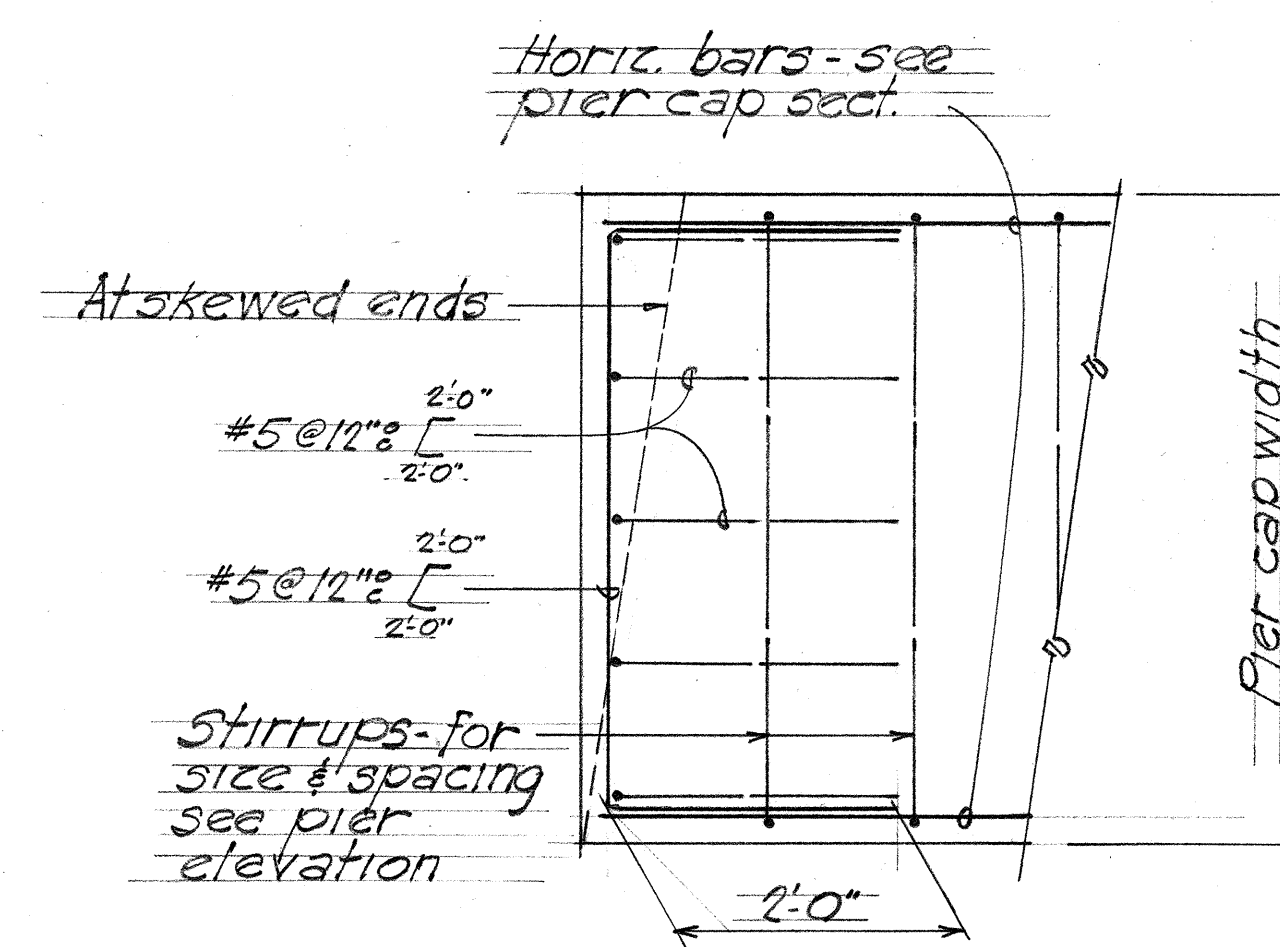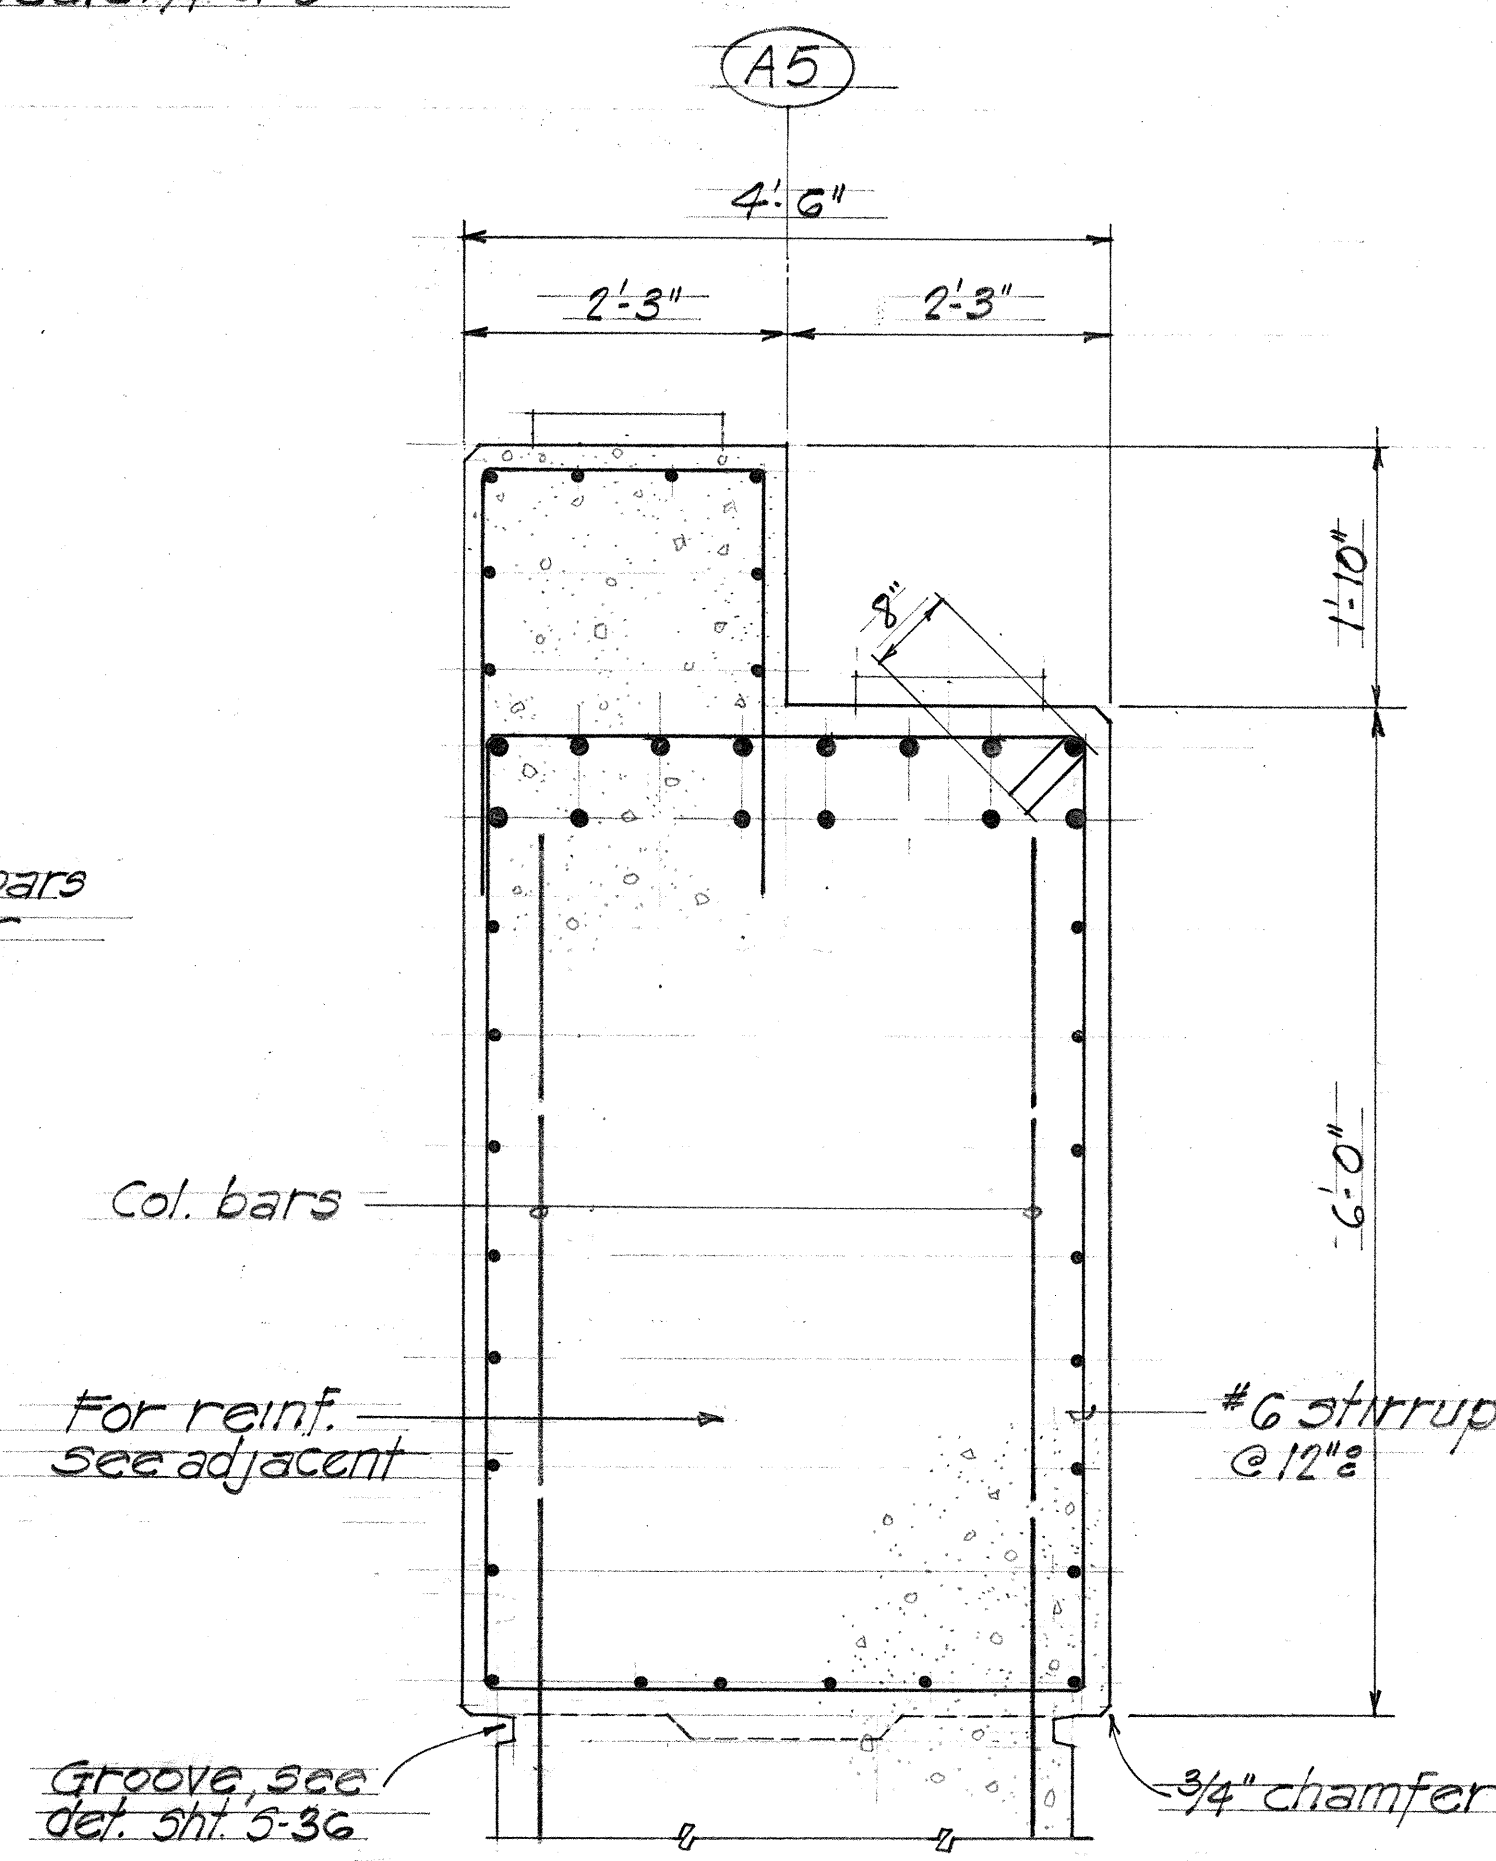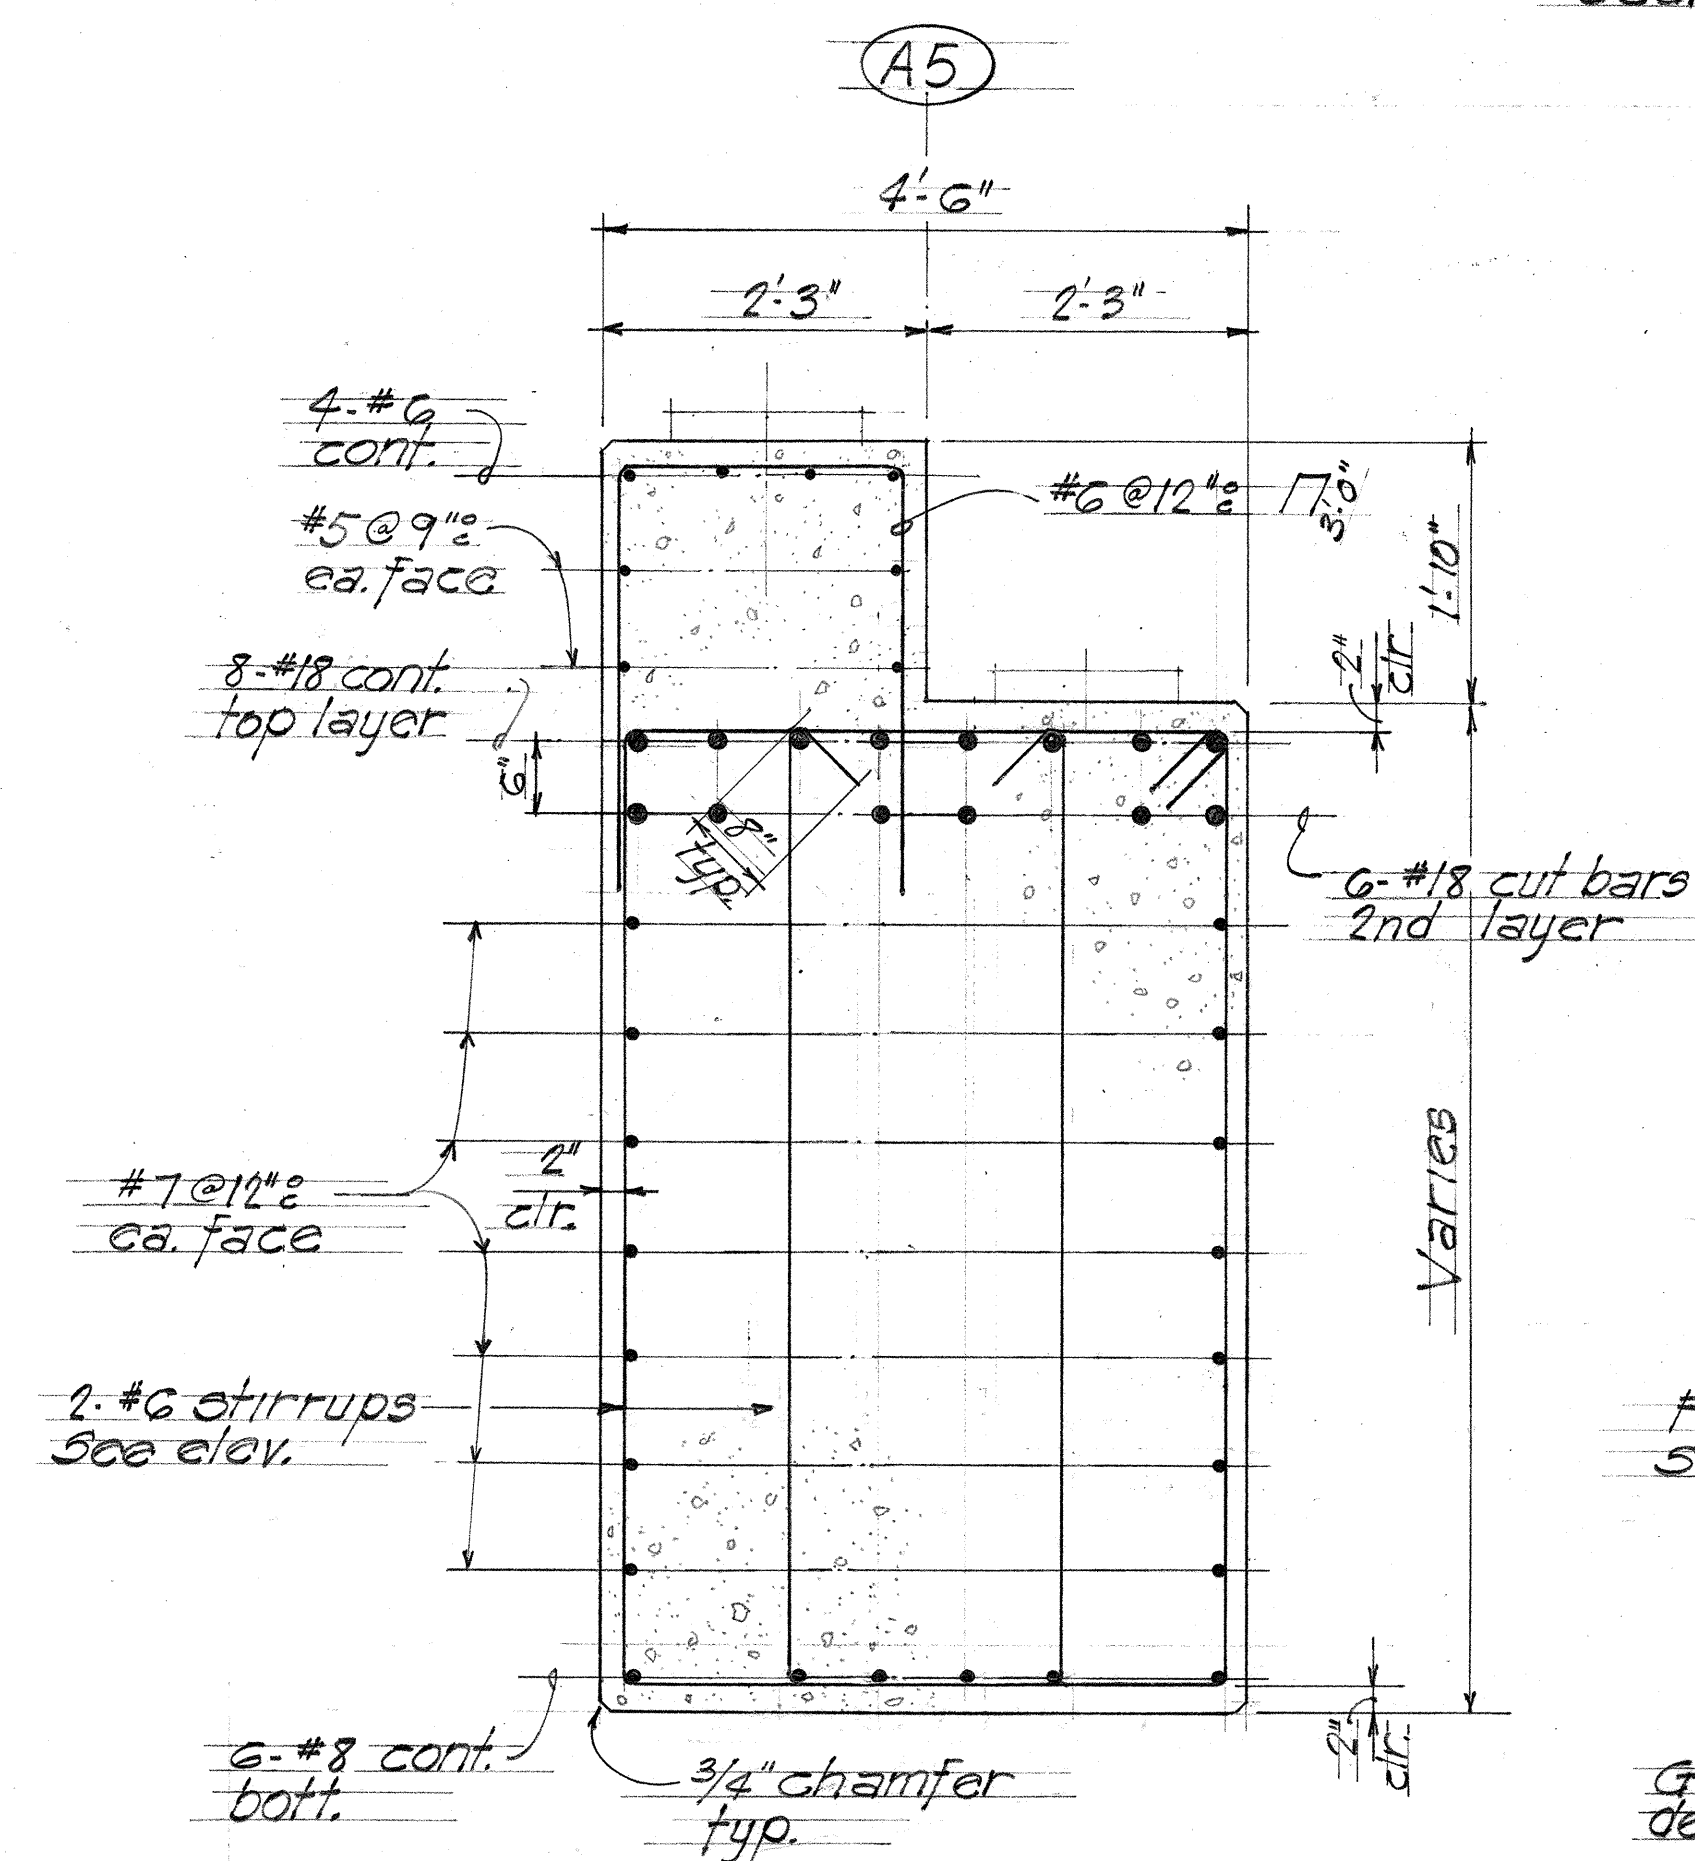

NOTE:  
Adjust pier cap top main reinforcing spacing to clear bearing plate anchor bolts.


|                   |         |
|-------------------|---------|
| DATE              | 5-21-82 |
| SURVEY PLOTTED BY | ...     |
| DRAWN BY          | ...     |
| CHECKED BY        | ...     |
| NOTED BY          | ...     |
| NO.               | ...     |

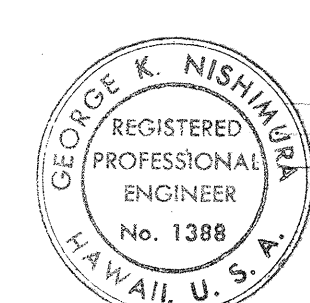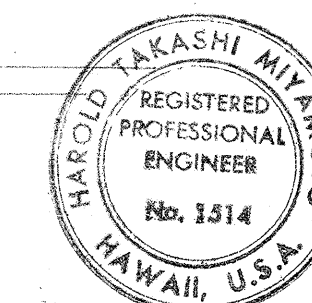

STATE OF HAWAII  
DEPARTMENT OF TRANSPORTATION  
HIGHWAYS DIVISION  
NIMITZ CONNECTOR (E.B.)  
RAMP "A" & RAMP "B"  
PIER A5 DETAIL  
KEEHI INTERCHANGE  
F.A.I. PROJ. NO. 1-HI-1 (168) 17  
Scale: As shown Date: JULY, 1981  
SHEET NO. 5-22 OF 49 SHEETS





| FED. ROAD DIST. NO. | STATE | FED. AID PROJ. NO. | FISCAL YEAR | SHEET NO. | TOTAL SHEETS |
|---------------------|-------|--------------------|-------------|-----------|--------------|
| HAWAII              | HAW.  | 1-HI-1(168)17      | 1982        | 105       | 145          |

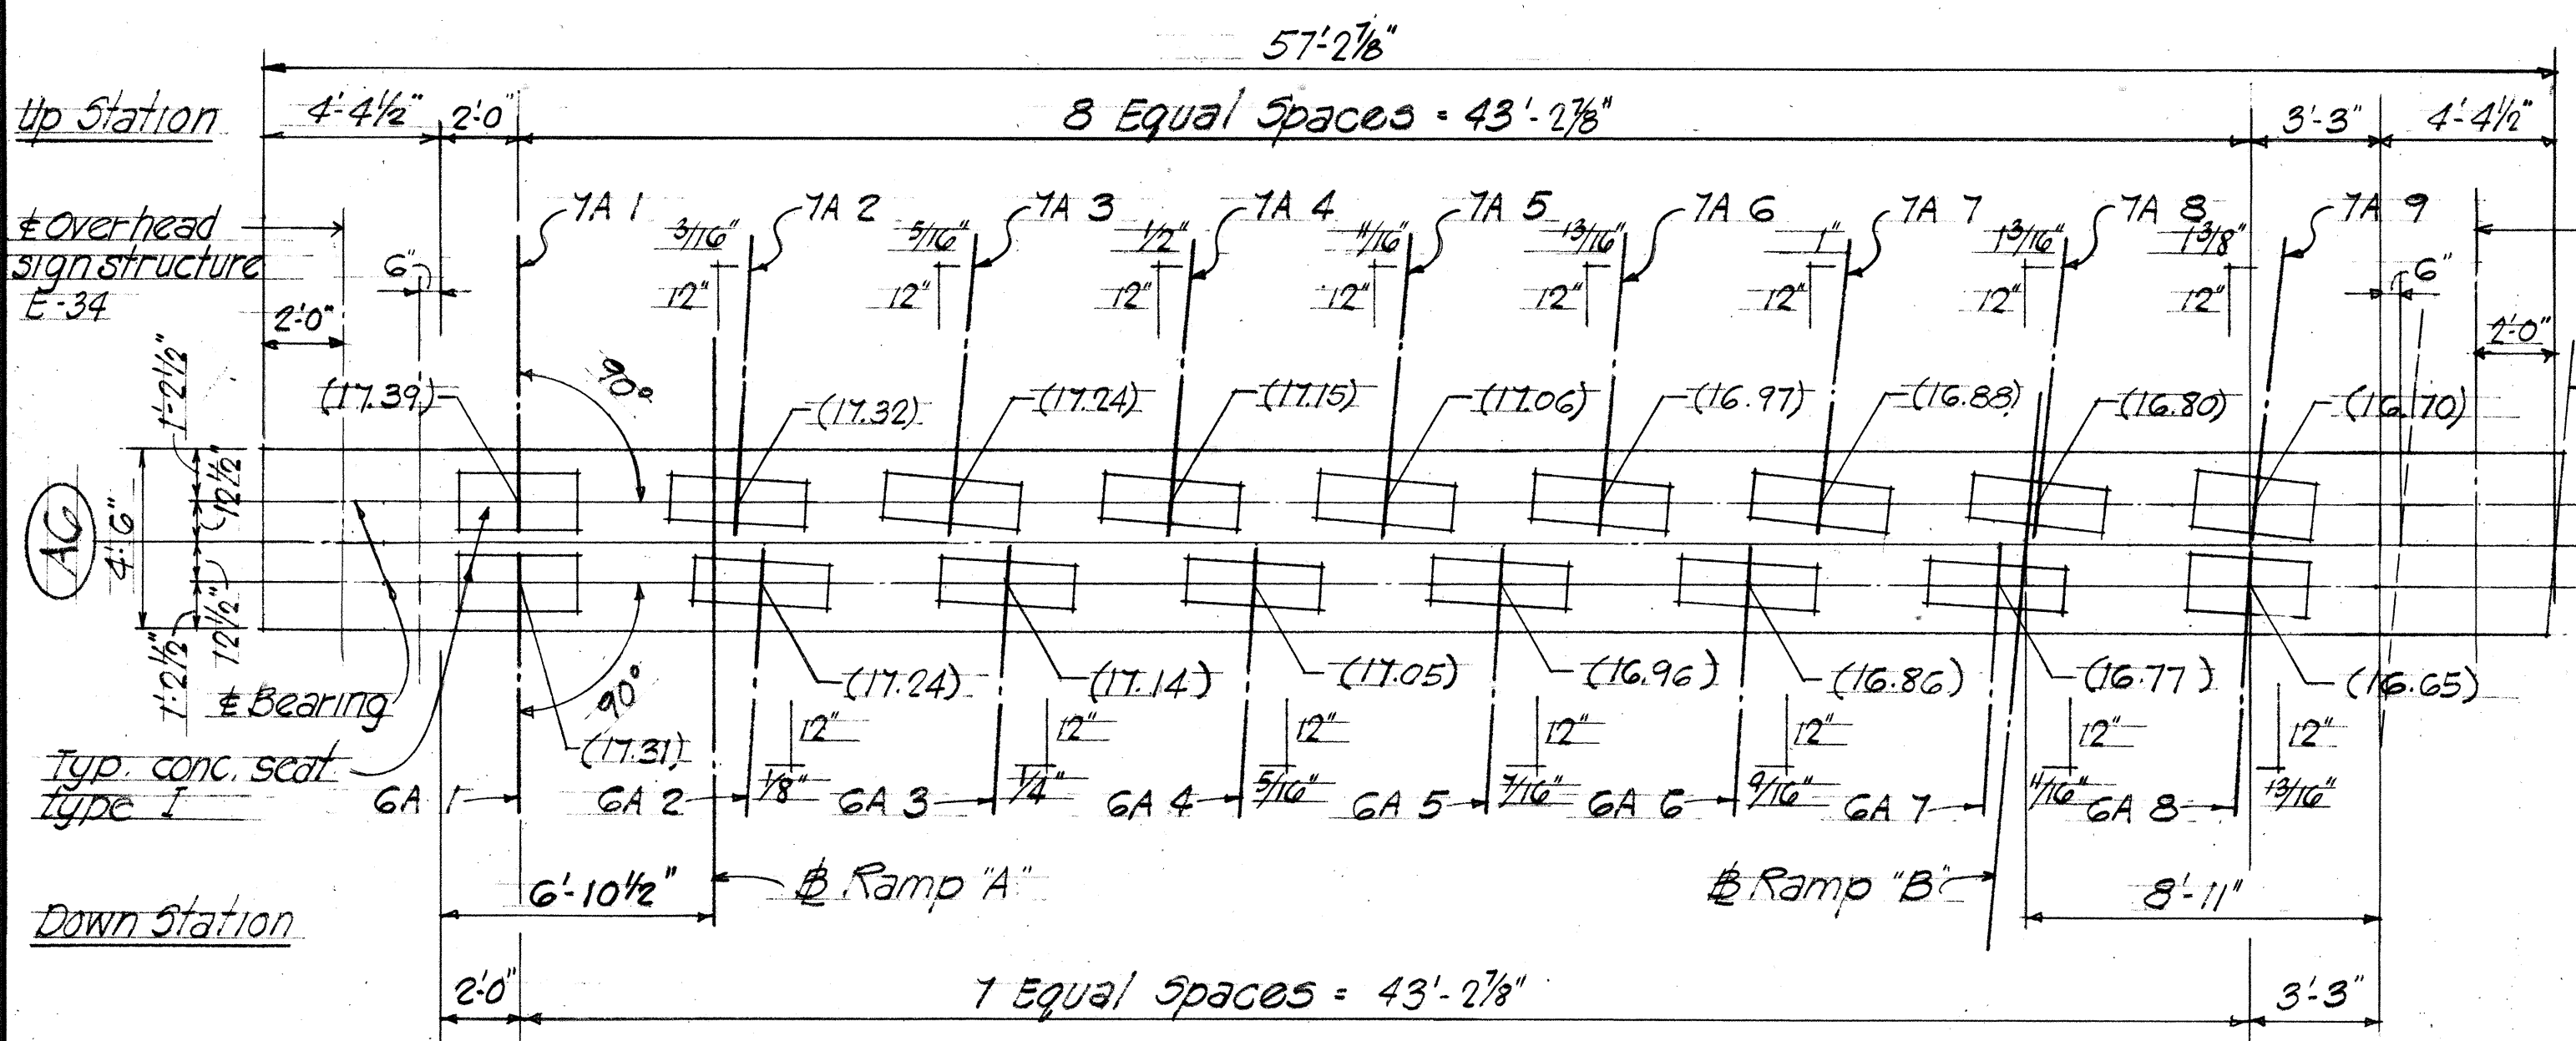

# NOTE

- All #18 & #14 bars shall be grade 60
- For Overhead Sign Structure E-34 See details on Sheet No. E5-1 thru E5-6

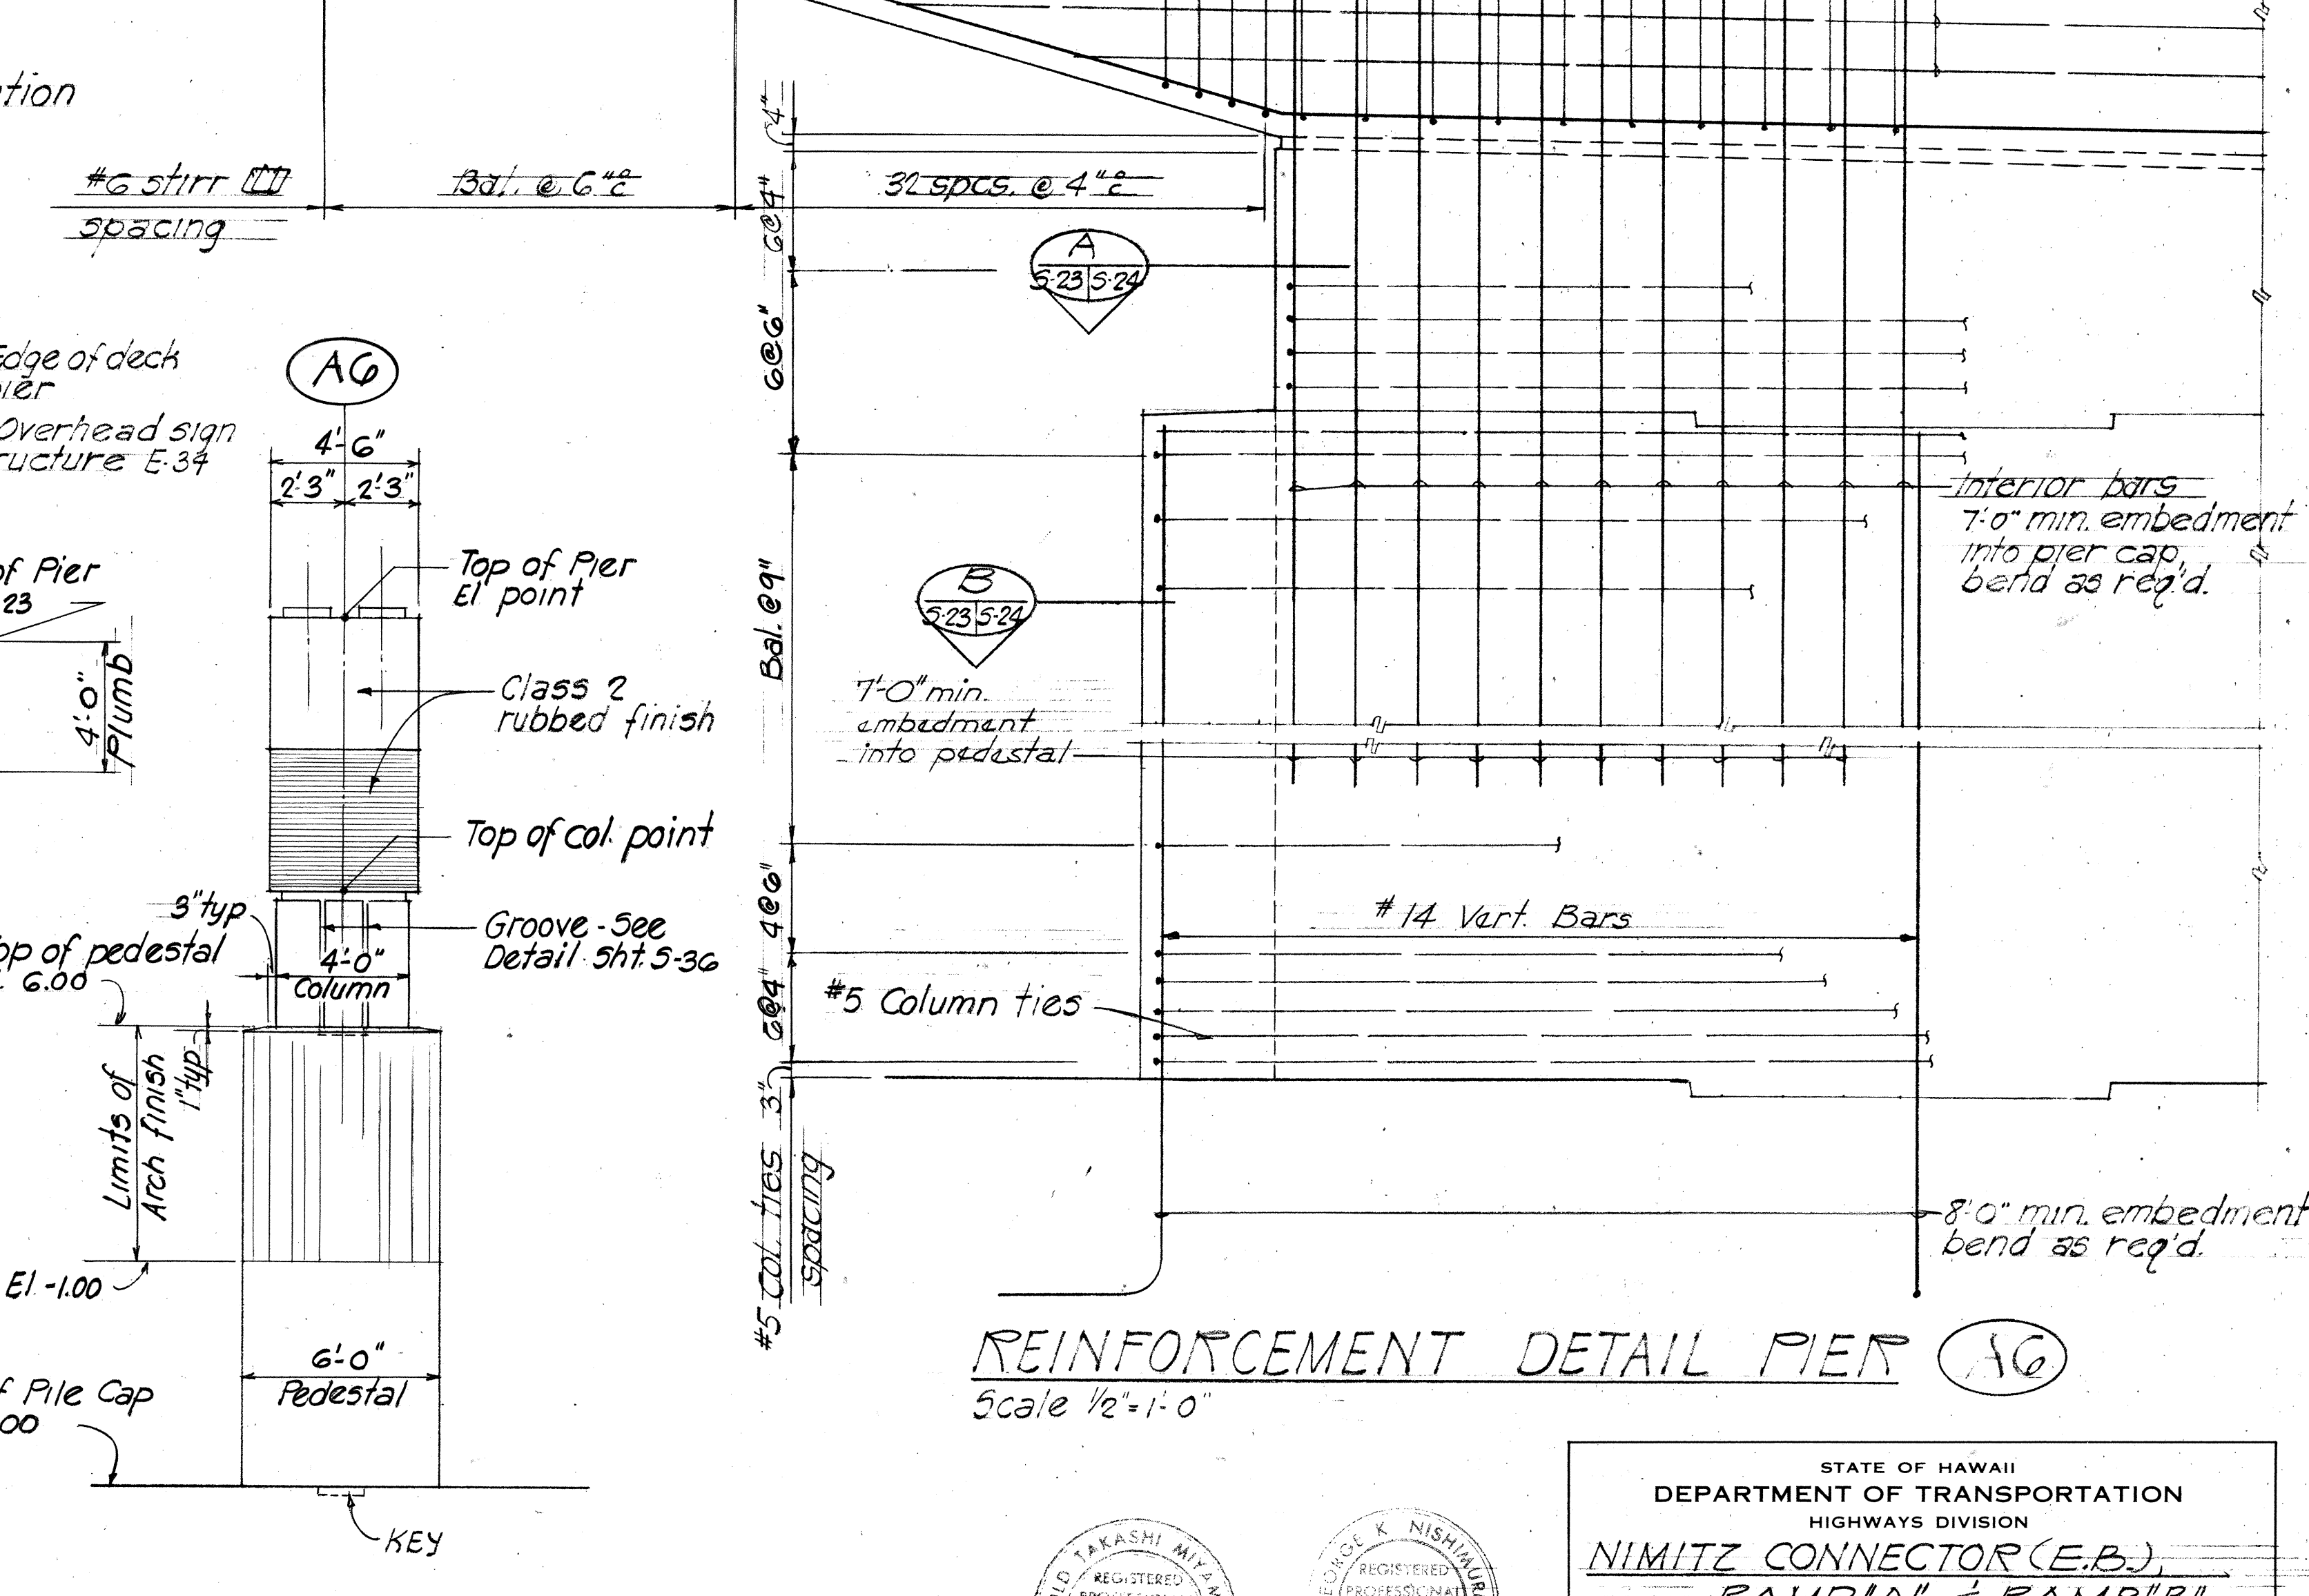
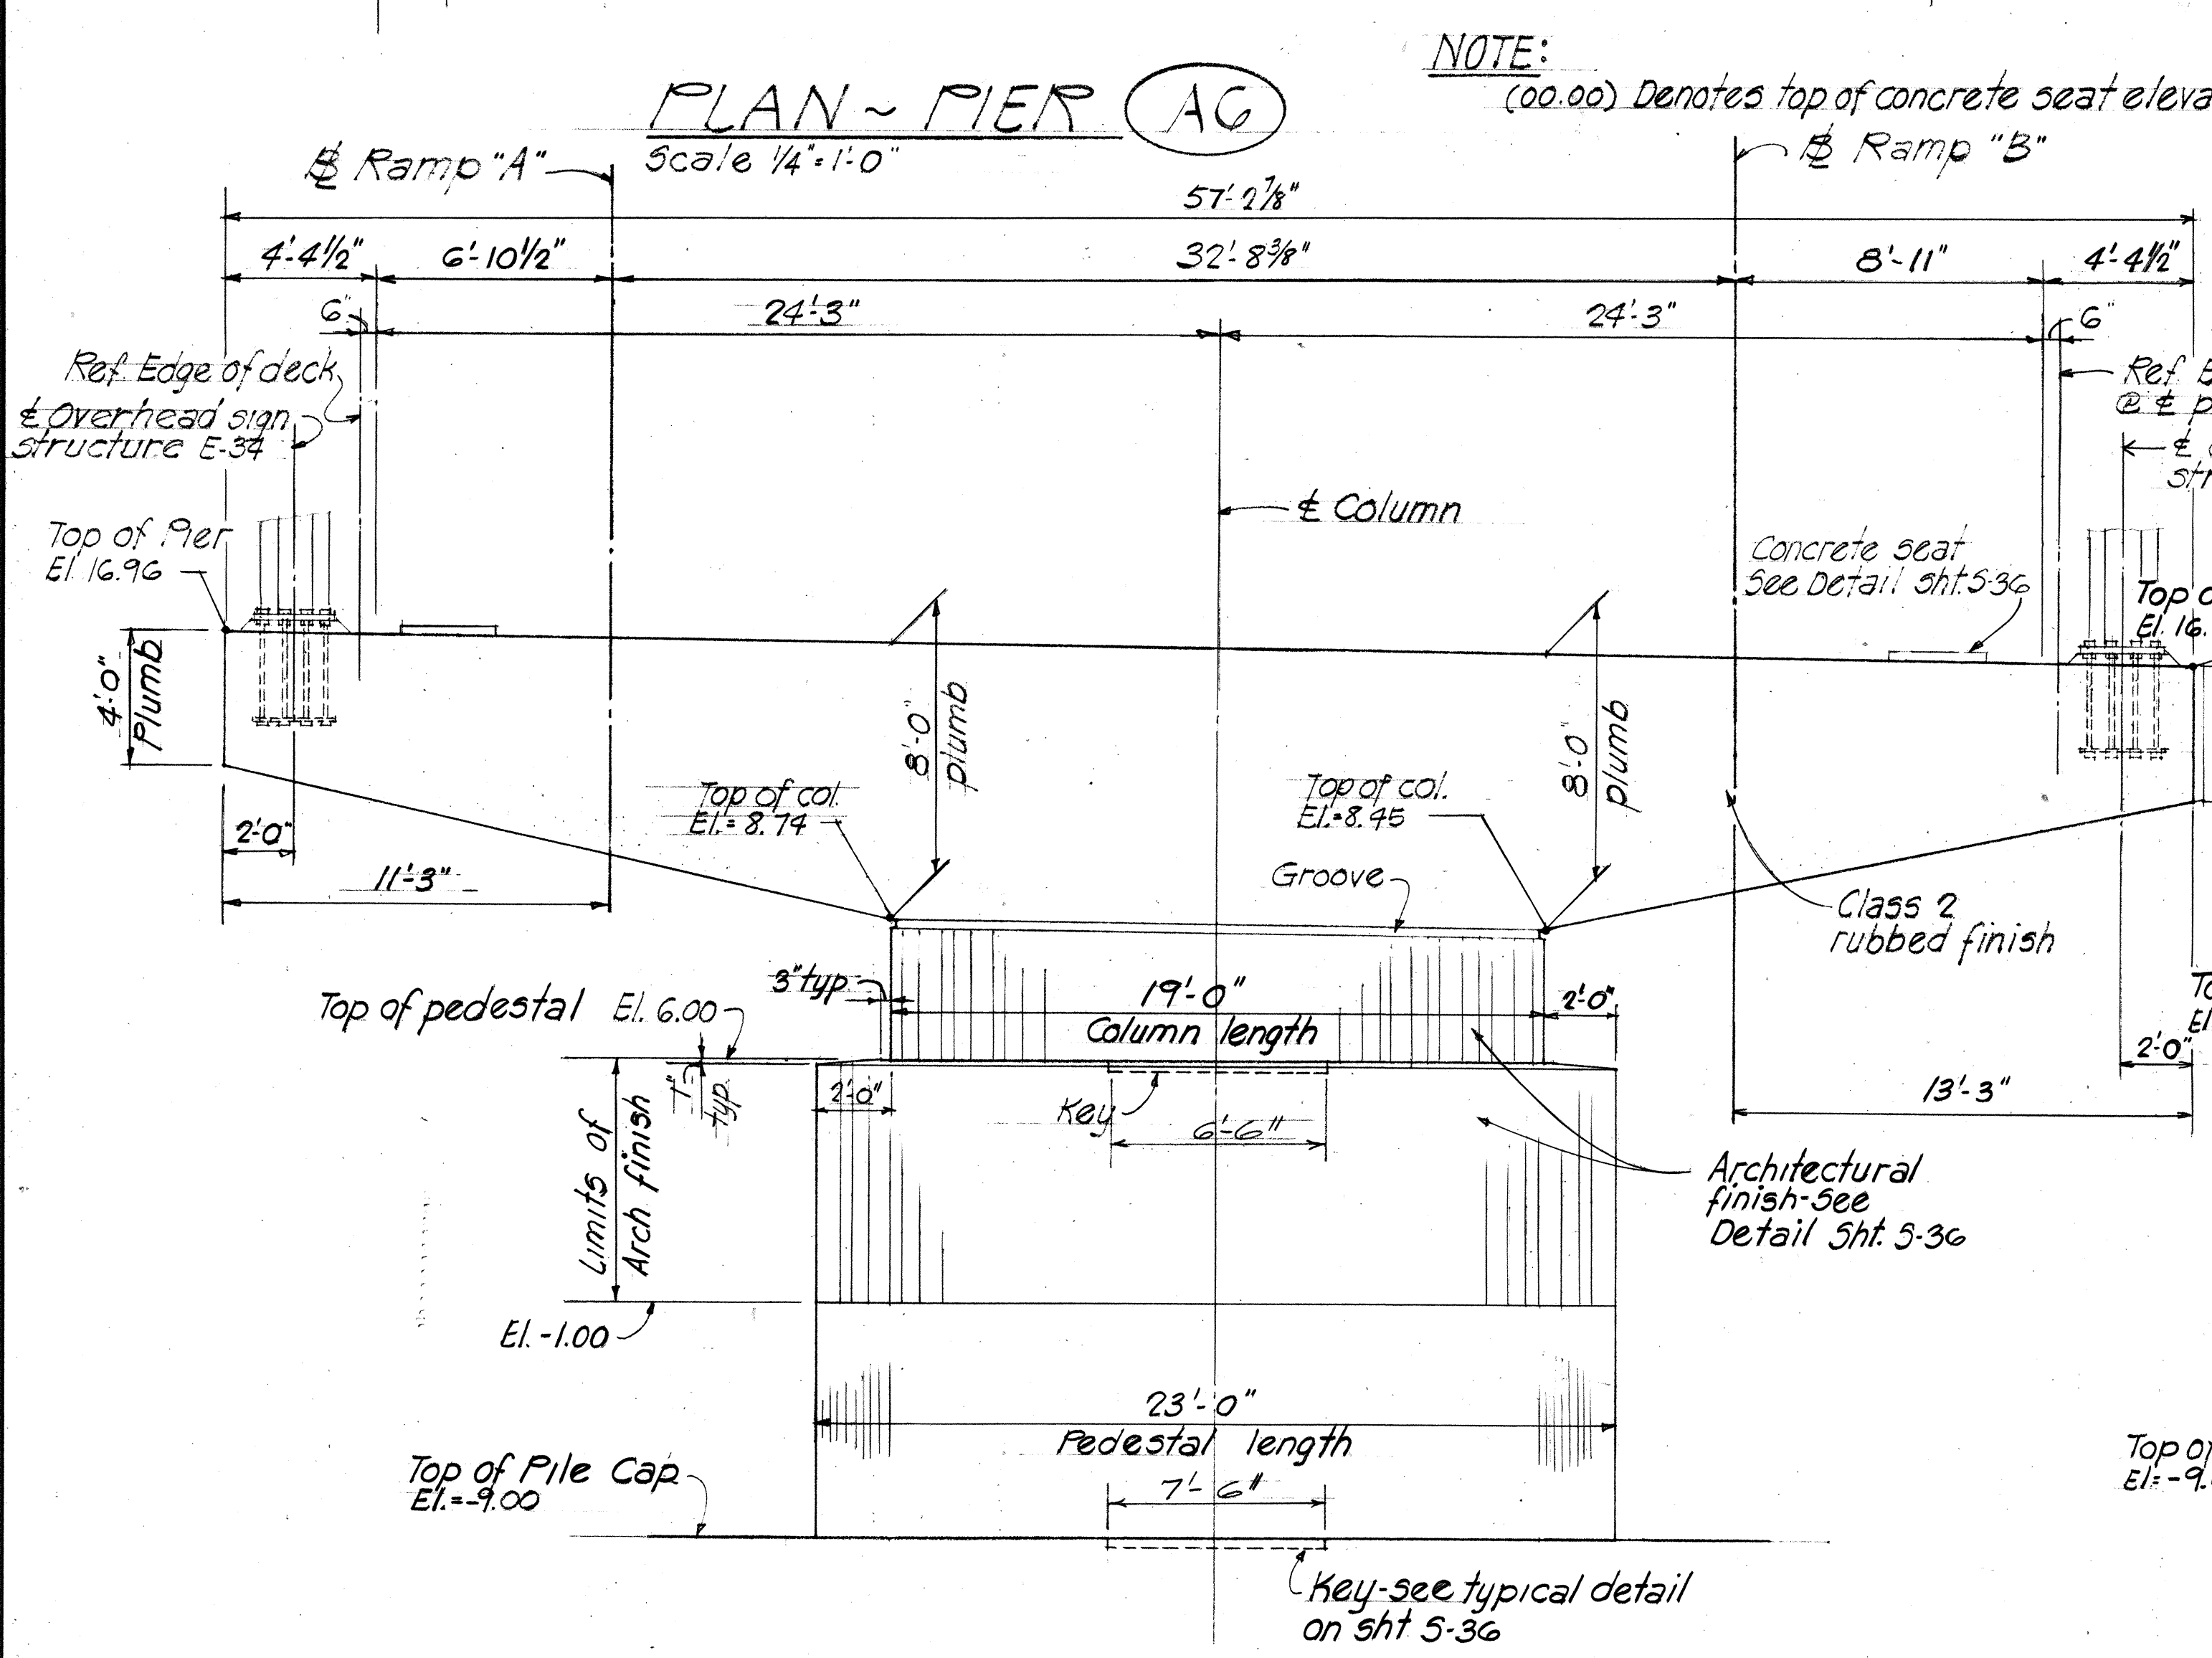


ELEVATION ~ PIER AG  
Scale 1/4" = 1'-0"

END ELEVATION  
Scale 1/4" = 1'-0"

REINFORCEMENT DETAIL PIER AG  
Scale 1/2" = 1'-0"

|            |             |               |
|------------|-------------|---------------|
| DATE       | DESIGNED BY | CHECKED BY    |
| PLANNED BY | TRACED BY   | QUANTITIES BY |
| NOTED BY   | DESIGNED BY | CHECKED BY    |
| ORIGINAL   | DESIGNED BY | CHECKED BY    |
| NO.        | DESIGNED BY | CHECKED BY    |

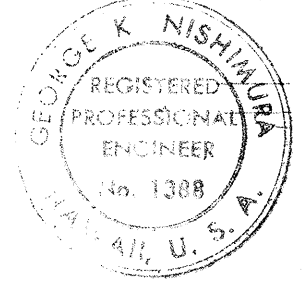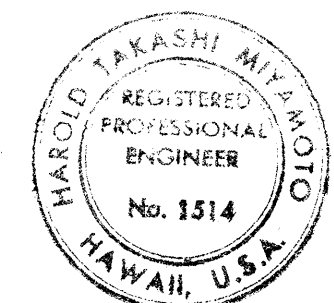

STATE OF HAWAII  
DEPARTMENT OF TRANSPORTATION  
HIGHWAYS DIVISION

NIMITZ CONNECTOR (E.B.)  
RAMP "A" & RAMP "B"


PIER AG DETAIL  
KEEHI INTERCHANGE

FAL PROJ. NO 1-HI-1(168)17  
Scale: As shown Date: JULY, 1981


SHEET No. 5-23 OF 49 SHEETS



| FED. ROAD DIST. NO. | STATE | FED. AID PROJ. NO. | FISCAL YEAR | SHEET NO. | TOTAL SHEETS |
|---------------------|-------|--------------------|-------------|-----------|--------------|
| HAWAII              | HAW.  | 1-HI-1(168)17      | 1982        | 106       | 145          |

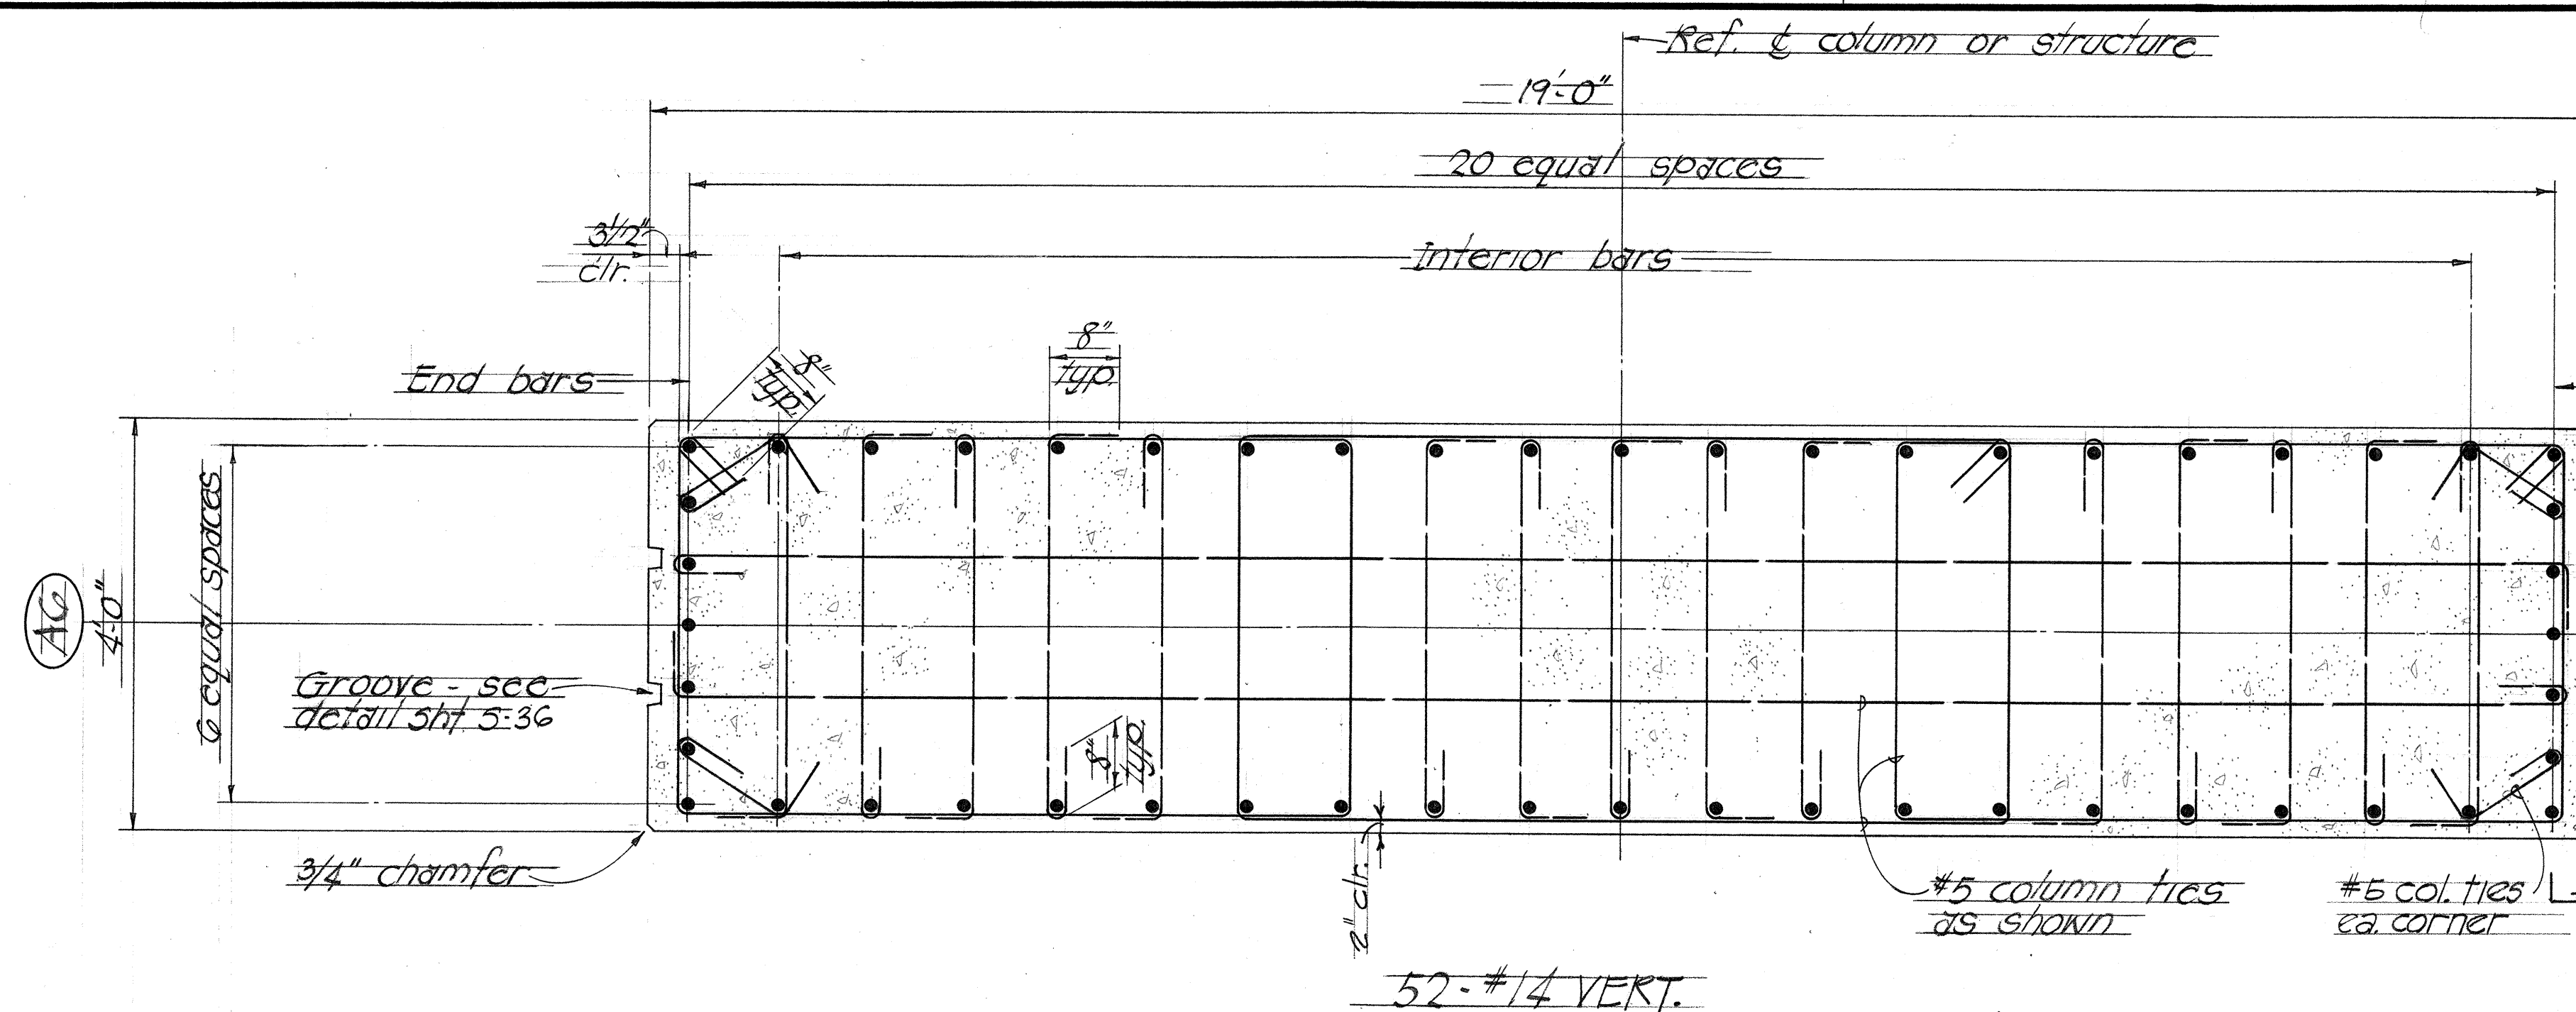


**SECTION A**  
Scale: 3/4" = 1'-0"  
5-23/5-24

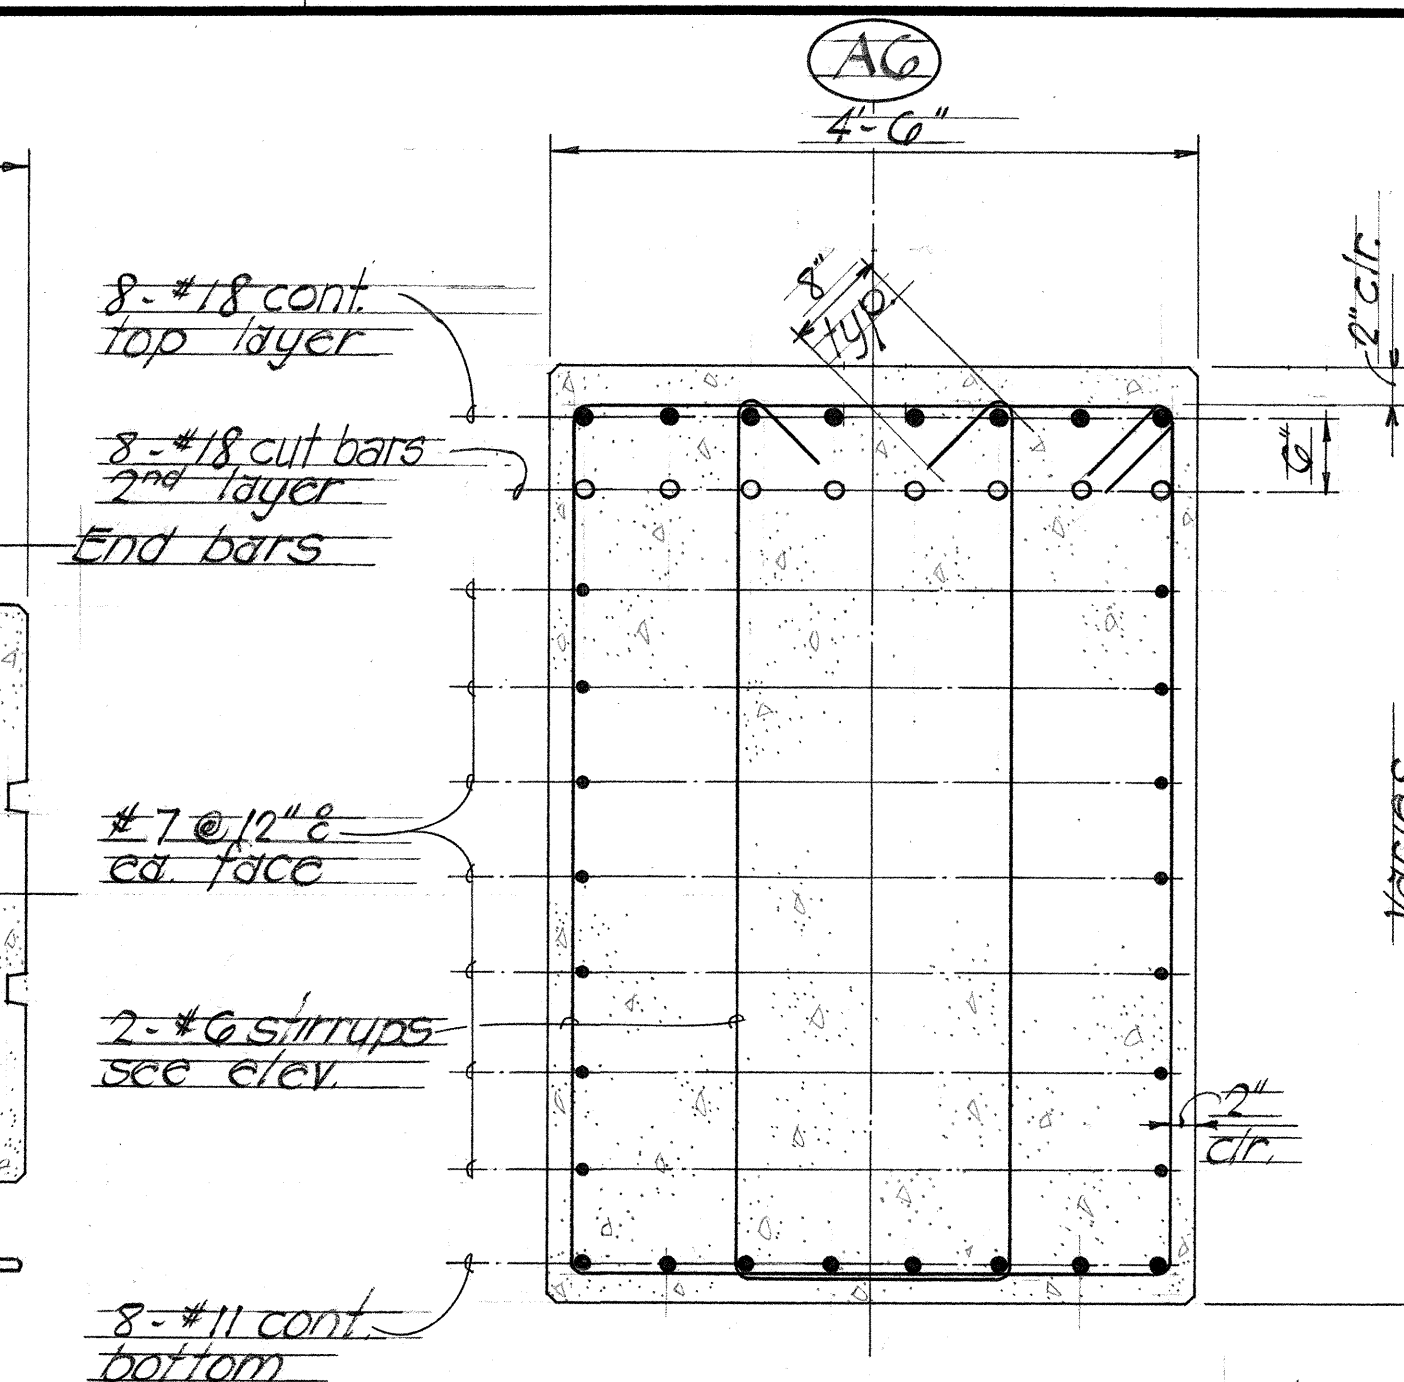

**SECTION C**  
Scale: 3/4" = 1'-0"  
5-23/5-24

For reinforcing  
see section


Groove - see  
detail SHT 5-36

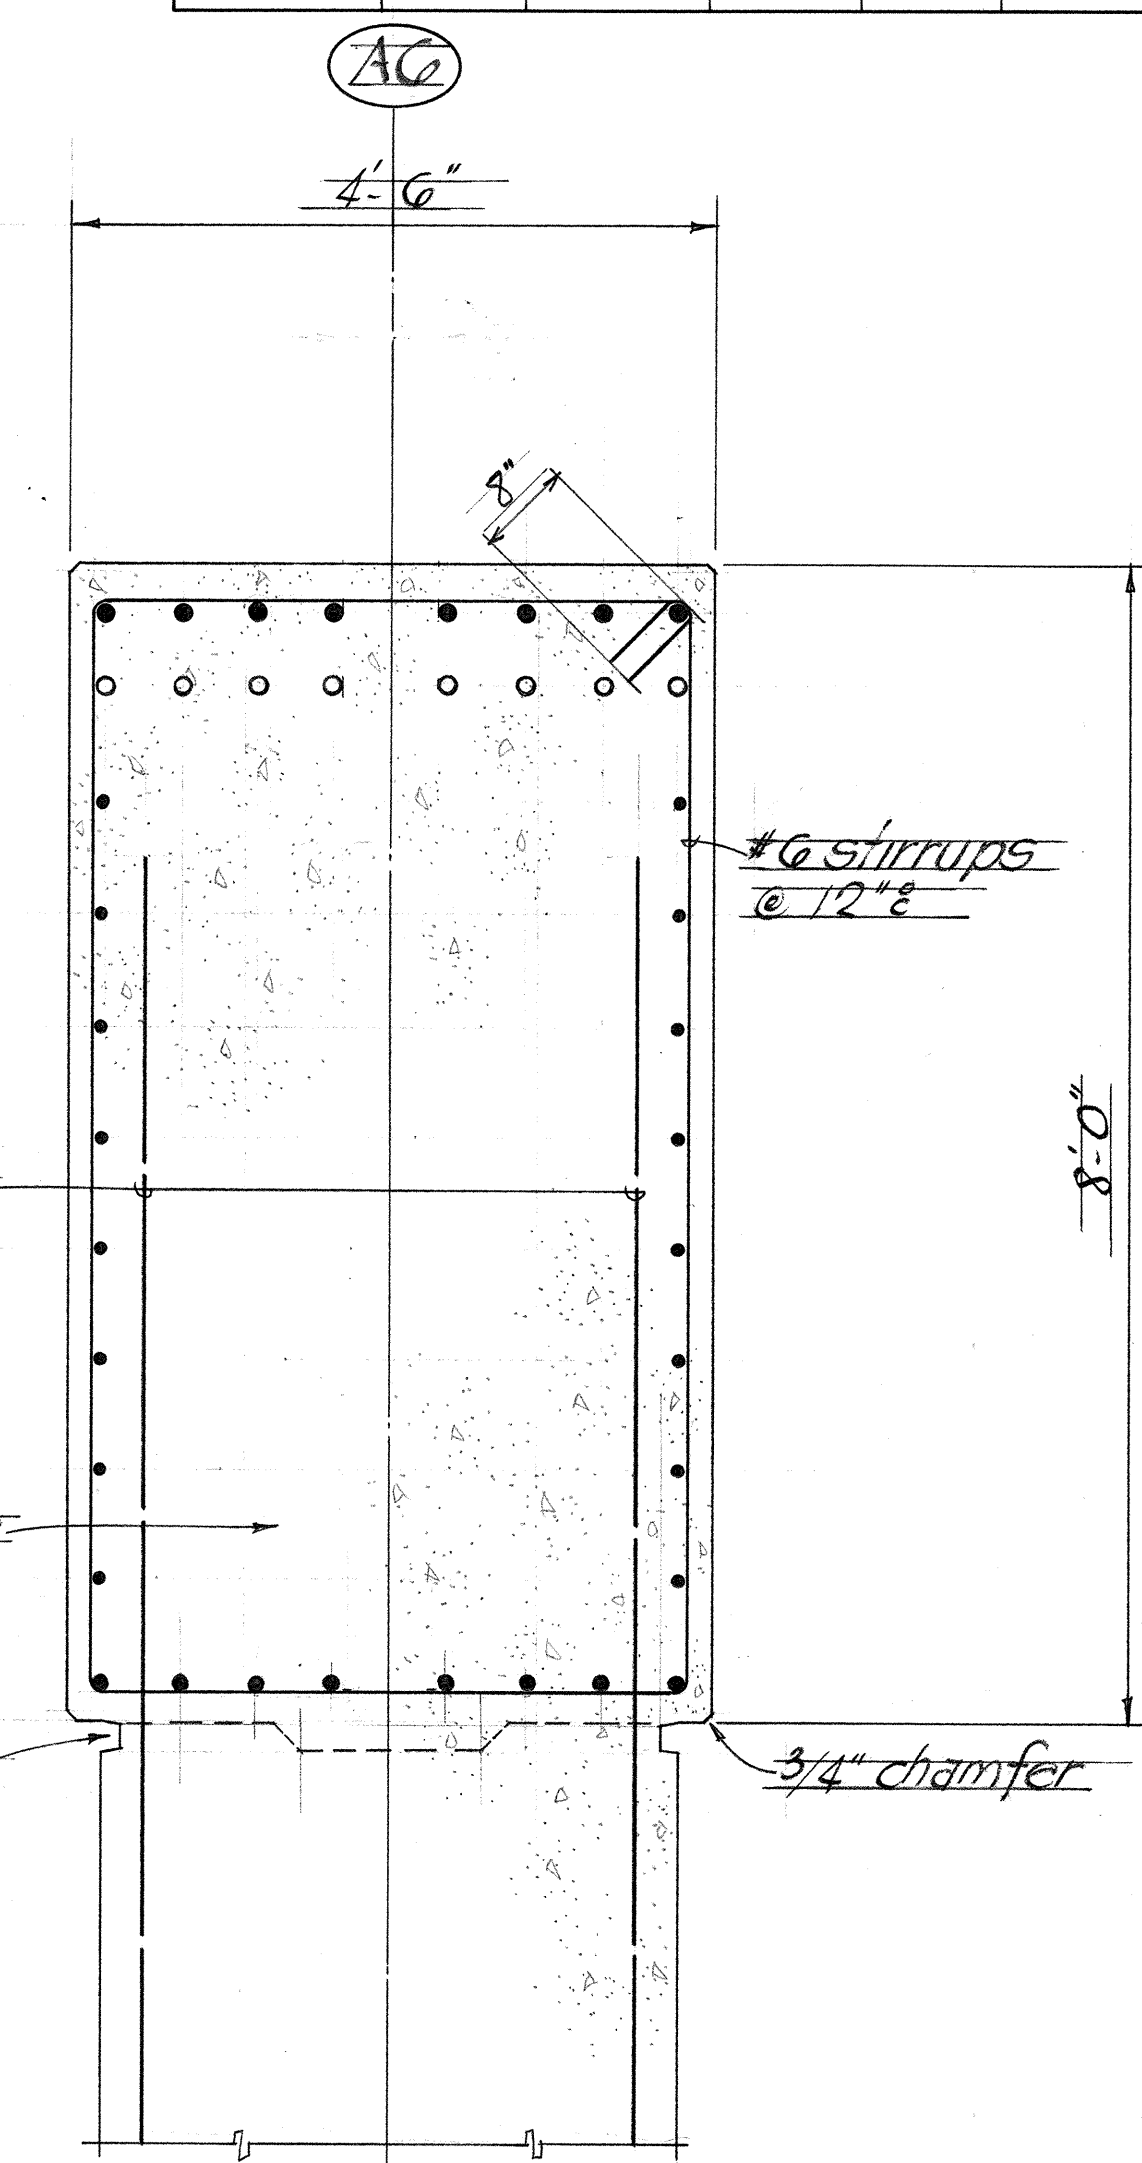

**SECTION D**  
Scale: 3/4" = 1'-0"  
5-23/5-24

**NOTE:**

1. All #18 & #14 bars shall be grade 60.
2. Adjust pier cap top main reinforcing spacing to clear bearing plate anchor bolts.

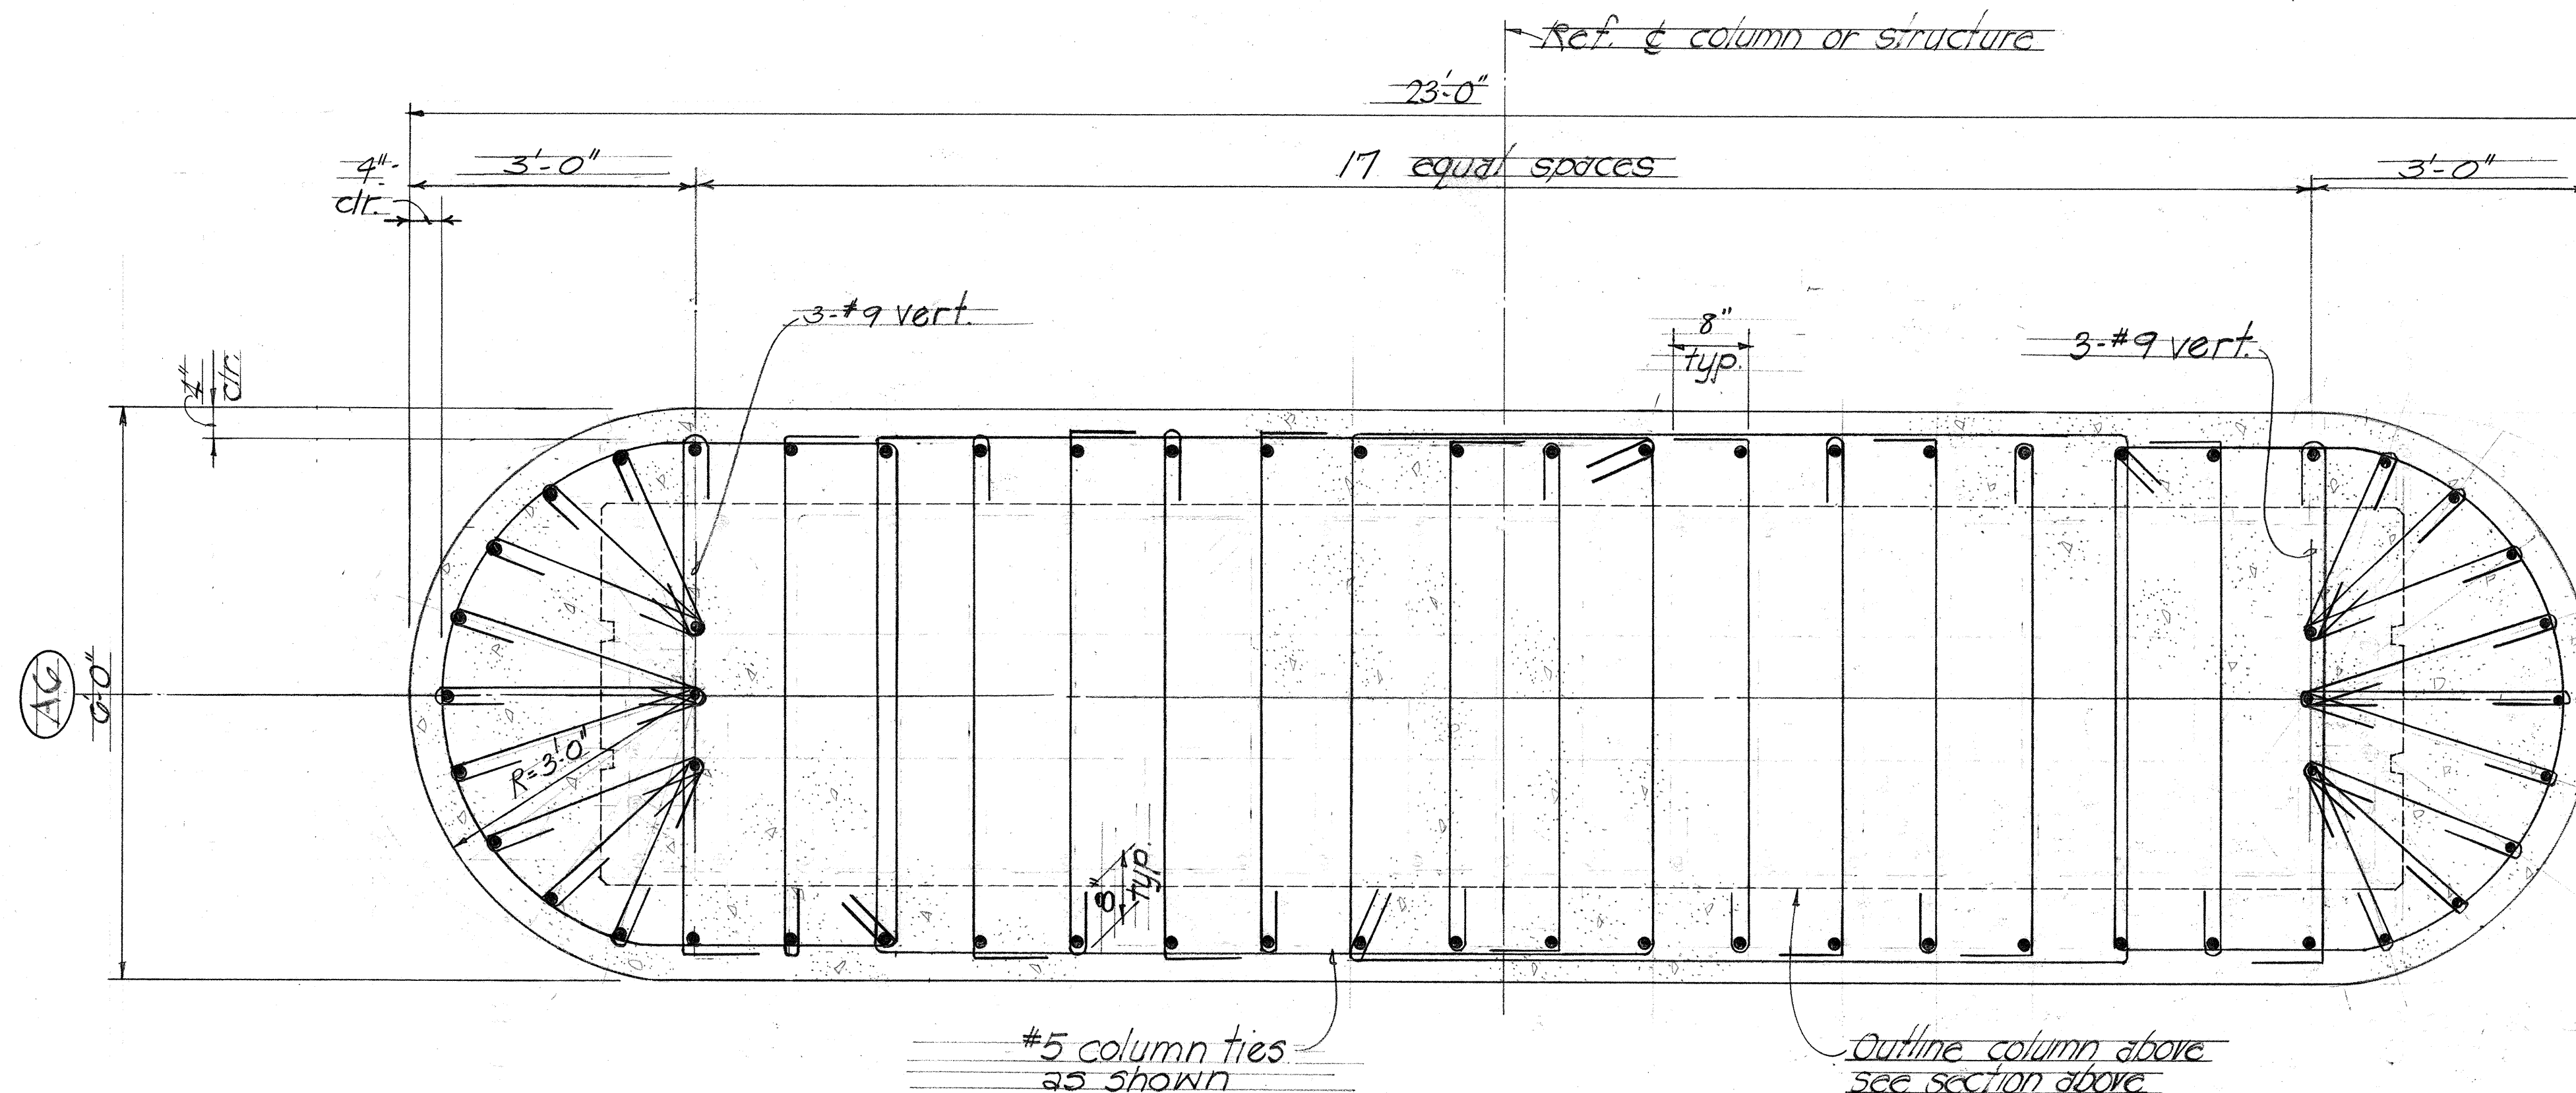


**SECTION B**  
Scale: 3/4" = 1'-0"  
5-23/5-24

Outline column above  
see section above



THIS WORK WAS PREPARED BY  
ME OR UNDER MY SUPERVISION

*Harold Takashi Miyamoto*

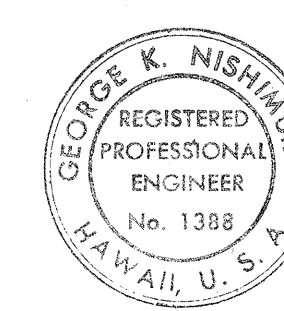


THIS WORK WAS PREPARED BY  
ME OR UNDER MY SUPERVISION

*George K. Nishimura*

STATE OF HAWAII  
DEPARTMENT OF TRANSPORTATION  
HIGHWAYS DIVISION  
**NIMITZ CONNECTOR (E.B.)**  
**RAMP "A" & RAMP "B"**  
**PIER AG DETAIL**  
**KEEHI INTERCHANGE**  
F.A.I. PROJ. NO. 1-HI-1 (168)17  
Scale: As shown Date: JULY, 1981  
SHEET NO. 5-24 OF 49 SHEETS



| FED. ROAD DIST. NO. | STATE | FED. AID PROJ. NO. | FISCAL YEAR | SHEET NO. | TOTAL SHEETS |
|---------------------|-------|--------------------|-------------|-----------|--------------|
| HAWAII              | HAW.  | 1-HI-1(168)17      | 1982        | 107       | 145          |

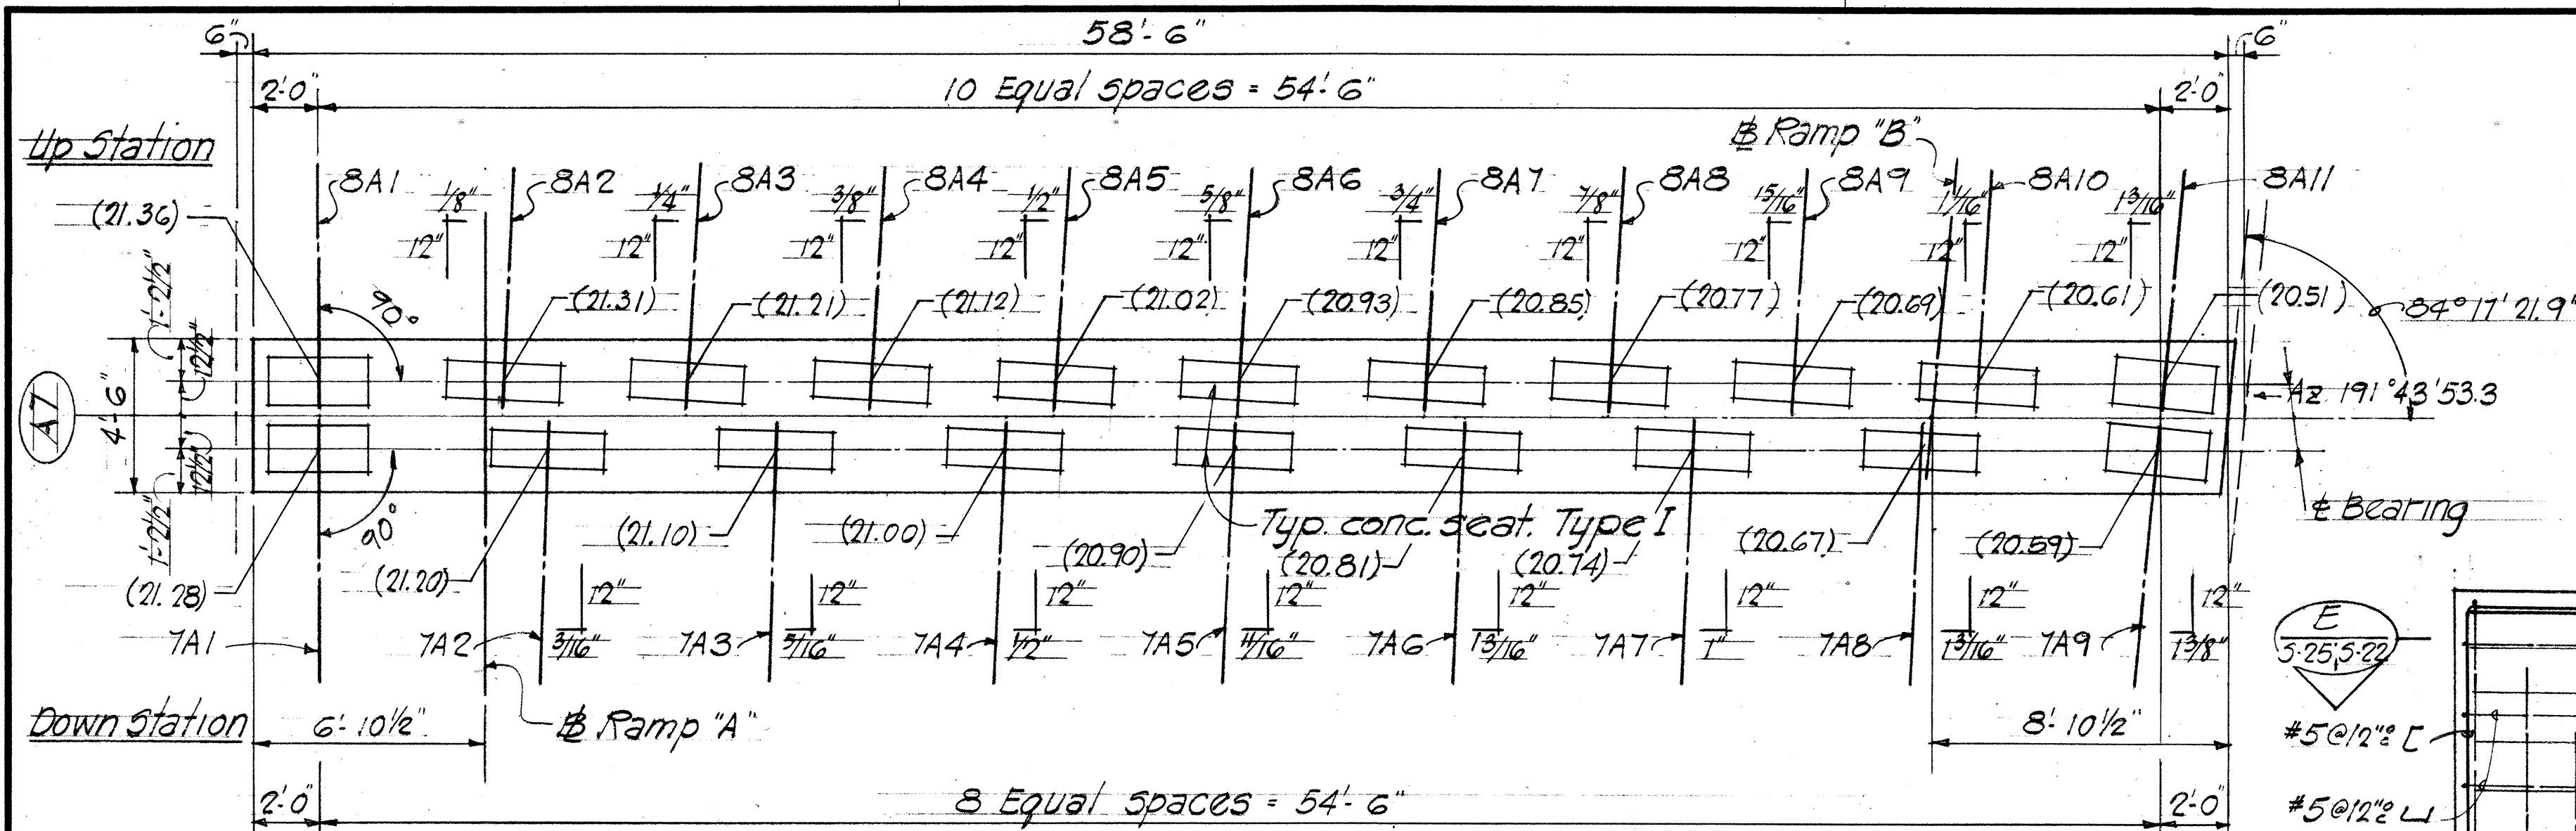


NOTE: All #18 & #14 bars shall be Grade 60


Reinforcing Symm. about pier cap

PLAN ~ PIER (A7)  
Scale 1/4" = 1'-0"

NOTE: (00.00) Denotes top of concrete seat elevation


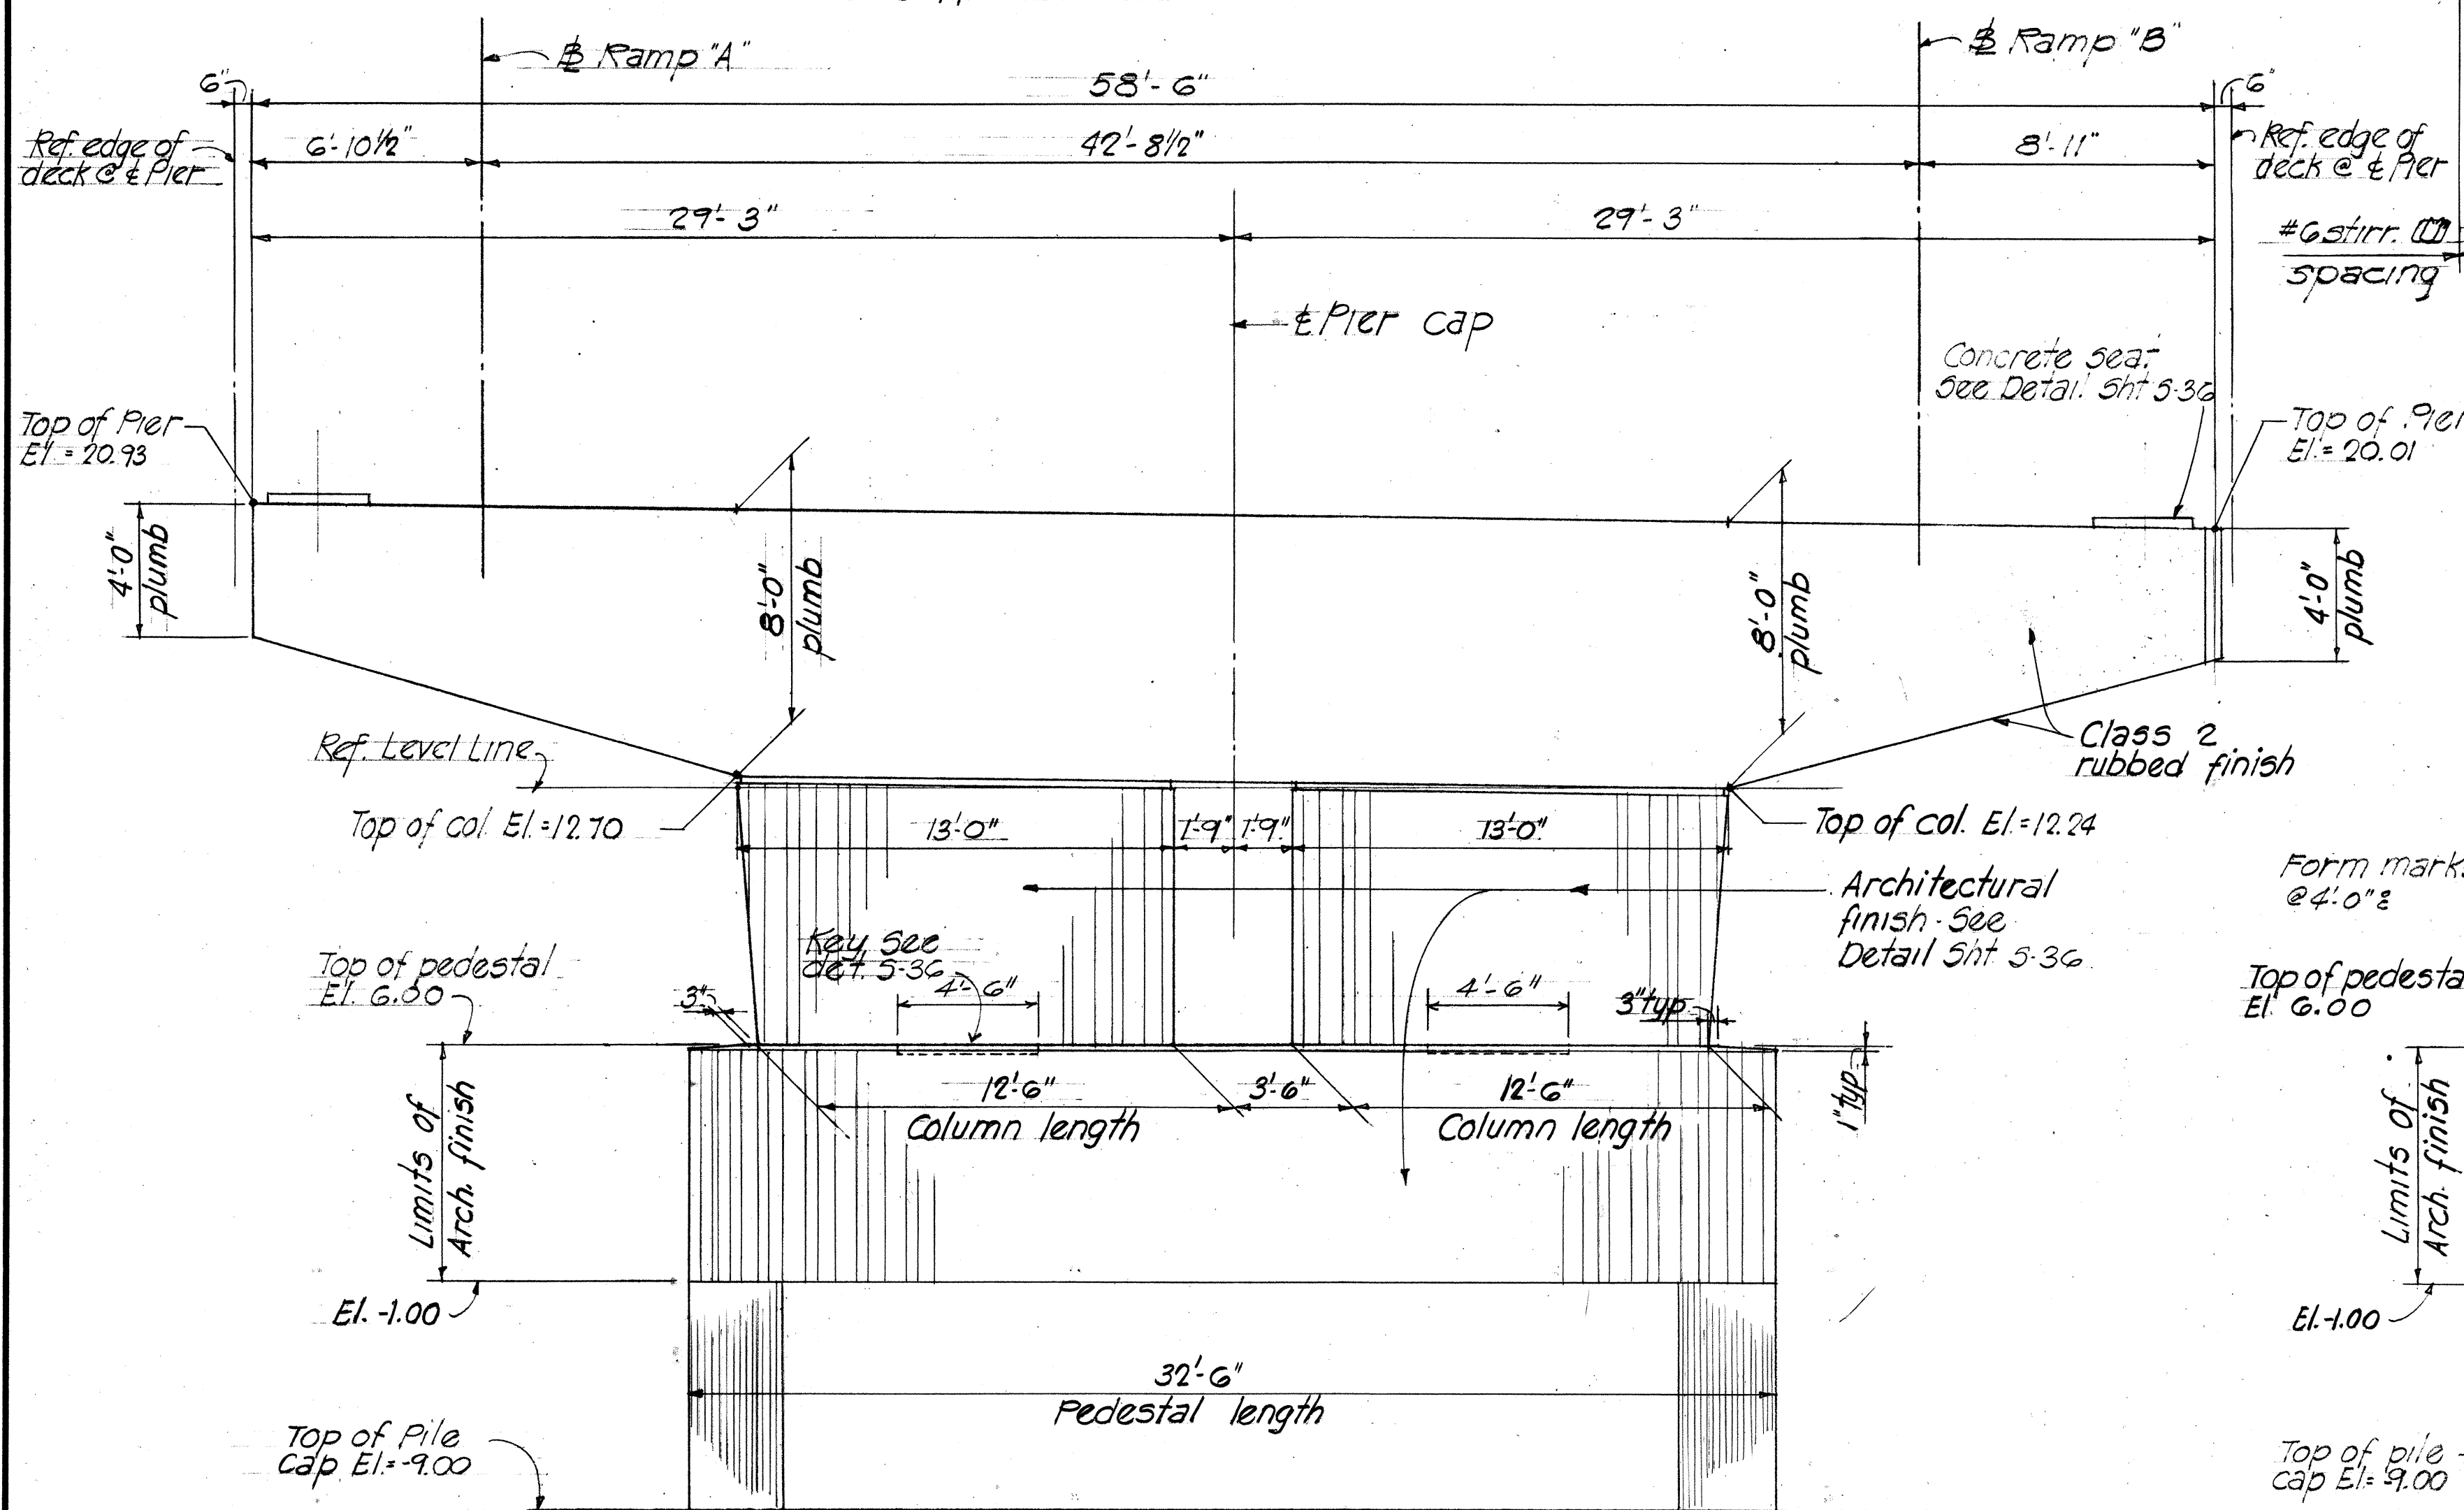


ELEVATION ~ PIER (A7)  
Scale 1/4" = 1'-0"

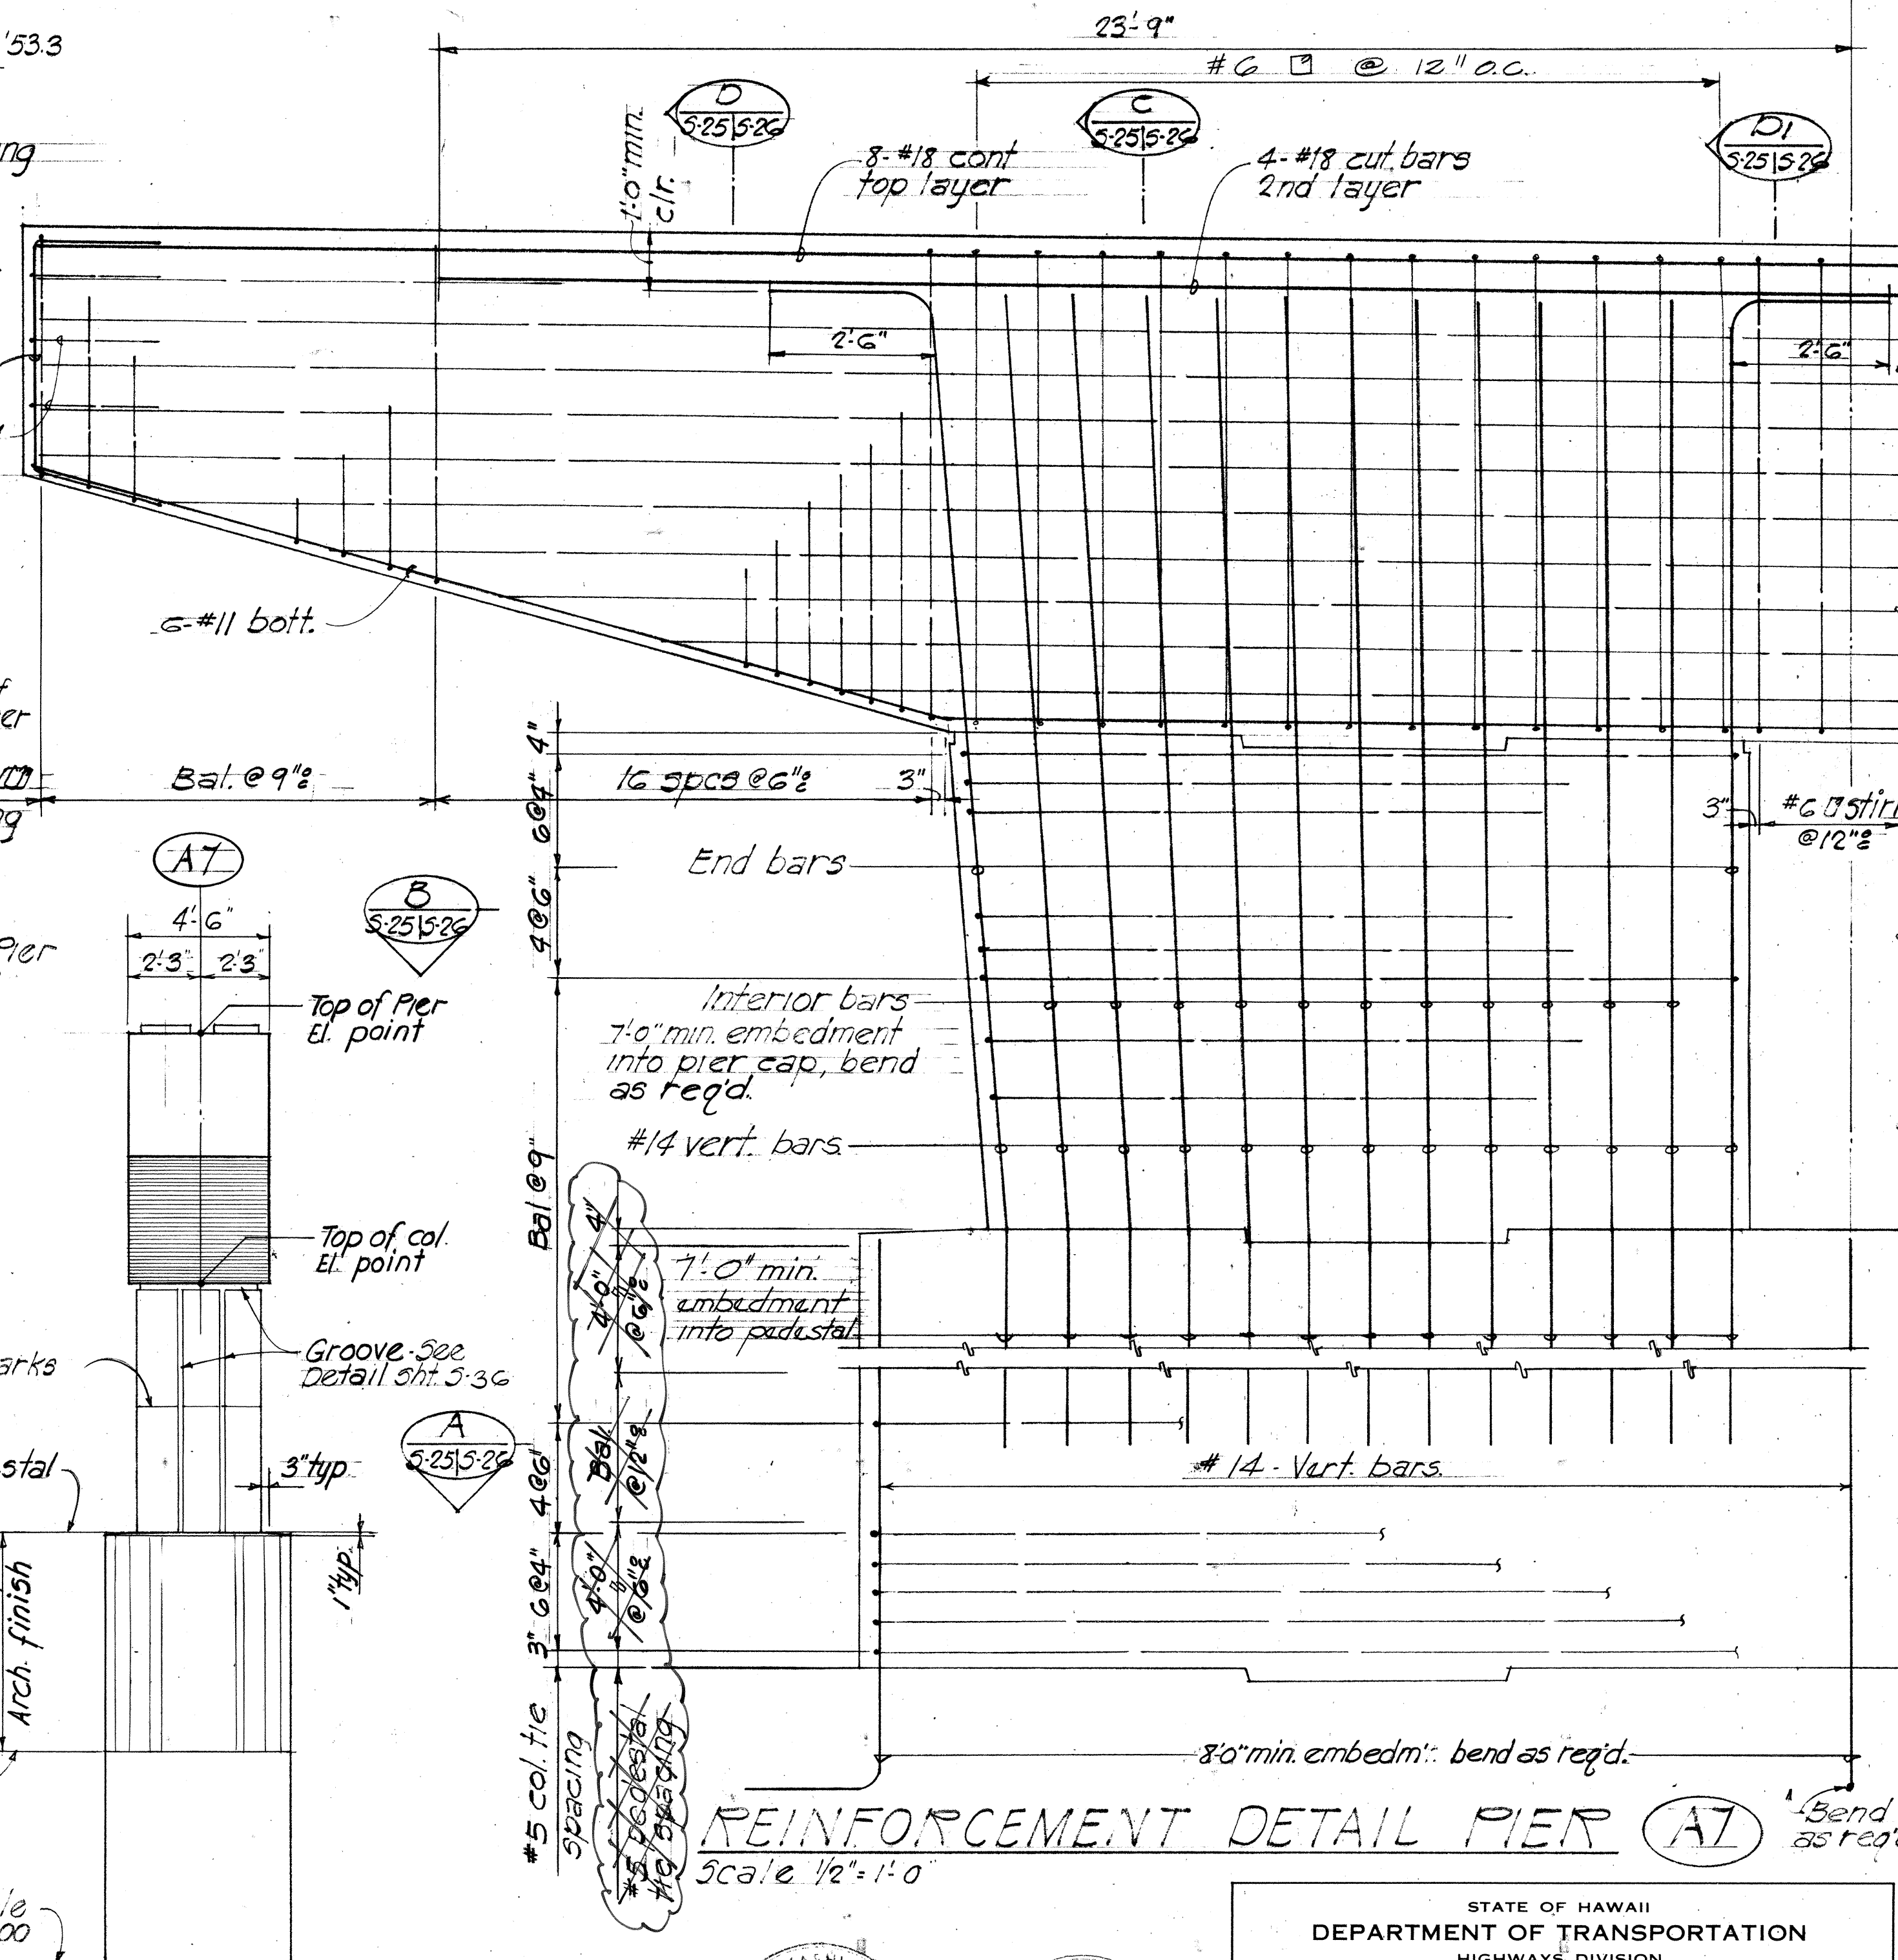

REINFORCEMENT DETAIL PIER (A7)  
Scale 1/2" = 1'-0"

SURVEY PLOTTED BY: \_\_\_\_\_  
DATE: \_\_\_\_\_  
DRAWN BY: \_\_\_\_\_  
DESIGNED BY: \_\_\_\_\_  
NOTE BOOK: \_\_\_\_\_  
QUANTITIES BY: \_\_\_\_\_  
CHECKED BY: \_\_\_\_\_  
No. \_\_\_\_\_

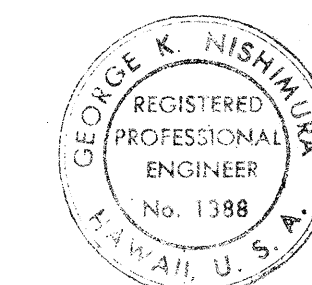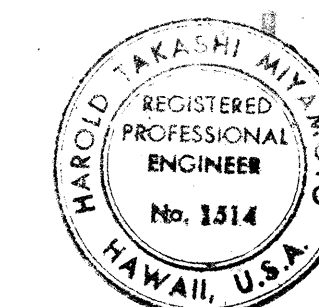


THIS WORK WAS PREPARED BY ME OR UNDER MY SUPERVISION

THIS WORK WAS PREPARED BY ME OR UNDER MY SUPERVISION


STATE OF HAWAII  
DEPARTMENT OF TRANSPORTATION  
HIGHWAYS DIVISION  
NIMITZ CONNECTOR (E.B.)  
RAMP "A" & RAMP "B"  
PIER A7 DETAIL  
KEEHI INTERCHANGE  
F.A.I. PROJ. NO. 1-HI-1(168)17  
Scale: AS SHOWN Date: JULY, 1981  
SHEET NO. 25 OF 49 SHEETS



| FED. ROAD DIST. NO. | STATE | FED. AID PROJ. NO. | FISCAL YEAR | SHEET NO. | TOTAL SHEETS |
|---------------------|-------|--------------------|-------------|-----------|--------------|
| HAWAII              | HAW.  | 1-HI-(68)17        | 1982        | 108       | 145          |

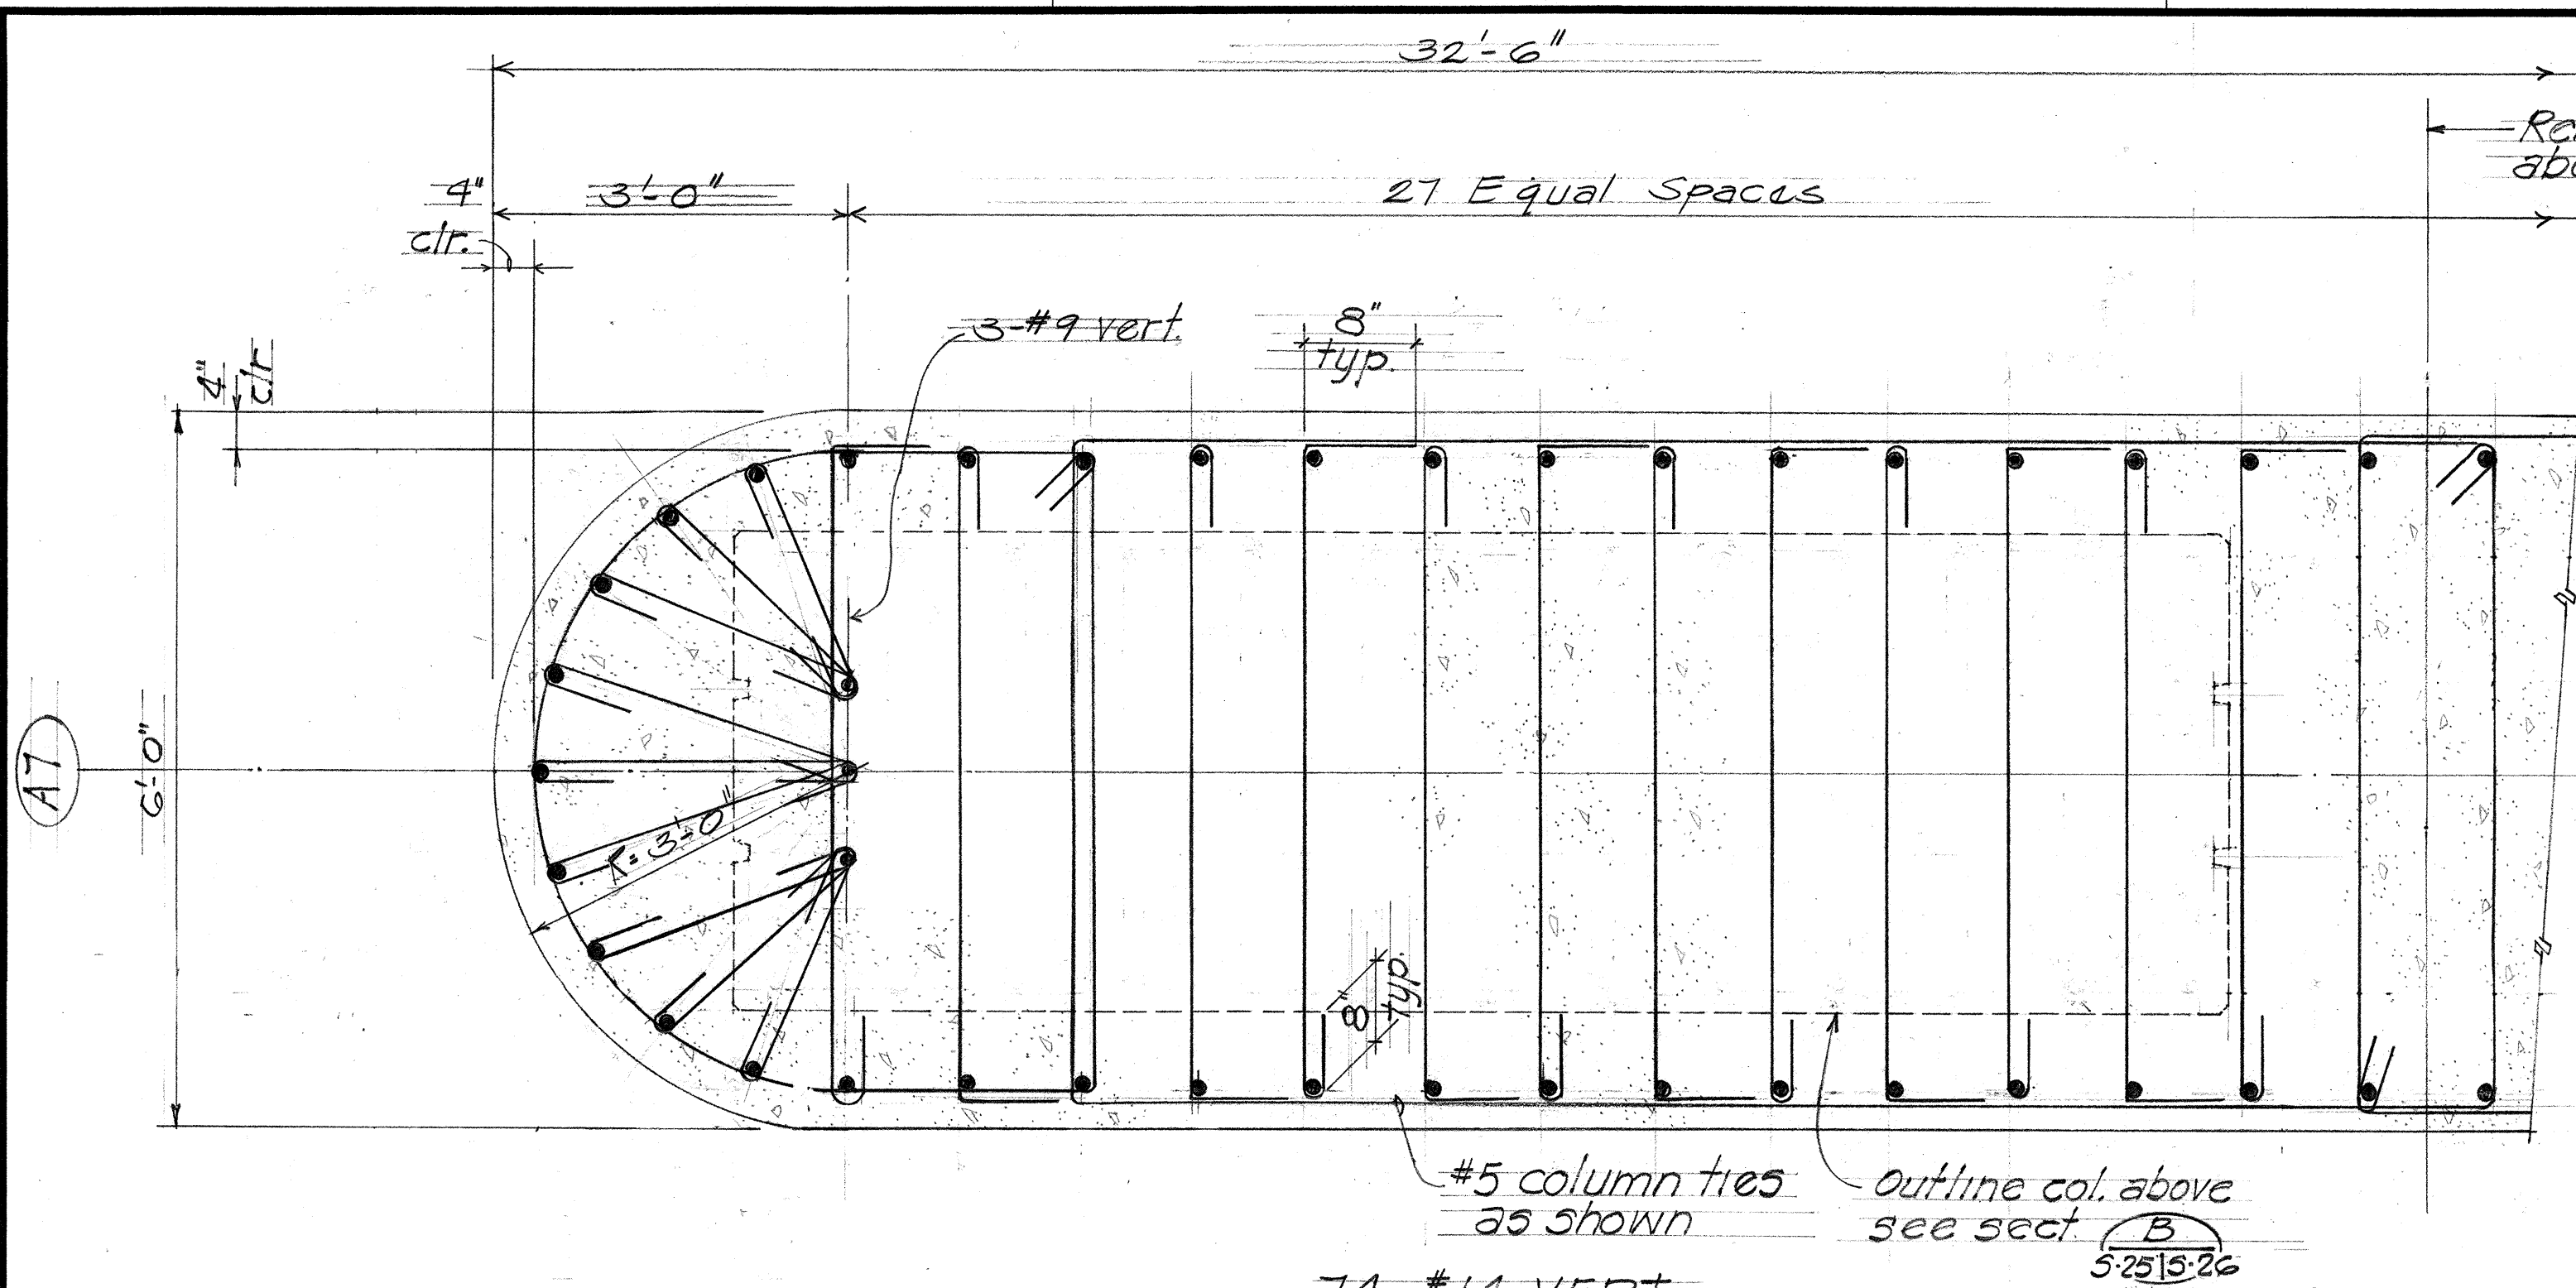


SECTION A  
Scale 3/4"=1'-0"  
5-2515-26

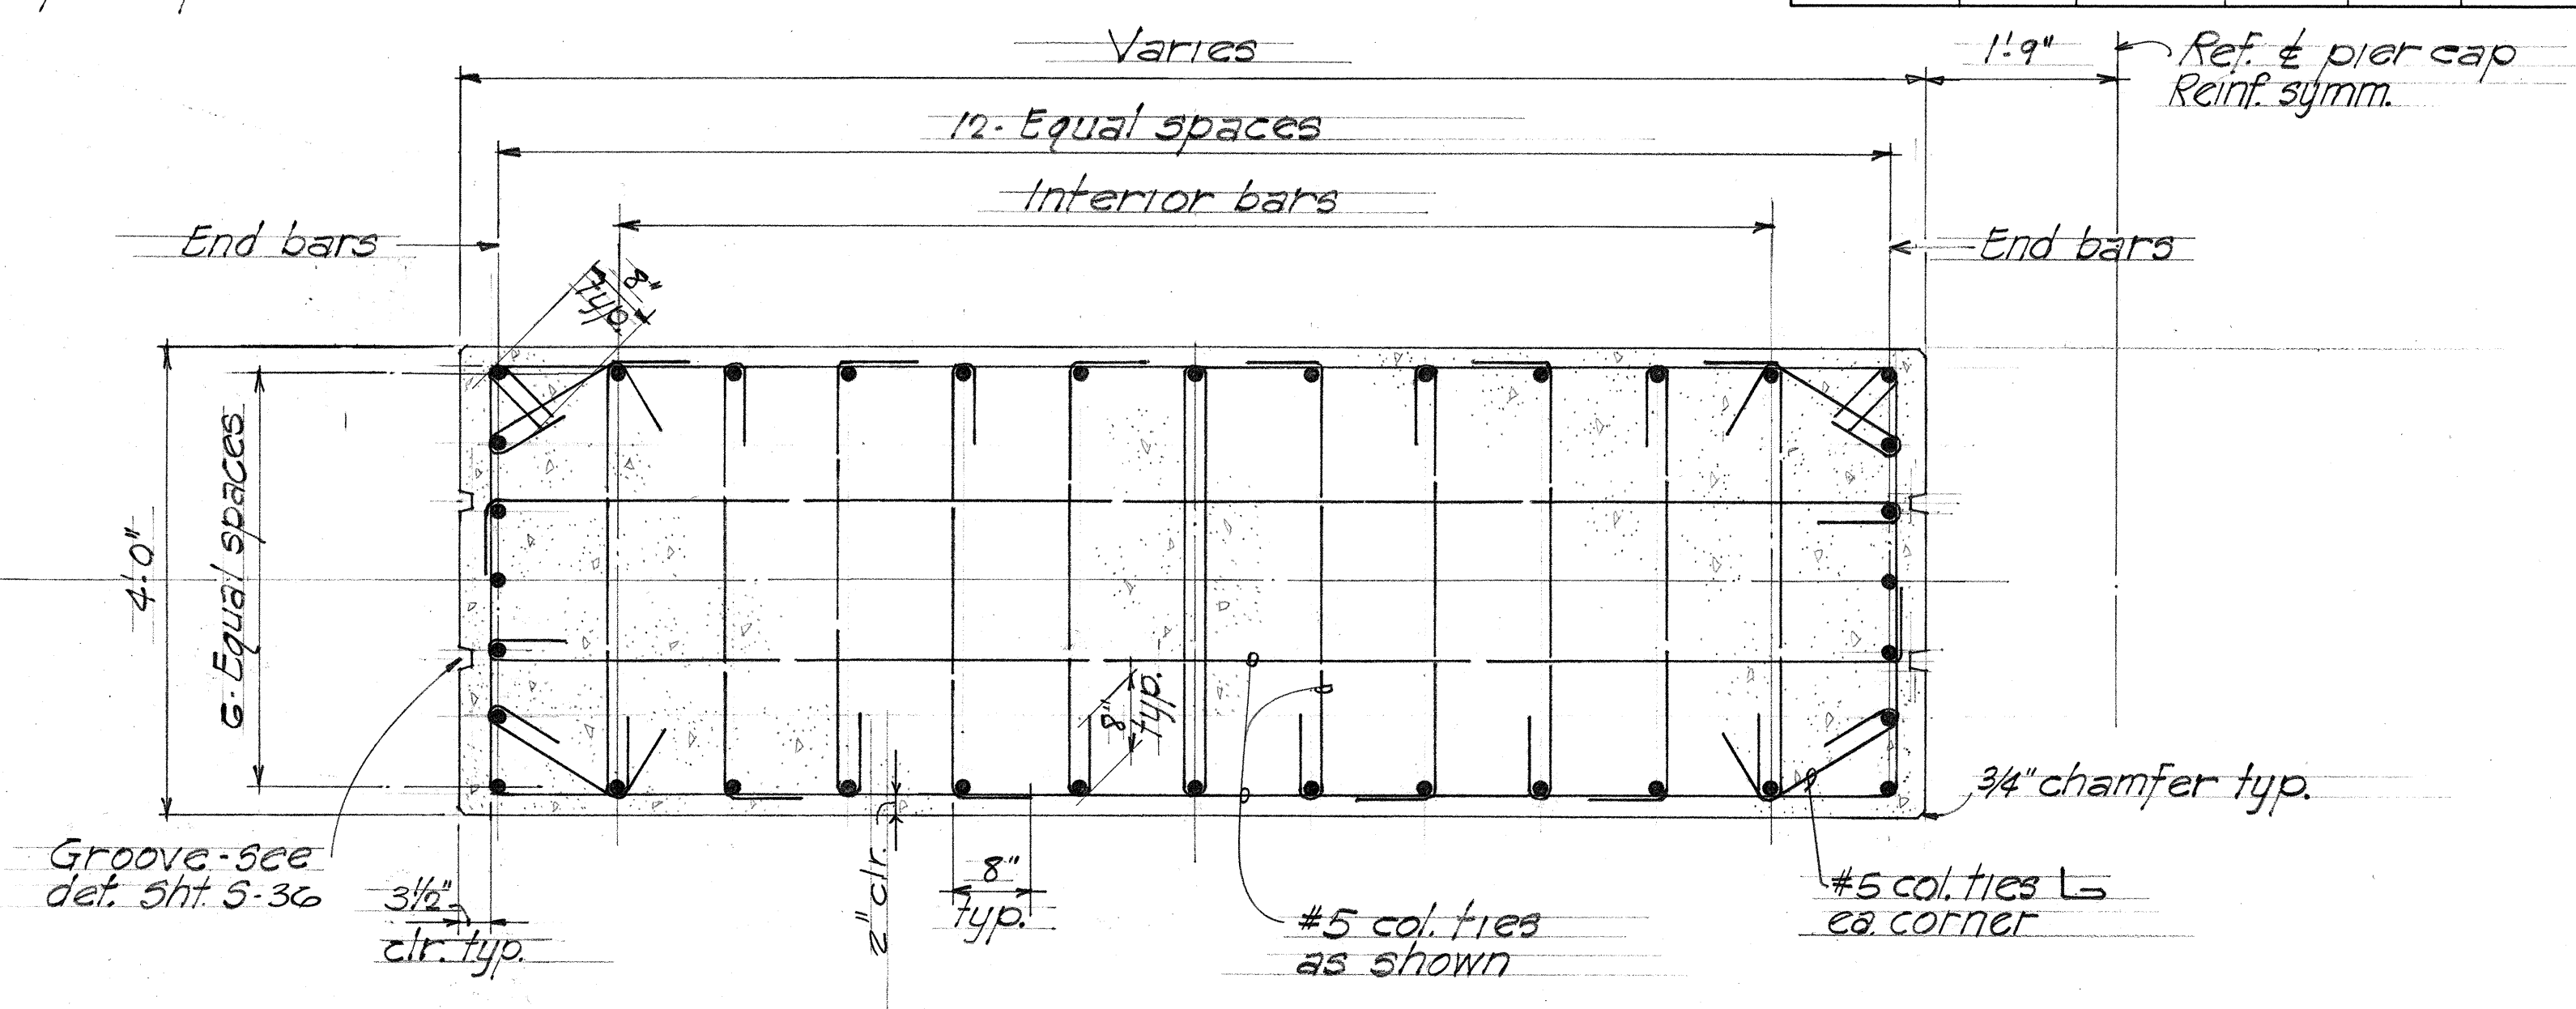


SECTION B  
Scale 3/4"=1'-0"  
5-2515-26



NOTE:  
1. All #18 & #14 bars shall be grade 60.  
2. Adjust pier cap top main reinforcing spacing to clear bearing plate anchor bolts.

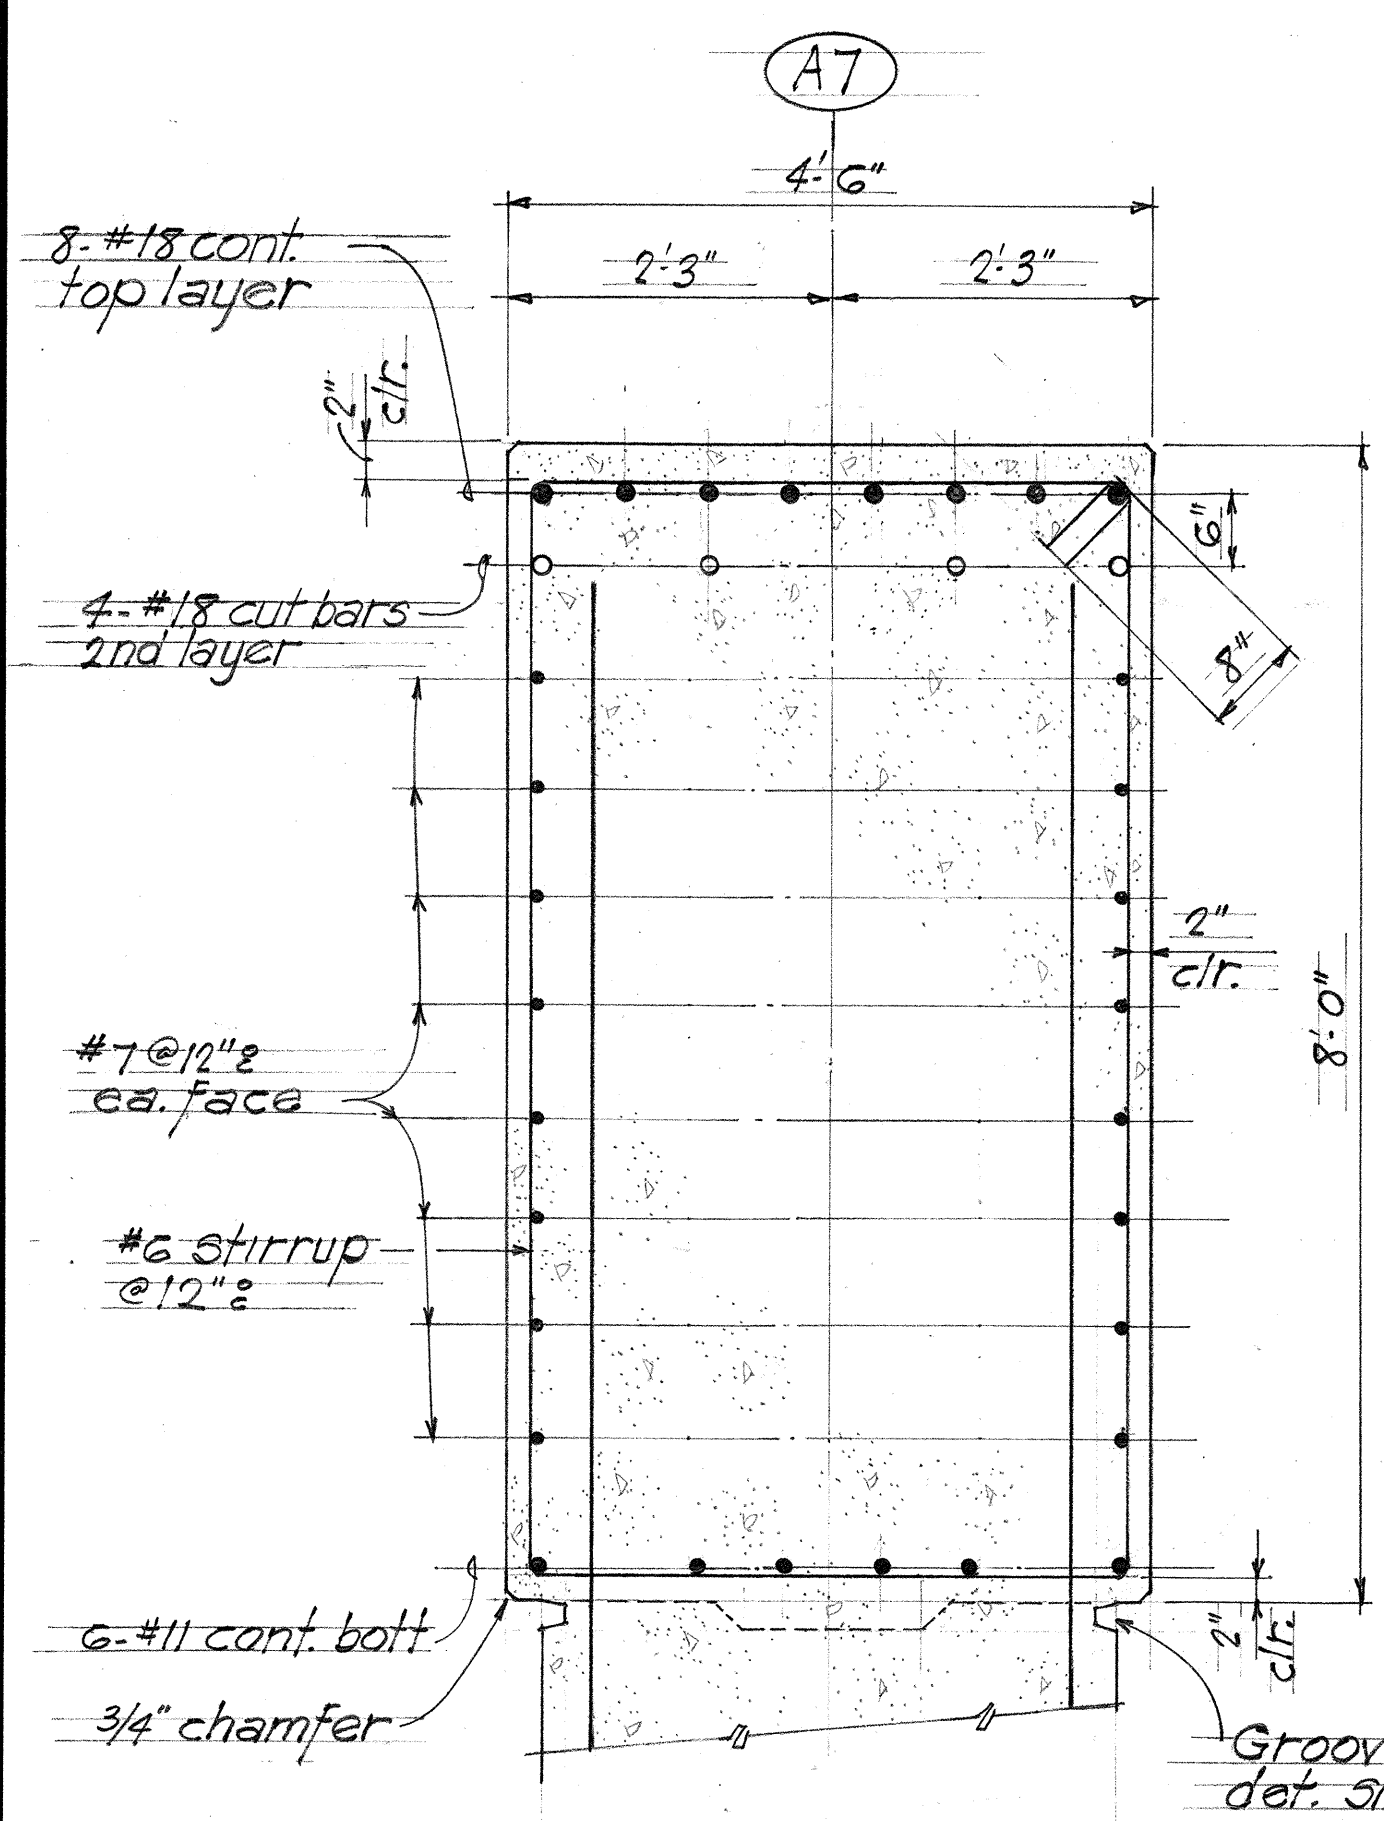

SECTION C  
Scale 3/4"=1'-0"  
5-2515-26

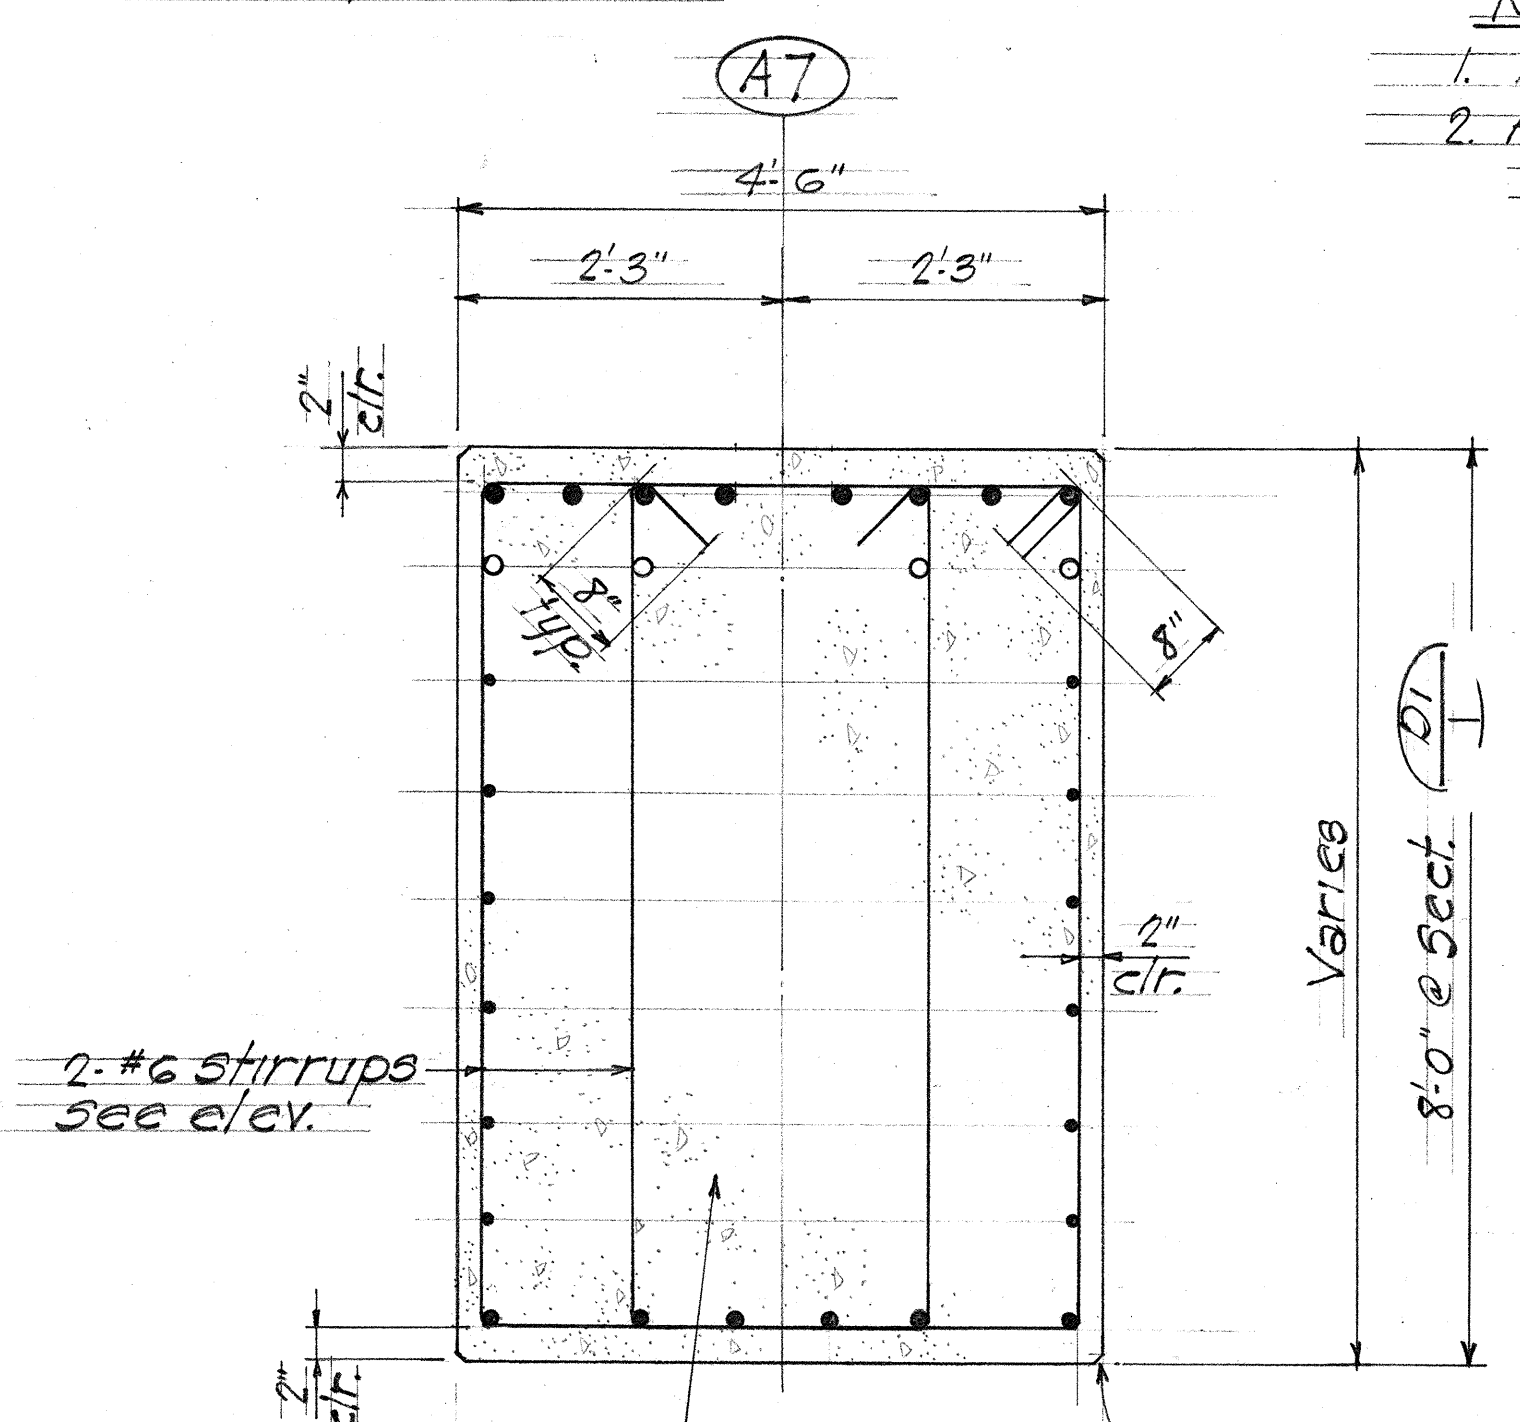

SECTION D  
Scale 3/4"=1'-0"  
5-2515-26

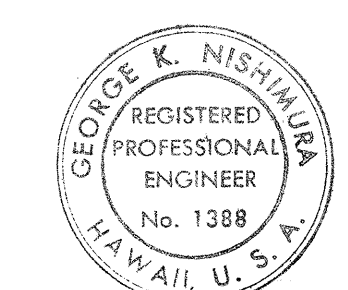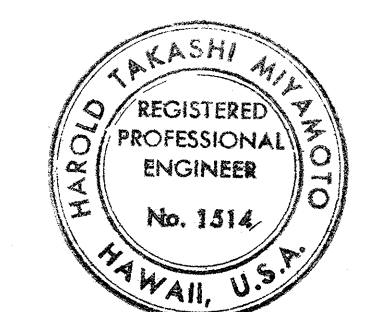

THIS WORK WAS PREPARED BY ME OR UNDER MY SUPERVISION

*Harold Takashi Miyamoto*

THIS WORK WAS PREPARED BY ME OR UNDER MY SUPERVISION


*George K. Nishimura*

STATE OF HAWAII  
DEPARTMENT OF TRANSPORTATION  
HIGHWAYS DIVISION  
**NIMITZ CONNECTOR (E.B.)**  
**RAMP "A" & RAMP "B"**  
**PIER A-7 DETAIL**  
KEEHI INTERCHANGE  
F.A.I. PROJ. NO. 1-HI-1 (168)17  
Scale: AS SHOWN Date: JULY, 1981  
SHEET NO. 5-26 OF 49 SHEETS

|                   |      |
|-------------------|------|
| SURVEY PLOTTED BY | DATE |
| DRAWN BY          |      |
| DESIGNED BY       |      |
| NOTE BOOK         |      |
| QUANTITIES BY     |      |
| CHECKED BY        |      |
| No.               |      |




| FED. ROAD DIST. NO. | STATE | FED. AID PROJ. NO. | FISCAL YEAR | SHEET NO. | TOTAL SHEETS |
|---------------------|-------|--------------------|-------------|-----------|--------------|
| HAWAII              | HAW.  | 1-HI-1(168)17      | 1982        | 109       | 145          |

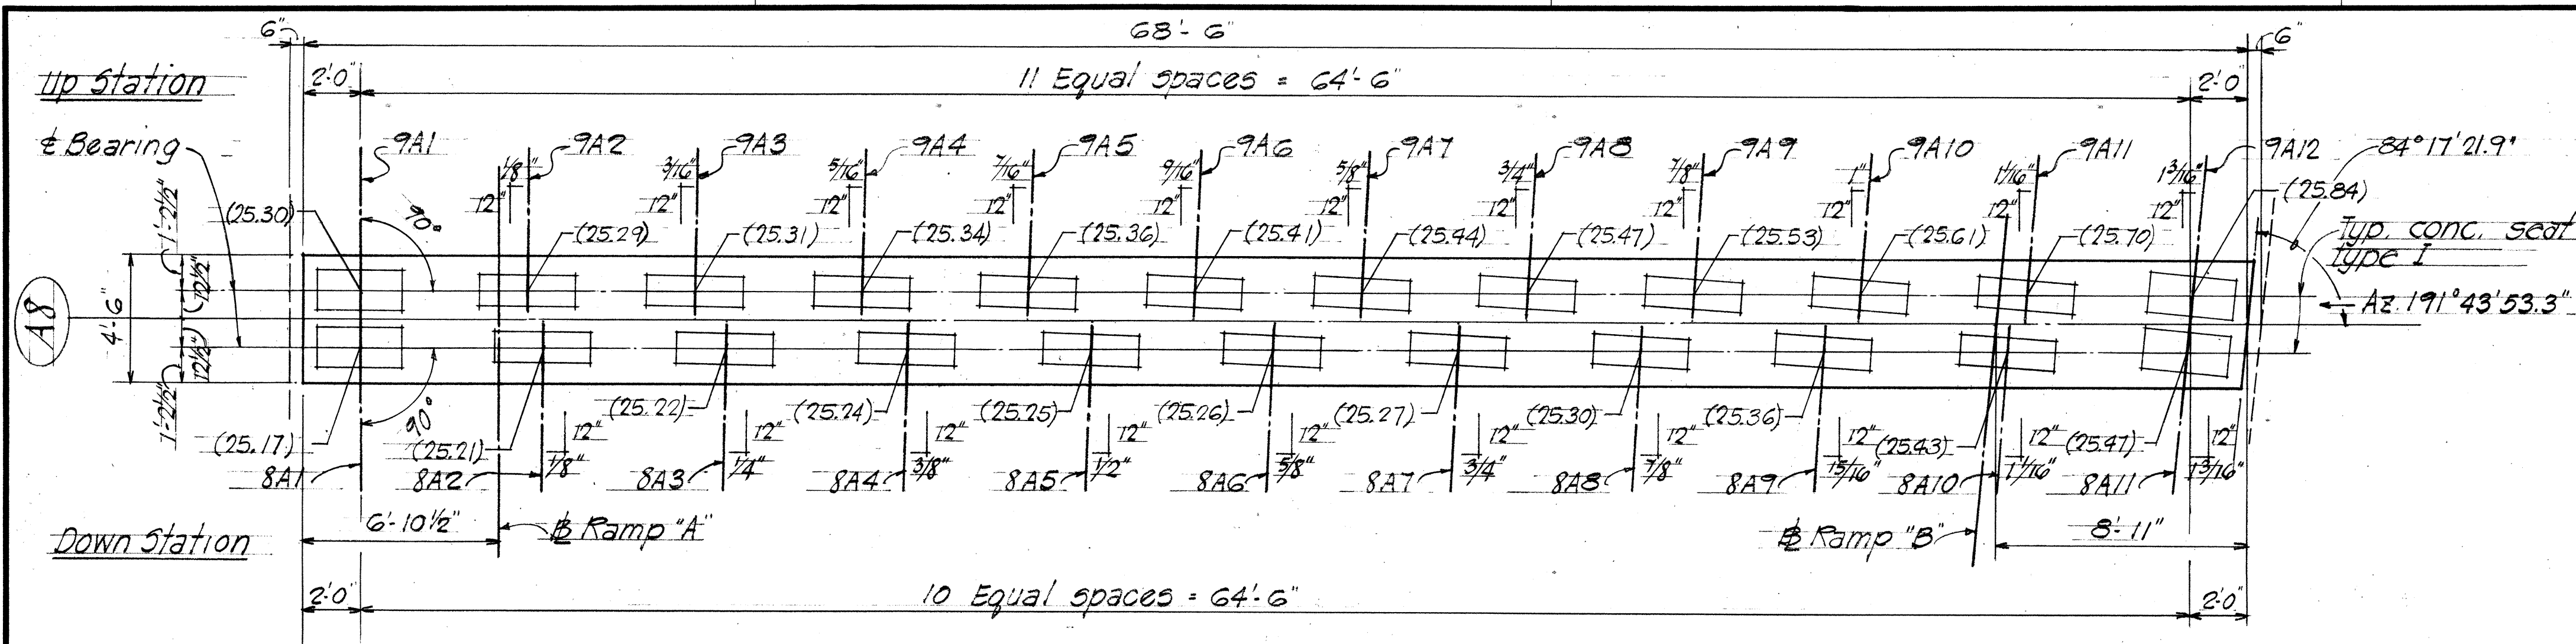


PLAN ~ PIER (A8)  
Scale 1/4" = 1'-0"


NOTE:  
(00.00) Denotes top of concrete seat elevation.

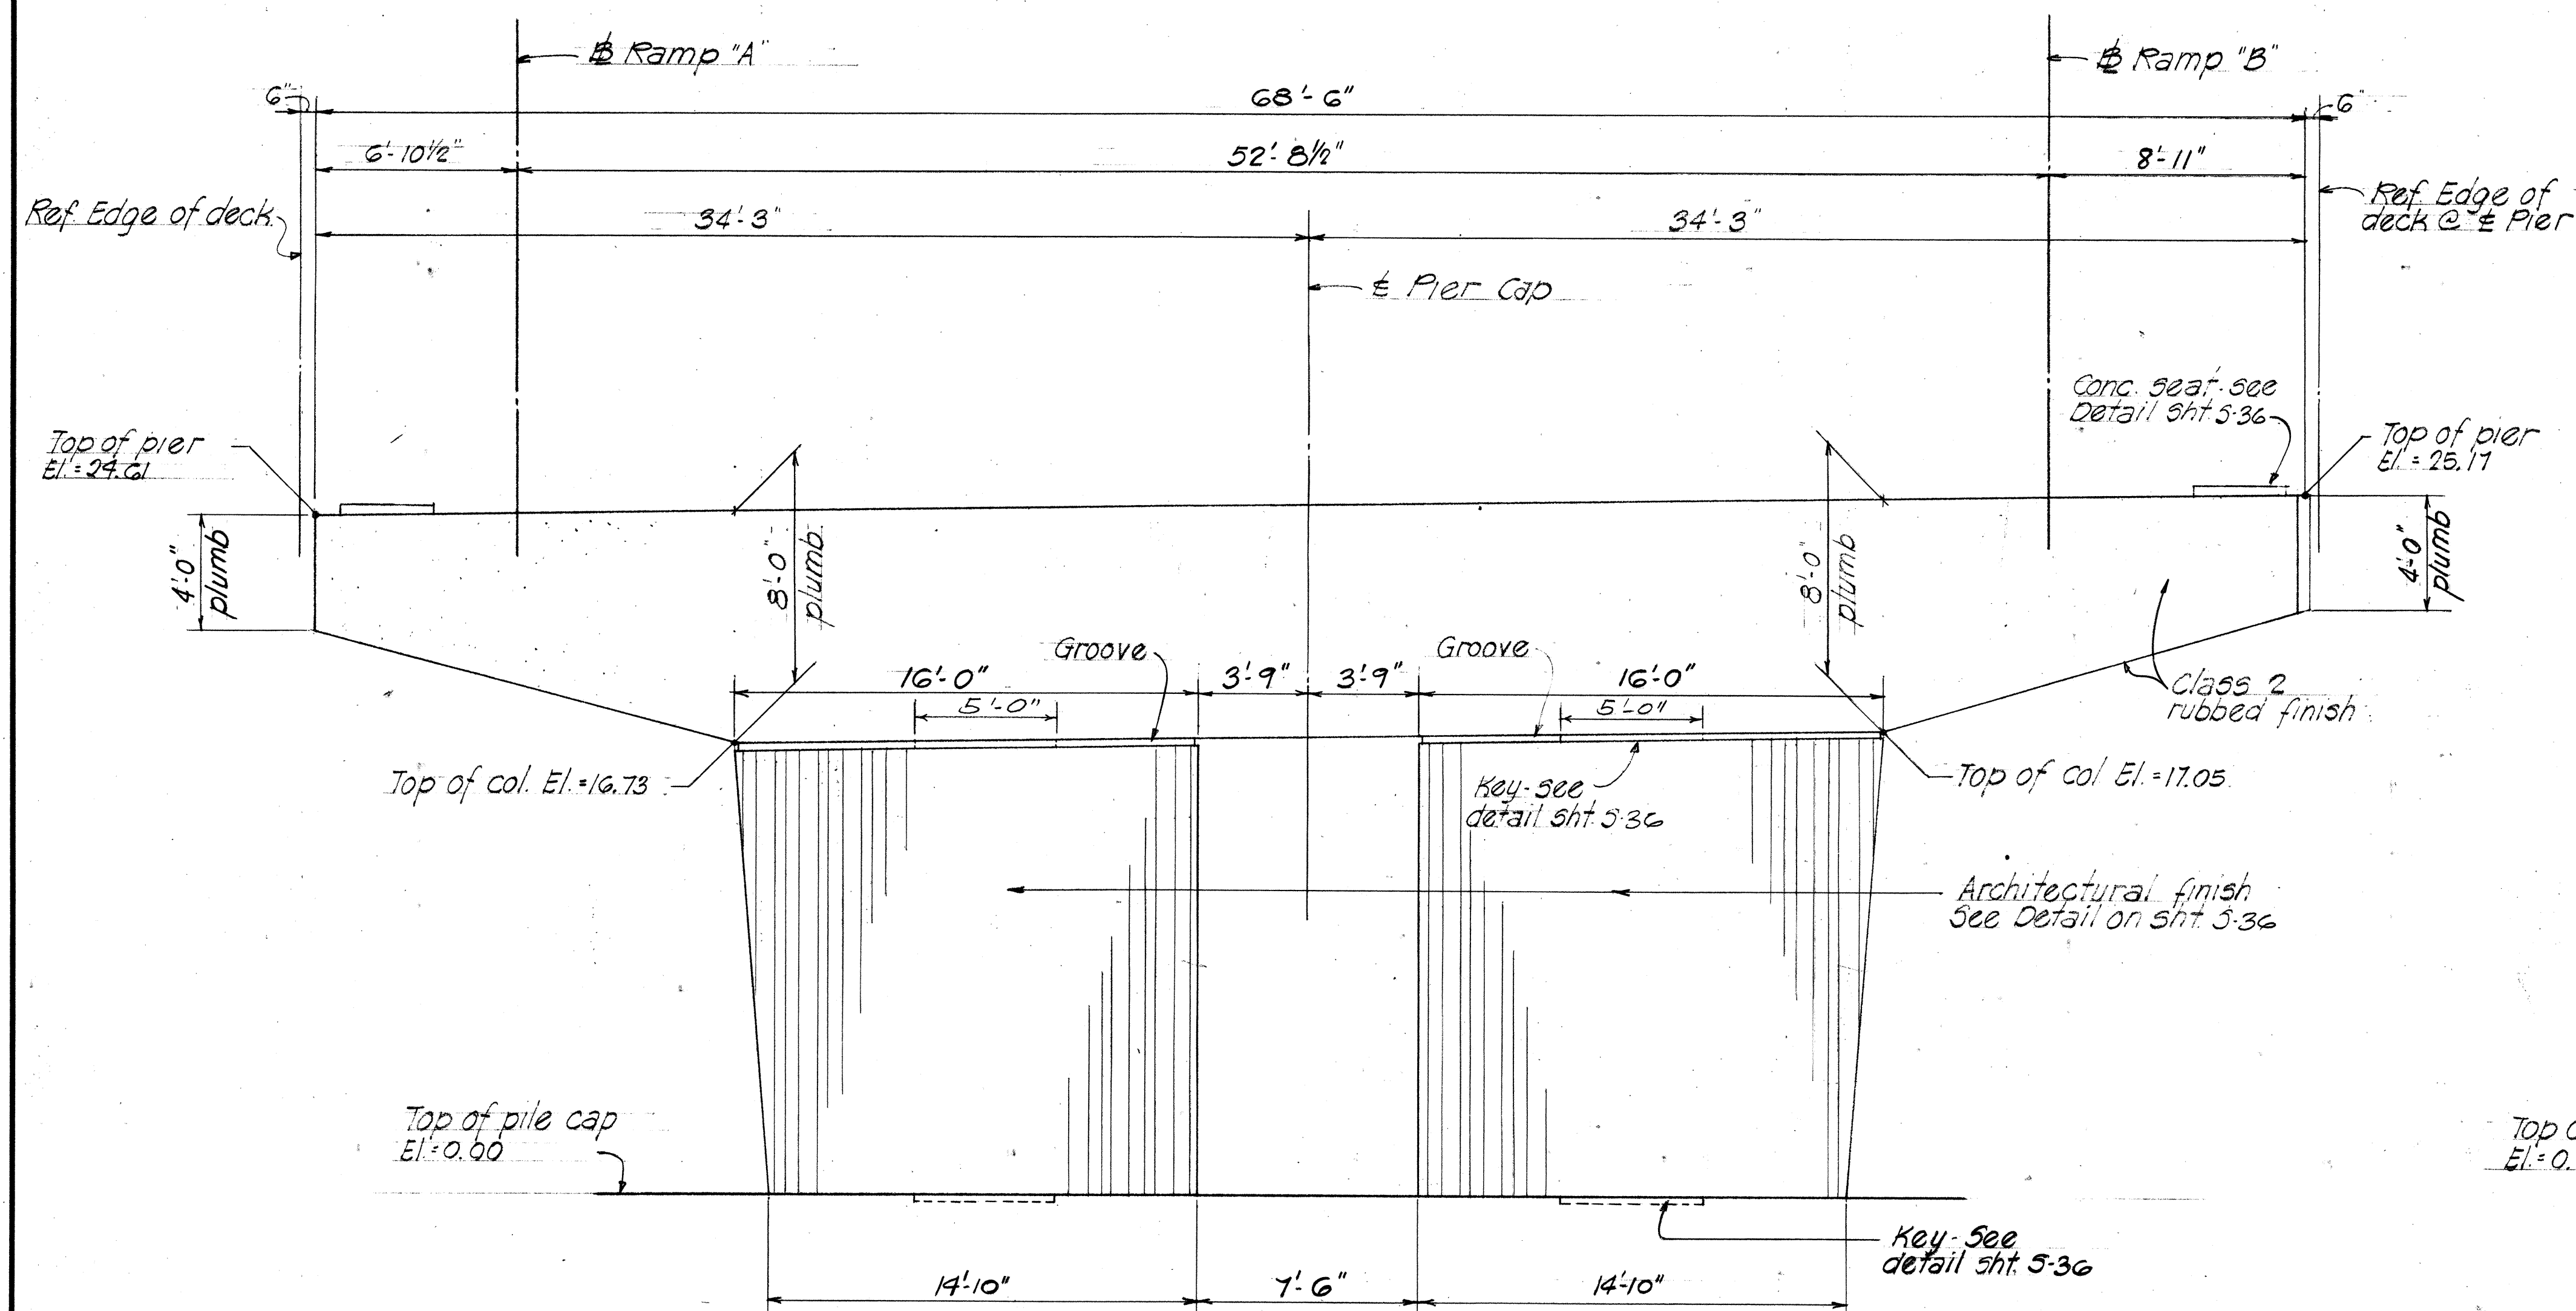

ELEVATION ~ PIER (A8)  
Scale 1/4" = 1'-0"

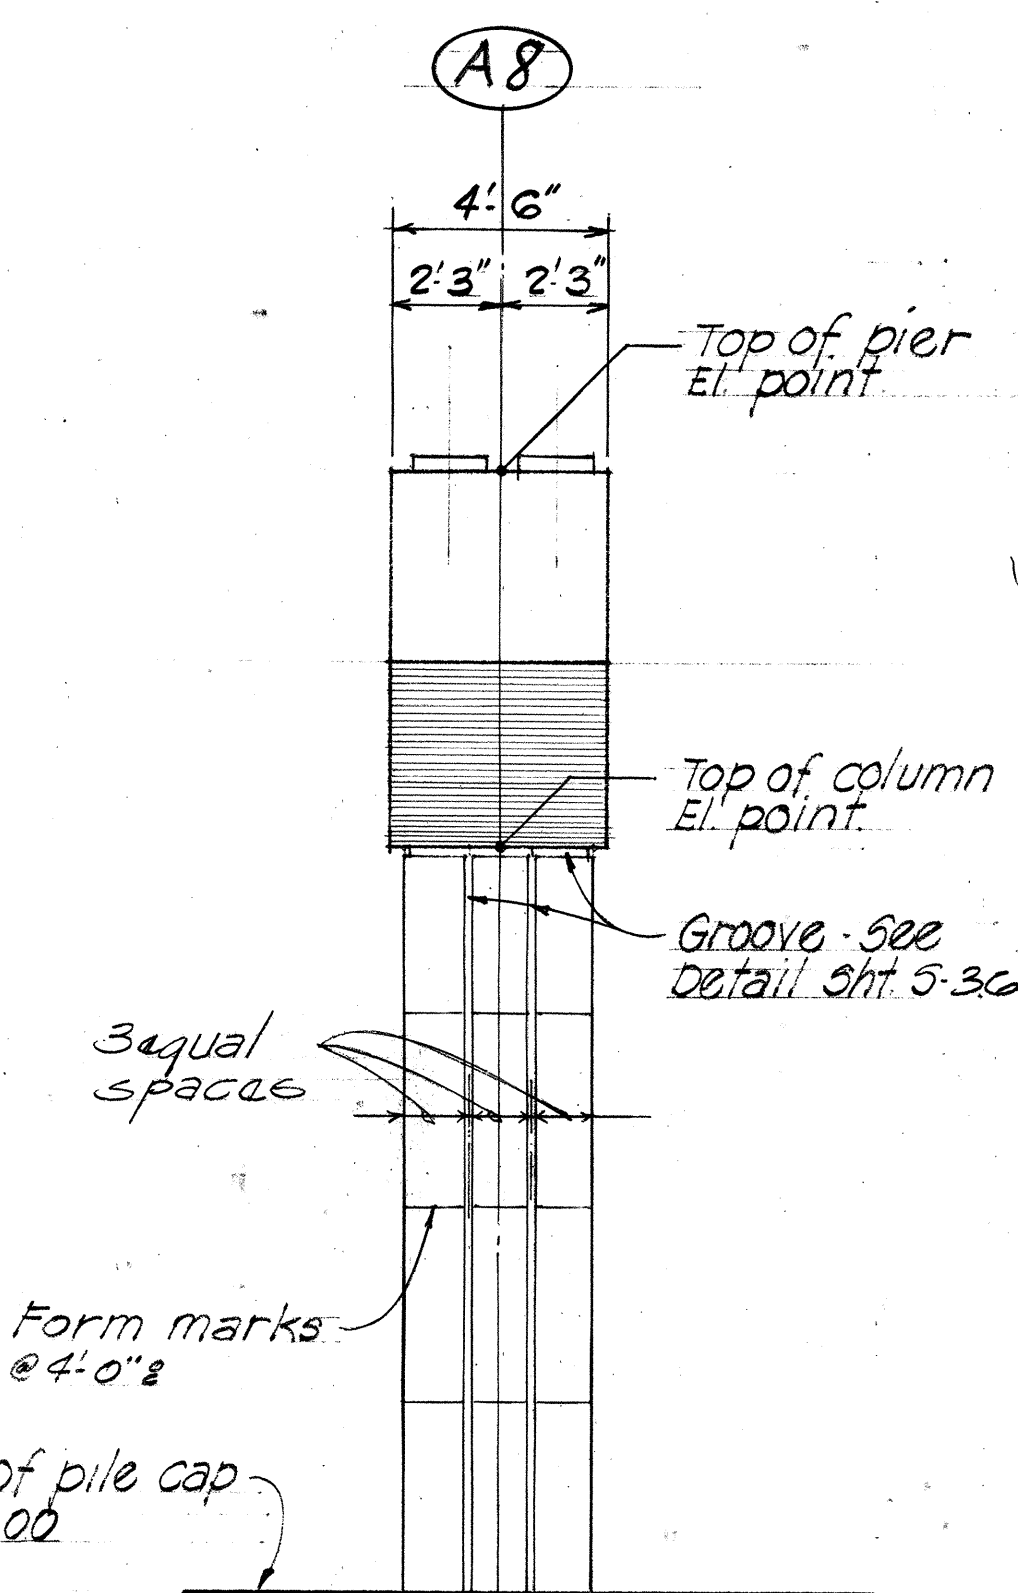

END ELEVATION  
Scale 1/4" = 1'-0"

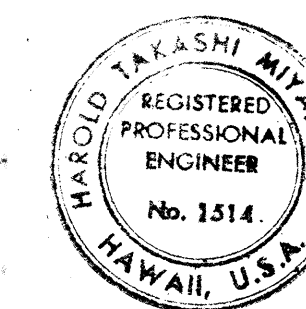

THIS WORK WAS PREPARED BY  
ME OR UNDER MY SUPERVISION

THIS WORK WAS PREPARED BY  
ME OR UNDER MY SUPERVISION


STATE OF HAWAII  
DEPARTMENT OF TRANSPORTATION  
HIGHWAYS DIVISION  
NIMITZ CONNECTOR (E.B.)  
RAMP "A" & RAMP "B"  
PIER A8 DETAIL  
KEEHI INTERCHANGE  
F.A.I. PROJ. NO. 1-HI-1(168)17  
Scale: As shown Date: JULY, 1981  
SHEET No. 5-27 OF 49 SHEETS




**NOTE**

All #18 and #14 bars shall be grade 60.


| FED. ROAD DIST. NO. | STATE | FED. AID PROJ. NO. | FISCAL YEAR | SHEET NO. | TOTAL SHEETS |
|---------------------|-------|--------------------|-------------|-----------|--------------|
| HAWAII              | HAW.  | 1-HI-1(168)17      | 1982        | 110       | 145          |

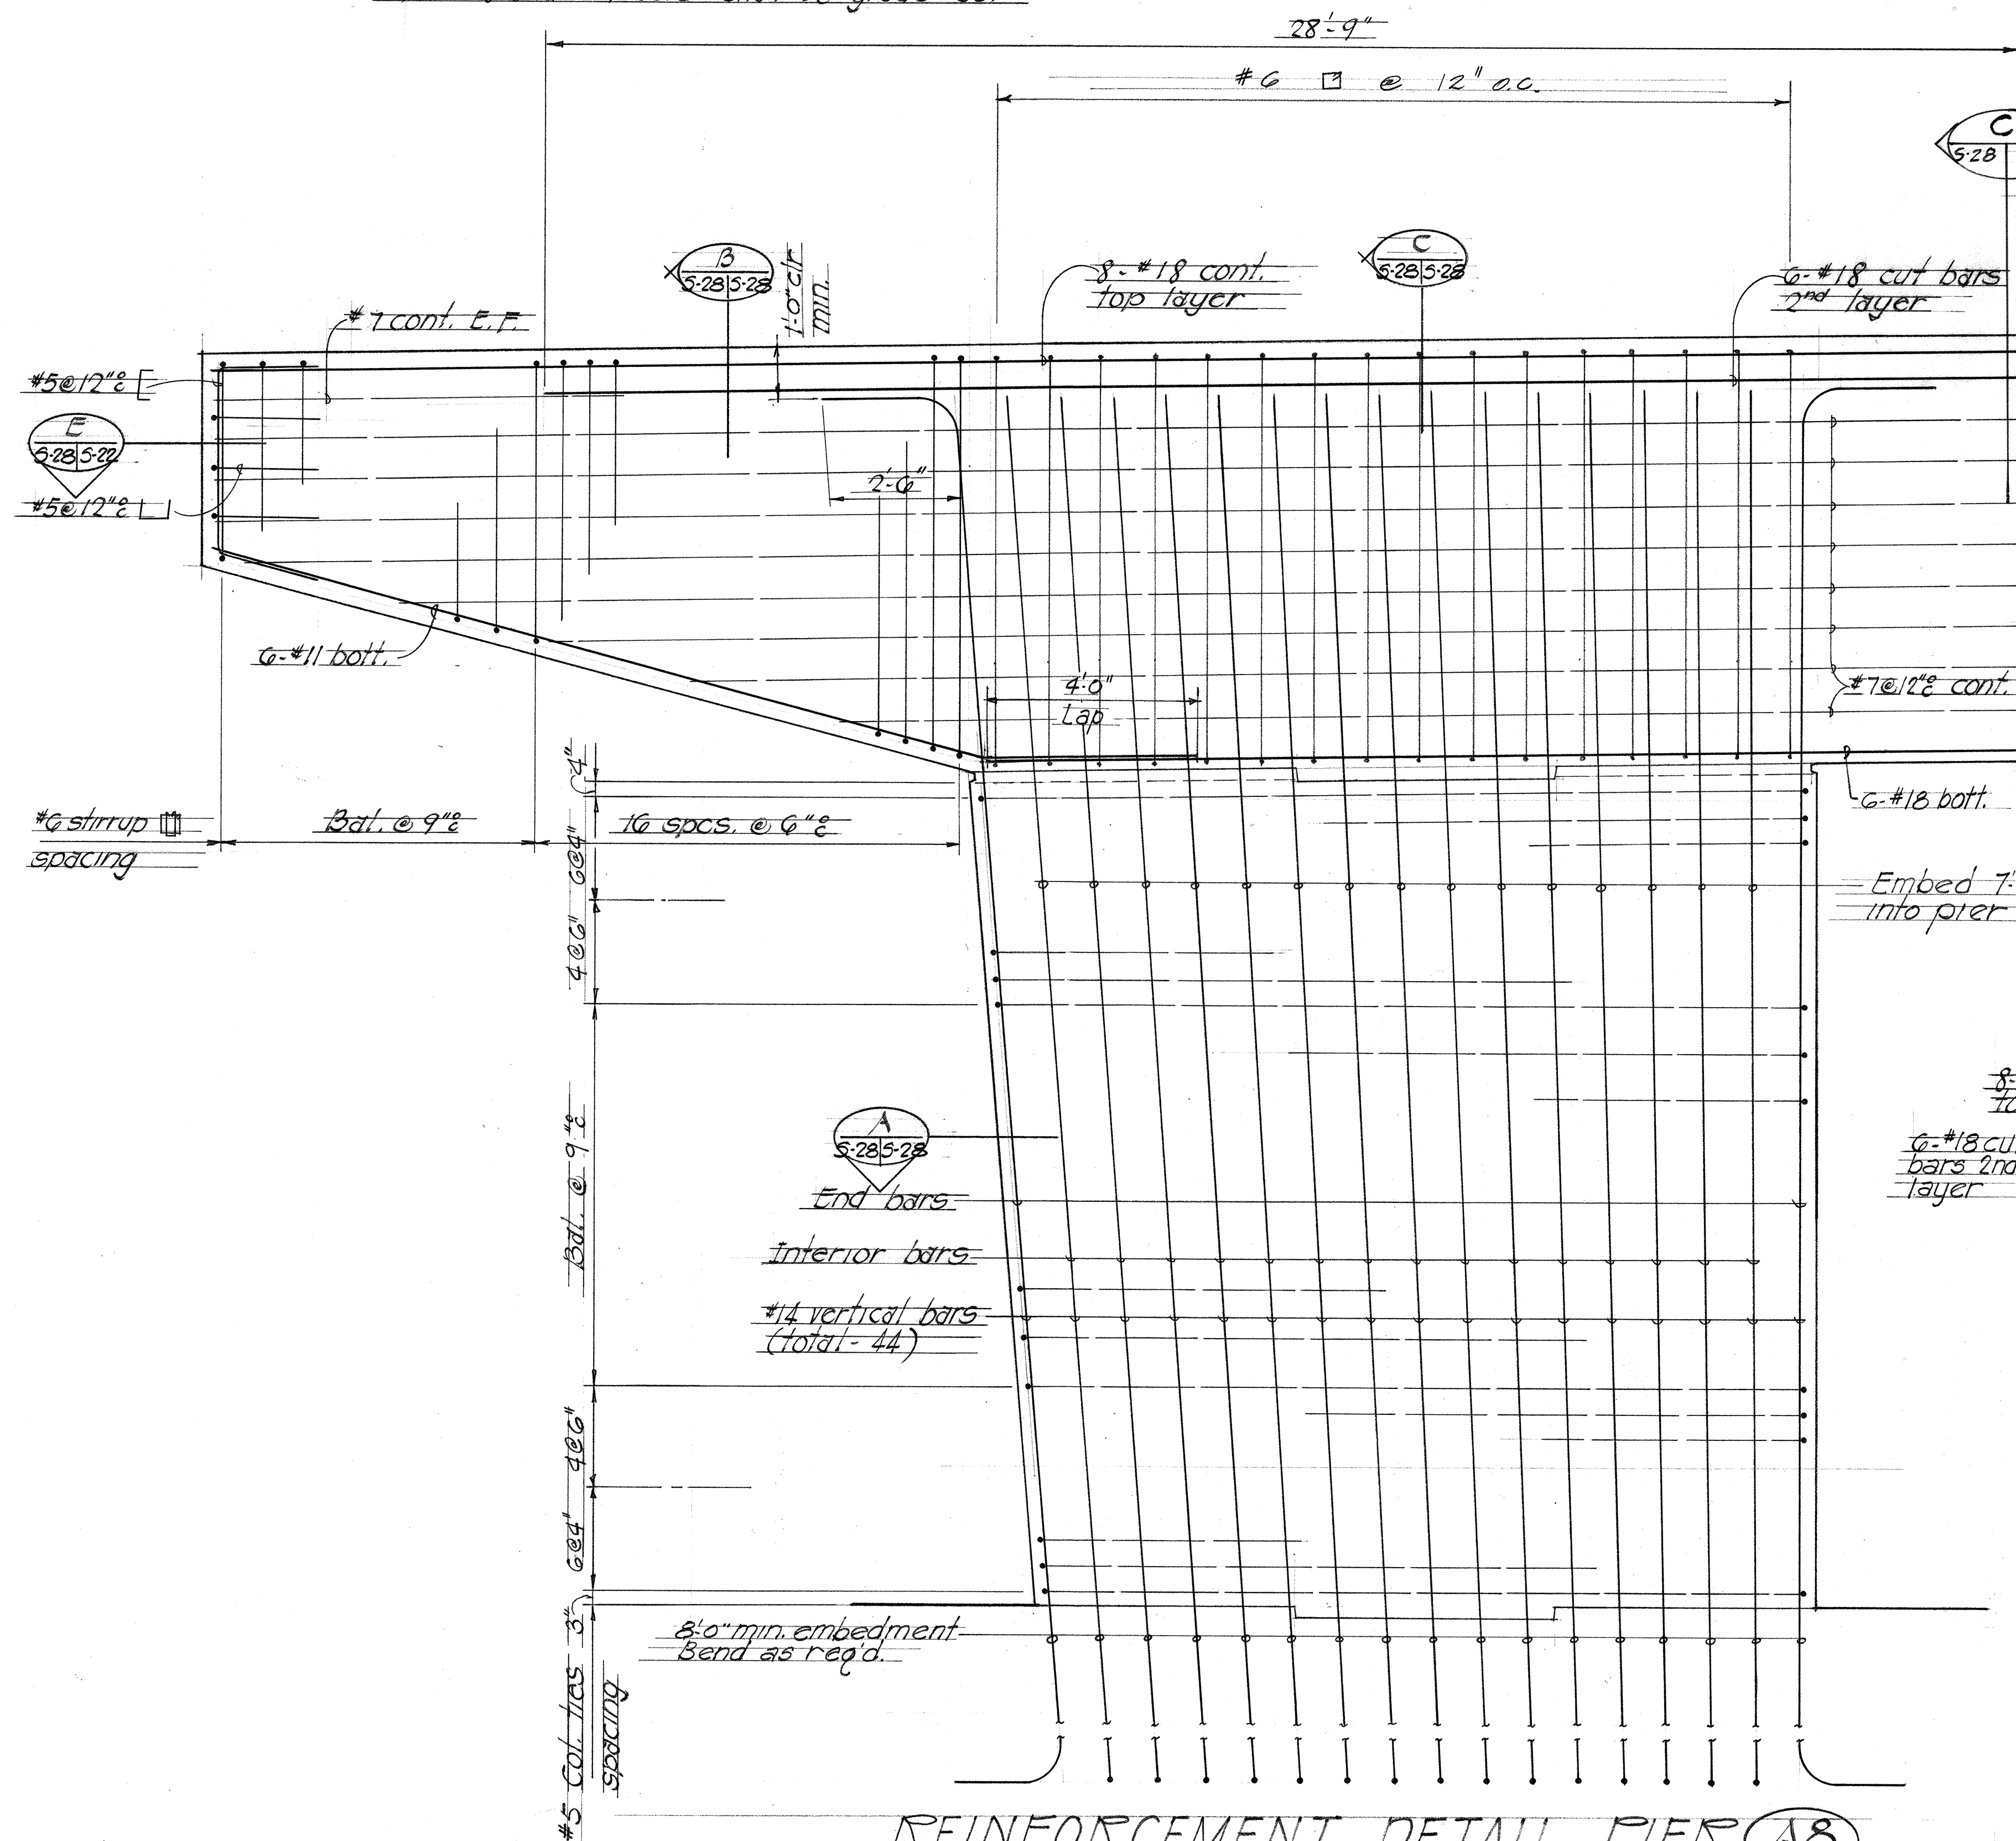

**REINFORCEMENT DETAIL PIER A8**  
Scale 1/2" = 1'-0"

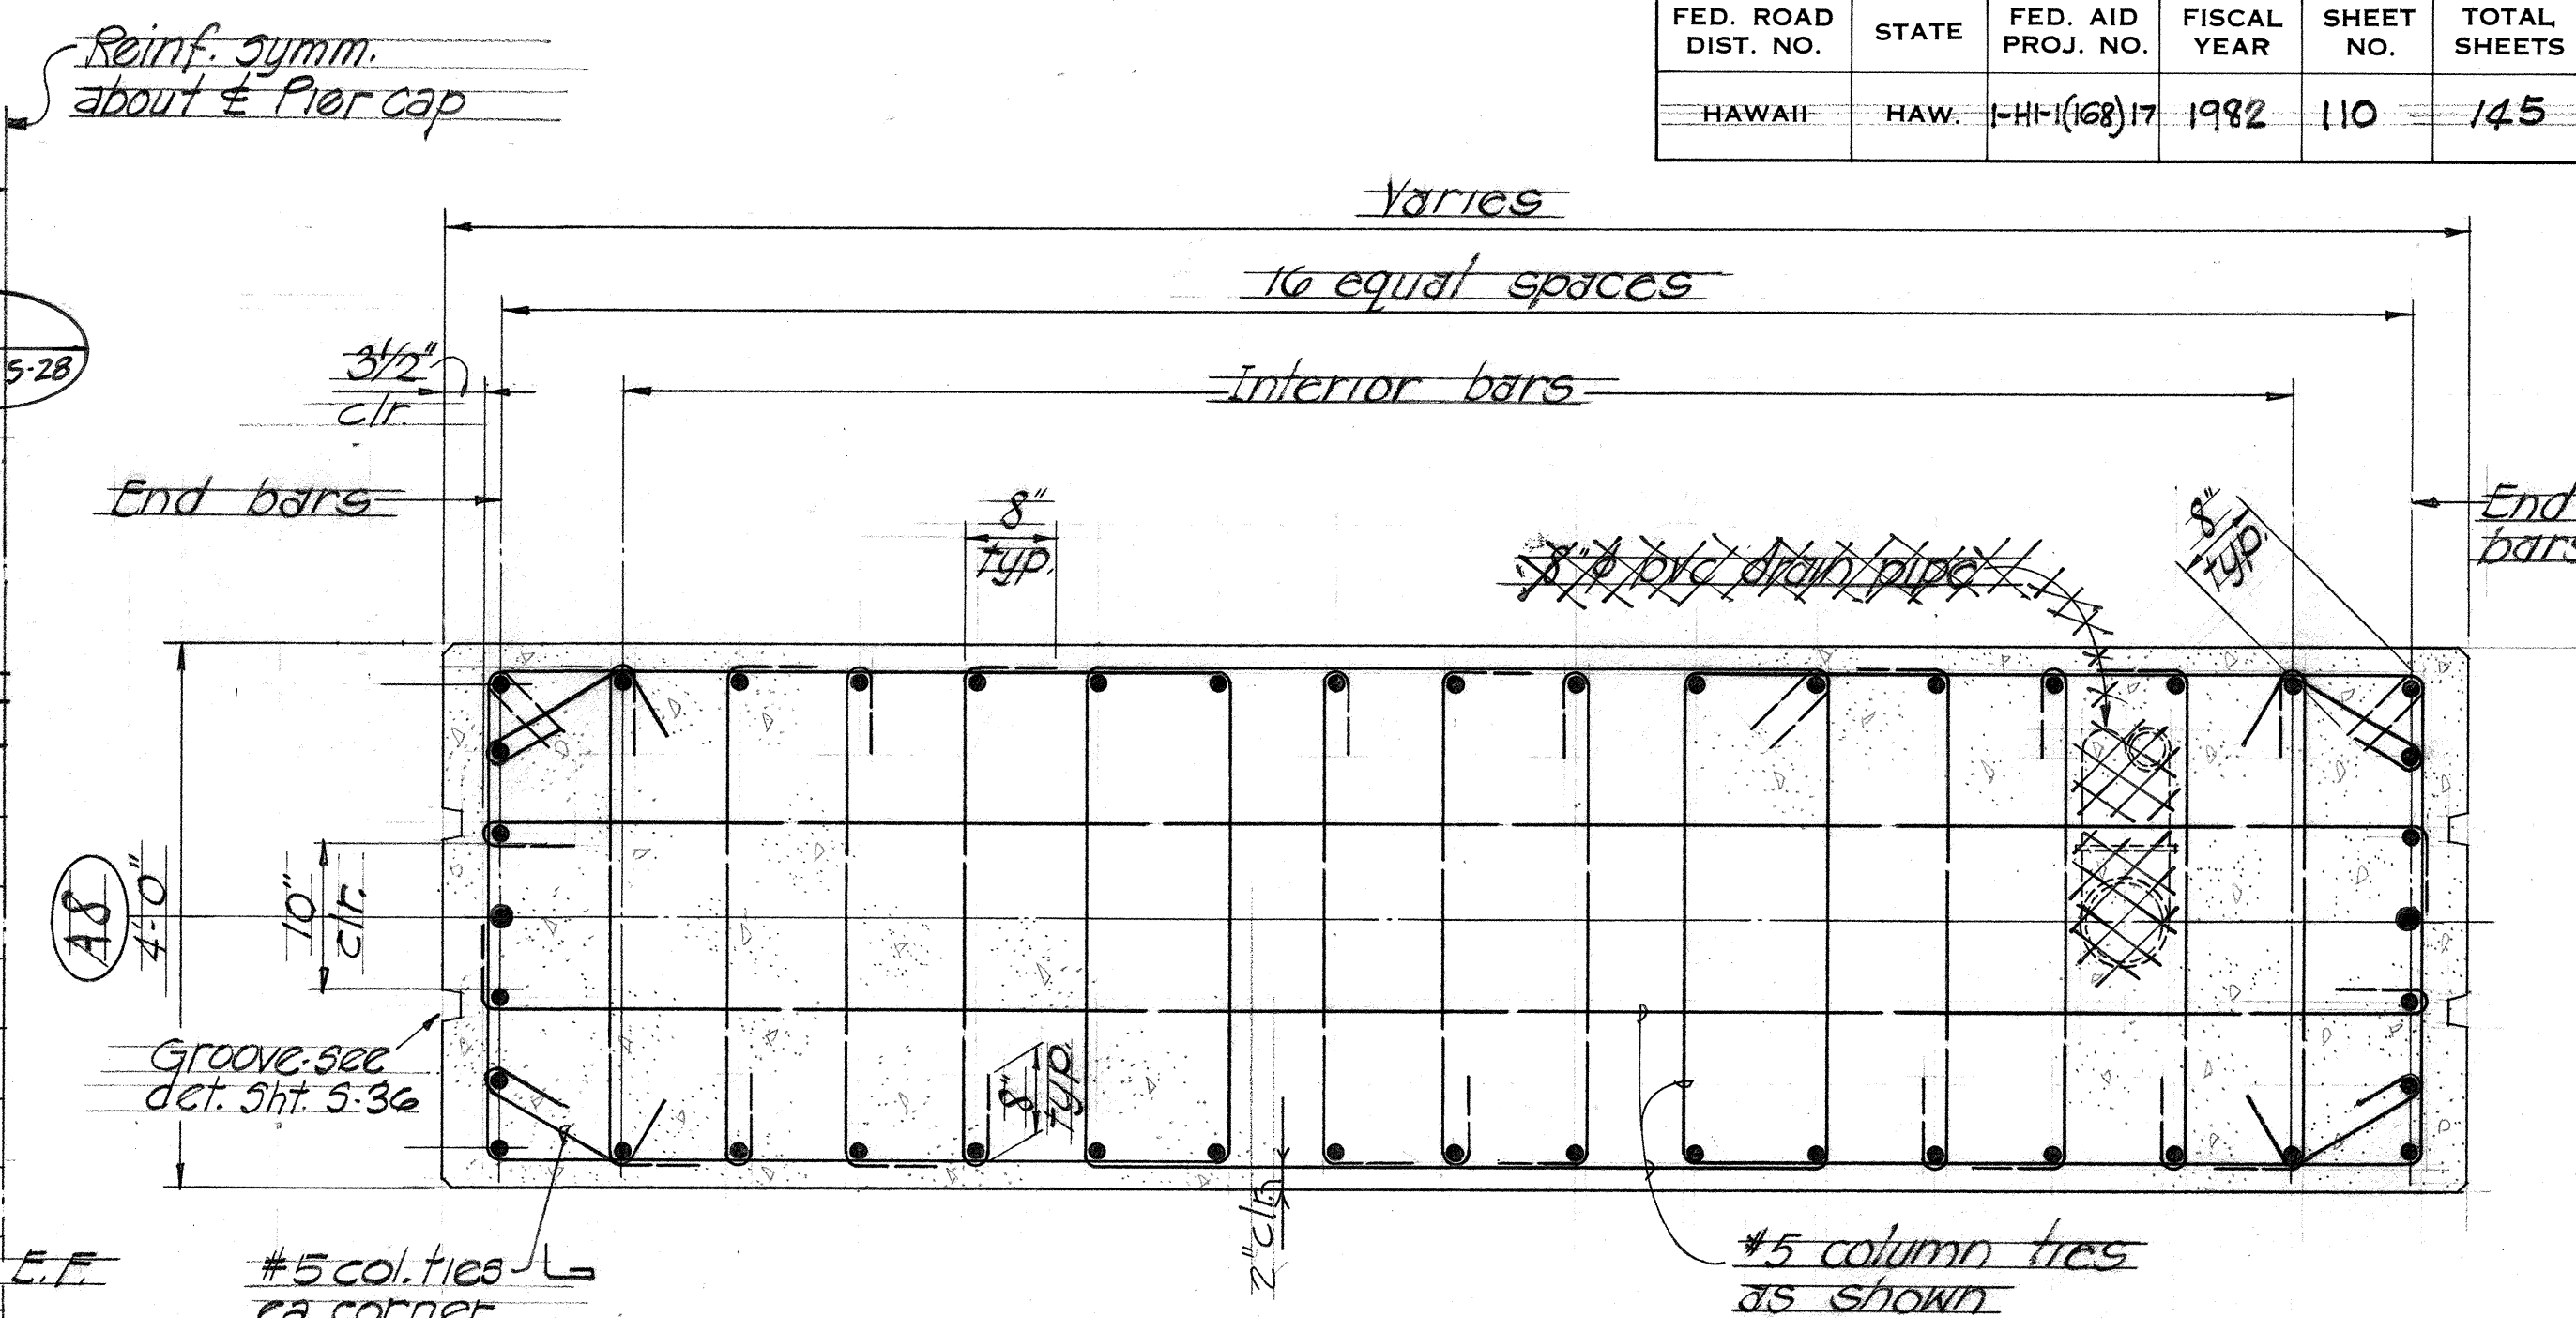



**SECTION A-A**  
Scale 3/4" = 1'-0"

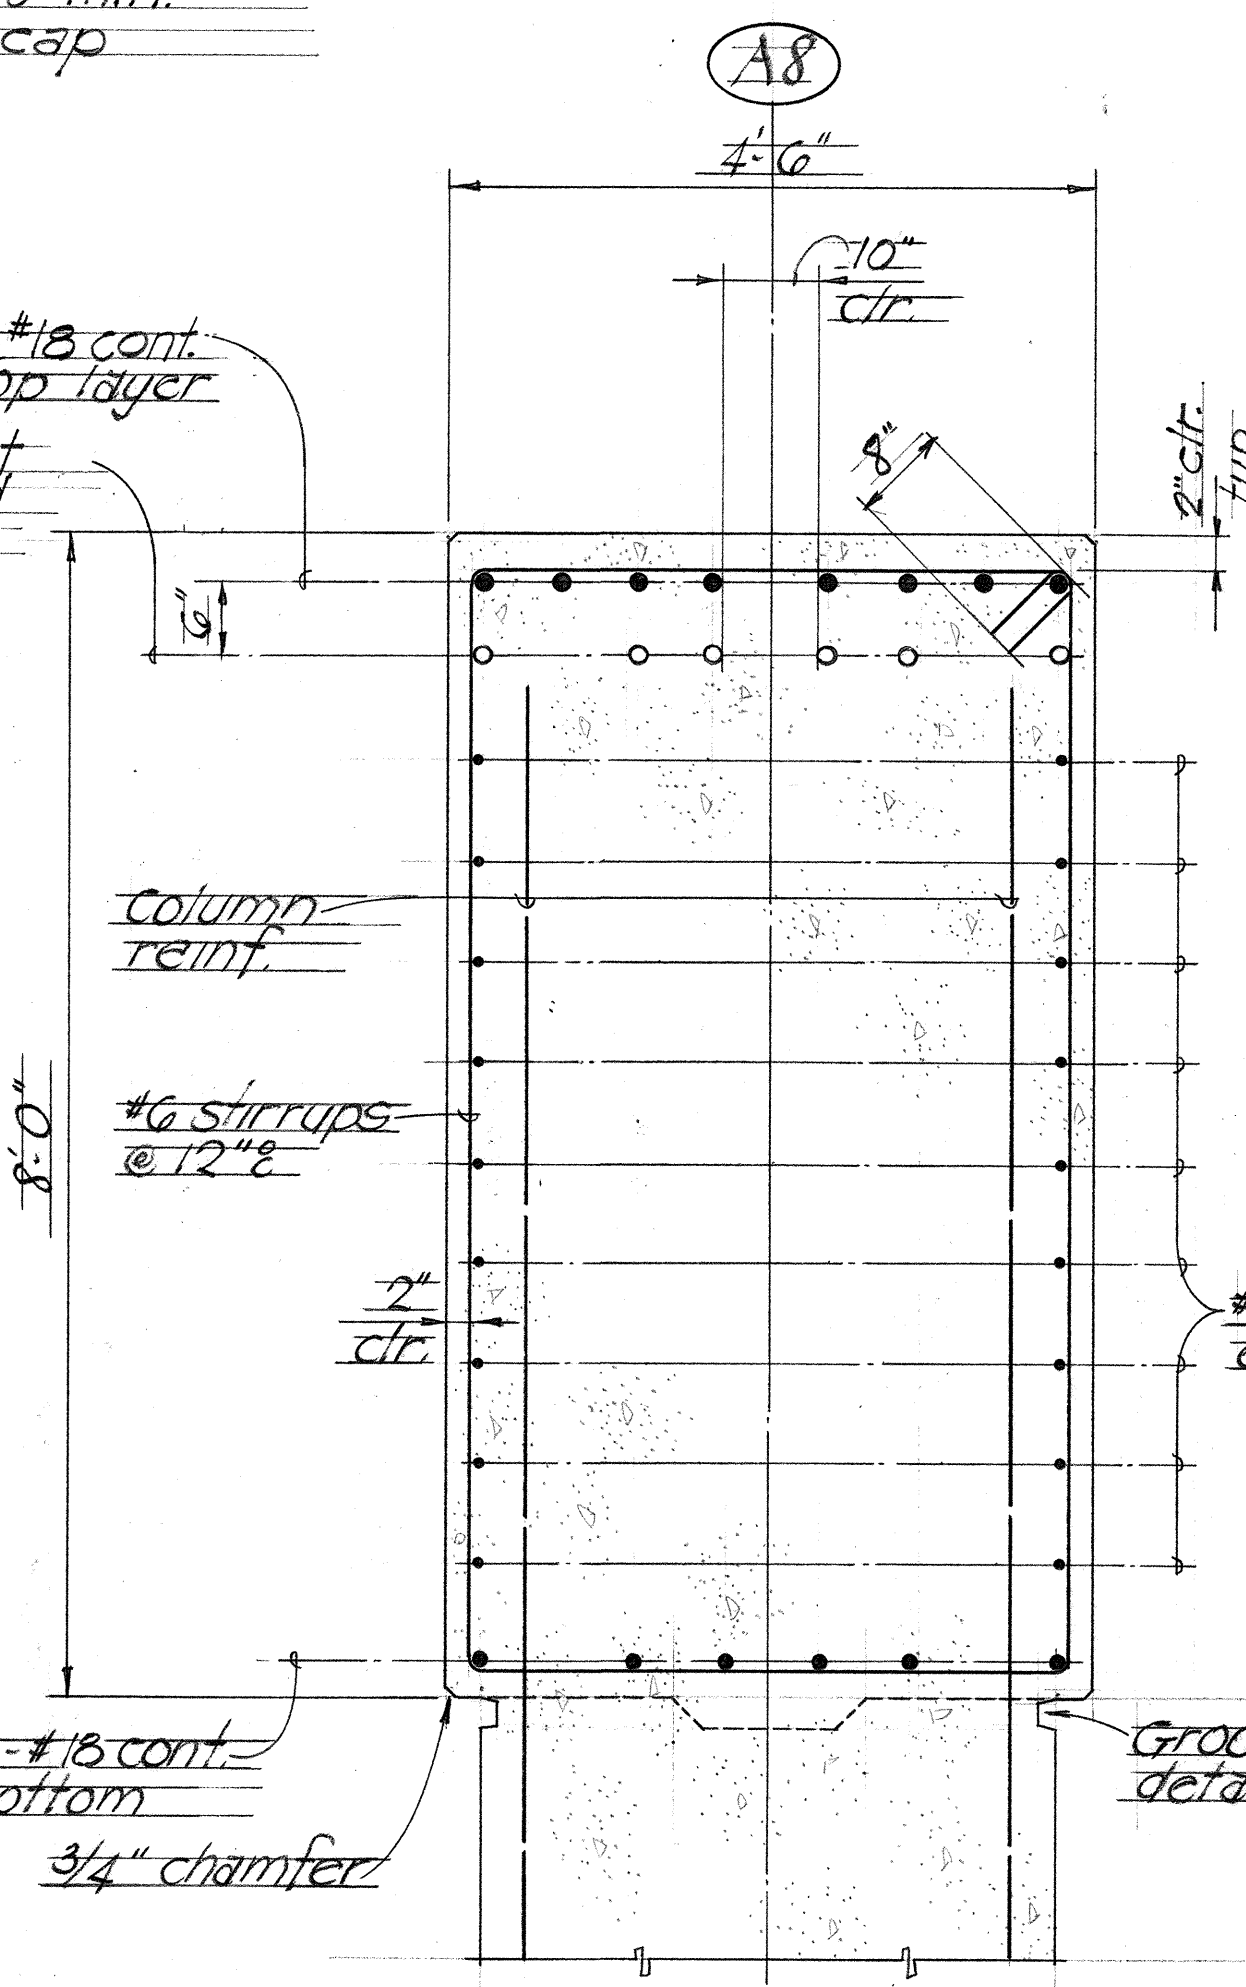

**SECTION B-B**  
Scale 3/4" = 1'-0"

**NOTE:**  
Adjust pier cap top main reinforcing spacing to clear bearing plate anchor bolts.

STATE OF HAWAII  
DEPARTMENT OF TRANSPORTATION  
HIGHWAYS DIVISION  
NIMITZ CONNECTOR (E.B.)  
RAMP "A" & RAMP "B"  
PIER A8 DETAIL  
KEEHI INTERCHANGE  
F.A.I. PROJ. NO. 1-HI-1 (168)17  
Scale: As shown Date: JULY, 1981  
SHEET No. 5-28 OF 49 SHEETS

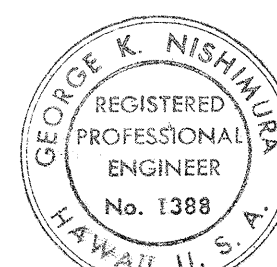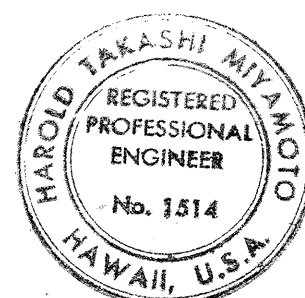


THIS WORK WAS PREPARED BY  
ME OR UNDER MY SUPERVISION  
*Harold Takashi Miyamoto*  
THIS WORK WAS PREPARED BY  
ME OR UNDER MY SUPERVISION  
*George K. Nishimura*


|                   |      |
|-------------------|------|
| SURVEY PLOTTED BY | DATE |
| DESIGNED BY       |      |
| NOTED BY          |      |
| CHECKED BY        |      |
| APPROVED BY       |      |




| FED. ROAD DIST. NO. | STATE | FED. AID PROJ. NO. | FISCAL YEAR | SHEET NO. | TOTAL SHEETS |
|---------------------|-------|--------------------|-------------|-----------|--------------|
| HAWAII              | HAW.  | HI-101(17)         | 1982        | 111       | 145          |

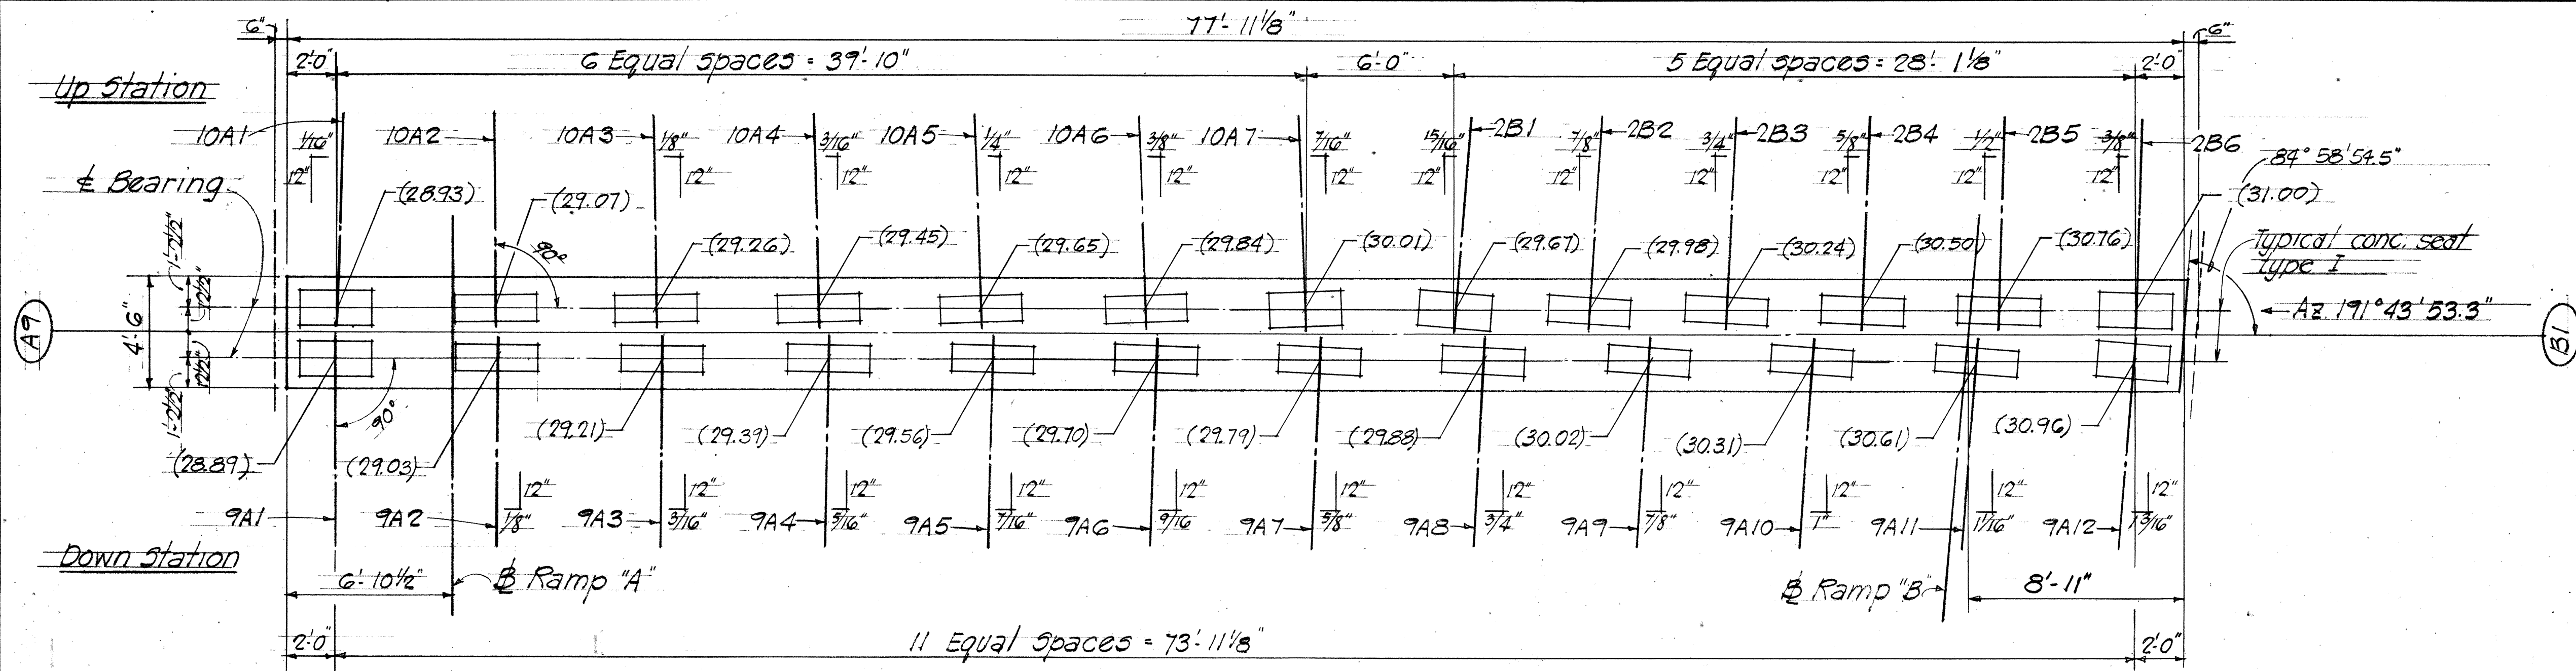


PLAN ~ PIER (A9) & (B1)  
Scale 1/4" = 1'-0"

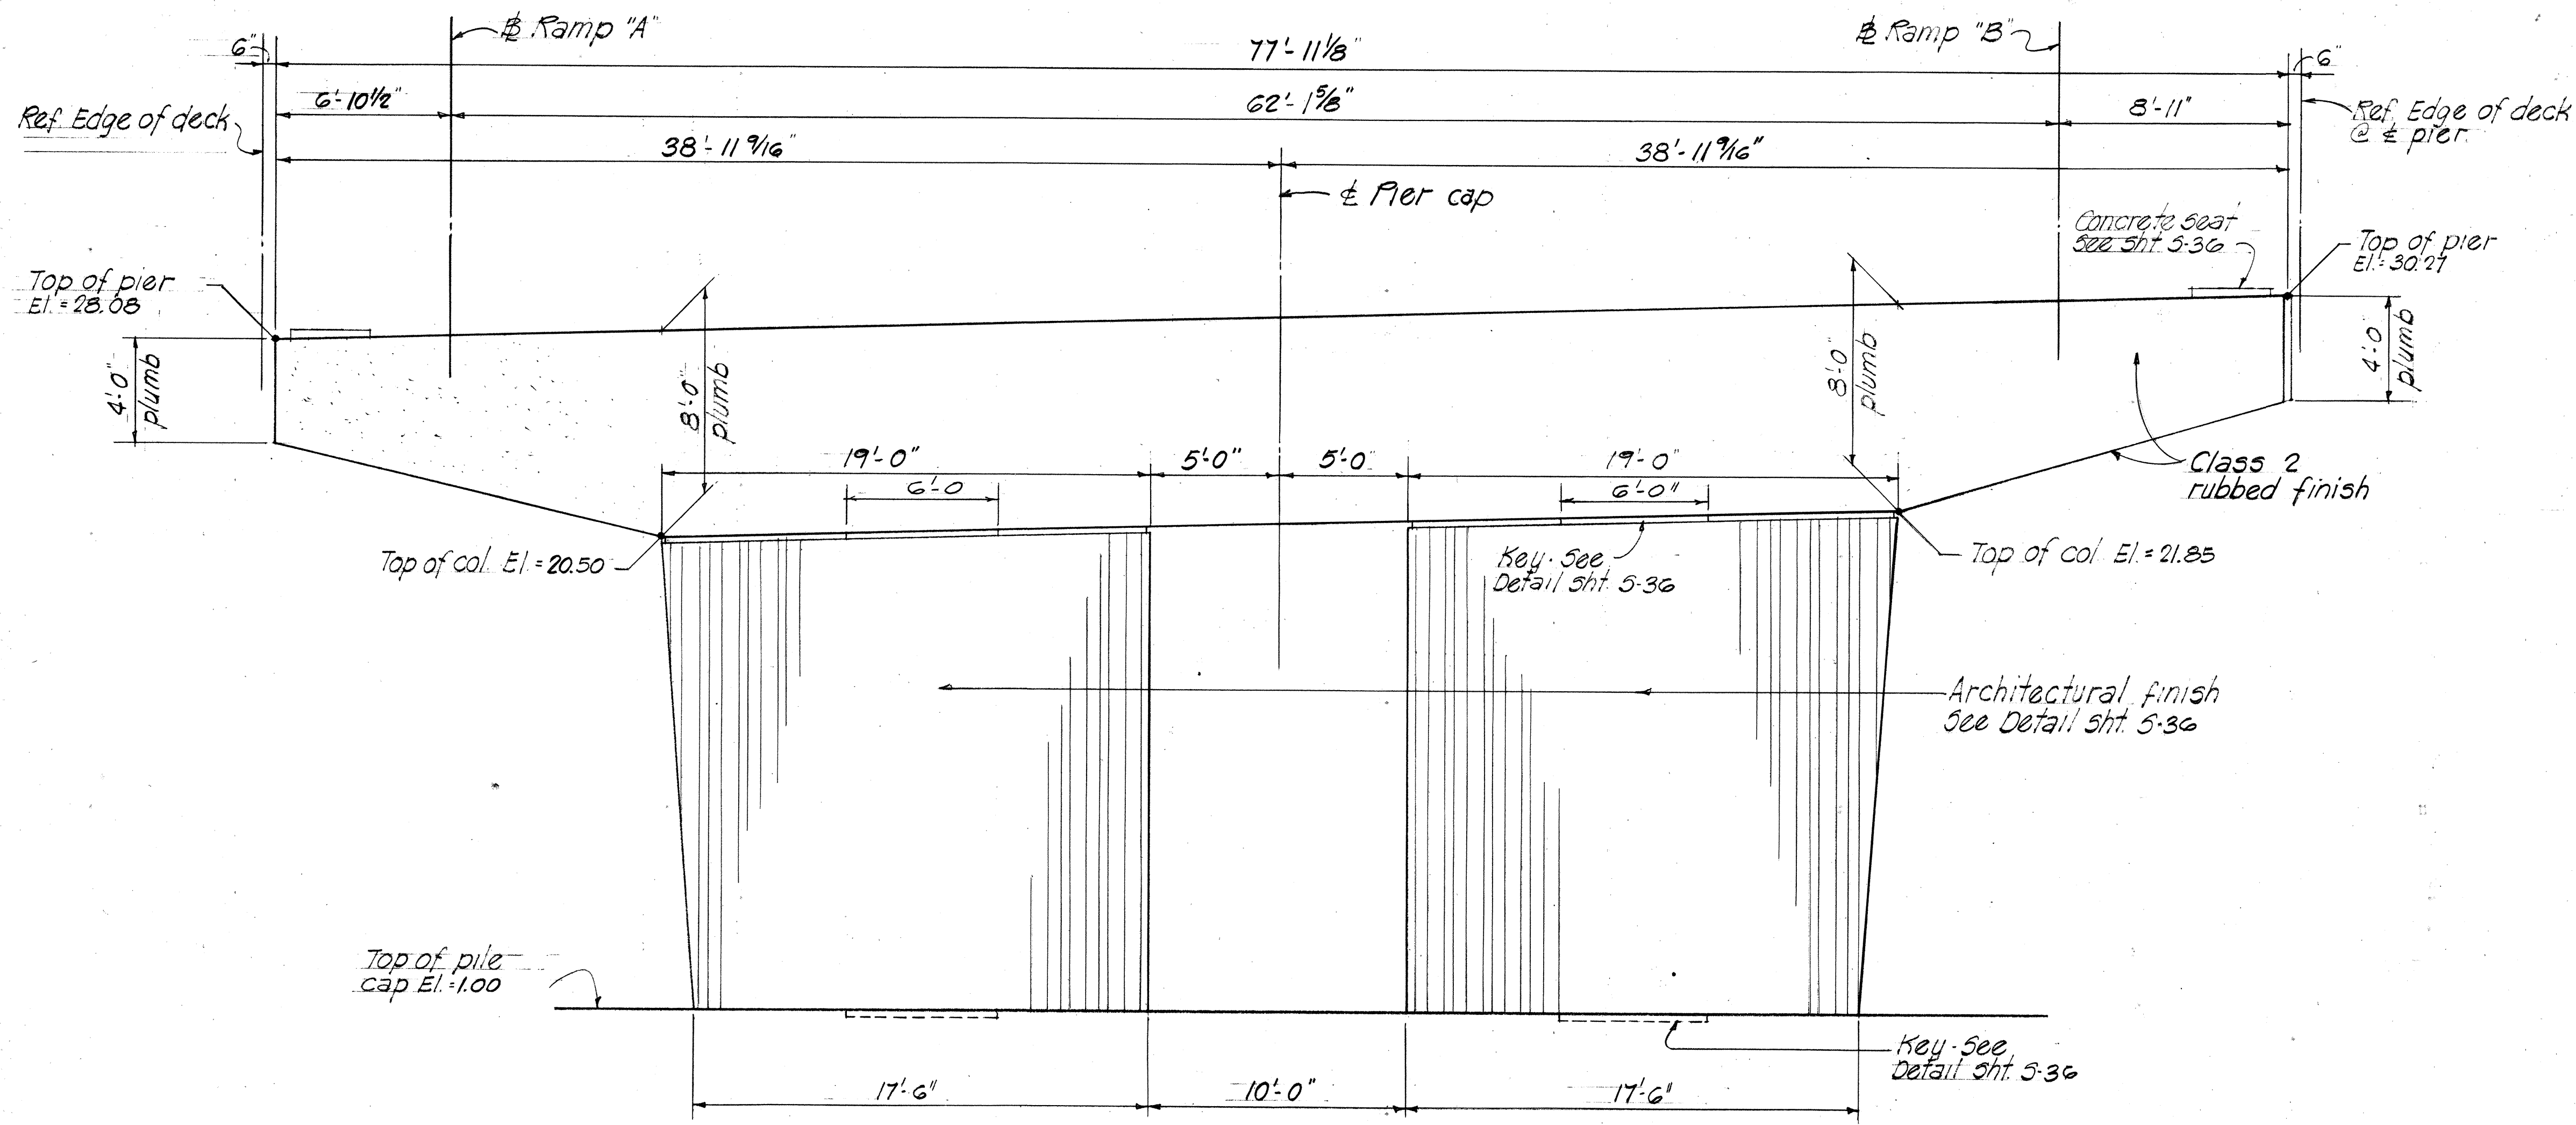

ELEVATION ~ PIER (A9) & (B1)  
Scale 1/4" = 1'-0"

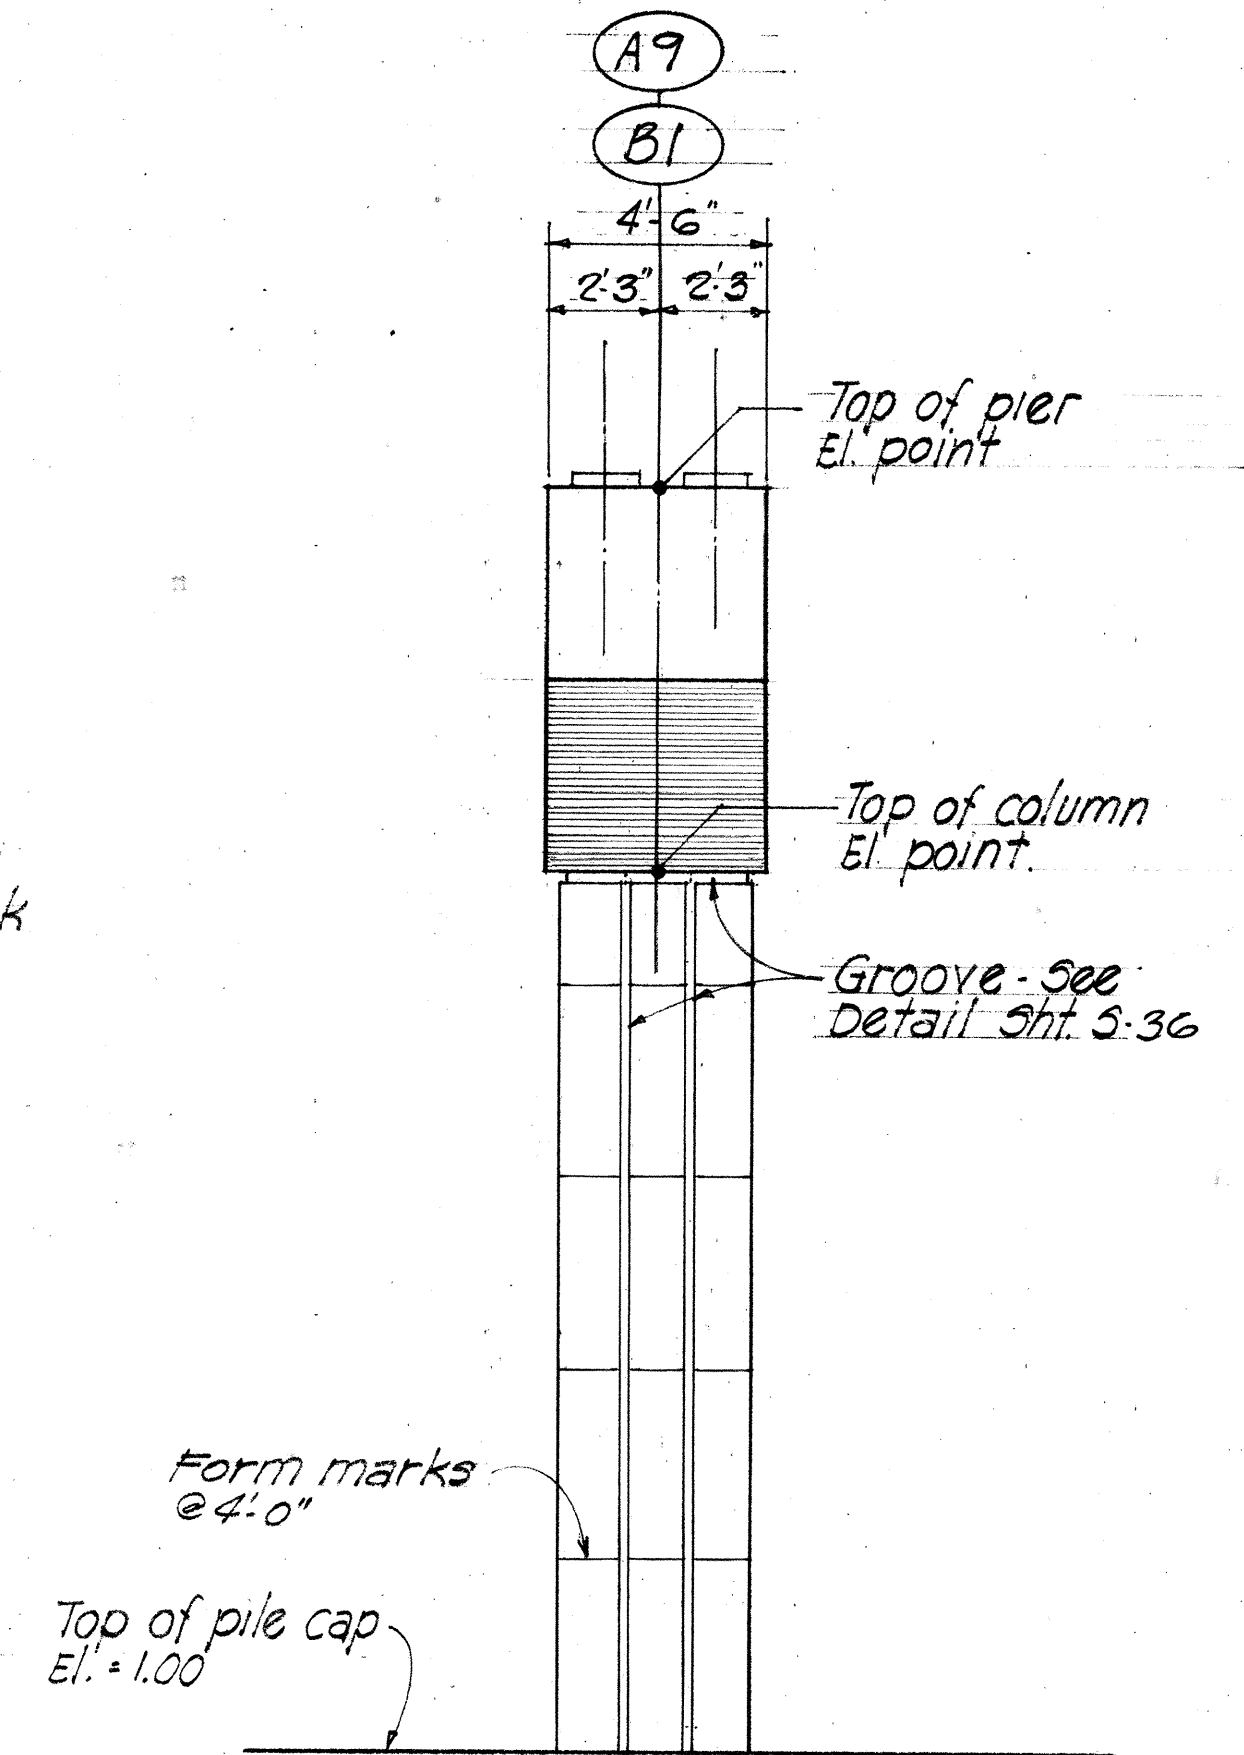

END ELEVATION  
Scale 1/4" = 1'-0"

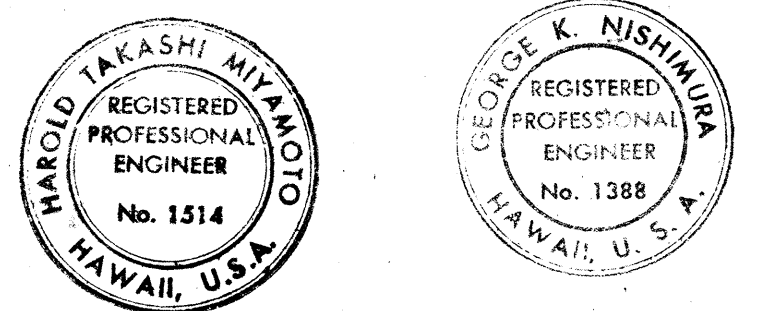

THIS WORK WAS PREPARED BY ME OR UNDER MY SUPERVISION  
*Harold Miyamoto*  
THIS WORK WAS PREPARED BY ME OR UNDER MY SUPERVISION  
*George K. Nishimura*


STATE OF HAWAII  
DEPARTMENT OF TRANSPORTATION  
HIGHWAYS DIVISION  
NIMITZ CONNECTOR (E.B.),  
RAMP "A" & RAMP "B"  
PIER A9 & B1 DETAIL  
KEEHI INTERCHANGE  
F.A.I. PROJ. NO. 1-HI-1 (108) IT  
Scale AS SHOWN Date JULY, 1981  
SHEET No. 5-29 OF 49 SHEETS

DATE  
DRAWN BY  
DESIGNED BY  
NOTED BY  
CHECKED BY  
ORIGINAL PLAN  
NOTE BOOK  
NO.



NOTE: All #18 & #14 bars shall be grade 60.

| FED. ROAD DIST. NO. | STATE | FED. AID PROJ. NO. | FISCAL YEAR | SHEET NO. | TOTAL SHEETS |
|---------------------|-------|--------------------|-------------|-----------|--------------|
| HAWAII              | HAW.  | 1-H1-1(168)17      | 1982        | 112       | 145          |

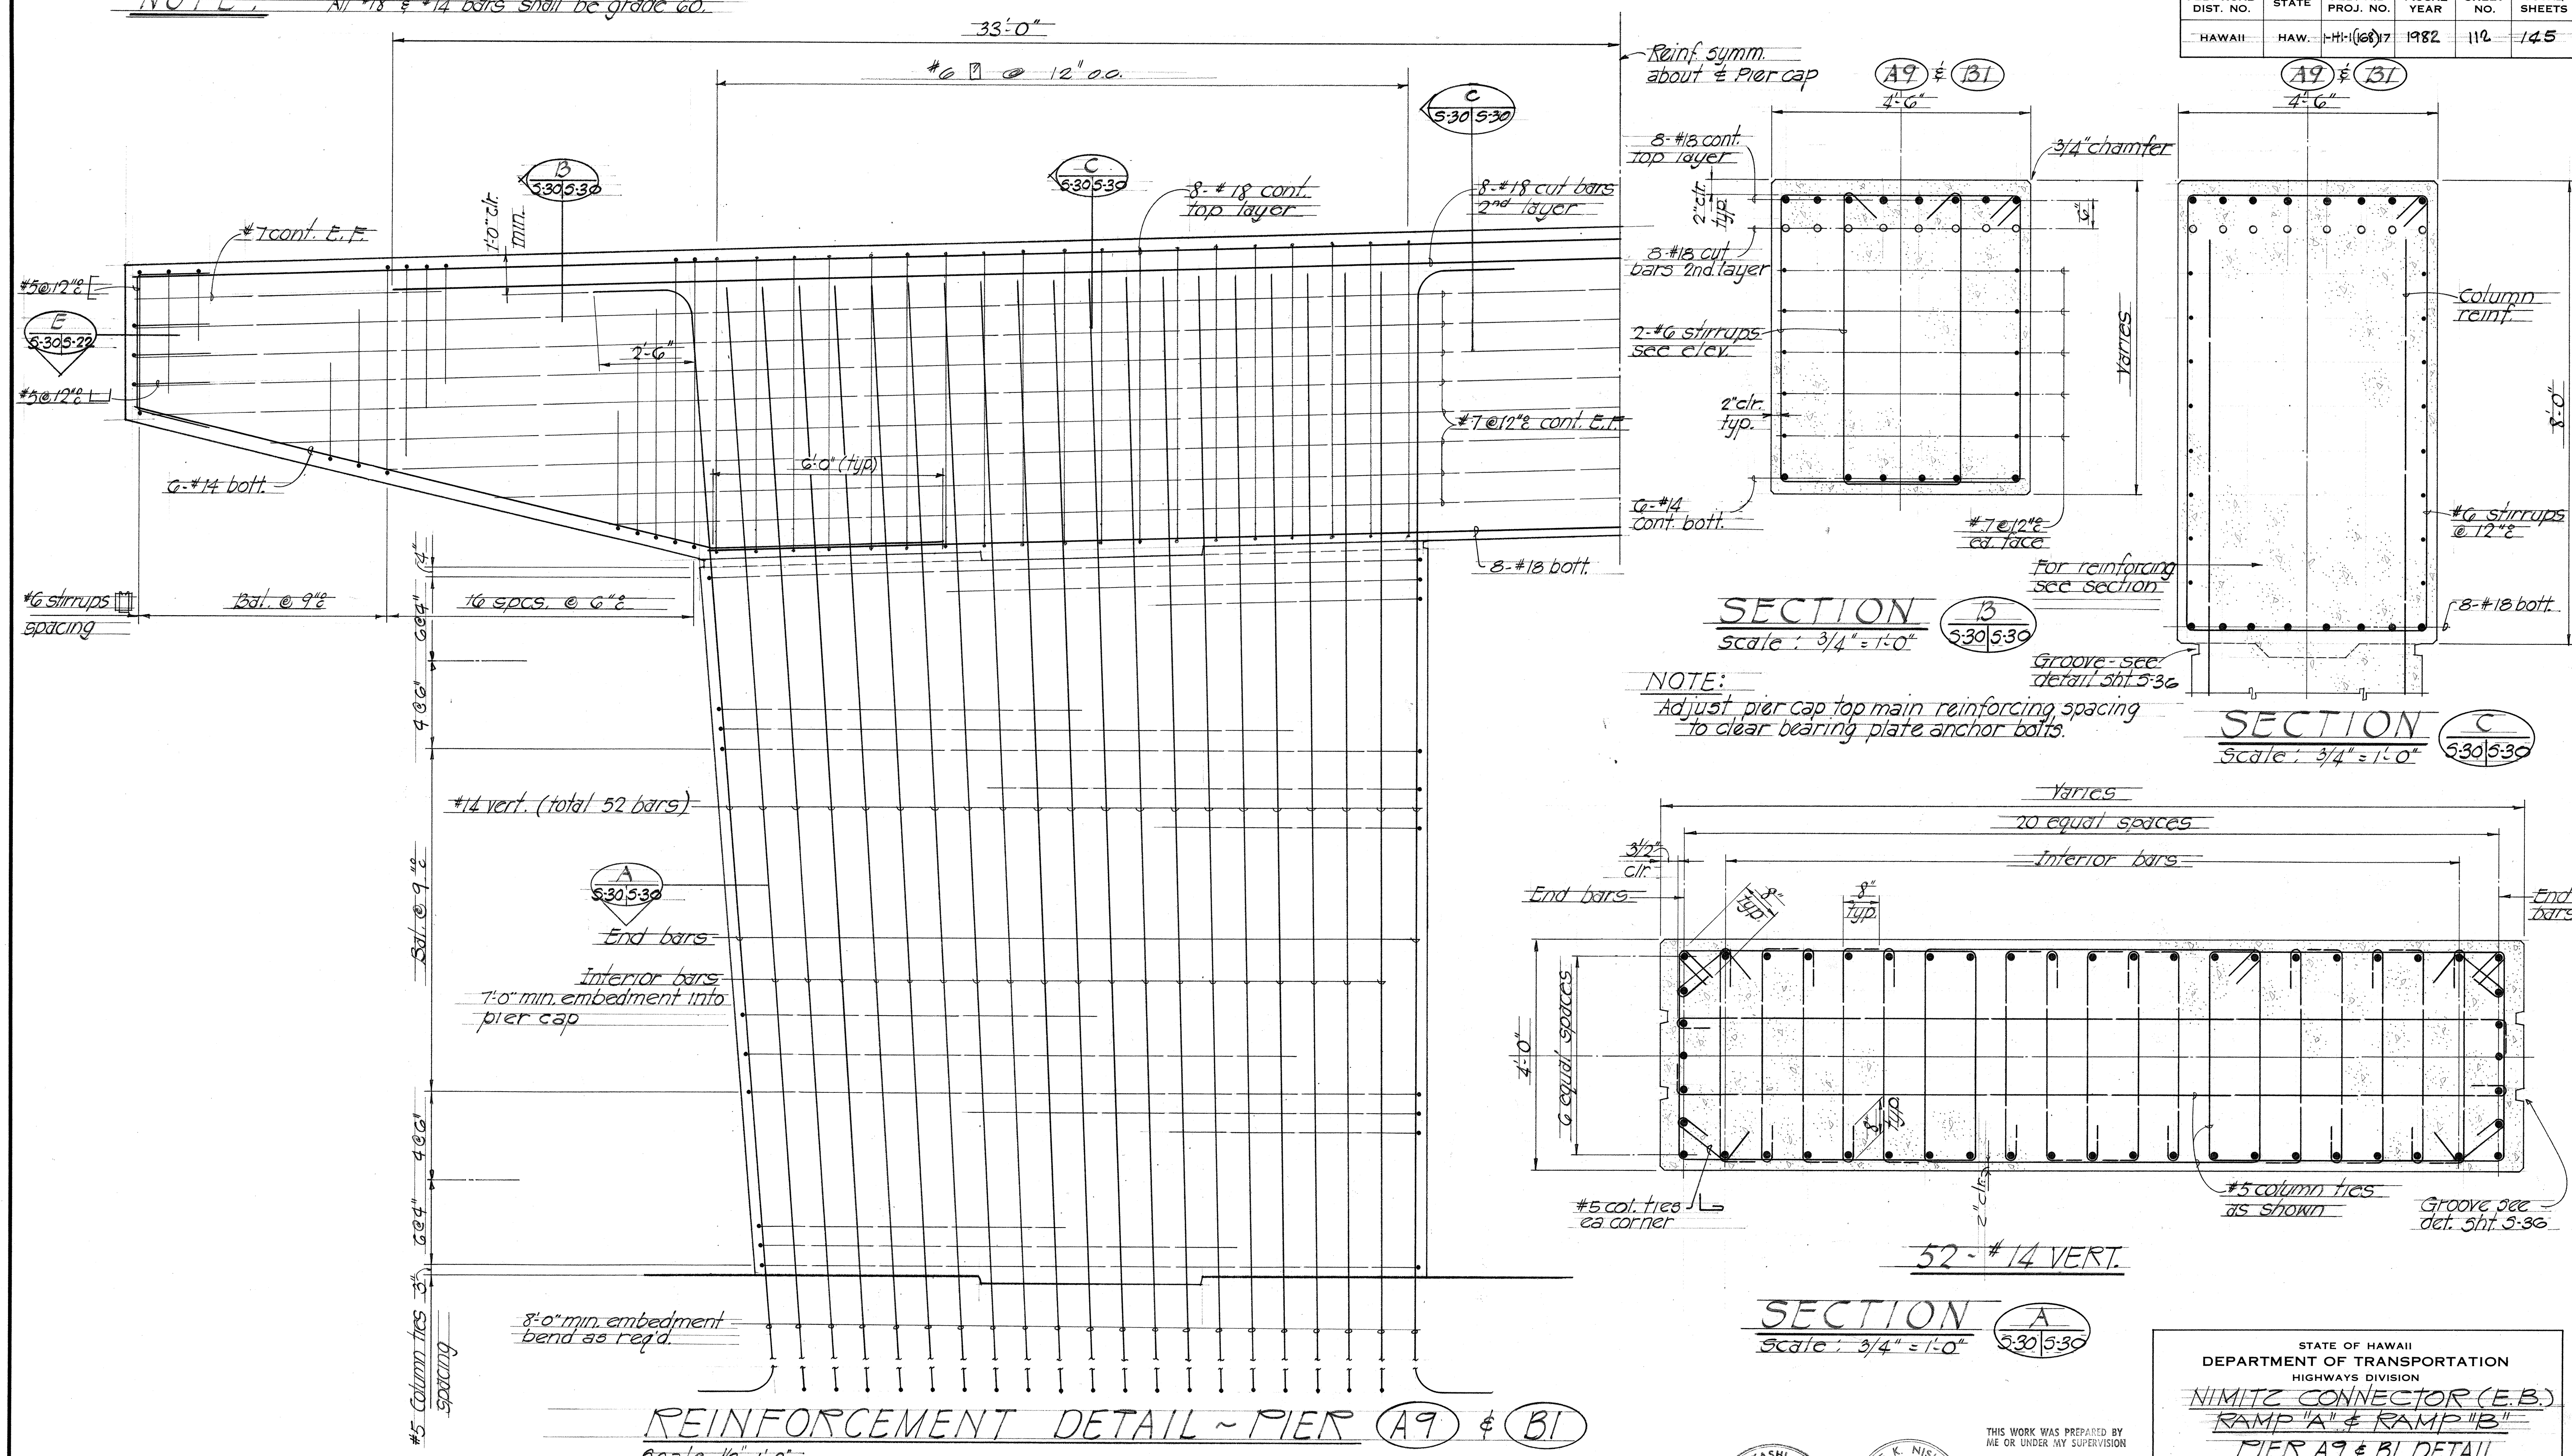



SECTION B  
Scale: 3/4" = 1'-0"

SECTION C  
Scale: 3/4" = 1'-0"

SECTION A  
Scale: 3/4" = 1'-0"

REINFORCEMENT DETAIL - PIER A9 & B1  
Scale: 1/2" = 1'-0"

|                   |       |
|-------------------|-------|
| DATE              | _____ |
| SURVEY PLOTTED BY | _____ |
| DRAWN BY          | _____ |
| DESIGNED BY       | _____ |
| CHECKED BY        | _____ |
| NO.               | _____ |

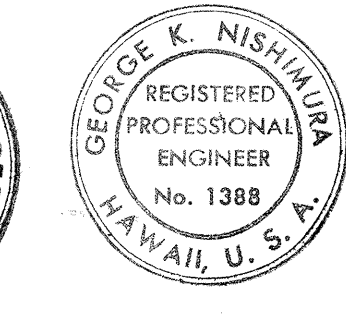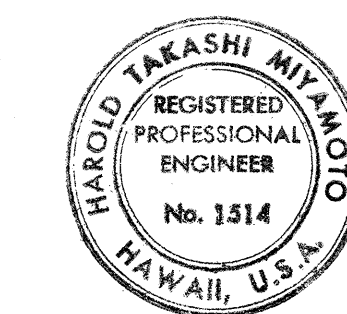

THIS WORK WAS PREPARED BY  
ME OR UNDER MY SUPERVISION  
*George K. Nishikura*  
THIS WORK WAS PREPARED BY  
ME OR UNDER MY SUPERVISION  
*Harold Takashi Miyamoto*


STATE OF HAWAII  
DEPARTMENT OF TRANSPORTATION  
HIGHWAYS DIVISION  
NIMITZ CONNECTOR (E.B.)  
RAMP "A" & RAMP "B"  
PIER A9 & B1 DETAIL  
KEEHI INTERCHANGE  
F.A.I. PROJ. NO. 1-H1-1(168)17  
Scale: AS SHOWN Date: JULY, 1981  
SHEET No. 530 OF 49 SHEETS








| FED. ROAD DIST. NO. | STATE | FED. AID PROJ. NO. | FISCAL YEAR | SHEET NO. | TOTAL SHEETS |
|---------------------|-------|--------------------|-------------|-----------|--------------|
| HAWAII              | HAW.  | 1-HI-1(168)17      | 1982        | 114       | 145          |

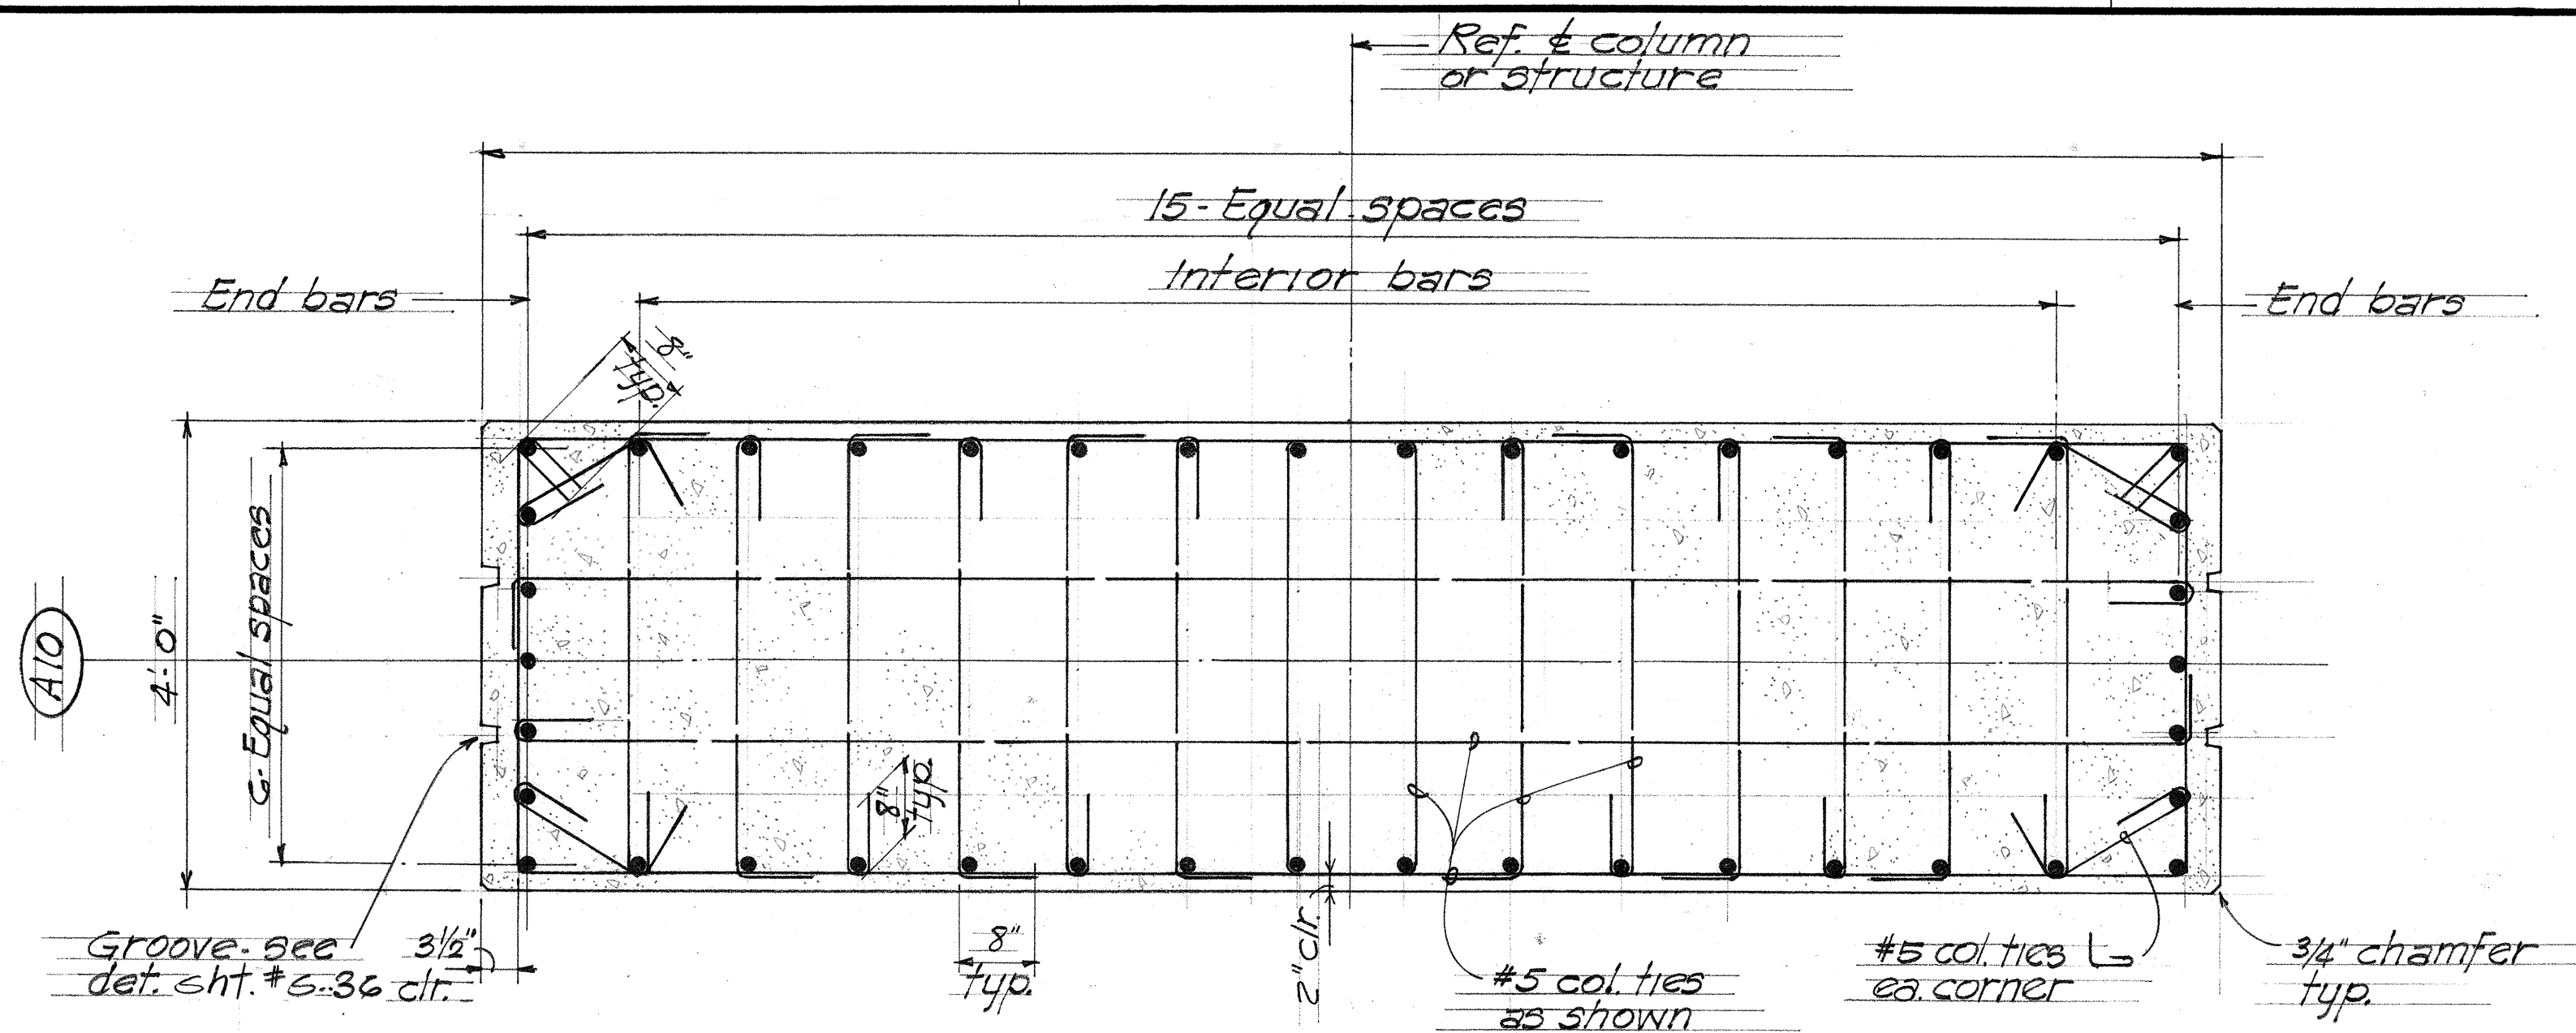


NOTE:  
All #13 & #14 bars shall be grade 60

42-#14 VERT.  
**SECTION A**  
Scale 3/4"=1'-0"  
5-31/5-32

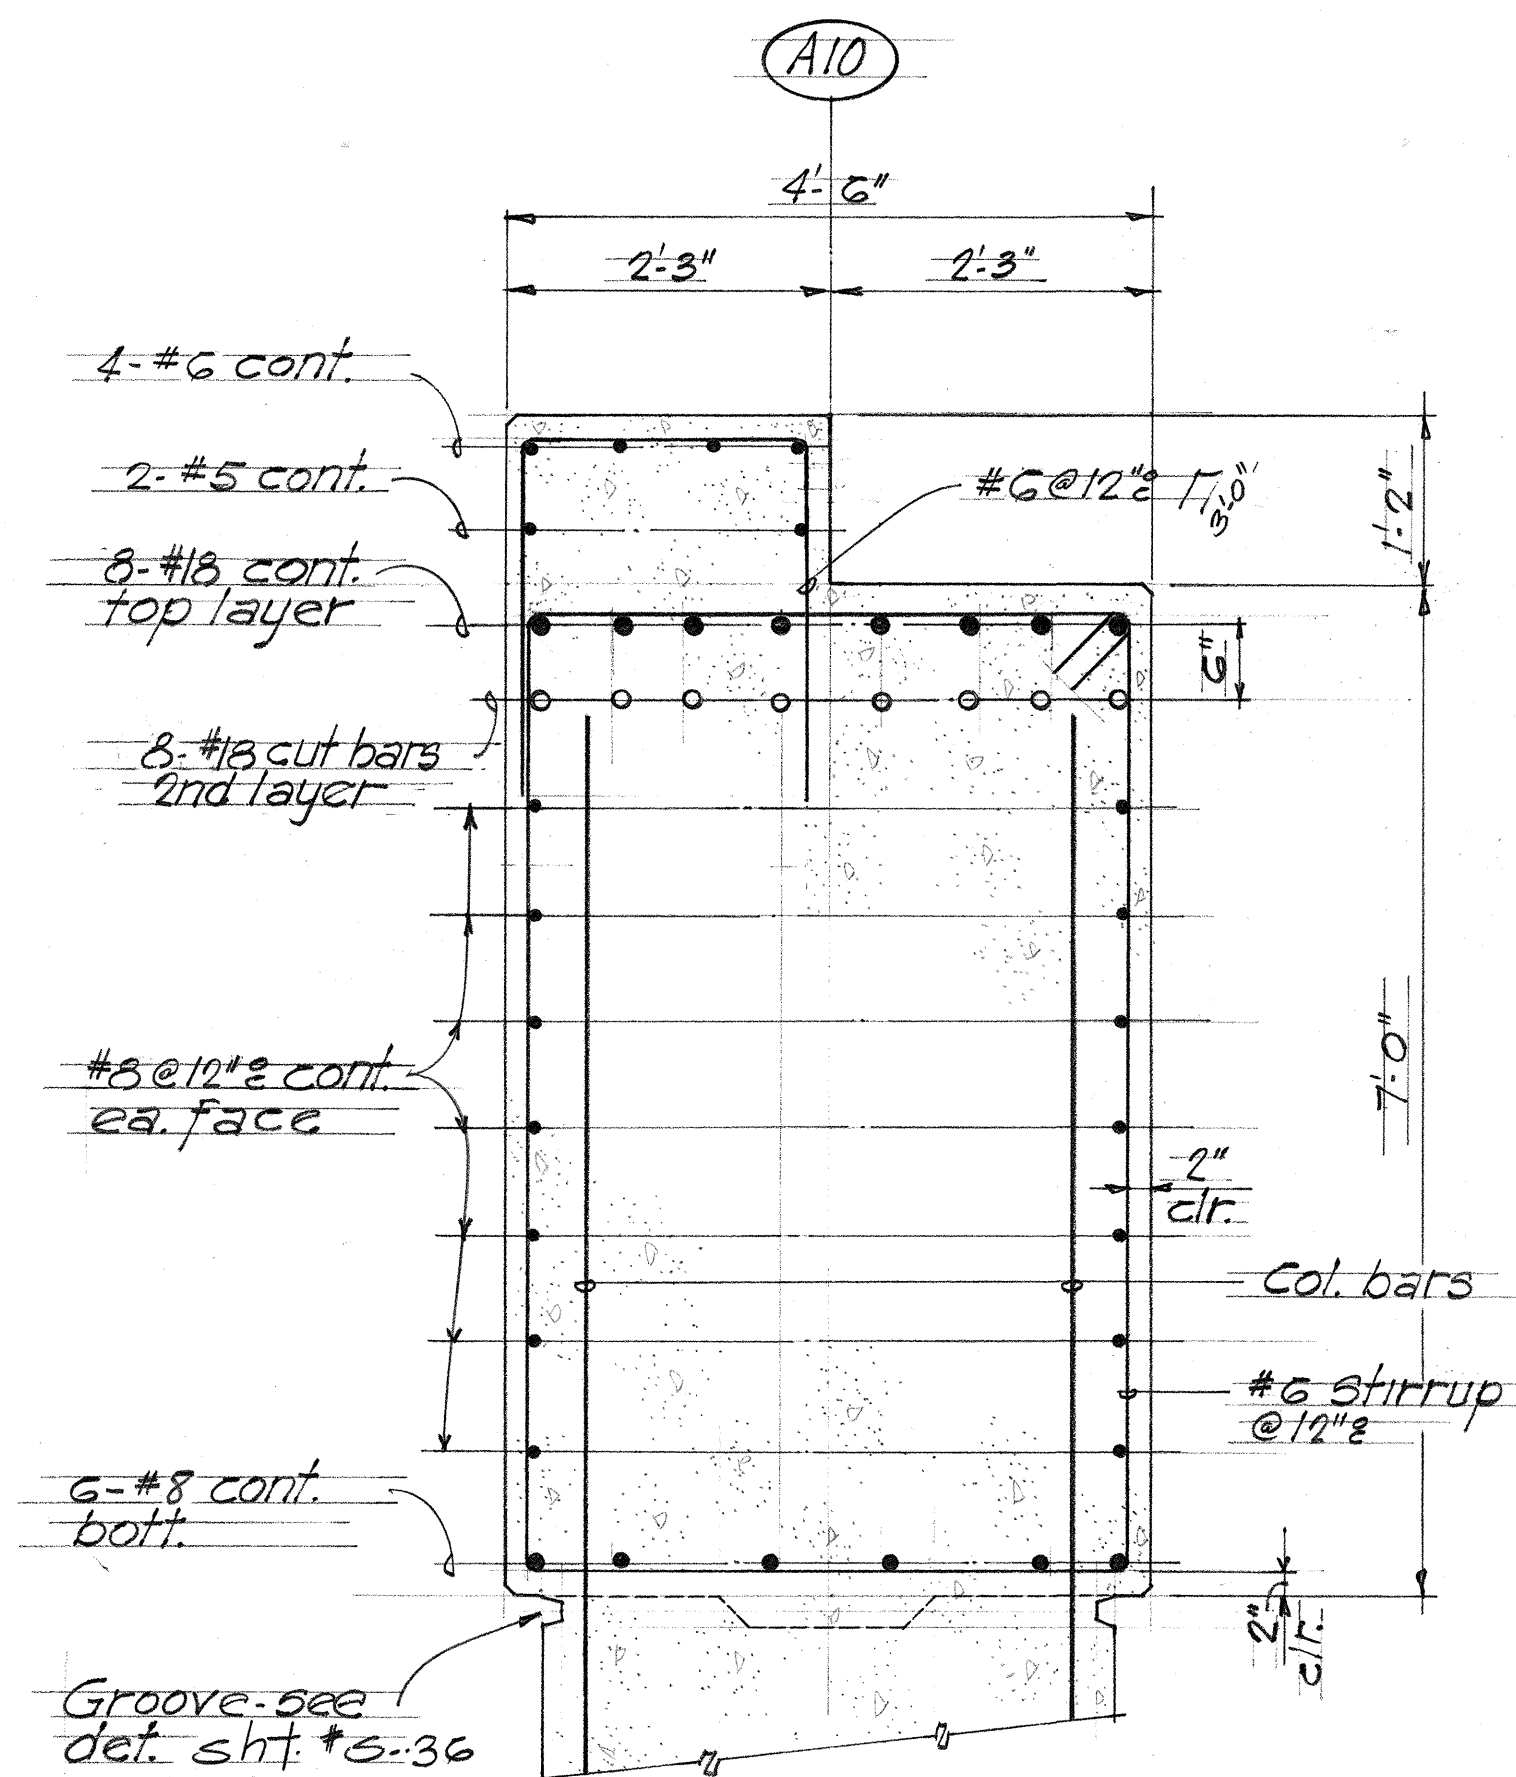


**SECTION B**  
Scale 3/4"=1'-0"  
5-31/5-32

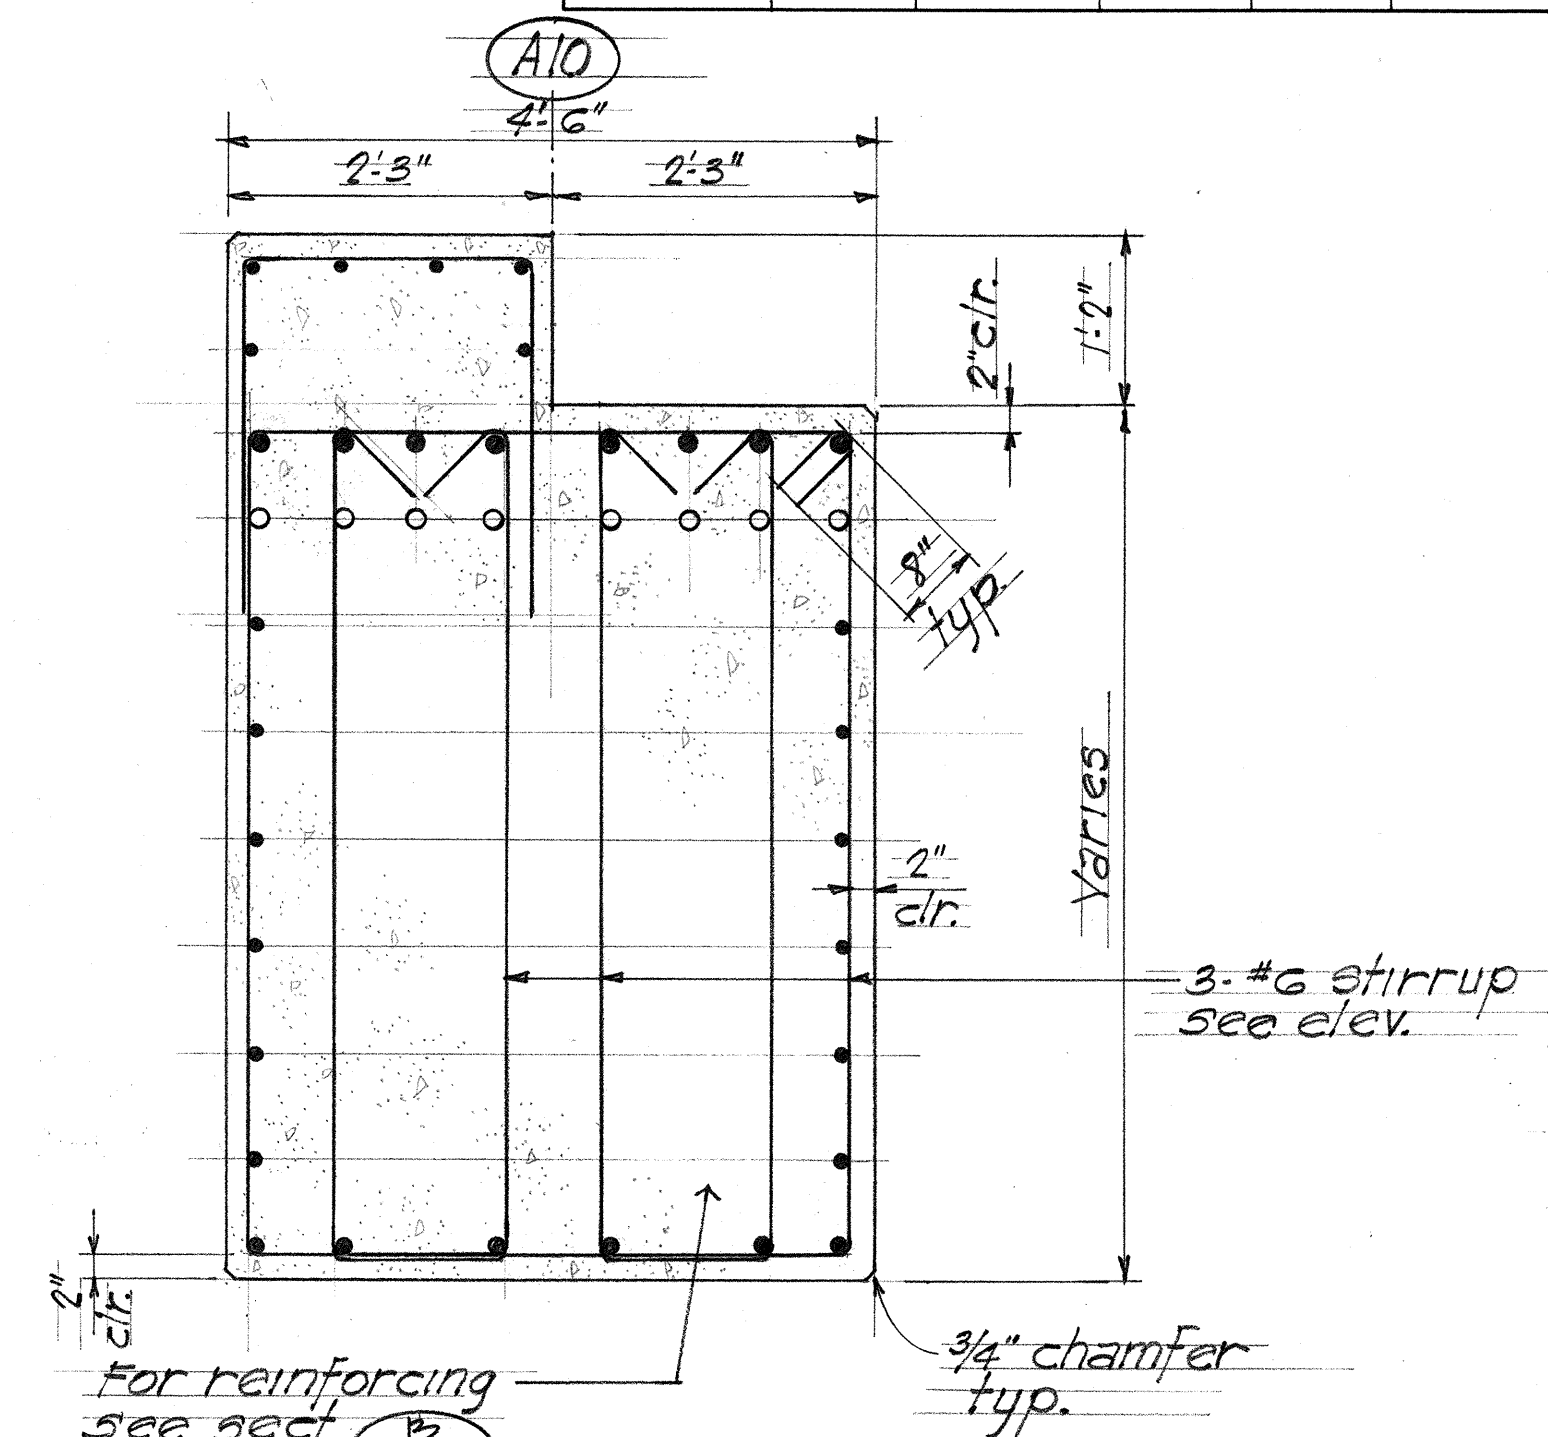

**SECTION C**  
Scale 3/4"=1'-0"  
5-31/5-32

NOTE:  
Adjust pier cap top main reinforcing spacing to clear bearing plate anchor bolts.

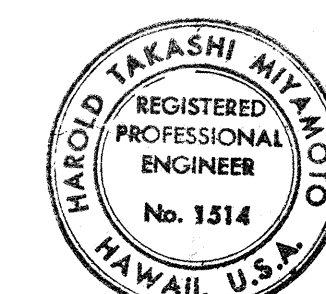

THIS WORK WAS PREPARED BY  
ME OR UNDER MY SUPERVISION

*Harold Takashi Miyamoto*



THIS WORK WAS PREPARED BY  
ME OR UNDER MY SUPERVISION

*George K. Nishimura*

STATE OF HAWAII  
DEPARTMENT OF TRANSPORTATION  
HIGHWAYS DIVISION  
**NIMITZ CONNECTOR (E.B.)**  
**RAMP "A" & RAMP "B"**  
**PIER A10 DETAIL**  
**KEEHI INTERCHANGE**  
F.A.I. PROJ. NO. 1-HI-1 (168) 17  
Scale: As shown Date: JULY, 1981  
SHEET No. 5-32 OF 49 SHEETS



[illegible]

Reinforcing symm. about c column  
# 6 @ 12" o.c.

[illegible]

Anchor bolts bevelled plates, nuts washers, coneric pads for installation

Reinforcing sym. about  $\bar{x}$

#5 column ties as shown

Varies

1.  
2.

secc  
(B2)  
4'-0"  
36.8"

G-Equal spaces

8"  
typ.

8"  
typ.

3 1/2" cir.

3/4" chamfer  
typ.

Interior bars

12-Equal spaces

#5 col ties ea. corner

End bars

Groove-see detail sht. #5-36

8"  
typ.

End bars

36- #14 VERT.

Scale  $\frac{3}{4}" = 1.0"$

Varies

2" #6 stirrups see e/e/r.

2" dia.

3/4" chamfer typ

For reinf. see sect.

2" dia.

#6 stirrup spacing

8

SECTION  
Scale 3/4" = 1'-0"

(B2)  
4'-6"

10-#14 cont.  
top layer

2" clr.  
typ.

8"

2-#14 cont.  
2nd layer

Col. bars

2" clr.  
typ.

#6 stirrups  
@ 12"

#6 @ 12" cont.  
ea. face

2" clr.

Groove. see  
det. sht. #S-36

1/4" chamfer

6-#8 cont.  
bolt.

TAKASHI  
ENGINEERING  
No. 15

Scale  $\frac{1}{2}" = 1'-0"$

SHEET NO. 533 OF 49 SHEETS

THIS WORK WAS PREPARED BY ME OR UNDER MY SUPERVISION


THIS WORK WAS PREPARED BY ME OR UNDER MY SUPERVISION

*Harold J. Bryant* *G. J. [Signature]*


SHEET NO. 533 OF 49 SHEETS



| FED. ROAD DIST. NO. | STATE | FED. AID PROJ. NO. | FISCAL YEAR | SHEET NO. | TOTAL SHEETS |
|---------------------|-------|--------------------|-------------|-----------|--------------|
| HAWAII              | HAW.  | HI-1(68)17         | 1982        | 116       | 145          |

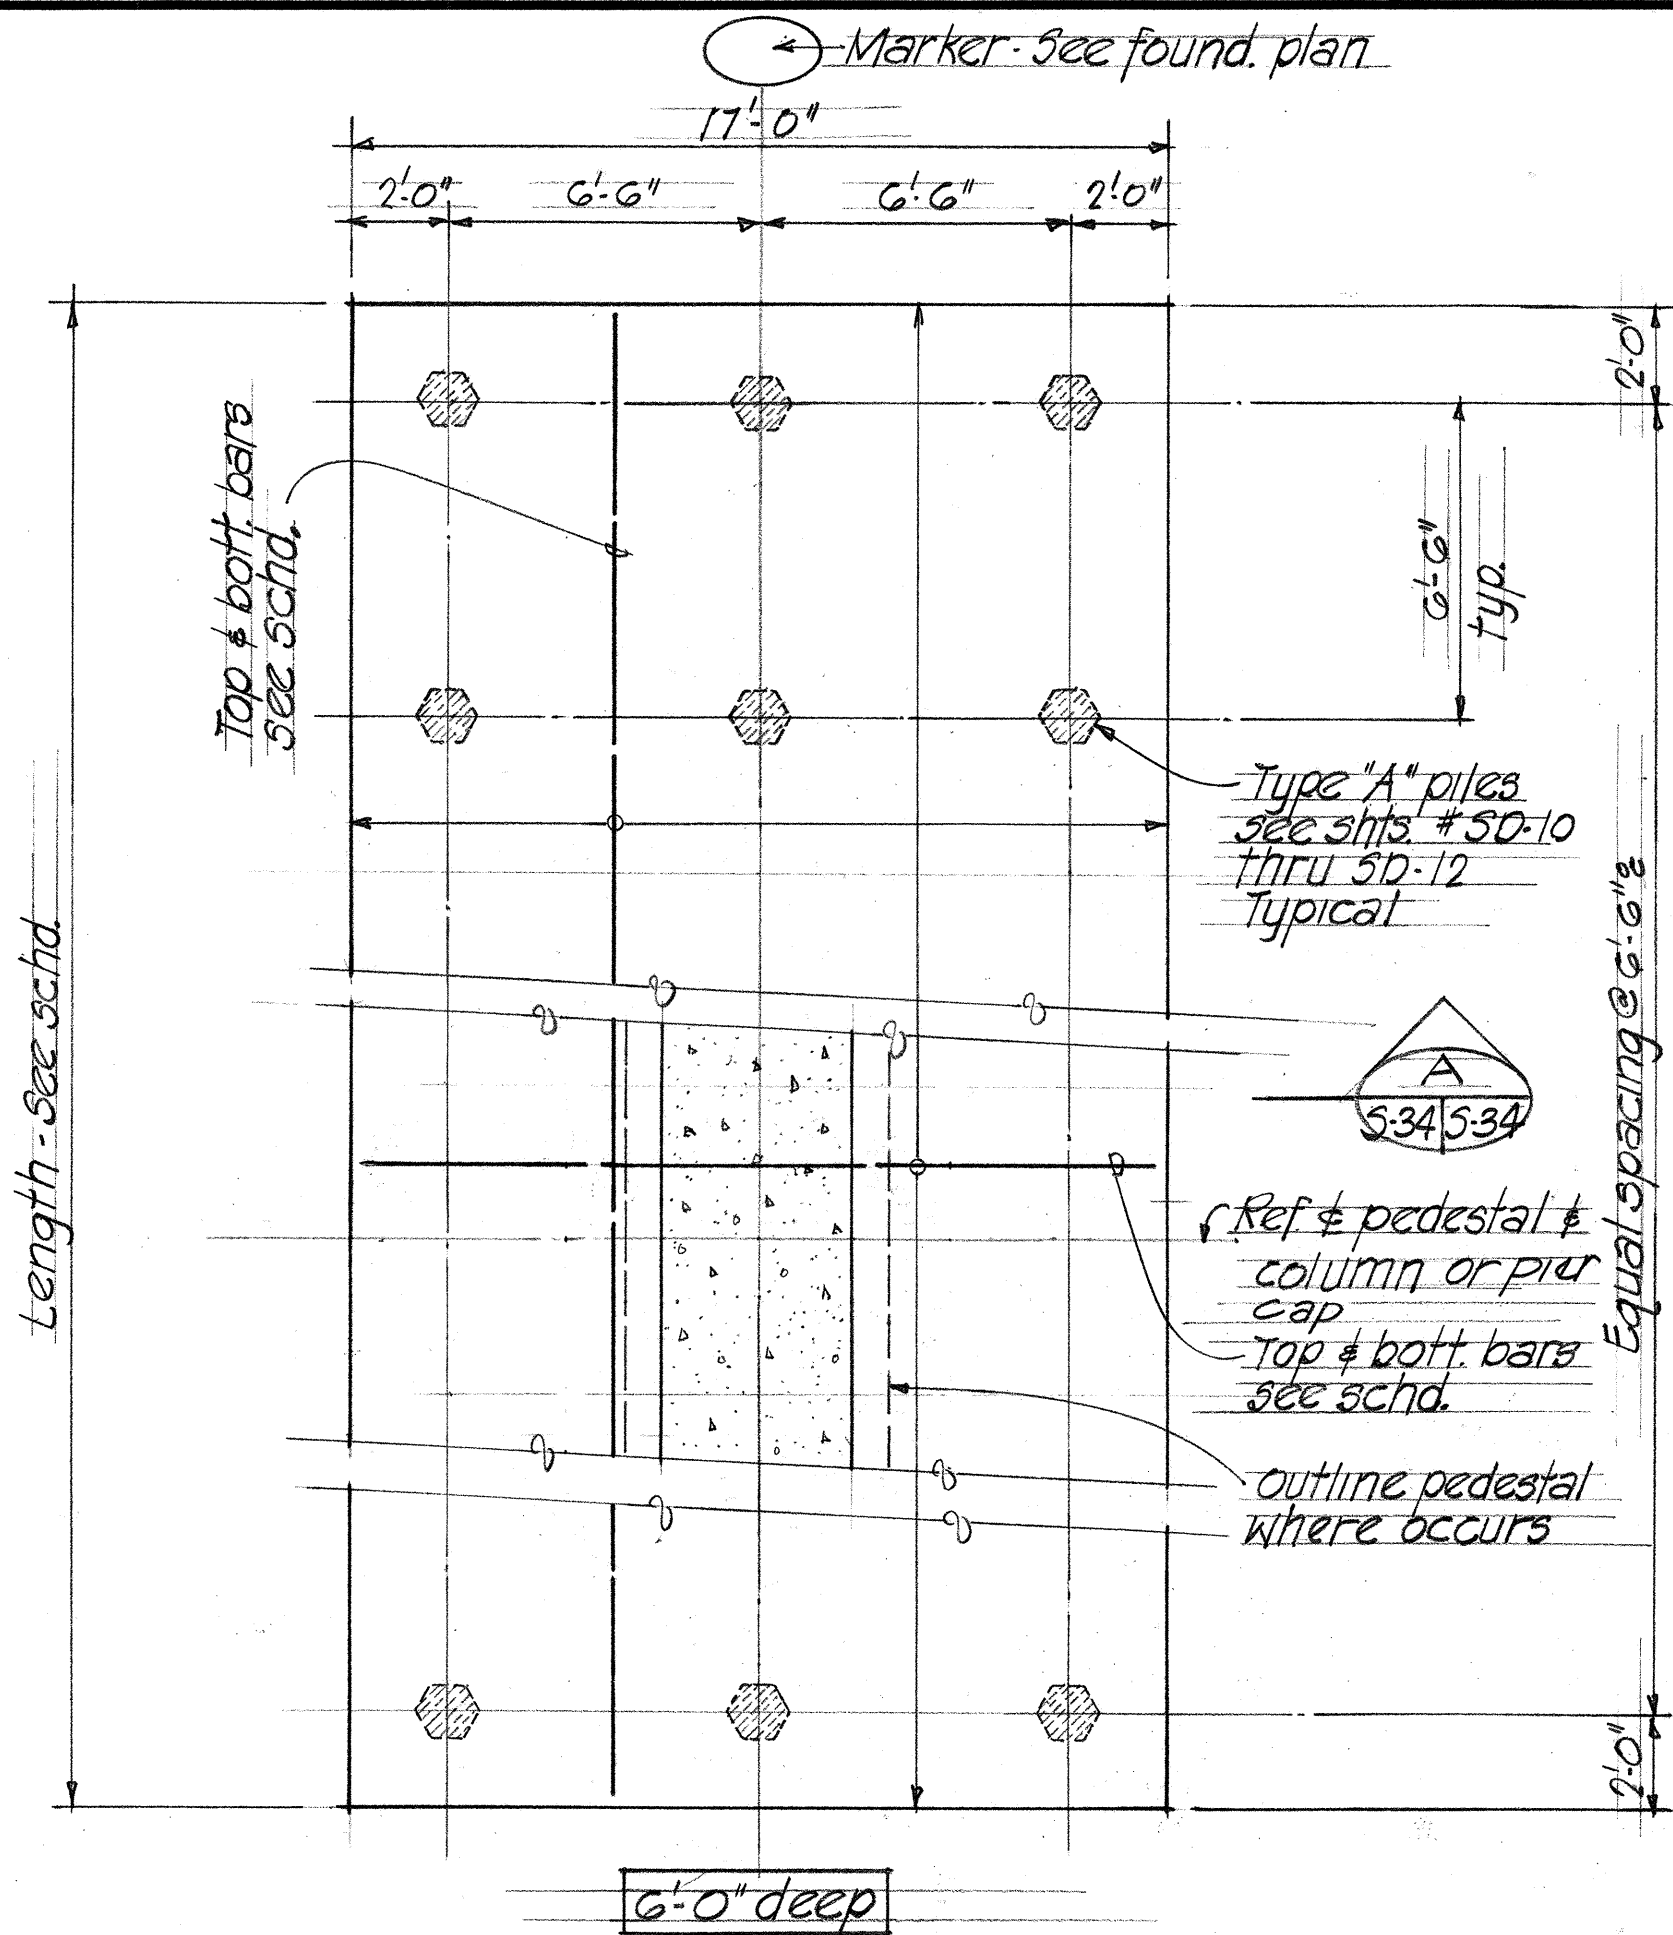


PLAN - PILE CAP TYPE "A", "B", "C" & "E"  
Scale 1/4" = 1'-0"

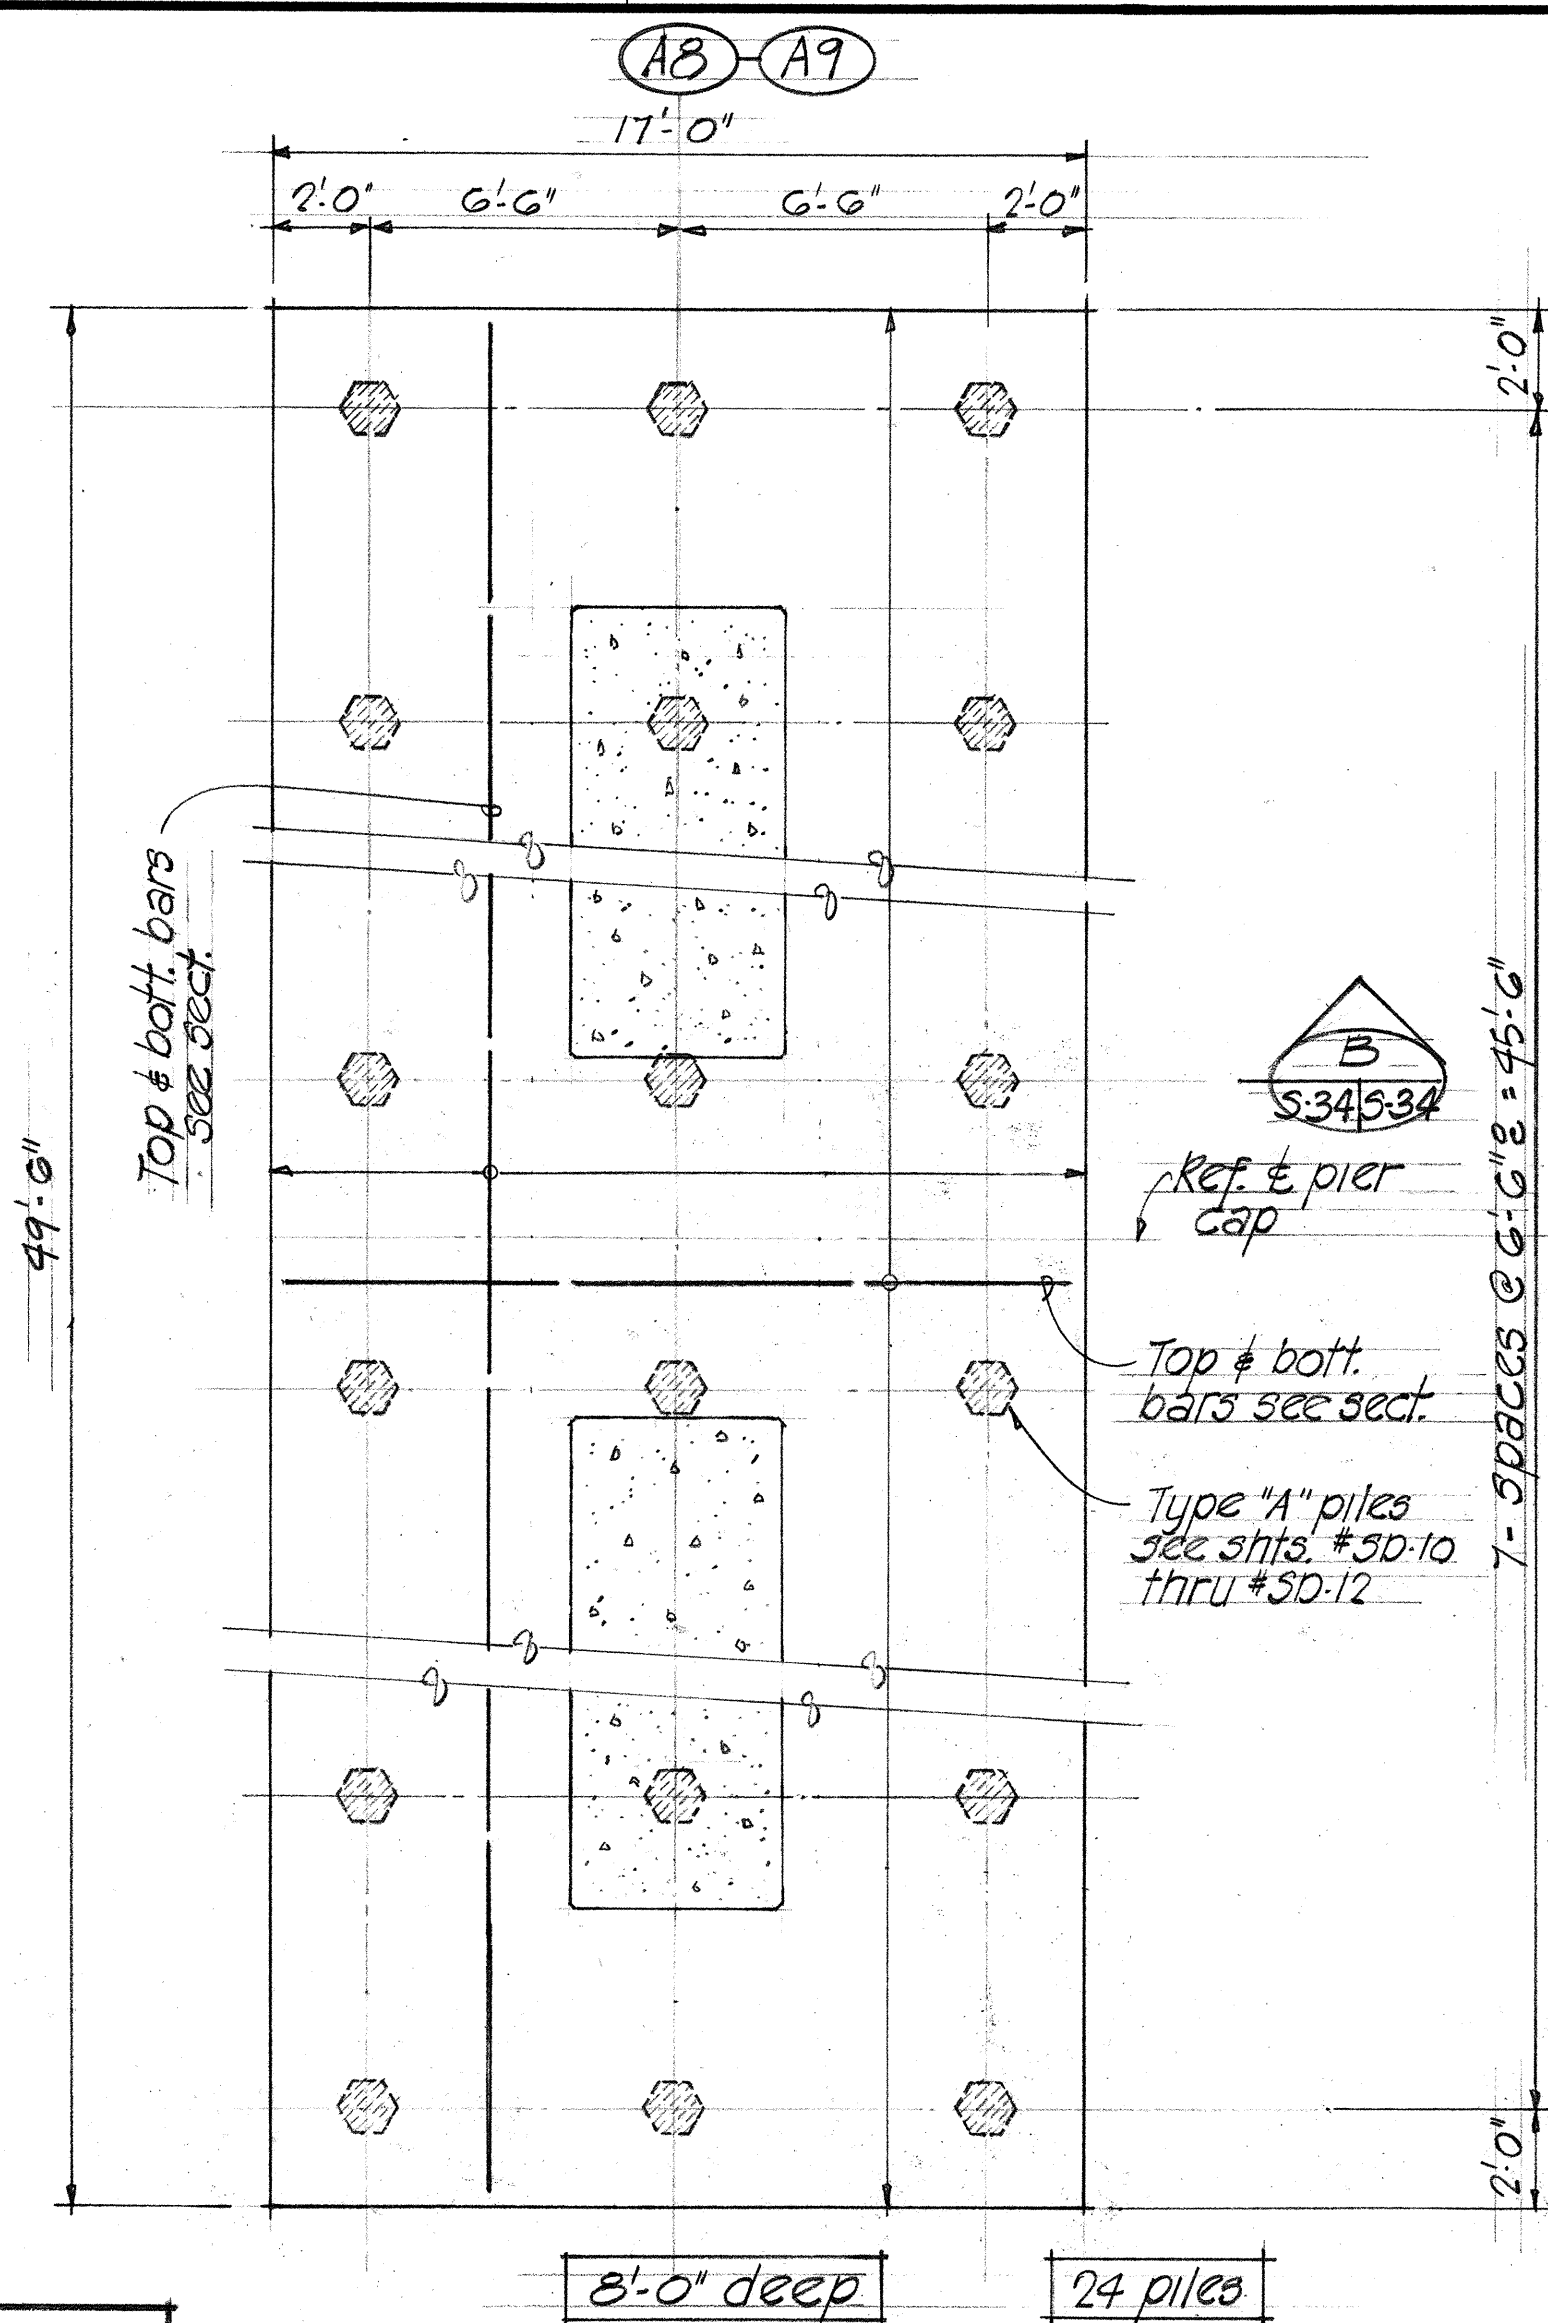


PLAN - PILE CAP TYPE "D"  
Scale 1/4" = 1'-0"

NOTE:  
All #10, #11, #14, & #18 bars to be grade 60.

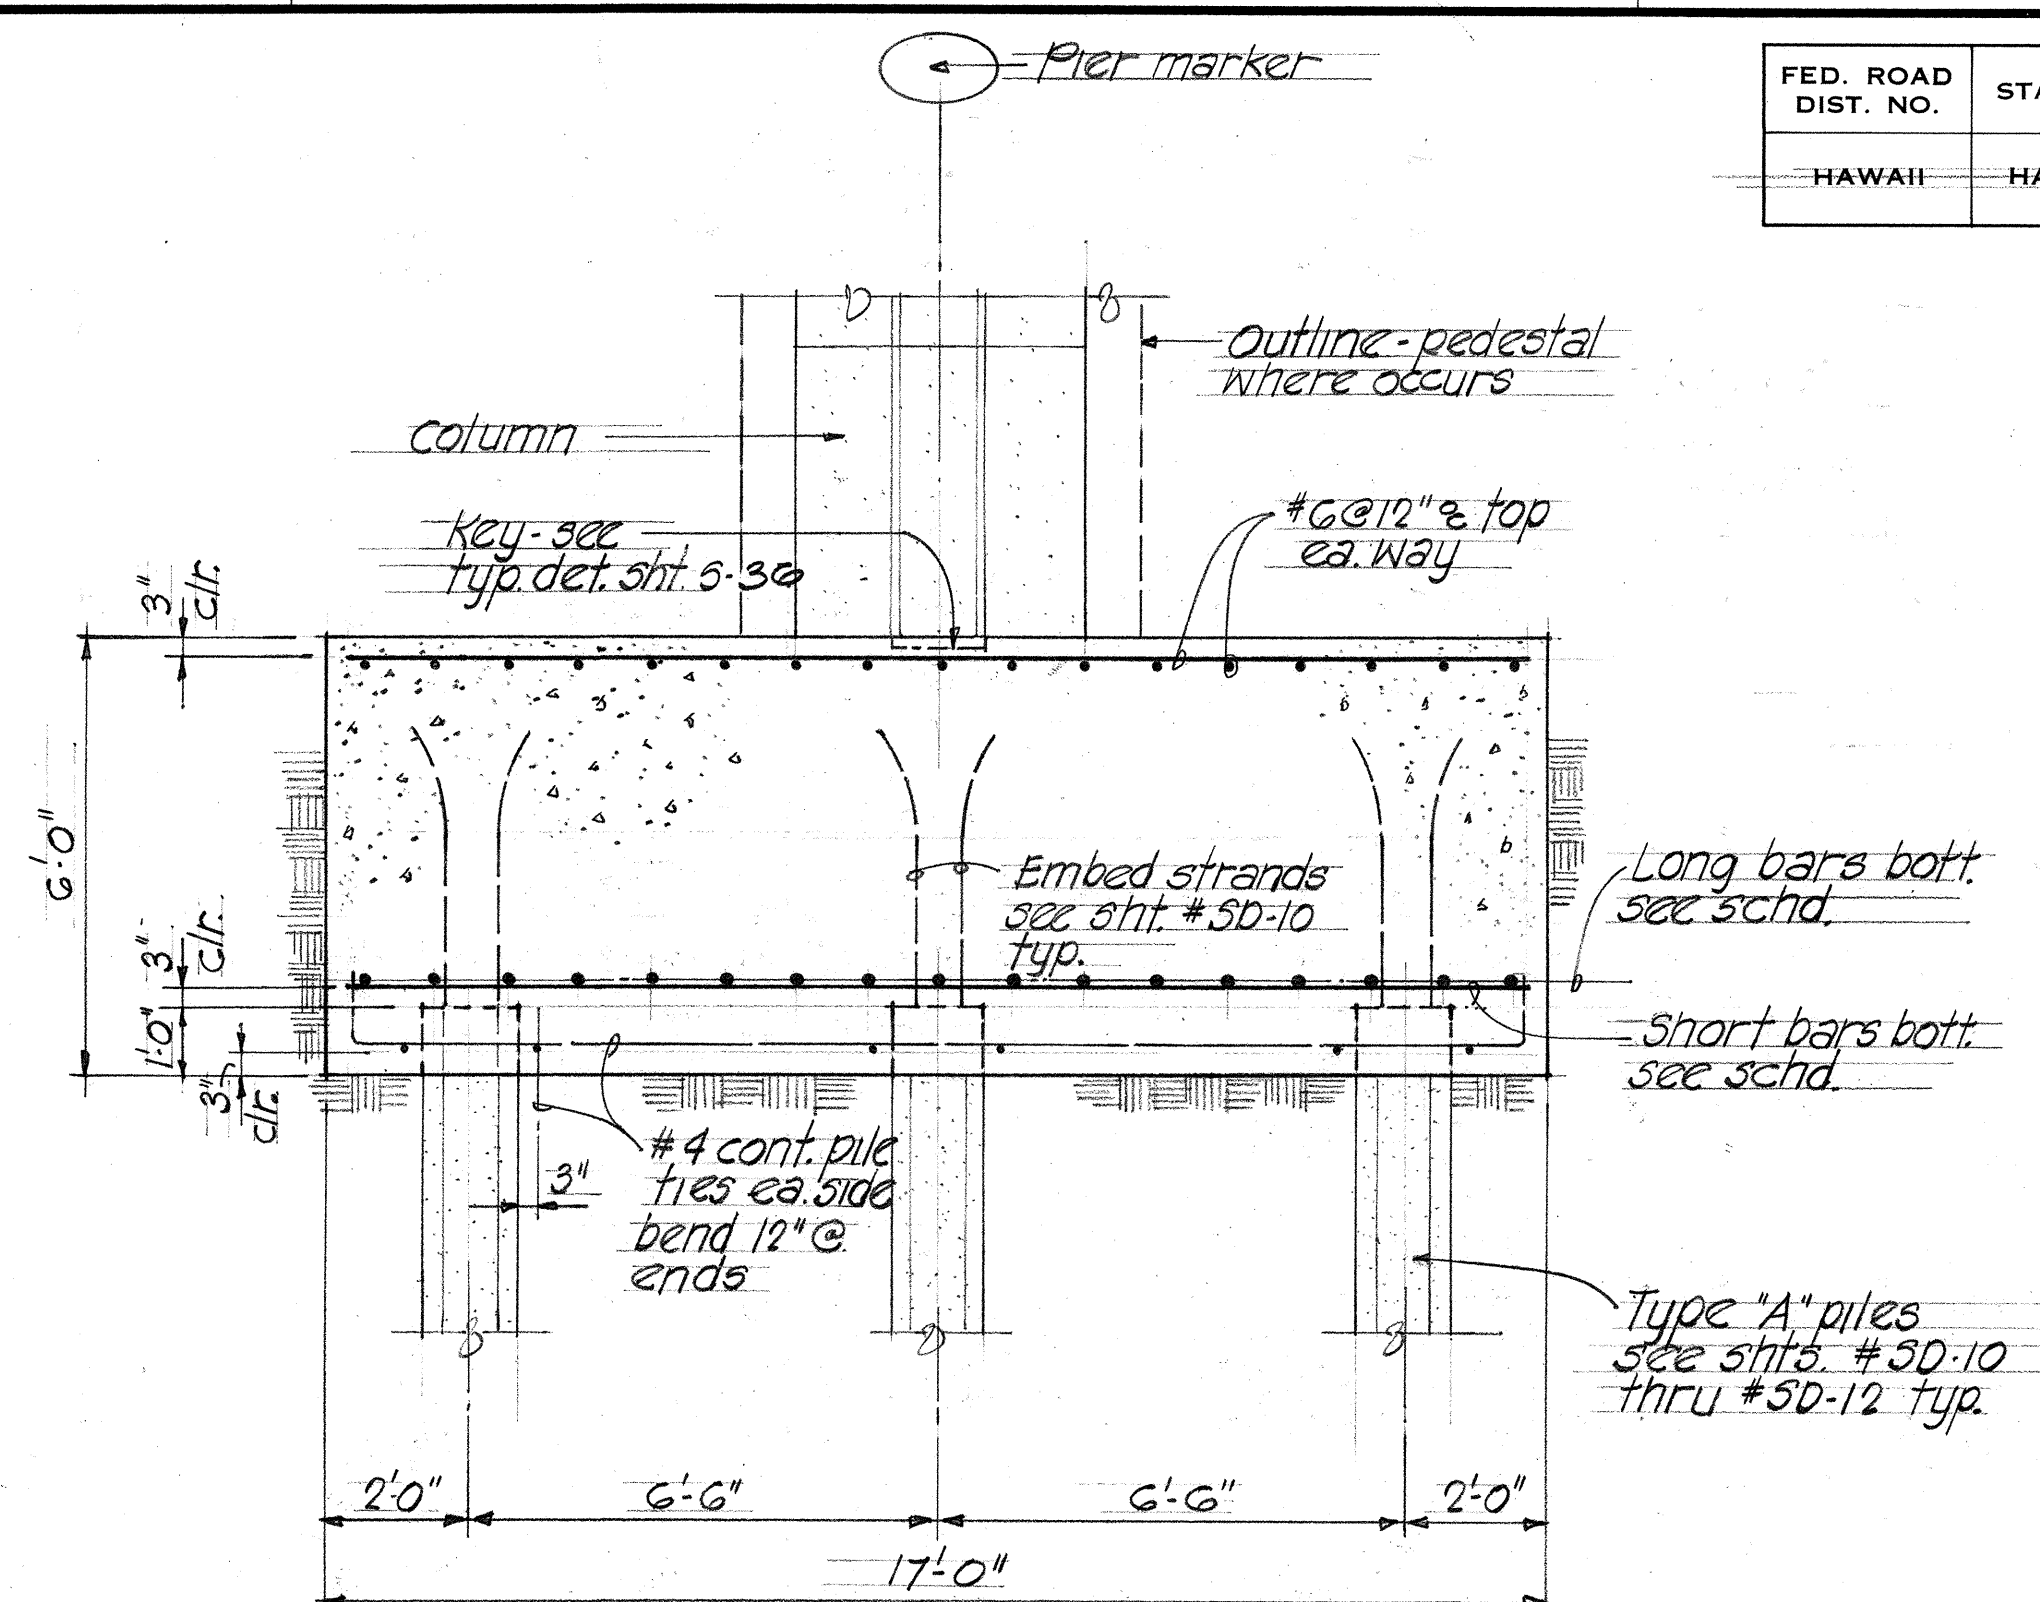

TYP. PILE CAP SECTION @ TYPE "A", "B", "C", & "E"  
Scale 3/8" = 1'-0"


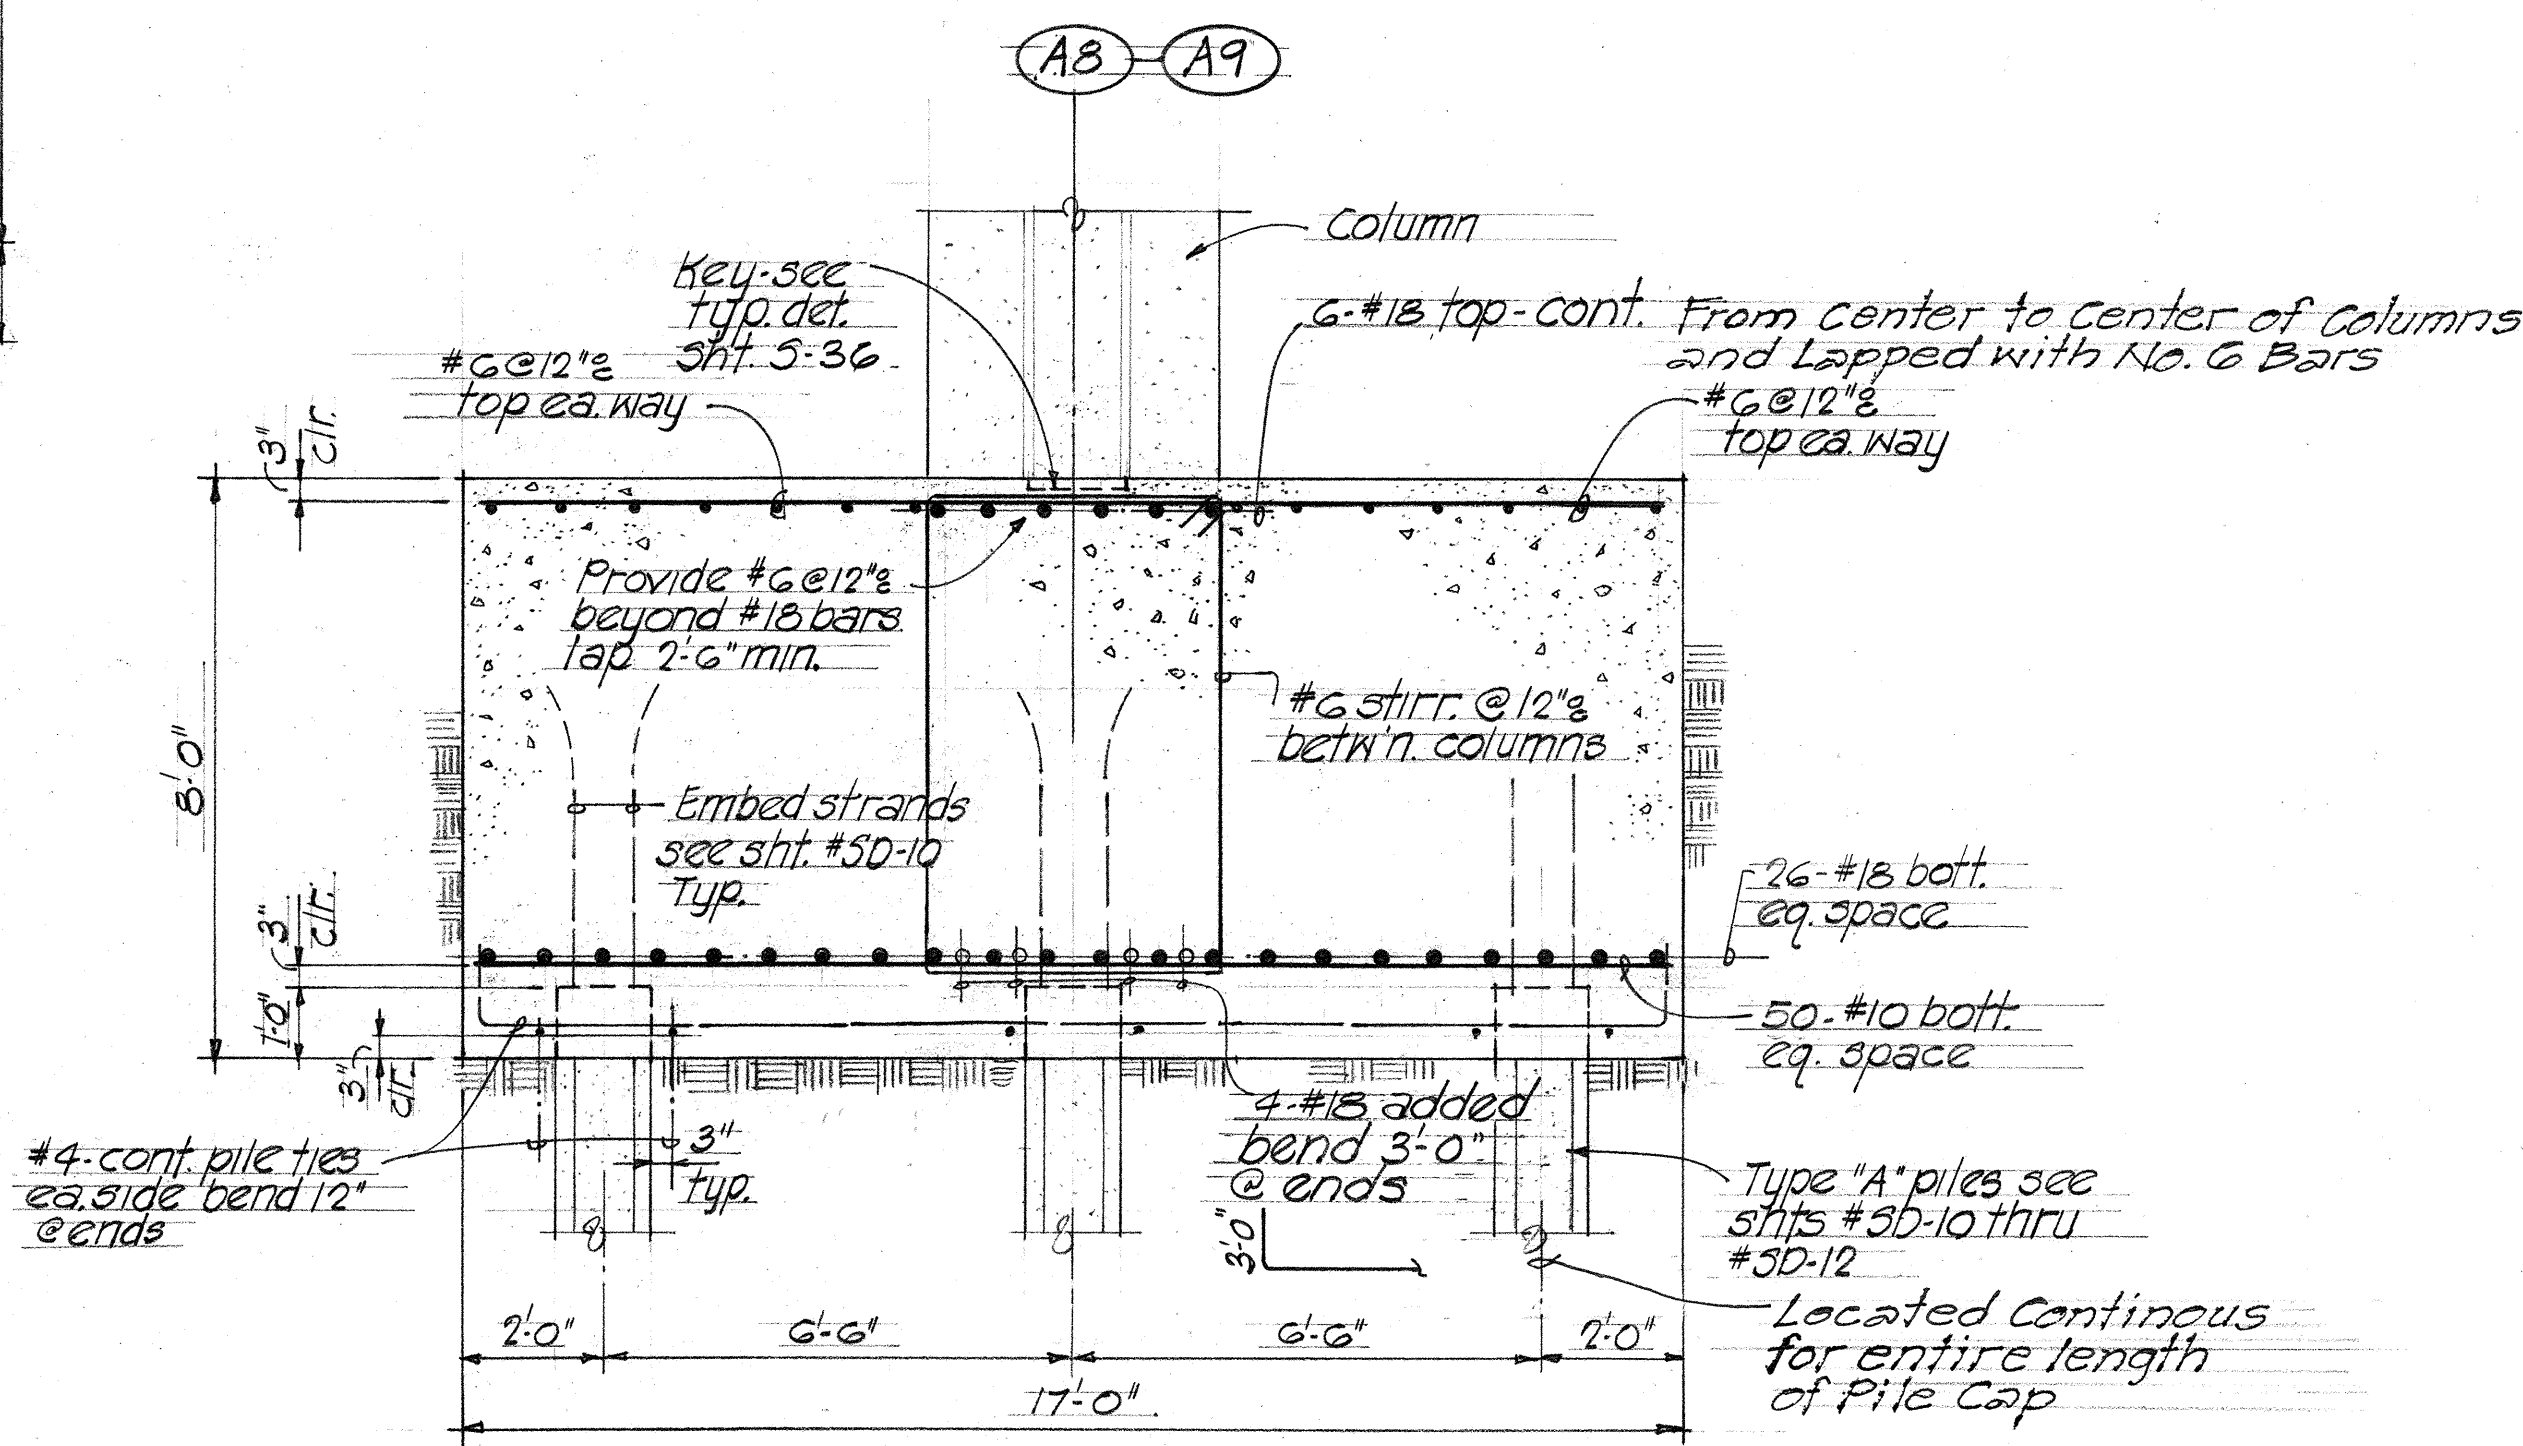


PILE CAP SECTION @ TYPE "D"  
Scale 3/8" = 1'-0"

### PILE CAP SCHEDULE

| Mark TYPE | Pile cap size   | Depth | Reinforcing   |                             | No. of piles | Remarks |
|-----------|-----------------|-------|---------------|-----------------------------|--------------|---------|
|           |                 |       | Top bars      | Bott. bars                  |              |         |
| TYPE "A"  | 17'-0" x 23'-6" | 6'-0" | #6 @ 12" E.W. | 24-#11 short<br>24-#11 long | 12-piles     |         |
| TYPE "B"  | 17'-0" x 30'-0" | 6'-0" | #6 @ 12" E.W. | 32-#11 short<br>18-#10 long | 15-piles     |         |
| TYPE "C"  | 17'-0" x 36'-6" | 6'-0" | #6 @ 12" E.W. | 38-#11 short<br>18-#10 long | 18-piles     |         |
| TYPE "E"  | 17'-0" x 30'-0" | 6'-0" | #6 @ 12" E.W. | 38-#11 short<br>24-#14 long | 15-piles     |         |

SURVEY PLOTTED BY: \_\_\_\_\_ DATE: \_\_\_\_\_  
 DESIGNED BY: \_\_\_\_\_  
 NOTE BOOK: \_\_\_\_\_  
 QUANTITIES BY: \_\_\_\_\_  
 CHECKED BY: \_\_\_\_\_

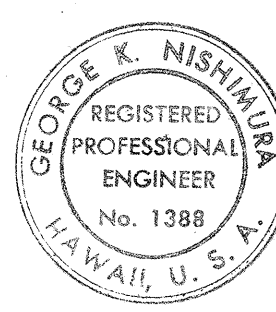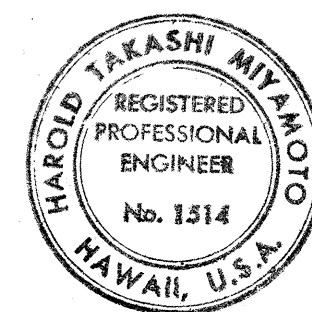


THIS WORK WAS PREPARED BY ME OR UNDER MY SUPERVISION


STATE OF HAWAII  
 DEPARTMENT OF TRANSPORTATION  
 HIGHWAYS DIVISION  
**NIMITZ CONNECTOR (E.B.)**  
**RAMP "A" & RAMP "B"**  
**PILE CAP DETAILS**  
**KEEHI INTERCHANGE**  
 F.A.I. PROJ. NO. I-HI-1(168)17  
 Scale: As shown Date: JULY, 1981  
 SHEET NO. 534 OF 49 SHEETS



| FED. ROAD DIST. NO. | STATE | FED. AID PROJ. NO. | FISCAL YEAR | SHEET NO. | TOTAL SHEETS |
|---------------------|-------|--------------------|-------------|-----------|--------------|
| HAWAII              | HAW.  | 1-HI-1(168)17      | 1982        | 117       | 145          |

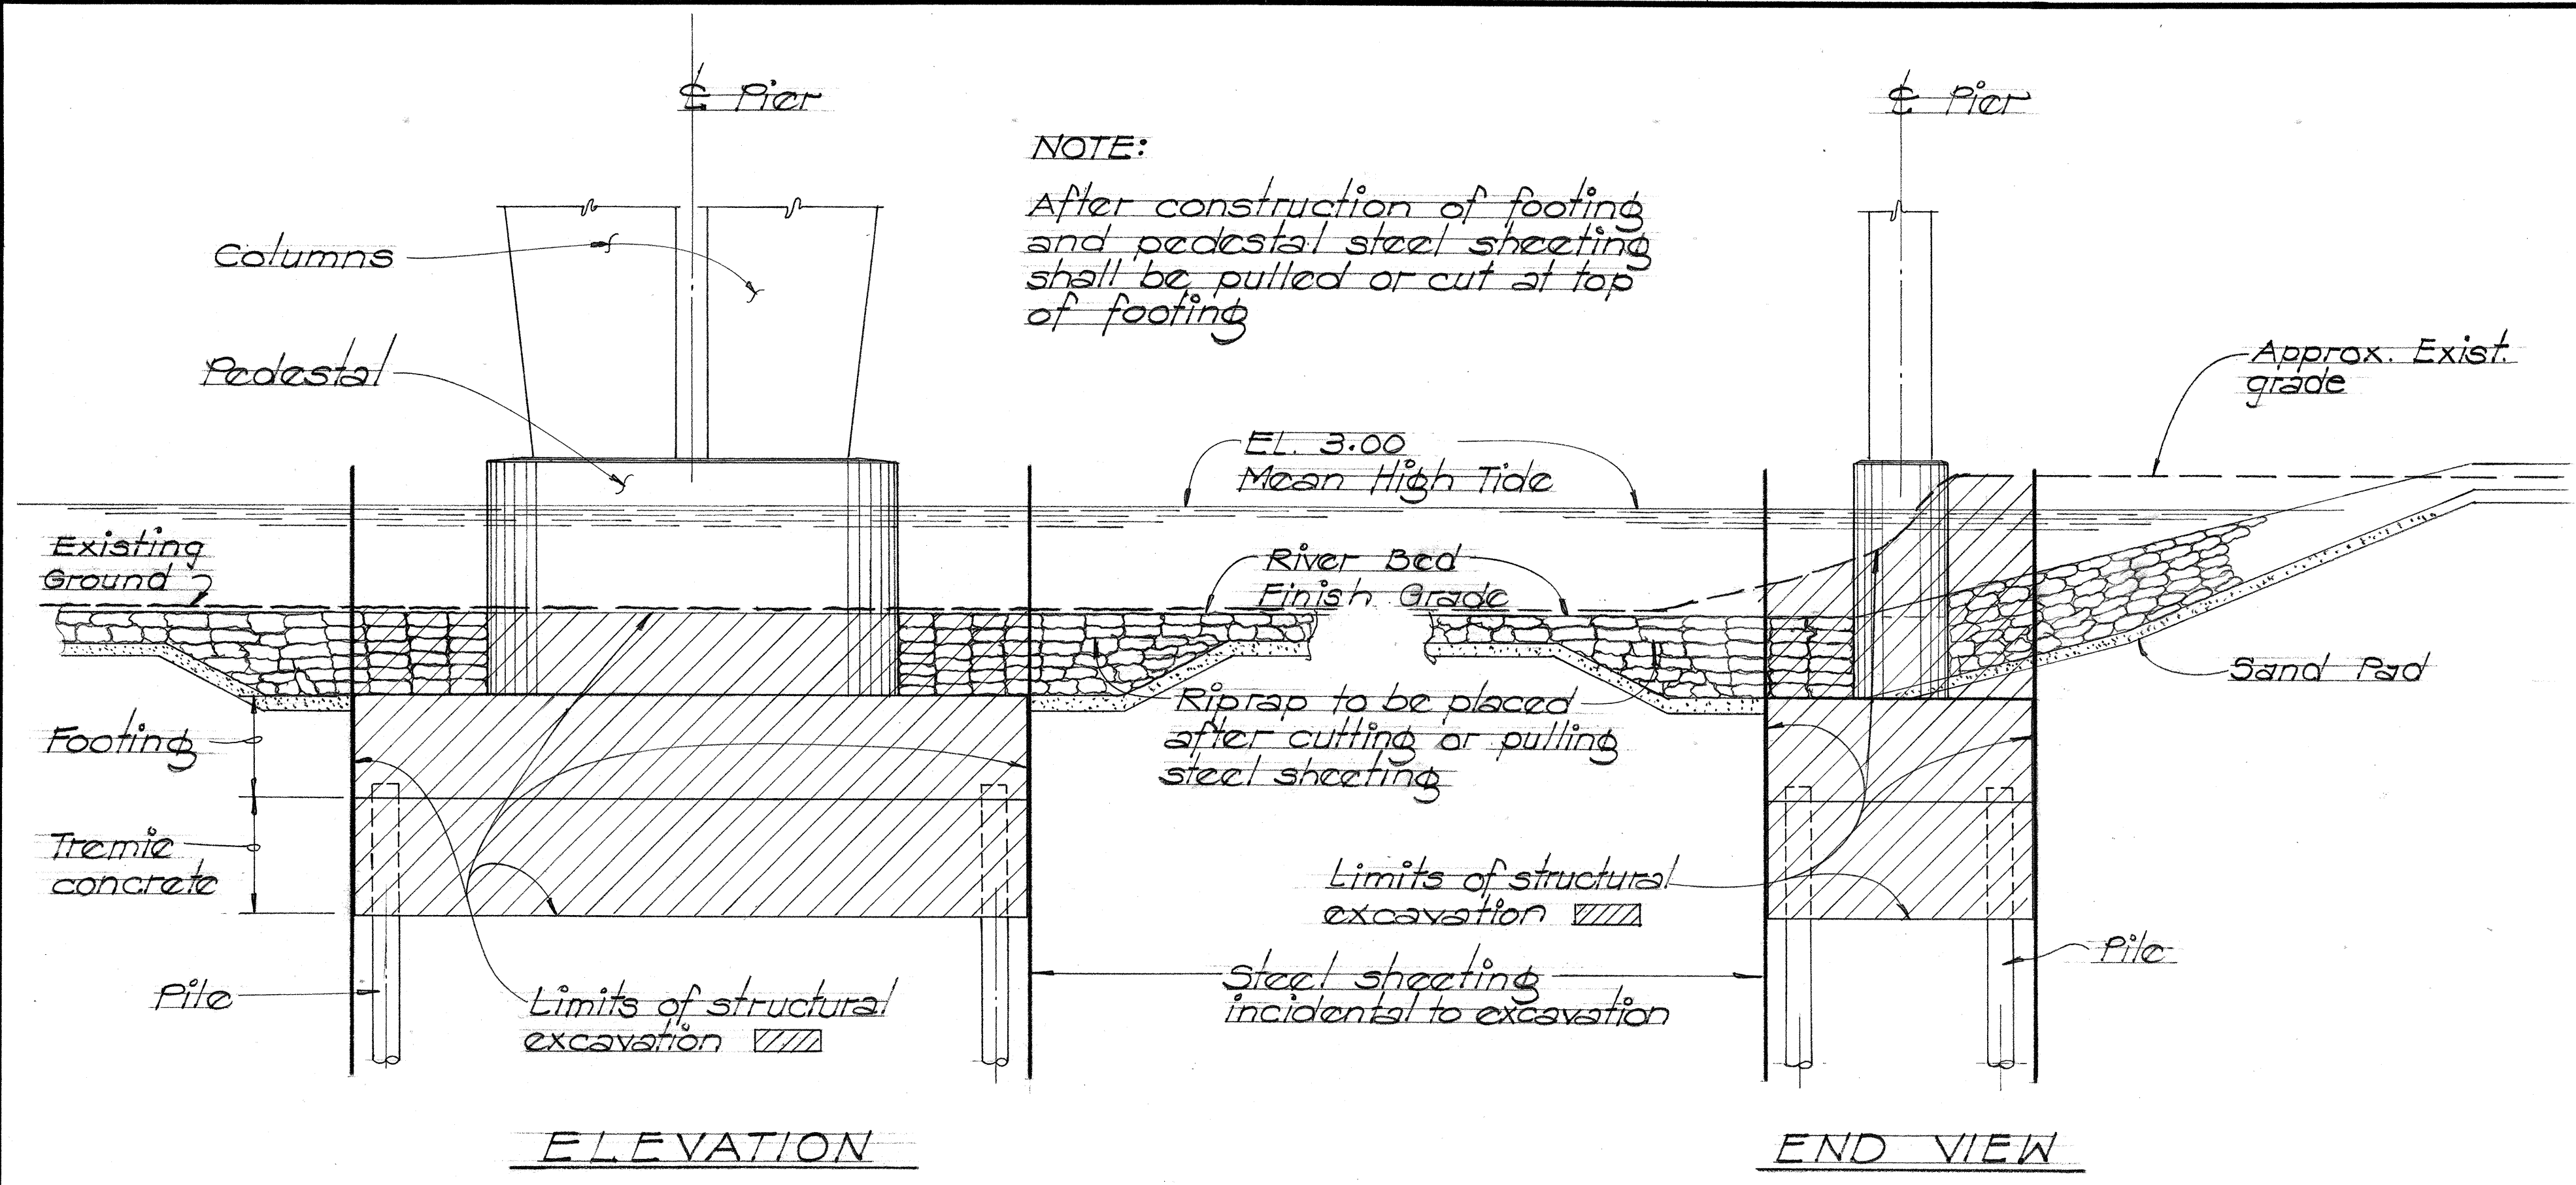


**PAY LIMITS**  
**PILE CAP BELOW WATER**

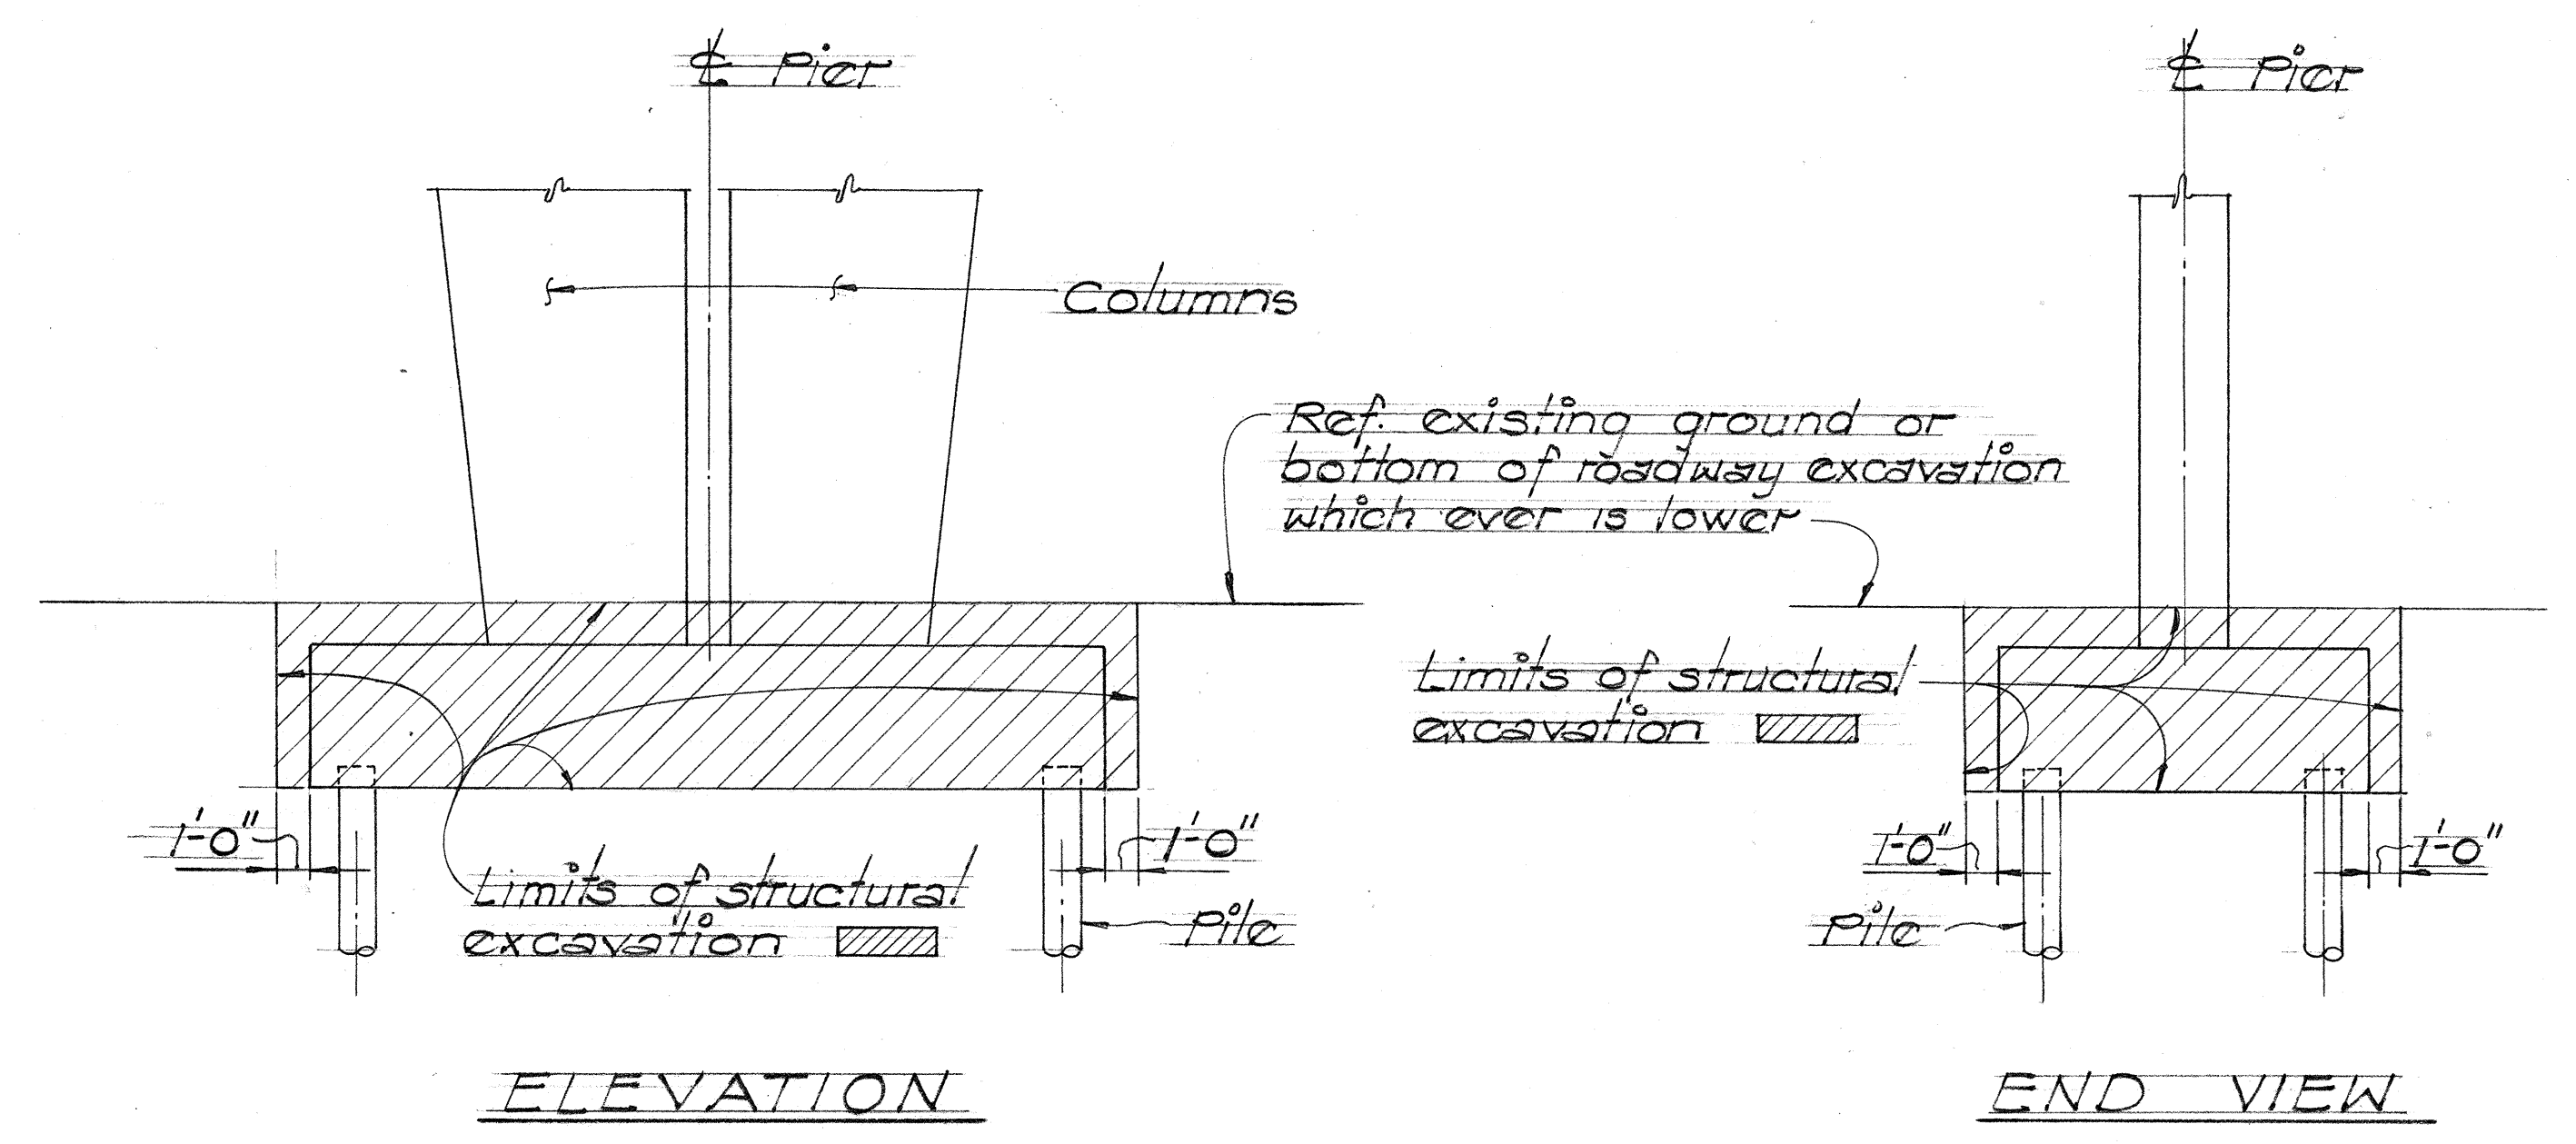

**PAY LIMITS**

|               |  |
|---------------|--|
| DATE          |  |
| DESIGNED BY   |  |
| CHECKED BY    |  |
| NOTED BY      |  |
| ORIGINAL PLAN |  |
| NO.           |  |

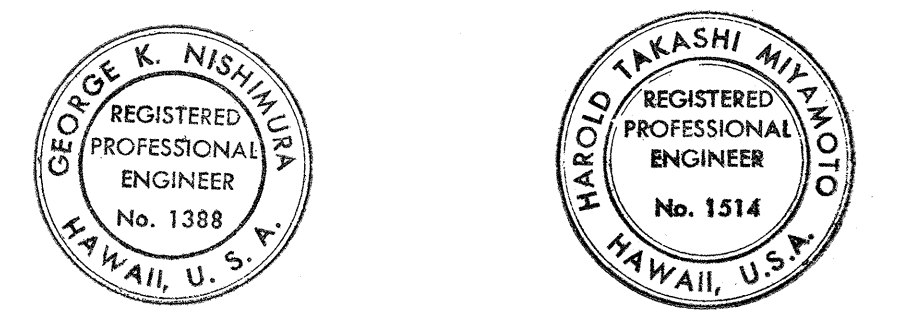

THIS WORK WAS PREPARED BY ME OR UNDER MY SUPERVISION

*[Signature]*

THIS WORK WAS PREPARED BY ME OR UNDER MY SUPERVISION

*[Signature]*




|                                                                                                                                                                                                                                                                                              |                                        |
|----------------------------------------------------------------------------------------------------------------------------------------------------------------------------------------------------------------------------------------------------------------------------------------------|----------------------------------------|
| STATE OF HAWAII<br>DEPARTMENT OF TRANSPORTATION<br>HIGHWAYS DIVISION<br><b>NIMITZ CONNECTOR (EB)</b><br><b>RAMP "A" AND RAMP "B"</b><br><b>PILE CAP PAY LIMITS</b><br>KEEHI INTERCHANGE<br>FAL PROJ. NO. 1-HI-1(168)17<br>SCALE: AS SHOWN      DATE: JULY, 1981<br>SHEET NO. 35 OF 49 SHEETS |                                        |
| 11-4-82                                                                                                                                                                                                                                                                                      | Change limits of structural excavation |
| DATE                                                                                                                                                                                                                                                                                         | REVISION                               |







| FED. ROAD DIST. NO. | STATE | FED. AID PROJ. NO. | FISCAL YEAR | SHEET NO. | TOTAL SHEETS |
|---------------------|-------|--------------------|-------------|-----------|--------------|
| HAWAII              | HAW.  | FH-1(68)17         | 1982        | 119       | 149          |

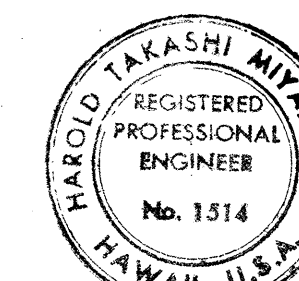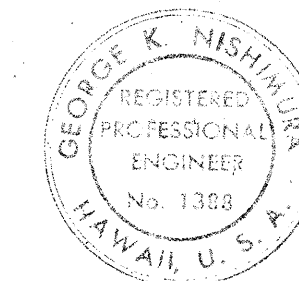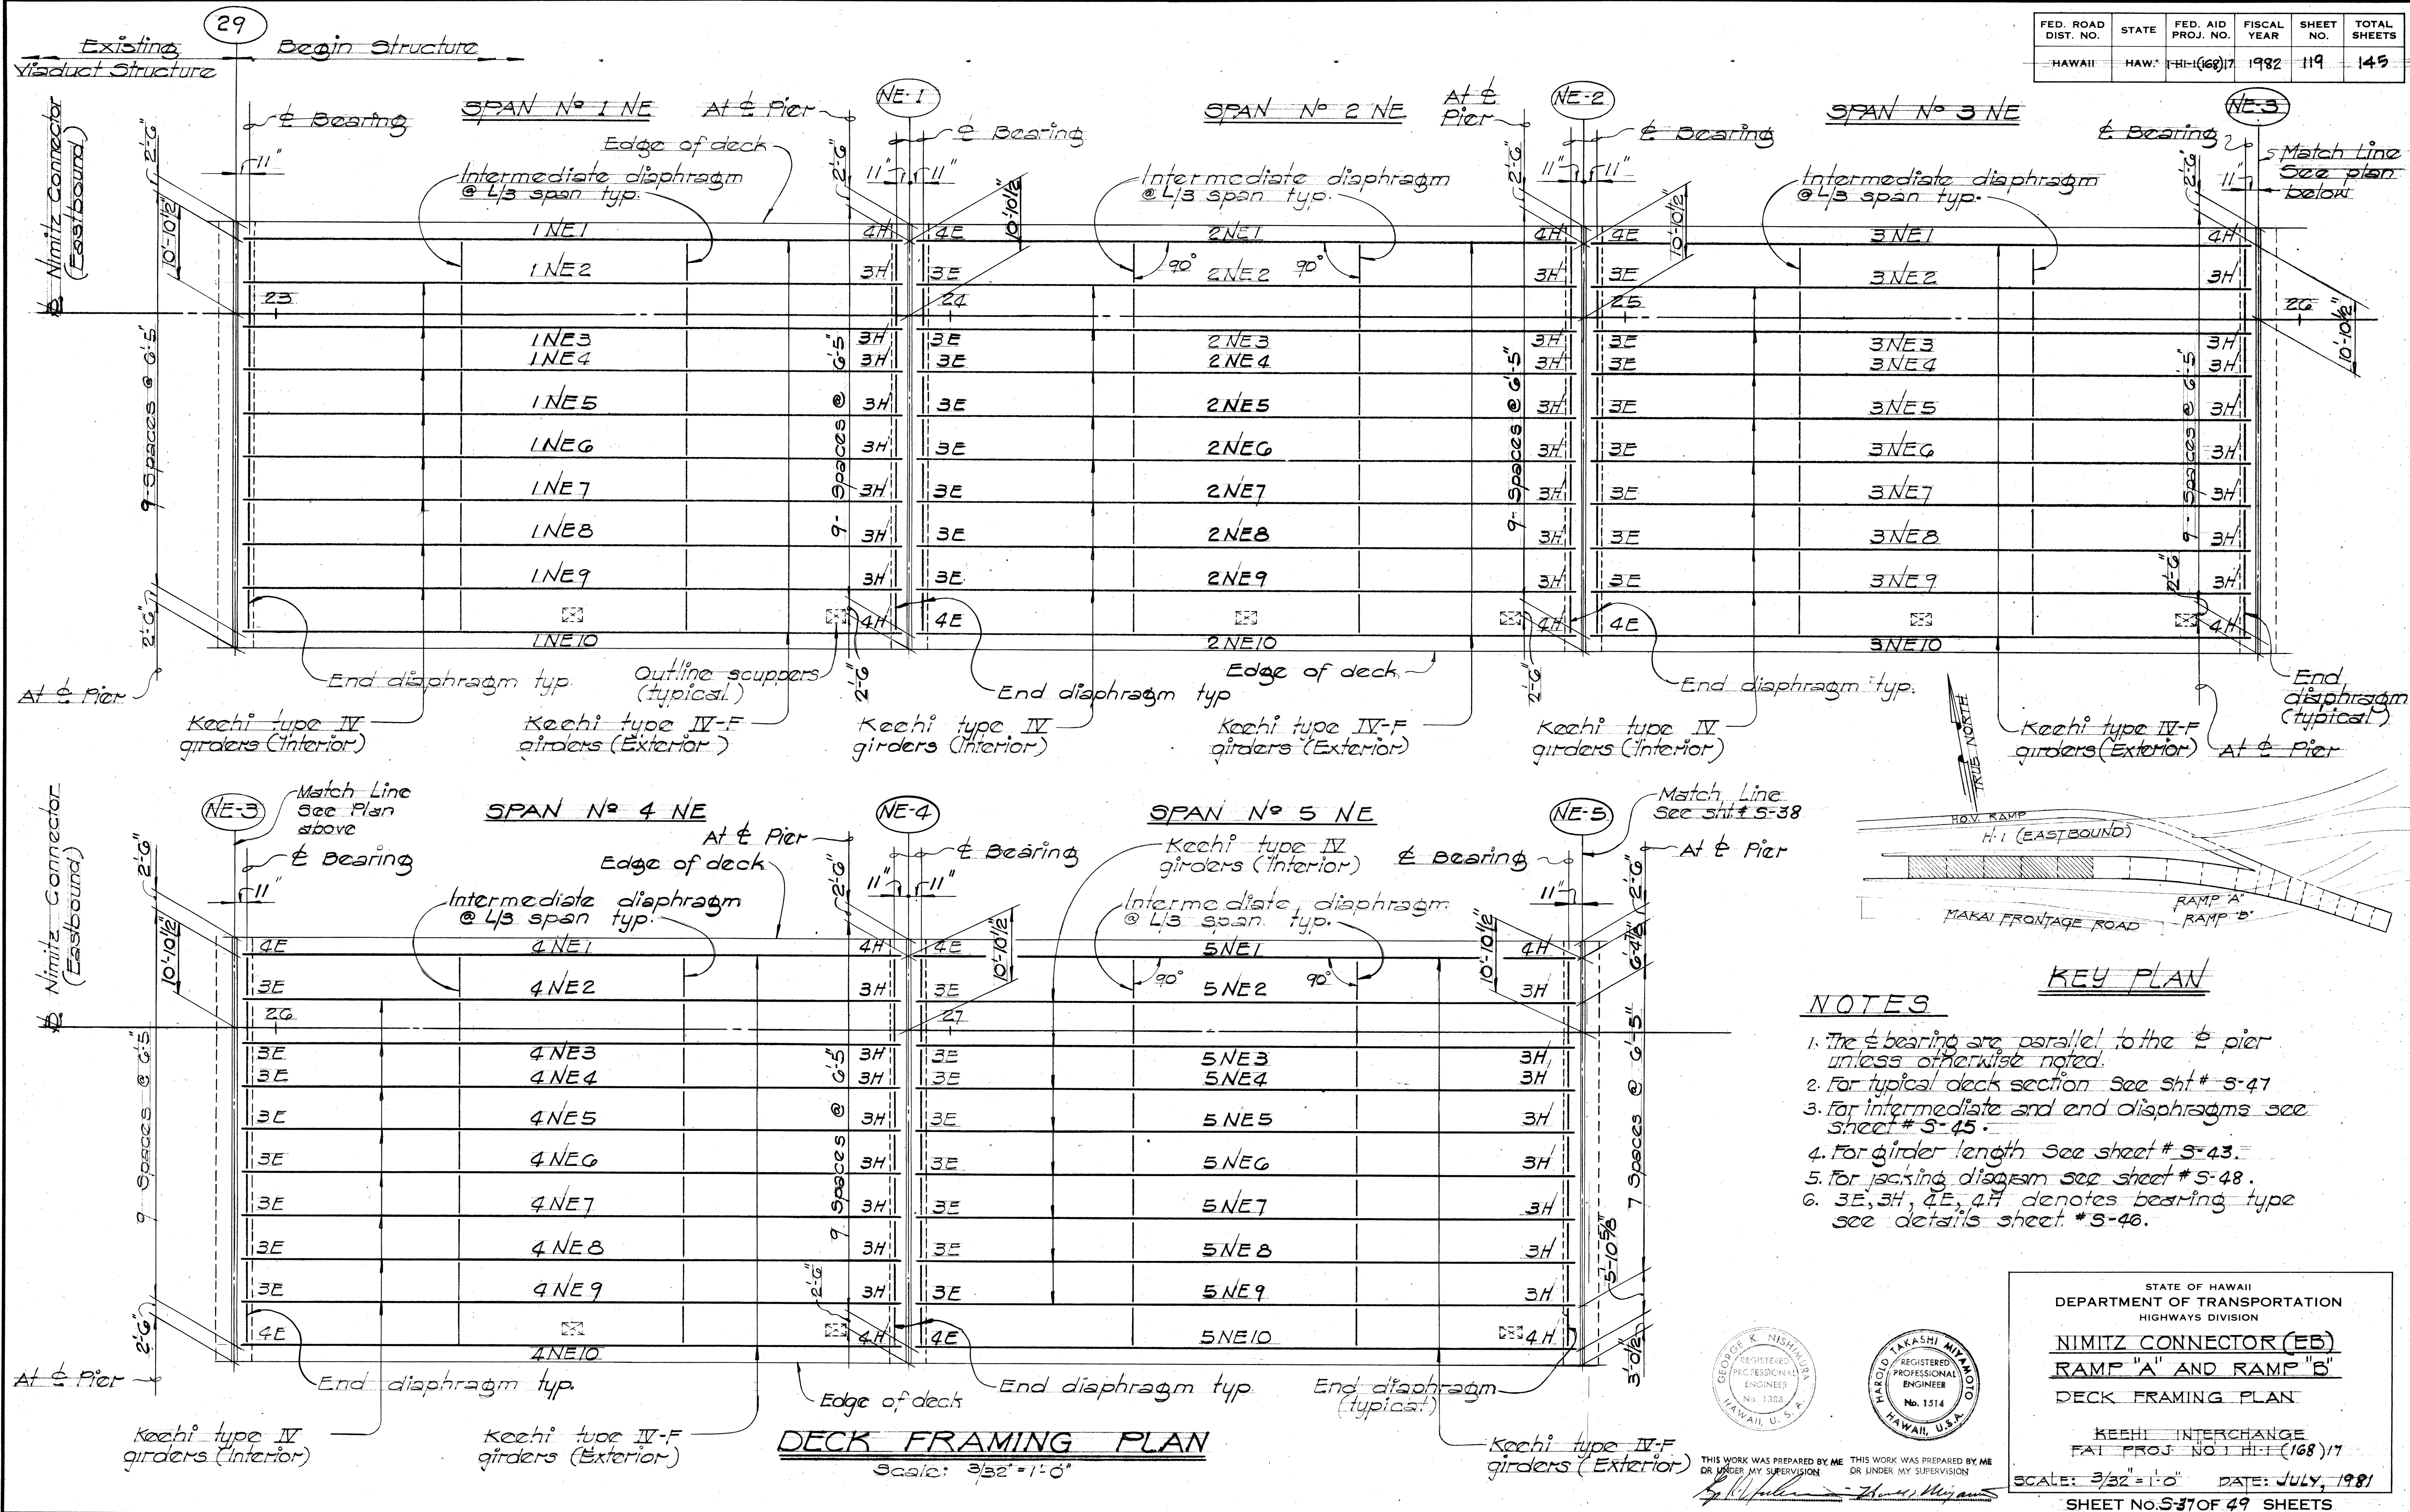


STATE OF HAWAII  
DEPARTMENT OF TRANSPORTATION  
HIGHWAYS DIVISION  
**NIMITZ CONNECTOR (EB)**  
**RAMP "A" AND RAMP "B"**  
**DECK FRAMING PLAN**

KEEHI INTERCHANGE  
FAT PROJ. NO. FH-1(68)17  
SCALE: 3/32" = 1'-0" DATE: JULY, 1981  
SHEET NO. S-37 OF 49 SHEETS





| FED. ROAD DIST. NO. | STATE | FED. AID PROJ. NO. | FISCAL YEAR | SHEET NO. | TOTAL SHEETS |
|---------------------|-------|--------------------|-------------|-----------|--------------|
| HAWAII              | HAW.  | 1-HI-1(68)17       | 1982        | 120       | 145          |

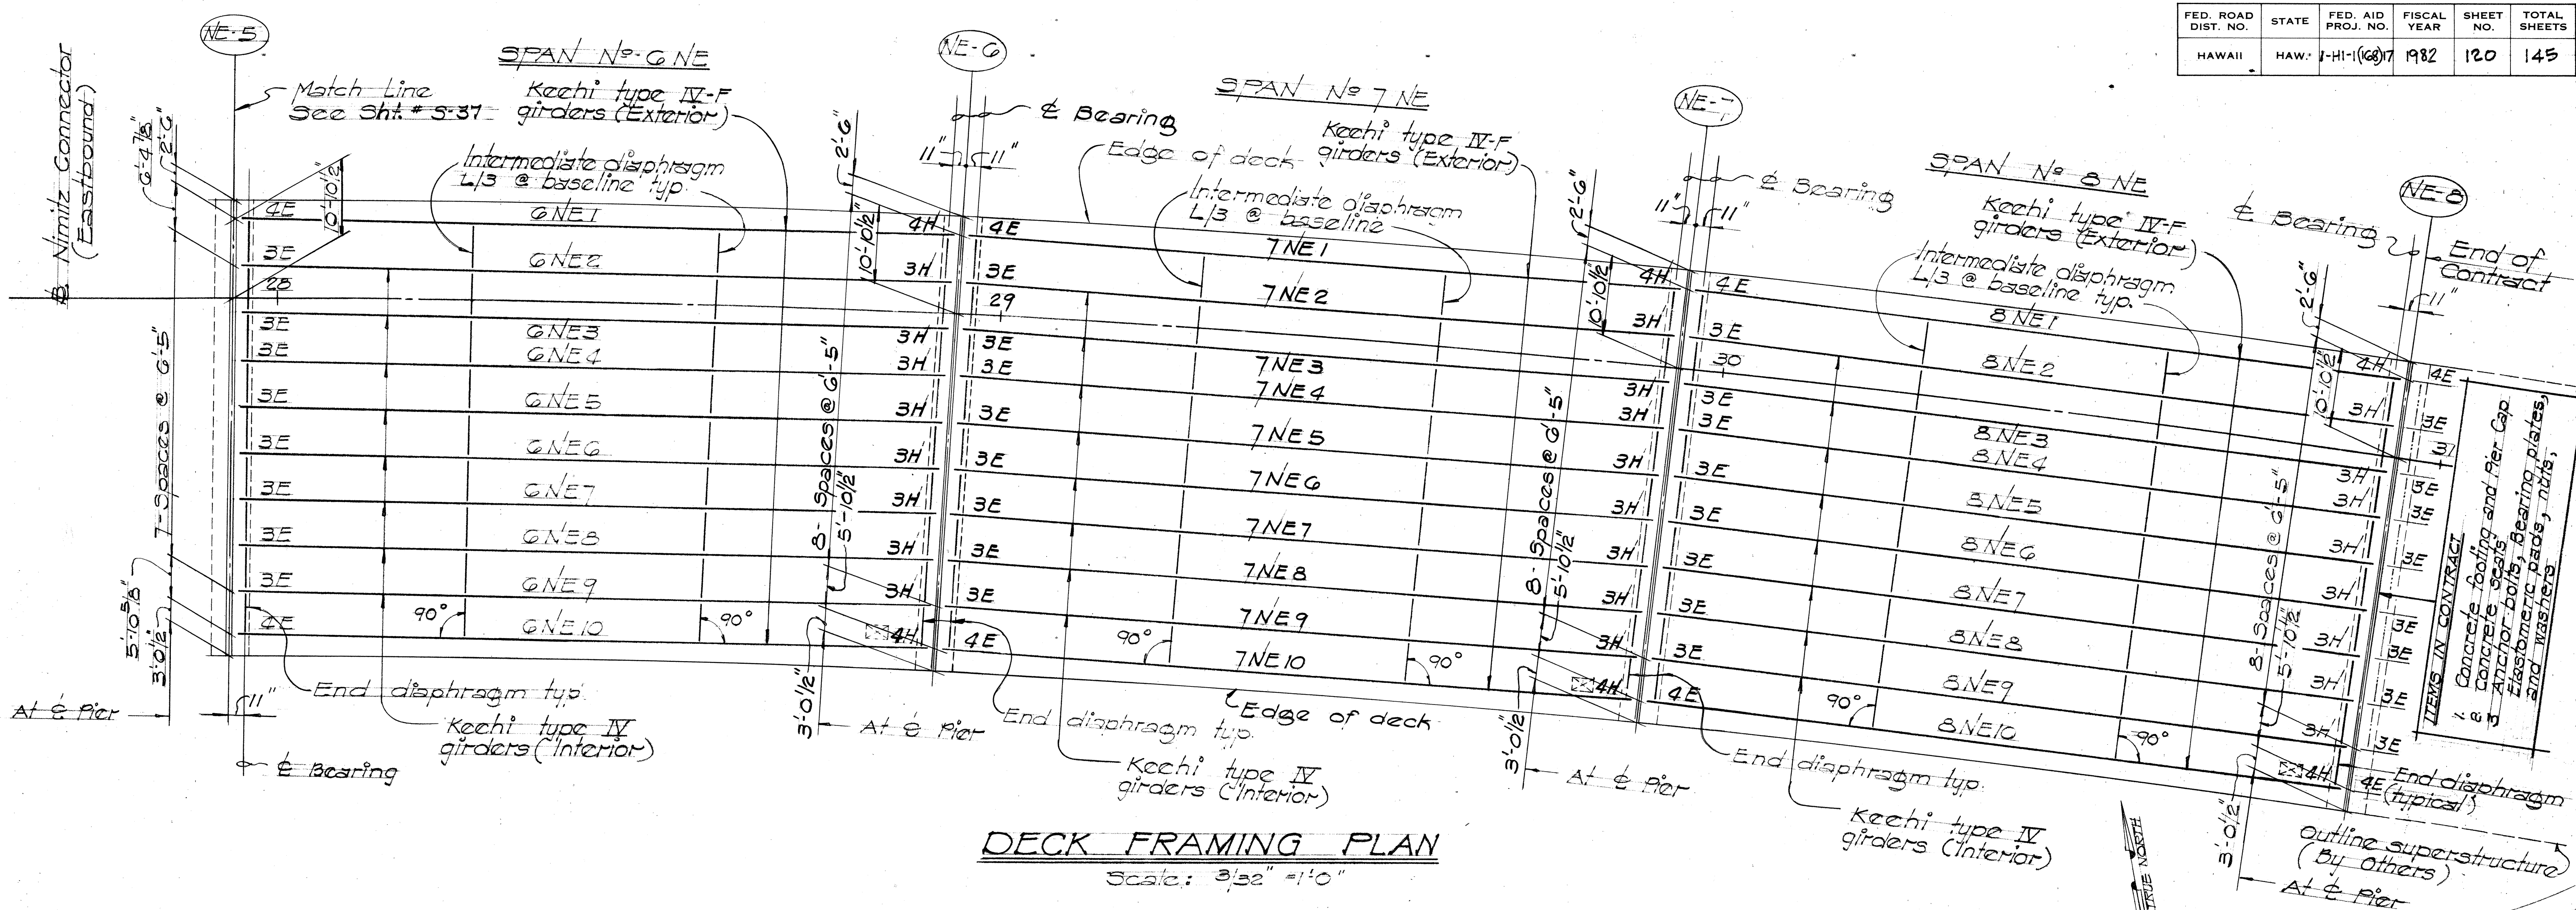

# NOTES

- 3E, 3H, 4E, 4H denotes bearing type. See detail sheet # S-40.
- The E bearing are parallel to the E pier unless otherwise noted.
- For typical deck sections see sheet # S-47.
- For intermediate and end diaphragms see sheet # S-45.
- For girder length see sheet # S-43.
- For jacking diagram see sheet # S-48.

|                   |       |
|-------------------|-------|
| DATE              | _____ |
| SURVEY PLOTTED BY | _____ |
| ORIGINAL DRAWN BY | _____ |
| TRACED BY         | _____ |
| DESIGNED BY       | _____ |
| CHECKED BY        | _____ |
| NO.               | _____ |



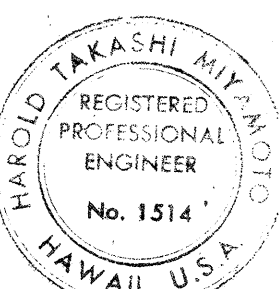
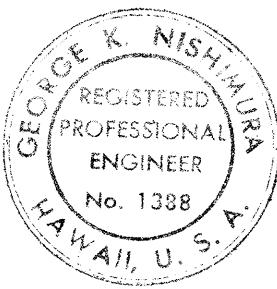


THIS WORK WAS PREPARED BY ME OR UNDER MY SUPERVISION  
*[Signature]*  
 REGISTERED PROFESSIONAL ENGINEER  
 No. 1388  
 HAWAII, U.S.A.

STATE OF HAWAII  
 DEPARTMENT OF TRANSPORTATION  
 HIGHWAYS DIVISION  
**NIMITZ CONNECTOR (EB),  
 RAMP "A" AND RAMP "B"**  
**DECK FRAMING PLAN**  
 KECHI INTERCHANGE  
 F&I PROJ. NO. 1-HI-1(68)17  
 SCALE: 3/32" = 1'-0" DATE: JULY, 1981  
 SHEET NO. 5-38 OF 49 SHEETS



| FED. ROAD DIST. NO. | STATE | FED. AID PROJ. NO. | FISCAL YEAR | SHEET NO. | TOTAL SHEETS |
|---------------------|-------|--------------------|-------------|-----------|--------------|
| HAWAII              | HAW.  | 1-HI-1(108)17      | 1982        | 121       | 145          |

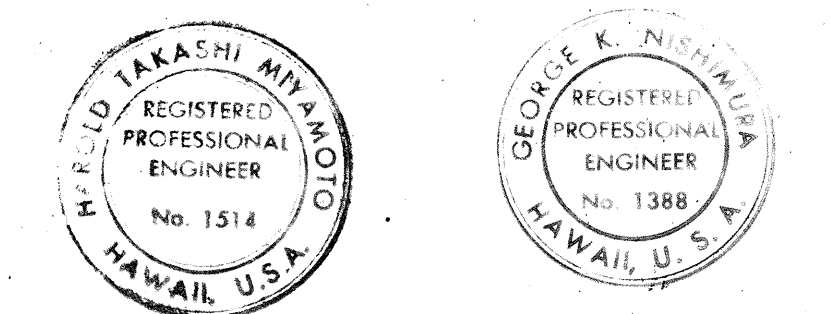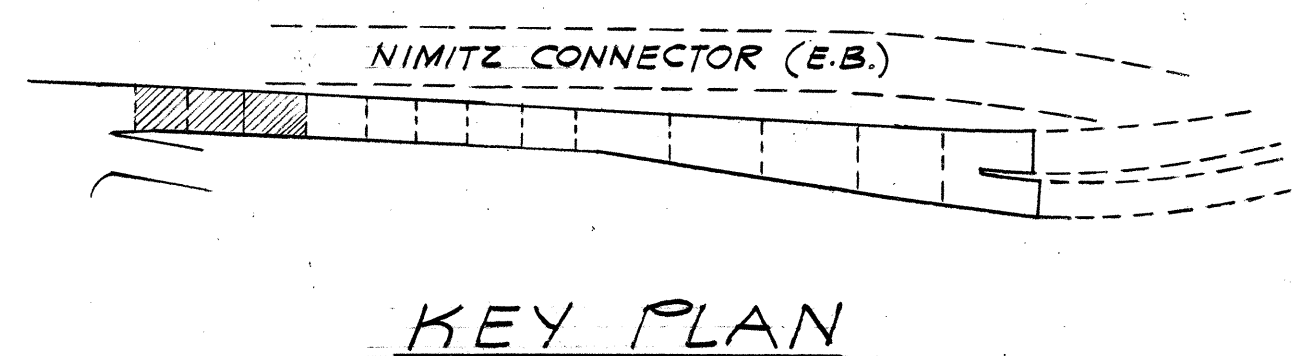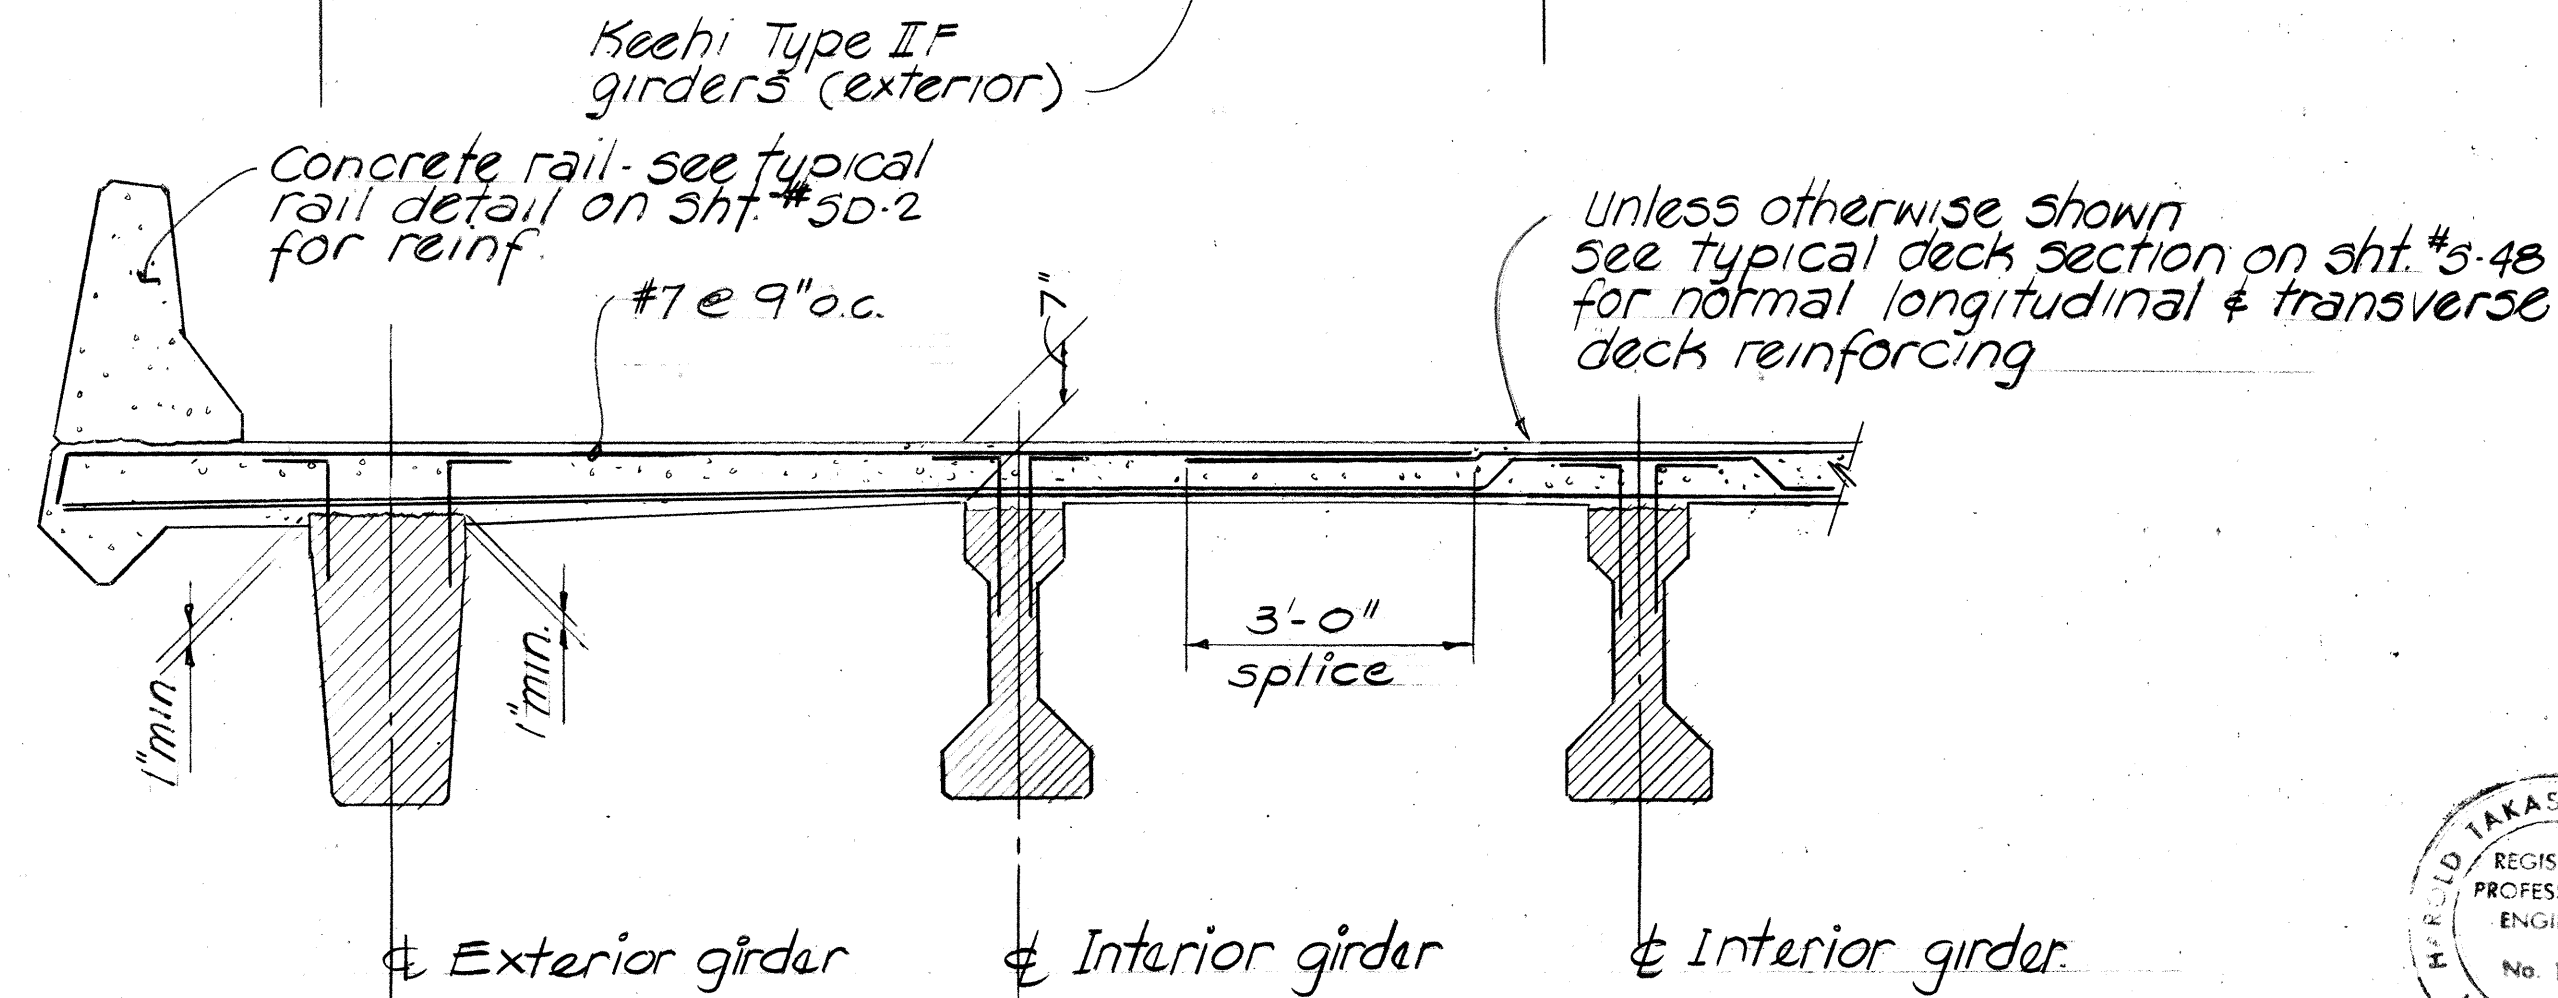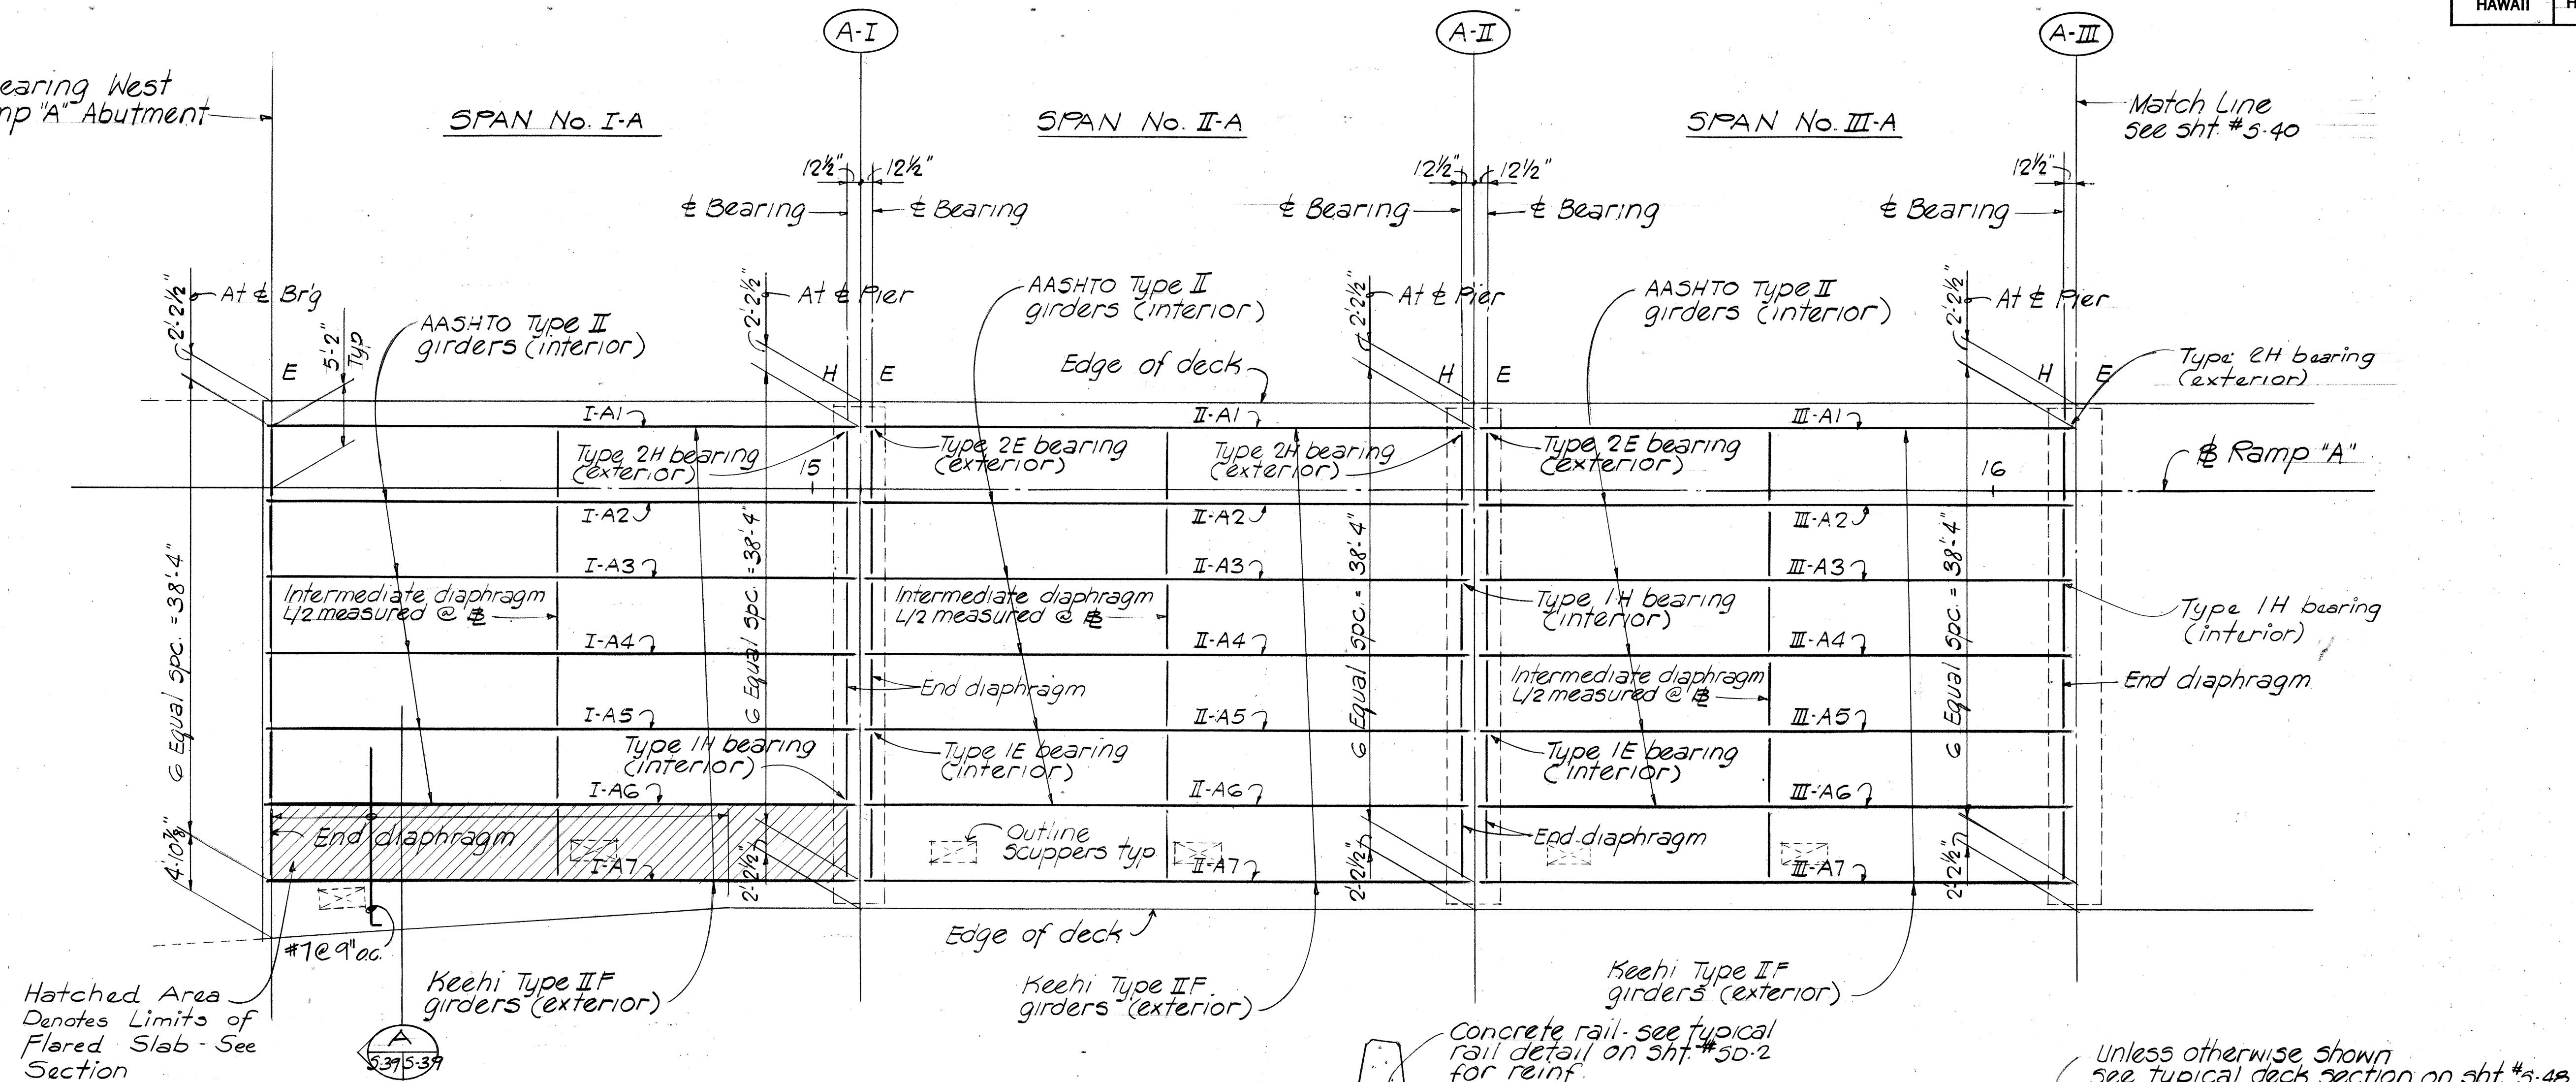


THIS WORK WAS PREPARED BY ME OR UNDER MY SUPERVISION  
*George K. Nishimura*  
 REGISTERED PROFESSIONAL ENGINEER  
 No. 1514  
 HAWAII, U.S.A.

STATE OF HAWAII  
 DEPARTMENT OF TRANSPORTATION  
 LAND TRANSPORTATION FACILITIES DIVISION  
**NIMITZ CONNECTOR (E.B.)  
 RAMP "A" & RAMP "B"**  
 DECK FRAMING PLAN  
 KEELHI INTERCHANGE  
 F.A.I. PROJ. No. 1-HI-1 (108)17  
 Scale: 1/8" = 1'-0" Date: July, 1981  
 SHEET No. 539 OF 49 SHEETS

|                   |       |
|-------------------|-------|
| DATE              | _____ |
| SURVEY PLOTTED BY | _____ |
| DRAWN BY          | _____ |
| CHECKED BY        | _____ |
| NOTE BOOK         | _____ |
| NO.               | _____ |



| FED. ROAD DIST. NO. | STATE | FED. AID PROJ. NO. | FISCAL YEAR | SHEET NO. | TOTAL SHEETS |
|---------------------|-------|--------------------|-------------|-----------|--------------|
| HAWAII              | HAW.  | HI-1(168) 17       | 1982        | 122       | 145          |

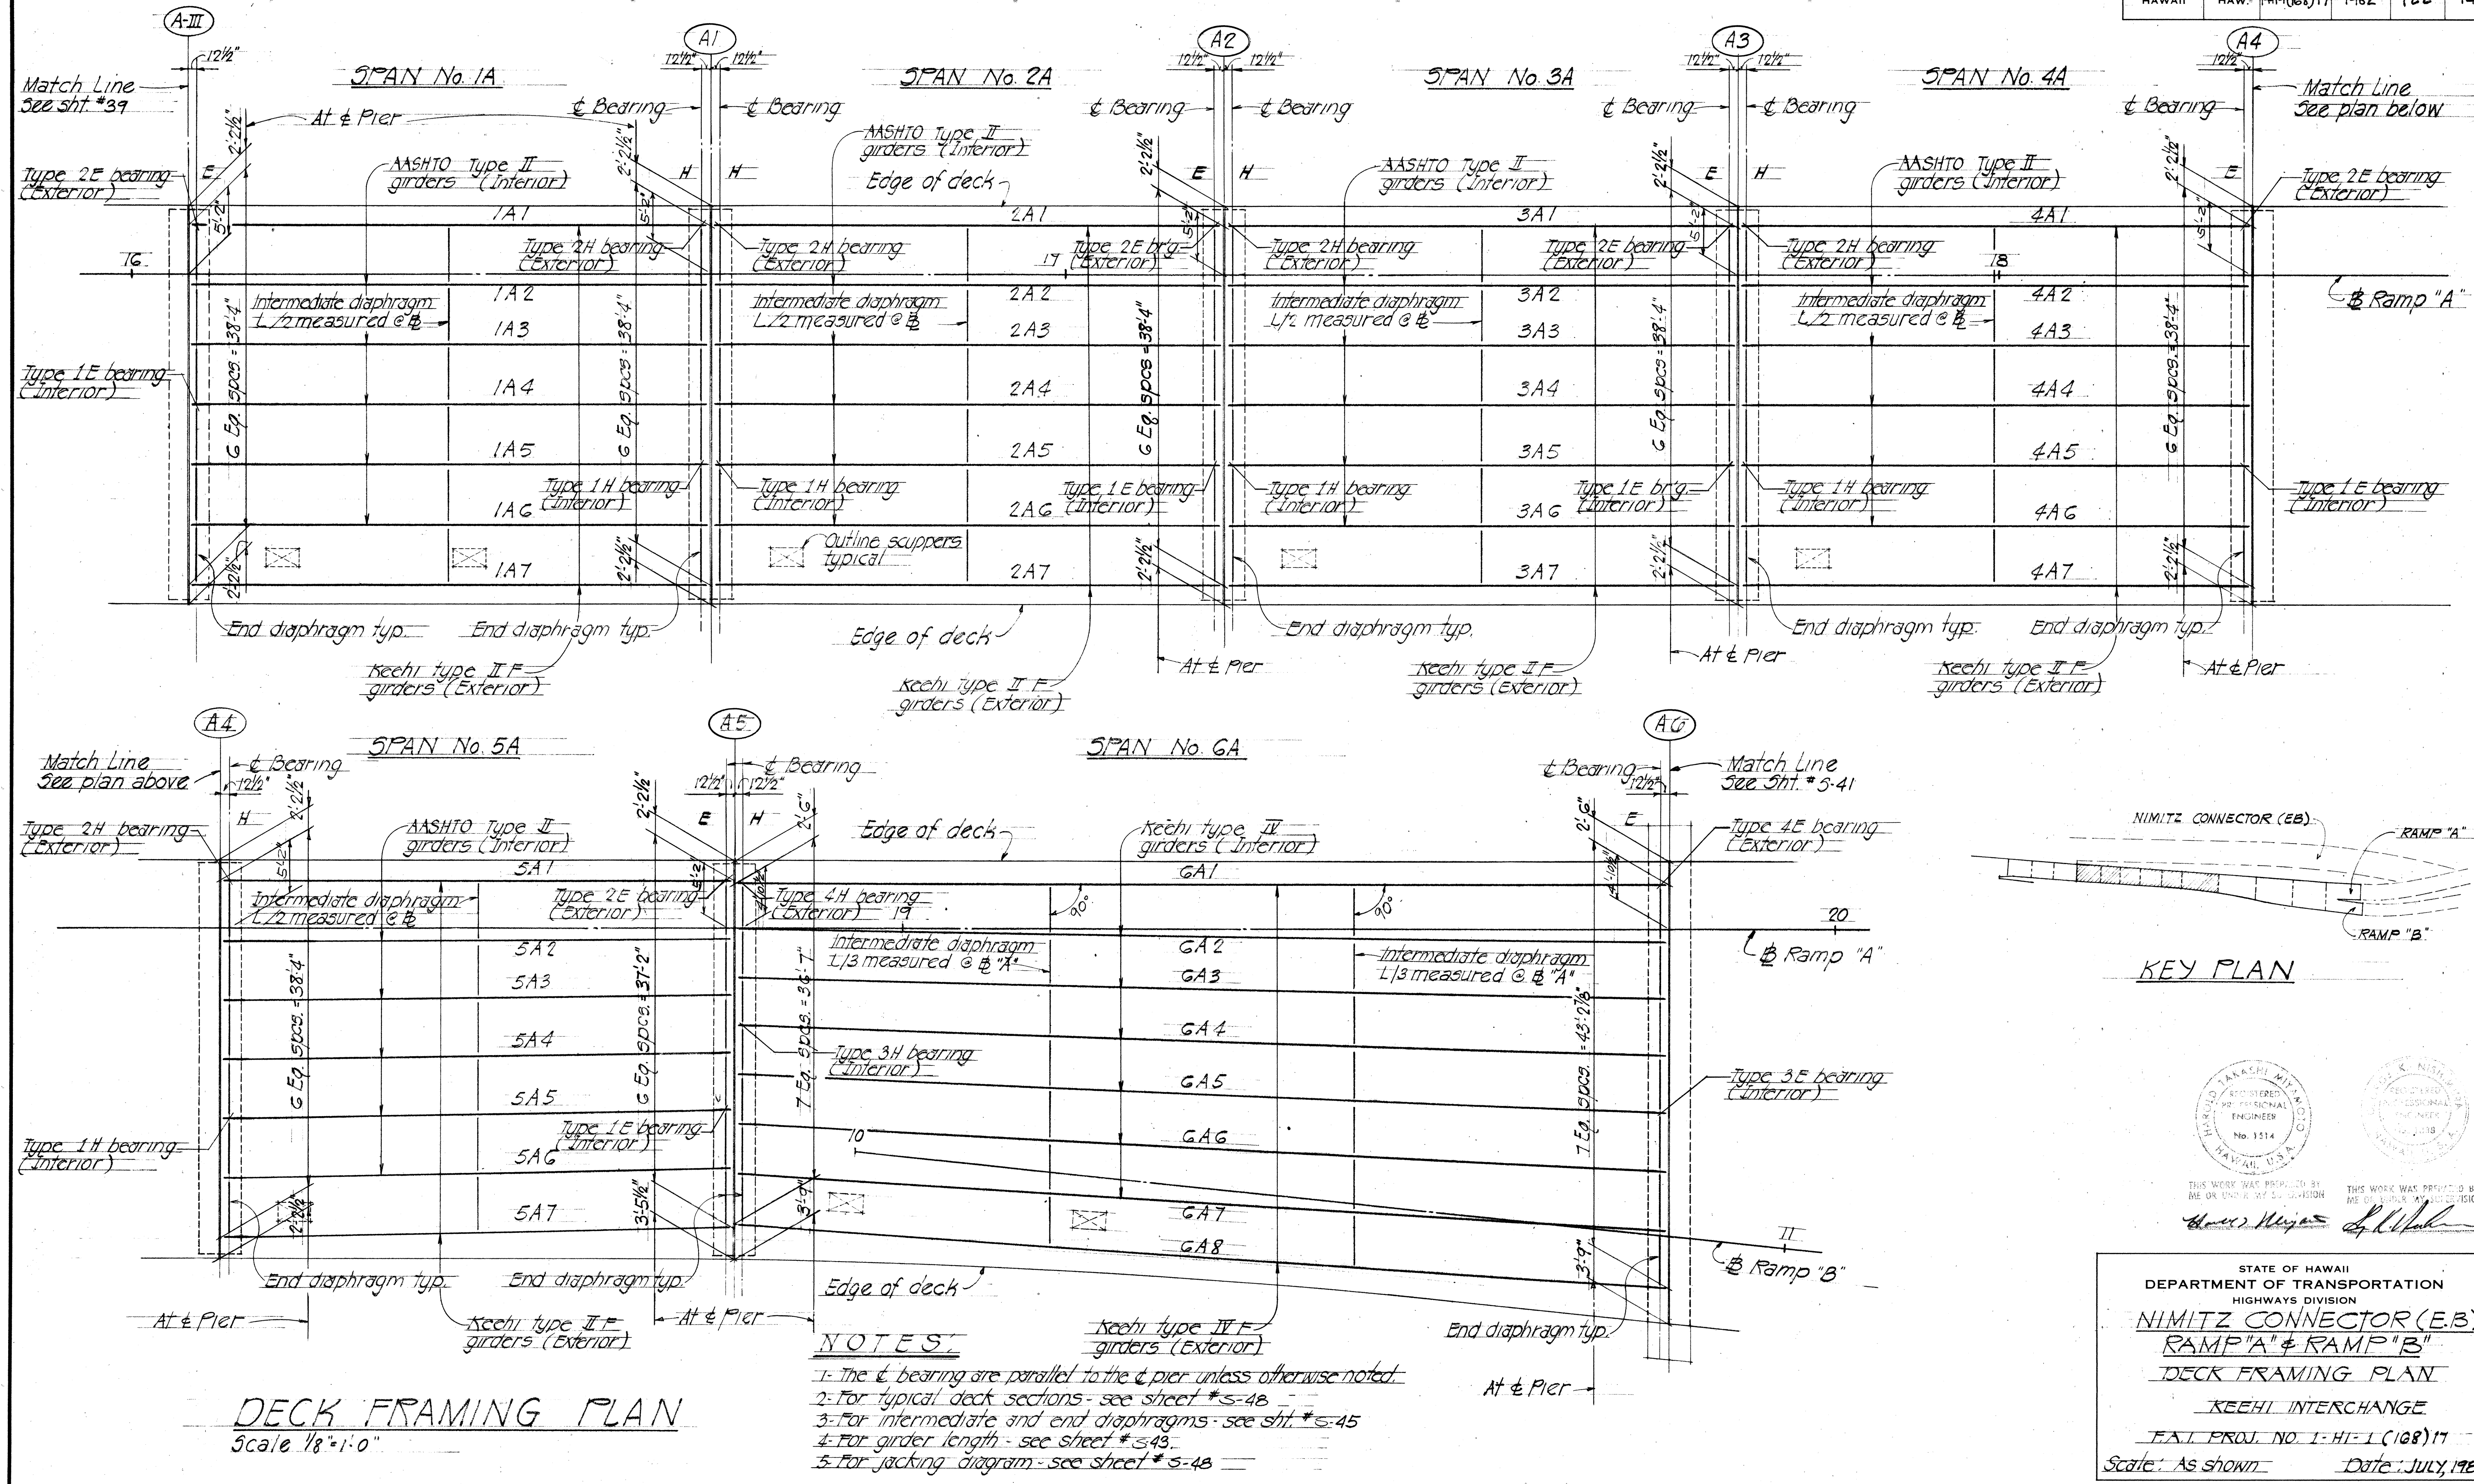

DATE: \_\_\_\_\_  
 SURVEY PLOTTED BY: \_\_\_\_\_  
 DRAWN BY: \_\_\_\_\_  
 DESIGNED BY: \_\_\_\_\_  
 CHECKED BY: \_\_\_\_\_  
 NO. \_\_\_\_\_

THIS WORK WAS PREPARED BY ME OR UNDER MY SUPERVISION

*Harold Miyano*

THIS WORK WAS PREPARED BY ME OR UNDER MY SUPERVISION

*K. Nishida*

STATE OF HAWAII  
 DEPARTMENT OF TRANSPORTATION  
 HIGHWAYS DIVISION

**NIMITZ CONNECTOR (E.B.)  
 RAMP "A" & RAMP "B"**

**DECK FRAMING PLAN**

KEEHI INTERCHANGE


FAT PROJ. NO. 1-HI-1 (168) 17

Scale: As shown Date: JULY, 1981

SHEET No. 540 OF 49 SHEETS







| FED. ROAD DIST. NO. | STATE | FED. AID PROJ. NO. | FISCAL YEAR | SHEET NO. | TOTAL SHEETS |
|---------------------|-------|--------------------|-------------|-----------|--------------|
| HAWAII              | HAW.  | 1-HI-1(168)17      | 1982        | 123       | 145          |

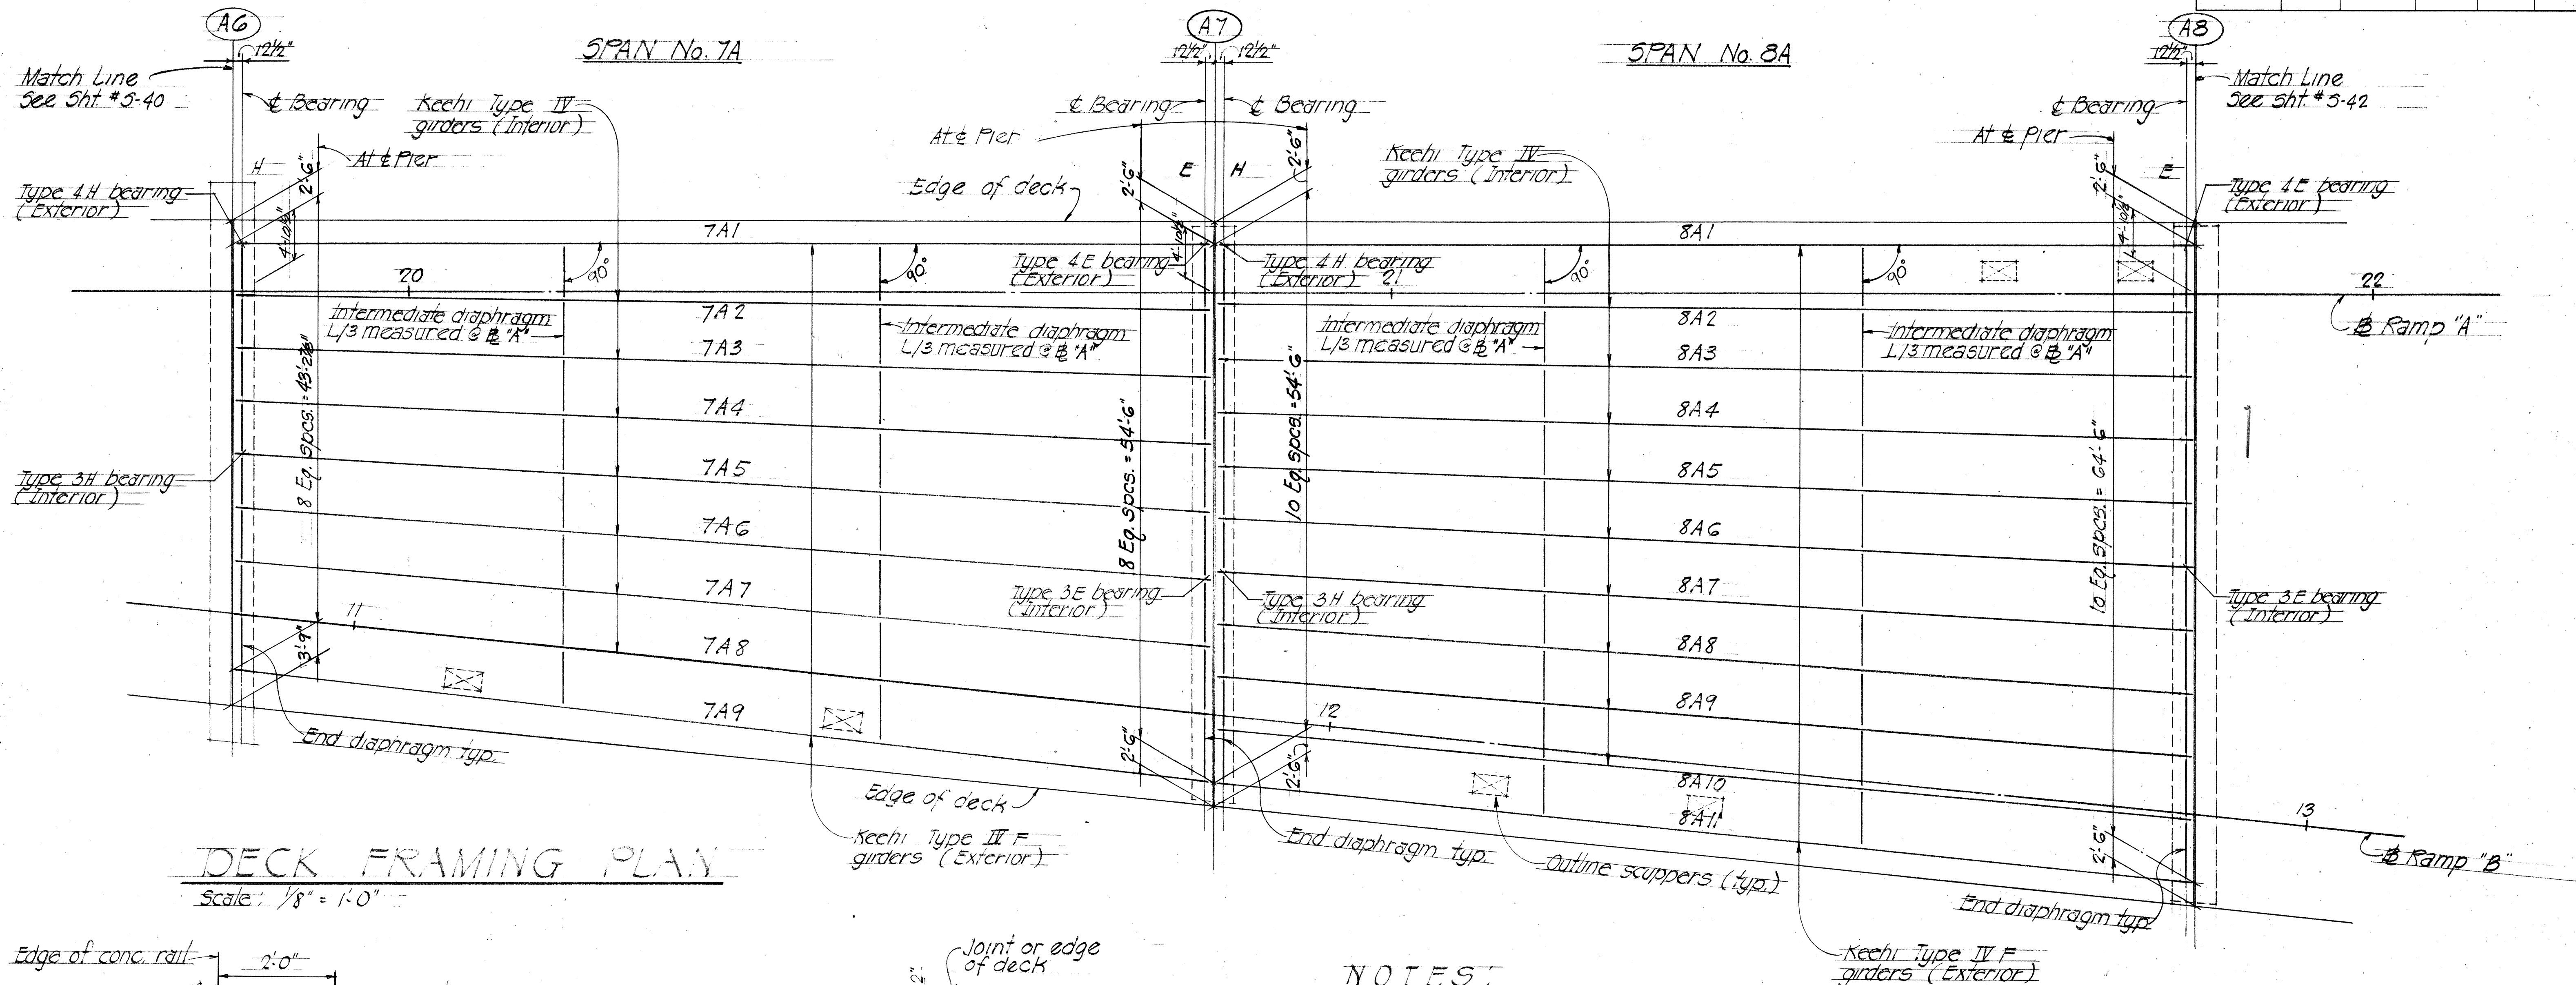

### NOTES

1. The  $\epsilon$  bearing are parallel to the  $\epsilon$  pier unless otherwise noted.
2. For typical deck sections - see sheet #5-48.
3. For intermediate and end diaphragms - see sheet #5-45.
4. For girder length - see sheet #5-43.

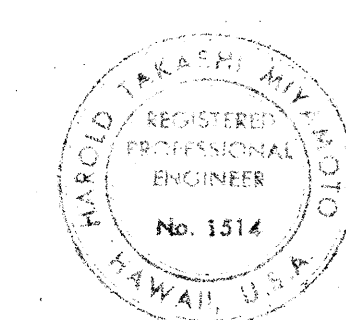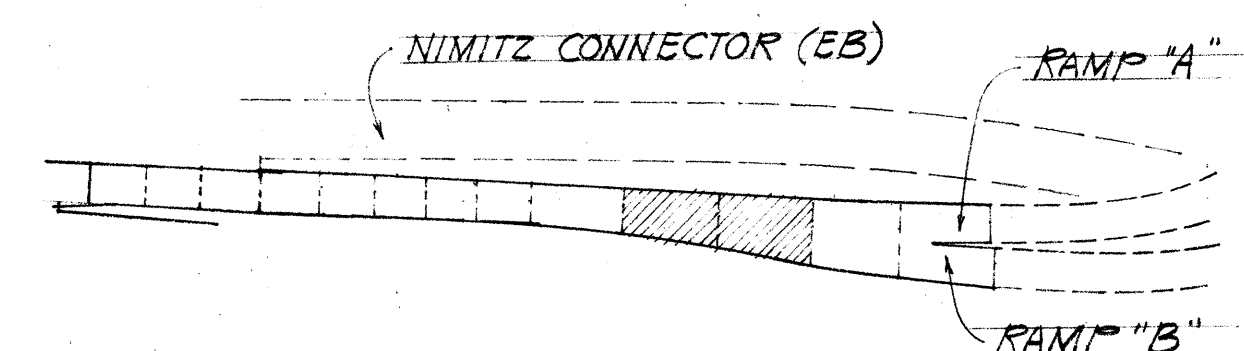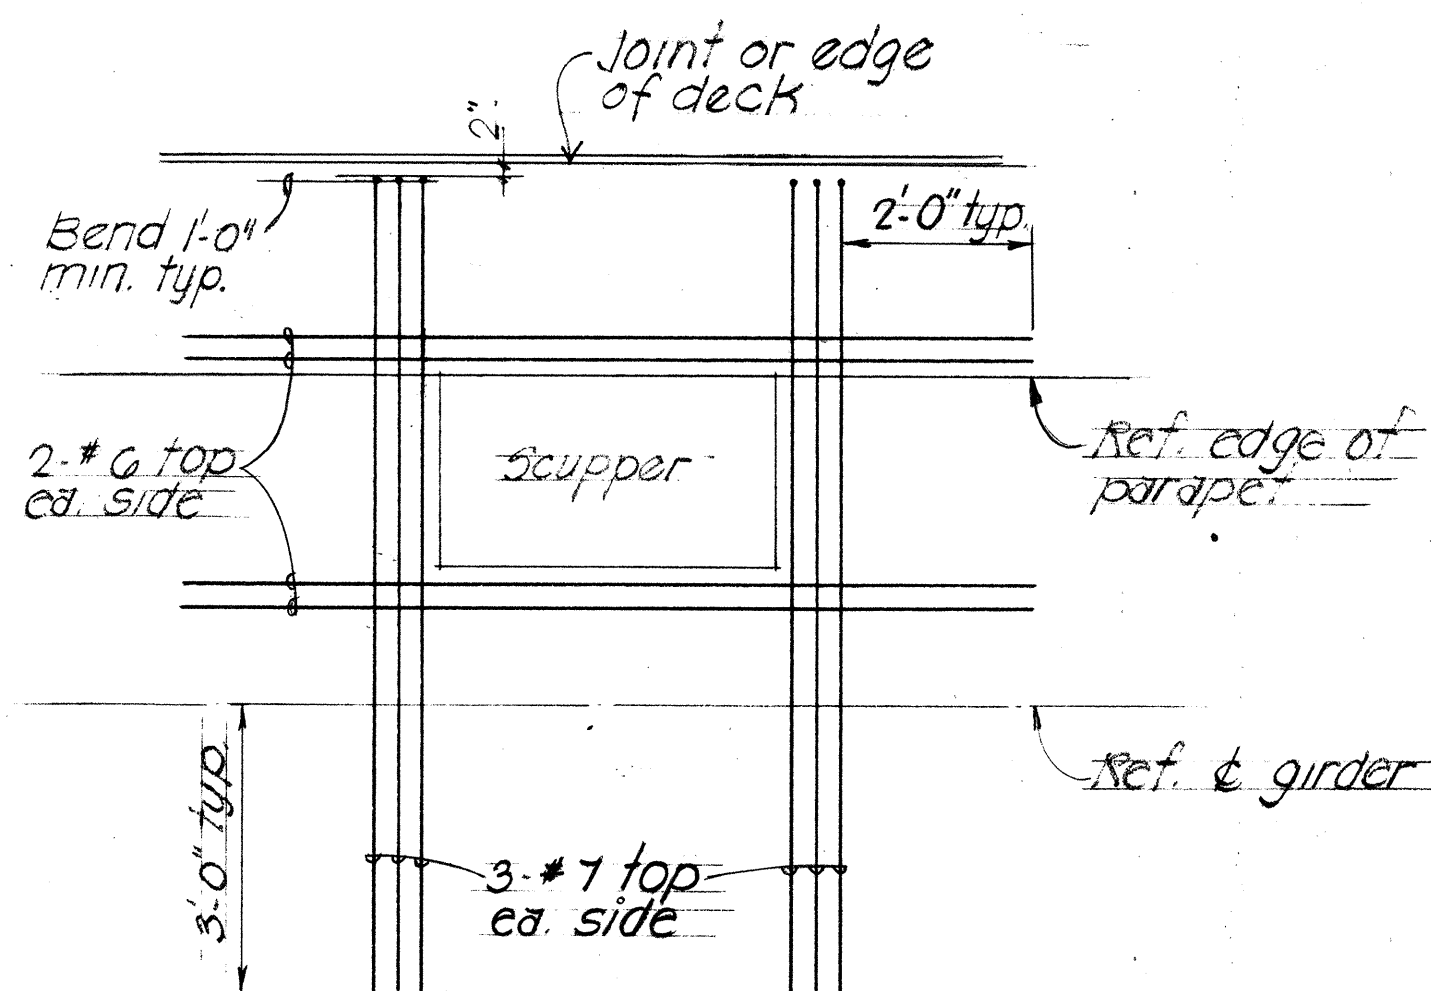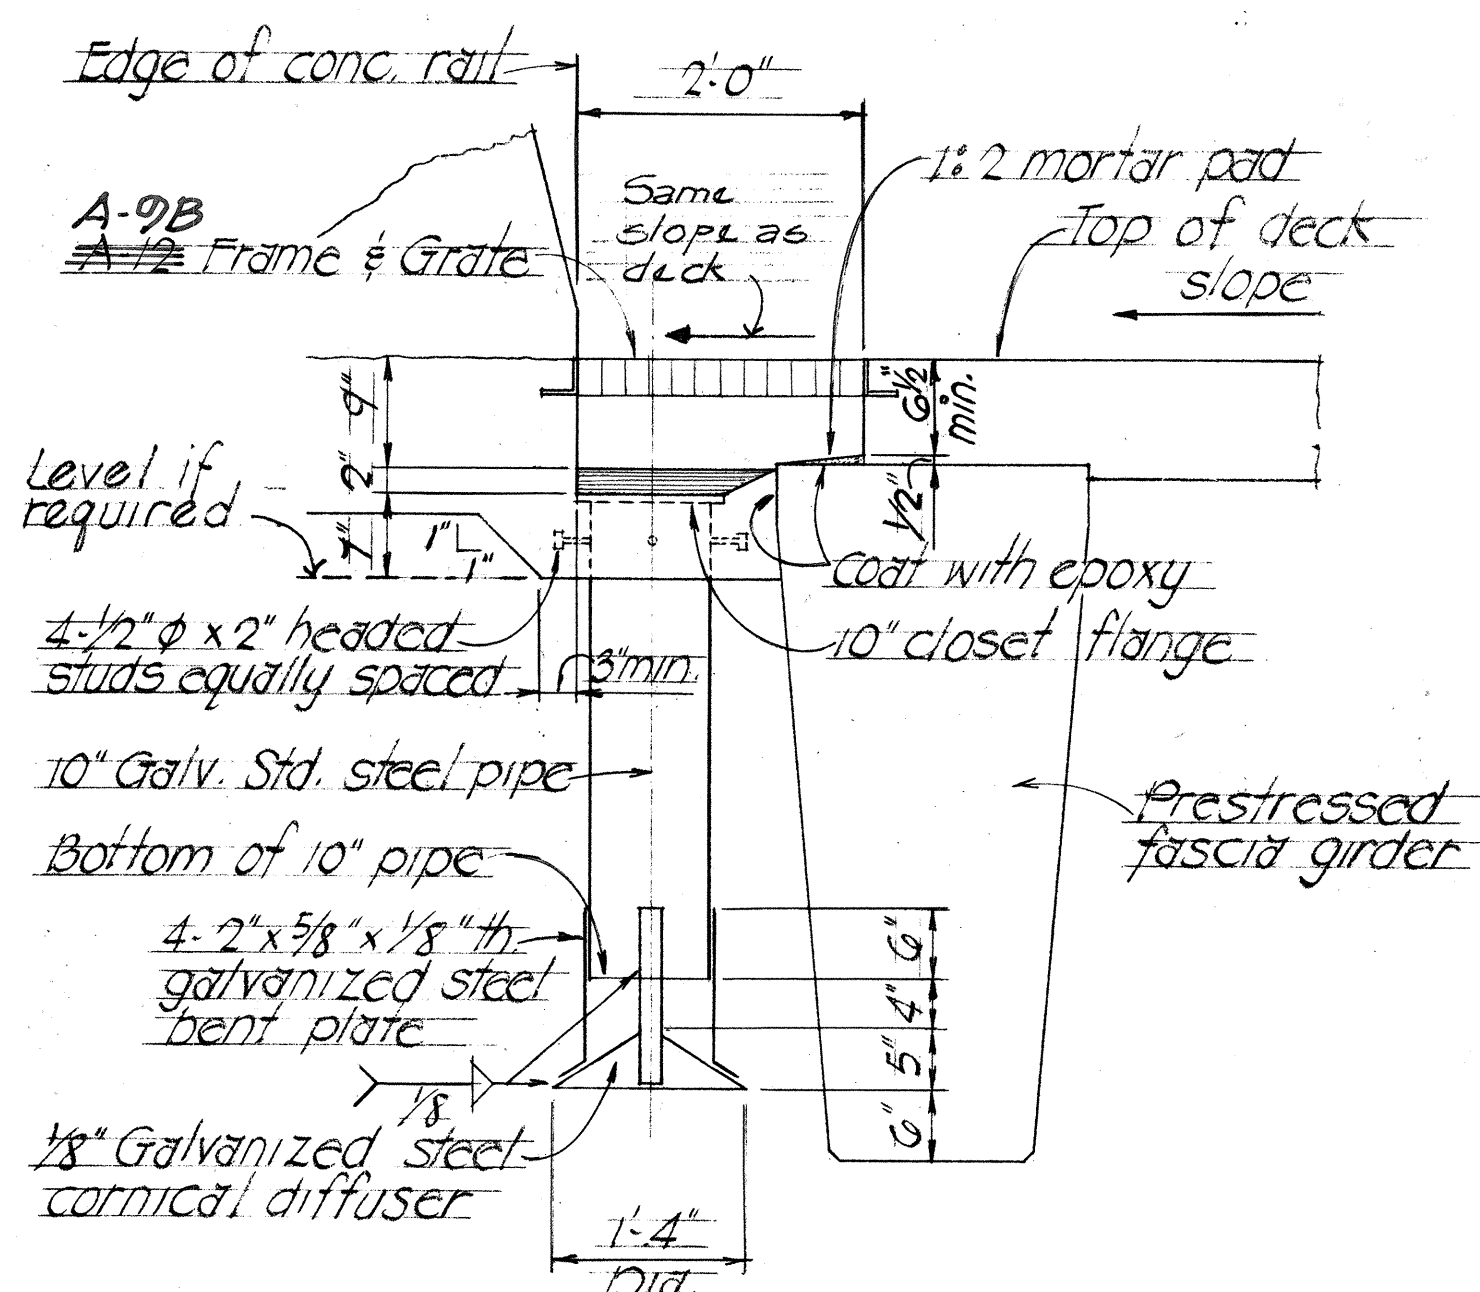


THIS WORK WAS PREPARED BY ME OR UNDER MY SUPERVISION

THIS WORK WAS PREPARED BY ME OR UNDER MY SUPERVISION

STATE OF HAWAII  
DEPARTMENT OF TRANSPORTATION  
HIGHWAYS DIVISION  
**NIMITZ CONNECTOR (E.B.)**  
**RAMP "A" & RAMP "B"**  
**DECK FRAMING PLAN**  
KEEHI INTERCHANGE  
F.A.I. PROJ. NO. 1-HI-1(168)17  
Scale: As shown Date: JULY, 1981  
SHEET No. 541 OF 49 SHEETS






| FED. ROAD DIST. NO. | STATE | FED. AID PROJ. NO. | FISCAL YEAR | SHEET NO. | TOTAL SHEETS |
|---------------------|-------|--------------------|-------------|-----------|--------------|
| HAWAII              | HAW.  | 1-HI-1(168)17      | 1982        | 124       | 143          |

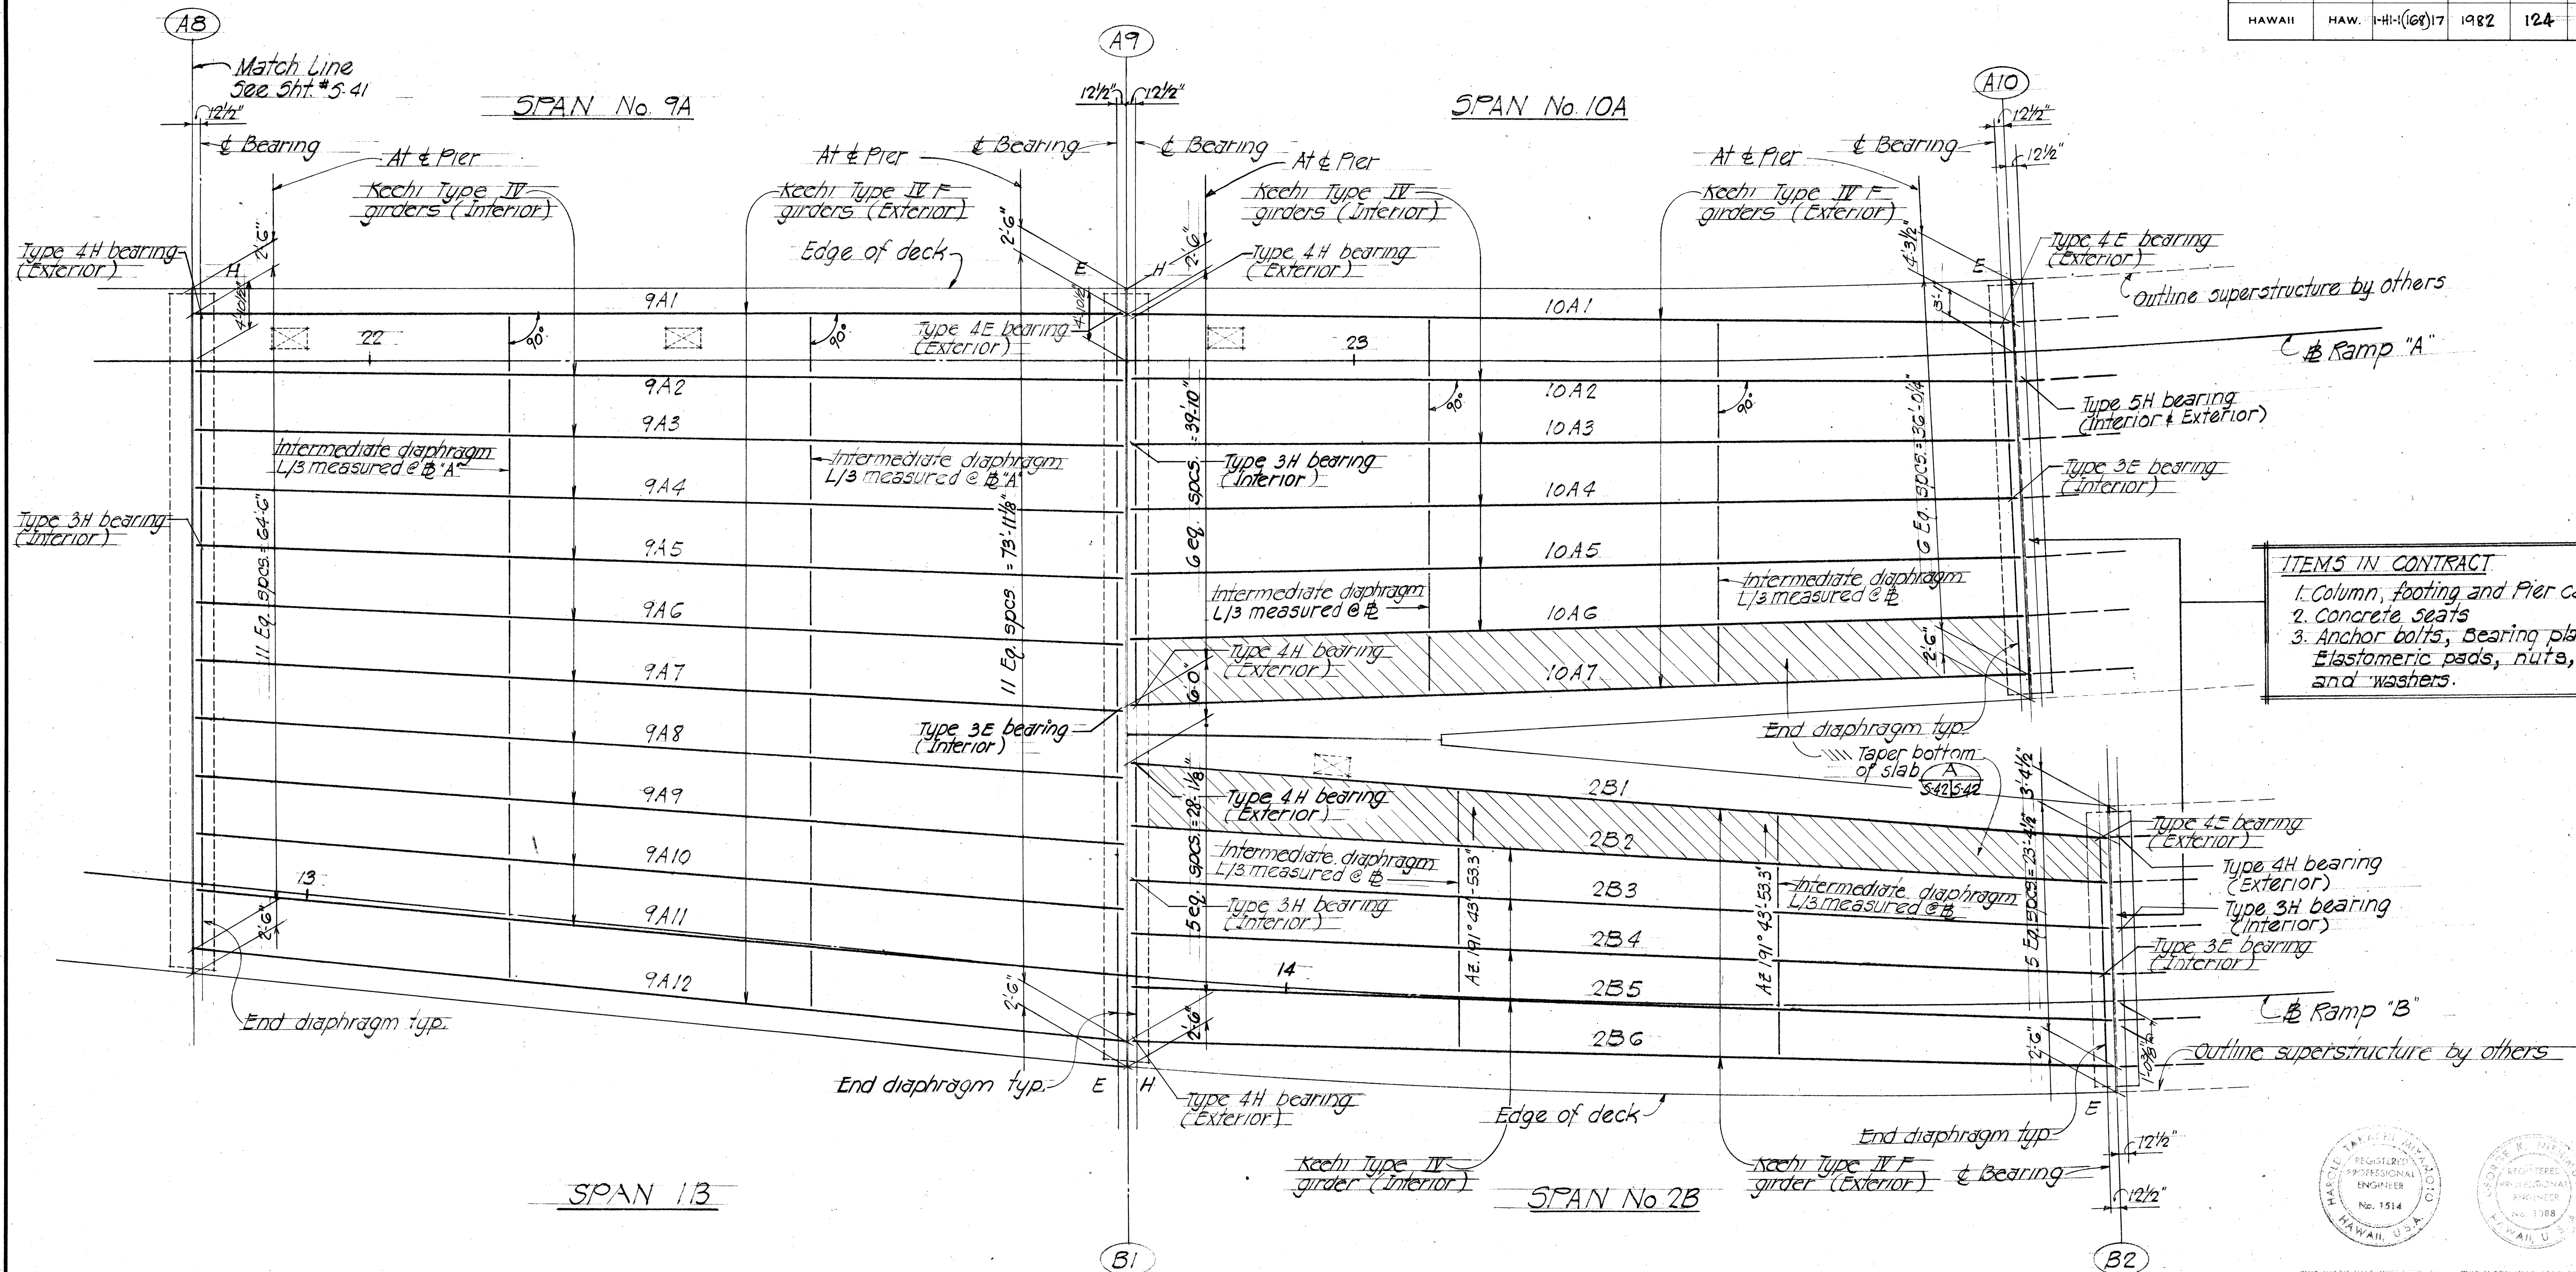

- ITEMS IN CONTRACT**
1. Column, footing and Pier cap.
  2. Concrete seats
  3. Anchor bolts, bearing plates, Elastomeric pads, nuts, and washers.

- NOTES**
1. The & bearing are parallel to the & pier unless otherwise noted.
  2. For typical deck sections - see sht. #S-48
  3. For intermediate and end diaphragms - see sheet #S-45
  4. For girder length - see sheet #S-43

**DECK FRAMING PLAN**  
Scale 1/8" = 1'-0"

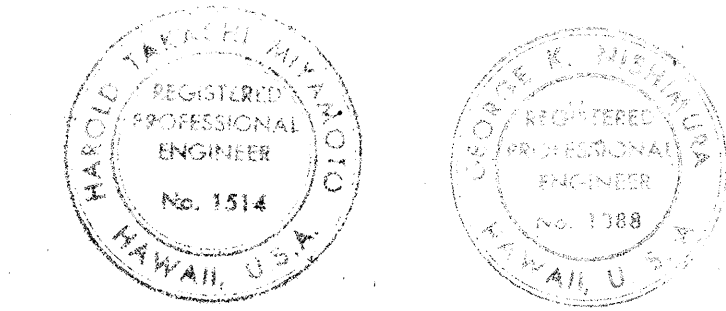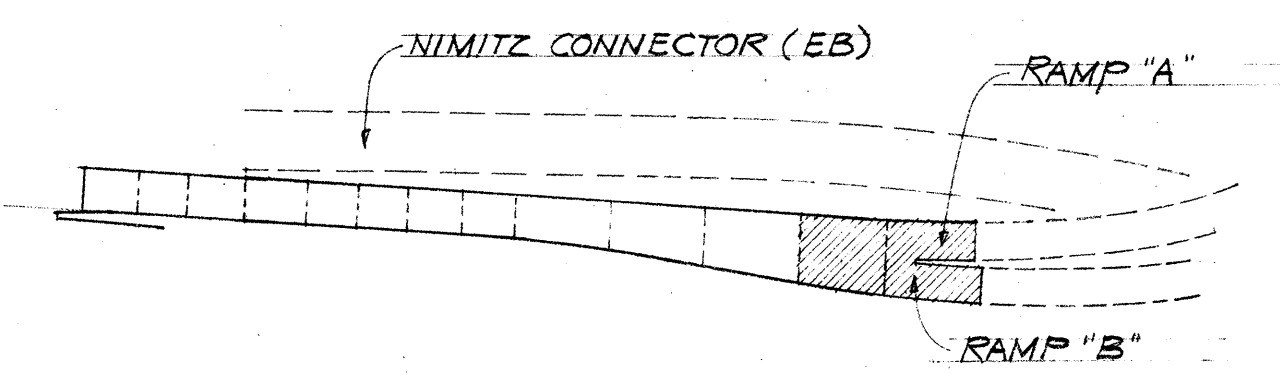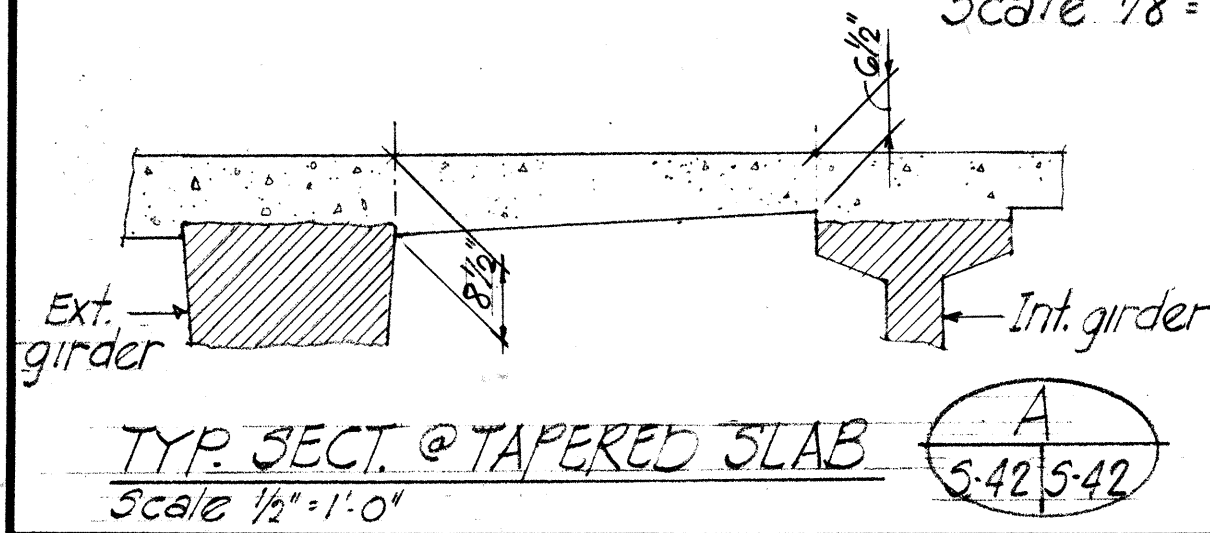

STATE OF HAWAII  
DEPARTMENT OF TRANSPORTATION  
HIGHWAYS DIVISION

**NIMITZ CONNECTOR (E.B.)  
RAMP "A" & RAMP "B"**

**DECK FRAMING PLAN**

KEEHI INTERCHANGE

FAL PROJ. NO. 1-HI-1(168)17

Scale: As shown Date: JULY, 1981

SHEET No. 5-42 OF 49 SHEETS



# BEAM TYPE SCHEDULE

| FED. ROAD DIST. NO. | STATE | FED. AID PROJ. NO. | FISCAL YEAR | SHEET NO. | TOTAL SHEETS |
|---------------------|-------|--------------------|-------------|-----------|--------------|
| HAWAII              | HAW.  | HI-1(168)17        | 1982        | 125       | 145          |

| Beam mark | Beam length<br>to & brg. | t'      | t''     | Plate<br>taper | Beam type | Beam mark | Beam length<br>to & brg. | t'      | t''     | Plate<br>taper | Beam type | Beam mark | Beam length<br>to & brg. | t'      | t''     | Plate<br>taper | Beam type | Beam mark | Beam length<br>to & brg. | t'     | t''    | Plate<br>taper | Beam type |
|-----------|--------------------------|---------|---------|----------------|-----------|-----------|--------------------------|---------|---------|----------------|-----------|-----------|--------------------------|---------|---------|----------------|-----------|-----------|--------------------------|--------|--------|----------------|-----------|
| 1A1       | 52.92                    | 1 1/8"  | 1 1/8"  | 1/4:12         | IF-A      | 7A9       | 98.53                    | 1 5/16" | 1 5/16" | 1/2:12         | IF-A      | 2NE5      | 98.26                    | 1 1/16" | 1 1/16" | 1/8:12         | IV-C      | 7NEG      | 97.22                    | 1 1/4" | 1 1/4" | 3/8:12         | IV-C      |
| 2         |                          |         |         |                | II-D      | 8A1       | 97.92                    | 1 1/4"  | 1 1/4"  | 1/16:12        | IF-A      | 6         |                          |         |         |                |           | 7         | 96.93                    |        |        | 3/8:12         |           |
| 3         |                          |         |         |                |           | 2         | 97.92                    | 1 3/16" | 1 3/16" | 1/2:12         | IV-C      | 7         |                          |         |         |                |           | 8         | 96.65                    |        |        | 1/16:12        |           |
| 4         |                          |         |         |                |           | 3         | 97.94                    |         |         |                |           | 8         |                          |         |         |                |           | 9         | 96.36                    |        |        | 1/16:12        | IV-C      |
| 5         |                          |         |         |                |           | 4         | 97.96                    |         |         |                |           | 9         |                          |         |         |                |           | 7NE10     | 96.10                    | 1 1/4" | 1 1/4" | 1/16:12        | IV-F-A    |
| 6         |                          |         |         |                | II-D      | 5         | 98.00                    |         |         |                |           | 2NE10     | 98.26                    | 1 1/16" | 1 1/16" | 1/8:12         | IV-F-A    | 8NE1      | 98.64                    | 1 1/4" | 1 1/4" | 3/8:12         | IV-F-A    |
| 1A7       | 52.92                    | 1 1/8"  | 1 1/8"  | 1/4:12         | IF-A      | 6         | 98.04                    | 1 3/16" | 1 3/16" | 1/2:12         |           | 3NE1      | 98.26                    | 1 1/8"  | 1 1/8"  | 3/16:12        | IV-F-A    | 2         | 98.36                    |        |        |                | II-C      |
| 2A1       | 52.92                    | 1 1/8"  | 1 1/8"  | 5/16:12        | IF-A      | 7         | 98.09                    | 1 1/4"  | 1 1/4"  | 1/16:12        |           | 2         |                          |         |         |                |           | 3         | 98.07                    |        |        |                |           |
| 2         |                          |         |         |                | II-D      | 8         | 98.16                    |         |         |                |           | 3         |                          |         |         |                |           | 4         | 97.79                    |        |        |                |           |
| 3         |                          |         |         |                |           | 9         | 98.23                    |         |         |                |           | 4         |                          |         |         |                |           | 5         | 97.50                    |        |        |                |           |
| 4         |                          |         |         |                |           | 10        | 98.31                    | 1 1/4"  | 1 1/4"  | 1/16:12        | IV-C      | 5         |                          |         |         |                |           | 6         | 97.22                    |        |        |                |           |
| 5         |                          |         |         |                |           | 8A11      | 98.41                    | 1 3/8"  | 1 3/8"  | 5/8:12         | IF-A      | 6         |                          |         |         |                |           | 7         | 96.93                    |        |        |                |           |
| 6         |                          |         |         |                | II-D      | 9A1       | 92.92                    | 1 1/4"  | 1 1/4"  | 1/16:12        | IF-B      | 7         |                          |         |         |                |           | 8         | 96.65                    |        |        |                |           |
| 2A7       | 52.92                    | 1 1/8"  | 1 1/8"  | 5/16:12        | IF-A      | 2         | 92.92                    | 1 3/16" | 1 3/16" | 1/2:12         | IV-C      | 8         |                          |         |         |                |           | 9         | 96.36                    |        |        |                | IV-C      |
| 3A1       | 52.92                    | 1 1/8"  | 1 1/8"  | 3/8:12         | IF-A      | 3         | 92.93                    |         |         |                |           | 9         |                          |         |         |                |           | 8NE10     | 96.10                    | 1 1/4" | 1 1/4" | 3/8:12         | IV-F-A    |
| 2         |                          |         |         |                | II-D      | 4         | 92.95                    |         |         |                |           | 3NE10     | 98.26                    | 1 1/8"  | 1 1/8"  | 3/16:12        | IV-F-A    | I-A1      | 48.76                    |        | 1 1/8" | 1/8:12         | IF-A      |
| 3         |                          |         |         |                |           | 5         | 92.98                    | 1 1/4"  | 1 1/4"  | 1/16:12        |           | 4NE1      | 98.26                    | 1 1/8"  | 1 1/8"  | 3/16:12        | IV-F-A    | I-A2      |                          |        |        | 1/8:12         | II-D      |
| 4         |                          |         |         |                |           | 6         | 93.01                    |         |         |                |           | 2         |                          |         |         | 3/16:12        | IV-C      | I-A3      |                          |        |        | 1/8:12         | II-D      |
| 5         |                          |         |         |                |           | 7         | 93.05                    |         |         |                |           | 3         |                          |         |         | 1/4:12         |           | I-A4      |                          |        |        | 1/16:12        | II-D      |
| 6         |                          |         |         |                | II-D      | 8         | 93.10                    |         |         |                |           | 4         |                          |         |         |                |           | I-A5      |                          |        |        |                | II-D      |
| 3A7       | 52.92                    | 1 1/8"  | 1 1/8"  | 3/8:12         | IF-A      | 9         | 93.16                    |         |         |                |           | 5         |                          |         |         |                |           | I-A6      |                          |        |        |                | II-D      |
| 4A1       | 52.92                    | 1 3/16" | 1 3/16" | 1/16:12        | IF-A      | 10        | 93.22                    |         |         | 5/8:12         |           | 6         |                          |         |         |                |           | I-A7      | 48.76                    |        | 1 1/8" | 1/16:12        | IF-A      |
| 2         |                          |         |         |                | II-D      | 11        | 93.29                    |         |         | 5/8:12         | II-C      | 7         |                          |         |         |                |           | A1        | 48.92                    | 1 1/8" | 1 1/8" | 1/8:12         | IF-A      |
| 3         |                          |         |         |                |           | 9A12      | 93.37                    | 1 3/8"  | 1 3/8"  | 1/16:12        | IV-F-B    | 8         |                          |         |         |                |           | A2        |                          |        |        |                | II-D      |
| 4         |                          |         |         |                |           | 10A1      | 87.73                    | 1 5/16" | 1 5/16" | 1/2:12         | IV-F-B    | 9         |                          |         |         |                |           | A3        |                          |        |        |                | II-D      |
| 5         |                          |         |         |                |           | 2         | 88.05                    | 1 1/4"  | 1 1/4"  |                | IV-C      | 4NE10     | 98.26                    | 1 1/8"  | 1 1/8"  | 1/4:12         | IV-F-A    | A4        |                          |        |        |                | II-D      |
| 6         |                          |         |         |                | II-D      | 3         | 88.37                    |         |         |                |           | 5NE1      | 98.20                    | 1 3/16" | 1 3/16" | 1/4:12         | IV-F-A    | A5        |                          |        |        |                | II-D      |
| 4A7       | 52.92                    | 1 3/16" | 1 3/16" | 1/16:12        | IF-A      | 4         | 88.69                    |         |         |                |           | 2         | 98.18                    |         |         | 1/4:12         | IV-C      | A6        |                          |        |        |                | II-A1-D   |
| 5A1       | 52.92                    | 1 3/16" | 1 3/16" | 1/2:12         | IF-A      | 5         | 89.02                    |         |         |                |           | 3         | 98.16                    |         |         | 5/16:12        |           | A7        | 48.92                    | 1 1/8" | 1 1/8" | 1/8:12         | IF-A      |
| 2         |                          |         |         |                | II-D      | 6         | 89.35                    |         |         | 1/16:12        | IV-C      | 4         | 98.14                    |         |         |                |           | A1        | 48.92                    | 1 1/8" | 1 1/8" | 3/16:12        | IF-A      |
| 3         |                          |         |         |                |           | 10A7      | 89.69                    | 1 5/16" | 1 5/16" | 1/16:12        | IV-F-A    | 5         | 98.12                    |         |         |                |           | A2        |                          |        |        |                | II-D      |
| 4         |                          |         |         |                |           | 2B1       | 97.84                    | 1 1/4"  | 1 1/4"  | 1/2:12         | IV-F-D    | 6         | 98.09                    |         |         |                |           | A3        |                          |        |        |                | II-D      |
| 5         | 52.92                    |         |         |                |           | 2         | 97.88                    | 1 3/16" | 1 3/16" |                | IV-C      | 7         | 98.07                    |         |         | 5/16:12        |           | A4        |                          |        |        |                | II-D      |
| 6         | 52.93                    |         |         |                | II-D      | 3         | 97.93                    |         |         |                |           | 8         | 98.05                    |         |         | 3/8:12         |           | A5        |                          |        |        |                | II-D      |
| 5A7       | 52.93                    | 1 3/16" | 1 3/16" | 1/2:12         | IF-A      | 4         | 97.98                    |         |         |                |           | 9         | 98.03                    |         |         | 3/8:12         | IV-C      | A6        |                          |        |        |                | II-A1-D   |
| 6A1       | 97.92                    | 1 5/16" | 1 5/16" | 1/2:12         | IV-F-A    | 5         | 98.04                    |         |         |                | IV-C      | 5NE10     | 98.01                    | 1 3/16" | 1 3/16" | 3/8:12         | IV-F-A    | A7        | 48.92                    | 1 1/8" | 1 1/8" | 3/16:12        | IF-A      |
| 2         | 97.92                    | 1 3/16" | 1 3/16" |                | IV-C      | 2B6       | 98.12                    | 1 1/4"  | 1 1/4"  | 1/2:12         | IV-F-A    | 6NE1      | 98.64                    | 1 1/4"  | 1 1/4"  | 5/16:12        | IV-F-A    |           |                          |        |        |                |           |
| 3         | 97.93                    |         |         |                |           | 1NE1      | 98.26                    |         | 1"      | 1/16:12        | IV-F-A    | 2         | 98.36                    |         |         | 5/16:12        | IV-C      |           |                          |        |        |                |           |
| 4         | 97.96                    |         |         |                |           | 2         |                          |         |         |                | IV-C      | 3         | 98.07                    |         |         | 5/16:12        |           |           |                          |        |        |                |           |
| 5         | 97.99                    |         |         |                |           | 3         |                          |         |         |                |           | 4         | 97.79                    |         |         | 3/8:12         |           |           |                          |        |        |                |           |
| 6         | 98.03                    |         |         |                |           | 4         |                          |         |         |                |           | 5         | 97.50                    |         |         |                |           |           |                          |        |        |                |           |
| 7         | 98.08                    | 1 3/16" | 1 3/16" |                | IV-C      | 5         |                          |         |         |                |           | 6         | 97.22                    |         |         |                |           |           |                          |        |        |                |           |
| 6A8       | 98.13                    | 1 5/16" | 1 5/16" | 1/2:12         | IV-F-A    | 6         |                          |         |         |                |           | 7         | 96.93                    |         |         | 3/8:12         |           |           |                          |        |        |                |           |
| 7A1       | 97.92                    | 1 5/16" | 1 5/16" | 1/2:12         | IV-F-A    | 7         |                          |         |         |                |           | 8         | 96.65                    |         |         | 1/16:12        |           |           |                          |        |        |                |           |
| 2         | 97.93                    | 1 1/4"  | 1 1/4"  |                | IV-C      | 8         |                          |         |         |                |           | 9         | 96.36                    |         |         | 1/16:12        | IV-C      |           |                          |        |        |                |           |
| 3         | 97.96                    |         |         |                |           | 9         |                          |         |         |                |           | 7NE10     | 96.10                    | 1 1/4"  | 1 1/4"  | 1/16:12        | IV-F-A    |           |                          |        |        |                |           |
| 4         | 98.01                    |         |         |                |           | 1NE10     | 98.26                    |         | 1"      | 1/16:12        | IV-F-A    | 7NE1      | 98.64                    | 1 1/4"  | 1 1/4"  | 3/8:12         | IV-F-A    |           |                          |        |        |                |           |
| 5         | 98.07                    |         |         |                |           | 2NE1      | 98.26                    | 1 1/16" | 1 1/16" | 1/8:12         | IV-F-A    | 2         | 98.36                    |         |         |                | IV-C      |           |                          |        |        |                |           |
| 6         | 98.16                    |         |         |                |           | 2         |                          |         |         |                | IV-C      | 3         | 98.07                    |         |         |                |           |           |                          |        |        |                |           |
| 7         | 98.27                    |         |         |                |           | 3         |                          |         |         |                | IV-C      | 4         | 97.79                    |         |         |                |           |           |                          |        |        |                |           |
| 7A8       | 98.39                    | 1 1/4"  | 1 1/4"  | 1/2:12         | IV-C      | 2NE4      | 98.26                    | 1 1/16" | 1 1/16" | 1/8:12         | IV-C      | 7NE5      | 97.50                    | 1 1/4"  | 1 1/4"  | 3/8:12         | IV-C      |           |                          |        |        |                |           |

STATE OF HAWAII  
DEPARTMENT OF TRANSPORTATION  
HIGHWAYS DIVISION  
NIMITZ CONNECTOR (E.B.)  
RAMP "A" & RAMP "B"  
BEAM TYPE SCHEDULE  
KEEHI INTERCHANGE  
F.A.I. PROJ. NO. 1-HI-1 (198) 17  
Scale: As shown Date: JULY, 1981  
SHEET NO. 43 OF 49 SHEETS

THIS WORK WAS PREPARED BY ME  
OR UNDER MY SUPERVISION  
Hans W. Kuyas

REGISTERED PROFESSIONAL  
ENGINEER  
No. 1388  
HAWAII, U.S.A.


THIS WORK WAS PREPARED BY ME  
OR UNDER MY SUPERVISION  
H. W. Kuyas

REGISTERED PROFESSIONAL  
ENGINEER  
No. 1514  
HAWAII, U.S.A.

## NOTES:


1. t' is the bearing plate thickness (inches) at down station end of the beam.
2. t'' is the plate thickness (inches) at up station end of beam.
3. Beam length given is horizontal distance between & bearing.
4. For placement of tapered plate see top of conc. seat elevations on pier details.

DATE: \_\_\_\_\_  
 SURVEY PLOTTED BY: \_\_\_\_\_  
 DRAWN BY: \_\_\_\_\_  
 DESIGNED BY: \_\_\_\_\_  
 CHECKED BY: \_\_\_\_\_  
 NO. \_\_\_\_\_

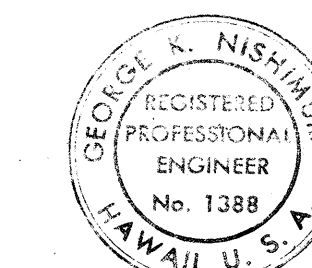

THIS WORK WAS PREPARED BY ME  
 OR UNDER MY SUPERVISION

*George K. Nishimura*

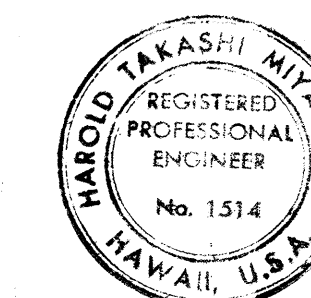

THIS WORK WAS PREPARED BY ME  
 OR UNDER MY SUPERVISION

*Harold Takashi Nishimura*

STATE OF HAWAII  
 DEPARTMENT OF TRANSPORTATION  
 HIGHWAYS DIVISION

NIMITZ CONNECTOR (E.B.)  
 RAMP "A" & RAMP "B"

BEAM TYPE SCHEDULE

KEEHI INTERCHANGE

F.A.I. PROJ. NO. I-HI-1(168)17

Scale: AS SHOWN Date: JULY, 1981

SHEET NO. 43 OF 49 SHEETS




| FED. ROAD DIST. NO. | STATE | FED. AID PROJ. NO. | FISCAL YEAR | SHEET NO. | TOTAL SHEETS |
|---------------------|-------|--------------------|-------------|-----------|--------------|
| HAWAII              | HAW.  | 1-HI-1(68)17       | 1982        | 126       | 145          |


# NOTES FOR PRESTRESSED BEAMS:

## PRETENSIONING


- Concrete shall have a minimum 28 day compressive strength of 6,000 psi.
- A. Pretensioned strands in Keehi Beams Type IV, & IV-F shall be 7 wire 1/2"  $\phi$  stress-relieved steel strands (area=0.153 in.<sup>2</sup>) with an ultimate strength of 270 ksi. For properties See State Standard Specifications.  
Initial strand stress (before any losses): 199 ksi.; Initial loss = 20,000 psi.  
Total loss due to creep, shrinkage, elastic shortening and relaxation of steel = 45,000 psi.
- B. Pretensioned strands in AASHTO Beam Type II and Keehi Beam Type II-F shall be 7 wire 7/16"  $\phi$  stress-relieved steel strands (area = 0.115 in.<sup>2</sup>) with an ultimate strength of 270 ksi. For properties see State Standard Specifications.  
Initial strand stress (before any losses): 196 ksi.; Initial loss = 20,000 psi.  
Total loss due to creep, shrinkage, elastic shortening and relaxation of steel = 45,000 psi.
- Non-prestressed reinforcing steel shall be Grade 40 unless otherwise noted. For properties see State Standard Specifications.
- The calculated camber includes the effect of the initial prestress force and the weight of the beam after removal from bed. Negative values shown for calculated camber indicate a net upward deflection. Calculated camber values shown do not account for any camber growth of the beam. The actual camber shall not exceed the calculated camber shown on the plans by more than 100 % at time of installation.
- The dead load deflection includes the combined effects of the weight of slab, haunch and diaphragm.
- Strand pattern shall be symmetrical about the longitudinal  $\bar{C}$  of the beam.
- Strand release sequence shall not induce any lateral deflection of the beam.
- Contractor shall submit his proposed strand pattern and releasing sequence to the Engineer for approval.
- During curing care shall be taken to avoid any lateral deflection of the beam due to improper orientation.
- Lifting devices shall be placed as close as possible to the center line of bearings of the beam. Details and locations of lifting devices shall be submitted to the Engineer for approval. Such approval does not relieve the Contractor of his responsibility if the beam is damaged due to failure of the lifting device.
- See Framing Plans for locations of diaphragms and beam mark numbers. For beam types and lengths see beam type schedule. Lengths shown do not include effect of elastic shortening.
- In lieu of the 7 wire 1/2" dia. stress-relieved steel strands (area 0.153 in.<sup>2</sup>) with an ultimate strength of 270 ksi, the Contractor at his option may use 7 wire 7/16" dia. stress-relieved steel strands (area 0.115 in.<sup>2</sup>) with an ultimate strength of 270 ksi. For properties of 7/16" dia. strand see special provision. However the working force and its center of gravity as stated, shall not be revised unless approved by the Engineer.

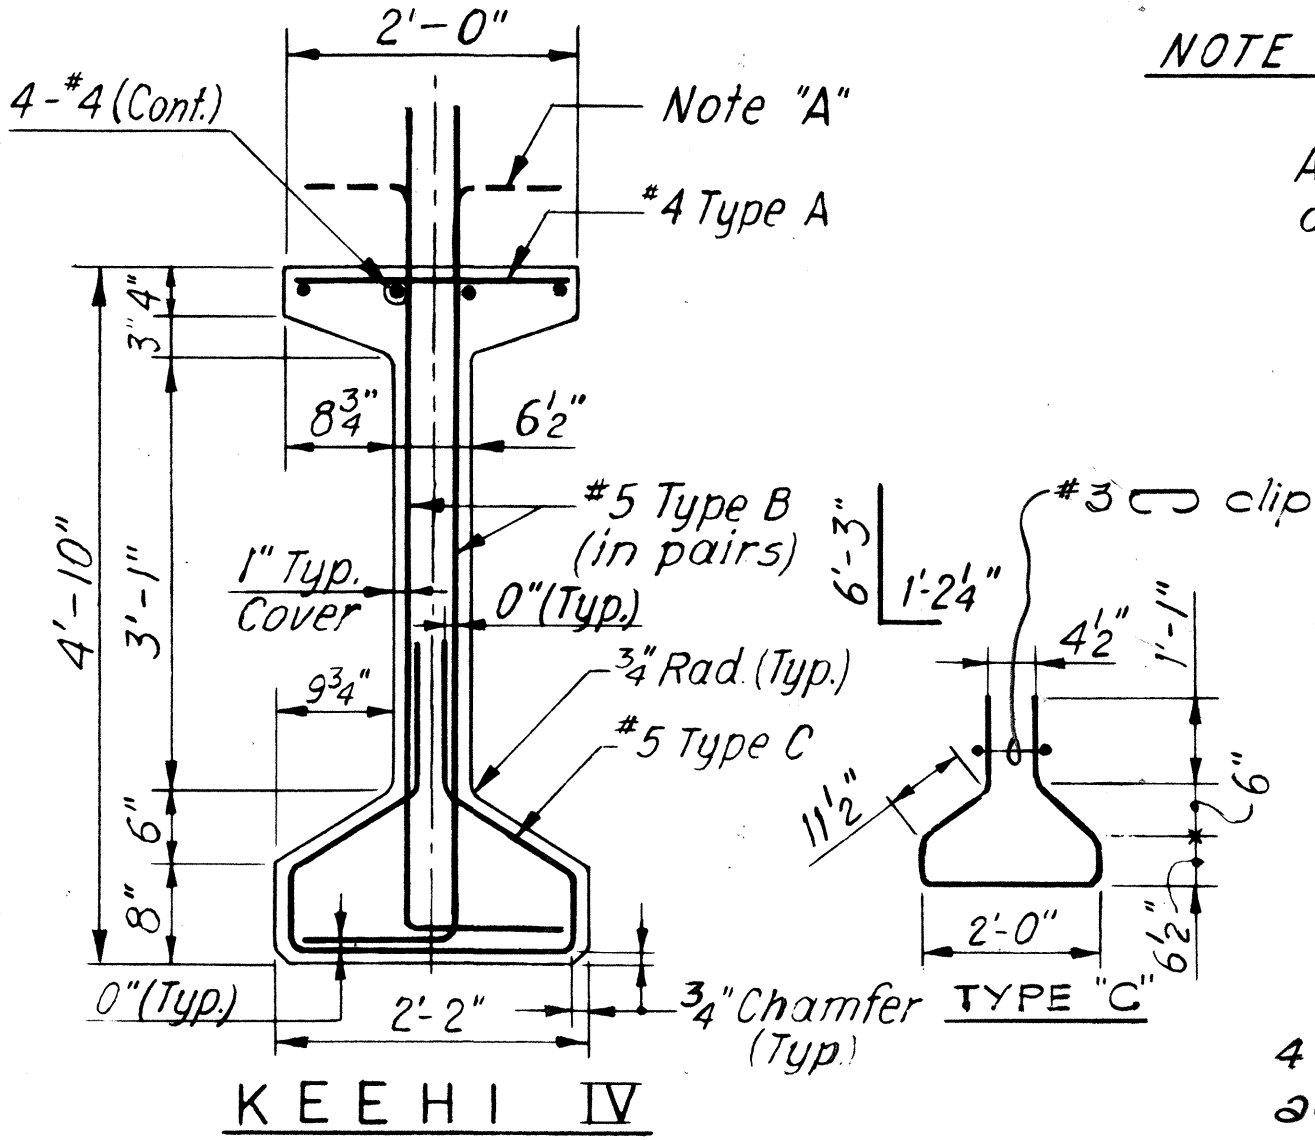

NOTE "A": Bend bars in field 1/2" below top of deck. All reinforcing dimensions are out to out.

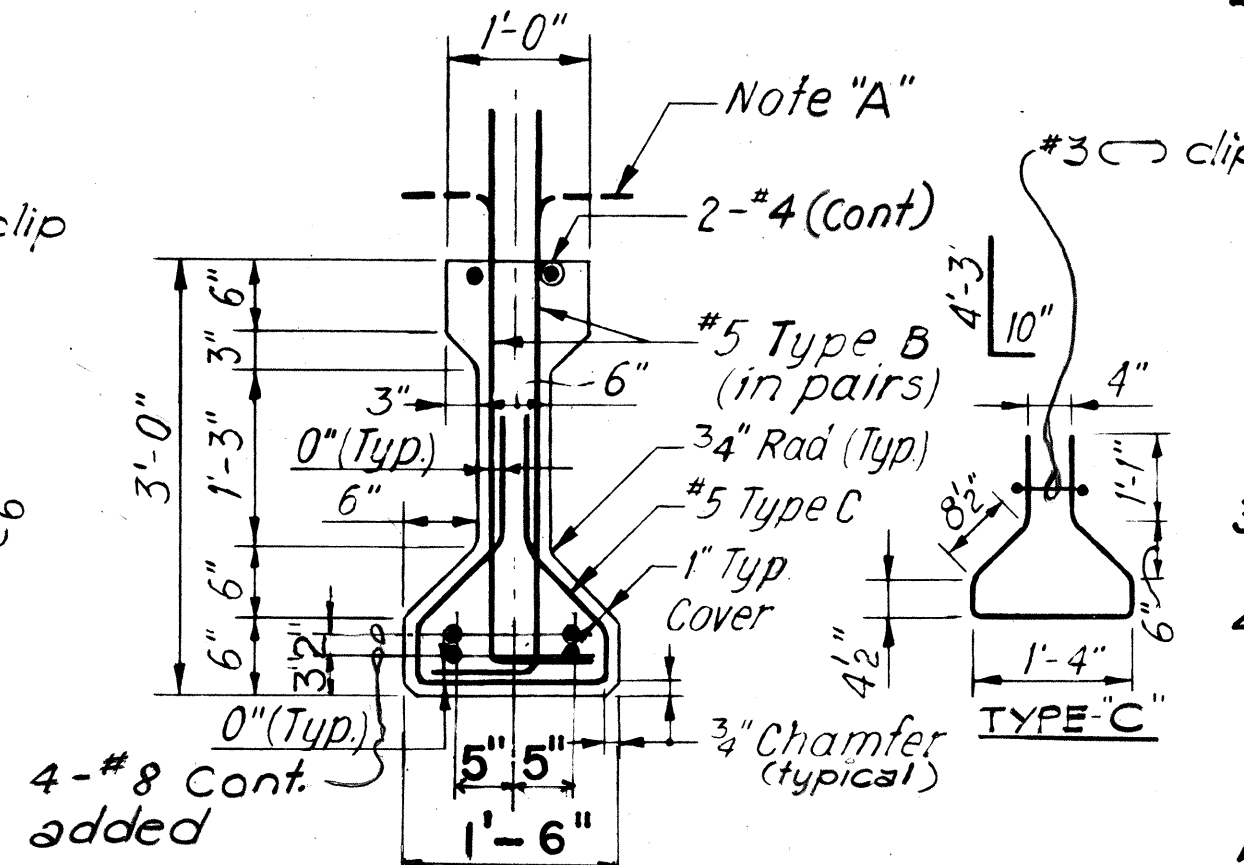


AASHTO TYPE II

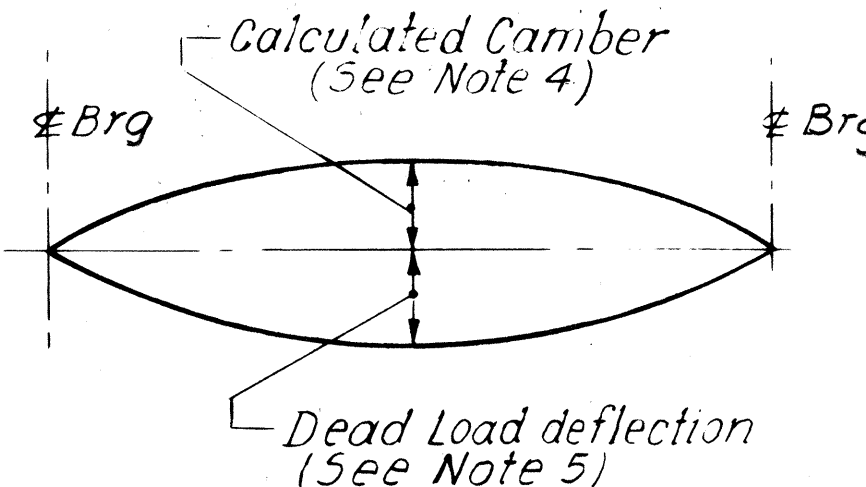

CAMBER DIAGRAM

See Beam End Plan Below

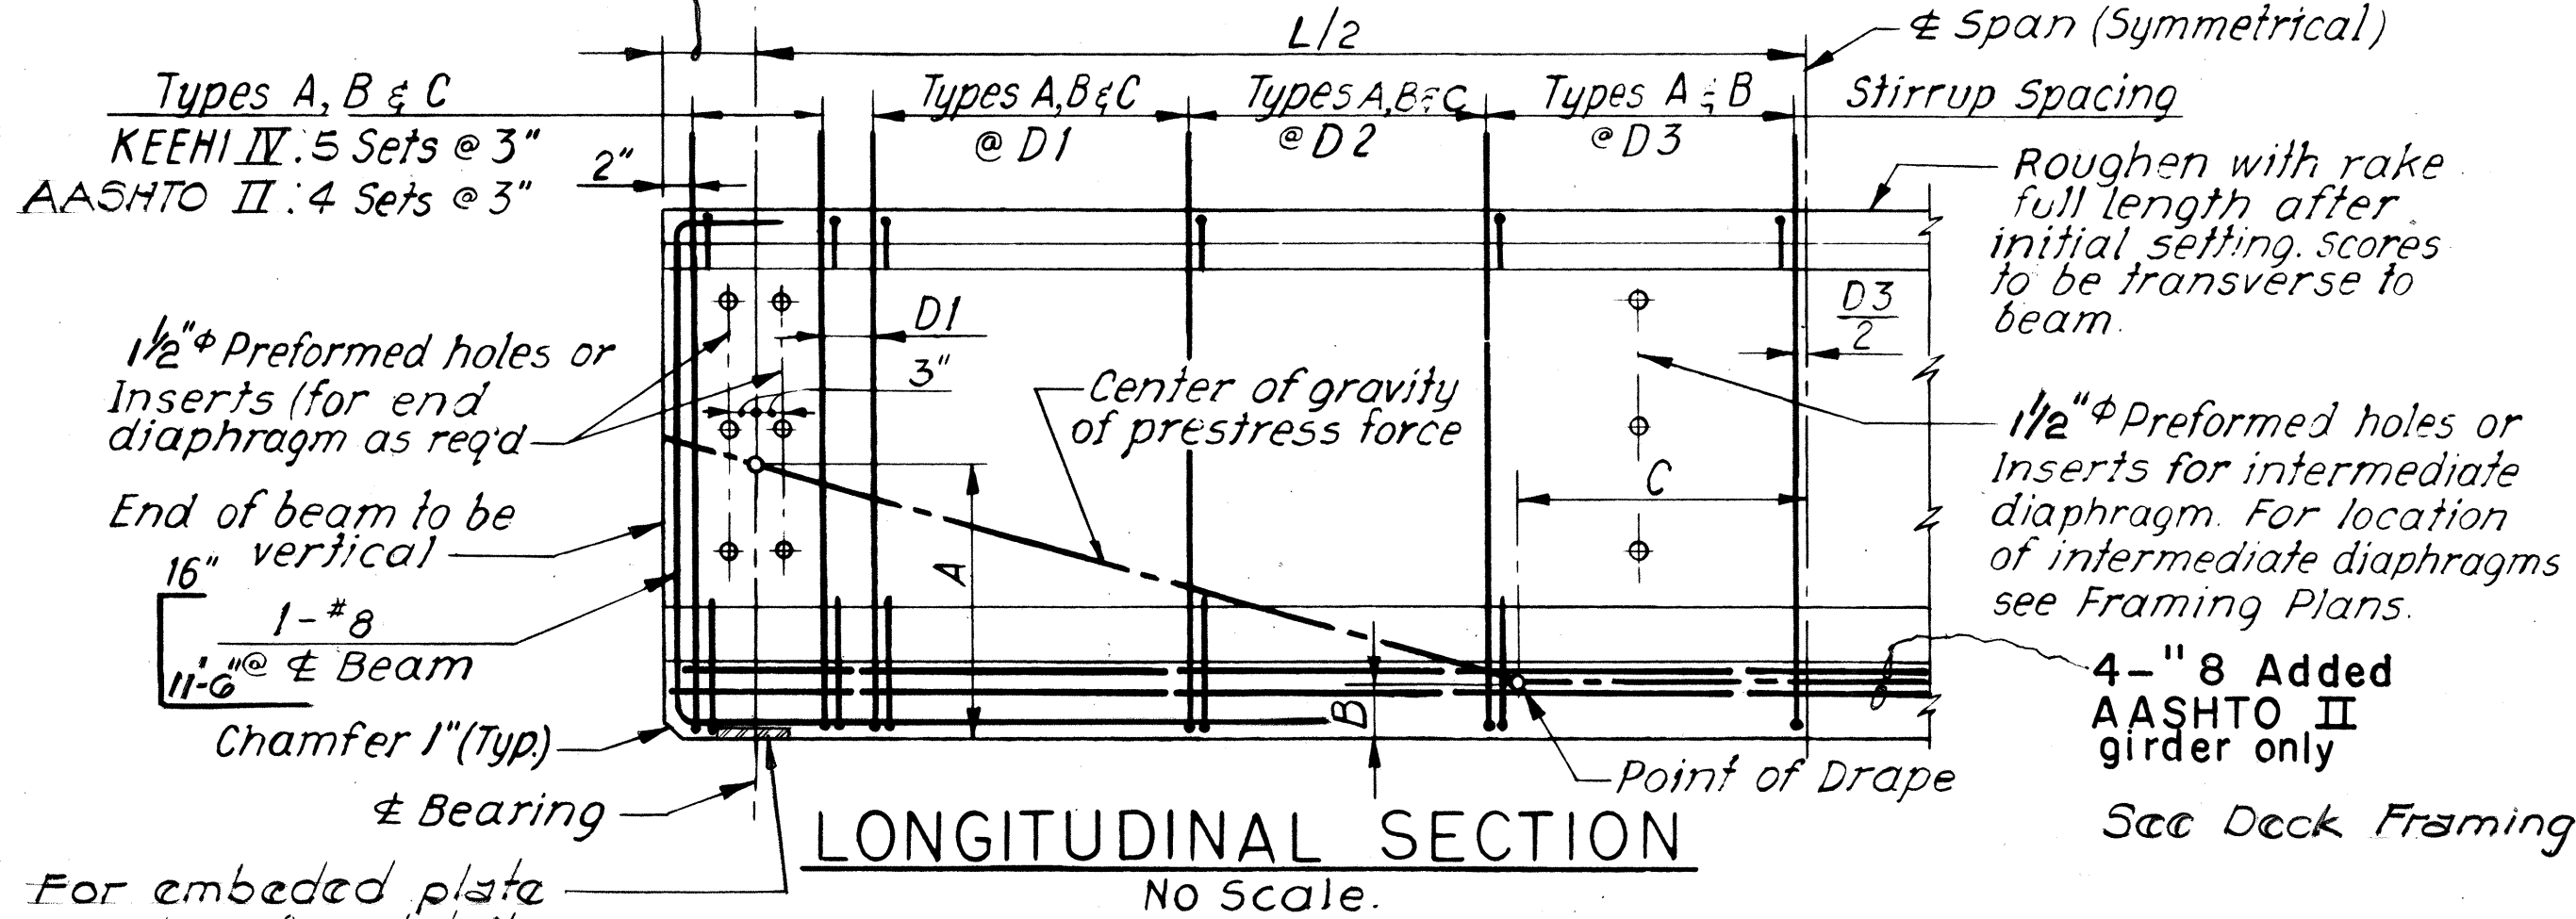

LONGITUDINAL SECTION

BEAM SCHEDULE


| BEAM TYPE | INITIAL PRESTRESS FORCE (KIPS) | WORKING FORCE (KIPS) | CALCULATED CAMBER SEE NOTE 4 | DEAD LOAD DEFLECTION SEE NOTE 5 | LOCATION OF CENTER OF GRAVITY OF PRESTRESS FORCE |        |                         | STIRRUPS                     |                              |            | REMARKS |
|-----------|--------------------------------|----------------------|------------------------------|---------------------------------|--------------------------------------------------|--------|-------------------------|------------------------------|------------------------------|------------|---------|
|           |                                |                      |                              |                                 | DIST A                                           | DIST B | DIST. TO PT. OF DRAPE C | NO. OF STIRRUPS @ SPACING D1 | NO. OF STIRRUPS @ SPACING D2 | SPACING D3 |         |
| IV-C      | 1158                           | 896                  | -1 5/16"                     | 1"                              | 1'-6"                                            | 4 1/2" | 10'-0"                  | 12 @ 9"                      | 18 @ 12"                     | 18"        | 4500    |
| II-D      | 676                            | 521                  | -5/8"                        | 1/2"                            | 1'-3"                                            | 7 7/8" | 5'-0"                   | 30 @ 4"                      | 22 @ 6"                      | 10"        | 4500    |

\* Before any losses


## NOTE

Bundling of prestressing reinforcement is permitted. Refer to Sht. T-18 Bundling of Prestressing Reinforcement Detail.

BEAM END PLAN

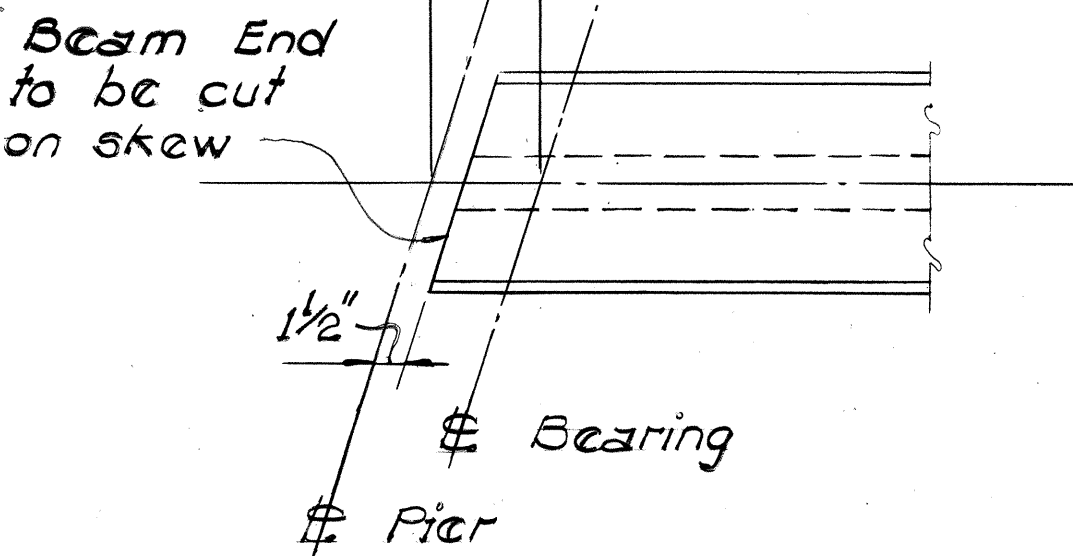

PRESTRESSED CONCRETE GIRDERS WILL BE FURNISHED BY OTHERS

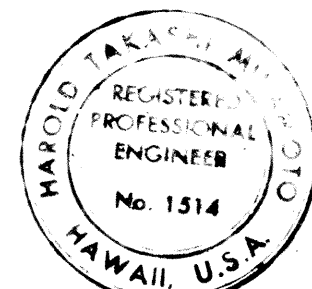


THIS WORK WAS PREPARED BY ME OR UNDER MY SUPERVISION  
 THIS WORK WAS PREPARED BY ME OR UNDER MY SUPERVISION

STATE OF HAWAII  
DEPARTMENT OF TRANSPORTATION  
HIGHWAYS DIVISION  
NIMITZ CONNECTOR (EB)  
RAMP A AND RAMP B  
PRESTRESS BEAM DETAILS  
SHEET 1 OF  
KEEHI INTERCHANGE  
F.A.I. PROJECT NO. 1-HI-1(68)17  
SCALE: DATE: JULY, 1981  
SHEET No. 542 OF 49 SHEETS


126



| FED. ROAD DIST. NO. | STATE | FED. AID PROJ. NO.                             | FISCAL YEAR | SHEET NO. | TOTAL SHEETS |
|---------------------|-------|------------------------------------------------|-------------|-----------|--------------|
| HAWAII              | HAW.  | HI-1(168)17                                    | 1982        | 121       | 145          |
| Date                |       | Revision                                       |             |           |              |
| 10-15-82            |       | Revised threaded inserts into exterior girder. |             |           |              |





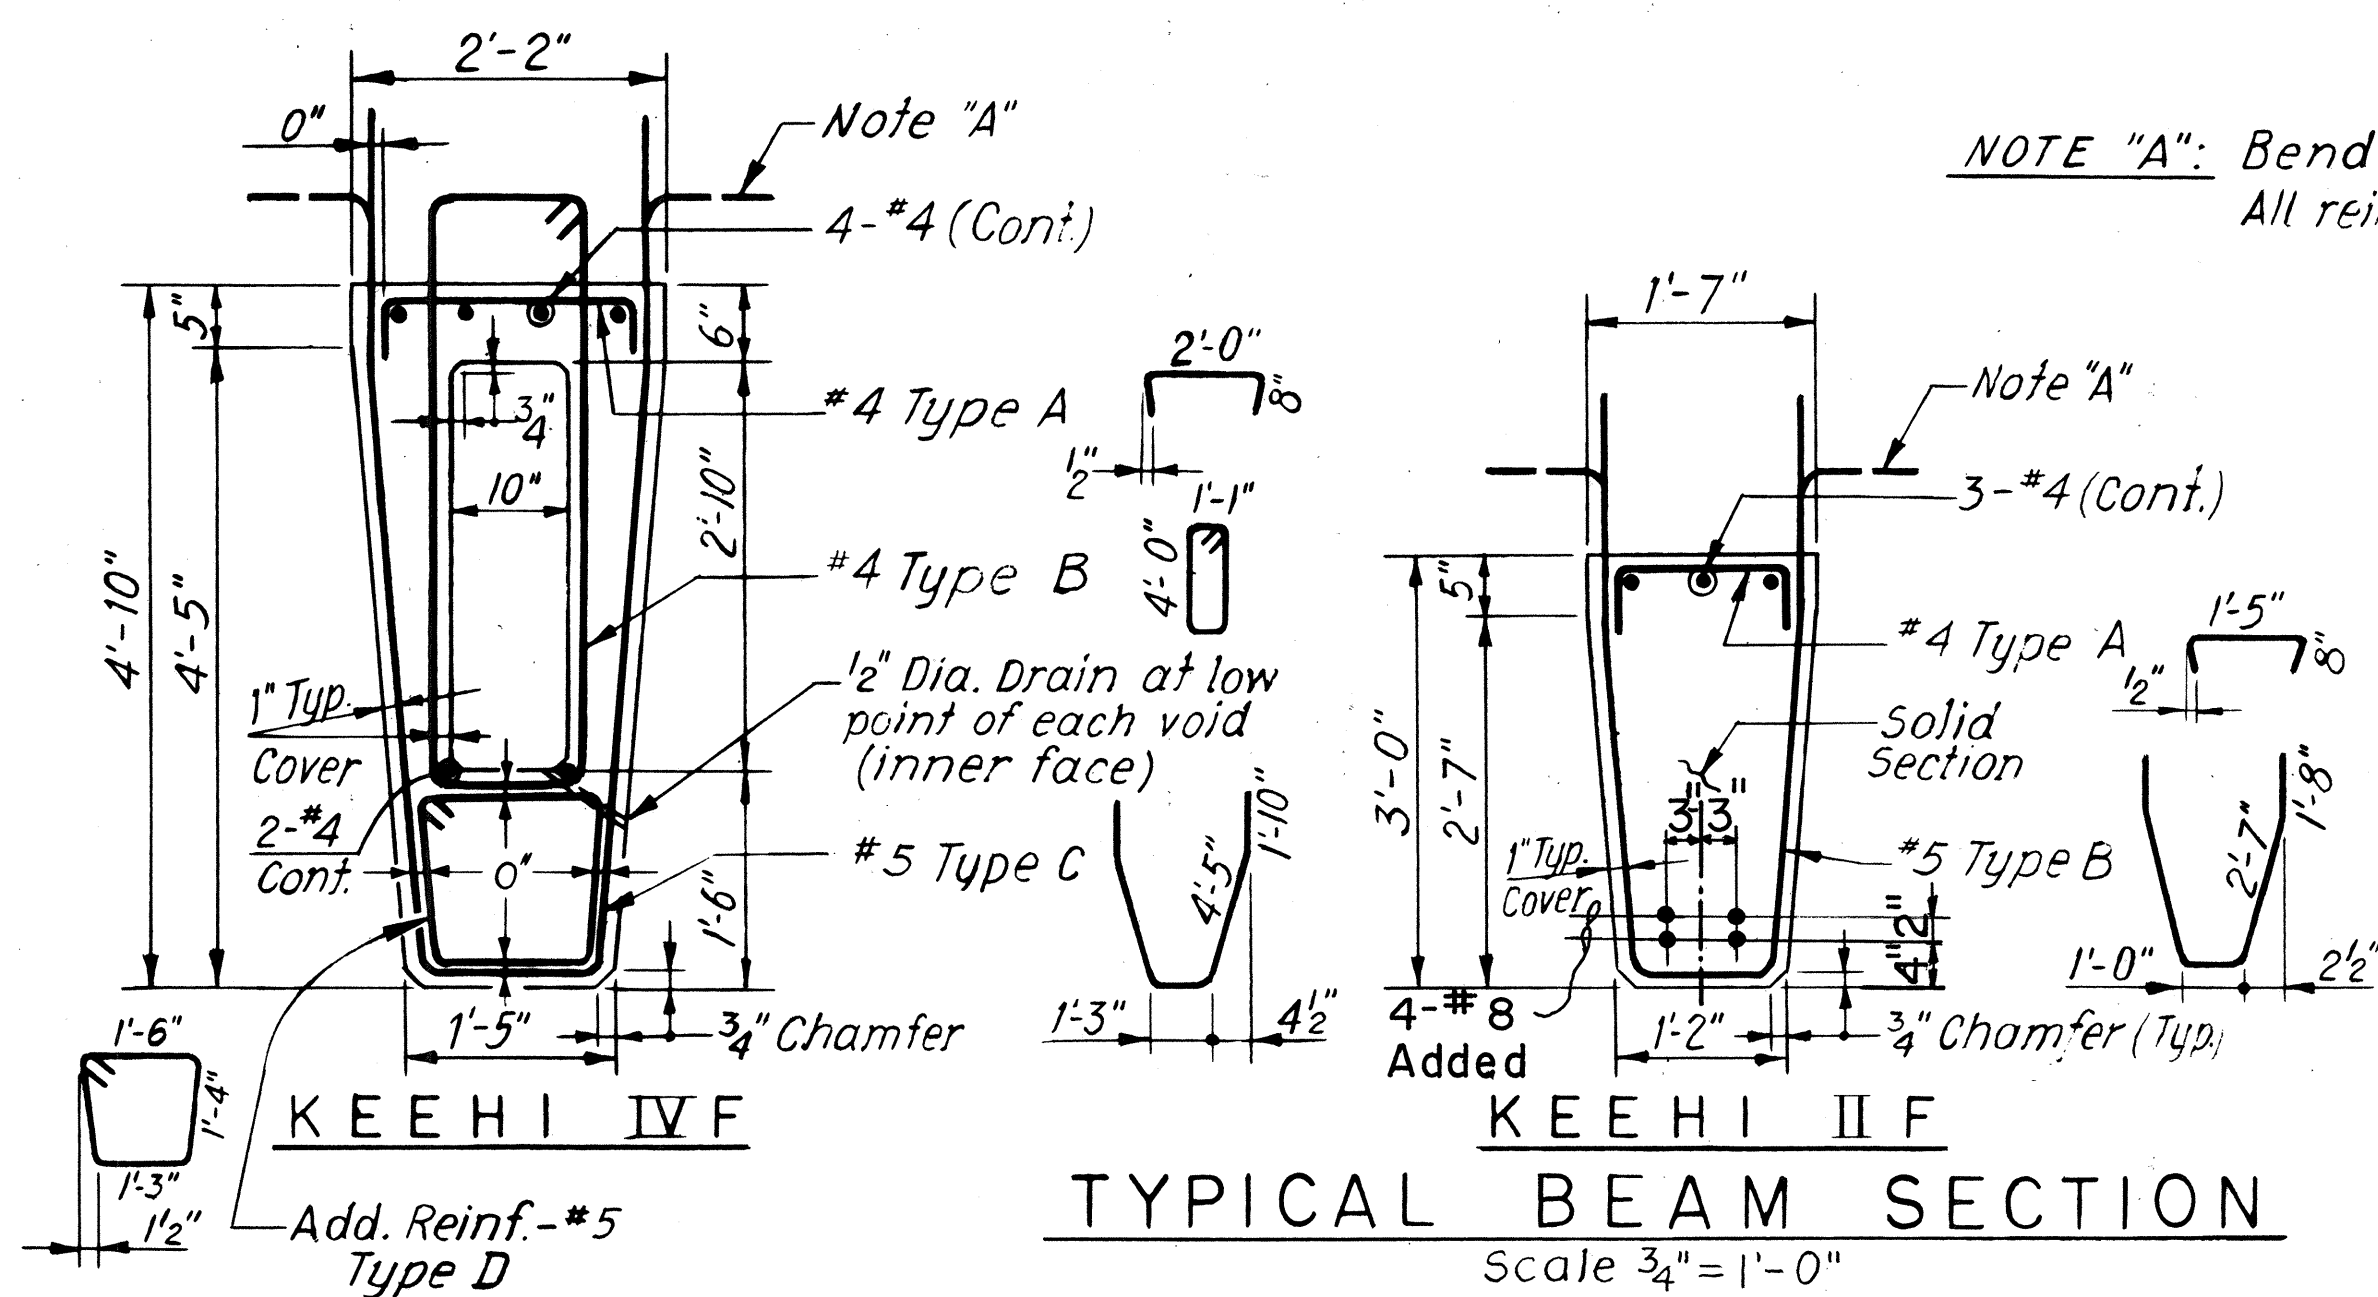


**PRESTRESSED CONCRETE GIRDERS WILL BE FURNISHED BY OTHERS**

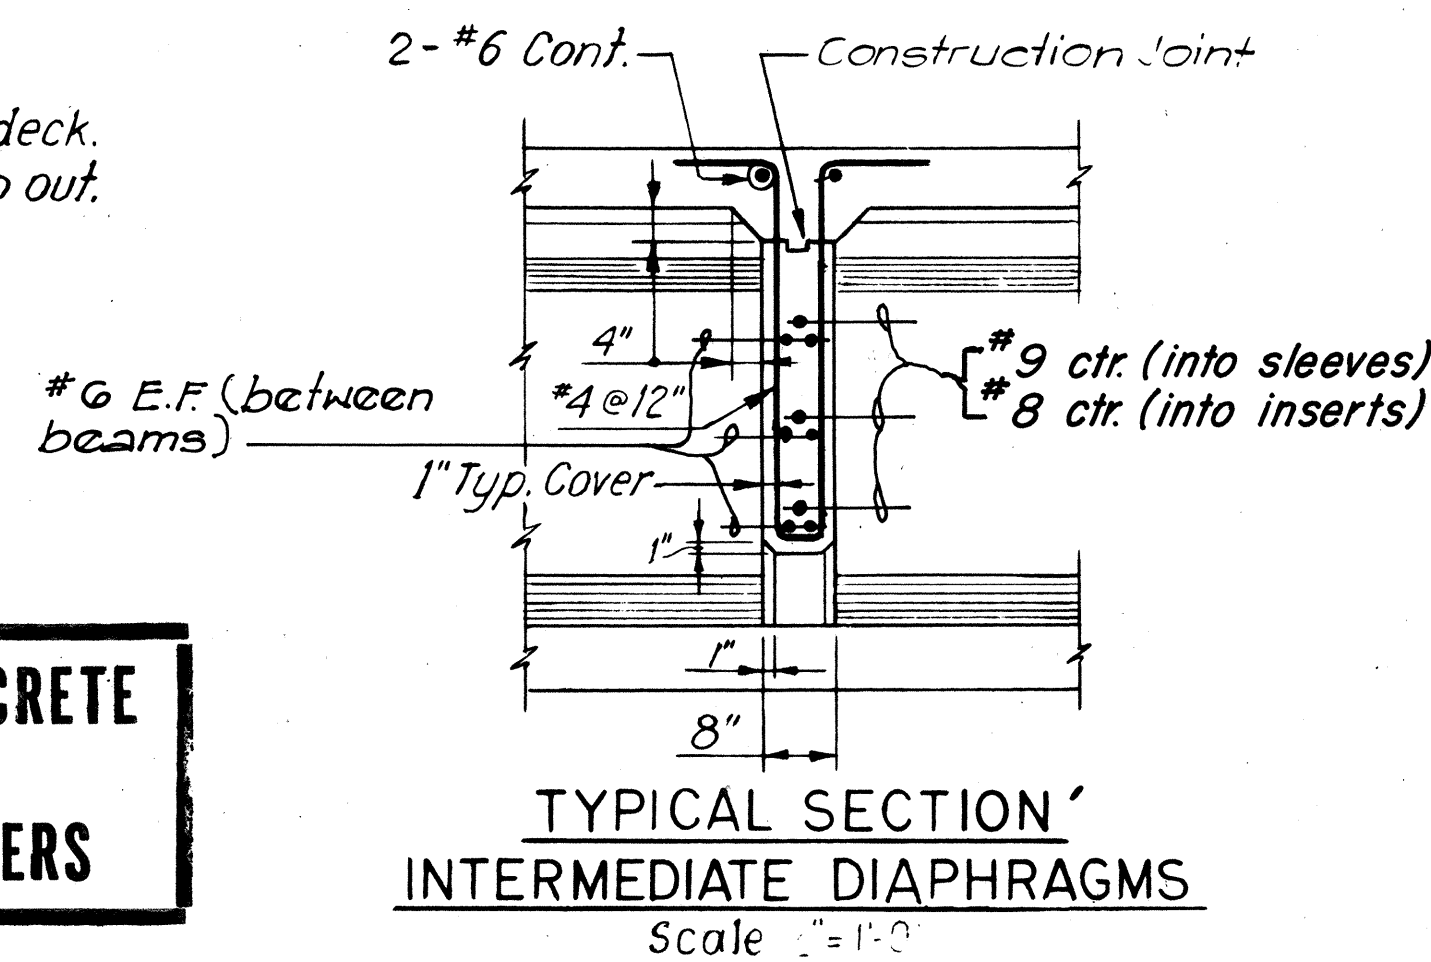

**NOTE:**

Diaphragm bars through sleeve or threaded into inserts shall be paid under. Reinforcing steel in bridges.

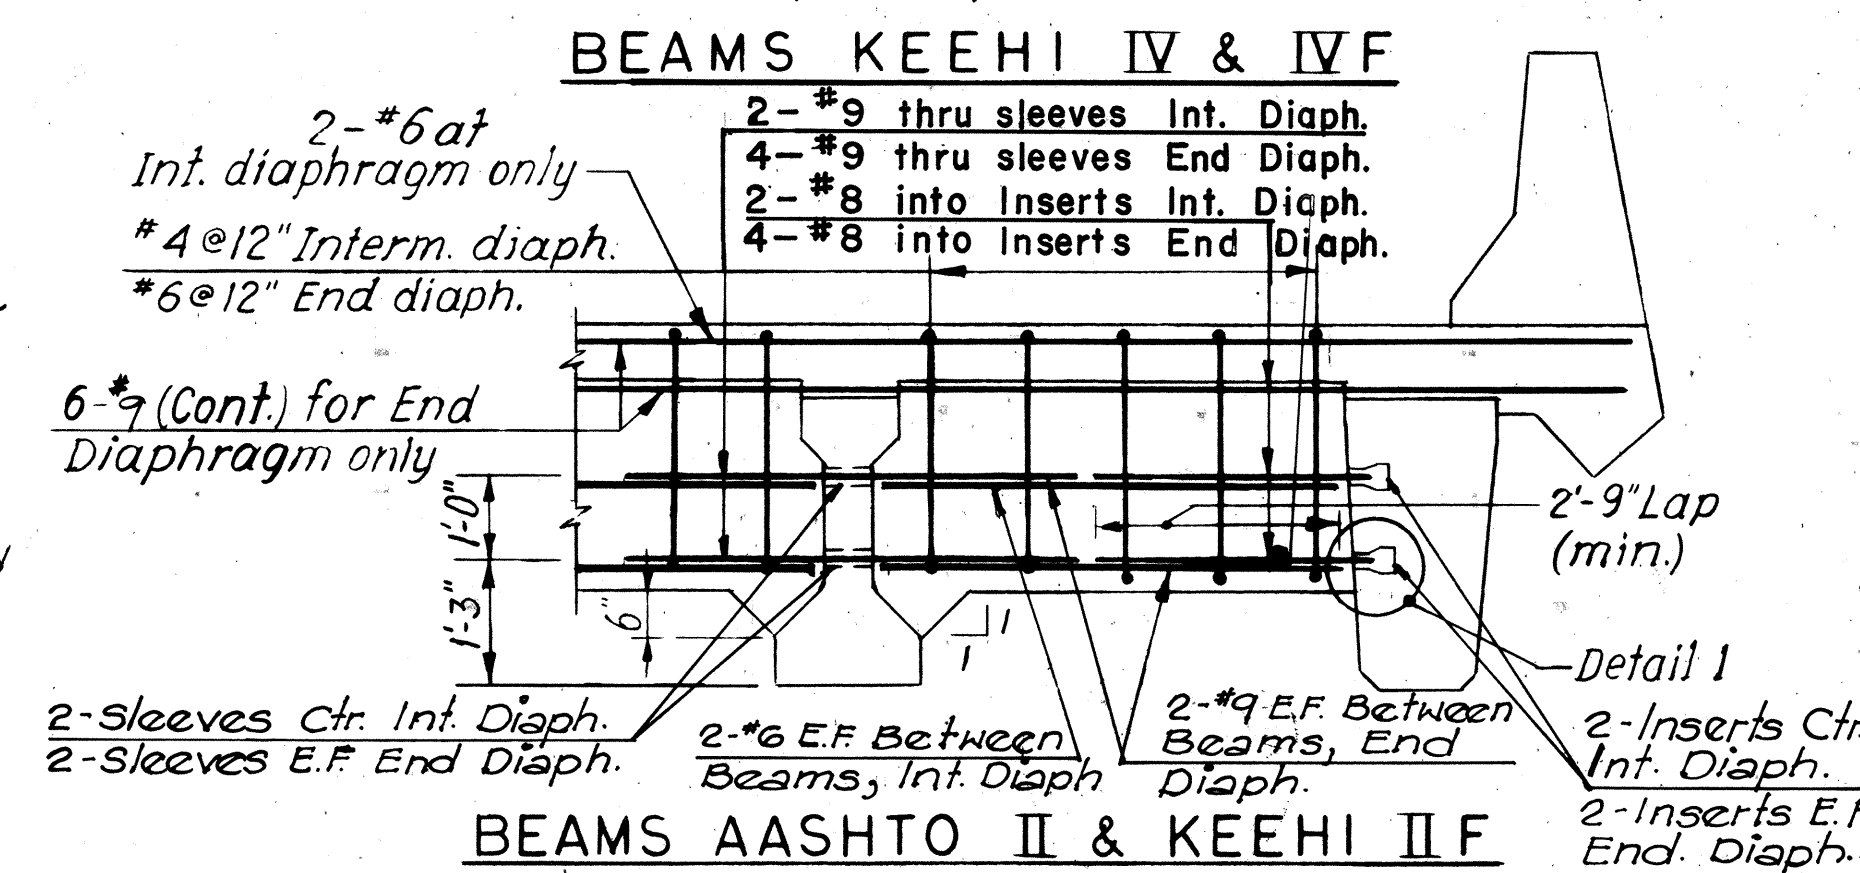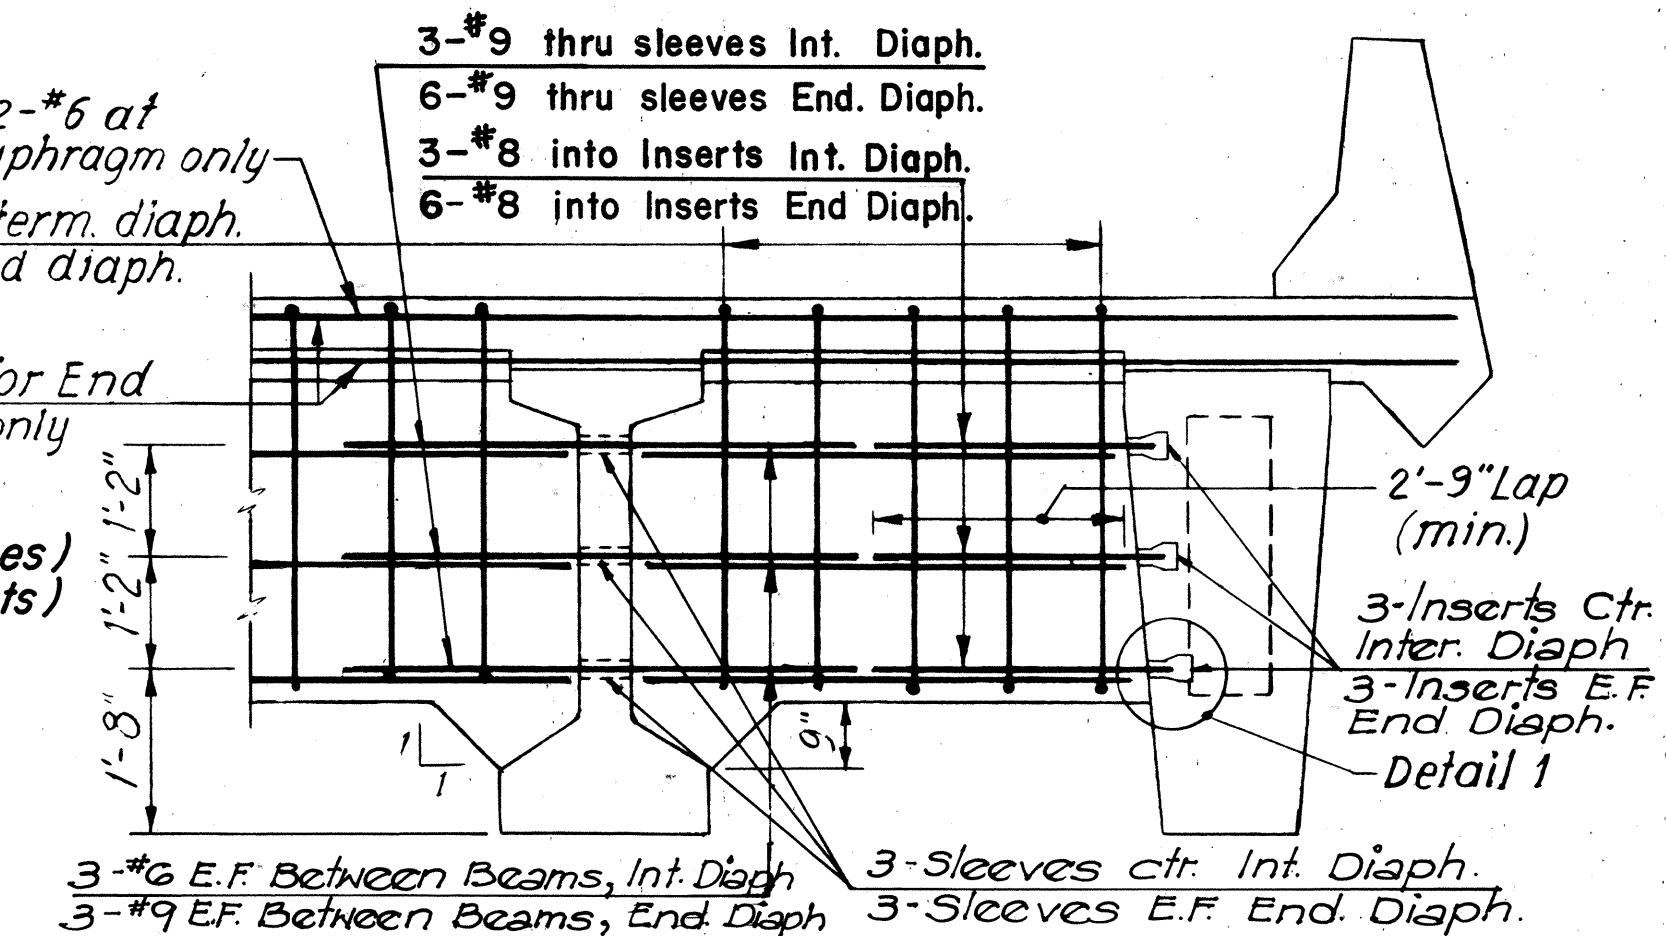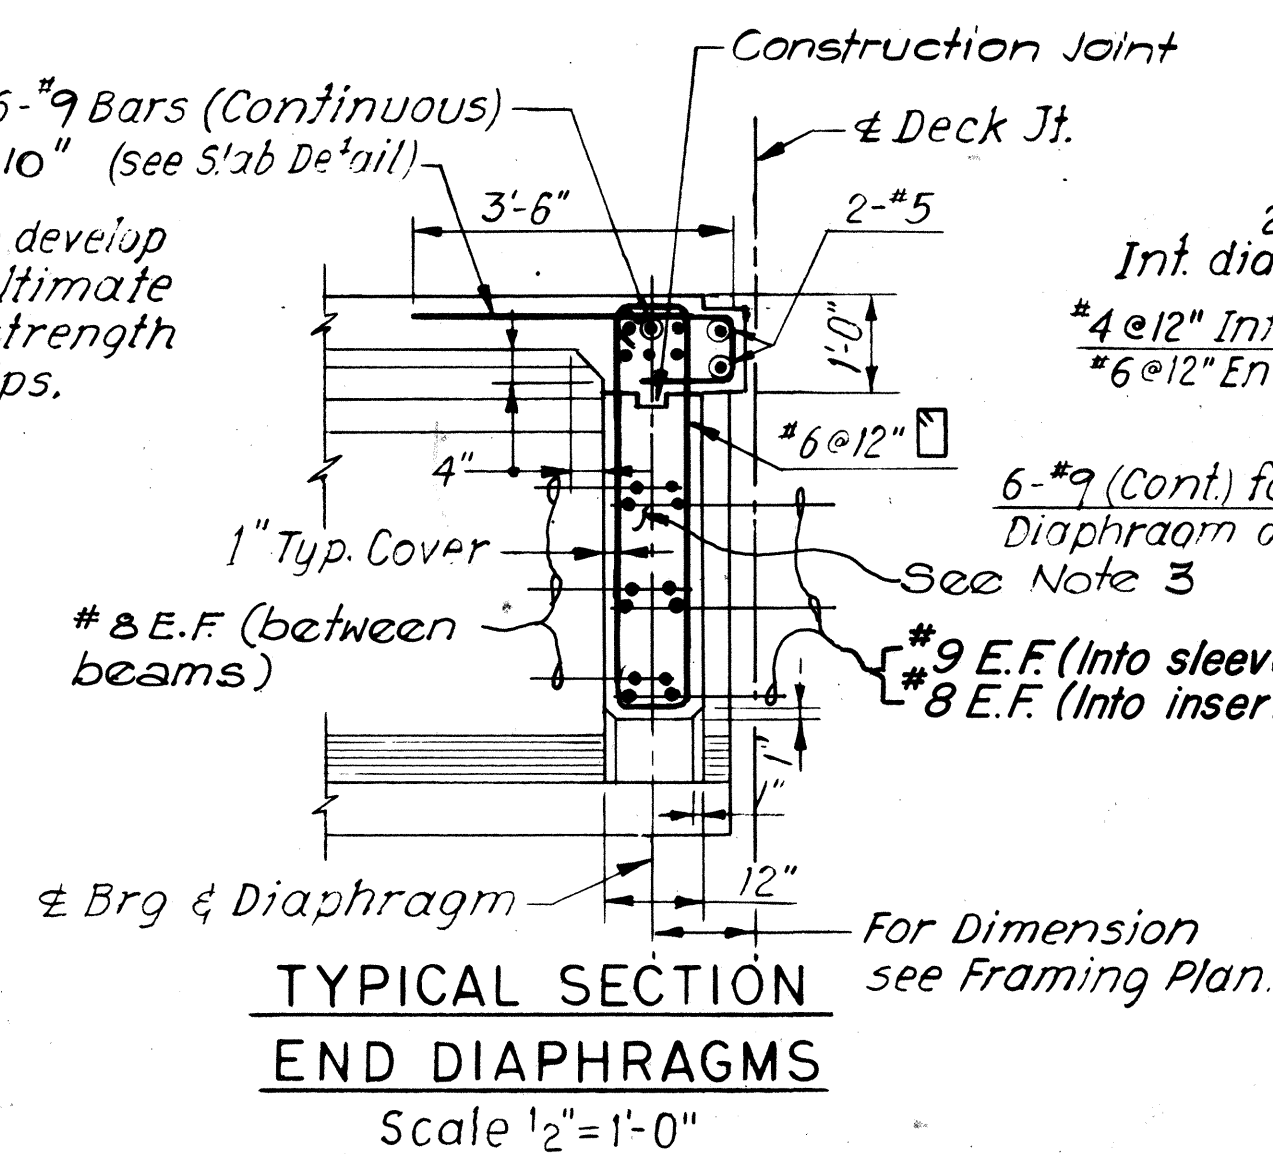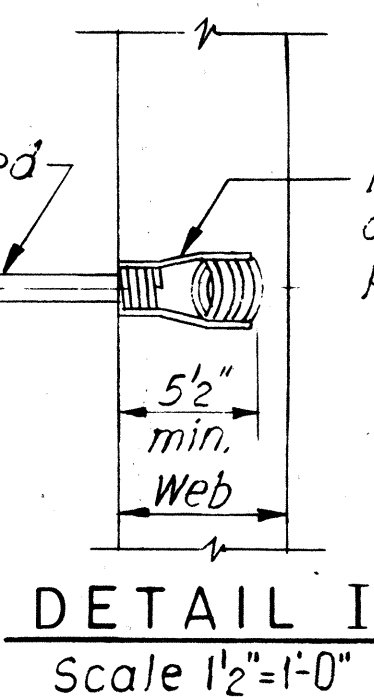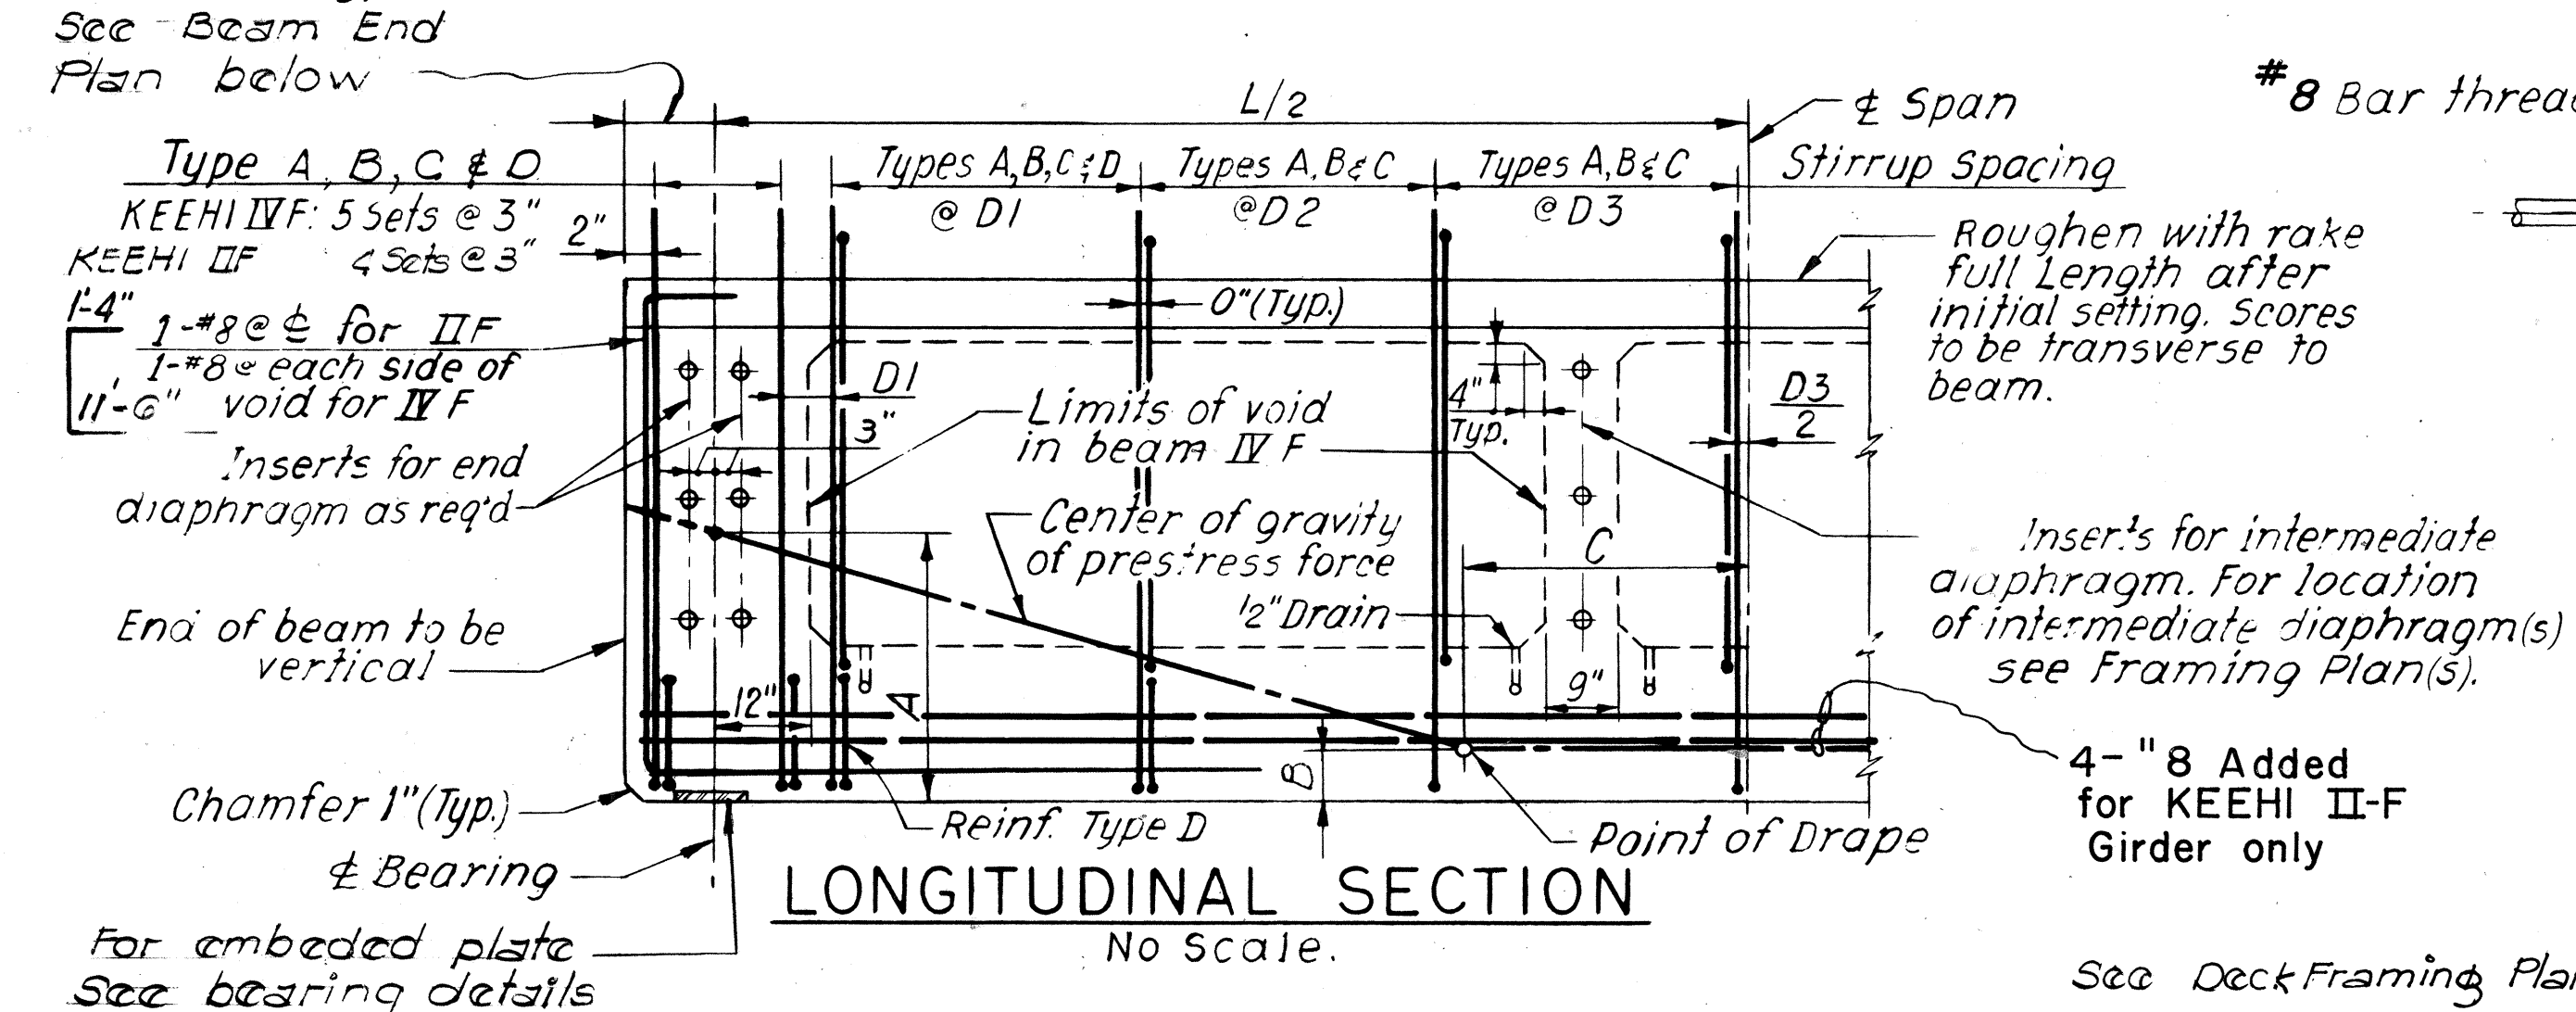


**NOTES:**

- For Prestress Notes and Camber Diagram See Sht. No. 5-44.
- Intermediate and End Diaphragms shall be Class A concrete.
- Apply epoxy bonding compound to contact area on inside face of fascia beams before placing end diaphragm concrete. Epoxy bonding compound incidental to concrete in bridges.
- Bars in sleeves shall be grouted in place before pouring the diaphragms.
- Inserts and sleeves are incidental to prestressed concrete beam.

**TYPICAL INTERMEDIATE AND END DIAPHRAGMS**

Scale: 1/2" = 1'-0"

**BEAM END PLAN**


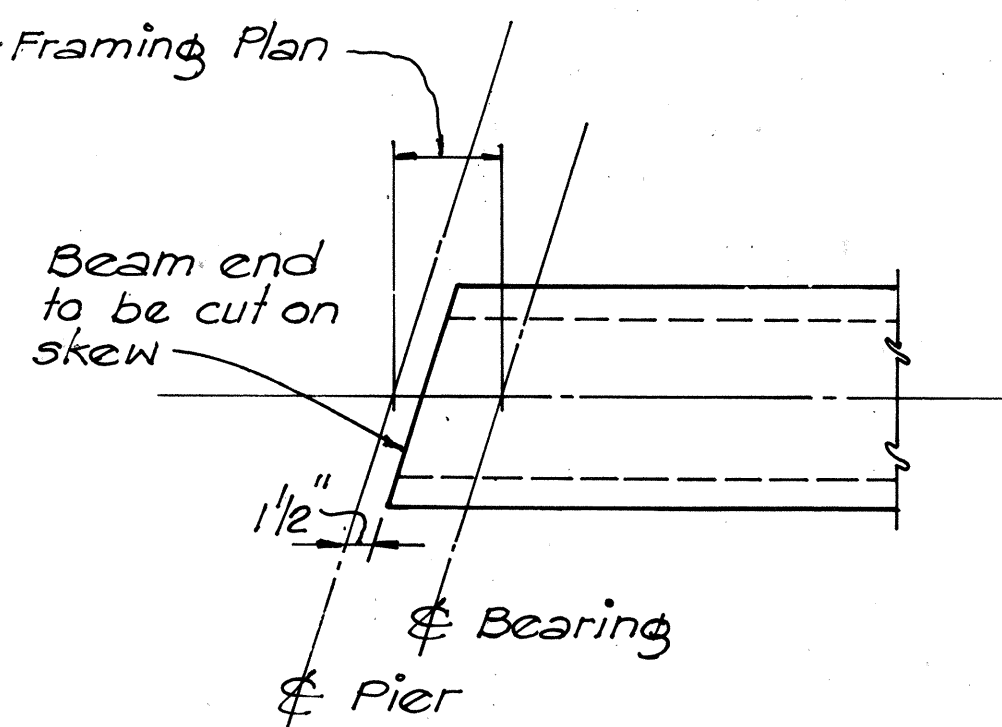


**BEAM SCHEDULE**

| BEAM TYPE | INITIAL* PRESTRESS FORCE (KIPS) | WORKING FORCE (KIPS) | CALCULATED CAMBER SEE NOTE 4 | DEAD LOAD DEFLECTION SEE NOTE 5 | LOCATION OF CENTER OF GRAVITY OF PRESTRESS FORCE |         |                         | STIRRUPS                     |                              |            | REQUIRED MIN. ULT. CONC. STRENGTH BEFORE RELEASE OF STRANDS (PSI) | REMARKS               |
|-----------|---------------------------------|----------------------|------------------------------|---------------------------------|--------------------------------------------------|---------|-------------------------|------------------------------|------------------------------|------------|-------------------------------------------------------------------|-----------------------|
|           |                                 |                      |                              |                                 | DIST. A                                          | DIST. B | DIST. TO PT. OF DRAPE C | NO. OF STIRRUPS @ SPACING D1 | NO. OF STIRRUPS @ SPACING D2 | SPACING D3 |                                                                   |                       |
| IVF-A     | 1402                            | 1085                 | -1 3/8"                      | 7/16"                           | 1'-9"                                            | 7 3/4"  | 10'-0"                  | 9 @ 15"                      | 10 @ 18"                     | 18"        | 4600                                                              | G-10A7 Release @ 4800 |
| IVF-B     | 1153                            | 896                  | -1"                          | 5/16"                           | 1'-10"                                           | 7"      | 9'-6"                   | 9 @ 15"                      | 10 @ 18"                     | 18"        | 4500                                                              |                       |
| IVF-D     | 1524                            | 1179                 | -1 5/8"                      | 7/8"                            | 1'-8"                                            | 8 1/4"  | 10'-0"                  | 15 @ 12"                     | 12 @ 15"                     | 18"        | 5000                                                              |                       |
| IIF-A     | 792                             | 613                  | -5/8"                        | 1/4"                            | 1'-4"                                            | 9 1/4"  | 5'-6"                   | 24 @ 6"                      | 12 @ 10"                     | 15"        | 4300                                                              |                       |

\* Before any losses

DATE: \_\_\_\_\_  
SURVEY PLOTTED BY: \_\_\_\_\_  
DRAWN BY: \_\_\_\_\_  
CHECKED BY: \_\_\_\_\_  
NOTE BOOK NO. \_\_\_\_\_

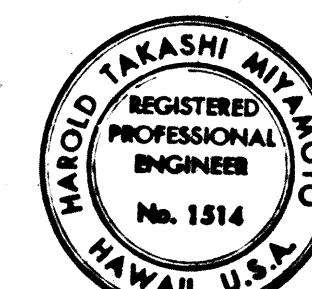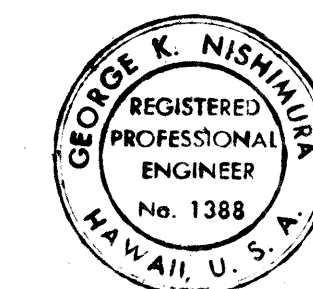

STATE OF HAWAII  
DEPARTMENT OF TRANSPORTATION  
HIGHWAYS DIVISION  
**NIMITZ CONNECTOR (EB)**  
**RAMP "A" AND RAMP "B"**  
**PRESTRESS BEAM DETAILS**  
SHEET 2 OF


KEEHI INTERCHANGE  
F.A.I. PROJECT NO. 1-HI-1(168)17  
SCALE: \_\_\_\_\_ DATE: JULY, 1981

SHEET No. 545 OF 49 SHEETS

ADD. 127



| FED. ROAD DIST. NO. | STATE | FED. AID PROJ. NO. | FISCAL YEAR | SHEET NO. | TOTAL SHEETS |
|---------------------|-------|--------------------|-------------|-----------|--------------|
| HAWAII              | HAW.  | 1-HI-1(168)17      | 1982        | 128       | 145          |


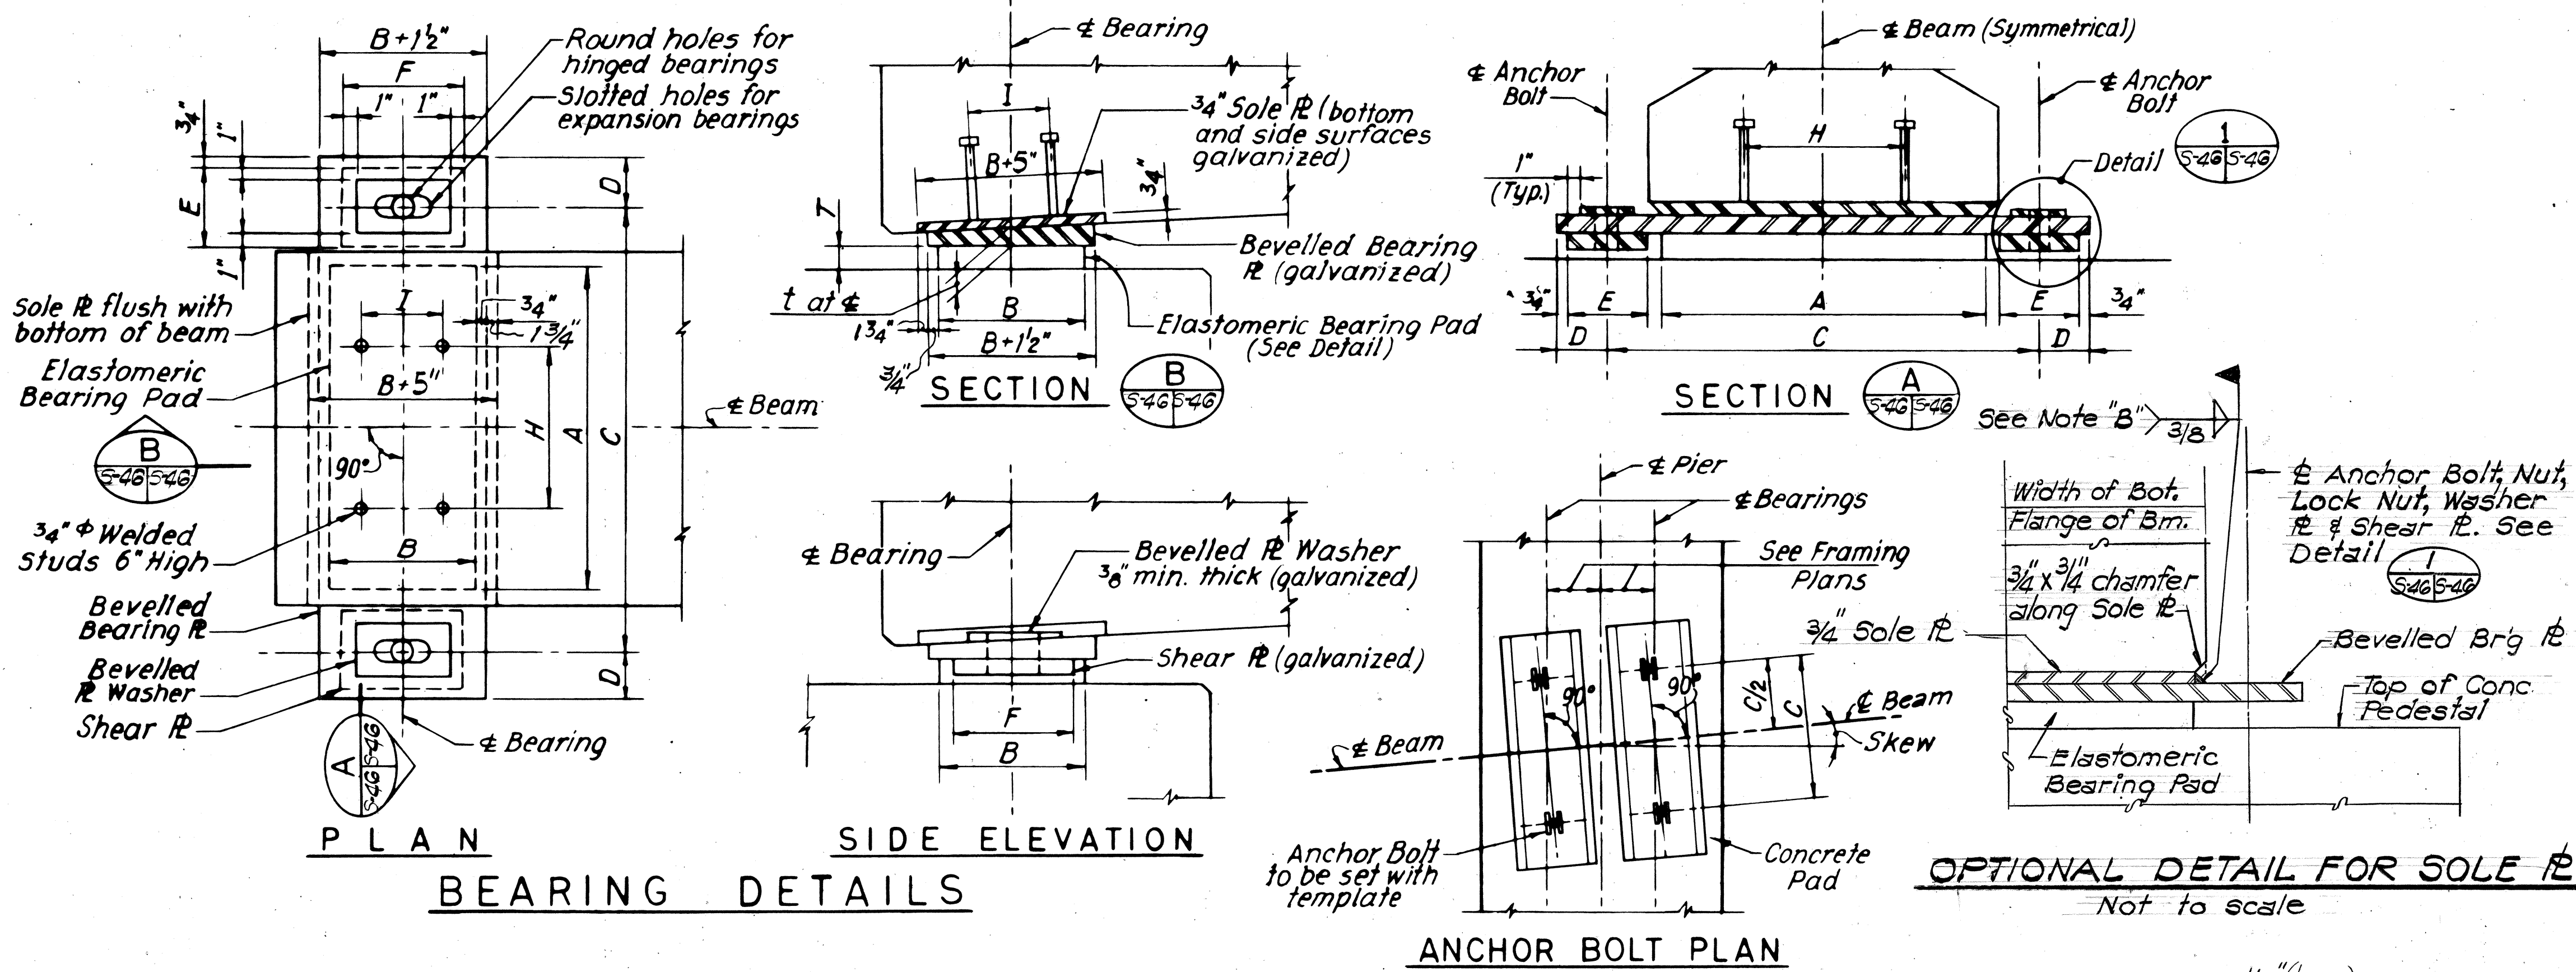


**NOTE: "A"**

At his option the Contractor may use bearing plates of uniform thickness,  $t$ , specified on the Beam Table Sht. No. S-43, instead of beveled bearing plates, where the bevels  $1/4":12$  or less. In these instances, the concrete seats shall be bevelled to compensate for the bearing plates being of uniform thickness.

**NOTE: B**

The Contractor shall minimize and dissipate the heat generated during the field welding of the  $3/4"$  sole plate to the bevelled bearing plate and during the field galvanizing of the weld. The Contractor shall take all necessary precautions to avoid burning the elastomeric bearing pad during welding and galvanizing. Welding of the sole plate to the bearing plate shall be done prior to the pouring of diaphragm and deck. Temporary wooden shims ( $A \times B \times 3/4$  min. thickness) shall be placed between the beveled bearing plates and the elastomeric bearing pads during field welding and galvanizing. Shims shall be removed.

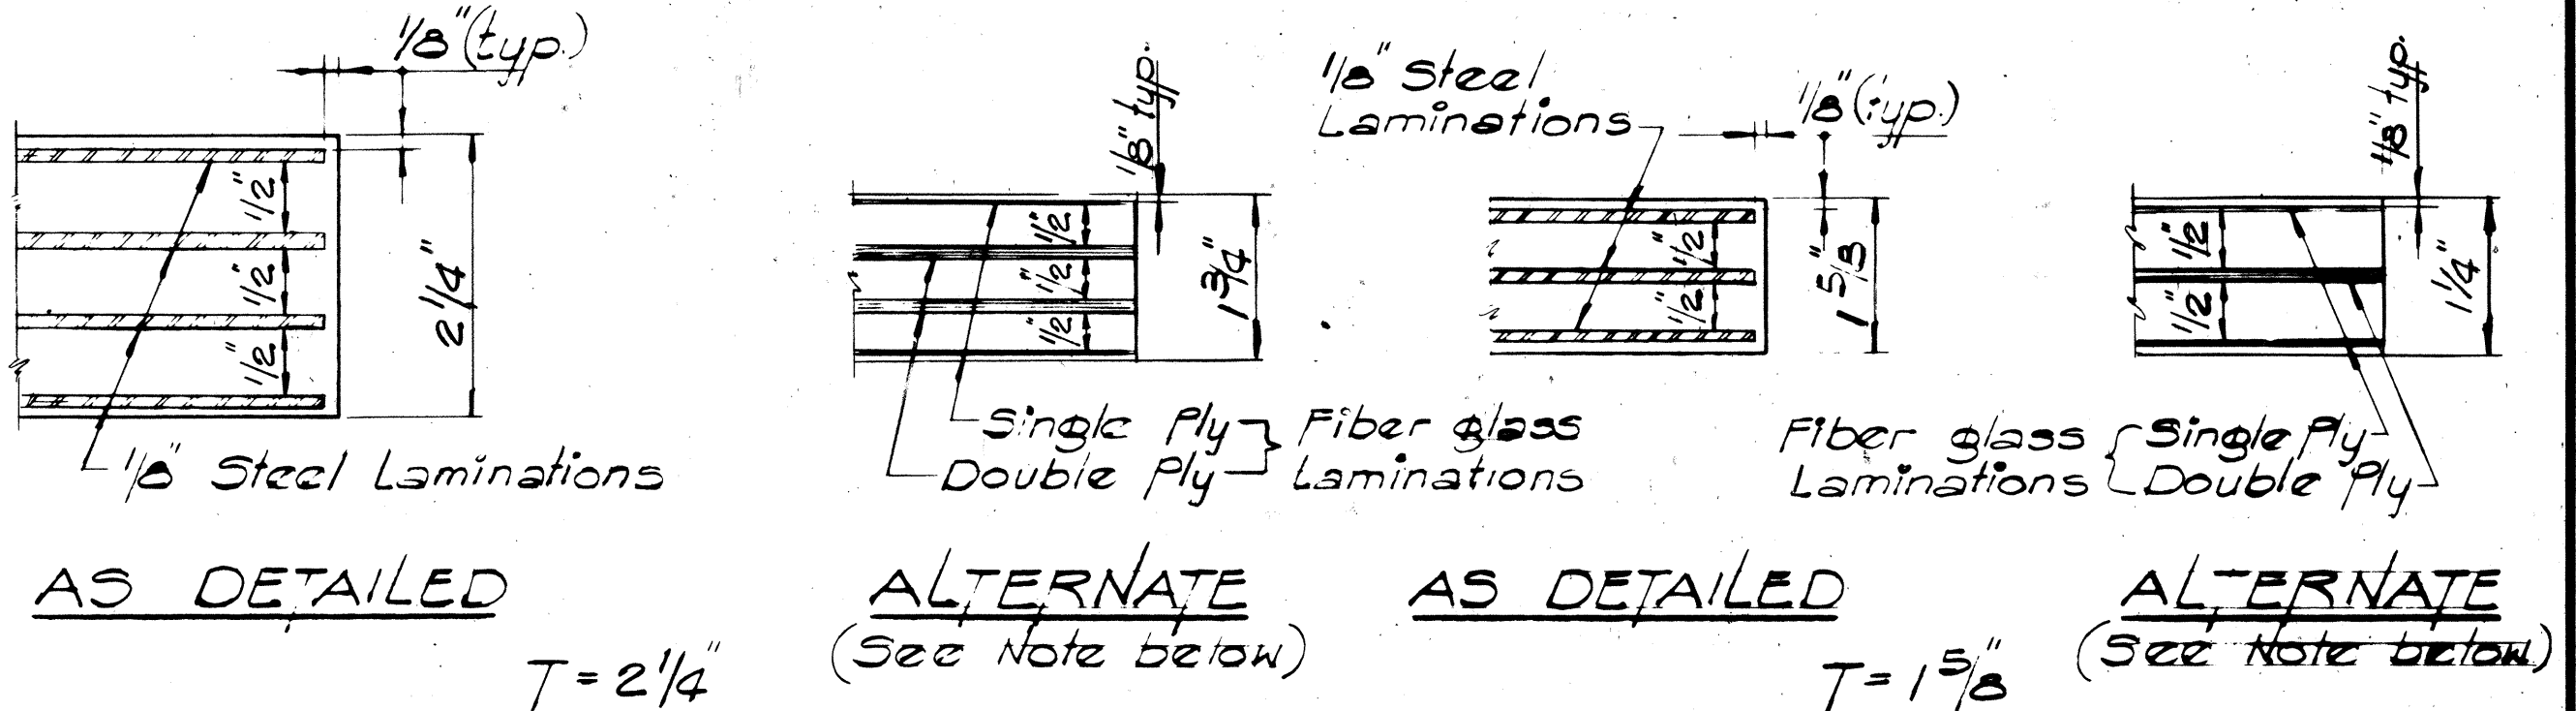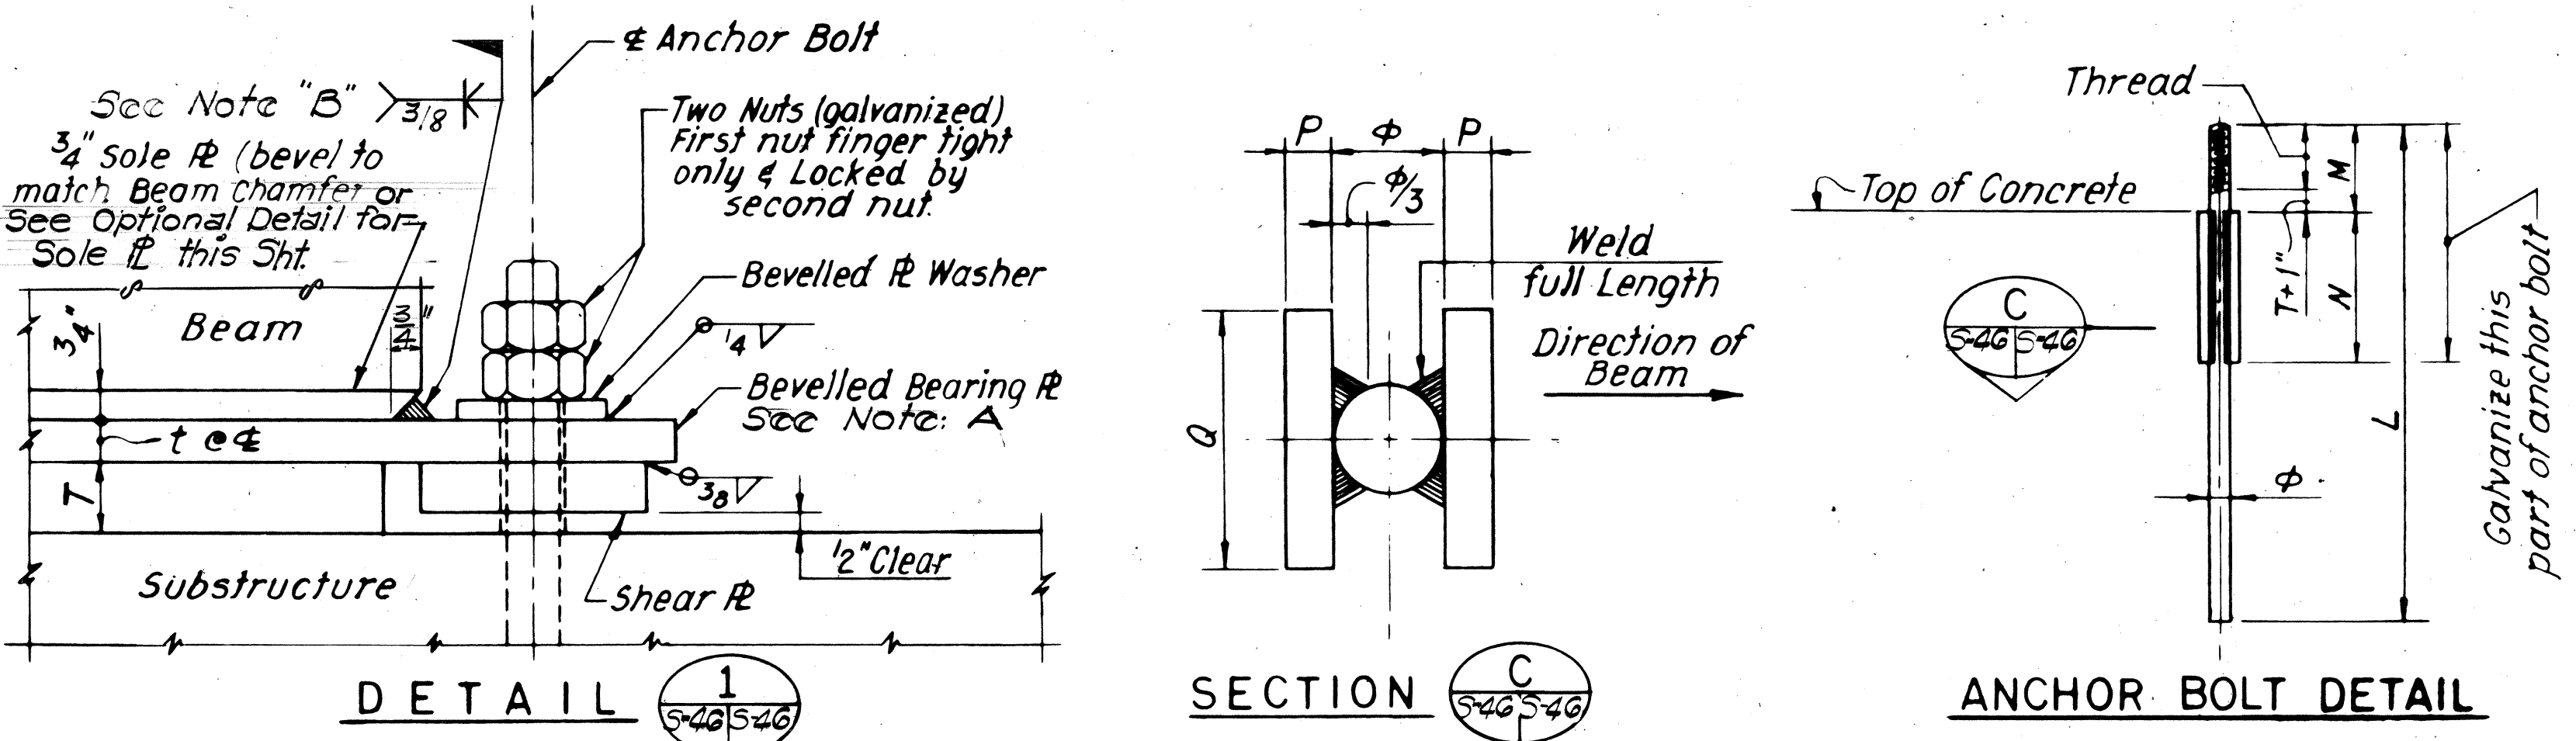

- NOTES:**
- Elastomeric Bearing Pads, Anchor bolts and bevelled bearing Pl's are incidental to Concrete in bridges. Sole Pl's welded studs are incidental to beams.
  - Durometer hardness of elastomeric pad shall be  $60 \pm 5$ .

**FIBER GLASS LAMINATED PADS**

All bearing seat elevations (Denoted also as bush hammer or pad elevations) are based on steel laminated elastomeric bearing pads. If the contractor elects to use fiber glass laminated elastomeric pads, instead of steel laminated elastomeric pads, he shall comply with the following requirements.

a. The fiber glass laminated elastomeric pads shall comply with the details shown on the plans and the requirements of the Special Provisions.


b. Appropriate revisions shall be made to the bearing seat elevations and shear Pl thickness to reflect the reduction in thickness for the fiber glass laminated bearing pads. Any such revision shall be approved by the Engineer.

| BEARING AND ANCHOR BOLT TABLE |                            |     |        |                     |        |    |     |                           |                 |    |                      |               |                |        |     |                  |        |        |
|-------------------------------|----------------------------|-----|--------|---------------------|--------|----|-----|---------------------------|-----------------|----|----------------------|---------------|----------------|--------|-----|------------------|--------|--------|
| BEARING<br>TYPE               | ELASTOMERIC<br>BEARING PAD |     |        | STEEL<br>DIMENSIONS |        |    |     |                           | STUD<br>SPACING |    | ANCHOR<br>BOLT HOLES |               | ANCHOR<br>BOLT |        |     | ANCHOR<br>PLATES |        |        |
|                               | A                          | B   | T      | C                   | D      | E  | F   | t                         | H               | I  | HINGED<br>BRGS.      | EXP.<br>BRGS. | Φ              | L      | M   | N                | Q      | P      |
| 1H                            | 16"                        | 8"  | 1 5/8" | 24"                 | 3 3/4" | 6" | 8"  | Table                     | 10"             | 6" | 1 1/2" Φ             |               | 1 1/4"         | 32"    | 8"  | 6"               | 3"     | 1/2"   |
| 1E                            | 16"                        | 8"  | 1 5/8" | 24"                 | 3 3/4" | 6" | 8"  |                           | 10"             | 6" |                      | 1 1/2" x 4"   |                | 1 1/4" | 32" | 8"               | 6"     | 3"     |
| 2H                            | 12"                        | 8"  | 1 5/8" | 20"                 | 3 3/4" | 6" | 8"  | Table                     | 8"              | 6" | 1 1/2" Φ             |               | 1 1/4"         | 32"    | 8"  | 6"               | 3"     | 1/2"   |
| 2E                            | 12"                        | 8"  | 1 5/8" | 20"                 | 3 3/4" | 6" | 8"  |                           | 8"              | 6" |                      | 1 1/2" x 4"   |                | 1 1/4" | 32" | 8"               | 6"     | 3"     |
| 3H                            | 24"                        | 8"  | 1 5/8" | 32"                 | 3 3/4" | 6" | 8"  | Sec<br>Beam<br>on<br>Chf. | 12"             | 6" | 1 3/4" Φ             |               | 1 1/2"         | 33"    | 9"  | 8"               | 4"     | 5/8"   |
| 3E                            | 24"                        | 8"  | 1 5/8" | 32"                 | 3 3/4" | 6" | 8"  |                           | 12"             | 6" |                      | 1 3/4" x 4"   |                | 1 1/2" | 33" | 9"               | 8"     | 4"     |
| 4H                            | 19"                        | 12" | 1 5/8" | 27"                 | 3 3/4" | 6" | 8"  | Sec<br>Beam<br>on<br>Chf. | 8"              | 6" | 2" Φ                 |               | 1 3/4"         | 39"    | 9"  | 8"               | 4 1/2" | 5/8"   |
| 4E                            | 19"                        | 12" | 1 5/8" | 27"                 | 3 3/4" | 6" | 8"  |                           | 8"              | 6" |                      | 2" x 4"       |                | 1 3/4" | 39" | 9"               | 8"     | 4 1/2" |
| 5H                            | 24"                        | 14" | 2 1/4" | 33"                 | 4 1/4" | 7" | 10" |                           | 12"             | 9" | 2 1/4" Φ             | —             | 2"             | 45"    | 10" | 9"               | 5"     | 3/4"   |

STATE OF HAWAII  
DEPARTMENT OF TRANSPORTATION  
HIGHWAYS DIVISION  
**NIMITZ CONNECTOR (EB)**  
**RAMP "A" AND RAMP "B"**  
**BEARING DETAILS**  
KEEHI INTERCHANGE  
F.A.I. PROJ. NO. 1-HI-1(168)17  
SCALE: AS SHOWN  
DATE: JULY, 1981  
SHEET NO. S-46 OF 49 SHEETS




| FED. ROAD DIST. NO. | STATE | FED. AID PROJ. NO. | FISCAL YEAR | SHEET NO. | TOTAL SHEETS |
|---------------------|-------|--------------------|-------------|-----------|--------------|
| HAWAII              | HAW.  | 1-HI-1(68)17       | 1982        | 129       | 145          |

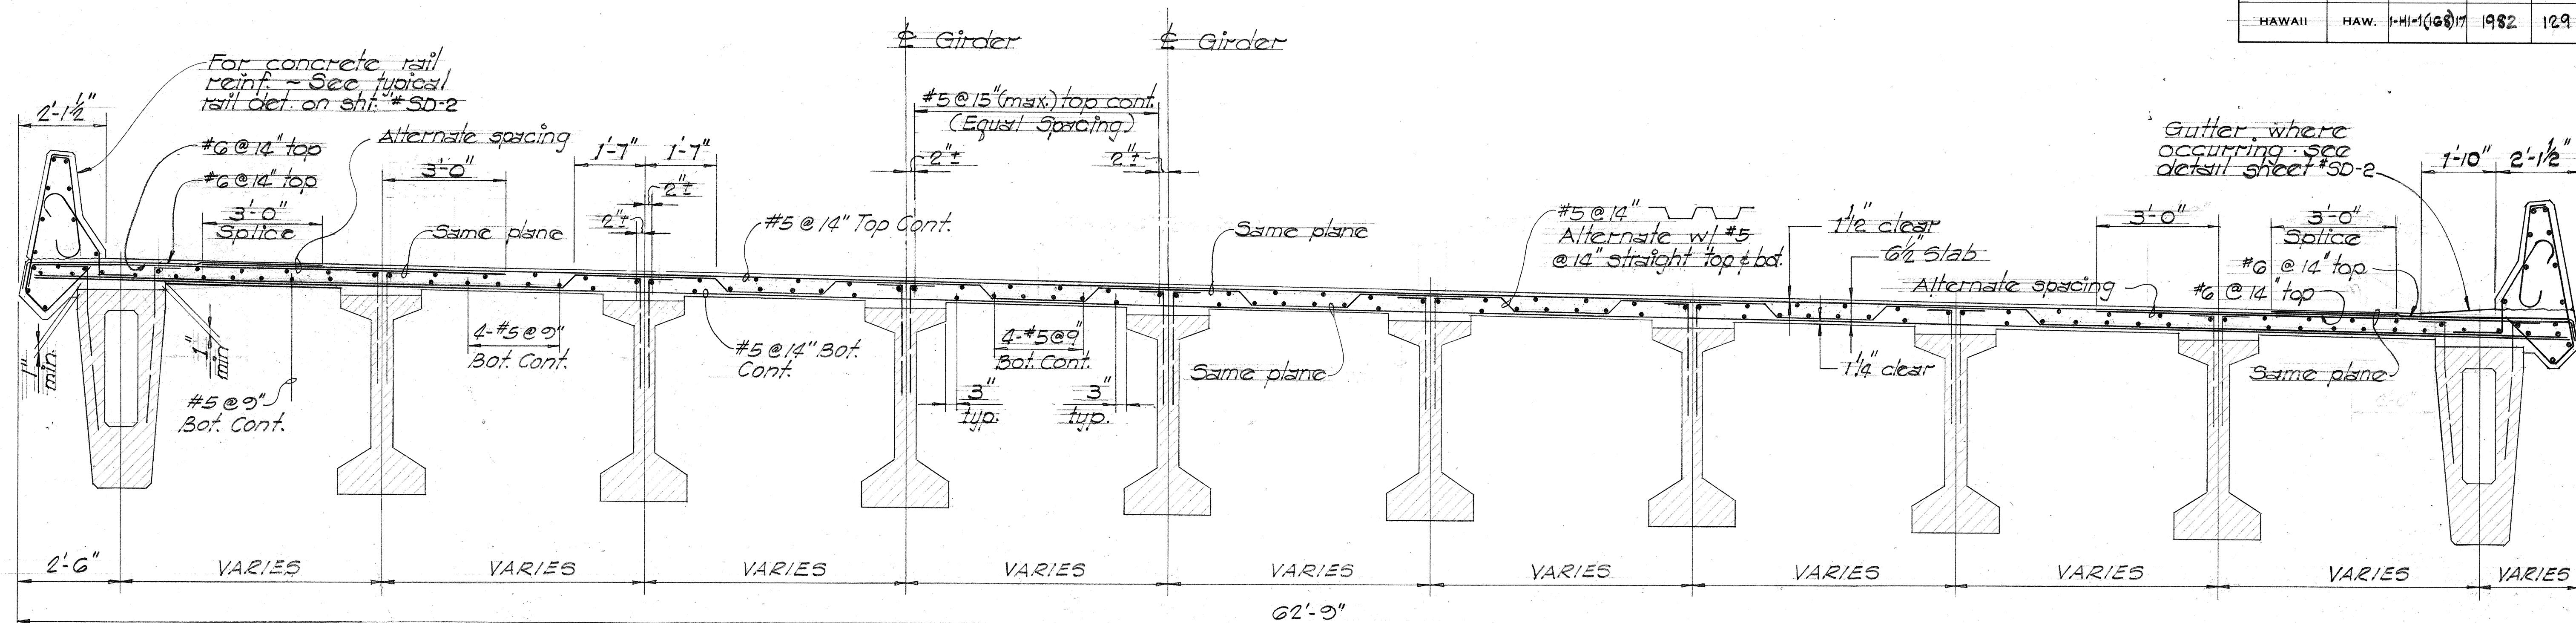


**NORMAL DECK SECTION**  
**NIMITZ CONNECTOR (EB)**  
 (FROM STA. 22+94 TO STA. 30+94.36)  
 LOOKING TOWARDS INCREASING STATIONS  
 Scale: 1/2" = 1'-0"

- NOTES**
1. In general all deck transverse bars shall be placed either radially or normal to the baseline. All transverse bars that are placed radially to the baseline shall be spaced as indicated on plans, measured along the edge of deck with the maximum curve length.
  2. For additional reinforcing at deck drains - See detail sheet #SD-9.
  3. See deck framing plans for girder spacing sheets #S-31 & S-32.
  4. Deck slab shall be Class BD concrete.

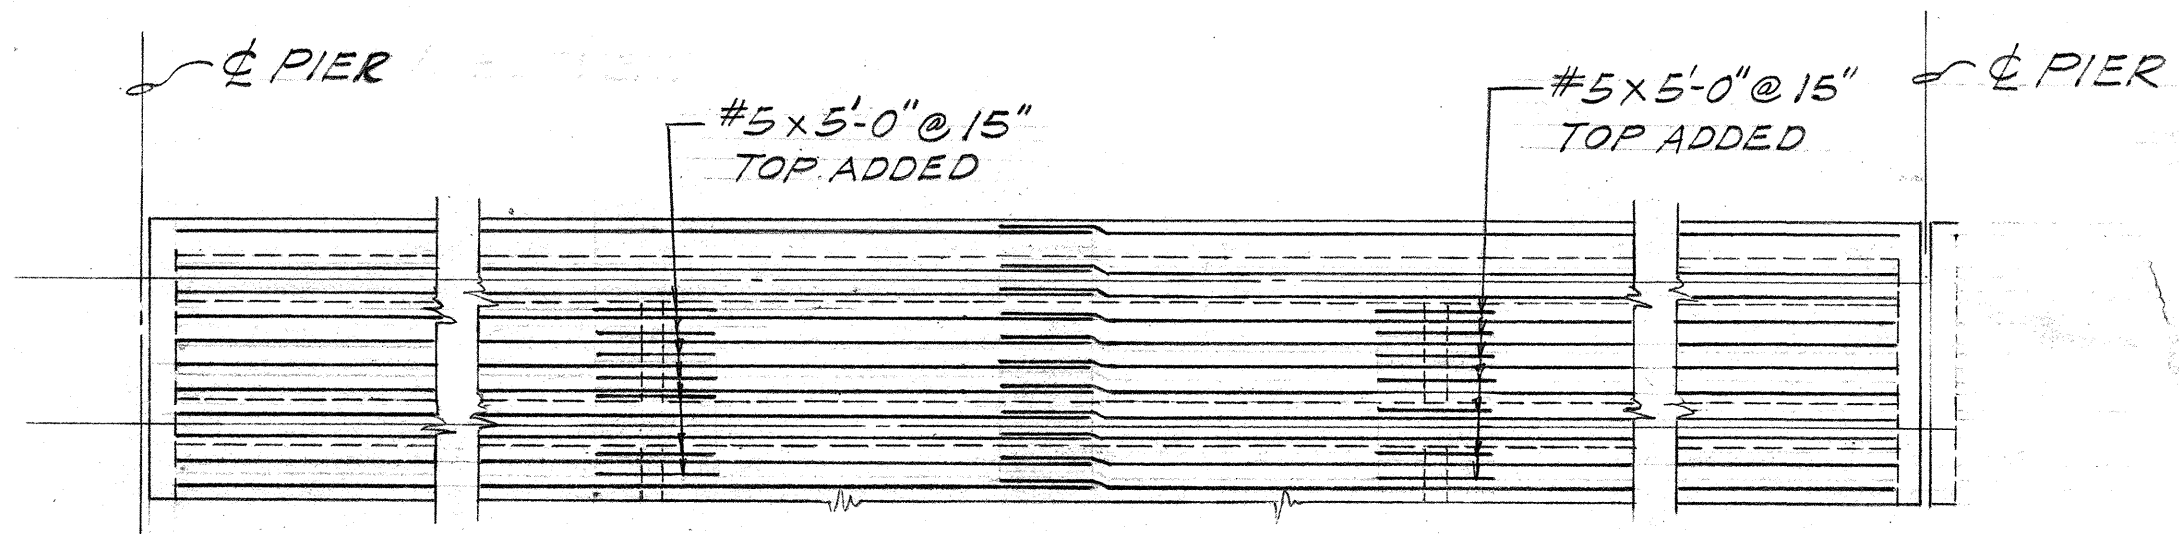


**EXTERIOR SPAN-TYPE II GIRDER**

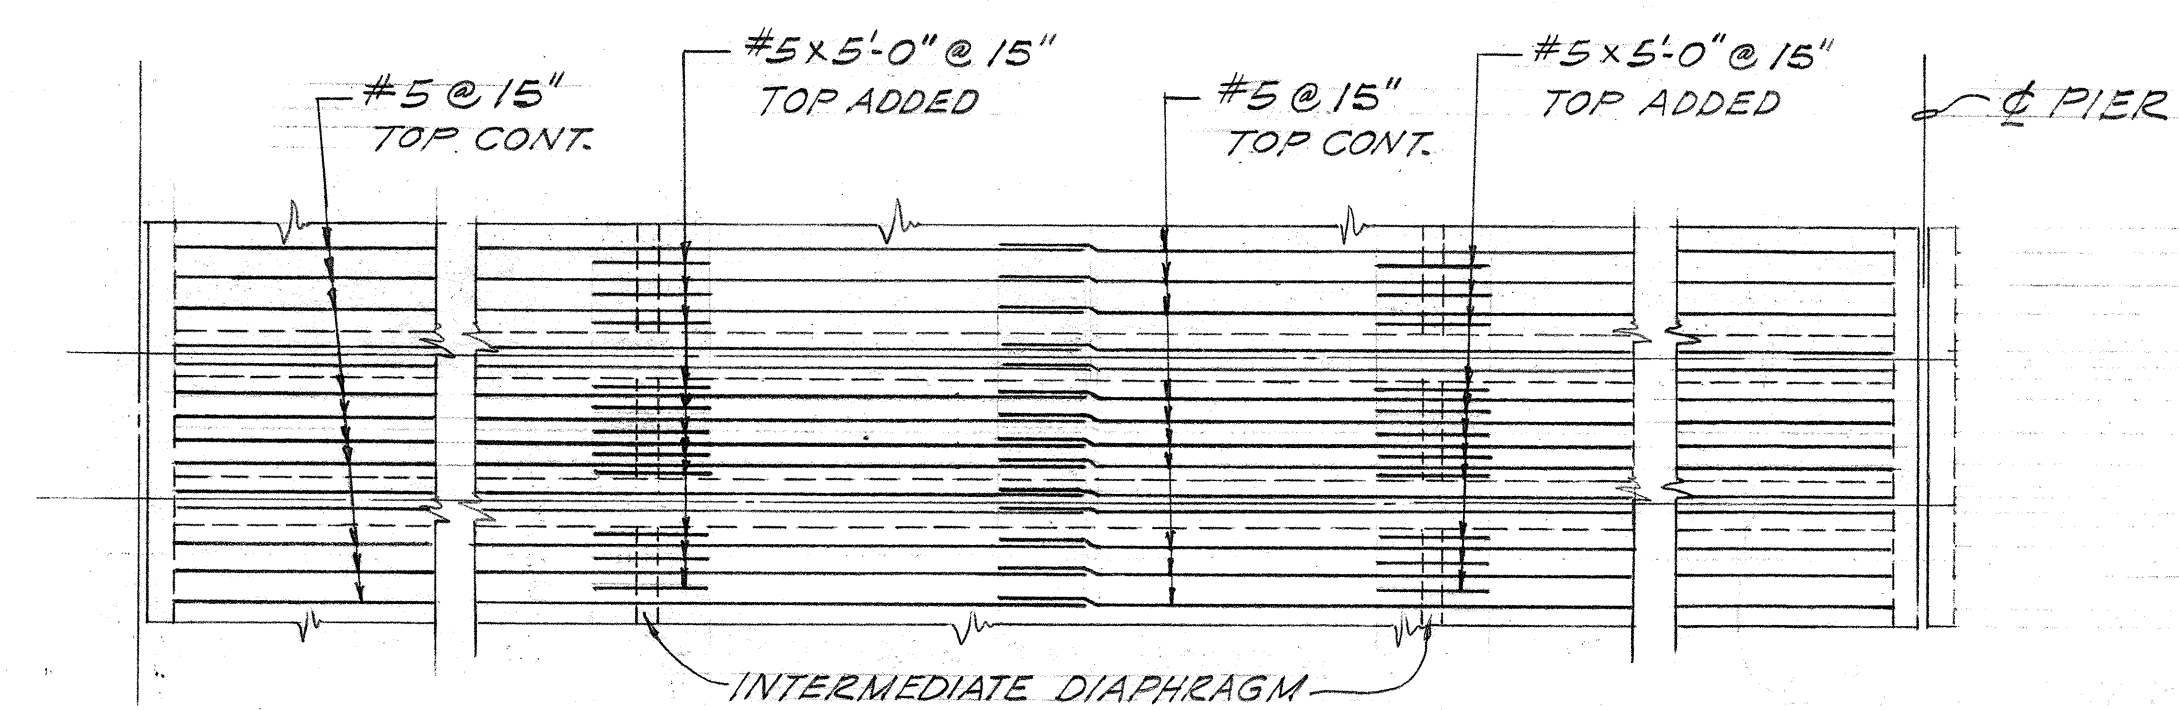


**INTERIOR SPAN-TYPE II GIRDER**

**TYPICAL ARRANGEMENT OF TOP REINFORCEMENT**  
 Scale: 1/8" = 1'-0"

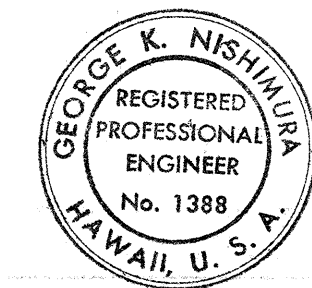

THIS WORK WAS PREPARED BY ME OR UNDER MY SUPERVISION

*George K. Nishimura*

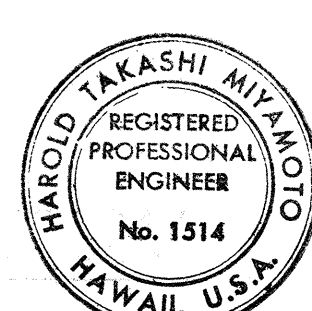

THIS WORK WAS PREPARED BY ME OR UNDER MY SUPERVISION

*Harold Takashi Miyamoto*

STATE OF HAWAII  
 DEPARTMENT OF TRANSPORTATION  
 HIGHWAYS DIVISION

**NIMITZ CONNECTOR (EB)**  
**RAMP "A" AND RAMP "B"**

TYPICAL DECK SECTION & TYPICAL DECK REINF.

KEEHI INTERCHANGE  
 F.A.I. PROJ. NO. 1 HI-1(68)17



SCALE: AS SHOWN DATE: JULY, 1981

SHEET NO. 5-47 OF 49 SHEETS

|                   |      |
|-------------------|------|
| SURVEY PLOTTED BY | DATE |
| DESIGNED BY       |      |
| TRACED BY         |      |
| NOTE BOOK         |      |
| QUANTITIES BY     |      |
| CHECKED BY        |      |
| NO.               |      |



| FED. ROAD DIST. NO. | STATE | FED. AID PROJ. NO. | FISCAL YEAR | SHEET NO. | TOTAL SHEETS |
|---------------------|-------|--------------------|-------------|-----------|--------------|
| HAWAII              | HAW.  | 1-H-1(68)17        | 1982        | 130       | 143          |

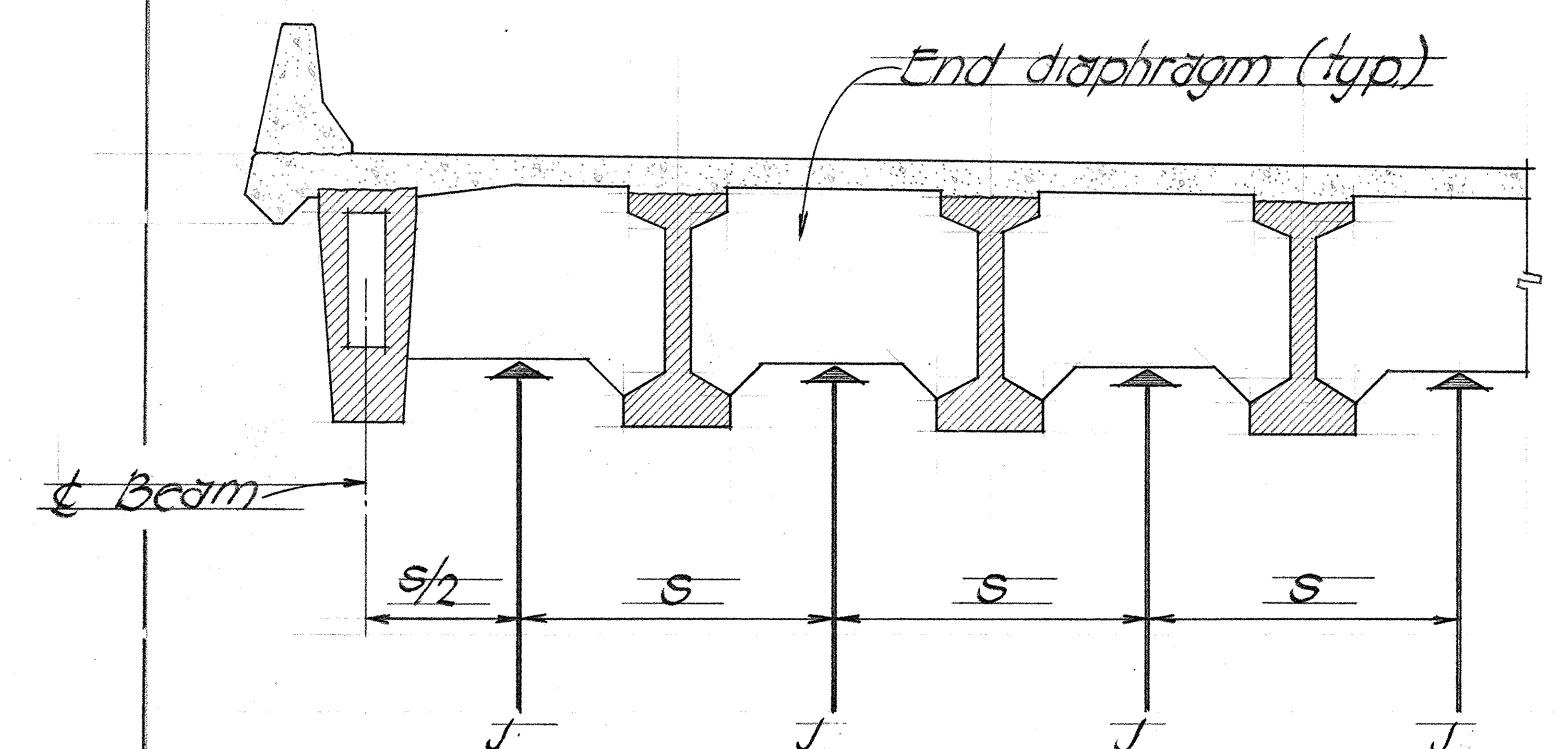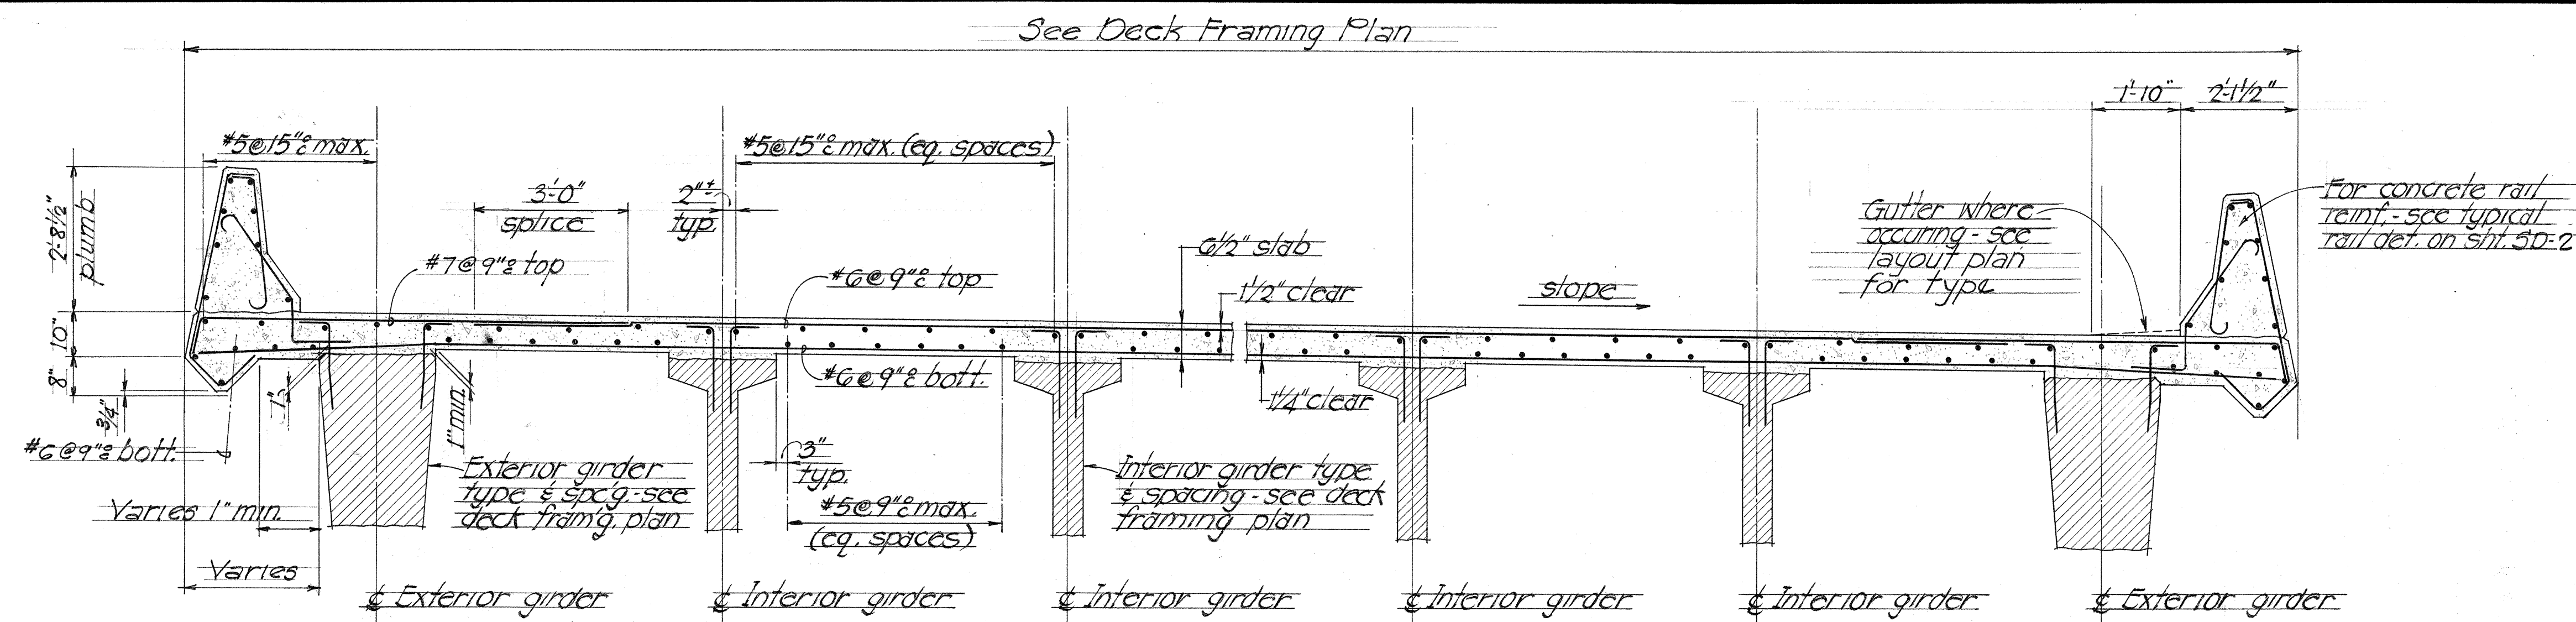

### FUTURE JACKING DIAGRAM

Scale: 1/4" = 1'-0" (NOT IN CONTRACT)

#### LEGEND


J Denotes jacking force  
S Denotes beam spacing

#### NOTE

Place jacks under the end diaphragms as shown in above diaphragms for any lifting of the superstructure.  
Future jacking diagram shown for reference only. Jacking is not in contract.



#### NOTES

- In general all deck transverse bars shall be placed either radially or normal to the baseline. All transverse bars that are placed radially to the baseline shall be spaced as indicated on plans, measured along the edge of deck with the maximum curve length.
- For additional reinforcing at deck scuppers see detail on sheet #5-41 and sheet #50-9.

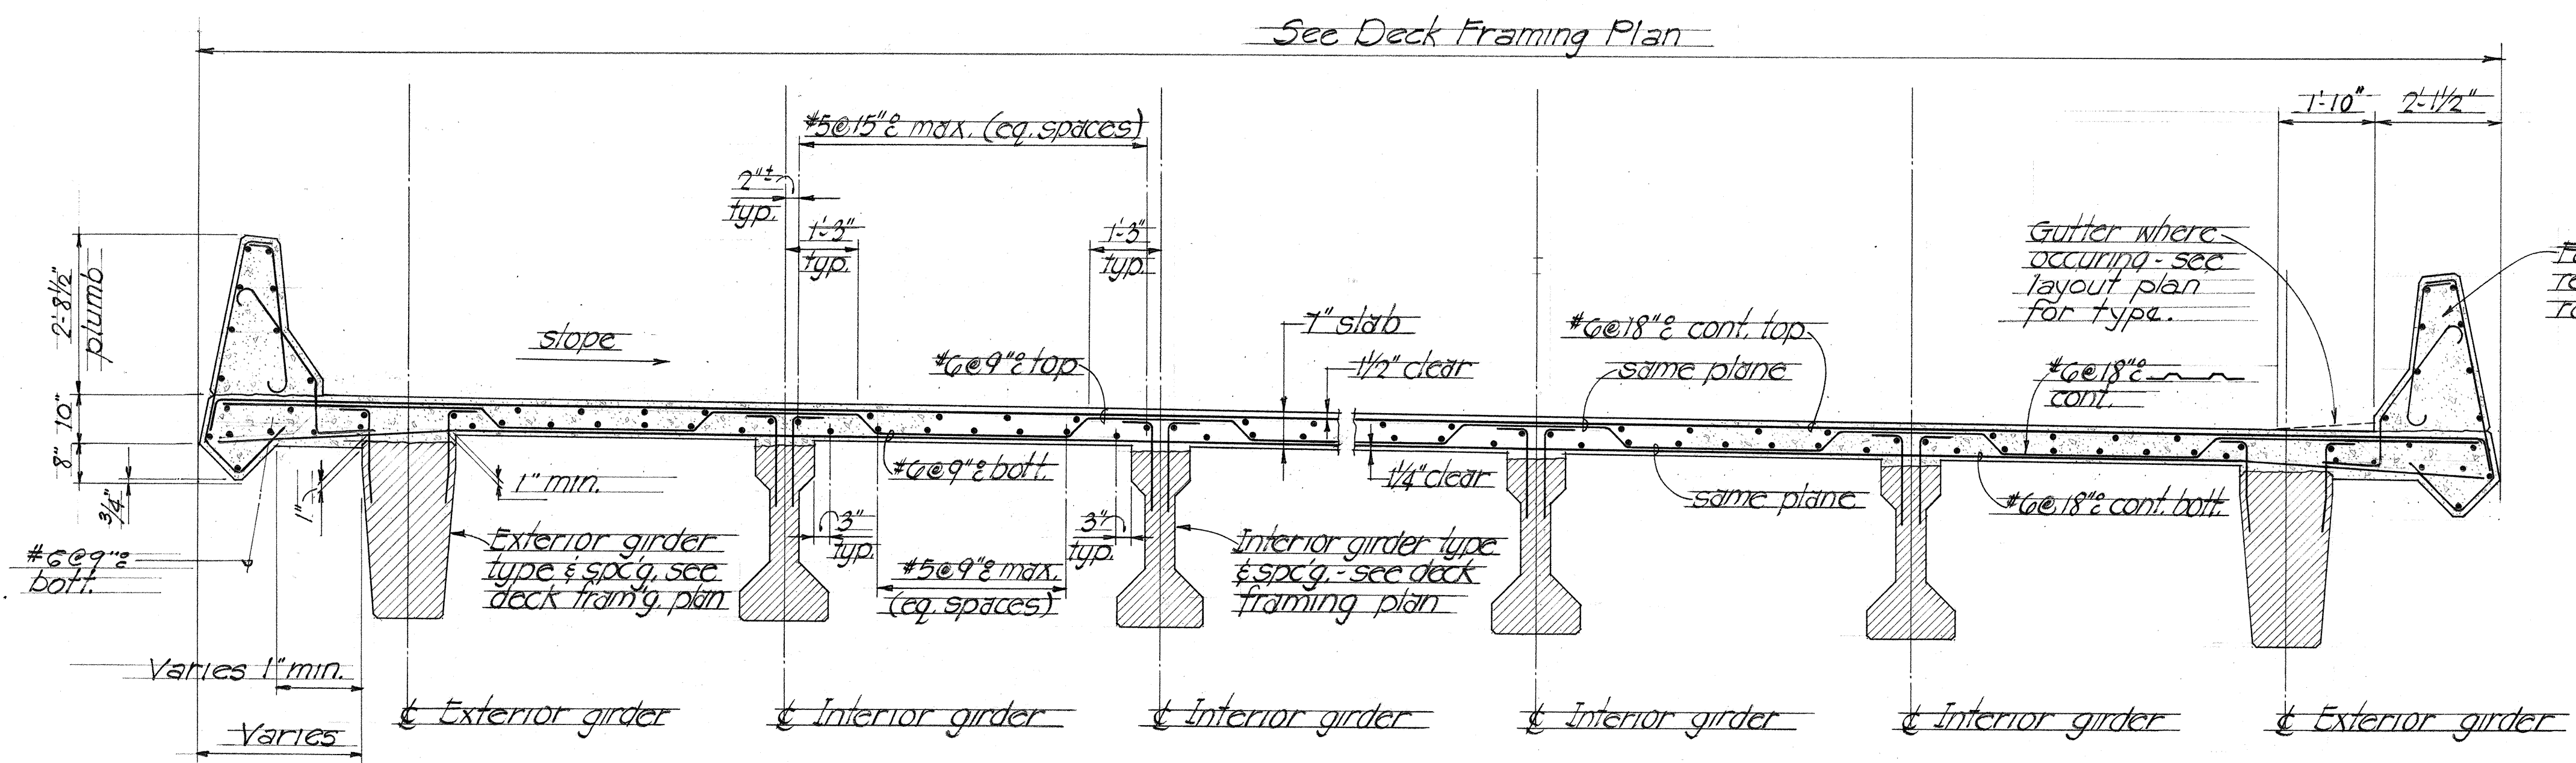

### TYPICAL DECK SECTION RAMP "A" STA. 14+55.2 THRU STA. 18+82

Scale: 1/2" = 1'-0"

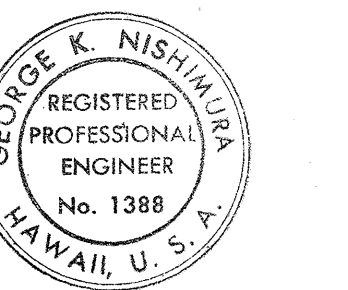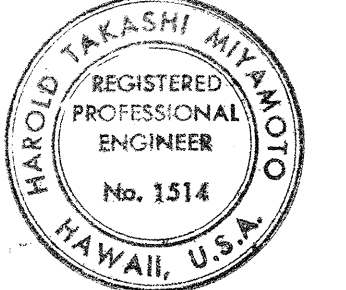

THIS WORK WAS PREPARED BY ME OR UNDER MY SUPERVISION  
*Harold Miyamoto* *George Nishimura*

STATE OF HAWAII  
DEPARTMENT OF TRANSPORTATION  
HIGHWAYS DIVISION  
**NIMITZ CONNECTOR (E.B.)**  
**RAMP "A" & RAMP "B"**  
**TYPICAL DECK SECTION**  
**KEEHI INTERCHANGE**  
F.A.I. PROJ. NO. 1-H-1 (168)17  
Scale: As shown Date: July, 1981  
SHEET NO. 548 OF 49 SHEETS



|                                                                                     |          |                                      |
|-------------------------------------------------------------------------------------|----------|--------------------------------------|
|  | 12/22/82 | Revise headwall for cushion barrier. |
| No.                                                                                 | Date     | Revision                             |



PRINTED ON NO. 1000M CLEARBRIN



| FED. ROAD DIST. NO. | STATE | FED. AID PROJ. NO. | FISCAL YEAR | SHEET NO. | TOTAL SHEETS |
|---------------------|-------|--------------------|-------------|-----------|--------------|
| HAWAII              | HAW.  | I-H-1(168)17       | 1982        | 132       | 145          |

1. **GENERAL SPECIFICATIONS:** HAWAII DEPARTMENT OF TRANSPORTATION, STANDARD SPECIFICATIONS FOR ROAD AND BRIDGE CONSTRUCTION, 1976, TOGETHER WITH SPECIAL PROVISIONS PREPARED FOR THIS CONTRACT.
2. **DESIGN SPECIFICATIONS:** A.A.S.H.T.O. 1977 STANDARD SPECIFICATIONS FOR HIGHWAY BRIDGES AND ITS SUBSEQUENT INTERIM SPECIFICATIONS.
3. **LOADS:**
- (A) **DEAD LOAD:** AN ALLOWANCE OF 18 P.S.F. FOR FUTURE WEARING SURFACE OF ASPHALT CONCRETE HAS BEEN PROVIDED FOR IN THE DESIGN.
- (B) **LIVE LOAD:** HS20-44 OR INTERSTATE LOADING.
4. **MATERIALS:**
- (A) ALL CONCRETE SHALL BE CLASS A UNLESS OTHERWISE NOTED. SEE SKETCH & NOTES ON APPROPRIATE SHEETS.
- (B) ALL REINFORCING STEEL SHALL BE A.S.T.M. A615, GRADE 40 UNLESS OTHERWISE NOTED.
- (C) ALL STRUCTURAL STEEL SHALL BE A.S.T.M. A-36, HOT DIP GALVANIZED, UNLESS OTHERWISE NOTED.
- (D) ALL ANCHOR BOLTS, WASHERS AND NUTS SHALL BE A.S.T.M. A-307, HOT DIP GALVANIZED, UNLESS OTHERWISE SPECIFIED.
- (E) FOR MATERIALS OF PRESTRESSED CONCRETE PILES SEE APPLICABLE PRESTRESSED CONCRETE NOTES.

5. **DESIGN STRESSES:** SHALL FOLLOW A.A.S.H.T.O. STANDARD SPECIFICATIONS FOR HIGHWAY BRIDGES IN ADDITION TO THOSE LISTED BELOW.

| CONCRETE | CLASS A OR B D | ALL OTHERS<br>(EXCEPT PRESTRESSED CONCRETE BEAMS AND UNLESS OTHERWISE NOTED ON THE PLANS) |
|----------|----------------|-------------------------------------------------------------------------------------------|
| F'c      | 3000 P.S.I.    | 4000 P.S.I.                                                                               |
| Fc       | 1200 P.S.I.    | 1600 P.S.I.                                                                               |
| N        | 9              | 8                                                                                         |

~~FOR PRESTRESSED CONCRETE BEAMS, SEE PRESTRESSED CONCRETE NOTES. N.I.C.~~

6. **REINFORCEMENT:**
- (A) THE MINIMUM COVERING MEASURED FROM THE SURFACE OF THE CONCRETE TO THE FACE OF ANY REINFORCING BARS SHALL BE AS FOLLOWS:
- A.1. **DECK SLABS** (FOR BOX GIRDERS, T-BEAMS, PRESTRESSED BEAMS)
- A. TOP BARS = 1 1/2"
- B. BOTTOM BARS = 1 1/4"
- A.2. **BOX GIRDERS**
- A. 1 1/4" TO STIRRUP FROM OUTSIDE FACES
- B. 1" TO STIRRUP FROM INSIDE FACES.
- A.3. ~~FOR PRESTRESSED CONCRETE BEAMS SEE PRESTRESSED CONCRETE BEAM DETAILS. N.I.C.~~
- A.4. **ABUTMENTS, PIERS AND RETAINING WALLS** = 2"
- A.5. **COLUMNS** = 2" TO TIES
- A.6. **CONCRETE CAST AGAINST AND PERMANENTLY EXPOSED TO EARTH** = 3".
- A.7. **CONCRETE EXPOSED TO SEA WATER** = 4". (COLUMN PEDESTALS AND FOOTINGS IN STREAM)
- (B) REINFORCING BARS SHALL BE DETAILED IN ACCORDANCE WITH A.C.I. MANUAL OF STANDARD PRACTICE FOR DETAILING REINFORCED CONCRETE HIGHWAY STRUCTURES UNLESS OTHERWISE NOTED.
- (C) MINIMUM CLEAR SPACING BETWEEN PARALLEL BARS SHALL BE 1 1/2 TIMES THE DIAMETER OF BARS (FOR NON BUNDLED BARS), BUT IN NO CASE SHALL THE CLEAR DISTANCE BETWEEN THE BARS BE LESS THAN 1 1/2 TIMES THE MAXIMUM SIZE OF THE COARSE AGGREGATE.
- (D) ALL DIMENSIONS RELATING TO REINFORCING BARS (EG. SPACING OF BARS, ETC.,) ARE TO CENTERS OF BARS UNLESS OTHERWISE NOTED.
- (E) REINFORCING BARS SHALL BE SECURELY TIED AT ALL INTERSECTIONS AND LAP SPLICES EXCEPT WHERE THE SPACING OF INTERSECTIONS IS LESS THAN ONE FOOT IN EACH DIRECTION, IN WHICH CASE ALTERNATE INTERSECTIONS SHALL BE TIED.
- (F) VERTICAL COLUMN BARS SHALL BE ARRANGED IN SUCH A MANNER AS TO AVOID INTERFERENCE WITH PIER CAP BARS ABOVE AS DIRECTED BY THE ENGINEER.
7. **ELASTOMERIC PADS:** BOTTOM OF BRIDGE BEARING PADS SHALL BE SECURED TO THE CONCRETE SEATS, TO PREVENT DISPLACEMENT, WITH ADHESIVES APPROVED BY THE ENGINEER.

8. **CONSTRUCTION METHODS.**
- (A) SEE STANDARD SPECIFICATIONS AND SPECIAL PROVISIONS.
- (B) IN GENERAL TOP OF CONCRETE DECK SLAB SHALL BE CONSTRUCTED TO FOLLOW THE ROADWAY VERTICAL AND HORIZONTAL CURVES.
- (C) FALSEWORK FOR PIER CAPS SHALL BE SUPPORTED BY THE PIER COLUMNS AND/OR PILE CAPS. IN NO INSTANCE SHALL FORM SUPPORTS BE CARRIED TO MUDSILLS, ETC. ON GRADE.
- (D) GIRDER CONCRETE SEATS RECEIVING ELASTOMERIC PADS SHALL BE POURED MONOLITHICALLY WITH SUPPORTING STRUCTURE. BEARING AREA DEVIATION FROM PLANE SHALL NOT EXCEED 1/16-INCH. THE PAD SHALL BE CONSTRUCTED HIGHER THAN SHOWN ON PLANS & SHALL THEN BE GROUND DOWN TO THE REQUIRED ELEVATION.
- (E) SPREAD FOOTINGS SHALL BE EXCAVATED AND POURED NEAT AGAINST UNDISTURBED GROUND. IN CASE OF OVER EXCAVATION, SPACE BETWEEN FOOTING AND GROUND SHALL BE FILLED WITH CONCRETE AT THE CONTRACTOR'S EXPENSE AND AS DIRECTED BY THE ENGINEER. THE MINIMUM QUALITY OF THE FILL CONCRETE SHALL BE CLASS D.
- (F) IN THE INSTALLATION OF ANCHOR BOLTS FOR BRIDGE BEARINGS, LIGHTING STANDARDS AND EXPRESSWAY BRIDGE SIGN STRUCTURES, THE CONTRACTOR SHALL PROVIDE RIGID TEMPLATES TO MAINTAIN THE PROPER LOCATIONS AND SHALL PROTECT SUCH ANCHOR BOLTS AT ALL TIMES DURING THE PERIOD OF CONSTRUCTION. METHODS SHALL BE APPROVED BY THE ENGINEER.
- (G) EXCEPT AS OTHERWISE NOTED, ALL VERTICAL DIMENSIONS ARE MEASURED PLUMB.


9. **GENERAL**
- (A) ALL ITEMS NOTED INCIDENTAL WILL NOT BE PAID FOR SEPARATELY.
- (B) THE CONTRACTOR SHALL VERIFY THE LOCATION OF ALL UTILITY LINES AND NOTIFY THE RESPECTIVE OWNERS BEFORE COMMENCING THE WORK OF EXCAVATION OR THE DRIVING OF PILES, INCLUDING ANY TEMPORARY PILING OR SHEETING.
- (C) FOR CONCRETE FINISH SEE STANDARD SPECIFICATIONS AND FOR ARCHITECTURAL TREATMENT OF COLUMNS, SEE DETAILS.
- (D) CONSTRUCTION JOINTS MAY BE RELOCATED OR ADDITIONAL ONES ADDED SUBJECT TO THE APPROVAL OF THE ENGINEER.
- (E) UNLESS OTHERWISE NOTED, ALL EXPOSED CONCRETE EDGES SHALL BE CHAMFERED 3/4" x 3/4".
- (F) STANDARD DETAIL DRAWINGS REFER TO ALL STRUCTURES IN GENERAL, EXCEPT FOR MODIFICATIONS AS MAY BE REQUIRED FOR SPECIAL CONDITIONS. FOR SUCH MODIFICATIONS REFER TO THE CORRESPONDING DETAILED DRAWINGS.
- (G) FOR ELECTRICAL CONDUIT LOCATION DETAILS SEE ELECTRICAL DRAWINGS.
10. **FOUNDATION:**
- (A) DESIGN LOAD FOR PILE TYPE A=115 TONS & PILE TYPE B=85 TONS, UNLESS OTHERWISE NOTED.
- (B) FOR BORING LOGS AND THEIR LOCATION SEE SHEET NOS. B-1, B-2, ETC.
- (C) THE PILE TIP ELEVATIONS SHOWN ON THE PLANS ARE BASED ON BORING DATA.
- (D) IN DRIVING EACH GROUP OF PILES, THE CONTRACTOR SHALL START FROM CENTER OF THE GROUP AND PROCEED OUTWARDS, EXCEPT FOR TEST PILES AND LOAD TEST PILES.
- (E) THE CONTRACTOR SHALL VERIFY THE TYPE OF SURFACE SOIL BEFORE STARTING TO DRIVE ANY PILE. WHERE THERE IS A SURFACE CRUST, A TEMPORARY STEEL SLEEVE SHALL BE USED TO PROTECT THE BITUMEN COATING ON PILES. THE SLEEVE SHALL EXTEND THROUGH THE DEPTH OF THE CRUST. THE SLEEVE SHALL BE REMOVED AFTER THE PILE IS DRIVEN AND THE ANNULAR SPACE AROUND THE PILE SHALL BE BACKFILLED AS SPECIFIED IN THE SPECIAL PROVISIONS. (FOR DETAILS SEE SHEET NO. SD-11)
- (F) SQUARE PILES ARE TO BE SO ALIGNED THAT FRONT AND REAR FACES OF PILES ARE PARALLEL TO CENTERLINE OF PIER.
- (G) LOAD TEST PILES INDICATED IN FOUNDATION PLAN SHALL BE FURNISHED 13' LONGER THAN REGULAR PILES.
- (H) TEST PILES INDICATED IN FOUNDATION PLAN SHALL BE FURNISHED 5' LONGER THAN REGULAR PILES.

\* DESIGN LOAD FOR PILES EXCLUDES PILE WEIGHT AND ESTIMATED DOWNDRAW.


11. **REFERENCES:**
- (A) ~~FOR PRESTRESSED CONCRETE NOTES, SEE DRAWINGS FOR PRESTRESSED BEAM DETAILS. N.I.C.~~
- (B) FOR SIGN STRUCTURE NOTES, SEE DRAWING NO. ES-1.
- (C) FOR ADDITIONAL PILE NOTES SEE DRAWING NO. SD-10.
12. THE CONTRACTOR SHALL VERIFY THE LOCATIONS & DIMENSIONS OF SUBSTRUCTURES BUILT BY OTHERS PRIOR TO FABRICATION OF THE GIRDERS WHICH WILL BE SUPPORTED BY THESE STRUCTURES.

13. **SYMBOLS AND ABBREVIATIONS**

|               |                      |                |                                             |
|---------------|----------------------|----------------|---------------------------------------------|
| (E) OR (EXP.) | - EXPANSION          | O.C.           | - ON CENTERS                                |
| (H)           | - HINGE              | O/S            | - OFFSET                                    |
| ALT.          | - ALTERNATE          | STR.           | - STRAIGHT OR STRINGER                      |
| AZ.           | - AZIMUTH            | STIRR.         | - STIRRUP                                   |
| $\bar{C}$     | - CENTERLINE         | TYP.           | - TYPICAL                                   |
| $\bar{B}$     | - BASELINE           | (T) OR T.      | - TOP                                       |
| E.F.          | - EACH FACE          | (B) OR B.      | - BOTTOM                                    |
| B.F.          | - BOTH FACES         | BRG.           | - BEARING                                   |
| F.F.          | - FAR FACE           | T.O.D.         | - TOP OF DECK                               |
| N.F.          | - NEAR FACE          | W.P.           | - WORKING POINT                             |
| C.J.          | - CONSTRUCTION JOINT | a              | - AT                                        |
| CL.           | - CLEAR              | $\phi$ OR DIA. | - DIAMETER                                  |
| EL., ELEV.    | - ELEVATION          | $\bar{P}$      | - PLATE                                     |
| E.P.          | - EDGE OF PAVEMENT   |                | DETAIL OR SECTION DESIGNATION               |
| EB            | - EAST BOUND         |                | SHEET NO. SECTION OR DETAIL IS DRAWN.       |
| FIN. GR.      | - FINISHED GRADE     |                | SHEET NO. SECTION IS CUT OR DETAIL LOCATION |
| WB            | - WEST BOUND         |                |                                             |
| INV.          | - INVERT             |                |                                             |
| JT.           | - JOINT              |                |                                             |
| N.T.S.        | - NOT TO SCALE       |                |                                             |

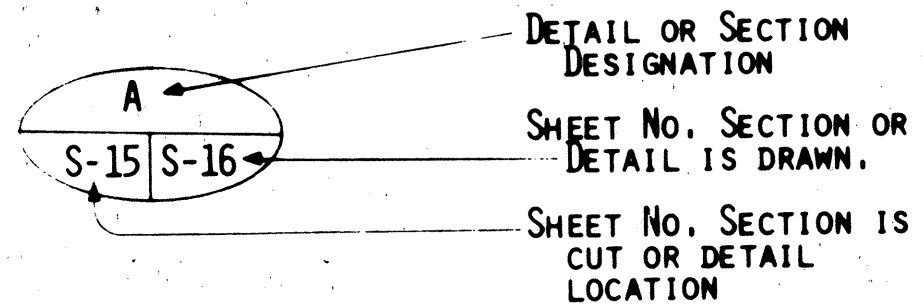

**PRESTRESSED CONCRETE  
GIRDERS WILL BE  
FURNISHED BY OTHERS**

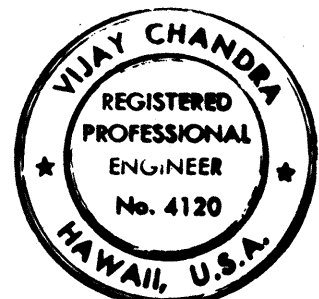


THIS WORK WAS PREPARED BY  
ME OR UNDER MY SUPERVISION.  
Vijay Chandra  
Signature


|                                                                      |               |
|----------------------------------------------------------------------|---------------|
| STATE OF HAWAII<br>DEPARTMENT OF TRANSPORTATION<br>HIGHWAYS DIVISION |               |
| <b>GENERAL NOTES</b>                                                 |               |
| KEEHI INTERCHANGE<br>F.A.I. PROJECT NO. I-H-1-(168 )17               |               |
| SCALE:                                                               | DATE: 8/17/81 |
| SHEET No. Y-1 OF 11 SHEETS SD-1                                      |               |




| FED. ROAD DIST. NO. | STATE | FED. AID PROJ. NO. | FISCAL YEAR | SHEET NO. | TOTAL SHEETS |
|---------------------|-------|--------------------|-------------|-----------|--------------|
| HAWAII              | HAW.  | 1H1(168)17         | 1982        | 133       | 145          |

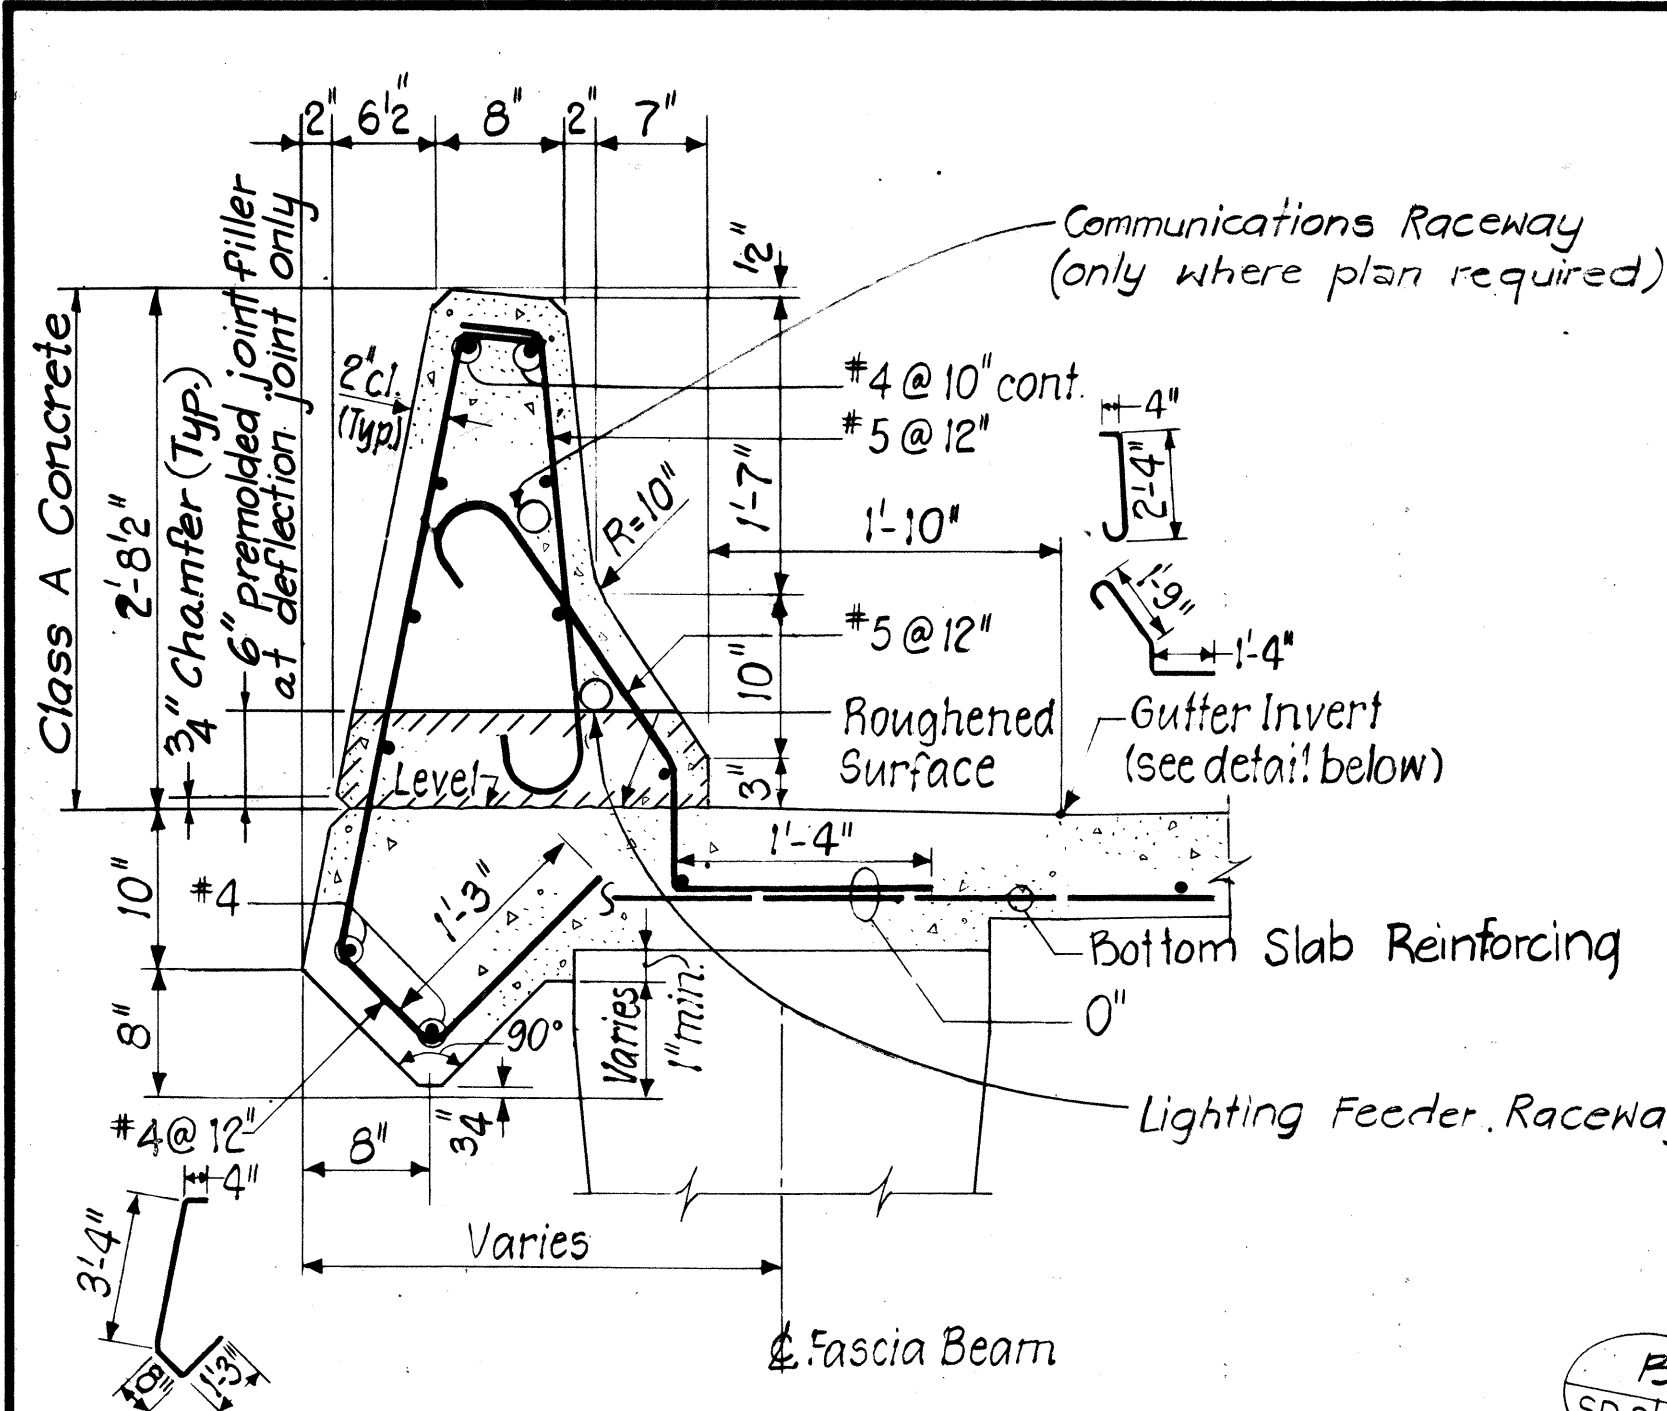


STANDARD PARAPET SECTION  
Scale: 1" = 1'-0"

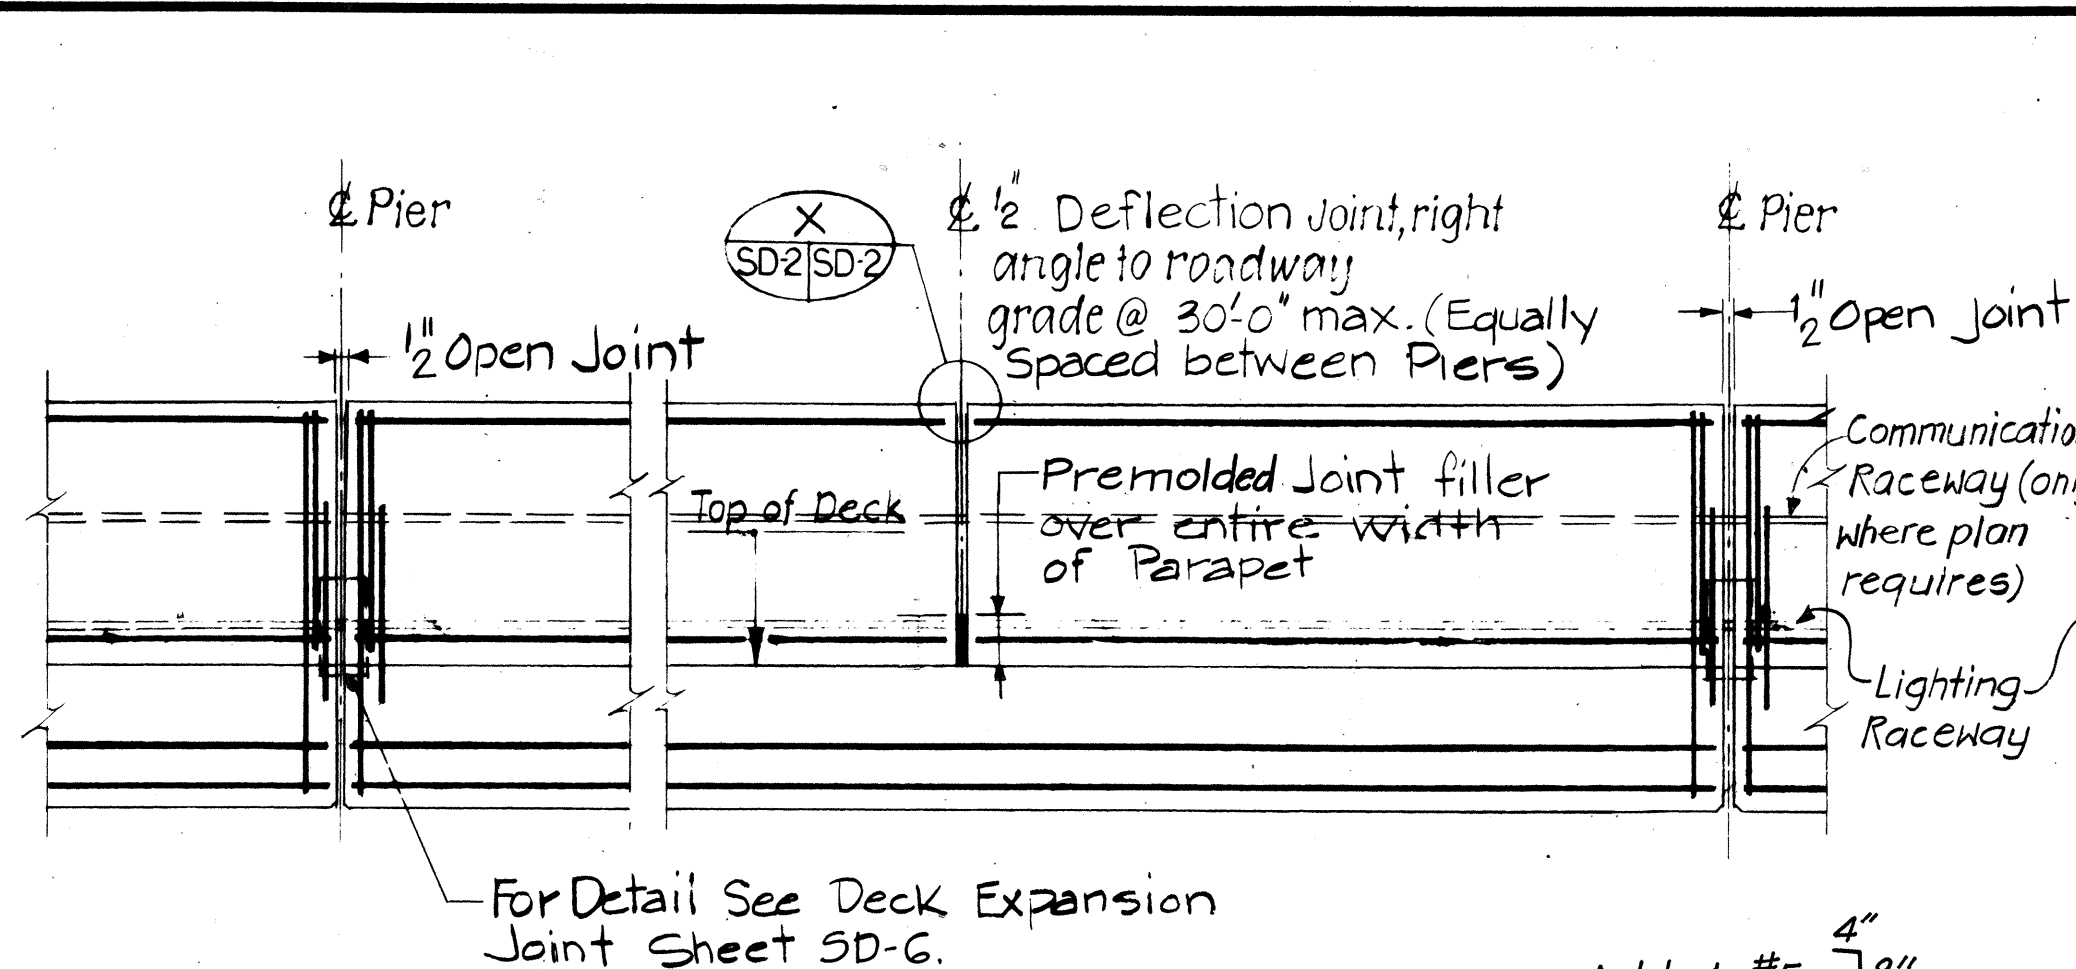


STANDARD PARAPET  
TYPICAL LONGITUDINAL SECTION  
Scale: 1/2" = 1'-0"

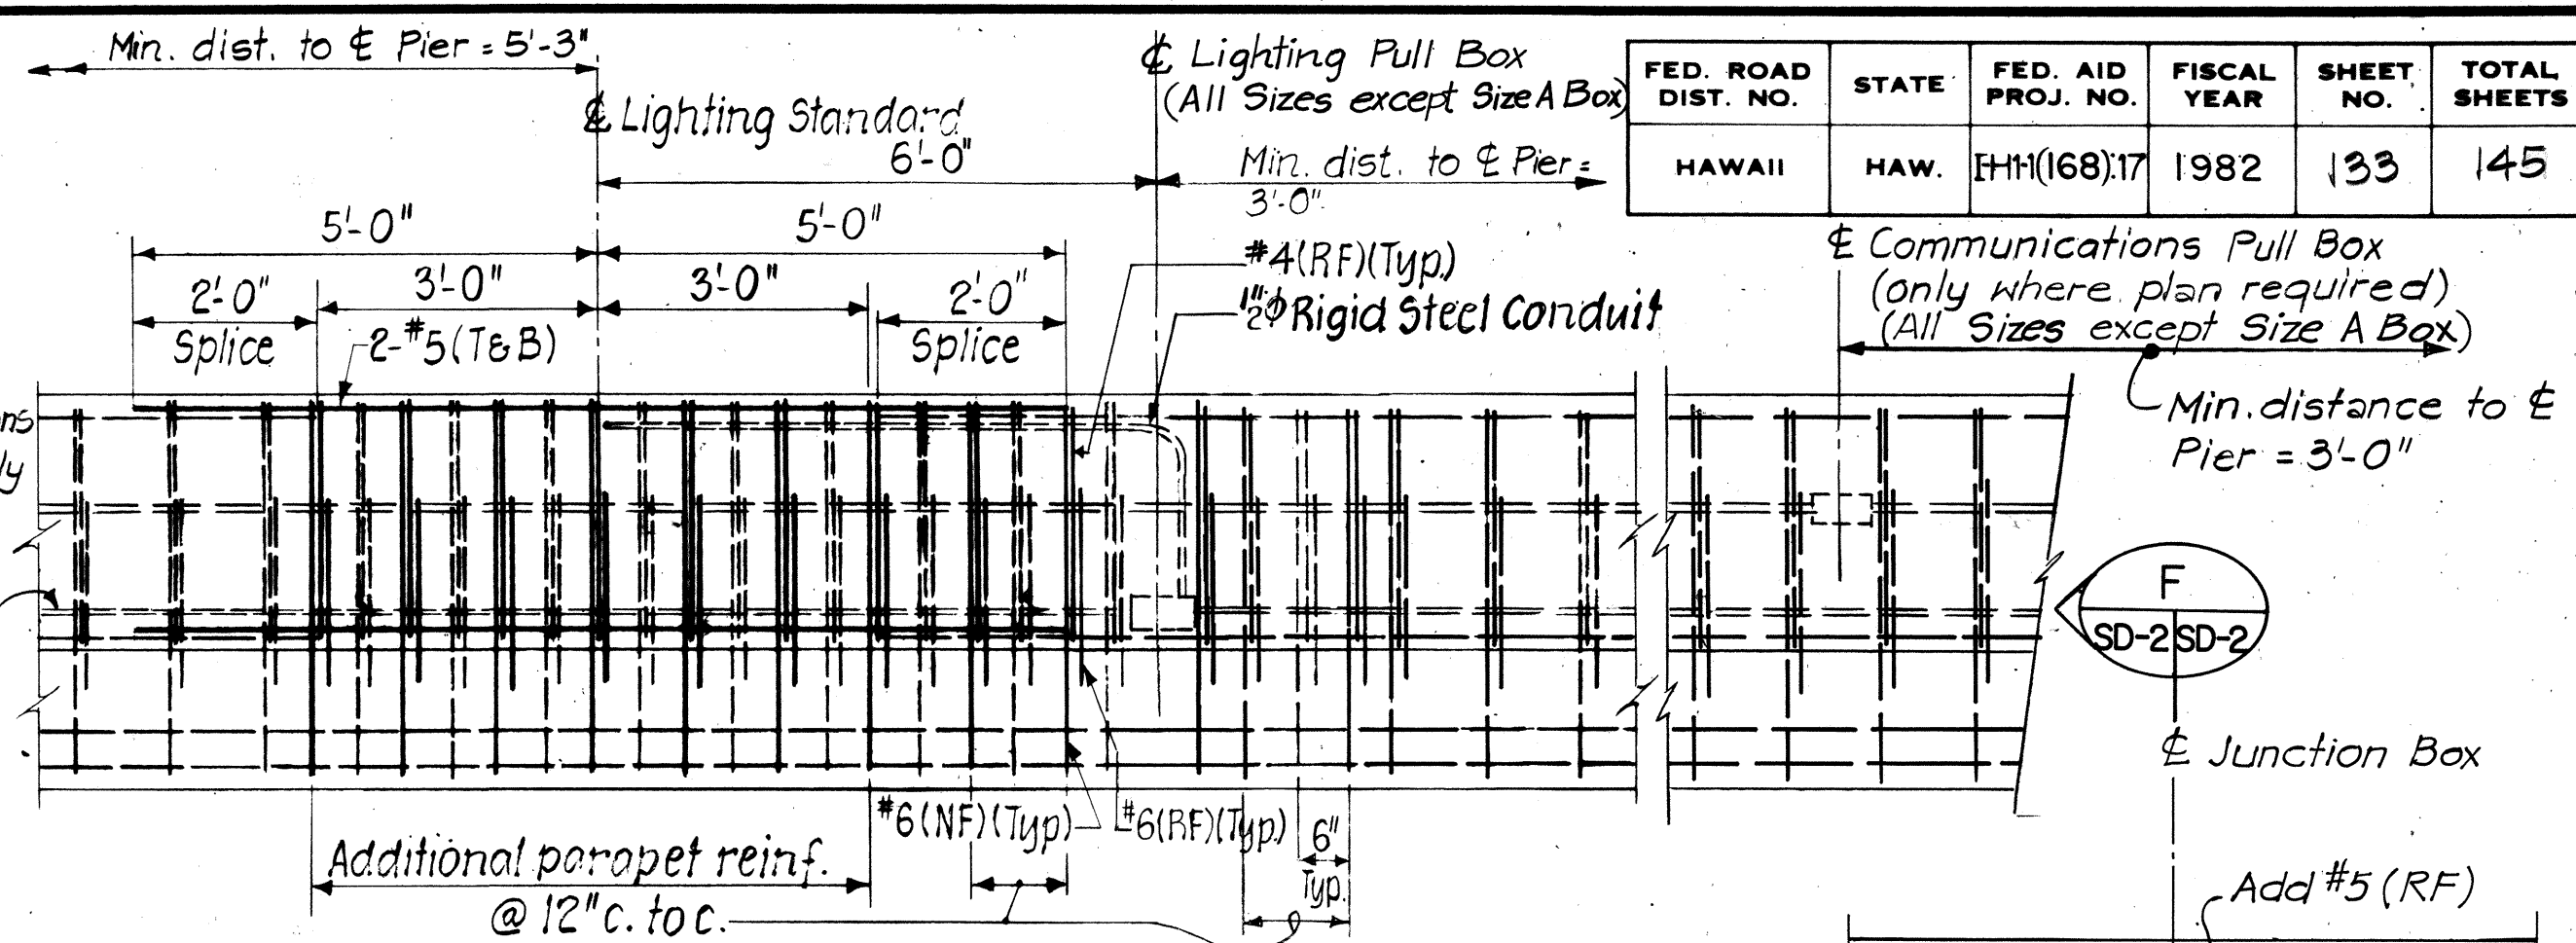


NOTE: For location of Lighting Standard See General Plan  
PARAPET REIN. AT LIGHTING STANDARD & JUNCTION BOX  
TYPICAL LONGITUDINAL SECTION  
Scale: 1/2" = 1'-0"

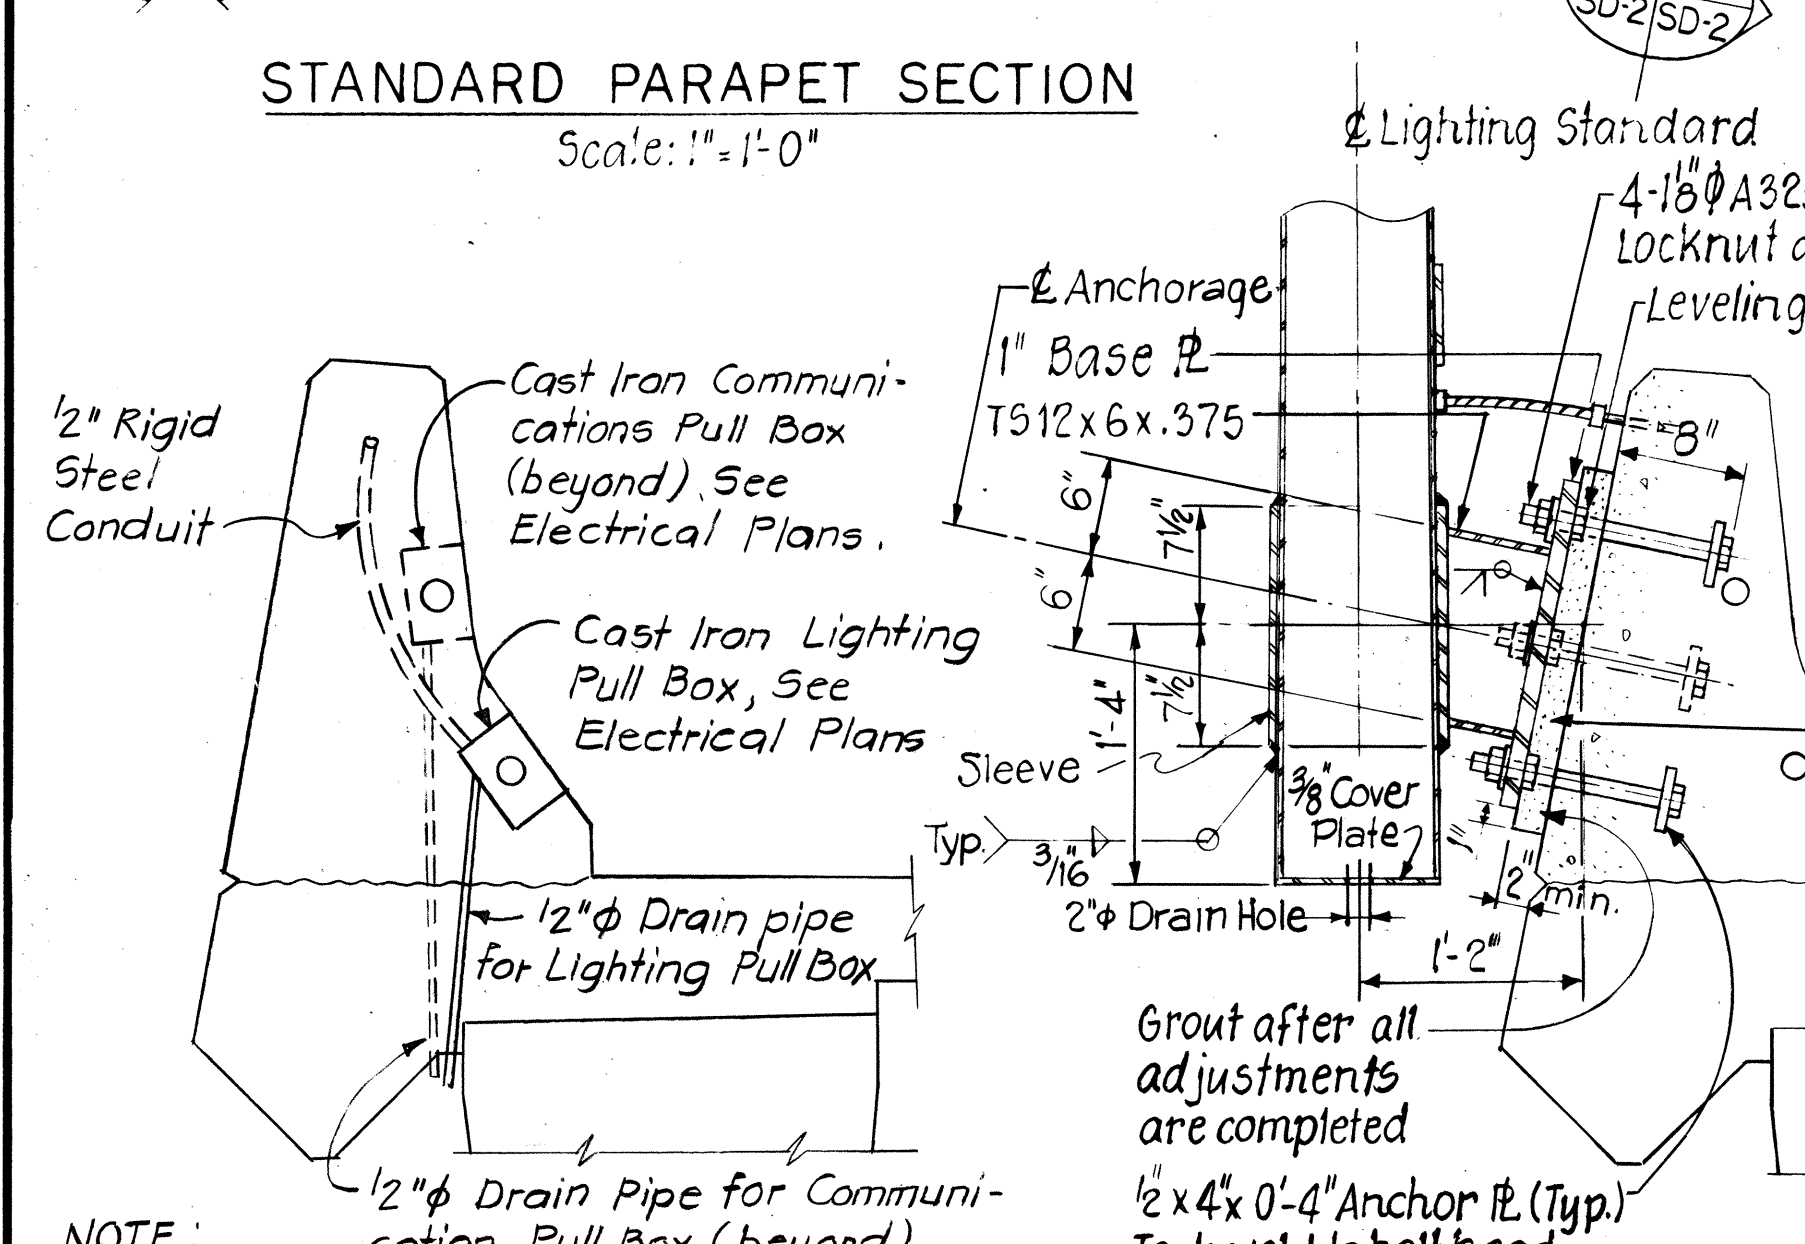


PARAPET DETAIL AT  
JUNCTION BOXES  
Scale: 1" = 1'-0"

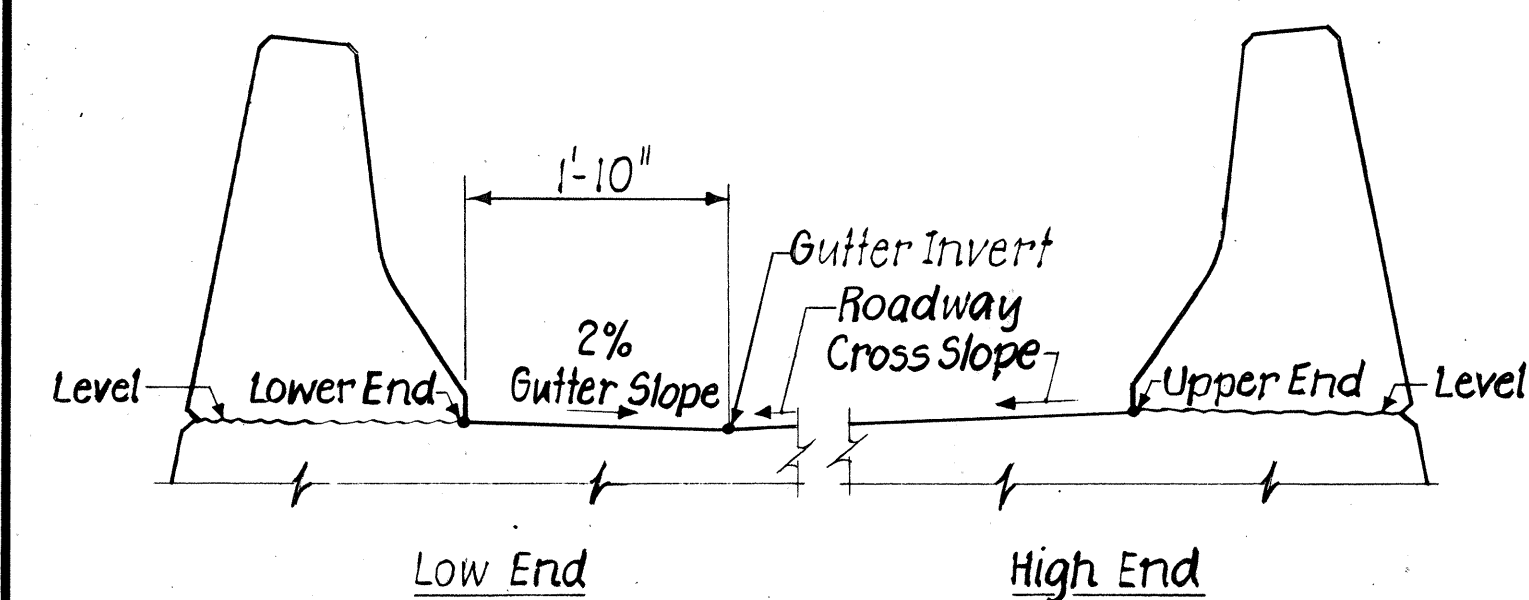


TYPICAL CROSS SLOPE DETAIL FOR DRAINAGE  
Scale: 3/4" = 1'-0"

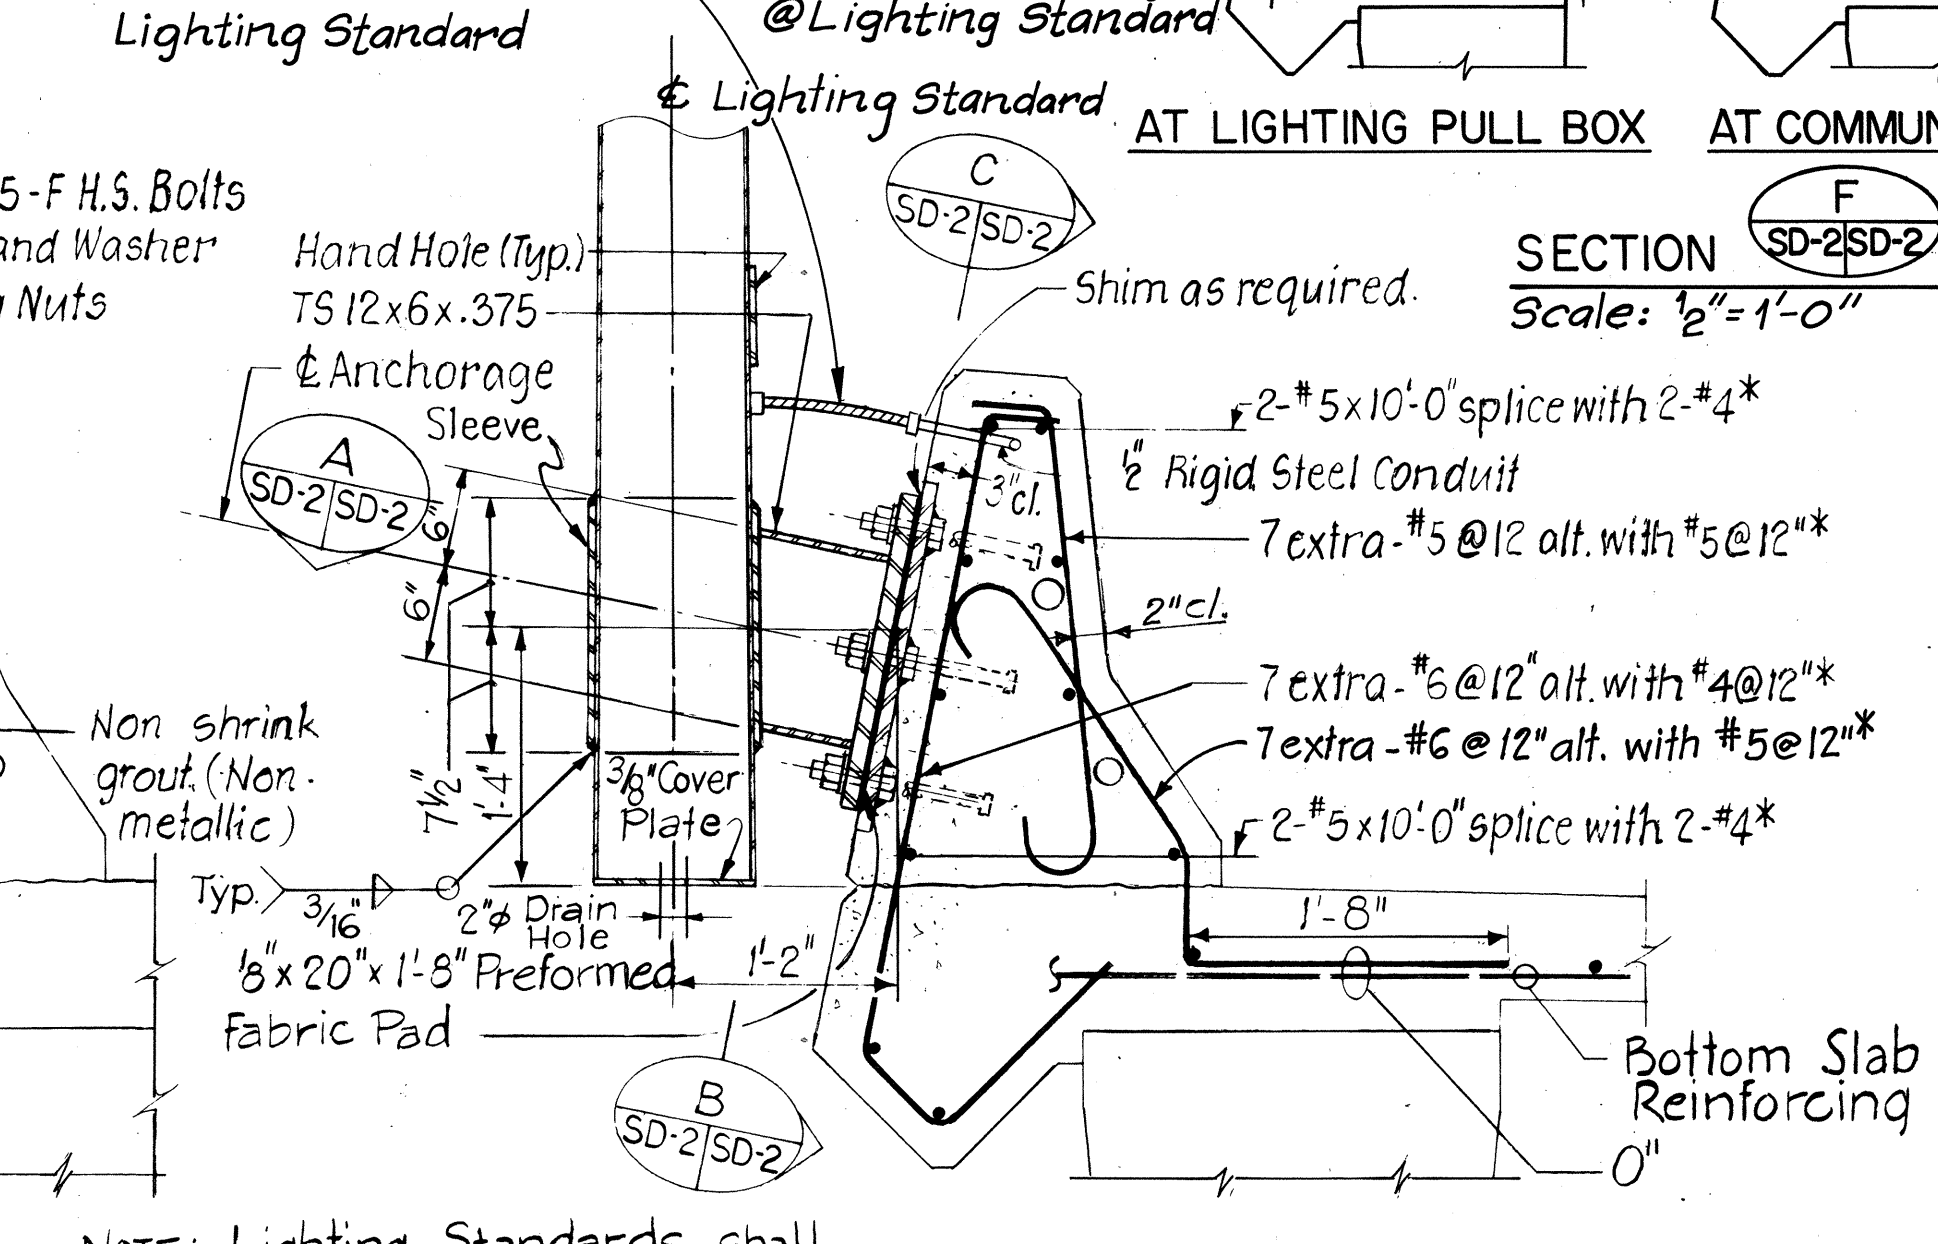


PARAPET DETAIL AT LIGHTING STANDARD  
Scale: 1" = 1'-0"

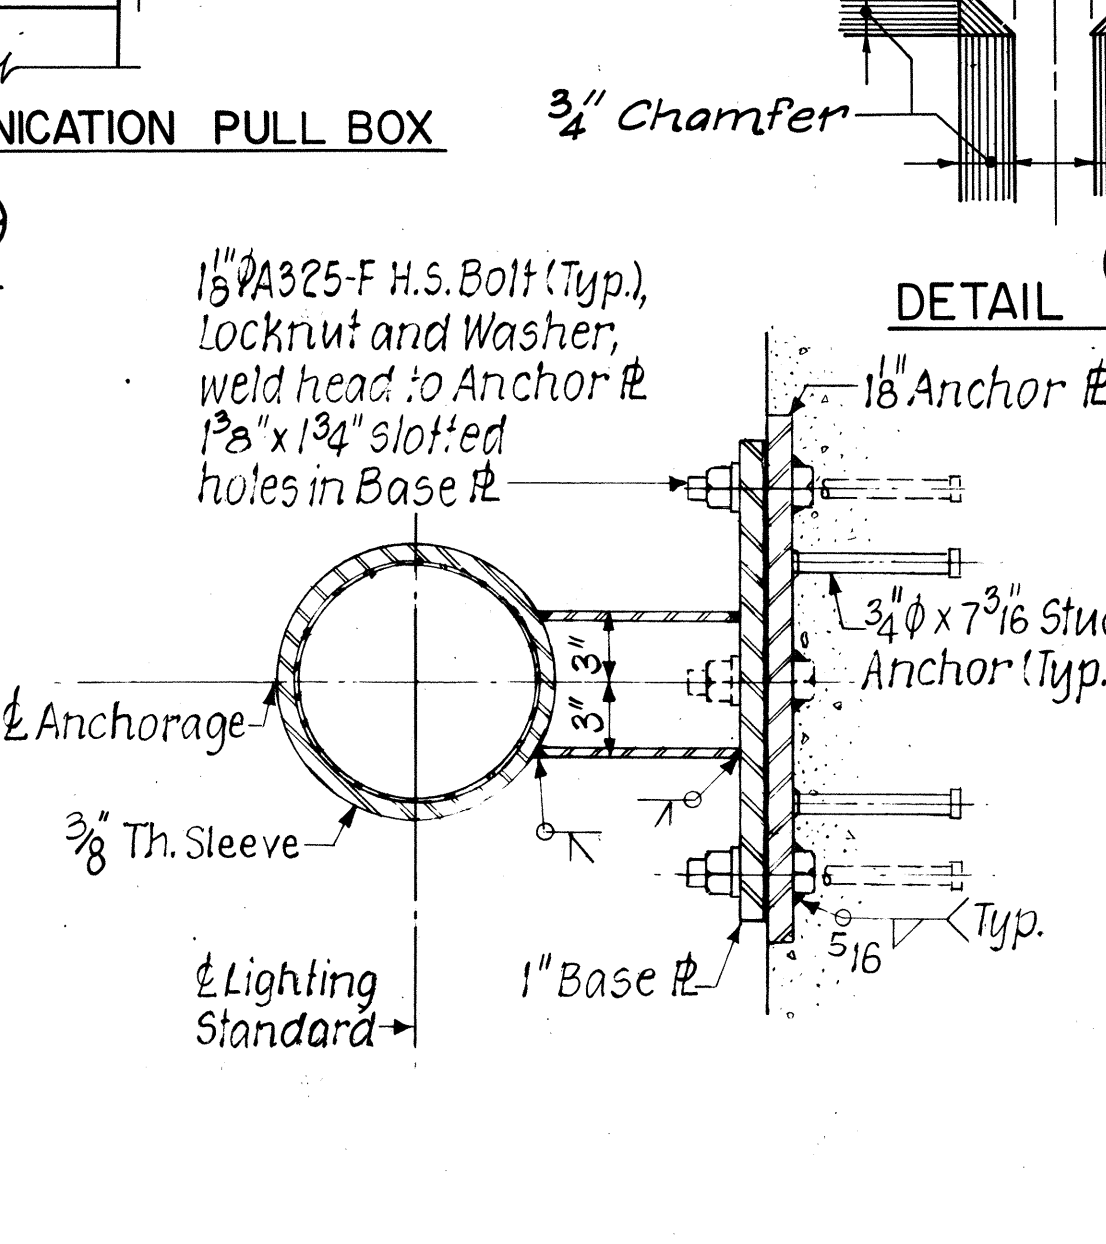


SECTION A  
SD-2/SD-2  
Scale: 1/2" = 1'-0"

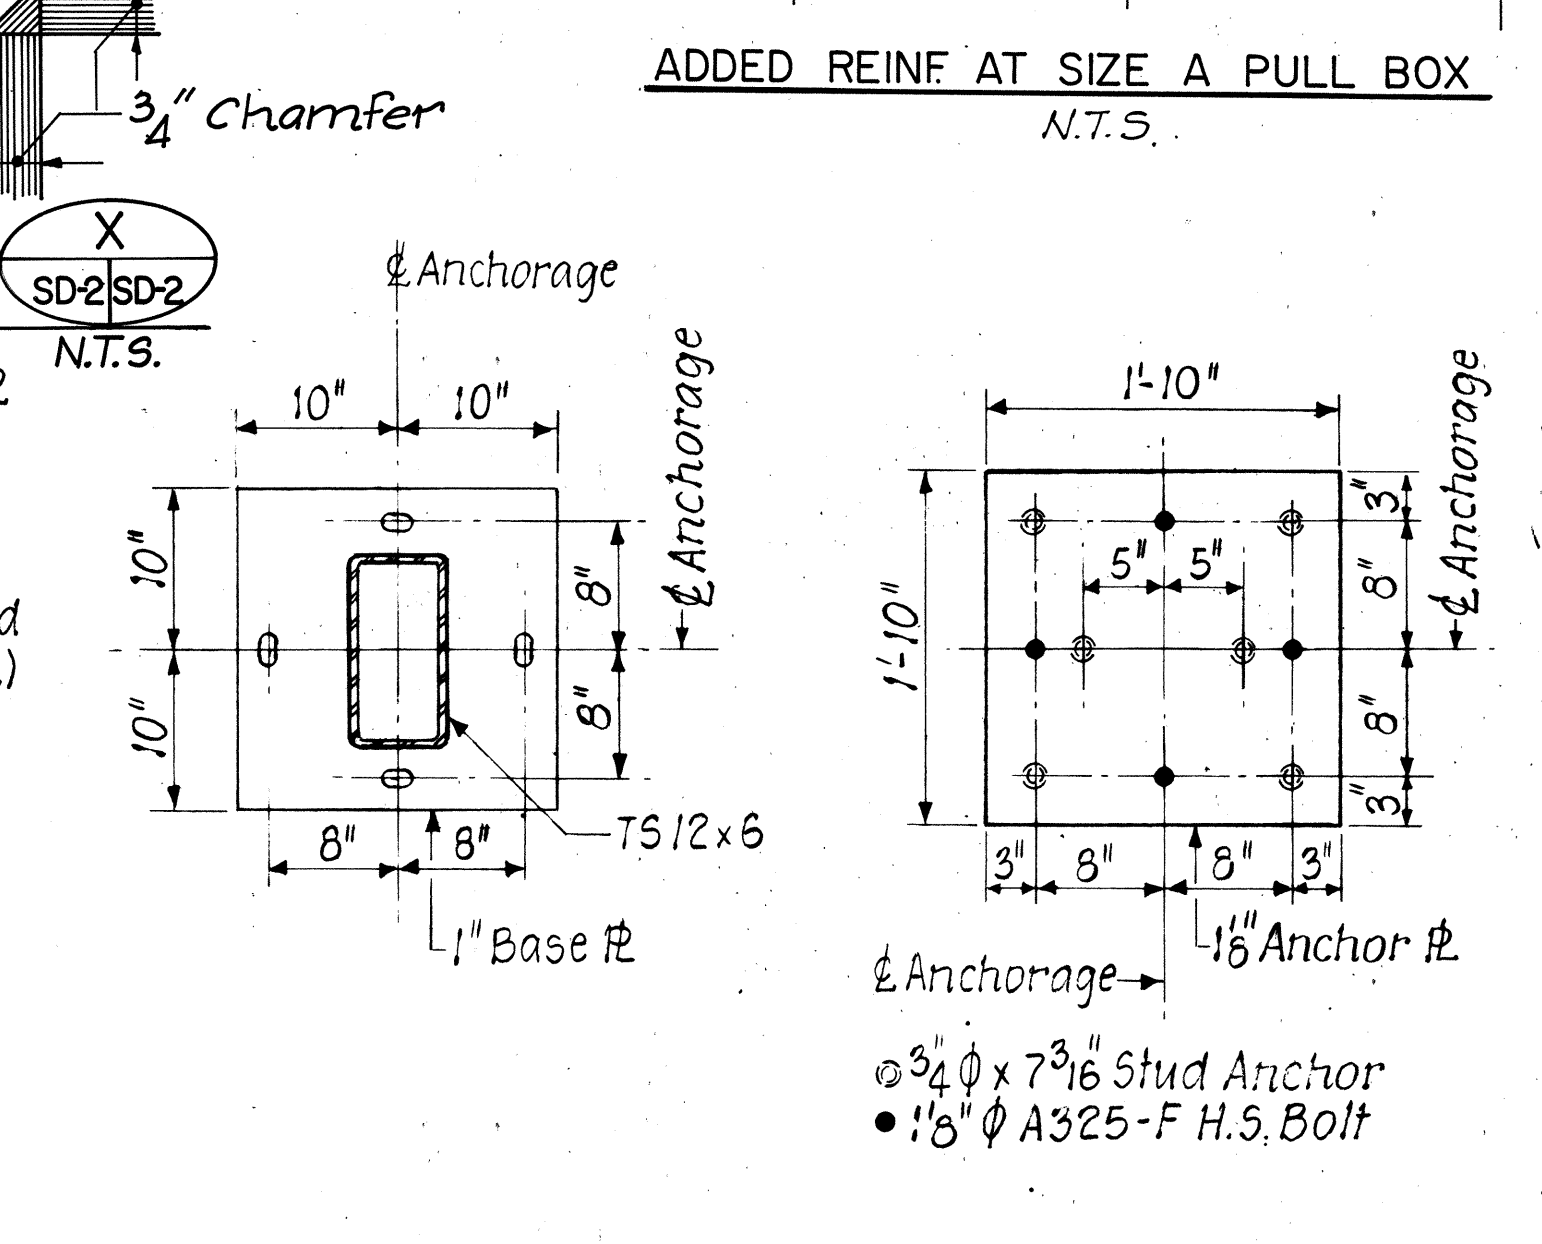


SECTION B  
SD-2/SD-2  
Scale: 1" = 1'-0"

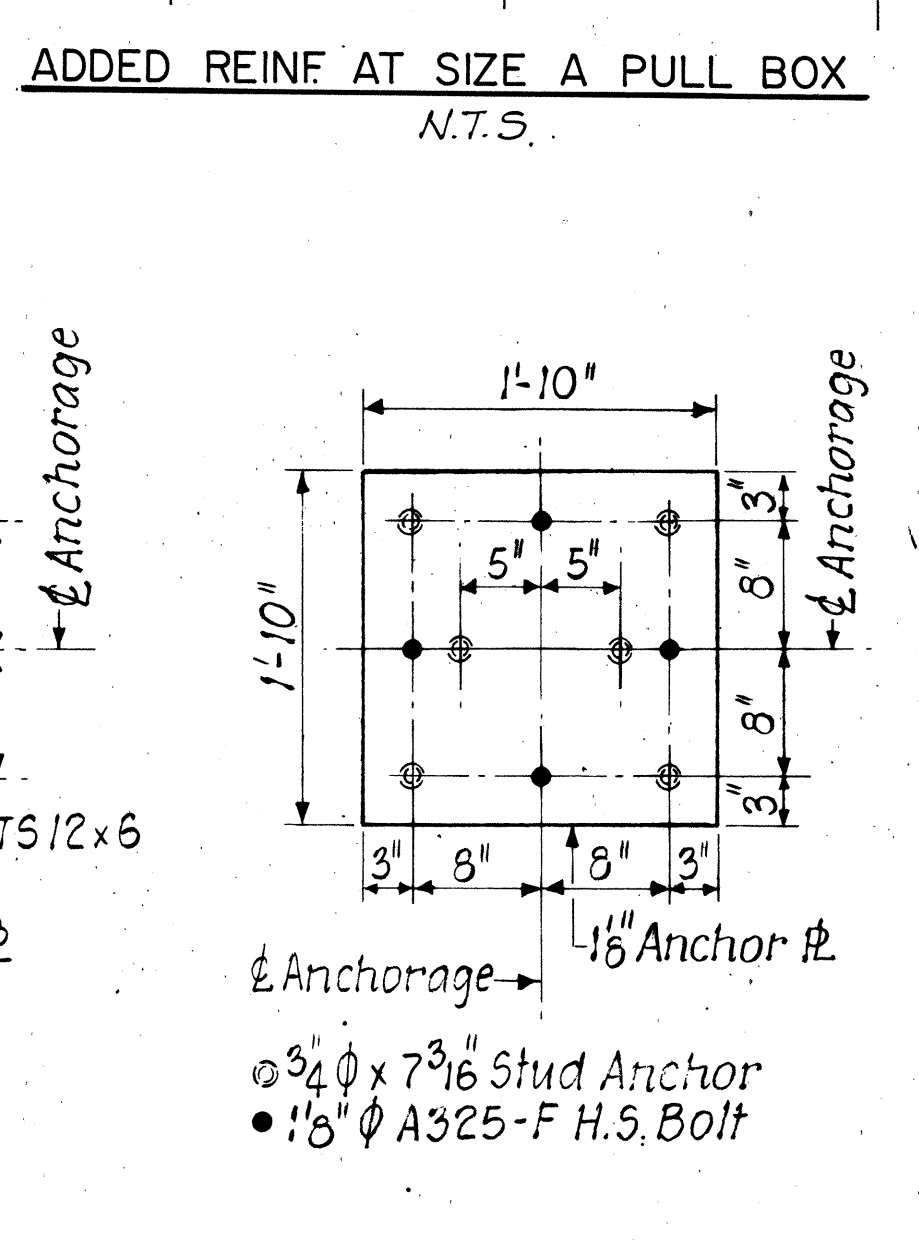


SECTION C  
SD-2/SD-2  
Scale: 1" = 1'-0"

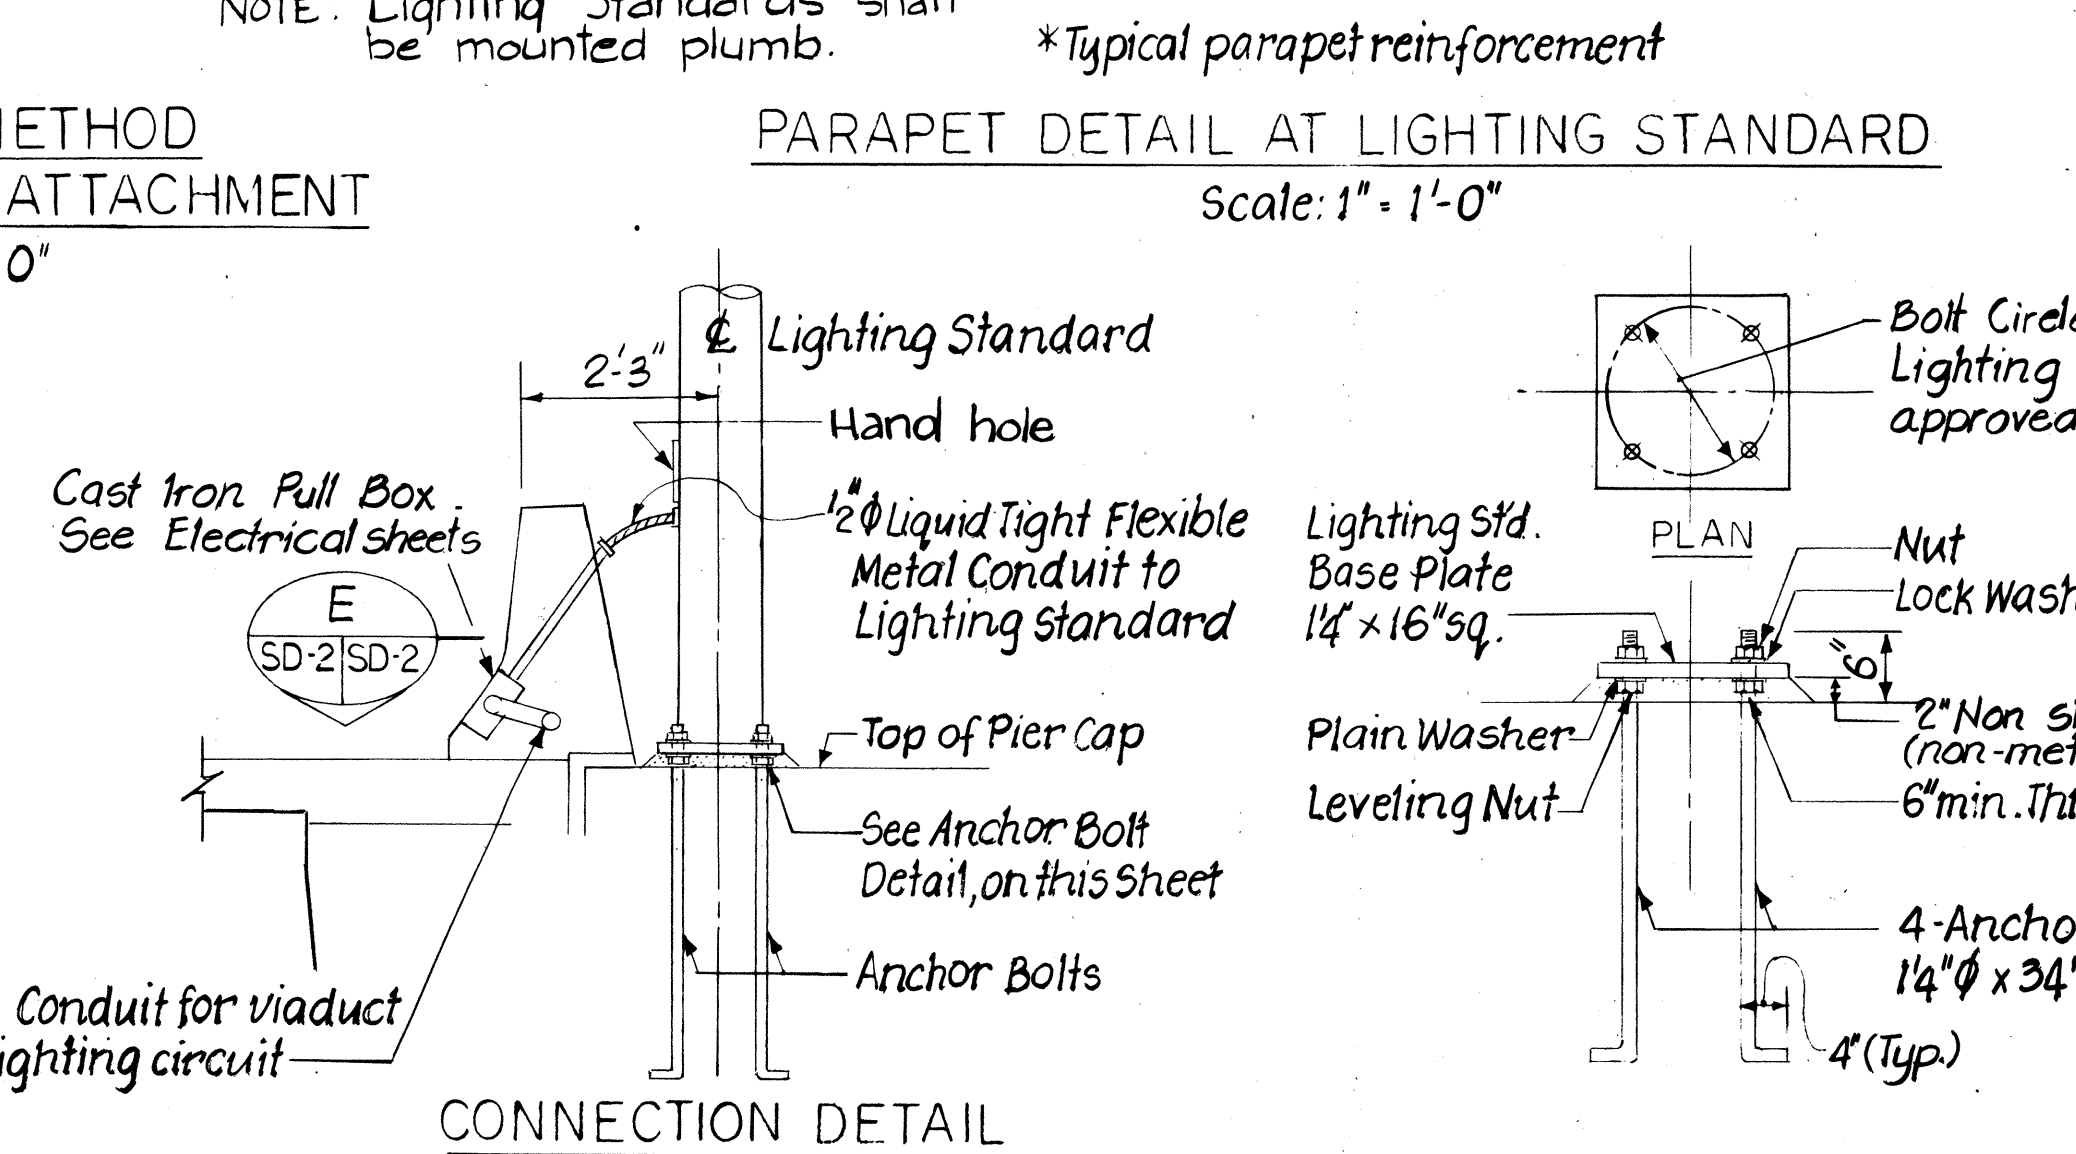


CONNECTION DETAIL  
Scale: 1/2" = 1'-0"

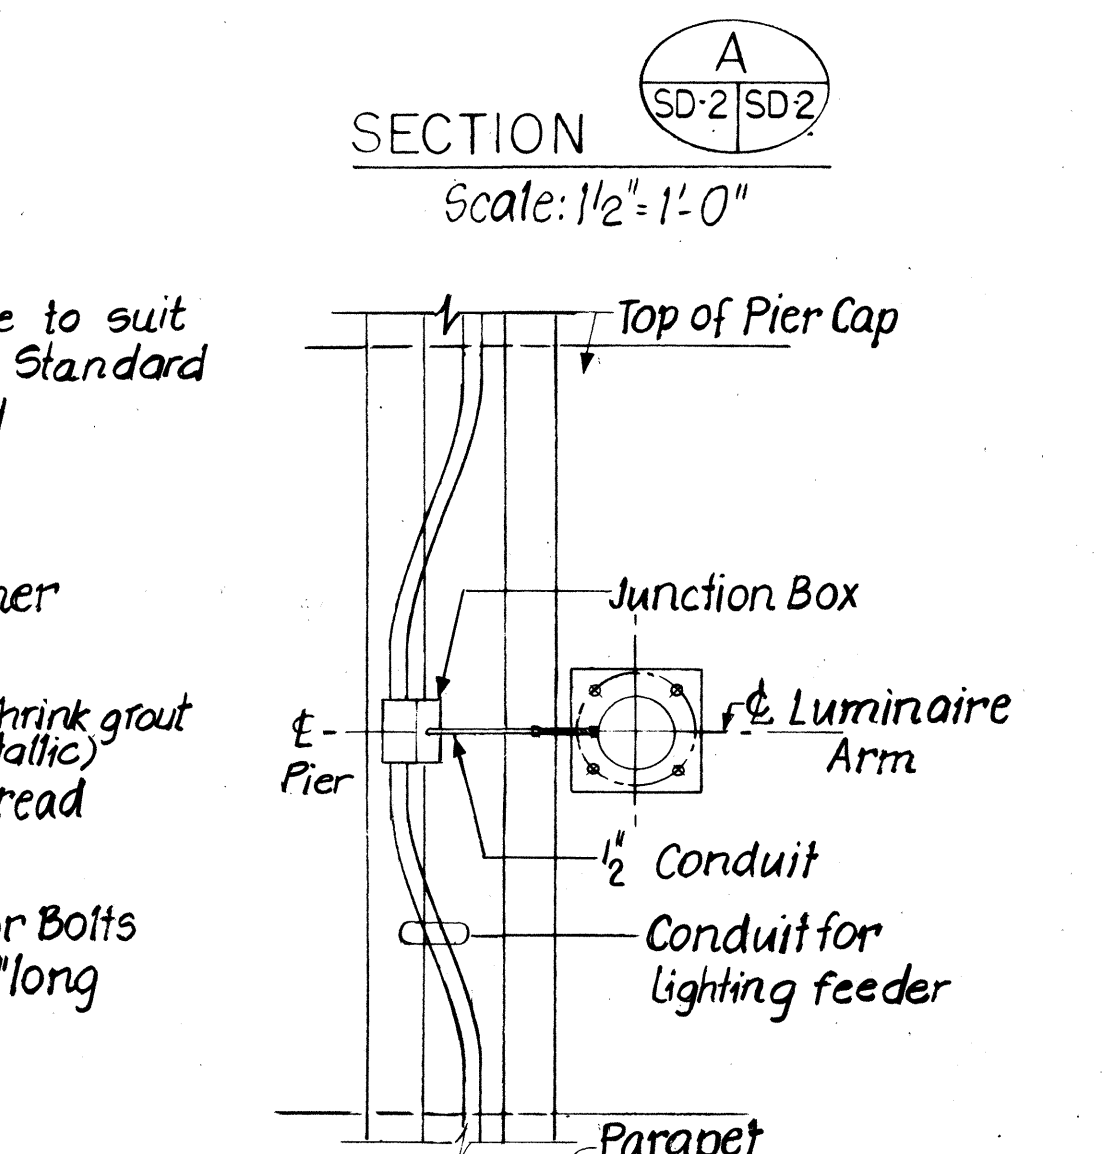

ANCHOR BOLT DETAIL  
Scale: 3/4" = 1'-0"

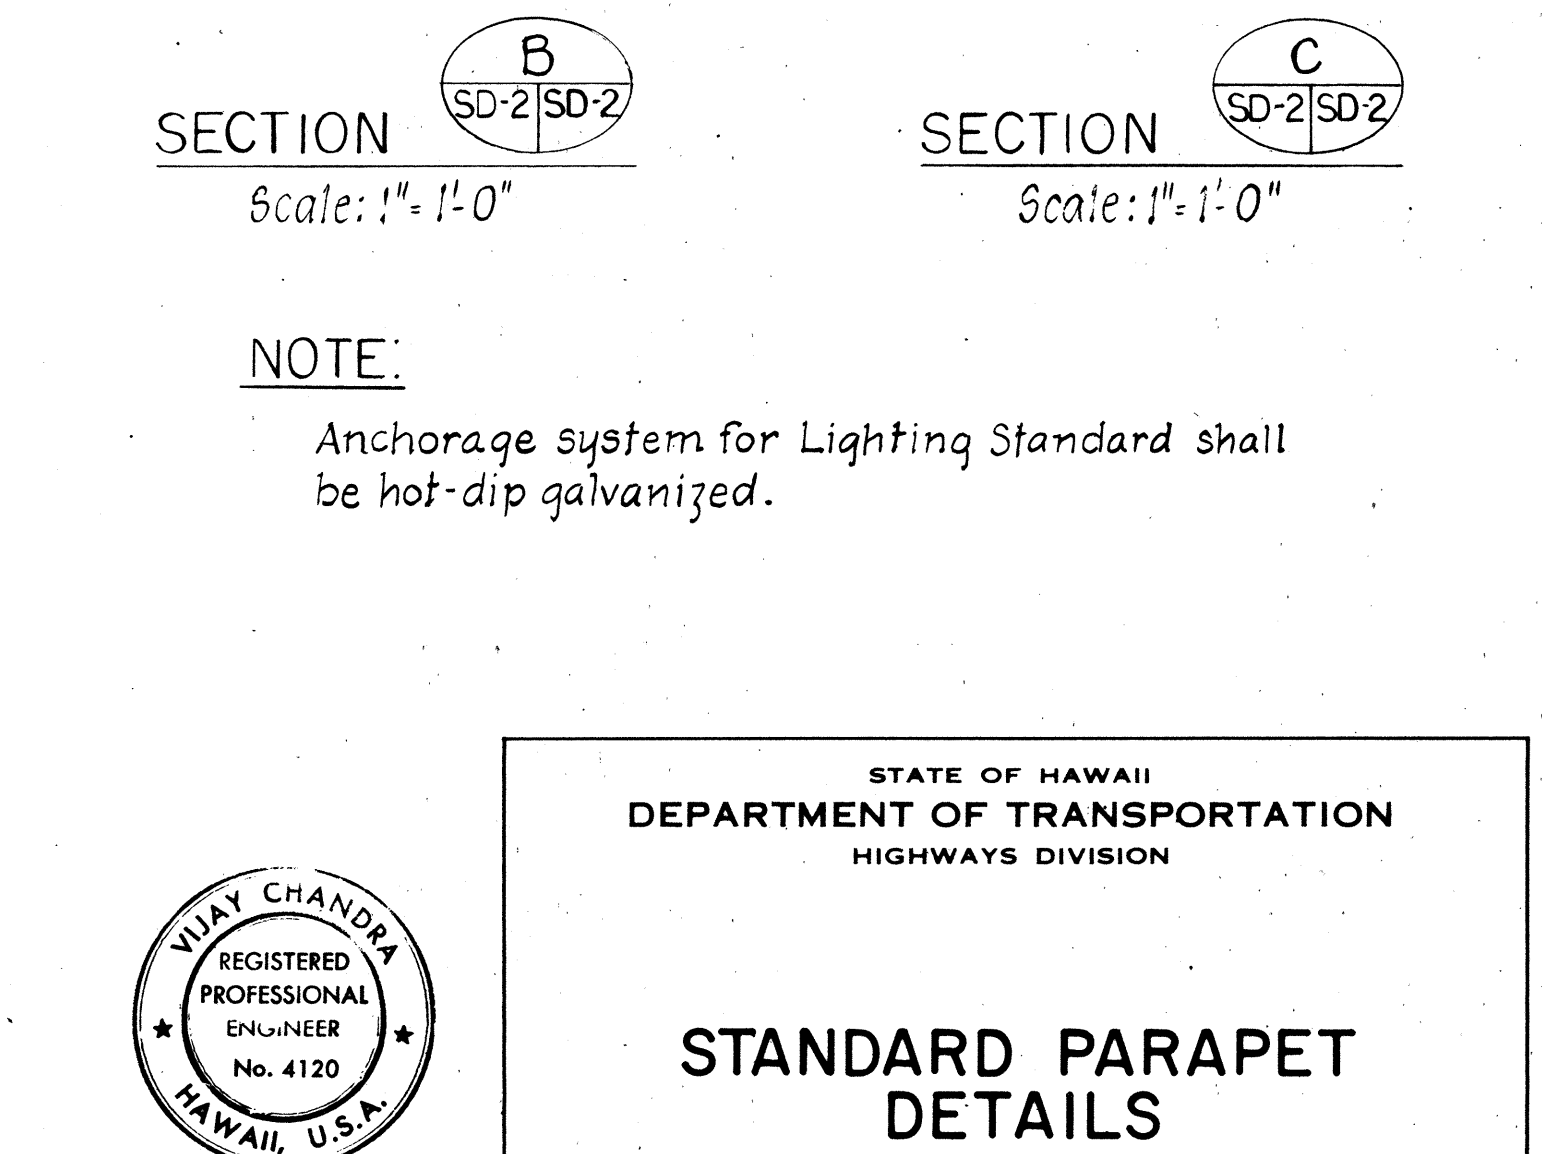

PIER MOUNTED LIGHTING STANDARD  
Scale: 1/2" = 1'-0"

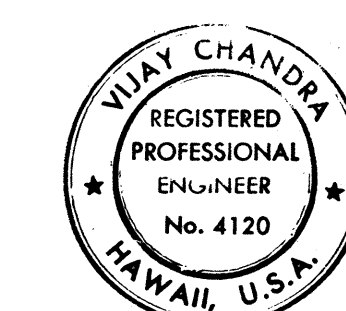

THIS WORK WAS PREPARED BY ME OR UNDER MY SUPERVISION.  
J. Jay Chandra  
Signature

STATE OF HAWAII  
DEPARTMENT OF TRANSPORTATION  
HIGHWAYS DIVISION


**STANDARD PARAPET DETAILS**

KEEHI INTERCHANGE  
F.A.I. PROJECT NO. 1-HI-1(168)17  
SCALE: AS SHOWN  
DATE: 8/17/81

SHEET NO. Y-2 OF 11 SHEETS SD-2



| FED. ROAD DIST. NO. | STATE | FED. AID PROJ. NO. | FISCAL YEAR | SHEET NO. | TOTAL SHEETS |
|---------------------|-------|--------------------|-------------|-----------|--------------|
| HAWAII              | HAW.  | 1-HI-1(168)17      | 1982        | 134       | 145          |

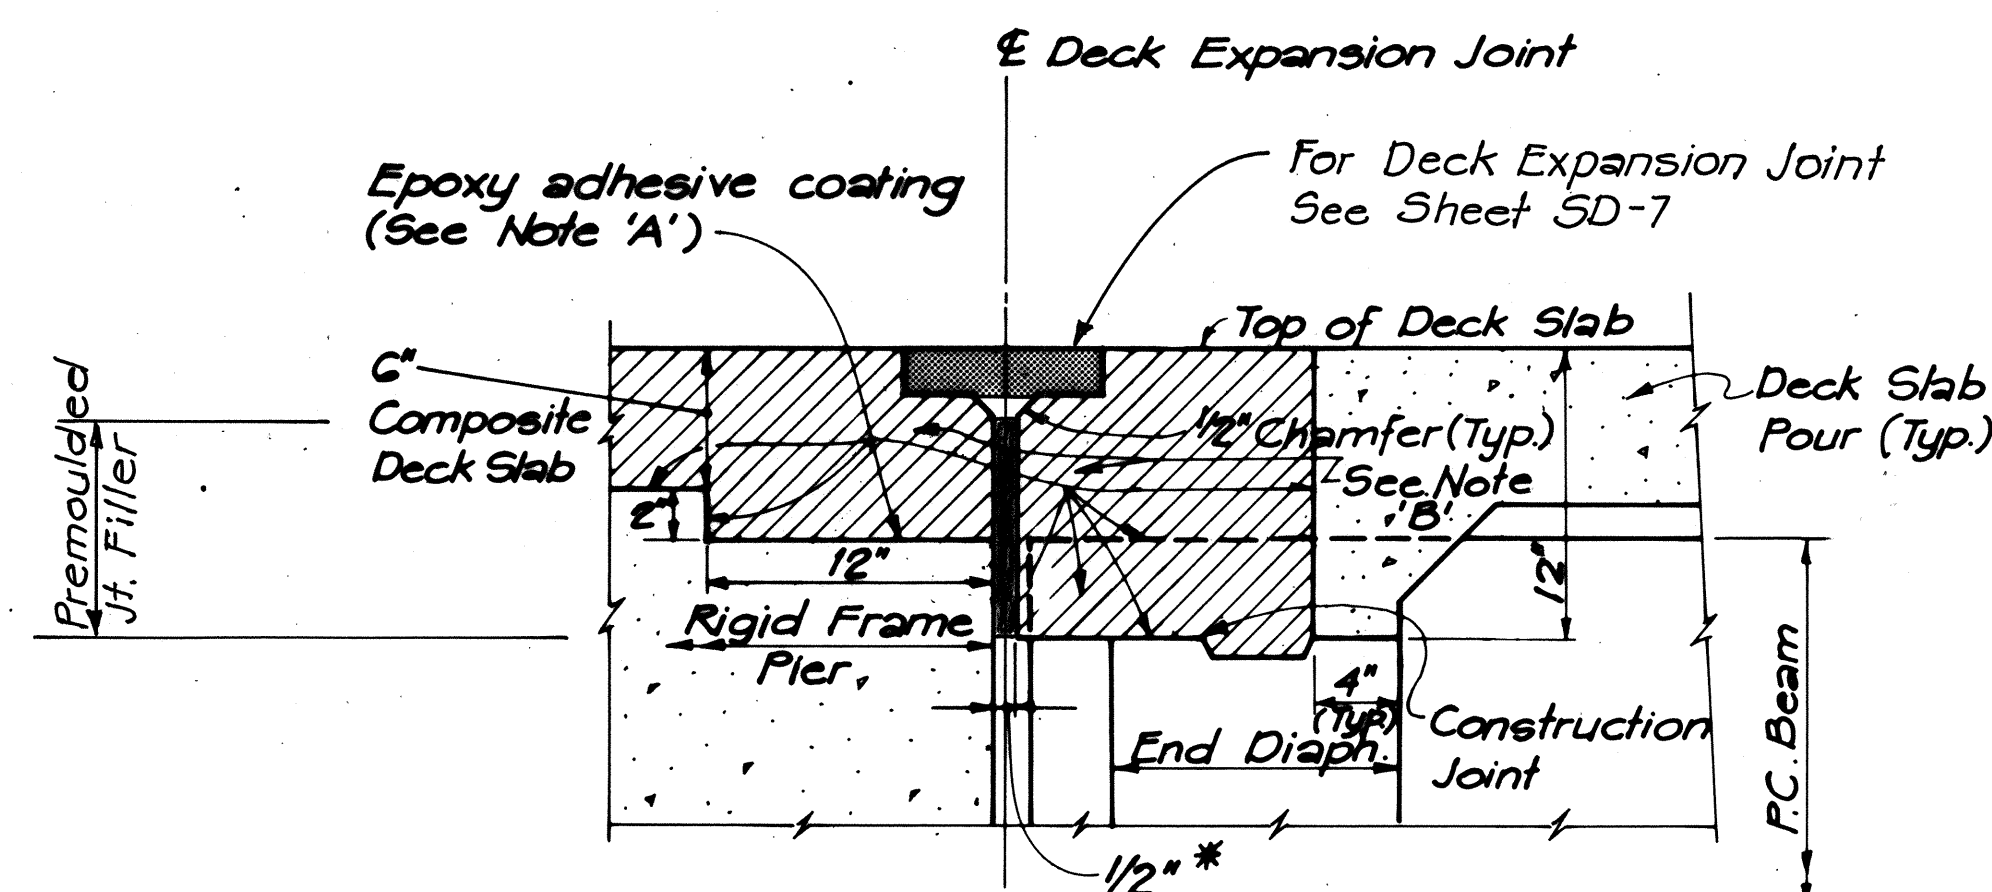


**TYPICAL DECK SECTION AT RIGID FRAME**  
N.T.S.


**NOTE 'A':** Just prior to concreting of the hatched areas, coat the indicated surfaces with an epoxy adhesive. (See Special provision Sec.705.13)

**NOTE 'B':** Hatched Areas shall be concreted after 14 days of deck slab pour. Anchor devices shall be located and held in their final position, as per Manufacturer's requirement, during the concreting of the hatched areas.


\* Joint opening at time of installation of joint. Joint to be formed by Premoulded filler.

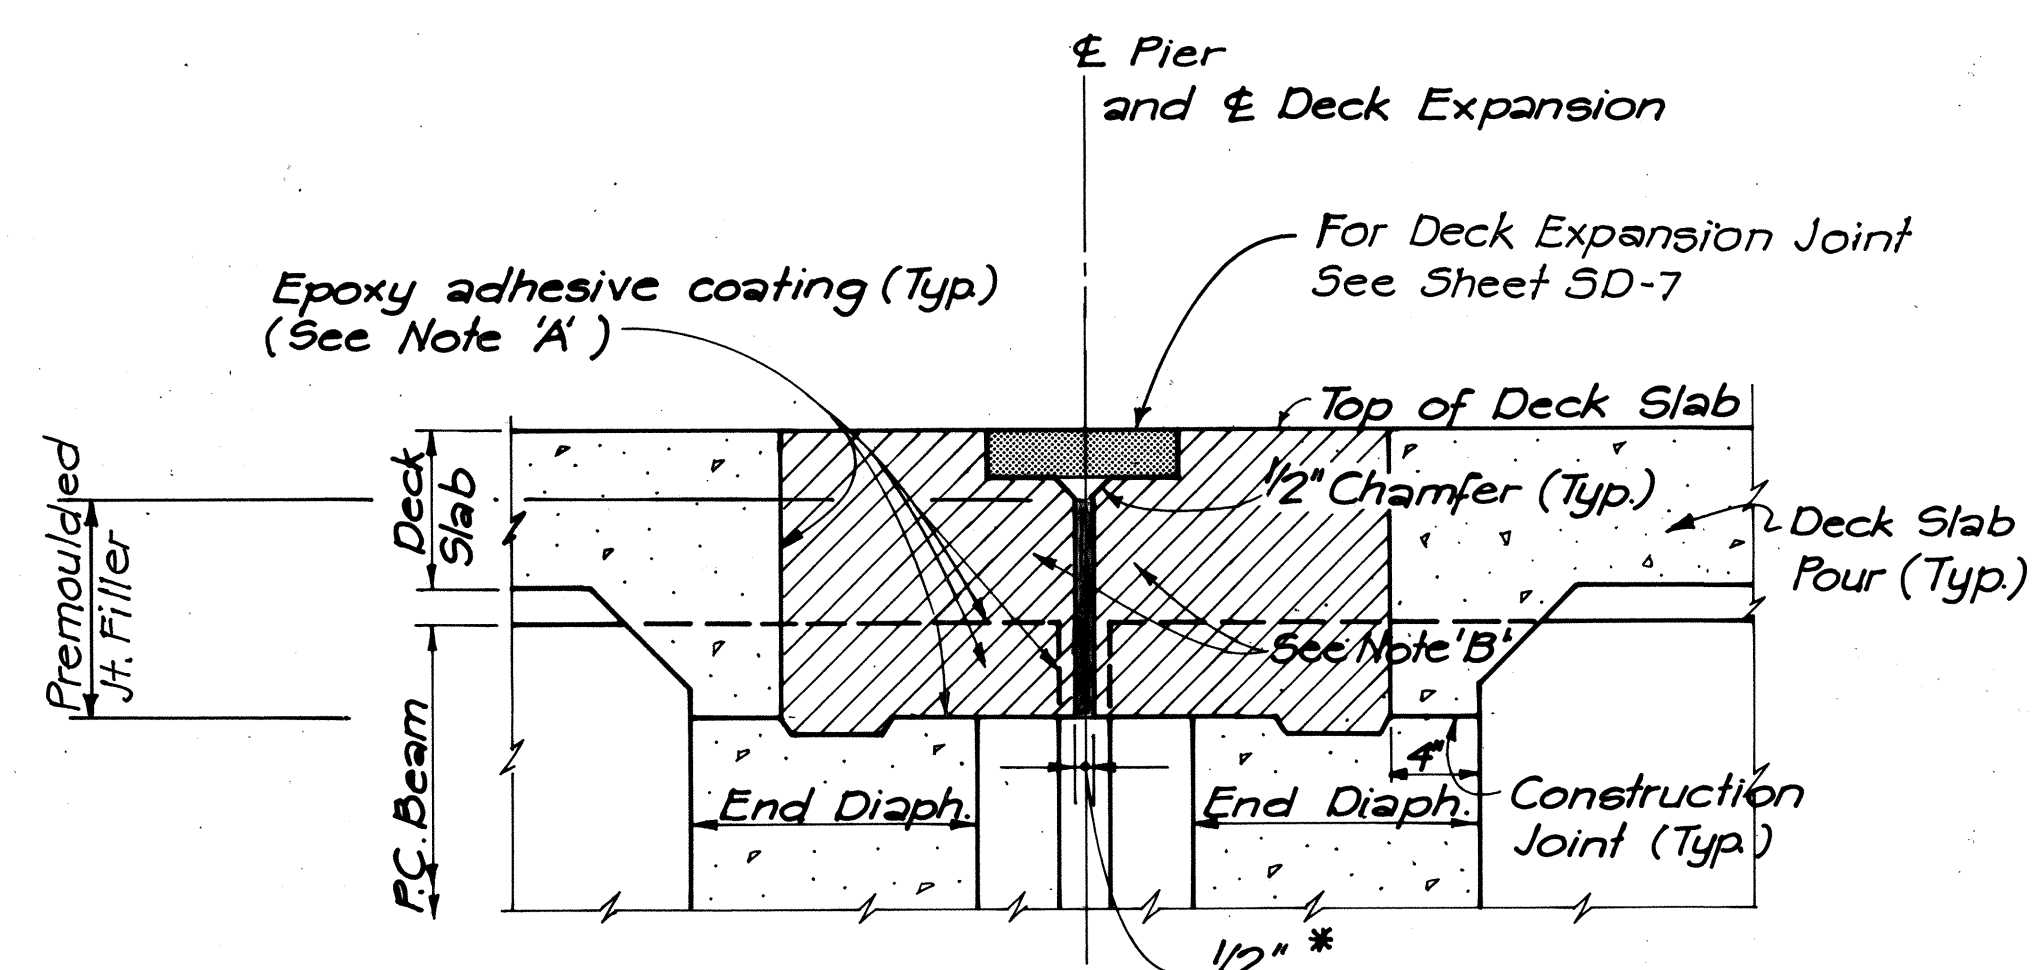


**TYPICAL DECK SECTION**  
**(AT ALL PIERS EXCEPT RIGID FRAMES)**  
N.T.S.

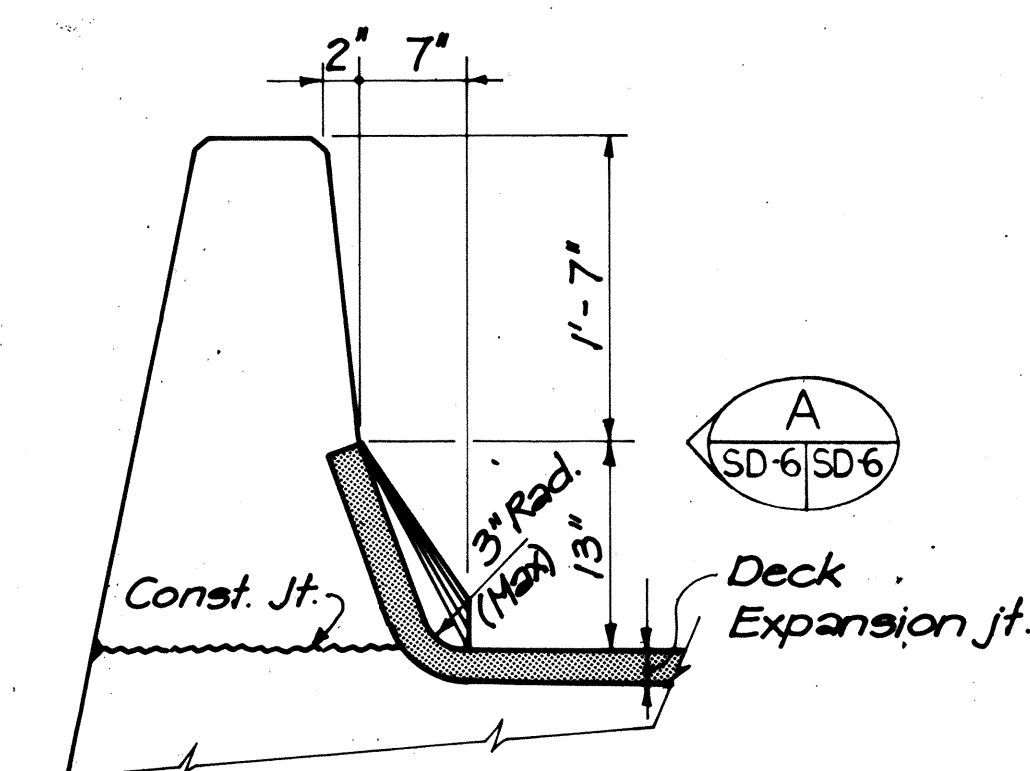


**TYPICAL SECTION AT STANDARD PARAPET**

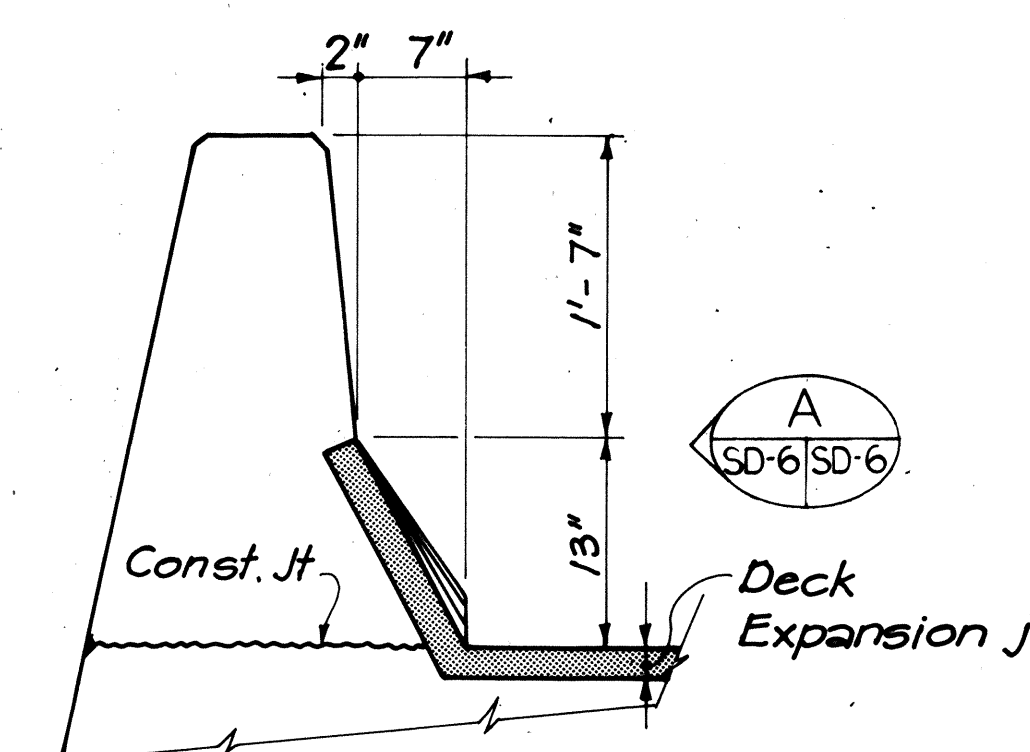


**ALTERNATE DETAIL AT PARAPET**  
N.T.S.

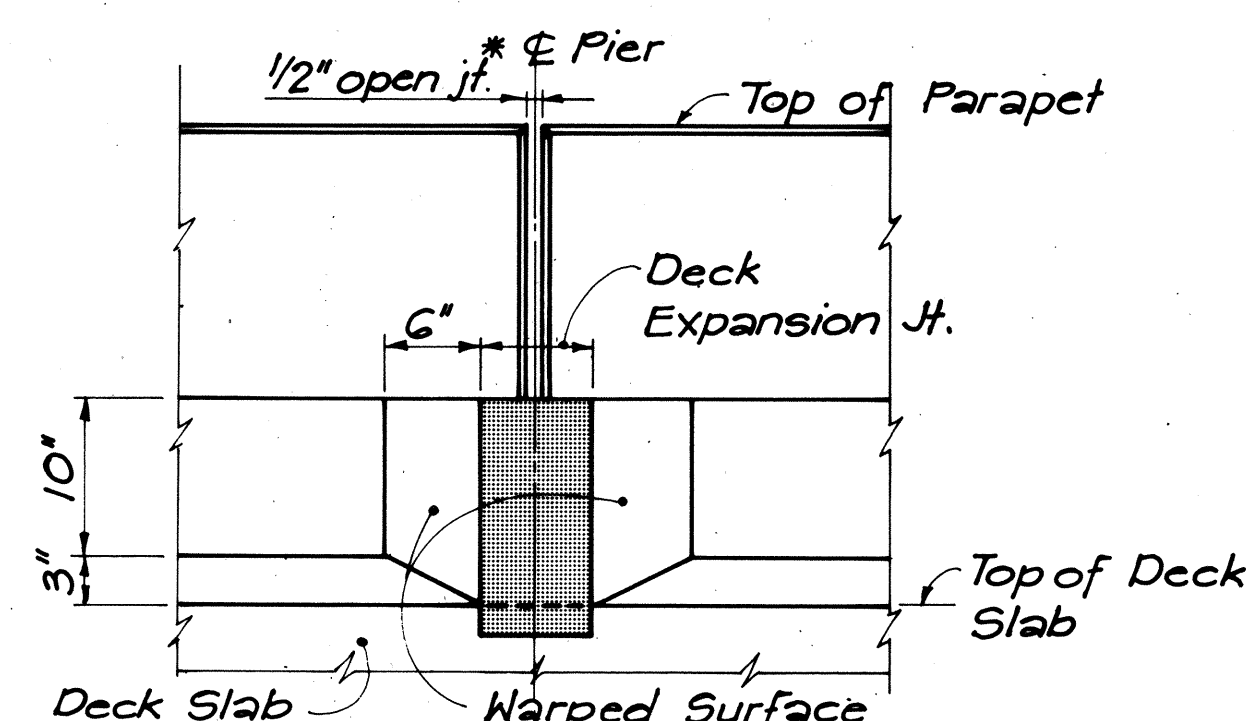


**VIEW A**  
N.T.S. SD-6/SD-6

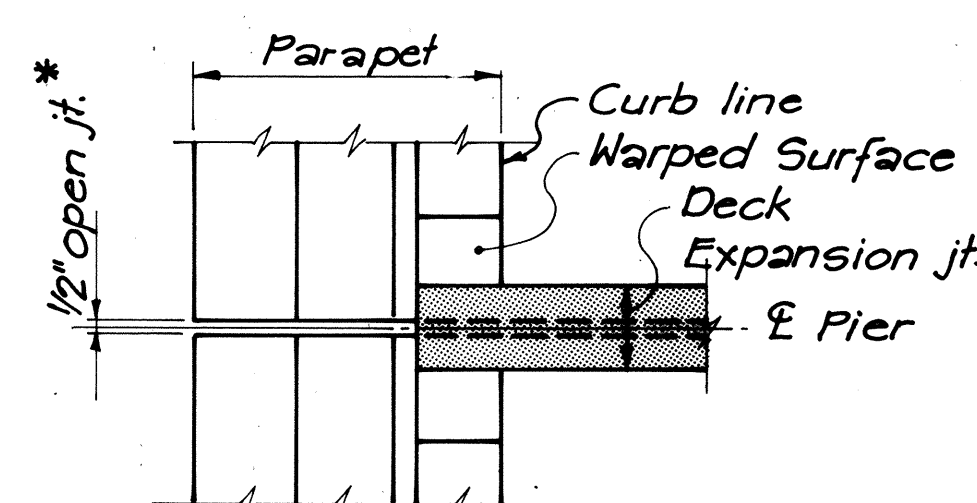


**TYPICAL PLAN - SKEW ANGLE = 0° - 15°**  
N.T.S.

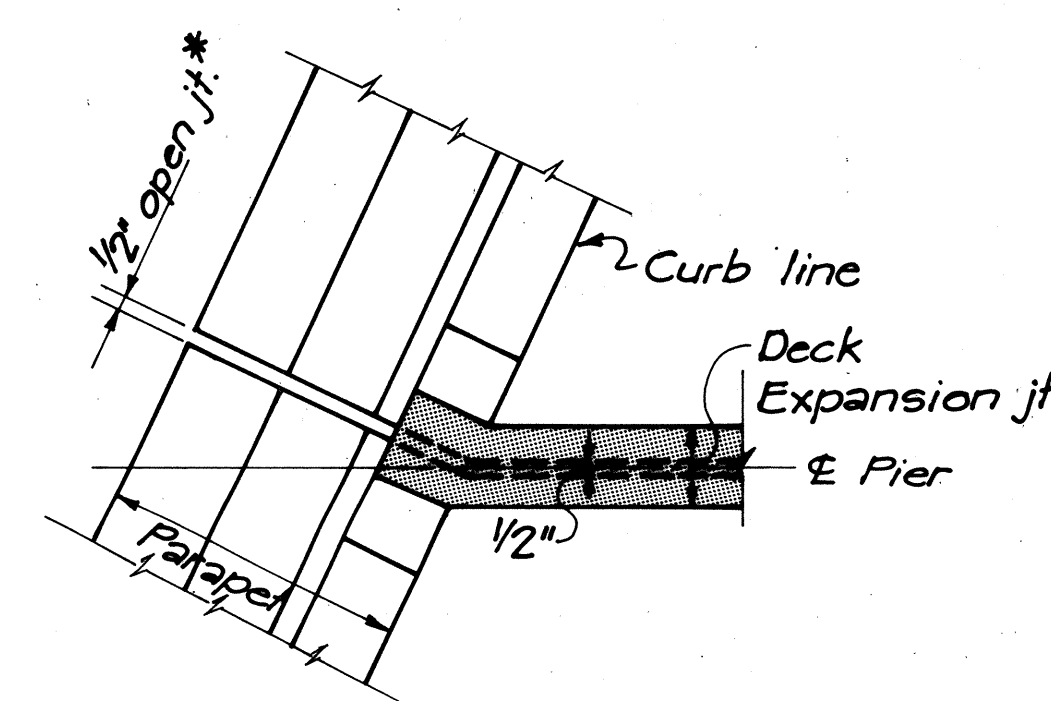


**TYPICAL PLAN - SKEW ANGLE = OVER 15°**  
N.T.S.

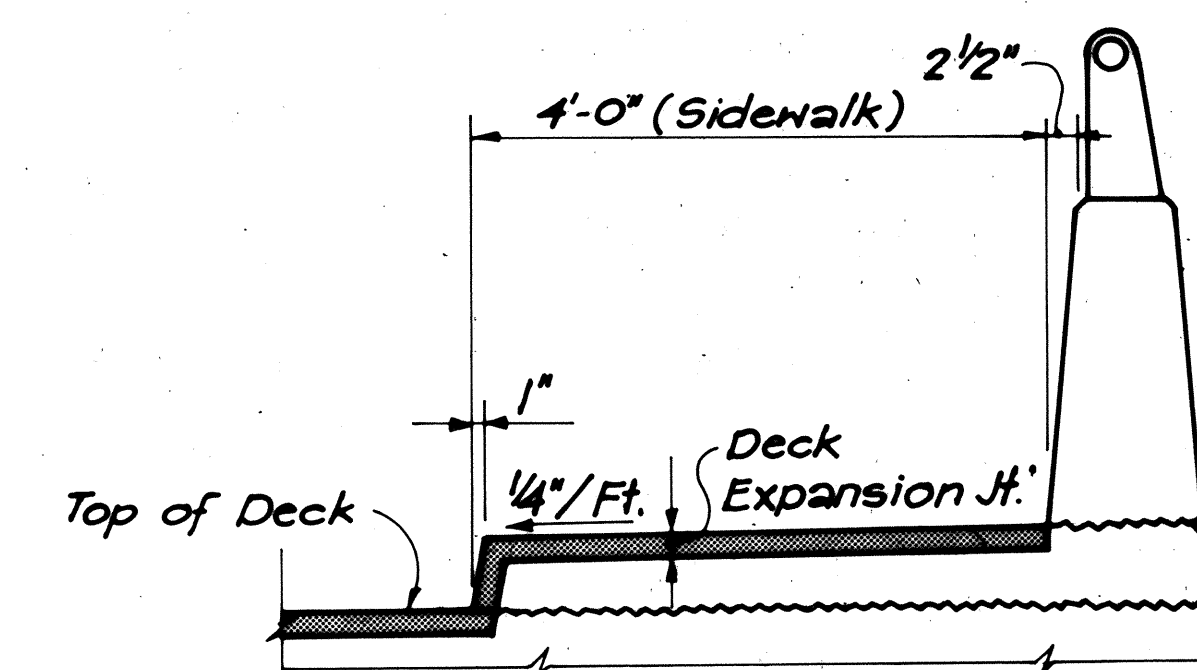

**TYPICAL SECTION AT SIDEWALK PARAPET**  
N.T.S.

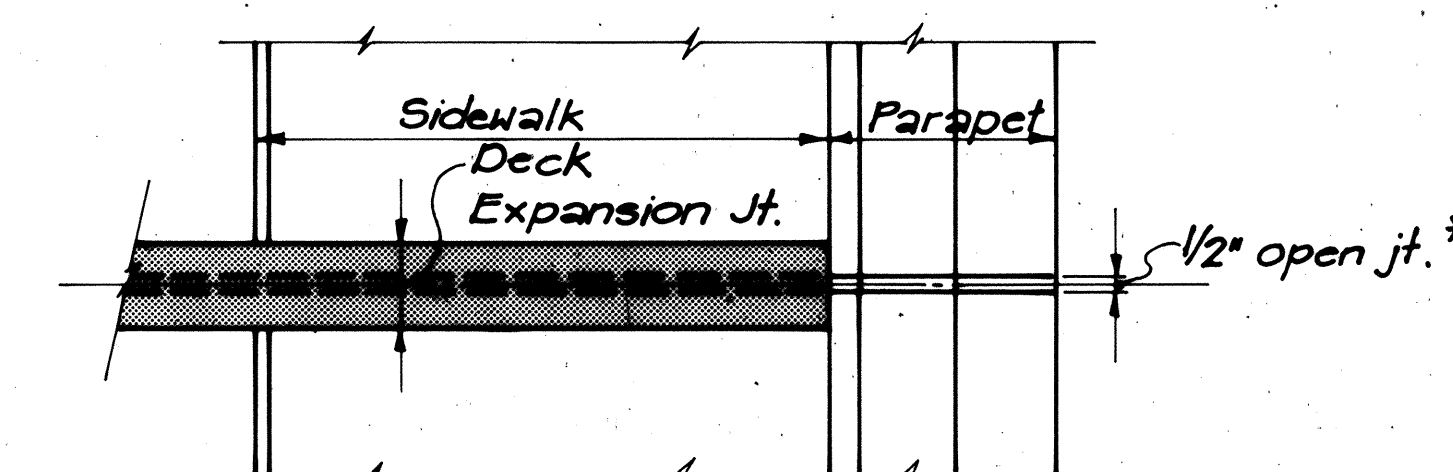

**TYPICAL PLAN**  
N.T.S.

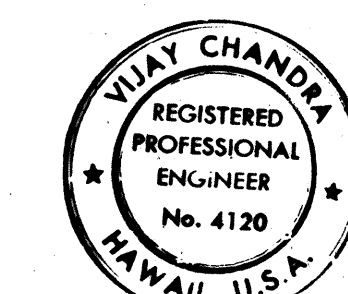

THIS WORK WAS PREPARED BY ME OR UNDER MY SUPERVISION.  
Vijay Chandra  
Signature

STATE OF HAWAII  
DEPARTMENT OF TRANSPORTATION  
HIGHWAYS DIVISION

STANDARD DETAILS


**DECK EXPANSION JOINT**  
SHEET 1 OF 2

KEEHI INTERCHANGE  
F.A.I. PROJECT NO. 1-HI-1(168)17  
SCALE: DATE: 8/17/81


SHEET No. Y-3 OF 11 SHEETS SD-6



| FED. ROAD DIST. NO. | STATE | FED. AID PROJ. NO. | FISCAL YEAR | SHEET NO. | TOTAL SHEETS |
|---------------------|-------|--------------------|-------------|-----------|--------------|
| HAWAII              | HAW.  | 1HH(168)17         | 1982        | 135       | 145          |

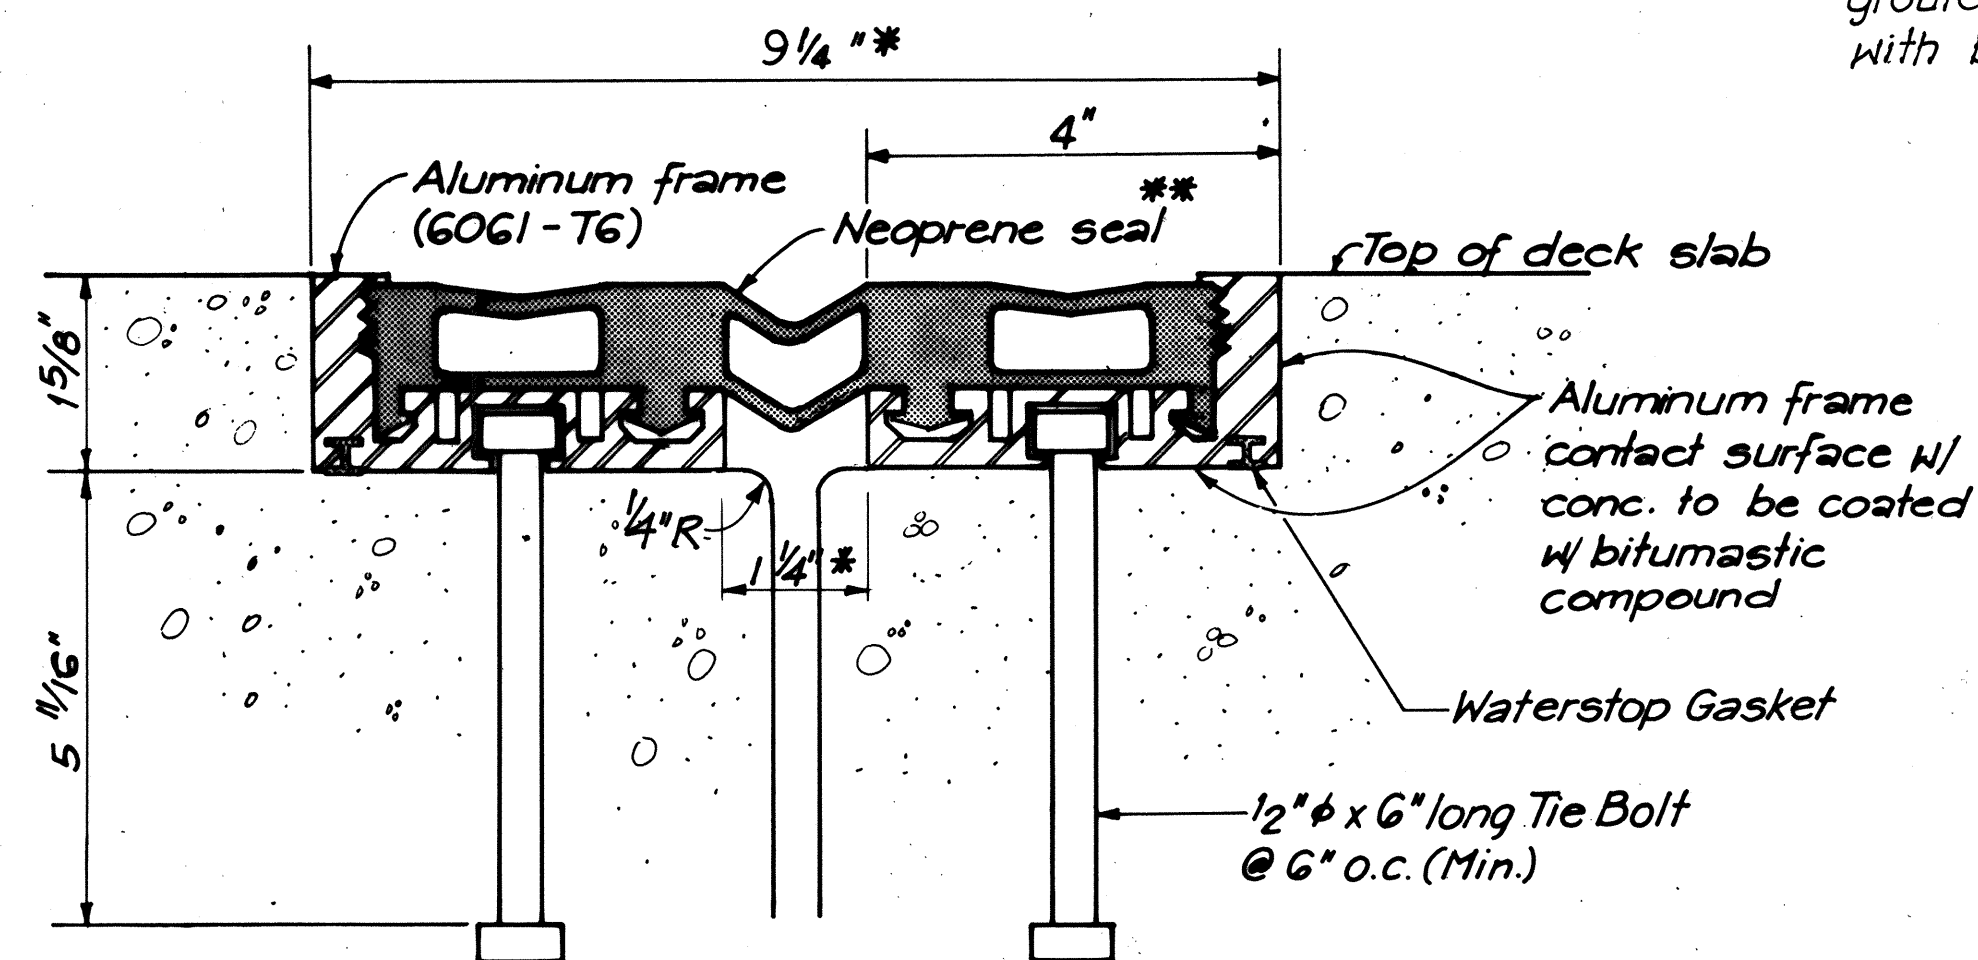


**DELASTIFLEX TYPE SM200**  
(Manufacturer: D.S. Brown & Co.)

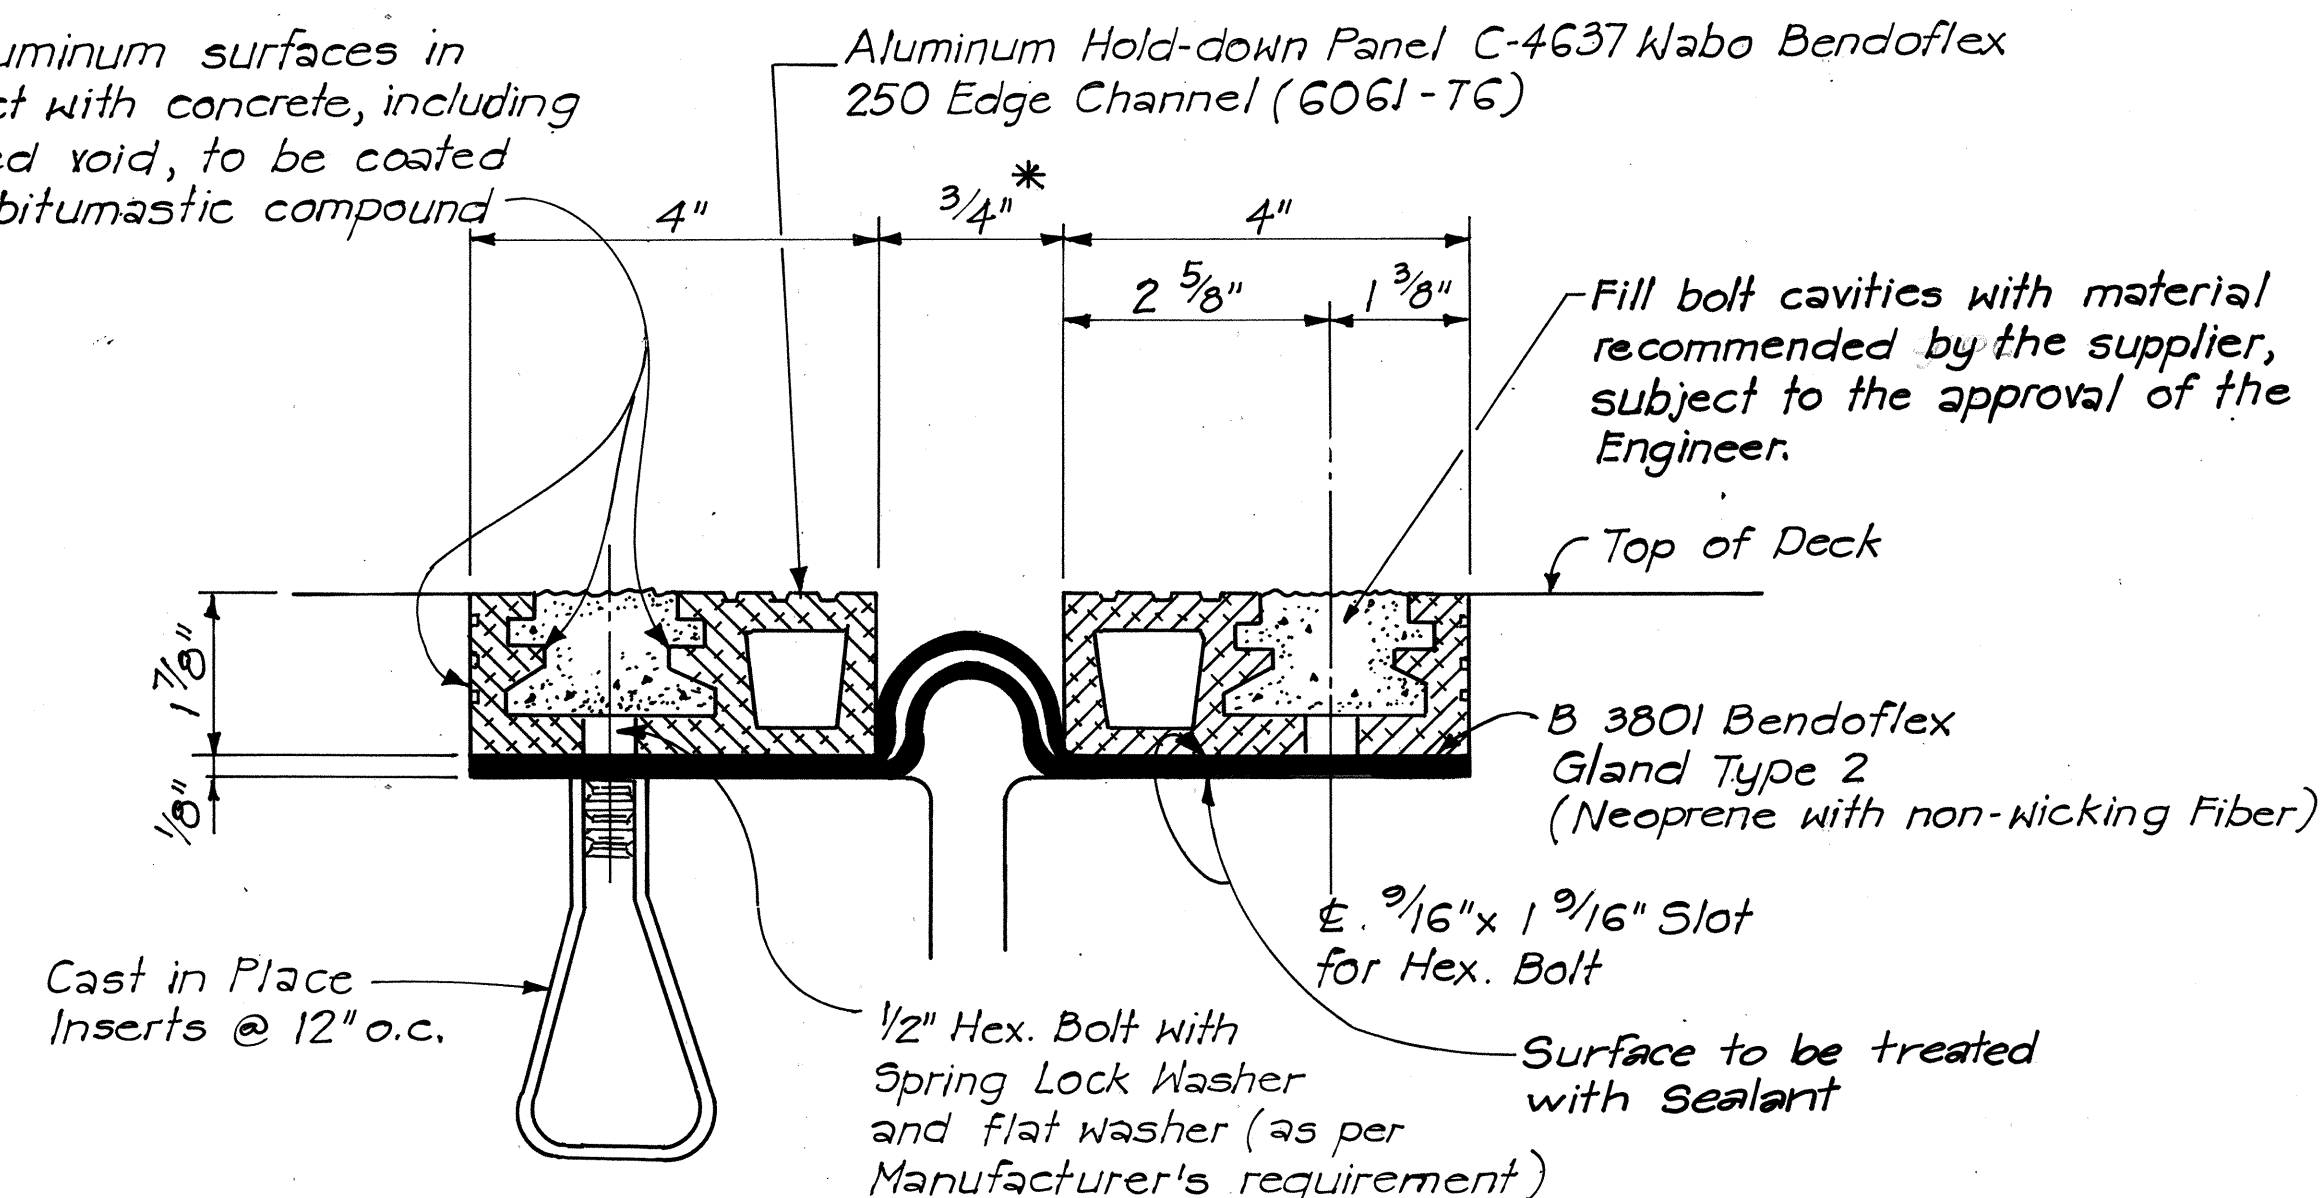

**WABO BENDOFLEX 250**  
(Manufacturer: Watson Bowman Ass. Inc.)

- \* = Installation width @ 75°F  
\*\* = Seal Gland or membrane shall be continuous across the full width of the Structure.

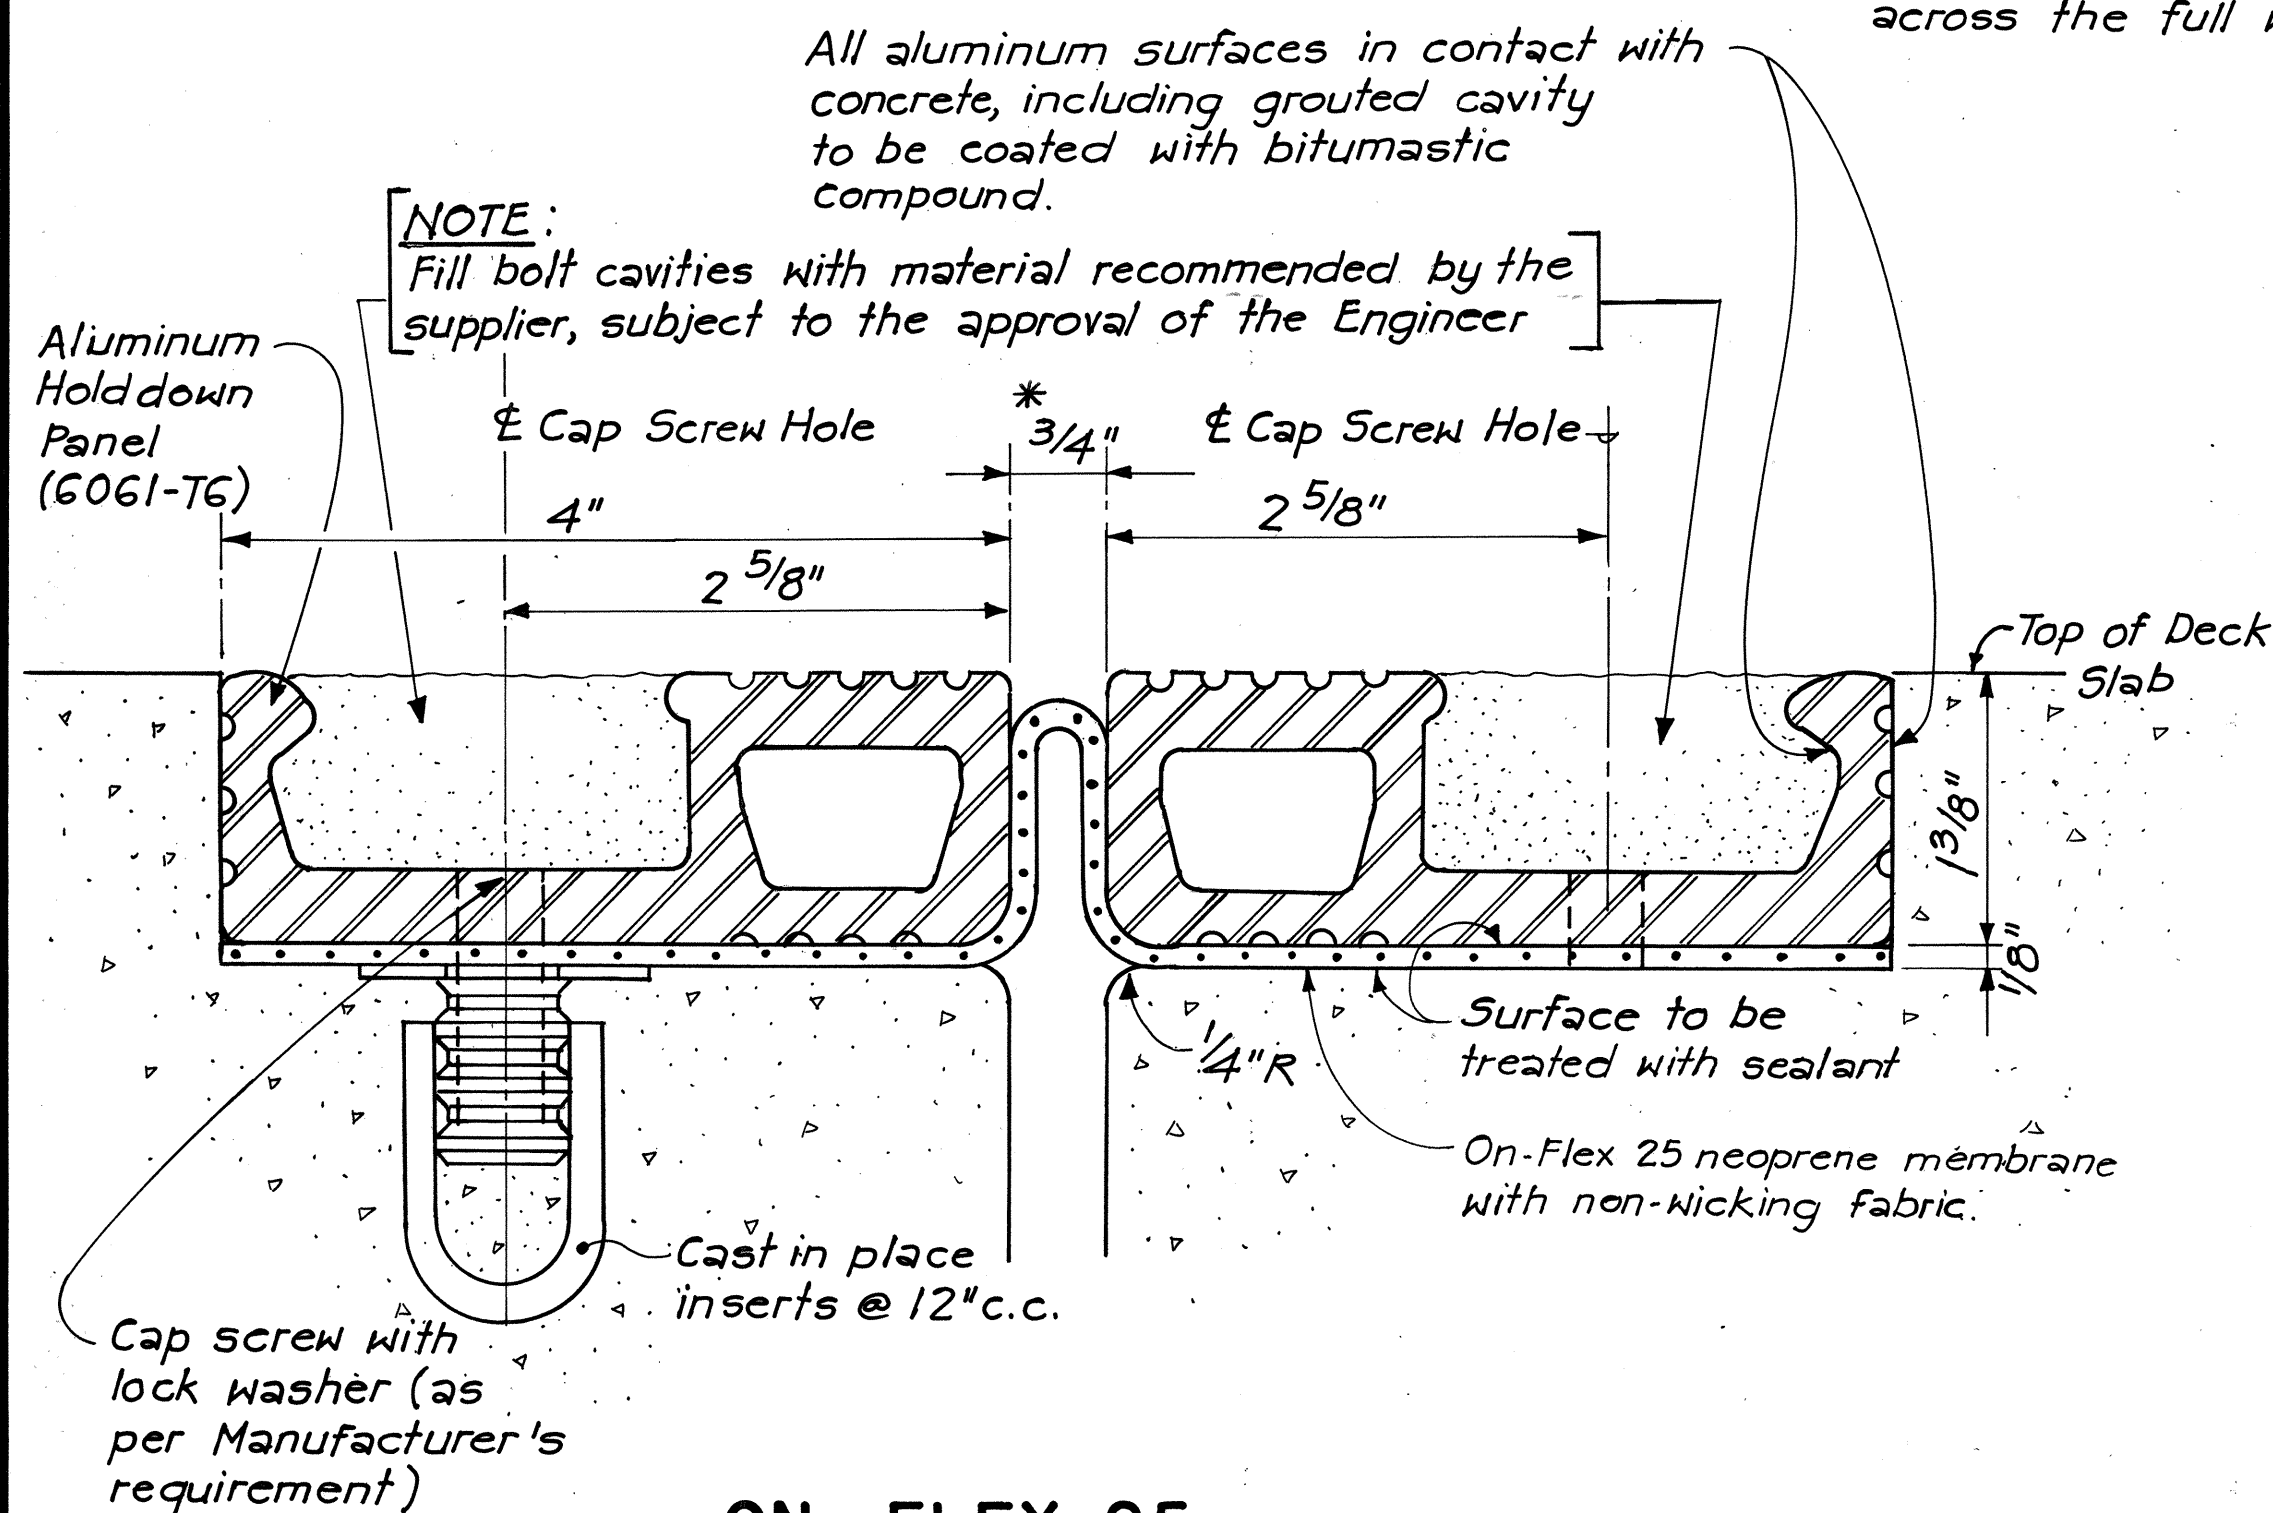

**ON-FLEX 25**  
(Manufacturer: Structural Accessories Inc.)

**NOTES:**

- Three alternative Deck Expansion Joint Systems are shown. Contractor has the option of selecting any one of the systems. The Contractor shall submit detailed shop drawings of the selected joint to the Engineer for approval.
- The Contractor also has the option of using an alternative Deck Expansion Joint System provided it complies with the requirements of the plans and specifications.

|                   |      |
|-------------------|------|
| SURVEY PLOTTED BY | DATE |
| DESIGNED BY       |      |
| QUANTITIES BY     |      |
| CHECKED BY        |      |
| ORIGINAL PLAN     |      |
| NOTE BOOK         |      |



HIS WORK WAS PREPARED BY ME  
OR UNDER MY SUPERVISION  
*John P. Johnson*

|                                                                                      |  |
|--------------------------------------------------------------------------------------|--|
| STATE OF HAWAII<br>DEPARTMENT OF TRANSPORTATION<br>HIGHWAYS DIVISION                 |  |
| STANDARD DETAILS<br>DECK EXPANSION JOINT<br>SHEET 2 OF 2                             |  |
| KEEHI INTERCHANGE<br>F.A.I. PROJECT NO. 1-HI-1 (168):17<br>SCALE: NONE DATE: 8/17/81 |  |
| SHEET NO. Y-4 OF 11 SHEETS SD-7                                                      |  |












| FED. ROAD DIST. NO. | STATE | FED. AID PROJ. NO. | FISCAL YEAR | SHEET NO. | TOTAL SHEETS |
|---------------------|-------|--------------------|-------------|-----------|--------------|
| HAWAII              | HAW.  | HI-1(168):17       | 1982        | 138       | 145          |


**NOTES FOR  
PILE TYPE A & PILE TYPE B**

- Concrete shall have a minimum 28-day compressive strength of 6500 psi. Required minimum concrete compressive strength before release of strands = 4000 psi.
- Pretensioned strands shall be 7 wire stress-relieved strands with an ultimate strength of 270 ksi. Diameter of strands shall be as shown on the Typical Pile Sections. Total loss due to creep, shrinkage, elastic shortening and relaxation of steel = 37,000 psi. Total working force shown on the Typical Pile Sections is the net force after all losses.
- Non-prestressed reinforcing steel for pile build up shall be A.S.T.M. A615 Grade 60. Spiral ties shall be cold drawn A.S.T.M. A02.
- For details of pile splices see sheet No. 5D-12.
- All piles shall have driving shoes.
- At the top of the top segment of the pile, a female splice as shown on Sheet 5D-12 shall be cast with the pile. No pile shall be driven without a female part of the splice at the top of the pile.
- The splice shall be designed for an ultimate moment of 120 ft. Kips.
- Portion of pile embedded into footing (or pile cap) shall be of sound concrete. Damaged portions shall be removed and pile shall be built-up to the cut-off elevation shown on the Plan.
- The plumb of pile shall be checked for conformance to the allowable tolerances, as specified in the Special Provisions, before constructing the build-ups.
- Work of cutting off Prestressed Concrete Piles or Concrete Build-ups shall be performed in such a manner as to avoid spalling or damaging the pile below cut-off. In case of such damage the pile shall be replaced or repaired by the Contractor at his own expense as directed by the Engineer.
- Piles are to be manufactured & installed in accordance with the tolerances specified in the Special Provisions. Piles not conforming to the tolerances shall be rejected and will not be paid for. The Contractor shall furnish necessary labor and/or equipment to aid the Engineer in passing the plumb bob through the central inspection hole of each pile. This shall be done in the fabrication yard and immediately after driving each pile. Such assistance shall be incidental to furnishing piles and will not be paid for separately.
- Defective piles (See Subsection 505.03 (G) of Special Provisions) shall be cut off 1'-0" below bottom of footing or finish grade whichever is lower.
- Driving on pile build-ups shall not be permitted.


**NOTE F:** The 5" Corrugated Plastic Pipe shall be similar or equal to, as determined by the Engineer, to the corrugated plastic drainage tubing manufactured by Advance Drainage Systems and shall have a wall thickness of 0.05 inches, 5.13 inches OD on outside of corrugation and 5.07 inches OD on inside of corrugation, and a pitch of 0.7 inches. The pipe shall be furnished in minimum lengths of 10 feet and shall be non-perforated. The 5" Corrugated Plastic Pipe shall be coupled to short 1/2" PVC pipe lengths at the pile splices. (See Arrangement of PVC pipe connections at pile splice, Sheet No. 5D-12.) The short 5" PVC pipe shall be schedule 40 (5.563" O.D., 5.047" I.D.) rigid pipe.

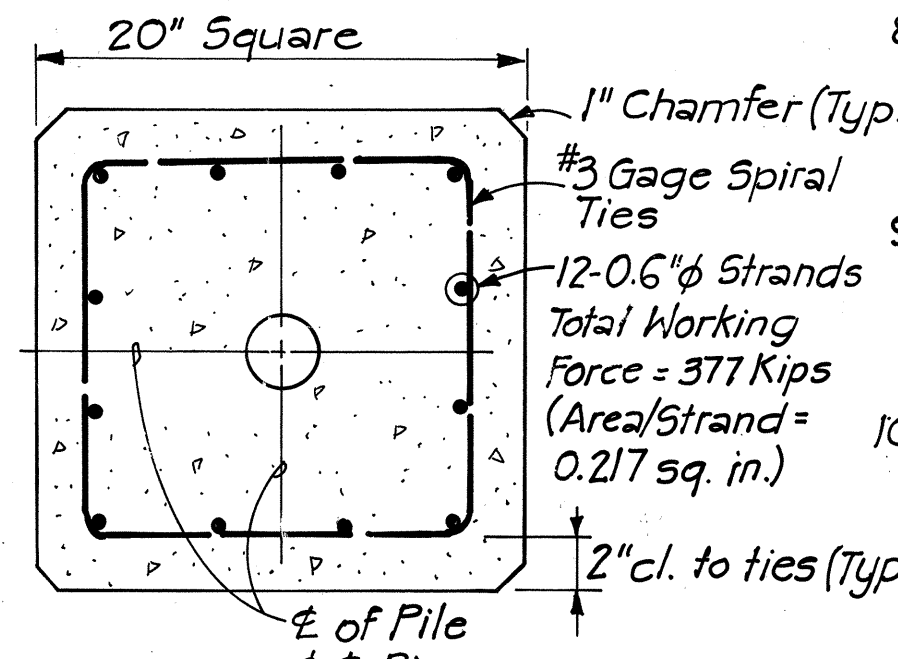

**OPTIONAL STRAND PATTERN**  
Scale: 1/2" = 1'-0"

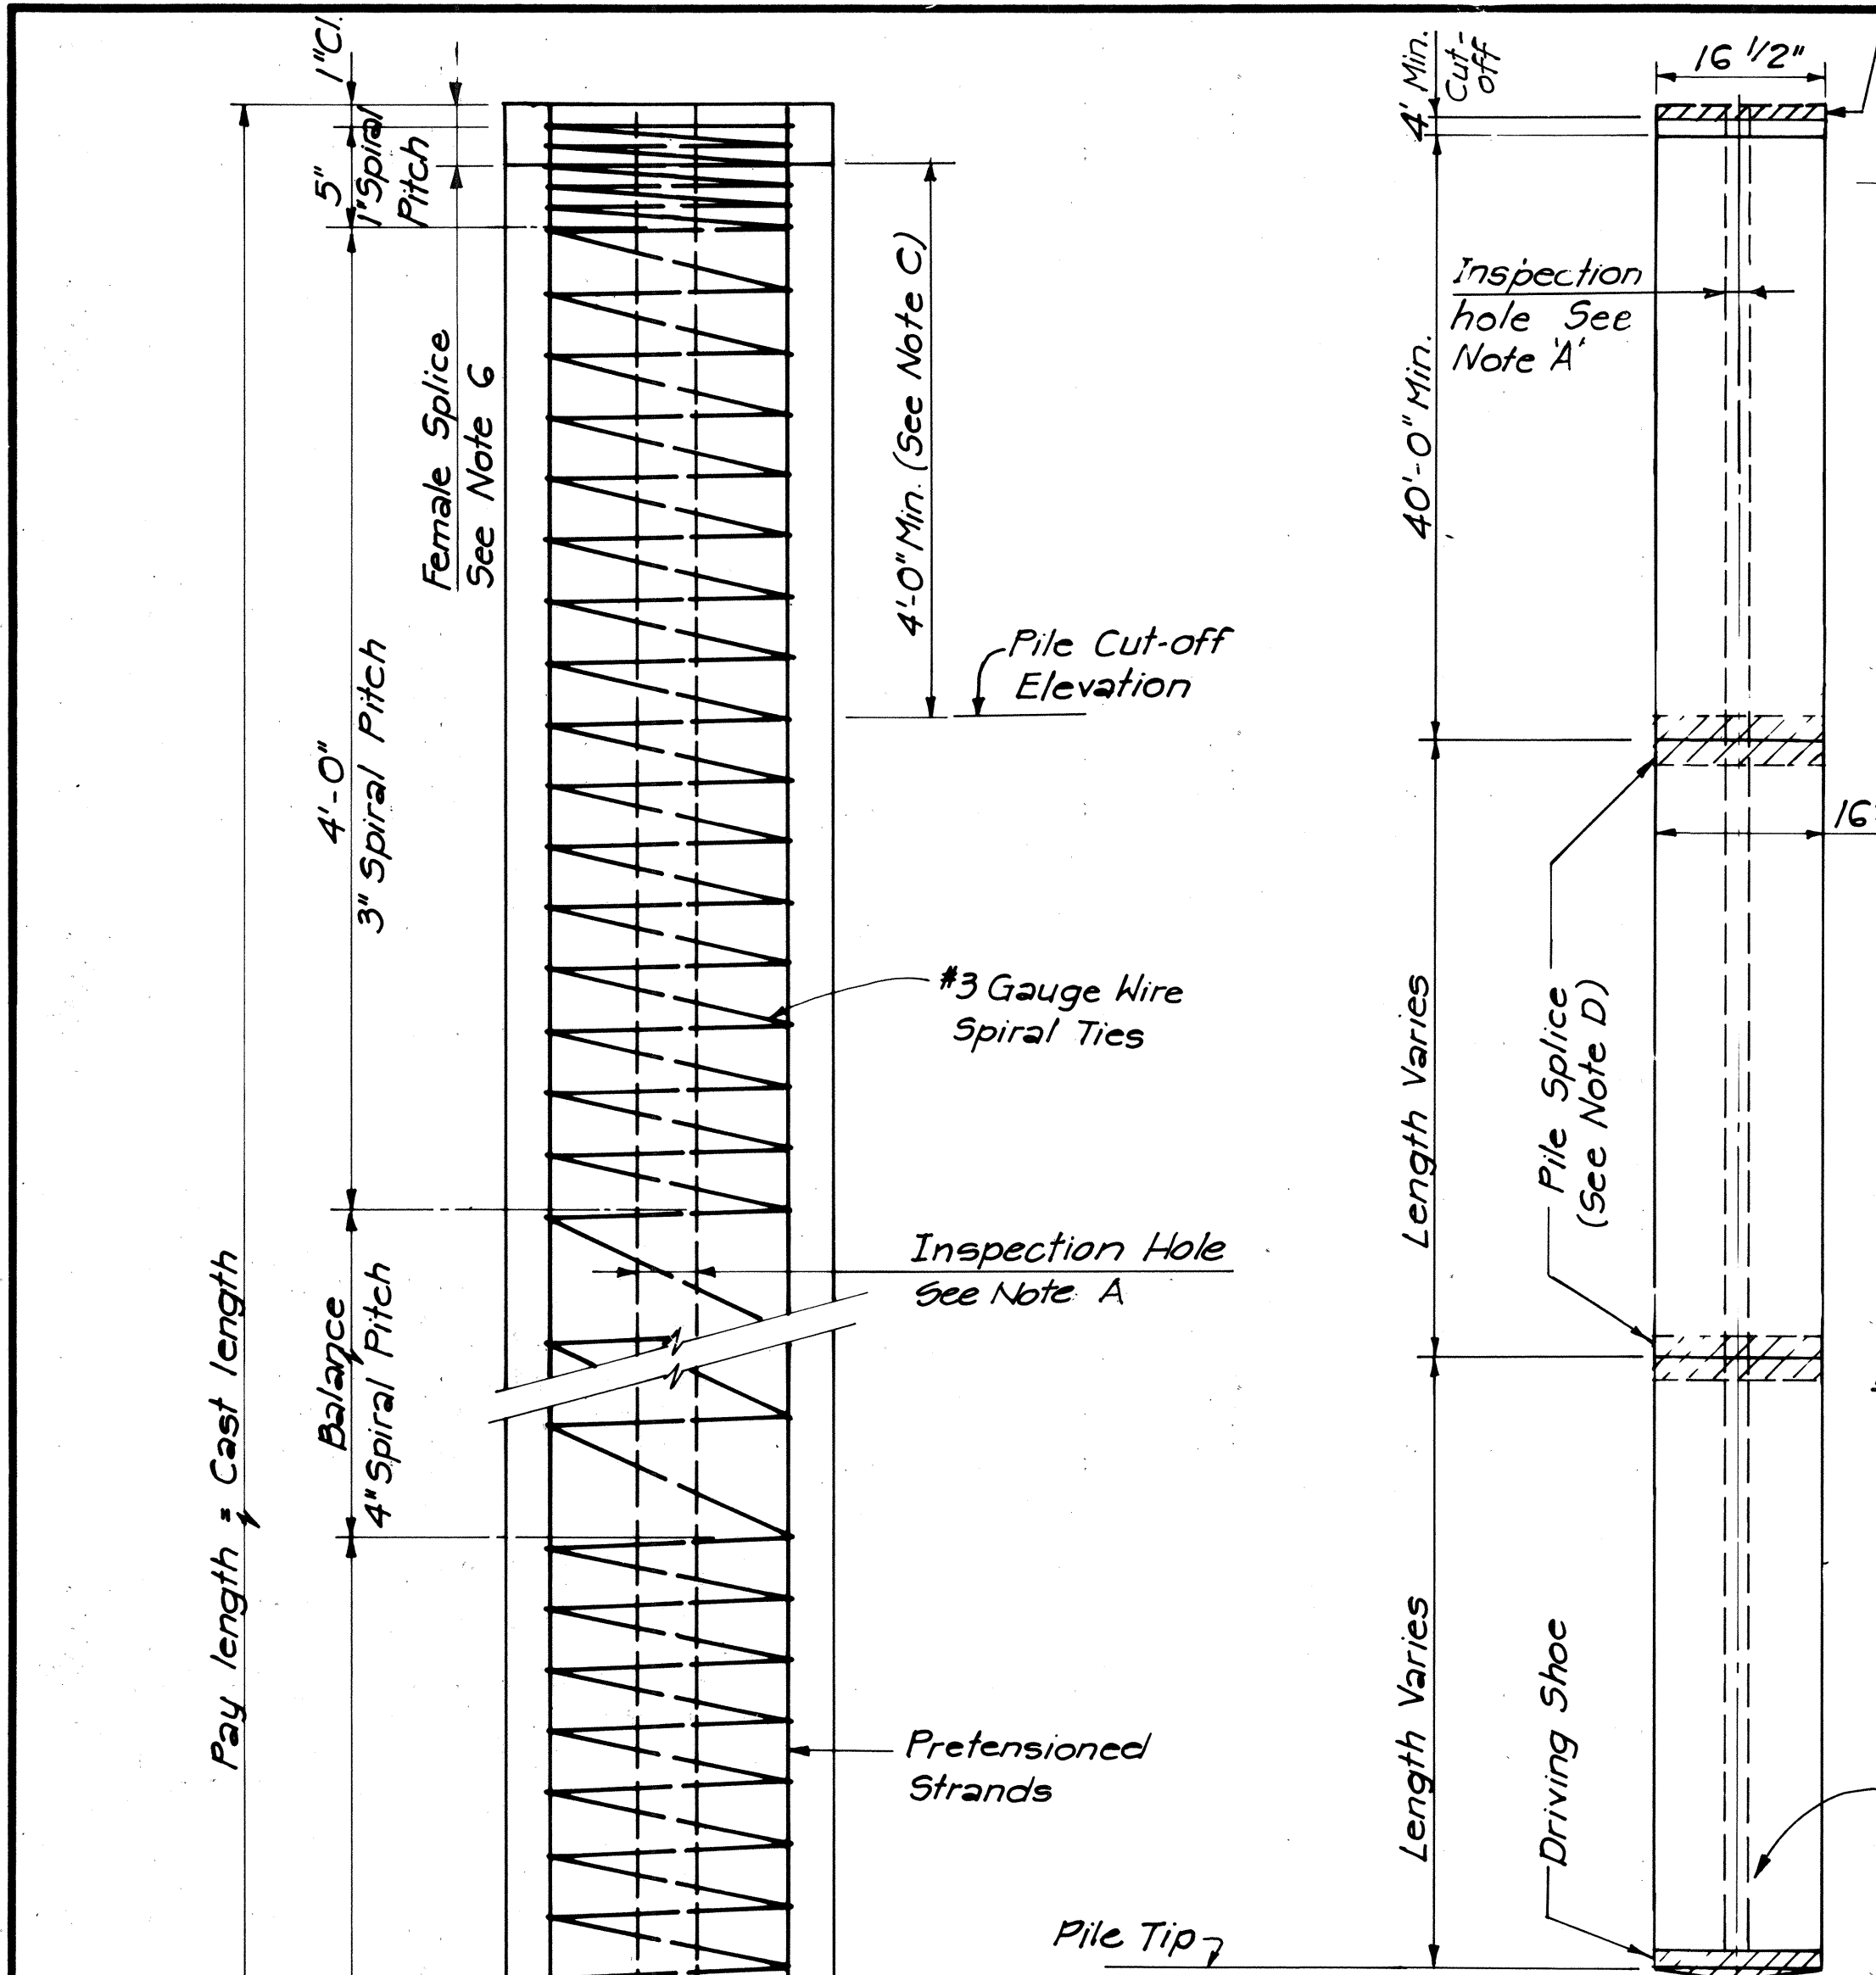


**PILE TYPE A**  
N.T.S.

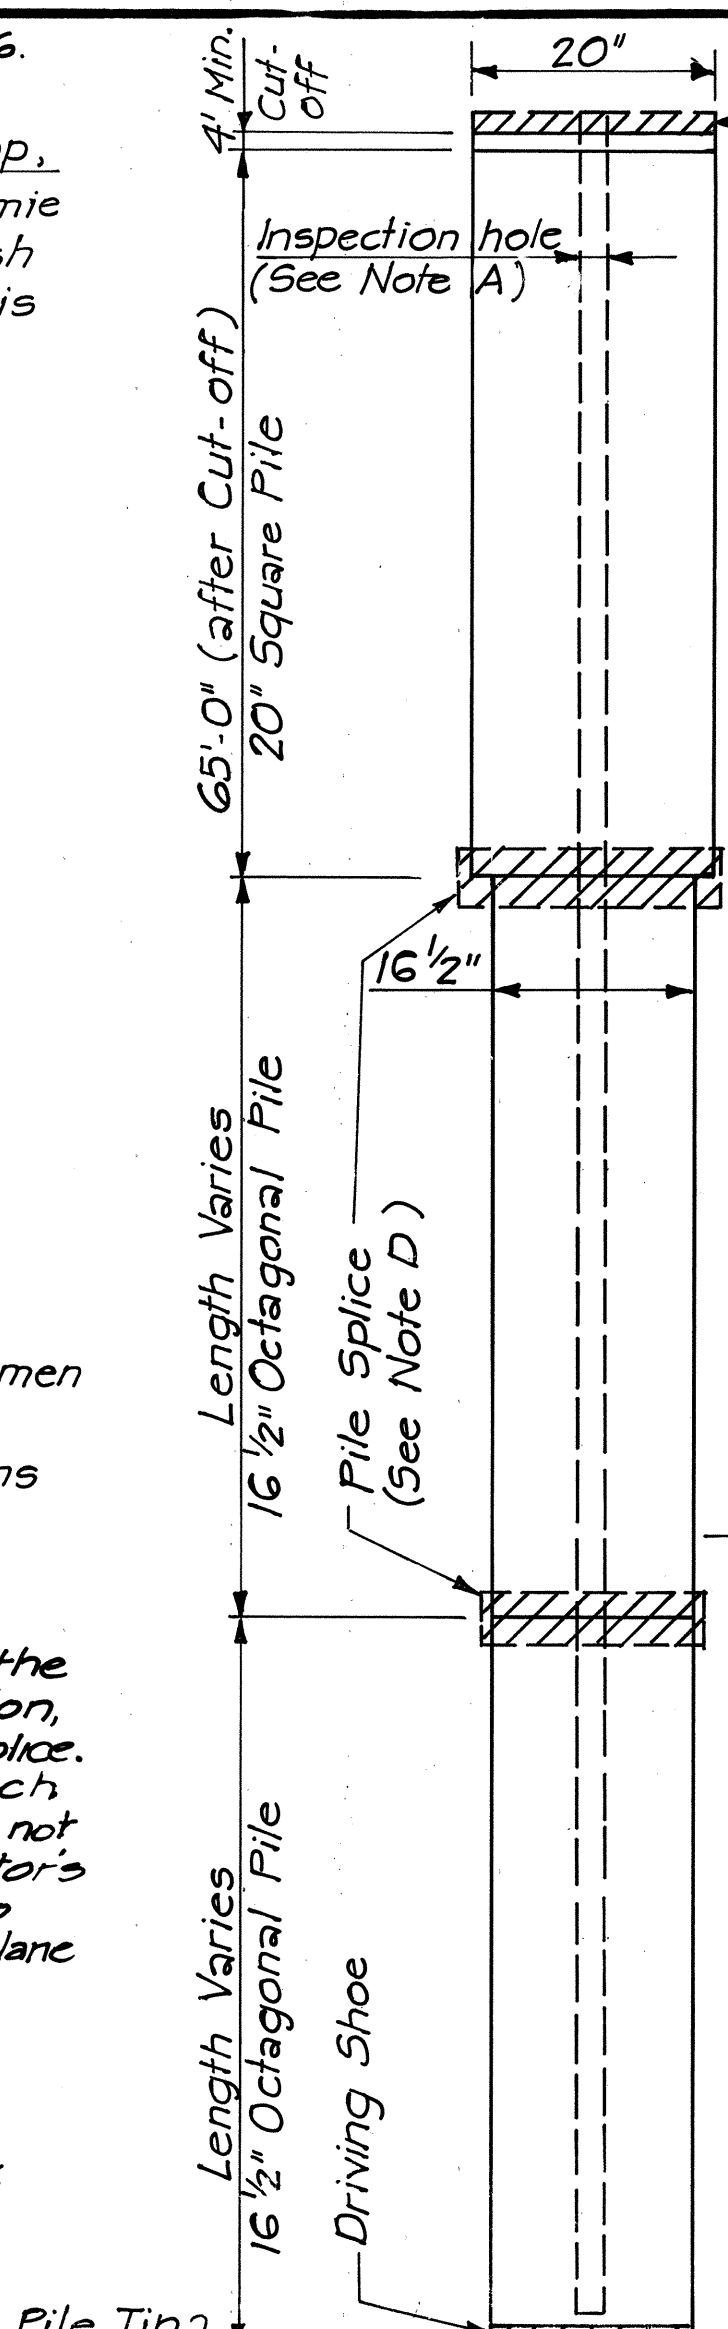



**PILE TYPE B**  
N.T.S.

- NOTE A:** Provide inspection holes in all piles as follows:  
1) All piles, except Load Test Piles shall have a 3" PVC Pipe cast in the center of the pile. The pipe shall have a radial tolerance of 1/8" off-set from center of pile except that within 3 feet of the ends of pile segments the radial tolerance shall be 1/4" off-set from the center of the pile. The 3" PVC Pipe shall be Schedule 40 (3.500" O.D., 3.068" I.D.) rigid plain end pipe with separate socket couplings. The allowable deviation from straight for the pipe is 1/8" in any 10 feet of length.  
2) Load Test Piles shall have a 5" Corrugated Plastic Pipe cast in the center of the pile instead of the 3" PVC pipe. The pipe shall be placed to the same tolerances specified for the 3" PVC pipe. For additional details see Note F.
- NOTE B:** The Bitumen Coating shall not protrude into Footing or Pile Cap. When a pile is exposed above ground, as in the case of certain pile bents, the bitumen coating shall be up to the finished grade (or stream bed) only. If the Pile Tip ends higher than the estimated Pile Tip Elevation, the Contractor shall remove the bitumen coating from the pile head that is to be embedded into the footing (or Pile Cap), or the portion above the finished grade, as applicable. Payment for removal is incidental to various contr. items.
- NOTE C:** Remove concrete over this length from top of top segment of pile. Leave Strands & Dowels exposed, for embedment into footing (or pile cap). Cut-off of concrete shall be normal to the axis of pile. For pile cut-off elevations see Foundation Plans.


**TYPICAL PILE DETAIL**  
N.T.S.

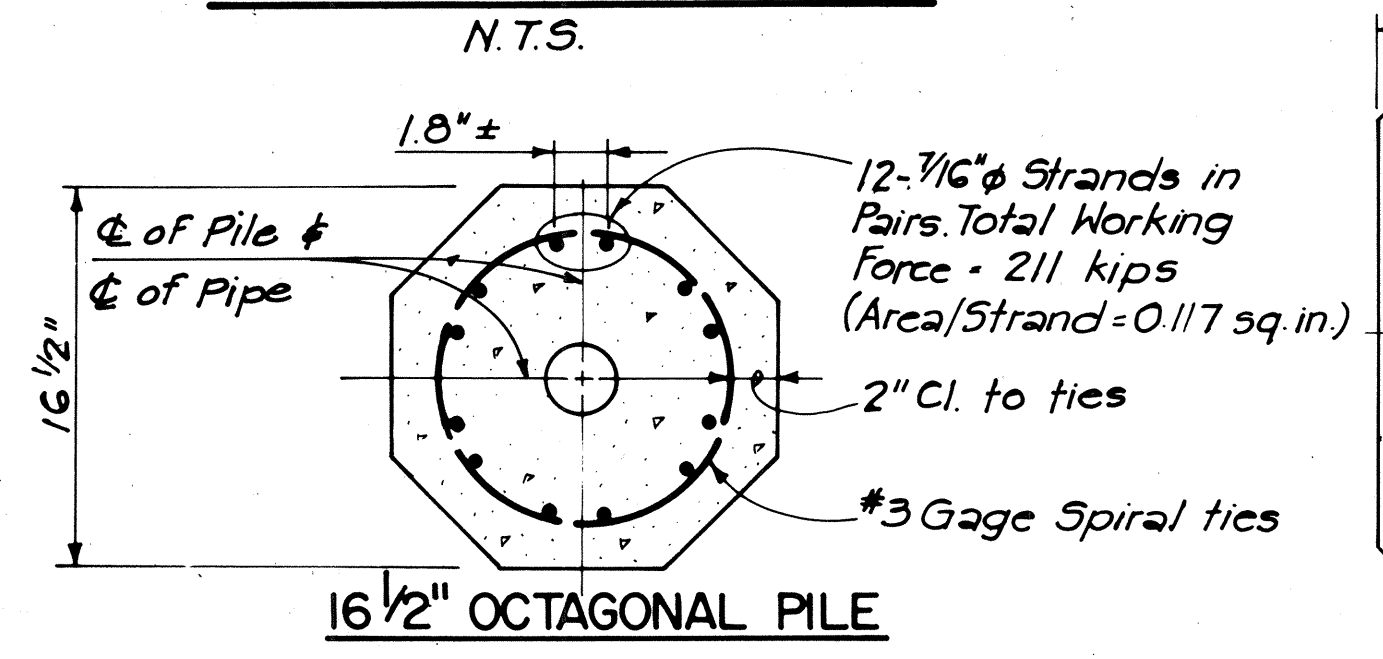

**TYPICAL PILE SECTION**  
Scale: 1/2" = 1'-0"

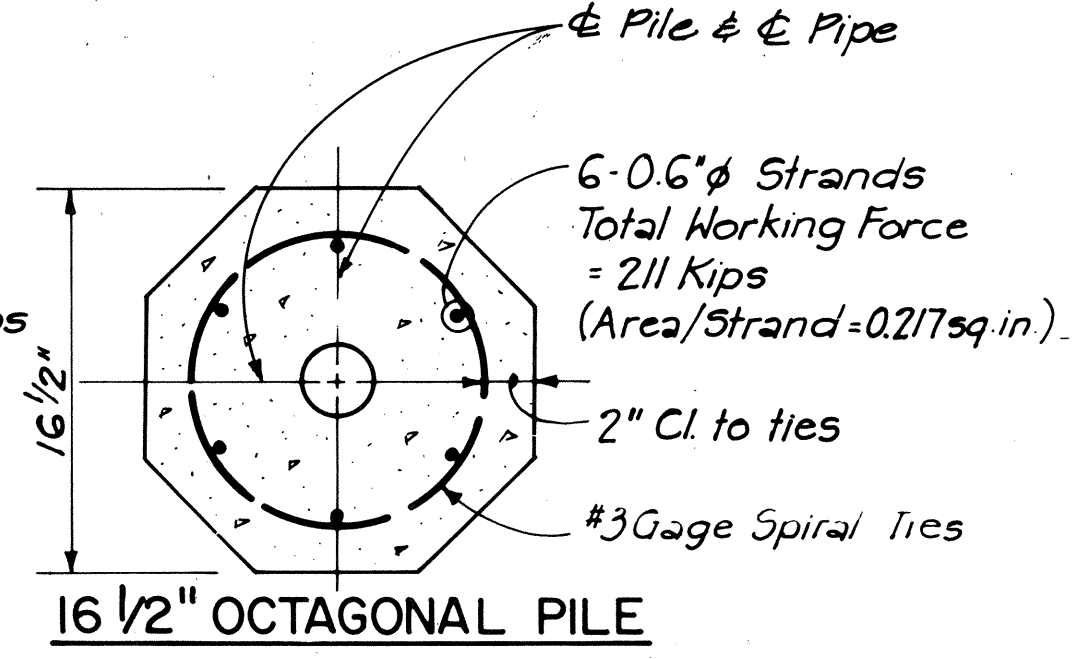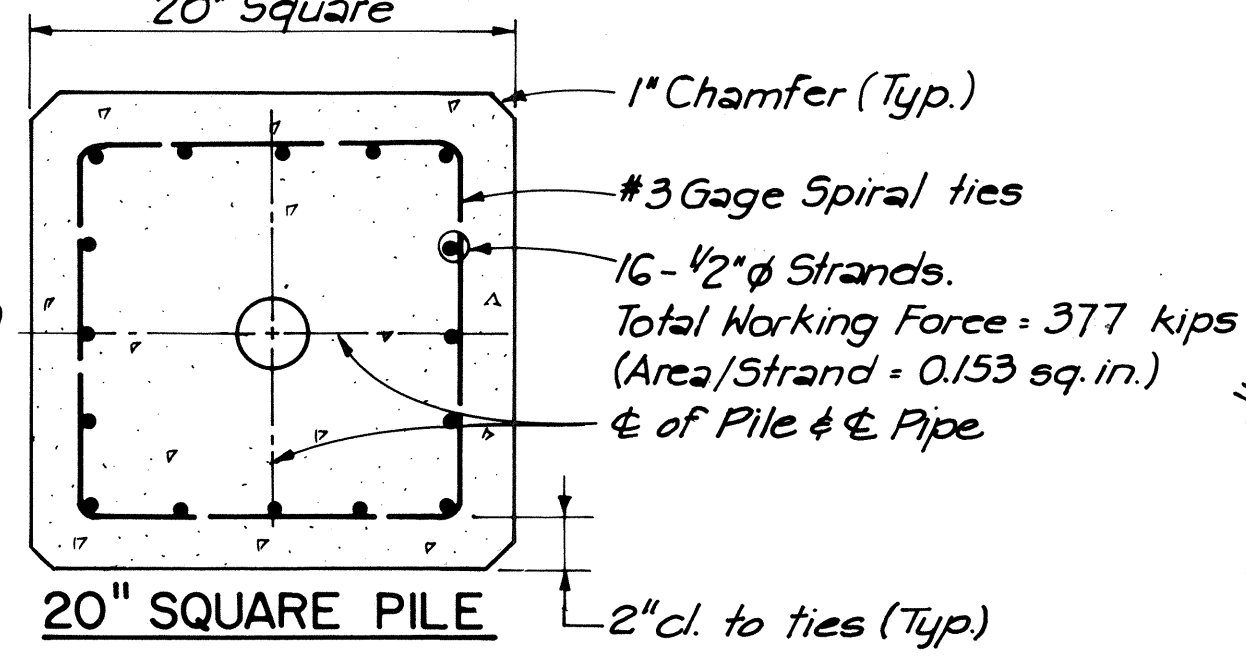

**OPTIONAL STRAND PATTERN**  
Scale: 1/2" = 1'-0"

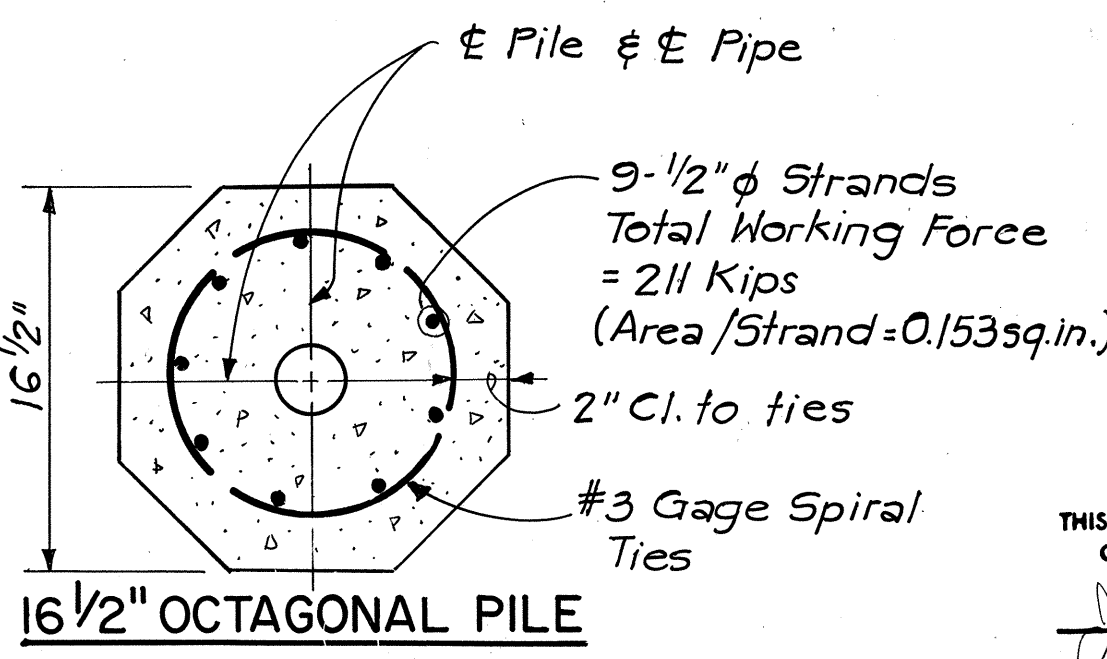

THIS WORK WAS PREPARED BY ME  
OR UNDER MY SUPERVISION.  
*John P. Johnson*  
REGISTERED PROFESSIONAL ENGINEER  
No. 3647  
HAWAII, U.S.A.

STATE OF HAWAII  
DEPARTMENT OF TRANSPORTATION  
HIGHWAYS DIVISION  
STANDARD DETAILS  
**PRESTRESSED CONCRETE PILES**

SHEET 1 OF 3  
KEEHI INTERCHANGE  
F.A.I. PROJECT NO. I-HI-1(168):17  
SCALE: AS SHOWN  
DATE: \_\_\_\_\_

SHEET NO. Y-7 OF 11 SHEETS 5D-10




| FED. ROAD DIST. NO. | STATE | FED. AID PROJ. NO. | FISCAL YEAR | SHEET NO. | TOTAL SHEETS |
|---------------------|-------|--------------------|-------------|-----------|--------------|
| HAWAII              | HAW.  | 1-HI-1(168)17      | 1982        | 139       | 145          |


| TABLE OF PILE LOAD TESTS & APPLICABLE FOOTINGS |                                                                           |
|------------------------------------------------|---------------------------------------------------------------------------|
| Pile Load Test at Pier Number                  | Applicable to Pier Footings                                               |
| MG**                                           | AI, AII, AIII<br>A1 thru A5, NE1, NE2, NE3, HE1, HE2, HE3, HV1, HV2 & HV3 |
| HG**                                           | HE4, HE5, HV4 & HV5                                                       |
| M13**                                          | B1, B2, AG thru A9, & NE4 thru NE7                                        |
| M19**                                          | NE8 & A10                                                                 |

This table subject to change, depending on results of Test Driving Piles.


\*\* Denotes Load Test Performed in prior Contracts by Others.

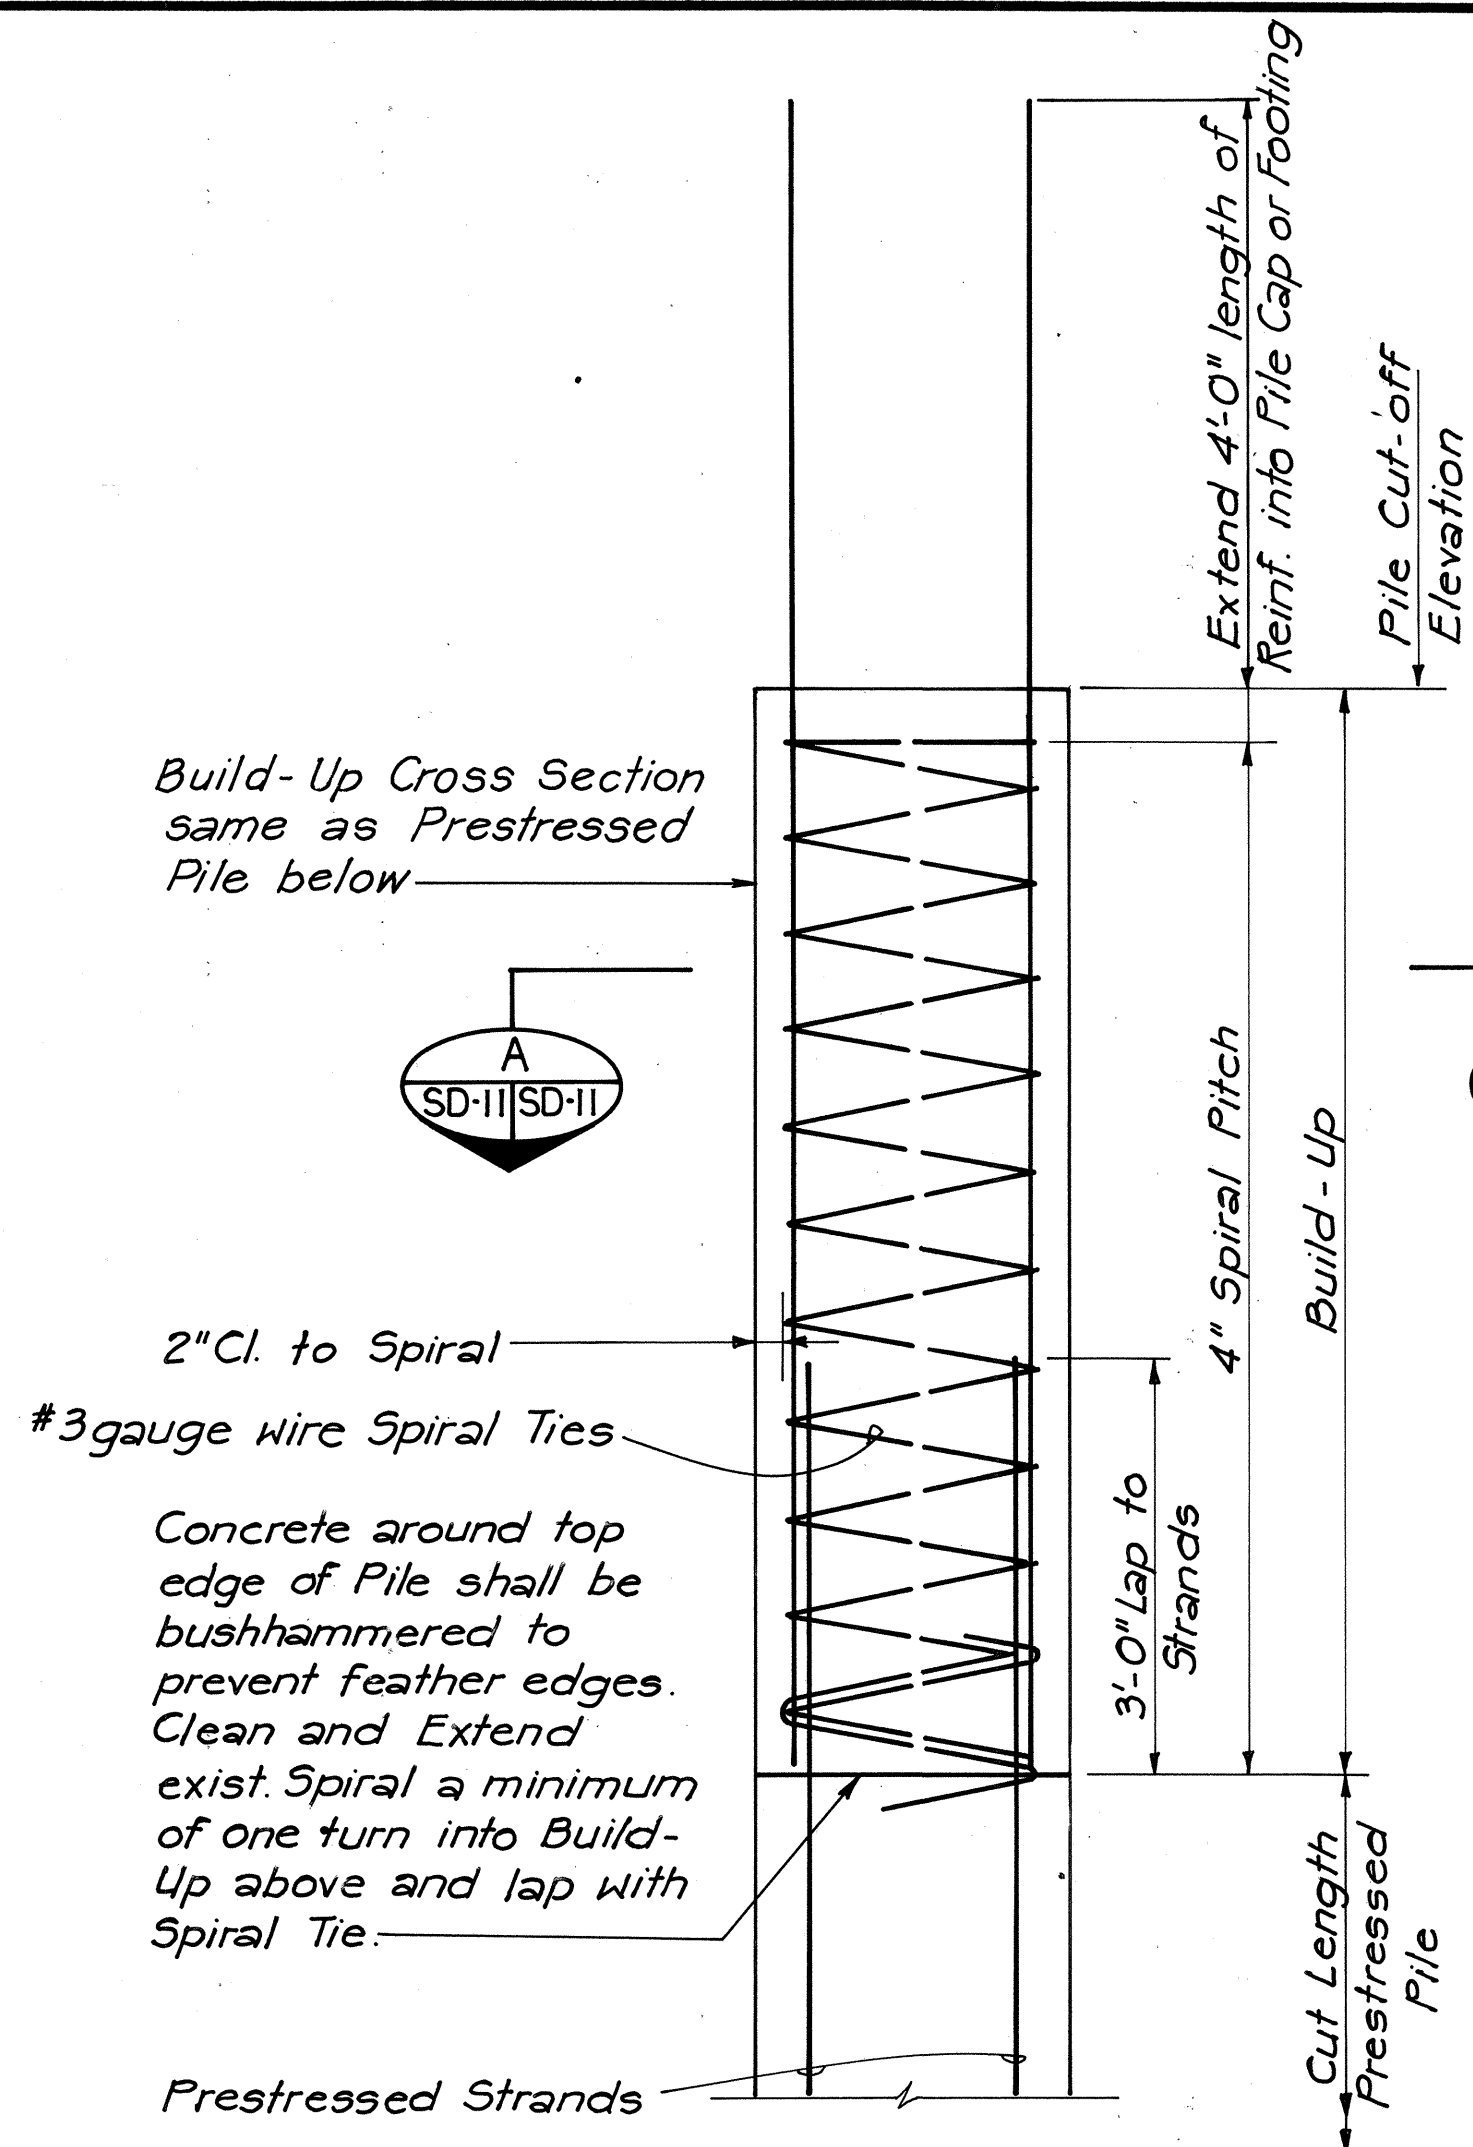

WITHOUT DRIVING  
TYPICAL PILE BUILD-UP DETAILS  
N.T.S.

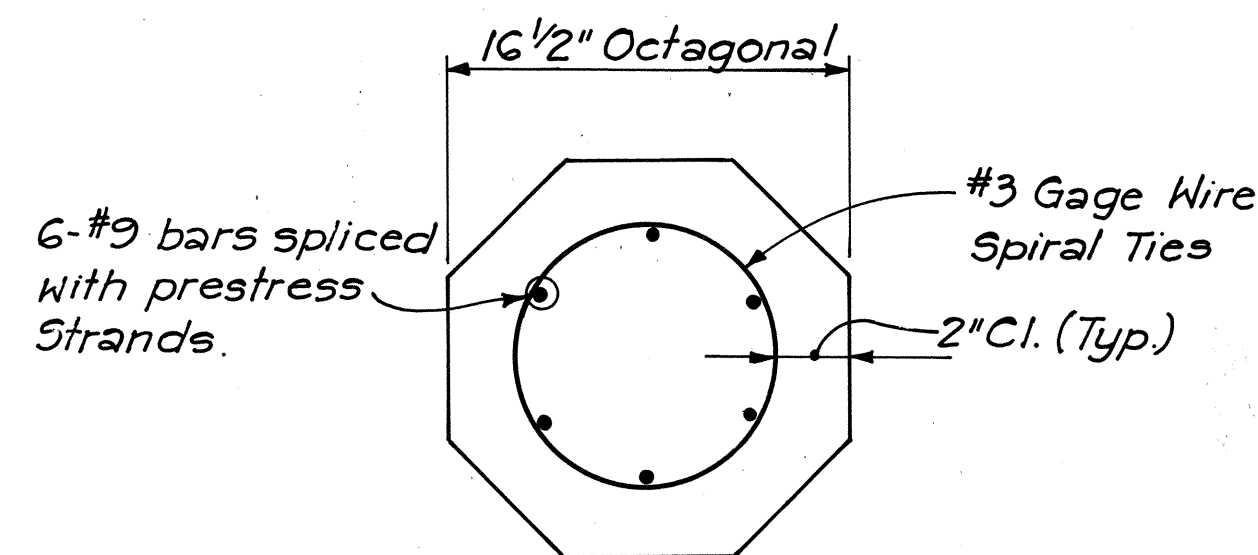


SECTION A  
Scale: 1 1/2" = 1'-0"

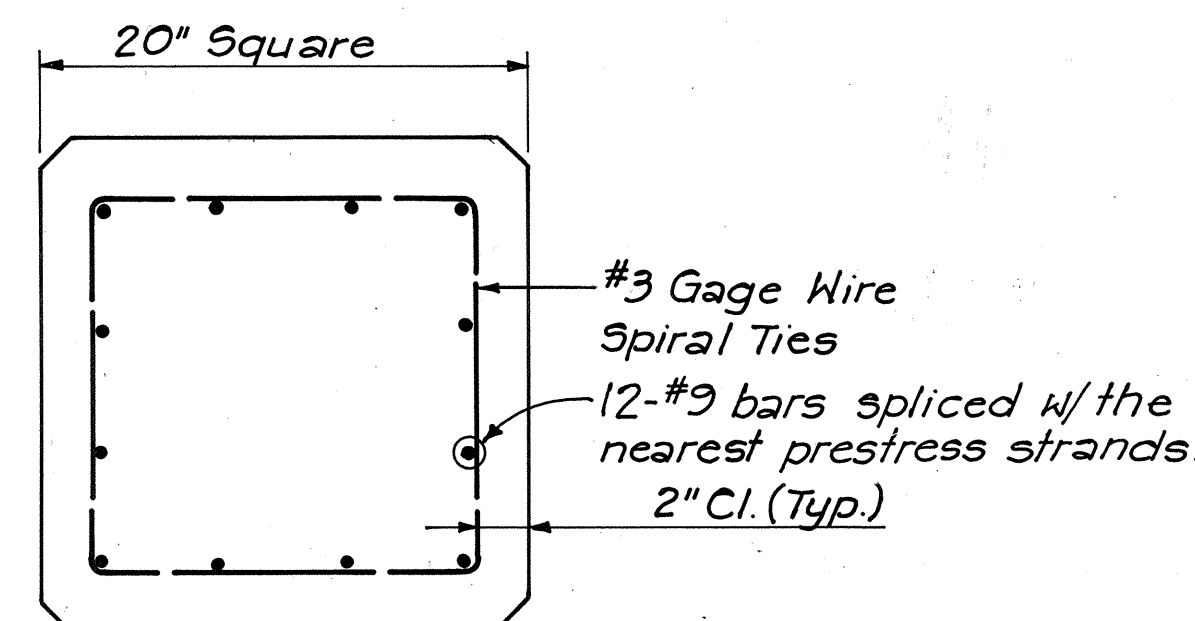


SECTION A  
Scale: 1 1/2" = 1'-0"

NOTE:


Concrete in pile build-ups shall have a minimum comp. cyl. strength  $f_c'$  of 5,000 psi at 28 days.

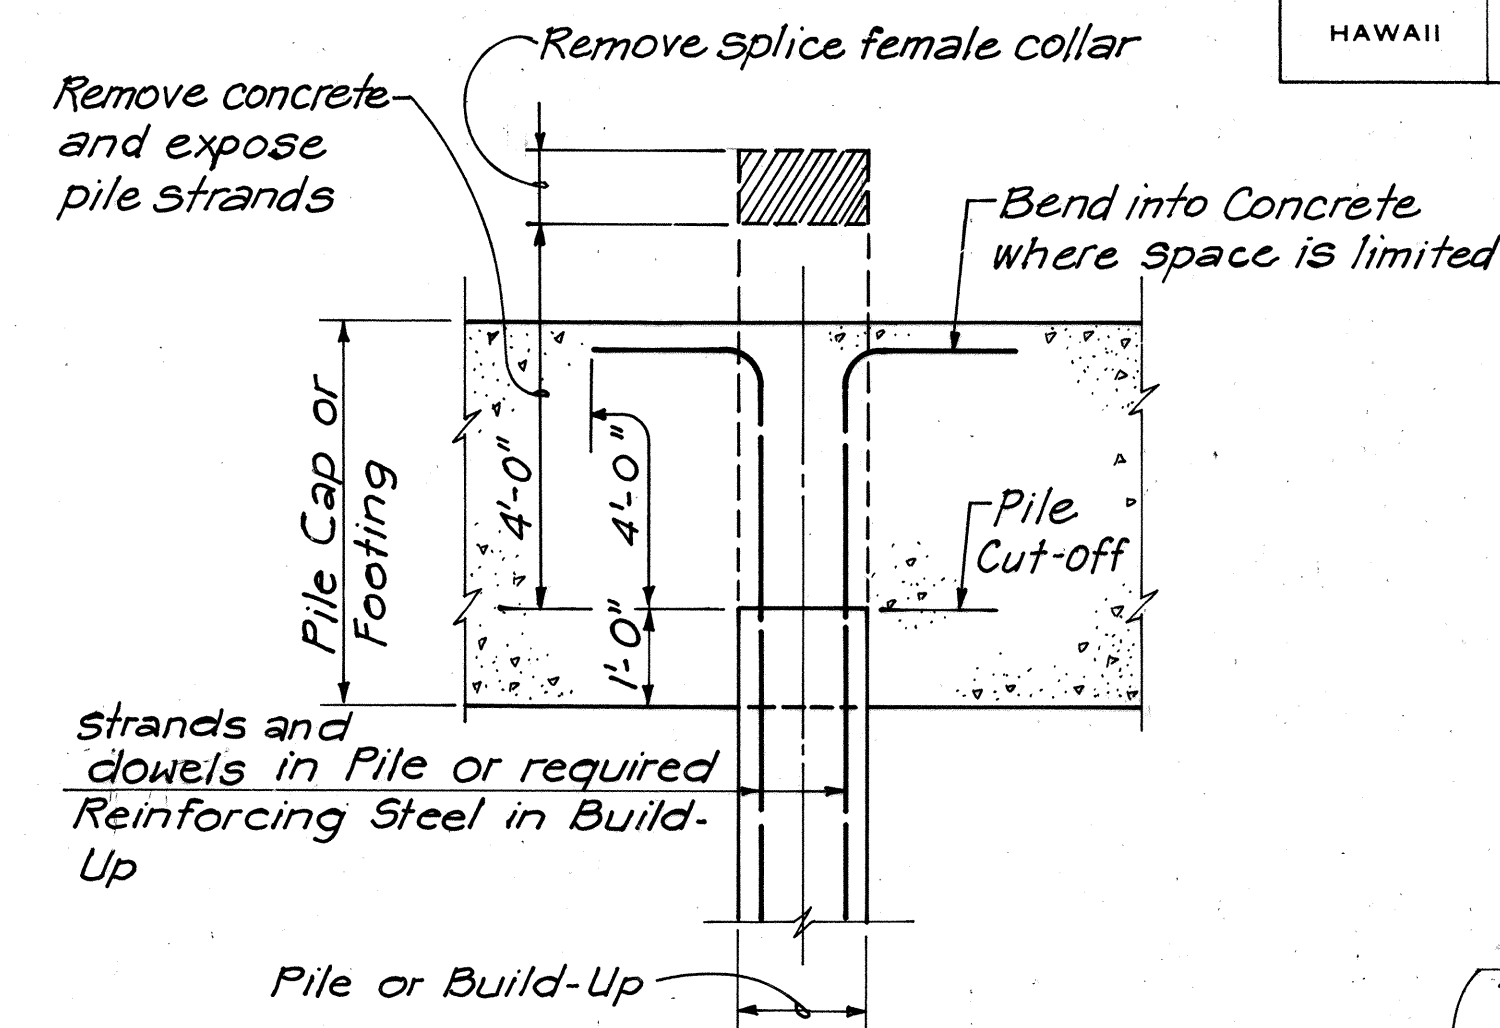


PILE REINFORCEMENT  
EXTENSION DETAIL  
Scale: 1/2" = 1'-0"

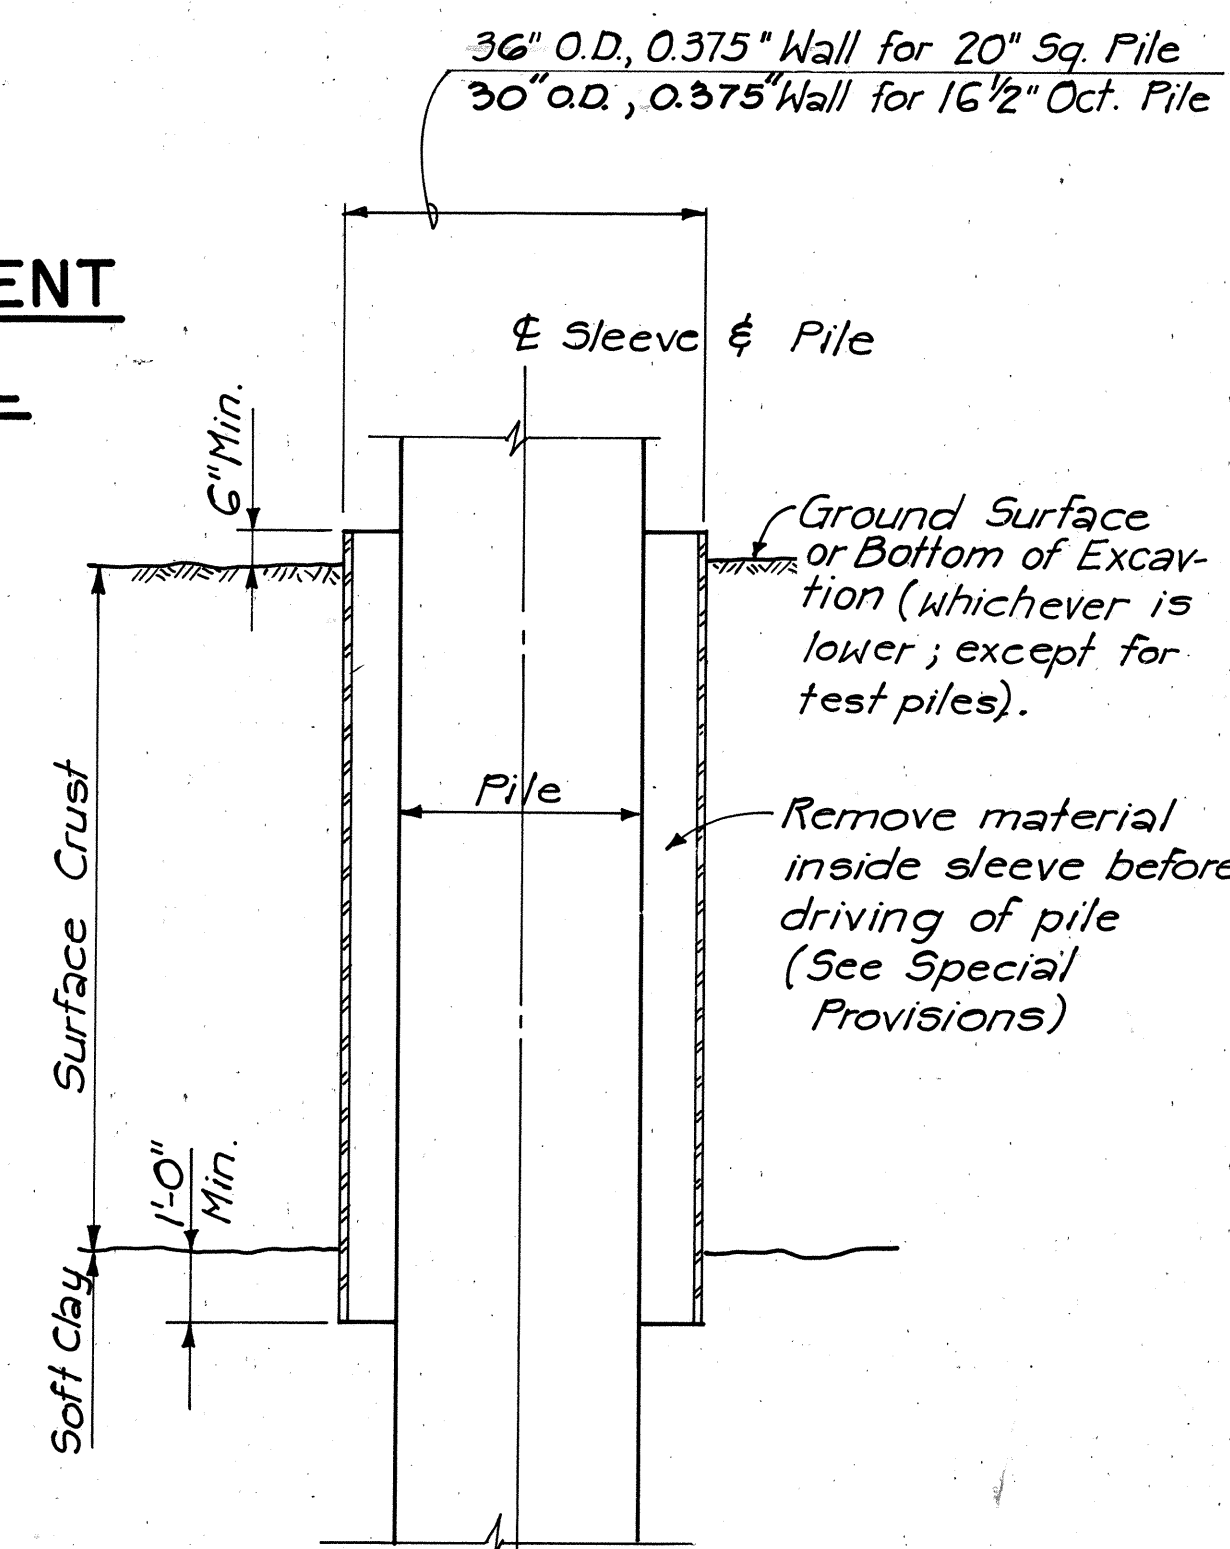

STEEL SLEEVE DETAIL  
Not to Scale

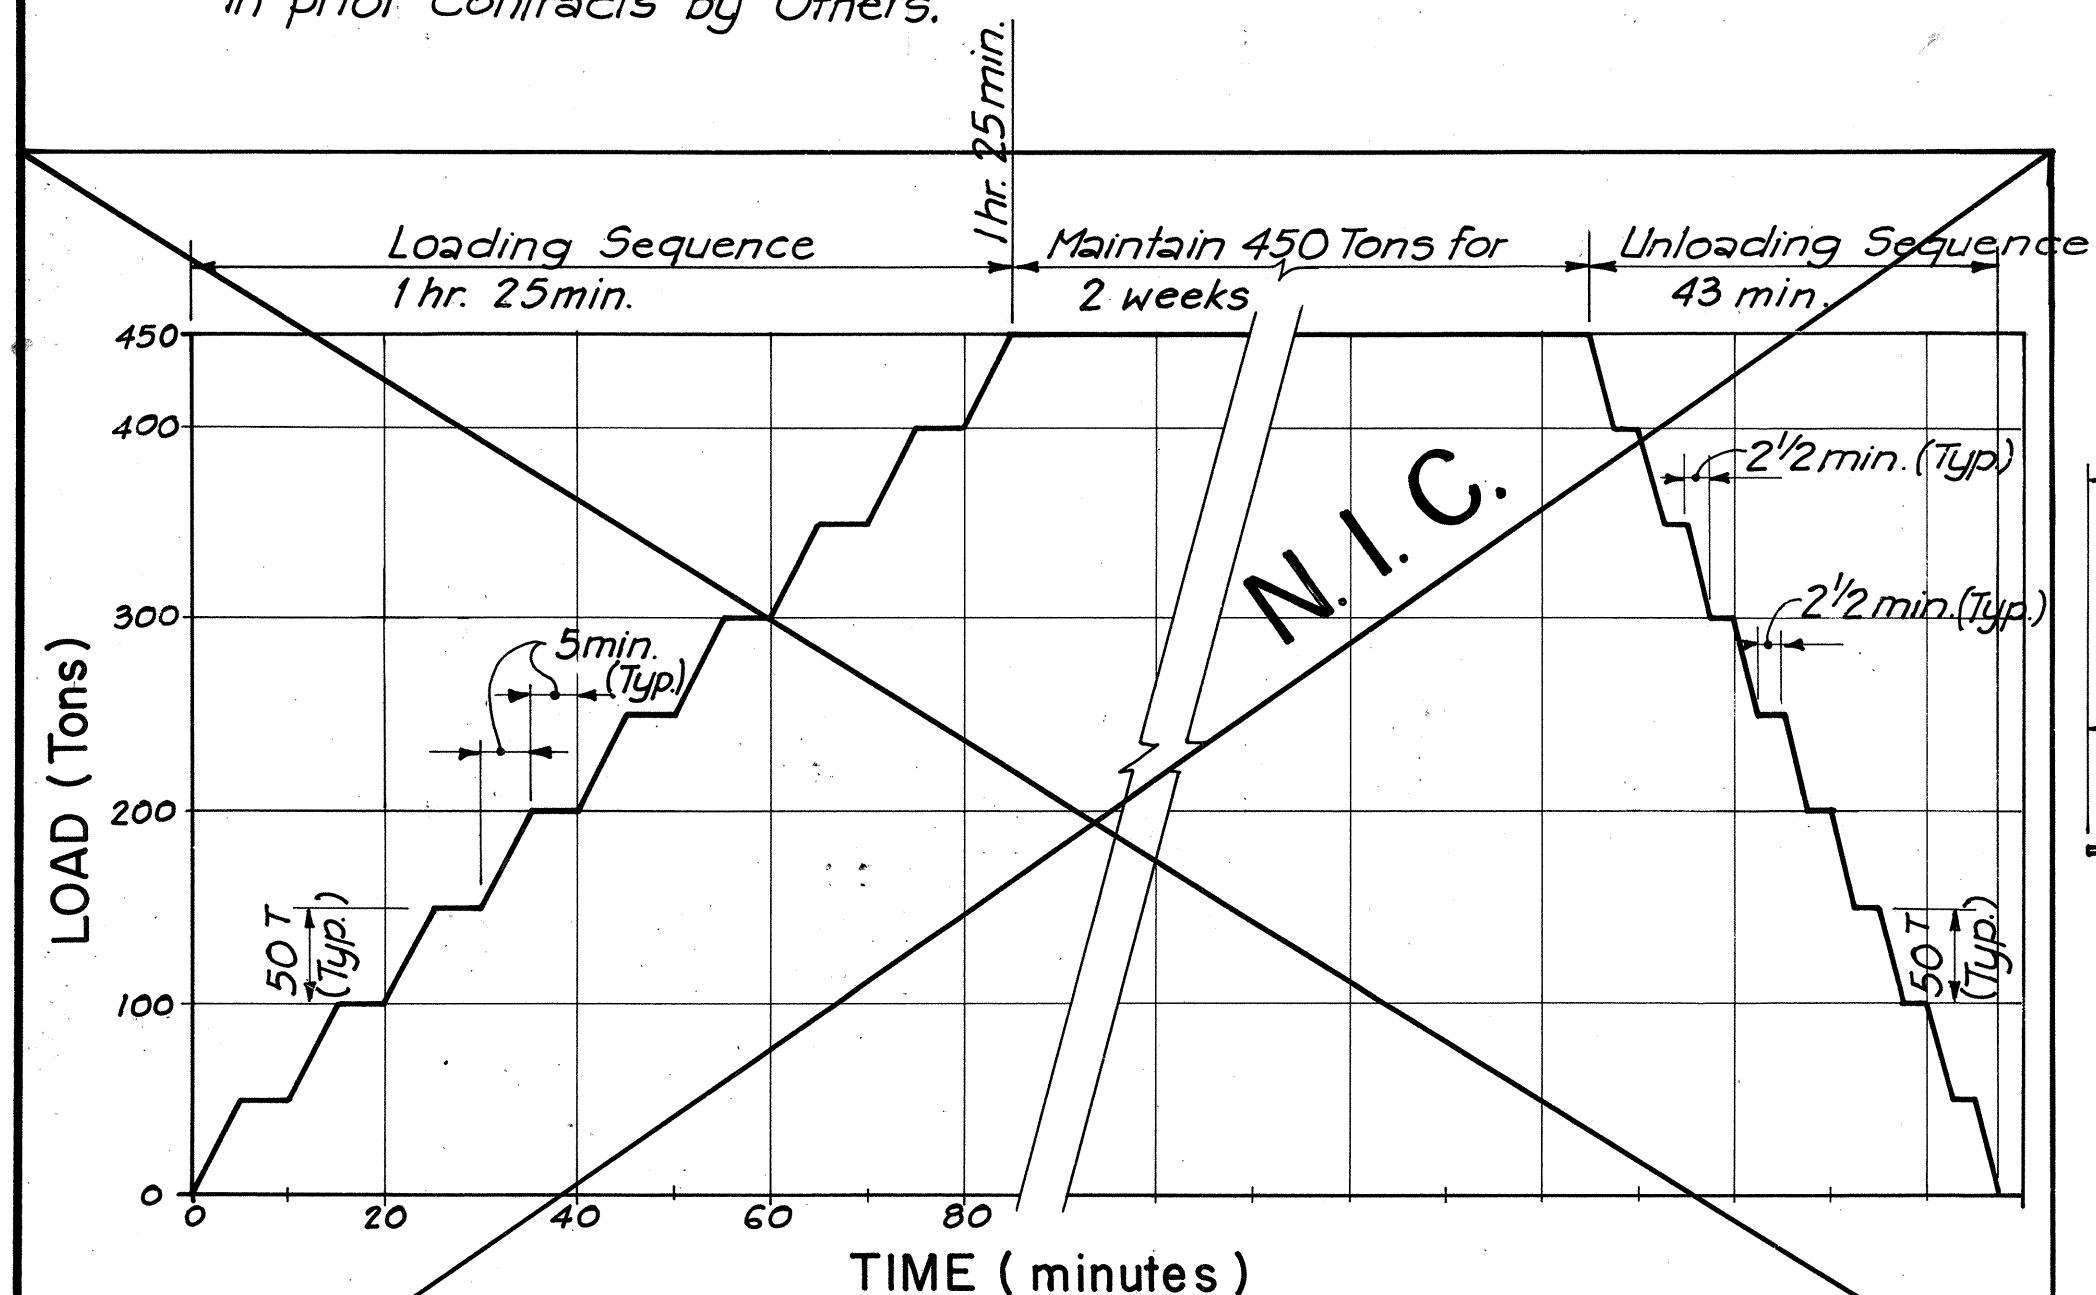


PILE LOAD TEST SEQUENCE DIAGRAM (FOR PILE TYPES A & B)  
Scale: Horizontal - 1" = 20 Minutes  
Vertical - 1" = 100 Tons

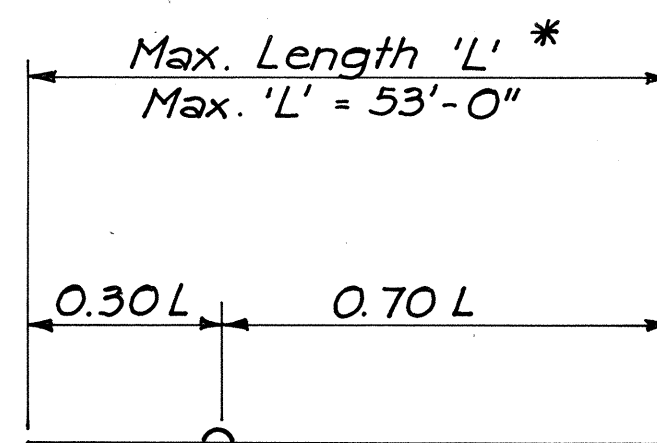


1- POINT PICK-UP

NOTE:

Unless special lifting devices are attached for pick-up points, pick-up points shall be plainly marked on all piles after removal of the forms, and all lifting shall be done at these points. The use of special embedded or attached lifting devices, the employment of pick-up points, or any other method of pick-up shall be subject to approval by Engineer.

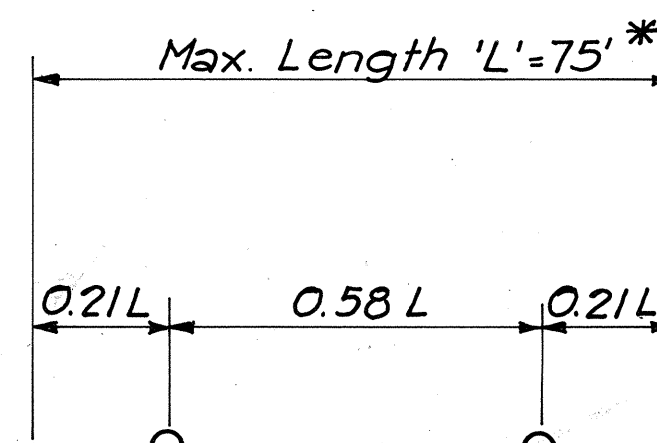


2- POINT PICK-UP

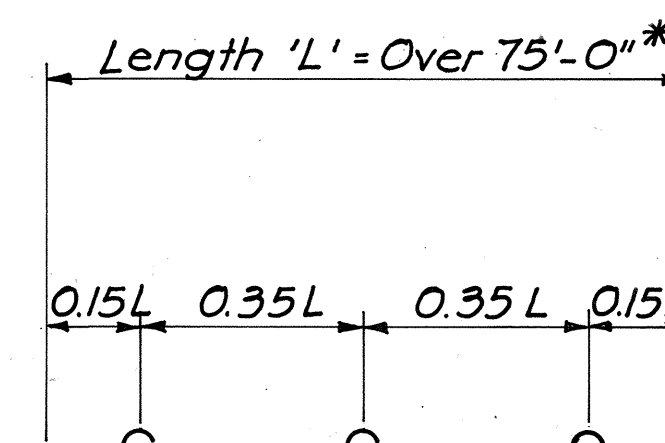

3- POINT PICK-UP

NOTES:

1. Surface crust is defined as the material between the ground line, or bottom of excavation, and the uniform soft clays (without the presence of granular materials).
2. Sleeves shall be installed plumb. Allowable deviation from vertical for the sleeve is '8" in 10 feet.
3. Splices, if required, shall be made so that inside face of sleeve is flush.

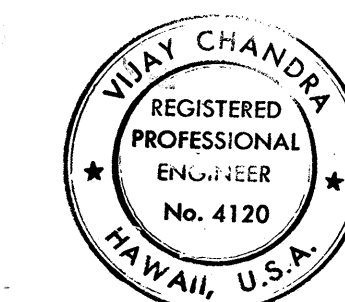


THIS WORK WAS PREPARED BY ME OR UNDER MY SUPERVISION.  
Vijay Chandra  
Signature

STATE OF HAWAII  
DEPARTMENT OF TRANSPORTATION  
HIGHWAYS DIVISION  
STANDARD DETAILS  
**PRESTRESSED CONCRETE PILES**  
DETAILS  
SHEET 2 OF 3  
KEEHI INTERCHANGE  
F.A.I. PROJECT NO. 1-HI-1(168)17  
SCALE: AS SHOWN  
DATE: \_\_\_\_\_  
SHEET NO. Y-8 OF 11 SHEETS SD-II






| FED. ROAD<br>DIST. NO. | STATE | FED. AID<br>PROJ. NO. | FISCAL<br>YEAR | SHEET<br>NO. | TOTAL<br>SHEETS |
|------------------------|-------|-----------------------|----------------|--------------|-----------------|
| HAWAII                 | HAW.  | I-HI-1(168):17        | 1982           | 140          | 145             |

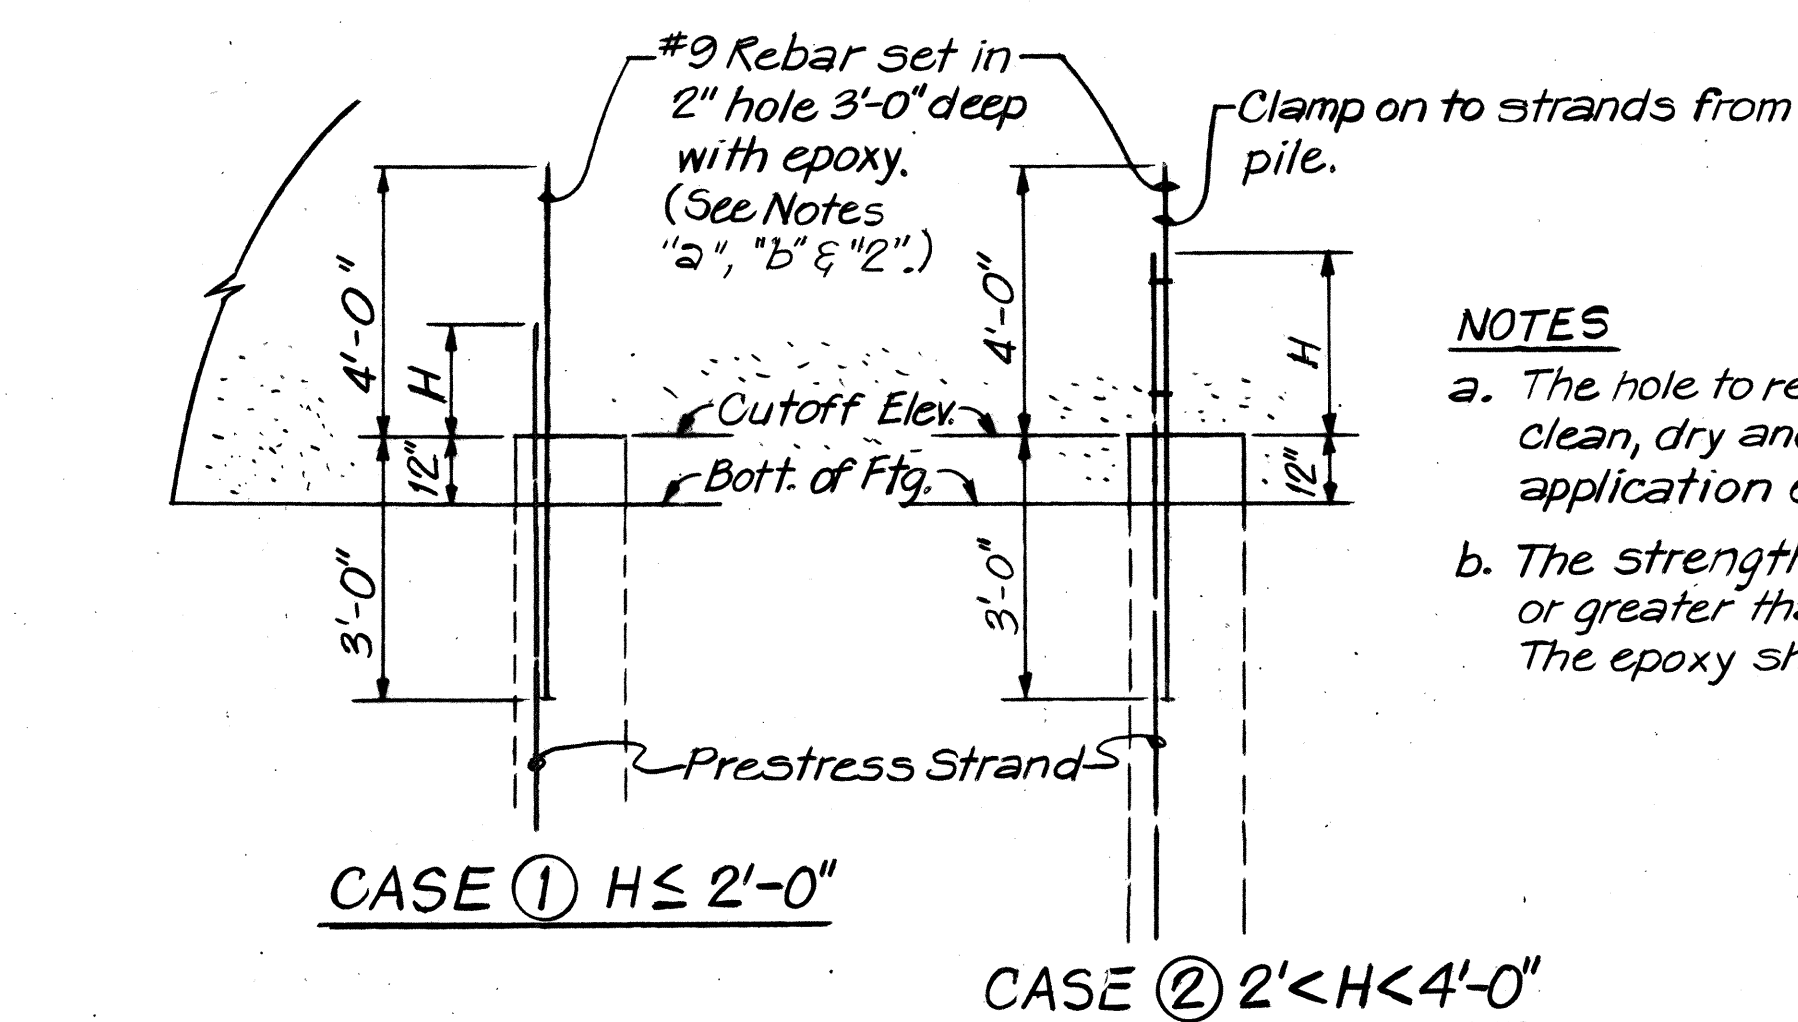

#### NOTES


- The hole to receive dowel shall be clean, dry and not oily prior to application of epoxy.
- The strength of epoxy shall be equal or greater than that of pile concrete. The epoxy shall be non-shrink.

Concrete around top edge of pile shall be bushhammered to prevent feather edges.

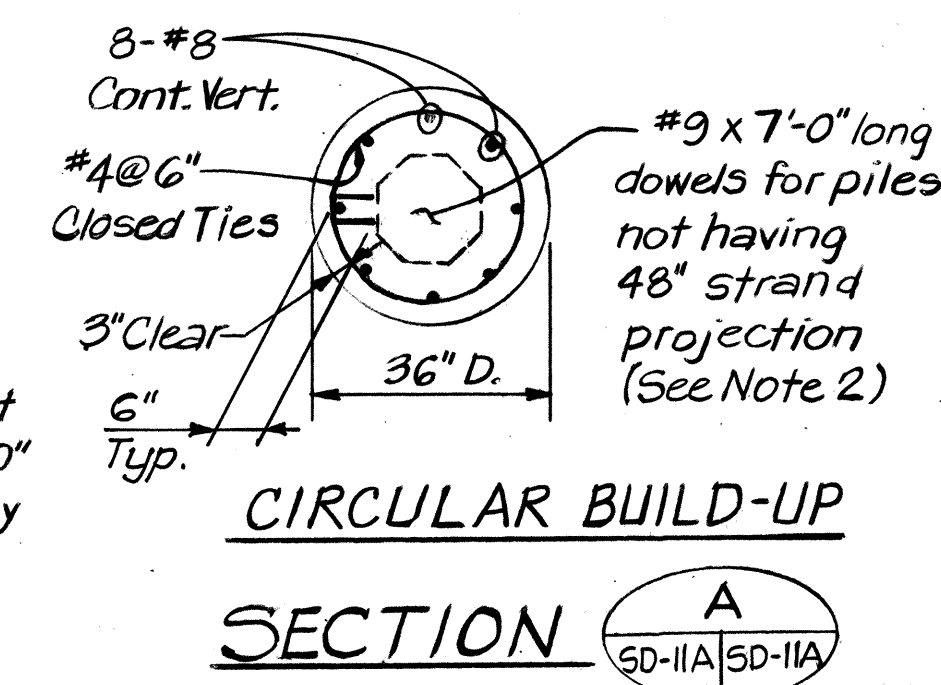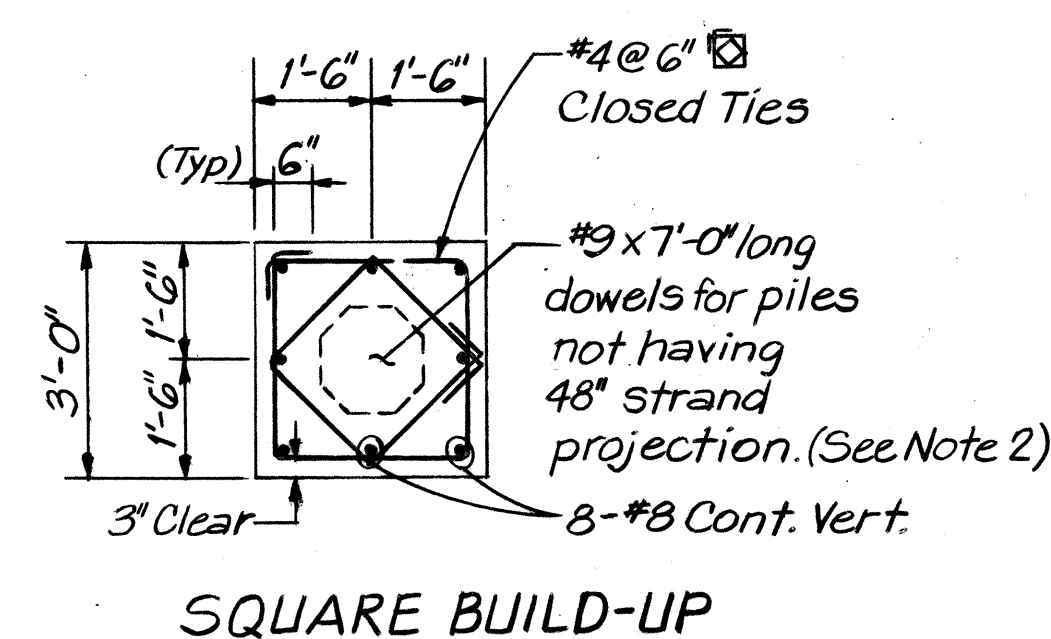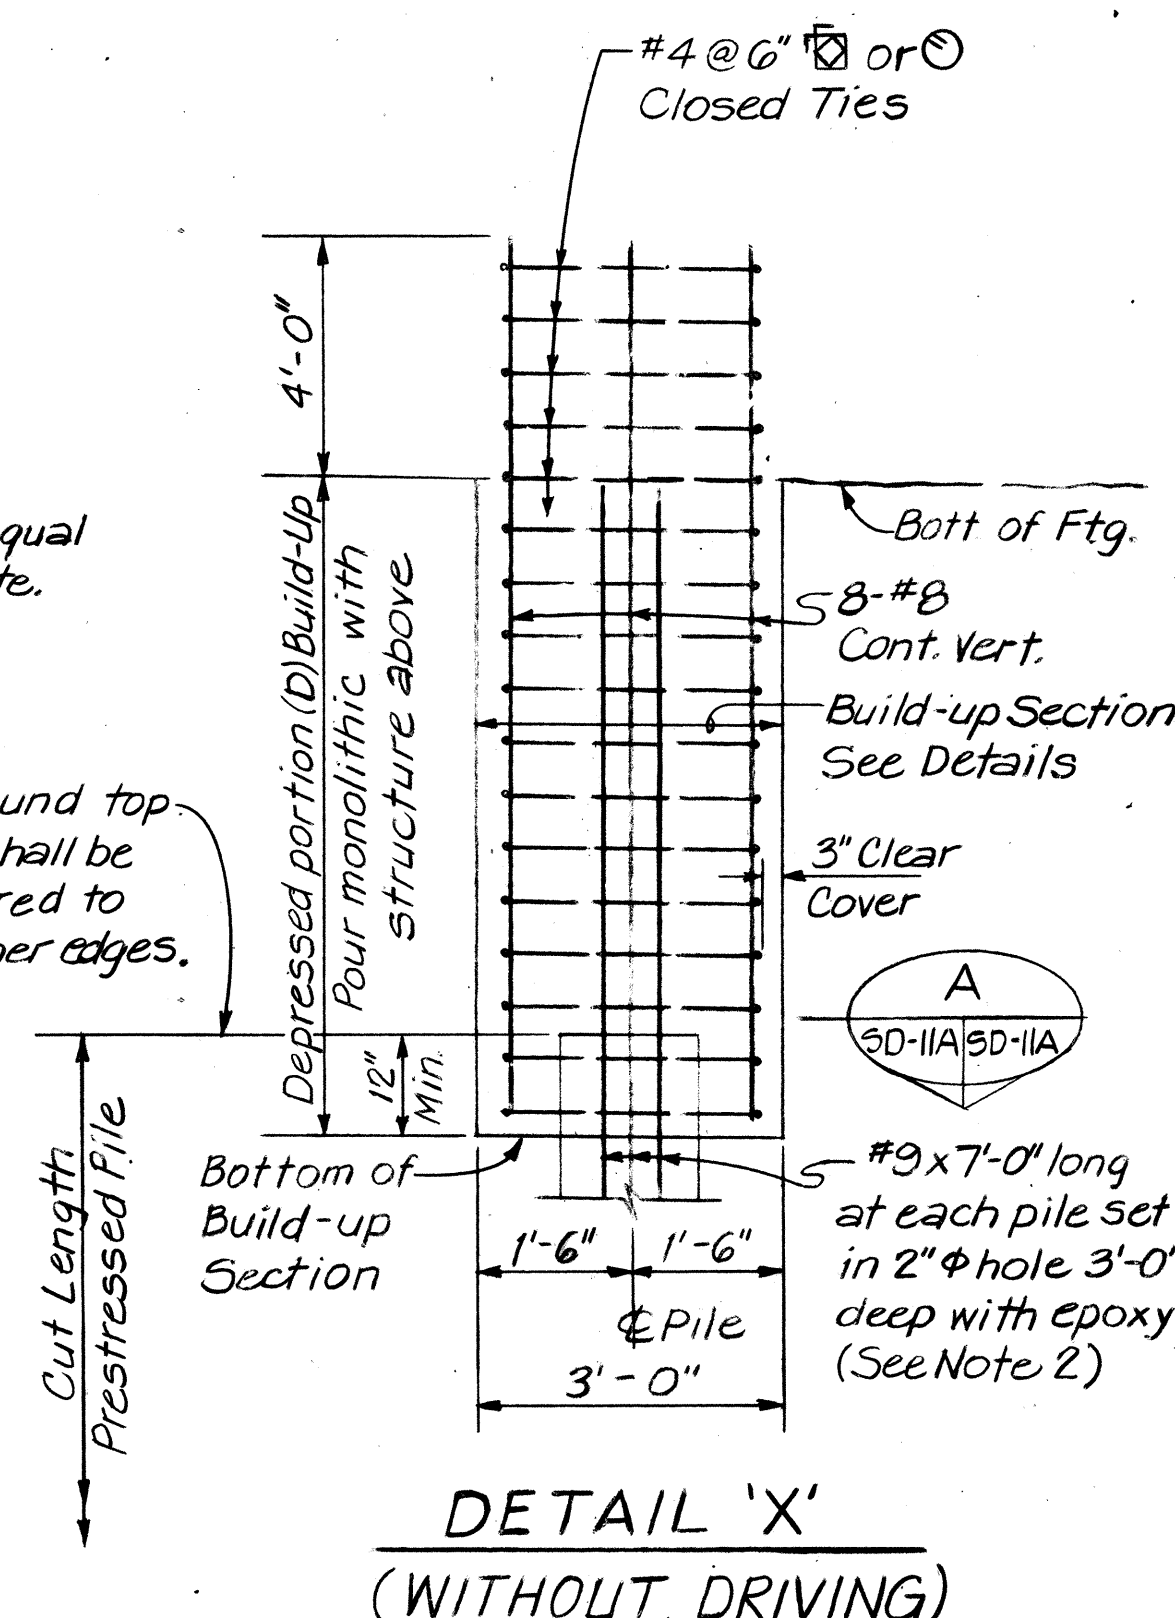

#### NOTES:

- Selection of pile build-up shall be determined by the Engineer. When height of depressed portion of footing (D) exceeds 5'-0" this alternative pile build-up shall not be allowed.
- Use same number of rebar (ASTM A615 Grade 60) as number of Prestress strands.
- Detail 'X' shall be used only for piles already driven to desired tip elevation.
- Concrete in Detail 'X' shall be class A, same strength as footing.
- Top of existing pile shall be roughened to 1/4" amplitude.
- Circular section may be used instead of square section if approved by the Engineer.

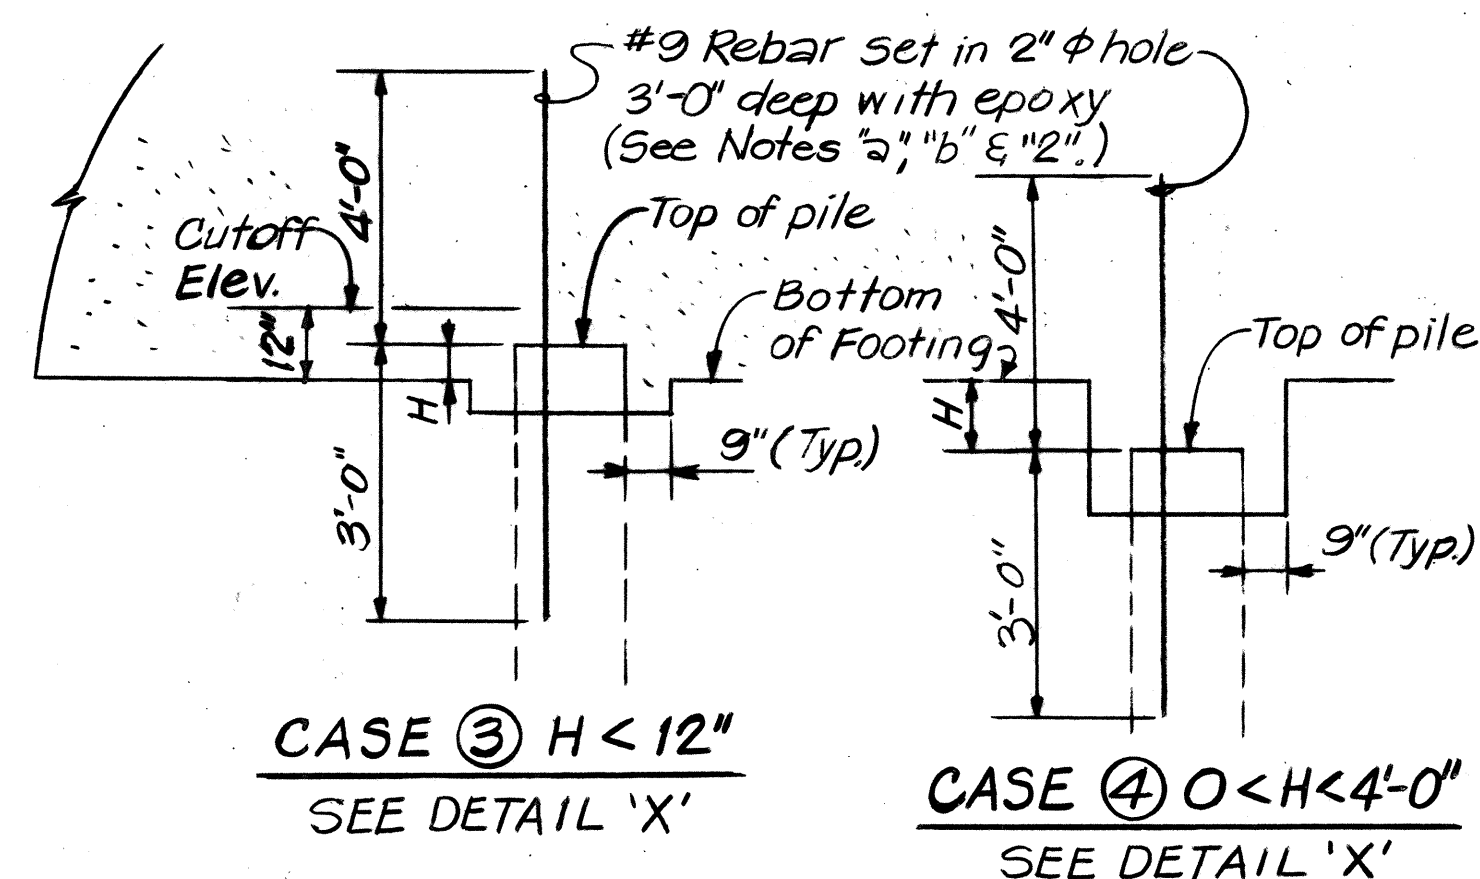


## ALTERNATIVE PILE BUILD-UP DETAILS

NOT TO SCALE

(NOTE: This Alternative Pile Build-Up shall not apply to Trestle Type Structures which have pile exposed above finished grade).

|                  |                   |      |
|------------------|-------------------|------|
| ORIGINAL<br>PLAN | SURVEY PLOTTED BY | DATE |
| NOTE BOOK        | DRAWN BY          |      |
|                  | DESIGNED BY       |      |
|                  | CHECKED BY        |      |

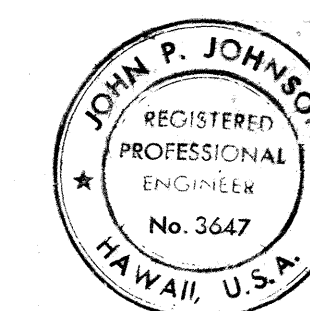


THIS WORK WAS PREPARED BY  
ME OR UNDER MY SUPERVISION.

*John P. Johnson*


|                                                                      |
|----------------------------------------------------------------------|
| STATE OF HAWAII<br>DEPARTMENT OF TRANSPORTATION<br>HIGHWAYS DIVISION |
| STANDARD DETAILS<br>PRESTRESSED CONCRETE PILES<br>DETAILS            |
| SHEET 2A OF 3                                                        |
| KEEHI INTERCHANGE<br>F.A.I. PROJECT NO. I-HI-1 (168):17              |
| SCALE: AS SHOWN DATE: 8/17/81                                        |
| SHEET No. Y-9 OF 11 SHEETS SD-IIA                                    |




| FED. ROAD DIST. NO. | STATE | FED. AID PROJ. NO. | FISCAL YEAR | SHEET NO. | TOTAL SHEETS |
|---------------------|-------|--------------------|-------------|-----------|--------------|
| HAWAII              | HAW.  | I-HI-1(168)17      | 1982        | 141       | 145          |

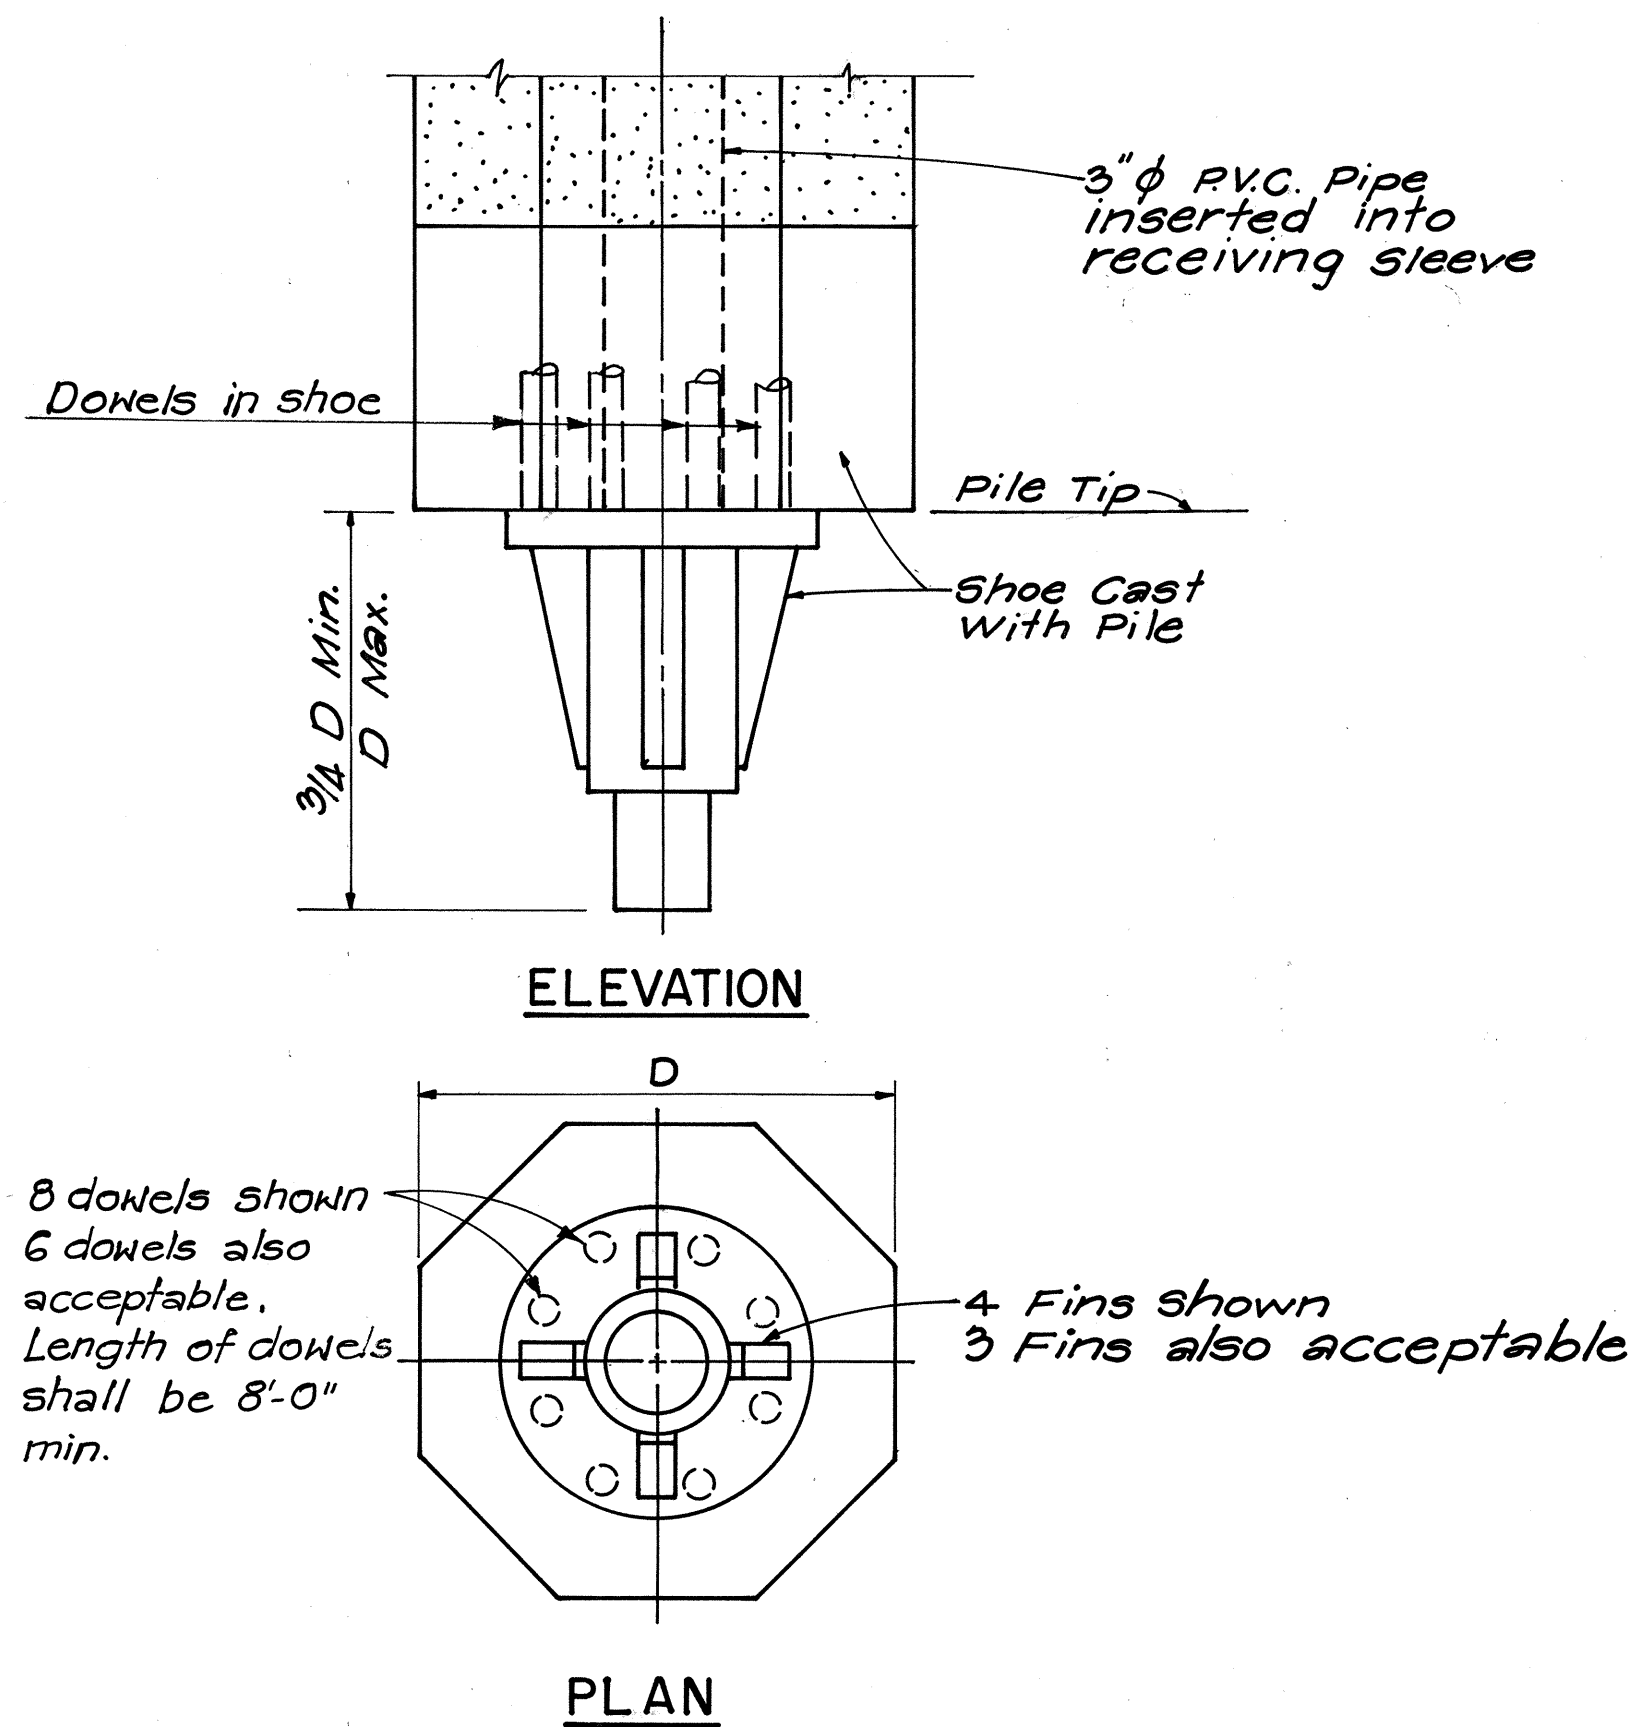

**ROCK DRIVING SHOE**  
NOT TO SCALE

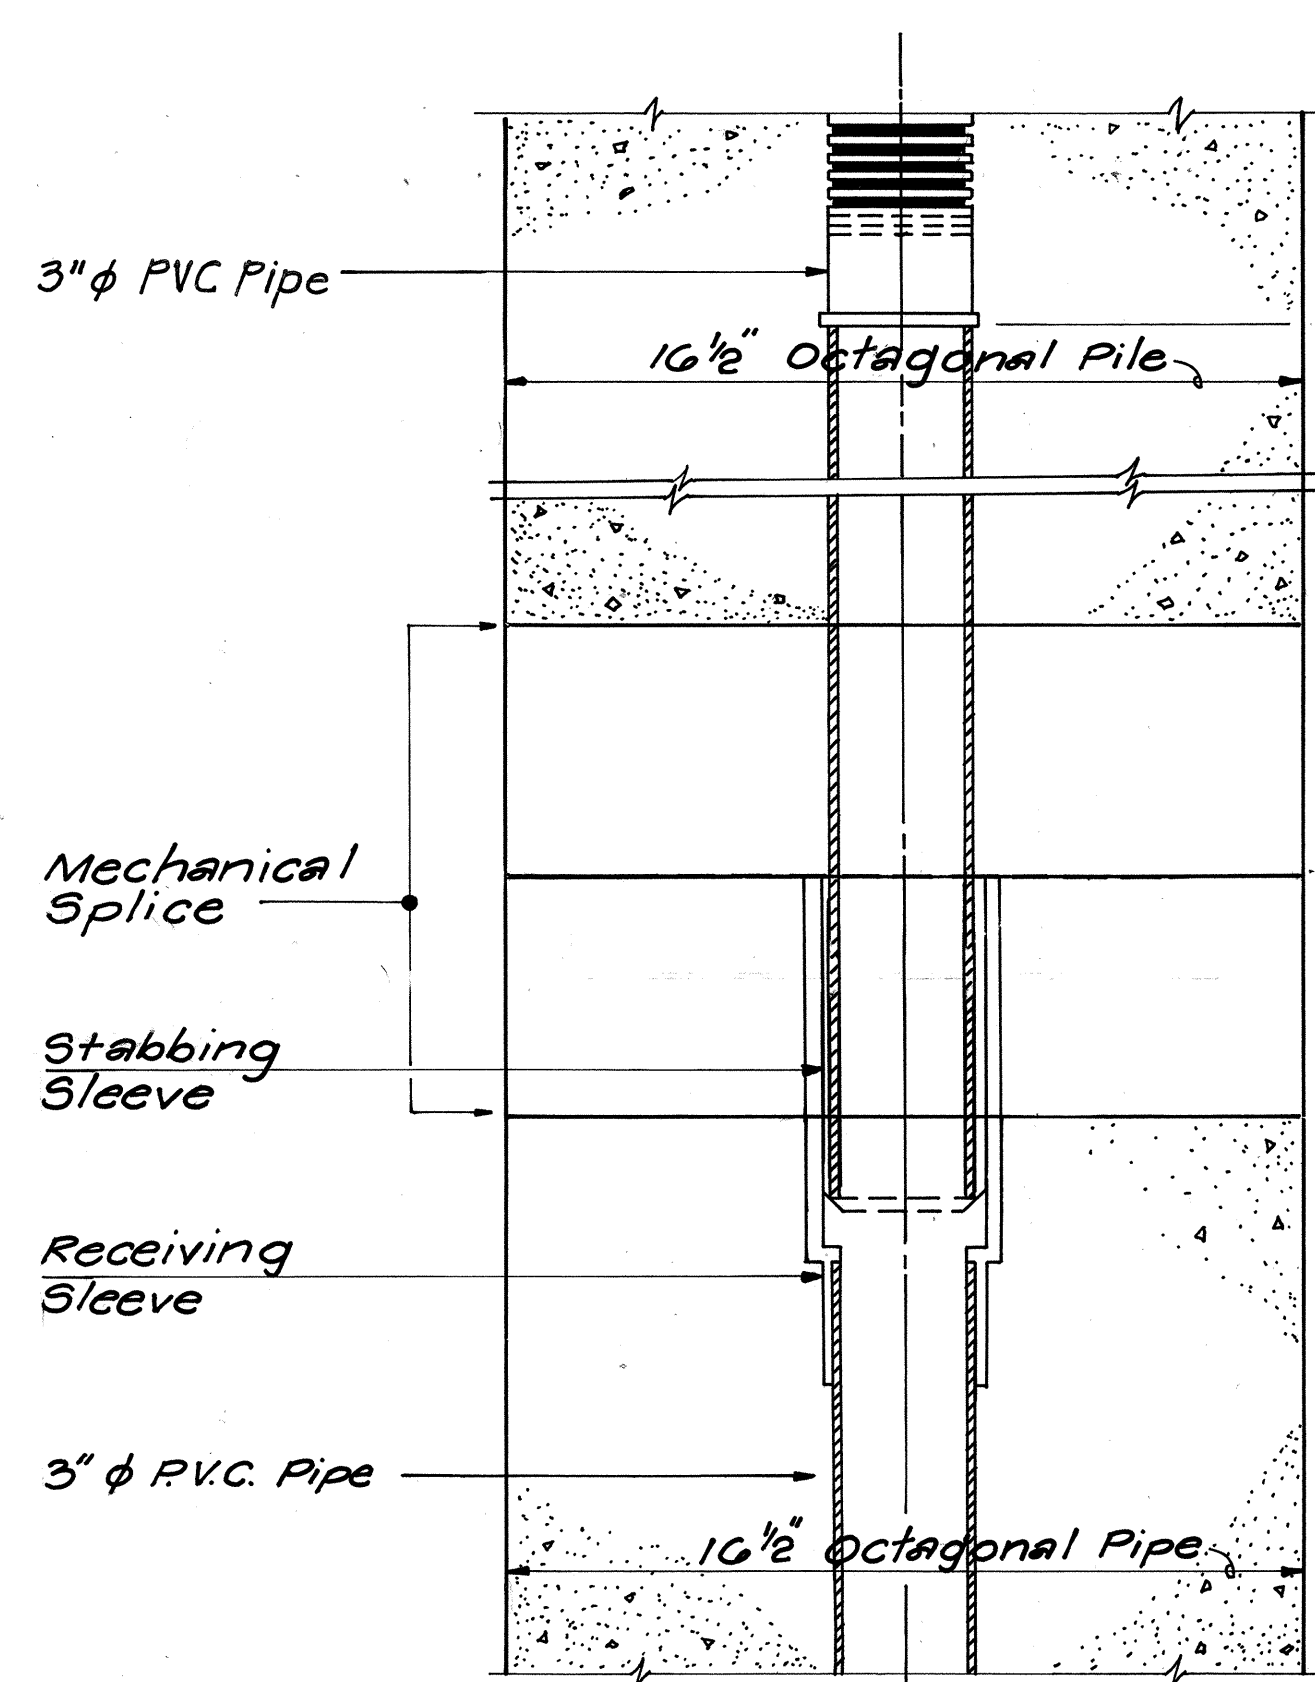


**BETWEEN 16 1/2" OCT. PILES**

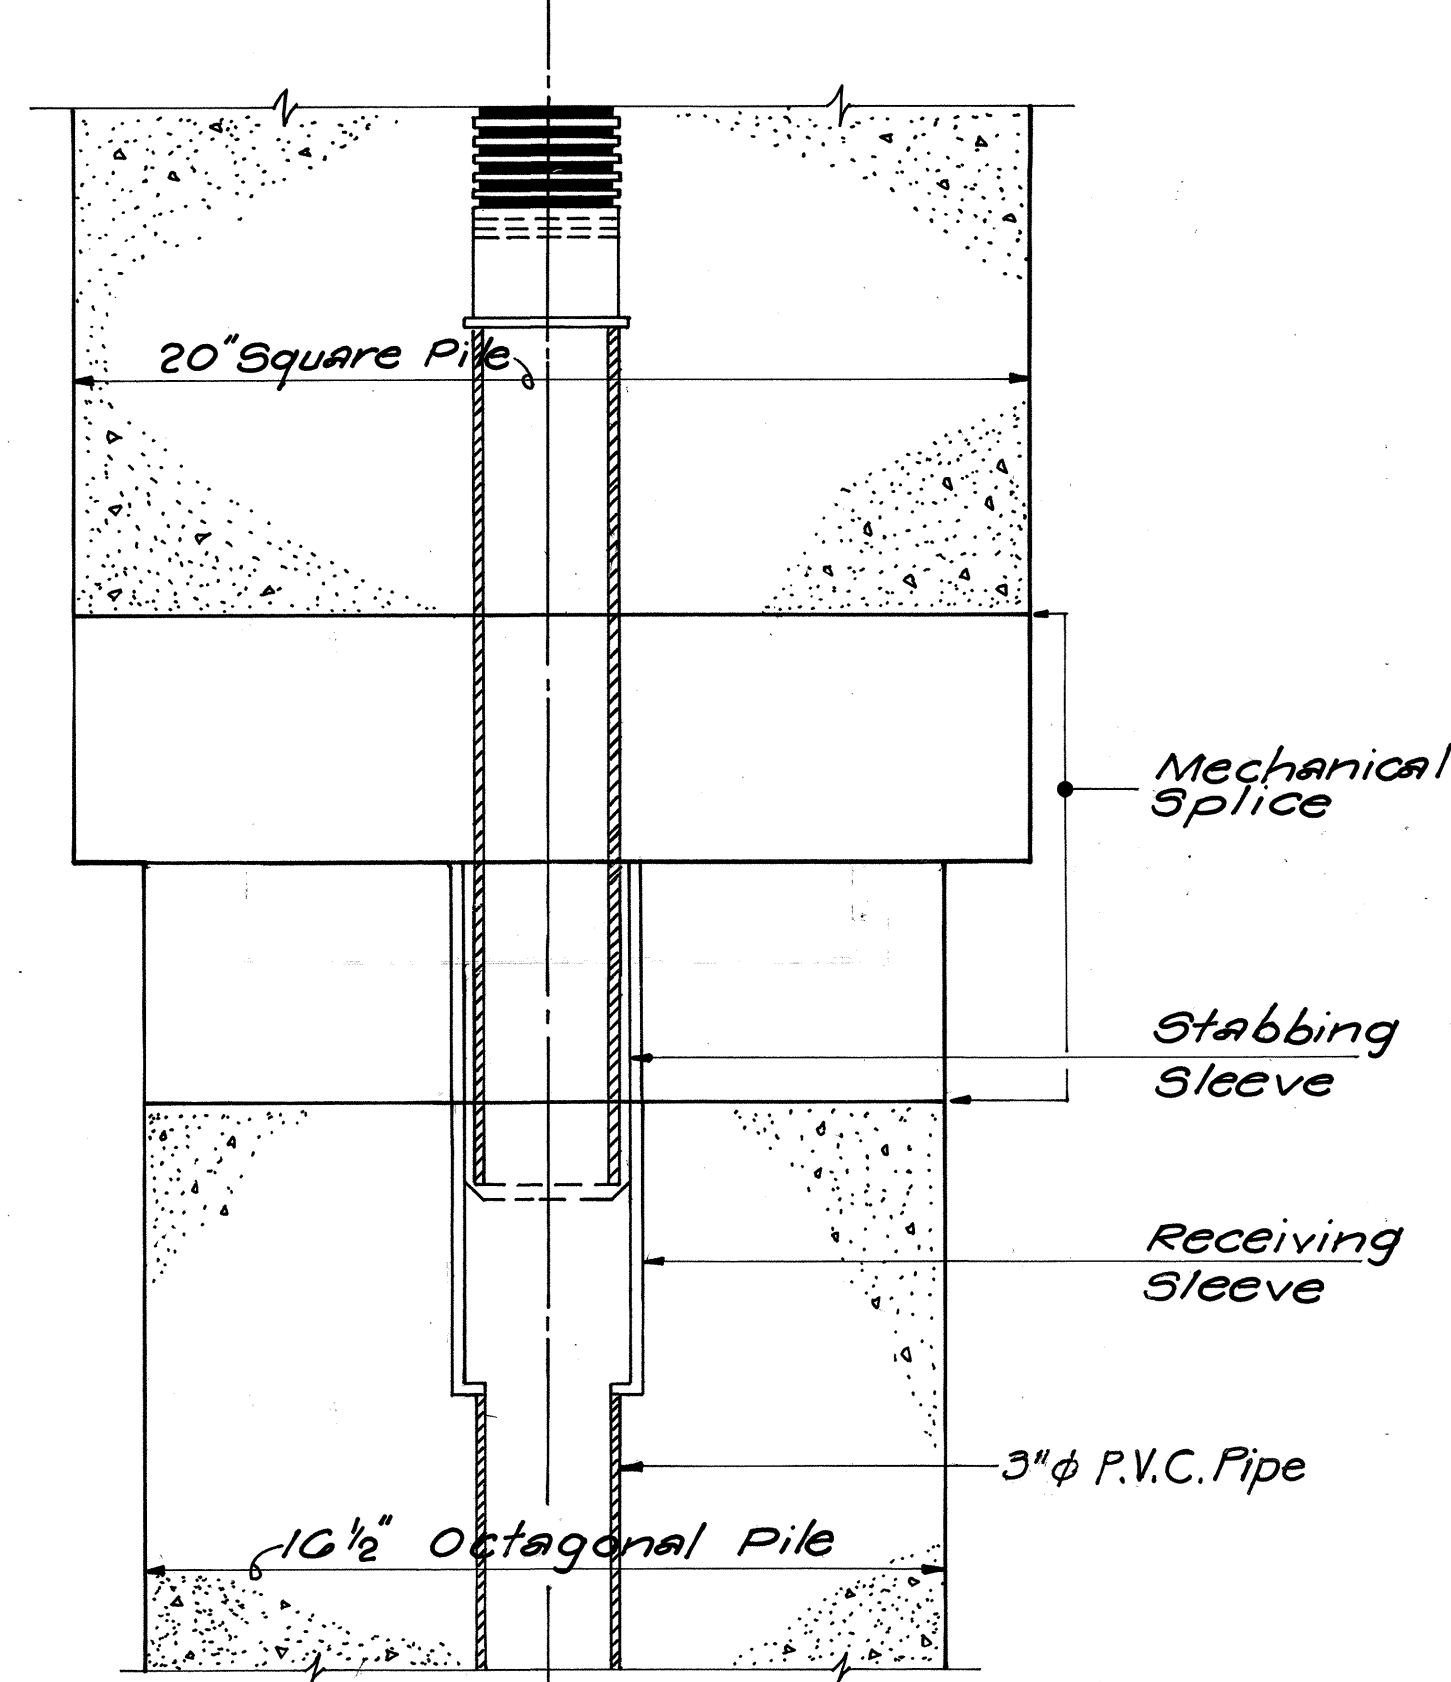


**BETWEEN 20" SQ. PILE & 16 1/2" OCT. PILE**

**ARRANGEMENT OF PVC PIPE CONNECTIONS AT PILE SPLICE**  
SCALE: 3"=1'-0"

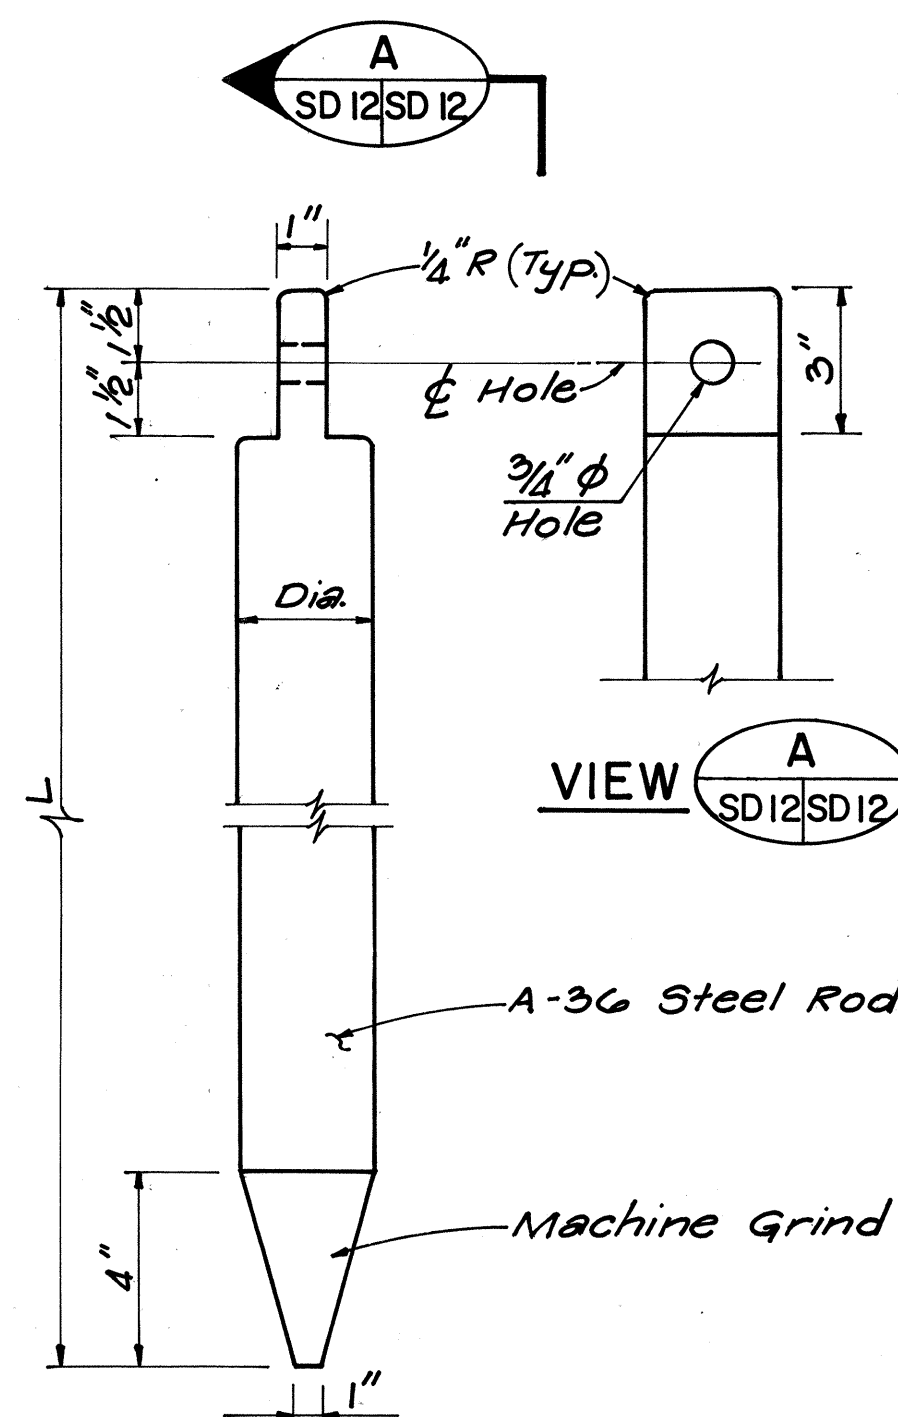

**PLUMB BOB #1 #2 #3 & #4**  
SCALE: 3"=1'-0"

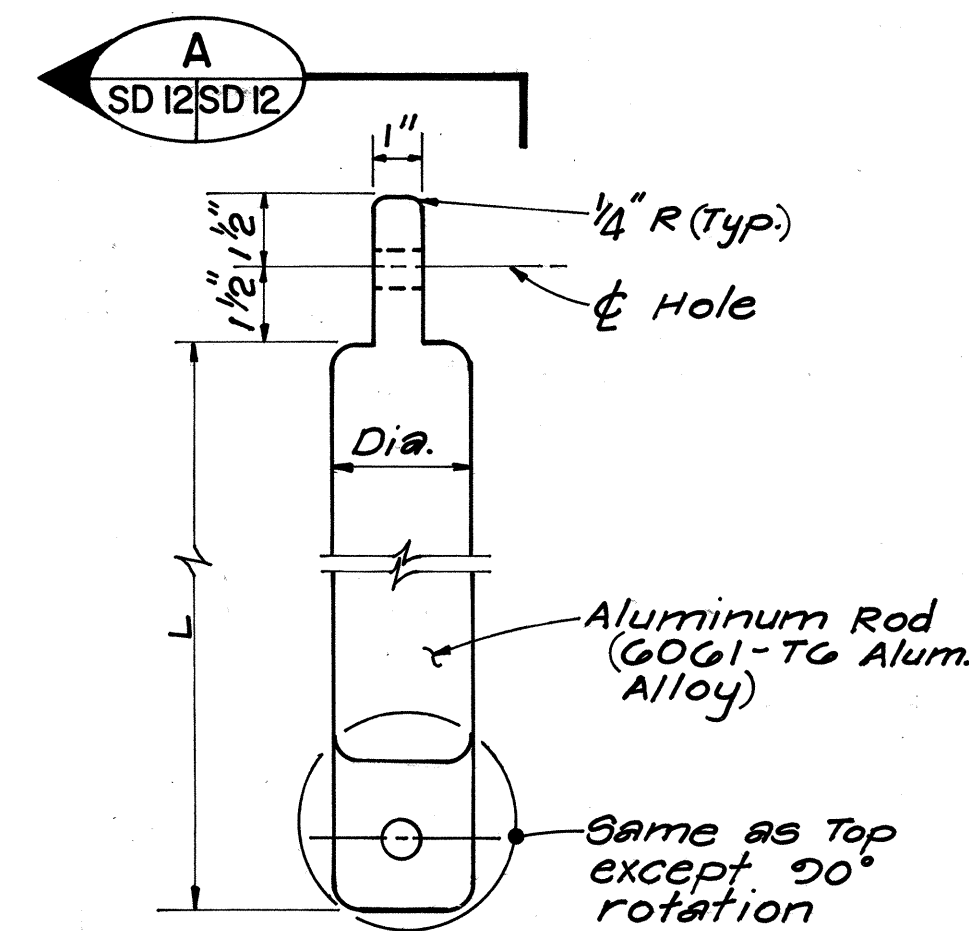


**PLUMB BOB #5 & #6**  
SCALE: 3"=1'-0"

| SIZE OF PLUMB BOBS |        |                     |
|--------------------|--------|---------------------|
| PLUMB BOB          | L      | DIA.                |
| #1                 | 11'-3" | 2 3/4" $\pm$ 0.006" |
| #2                 | 8'-0"  | 2 3/4" $\pm$ 0.006" |
| #3                 | 9'-2"  | 4 3/8" $\pm$ 0.012" |
| #4                 | 6'-9"  | 4 3/8" $\pm$ 0.012" |
| #5                 | 12'-0" | 2 3/4" $\pm$ 0.006" |
| #6                 | 12'-9" | 4 3/8" $\pm$ 0.012" |

N.I.C.  
N.I.C.  
N.I.C.

**PLUMB BOB NOTES:**

- All sharp edges shall be rounded.
- Allowable deviation from straight = 1/8"
- Plumb Bobs shall be attached to a measuring tape with "foot" and "inch" marked graduations.
- Plumb Bobs #1, #2, #3 & #4 shall be used at the driving site. Plumb Bobs #5 & #6 shall be used at the casting yard.

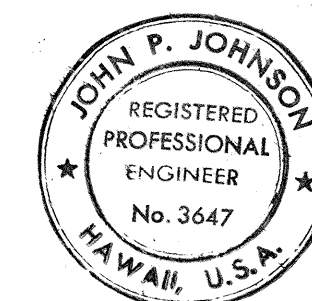

THIS WORK WAS PREPARED BY ME  
OR UNDER MY SUPERVISION.  
*John P. Johnson*


STATE OF HAWAII  
DEPARTMENT OF TRANSPORTATION  
HIGHWAYS DIVISION  
STANDARD DETAILS  
**PRESTRESSED CONCRETE PILES**  
DETAILS  
SHEET 3 OF 3  
KEEHI INTERCHANGE  
F.A.I. PROJECT NO. I-HI-1 ( 168 ) : 17  
SCALE: AS SHOWN DATE: 8/17/81  
SHEET NO. Y-10 OF 11 SHEETS SD-12



| FED. ROAD DIST. NO. | STATE | FED. AID PROJ. NO. | FISCAL YEAR | SHEET NO. | TOTAL SHEETS |
|---------------------|-------|--------------------|-------------|-----------|--------------|
| HAWAII              | HAW.  | 1-HH-1(168):17     | 1982        | 142       | 145          |


GENERAL NOTES

- Contractor has the option of using cast malleable iron, cast steel, welded, or bolted grate.
- All welds 3/8" unless otherwise noted.
- Type A-9 - Use in locations off the roadbed on all types of highways.
- Type A-12 - Use within the roadbed on all types of highways.

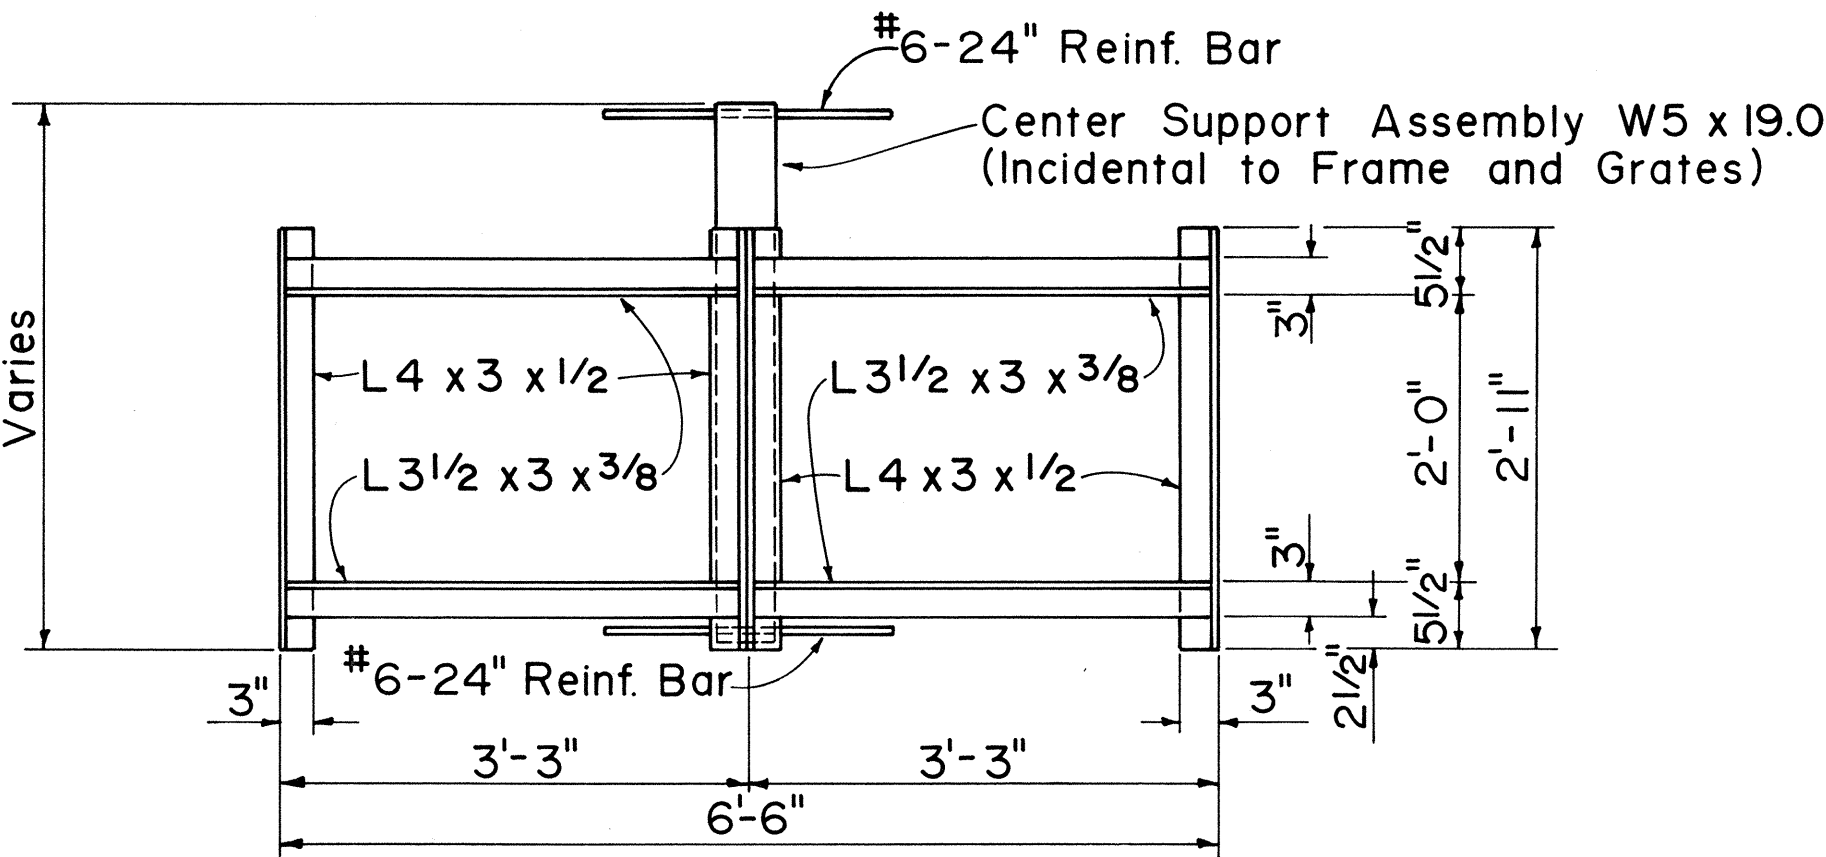


PLAN

(Two or More Grates)

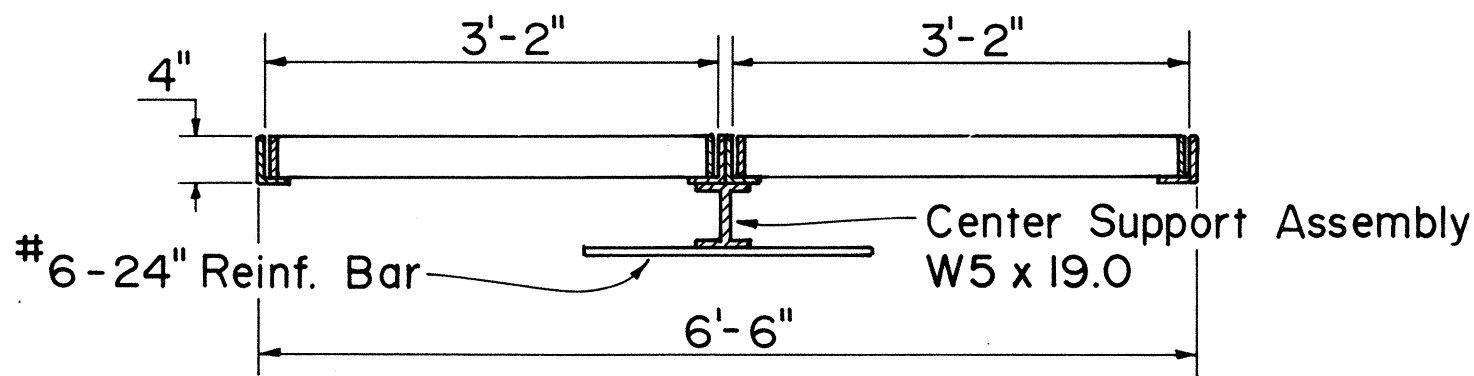


LONGITUDINAL SECTION

(Thru Frame & Grate)

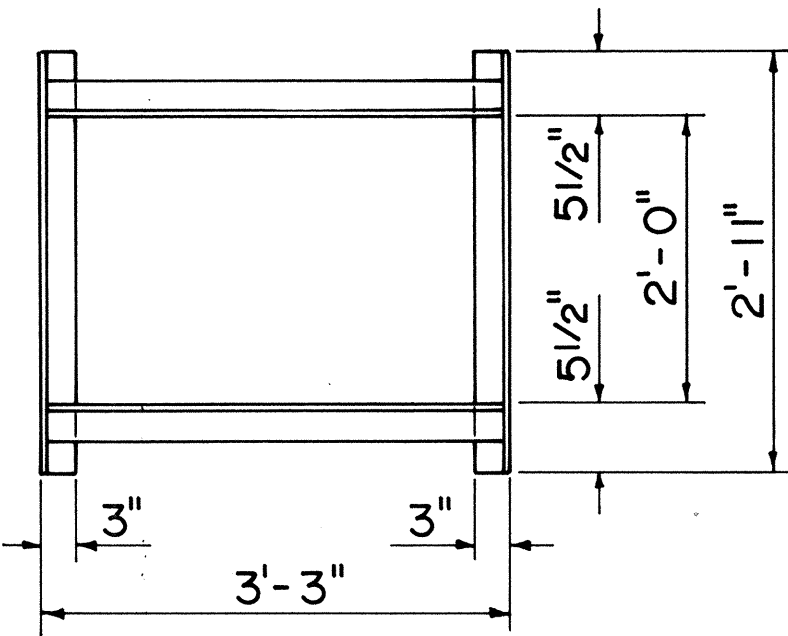

PLAN


(Single Grate)

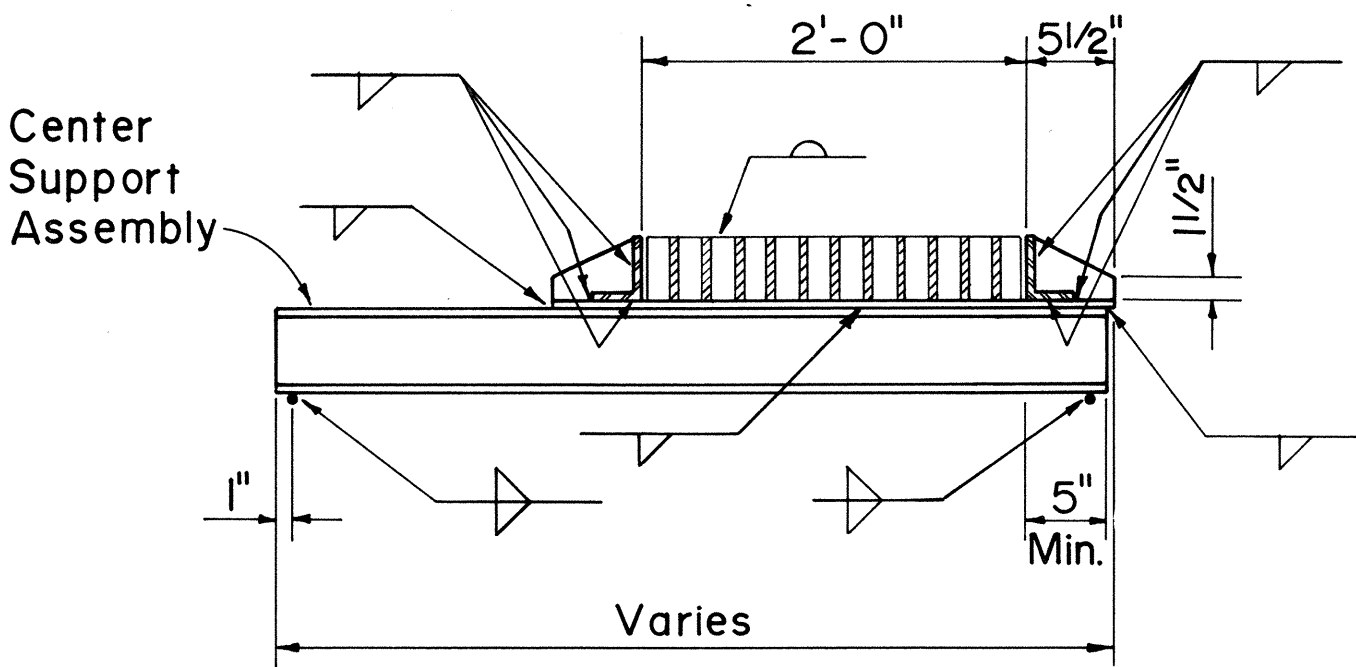


CROSS SECTION

(Thru Frame & Grate)


FRAME DETAILS

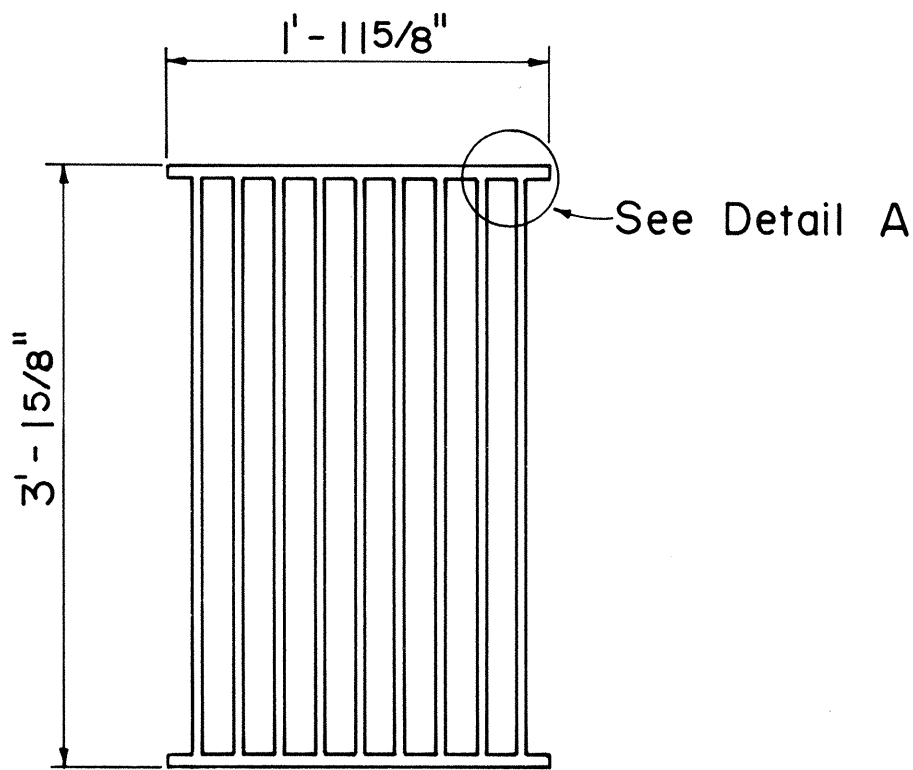

PLAN

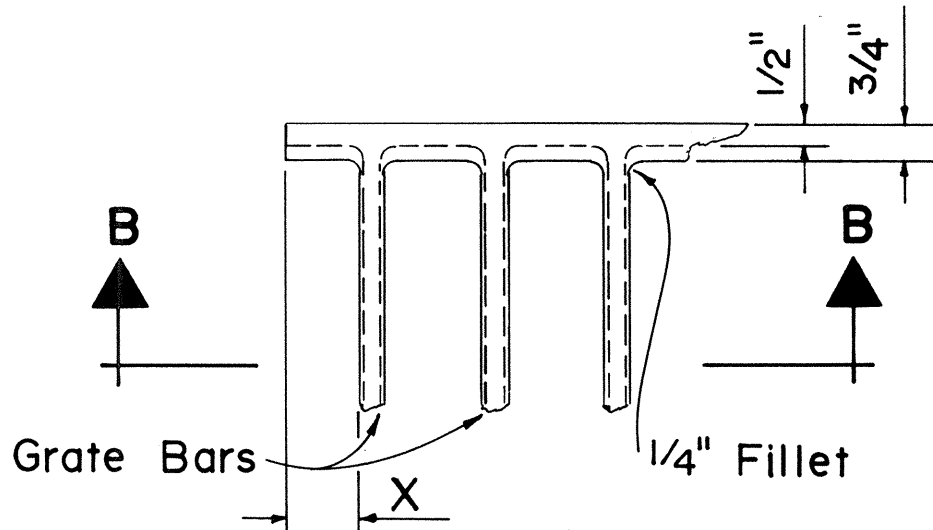


DETAIL A

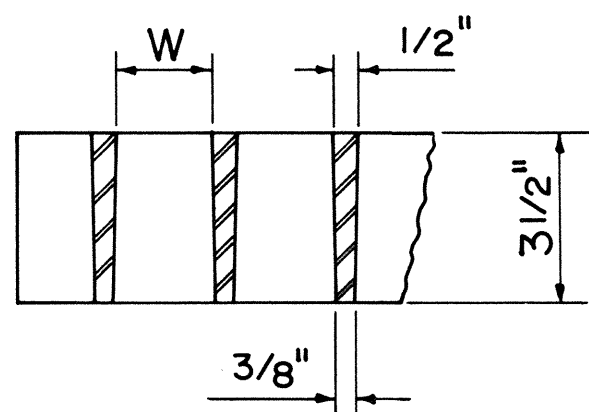


SECTION B-B


ALTERNATIVE CAST MALLEABLE IRON OR CAST STEEL GRATE

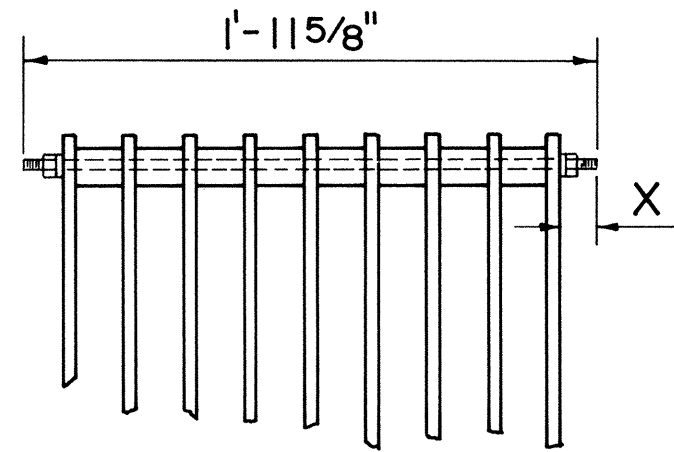


BOLTED END BLOCK

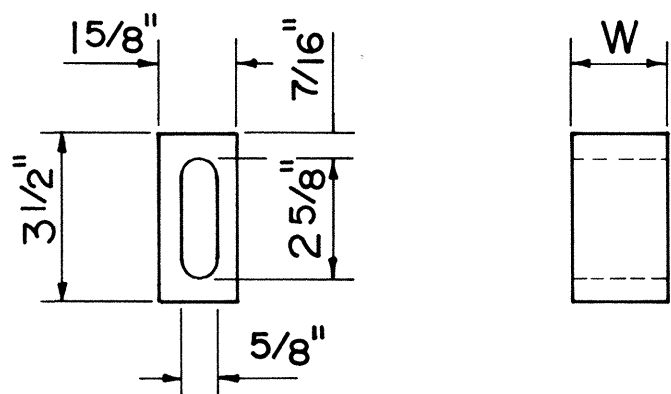

BAR SPACER

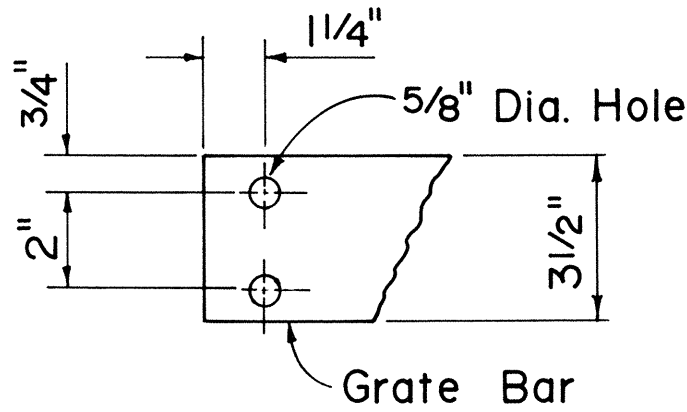


END OF BAR

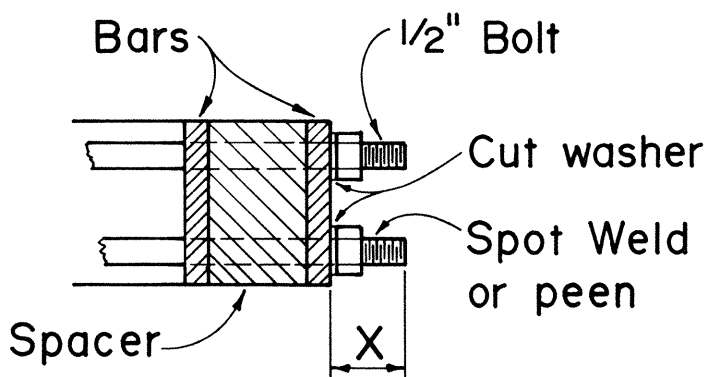


BOLTING DETAIL

ALTERNATIVE BOLTED GRATE

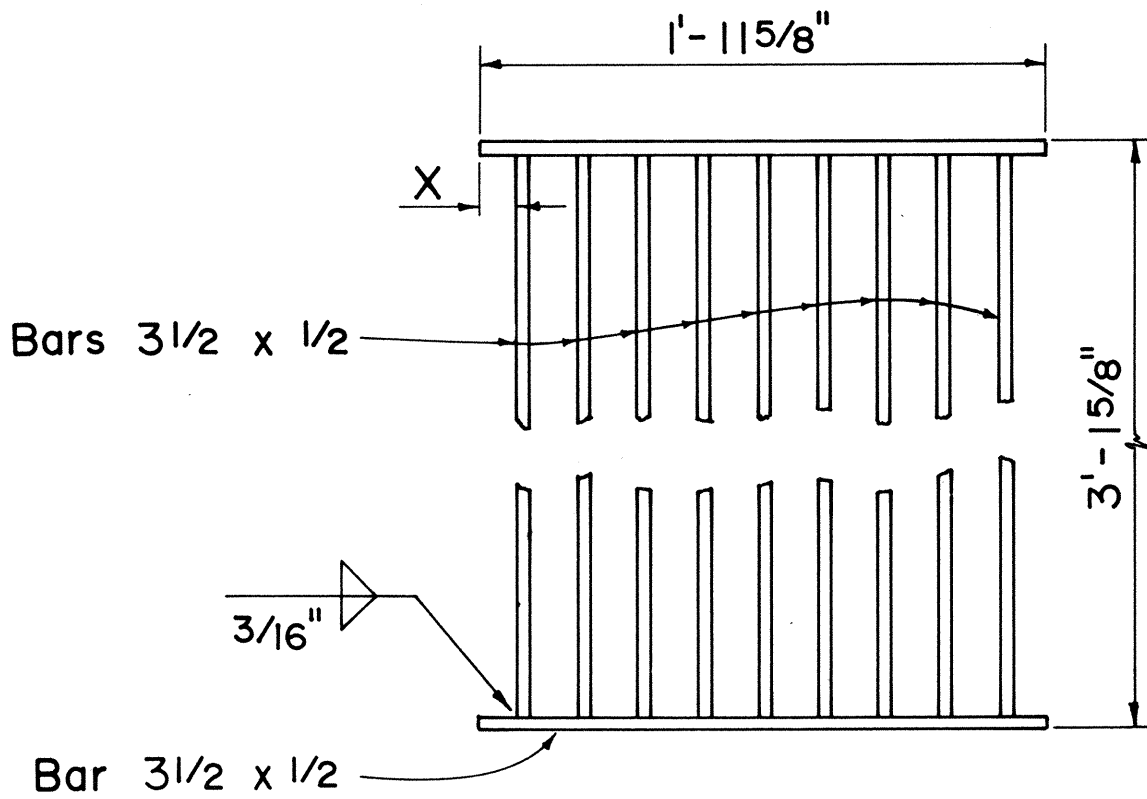

PLAN

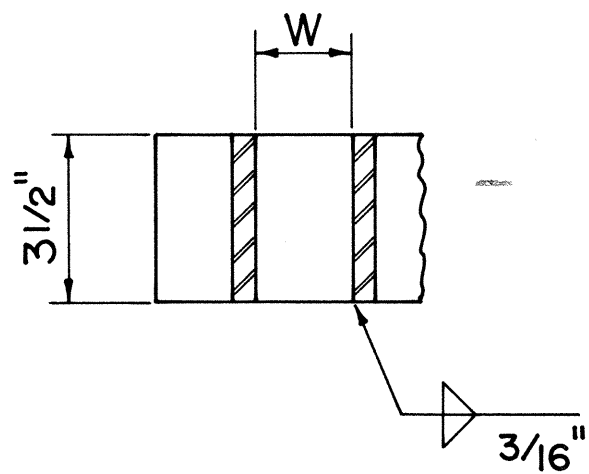

SECTION

ALTERNATIVE WELDED GRATE

| GRATE BAR SPACING TABLE |          |                     |         |
|-------------------------|----------|---------------------|---------|
| TYPE                    | NO. BARS | CLEAR BAR SPACING-W | X       |
| A-9                     | 9        | 2"                  | 1 9/16" |
| A-12                    | 12       | 1 3/8"              | 1 1/4"  |

| NO. | REVISION                                              | APPROVED BY | DATE    |
|-----|-------------------------------------------------------|-------------|---------|
| 1.  | Supersedes Sht. DH 7 approved 12-17-69                | H.T.        | 6/22/79 |
| 2.  | Revise standard nomenclature for rolled steel shapes. | H.T.        | 4/21/82 |

APPROVAL RECOMMENDED:  
 HYDRAULIC DESIGN ENGINEER  
 DATE 6-19-79

APPROVED:  
 ASSISTANT CHIEF, ENGINEERING  
 DATE 6-22-79

STATE OF HAWAII  
 DEPARTMENT OF TRANSPORTATION  
 HIGHWAYS DIVISION

STANDARD DETAILS  
 TYPE A-9 AND A-12  
 FRAMES AND GRATES

Not To Scale Date: Dec. 1977

SHEET NO. Y-11 OF 11 SHEETS DH 7