

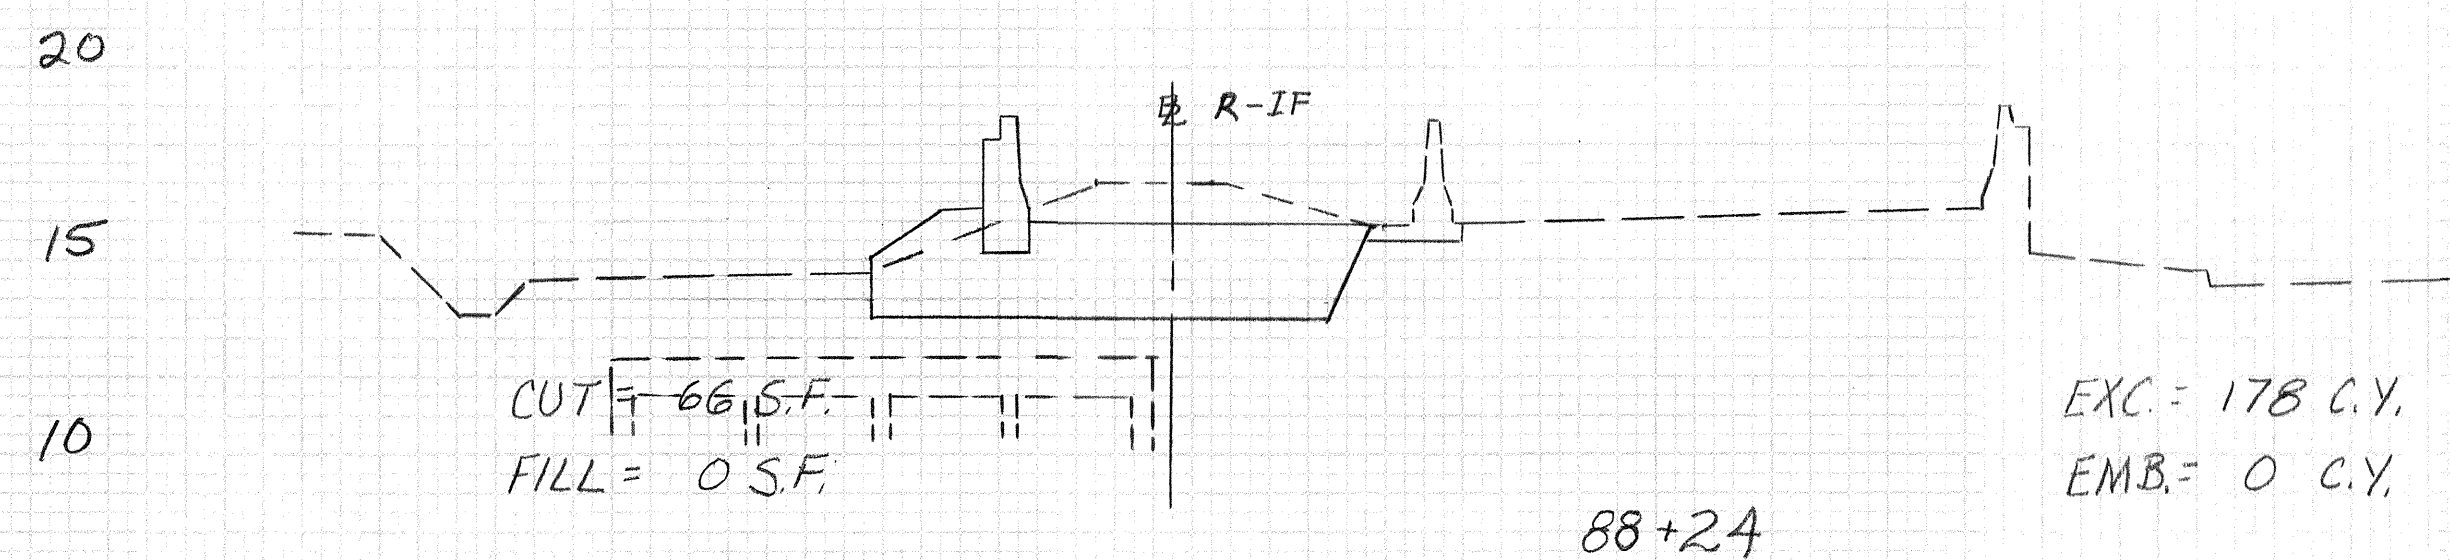
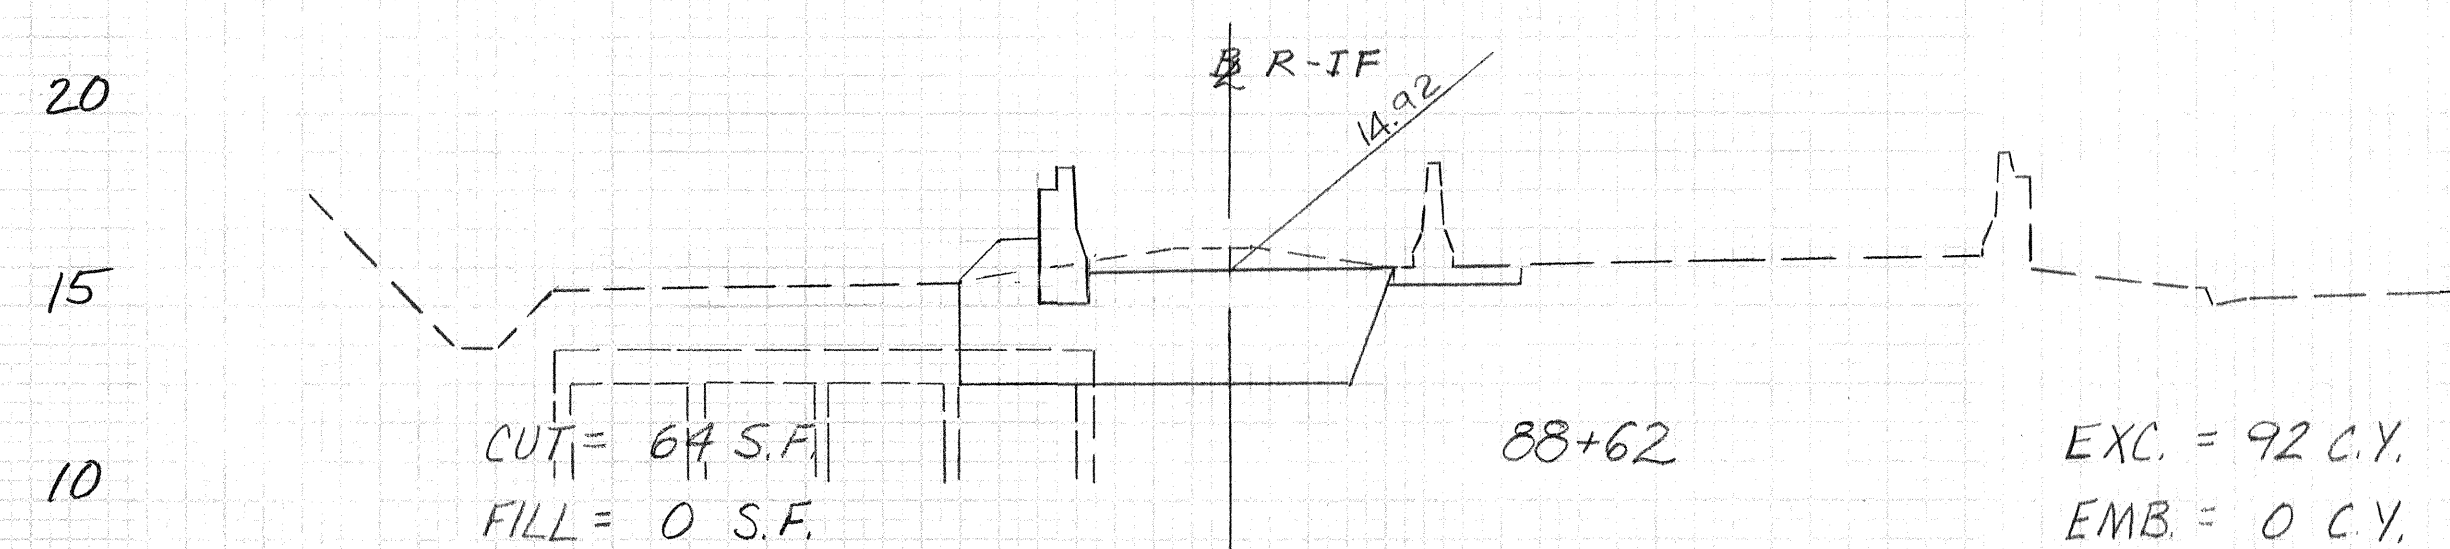
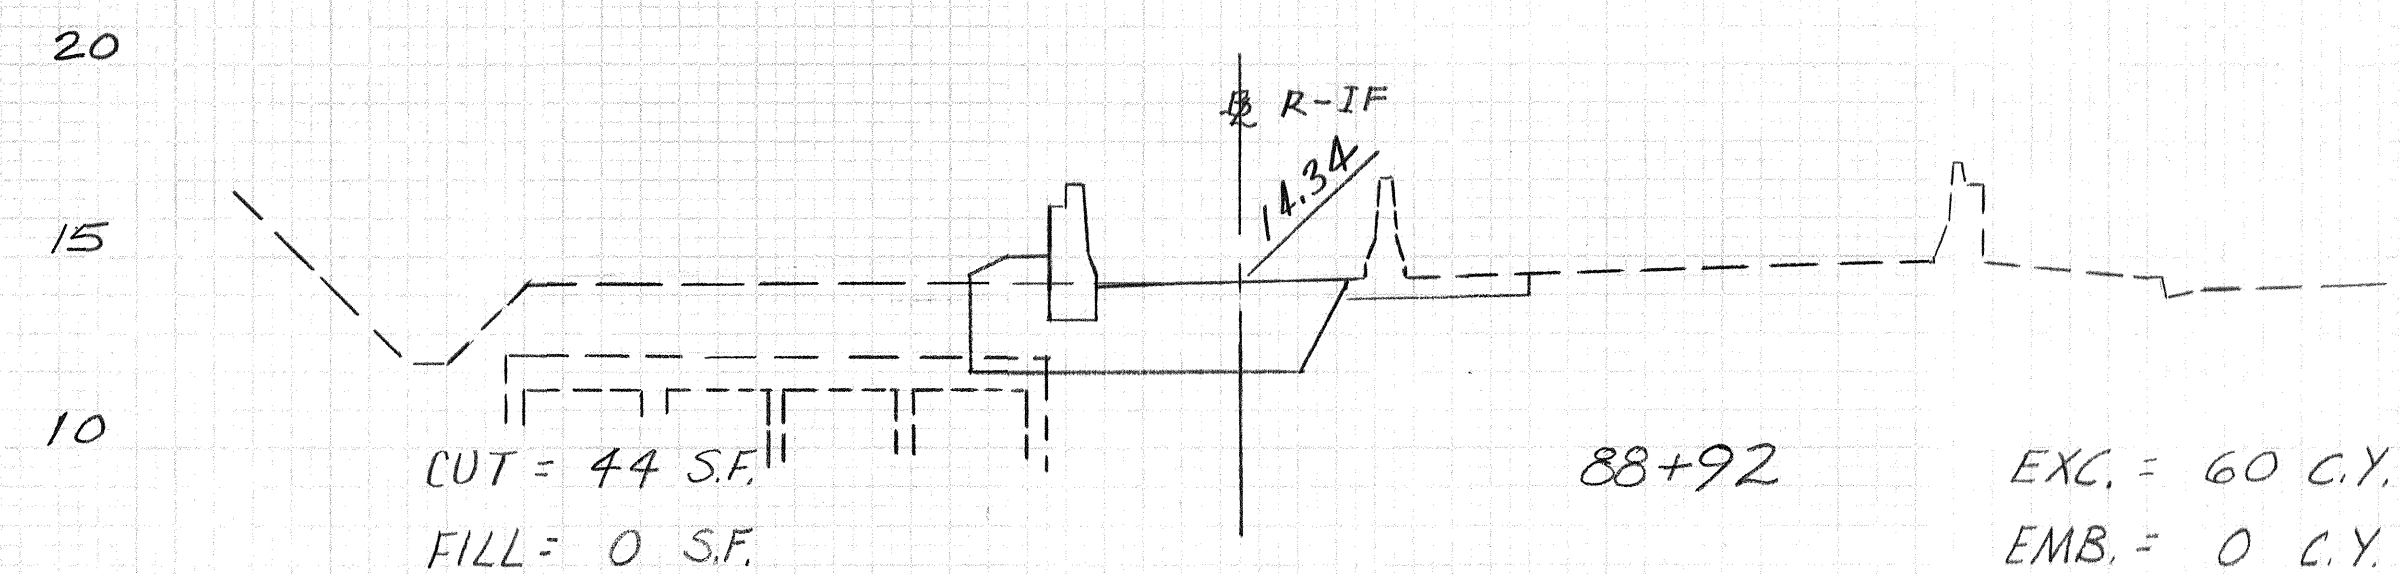
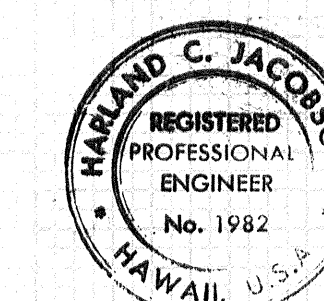


FED. ROAD DIST. NO.	STATE	FED. AID PROJ. NO.	FISCAL YEAR	SHEET NO.	TOTAL SHEETS
HAWAII	HAW.	I-HI-1(174):16	1982	70	70

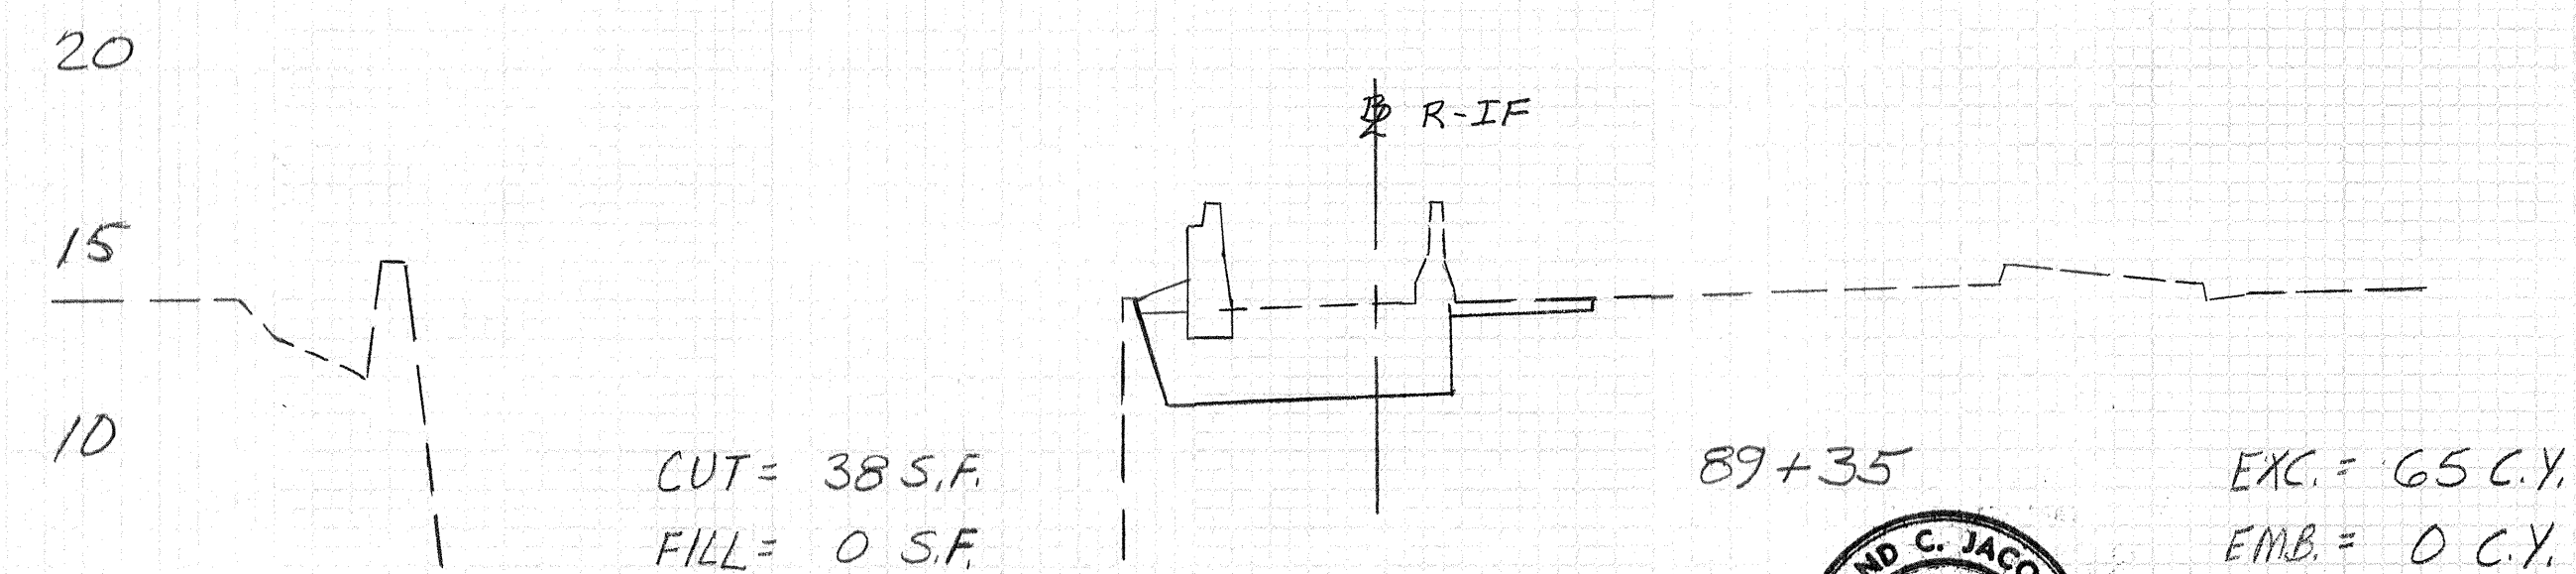

TOTALS

EXC. = 1693 C.Y.
EMB. = 0 C.Y.

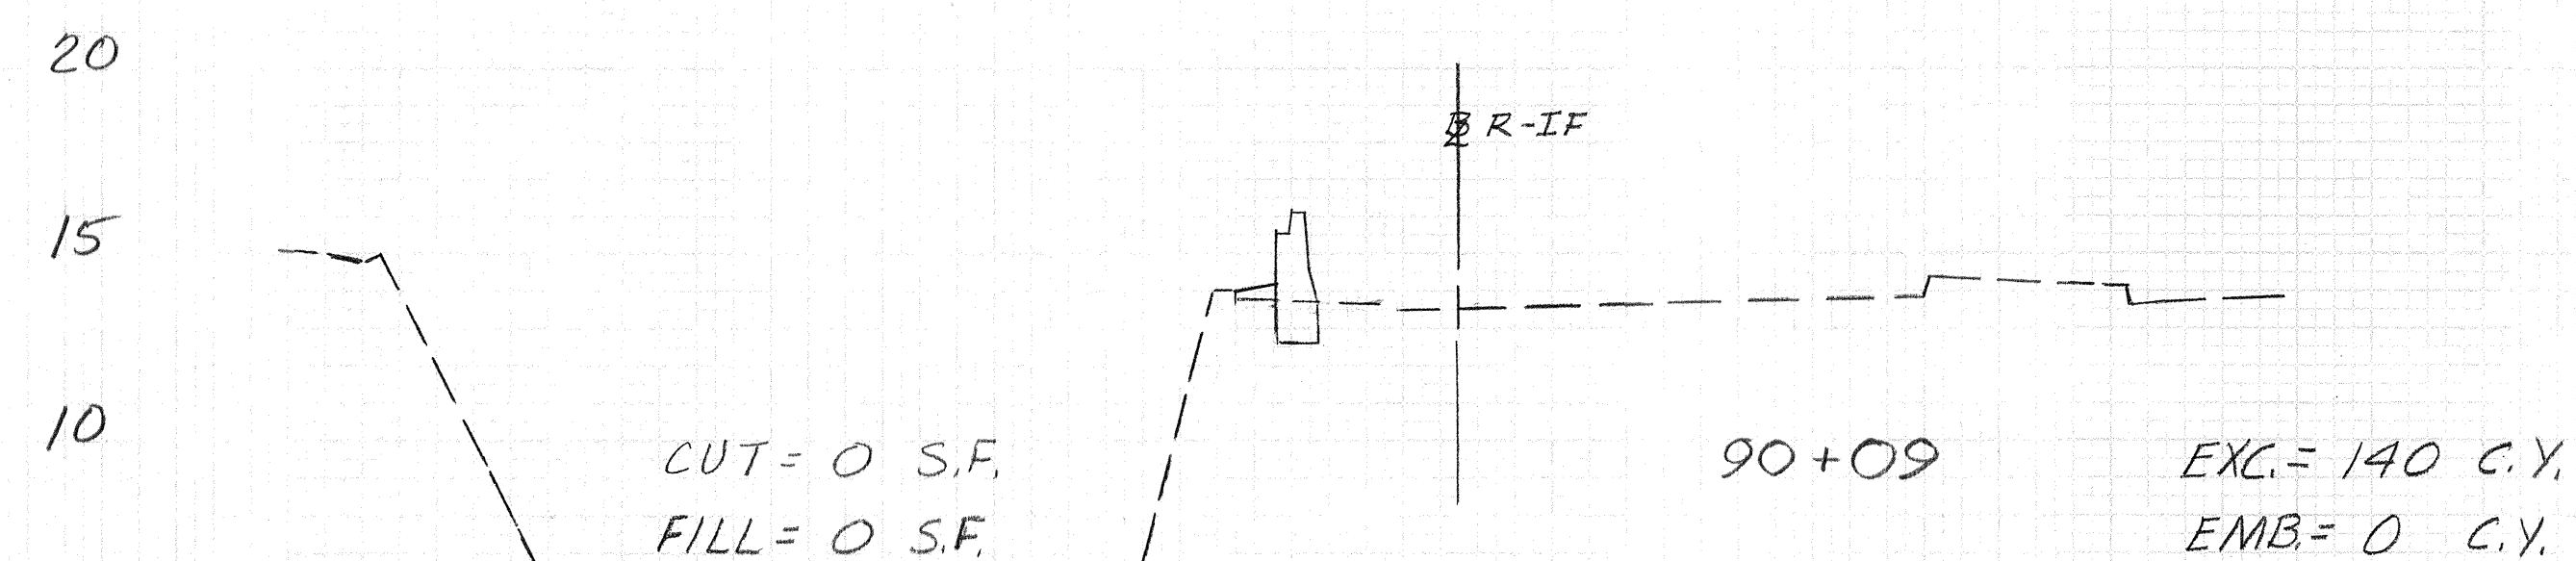

THIS WORK WAS PREPARED BY
ME OR UNDER MY SUPERVISION.
Harold C. Jacobson
Signature

HORZ. 1" = 10'
VERT. 1" = 5'

SHEET 2 OF 2