
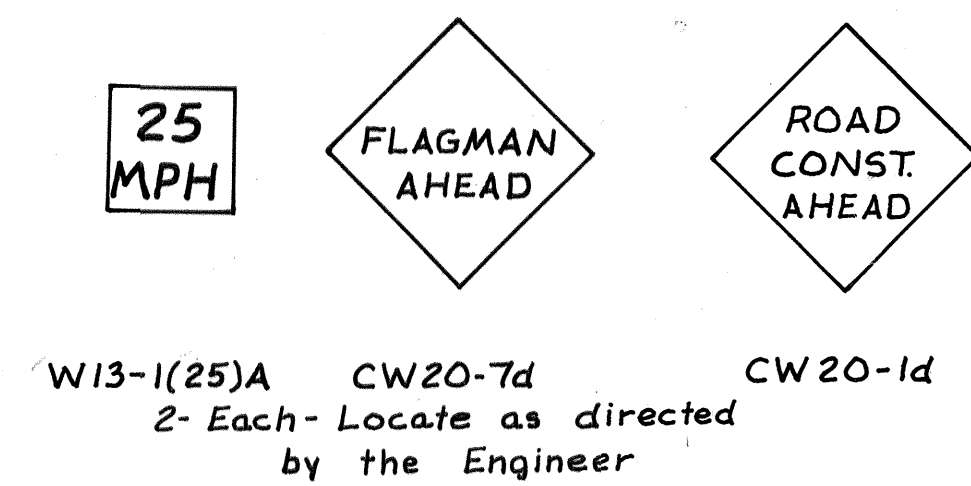
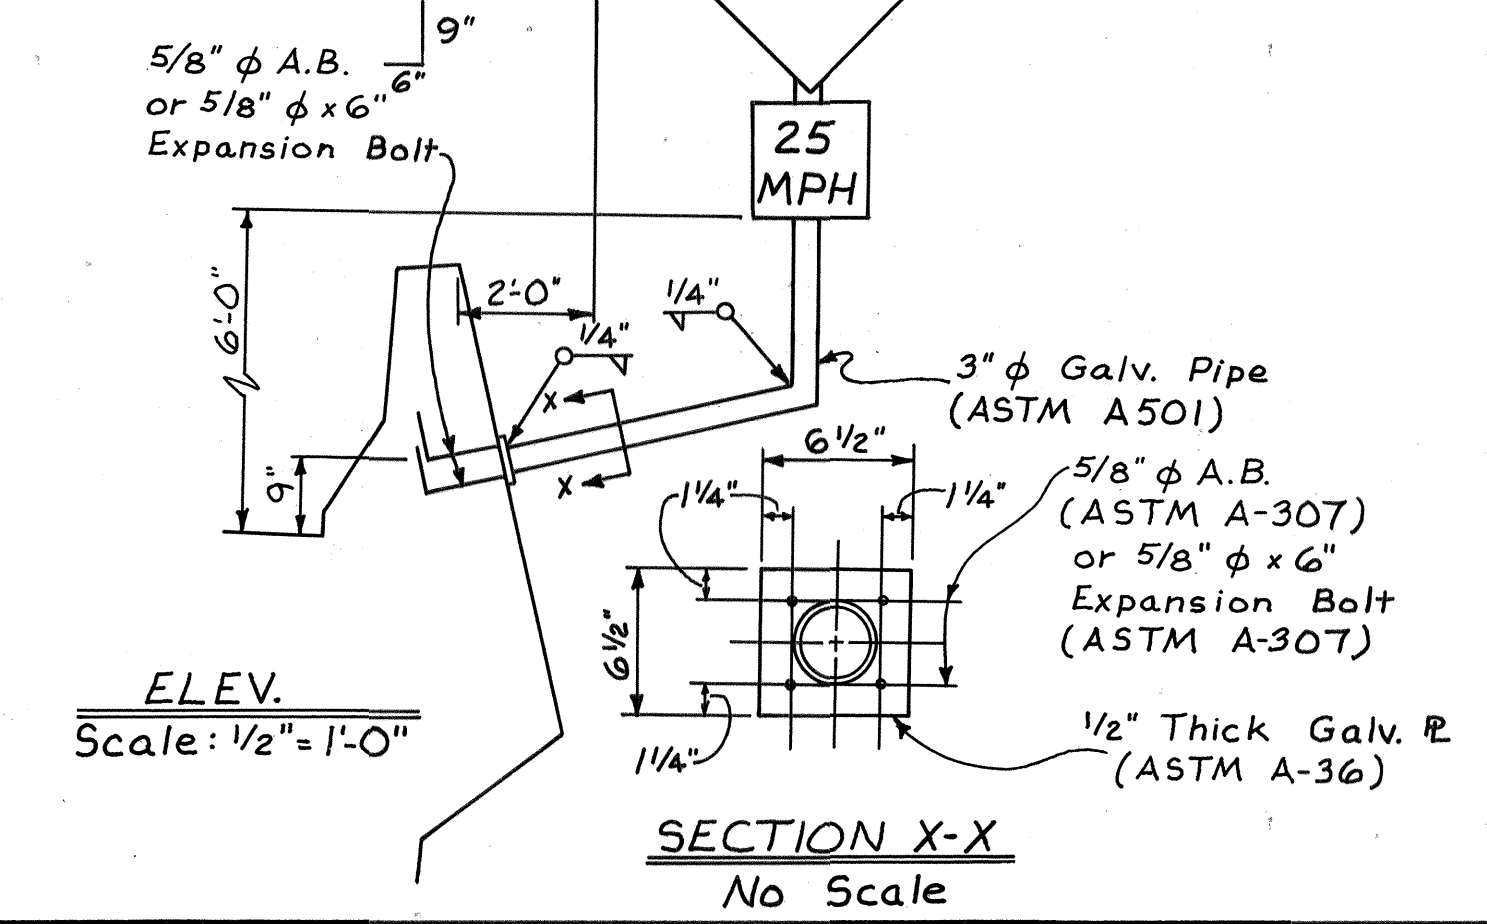
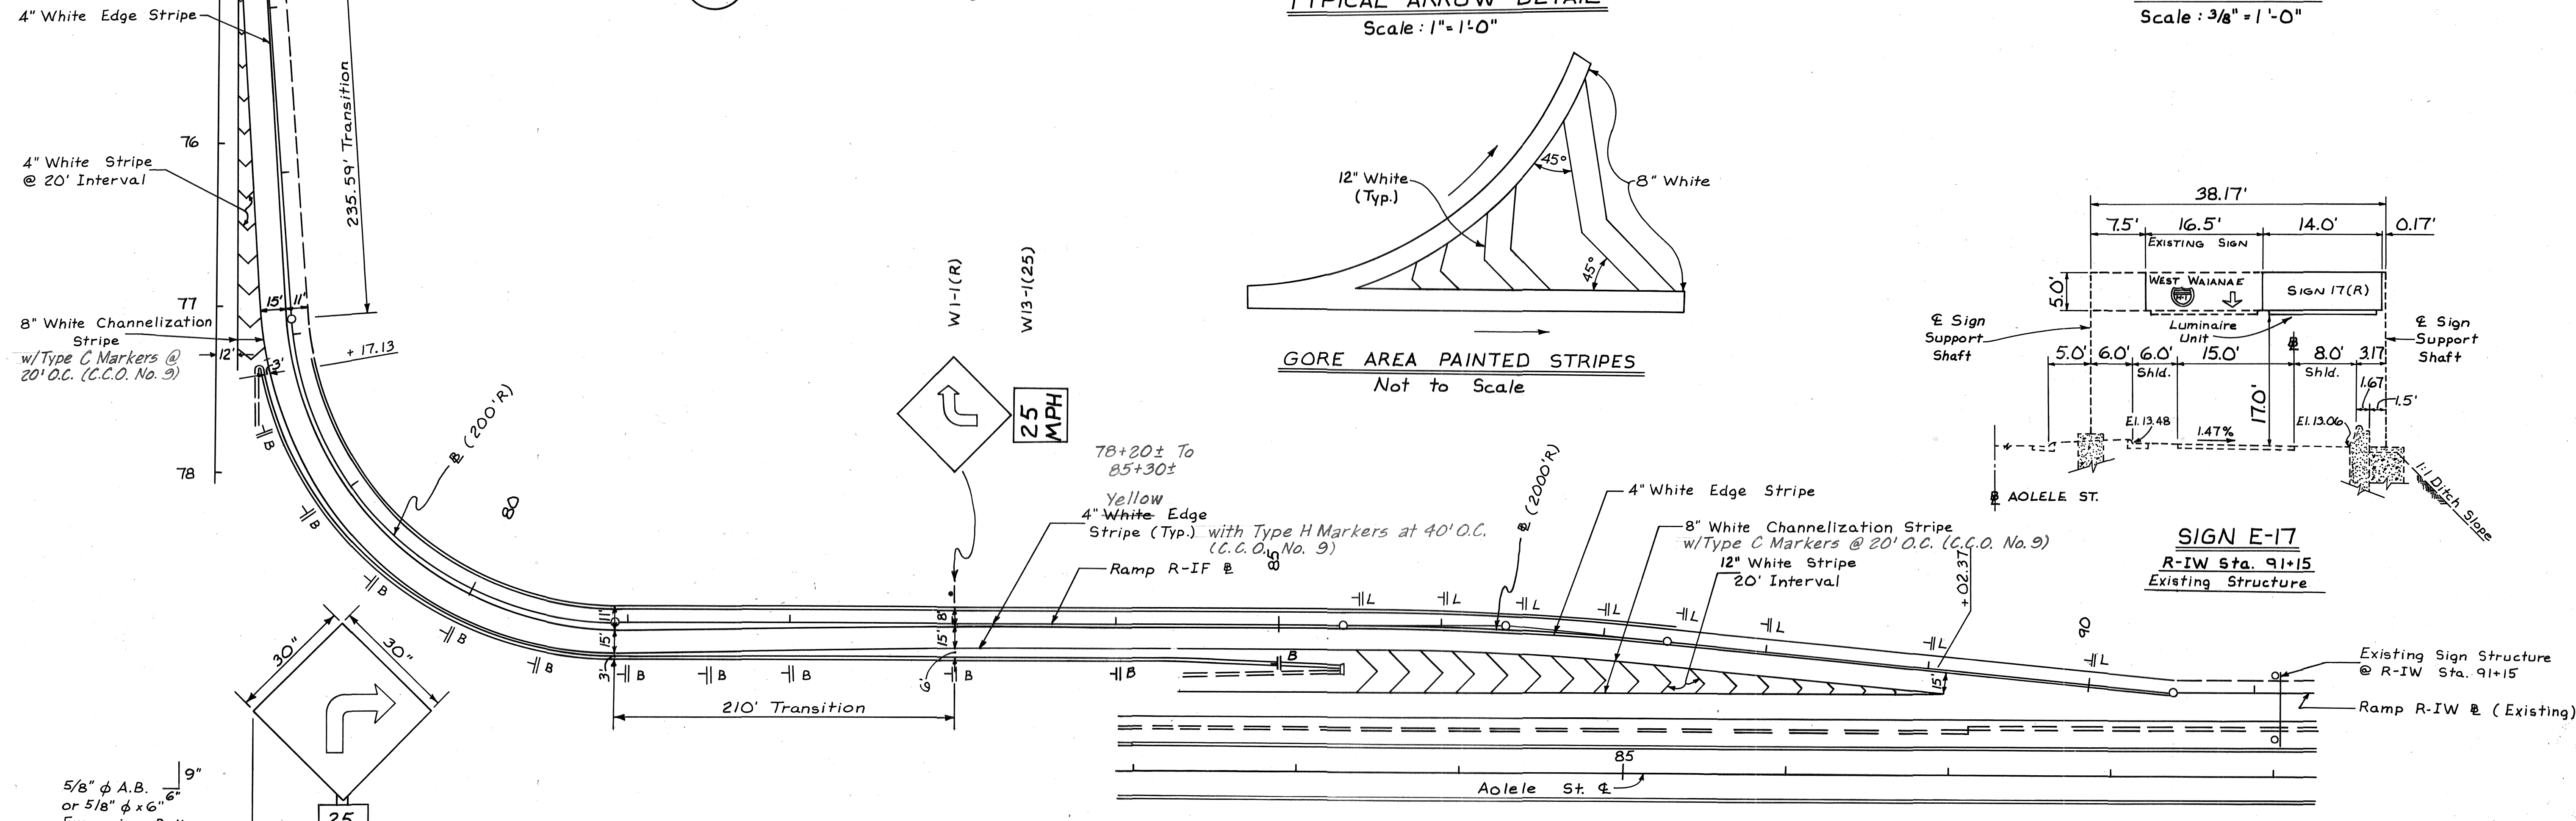
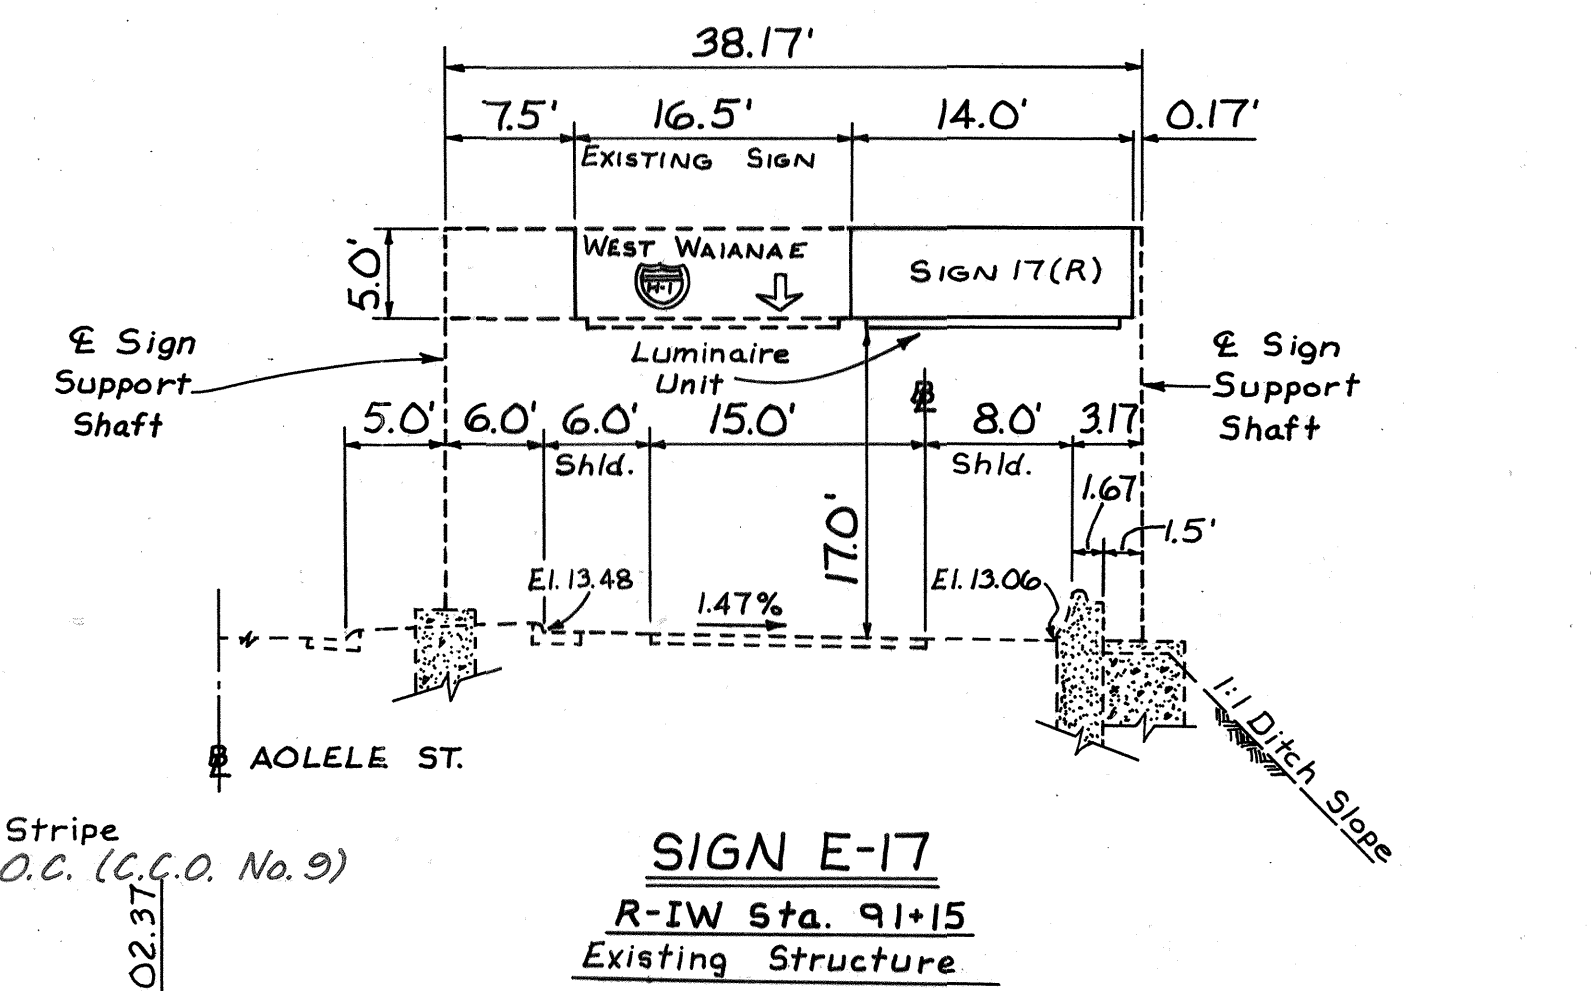
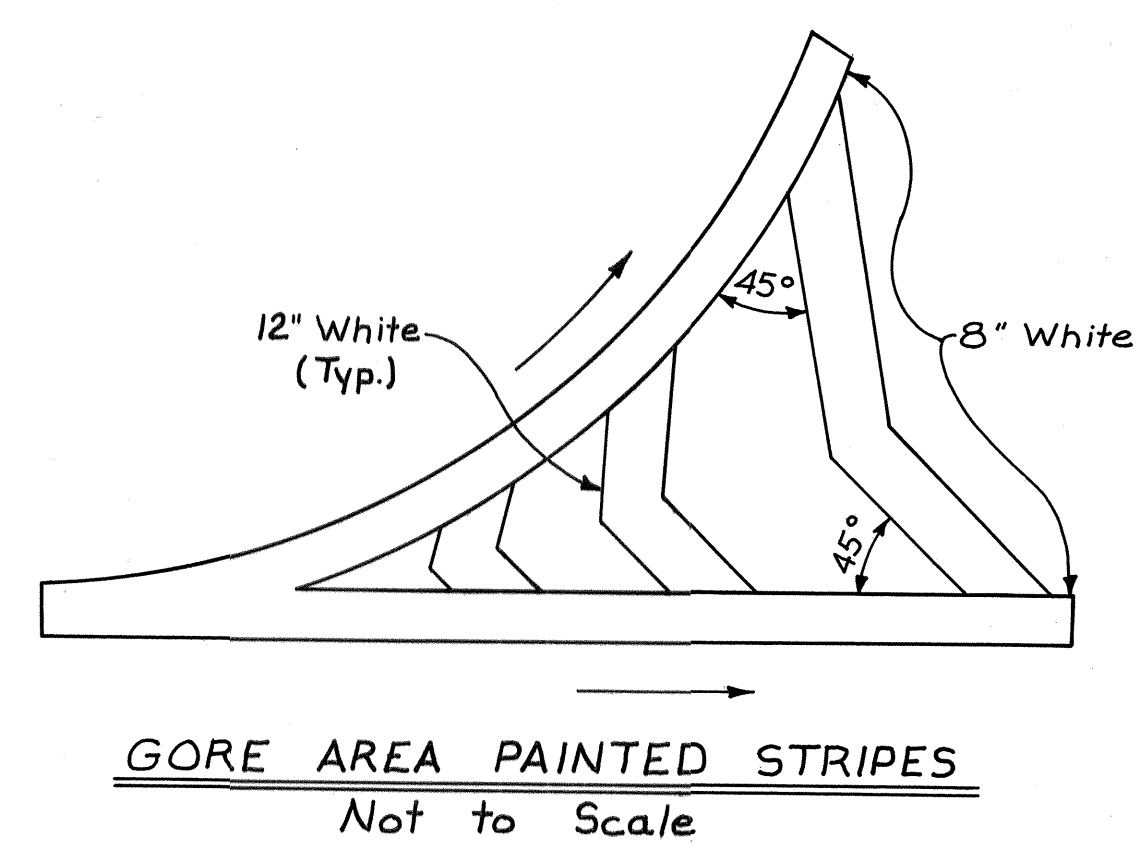
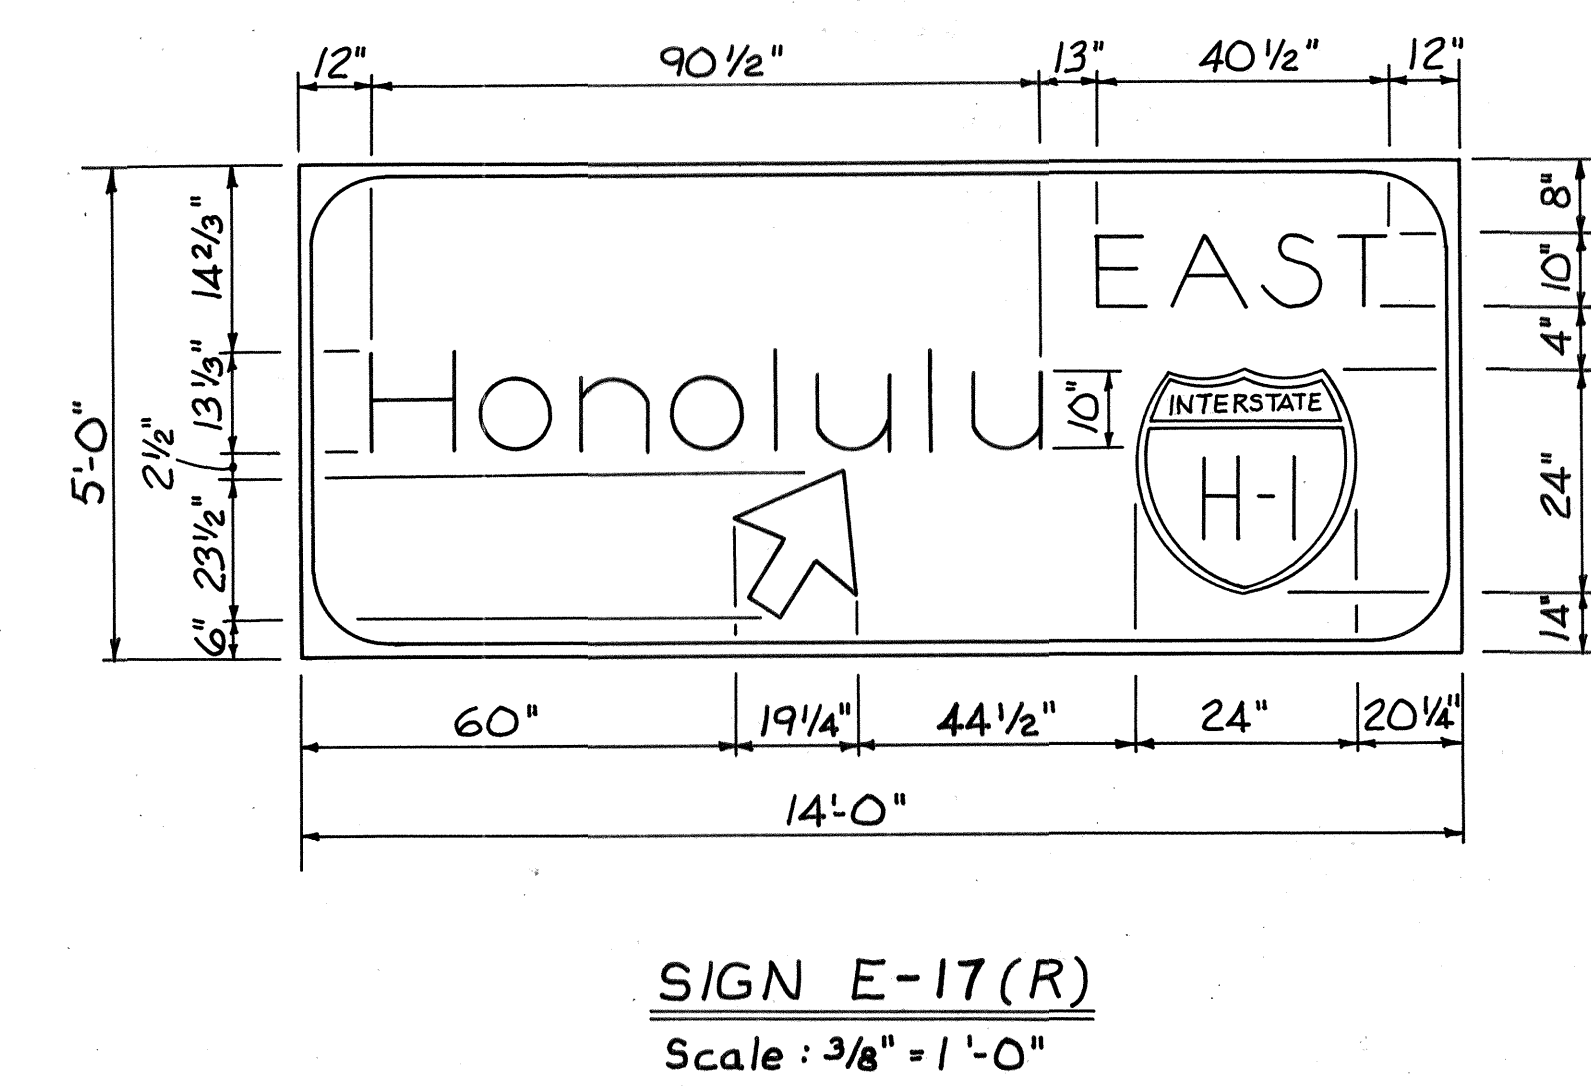
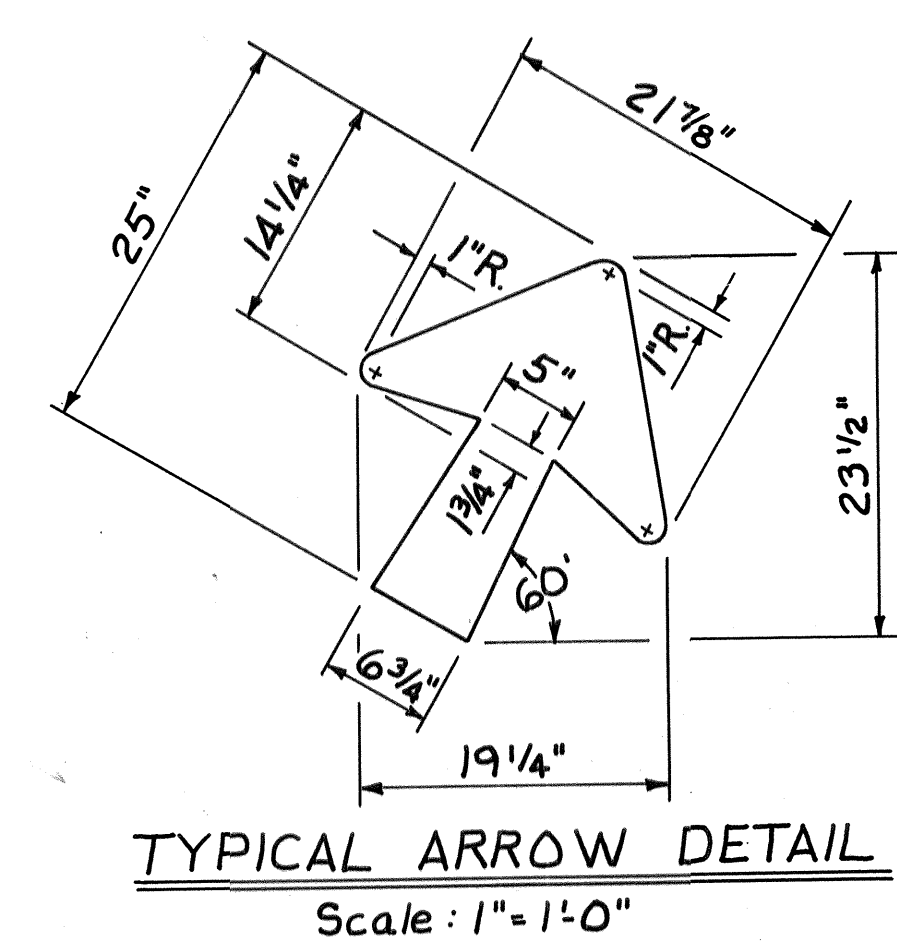


FED. ROAD DIST. NO.	STATE	FED. AID PROJ. NO.	FISCAL YEAR	SHEET NO.	TOTAL SHEETS
HAWAII	HAW.	I-HI-1(174):16	1982	12	70

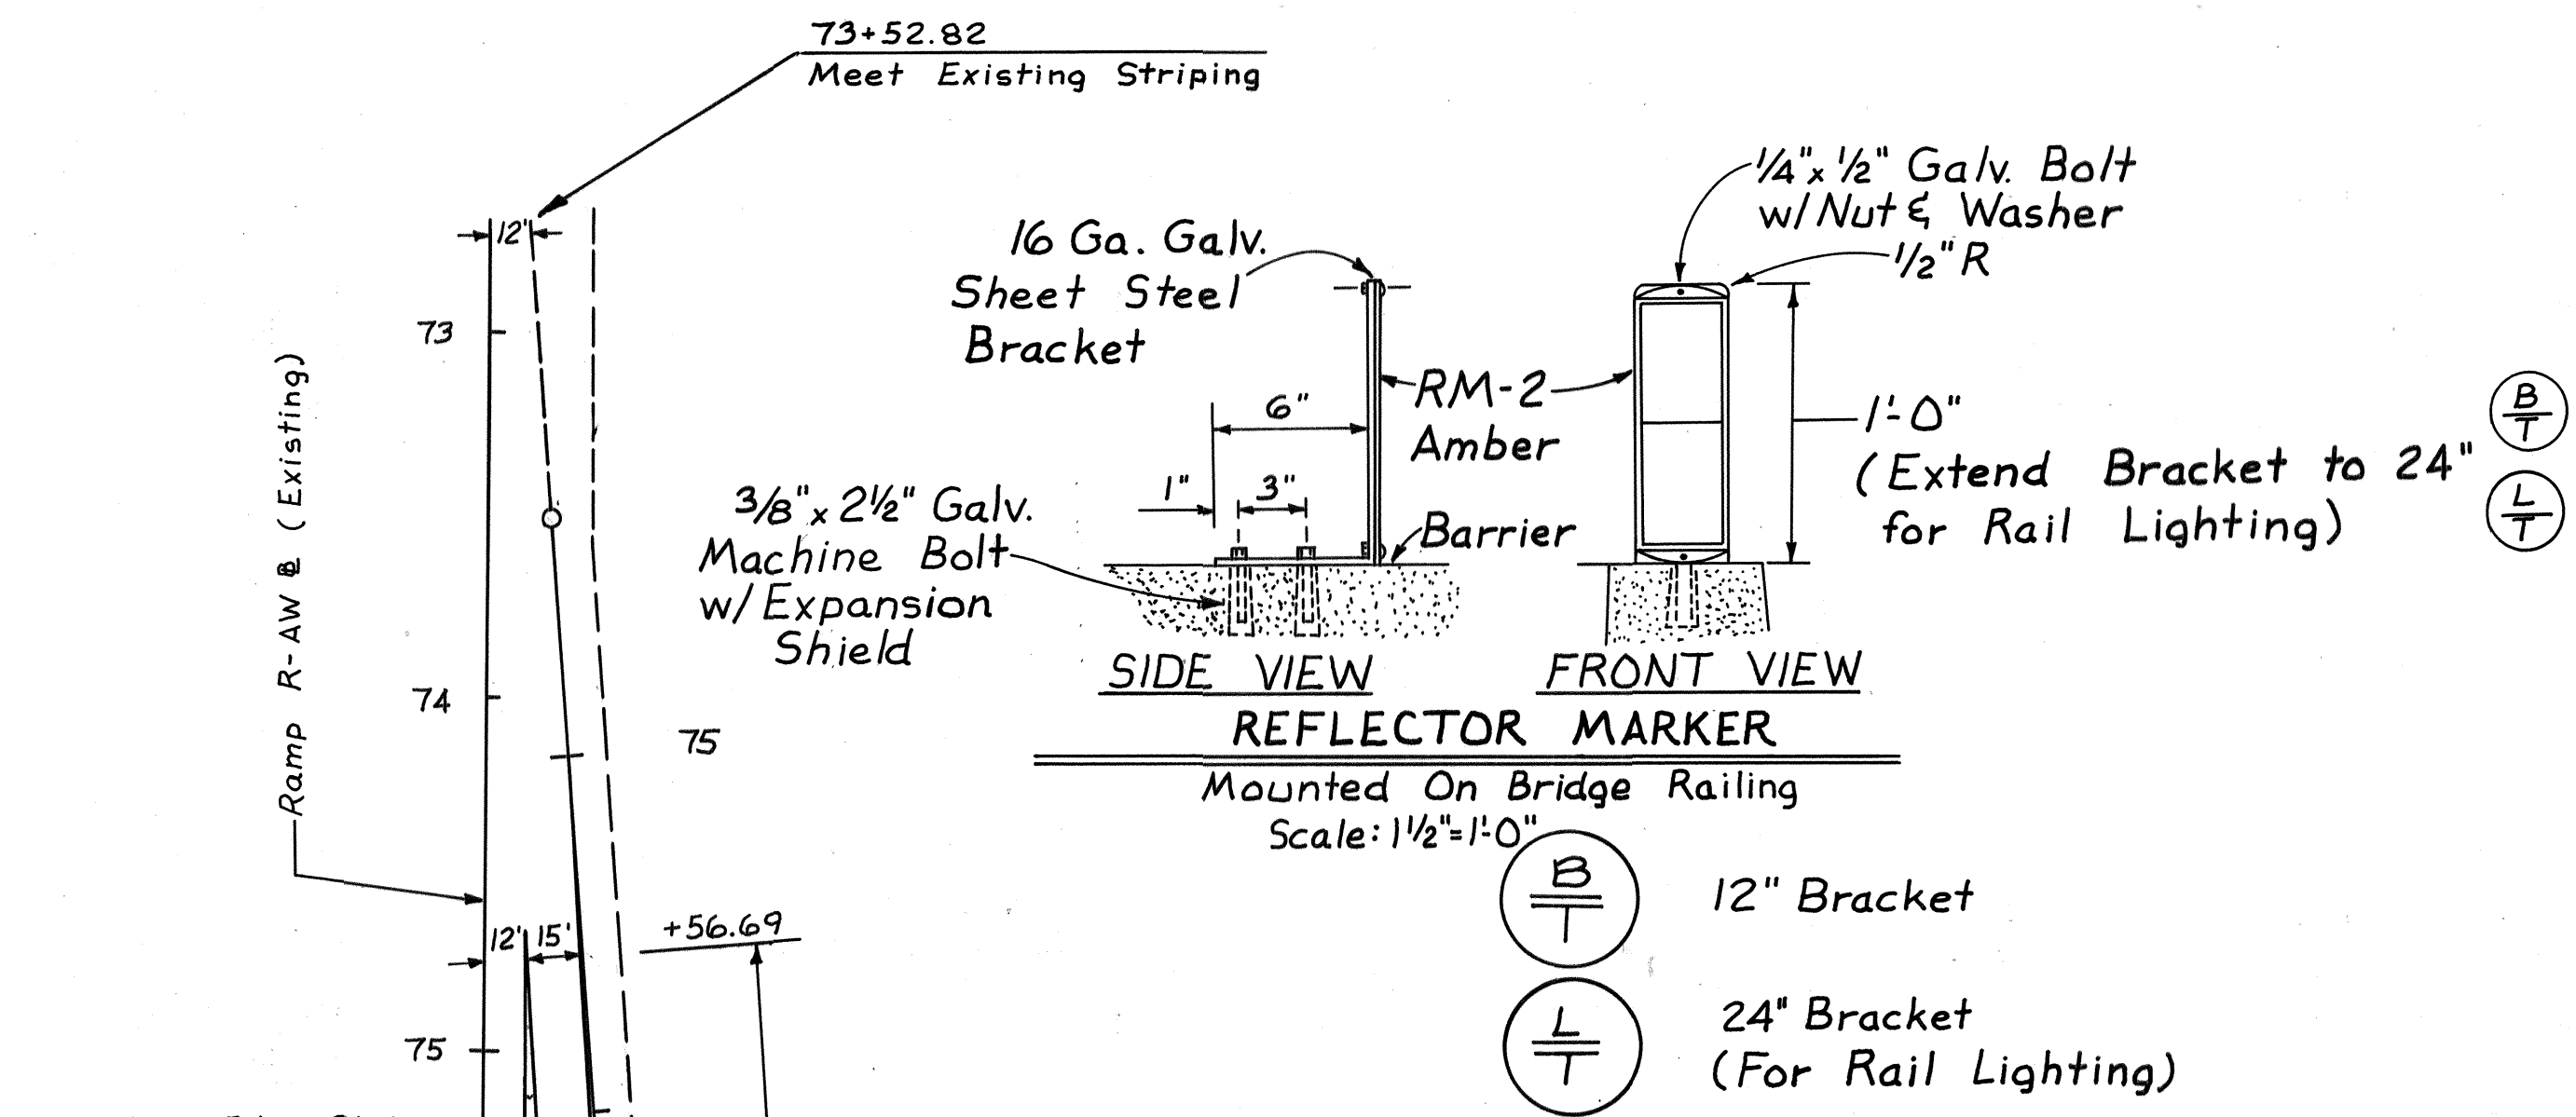

THIS WORK WAS PREPARED BY ME OR UNDER MY SUPERVISION.
 [Signature]
 REGISTERED PROFESSIONAL ENGINEER
 No. 1982
 HAWAII, U.S.A.

STATE OF HAWAII
 DEPARTMENT OF TRANSPORTATION
 HIGHWAYS DIVISION

RAMP - IF
 SIGNING & STRIPING

AIRPORT INTERCHANGE
 F.A.I. PROJ. NO. I-HI-1(174):16

SCALE 1" = 50' DATE: SEPT. 1982

SHEET NO. 1 OF 1 SHEETS

DATE	
SURVEY PLOTTED BY	
DRAWN BY	
TRACED BY	
NOTE BOOK	
DESIGNED BY	
CHECKED BY	
No.	