



FED. ROAD DIST. NO.	STATE	FED. AID PROJ. NO.	FISCAL YEAR	SHEET NO.	TOTAL SHEETS
HAWAII	HAW.	I-H-1(174)16	1982	2	70

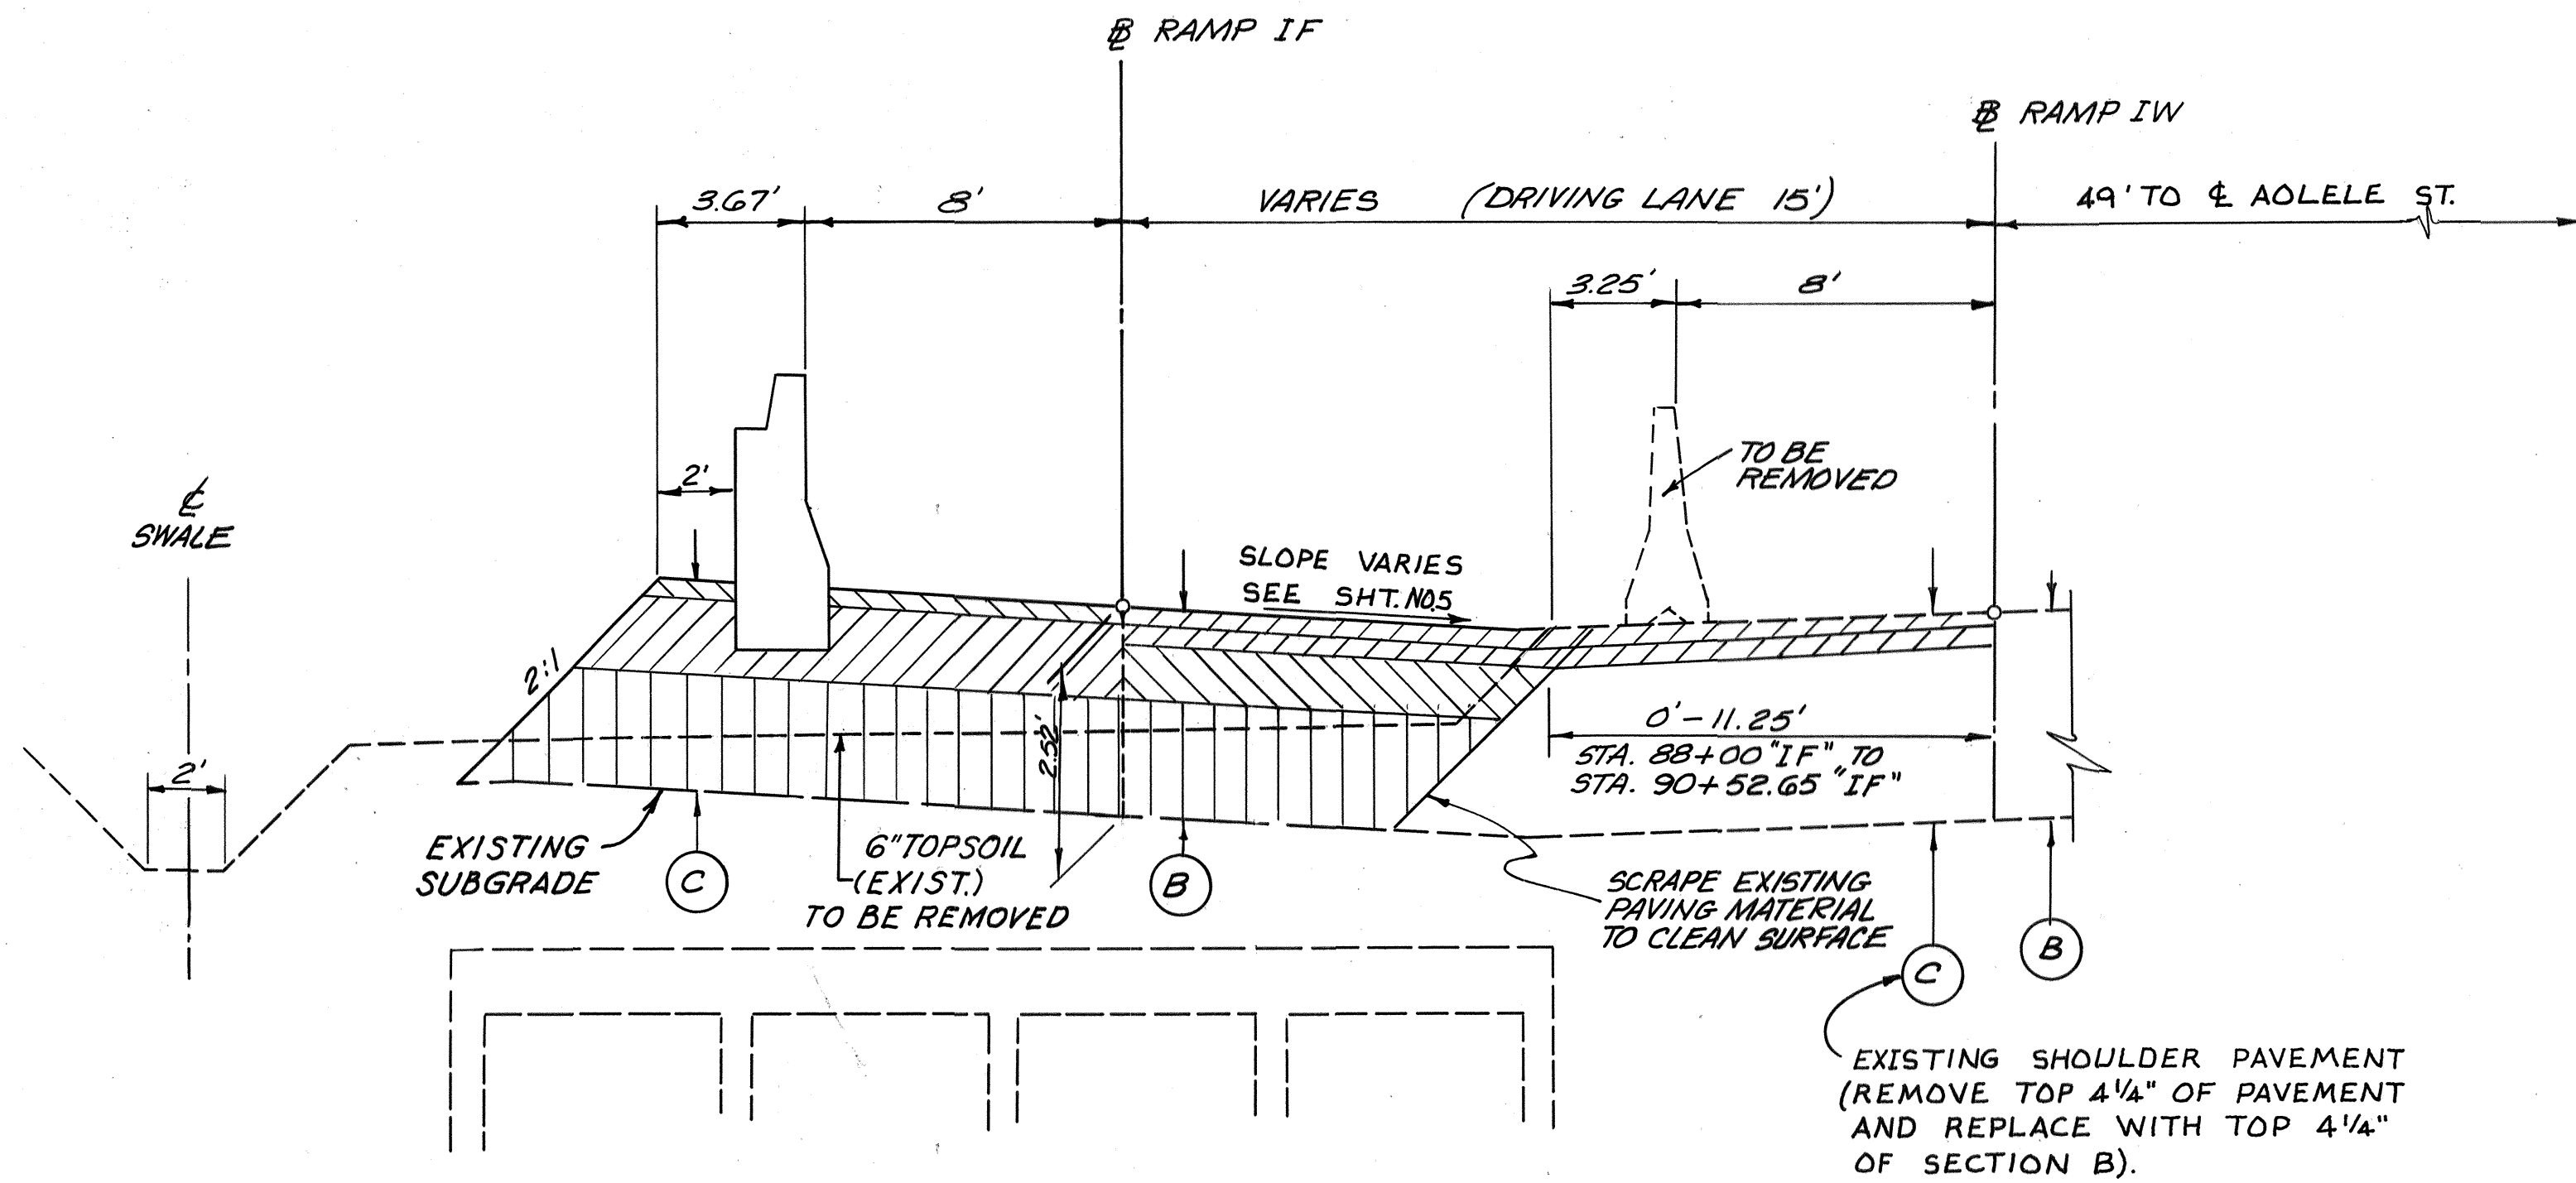


STA. 87+15.19 TO STA. 90+52.65

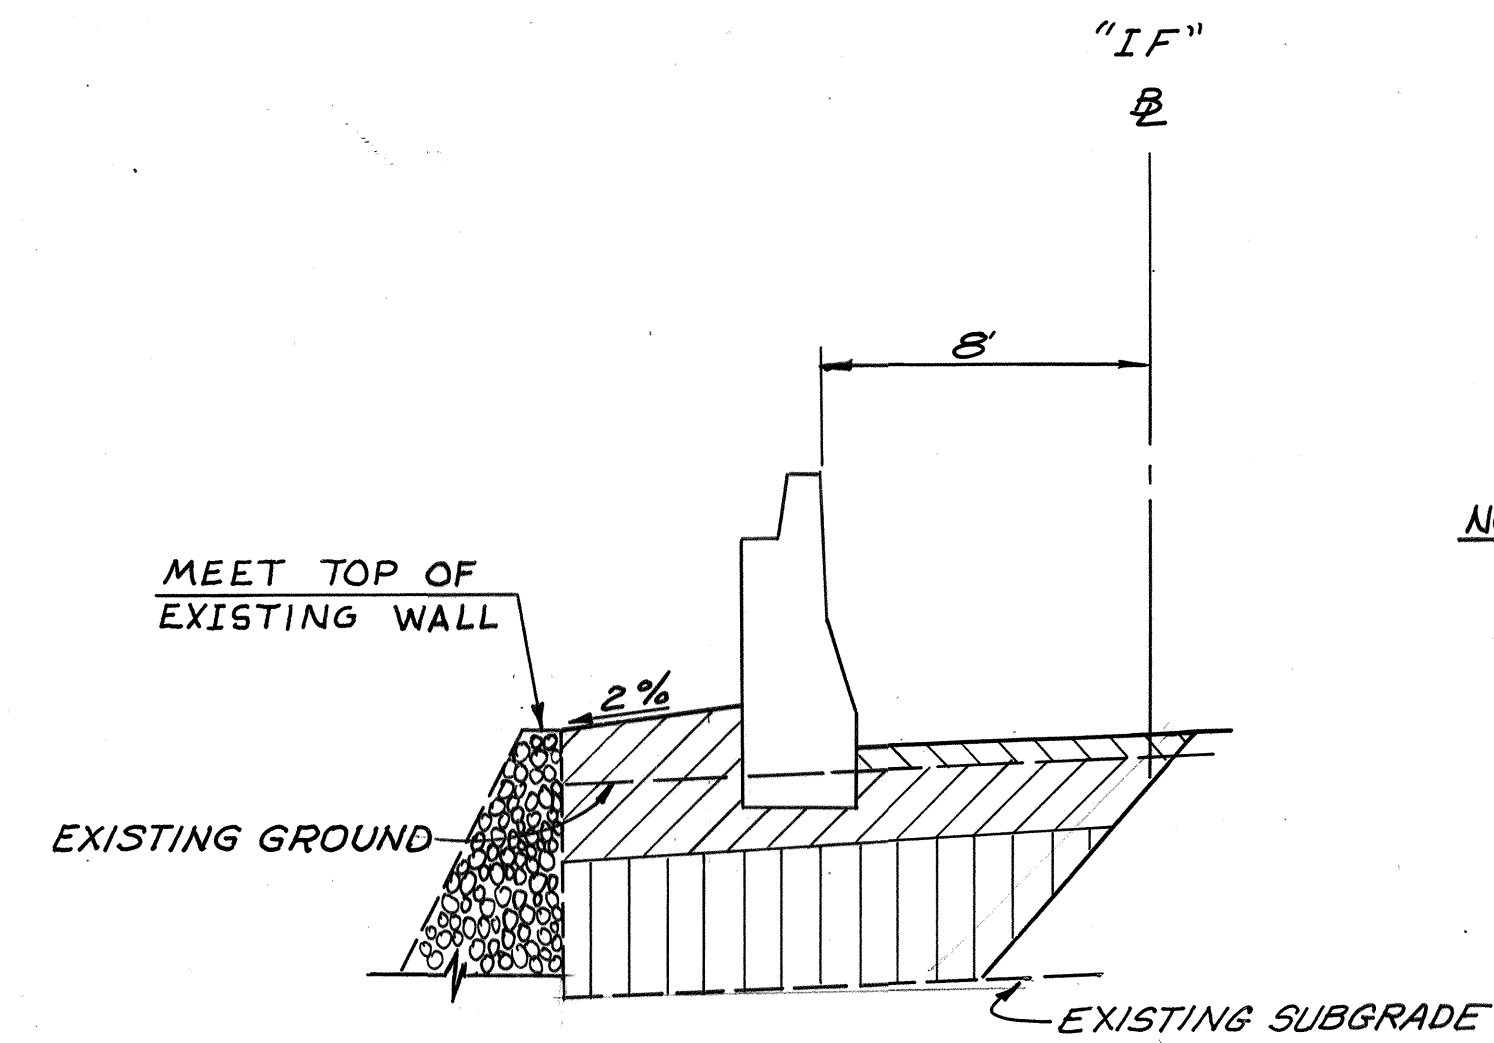


SHOULDER DETAIL
STA. 89+13.31 TO STA. 90+52.65 LT.


NOTE:
PORTABLE GUARD RAIL TO BE REMOVED, SHALL BE STOCKPILED AS DIRECTED BY THE ENGINEER AT KEEHI INTERCHANGE LOCATED APPROXIMATELY TWO MILES EAST OF CONSTRUCTION SITE.

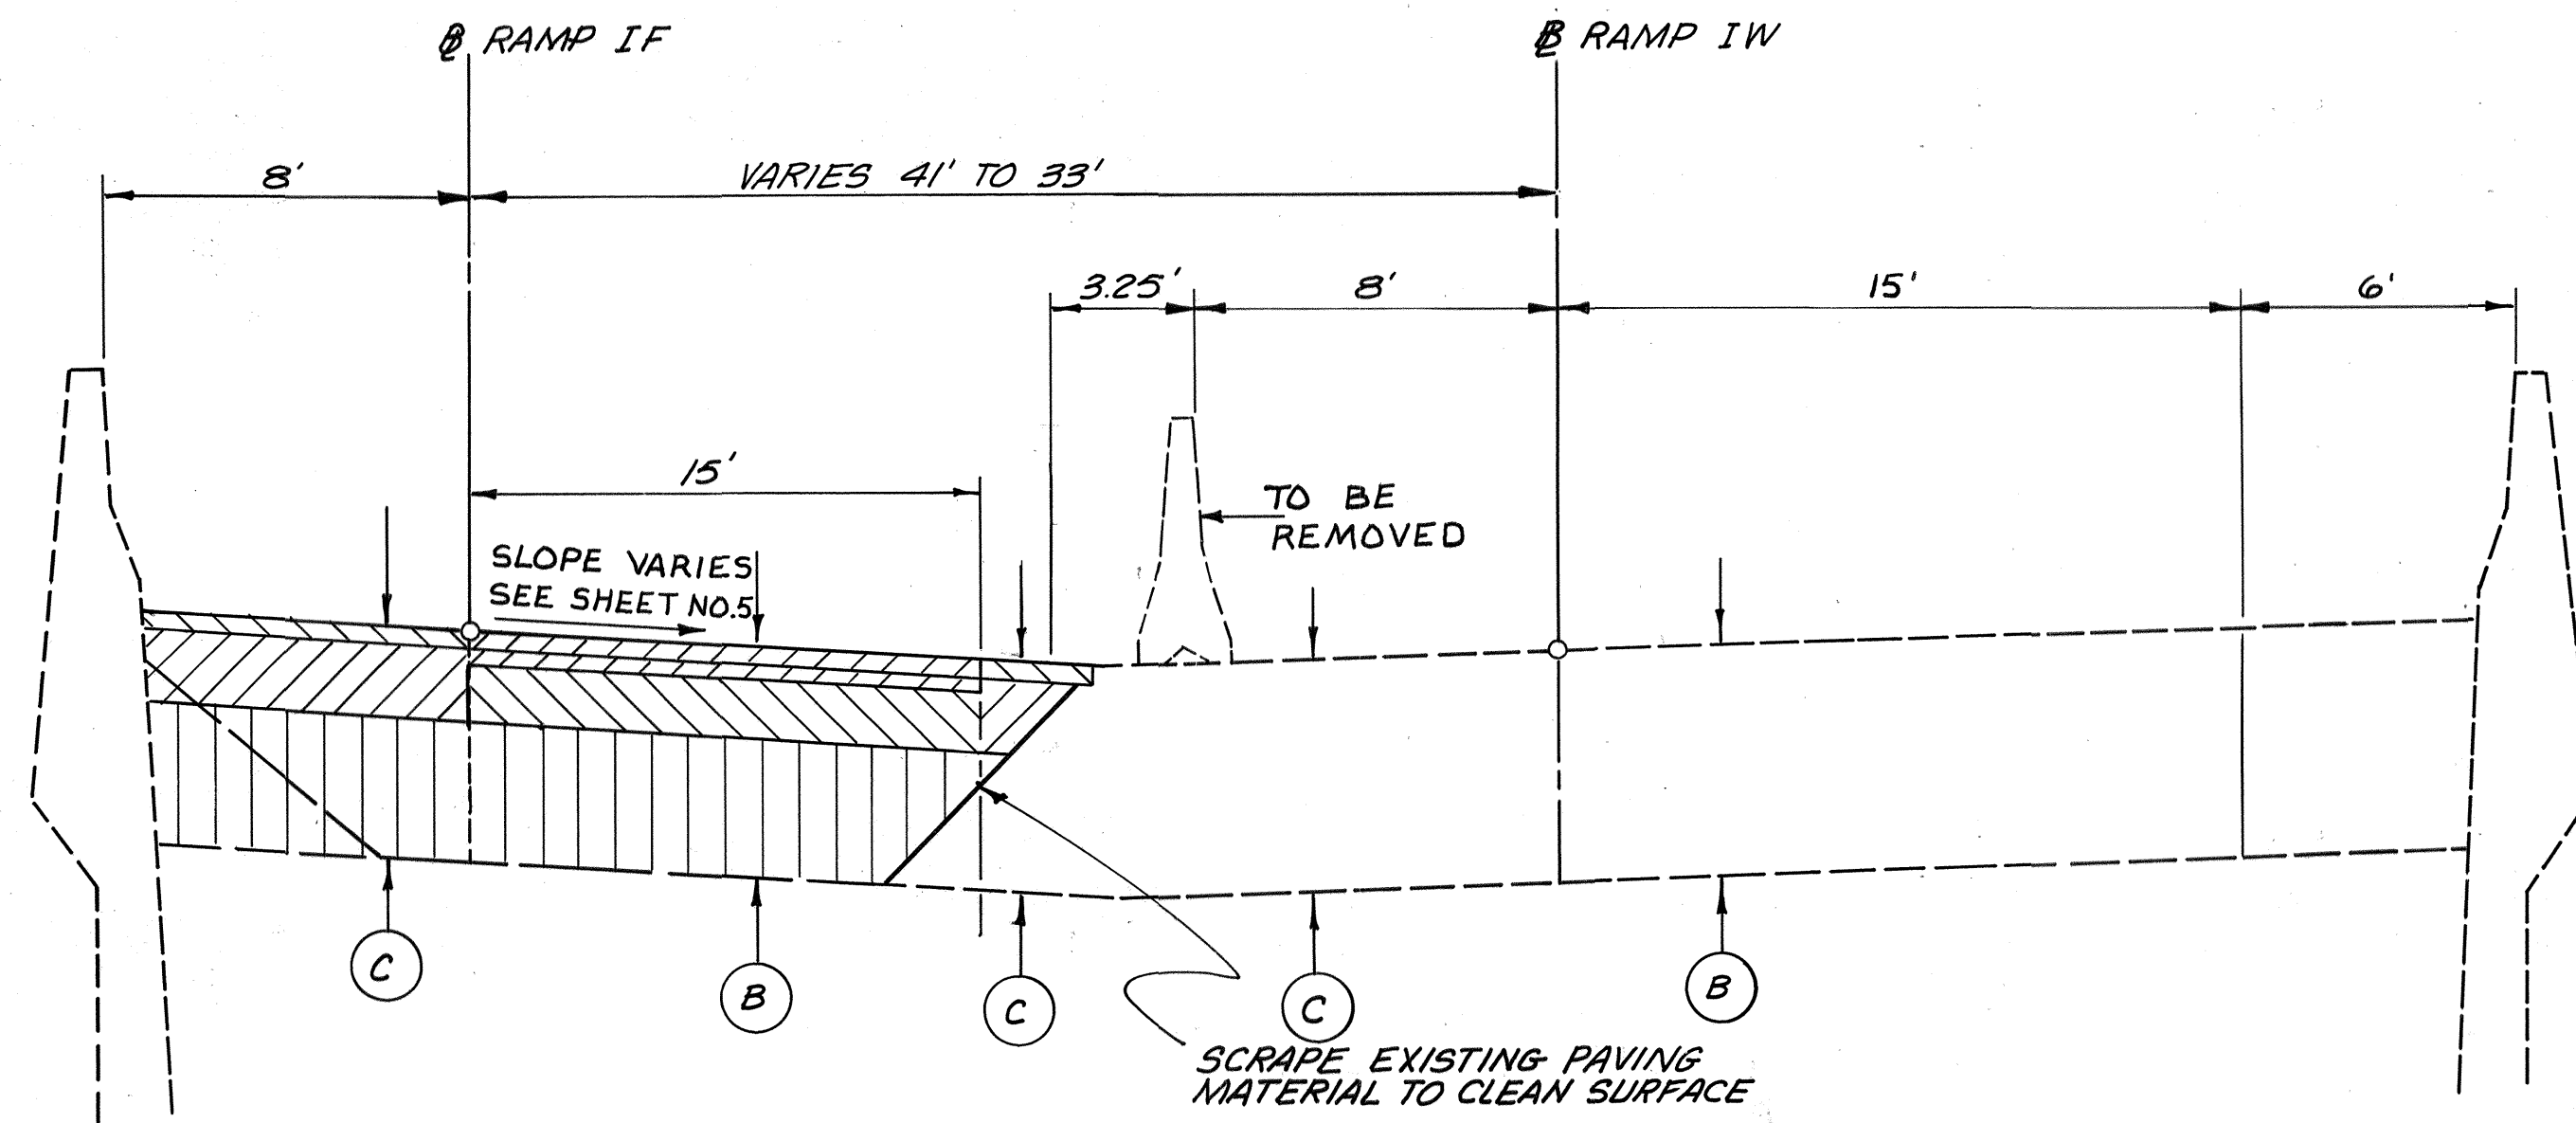


STA. 85+37.69 TO STA. 87+15.19

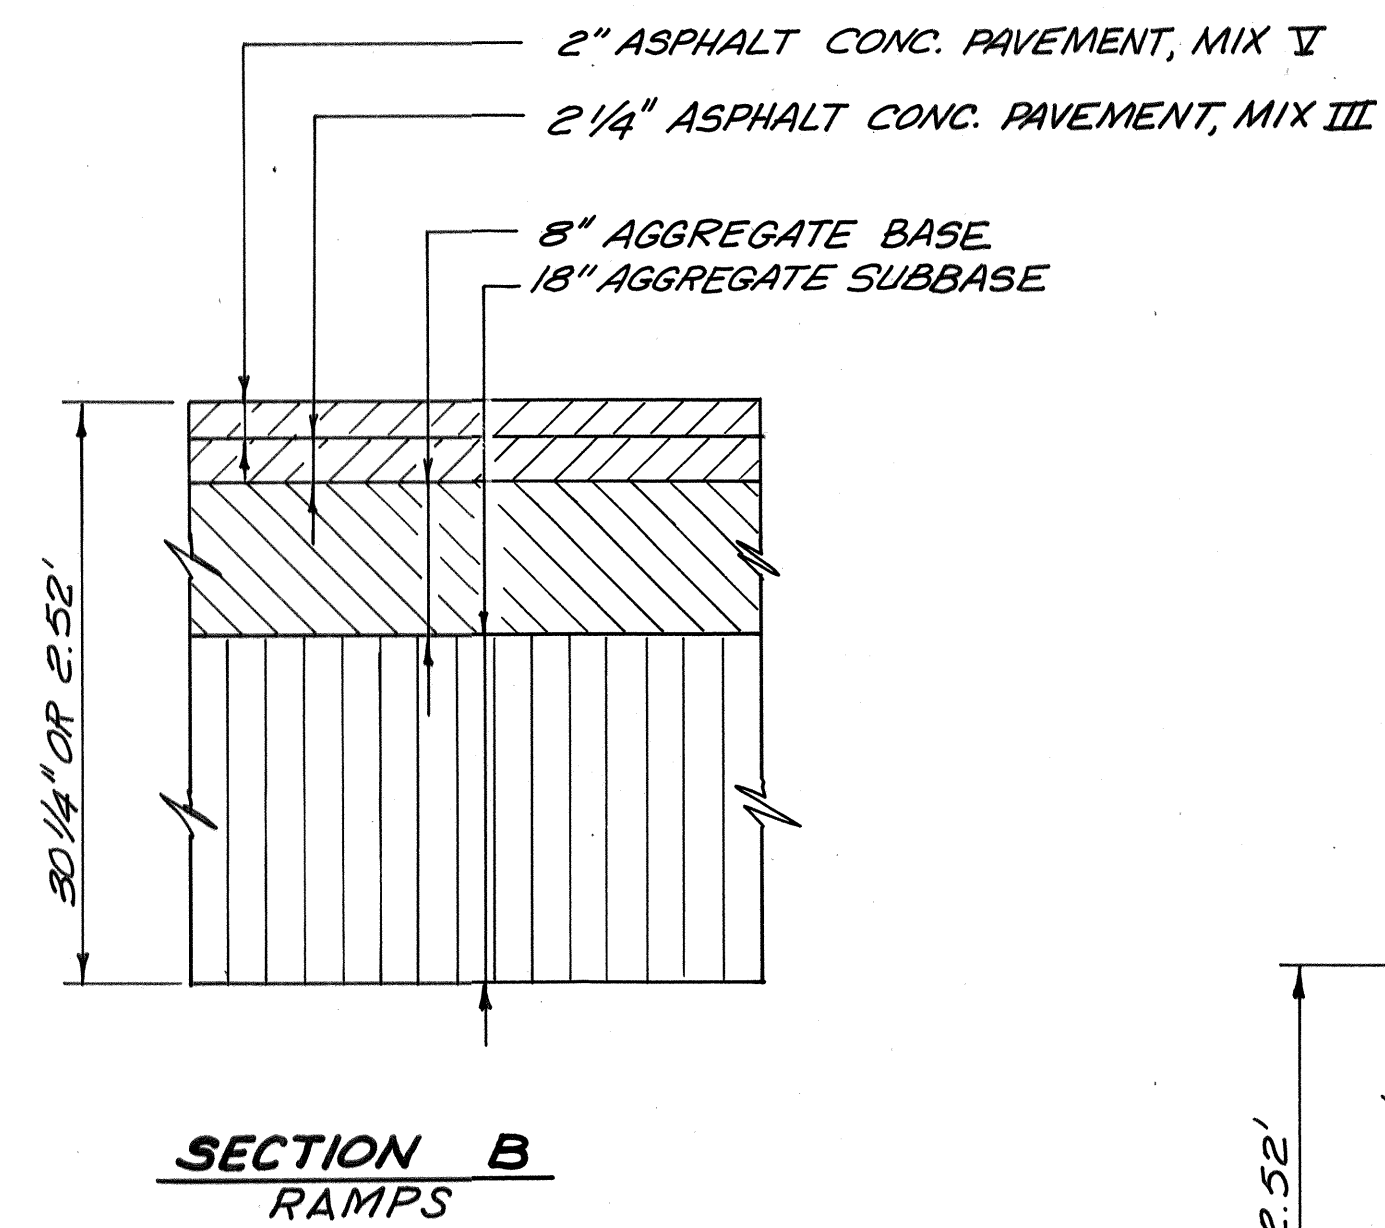

SECTION B
RAMPS

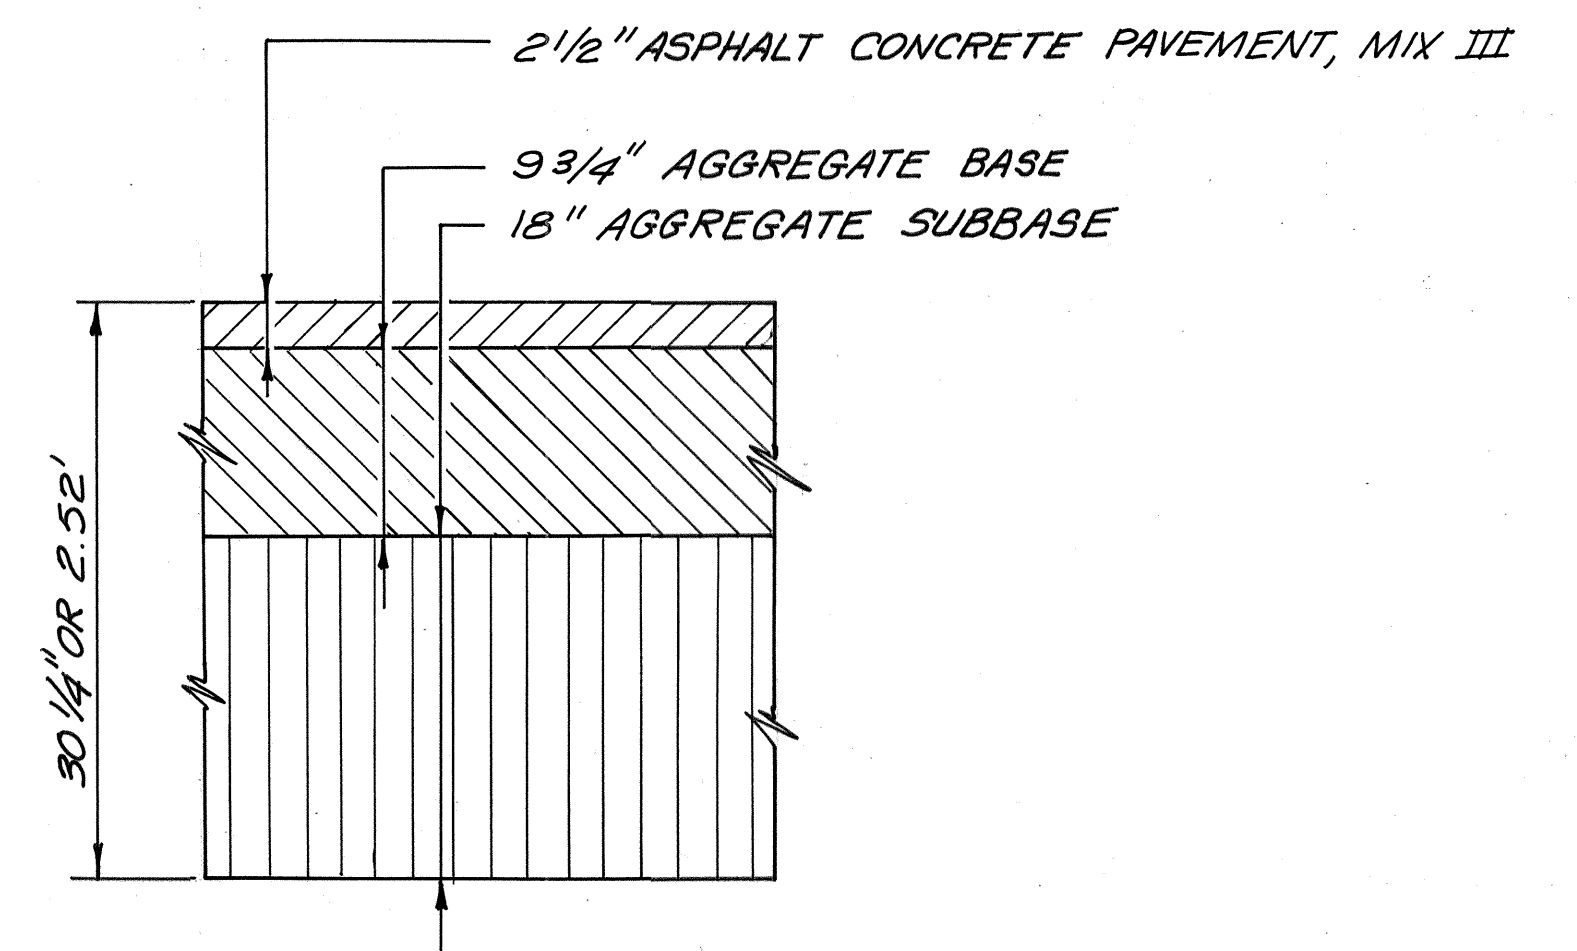

SECTION C
RAMP SHOULDERS

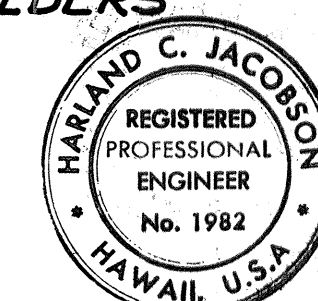

THIS WORK WAS PREPARED BY ME OR UNDER MY SUPERVISION.
Harold C. Jacobson
Signature

STATE OF HAWAII DEPARTMENT OF TRANSPORTATION LAND TRANSPORTATION FACILITIES DIVISION	
RAMP - IF TYPICAL SECTIONS	
AIRPORT INTERCHANGE E.A.I. PROJ. NO. I-H-1(174)-16	
SCALE: NONE	DATE: SEPT. 1982
SHEET No. 1 OF 1 SHEETS	

SURVEY PLOTTED BY	DATE
DRAWN BY	
DESIGNED BY	
NOTED BY	
CHECKED BY	
NO.	