


FED. ROAD DIST. NO.	STATE	FED. AID PROJ. NO.	FISCAL YEAR	SHEET NO.	TOTAL SHEETS
HAWAII	HAW.	I-HI-1(100):17	1982	2	47

NOTES:


- For mandatory completion requirements see Special Provisions, Subsection 108.03.
- The Contractor shall submit to the Engineer for approval a Traffic Control Plan (TCP) for each traffic pattern change not shown herein. The TCP shall be in full accordance with FHPM 6-4-2-12.
- Prestressed Concrete Girders will be furnished by Others.

THIS PLAN IS FOR INFORMATION ONLY.
IT DEPICTS THE RECOMMENDED CONSTRUCTION
PHASING FOR PROJECT NO. I-HI-1(168):17.


SEE SPECIAL PROVISIONS FOR MANDATORY
DELIVERY DATES OF PRESTRESSED CONCRETE
GIRDERS.

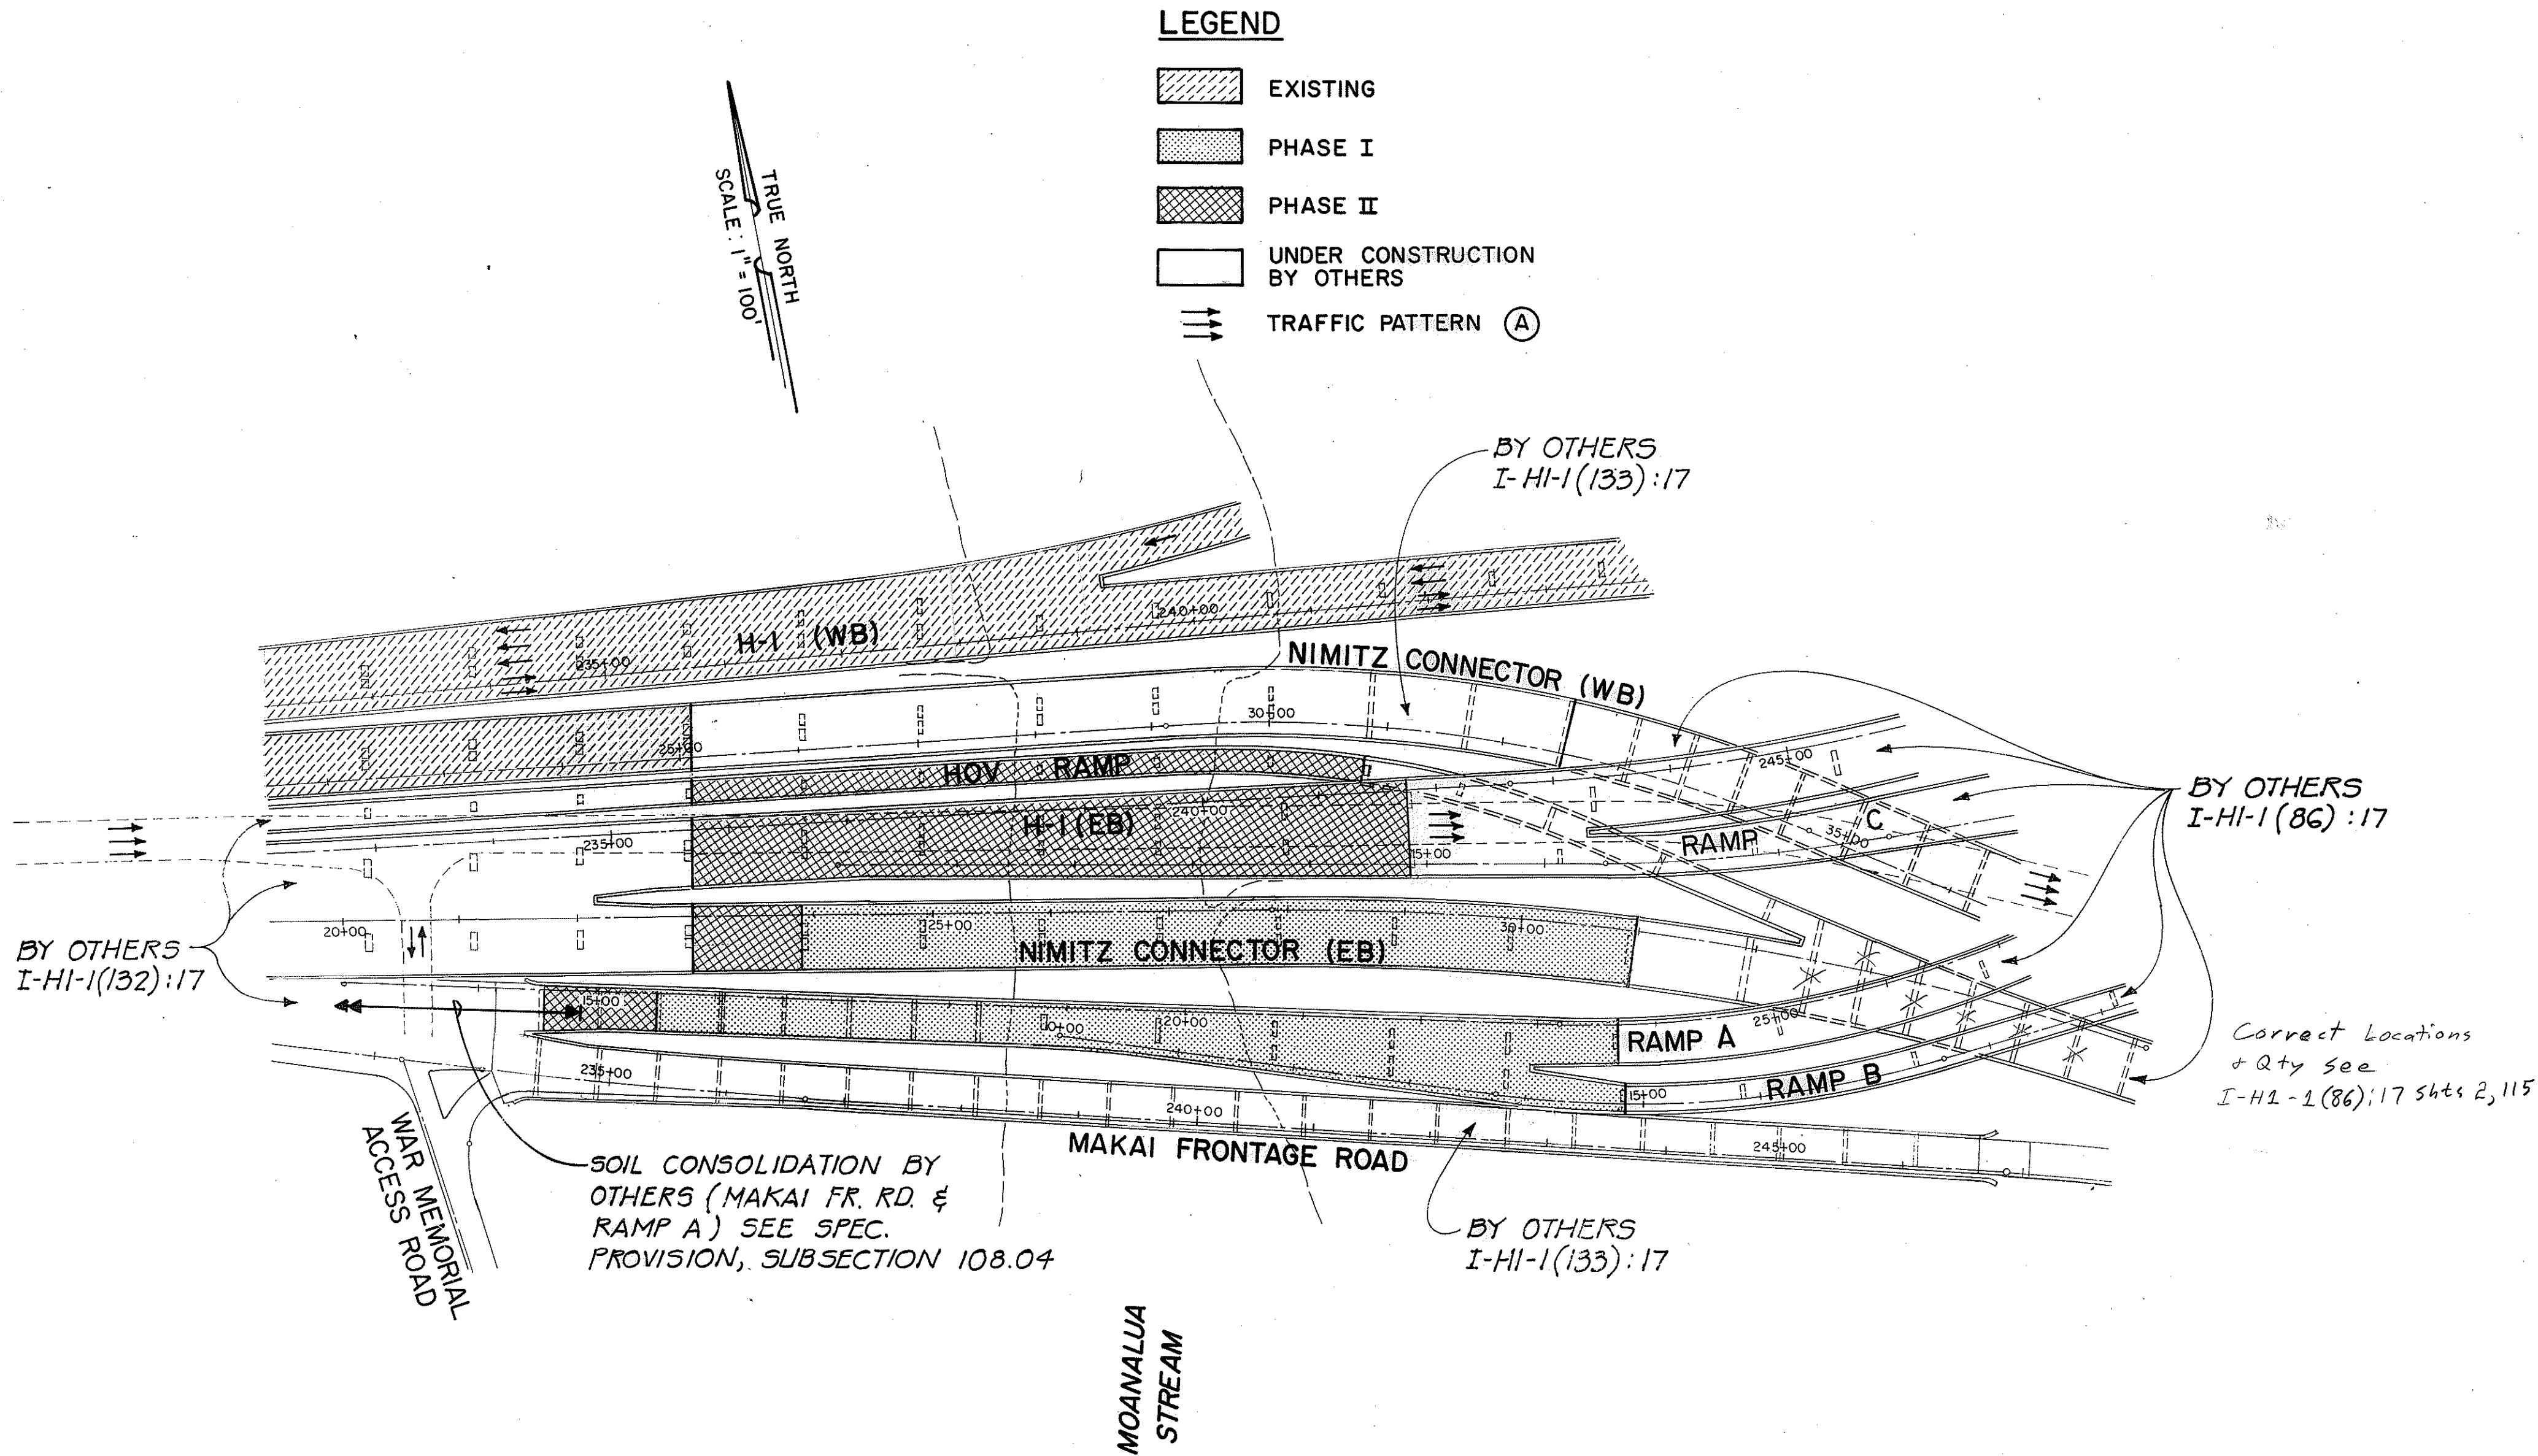

RECOMMENDED CONSTRUCTION PHASING:

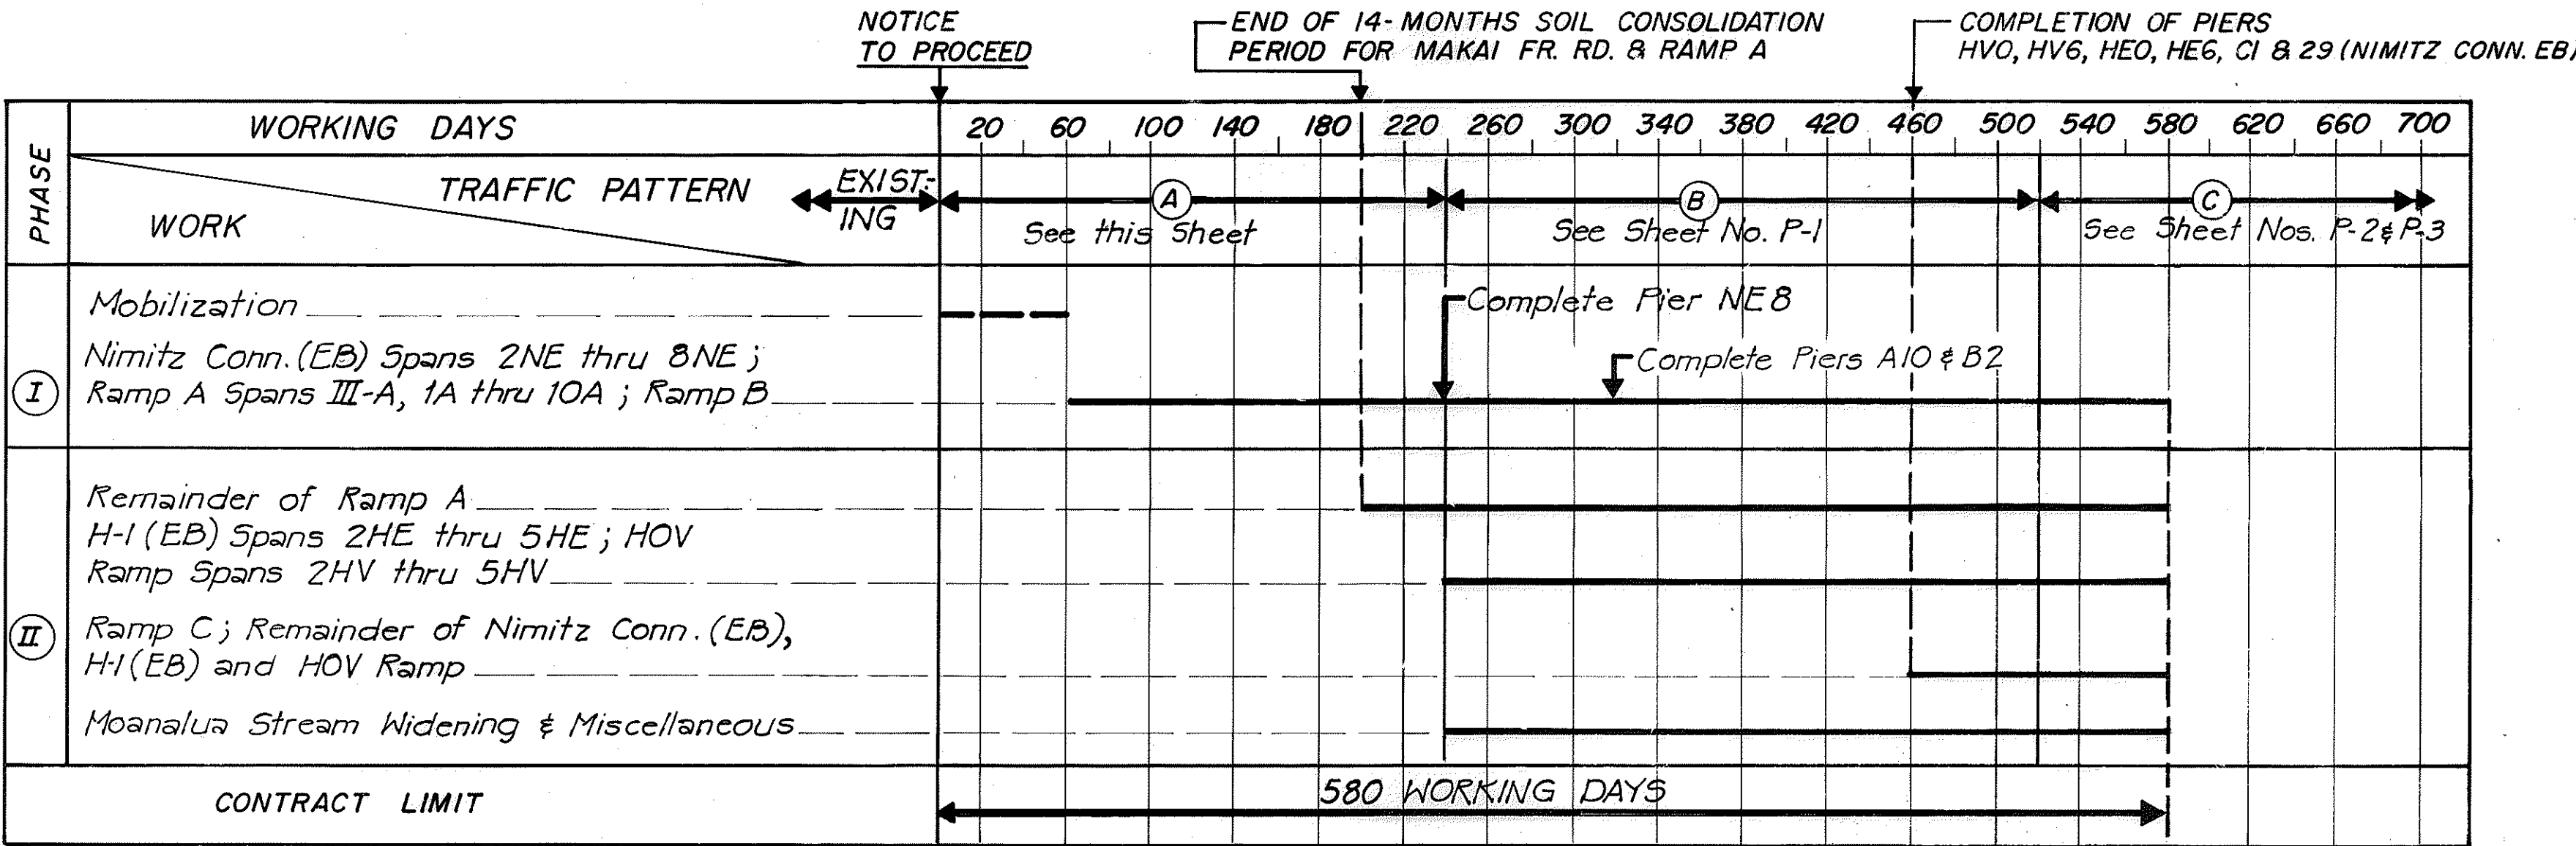

SURVEY PLOTTED BY	DATE
DRAWN BY	
NOTED BY	
CHECKED BY	
ORIGINAL PLAN	
NOTE BOOK	
NO.	

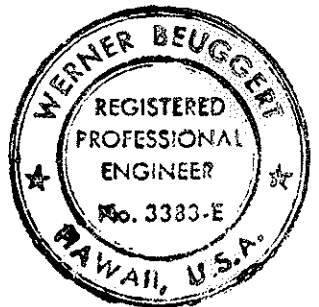

THIS WORK WAS PREPARED BY
ME OR UNDER MY SUPERVISION.

DATE	REVISION
STATE OF HAWAII DEPARTMENT OF TRANSPORTATION LAND TRANSPORTATION FACILITIES DIVISION	
CONSTRUCTION PHASING FOR THE 'GENERAL CONSTRUCTION CONTRACT' OF PROJECT NO. I-HI-1(168):17	
SCALE: 1" = 100' DATE: 8/17/81	
SHEET No. CP-1 OF 1 SHEETS	