



FED. ROAD DIST. NO.	STATE	FED. AID PROJ. NO.	FISCAL YEAR	SHEET NO.	TOTAL SHEETS
HAWAII	HAW.	I-HI-(175):16	1983	11	191

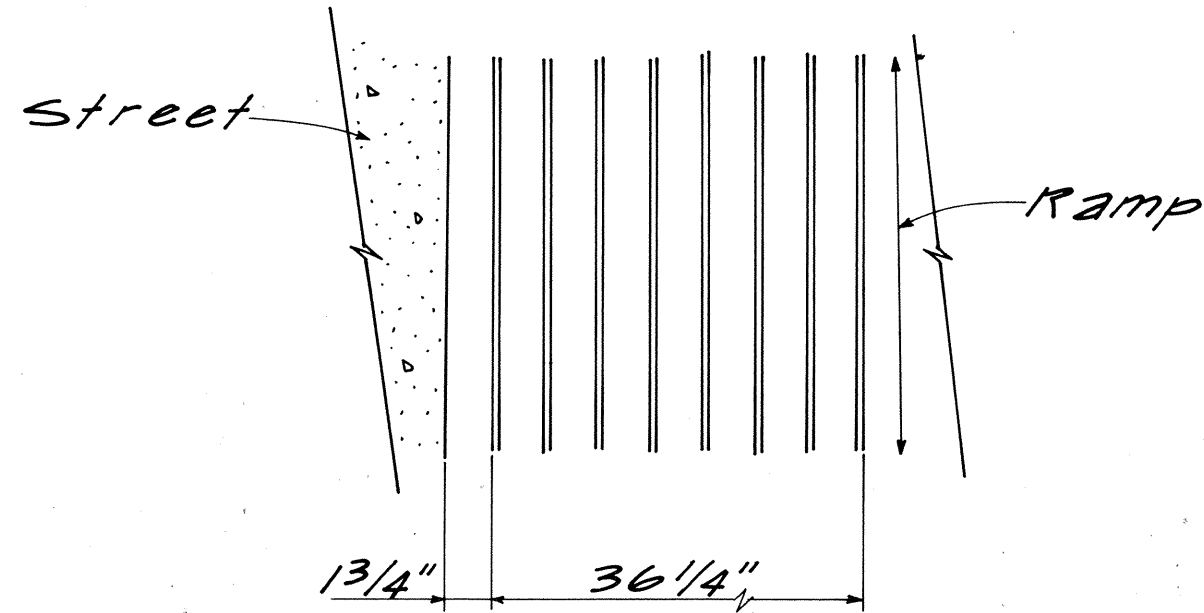


PLAN

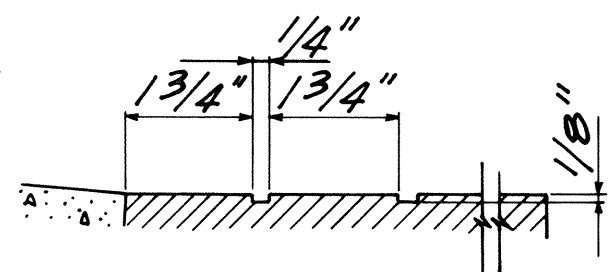


ELEVATION


GROOVE TACTILE WARNING SIGNAL
(Concrete Walks)

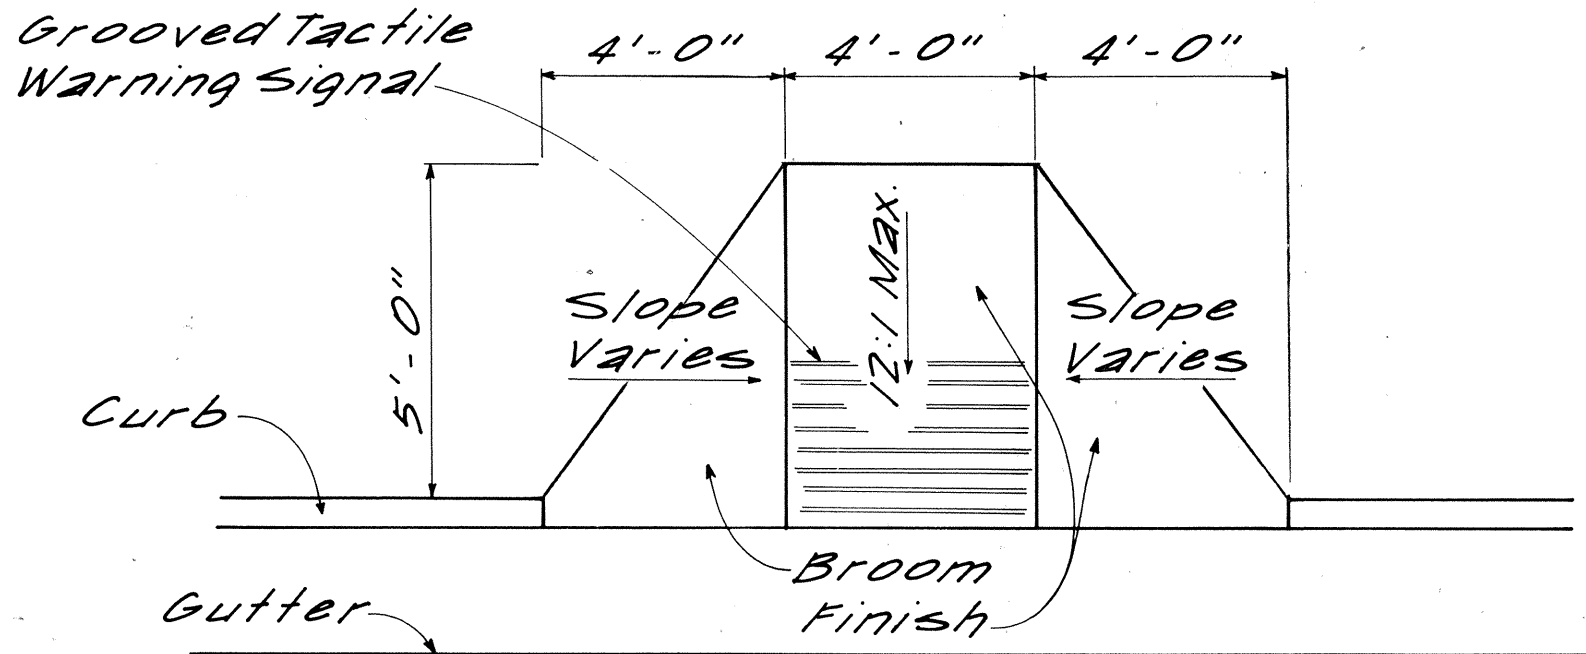

PLAN

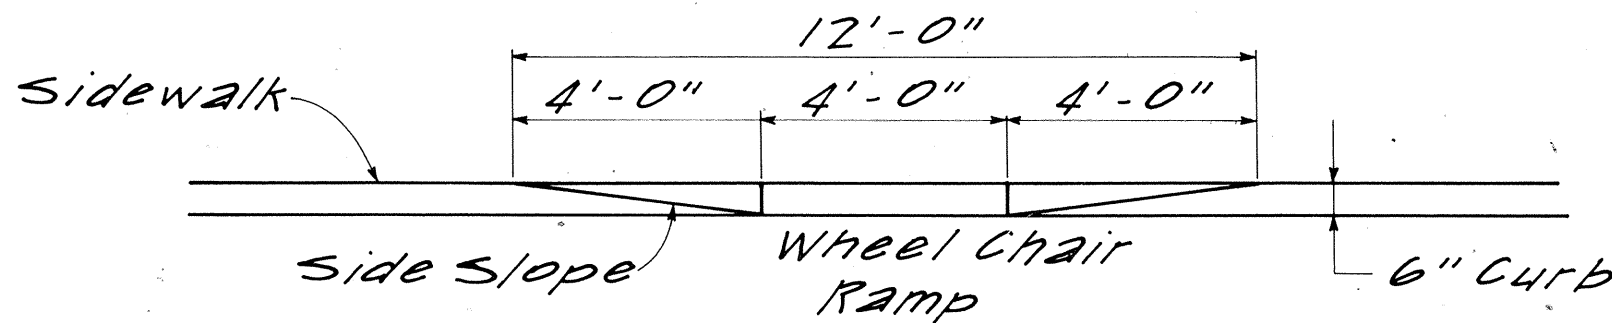



ELEVATION

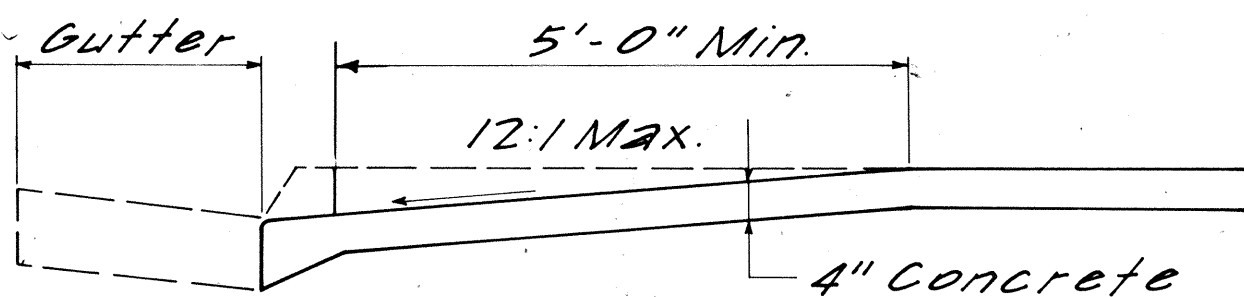


TYPICAL SECTION

WHEEL CHAIR RAMP -

Use when ideal conditions exist

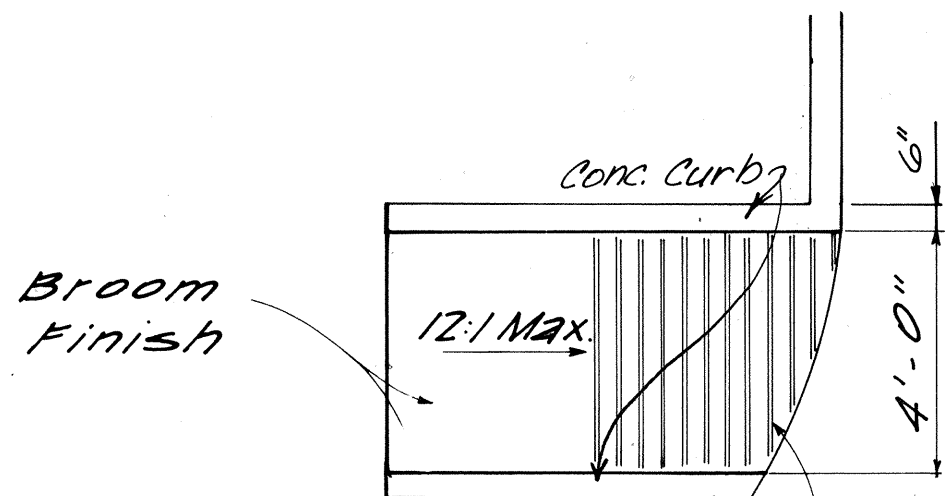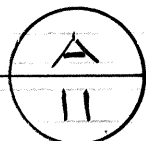

WHEEL CHAIR RAMP -

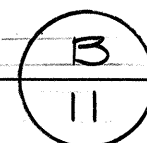


Grooved Tactile
Warning Signal
(Concrete Walks)

NOTE: Payment for wheel chair ramps is
included in Pay Item No. 608.0200
4-Inch Plain Concrete Sidewalk.

CURB, GUTTER & SIDEWALK SCHEDULES

SHEET NO.	STATION TO STATION	609.2010	609.2020	609.2170	609.2710	609.2715	609.6000	608.0200	608.2000	608.6000	
		CURB, TYPE 2A	CURB, TYPE 2D	GUTTER, TYPE 2G	CURB & GUTTER TYPE 2 AG	CURB & GUTTER TYPE 2 AGM	CURB, TYPE G	4-INCH PLAIN CONCRETE SIDEWALK	BITUMINOUS SIDEWALK	BED COURSE MATERIAL FOR SIDEWALK	
LF	LF	LF	LF	LF	LF	LF	6Q.YD	TON	CU.YD		
7	B'A' STA 2+98.10 TO B'L' STA 3+85±	105									
	B'A' STA 3+59.14 TO 6+92.03	451									
	B'A' STA 3+95.84 TO 6+55.25	378									
	B'A' STA 2+98.1 LT			15±							
	B'A' STA 3+59.14 TO 3+95.84			37							
	B'A' STA 6+55.25 TO 6+92.03			37							
	B'A' STA 3+00.7 TO 3+59.14				59						
	B'A' STA 3+95.84 TO 6+55.25				260						
	B'A' STA 6+92.03 TO 8+41.10				150						
	B'A' STA 3+20 TO B'L' STA 3+62±							63		7	
	B'A' STA 3+00 TO 6+67 - 60' RT						411				
	B'A' STA 6+85 - 55' RT TO 7+00						50				
8	B'L' STA 8+57-32' RT TO 9+90.85-20' RT	134									
	B'L' STA 8+98 TO 9+40	42									
	B'L' STA 10+06.53 TO AOLELE ST.	130									
	B'L' STA 8+98 TO 9+40			92							
	B'L' STA 9+40 TO AOLELE ST.				214						
	B'A' STA 8+41.10 TO 8+82.74-31.2 LT						54				
	B'L' STA 10+06.53 - 20' RT						9				
	B'A' STA 8+98.74 TO 9+77						129				
	B'A' STA 7+00 20' RT TO 9+71.05						271				
	B'A' STA 9+71.05 TO END RT.						54				
	ROAD 'B'						110				
	B'L' 8+57 TO 9+90.85							106		12	
	B'A' 8+98 - 26' LT TO ROAD 'B'								13	12	
	R-ED & R-WD-GORE PAVEMENT							89		10	
	R-WD B STA 67+63 TO AOLELE					78					
9	RODGER BLVD. I.B. STA 11+25		456					146		16	
	TOTALS	1240	456	181	683	78	1088	404	13	57	

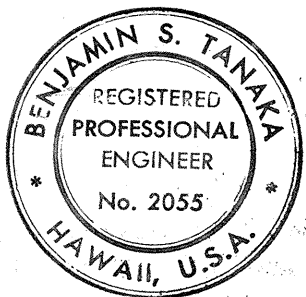

Benjamin S. Tanaka
THIS WORK WAS PREPARED BY ME
OR UNDER MY SUPERVISION.

STATE OF HAWAII
DEPARTMENT OF TRANSPORTATION
HIGHWAYS DIVISION

ROAD DETAILS
& SCHEDULES

AIRPORT INTERCHANGE
F.A.I. PROJECT NO. I-HI-(175):16

SCALE: NO SCALE

DATE: SEPT, 1982

SHEET No. OF SHEETS

ORIGINAL PLAN	DATE
DESIGNED BY	
NOTED BY	
CHECKED BY	
NO.	