




FED. ROAD DIST. NO.	STATE	FED. AID PROJ. NO.	FISCAL YEAR	SHEET NO.	TOTAL SHEETS
HAWAII	HAW.	I-HI-1(175)16	1983	4	191

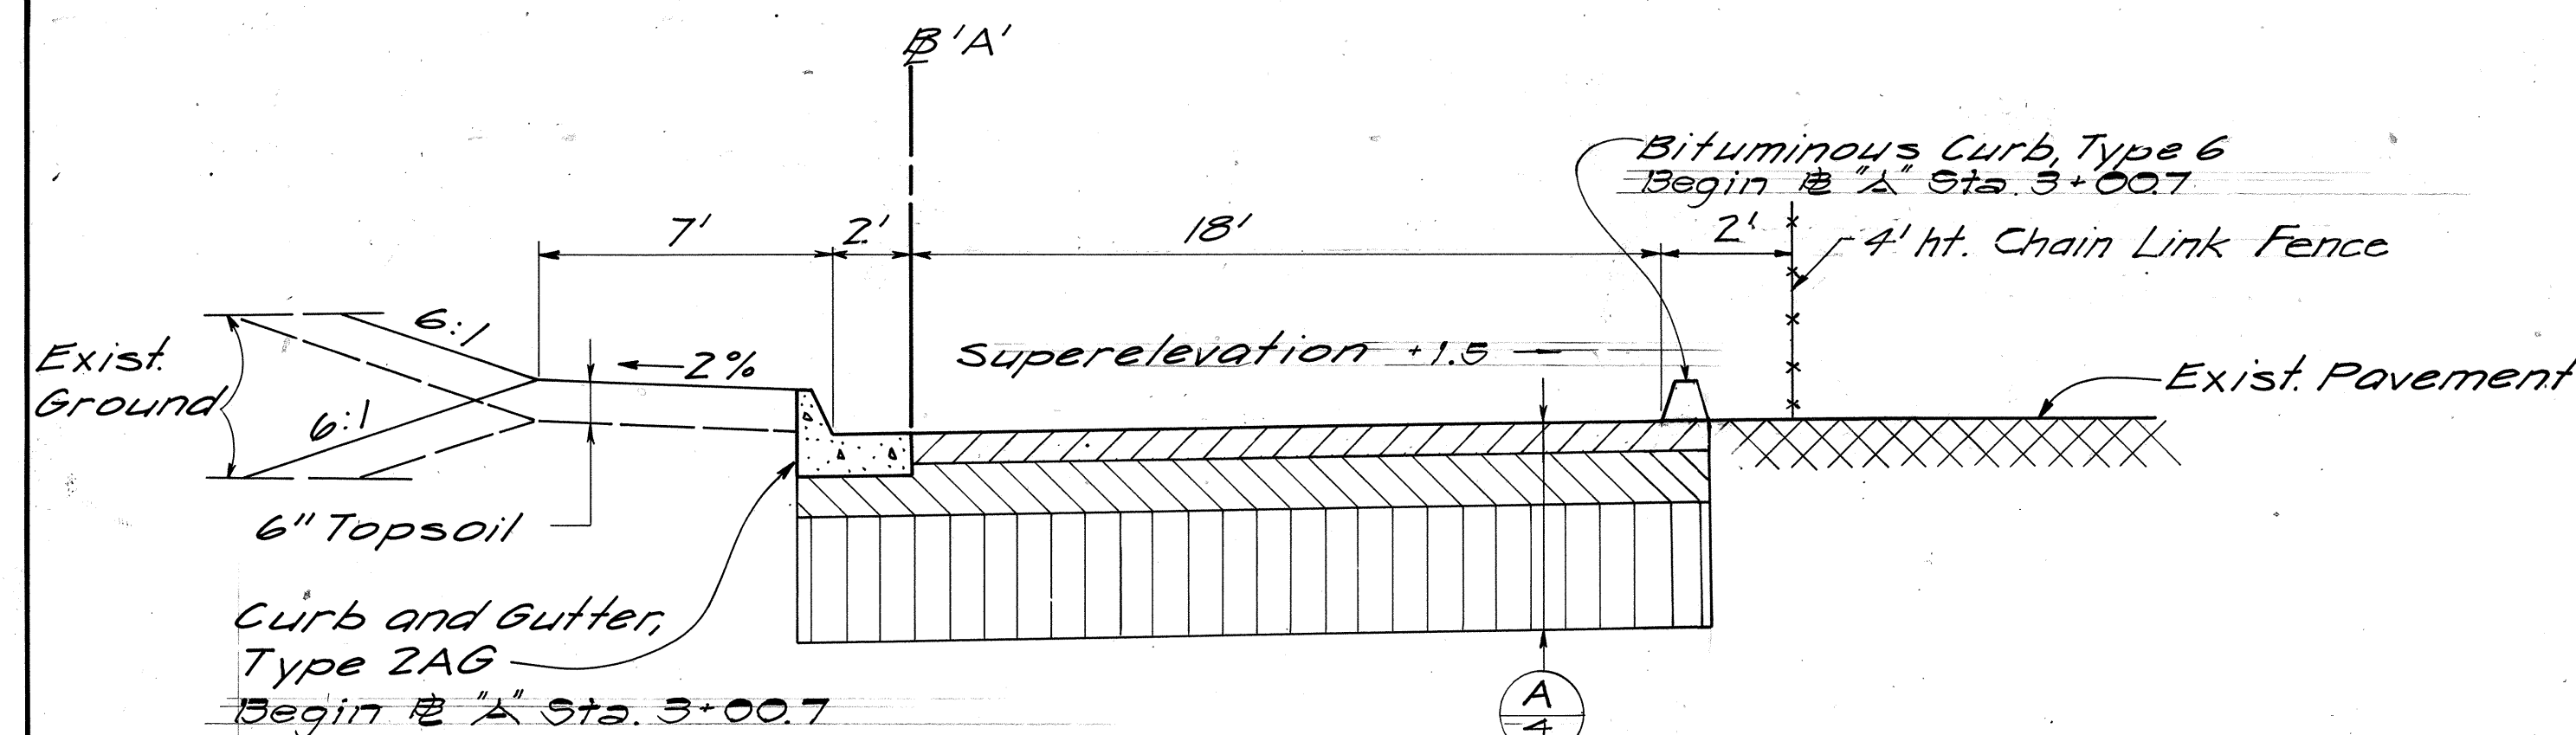


TYPICAL SECTION - AIRPORT RD 'A'
Sta. 4+00 to Sta. 9+00

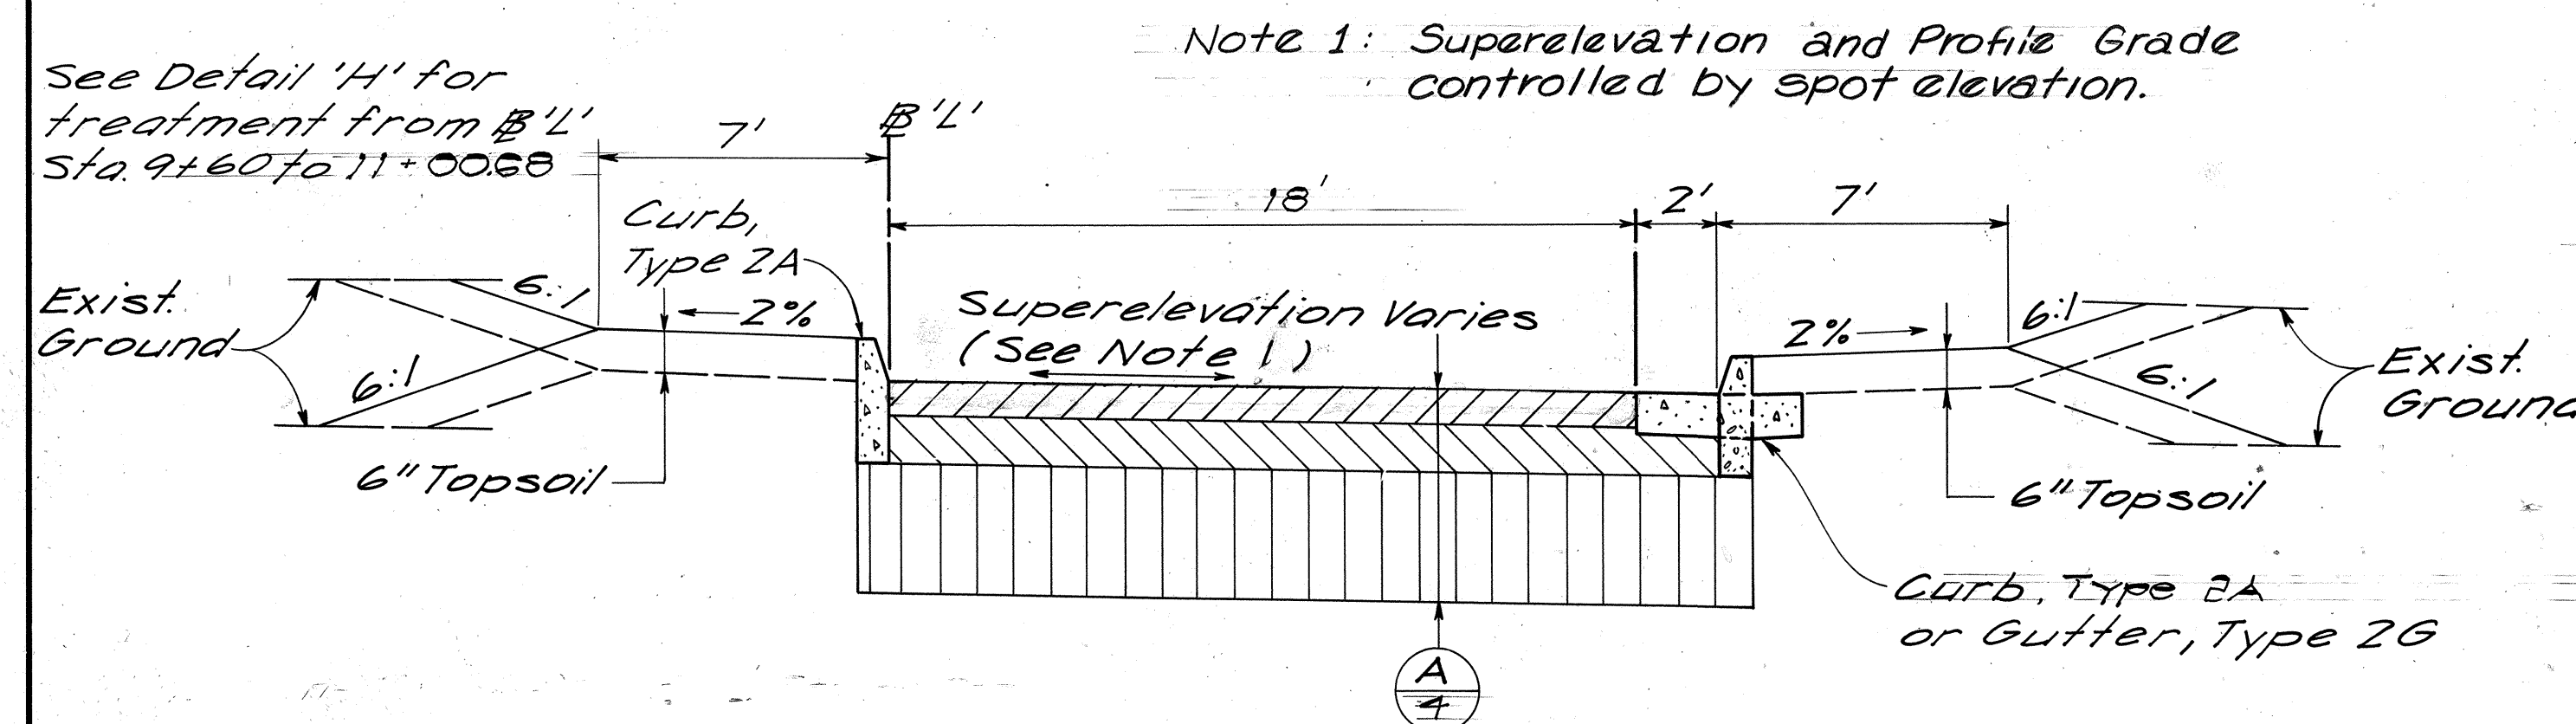


TYPICAL SECTION - AIRPORT ROAD 'L'
Sta. 9+18 to 11+00.68 (See Detail 'E' for Special Treatment of Pavement Section for Sta. 9+75 to Sta. 10+16)

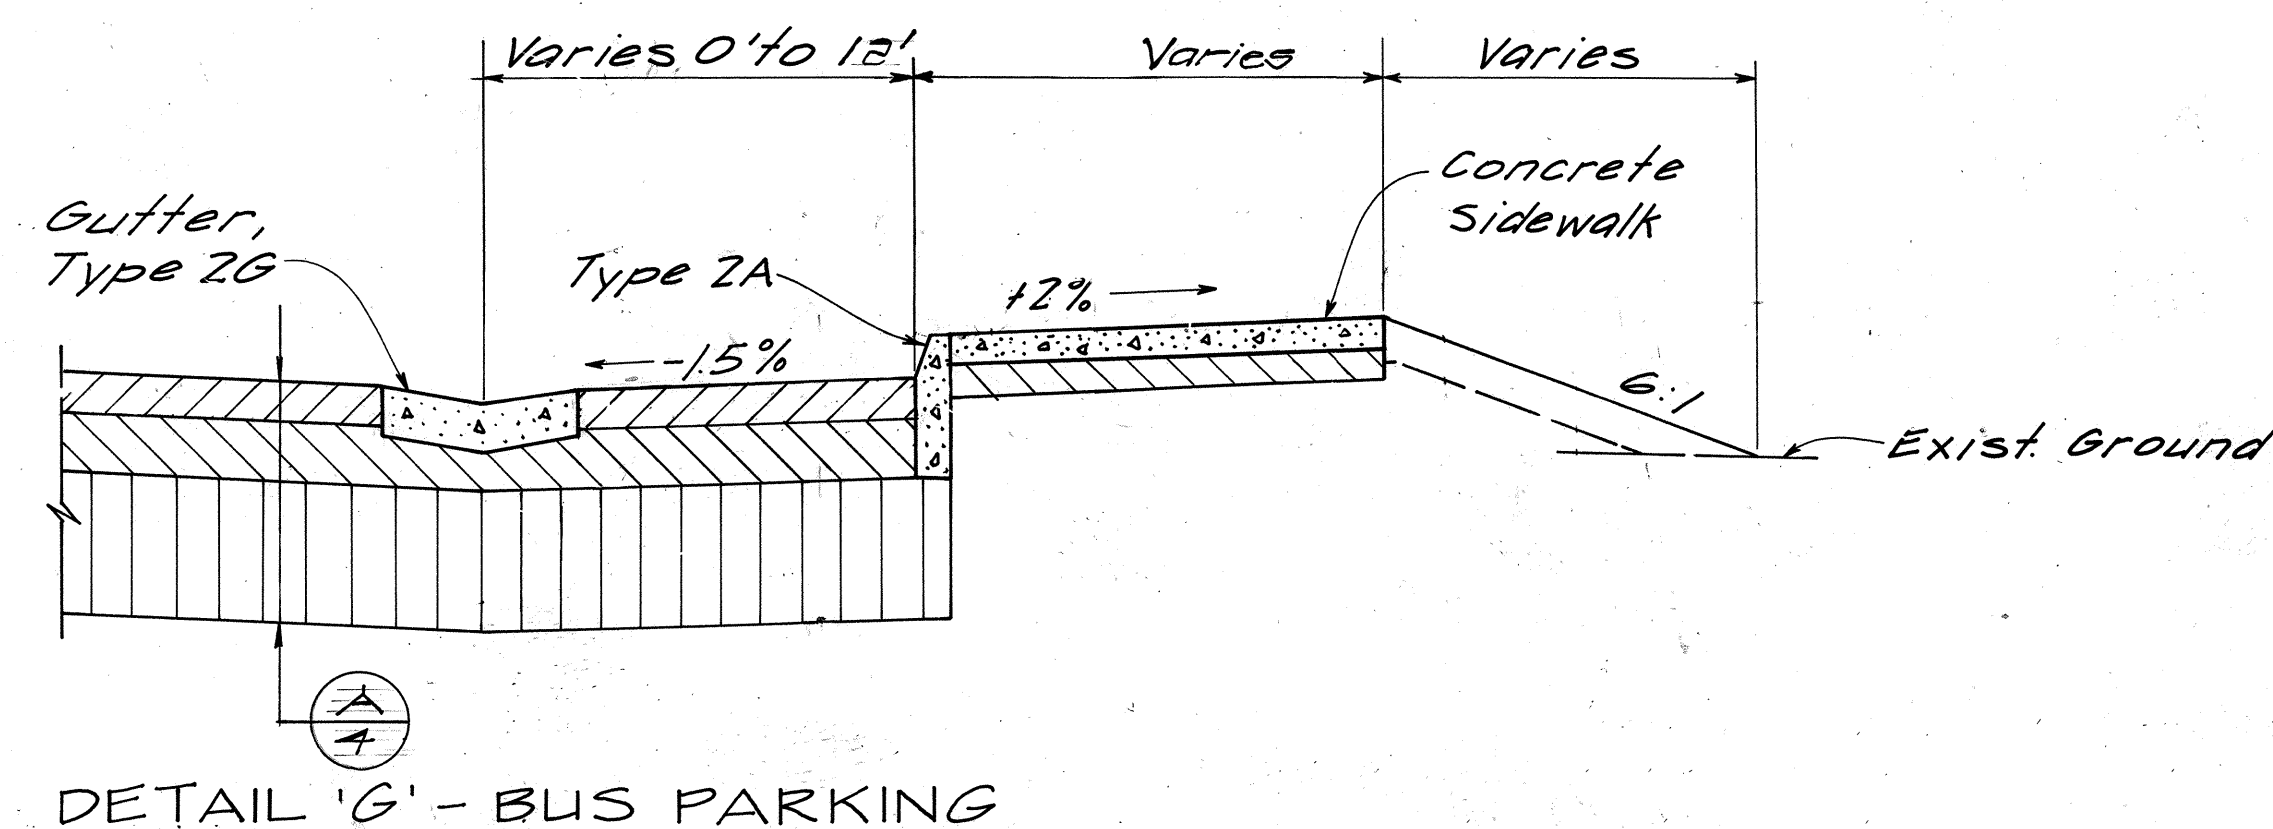


DETAIL 'G' - BUS PARKING
B-L' Sta. 2+80 to 3+75 & Sta. 8+57 to 9+31

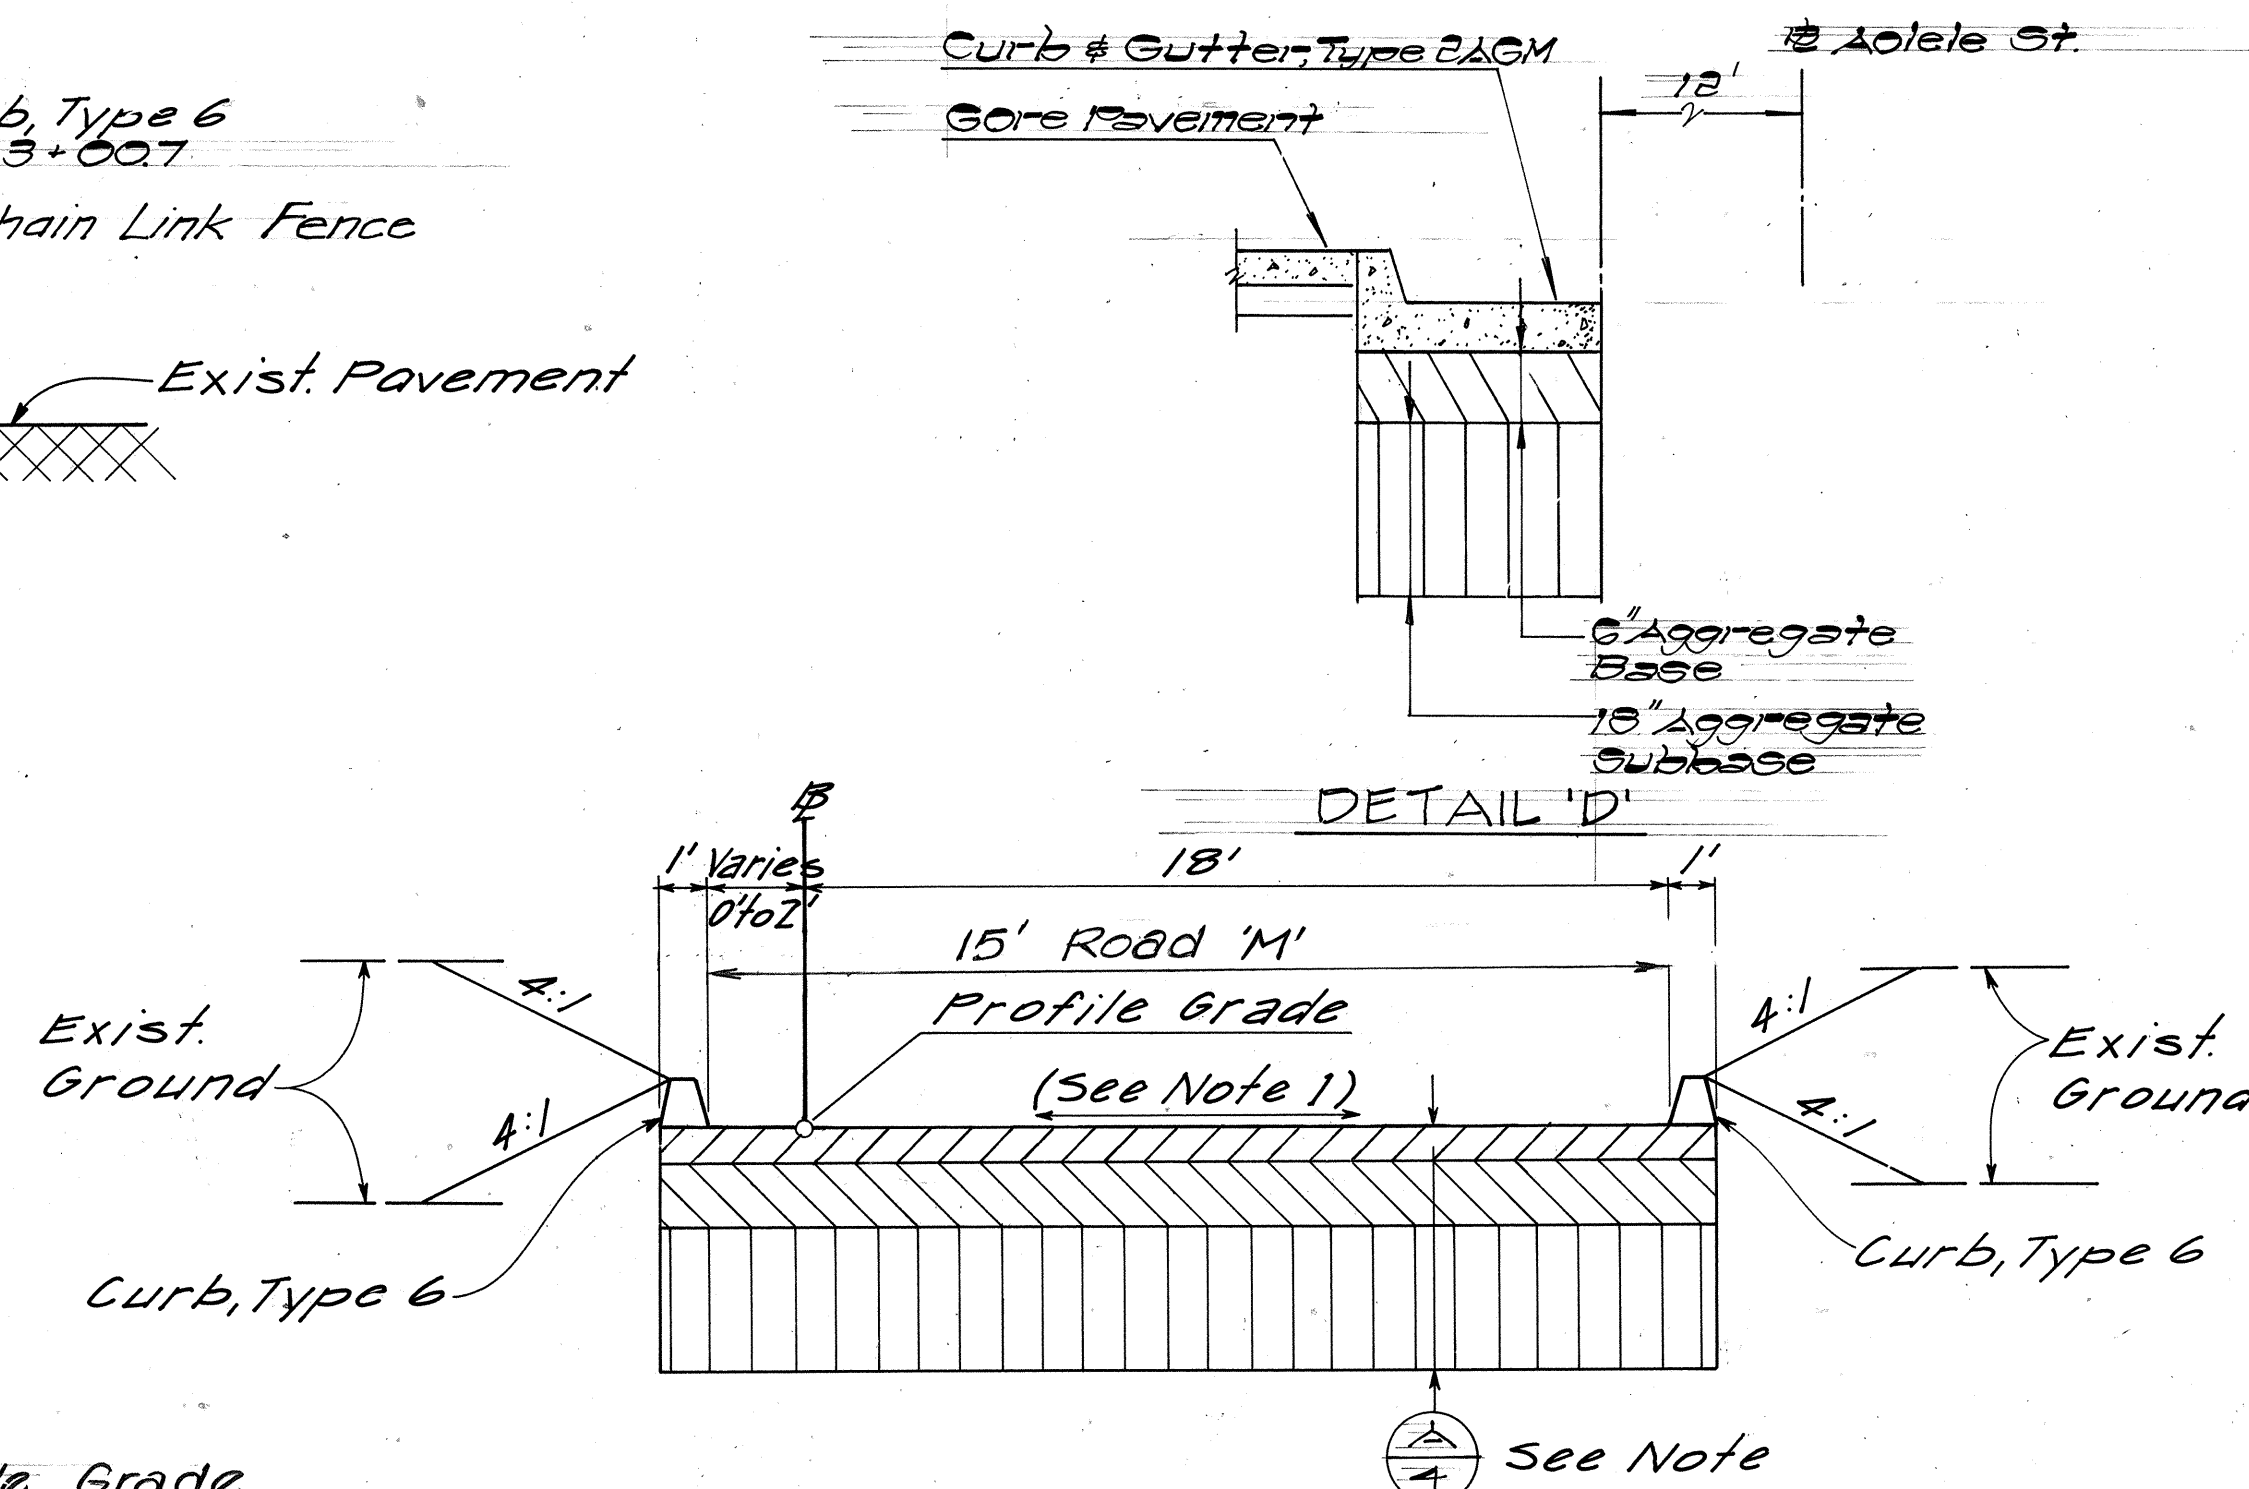


TYPICAL SECTION - AIRPORT ROAD 'A'
Sta. 9+00 to Sta. 9+80

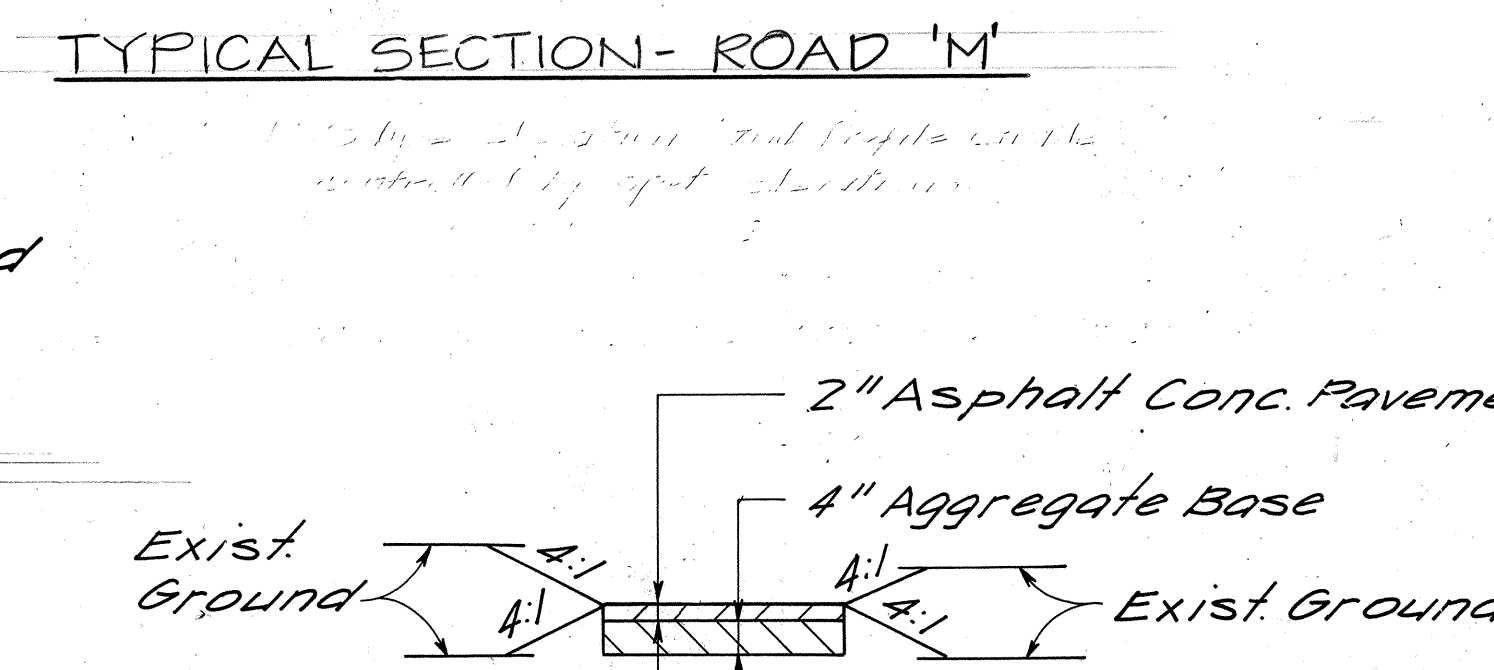


TYP. BITUMINOUS SIDEWALK SECTION

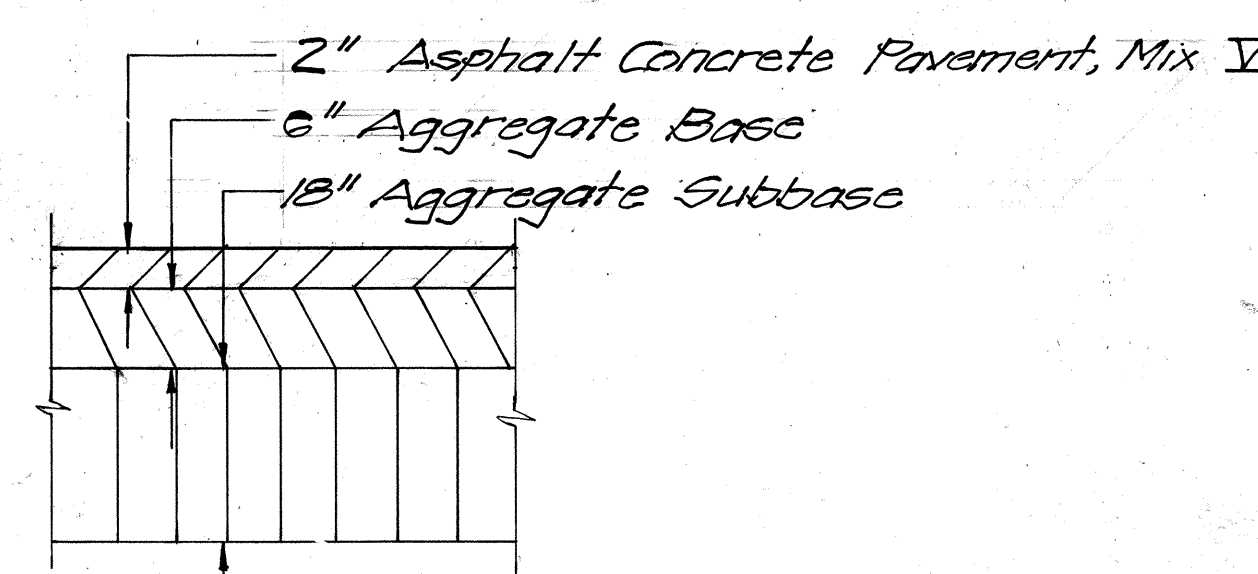


SECTION (A)

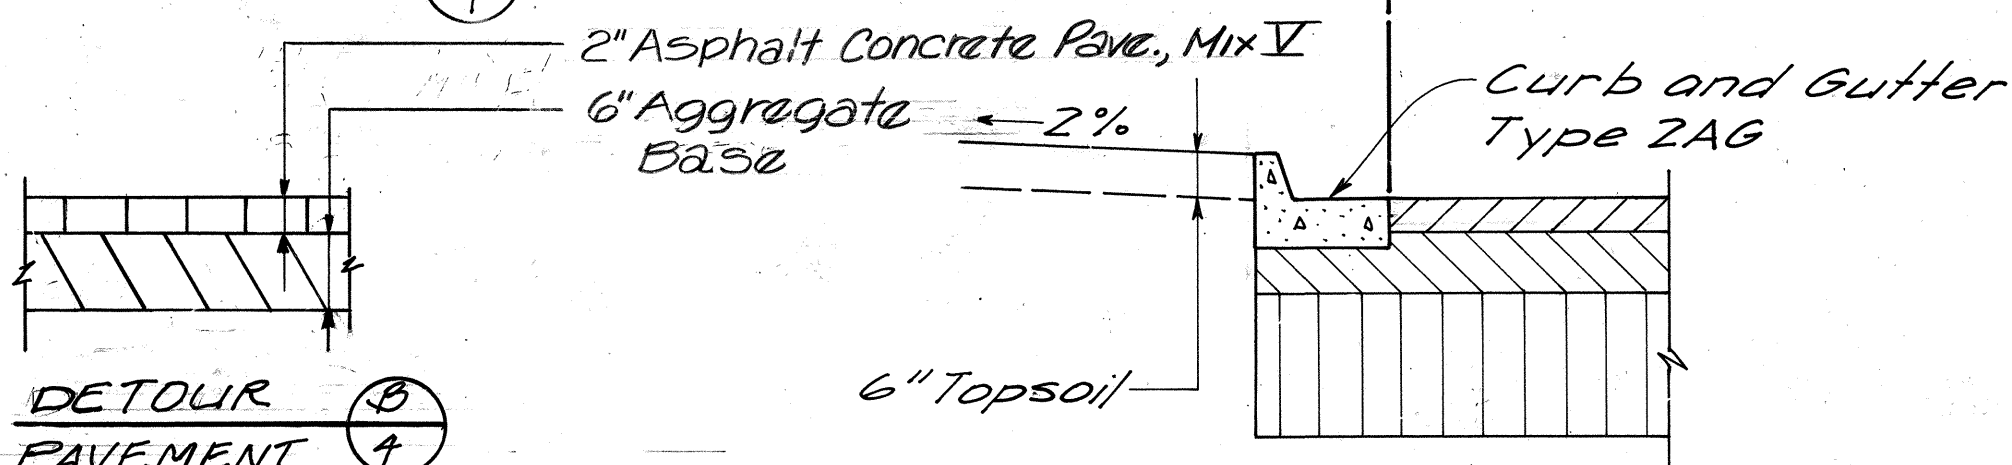

DETAIL 'H' PAVEMENT

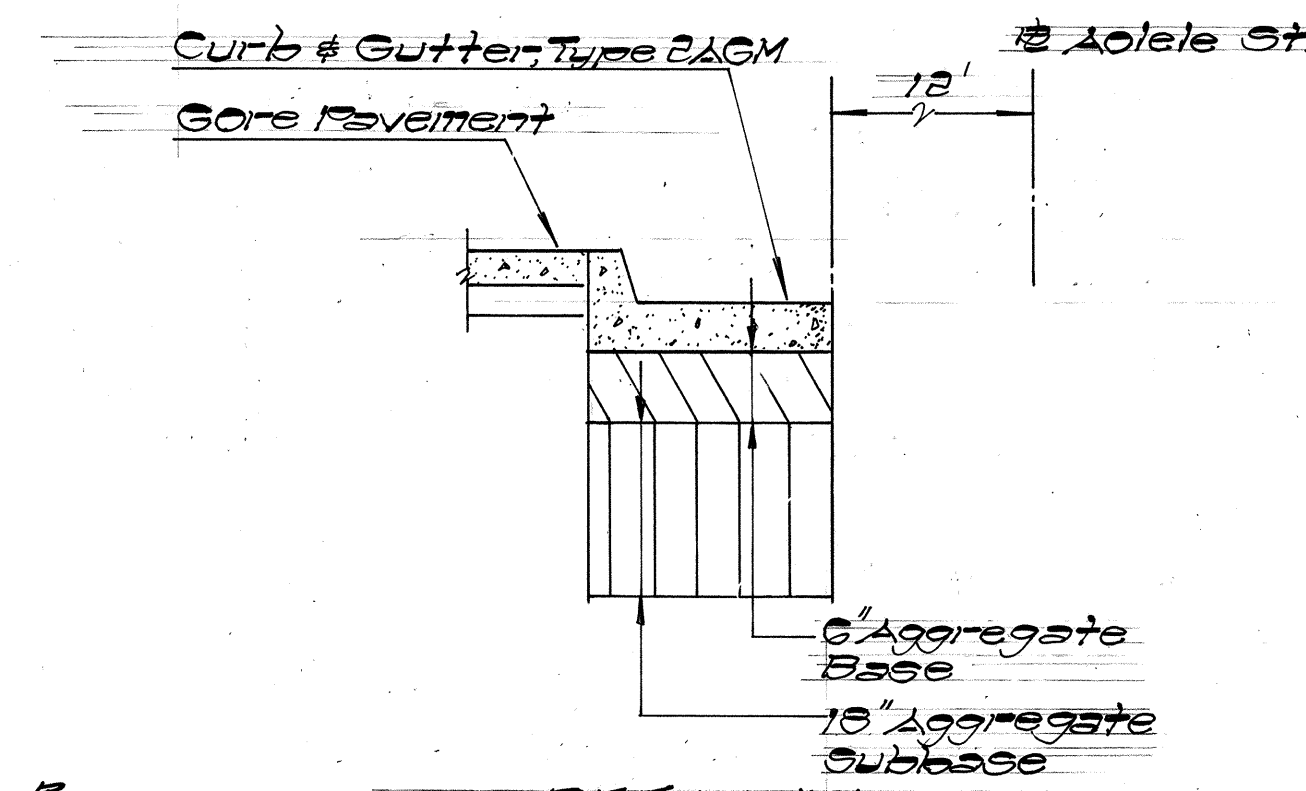


DETAIL 'D'

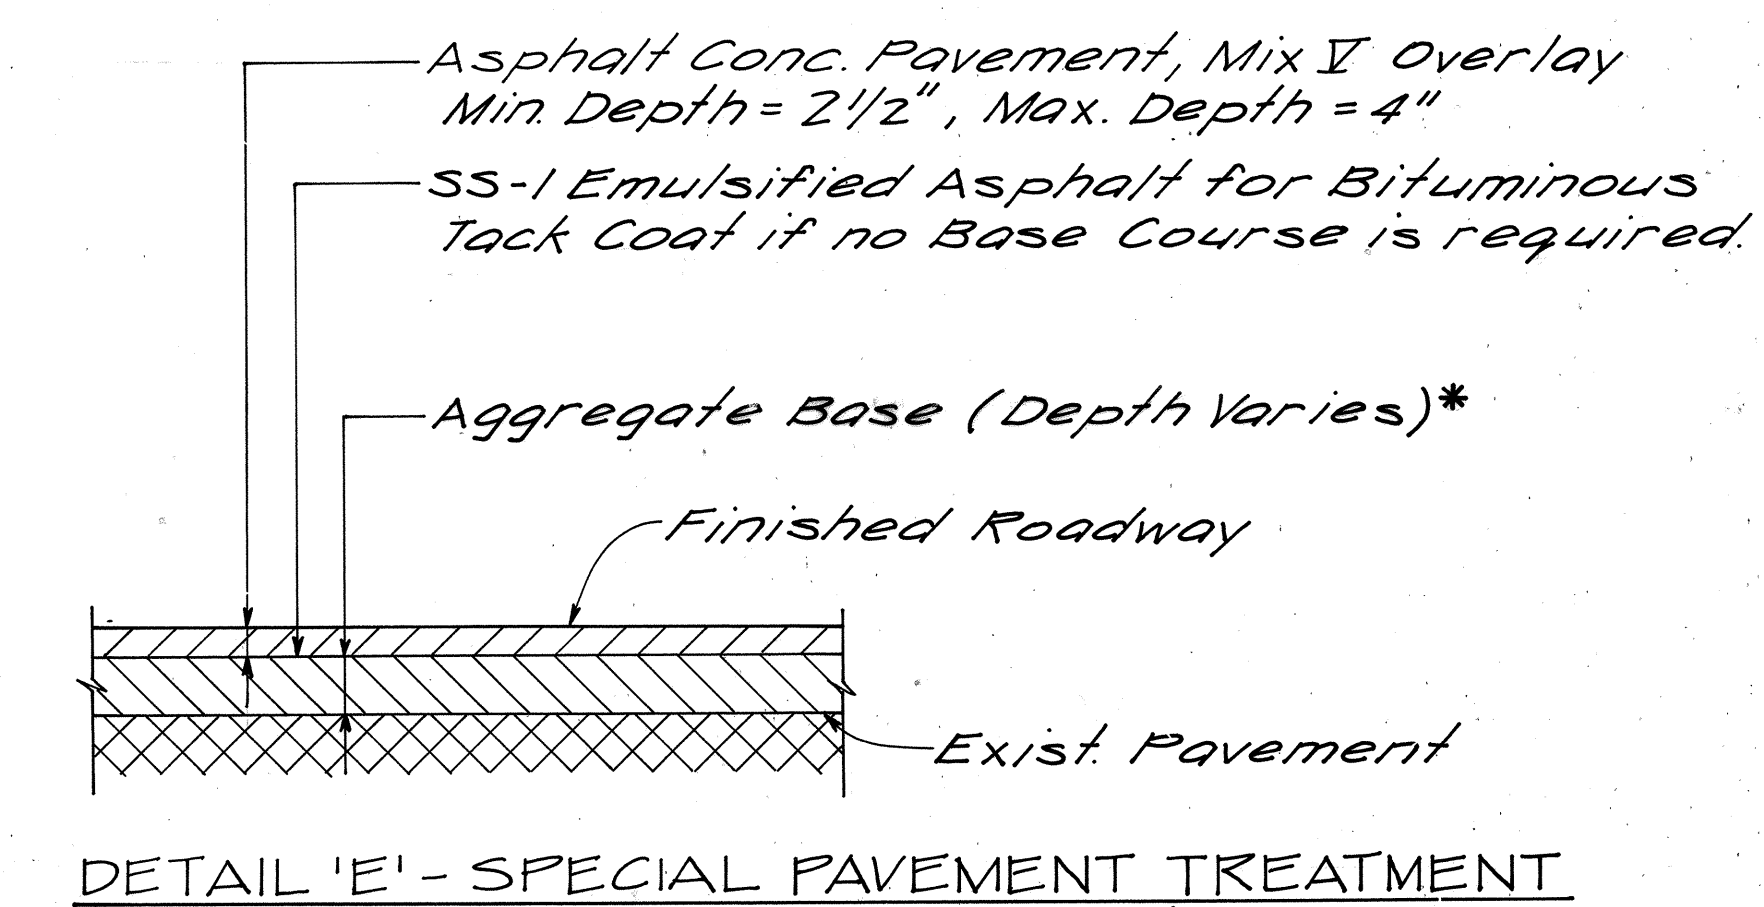


DETAIL 'E' - SPECIAL PAVEMENT TREATMENT


* Scarify Exist. Pavement before placing Aggregate Base

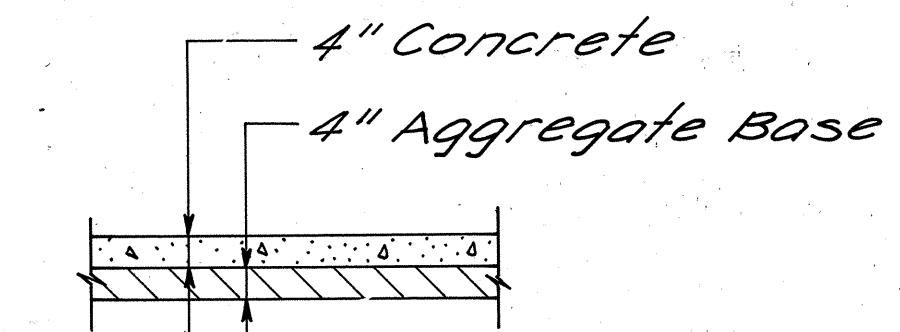

TYPICAL CONC. SIDEWALK SECTION
& GORE PAVEMENT SECTION

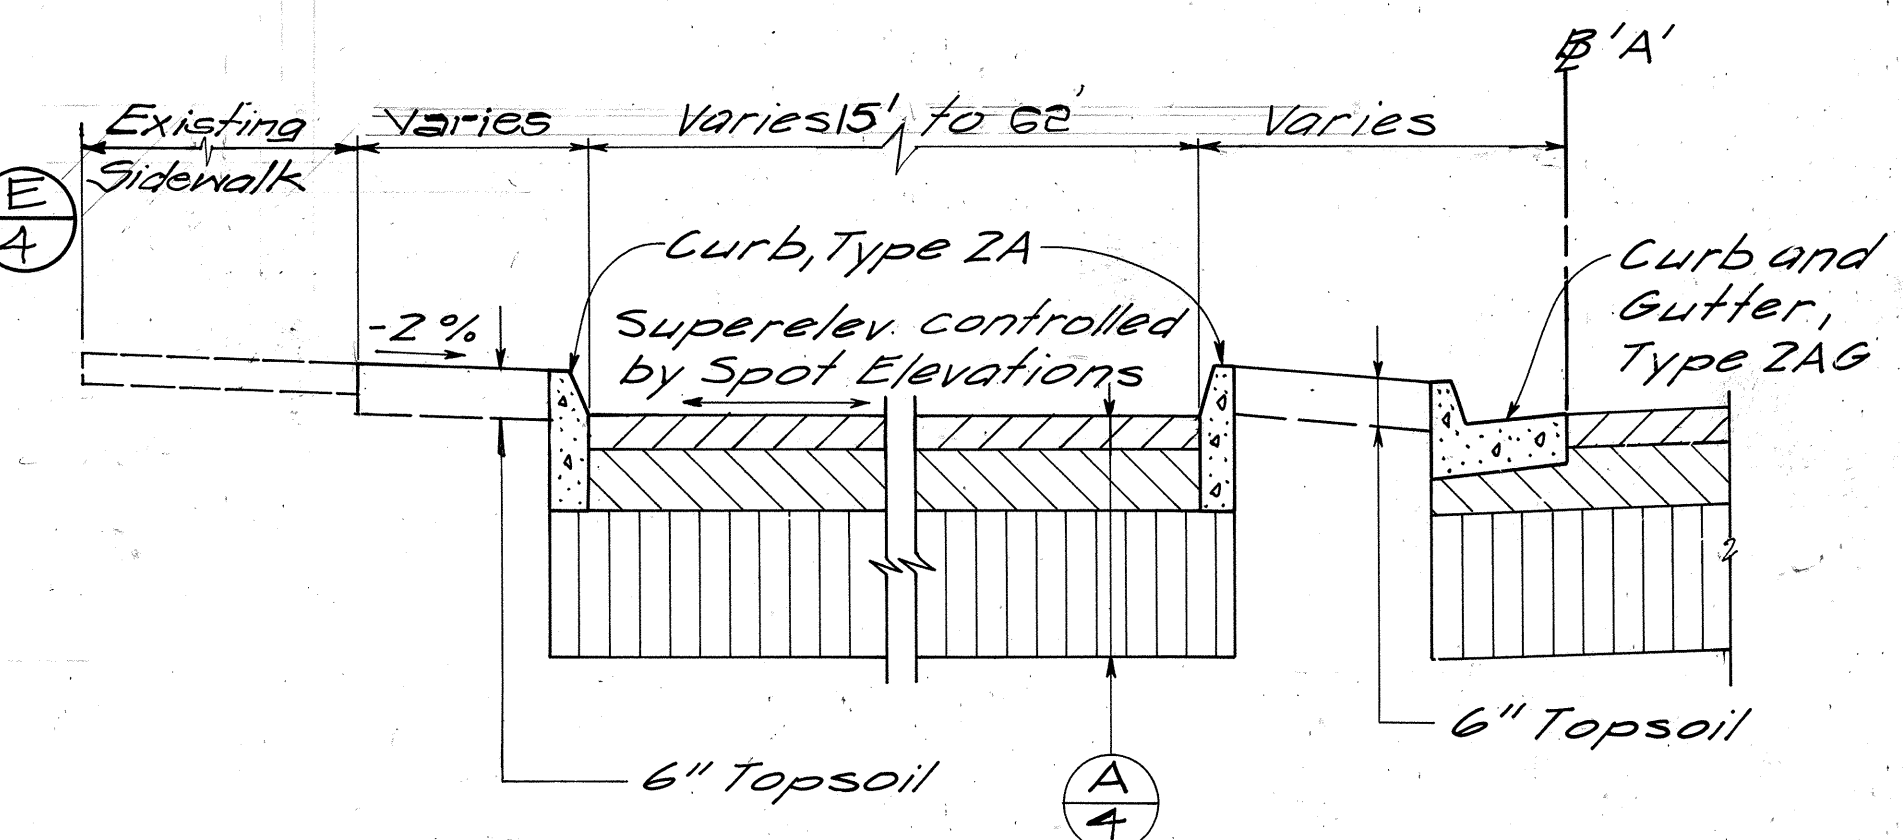

TYPICAL SECTION - LEI STAND
EMPLOYEE PARKING
(See Detail 'E' for Special Treatment of Pavement Section for R-HA Sta. 70+76.5 to Sta. 79+50)

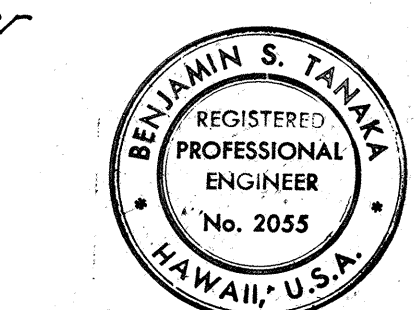

BENJAMIN S. TANAKA
REGISTERED PROFESSIONAL ENGINEER
No. 2055
HAWAII, U.S.A.
THIS WORK WAS PREPARED BY ME OR UNDER MY SUPERVISION.

STATE OF HAWAII
DEPARTMENT OF TRANSPORTATION
HIGHWAYS DIVISION

TYPICAL ROADWAY SECTIONS

AIRPORT INTERCHANGE
F.A.I. PROJECT NO. I-HI-1(175)16
SCALE: NOT TO SCALE DATE: SEPT., 1983
SHEET NO. 1 OF 1 SHEETS