


FED. ROAD DIST. NO.	STATE	FED. AID PROJ. NO.	FISCAL YEAR	SHEET NO.	TOTAL SHEETS
HAWAII	HAW.	IR-HI-1 (183)	1983	15	30

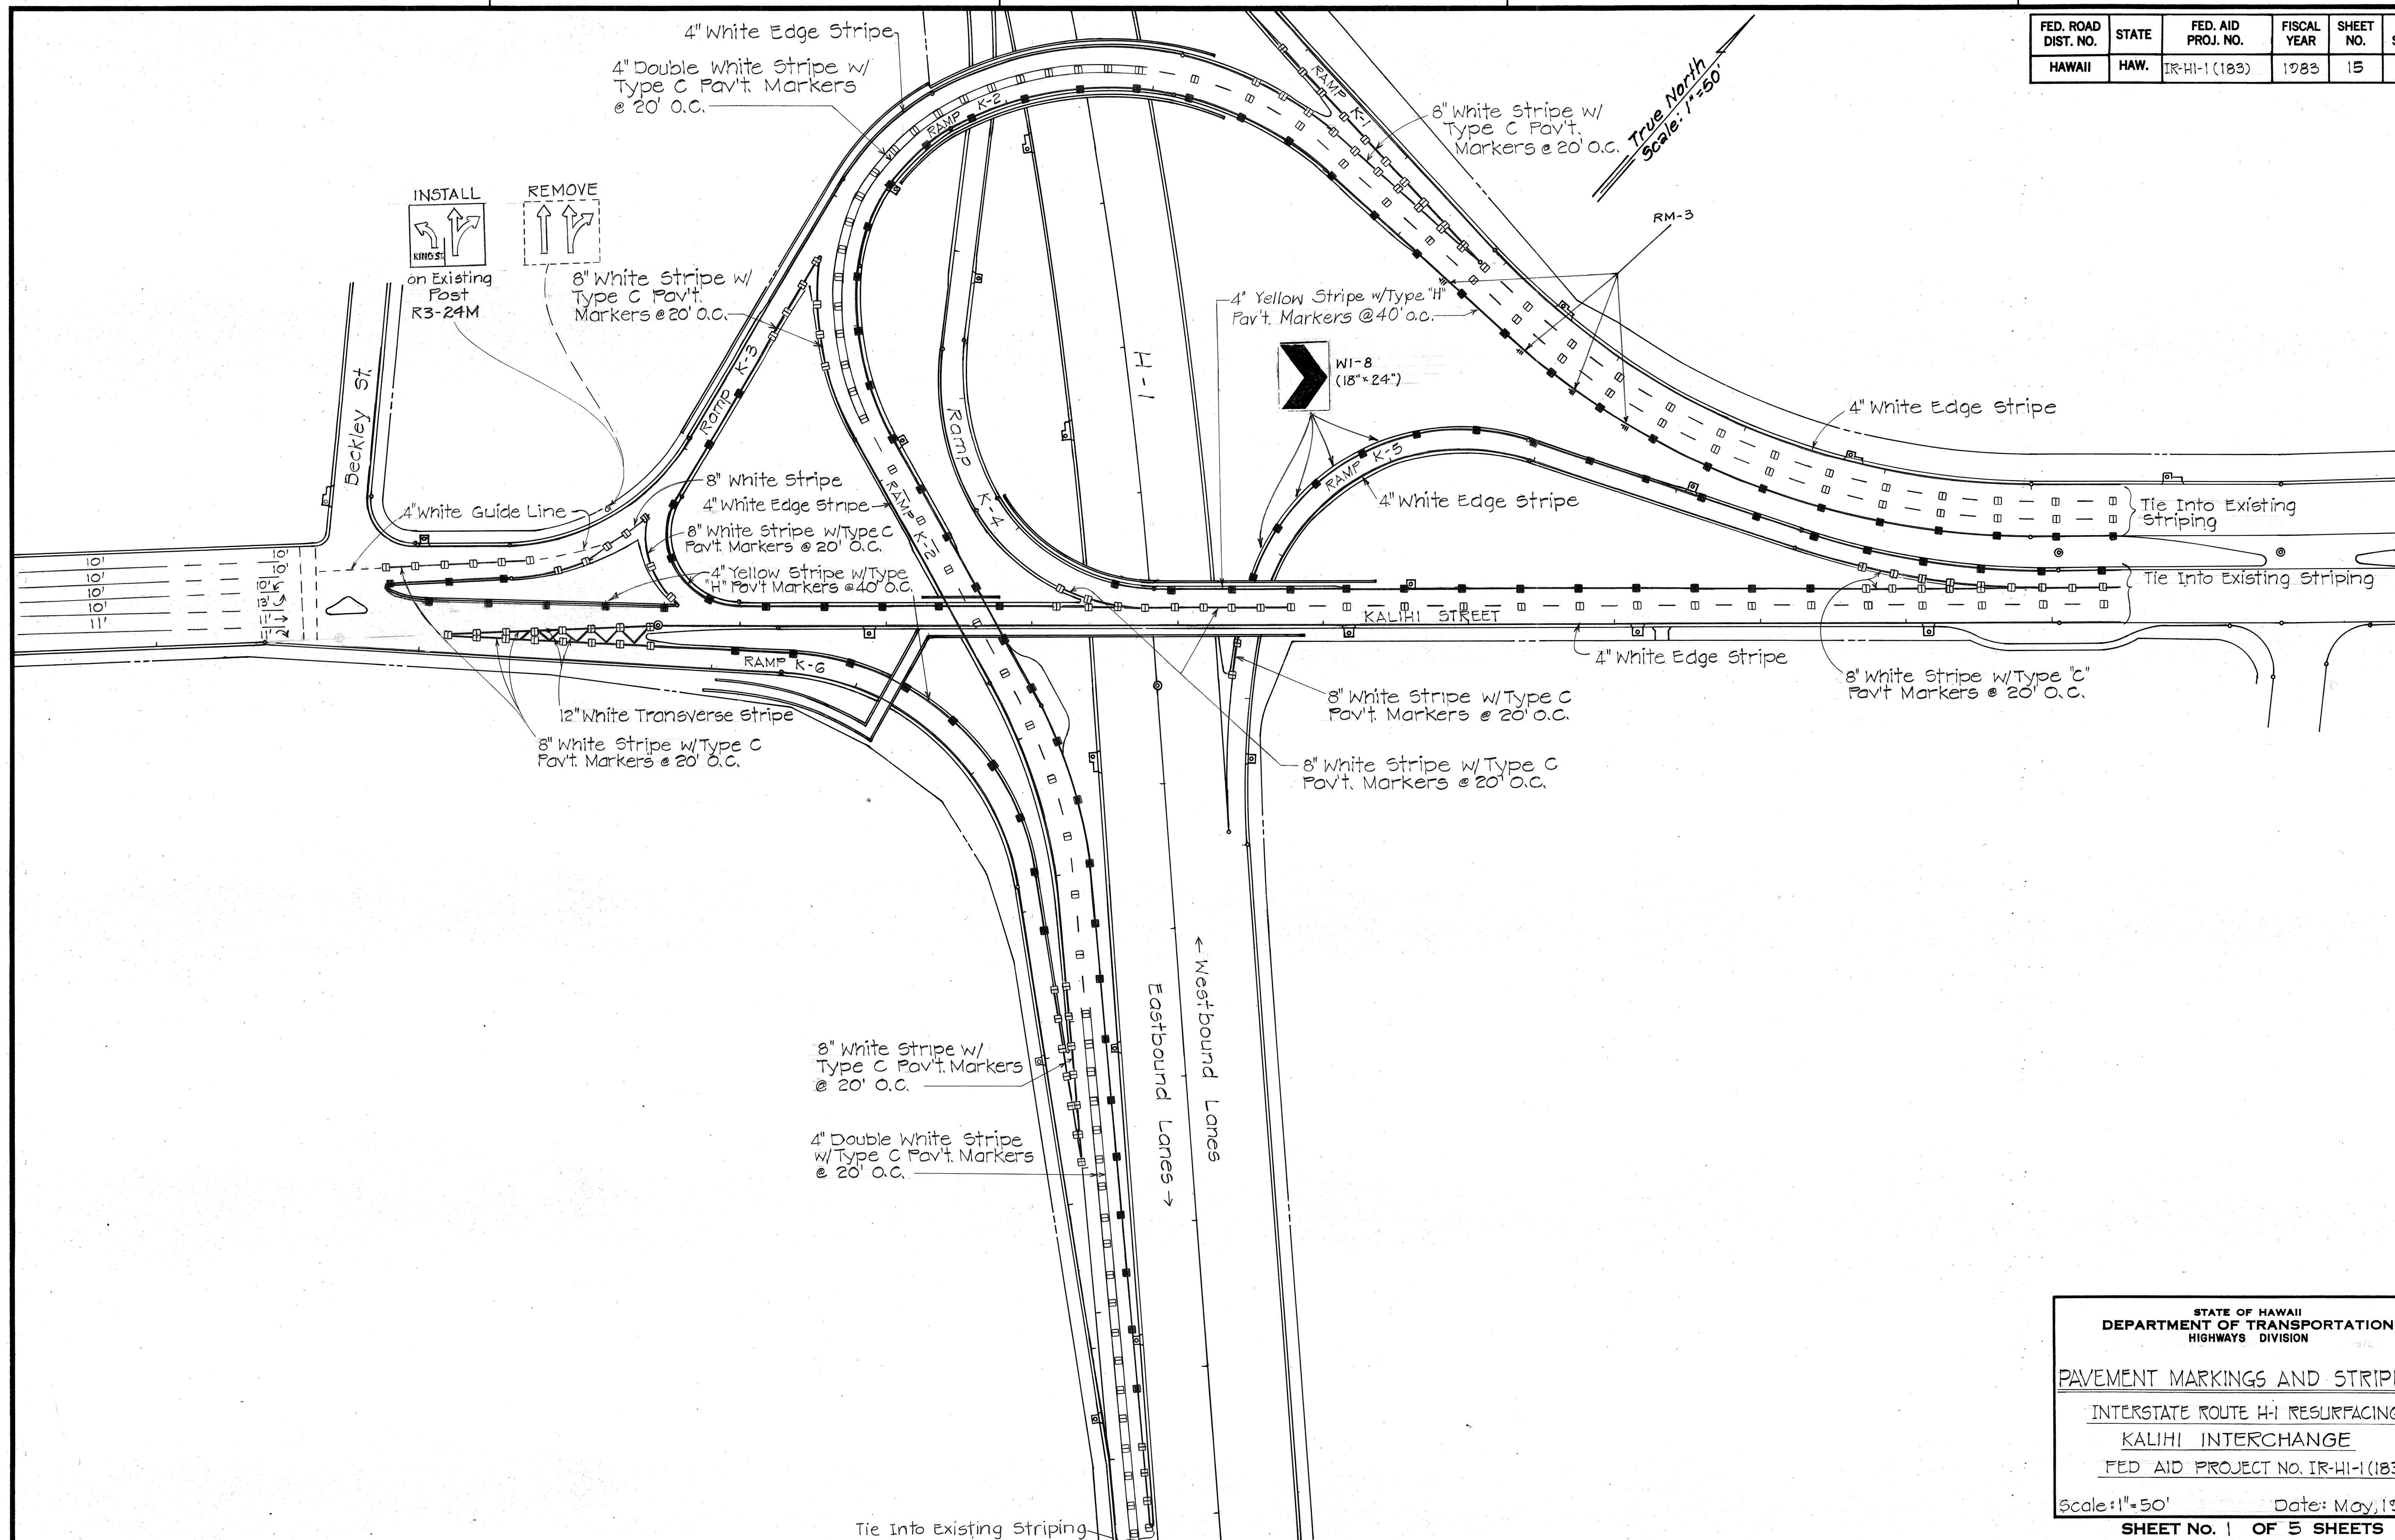

ORIGINAL PLAN	SURVEY PLOTTED BY _____	DATE _____
NOTE BOOK	DRAWN BY _____	" _____
	TRACED BY _____	" _____
	DESIGNED BY _____	" _____
	QUANTITIES BY _____	" _____
No. _____	CHECKED BY _____	" _____

STATE OF HAWAII
DEPARTMENT OF TRANSPORTATION
HIGHWAYS DIVISION

PAVEMENT MARKINGS AND STRIPING

INTERSTATE ROUTE 4-1 RESURFACING


KALIH! INTERCHANG

FED AID PROJECT NO. IR-HI-1(183

Scale: 1" = 50' Date: May, 1983

SHEET No. 1 OF 5 SHEET

FED. ROAD DIST. NO.	STATE	FED. AID PROJ. NO.	FISCAL YEAR	SHEET NO.	TOTAL SHEETS
HAWAII	HAW.	HI-1-02-83M	1983	17	30

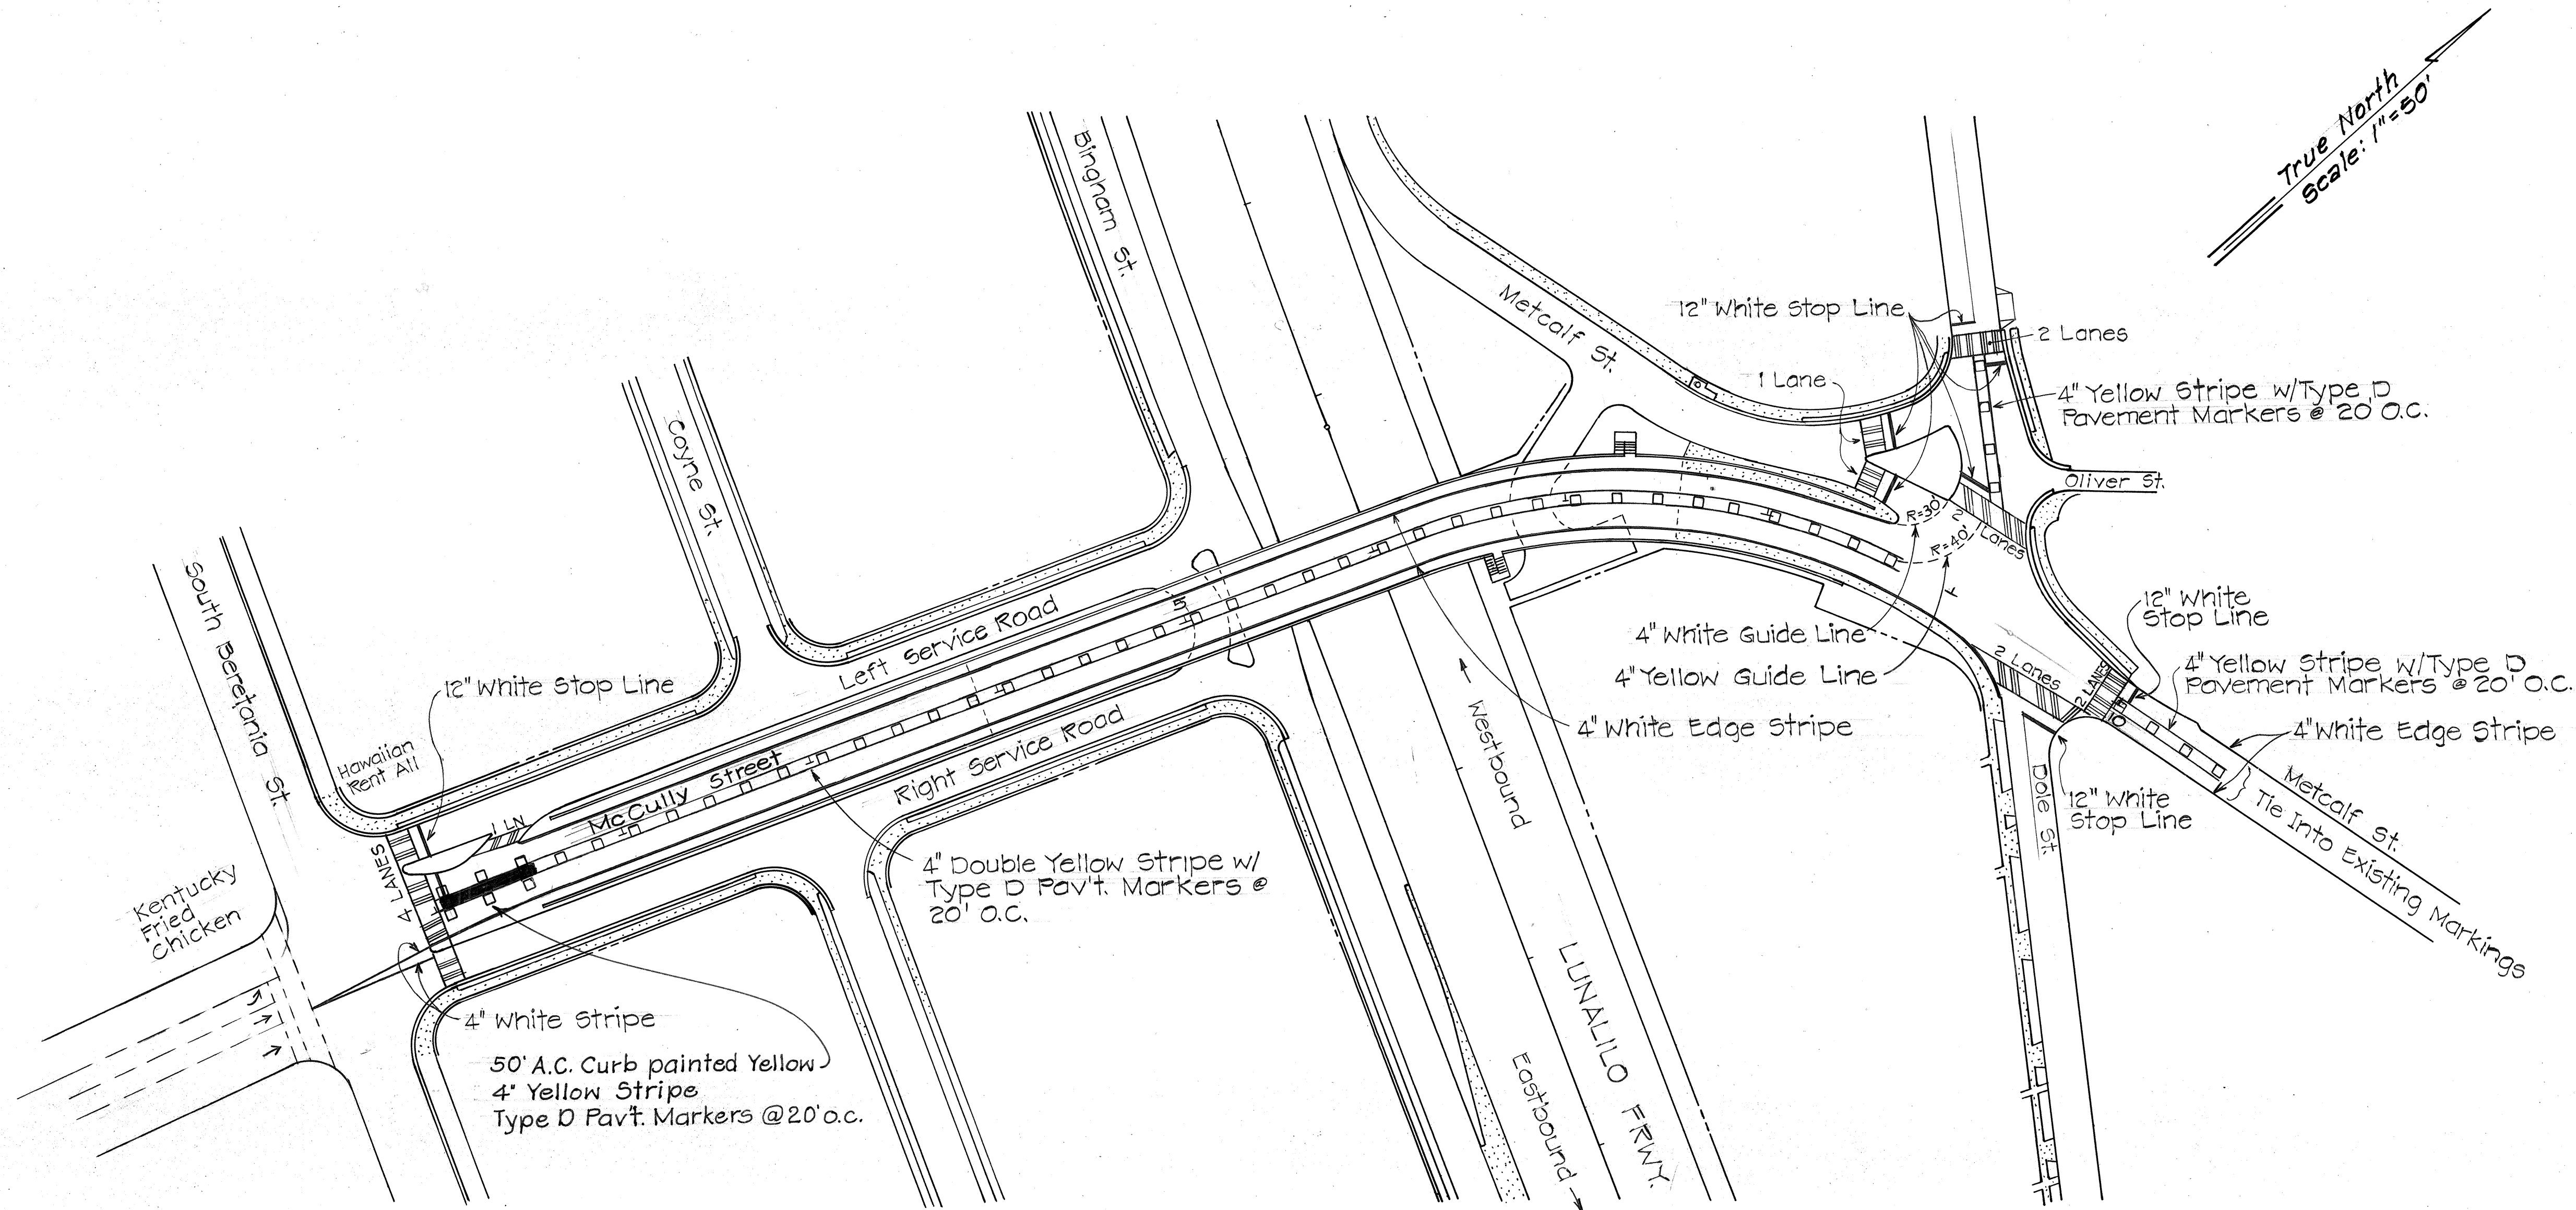

ORIGINAL PLAN	DATE
DESIGNED BY	
TRACED BY	
NOTED BY	
CHECKED BY	

STATE OF HAWAII
DEPARTMENT OF TRANSPORTATION
HIGHWAYS DIVISION

PAYEMENT MARKING AND STRIPING

INTERSTATE ROUTE H-1 RESURFACING

McCULLY ST. OVERPASS


PROJECT NO. HI-1-02-83M

Scale: 1"=50' Date: April, 1983

SHEET NO. 3 OF 5 SHEETS

FED. ROAD DIST. NO.	STATE	FED. AID PROJ. NO.	FISCAL YEAR	SHEET NO.	TOTAL SHEETS
HAWAII	HAW.	HI-I-02-83M	1983	00175-1	

TRUE NORTH
SCALE: 1"=40'

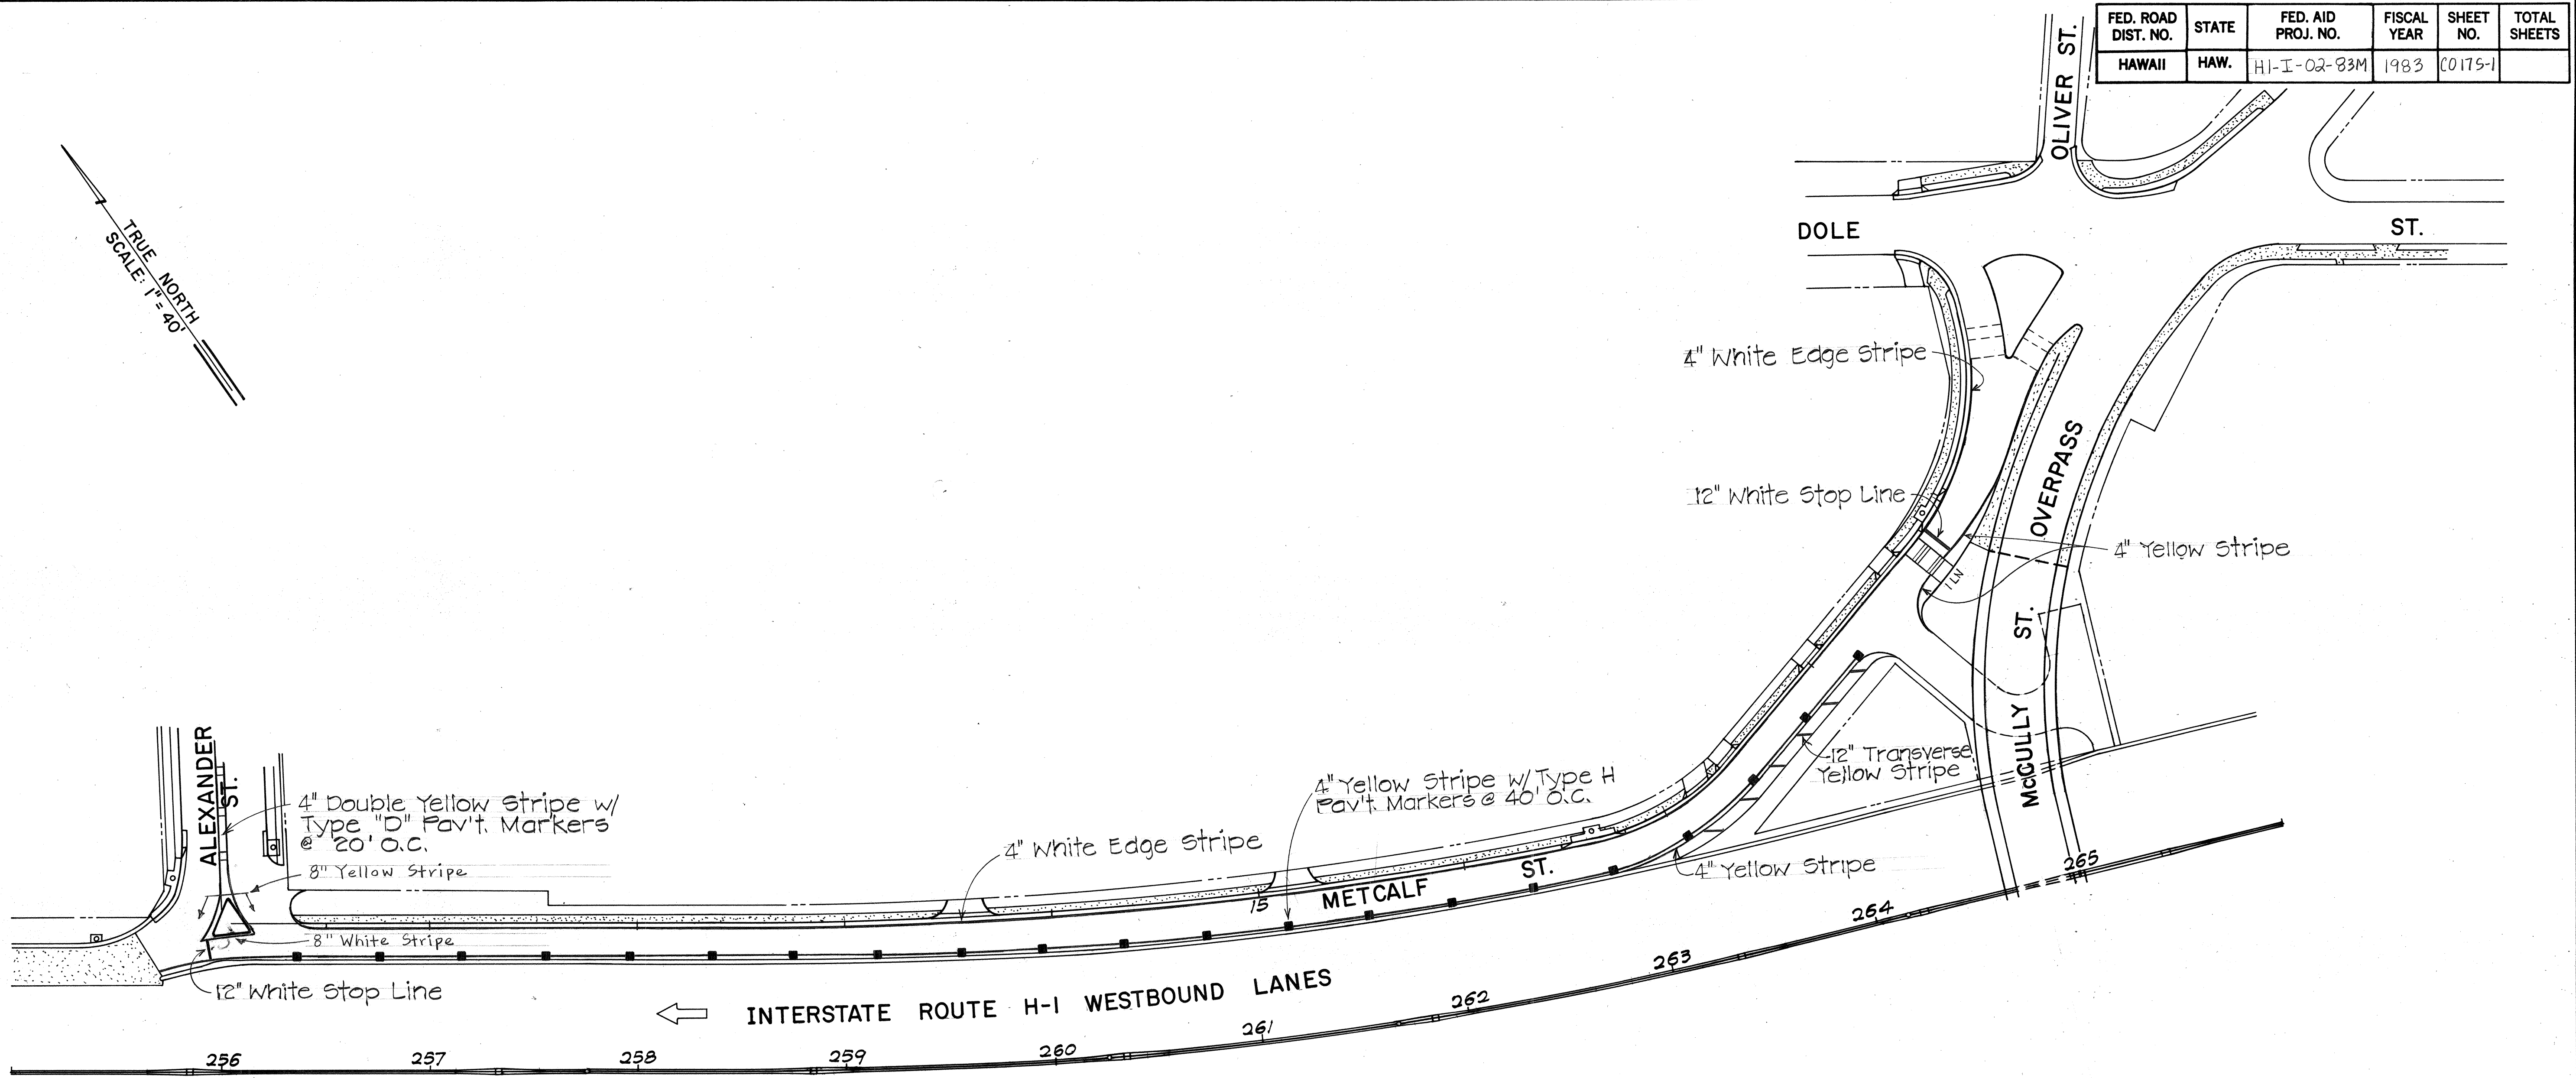

ORIGINAL PLAN	SURVEY PLOTTED BY	DATE
NOTE BOOK	DESIGNED BY	
	QUANTITIES BY	
	CHECKED BY	

STATE OF HAWAII
DEPARTMENT OF TRANSPORTATION
HIGHWAYS DIVISION

PAVEMENT MARKING & STRIPING
INTERSTATE ROUTE H-1 RESURFACING



METCALF STREET

PROJECT No. HI-I-02-83M

Scale: 1"=40' Date: Aug. 1983

SHEET NO. OF SHEETS

FED. ROAD DIST. NO.	STATE	PROJ. NO.	FISCAL YEAR	SHEET NO.	TOTAL SHEETS
HAWAII	HAW.	HI-I-02-83M	1983	19	30

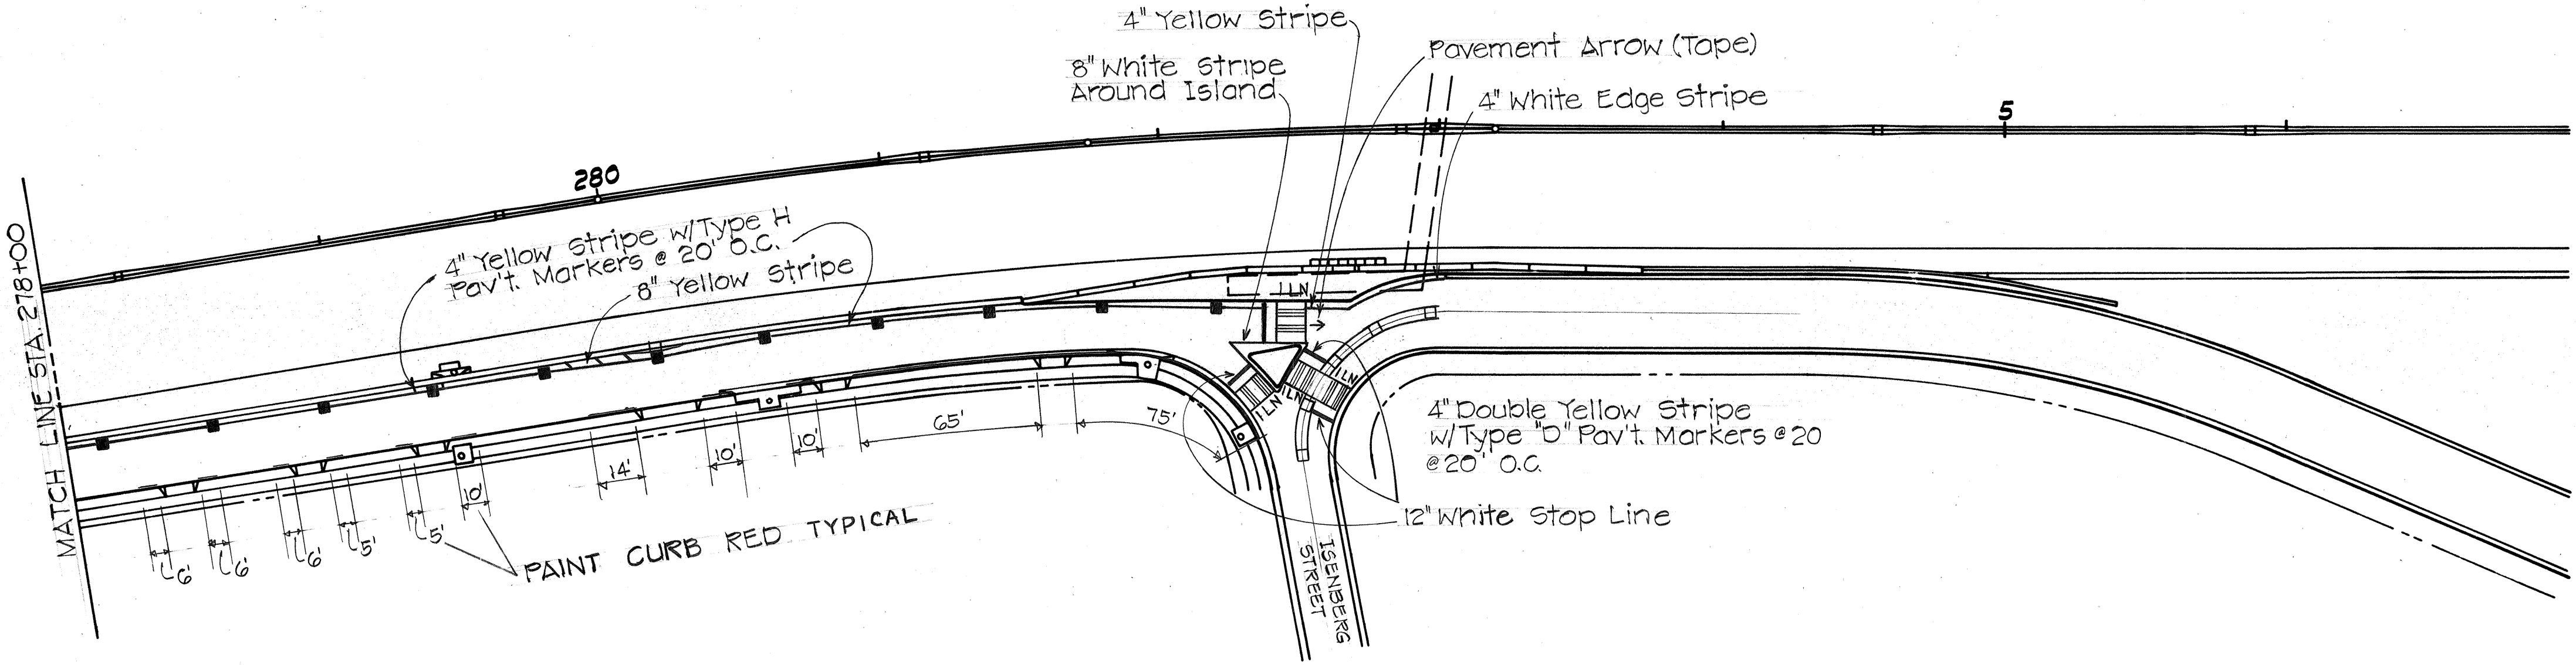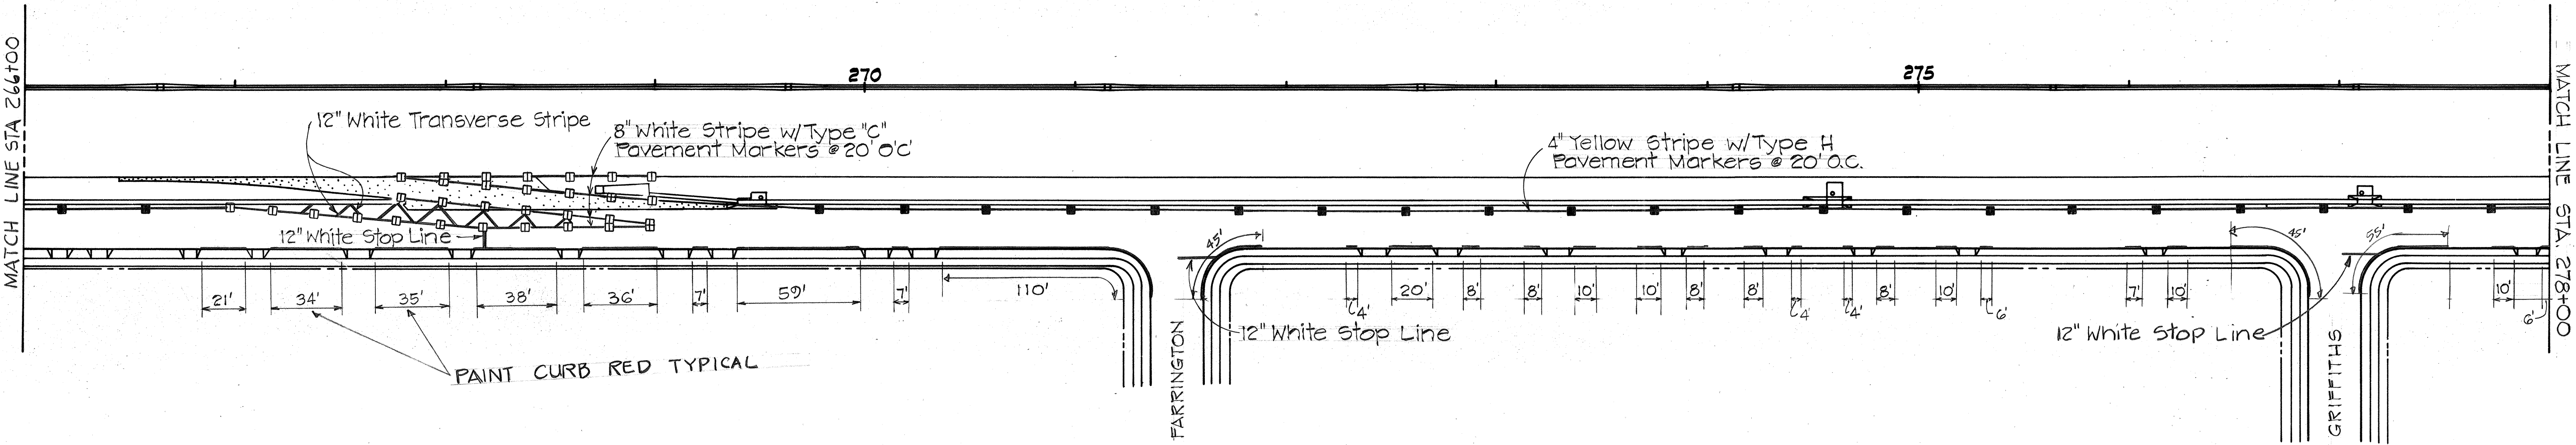

ORIGINAL PLAN	SURVEY PLOTTED BY	DATE
NOTE BOOK	DRAWN BY	
NO.	DESIGNED BY	
	QUANTITIES BY	
	CHECKED BY	

STATE OF HAWAII
DEPARTMENT OF TRANSPORTATION
HIGHWAYS DIVISION

PAVEMENT MARKING AND STRIPING
INTERSTATE ROUTE H-1 RESURFACING
BINGHAM ST.

PROJECT NO. HI-I-02-83M
Scale: 1"=40' Date: April, 1983
SHEET No. 5 OF 5 SHEETS