



FED. ROAD DIST. NO.	STATE	FED. AID PROJ. NO.	FISCAL YEAR	SHEET NO.	TOTAL SHEETS
HAWAII	HAW.	I-HI-1(132):17	1983	6	192

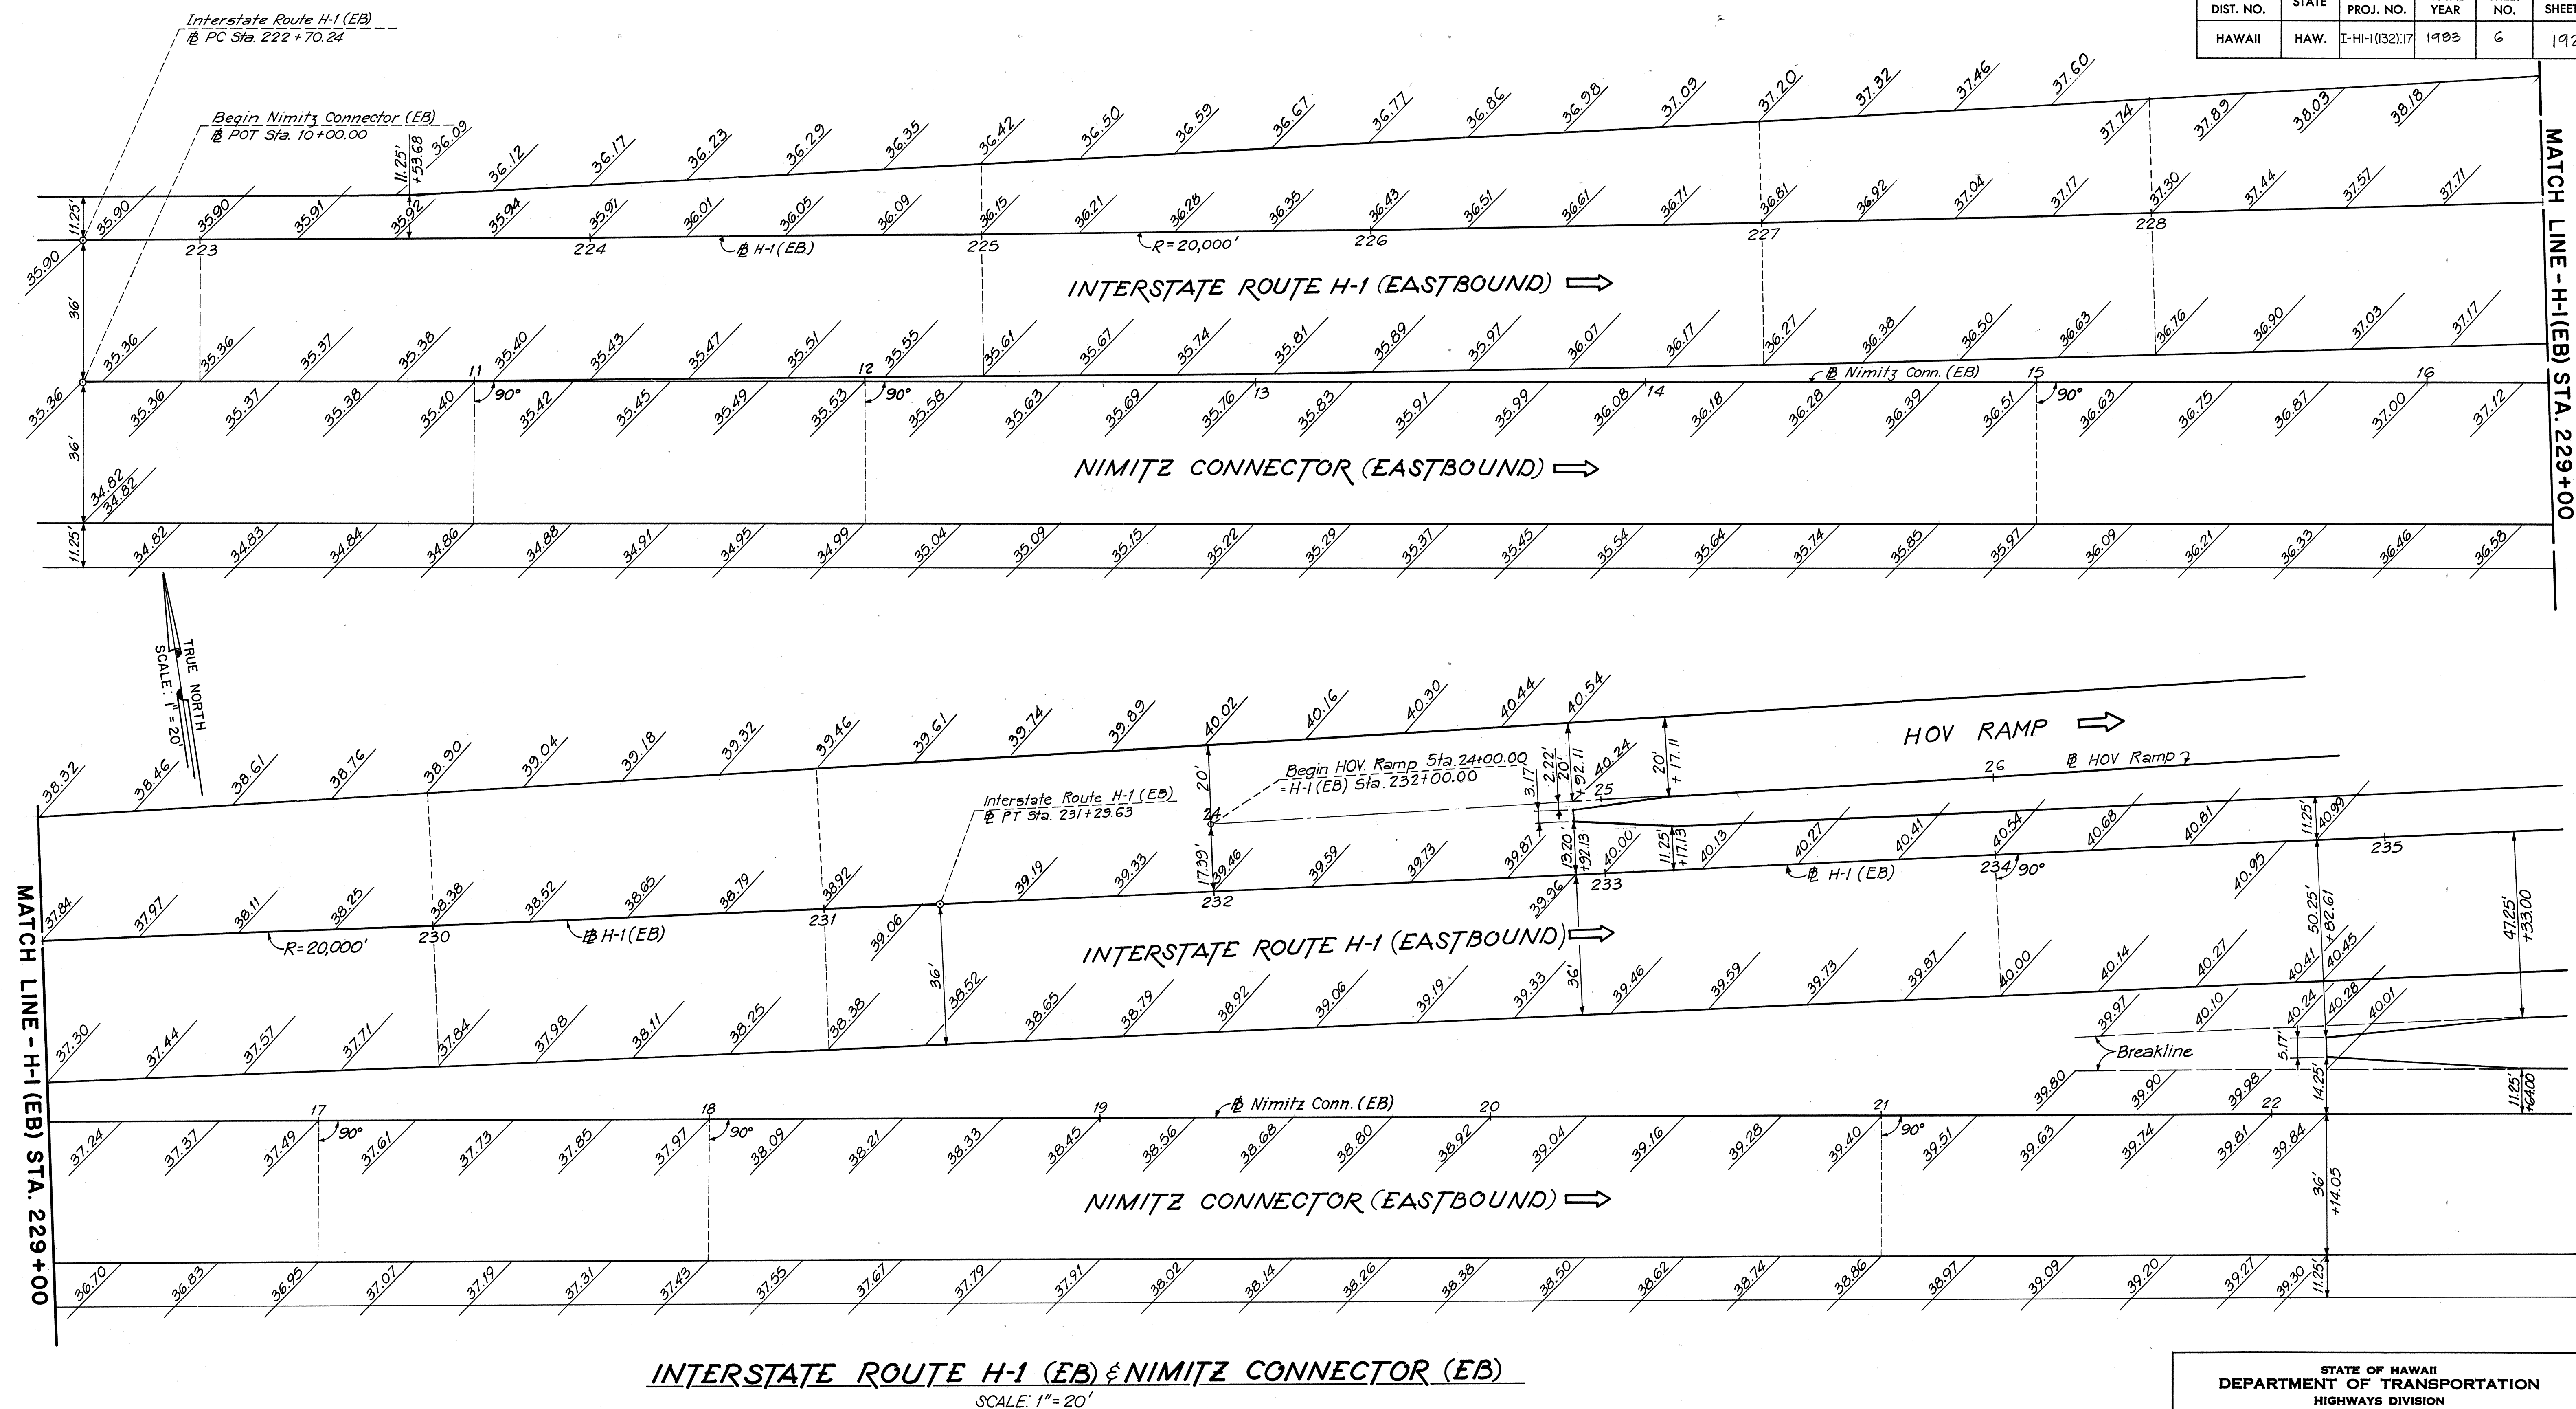

INTERSTATE ROUTE H-1 (EB) & NIMITZ CONNECTOR (EB)
SCALE: 1" = 20'

DATE	_____
DESIGNED BY	_____
CHECKED BY	_____
NO.	_____

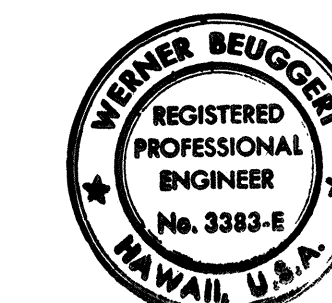

THIS WORK WAS PREPARED BY
ME OR UNDER MY SUPERVISION.
Werner Beugnot

STATE OF HAWAII
DEPARTMENT OF TRANSPORTATION
HIGHWAYS DIVISION

RAMP TERMINAL
H-1(EB)/N.C.(EB)/HOV RAMP

INTERSTATE ROUTE H-1
PROJECT NO. I-HI-1-1(132):17

SCALE: 1" = 20' DATE: 11/16/81
SHEET No. A-4 OF 8 SHEETS


FED. ROAD DIST. NO.	STATE	FED. AID PROJ. NO.	FISCAL YEAR	SHEET NO.	TOTAL SHEETS
HAWAII	HAW.	I-H-1(132):17	1983	6 S-1	192

LEGEND

13.10 Future Finish Grade Elevation
(Fin. Grade for this Contract is 2 1/2" lower.)

Temporary Pavement

3:45 Flare = Parabolic Curve, $x=45'$, $y=3'$

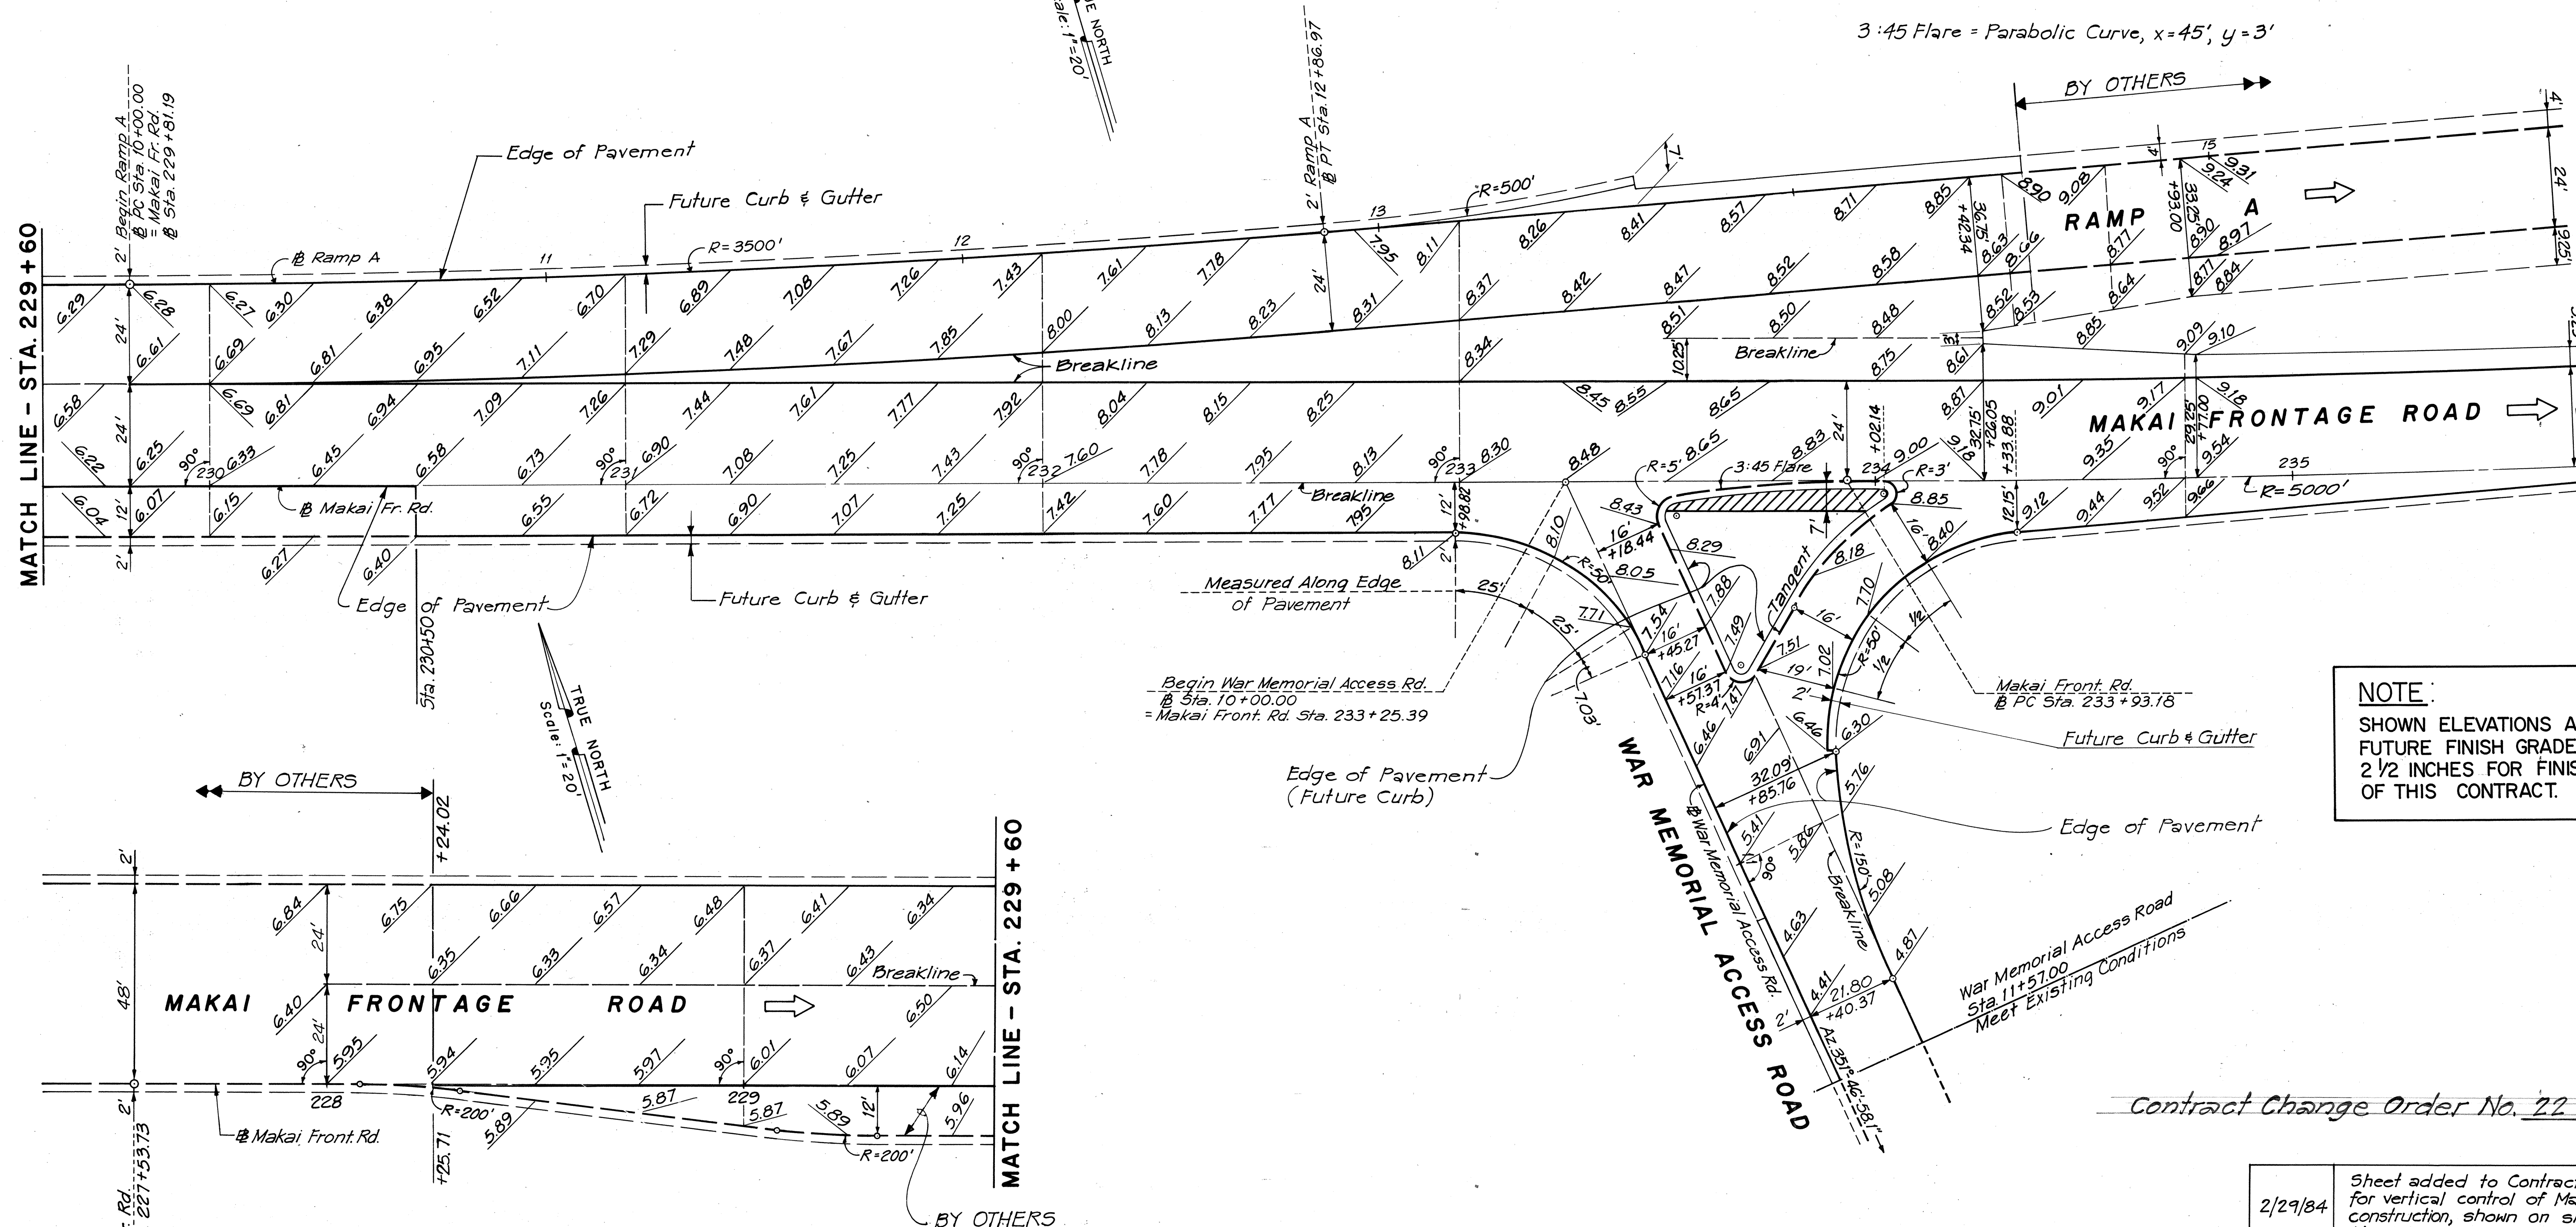

NOTE:


SHOWN ELEVATIONS ARE FOR FUTURE FINISH GRADE. DEDUCT 2 1/2 INCHES FOR FINISH GRADE OF THIS CONTRACT.

Contract Change Order No. 22

RAMP A & MAKAI FRONTAGE ROAD and WAR MEMORIAL ACCESS ROAD

SCALE: 1" = 20'

2/29/84	Sheet added to Contract Plan Set for vertical control of Makai Fr. Rd. construction, shown on sheet No. C.O.11.
DATE	REVISION
STATE OF HAWAII DEPARTMENT OF TRANSPORTATION HIGHWAYS DIVISION RAMP TERMINAL & INTERSECTION MAKAI FR. RD. / RAMP A / WAR MEMORIAL ACC. RD. INTERSTATE ROUTE H-1 PROJECT NO. I-H-1 (132):17 SCALE: 1" = 20' DATE: 4/30/81 SHEET No. A-4A OF 8 SHEETS	

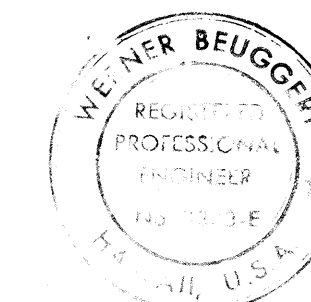

WAS PREPARED BY
Werner Beugnot

ORIGINAL PLAN	DATE
DESIGNED BY	
NOTED BY	
CHECKED BY	
DATE	


FED. ROAD DIST. NO.	STATE	FED. AID PROJ. NO.	FISCAL YEAR	SHEET NO.	TOTAL SHEETS
HAWAII	HAW.	I-HI-1(132)17	1983	6S-1	192

LEGEND

13.10 Future Finish Grade Elevation
(Fin. Grade for this Contract is 2 1/2" lower.)

Temporary Pavement

3:45 Flare = Parabolic Curve, $x=45'$, $y=3'$

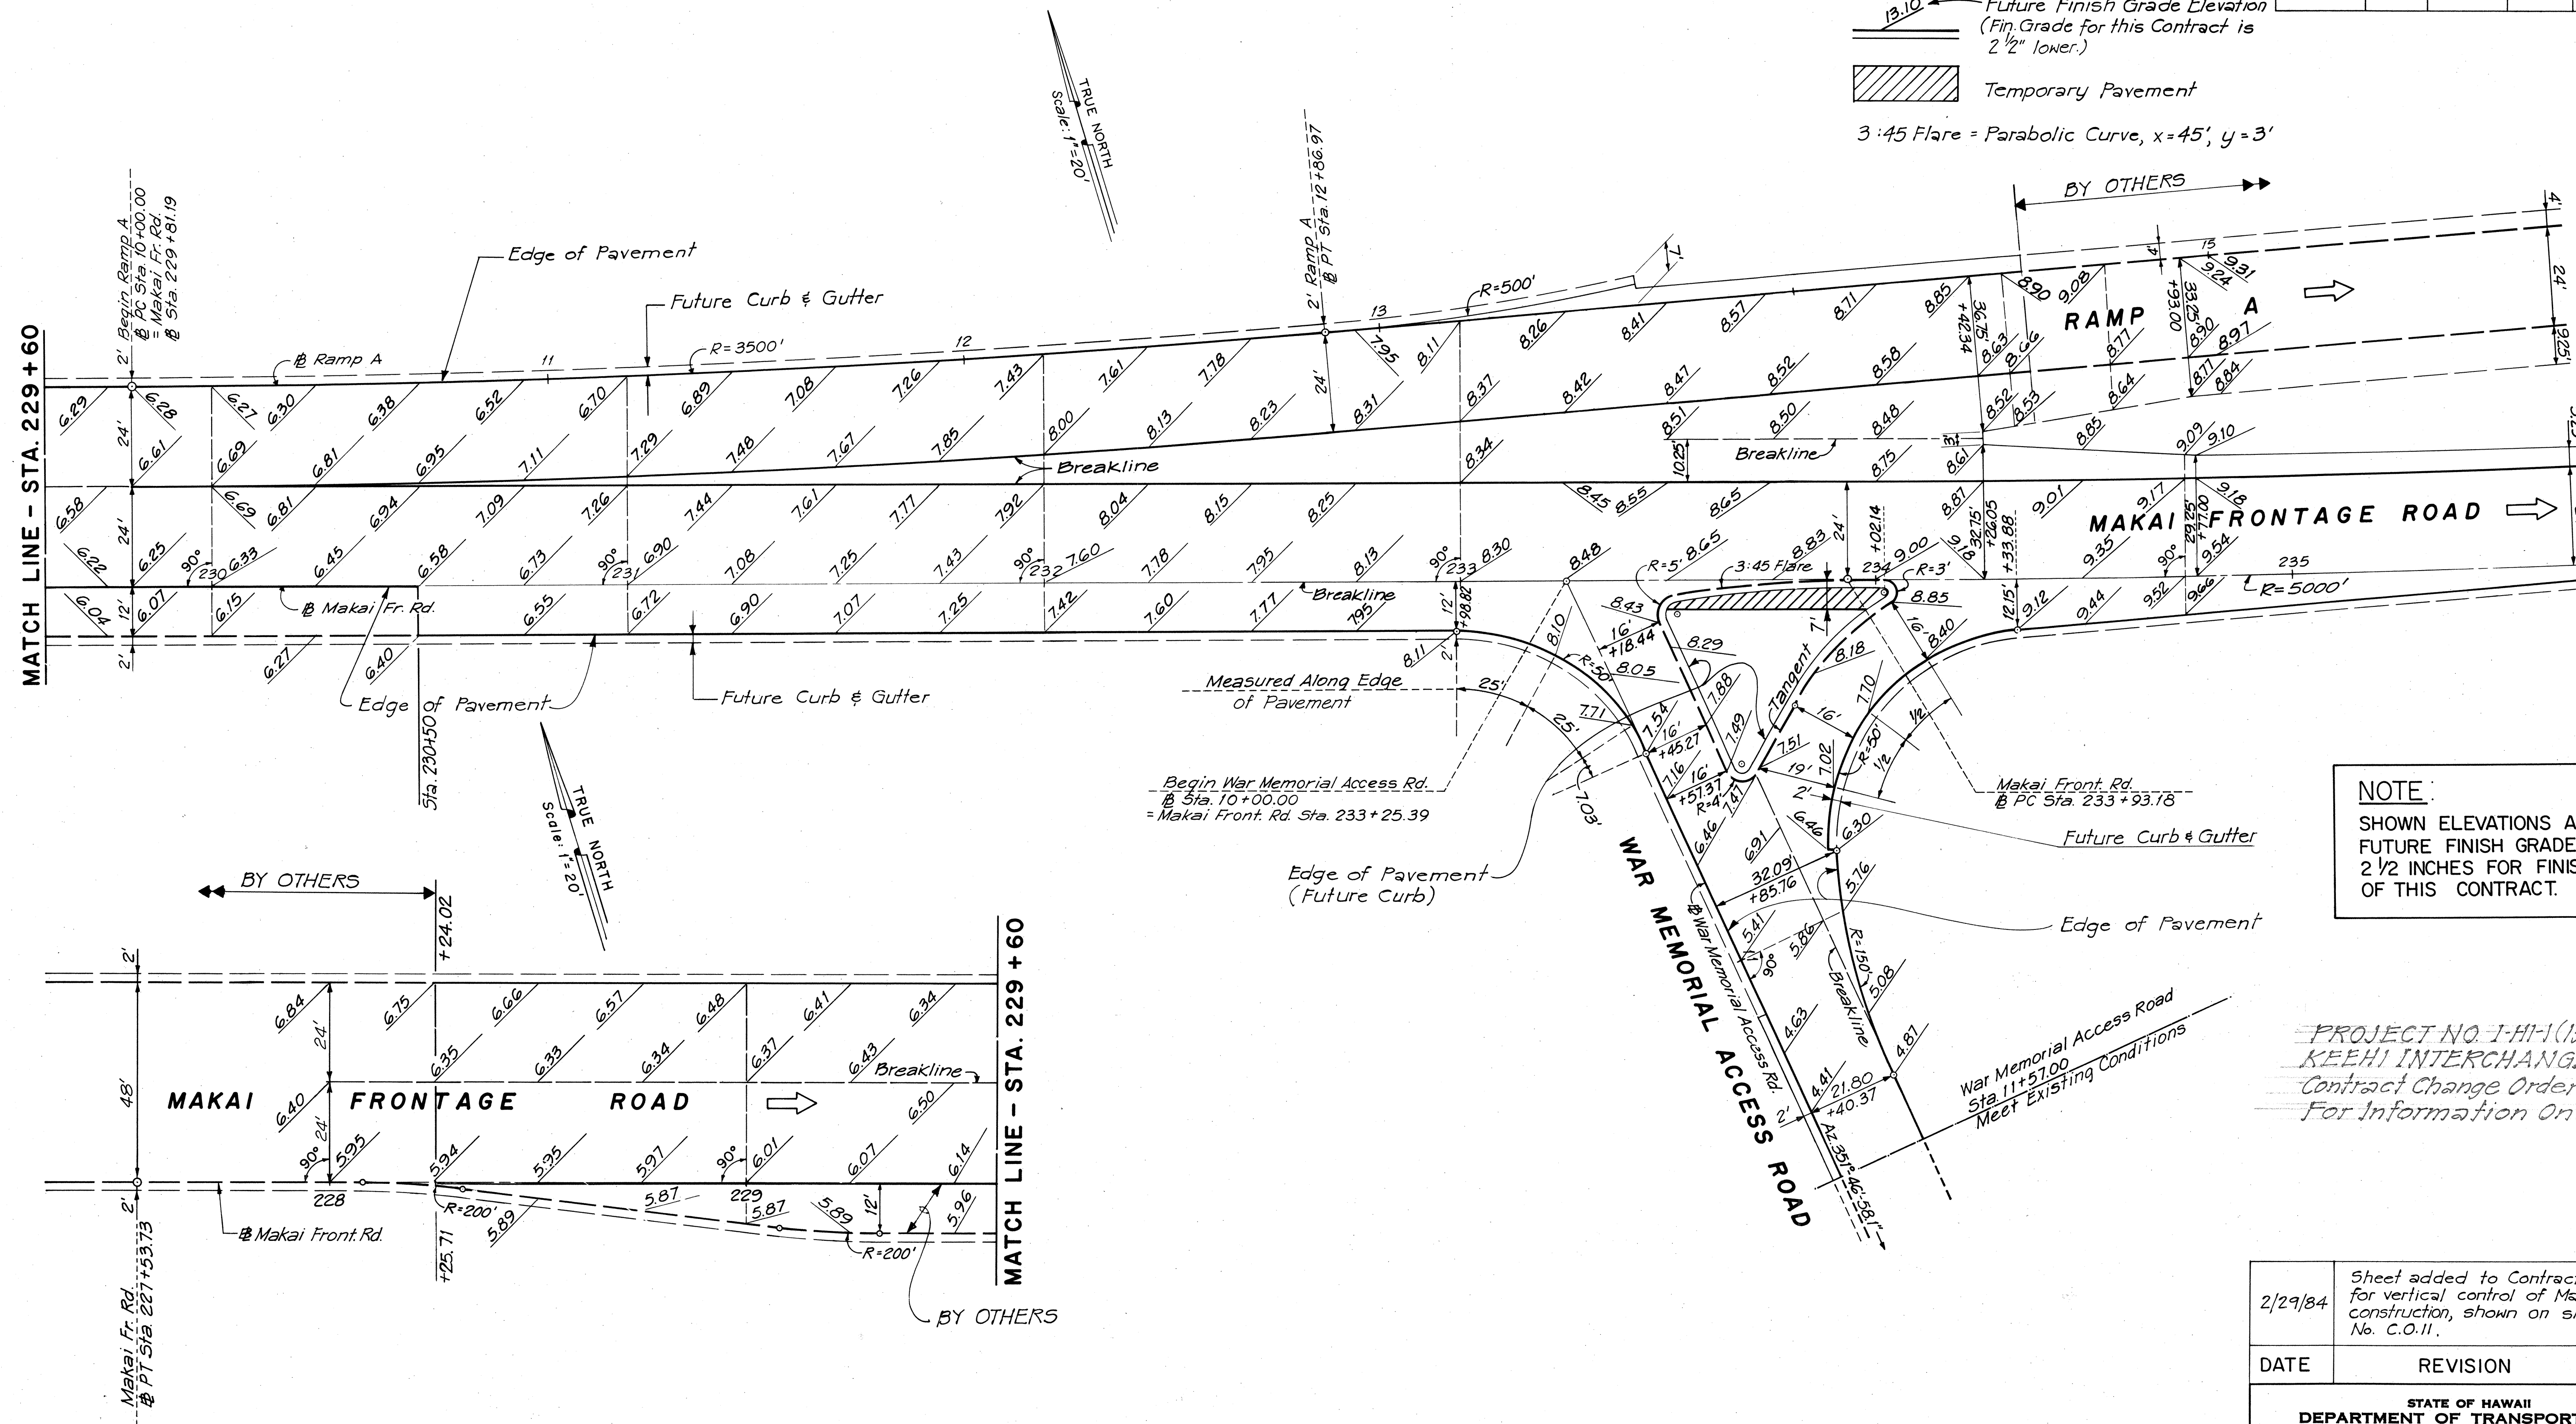

NOTE:

SHOWN ELEVATIONS ARE FOR FUTURE FINISH GRADE. DEDUCT 2 1/2 INCHES FOR FINISH GRADE OF THIS CONTRACT.

PROJECT NO. I-HI-1(133):17
KEEHI INTERCHANGE
Contract Change Order No. 34
For Information Only

RAMP A & MAKAI FRONTAGE ROAD and WAR MEMORIAL ACCESS ROAD

SCALE: 1" = 20'

2/29/84	Sheet added to Contract Plan Set for vertical control of Makai Fr. Rd. construction, shown on sheet No. C.O.11.
DATE	REVISION
STATE OF HAWAII DEPARTMENT OF TRANSPORTATION HIGHWAYS DIVISION RAMP TERMINAL & INTERSECTION MAKAI FR. RD. / RAMP A / WAR MEMORIAL ACC. RD. INTERSTATE ROUTE H-1 PROJECT NO. I-HI-1 (132):17 SCALE: 1" = 20' DATE: 4/30/81 SHEET No.A-4AOF 8 SHEETS	

C.O.6S-1

ORIGINAL PLAN	DATE
SURVEY PLOTTED BY	
DRAWN BY	
DESIGNED BY	
QUANTITIES BY	
CHECKED BY	