

## GENERAL NOTES

| FED. ROAD DIST. NO. | STATE | FED. AID PROJ. NO. | FISCAL YEAR | HEET NO. | TOTAL SHEETS |
|---------------------|-------|--------------------|-------------|----------|--------------|
| HAWAII              | HAW.  | I-HI-1(187)        | 1984        | 40       | 197          |

### DRAINAGE NOTES:

1. Existing drainage system will be functional at all times during construction. Contractor is to furnish materials, equipment, labor, tools and incidentals necessary to accomplish maintenance of flow, the cost of which shall be incidental to the various contract items.
2. Demolishing and removing a portion or the entire existing structure shall not be paid for separately, but shall be considered incidental to the various contract items.
3. Culverts within the catch basins, grated drop intakes and storm drain manholes shall be cut flush with the inside face of the wall. Above work shall be considered incidental to the various contract items.
4. Location of C.I. Frame and Cover for drain manholes or catch basins shall be determined by the Engineer in the field.
5. Contractor shall verify the locations of all culverts in the field. Any culvert damaged during construction shall be repaired or replaced by the Contractor at his expense.
6. Only non-pneumatic type of drill as approved by the Engineer will be permitted for drilling holes in concrete. Where indicated on plans, the approximate diameter of drilled holes for installation of dowels shall be 1½ inches, after installing dowels, the voids shall be filled with epoxy grout as directed by the Engineer. Above work shall be considered incidental to the various contract items.
7. Concrete for grated drop intakes, drain manholes and catch basins shall be Class "A".
8. Premolded joint filler and composition roofing paper shall be considered incidental to Class "A" Concrete.
9. Quantities for concrete gutter aprons shall be considered as part of structure.
10. Existing cast iron frame and covers shall be cleaned and painted before installation. Above work shall be considered incidental to the various contract items.
11. Salvaged C.I. Frame and Covers shall be cleaned, painted and returned to 727 Kakoi St, Honolulu, Hawaii 96810.

### SPRINKLER NOTES:

1. Abandon sprinkler systems affected by the roadway construction and as noted on the plans shall be removed. Removal shall be incidental to Roadway Excavation.
2. Excavation for cut and plug work shall not be paid for but shall be considered incidental to the various contract items.

### GAS FACILITIES NOTES:

1. The Gasco, Inc gas pipelines in the project area are plastic coated and cathodically protected. The Contractor shall be extremely careful when working near these gas pipe lines.
2. Prior written clearance must be obtained from Gasco, Inc. at least five (5) working days before starting excavation near these gas lines. Since gas line locations on field maps are approximate, the Contractor, after obtaining a written clearance, shall call Gasco, Inc., a minimum of 48 hours before starting excavation to arrange for field location of existing gas lines. The telephone number is 547-3575 during business hours, and 526-0066 after hours. The Contractor shall excavate and backfill around gas pipe lines in the presence of a Gasco, Inc. representative. All backfill within six inches of gas pipe line shall be select cushion material approved by Gasco, Inc.
3. For relocation of any gas pipe line, the Contractor shall notify Gasco, Inc. five (5) working days before starting work. The Contractor shall provide the necessary excavation and backfill, arrange for traffic permits and restore sidewalk pavement or other facilities. Any relocation of gas facilities shall be done by Gasco, Inc.
4. The Contractor shall notify Gasco, Inc. immediately after any damage has been caused to existing gas pipelines, their coatings or their cathodic protection devices. Repair work on this damage shall be done by Gasco, Inc. with payment for this work to be borne by the Contractor.
5. Minimum vertical or horizontal clearance between gas pipe lines and other pipelines, conduits, or ductlines shall be 12 inches. Adequate support and protection for gas pipe lines exposed in the trench shall be provided. Such support and protection shall be approved by Gasco, Inc.
6. The Contractor shall work in an expeditious manner in order to keep uncovered gas pipe lines exposed for as short a period of time as possible.

|                   |      |
|-------------------|------|
| SURVEY PLOTTED BY | DATE |
| DRAWN BY          |      |
| TRACED BY         |      |
| QUOTED BY         |      |
| CHECKED BY        |      |
| ORIGINAL PLAN     |      |
| NOTE BOOK         |      |
| No.               |      |

STATE OF HAWAII  
DEPARTMENT OF TRANSPORTATION  
HIGHWAYS DIVISION


**DRAINAGE NOTES**

INTERSTATE ROUTE H-1 IMPROVEMENTS  
MIDDLE STREET TO KALIHI INTERCHANGE  
WESTBOUND LANES  
F.A.I. PROJ. NO. I-HI-1(187)

DATE: JUNE 1983

SHEET NO. 1 OF 30 SHEETS

| FED. ROAD DIST. NO. | STATE | FED. AID PROJ. NO. | FISCAL YEAR | SHEET NO. | TOTAL SHEETS |
|---------------------|-------|--------------------|-------------|-----------|--------------|
| HAWAII              | HAW.  | I-HI-1(187)        | 1984        | 50        | 197          |

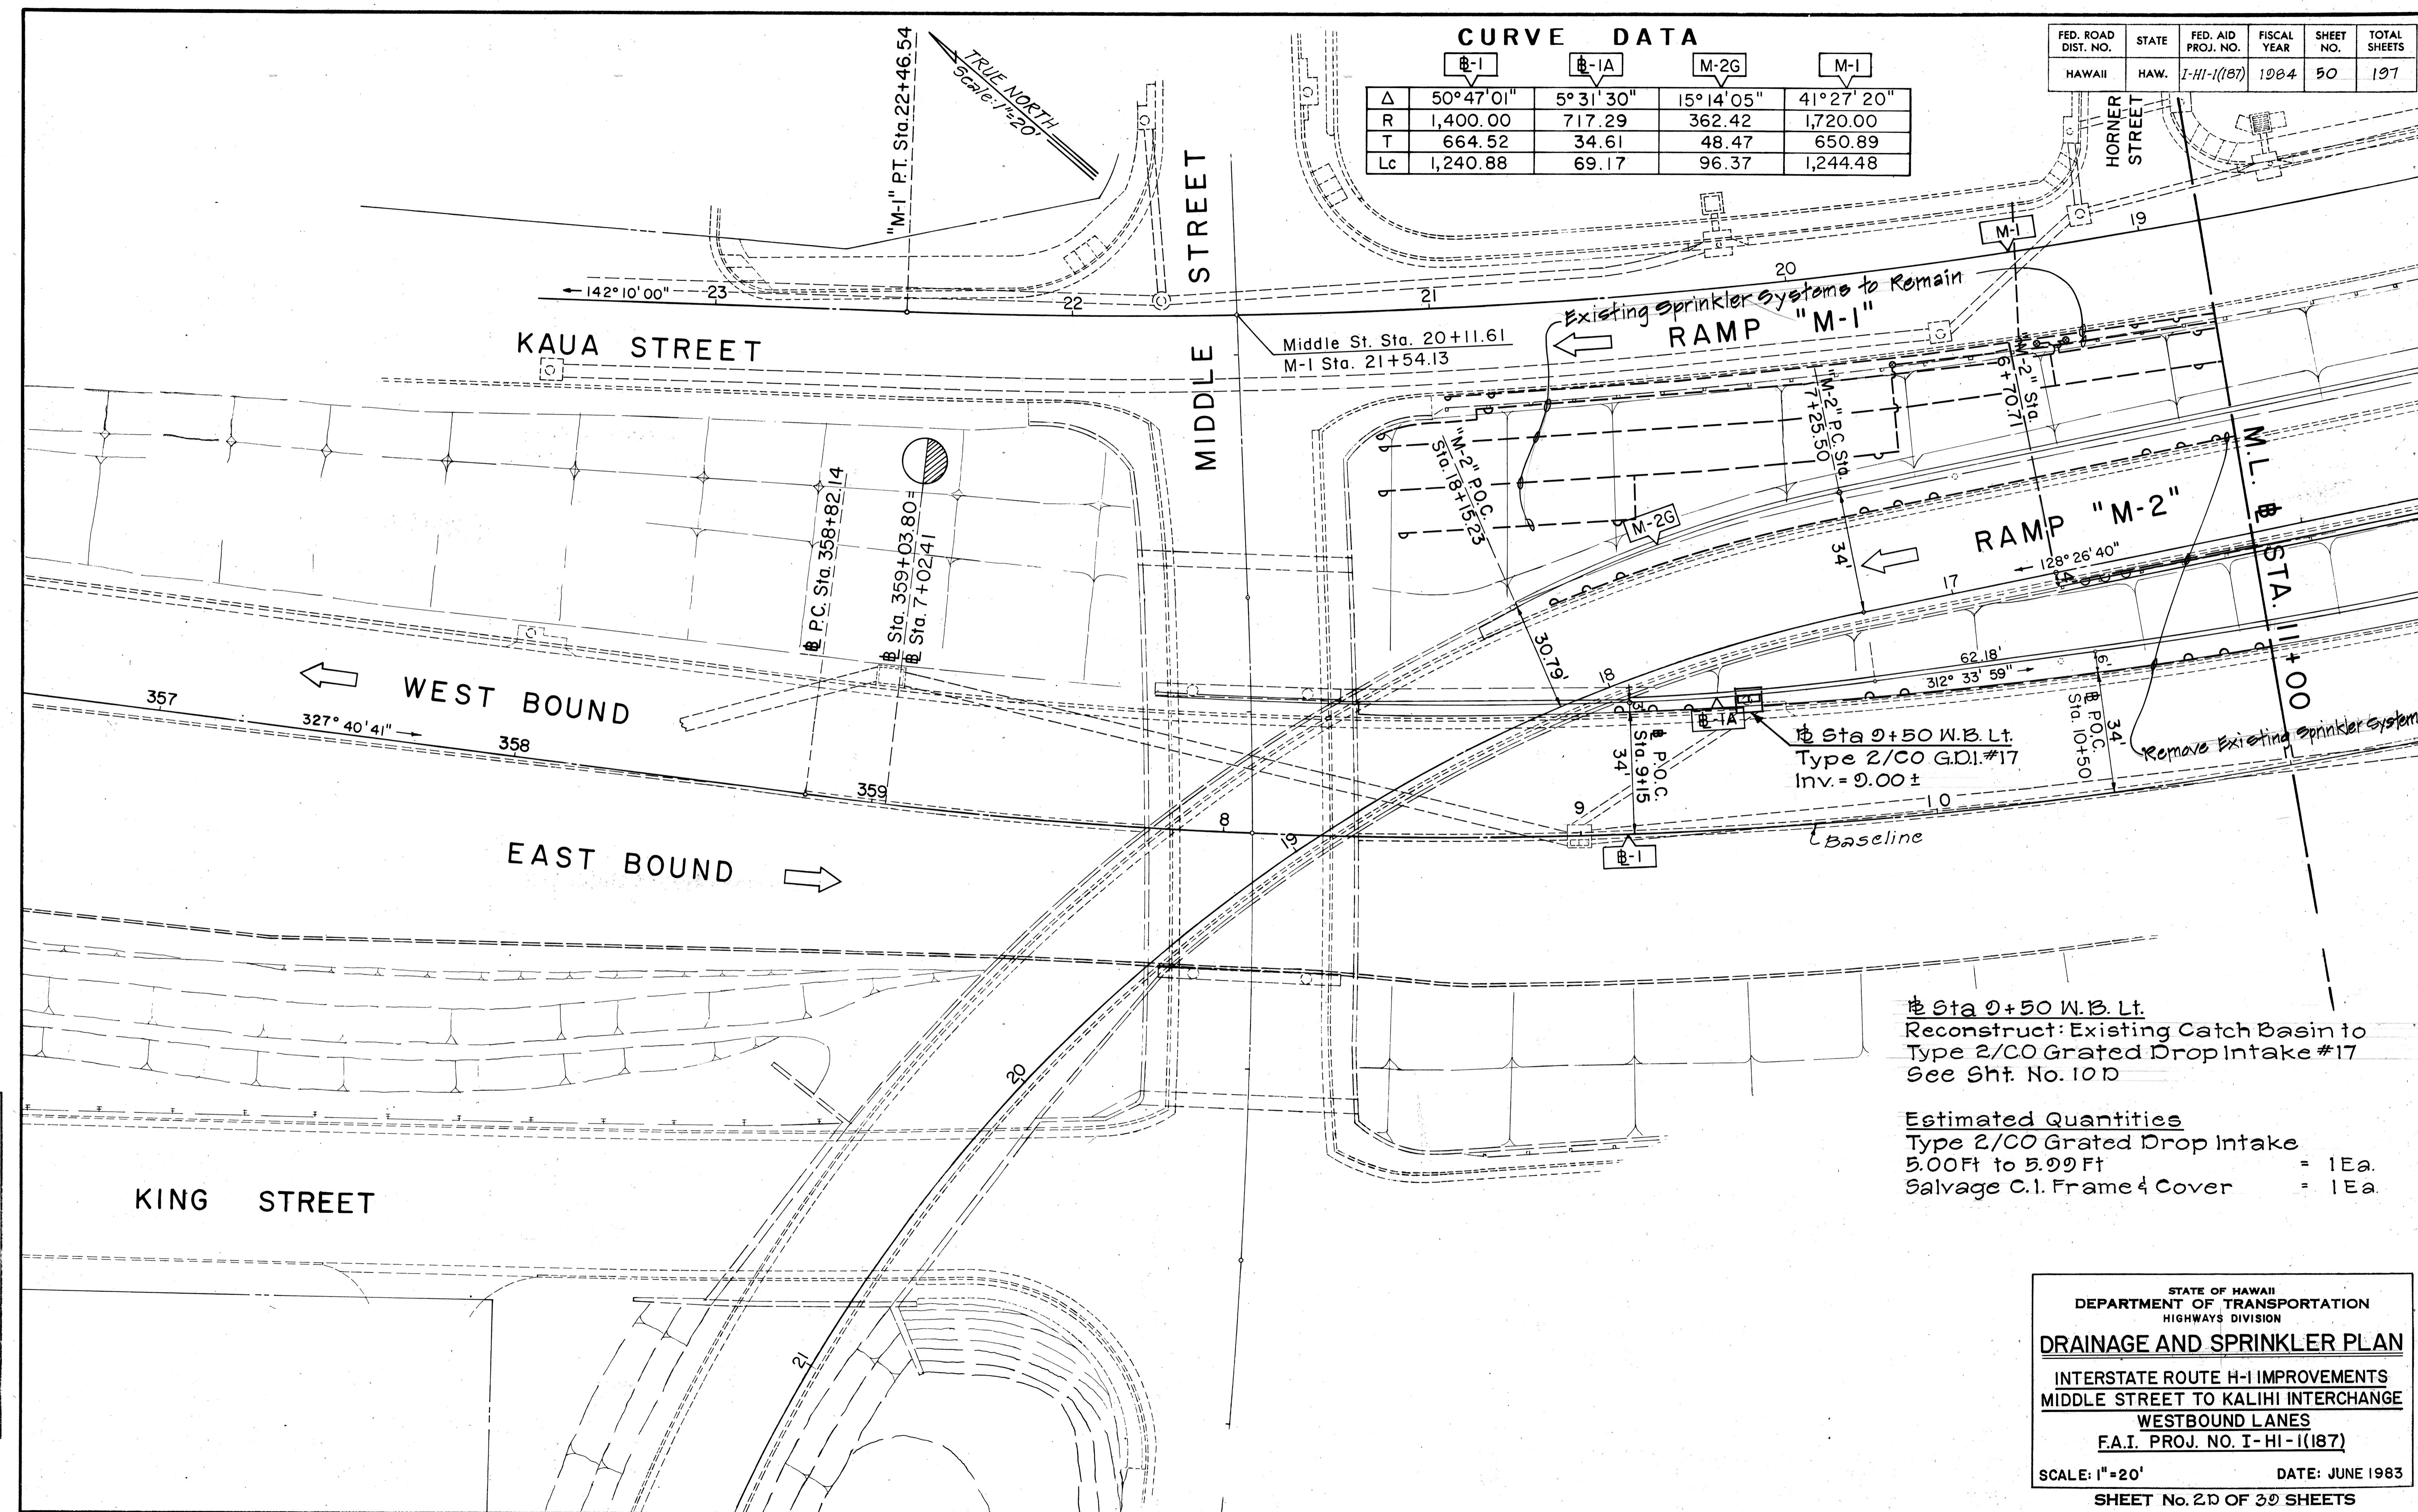

ORIGINAL PLAN  
SURVEY PLOTTED BY \_\_\_\_\_  
DRAWN BY \_\_\_\_\_  
TRACED BY \_\_\_\_\_  
DESIGNED BY \_\_\_\_\_  
CHECKED BY \_\_\_\_\_  
NOTE BOOK No. \_\_\_\_\_

### CURVE DATA

|    | B-IB       | B-IC       | M-IA       | M-IC        |
|----|------------|------------|------------|-------------|
| Δ  | 5° 49' 53" | 5° 18' 57" | 4° 59' 48" | 82° 58' 49" |
| R  | 196.34     | 215.41     | 657.55     | 25.00       |
| T  | 10.00      | 10.00      | 28.69      | 22.11       |
| Lc | 19.98      | 19.99      | 57.34      | 36.21       |


|    | B-I         | M-I         | M-2B        | M-2C        |
|----|-------------|-------------|-------------|-------------|
| Δ  | 50° 47' 01" | 41° 27' 20" | 20° 29' 15" | 11° 03' 45" |
| R  | 1,400.00    | 1,720.00    | 1,152.40    | 1,184.00    |
| T  | 664.52      | 650.89      | 208.26      | 114.66      |
| Lc | 1,240.88    | 1,244.48    | 412.07      | 228.60      |

|    | OL-1        | OL-2         | M-2H       |
|----|-------------|--------------|------------|
| Δ  | 73° 31' 38" | 111° 22' 30" | 3° 50' 32" |
| R  | 64.00       | 18.00        | 298.14     |
| T  | 47.82       | 26.37        | 10.00      |
| Lc | 82.13       | 34.99        | 19.99      |

| FED. ROAD DIST. NO. | STATE  | FED. AID PROJ. NO. | FISCAL YEAR | SHEET NO. | TOTAL SHEETS |
|---------------------|--------|--------------------|-------------|-----------|--------------|
| HAWAII              | HAWAII | I-HI-1(87)         | 1984        | C051      | 191          |

Ramp M-1 Sta. 13+50 Rt.  
Type 2 G.D.I. #31  
Inv. = 44.00

TRUE NORTH  
Scale: 1" = 20'

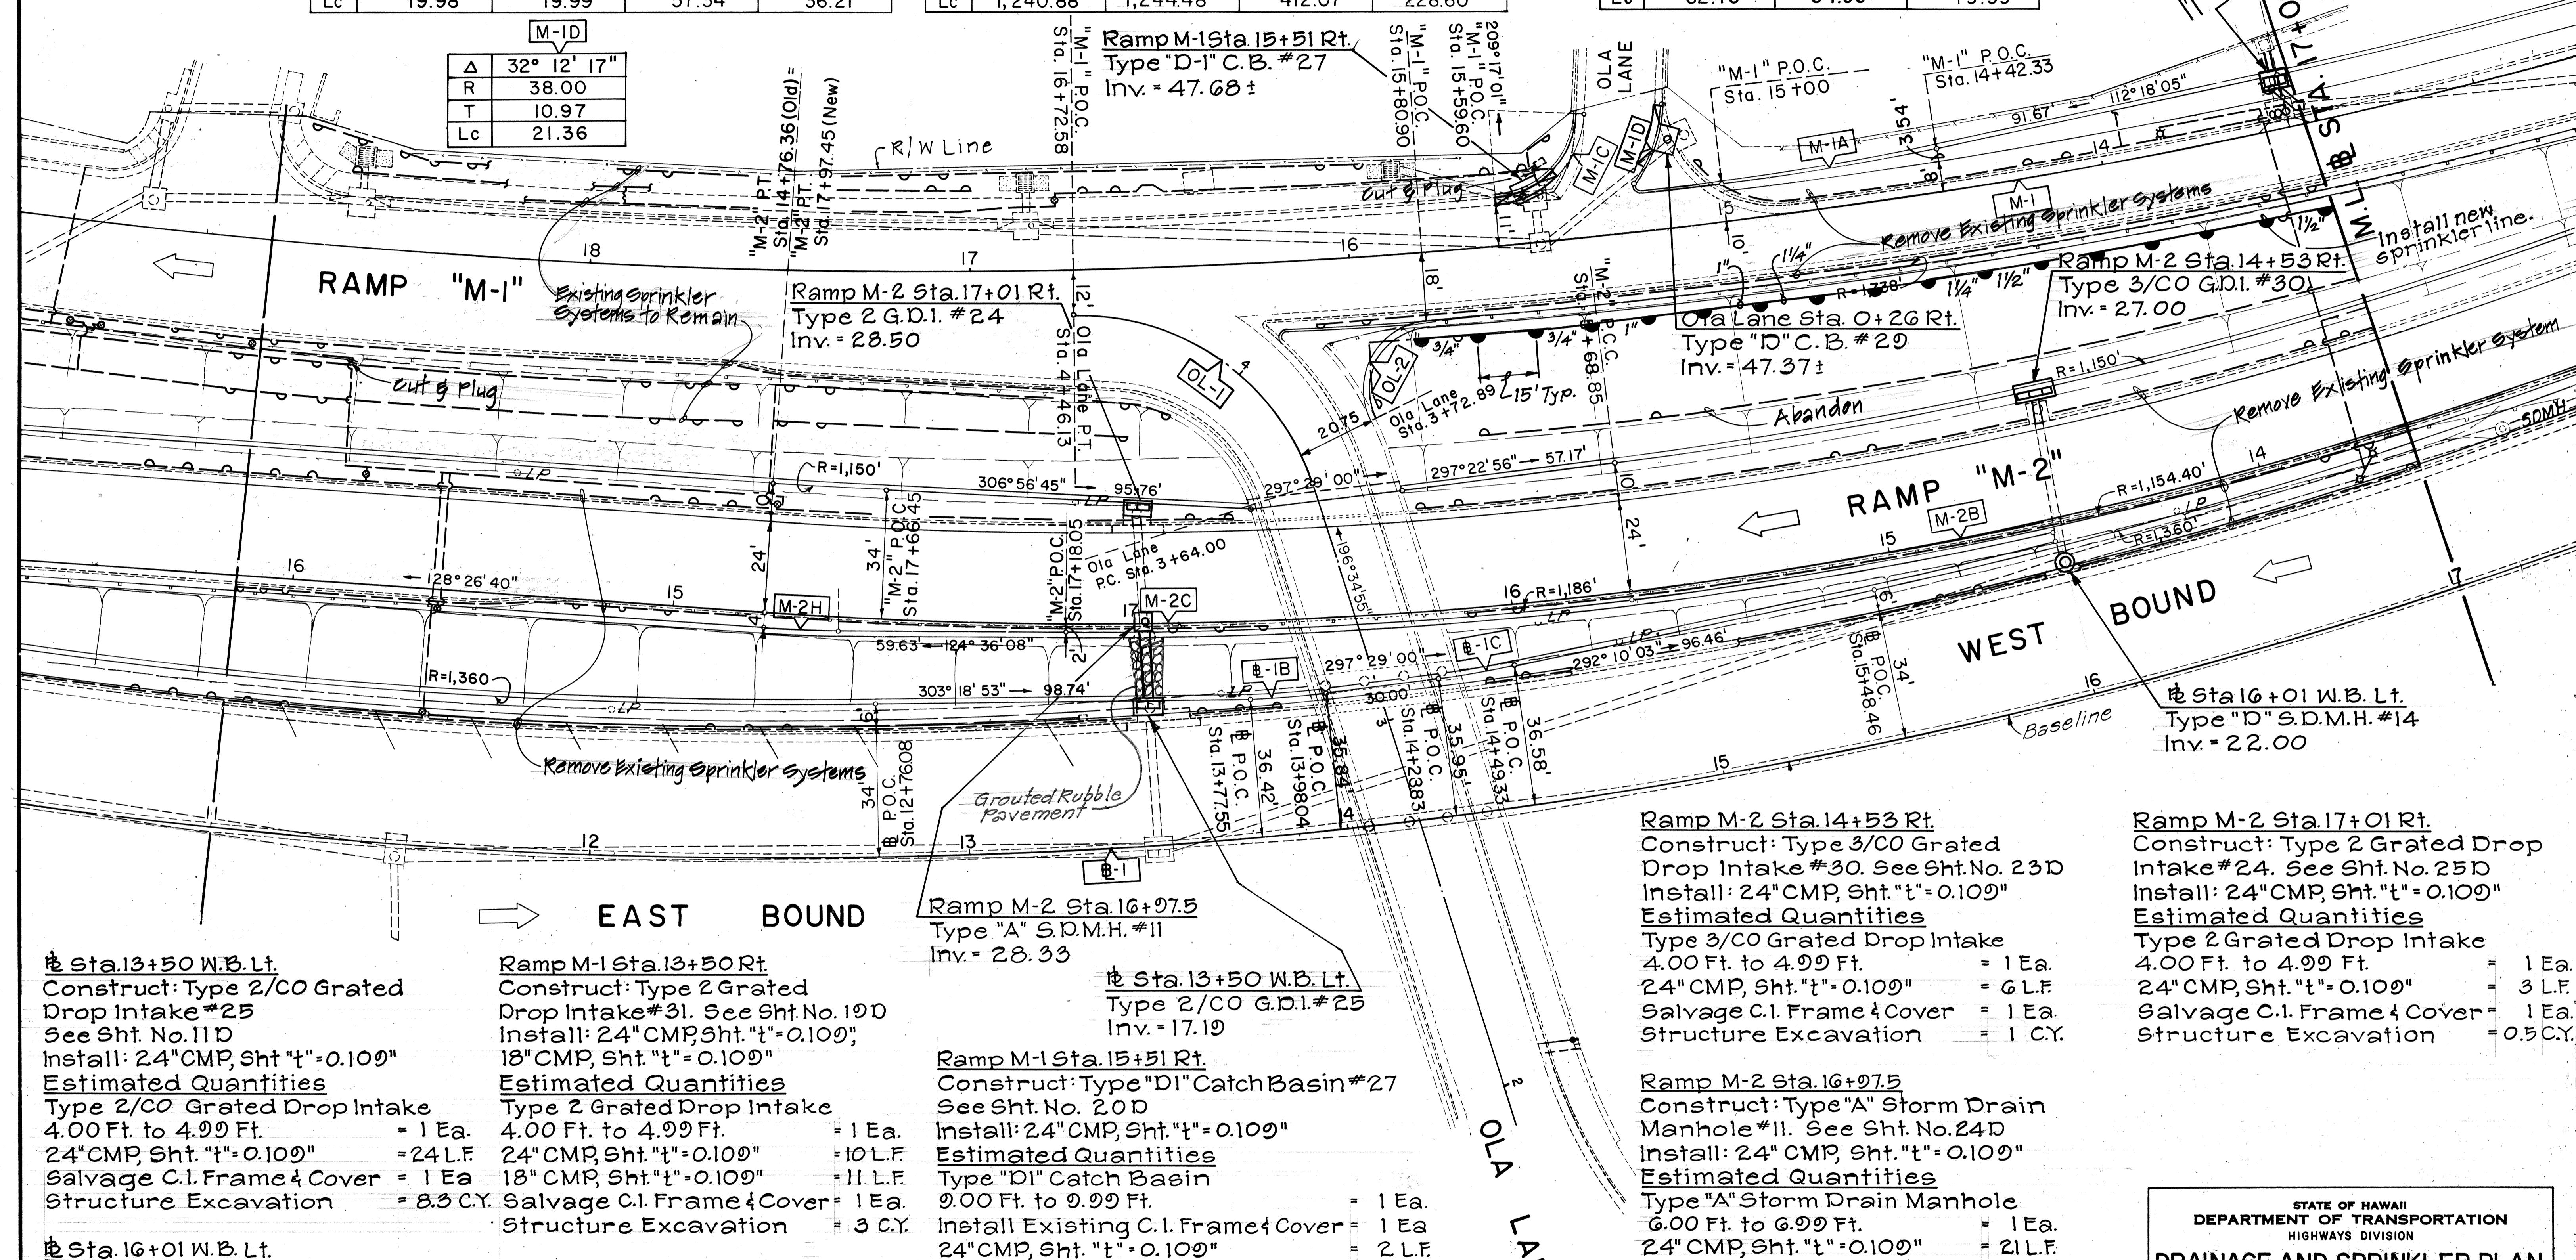


6/28/84 Add new sprinkler line on Ramp M-1 Sta. 17+75± to Sta. 15+80±

DATE: JUNE 1983

|  |                             |
|--|-----------------------------|
| STATE OF HAWAII<br>DEPARTMENT OF TRANSPORTATION<br>HIGHWAYS DIVISION     | DRAINAGE AND SPRINKLER PLAN |
| INTERSTATE ROUTE H-1 IMPROVEMENTS<br>MIDDLE STREET TO KALIHI INTERCHANGE | WESTBOUND LANES             |
| F.A.I. PROJ. NO. I-HI-1(87)  | DATE: JUNE 1983             |
| SCALE: 1" = 20'  | SHEET NO. 3D OF 30 SHEETS   |

C.O.5

| FED. ROAD DIST. NO. | STATE  | FED. AID PROJ. NO. | FISCAL YEAR | SHEET NO. | TOTAL SHEETS |
|---------------------|--------|--------------------|-------------|-----------|--------------|
| HAWAII              | HAWAII | I-HI-1(187)        | 1984        | C052      | 197          |

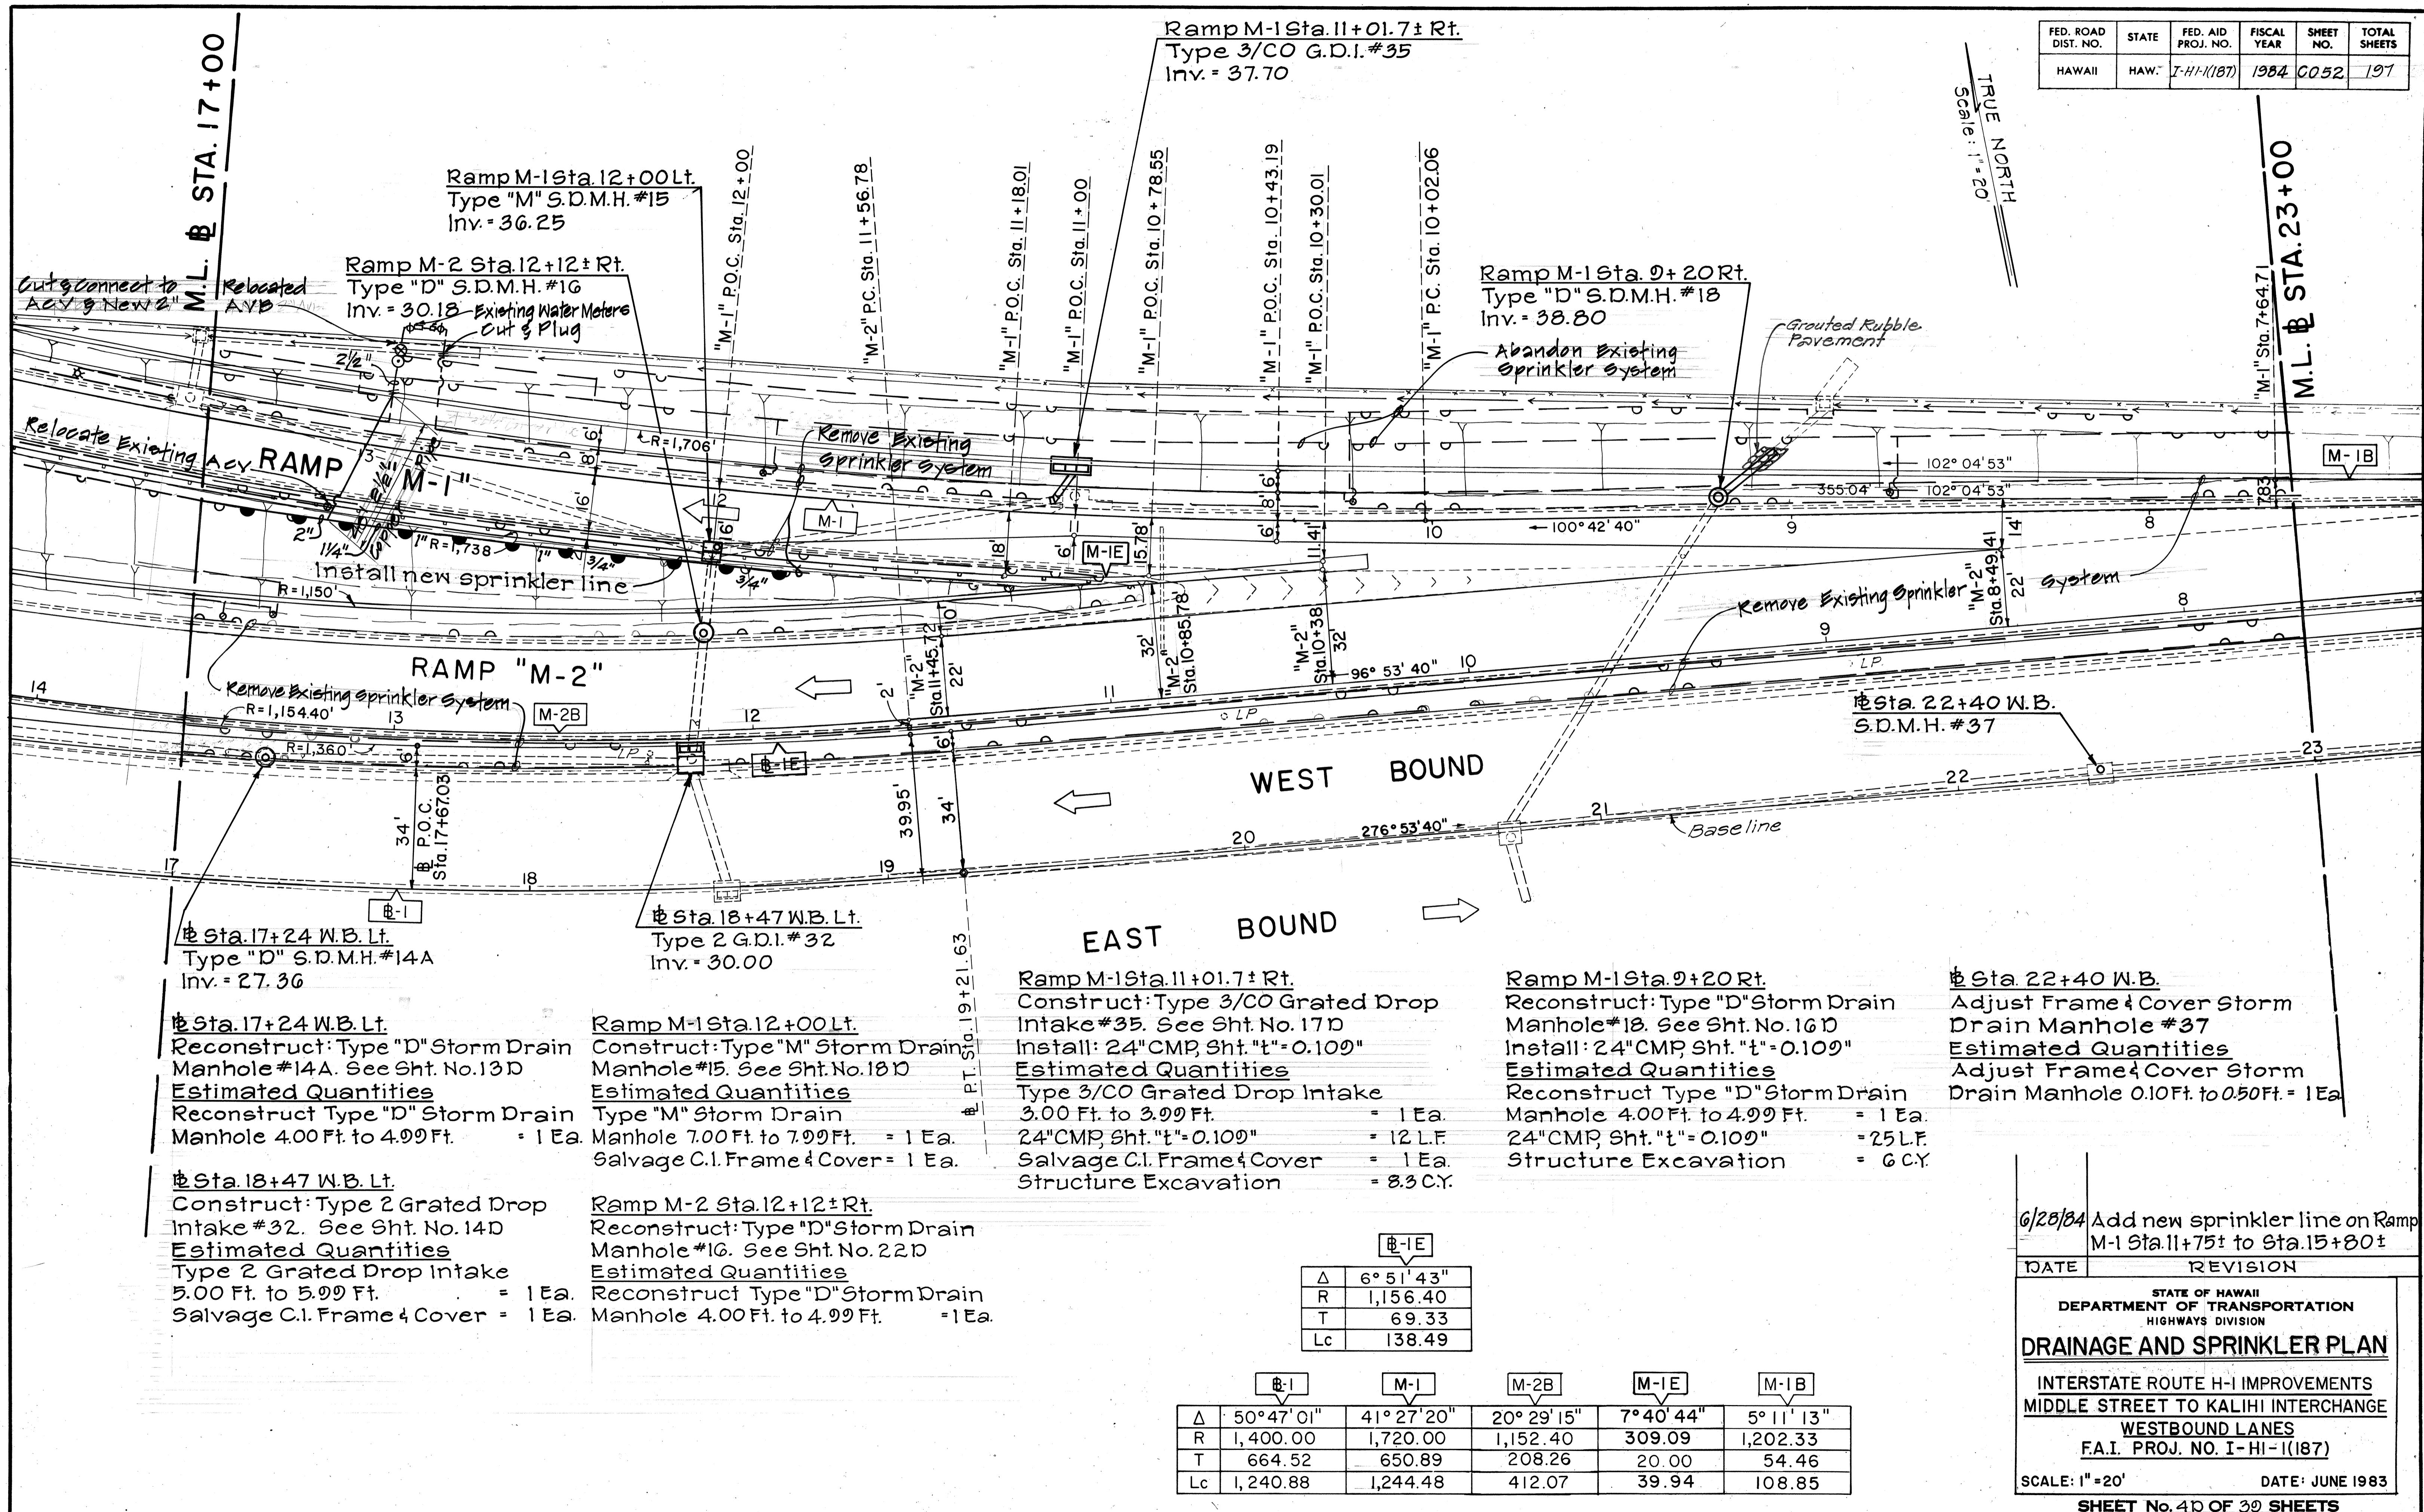

| FED. ROAD DIST. NO. | STATE | FED. AID PROJ. NO. | FISCAL YEAR | HEET NO. | TOTAL SHEETS |
|---------------------|-------|--------------------|-------------|----------|--------------|
| HAWAII              | HAW.  | I-HI-1(I87)        | 1984        | 53       | 197          |

### CURVE DATA

| B-2 |             |            | M-2        |  |  | B-2A |  |  |
|-----|-------------|------------|------------|--|--|------|--|--|
| Δ   | 38° 06' 20" | 9° 51' 10" | 1° 51' 41" |  |  |      |  |  |
| R   | 4,000.00    | 2,450.00   | 1,231.19   |  |  |      |  |  |
| T   | 1,381.43    | 211.17     | 20.00      |  |  |      |  |  |
| Lc  | 2,660.27    | 421.31     | 40.00      |  |  |      |  |  |

| M-1B       |  |  |
|------------|--|--|
| 5° 11' 13" |  |  |
| 1,202.33   |  |  |
| 54.46      |  |  |
| 108.85     |  |  |

M.L. B STA. 23+00

Begin Ramp "M-1" Sta. 6+88.06  
"M-2" Sta. 6+94.55

Ramp M-2 Sta. 6+94  
Type 2 G.D.I. #38  
Inv. = 47.28

Abandon Existing Sprinkler System

R/W Line

R = 2,480.00'

355.04'  
102° 04' 53"  
100° 42' 40"  
Remove Existing  
Sprinkler System  
96° 53' 40"  
LP

B P.C. St. 23+72.15  
B P.O.C.  
Sta. 23+80  
40.01'  
B P.O.C.  
Sta. 23+80  
23 - 276° 53' 40"

RAMP "M-2"  
WEST BOUND

6  
5  
4  
3  
2  
1

B Sta. 23+50 W.B.  
Type 4 G.D.I. #20

B Sta. 23+50 W.B.  
Adjust Frame & Grates Type 4 Grated  
Drop Intake #20. See Sht No. 29D  
Estimated Quantities  
Adjust Frame & Grates 0.10 Ft. to 0.50 Ft = 4 Ea.

B Sta. 25+20 W.B.  
Adjust Frame & Grates Type 3 Grated  
Drop Intake #40. See Sht. No. 29D  
Estimated Quantities  
Adjust Frame & Grates 0.10 Ft. to 0.50 Ft = 3 Ea.

Ramp M-2 Sta. 6+94  
Construct: Type 2 Grated  
Drop Intake #38. See Sht. No. 21D  
Install: 24" CMP, Sht. "t" = 0.109"  
Estimated Quantities

Type 2 Grated Drop Intake  
5.00 Ft. to 5.90 Ft. = 1 Ea.  
24" CMP, Sht. "t" = 0.109" = 9 L.F.  
Salvage C.I. Frame & Cover = 1 Ea.  
Structure Excavation = 8.2 C.Y.

Scale: 1" = 20'  
TRUE NORTH  
"M-2" P.C. Sta. 2+41.03

RICHARD LANE

M.L. B STA. 29+00

53

|               |             |
|---------------|-------------|
| ORIGINAL PLAN | DRAWN BY    |
| NOTE BOOK     | TRACED BY   |
| QUOTED BY     | DESIGNED BY |
| CHECKED BY    |             |

STATE OF HAWAII  
DEPARTMENT OF TRANSPORTATION  
HIGHWAYS DIVISION  
**DRAINAGE AND SPRINKLER PLAN**  
INTERSTATE ROUTE H-I IMPROVEMENTS  
MIDDLE STREET TO KALIHI INTERCHANGE  
WESTBOUND LANES  
F.A.I. PROJ. NO. I-HI-1(I87)  
SCALE: 1" = 20'  
DATE: JUNE 1983  
SHEET No. 53 OF 30 SHEETS

53

## CURVE DATA

B-2


|    |             |
|----|-------------|
| Δ  | 38° 06' 20" |
| R  | 4,000.00    |
| T  | 1,381.43    |
| Lc | 2,660.27    |

| FED. ROAD DIST. NO. | STATE | FED. AID PROJ. NO. | FISCAL YEAR | SHEET NO. | TOTAL SHEETS |
|---------------------|-------|--------------------|-------------|-----------|--------------|
| HAWAII              | HAW.  | I-HI-1(187)        | 1984        | 54        | 197          |

M.L. B STA. 29+00

TRUE NORTH Scale:  $\frac{1}{11} = 20'$ 

M.L. B STA. 35+00

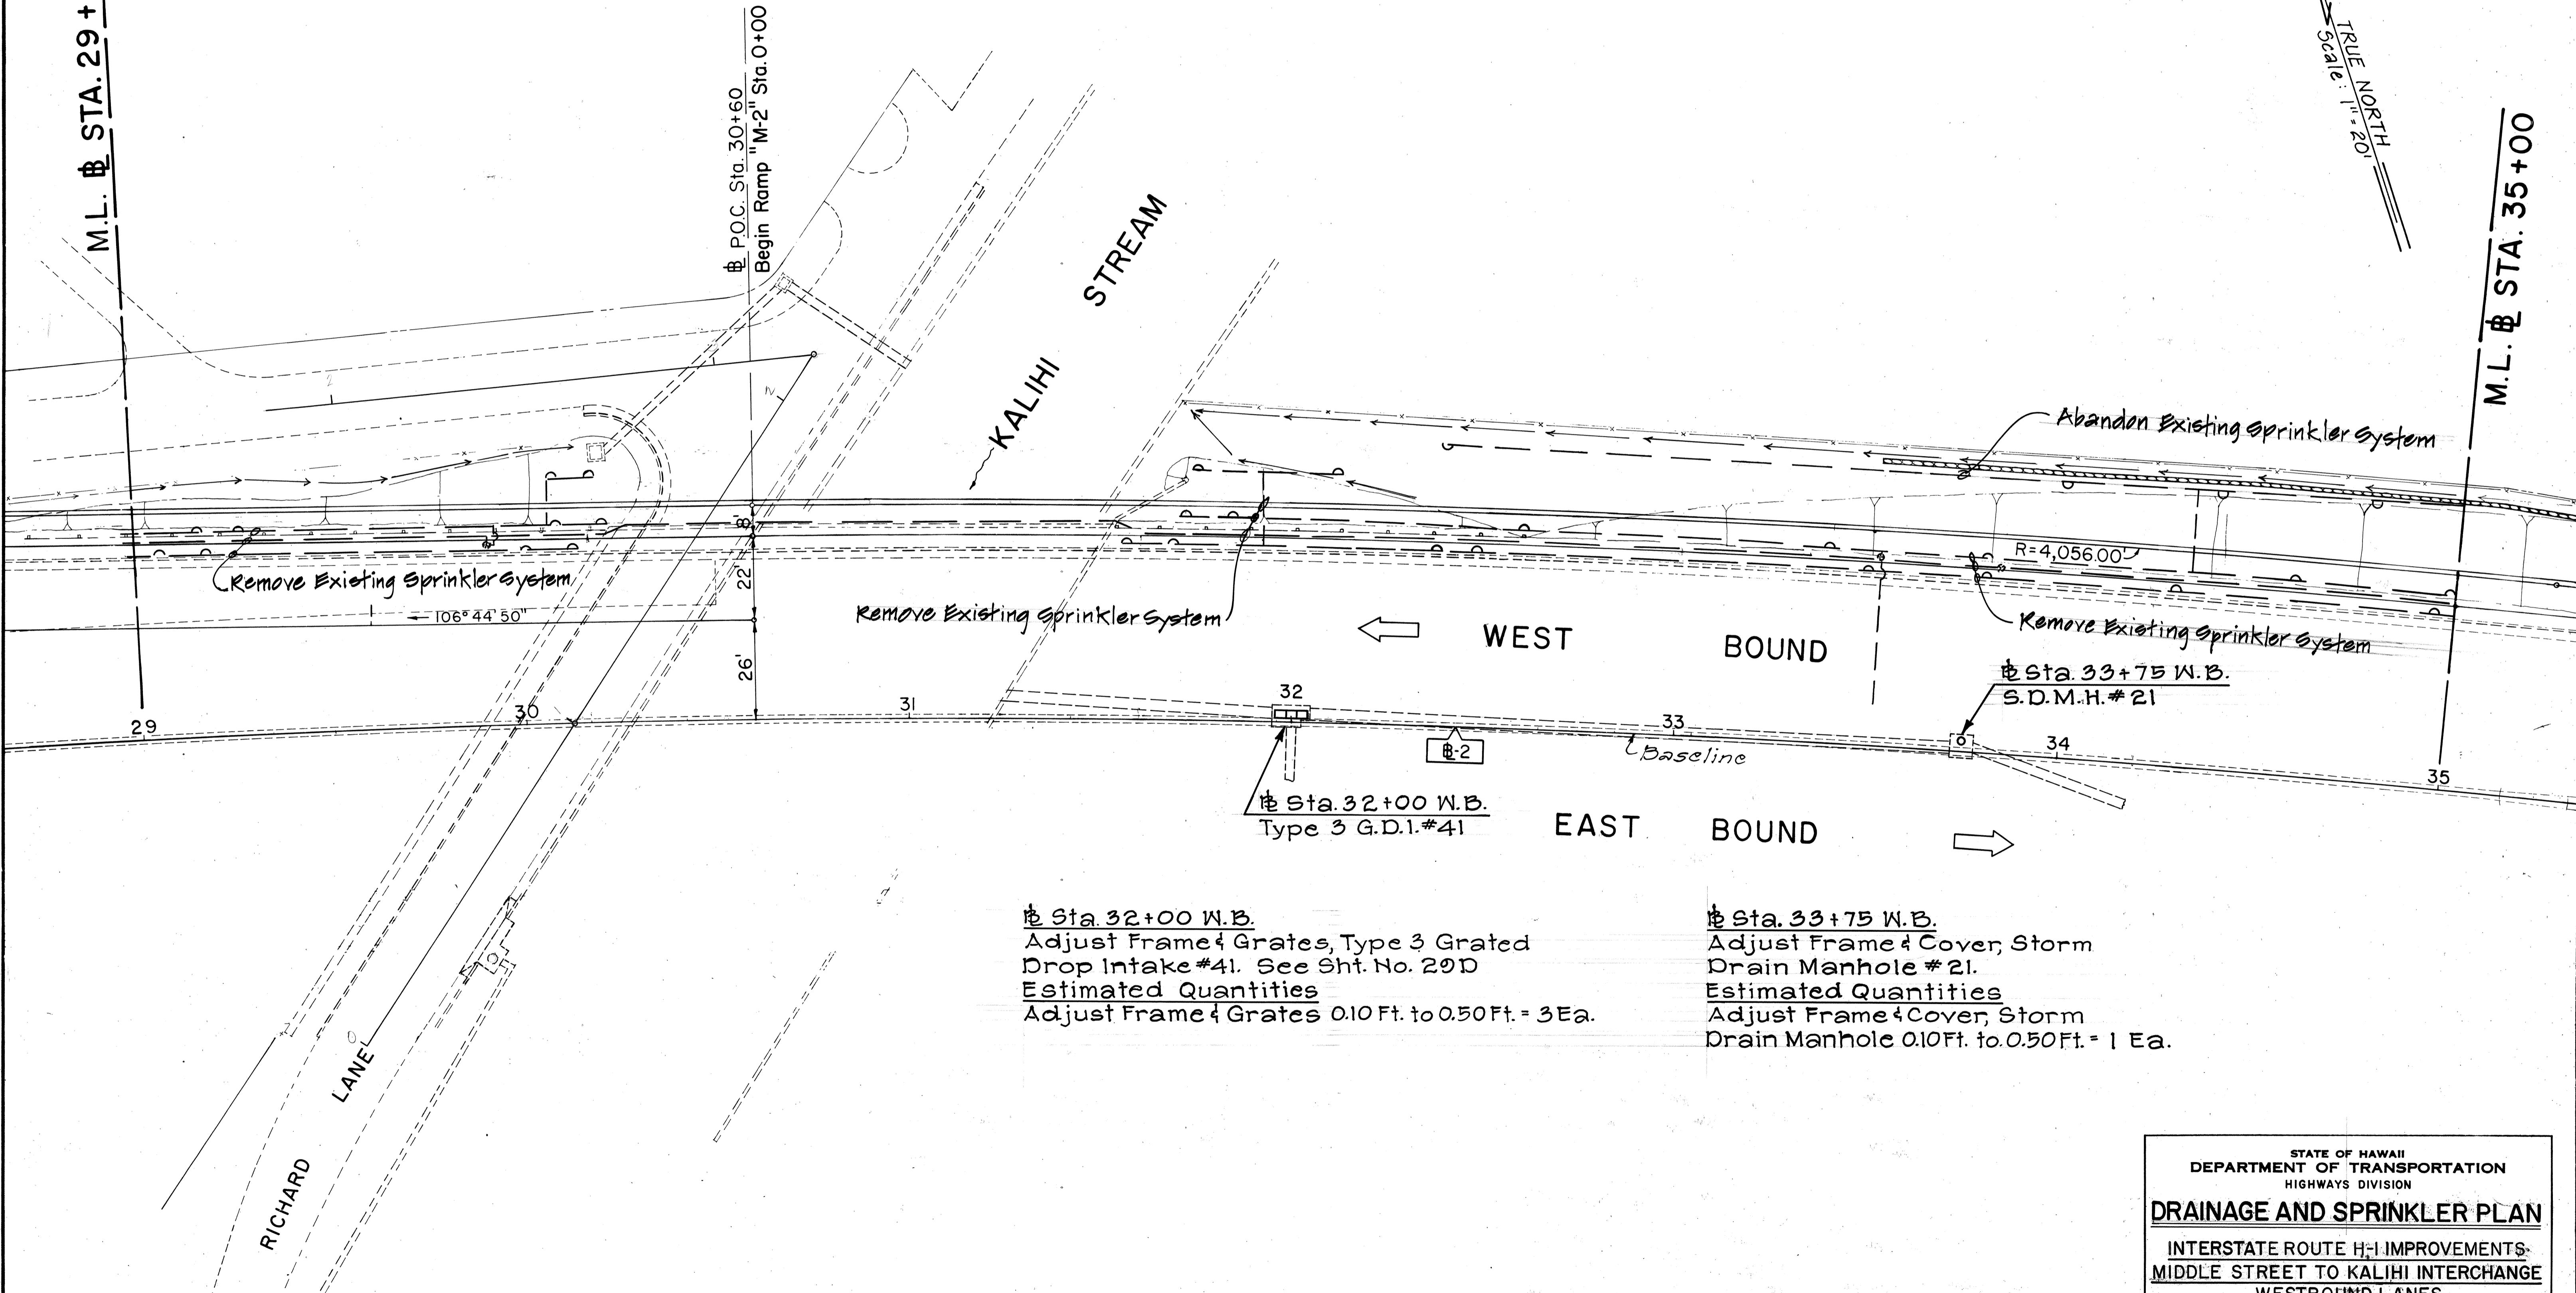

STATE OF HAWAII  
DEPARTMENT OF TRANSPORTATION  
HIGHWAYS DIVISION  
**DRAINAGE AND SPRINKLER PLAN**  
INTERSTATE ROUTE H-I IMPROVEMENTS  
MIDDLE STREET TO KALIHI INTERCHANGE  
WESTBOUND LANES  
F.A.I. PROJ. NO. I-HI-1(187)  
SCALE: 1" = 20'  
DATE: JUNE 1983  
SHEET NO. 60 OF 30 SHEETS

Sta. 35+50 W.B. to Sta. 41+01 W.B.Lt. (Ramp K1 Sta. 2+28)

Install: Underdrain. For details See Sht. No. 301D

Estimated Quantities

Structural Exc.

Filter Fabric

Filter Material for Underdrains

12-Inch Perforated Underdrain Pipe

12-Inch Non-Perforated Underdrain Pipe

Cleanout

Connection to G.D.I.

= 260 C.Y.

= 220 S.Y.

= 116 C.Y.

= 600 L.F.

= 144 L.F.

= 5 Ea.

= 2 Ea.

|    |             |
|----|-------------|
| Δ  | 38° 06' 20" |
| R  | 4,000.00    |
| T  | 1,381.43    |
| Lc | 2,660.27    |

**CURVE DATA**

| B-2F       | B-2G       | B-2H       |
|------------|------------|------------|
| 5° 47' 26" | 4° 36' 57" | 1° 52' 59" |
| 197.73     | 248.13     | 608.49     |
| 10.00      | 10.00      | 10.00      |
| 19.98      | 19.99      | 20.00      |

| FED. ROAD DIST. NO. | STATE | FED. AID PROJ. NO. | FISCAL YEAR | SHEET NO. | TOTAL SHEETS |
|---------------------|-------|--------------------|-------------|-----------|--------------|
| HAWAII              | HAW.  | I-HI-1(87)         | 1984        | 55        | 197          |


TRUE NORTH  
Scale: 1" = 20'

Sta. 41+00 W.B. Lt.  
45° El. Inv. 60.89

Sta. 40+95 W.B. Lt.  
45° El. Inv. 56.81

Sta. 40+45 W.B. Lt.  
Cleanout

Sta. 41+00 W.B.  
Type 3 G.D.I. #41

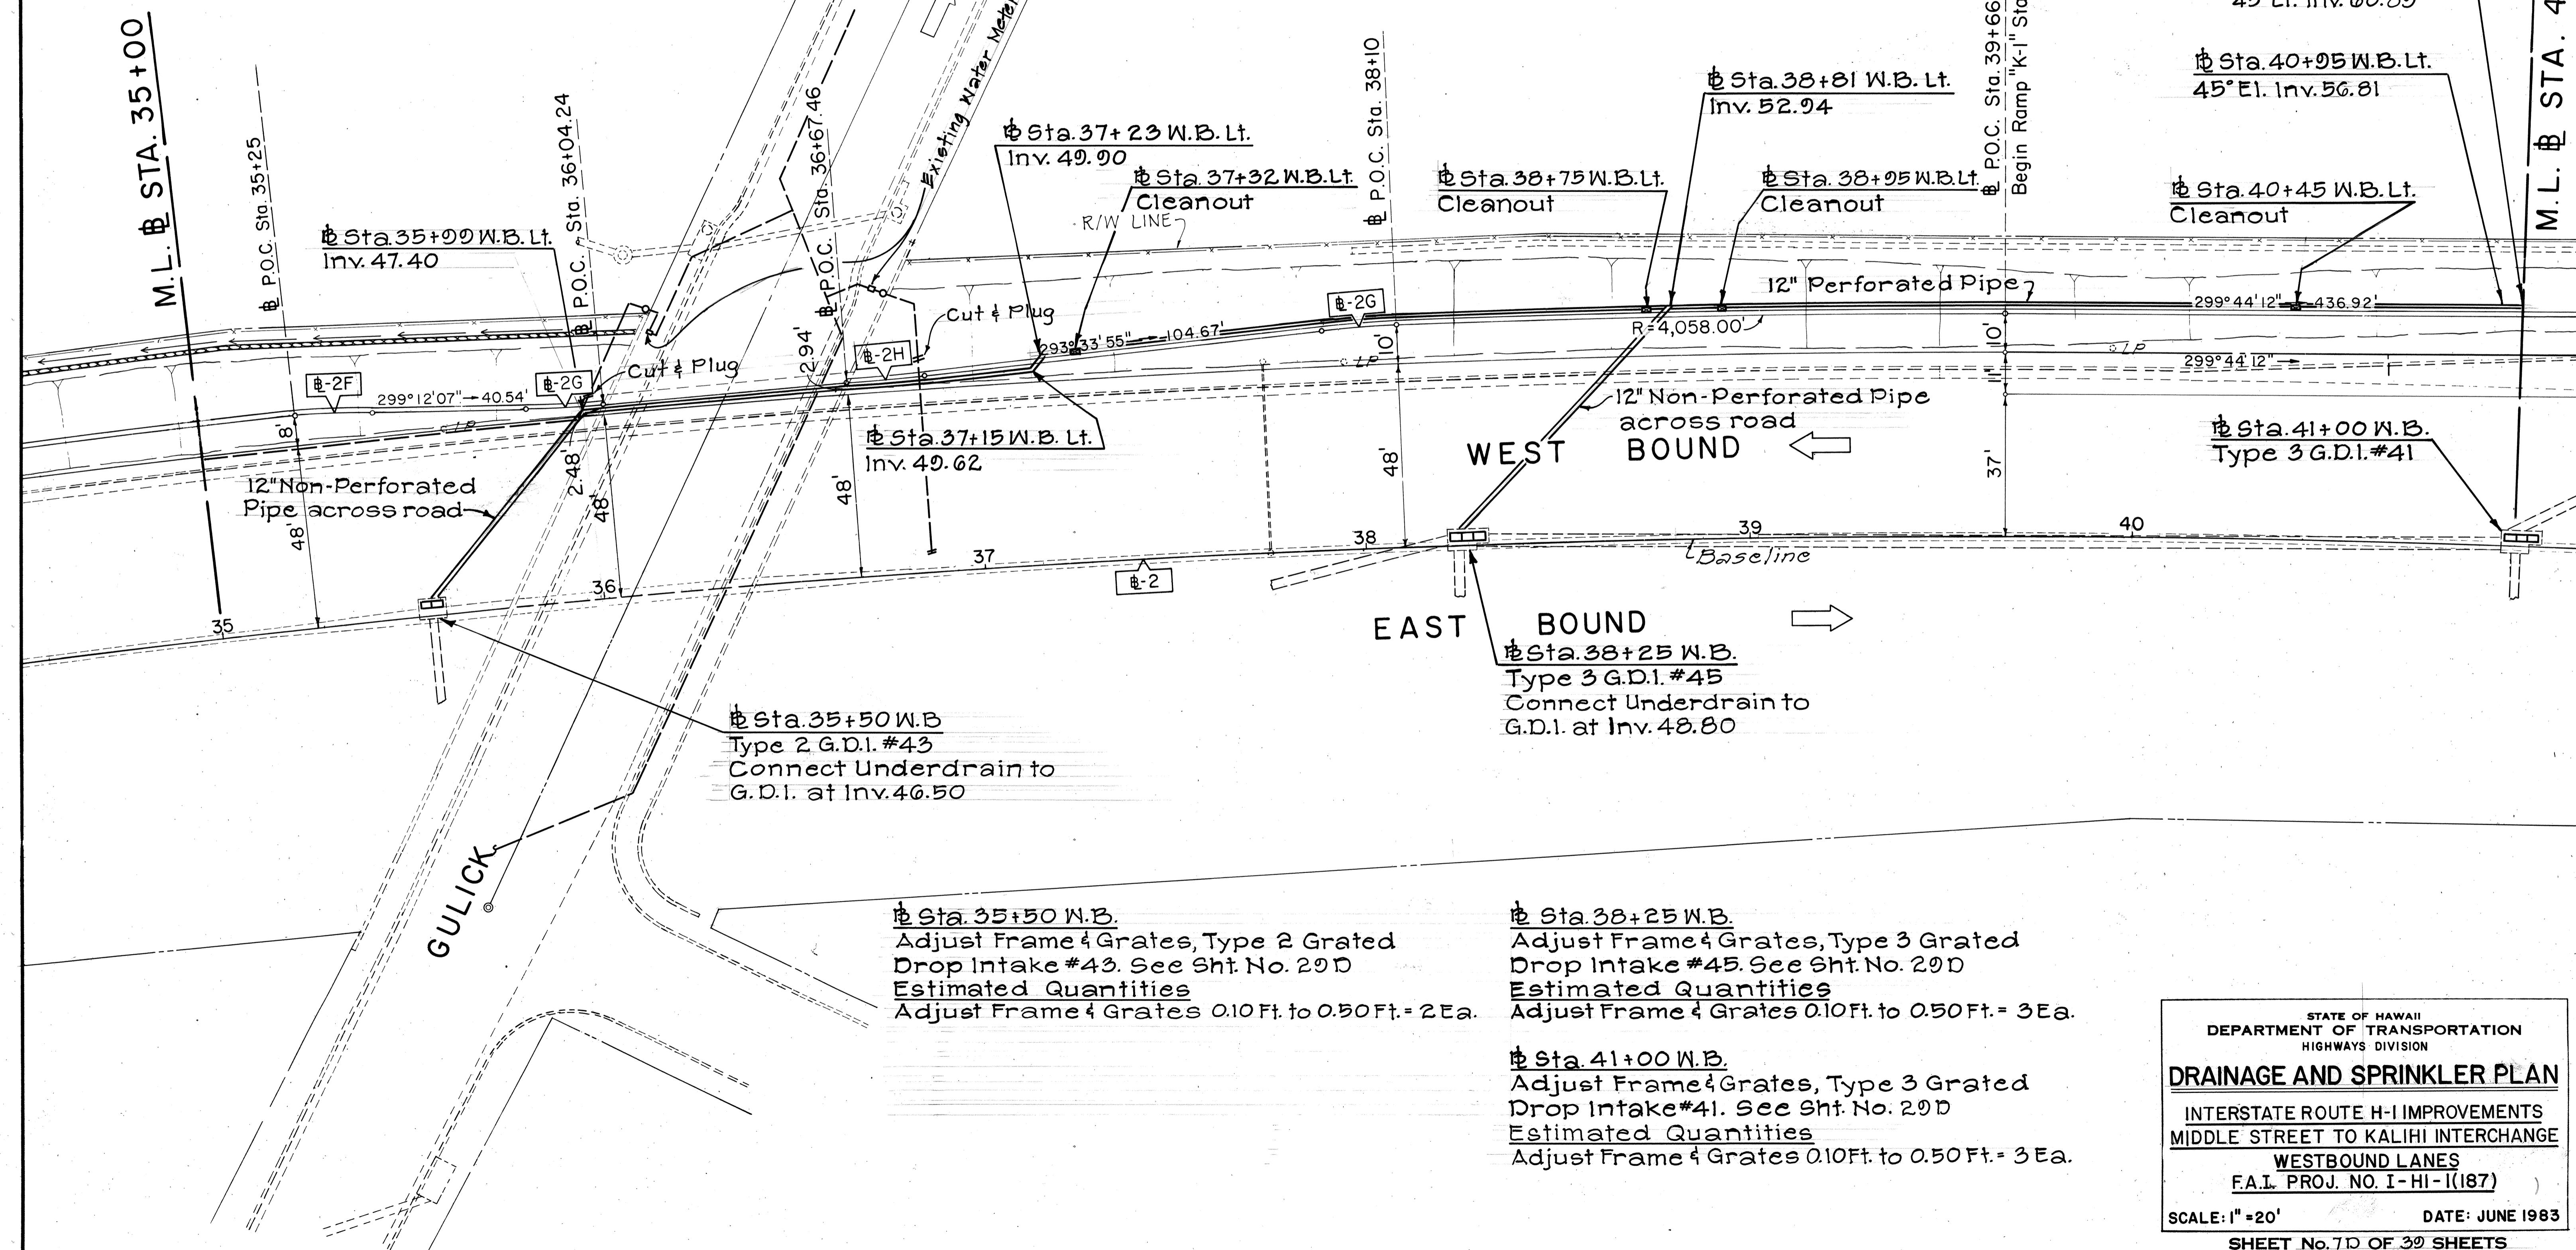

STATE OF HAWAII  
DEPARTMENT OF TRANSPORTATION  
HIGHWAYS DIVISION

**DRAINAGE AND SPRINKLER PLAN**

INTERSTATE ROUTE H-I IMPROVEMENTS  
MIDDLE STREET TO KALIHI INTERCHANGE

WESTBOUND LANES

F.A.I. PROJ. NO. I-HI-1(187)


SCALE: 1" = 20' DATE: JUNE 1983

SHEET NO. 7D OF 39 SHEETS

| FED. ROAD DIST. NO. | STATE | FED. AID PROJ. NO. | FISCAL YEAR | SHEET NO. | TOTAL SHEETS |
|---------------------|-------|--------------------|-------------|-----------|--------------|
| HAWAII              | HAW.  | I-HI-1(I87)        | 1984        | 56        | 191          |

### CURVE DATA

| B-2                | K-1       | K-IA      | K-IB      |
|--------------------|-----------|-----------|-----------|
| $\Delta$ 38°06'20" | 23°40'48" | 23°40'48" | 23°40'48" |
| R 4,000.00         | 750.00    | 652.98    | 728.35    |
| T 1,381.43         | 157.23    | 136.89    | 152.69    |
| Lc 2,660.27        | 309.97    | 269.87    | 301.02    |

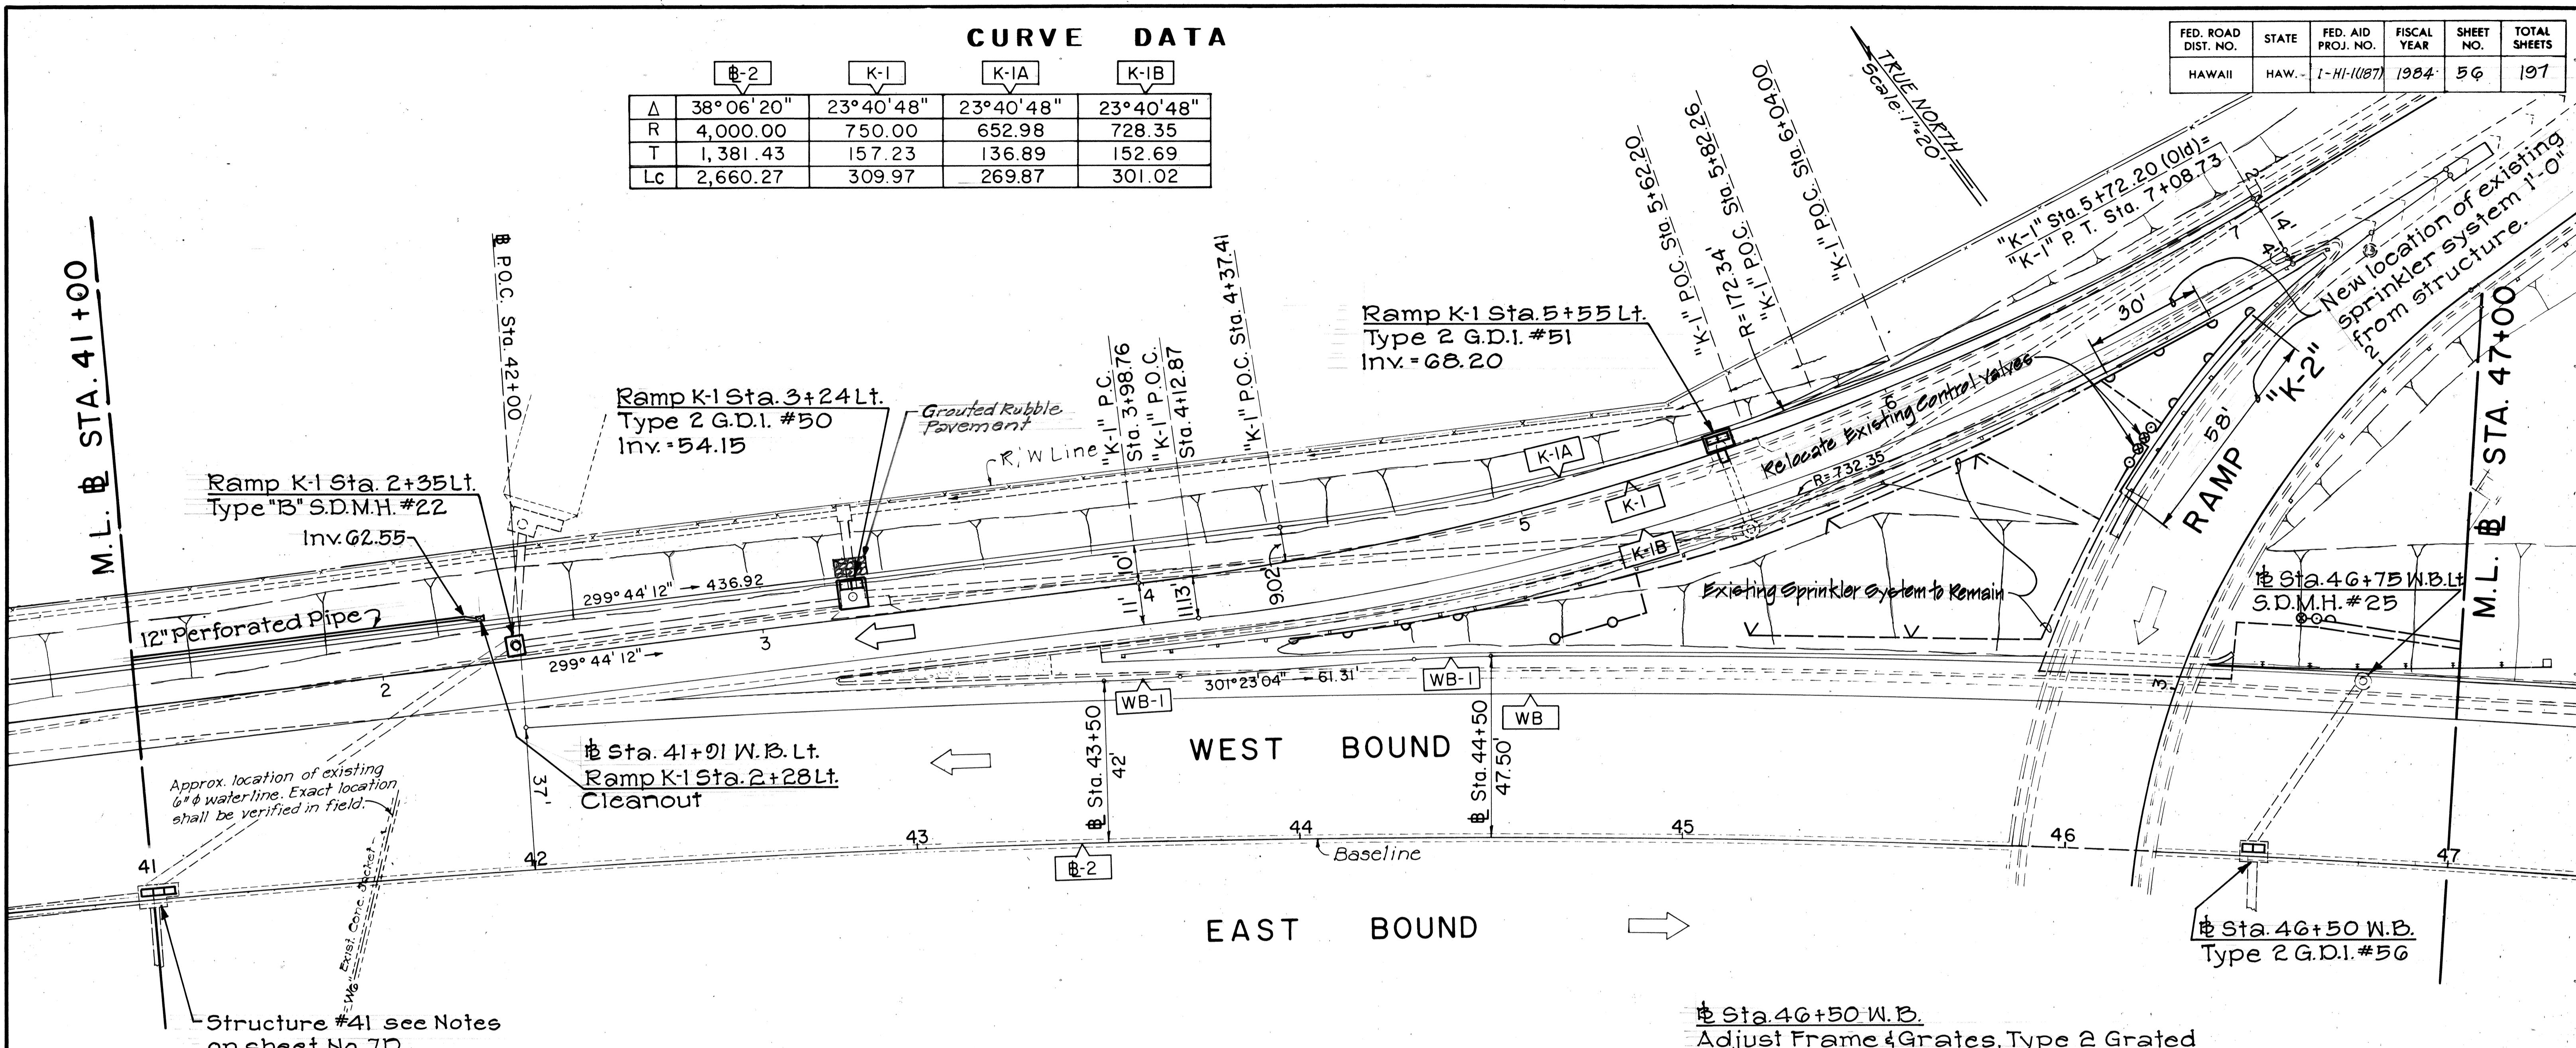

Ramp K-1 Sta. 2+35 L.t.  
Reconstruct: Type "B" Storm Drain  
Manhole #22. See Sht. No. 15D  
Estimated Quantities  
Reconstruct Type "B" Storm Drain  
Manhole 1.00Ft. to 1.00Ft. = 1 Ea.

Ramp K-1 Sta. 3+24 L.t.  
Construct: Type 2 Grated Drop  
Intake #50. See Sht. No. 26D  
Estimated Quantities  
Type 2 Grated Drop Intake  
8.00 Ft. to 8.99 Ft. = 1 Ea.  
Salvage C.I. Frame & Cover = 1 Ea.

Ramp K-1 Sta. 5+55 L.t.  
Construct: Type 2 Grated Drop  
Intake #51. See Sht. No. 27D  
Install: 24" CMP, Sht. "t" = 0.10"  
Estimated Quantities  
Type 2 Grated Drop Intake  
3.00 Ft. to 3.99 Ft. = 1 Ea.  
24" CMP, Sht. "t" = 0.10" = 3 L.F.  
Salvage C.I. Frame & Cover = 1 Ea.

WB Sta. 46+50 W.B.  
Adjust Frame & Grates, Type 2 Grated  
Drop Intake #50. See Sht. No. 29D  
Estimated Quantities  
Adjust Frame & Grate 0.10 Ft. to 0.50 Ft. = 2 Ea.

WB Sta. 46+75 W.B. Lt.  
Adjust Frame & Cover, Storm Drain  
Manhole #25  
Estimated Quantities  
Adjust Frame & Cover, Storm Drain  
Manhole 0.10 Ft. to 0.50 Ft. = 1 Ea.

STATE OF HAWAII  
DEPARTMENT OF TRANSPORTATION  
HIGHWAYS DIVISION  
**DRAINAGE AND SPRINKLER PLAN**  
INTERSTATE ROUTE H-I IMPROVEMENTS  
MIDDLE STREET TO KALIHI INTERCHANGE  
WESTBOUND LANES  
F.A.I. PROJ. NO. I-HI-1(I87)  
SCALE: 1" = 20'  
DATE: JUNE 1983  
SHEET No. 8D OF 39 SHEETS


**CURVE DATA**

| B-2 |             |
|-----|-------------|
| Δ   | 38° 06' 20" |
| R   | 4,000.00    |
| T   | 1,381.43    |
| Lc  | 2,660.27    |



| WB          |  |
|-------------|--|
| II° 55' 25" |  |
| 4,268.78    |  |
| 445.78      |  |
| 888.36      |  |

| FED. ROAD DIST. NO. | STATE | FED. AID PROJ. NO. | FISCAL YEAR | SHEET NO. | TOTAL SHEETS |
|---------------------|-------|--------------------|-------------|-----------|--------------|
| HAWAII              | HAW.  | I-HI-1(187)        | 1984        | 57        | 101          |

M.L. STA. 47+00

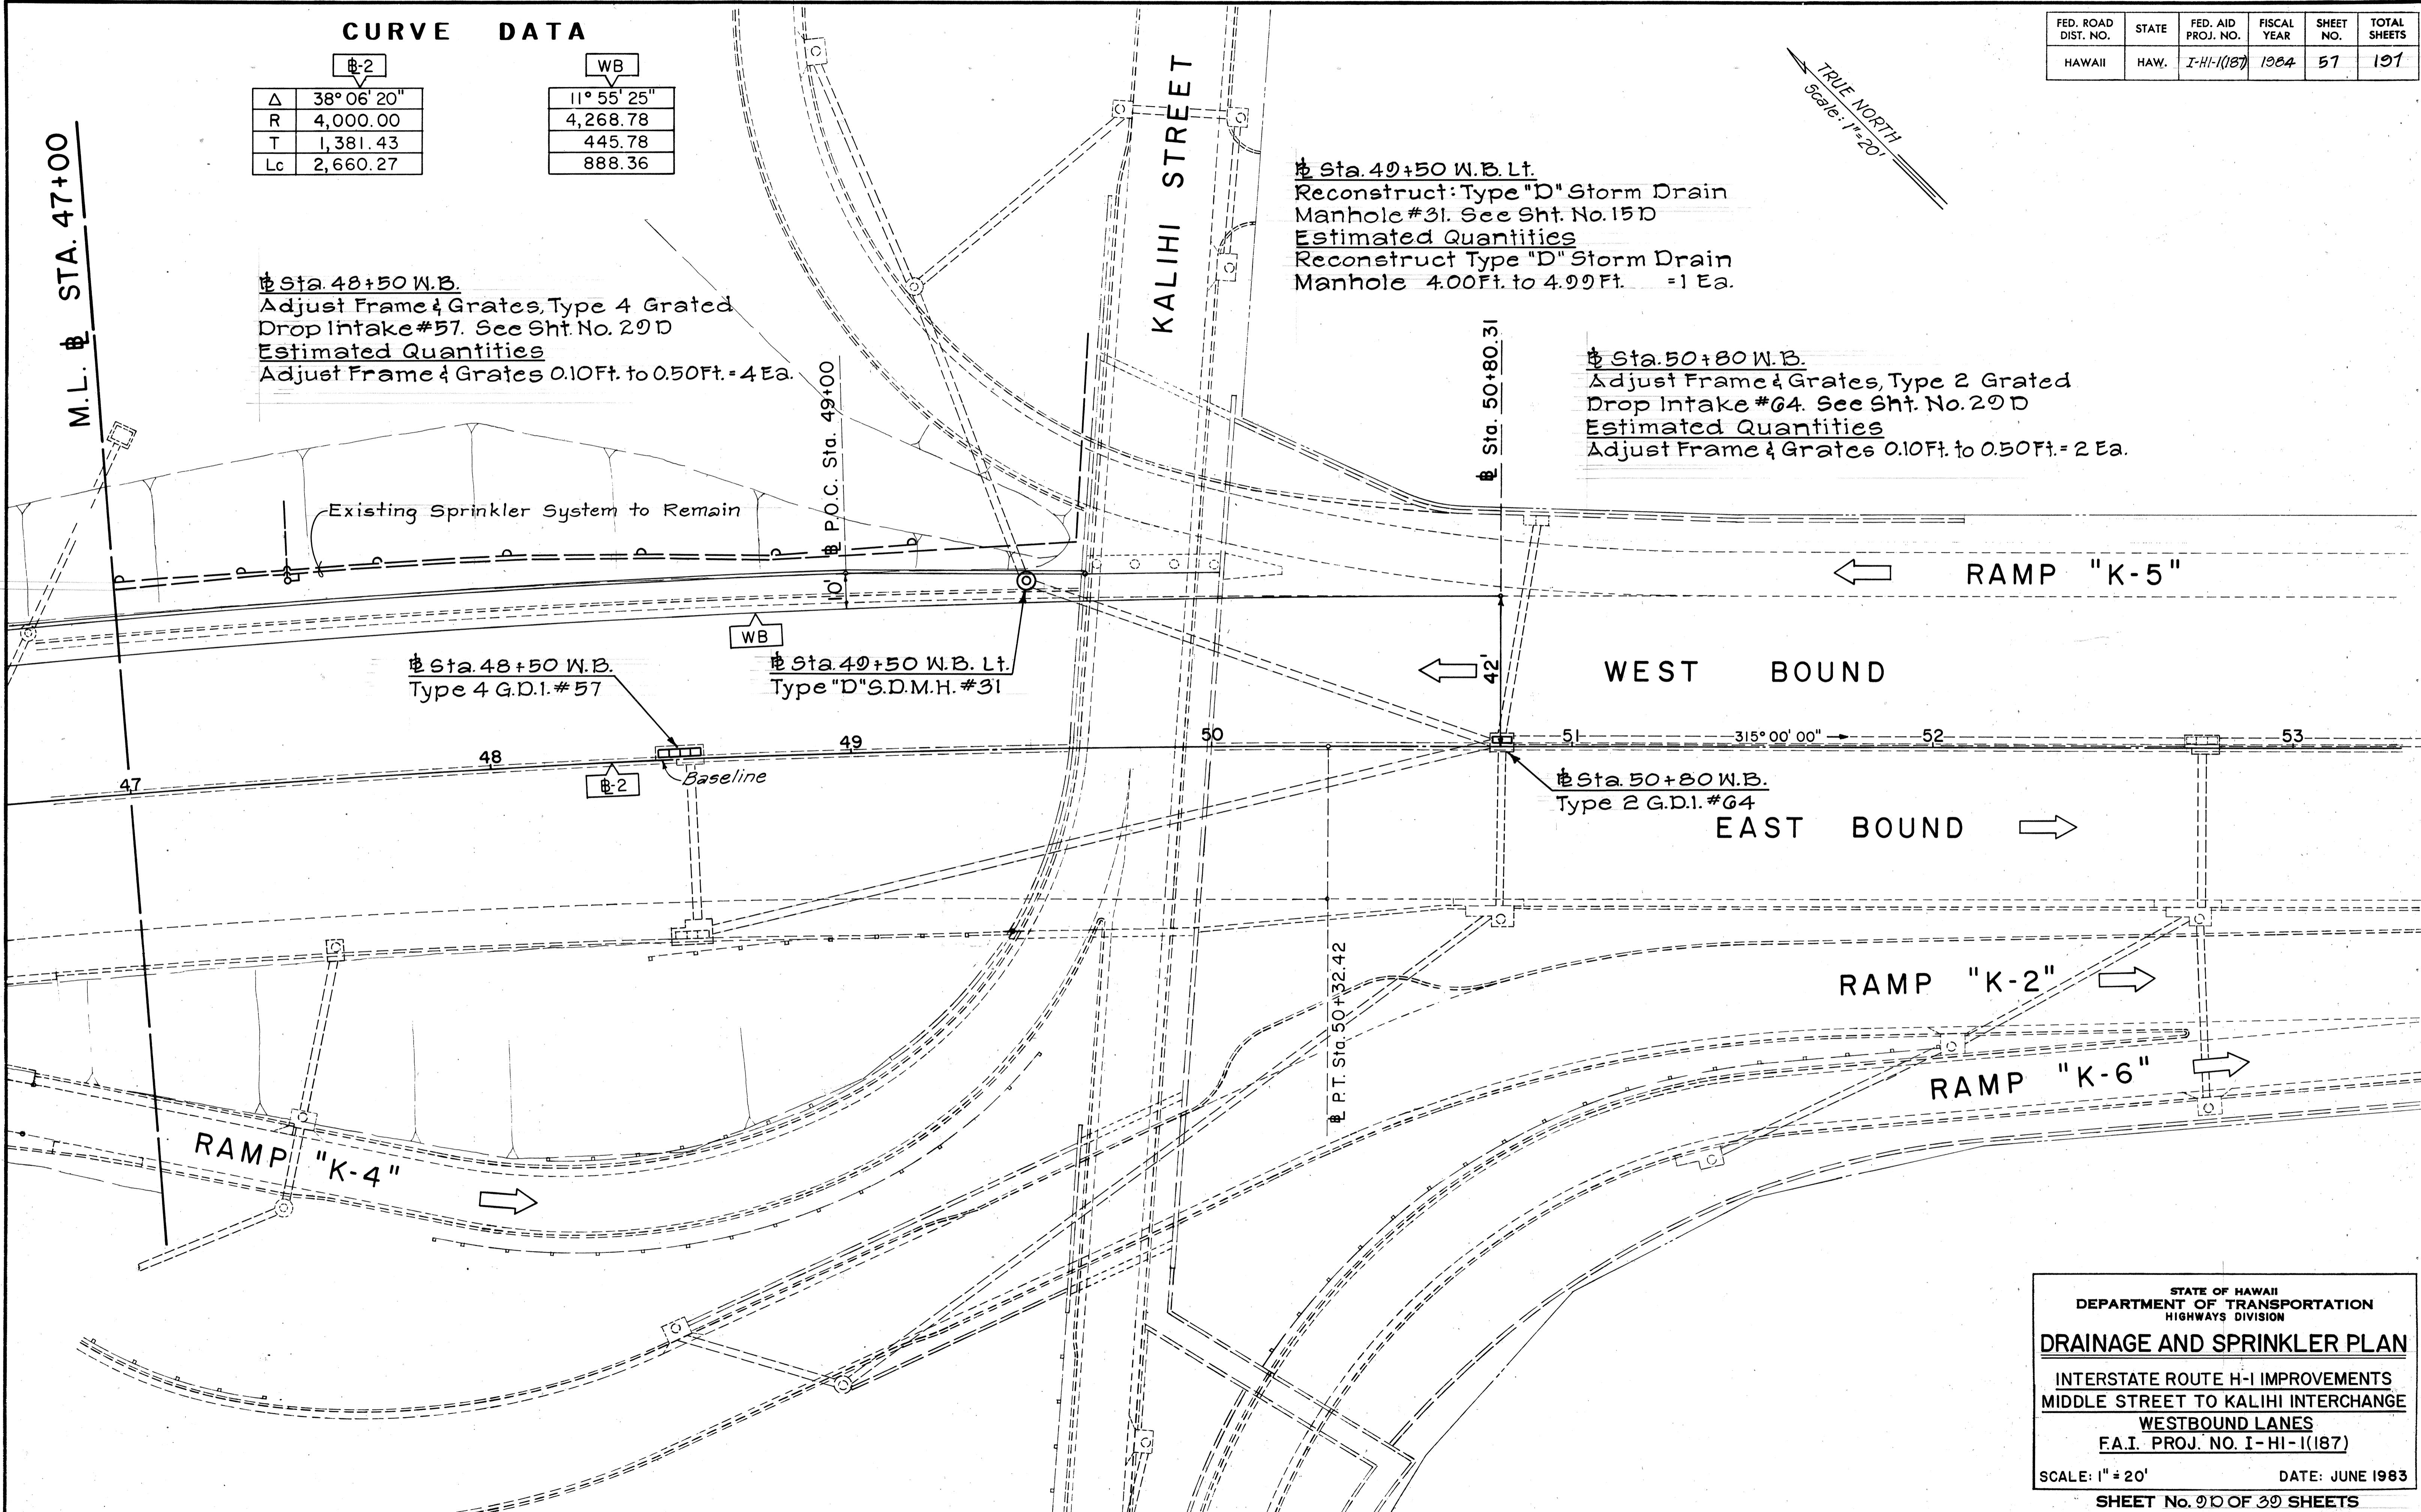


| FED. ROAD DIST. NO. | STATE | FED. AID PROJ. NO. | FISCAL YEAR | SHEET NO. | TOTAL SHEETS |
|---------------------|-------|--------------------|-------------|-----------|--------------|
| HAWAII              | HAW.  | I-HI-1(187)        | 1984        | 58        | 101          |

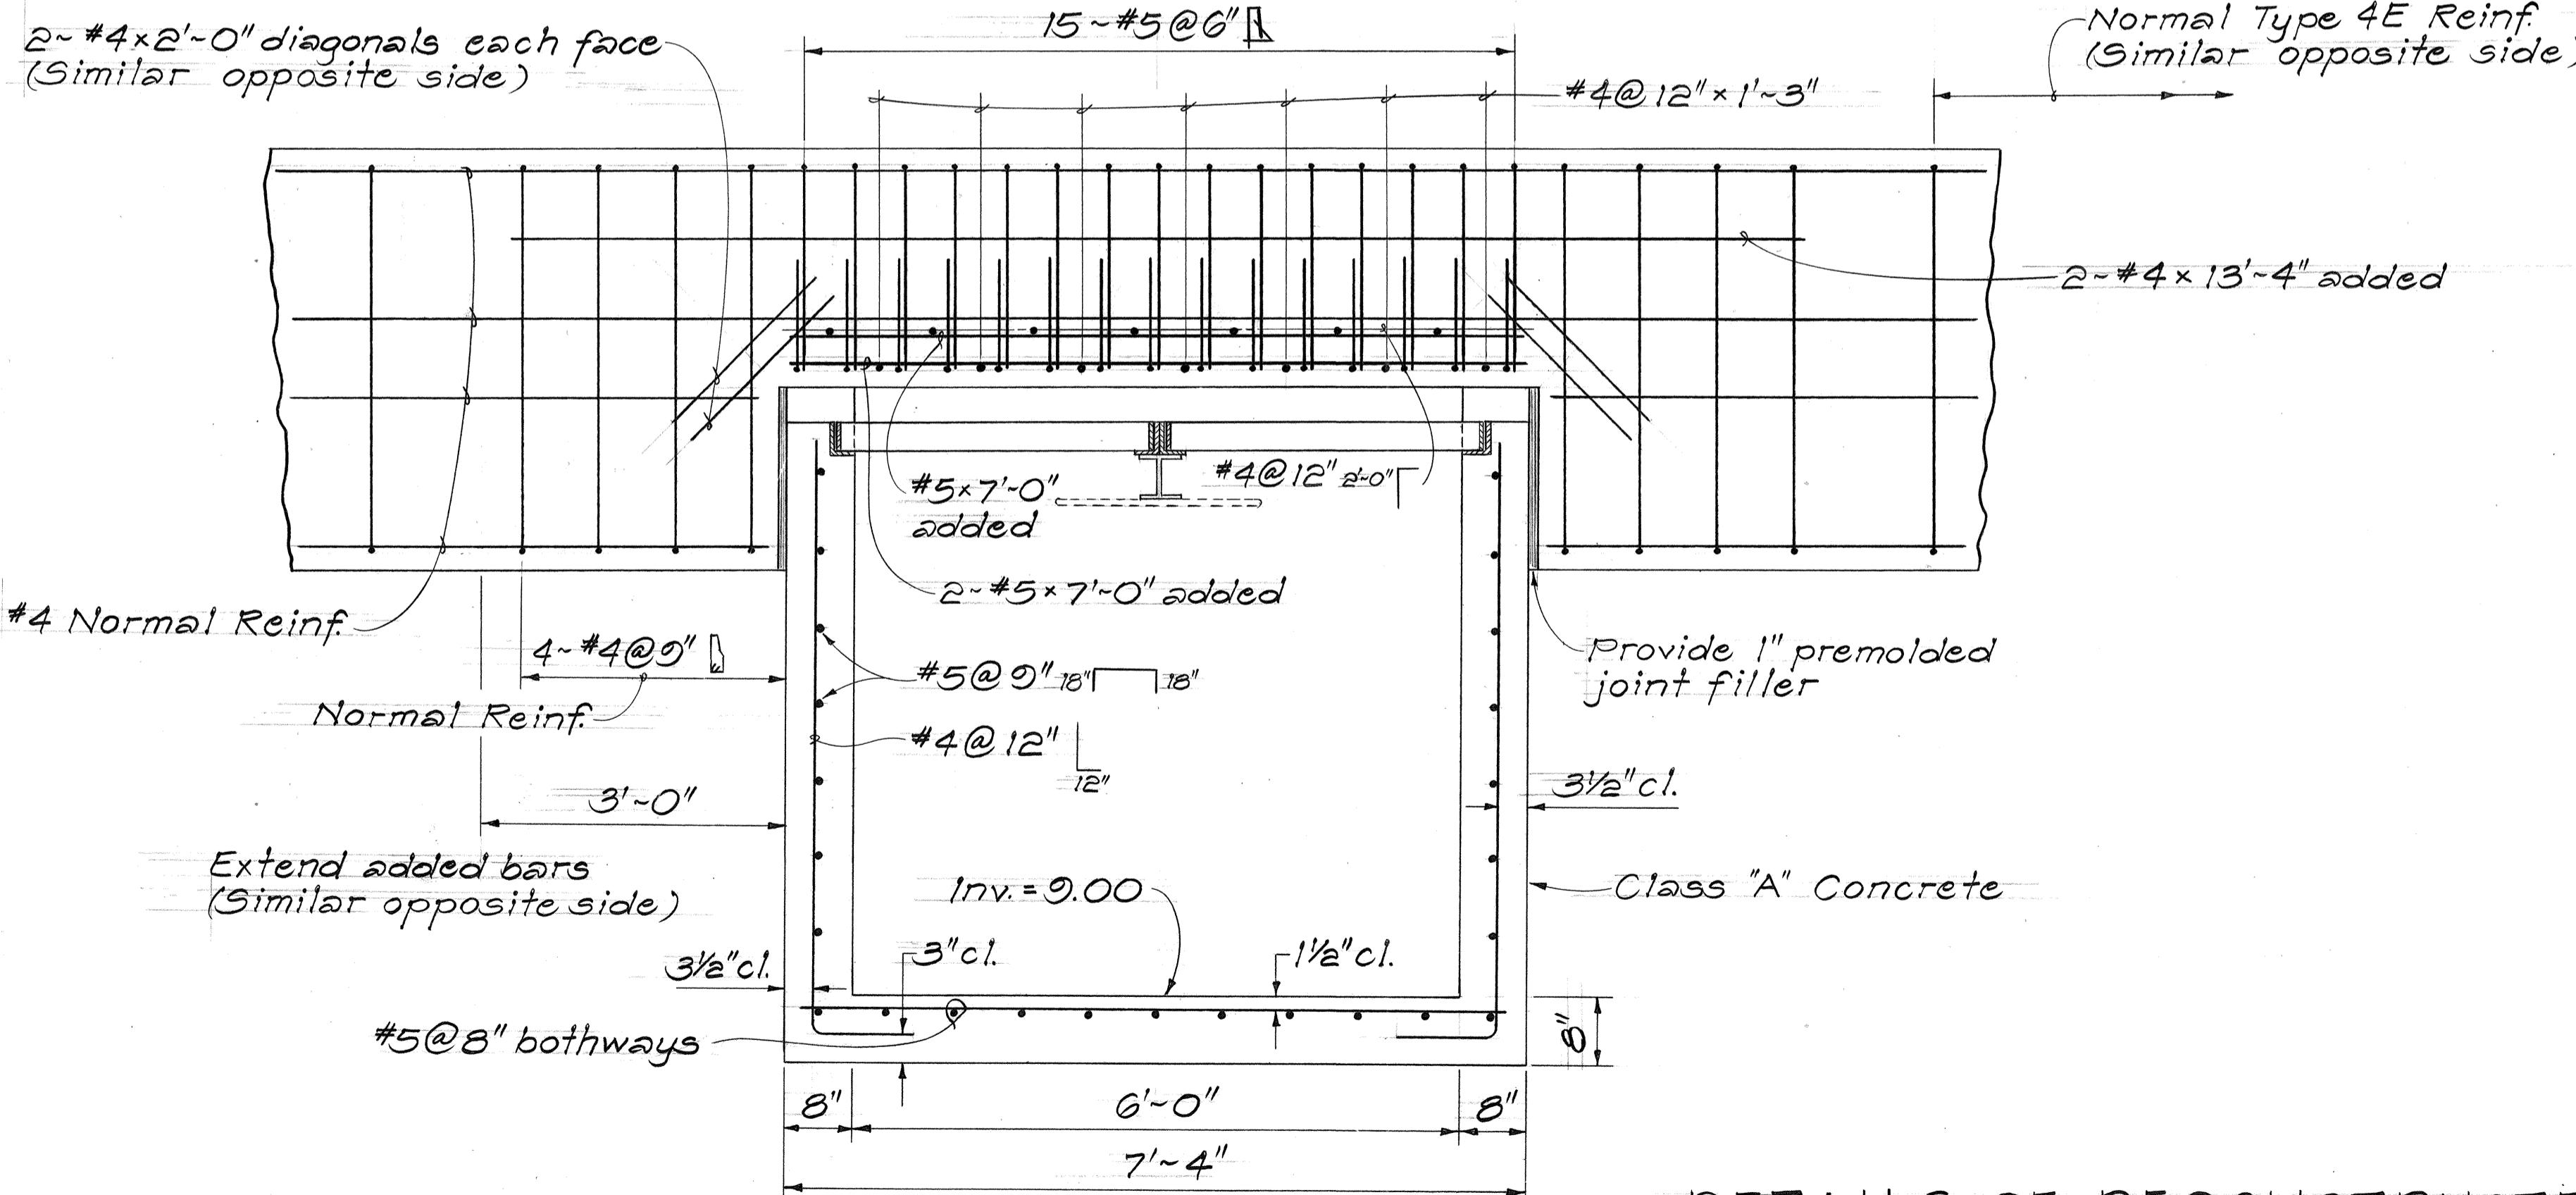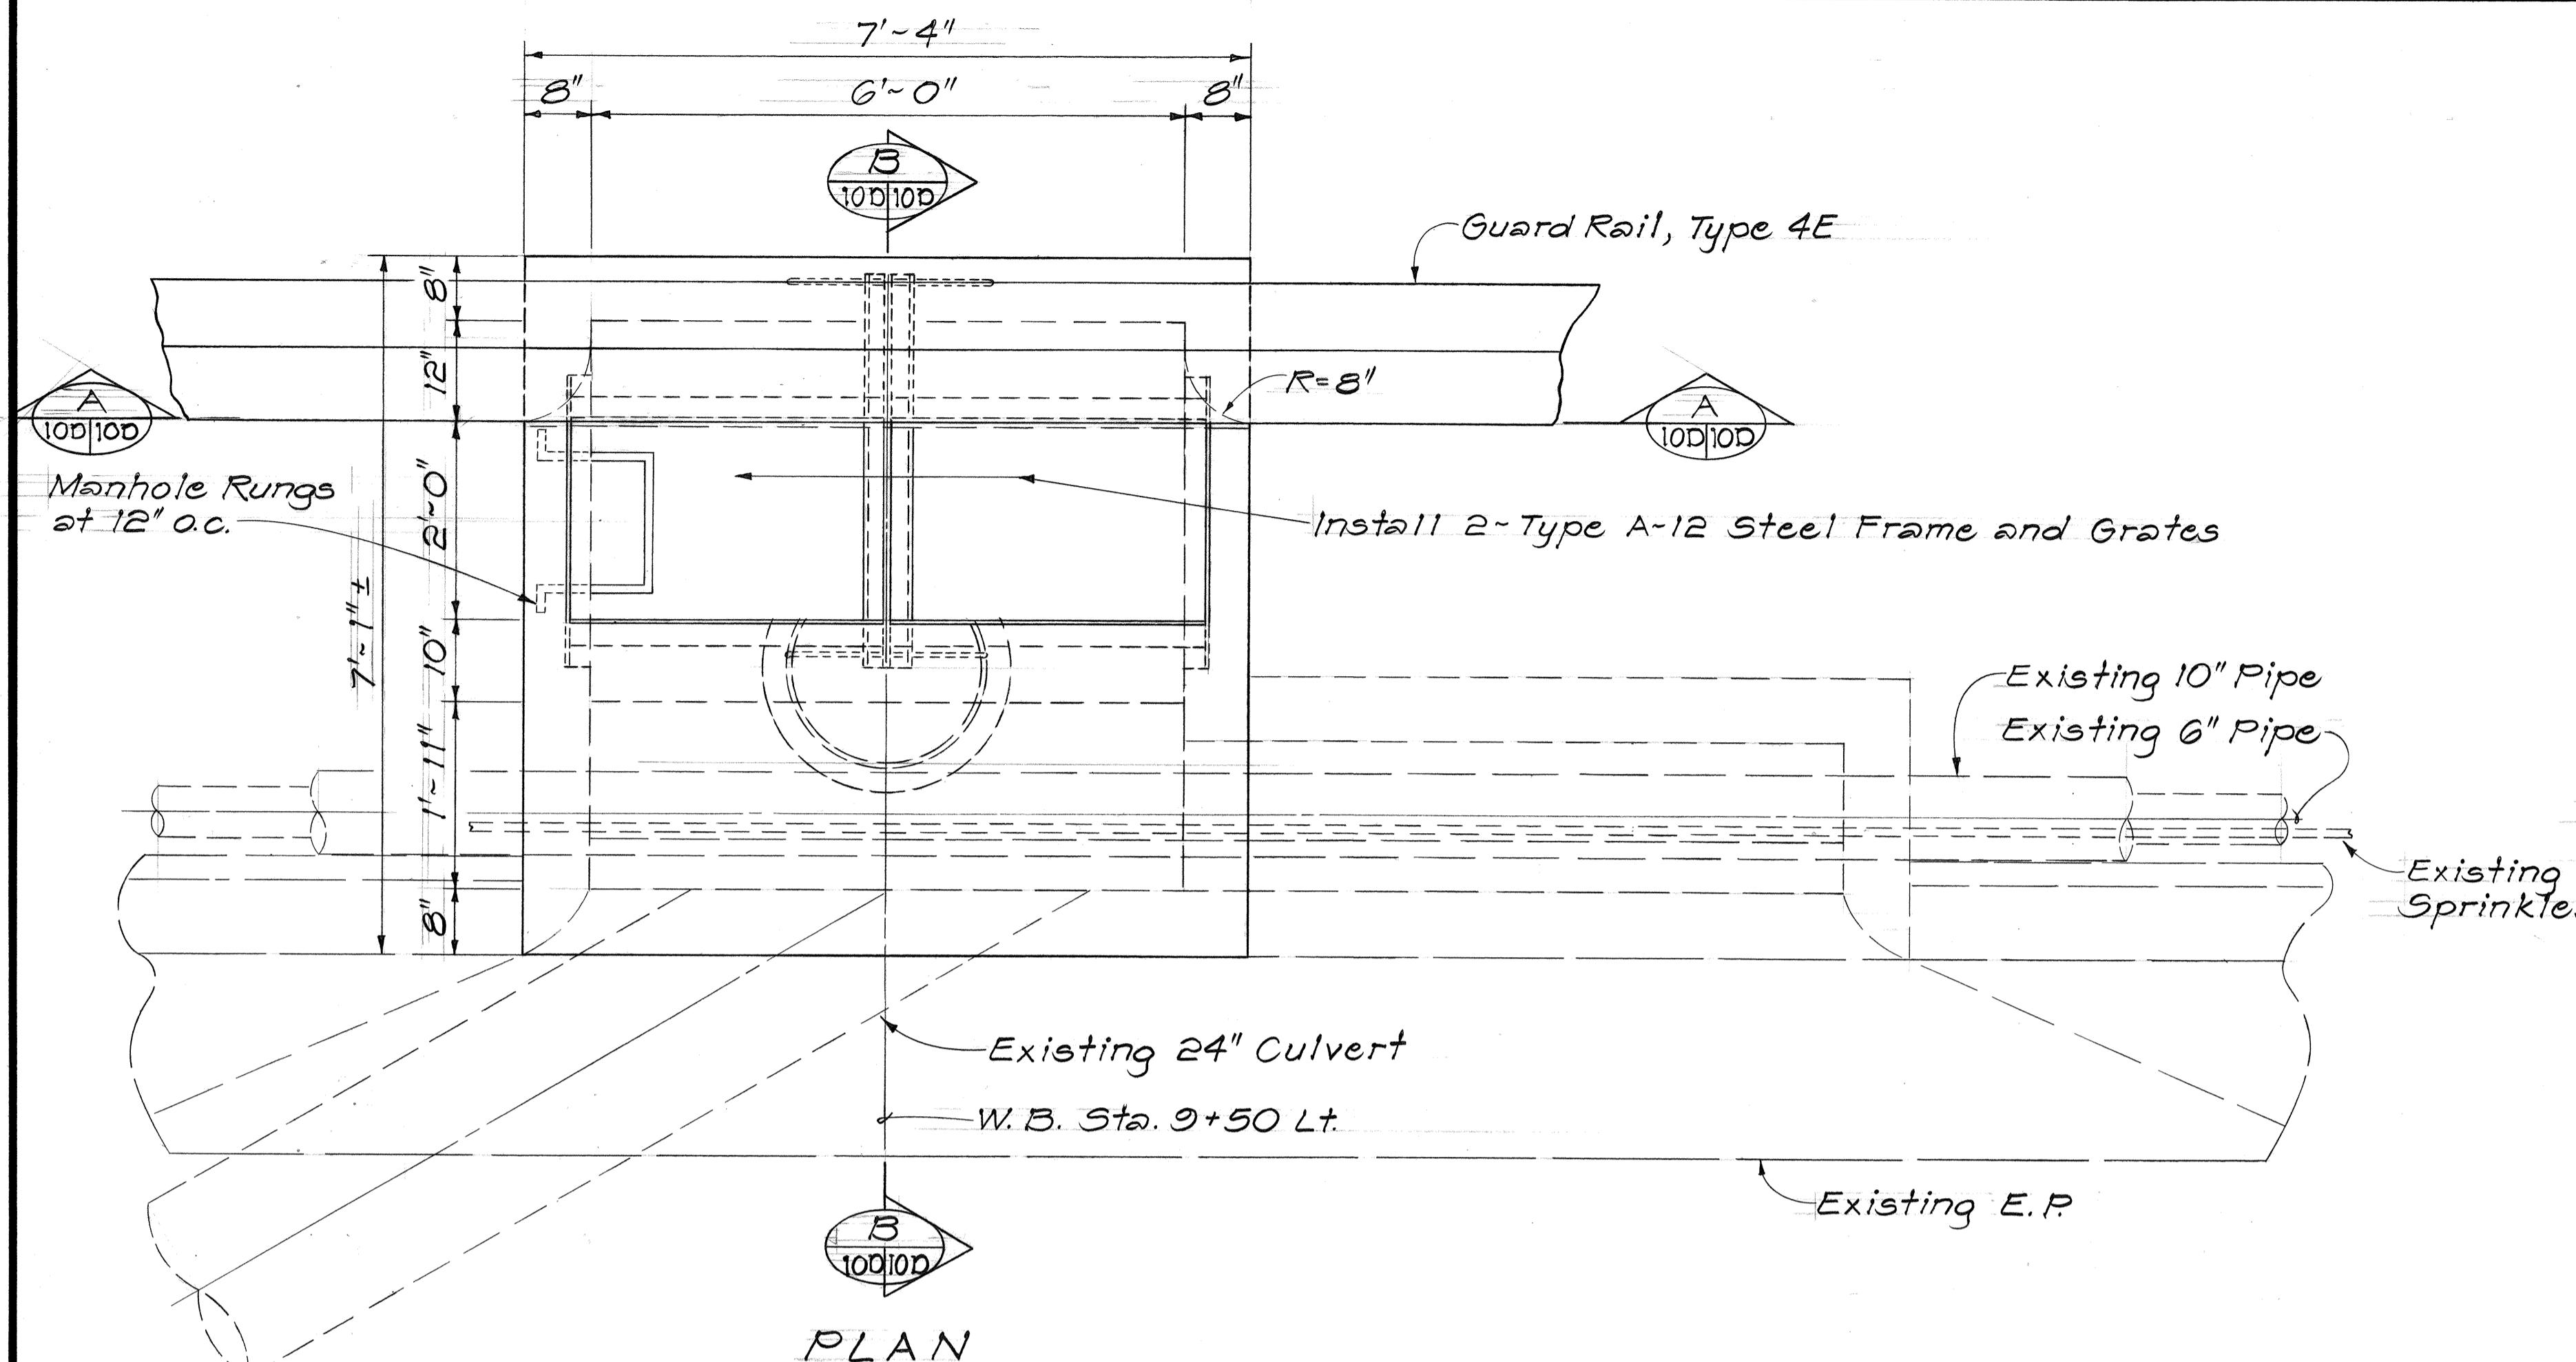



DETAILS OF RECONSTRUCTED TYPE 2/C.O. G.D.I.#17  
AT W.B. STA. 9+50 LT.

Scale: 3/4" = 1'-0"

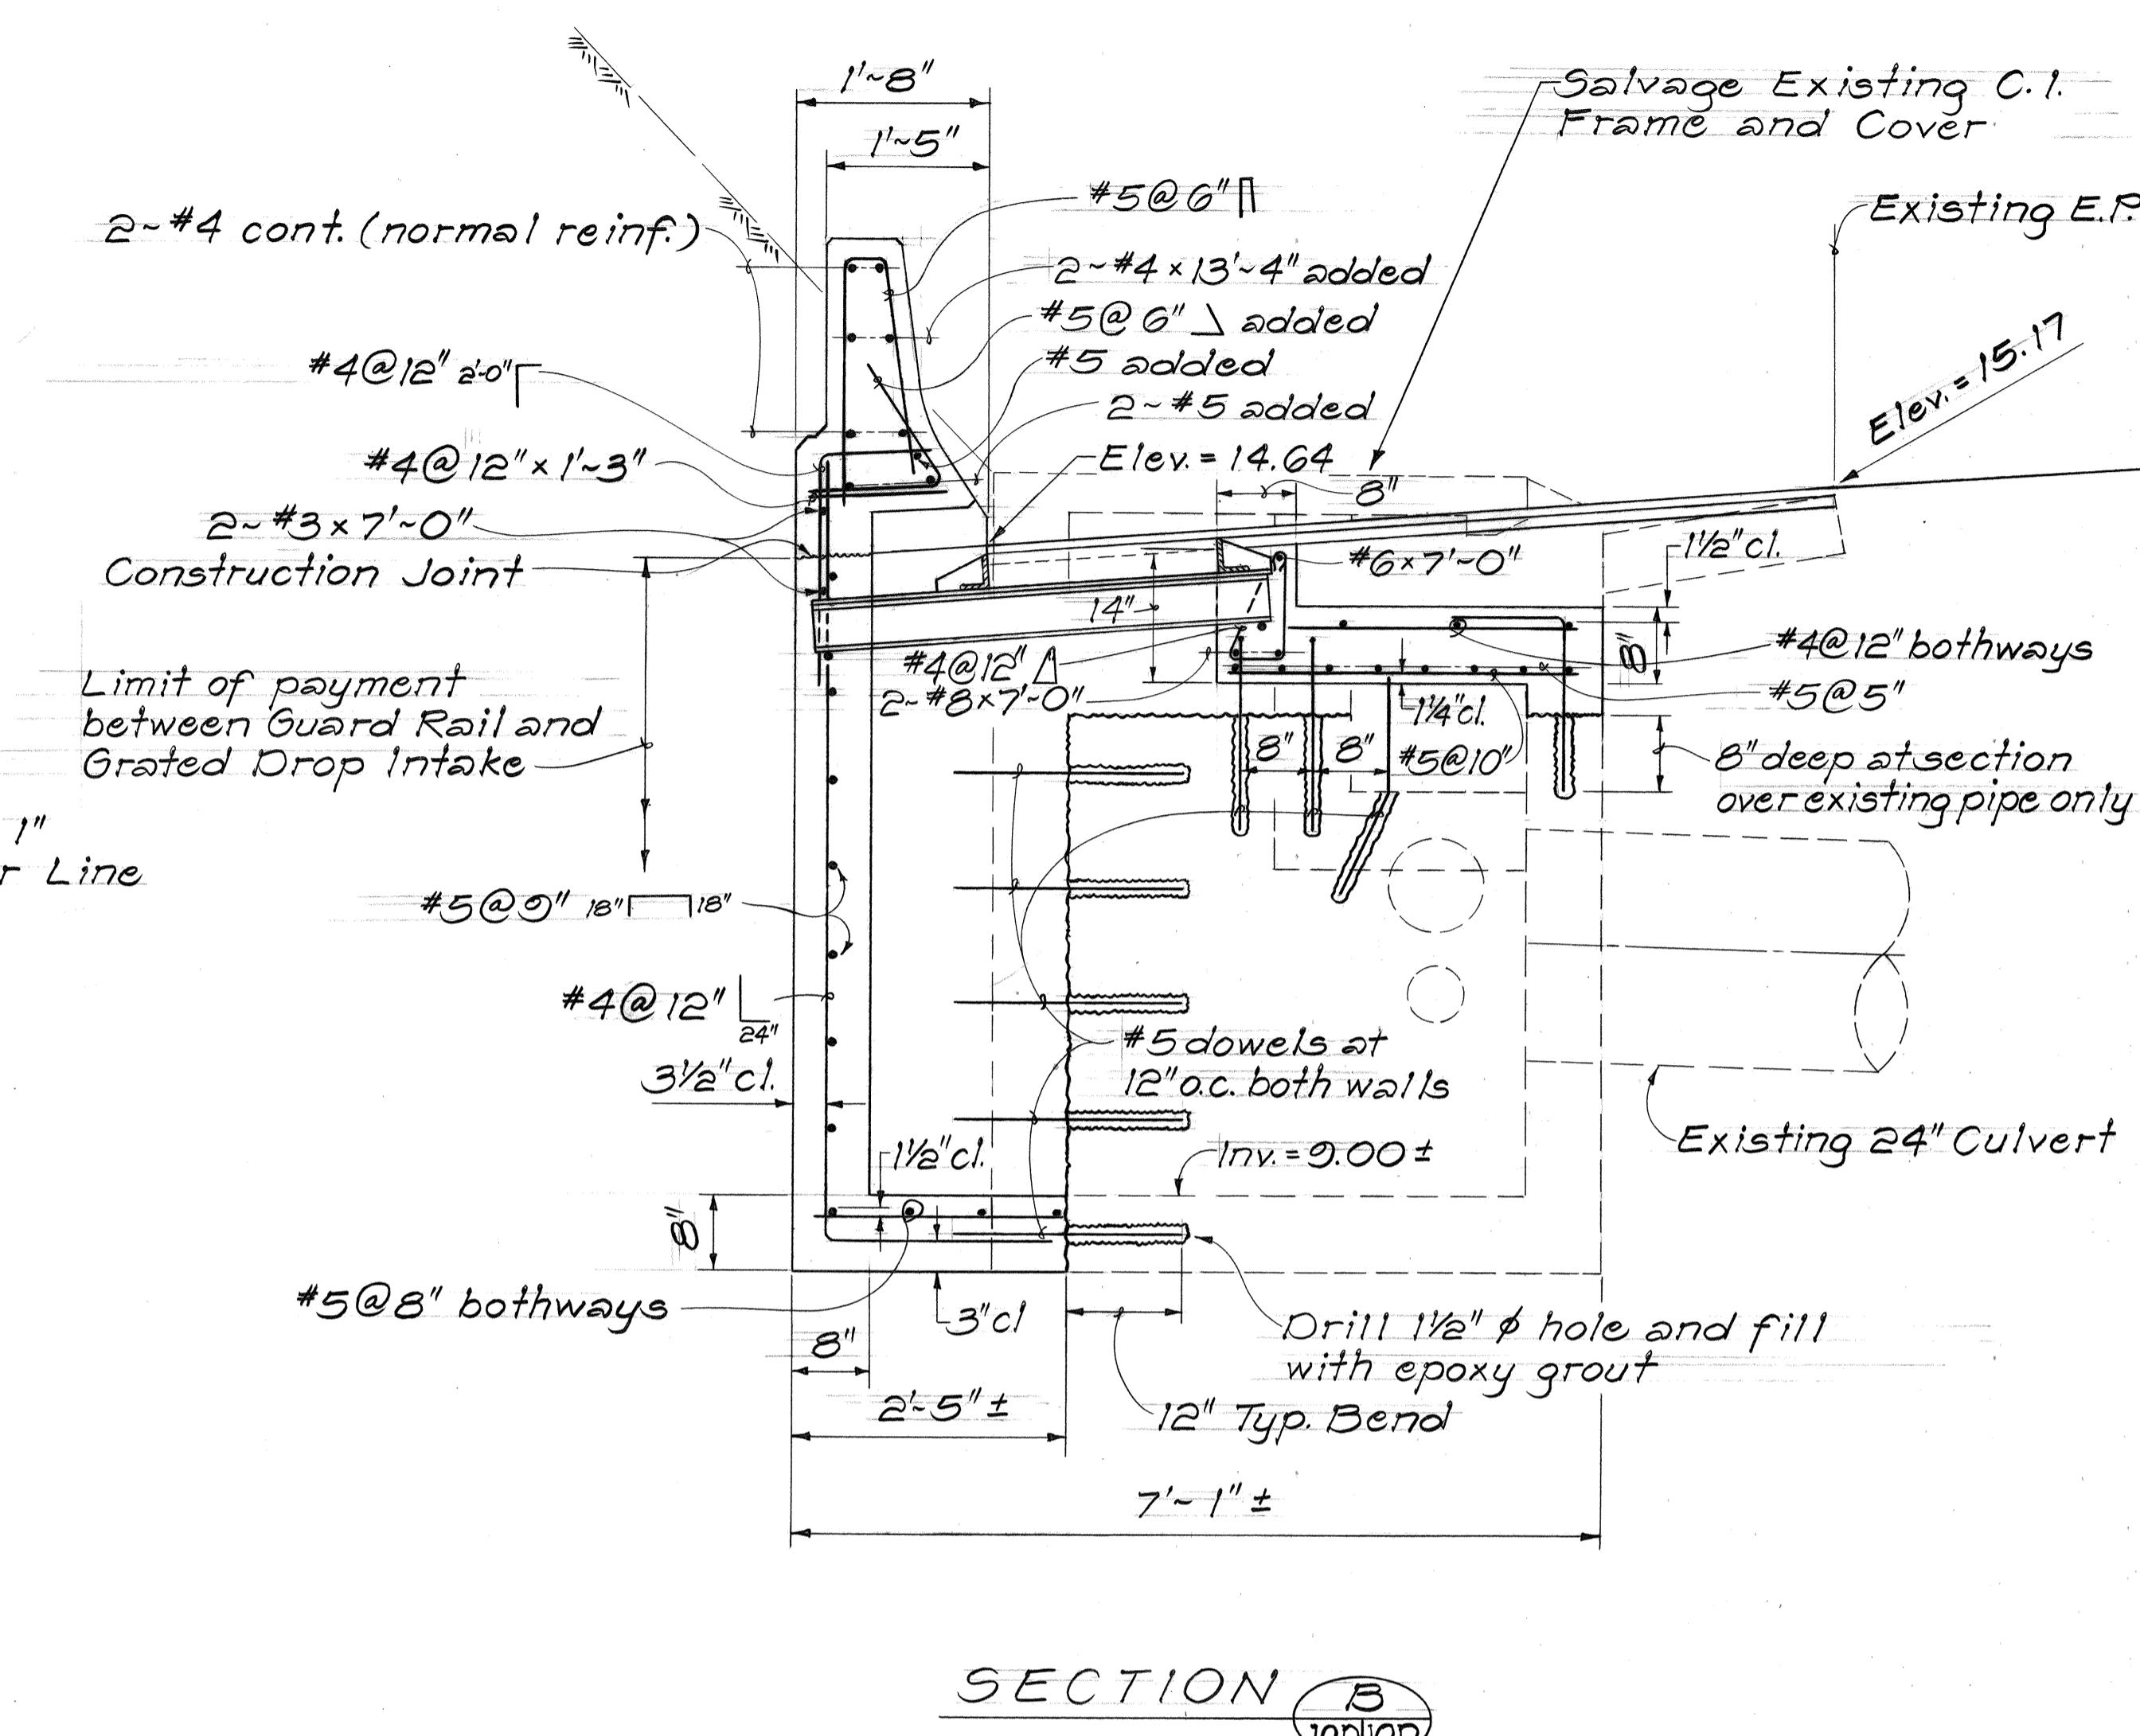



STATE OF HAWAII  
DEPARTMENT OF TRANSPORTATION  
LAND TRANSPORTATION FACILITIES DIVISION  
**DRAINAGE DETAILS**  
INTERSTATE ROUTE H-I IMPROVEMENTS  
MIDDLE STREET TO KALIHI INTERCHANGE  
WESTBOUND LANES  
F.A.I. PROJ. NO. I-HI-1(187)  
SCALE: 3/4" = 1'-0" DATE: JUNE 1983  
SHEET NO. 100 OF 30 SHEETS

| FED. ROAD DIST. NO. | STATE | FED. AID PROJ. NO. | FISCAL YEAR | SHEET NO. | TOTAL SHEETS |
|---------------------|-------|--------------------|-------------|-----------|--------------|
| HAWAII              | HAW.  | I-HI-1(187)        | 1984        | 50        | 191          |

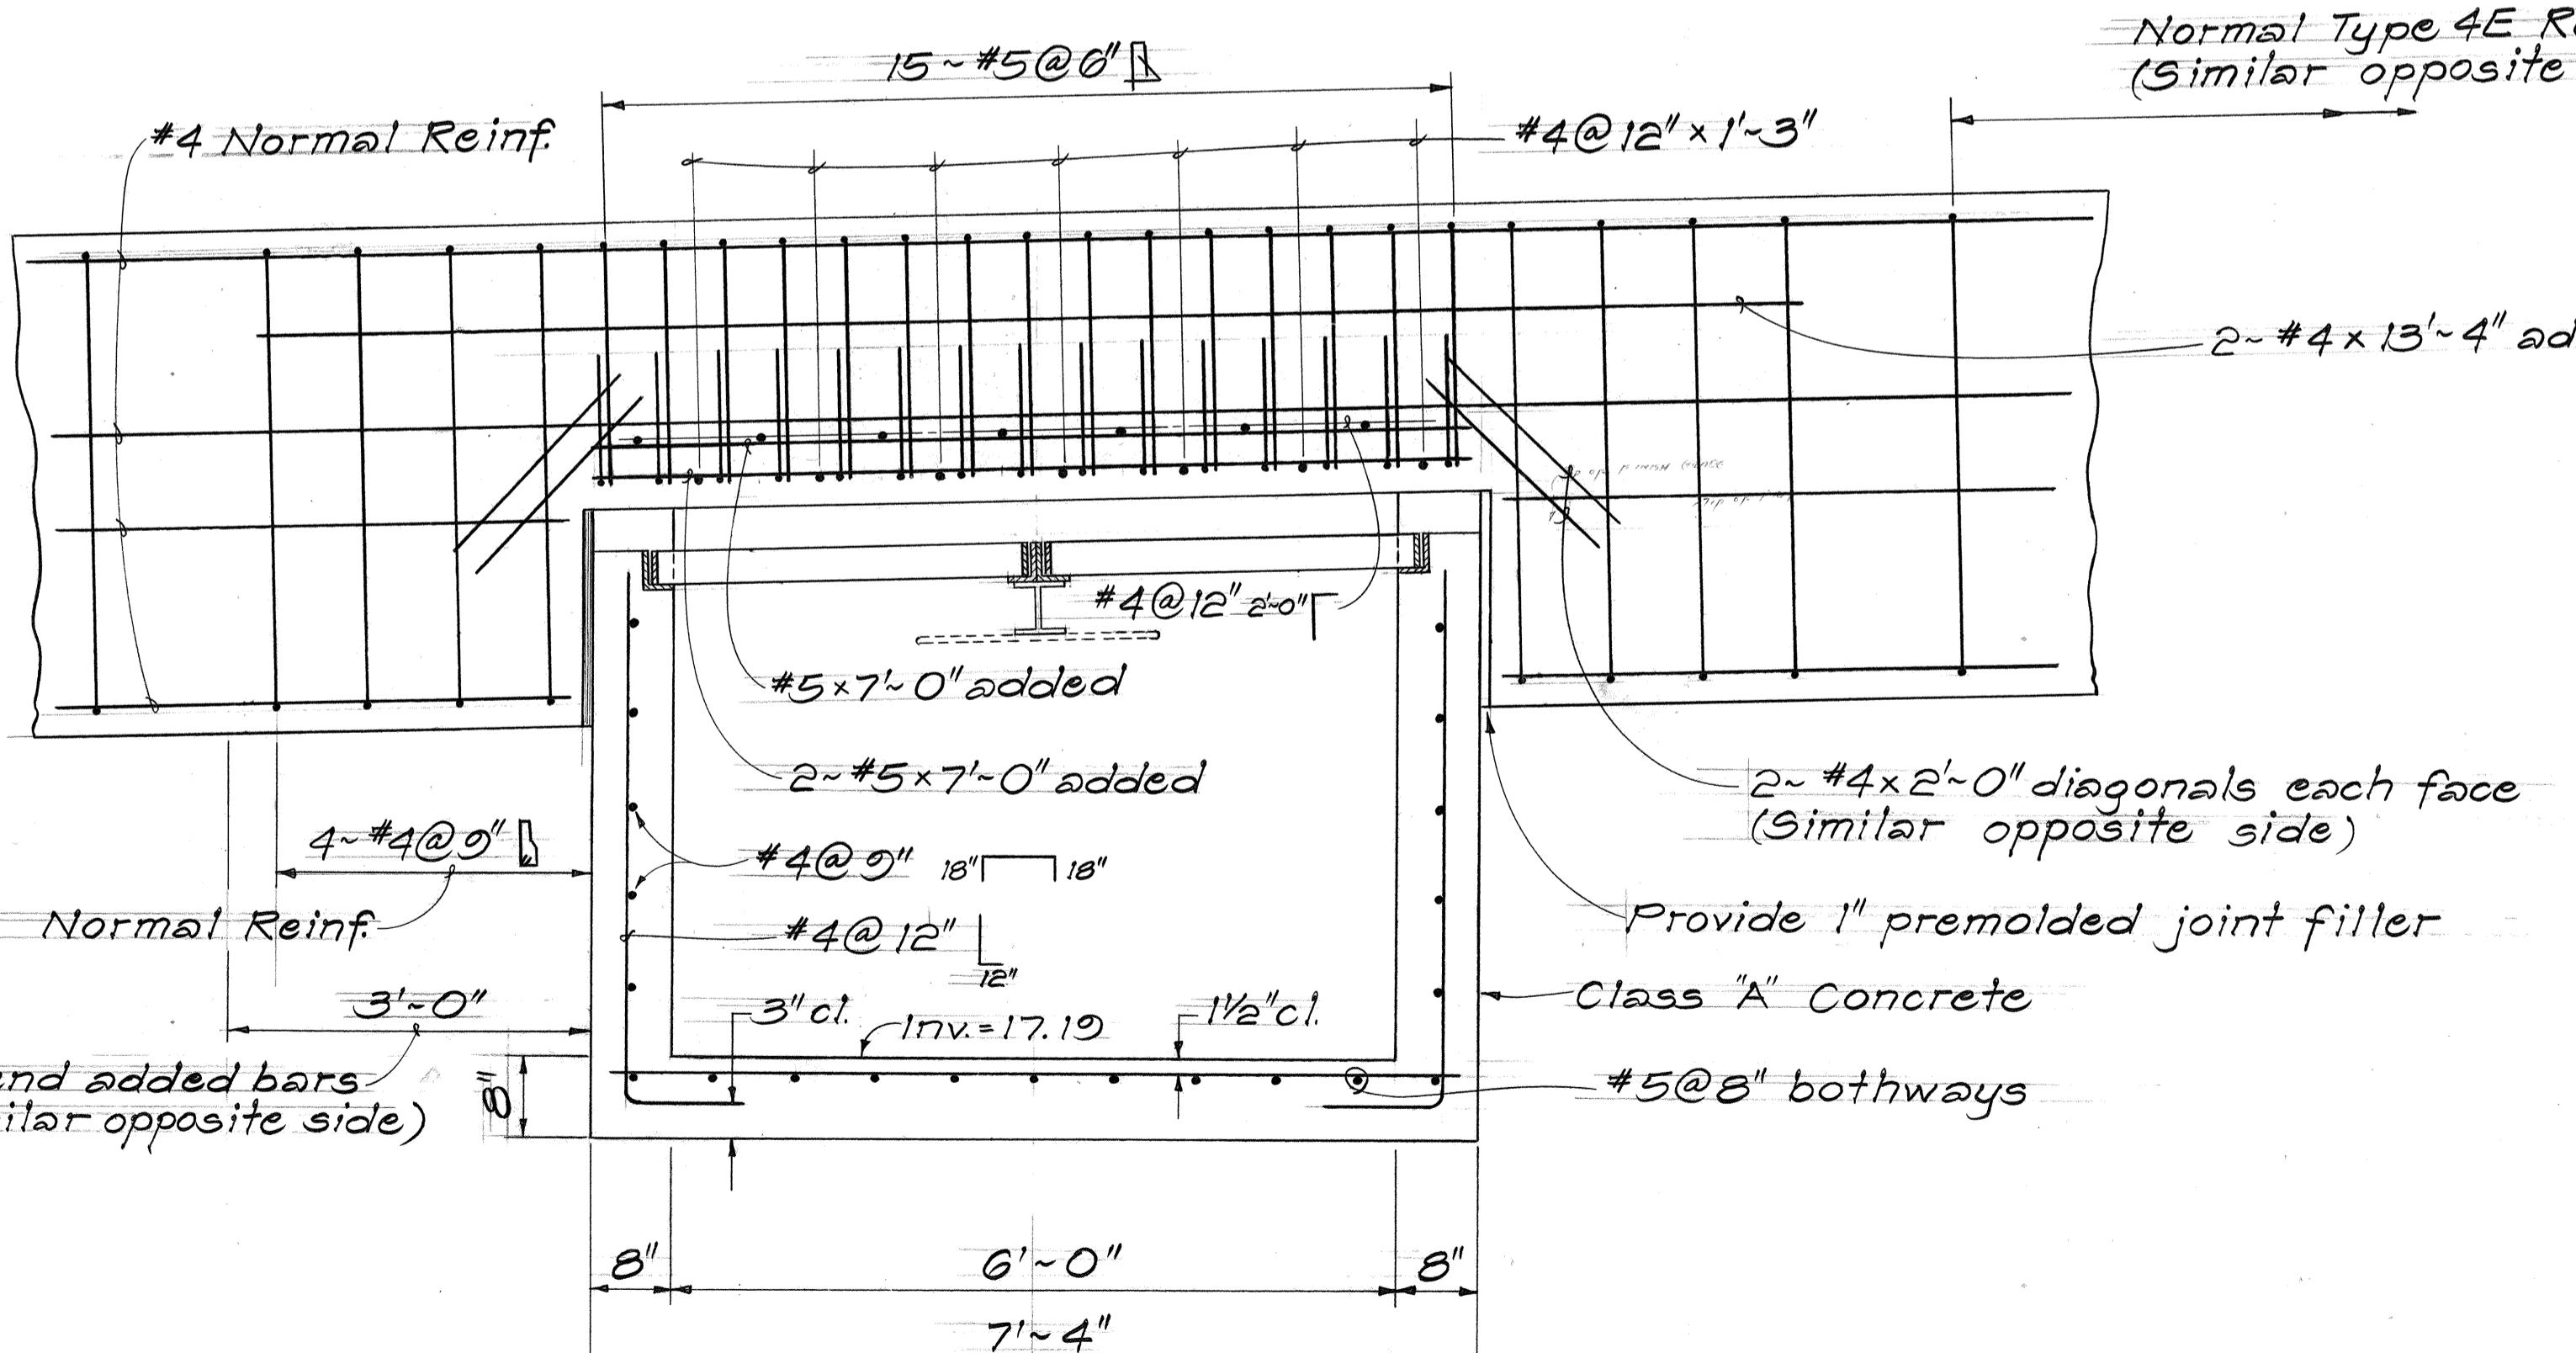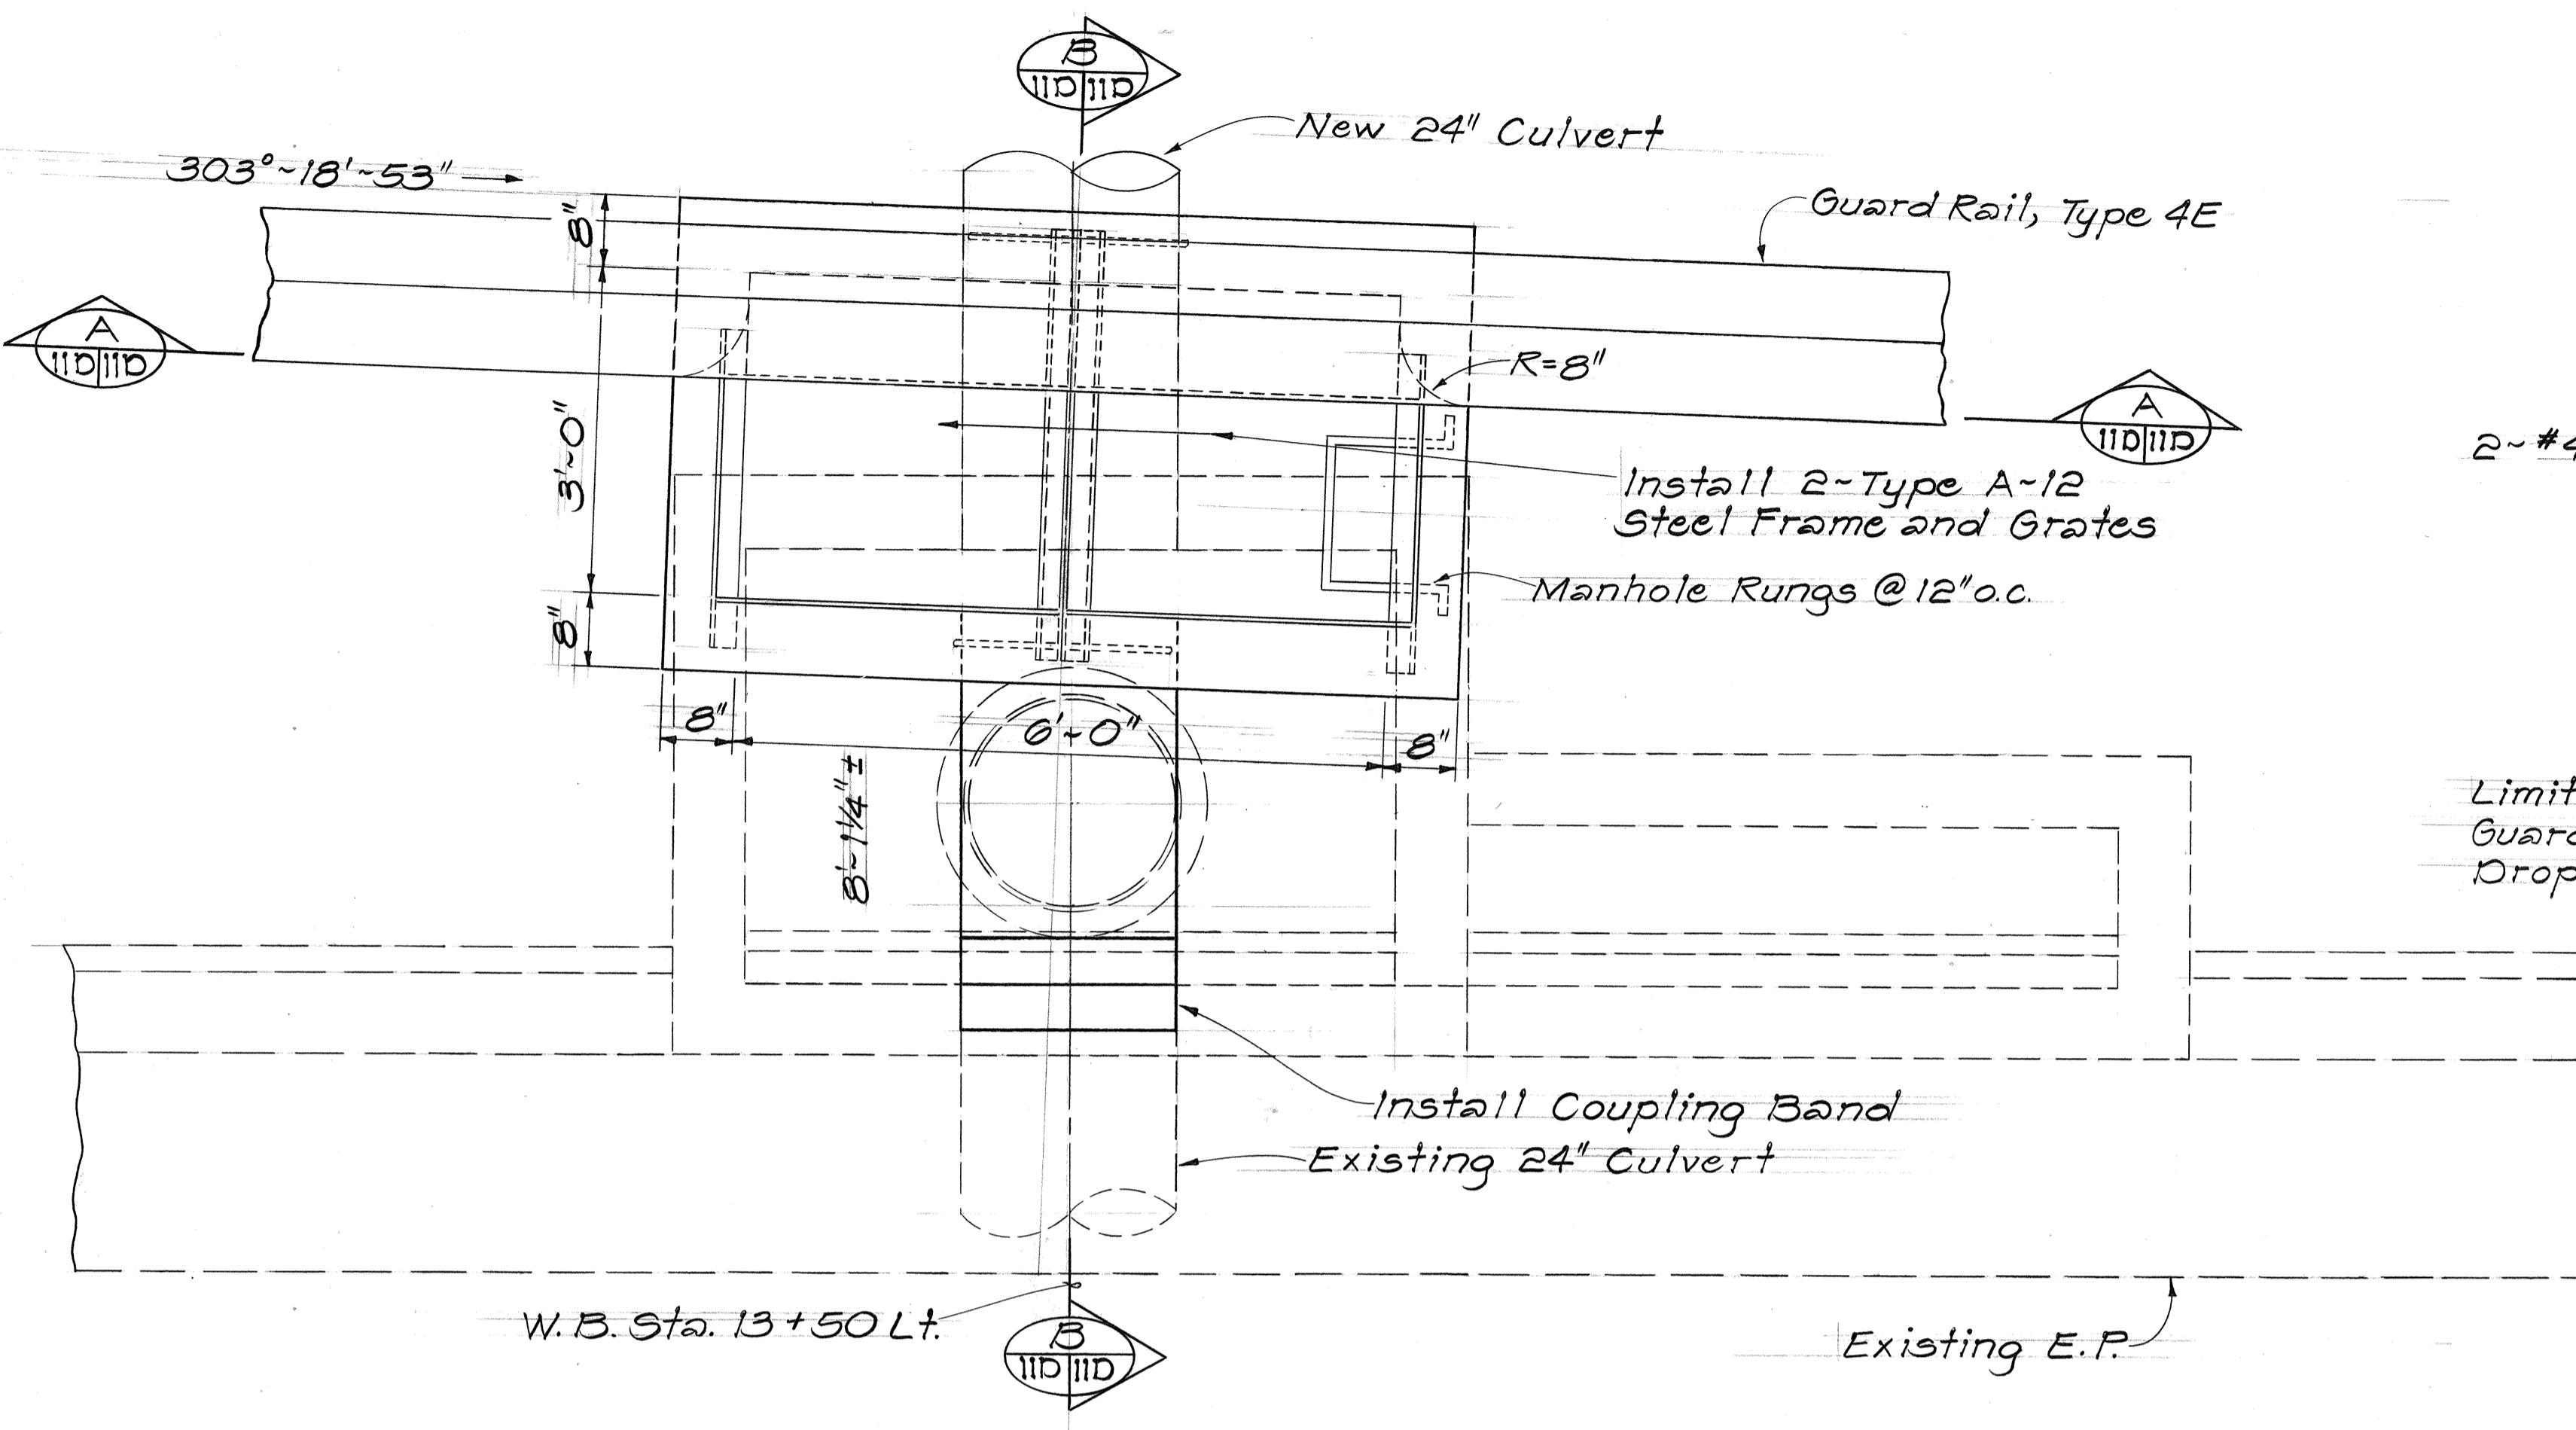

DETAILS OF TYPE 2/C.O. G.D.I. #25 AT W.B. STA. 13+50 LT.



Scale: 3/4" = 1'-0"

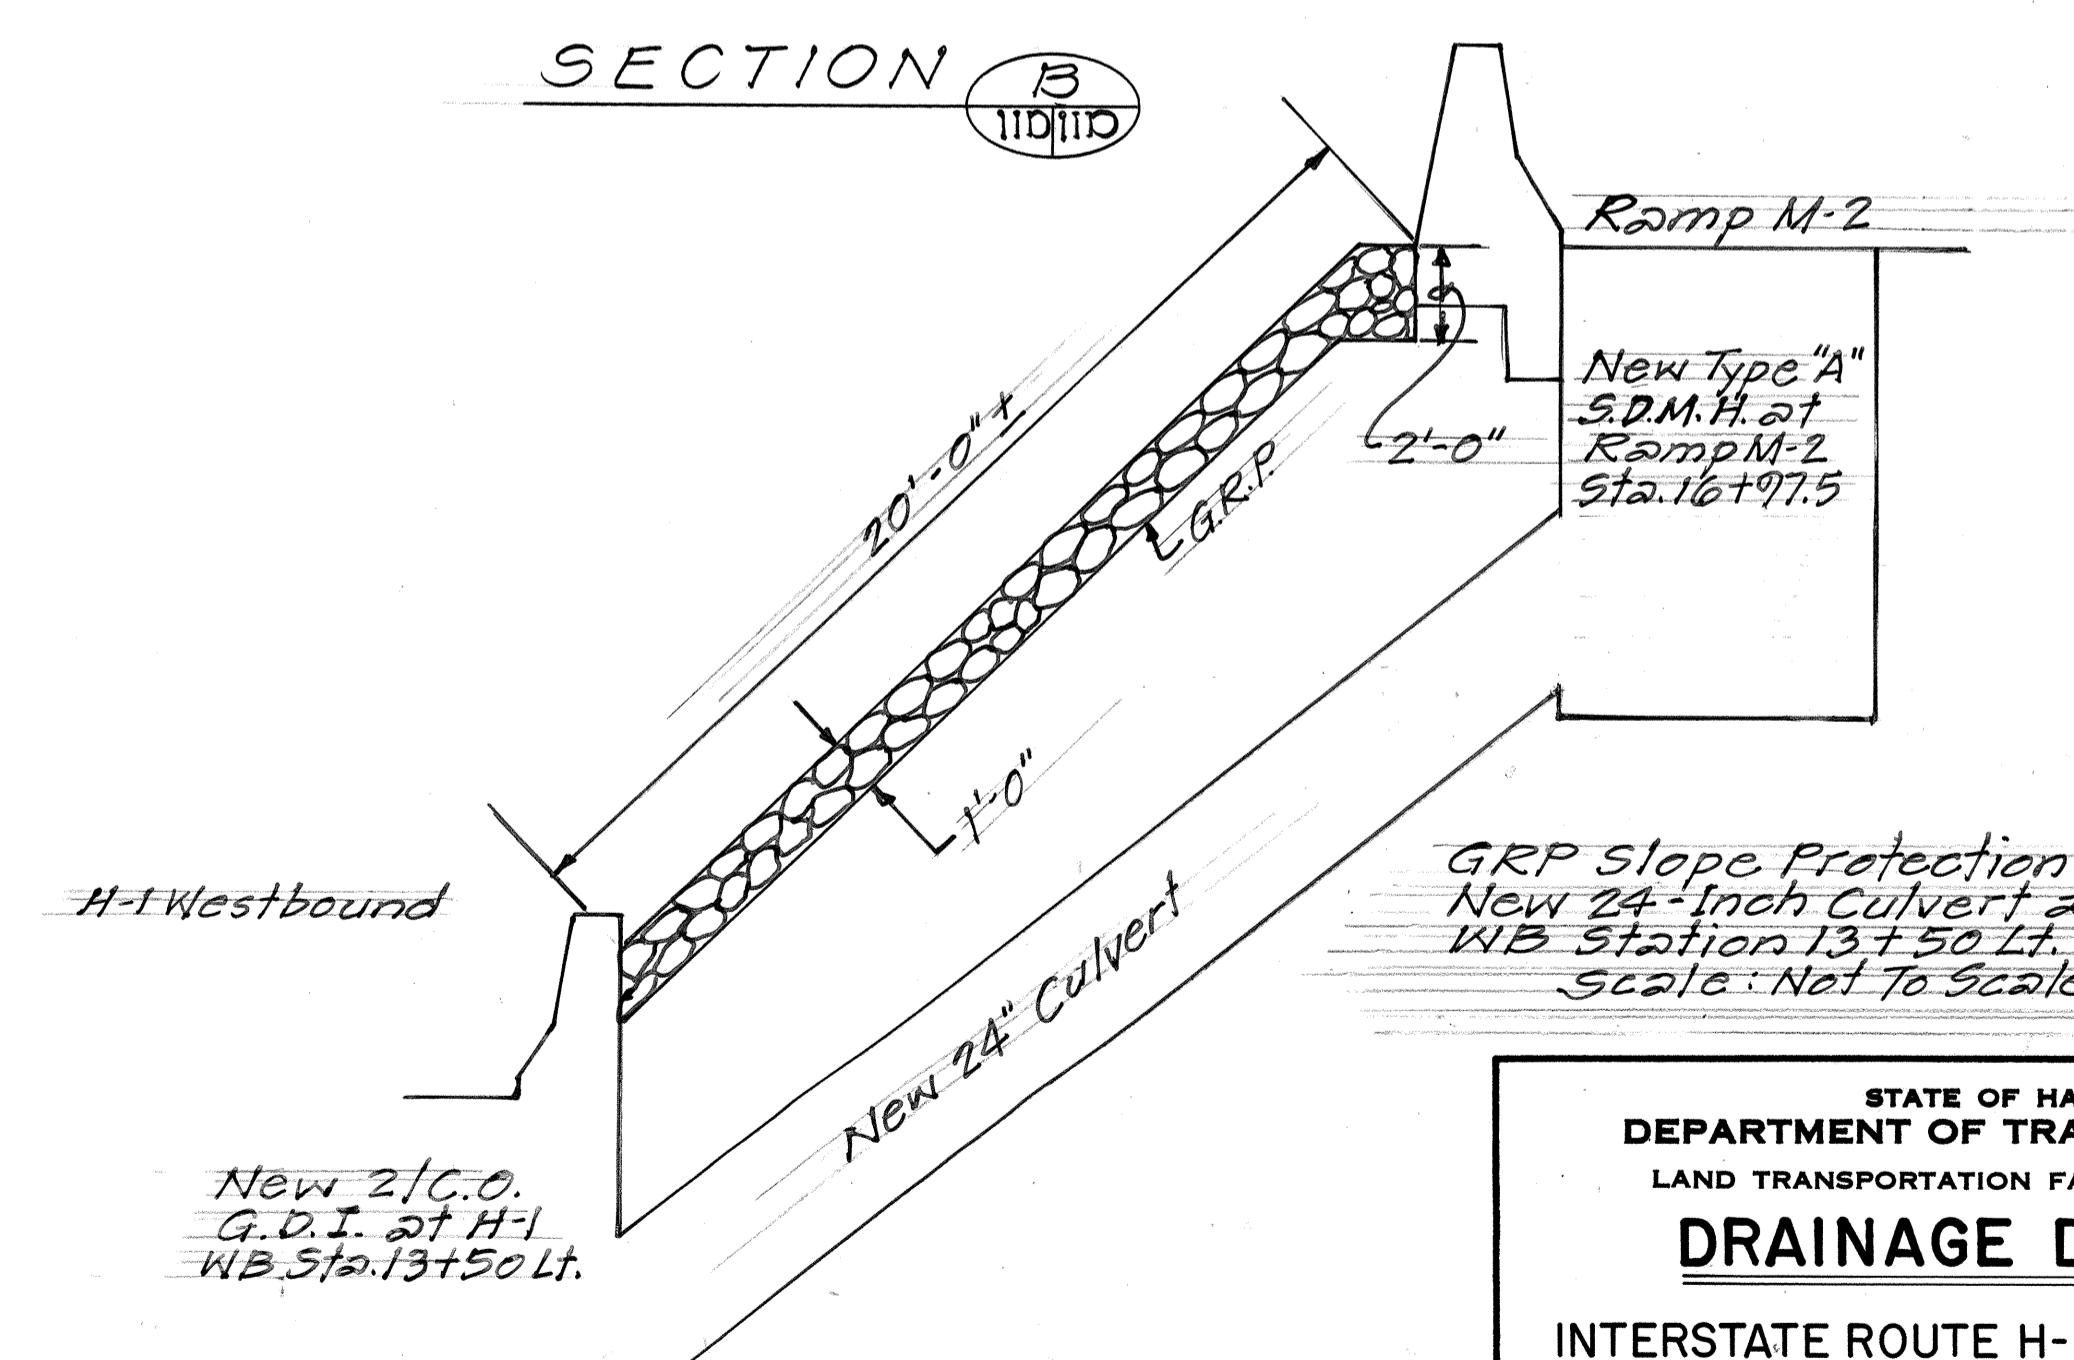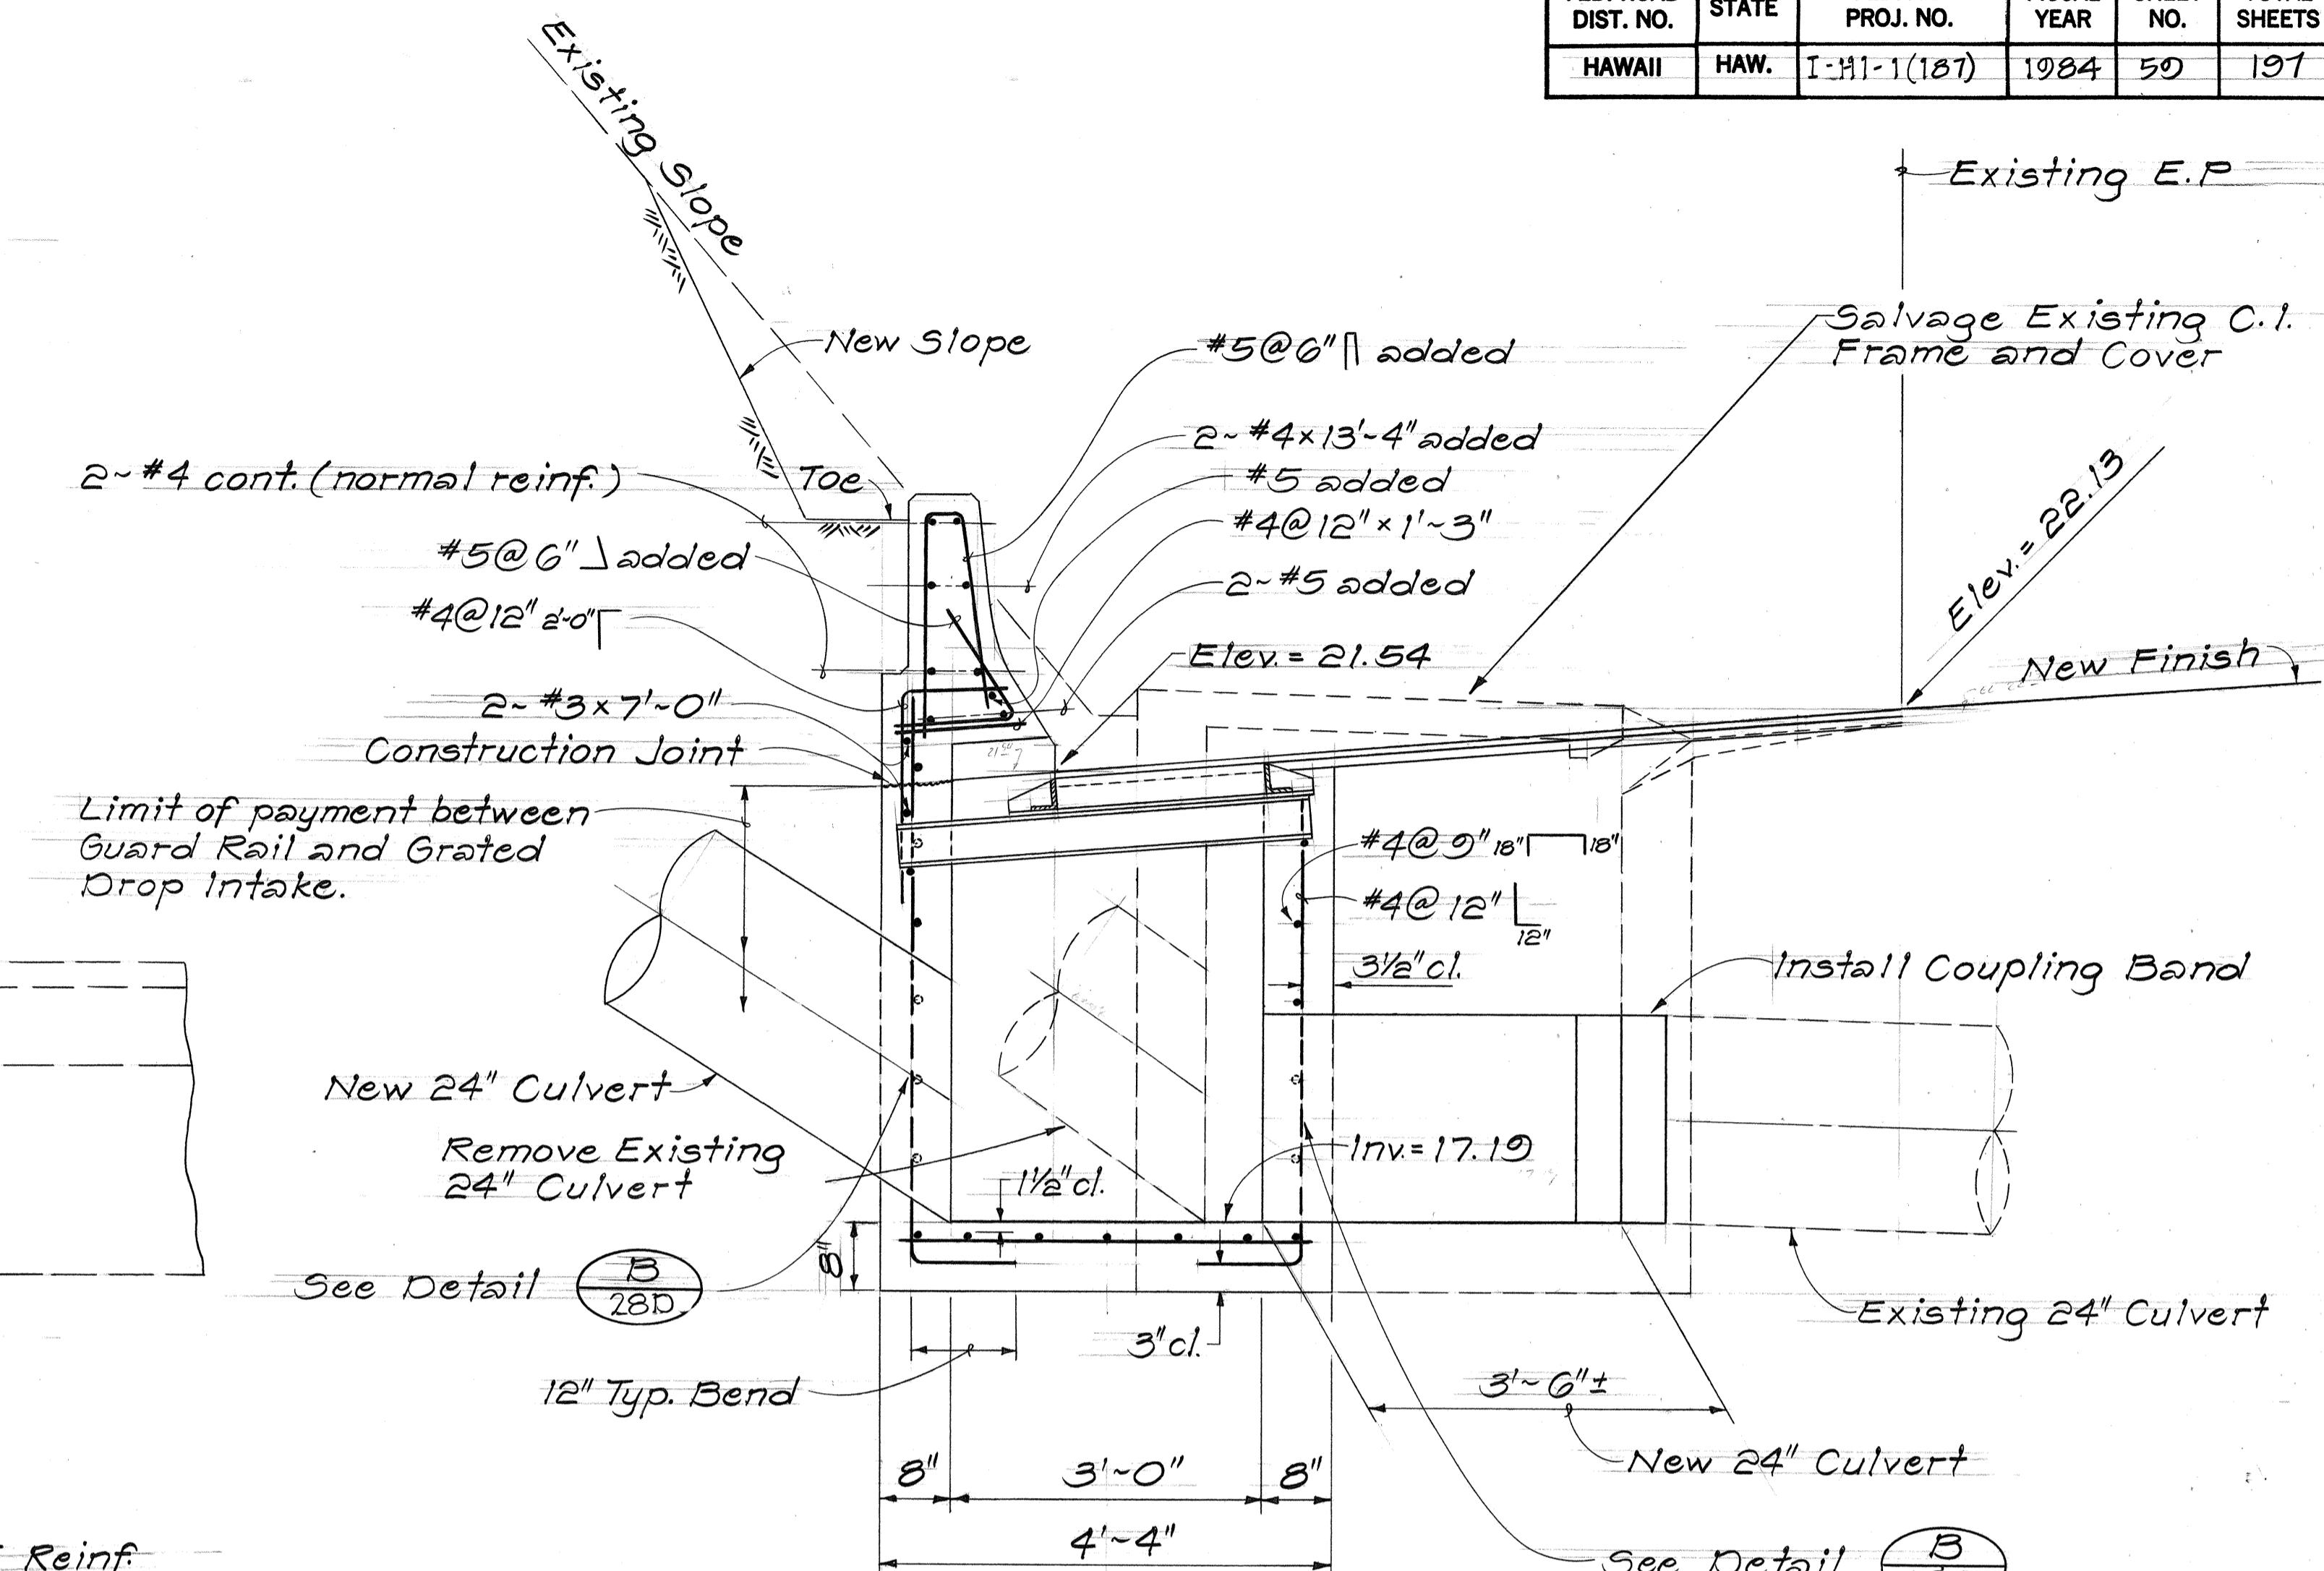

|   |
|---|
| STATE OF HAWAII<br>DEPARTMENT OF TRANSPORTATION<br>LAND TRANSPORTATION FACILITIES DIVISION                                  |
| <b>DRAINAGE DETAILS</b>   |
| INTERSTATE ROUTE H-1 IMPROVEMENTS<br>MIDDLE STREET TO KALIHI INTERCHANGE<br>WESTBOUND LANES<br>F.A.I. PROJ. NO. I-HI-1(187) |
| SCALE: 3/4" = 1'-0"   |
| DATE: JUNE 1983   |

SHEET NO. 110 OF 30 SHEETS

| FED. ROAD DIST. NO. | STATE | FED. AID PROJ. NO. | FISCAL YEAR | SHEET NO. | TOTAL SHEETS |
|---------------------|-------|--------------------|-------------|-----------|--------------|
| HAWAII              | HAW.  | I-HI-1(187)        | 1984        | 60        | 197          |

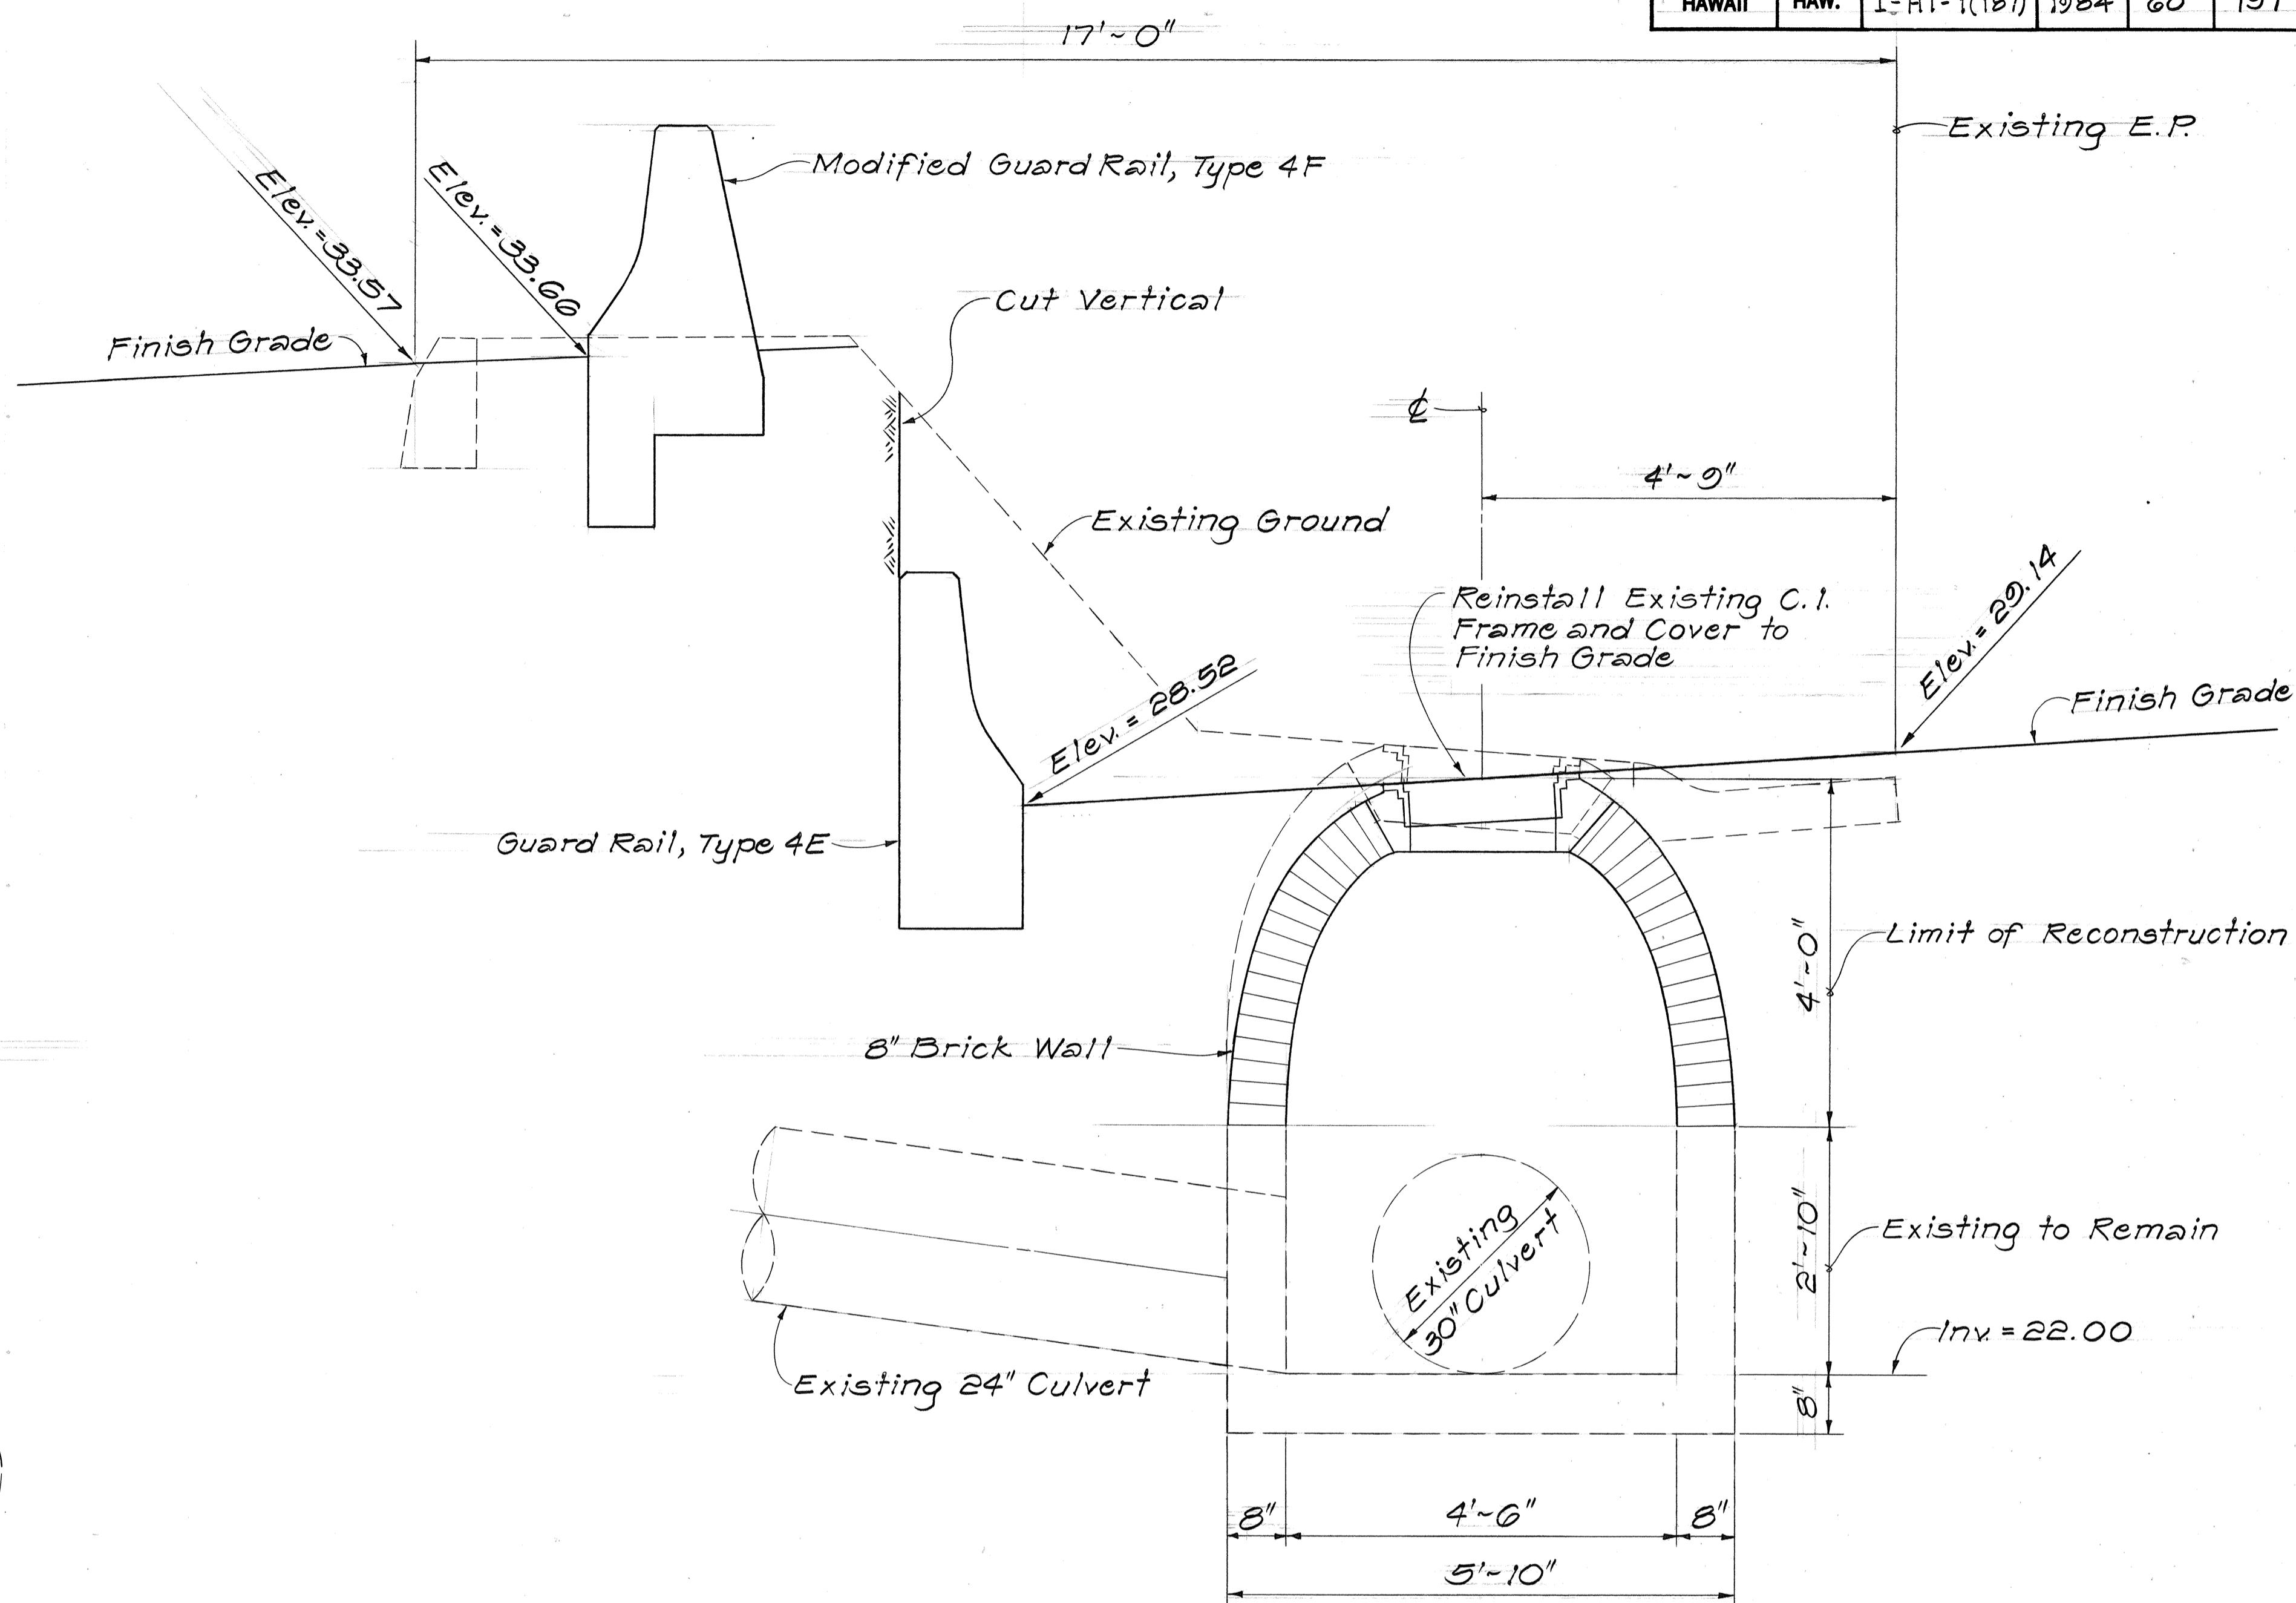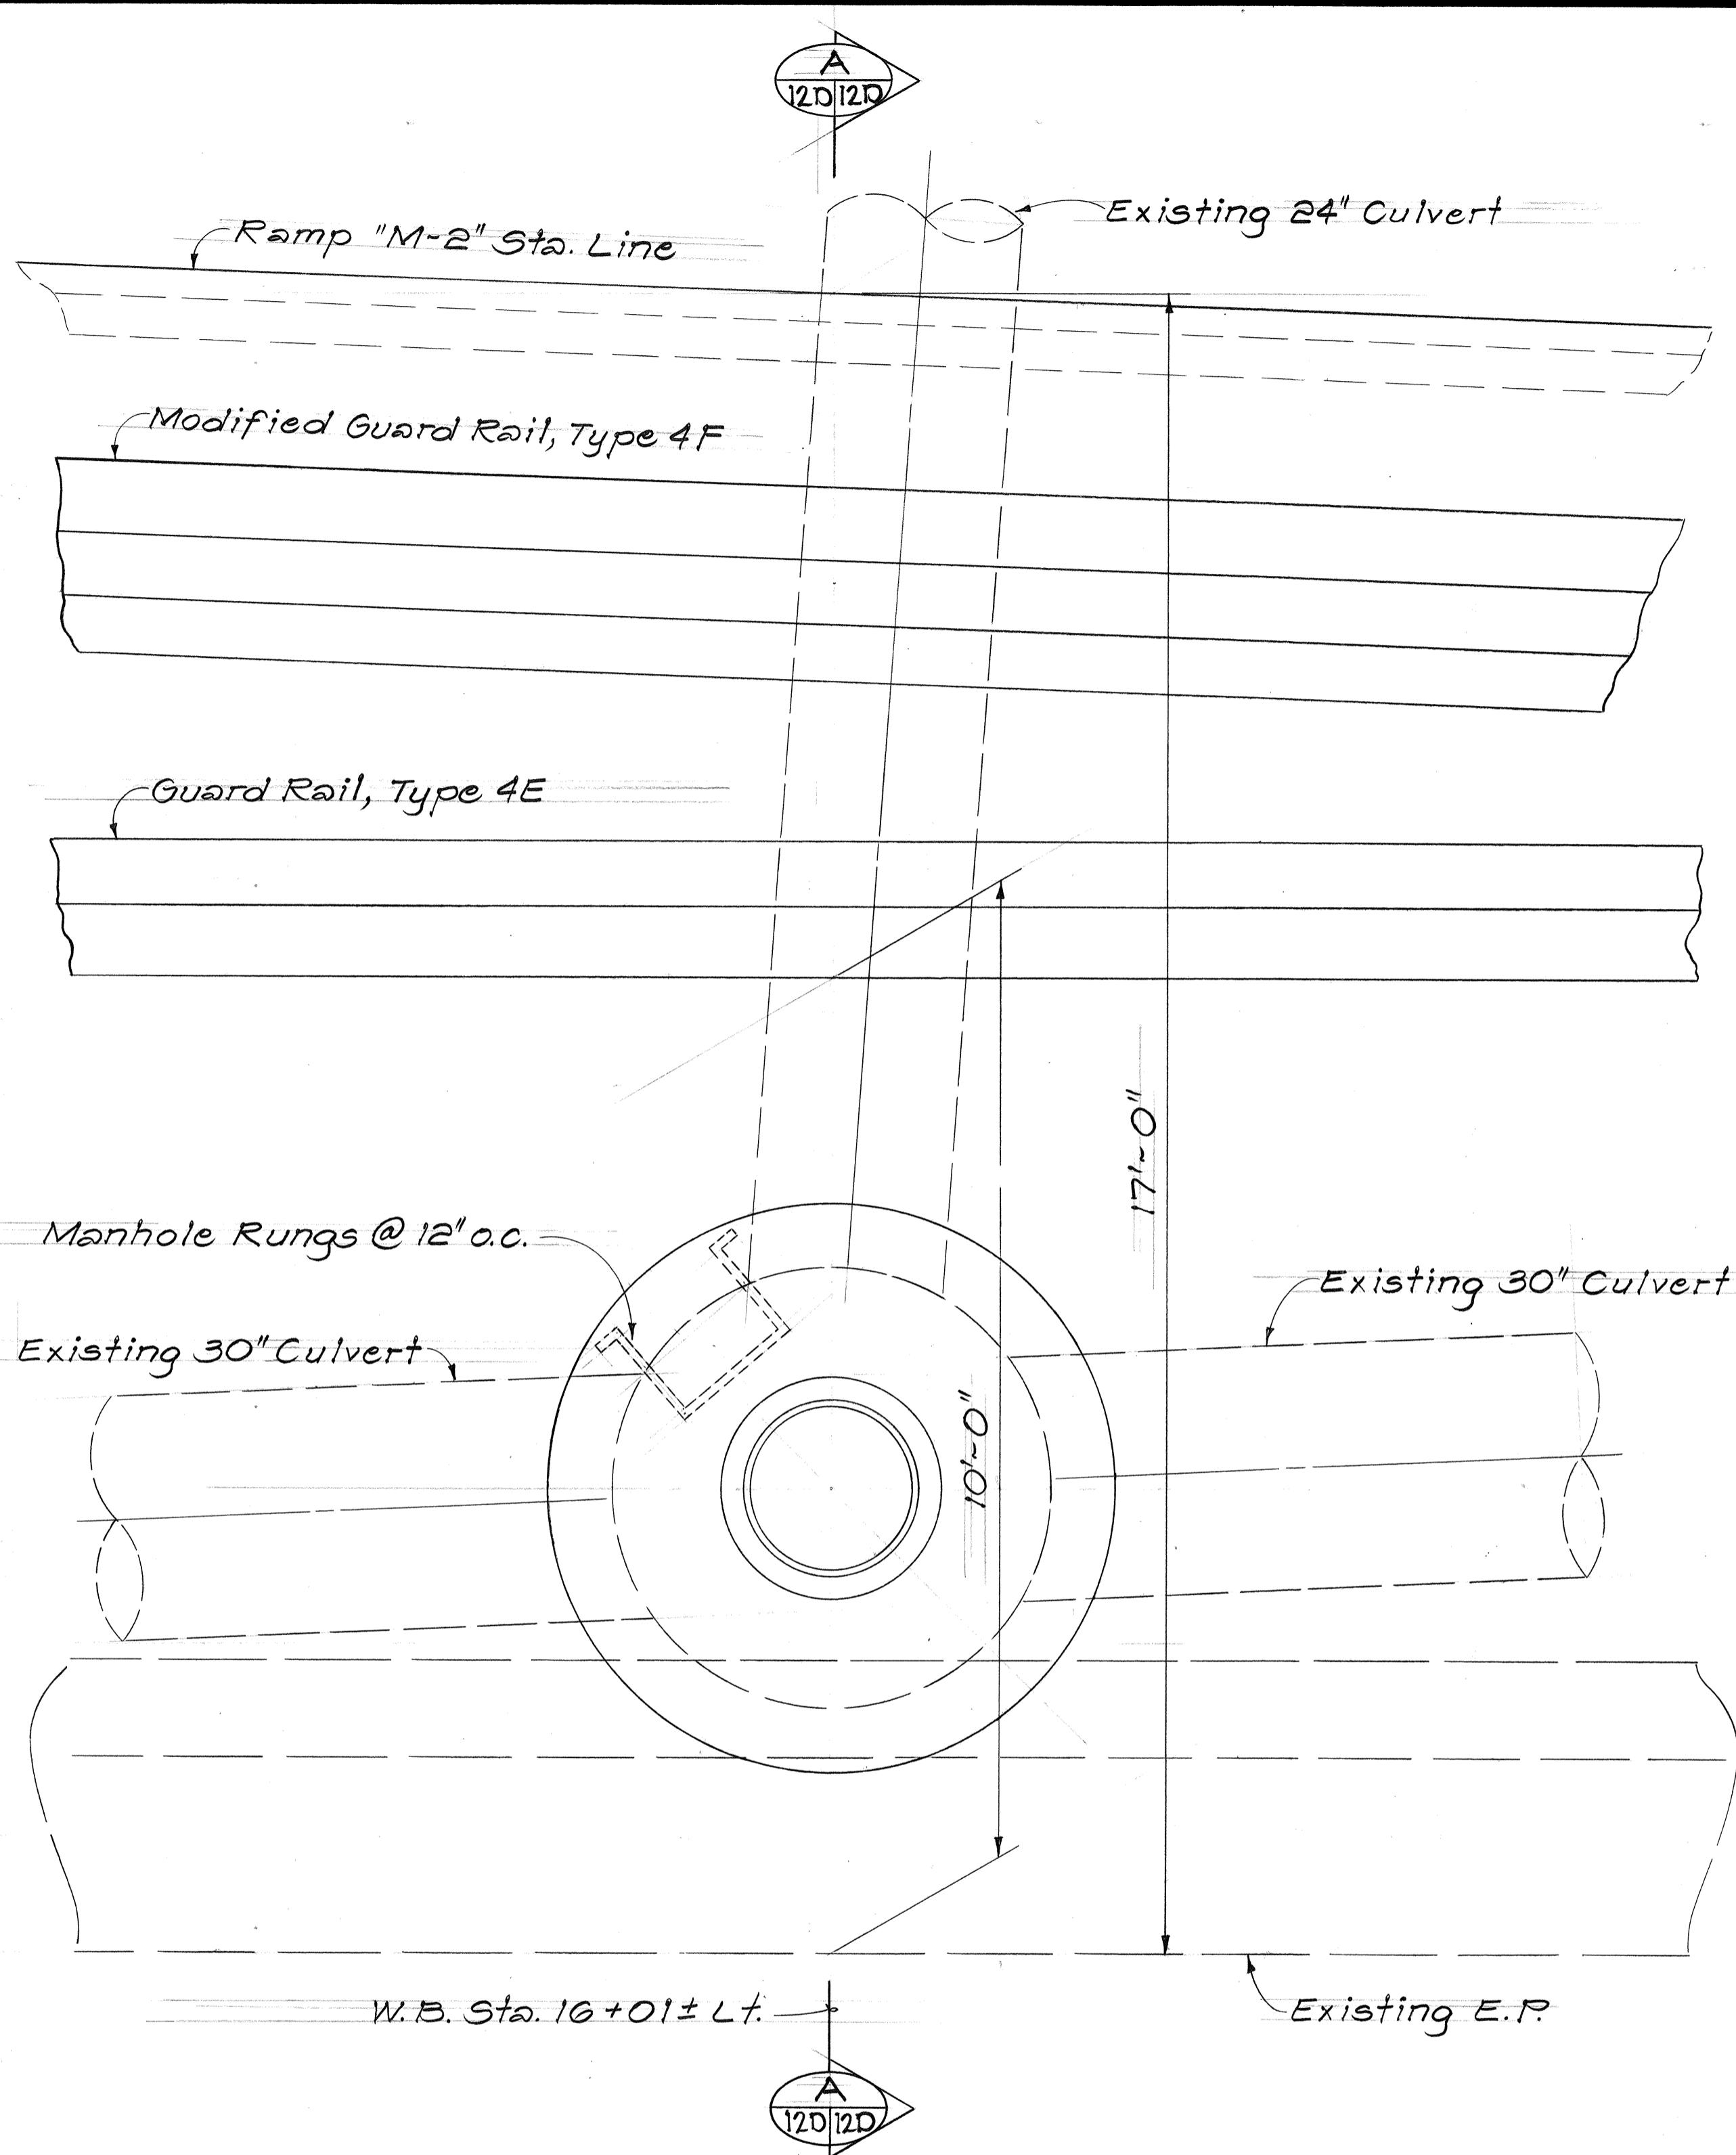

|           |               |
|-----------|---------------|
| ORIGINAL  | SURVEYED BY   |
| PLAN      | DRAWN BY      |
| NOTE BOOK | TRACED BY     |
| No.       | DESIGNED BY   |
|           | QUANTIFIED BY |
|           | CHECKED BY    |



PLAN

### RECONSTRUCTION OF TYPE "D" S.D.M.H. #14 AT W.B. STA. 16+01 ± LT.

Scale: 3/4" = 1'-0"

STATE OF HAWAII  
DEPARTMENT OF TRANSPORTATION  
LAND TRANSPORTATION FACILITIES DIVISION  
**DRAINAGE DETAILS**  
INTERSTATE ROUTE H-I IMPROVEMENTS  
MIDDLE STREET TO KALIHI INTERCHANGE  
WESTBOUND LANES  
F.A.I. PROJ. NO. I-HI-1(187)  
SCALE: 3/4" = 1'-0" DATE: JUNE 1983  
SHEET NO.120 OF 30 SHEETS


| FED. ROAD DIST. NO. | STATE | FED. AID PROJ. NO. | FISCAL YEAR | SHEET NO. | TOTAL SHEETS |
|---------------------|-------|--------------------|-------------|-----------|--------------|
| HAWAII              | HAW.  | I-HI-1(187)        | 1984        | 61        | 191          |

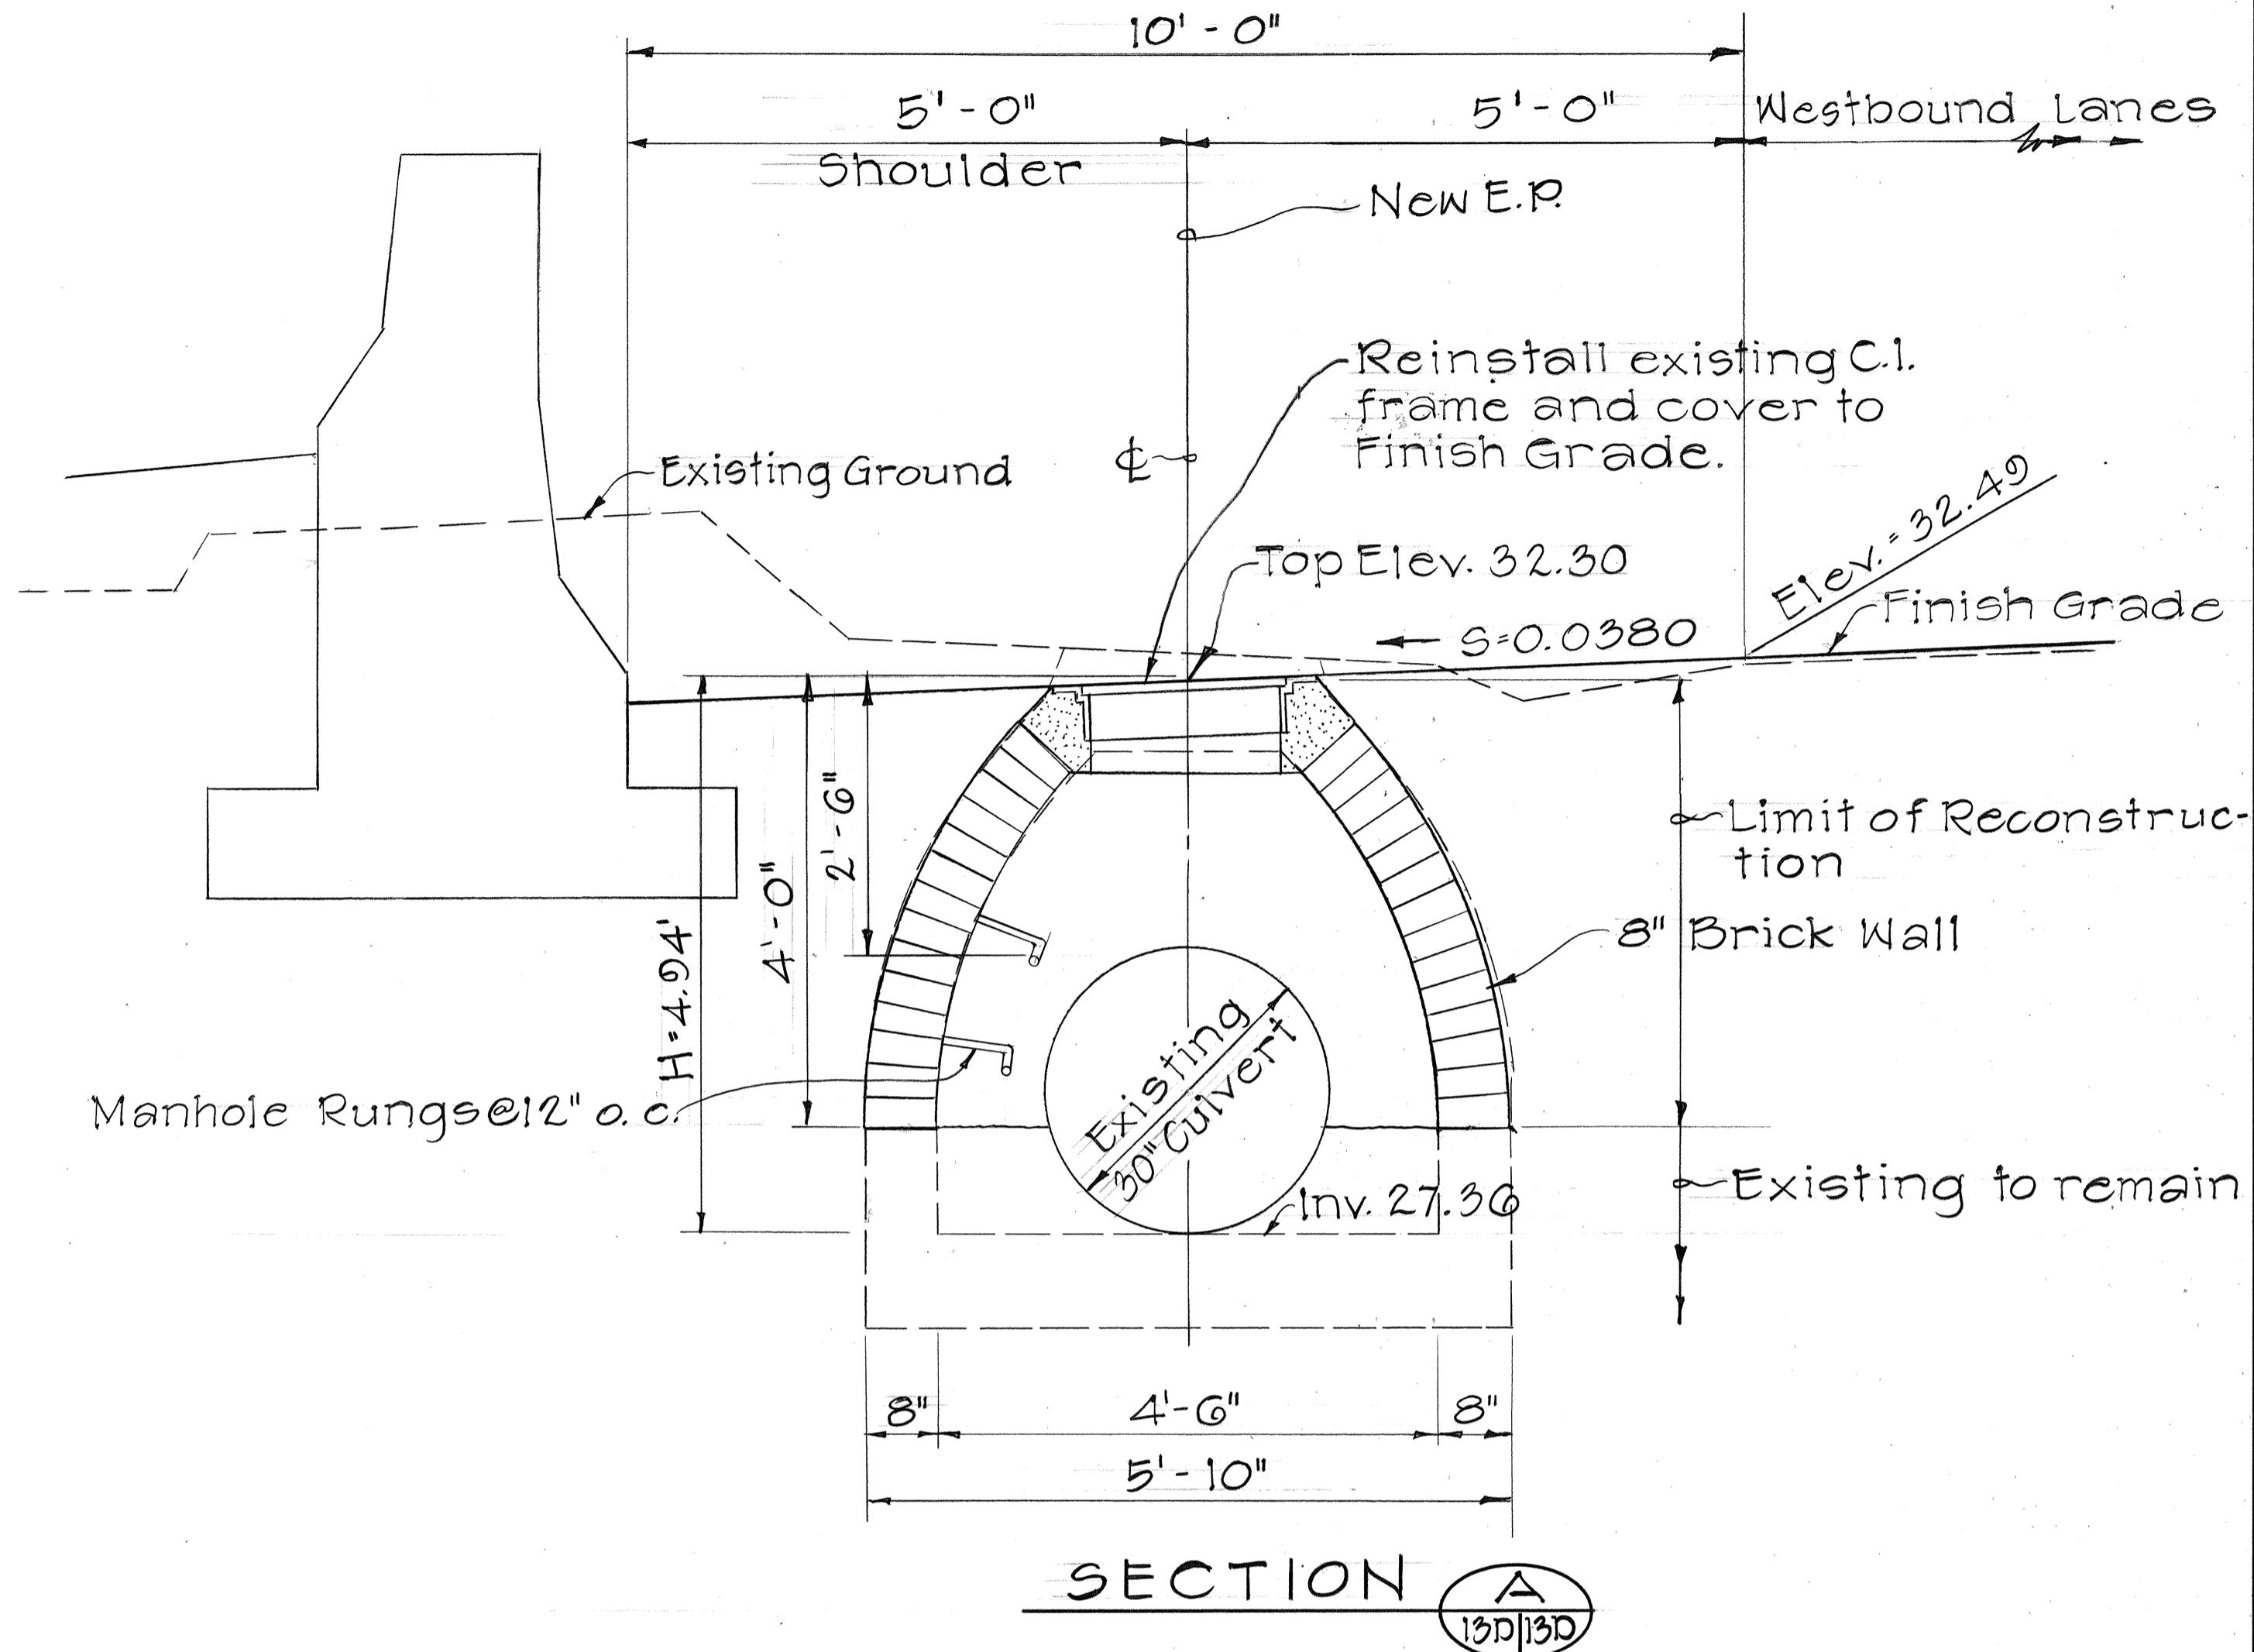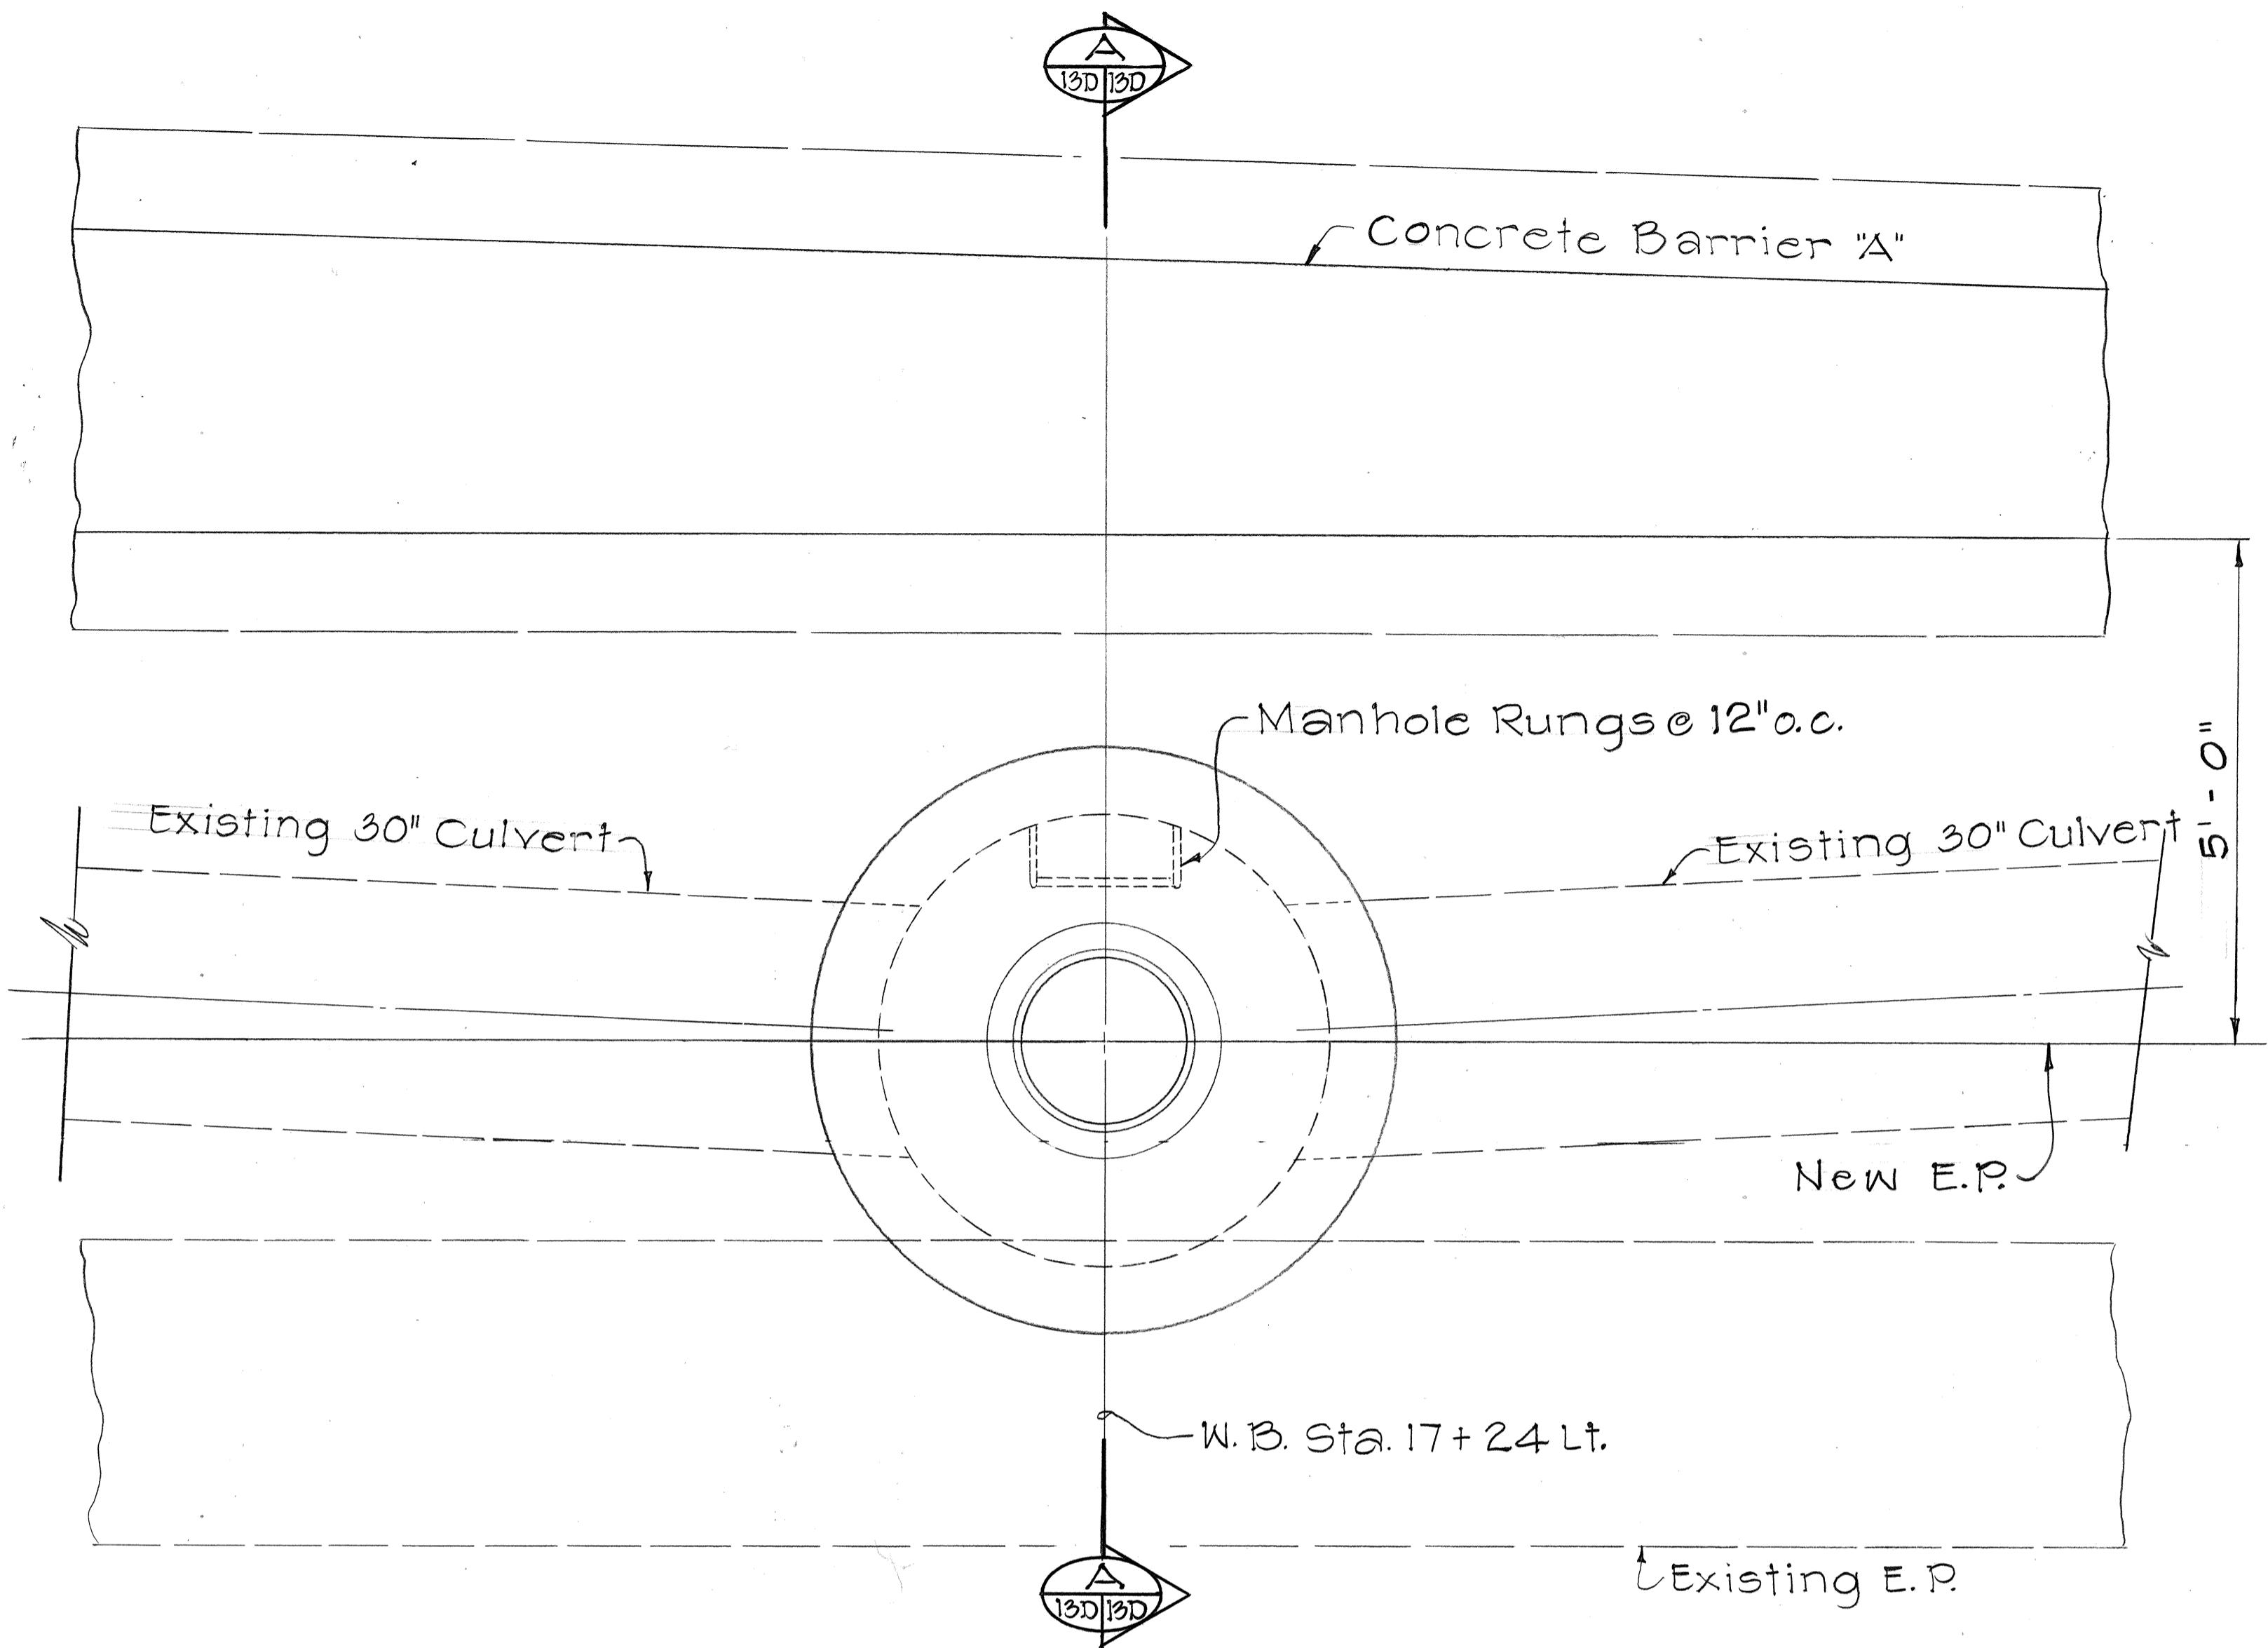

|                   |           |
|-------------------|-----------|
| ORIGINAL PLAN     | DATE      |
| SURVEY PLOTTED BY |           |
| DRAINED BY        |           |
| TRACED BY         |           |
| DESIGNED BY       |           |
| QUANTITIES BY     |           |
| CHECKED BY        |           |
| NOTE BOOK         | No. _____ |

STATE OF HAWAII  
DEPARTMENT OF TRANSPORTATION  
HIGHWAYS DIVISION  
**DRAINAGE DETAILS**  
INTERSTATE ROUTE H-I IMPROVEMENTS  
MIDDLE STREET TO KALIHI INTERCHANGE  
WESTBOUND LANES  
F.A.I. PROJ. NO. I-HI-1(187)  
SCALE:  $3/4" = 1'-0"$  DATE: JUNE 1983  
SHEET NO. 13D OF 30 SHEETS



| FED. ROAD DIST. NO. | STATE | FED. AID PROJ. NO. | FISCAL YEAR | SHEET NO. | TOTAL SHEETS |
|---------------------|-------|--------------------|-------------|-----------|--------------|
| HAWAII              | HAW.  | I-HI-1(187)        | 1984        | 62        | 191          |

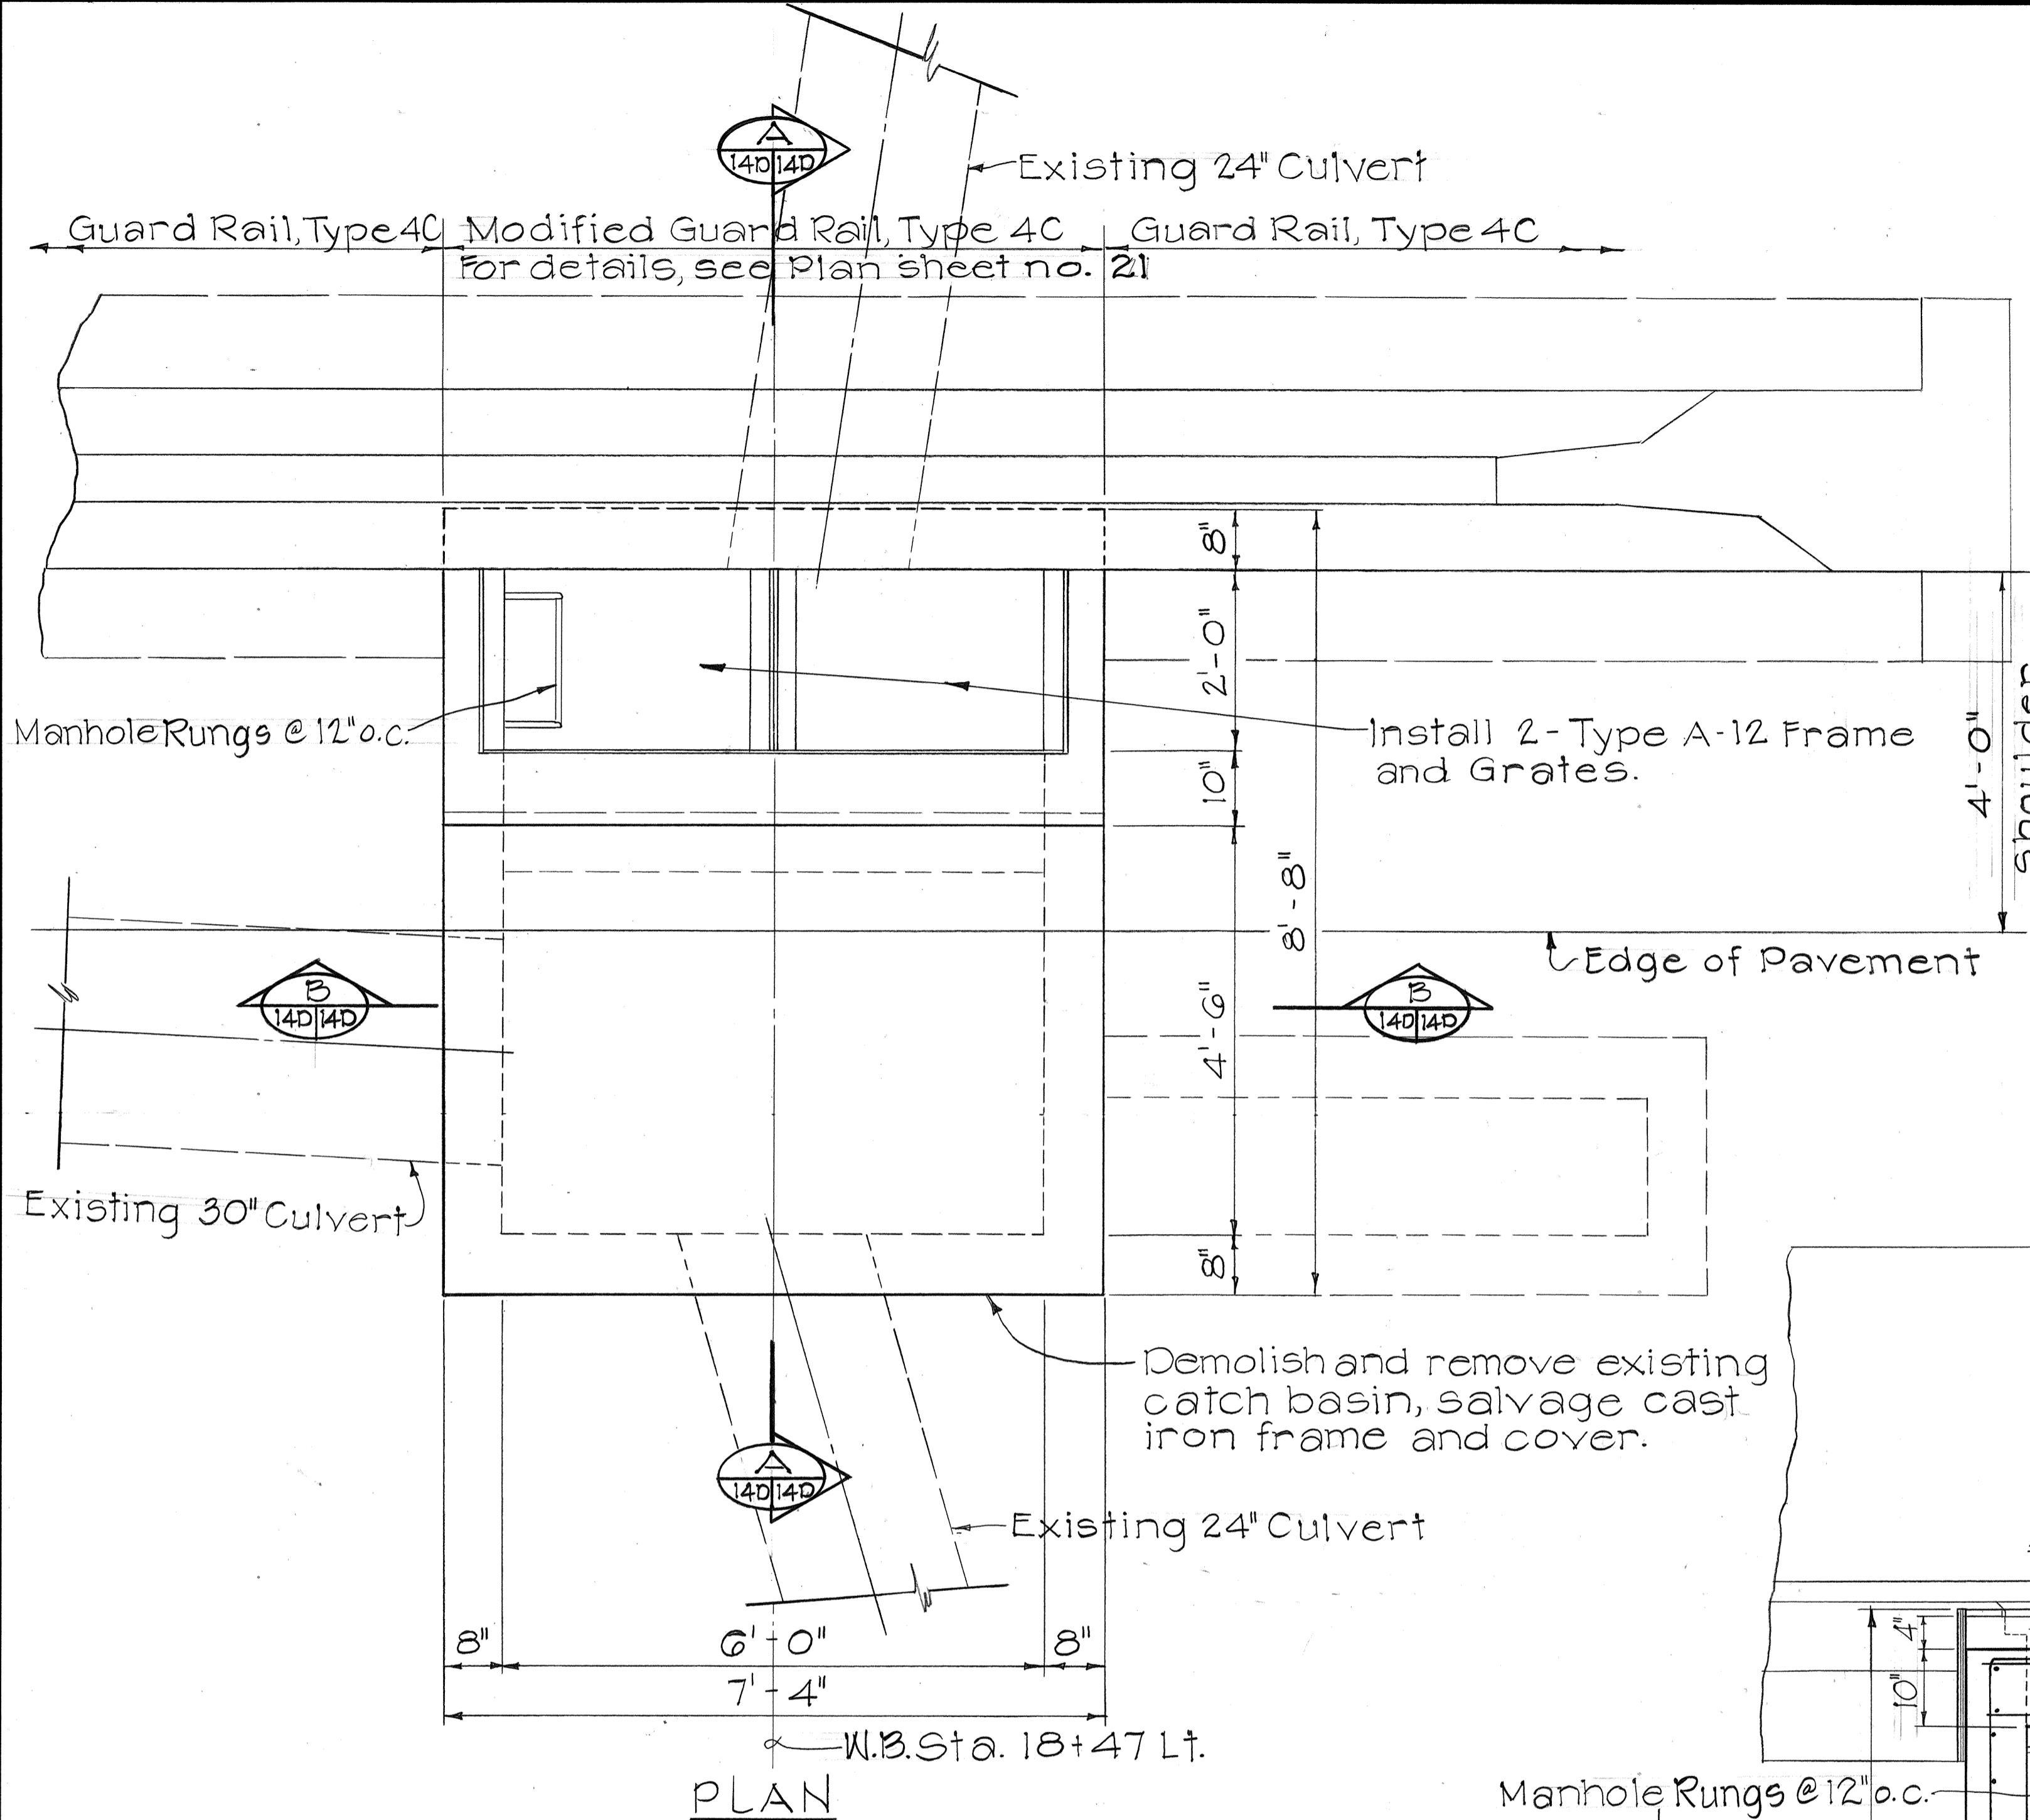

|                            |      |
|----------------------------|------|
| ORIGINAL SURVEY PLOTTED BY | DATE |
| PLAN DRAWN BY              |      |
| TRACED BY                  |      |
| DESIGNED BY                |      |
| QUANTITIES BY              |      |
| CHECKED BY                 |      |
| NOTE BOOK NO.              |      |


DETAILS OF TYPE 2 G.D.I. #32 AT W.B. STA 18+47 LT.

Scale: 3/4" = 1'-0"

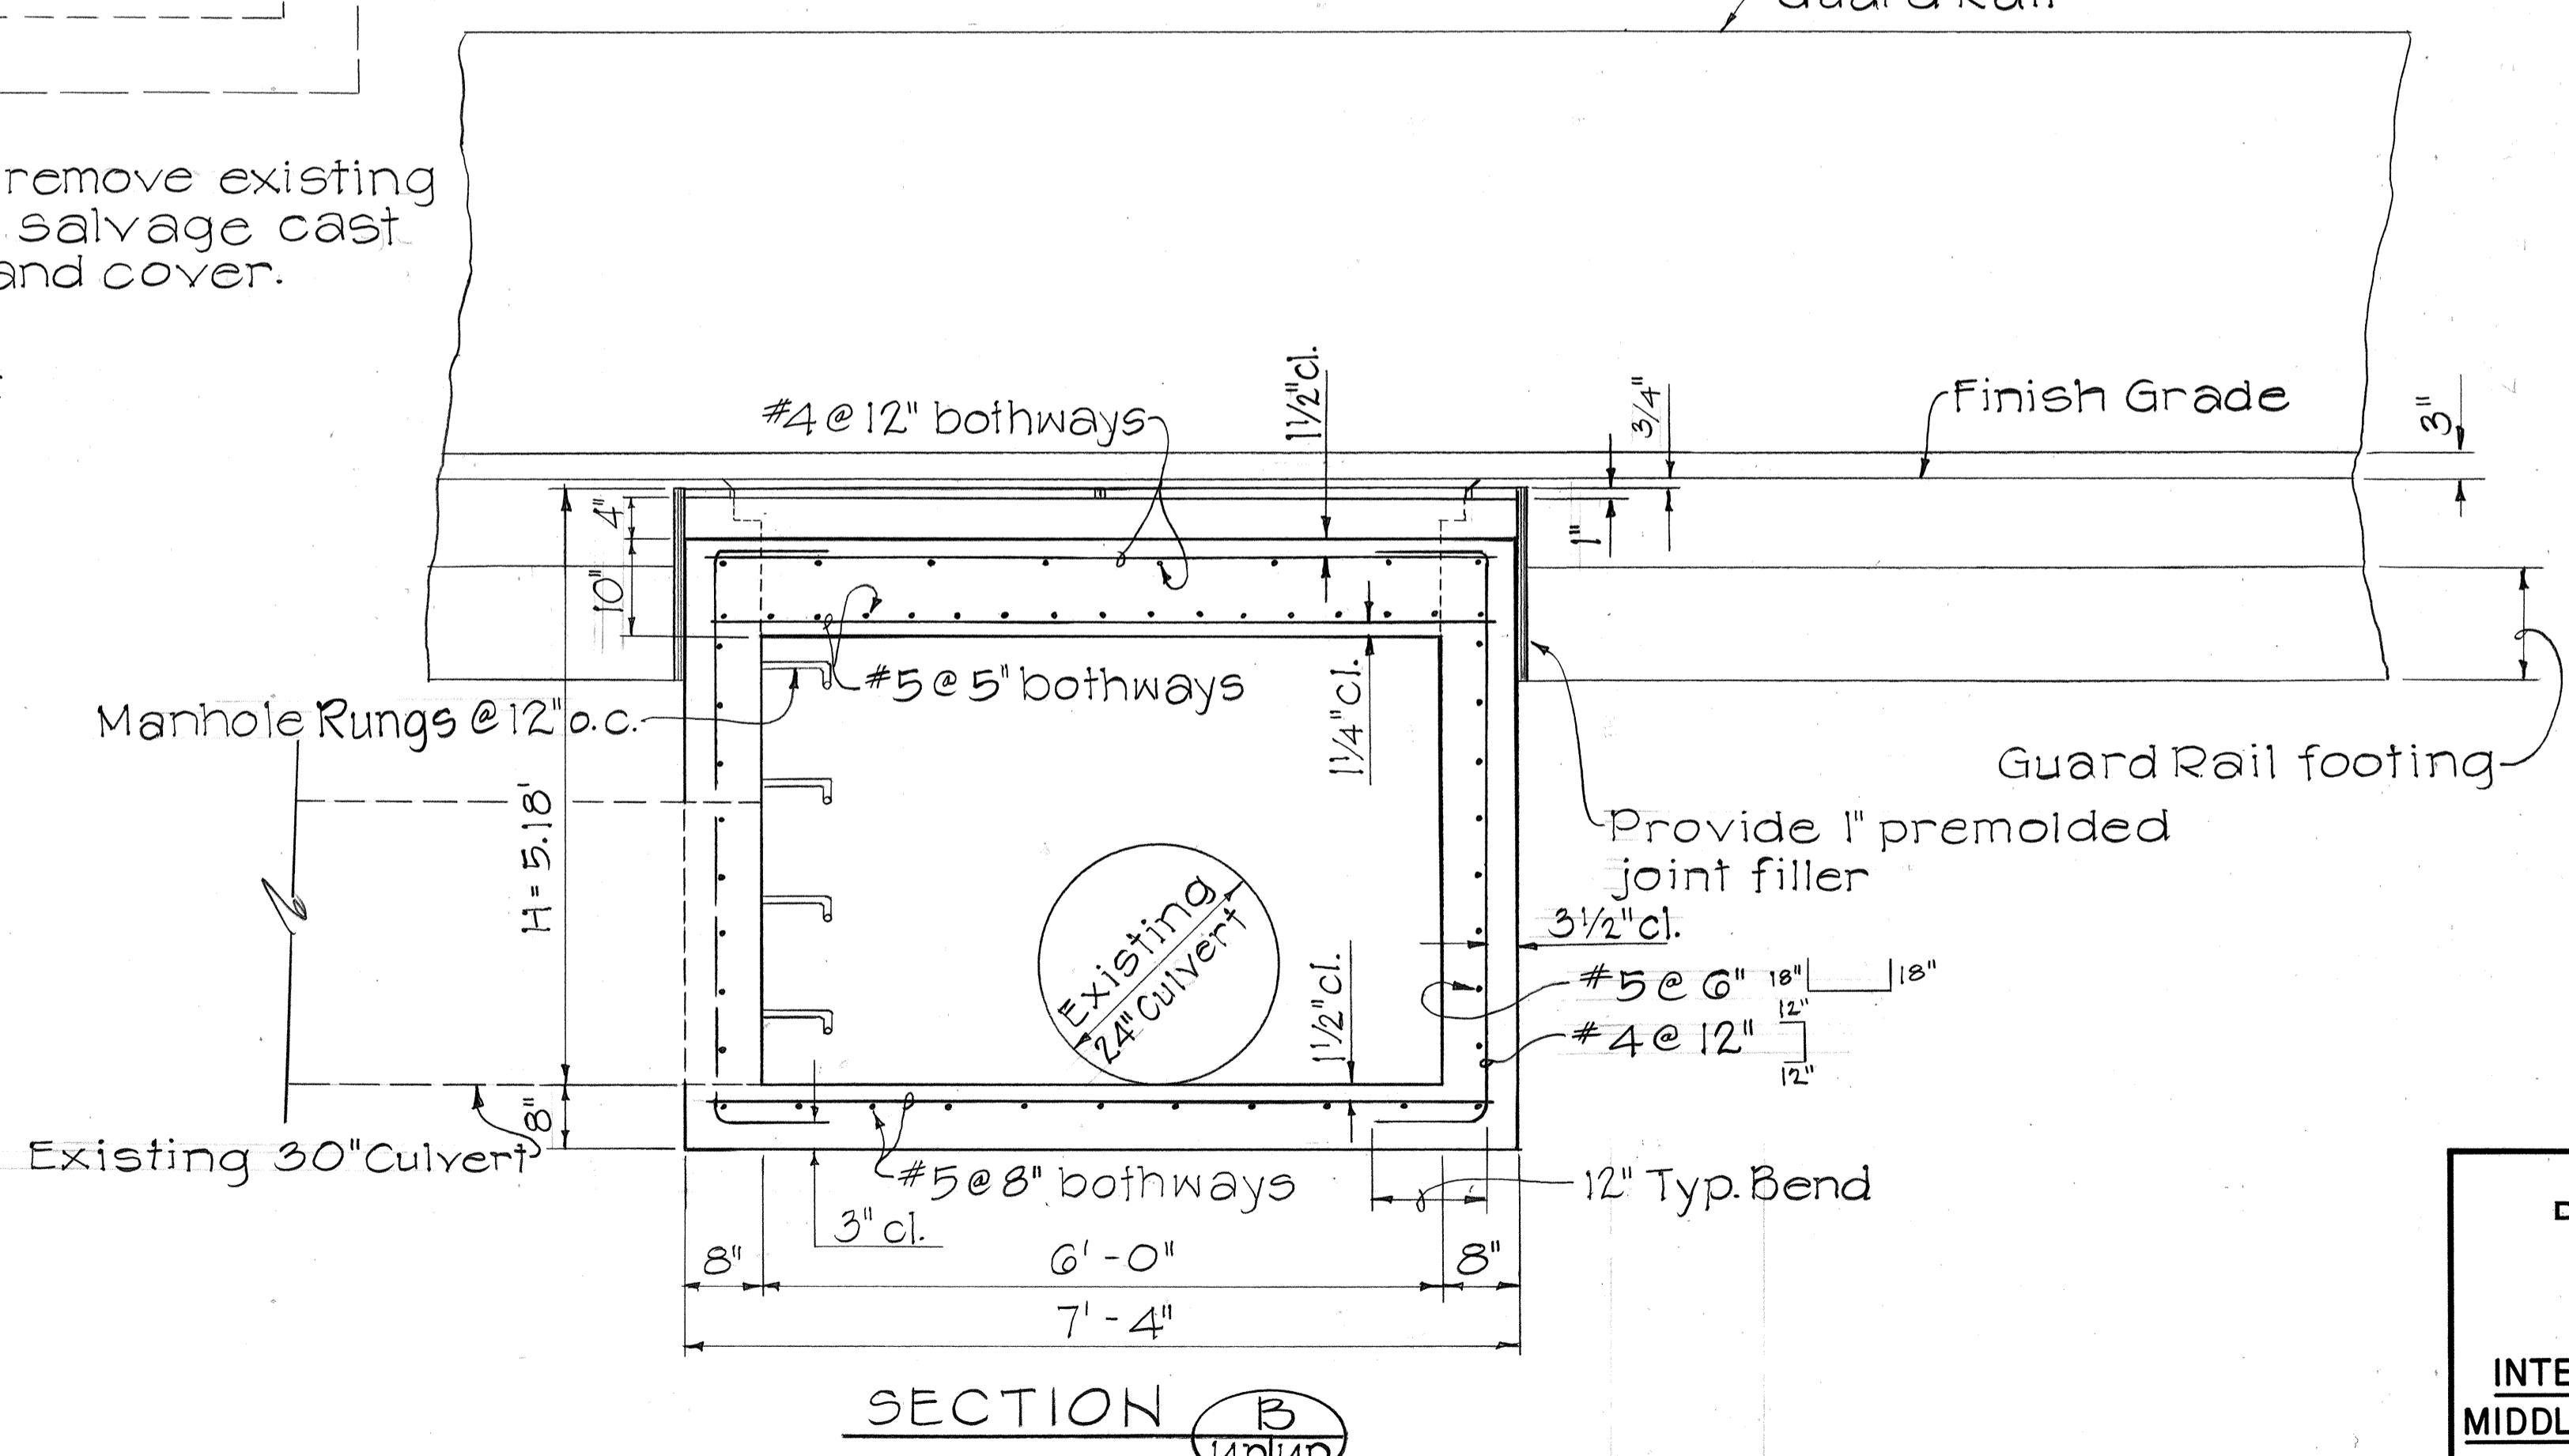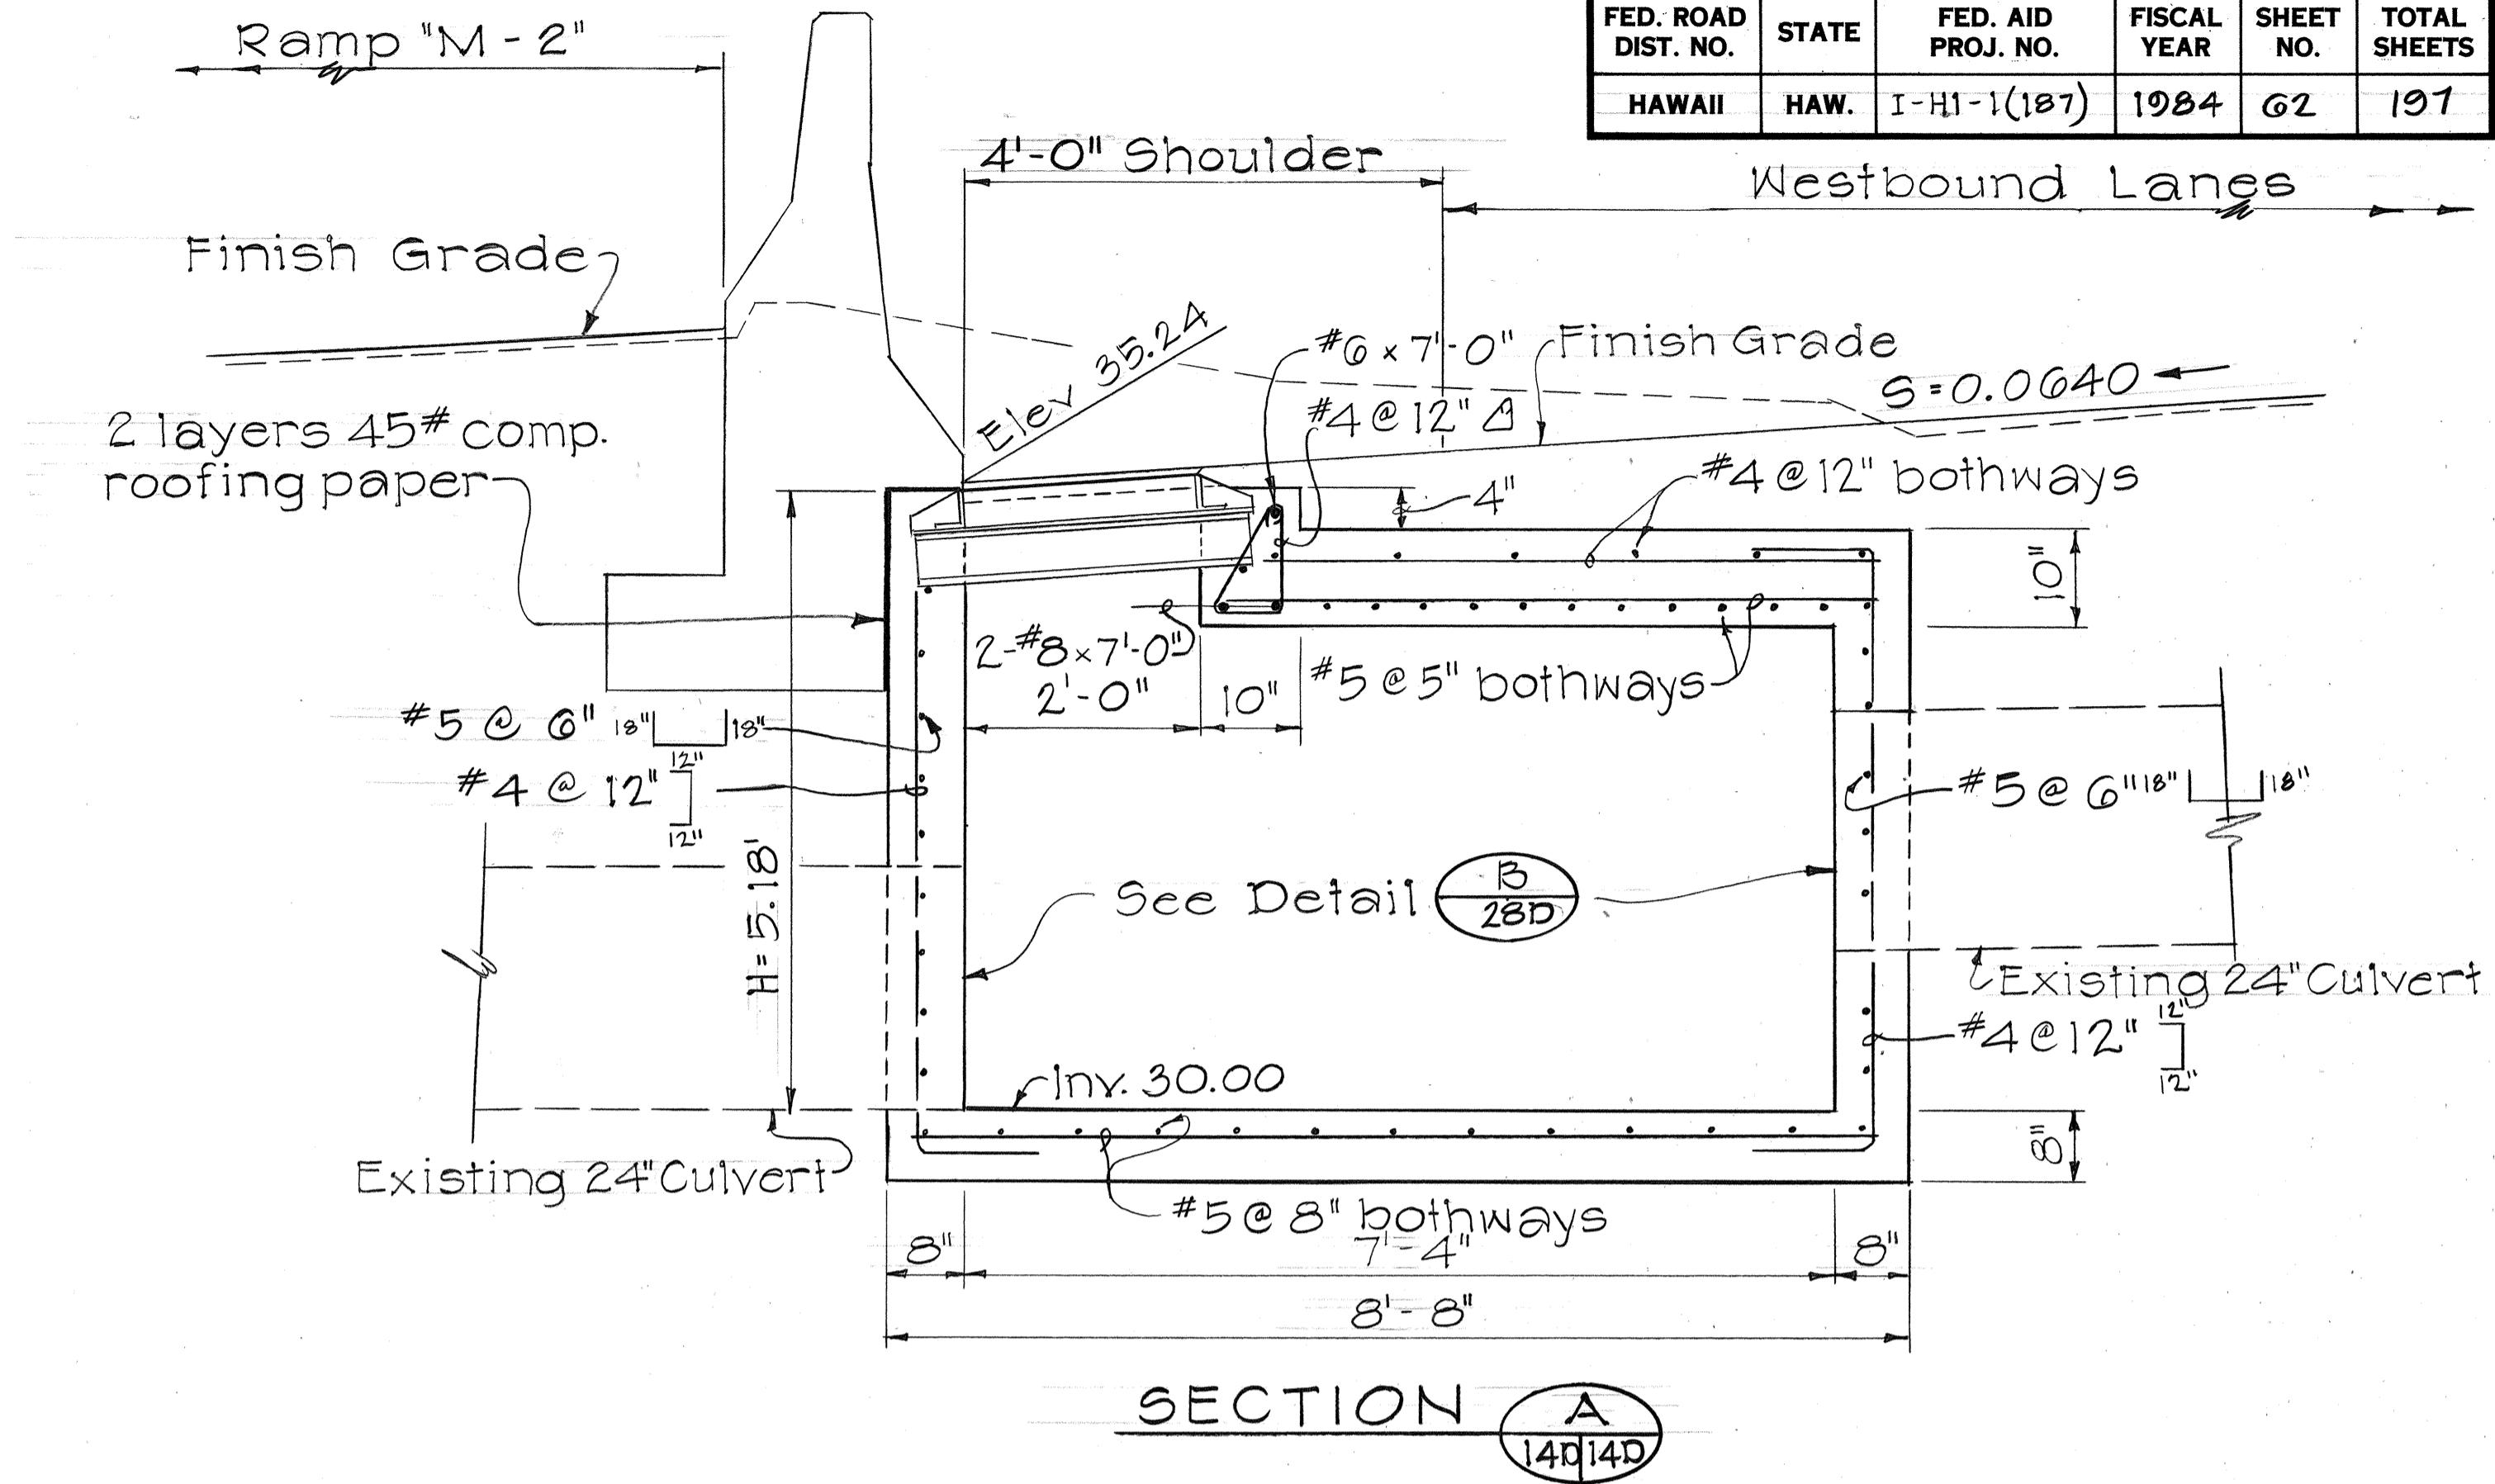


STATE OF HAWAII  
DEPARTMENT OF TRANSPORTATION  
HIGHWAYS DIVISION  
**DRAINAGE DETAILS**  
INTERSTATE ROUTE H-I IMPROVEMENTS  
MIDDLE STREET TO KALIHI INTERCHANGE  
WESTBOUND LANES  
F.A.I. PROJ. NO. I-HI-1(187)  
SCALE: 3/4" = 1'-0" DATE: JUNE 1983  
SHEET NO. 14DOF 39 SHEETS

| FED. ROAD DIST. NO. | STATE | FED. AID PROJ. NO. | FISCAL YEAR | SHEET NO. | TOTAL SHEETS |
|---------------------|-------|--------------------|-------------|-----------|--------------|
| HAWAII              | HAW.  | I-HI-1(187)        | 1984        | 63        | 197          |

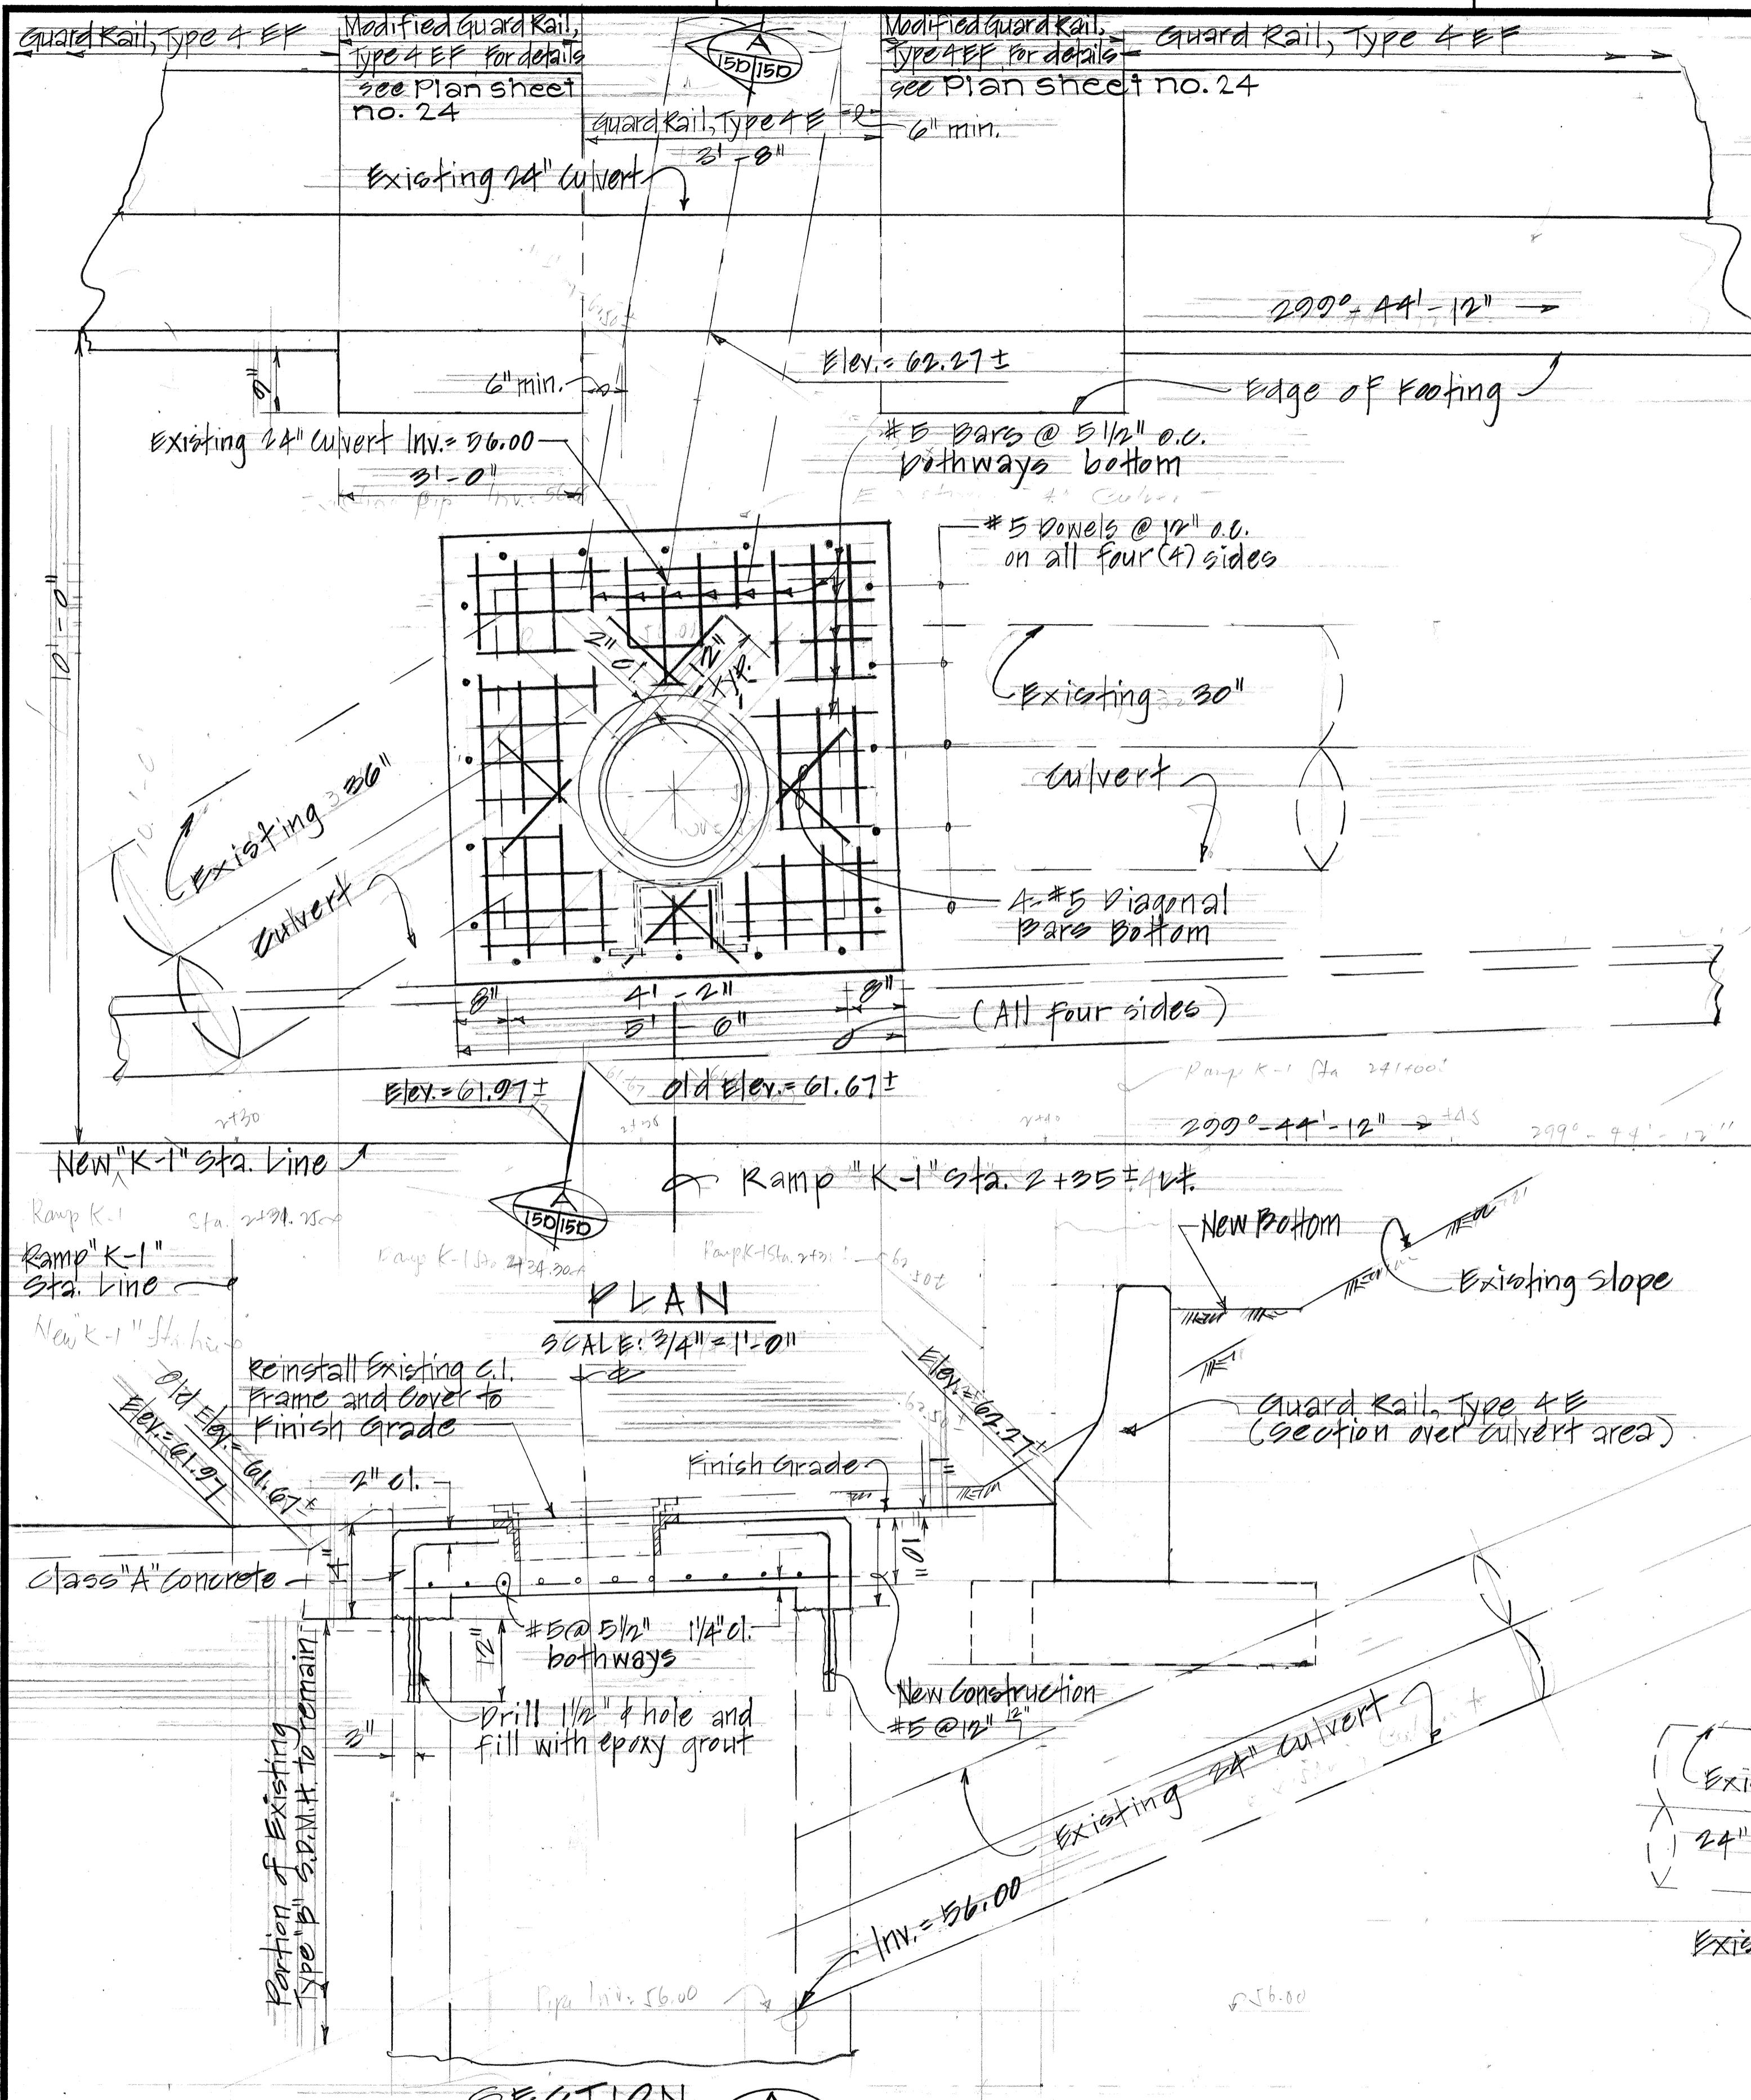


**DETAILS OF RECONSTRUCTED TOP SLAB FOR EXISTING TYPE "B" S.D.M.H. #22 RAMP "K-1" STA. 2+38 ± LT.**

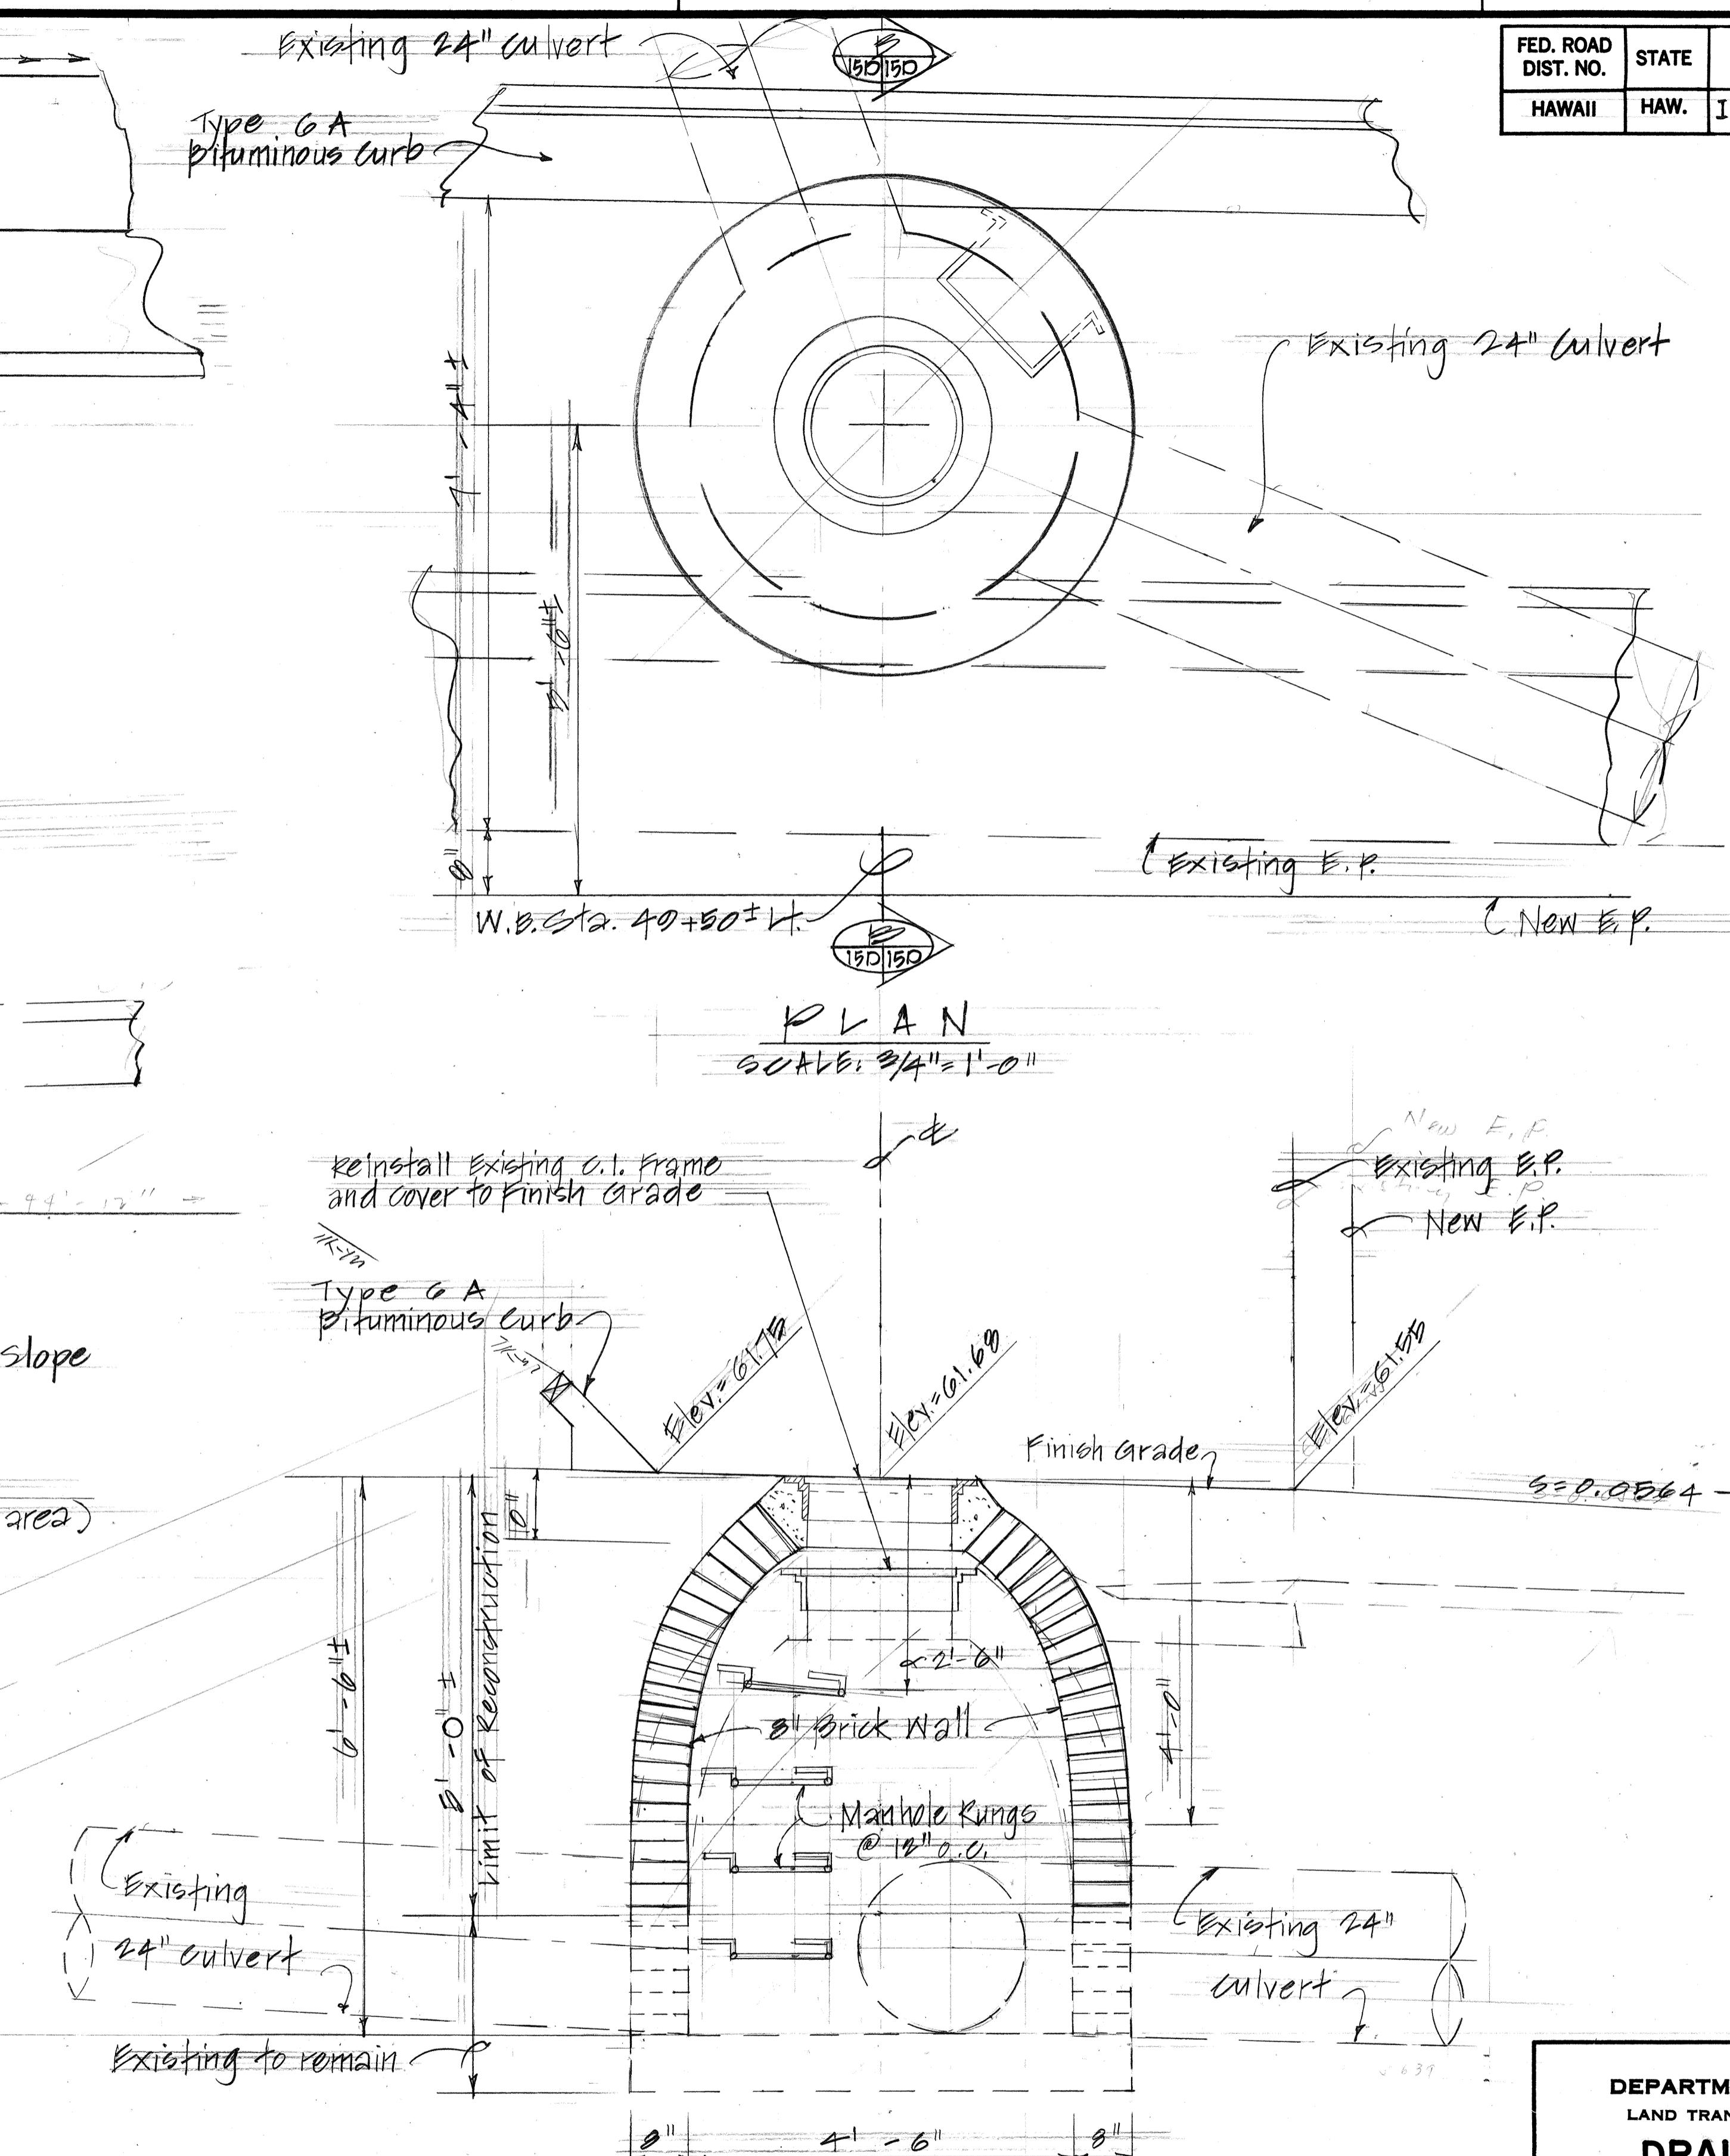

**RECONSTRUCTION OF EXISTING TYPE "D" S.D.M.H. #31 AT W.B. STA. 49+50 ± LT.**

STATE OF HAWAII  
DEPARTMENT OF TRANSPORTATION  
LAND TRANSPORTATION FACILITIES DIVISION  
**DRAINAGE DETAILS**  
INTERSTATE ROUTE H-I IMPROVEMENTS  
MIDDLE STREET TO KALIHI INTERCHANGE  
WESTBOUND LANES  
F.A. PROJ. NO. I-HI-1(187)  
SCALE:  $3/4"-1'-0"$  DATE: JUNE 1983  
SHEET NO. 150 OF 39 SHEETS

| FED. ROAD DIST. NO. | STATE | FED. AID PROJ. NO. | FISCAL YEAR | SHEET NO. | TOTAL SHEETS |
|---------------------|-------|--------------------|-------------|-----------|--------------|
| HAWAII              | HAW.  | I-HI-1(187)        | 1984        | 64        | 197          |



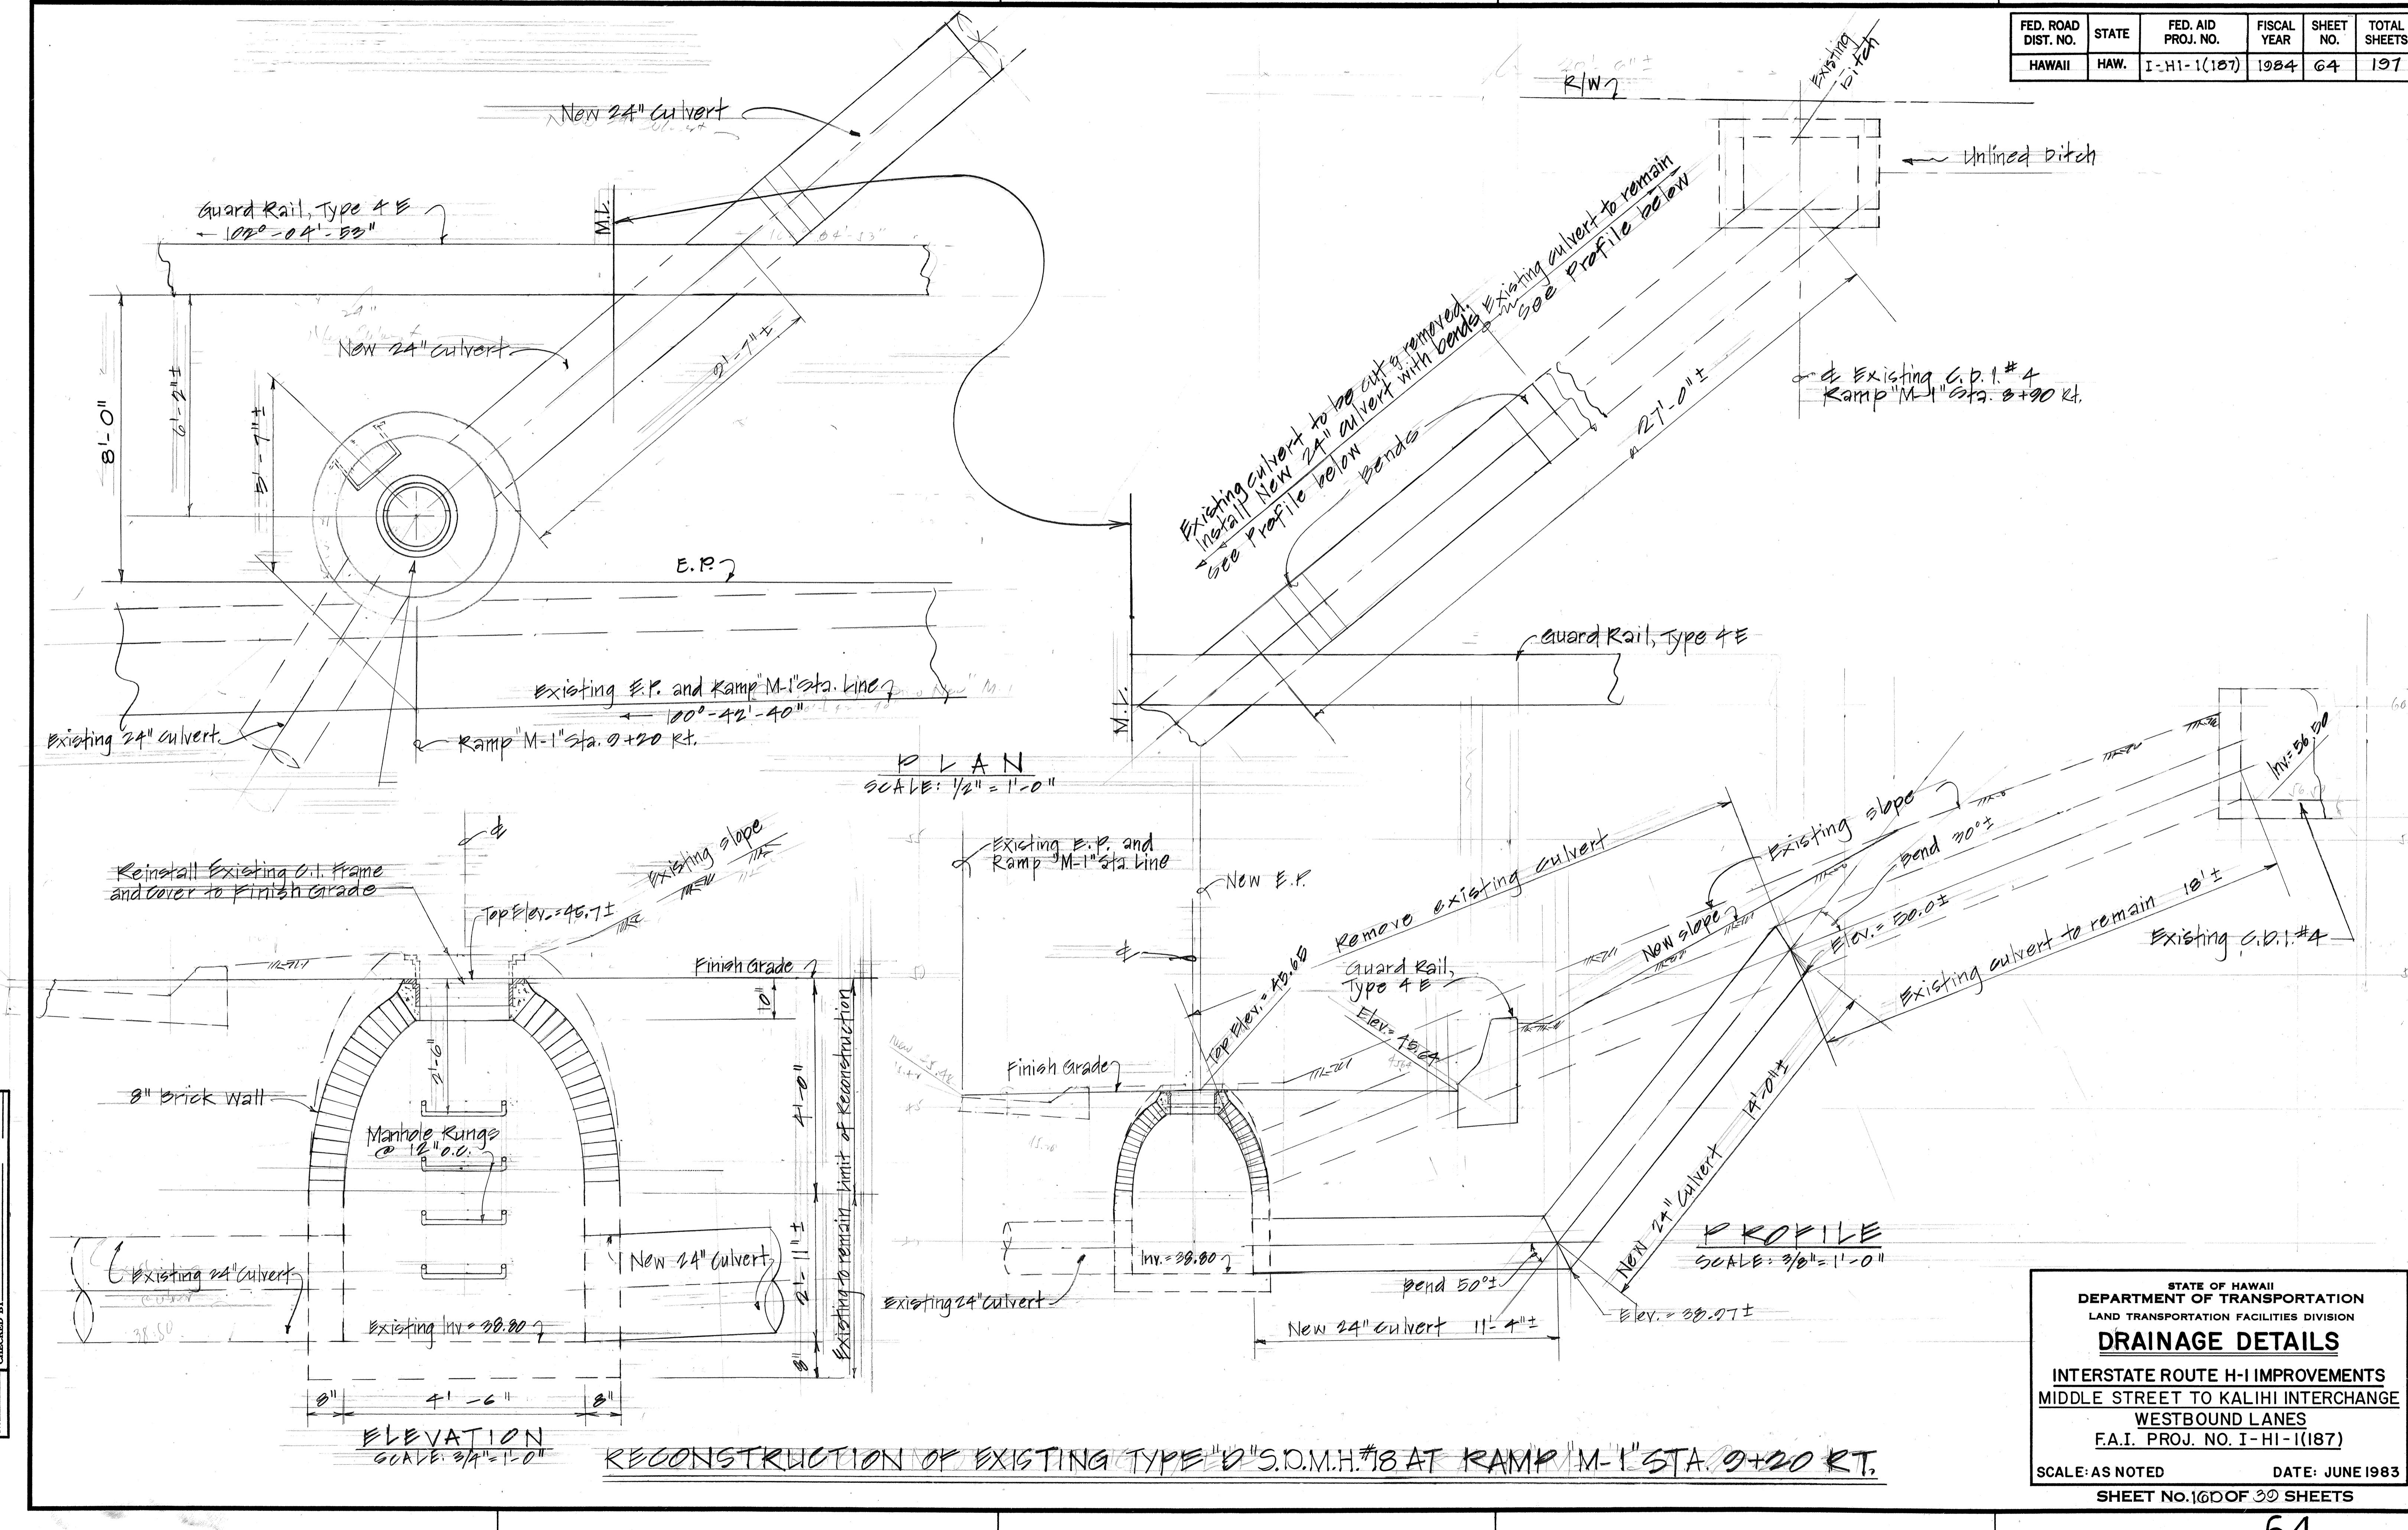


STATE OF HAWAII  
DEPARTMENT OF TRANSPORTATION  
LAND TRANSPORTATION FACILITIES DIVISION  
**DRAINAGE DETAILS**

INTERSTATE ROUTE H-I IMPROVEMENTS  
MIDDLE STREET TO KALIHI INTERCHANGE  
WESTBOUND LANES  
F.A.I. PROJ. NO. I-HI-1(187)



SCALE: AS NOTED  
DATE: JUNE 1983  
SHEET NO. 160 OF 39 SHEETS

| FED. ROAD DIST. NO. | STATE | FED. AID PROJ. NO. | FISCAL YEAR | SHEET NO. | TOTAL SHEETS |
|---------------------|-------|--------------------|-------------|-----------|--------------|
| HAWAII              | HAW.  | I-HI-1(187)        | 1984        | 65        | 197          |

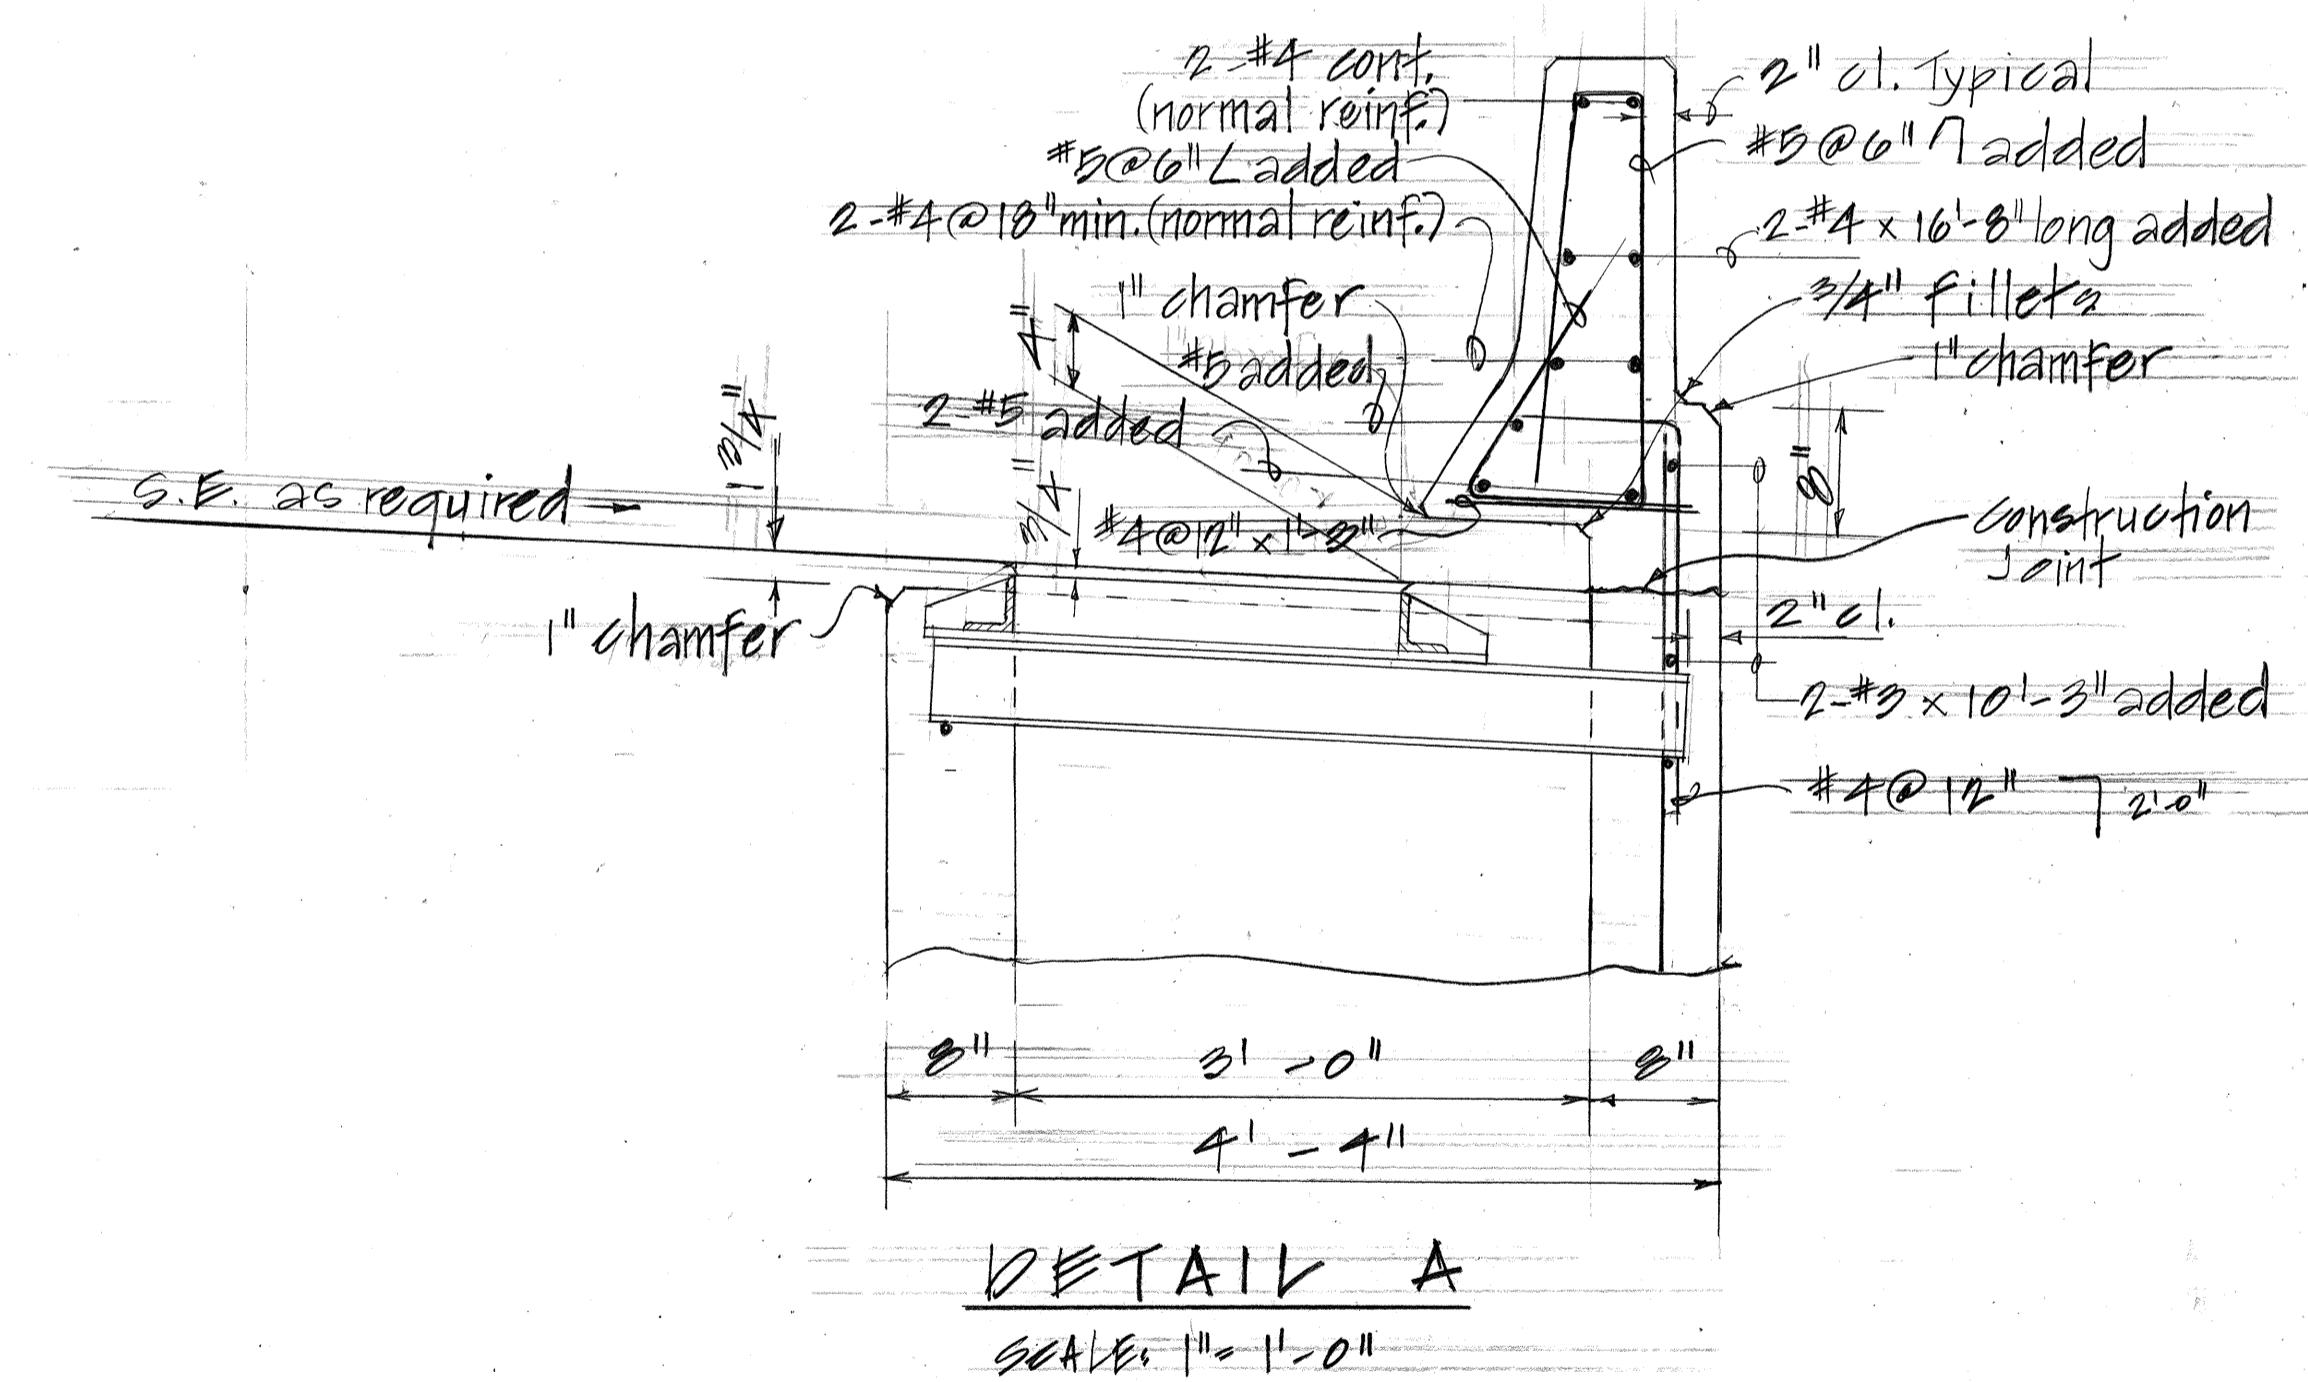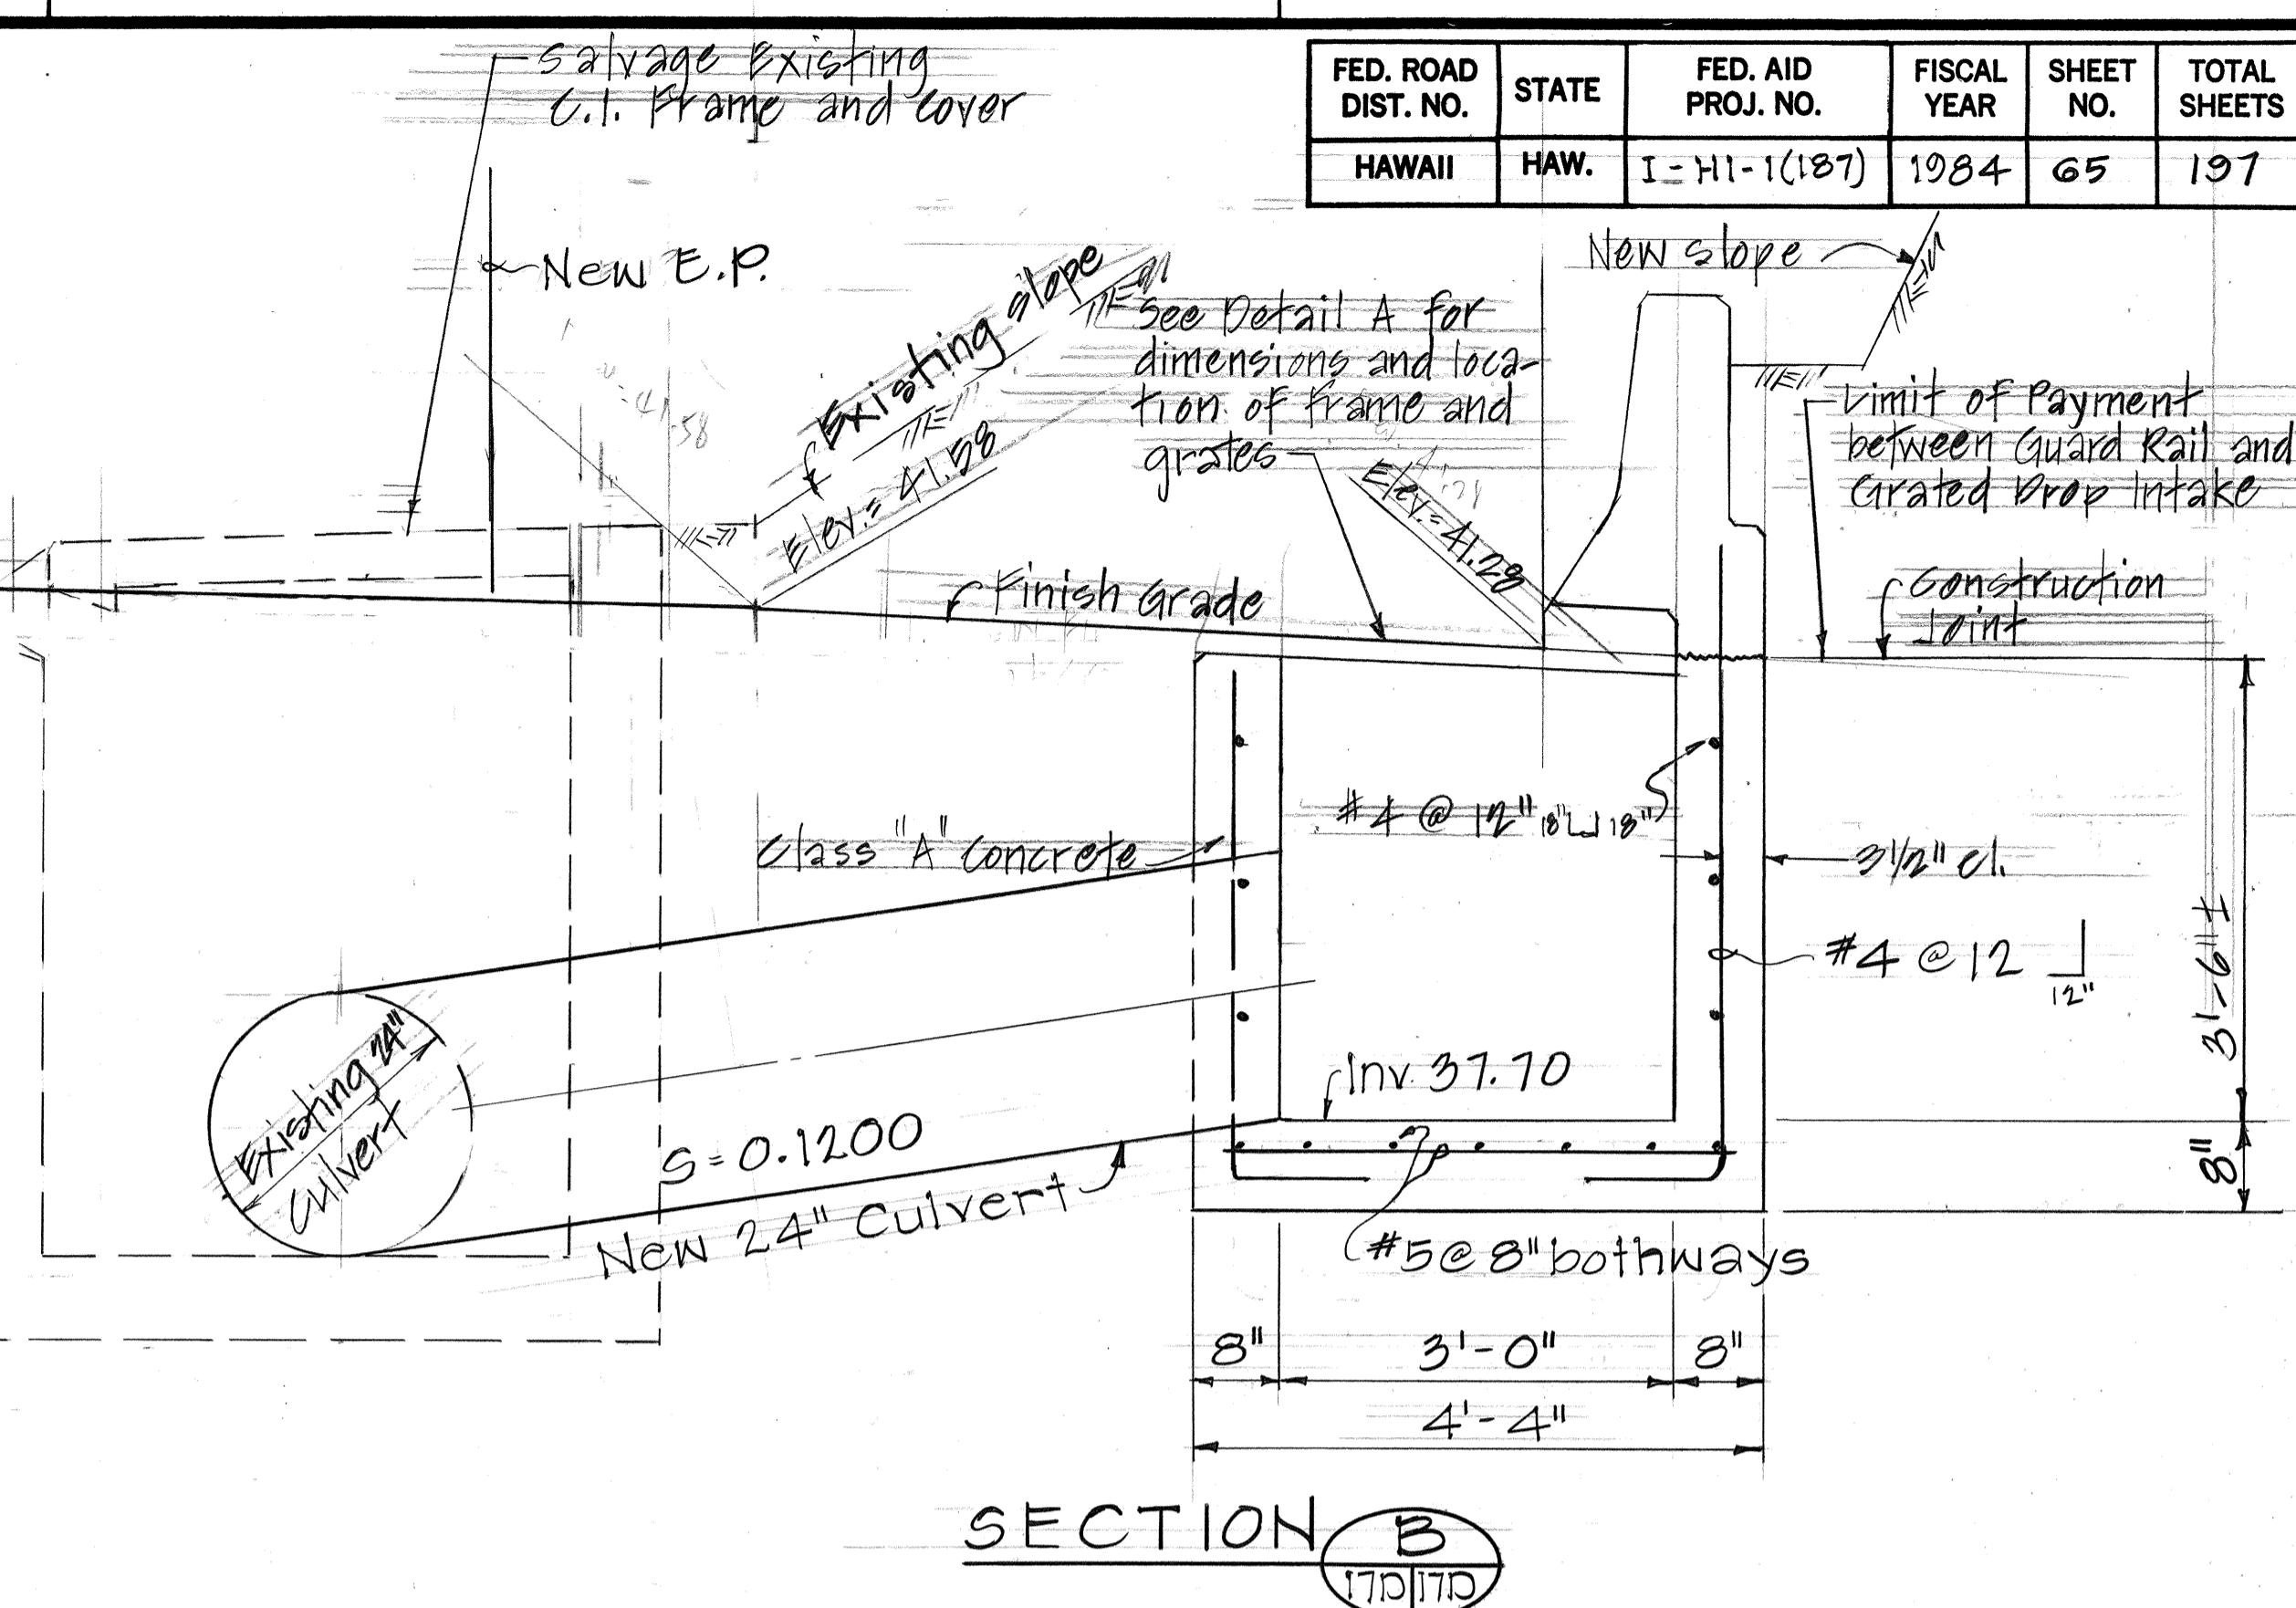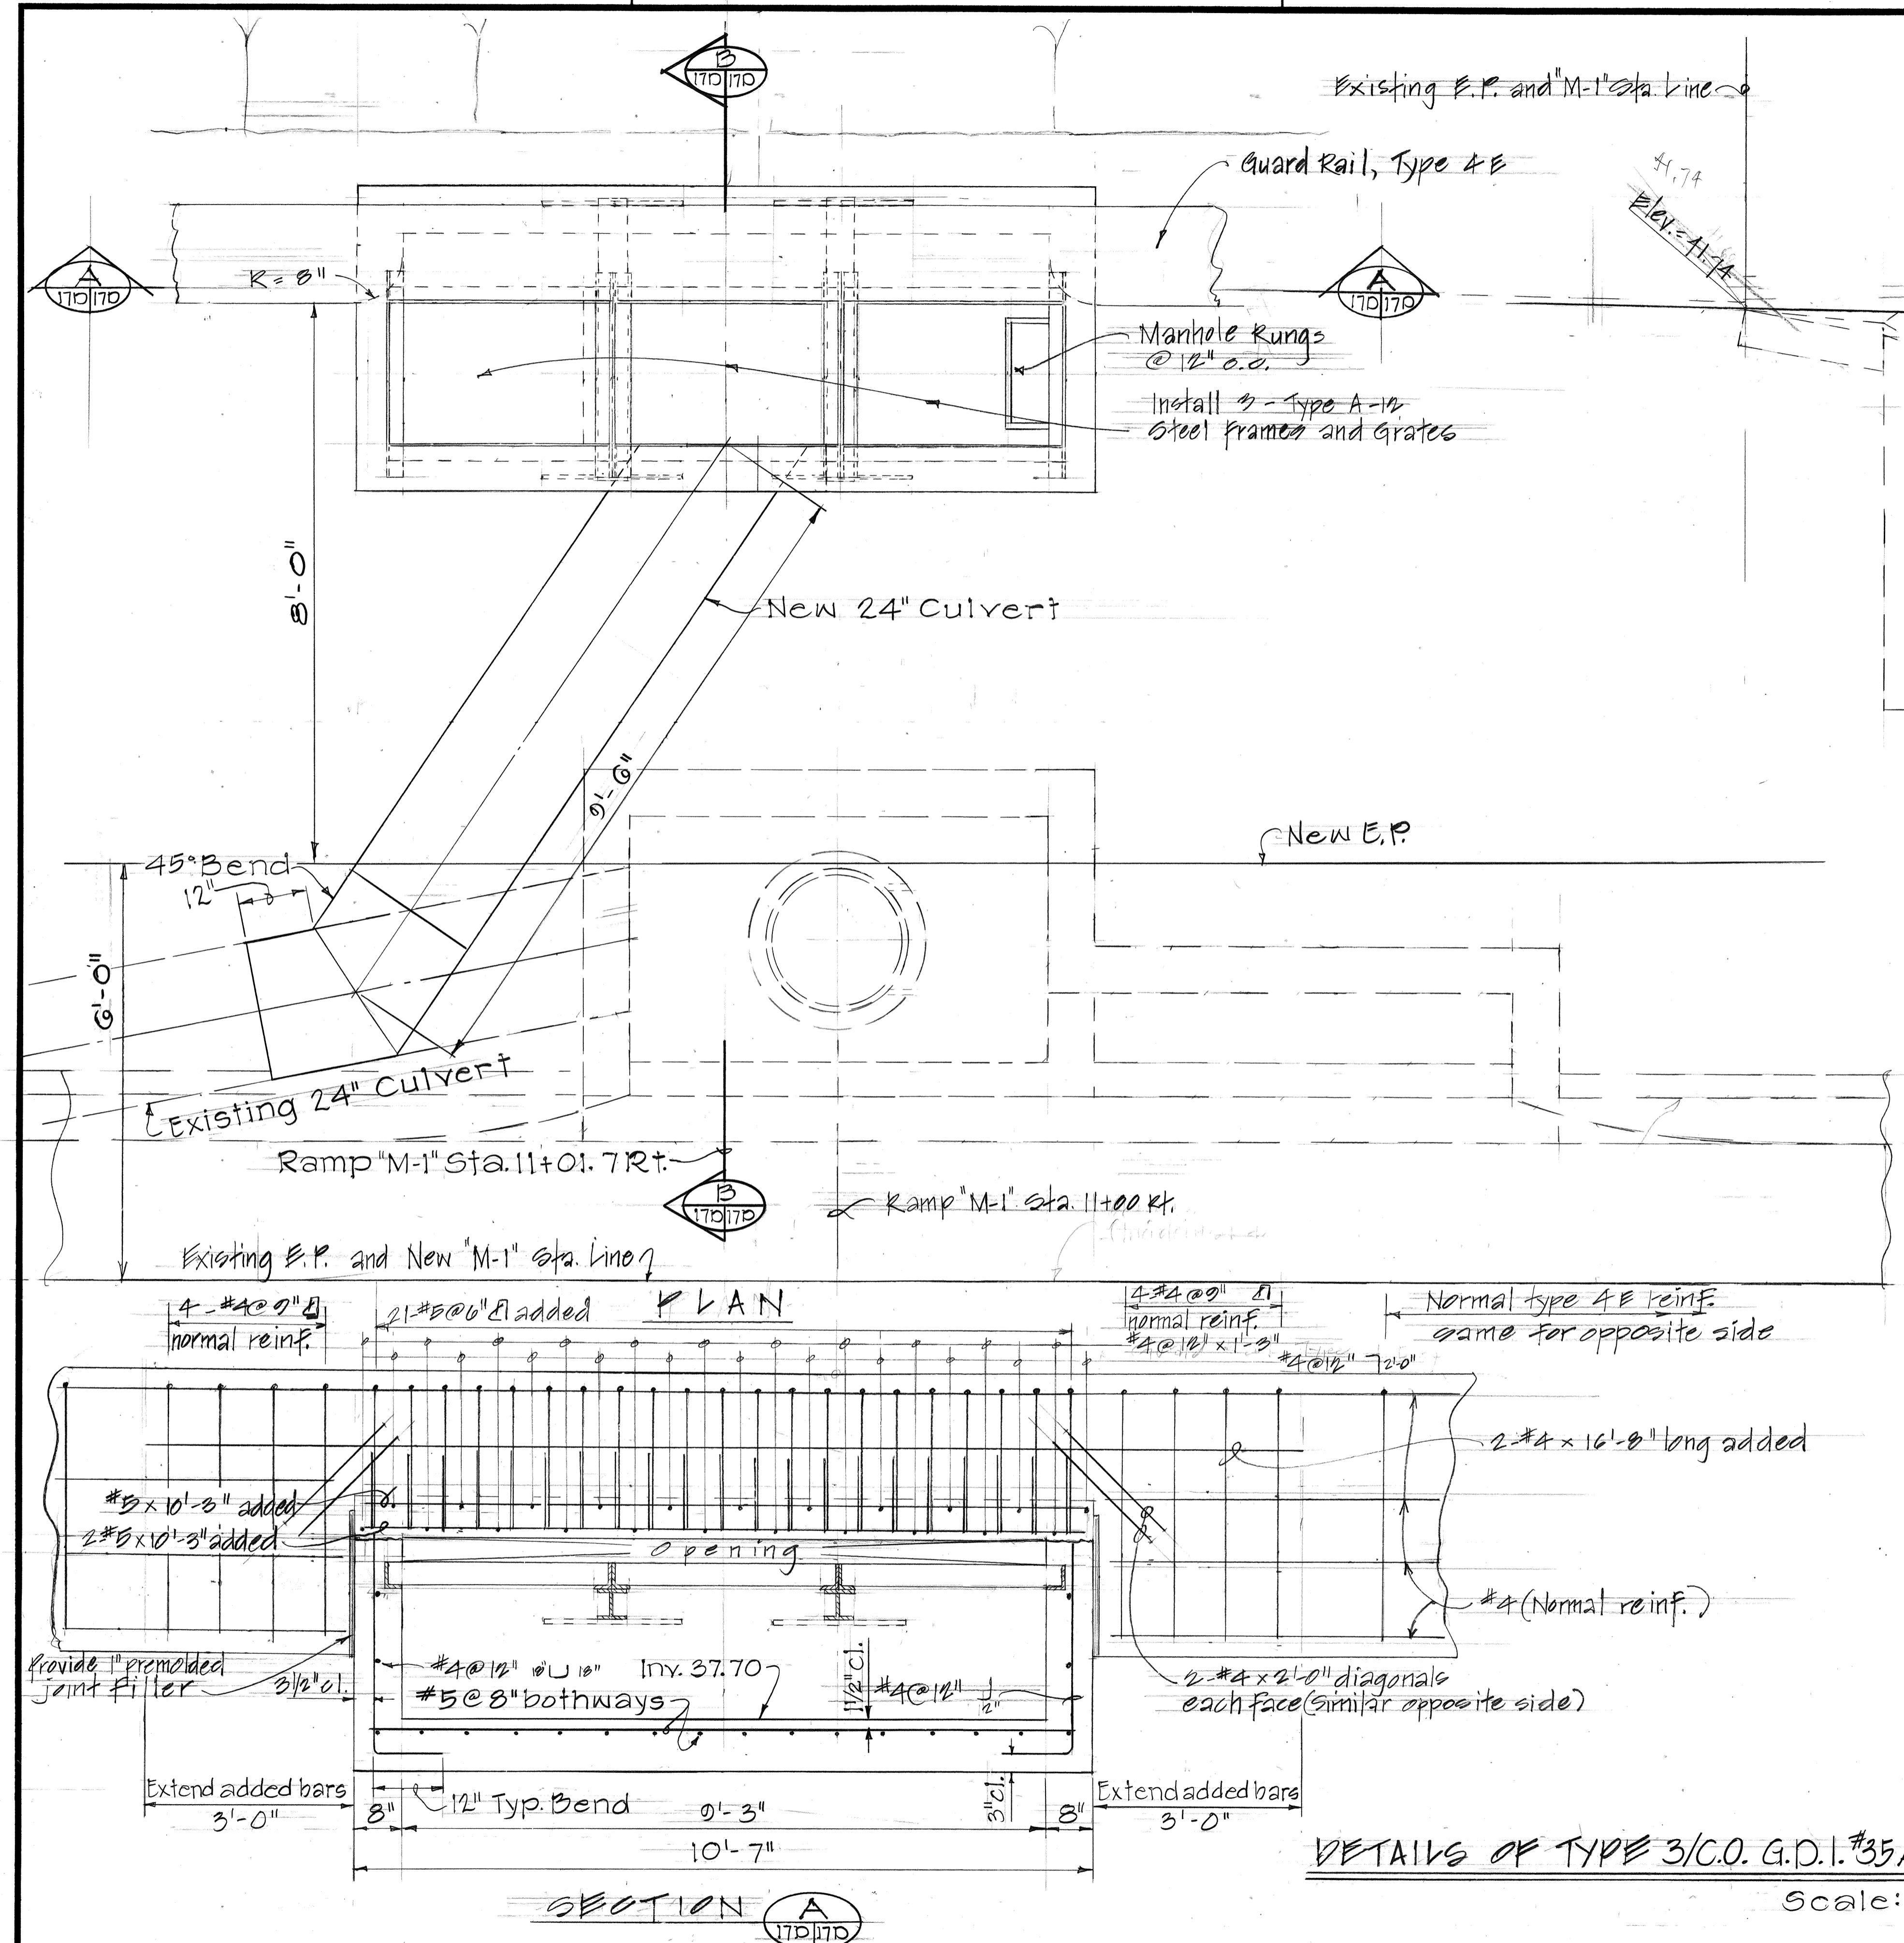


STATE OF HAWAII  
DEPARTMENT OF TRANSPORTATION  
LAND TRANSPORTATION FACILITIES DIVISION  
**DRAINAGE DETAILS**  
INTERSTATE ROUTE H-1 IMPROVEMENTS  
MIDDLE STREET TO KALIHI INTERCHANGE  
WESTBOUND LANES  
F.A.I. PROJ. NO. I-HI-1(187)  
SCALE: AS NOTED DATE: JUNE 1983  
SHEET NO. 17D OF 30 SHEETS

| FED. ROAD DIST. NO. | STATE | FED. AID PROJ. NO. | FISCAL YEAR | SHEET NO. | TOTAL SHEETS |
|---------------------|-------|--------------------|-------------|-----------|--------------|
| HAWAII              | HAW.  | I-HI-1(187)        | 1984        | 66        | 191          |

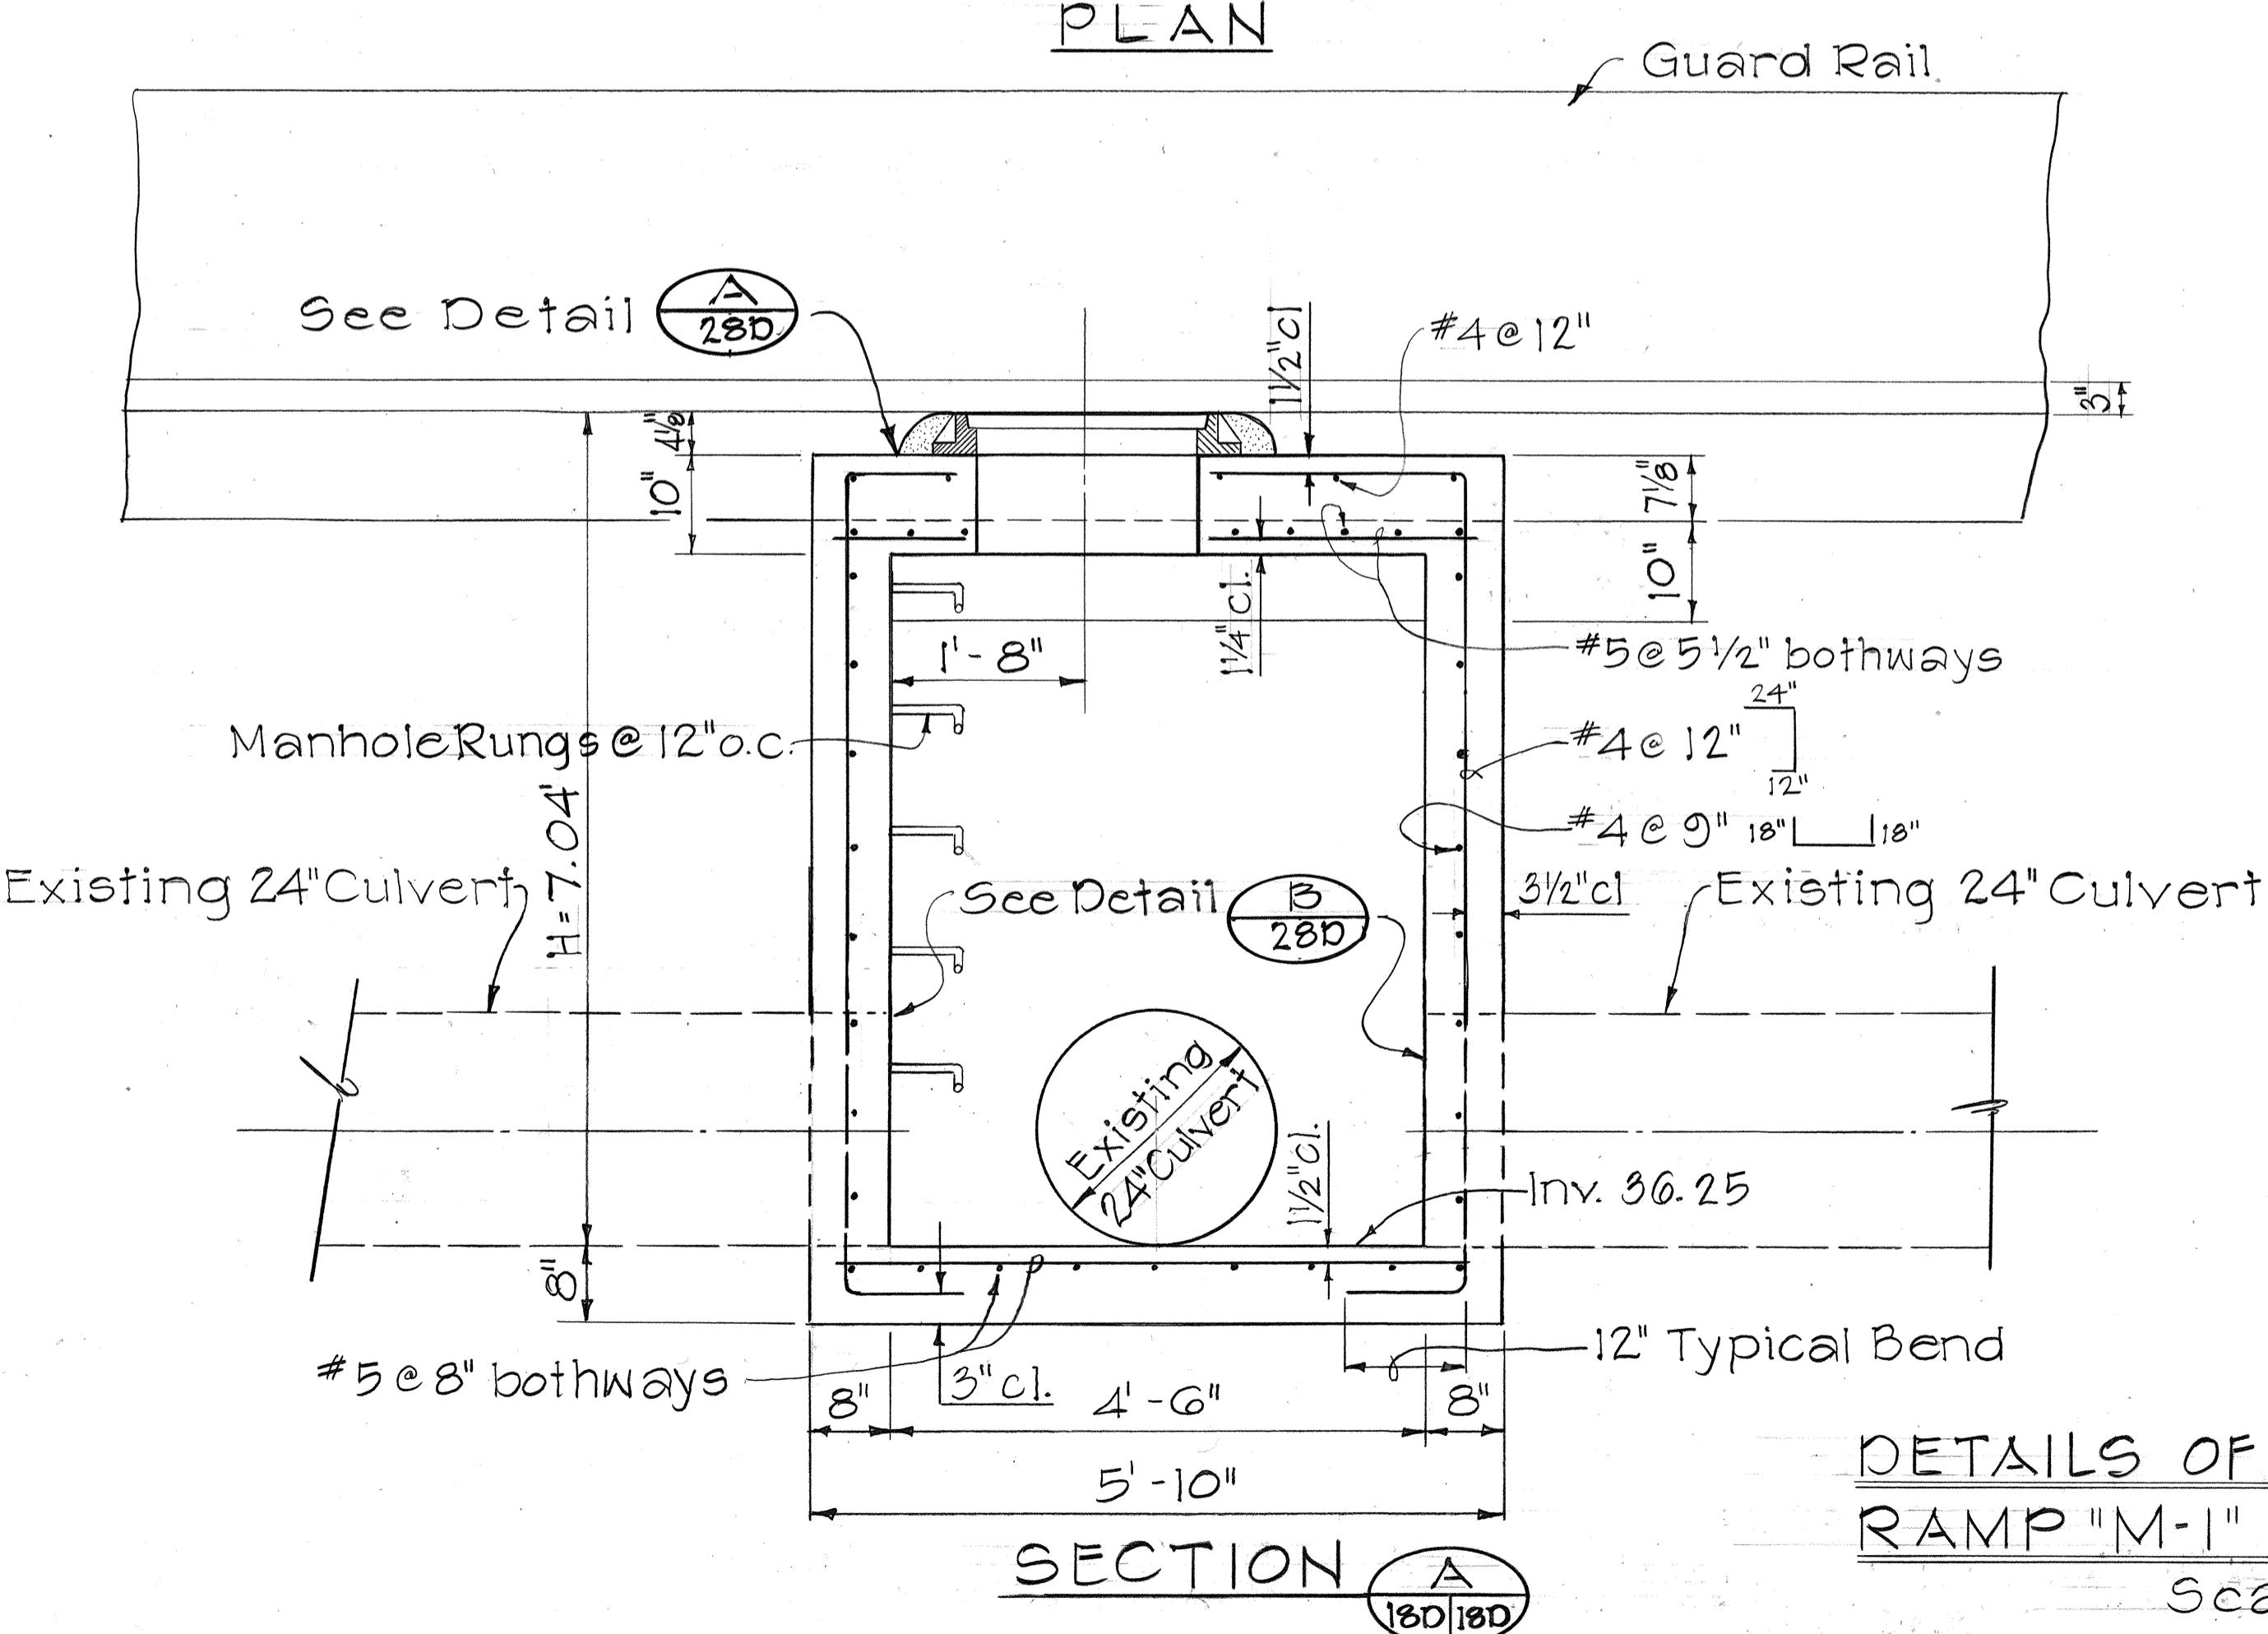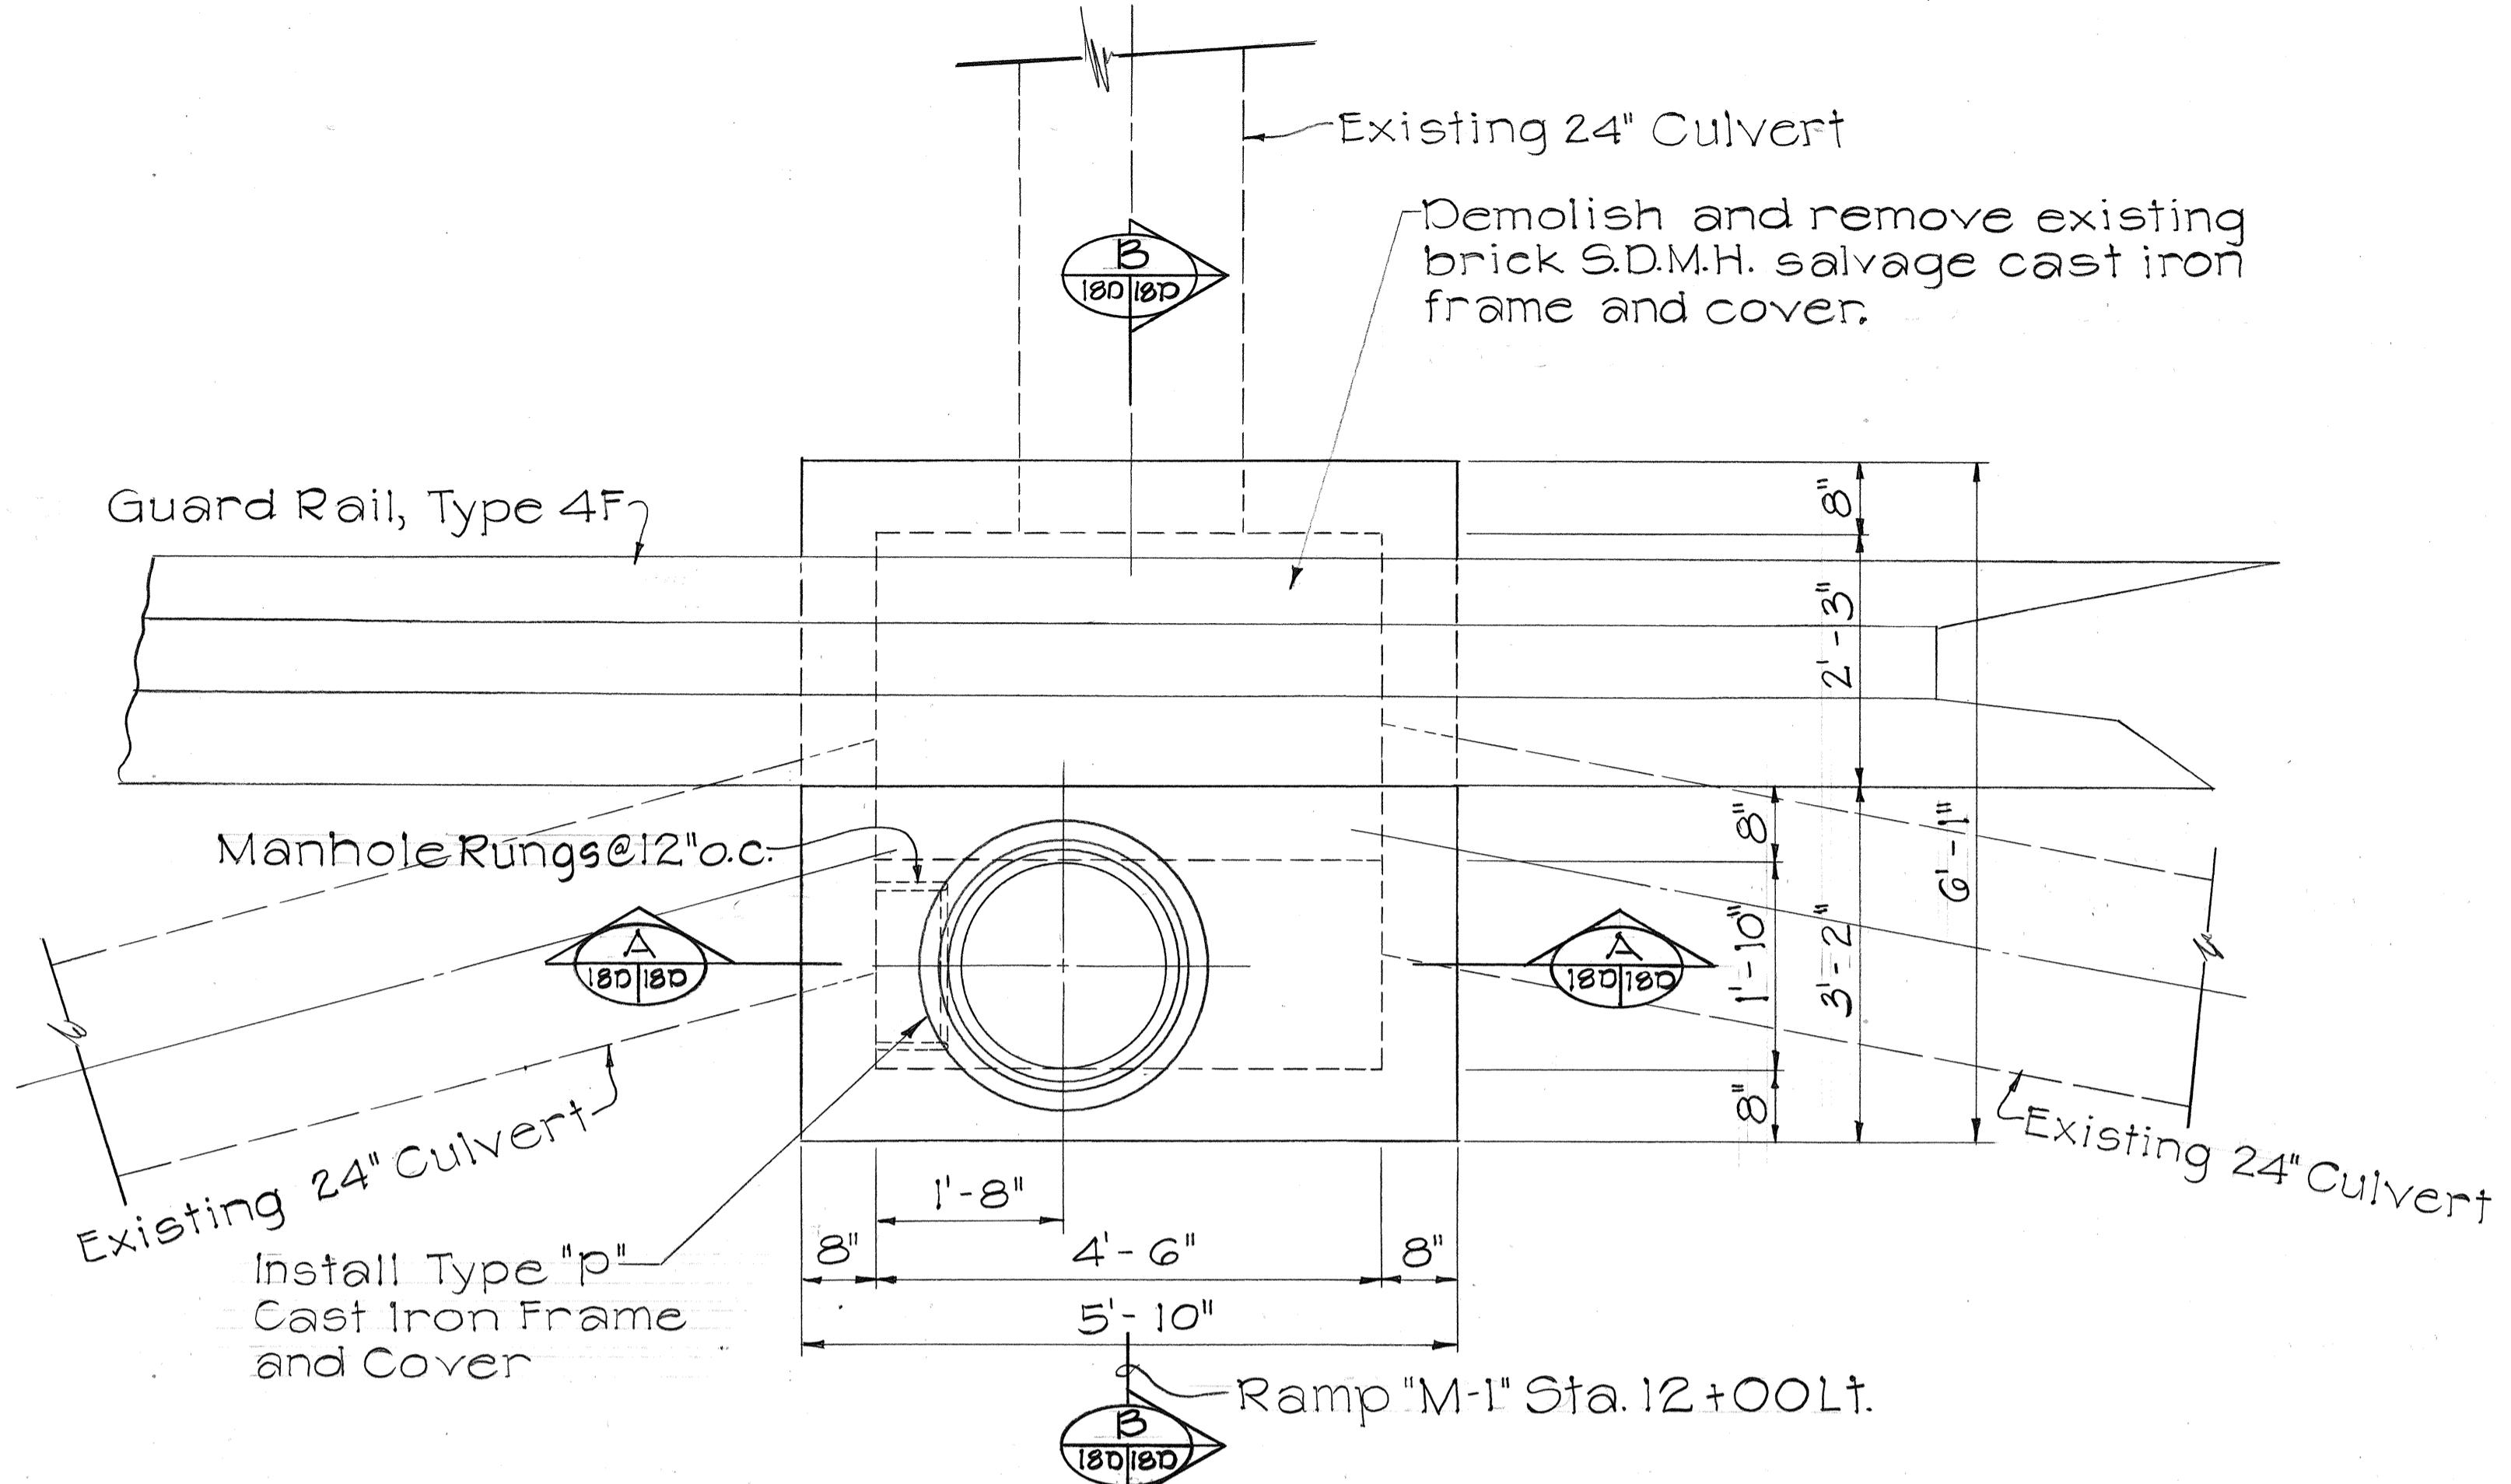




DETAILS OF TYPE "M" S.D.M.H. #15 AT  
RAMP "M-1" STA. 12+00 LT.

Scale: 3/4" = 1'-0"

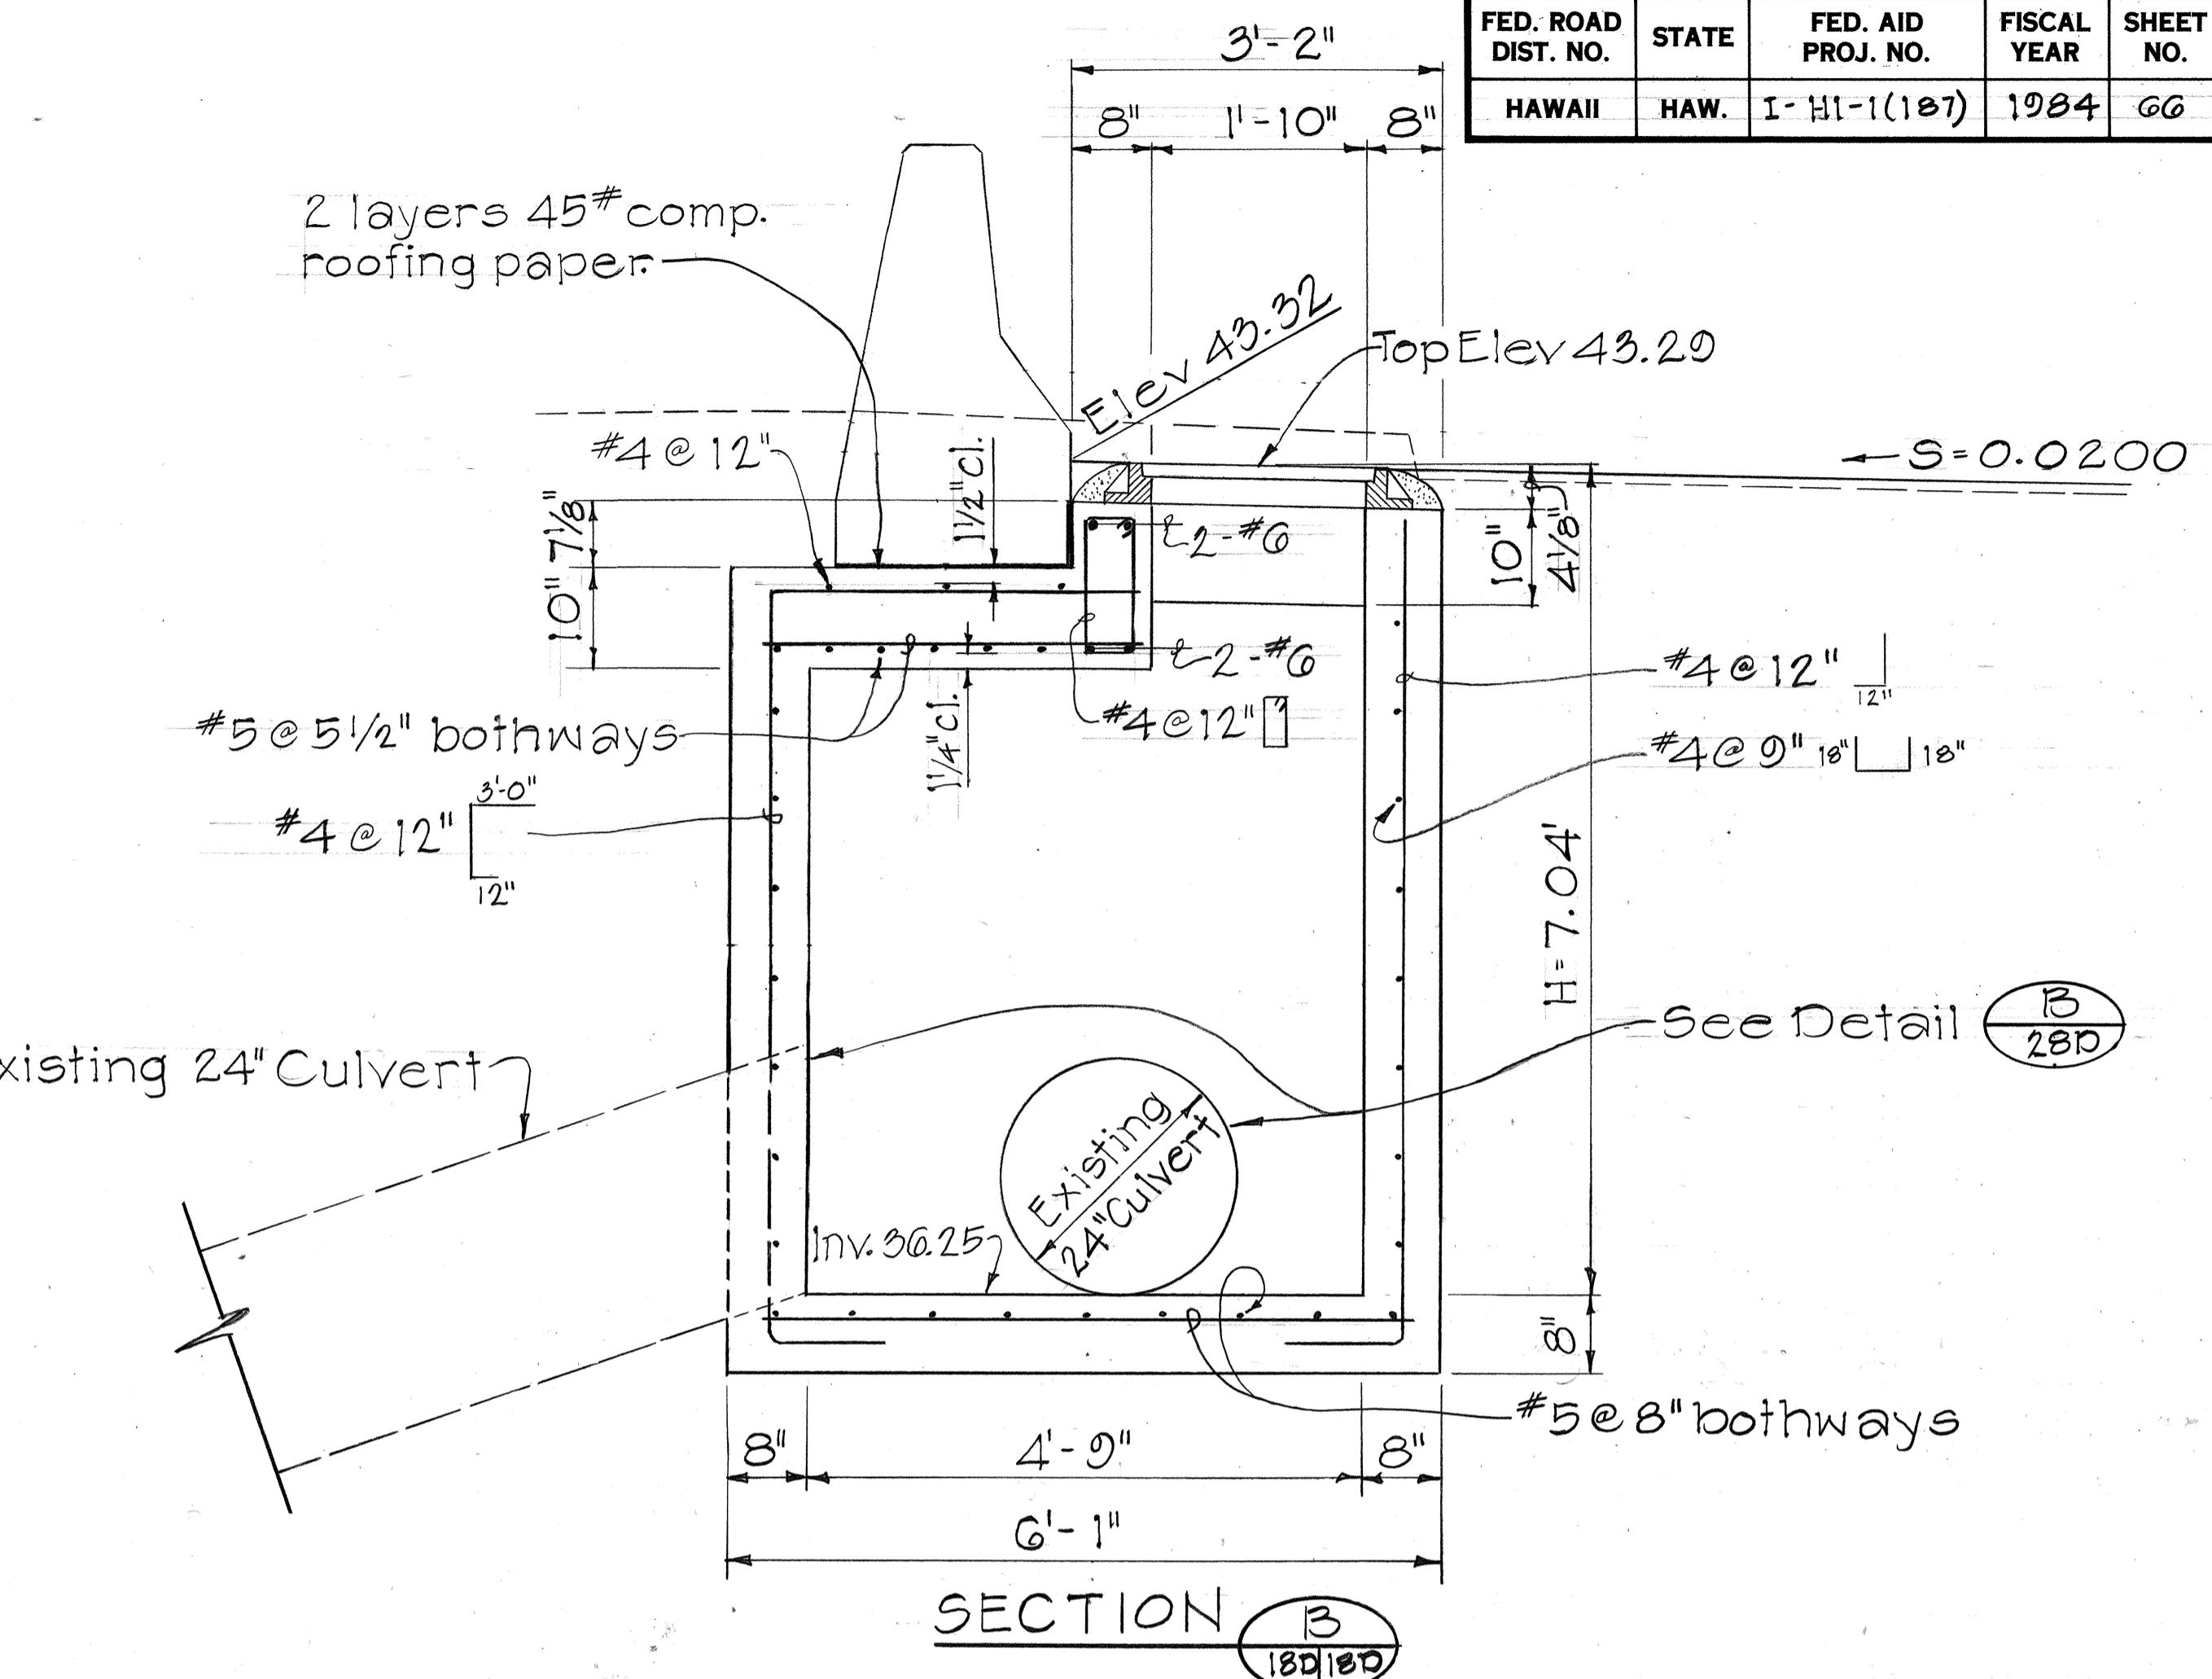

STATE OF HAWAII  
DEPARTMENT OF TRANSPORTATION  
HIGHWAYS DIVISION  
**DRAINAGE DETAILS**  
INTERSTATE ROUTE H-1 IMPROVEMENTS  
MIDDLE STREET TO KALIHI INTERCHANGE  
WESTBOUND LANES  
F.A.I. PROJ. NO. I-HI-1(187)  
SCALE: 3/4" = 1'-0" DATE: JUNE 1983  
SHEET NO. 18D OF 30 SHEETS


| FED. ROAD<br>DIST. NO. | STATE | FED. AID<br>PROJ. NO. | FISCAL<br>YEAR | SHEET<br>NO. | TOTAL<br>SHEETS |
|------------------------|-------|-----------------------|----------------|--------------|-----------------|
| HAWAII                 | HAW.  | I-HI-1(187)           | 1984           | 67           | 197             |

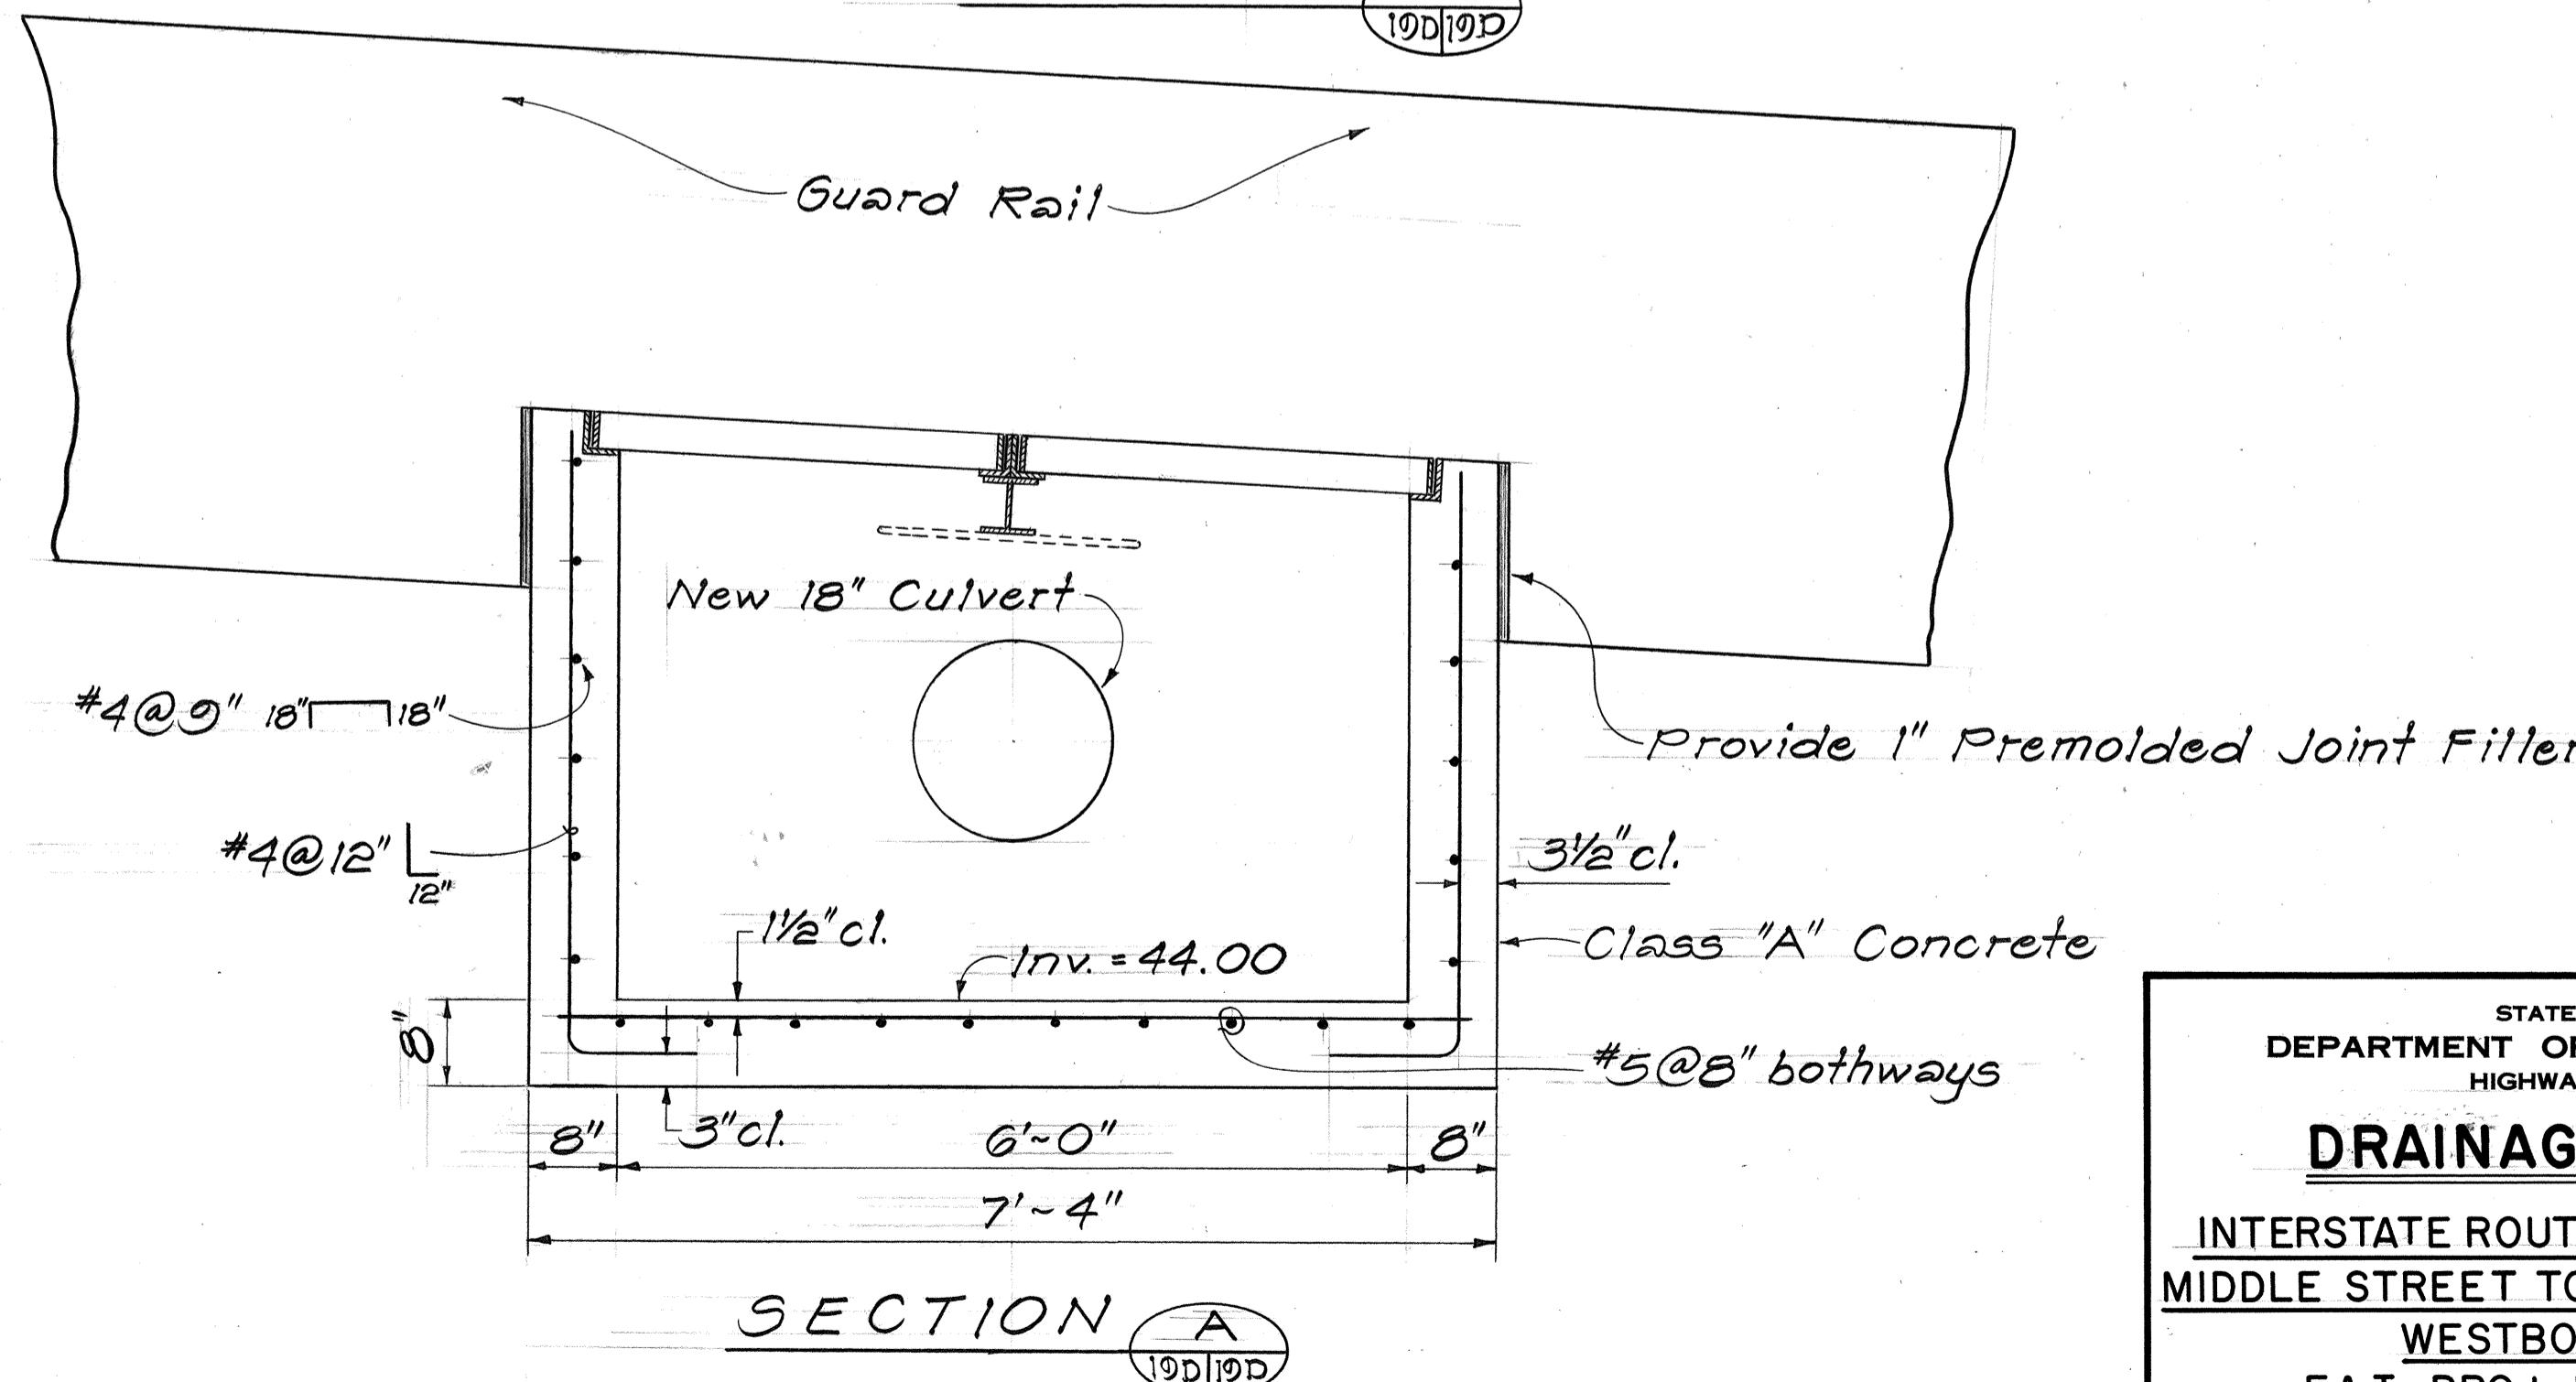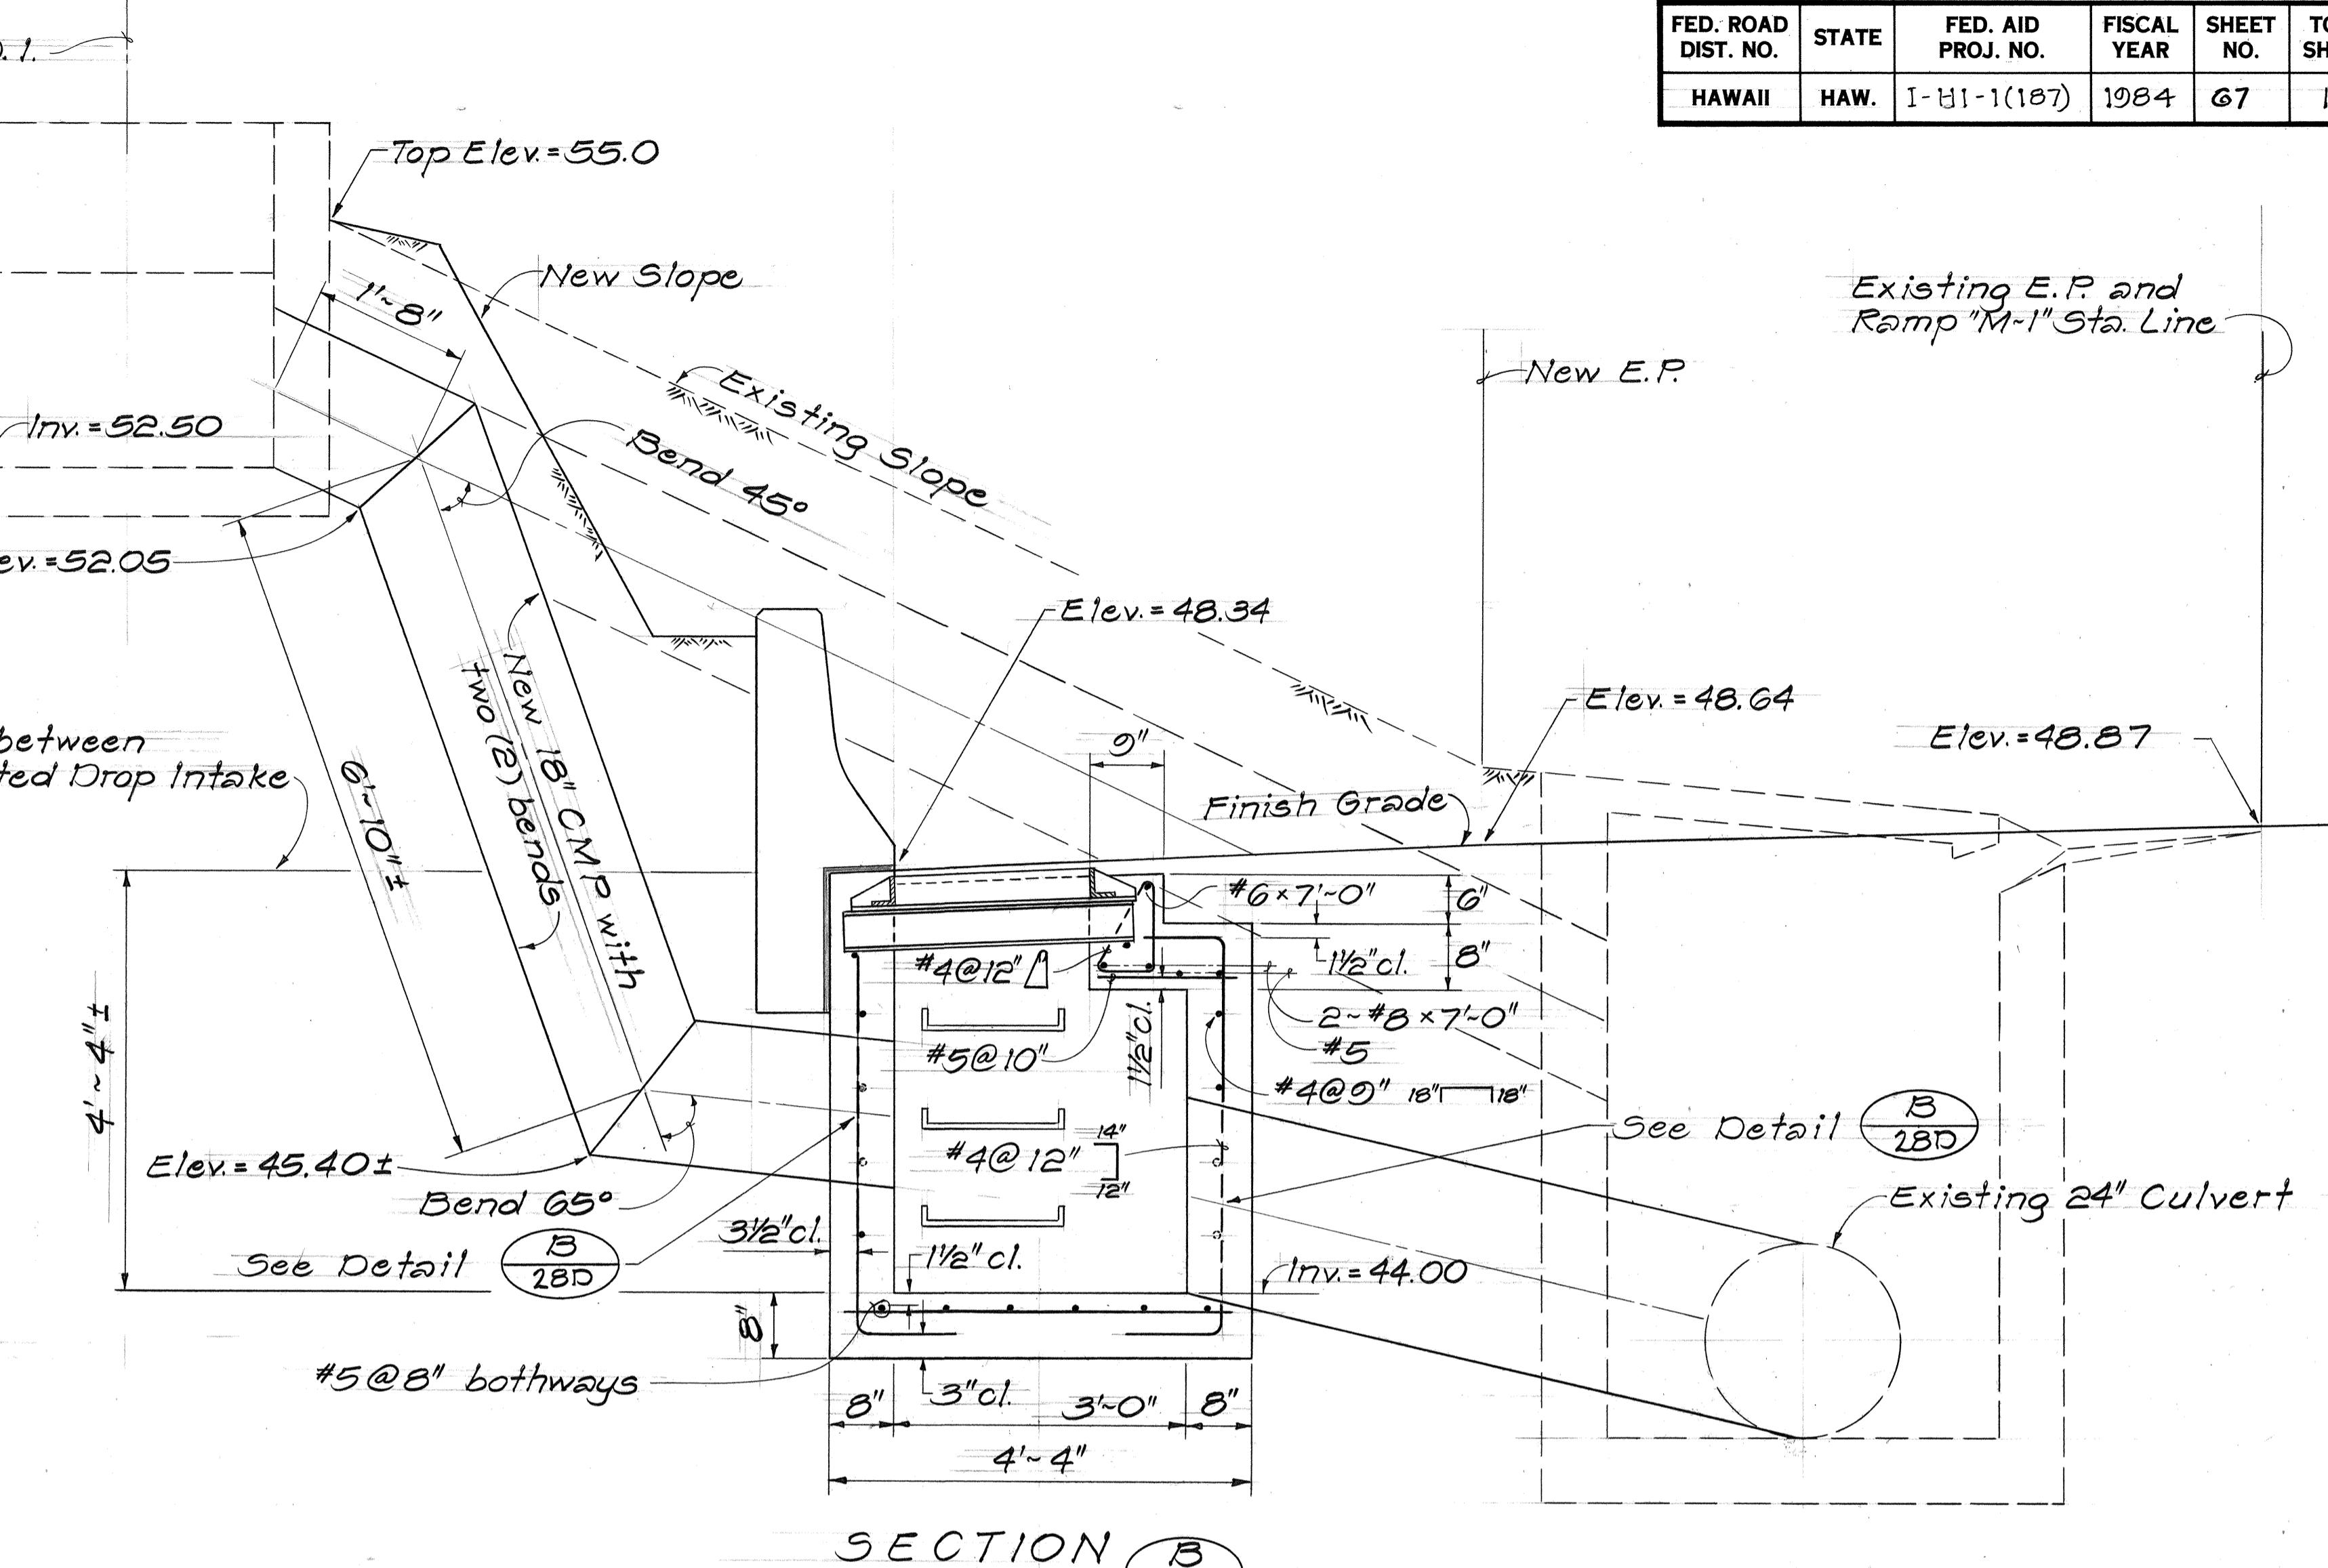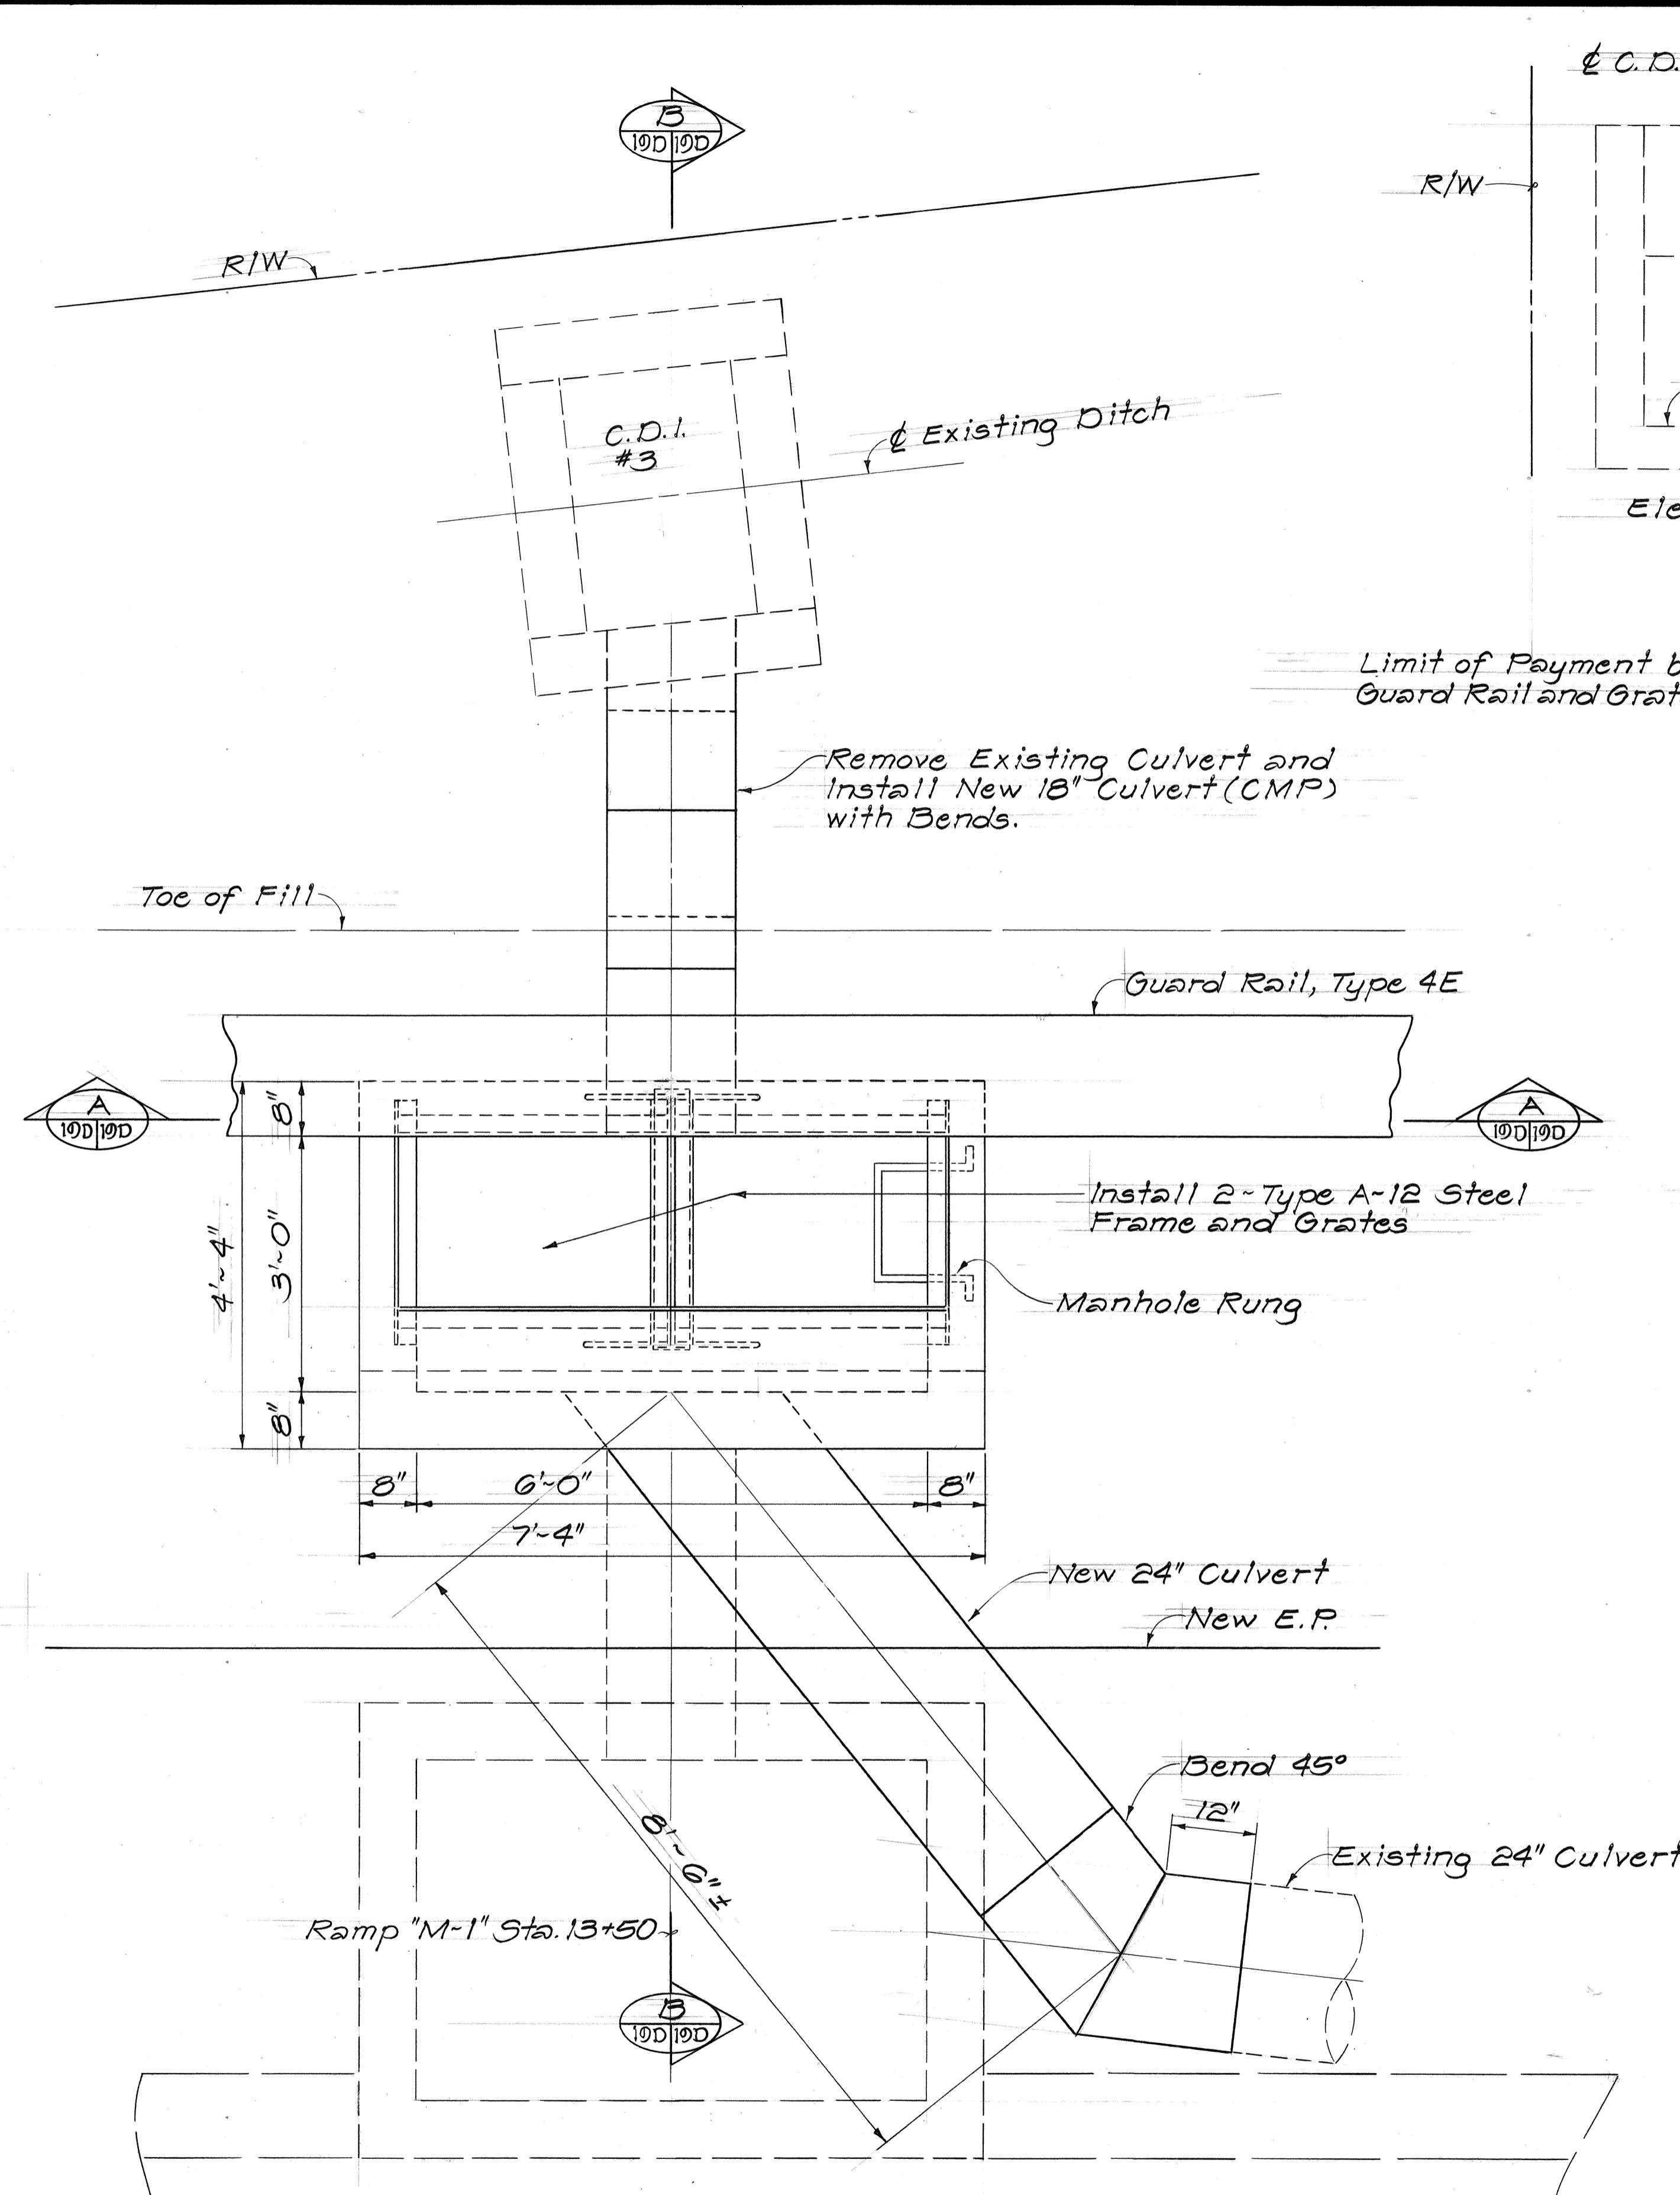

STATE OF HAWAII  
 DEPARTMENT OF TRANSPORTATION  
 HIGHWAYS DIVISION  
**DRAINAGE DETAILS**  
 INTERSTATE ROUTE H-I IMPROVEMENTS  
 MIDDLE STREET TO KALIHILINTERCHANGE  
 WESTBOUND LANES  
 F.A.I. PROJ. NO. I-HI-1(187)  
 SCALE: 3/4"=1'-0" DATE: JUNE 1983  
 SHEET NO. 10 OF 30 SHEETS




DETAILS OF TYPE 2 G.D.I. #31 AT RAMP "M-1" STA. 13+50 RT.  
 Scale: 3/4"=1'-0"

| FED. ROAD DIST. NO. | STATE | FED. AID PROJ. NO. | FISCAL YEAR | SHEET NO. | TOTAL SHEETS |
|---------------------|-------|--------------------|-------------|-----------|--------------|
| HAWAII              | HAW.  | I-HI-1(187)        | 1984        | 68        | 107          |

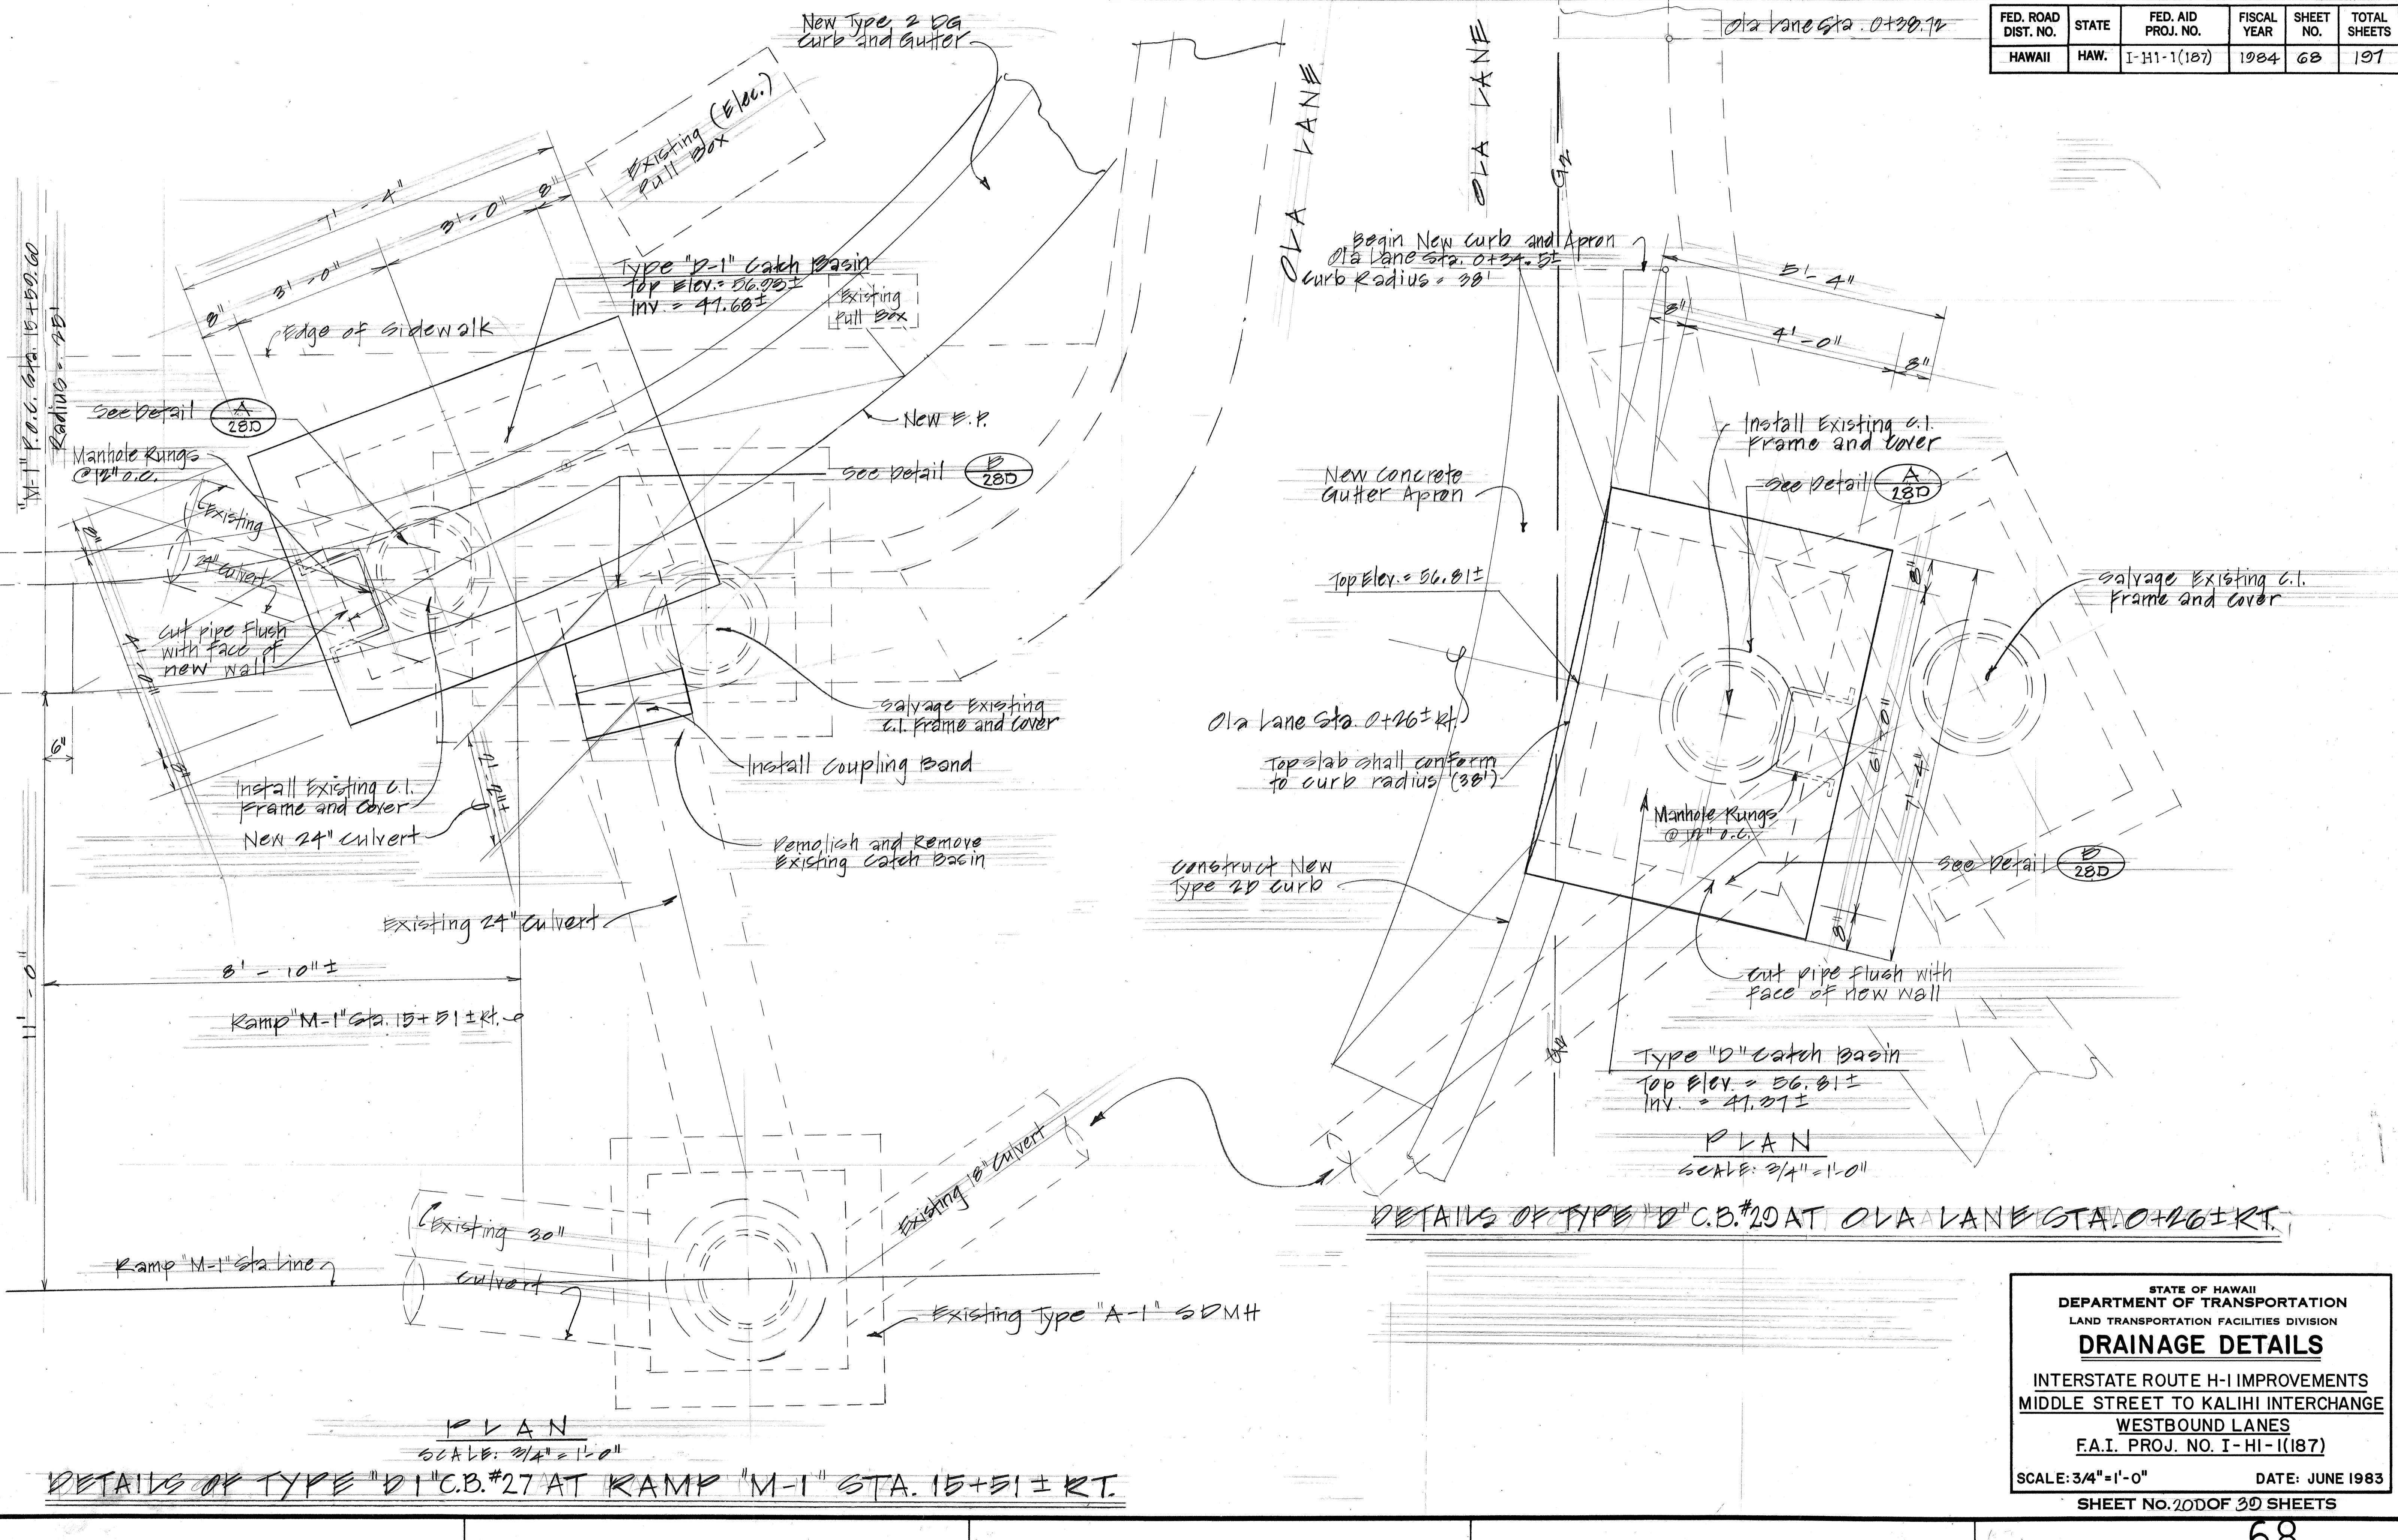

|                            |      |
|----------------------------|------|
| ORIGINAL SURVEY PLOTTED BY | DATE |
| DRAWN BY                   |      |
| TRACED BY                  |      |
| DESIGNED BY                |      |
| QUANTITIES BY              |      |
| CHECKED BY                 |      |
| No.                        |      |

| FED. ROAD DIST. NO. | STATE | FED. AID PROJ. NO. | FISCAL YEAR | SHEET NO. | TOTAL SHEETS |
|---------------------|-------|--------------------|-------------|-----------|--------------|
| HAWAII              | HAW.  | I-HI-1(187)        | 1984        | 69        | 191          |

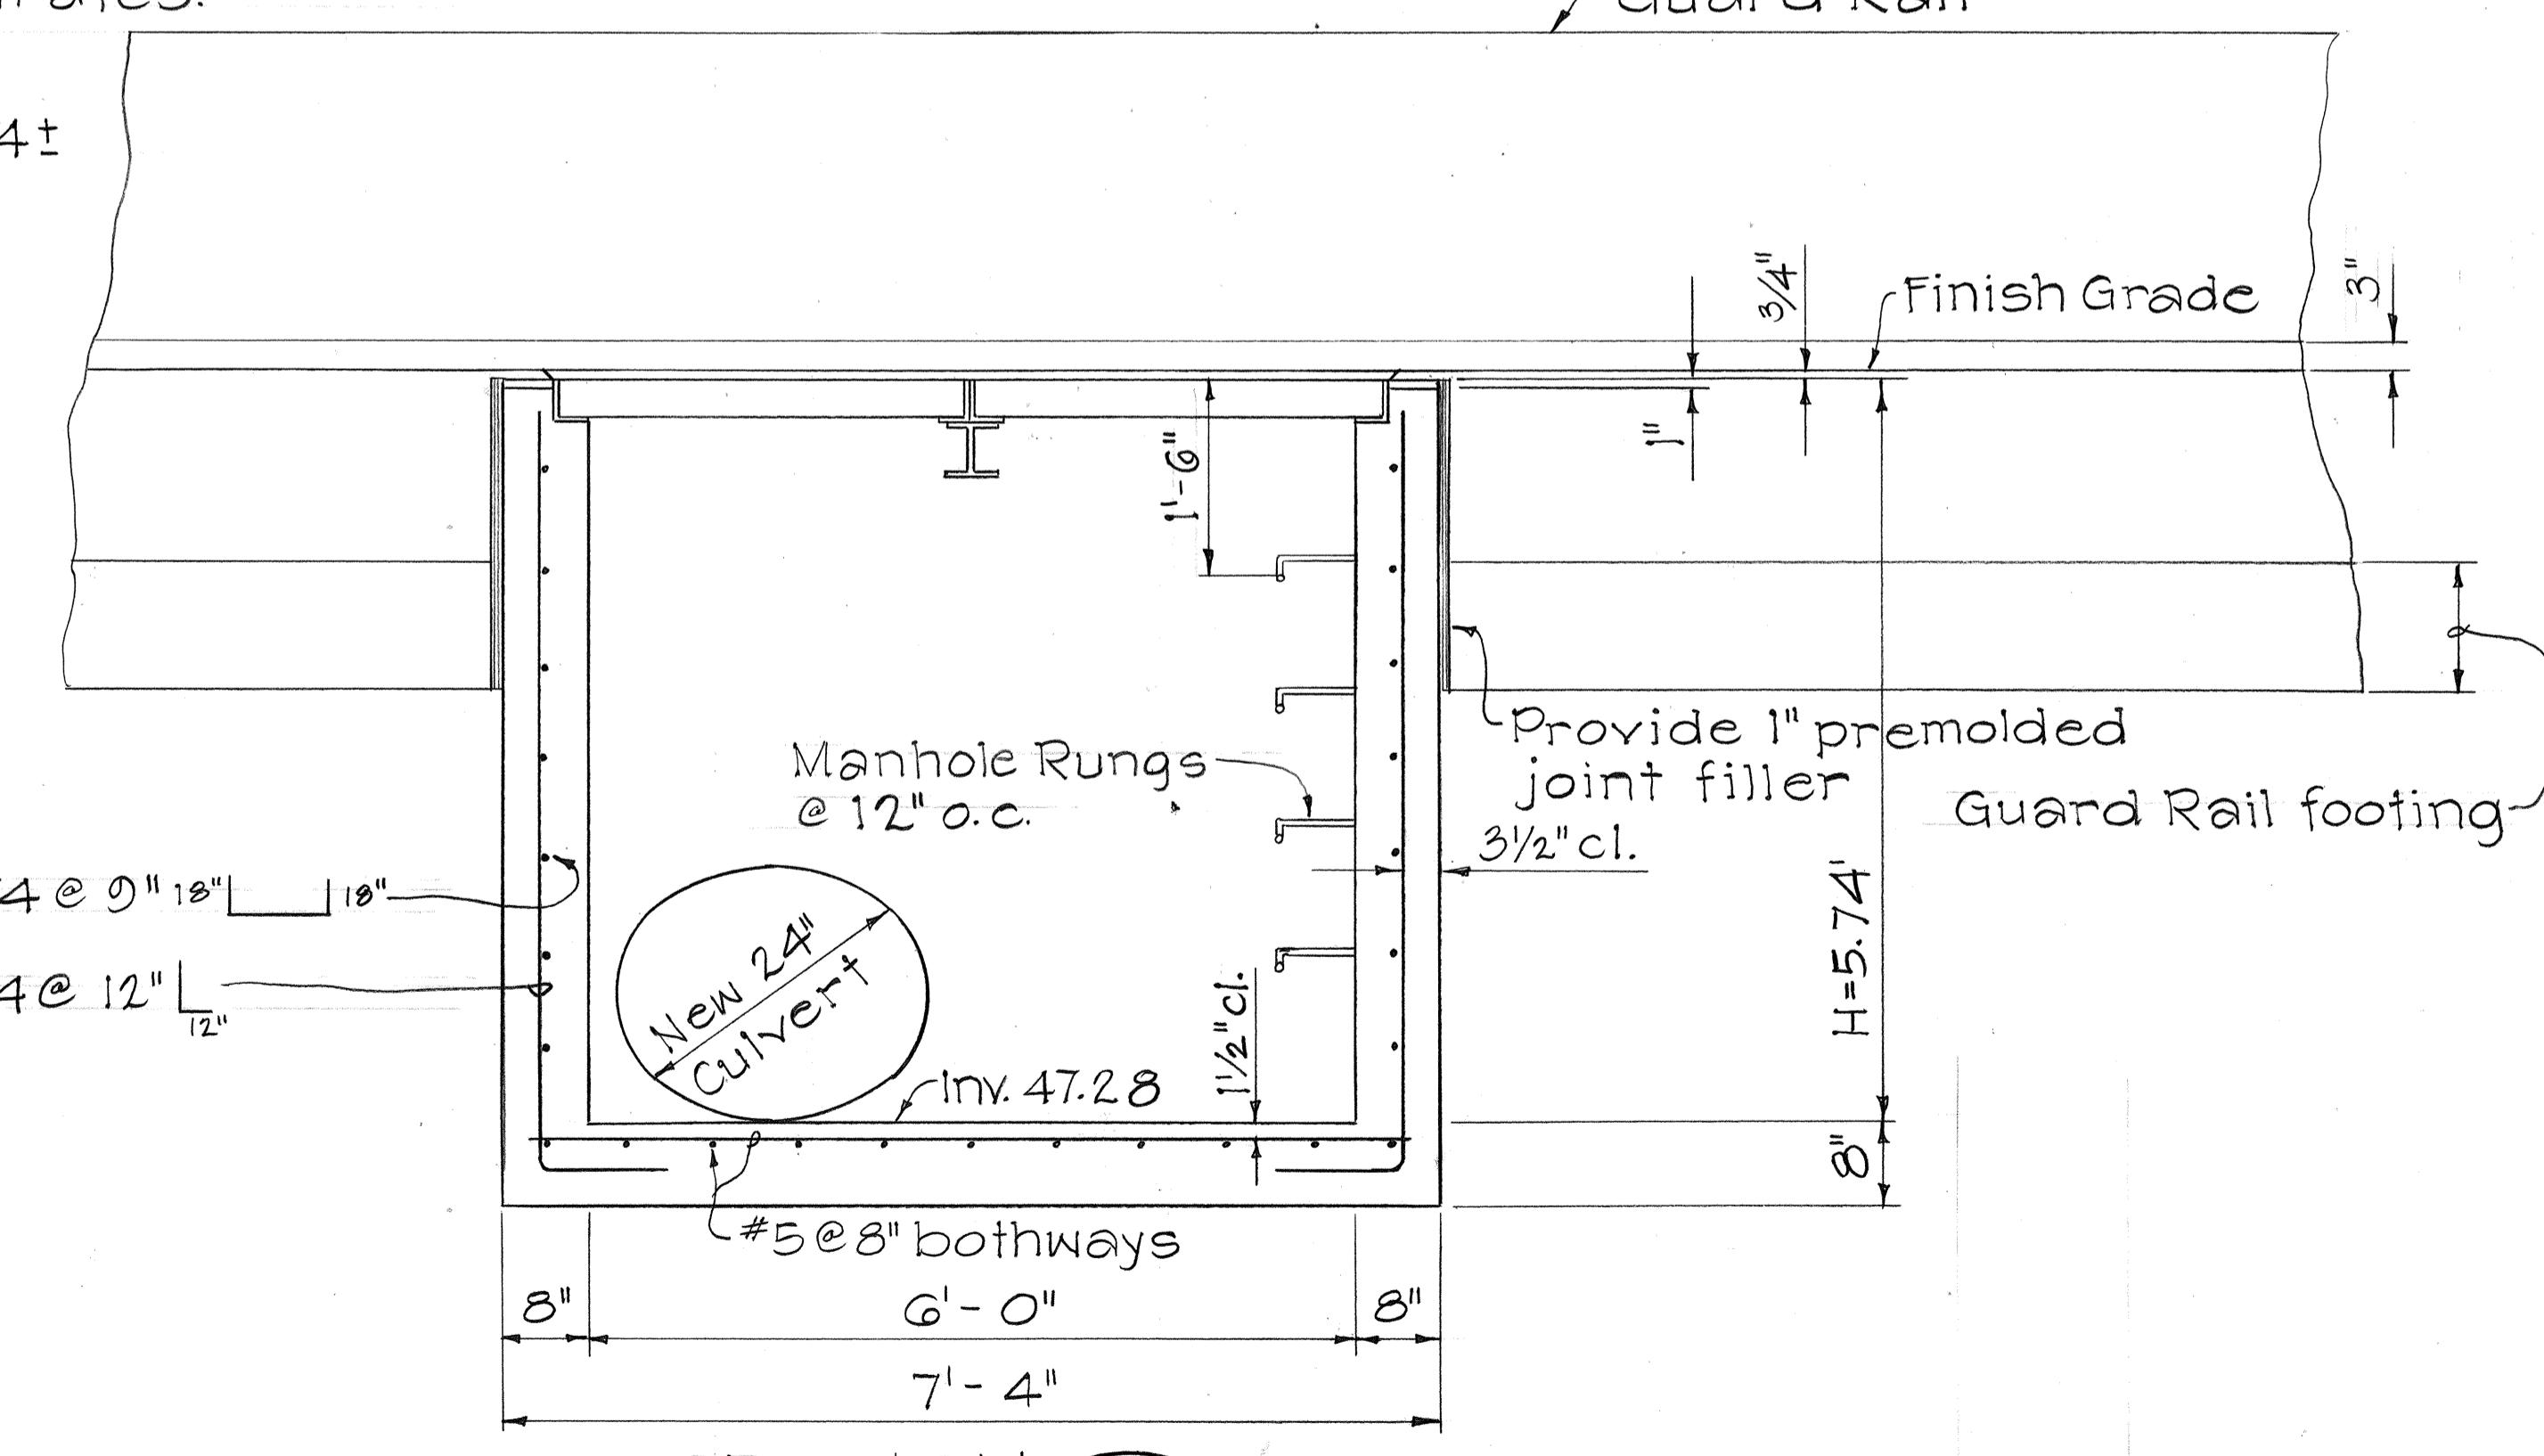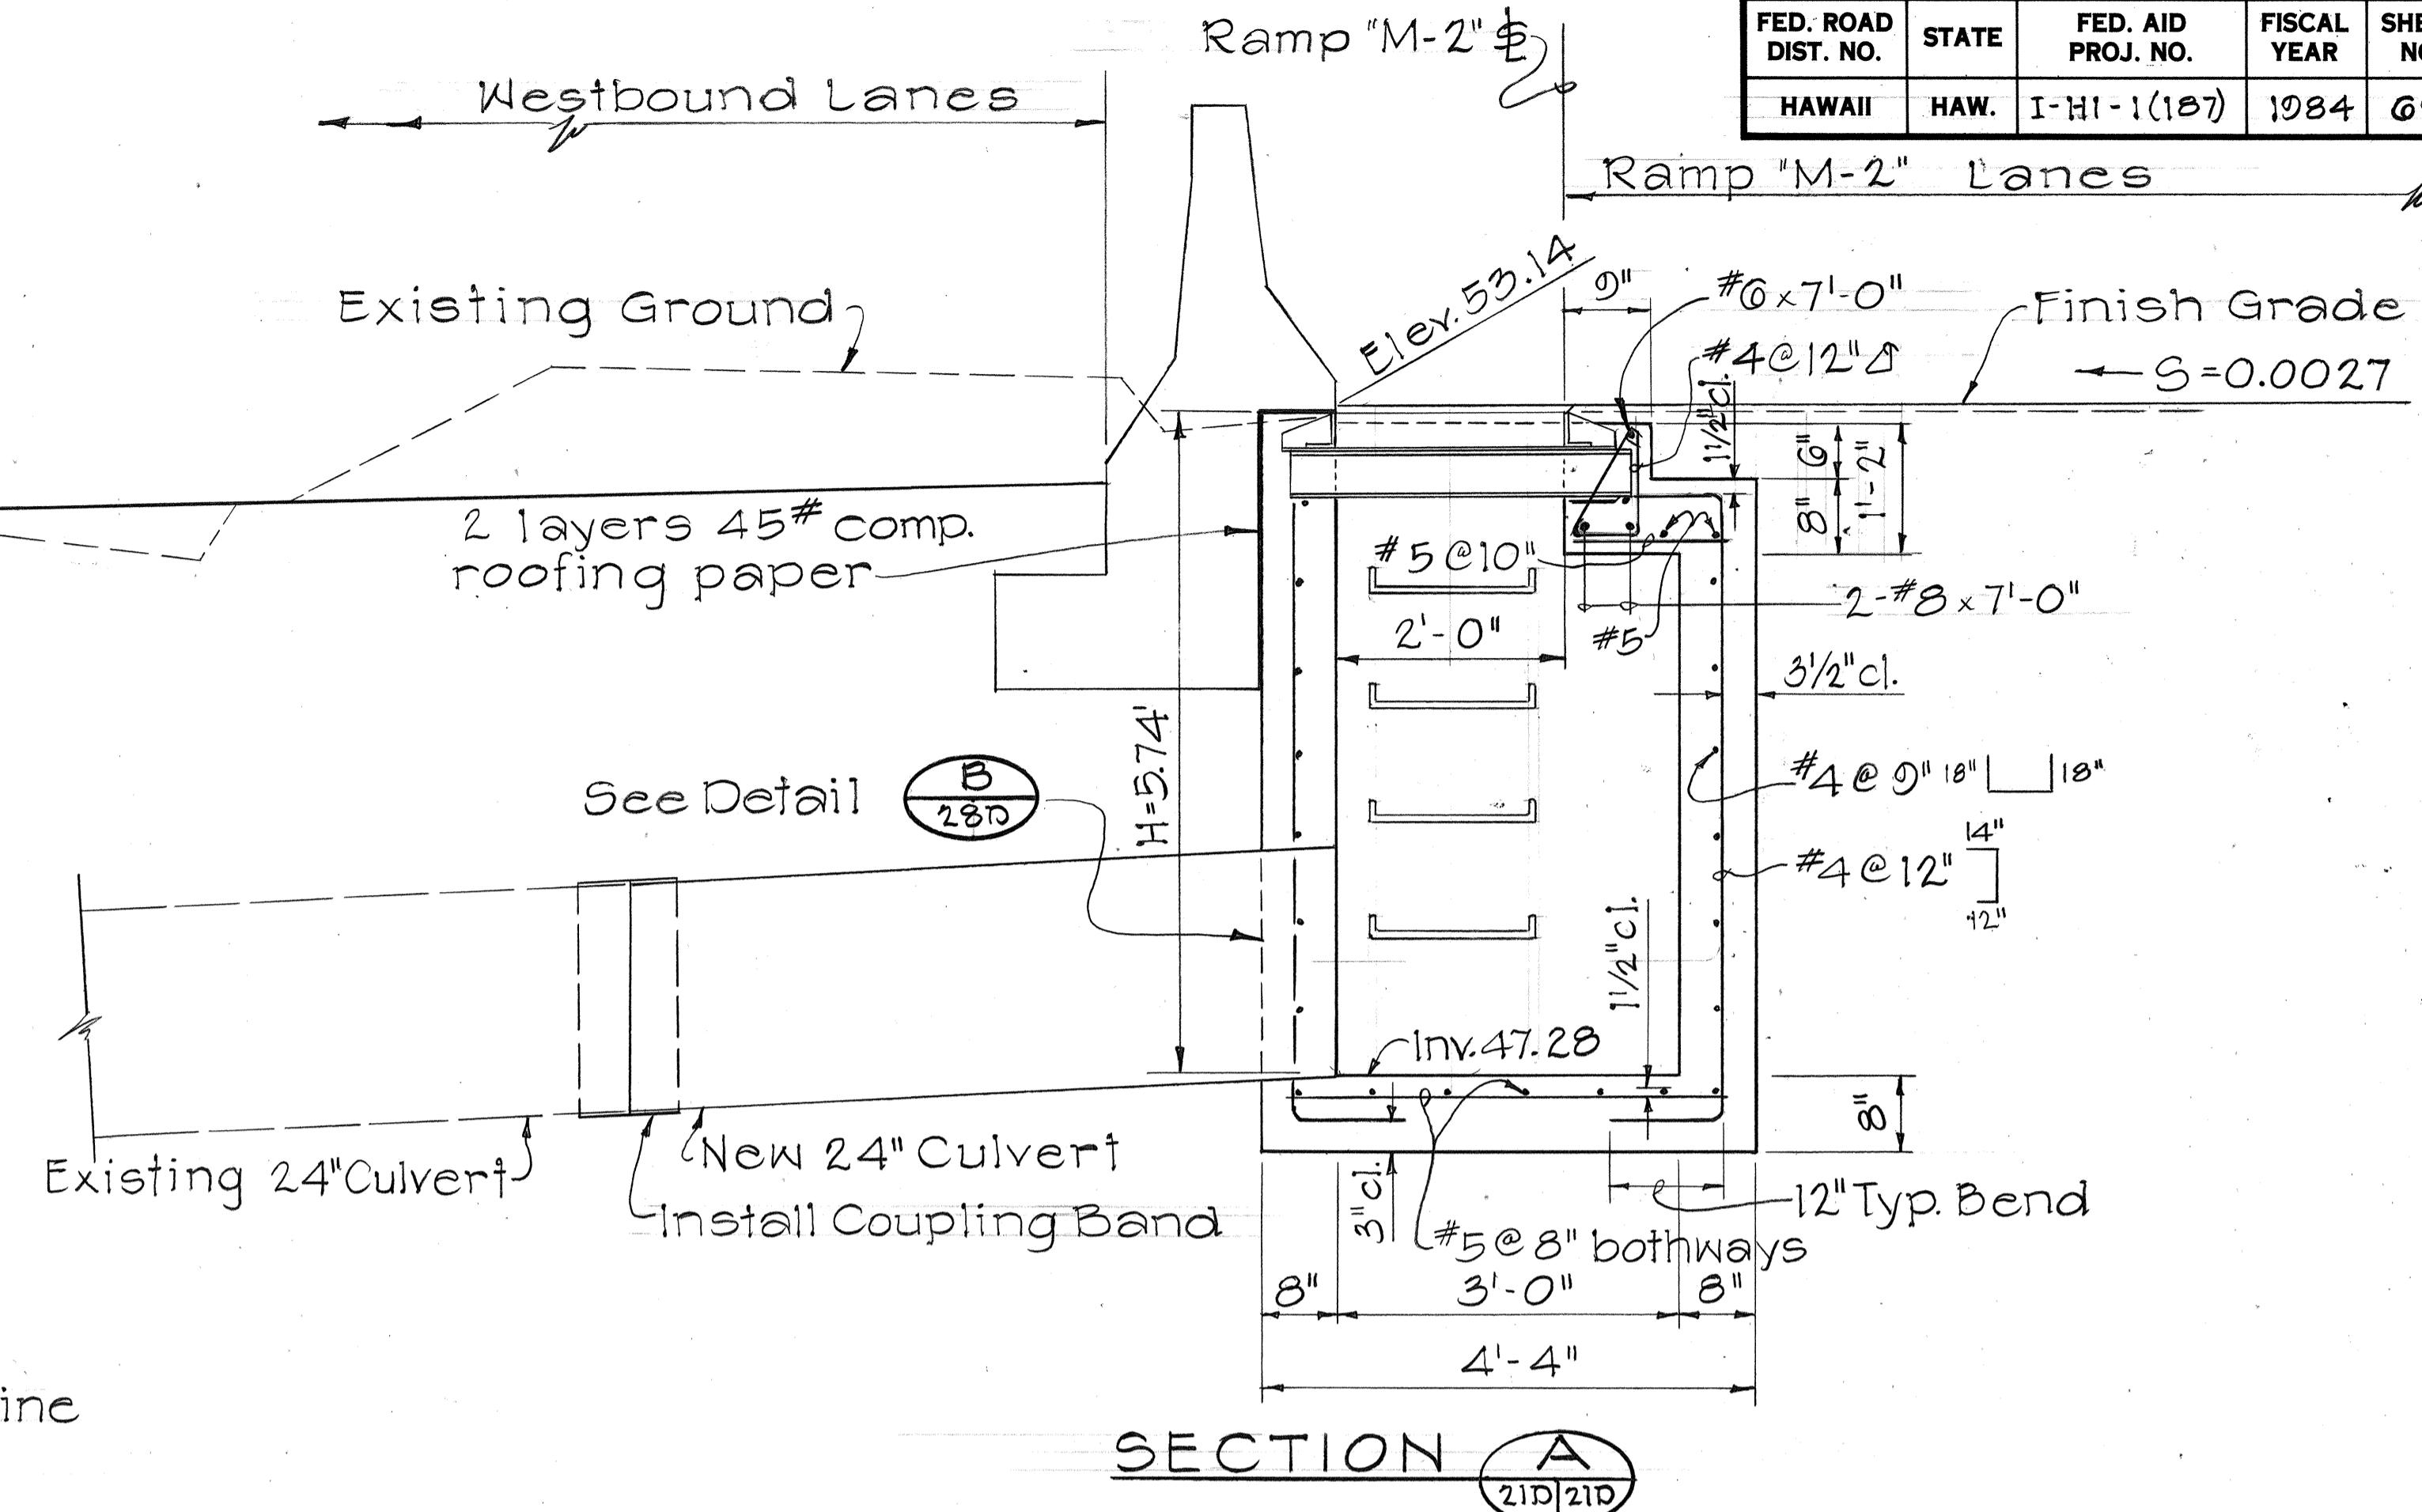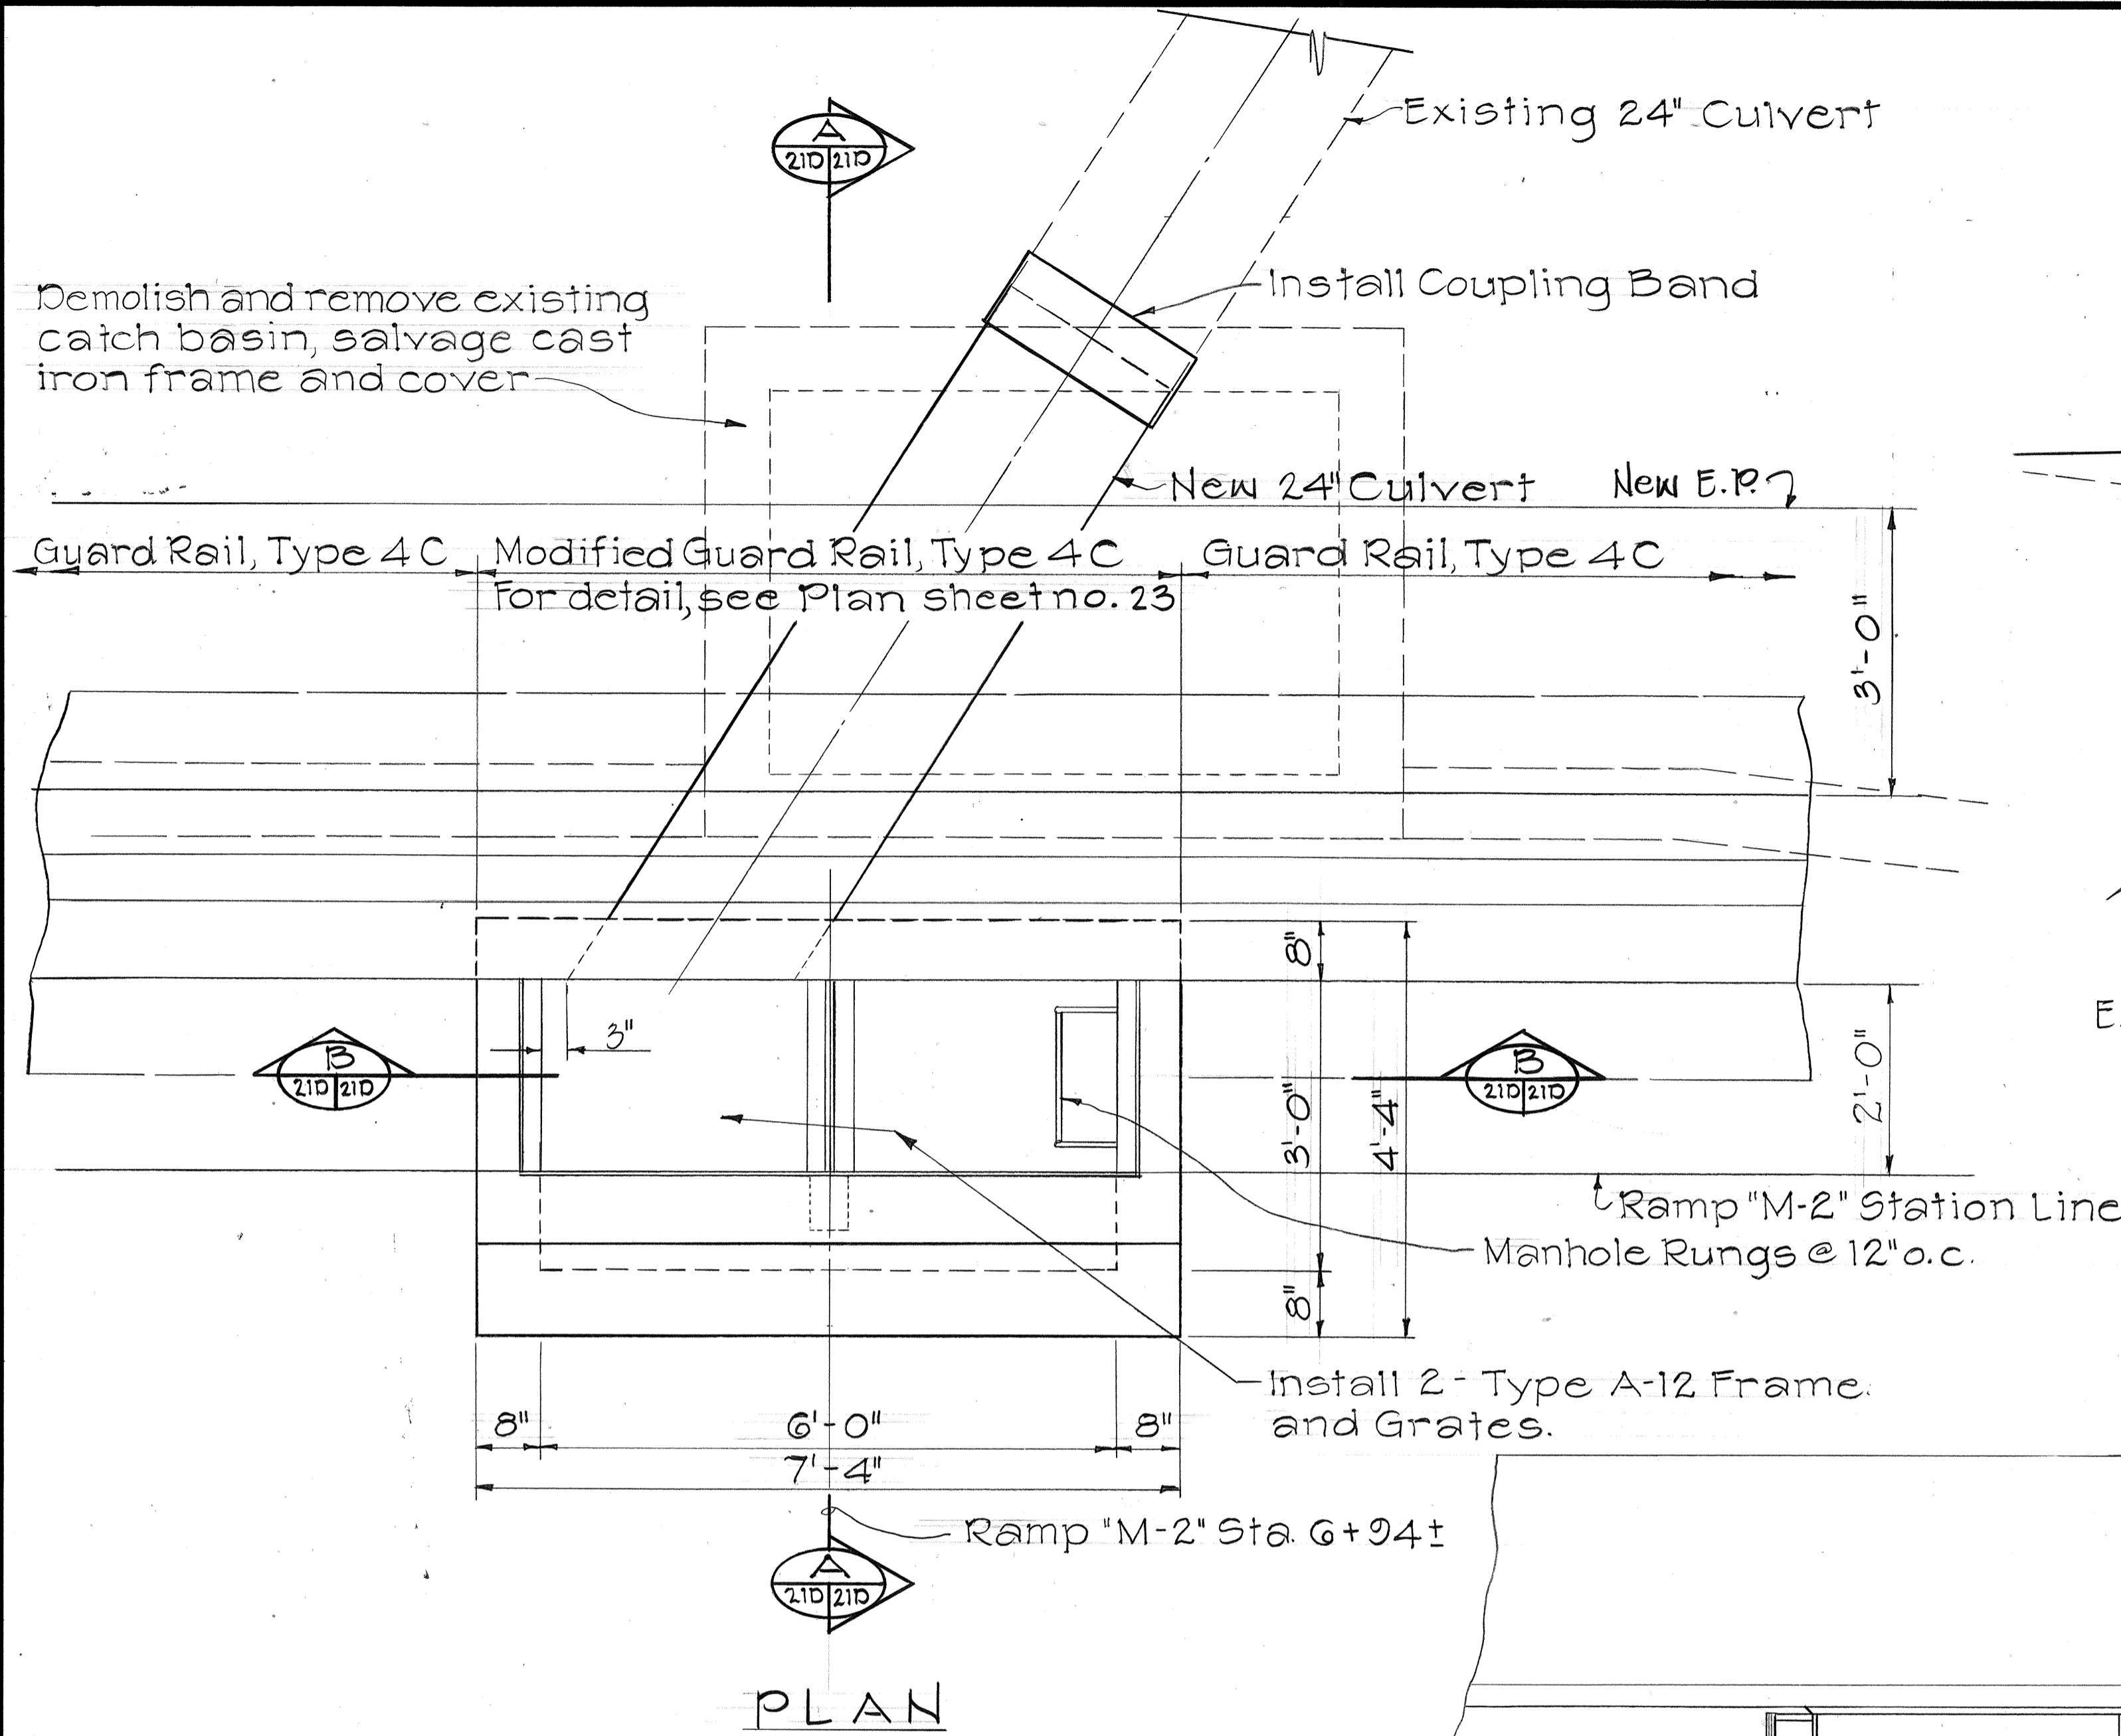


DETAILS OF TYPE 2 G.D.I. #38 AT RAMP "M-2" STA. G+94±

Scale: 3/4" = 1'-0"

|                                     |                              |
|-------------------------------------|------------------------------|
| STATE OF HAWAII                     | DEPARTMENT OF TRANSPORTATION |
| HIGHWAYS DIVISION                   |                              |
| <b>DRAINAGE DETAILS</b>             |                              |
| INTERSTATE ROUTE H-I IMPROVEMENTS   |                              |
| MIDDLE STREET TO KALIHI INTERCHANGE |                              |
| WESTBOUND LANES                     |                              |
| F.A.I. PROJ. NO. I-HI-1(187)        |                              |
| SCALE: 3/4" = 1'-0"                 |                              |
| DATE: JUNE 1983                     |                              |
| SHEET NO. 210 OF 39 SHEETS          |                              |

| FED. ROAD<br>DIST. NO. | STATE | FED. AID<br>PROJ. NO. | FISCAL<br>YEAR | SHEET<br>NO. | TOTAL<br>SHEETS |
|------------------------|-------|-----------------------|----------------|--------------|-----------------|
| HAWAII                 | HAW.  | I-HI-1(187)           | 1984           | 70           | 191             |

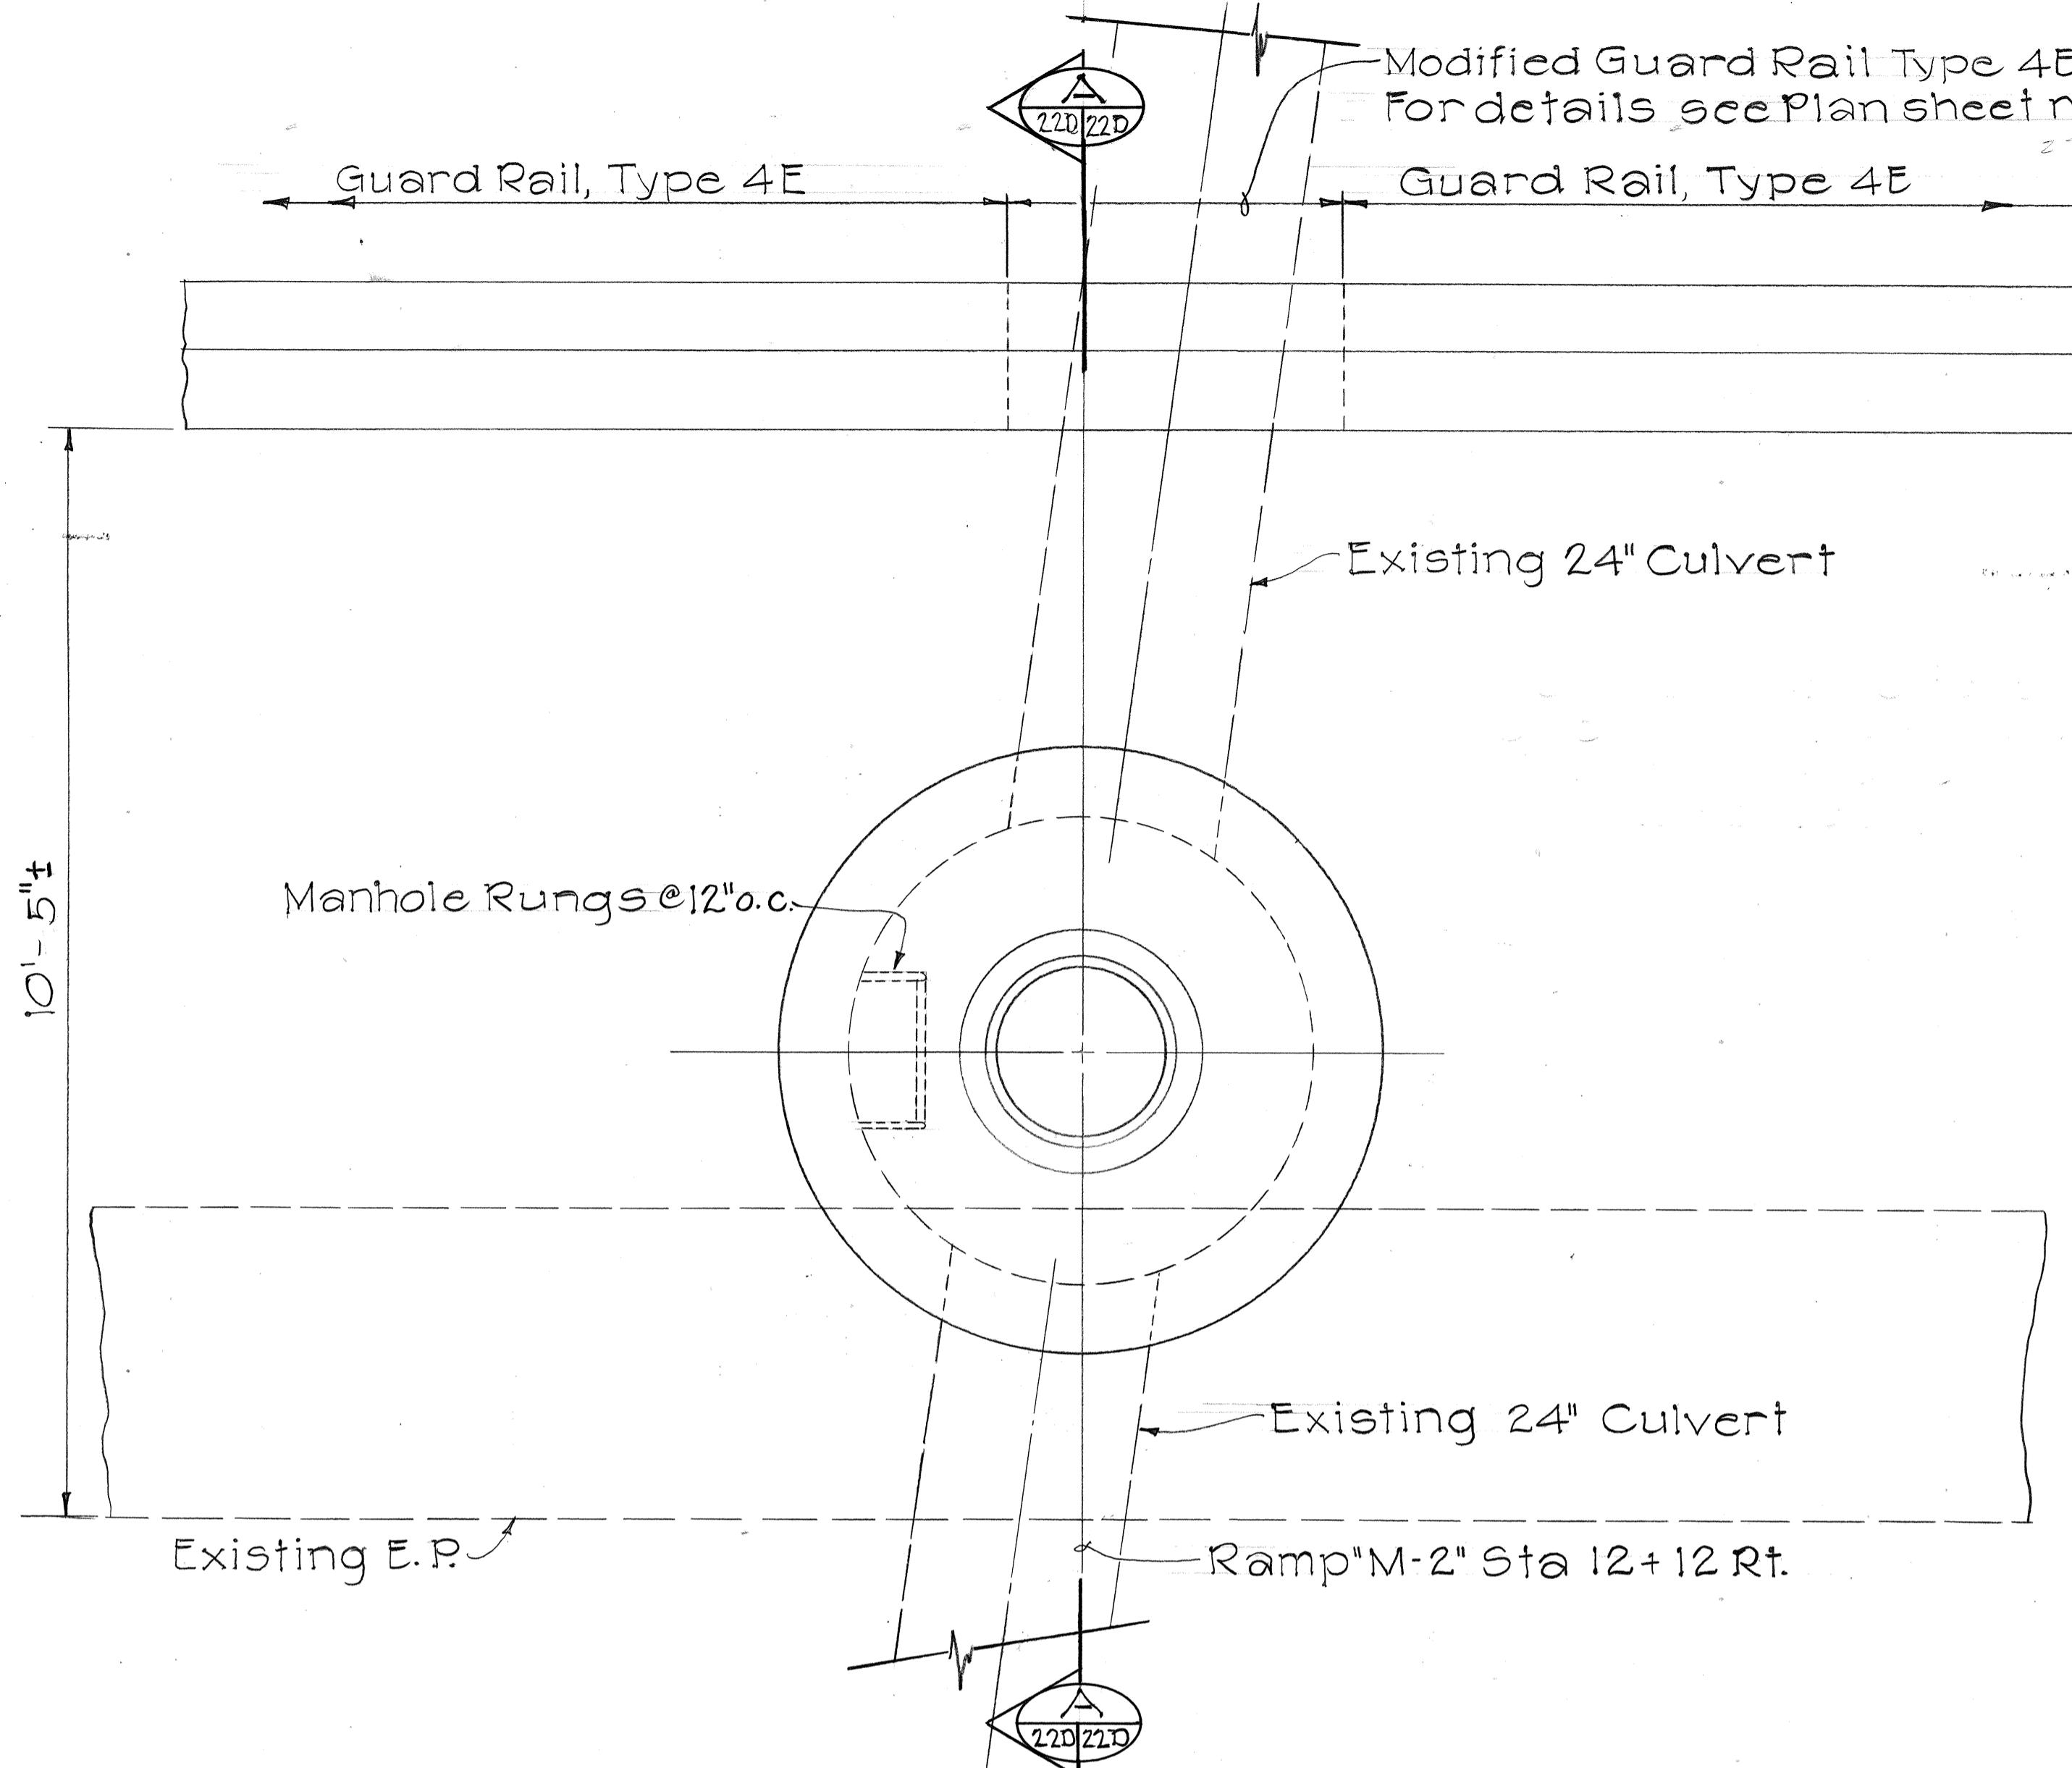


PLAN

RECONSTRUCTION OF TYPE "D" S.D.M.H. #16 AT RAMP "M-2" STA. 12+12 RT.




Scale:  $\frac{3}{4}'' = 1'-0''$

|               |                   |
|---------------|-------------------|
| ORIGINAL PLAN | SURVEY PLOTTED BY |
| NOTE BOOK     | DRAWN BY          |
| TRACED BY     | DESIGNED BY       |
| QUANTITY BY   | CHECKED BY        |
| No. _____     |                   |

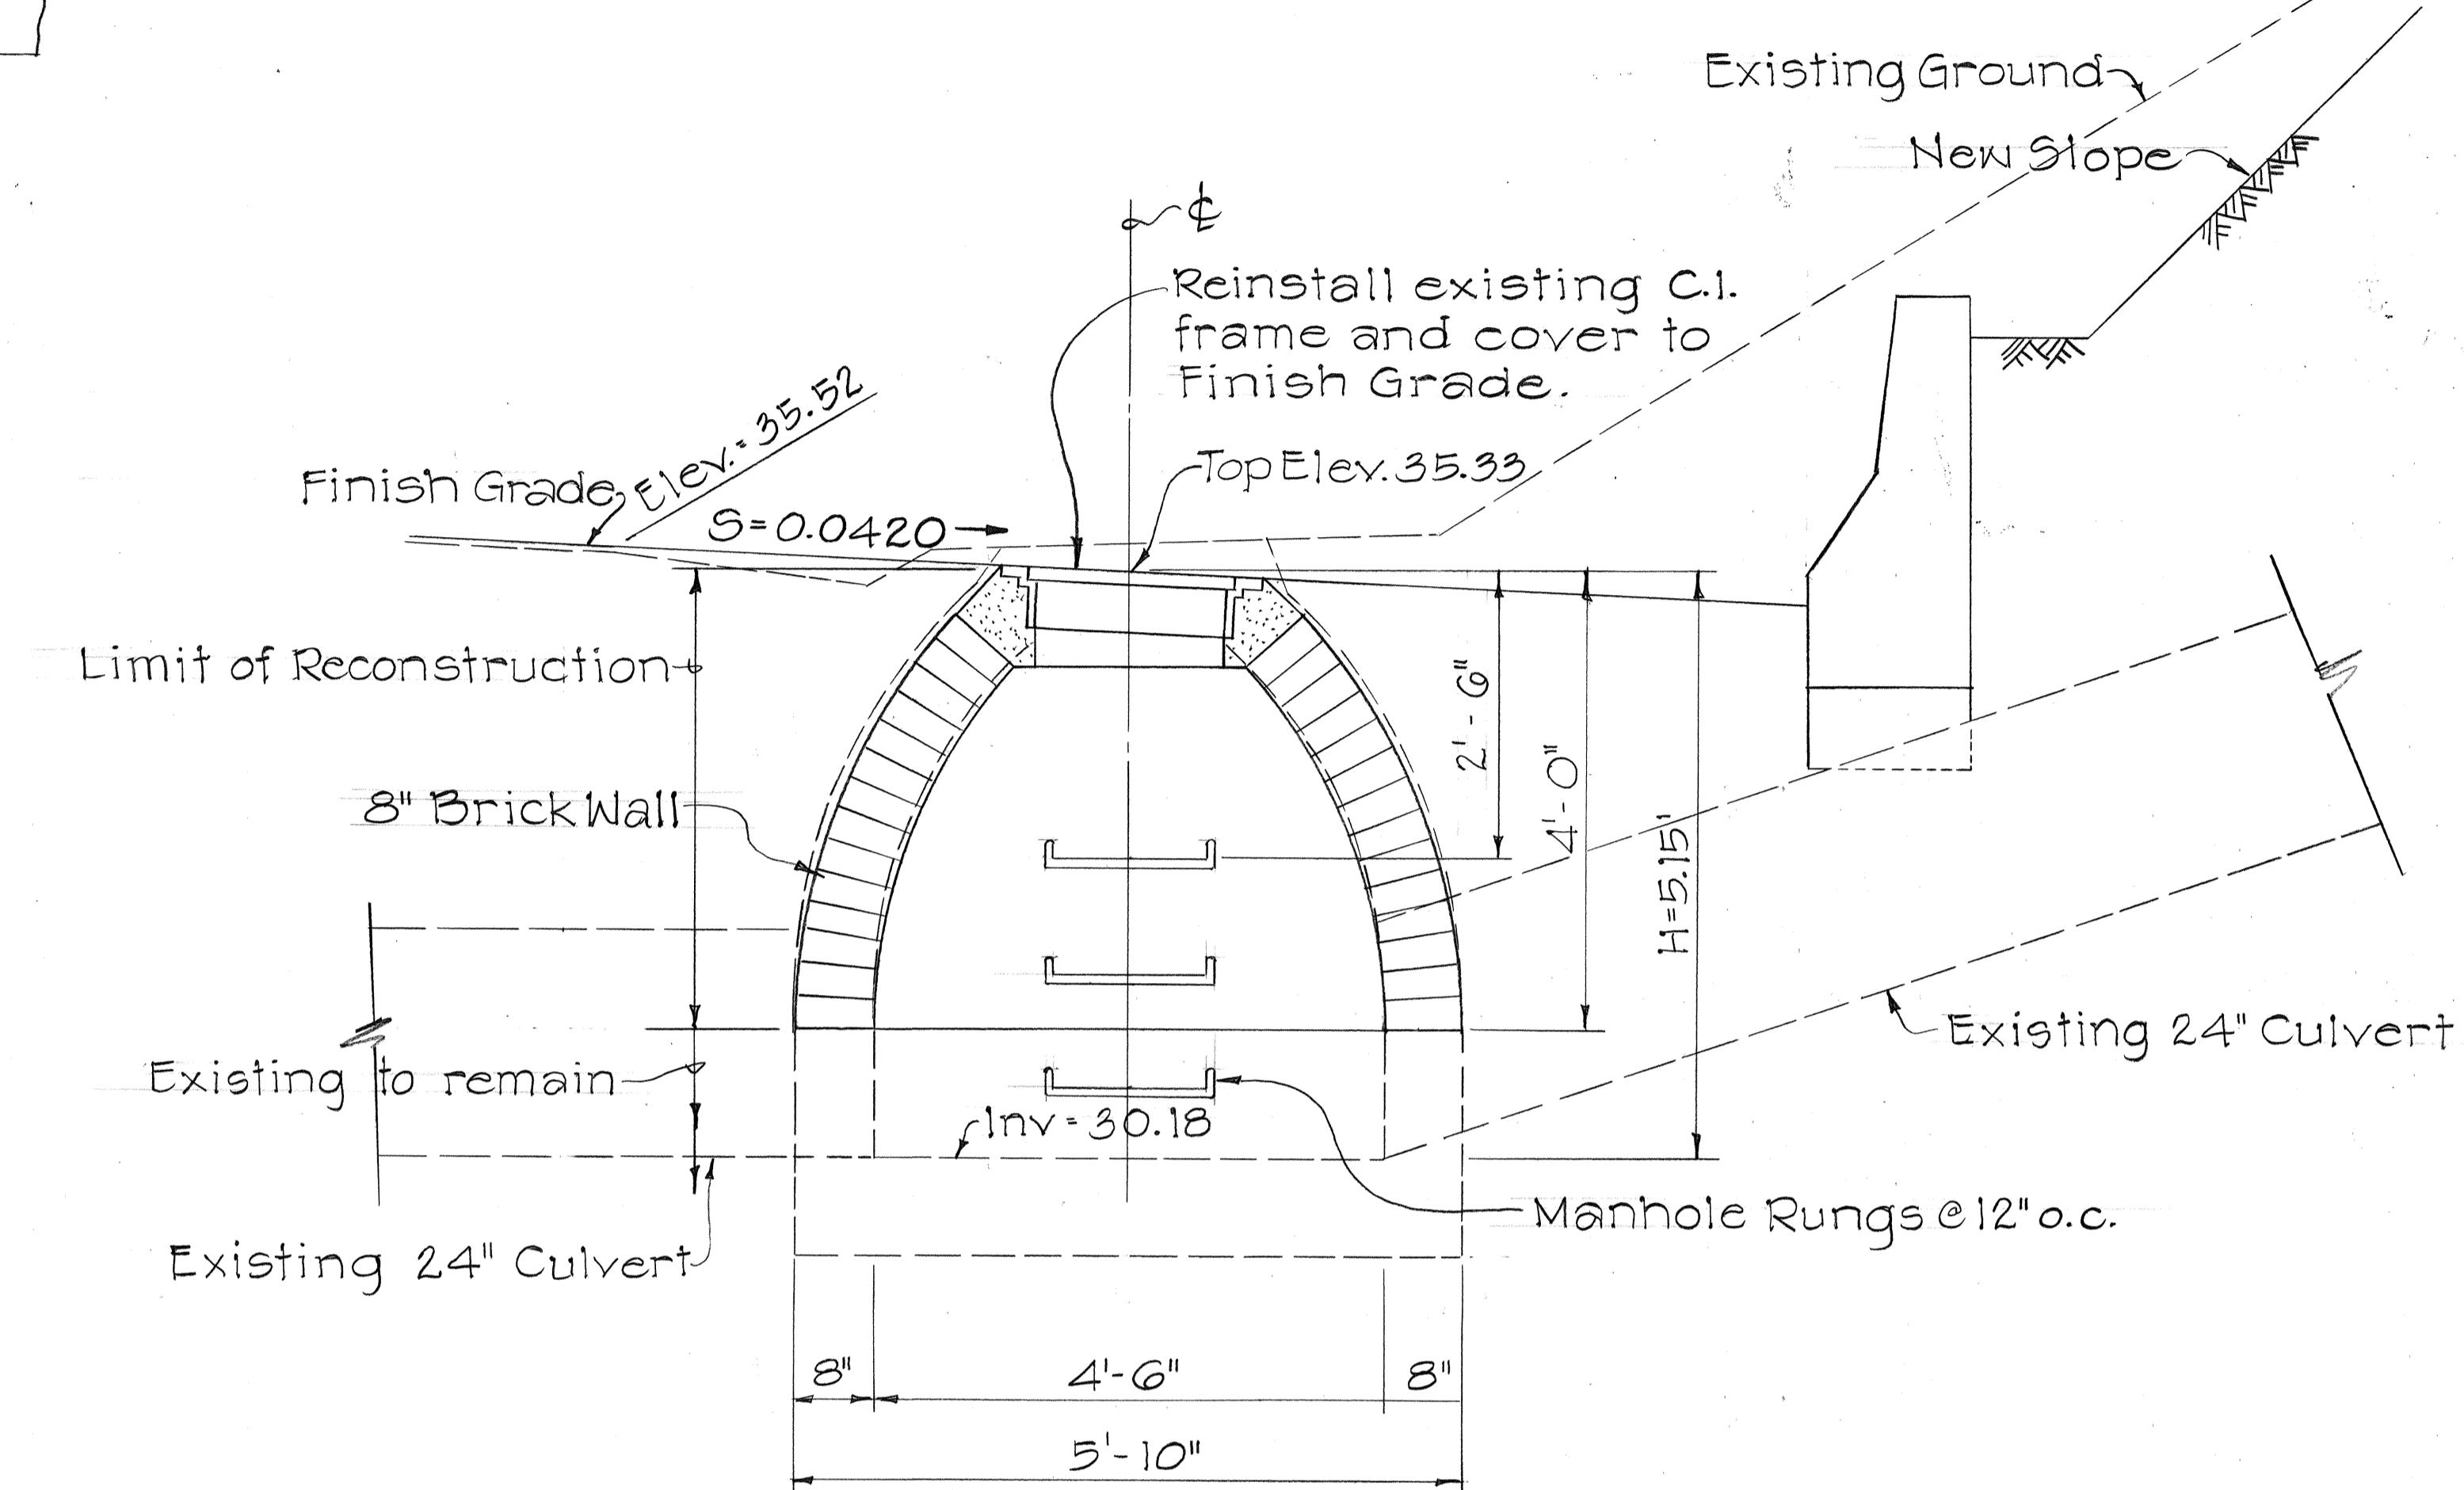

STATE OF HAWAII  
DEPARTMENT OF TRANSPORTATION  
HIGHWAYS DIVISION  
**DRAINAGE DETAILS**  
INTERSTATE ROUTE H-1 IMPROVEMENTS  
MIDDLE STREET TO KALIHI INTERCHANGE  
WESTBOUND LANES  
F.A.I. PROJ. NO. I-HI-1(187)  
SCALE:  $\frac{3}{4}'' = 1'-0''$  DATE: JUNE 1983  
SHEET NO. 22 OF 30 SHEETS




| FED. ROAD DIST. NO. | STATE | FED. AID PROJ. NO. | FISCAL YEAR | SHEET NO. | TOTAL SHEETS |
|---------------------|-------|--------------------|-------------|-----------|--------------|
| HAWAII              | HAW.  | I-HI-1(I87)        | 1984        | 71        | 191          |

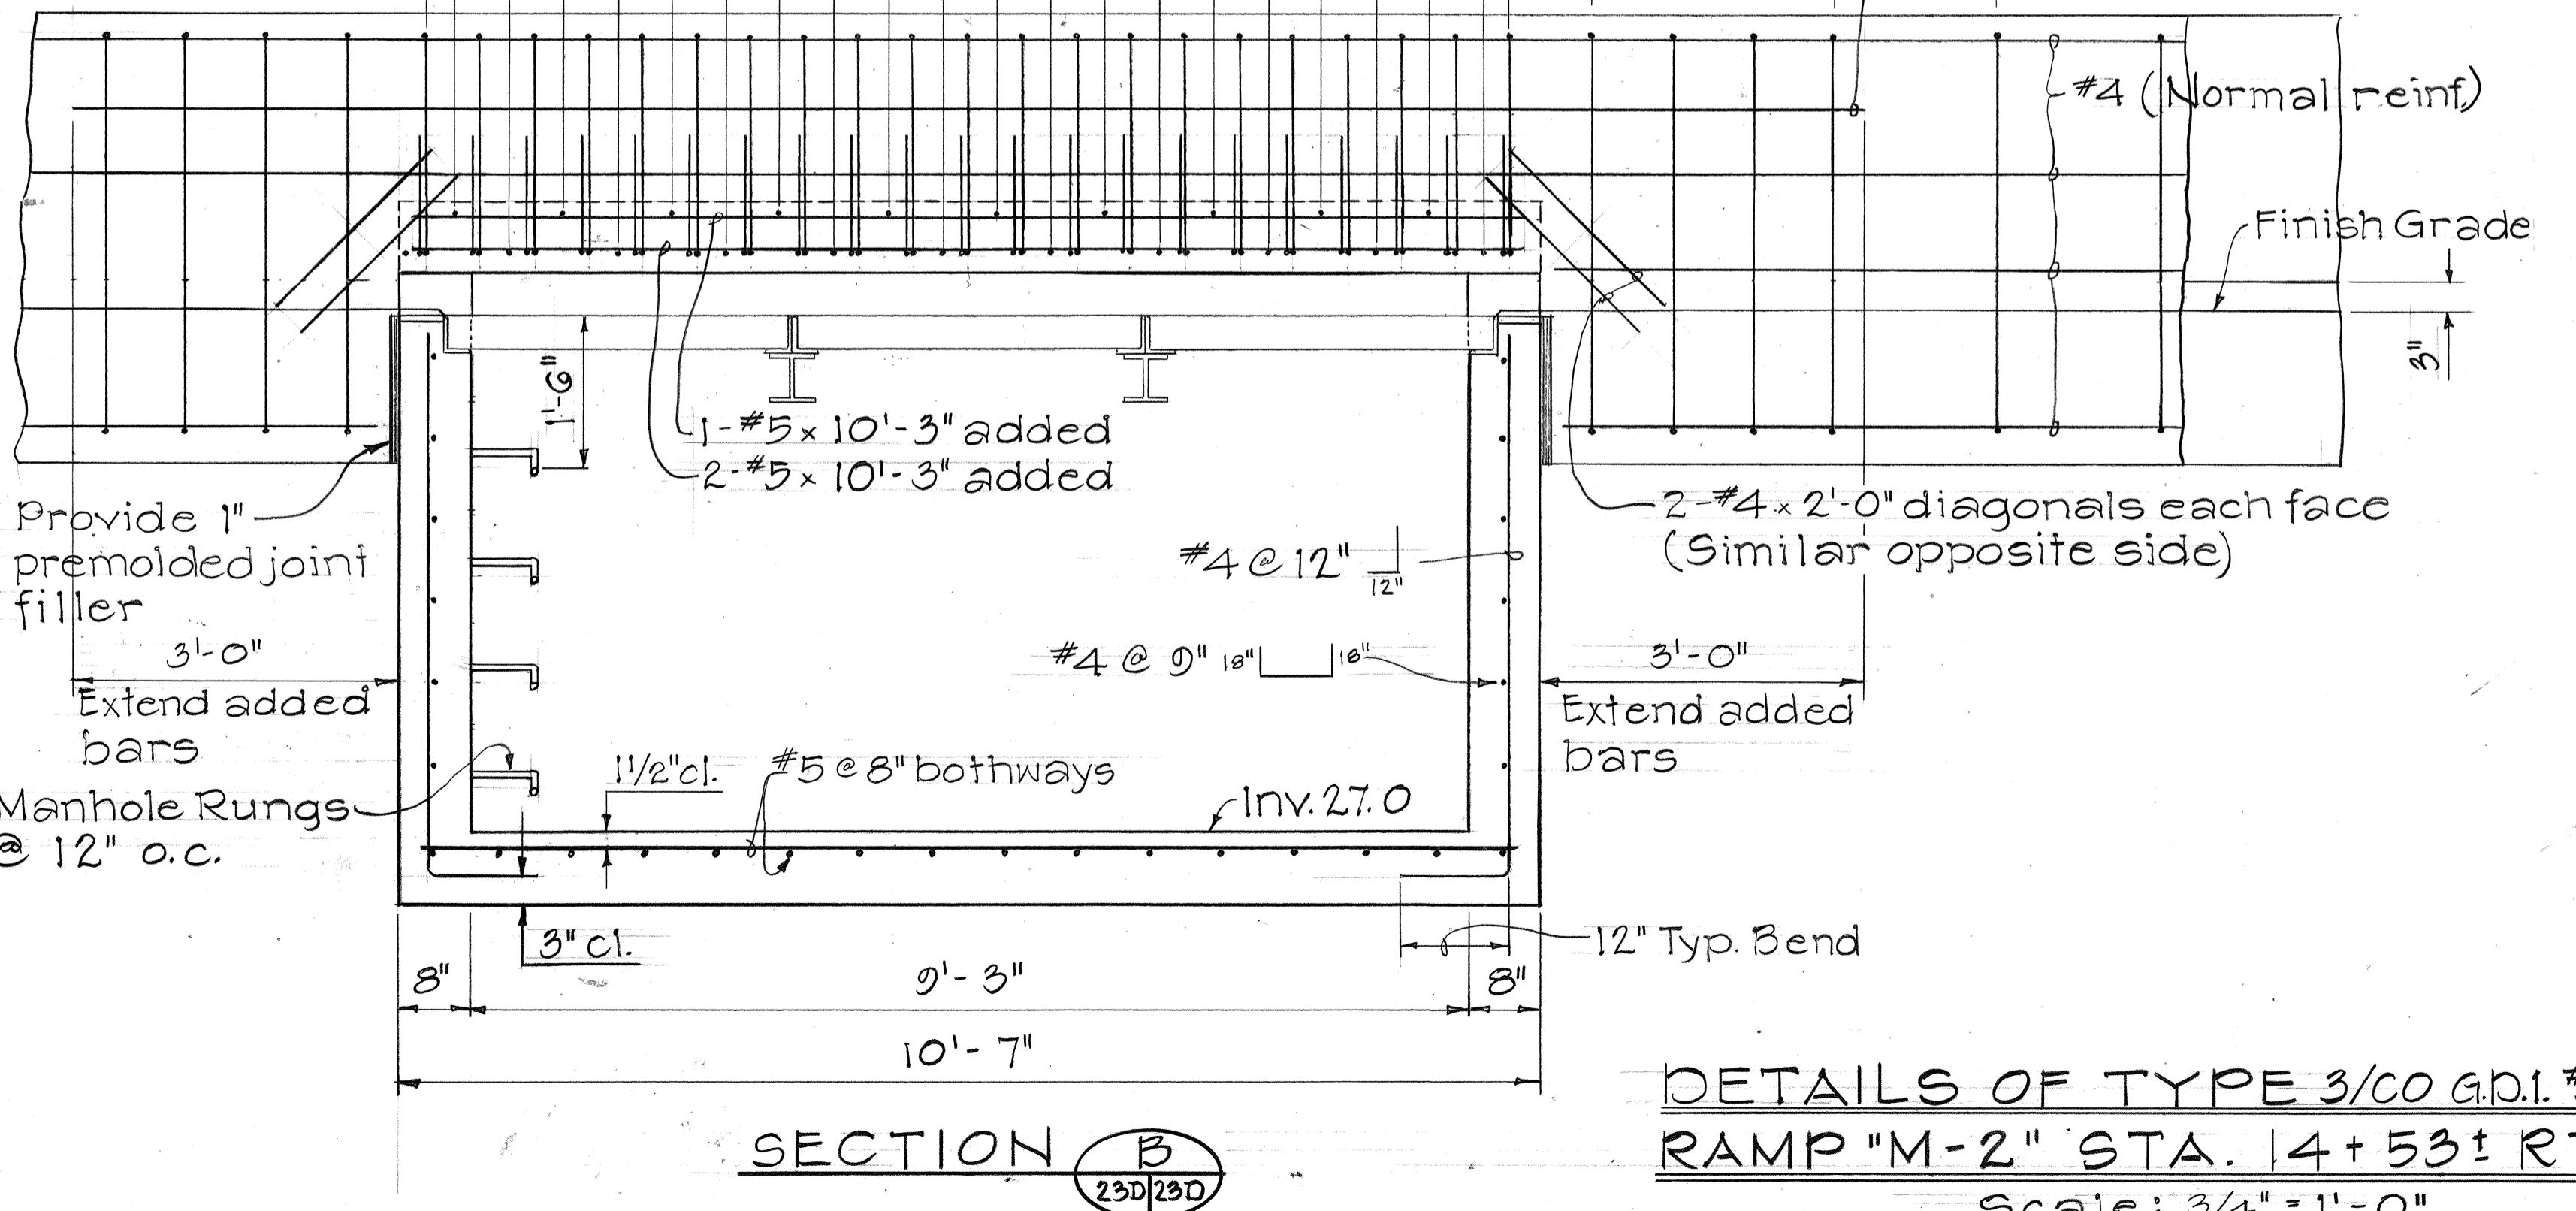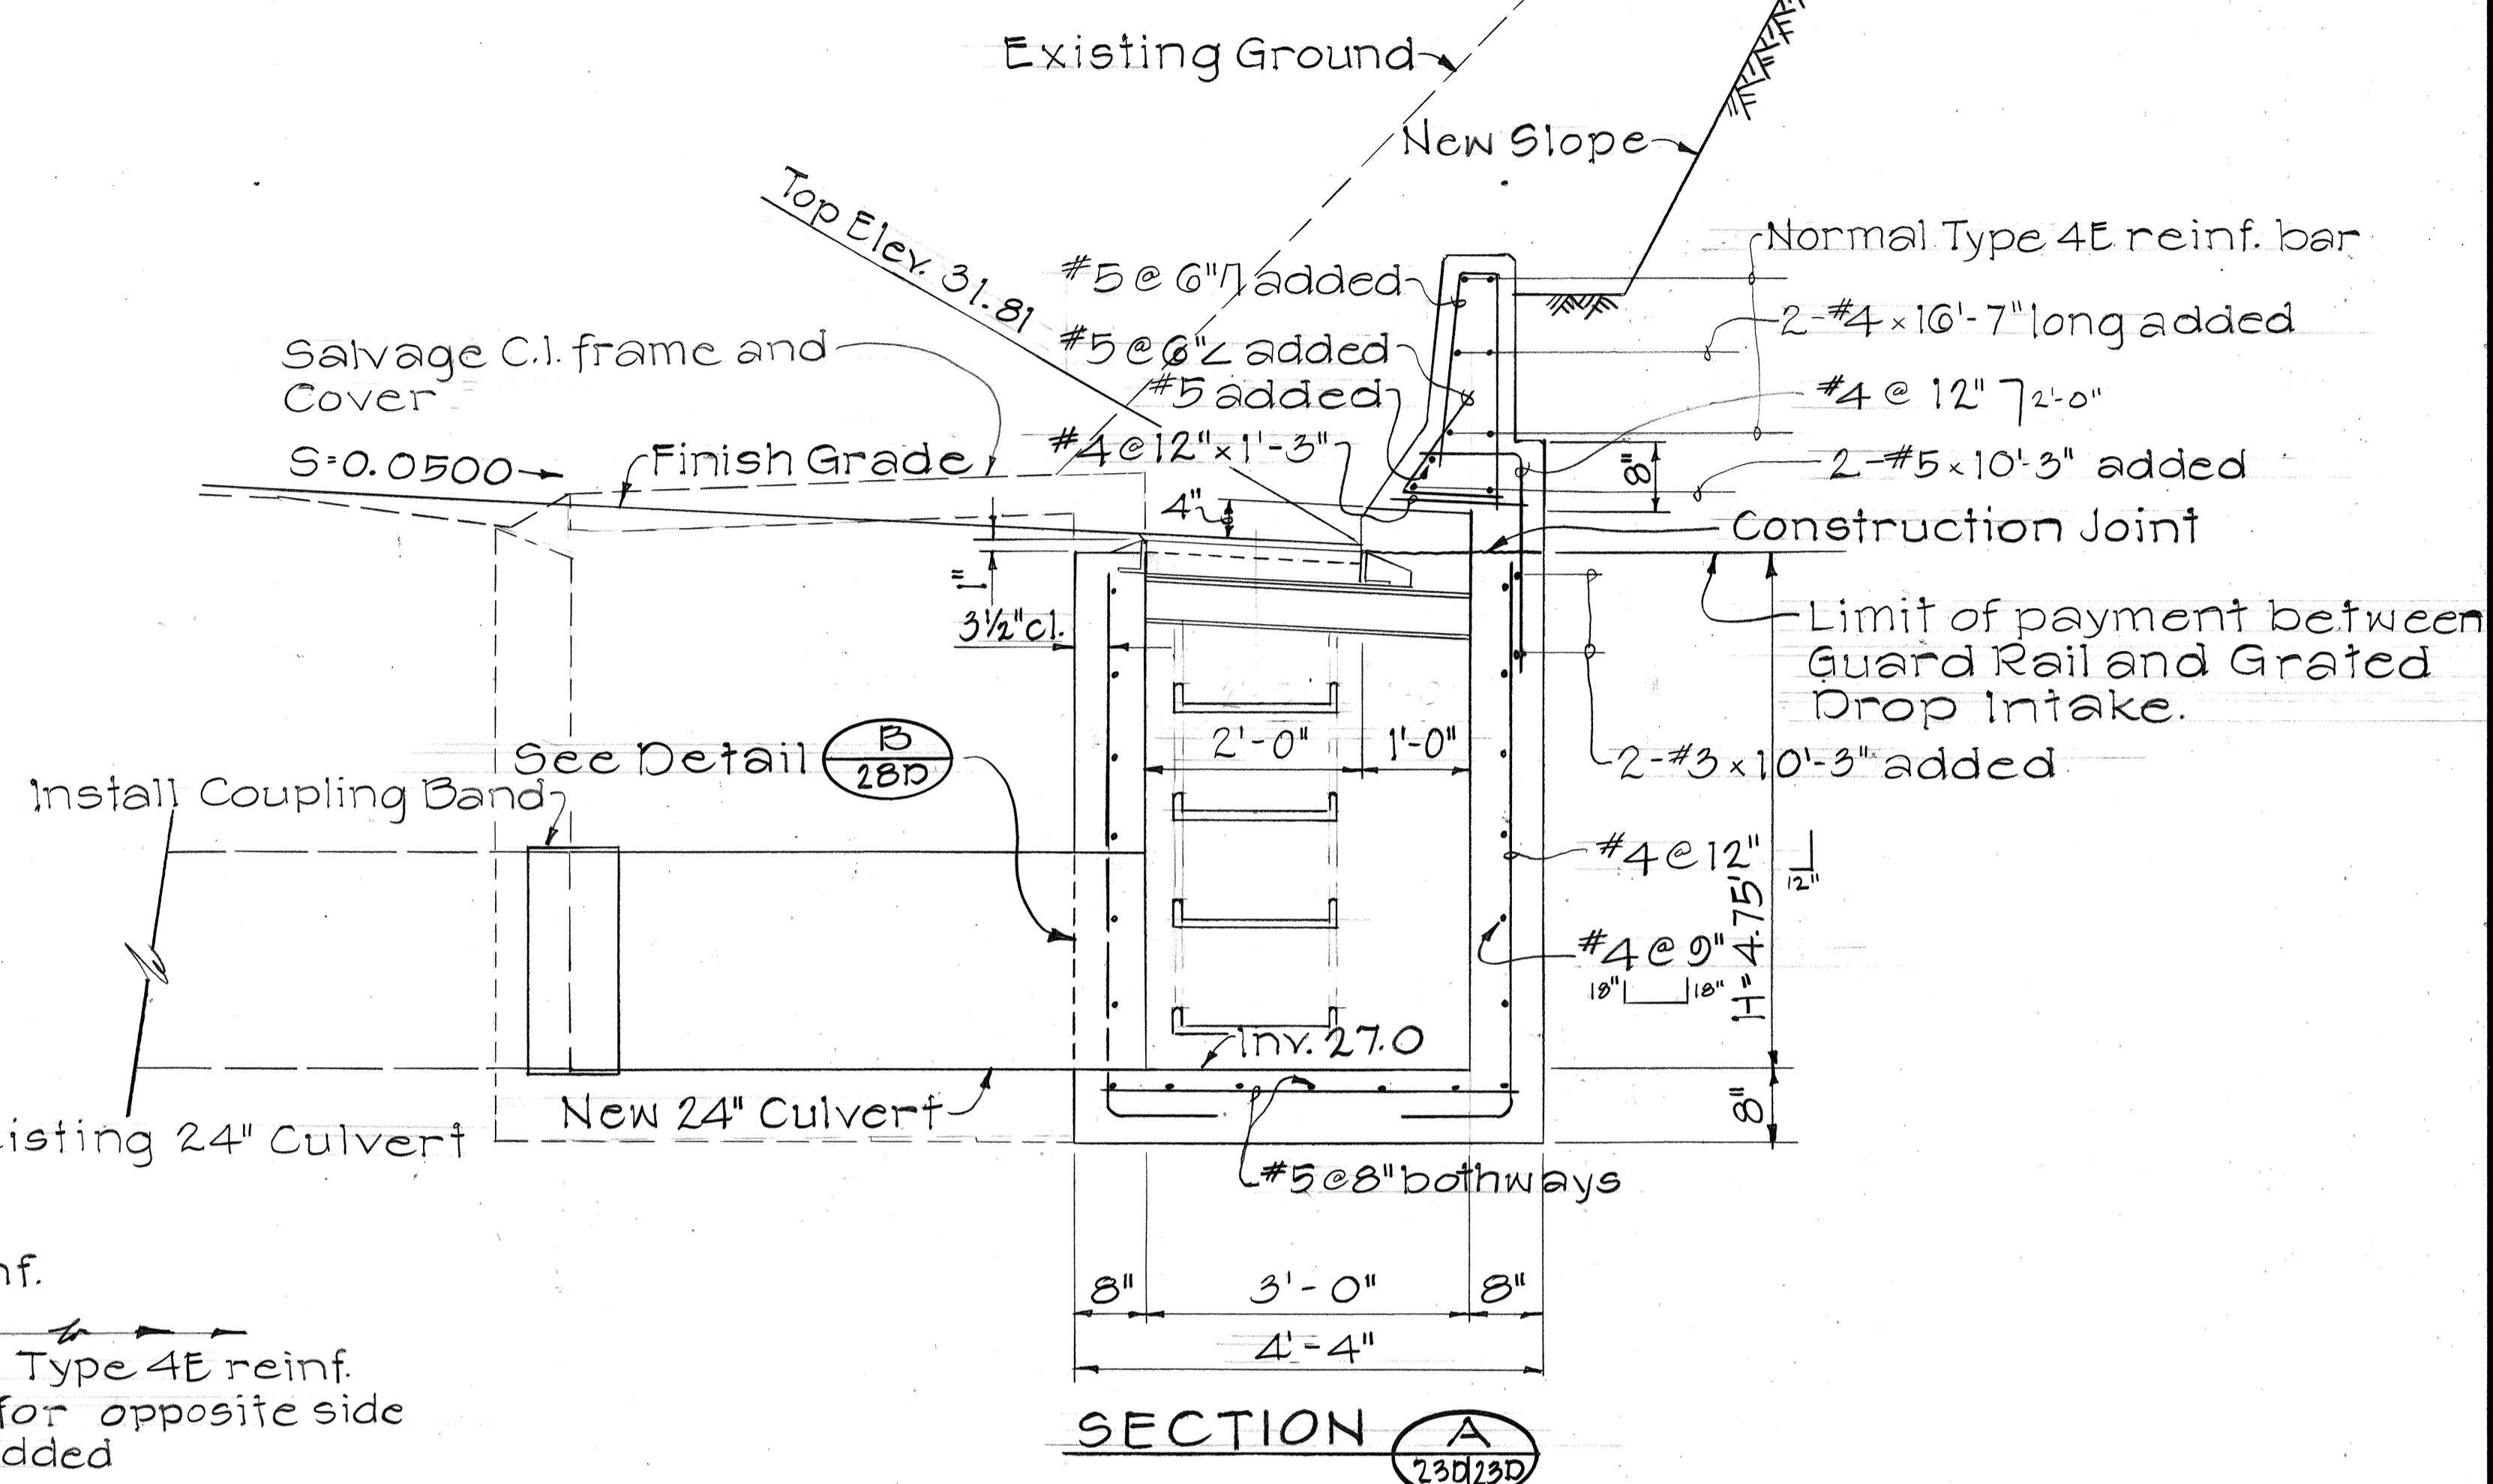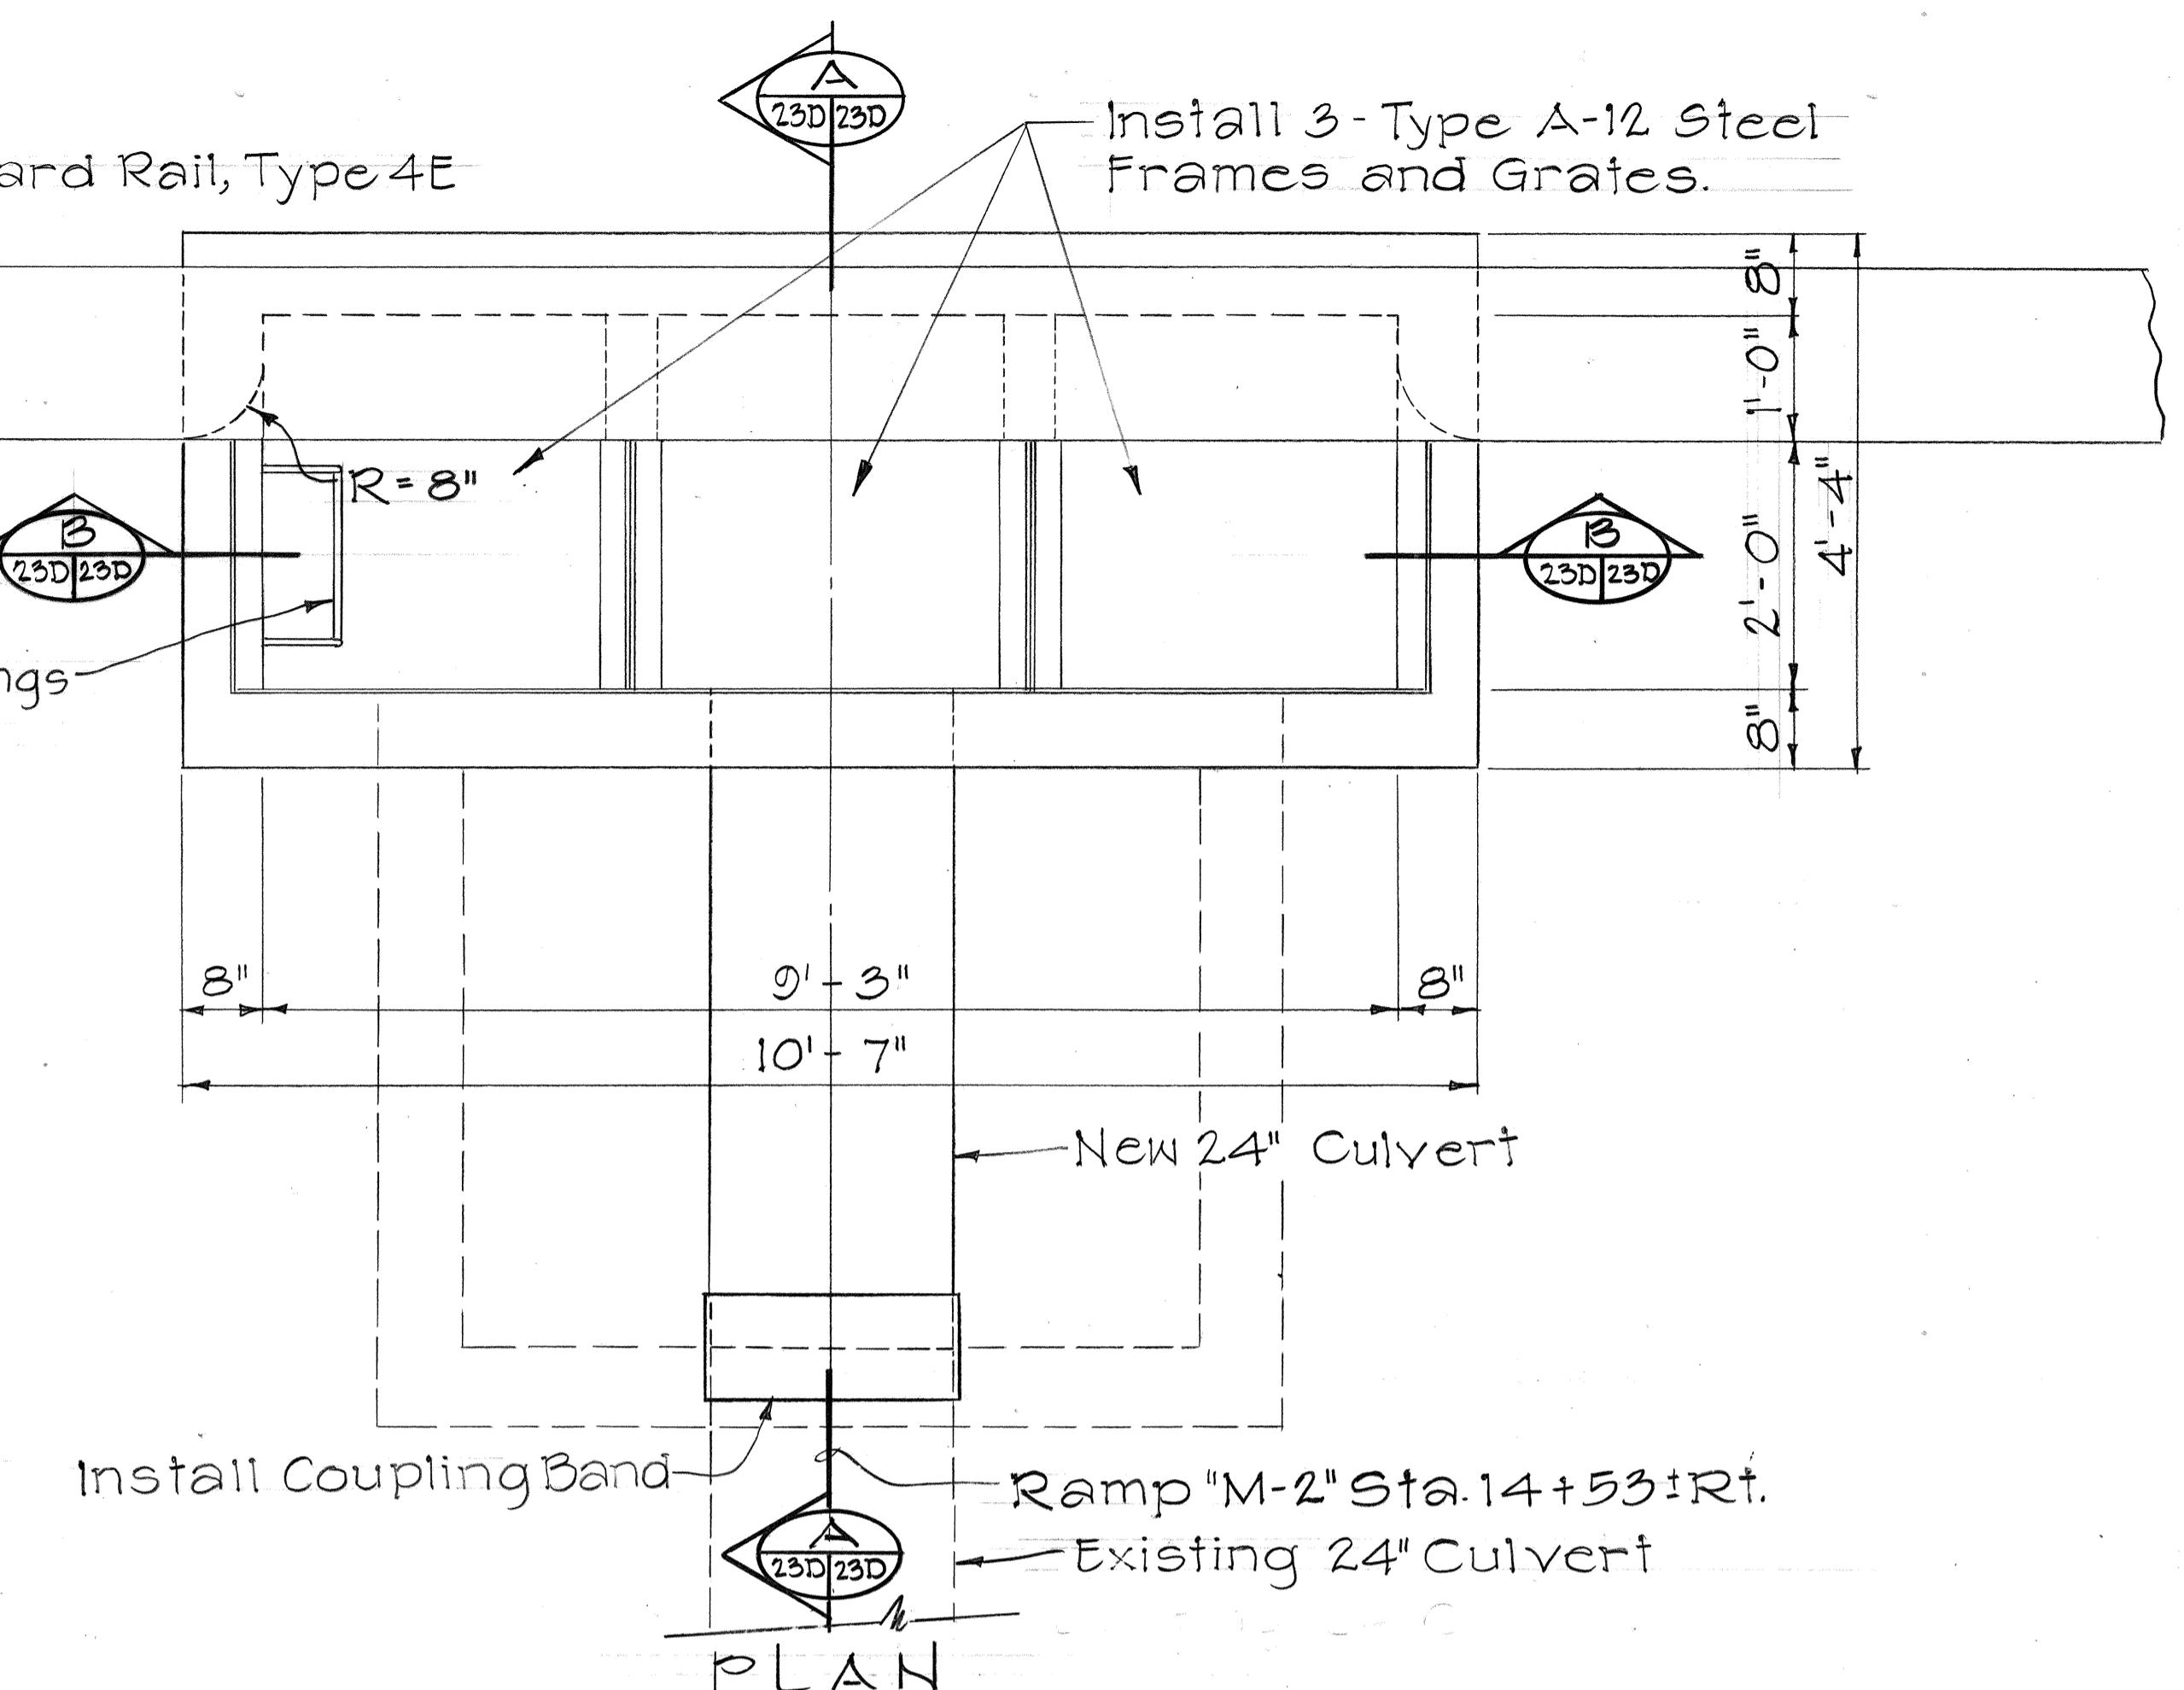

DETAILS OF TYPE 3/CO G.D. #30 AT  
RAMPS "M-2" STA. 14+53± RT.  
Scale: 3/4" = 1'-0"


STATE OF HAWAII  
DEPARTMENT OF TRANSPORTATION  
HIGHWAYS DIVISION  
**DRAINAGE DETAILS**  
INTERSTATE ROUTE H-I IMPROVEMENTS  
MIDDLE STREET TO KALIHI INTERCHANGE  
WESTBOUND LANES  
F.A.I. PROJ. NO. I-HI-1(I87)  
SCALE: AS NOTED DATE: JUNE 1983  
SHEET NO. 23D OF 30 SHEETS

| FED. ROAD<br>DIST. NO. | STATE | FED. AID<br>PROJ. NO. | FISCAL<br>YEAR | SHEET<br>NO. | TOTAL<br>SHEETS |
|------------------------|-------|-----------------------|----------------|--------------|-----------------|
| HAWAII                 | HAW.  | I-HI-1(187)           | 1984           | 72           | 197             |

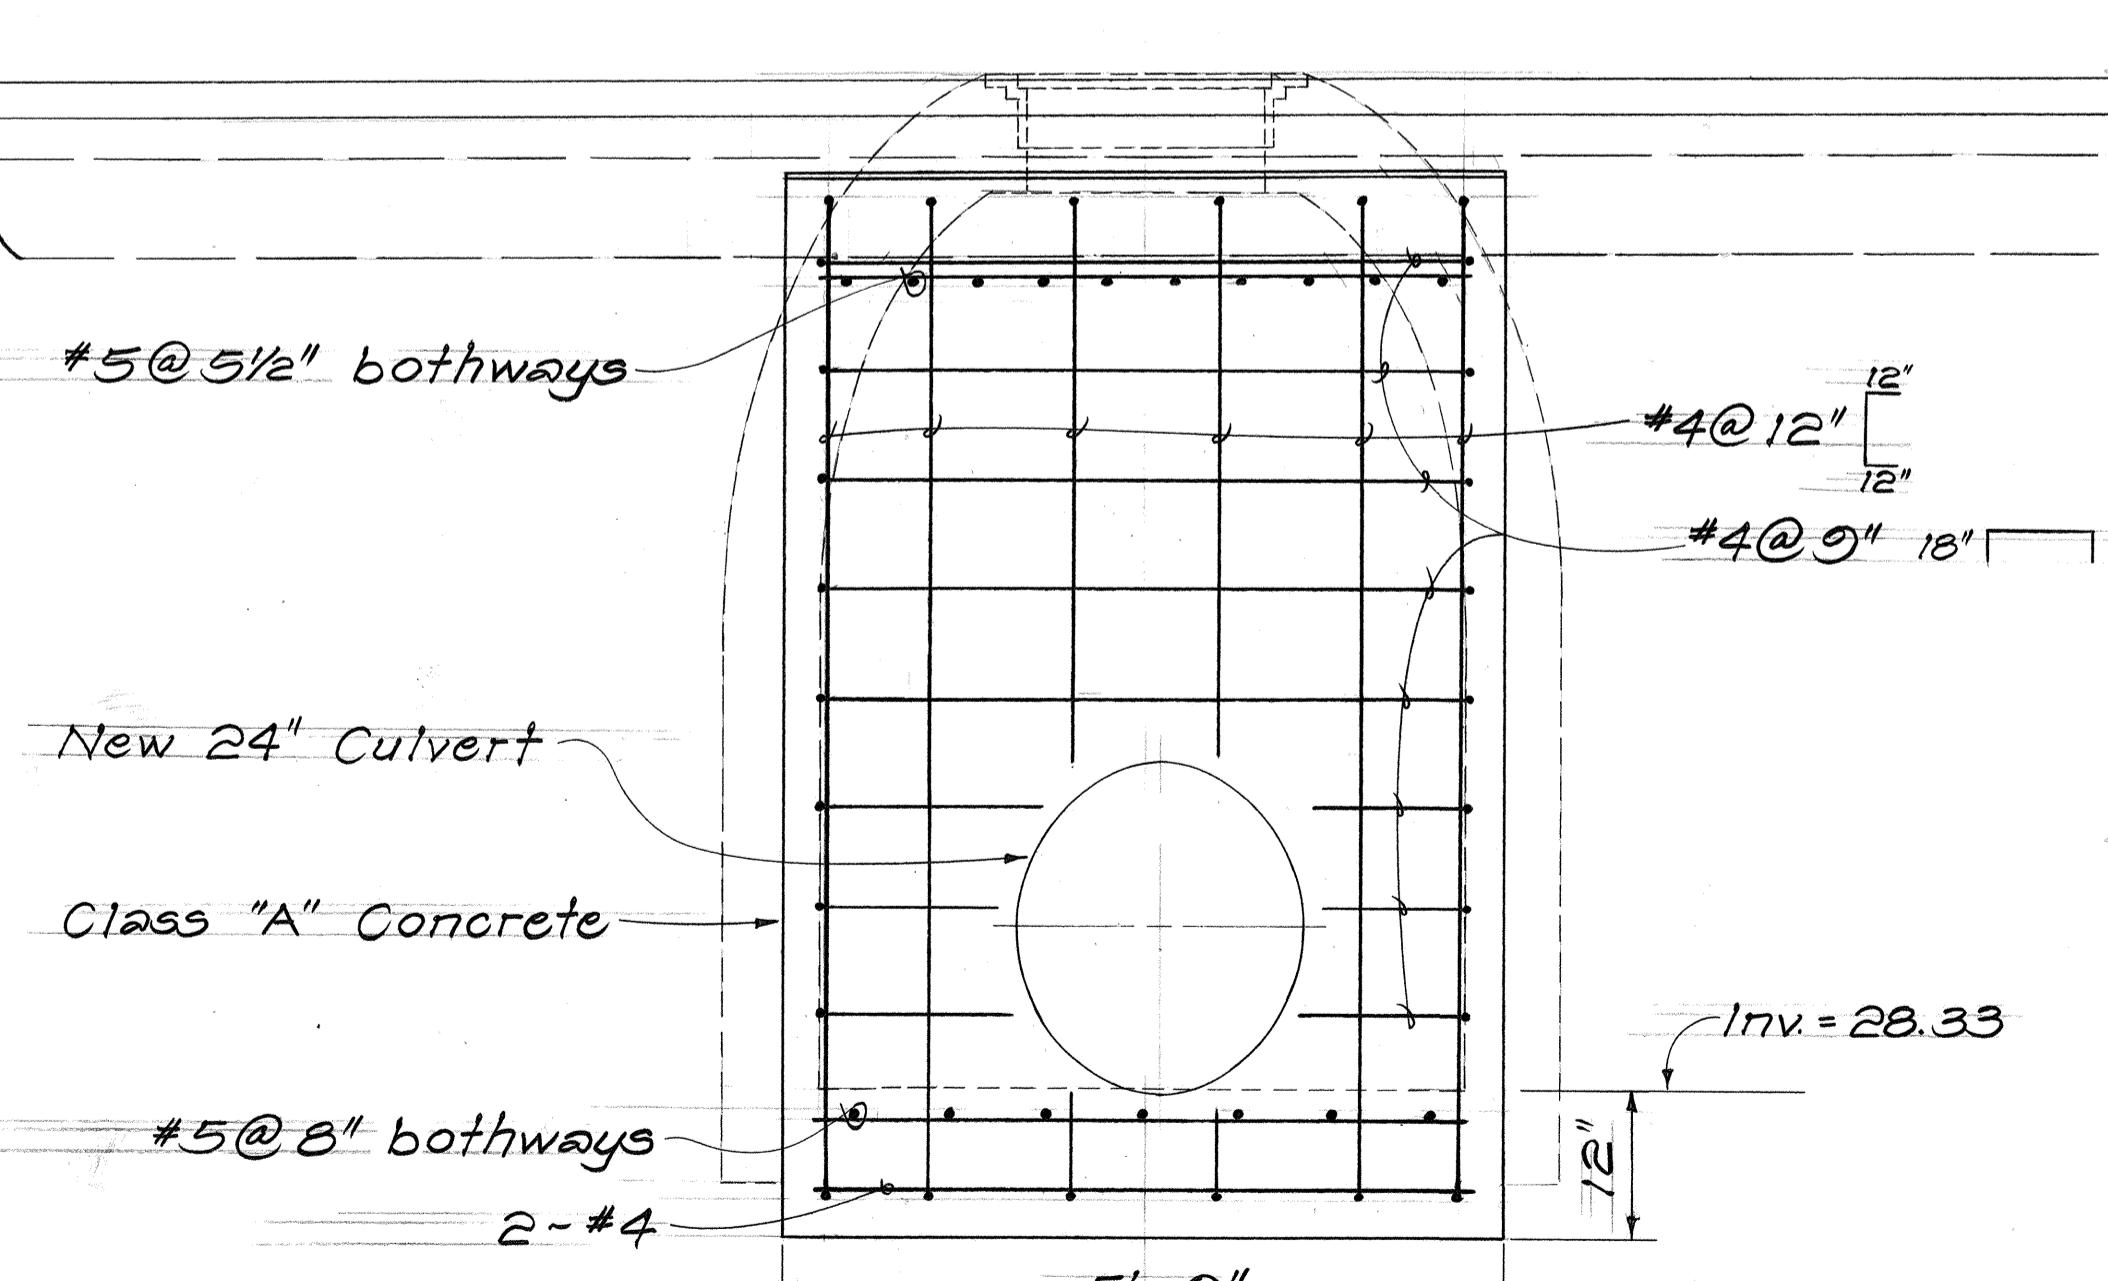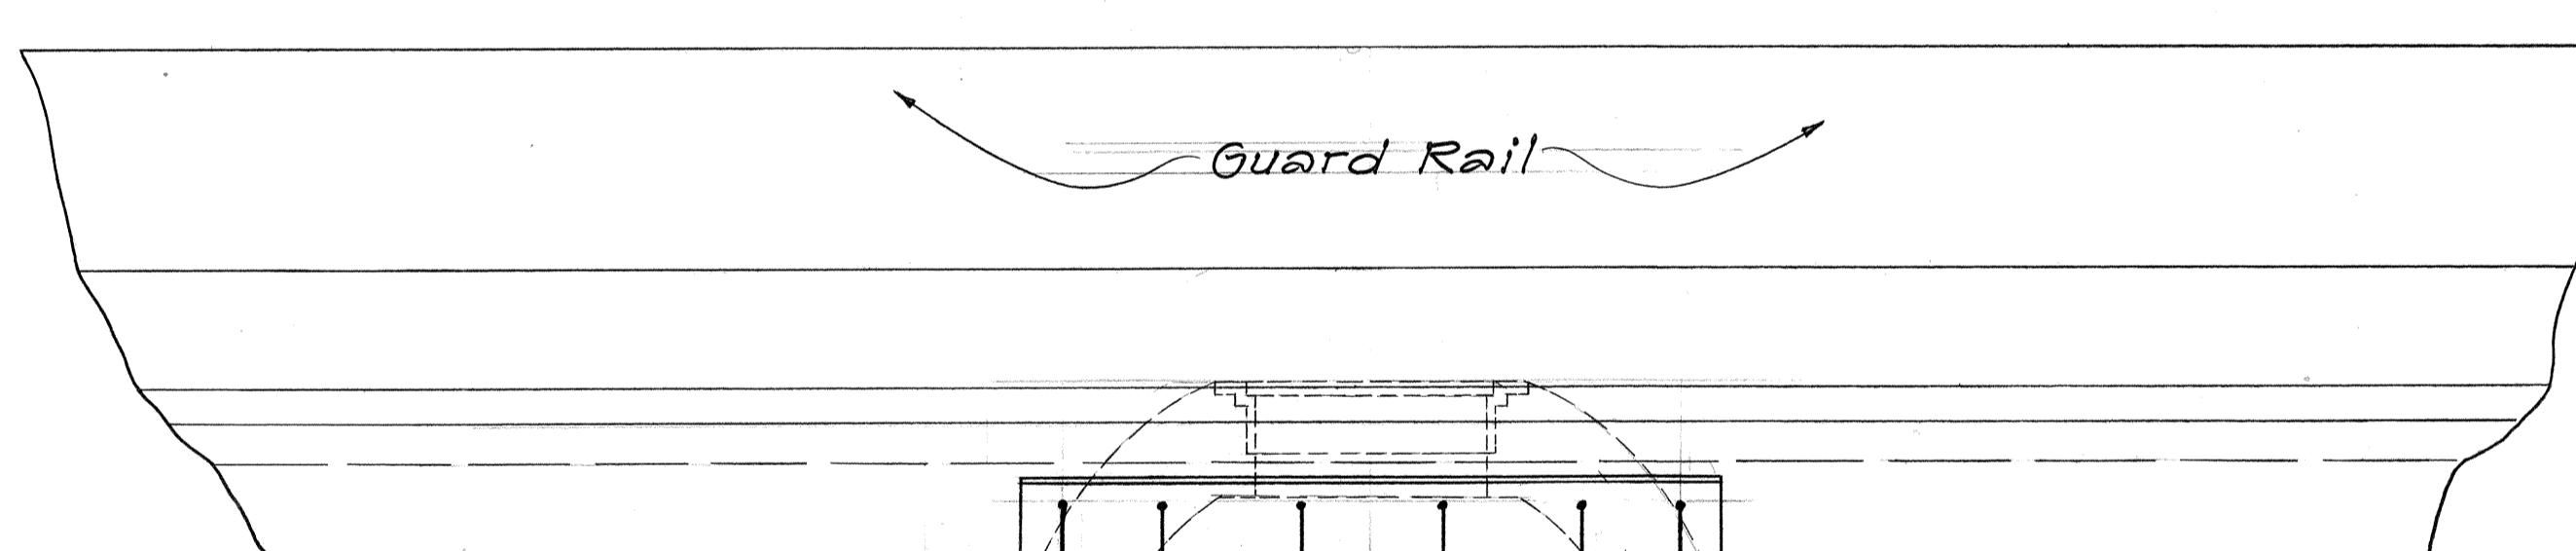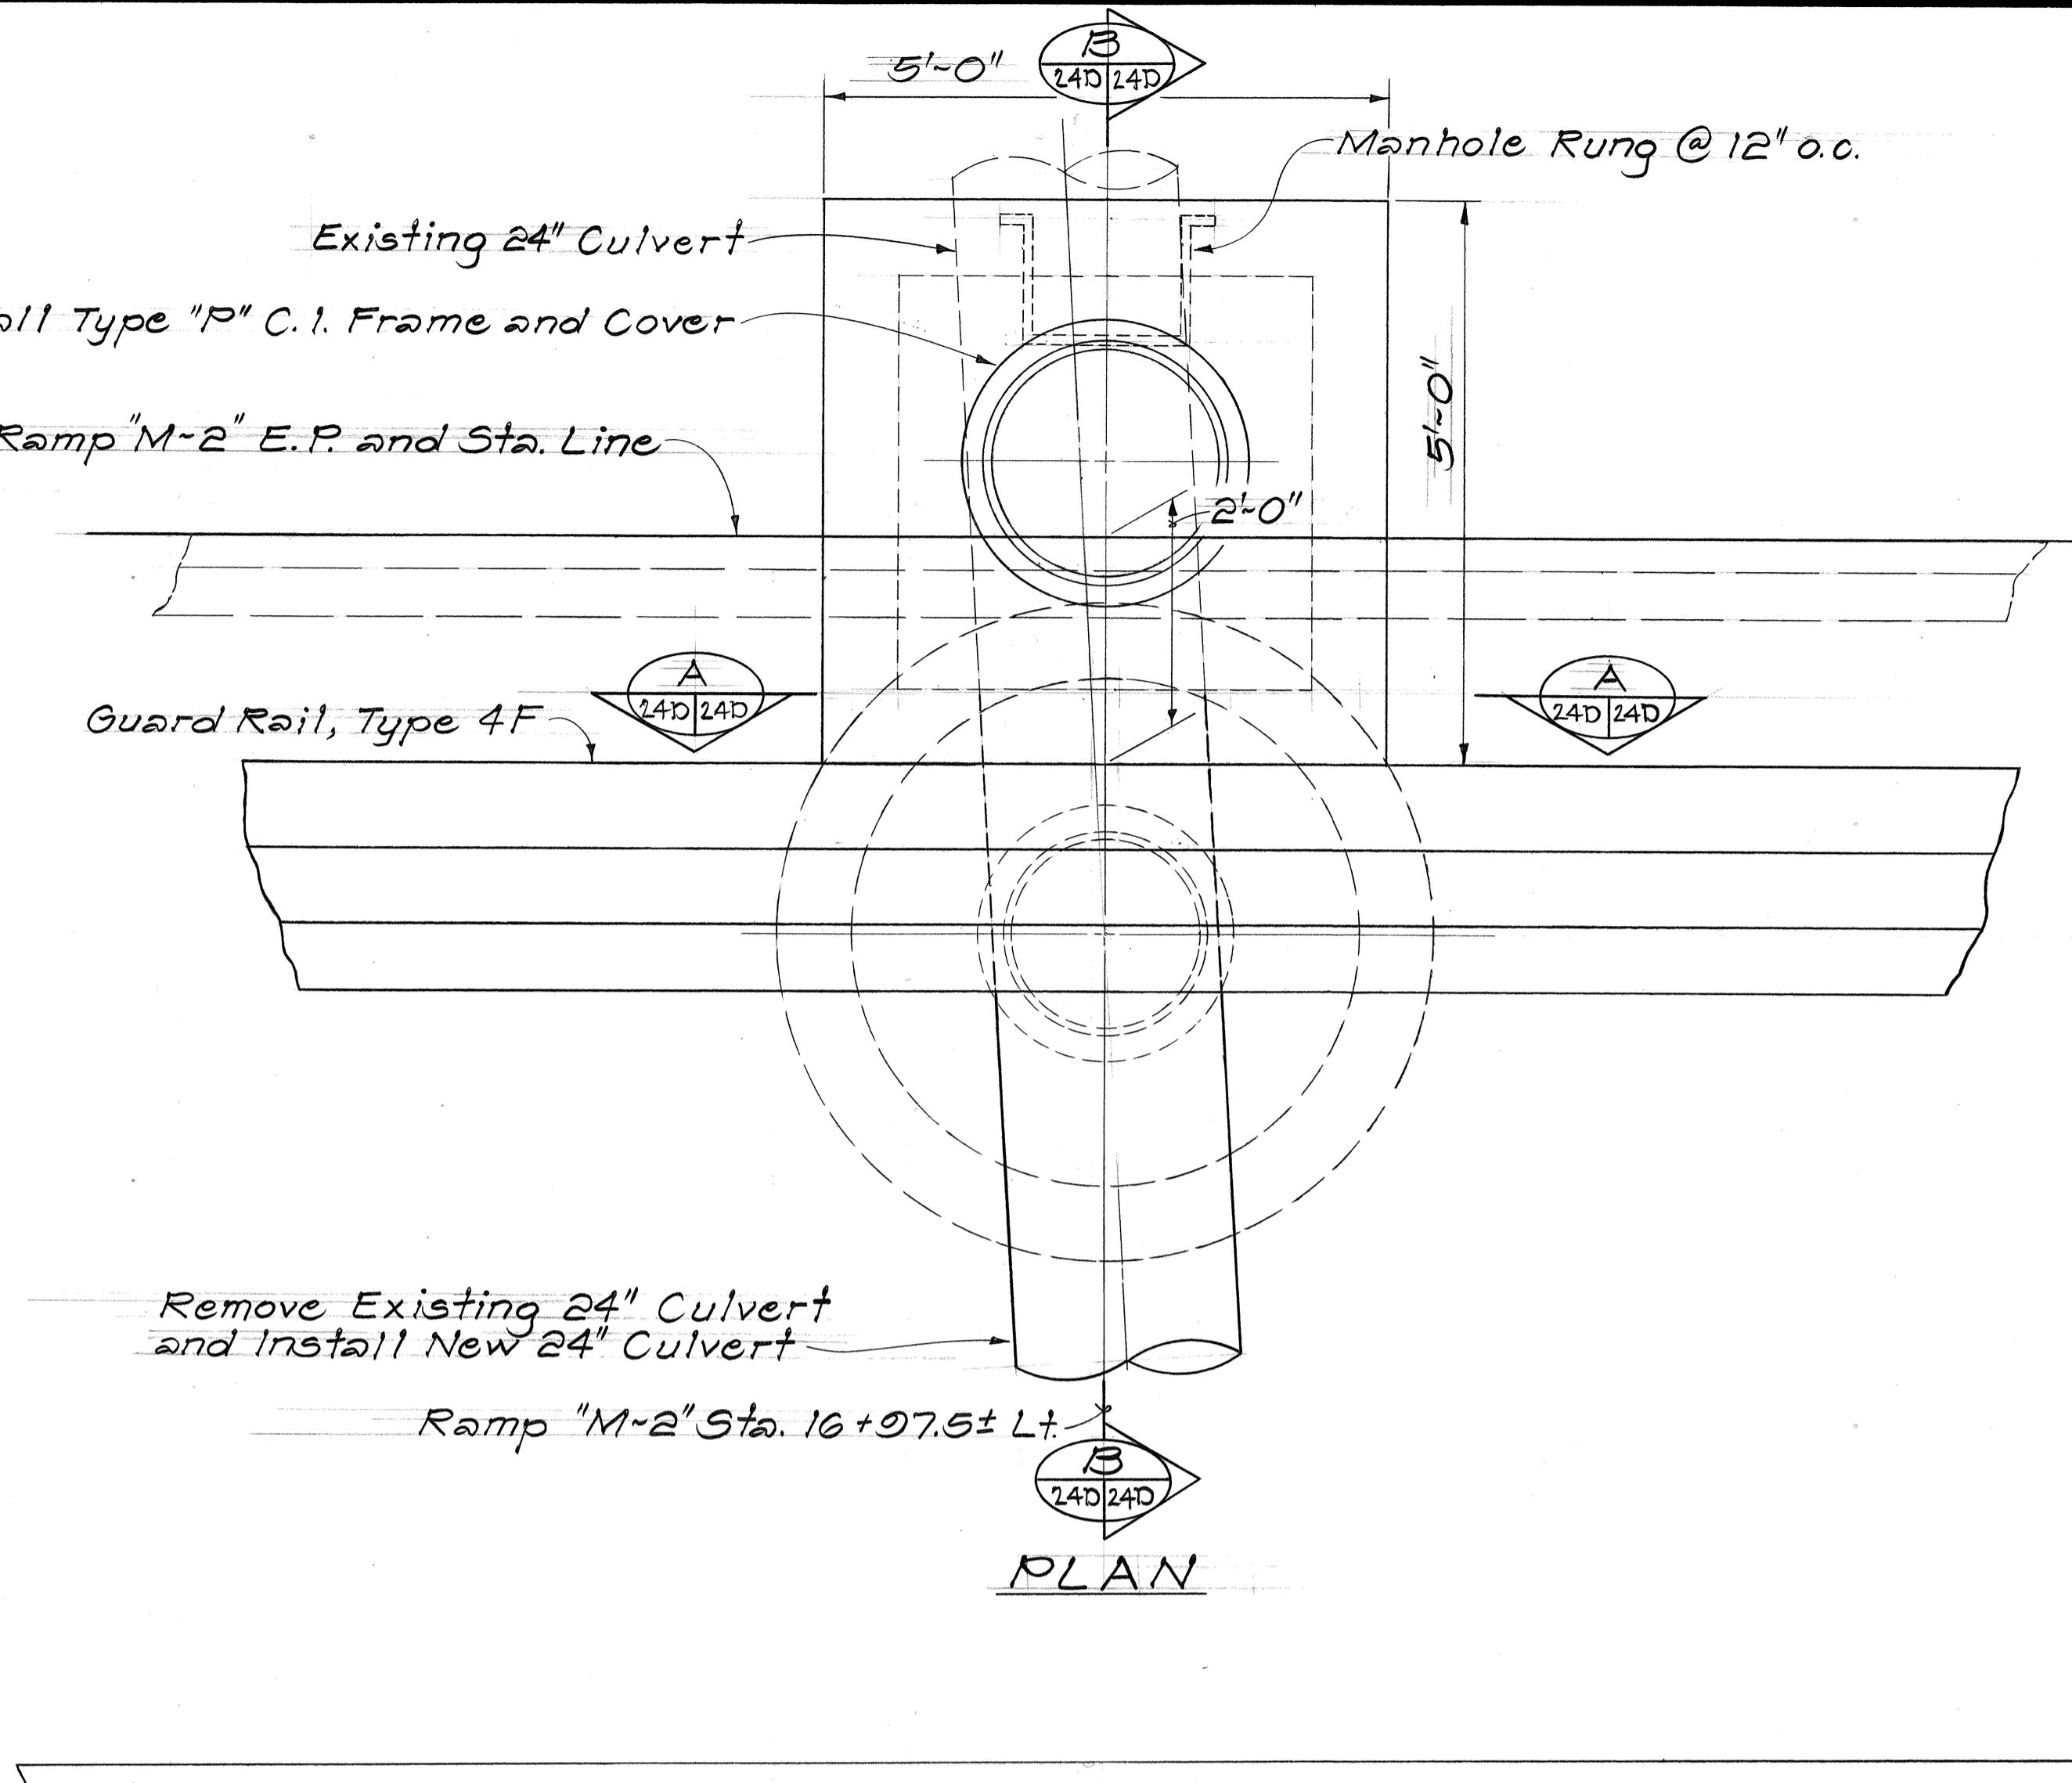




SECTION A  
24D 24D

DETAILS OF TYPE "A" S.D.M.H. #11 AT RAMP "M-2" STA. 16+07.5±  
Scale: 3/4" = 1'-0"

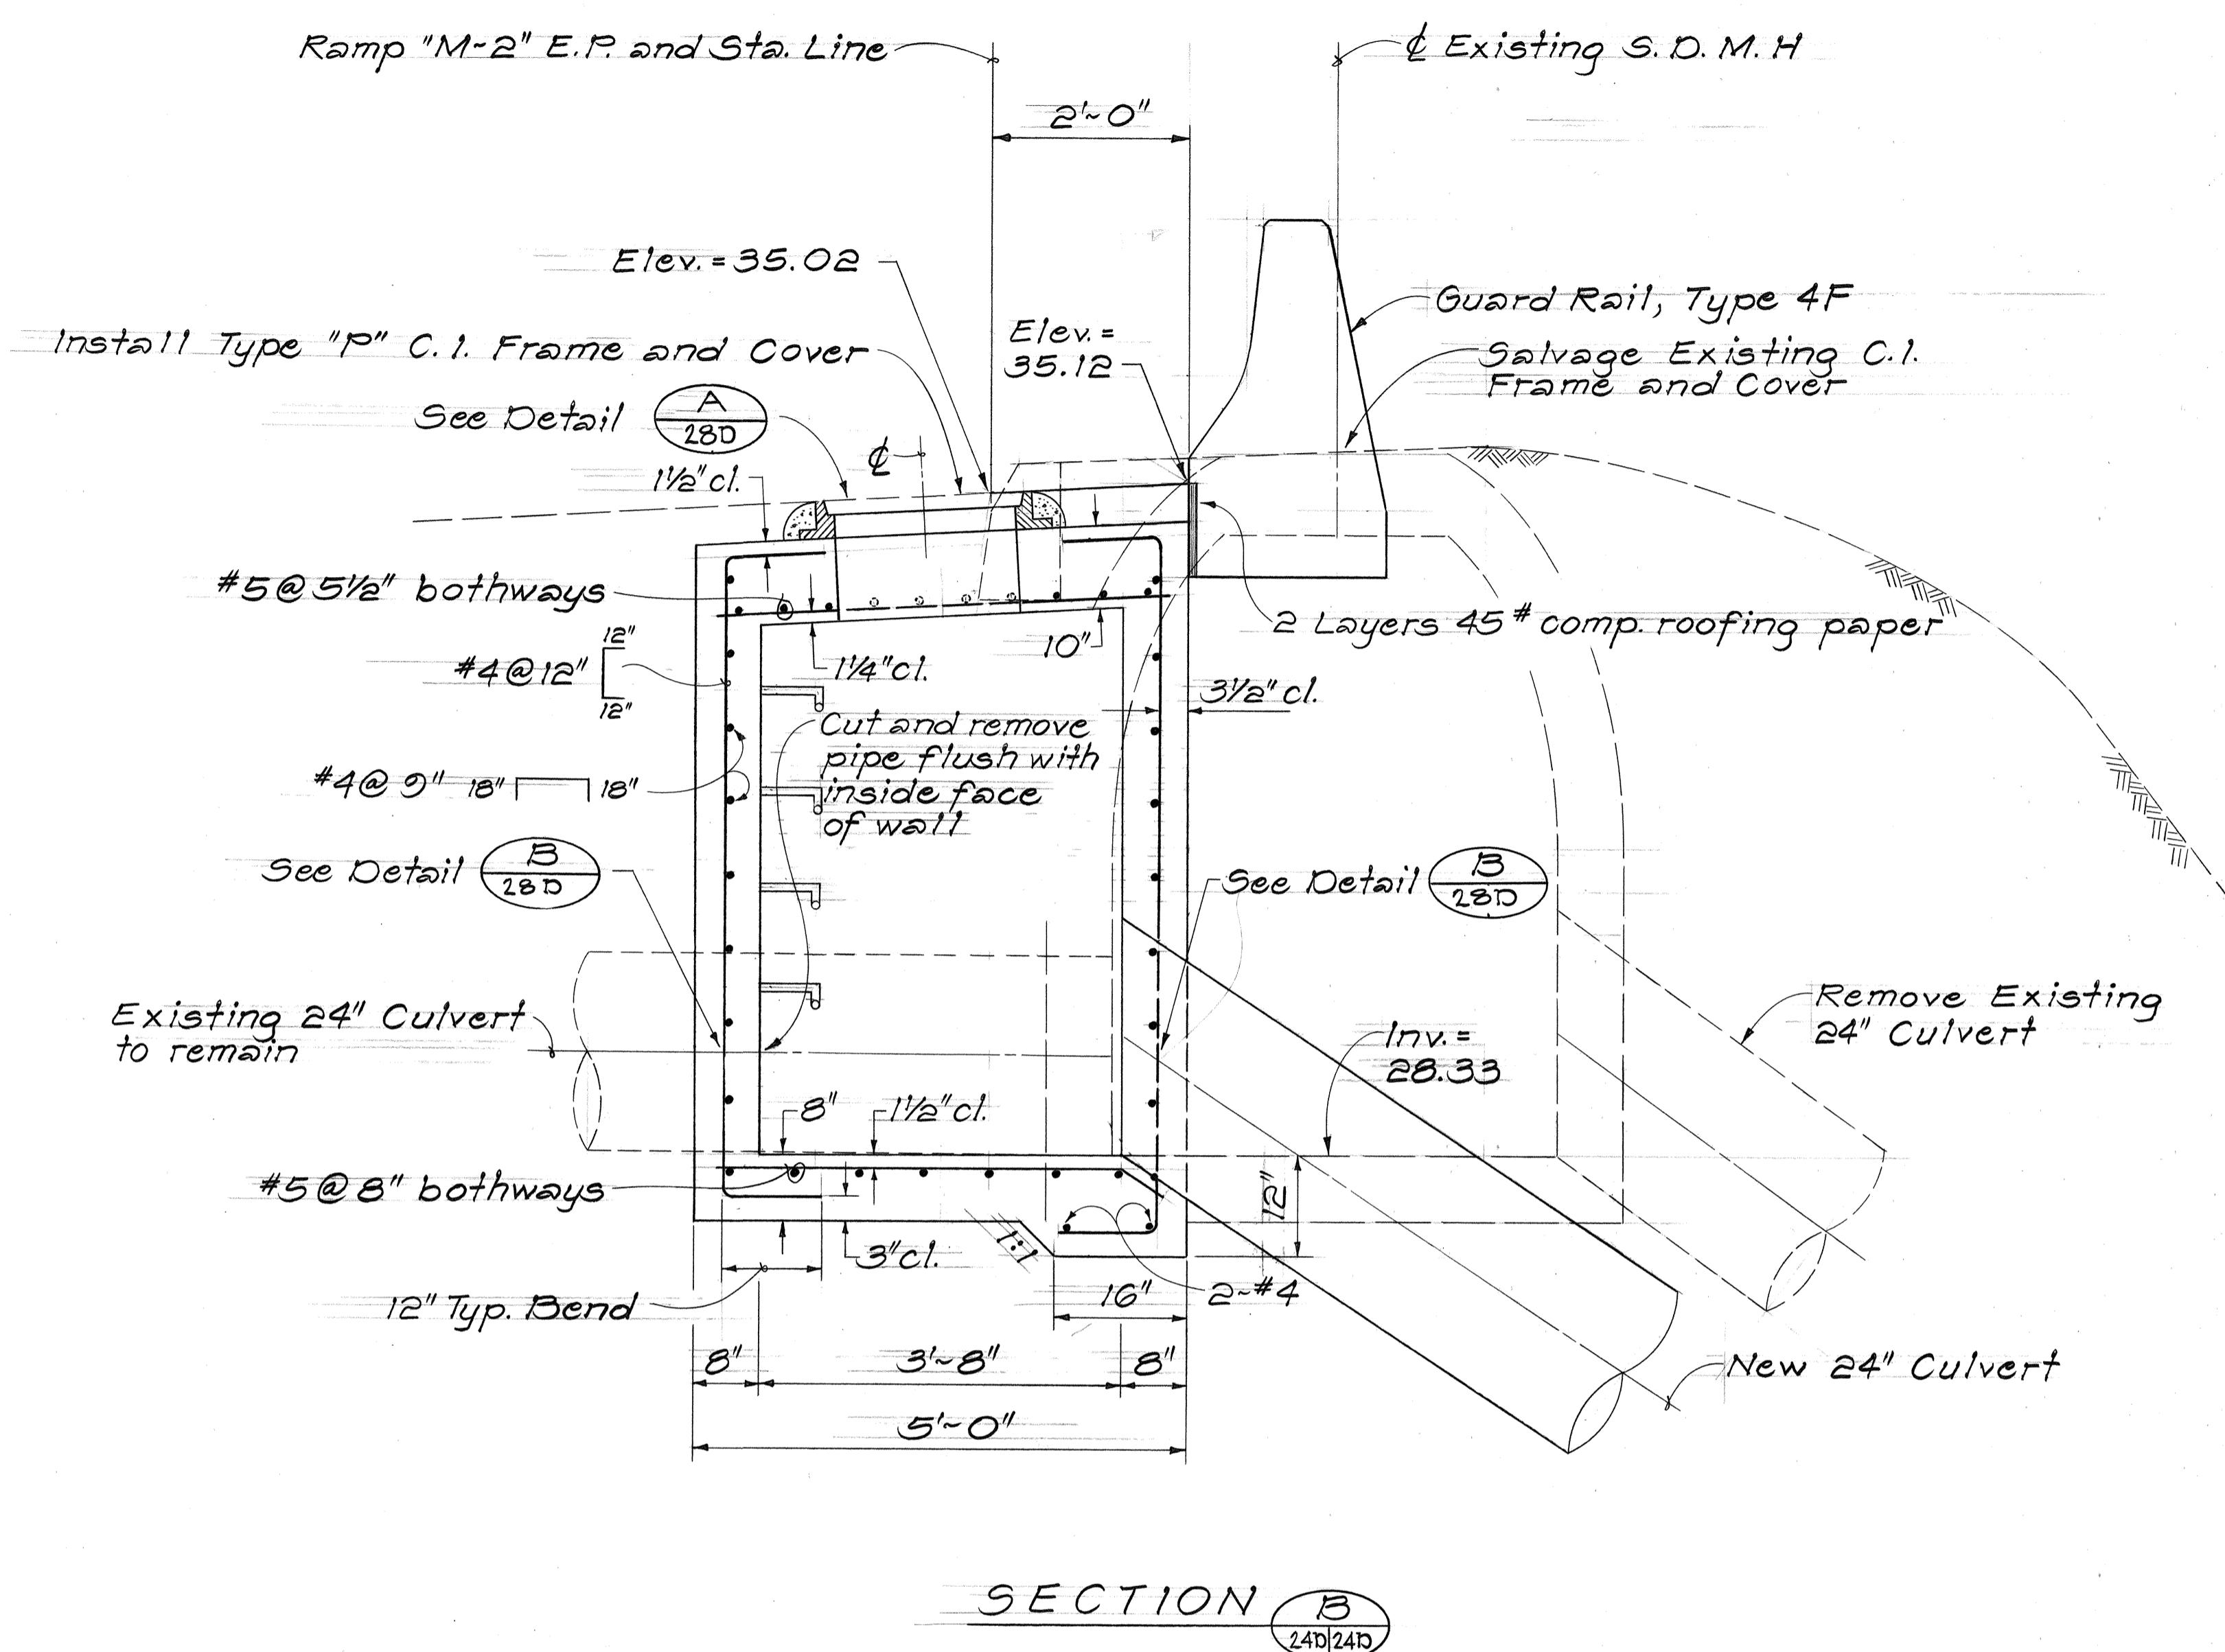

STATE OF HAWAII  
DEPARTMENT OF TRANSPORTATION  
LAND TRANSPORTATION FACILITIES DIVISION  
**DRAINAGE DETAILS**  
INTERSTATE ROUTE H-1 IMPROVEMENTS  
MIDDLE STREET TO KALIHI INTERCHANGE  
WESTBOUND LANES  
F.A.I. PROJ. NO. I-HI-1(187)  
SCALE: 3/4" = 1'-0"  
DATE: JUNE 1983  
SHEET NO. 24D OF 30 SHEETS

| FED. ROAD DIST. NO. | STATE | FED. AID PROJ. NO. | FISCAL YEAR | SHEET NO. | TOTAL SHEETS |
|---------------------|-------|--------------------|-------------|-----------|--------------|
| HAWAII              | HAW.  | I-HI-1(187)        | 1984        | 73        | 191          |

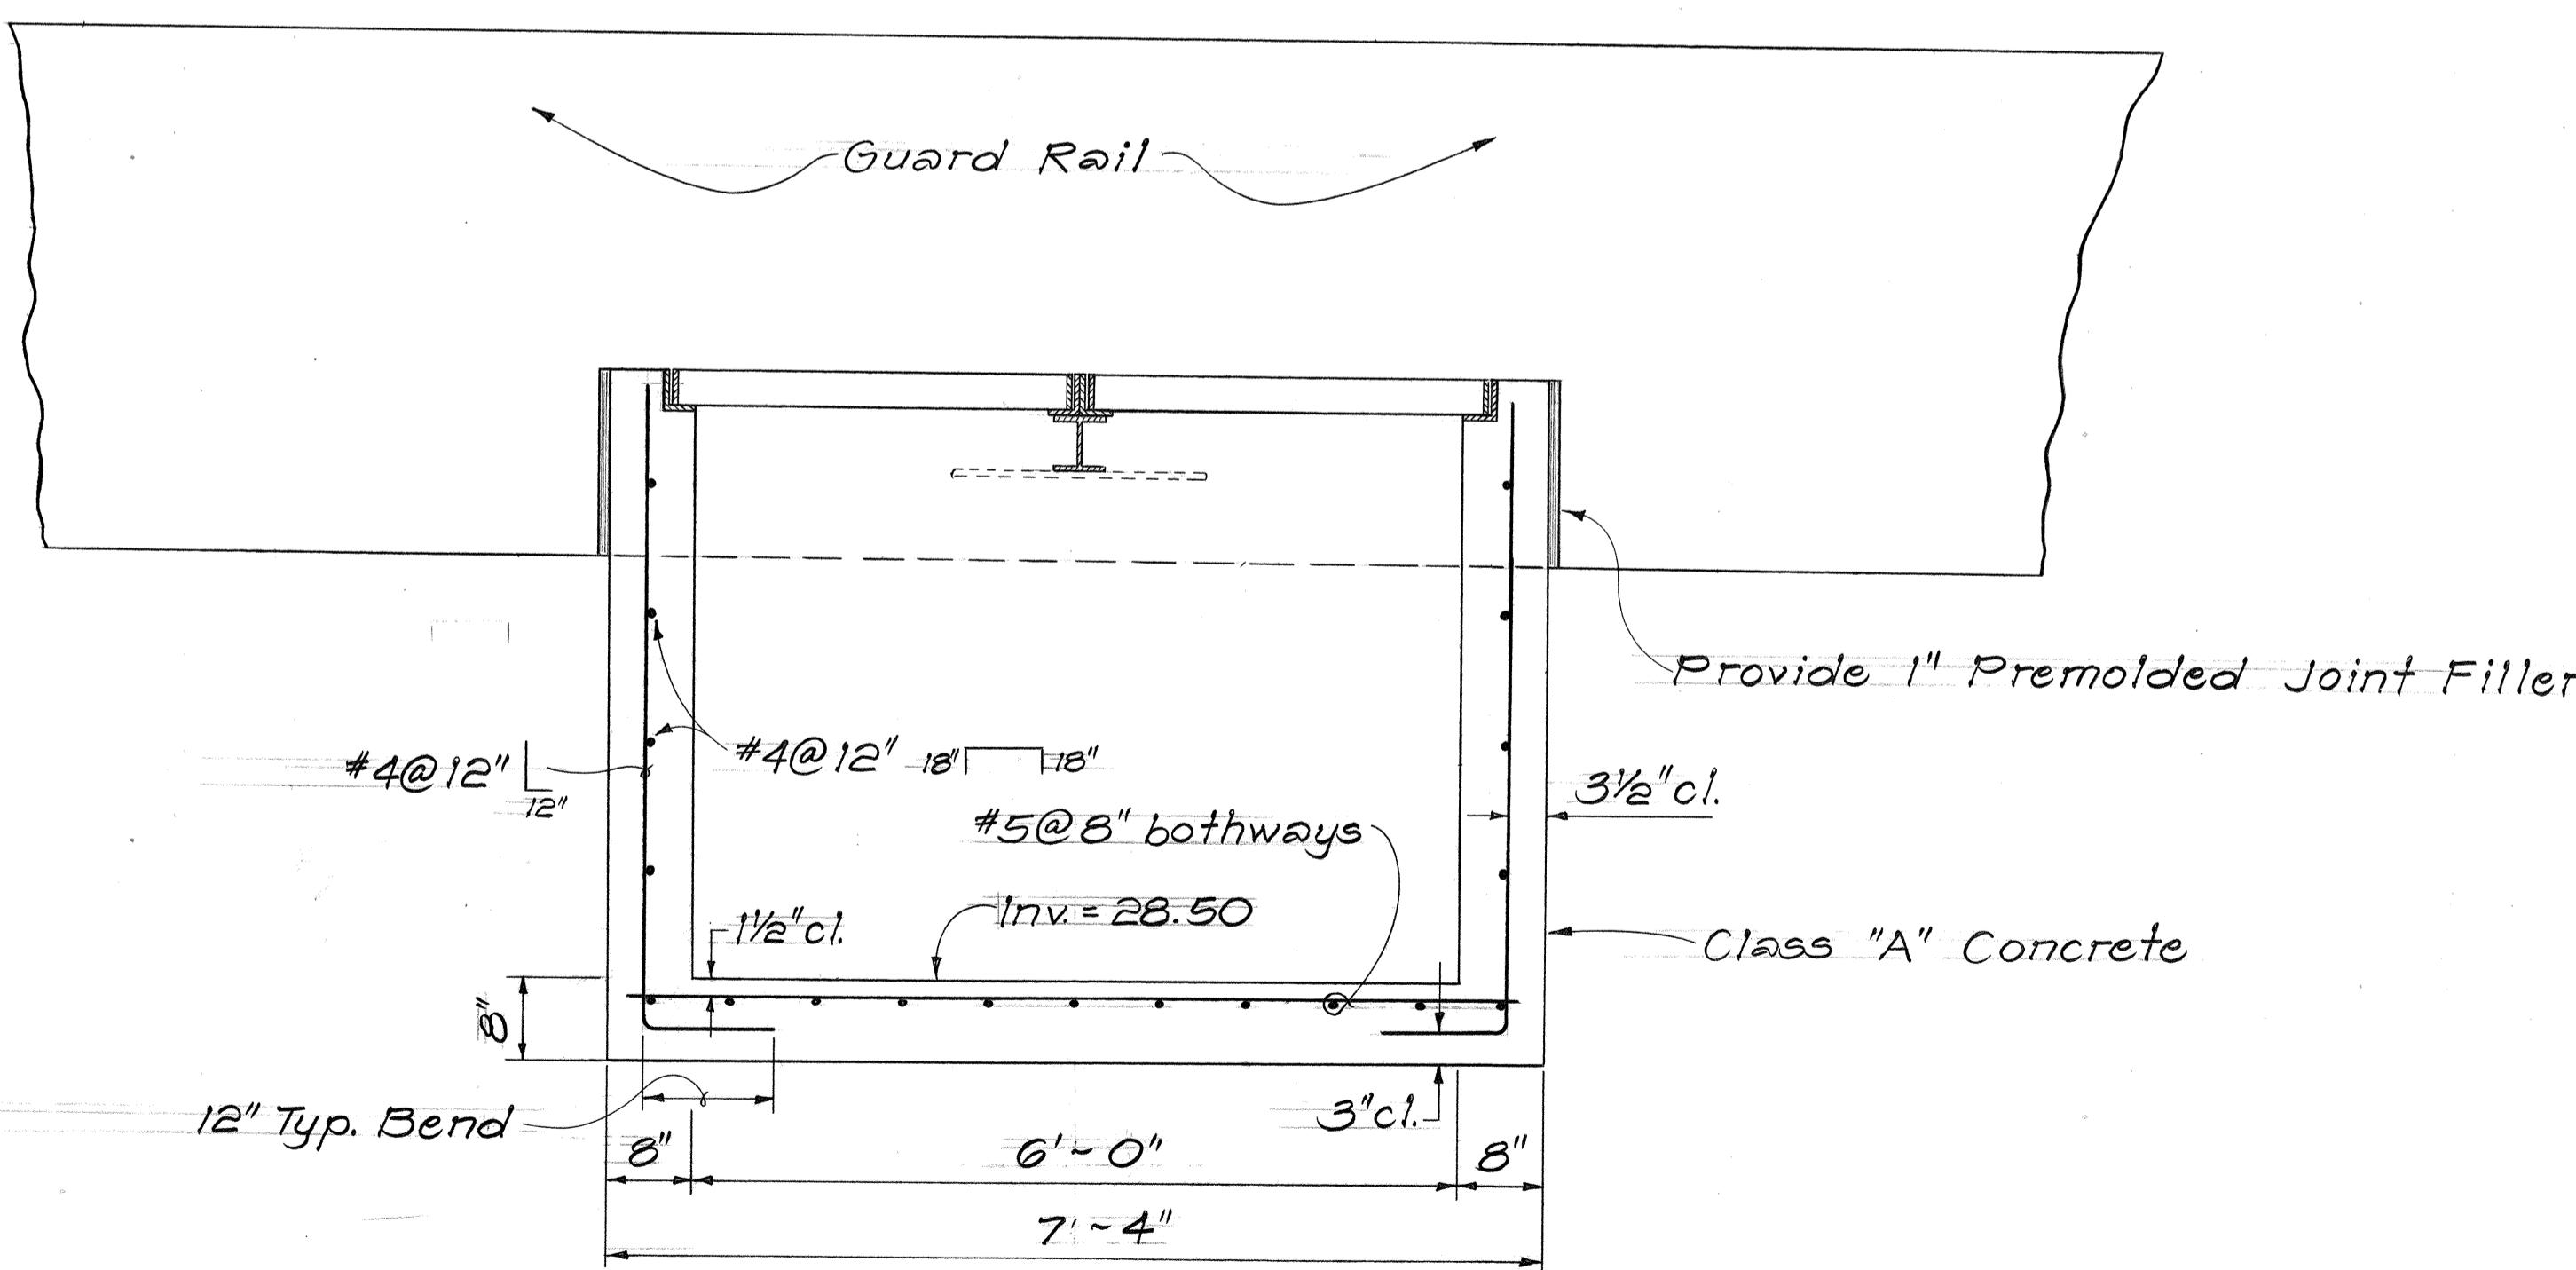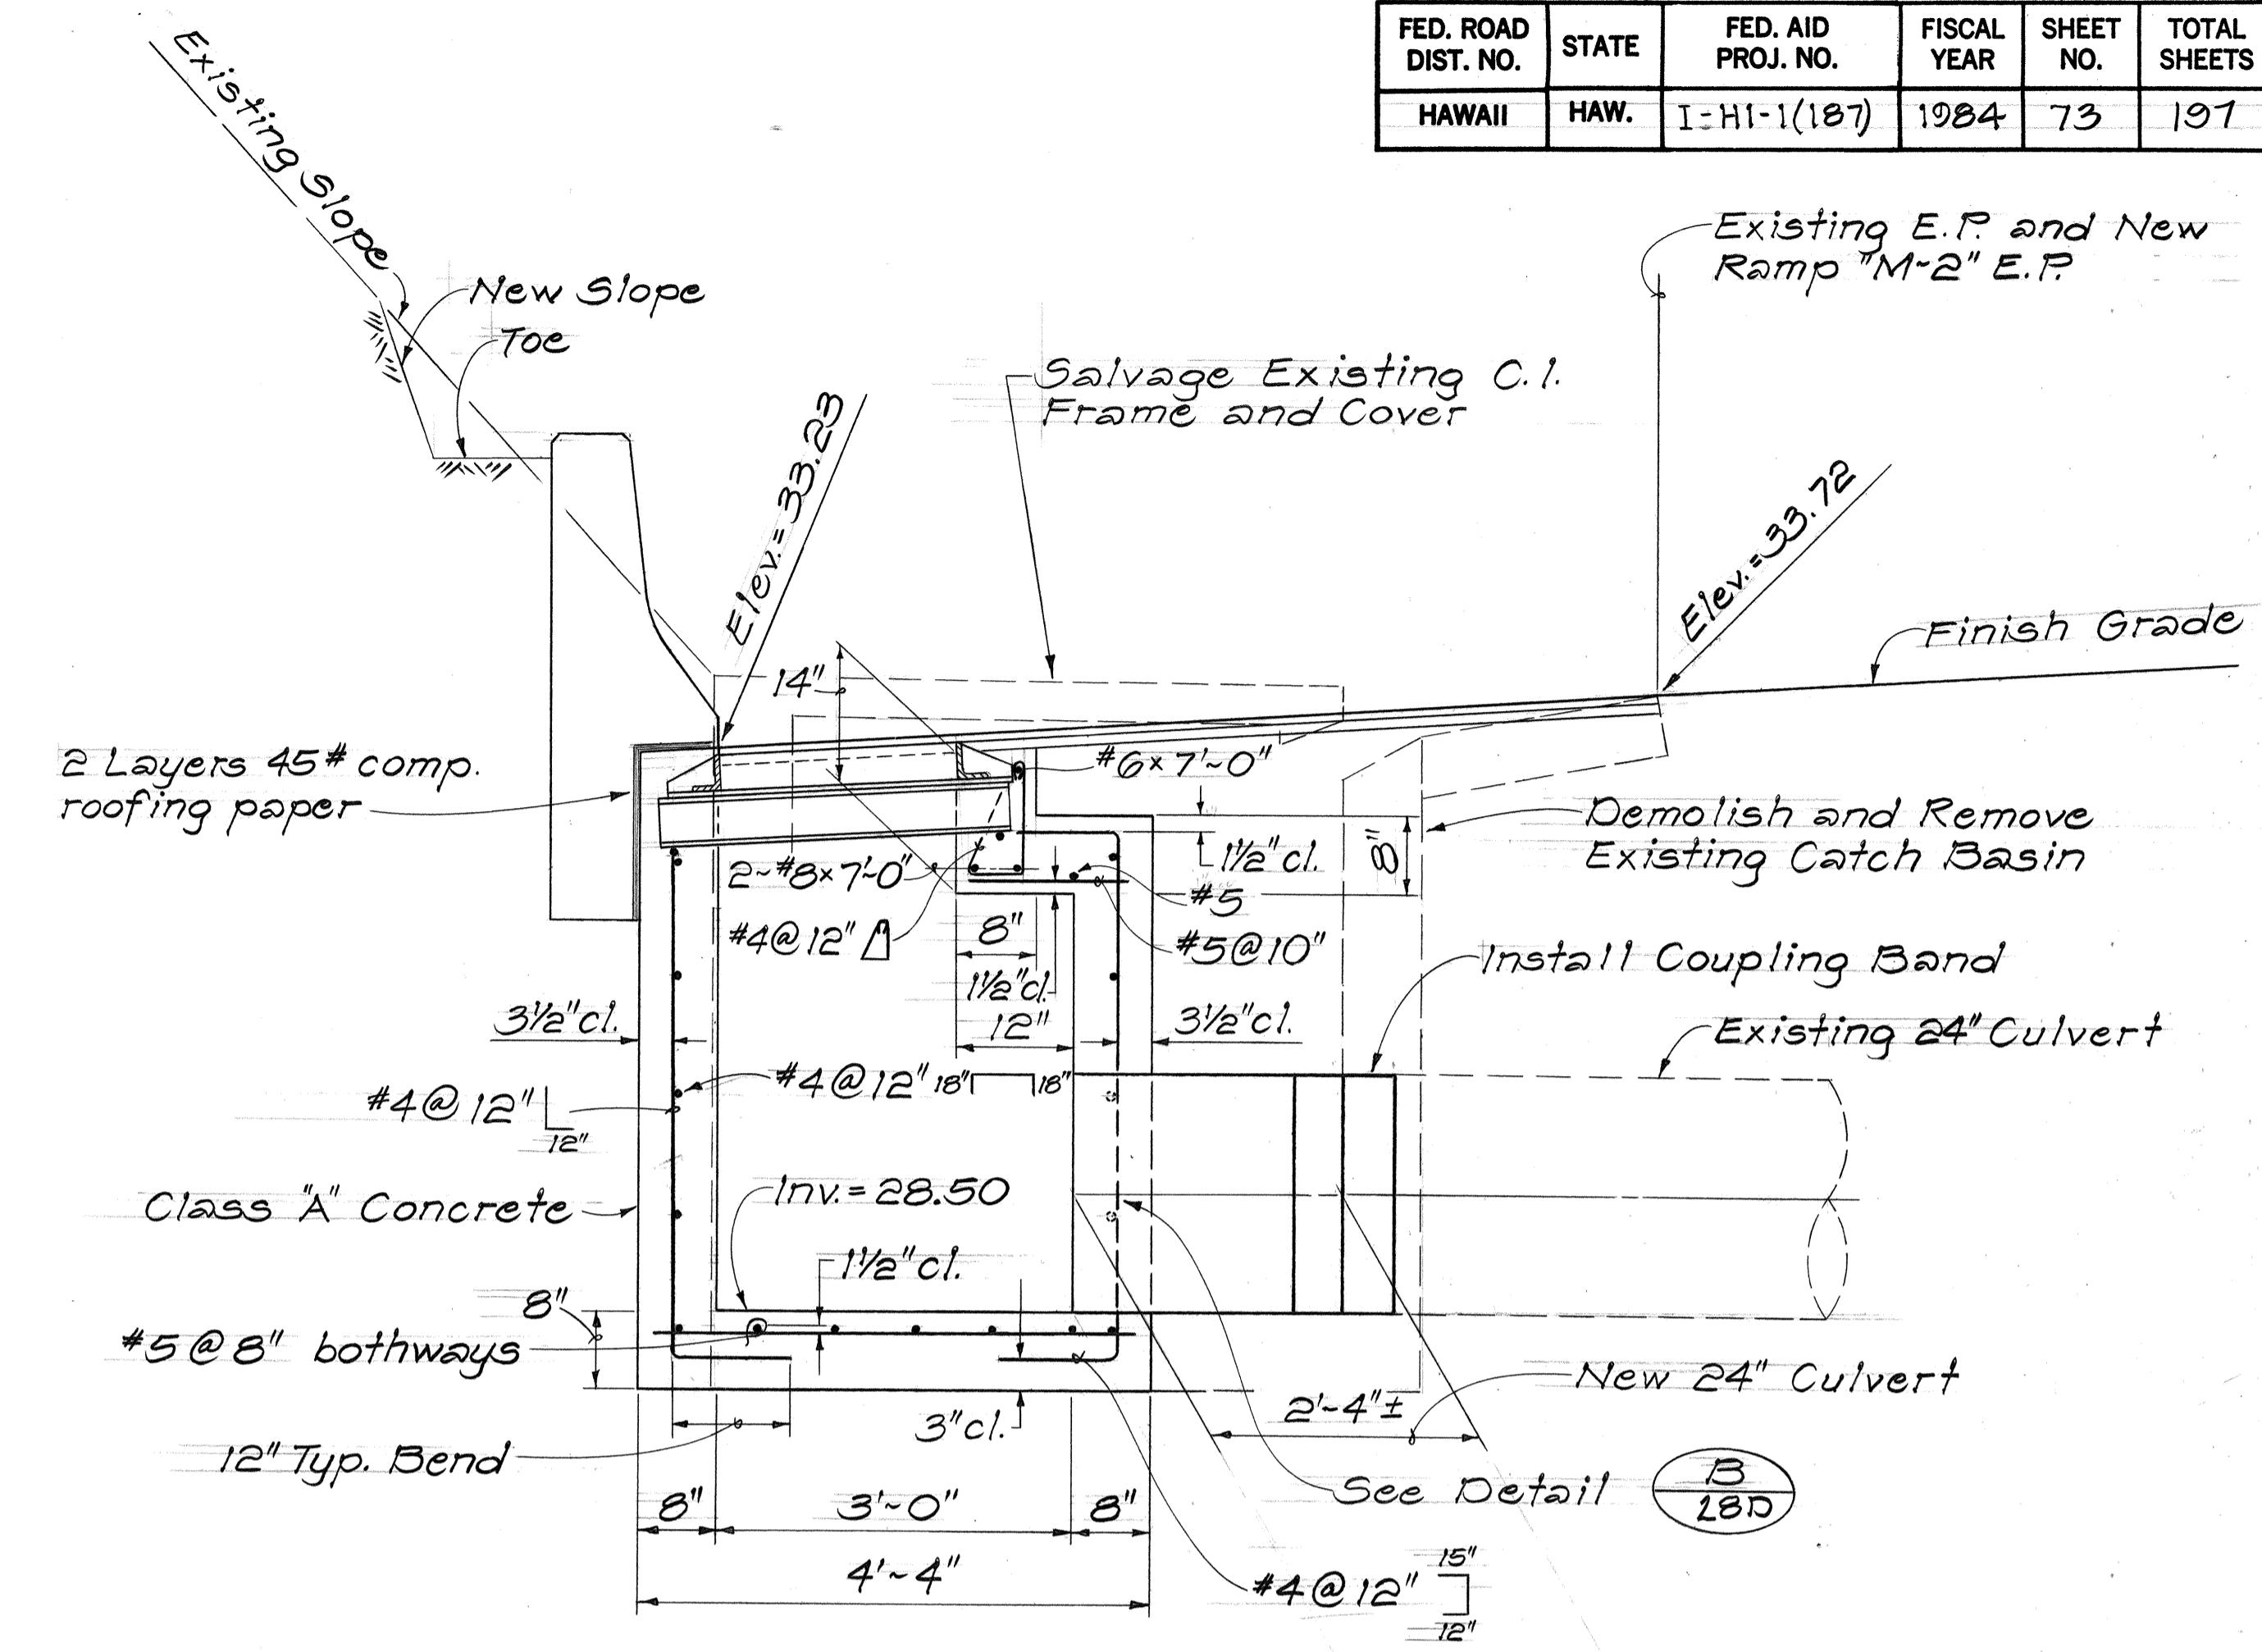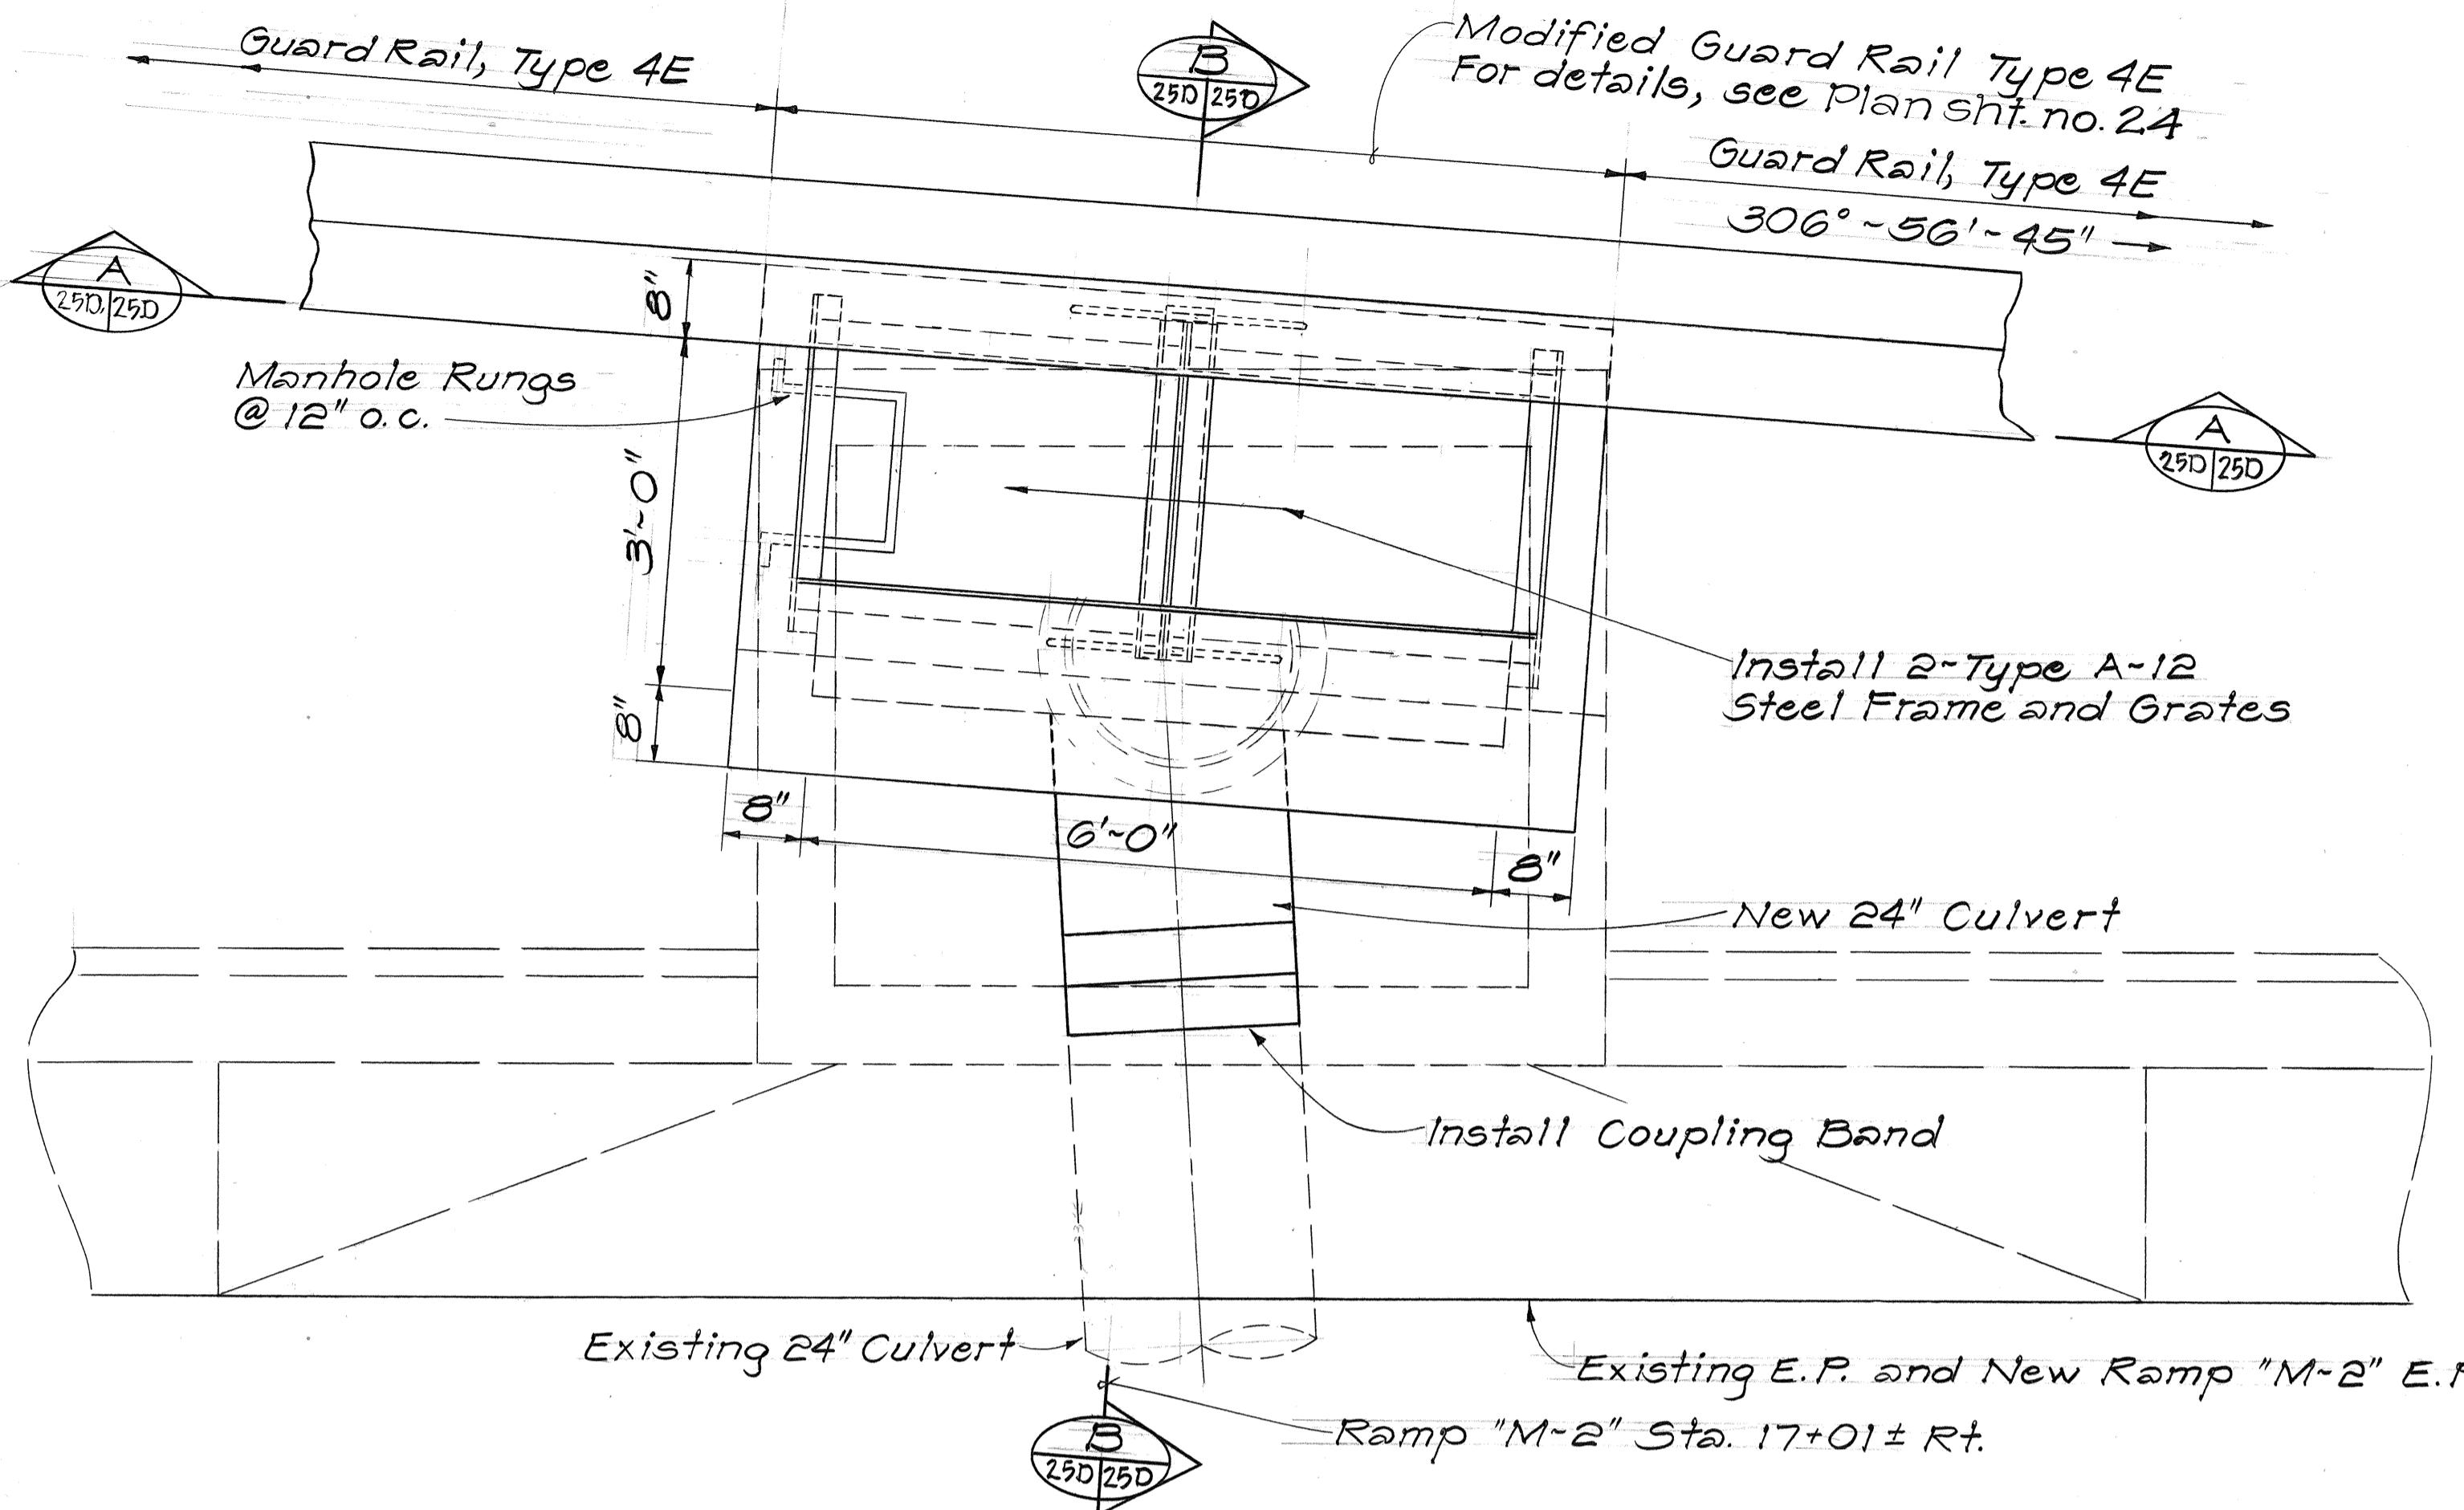


DETAILS OF TYPE 2 G.D.I. #24 AT RAMP "M-2" STA. 17+01± RT.

Scale: 3/4" = 1'-0"

STATE OF HAWAII  
DEPARTMENT OF TRANSPORTATION  
LAND TRANSPORTATION FACILITIES DIVISION  
**DRAINAGE DETAILS**  
INTERSTATE ROUTE H-1 IMPROVEMENTS  
MIDDLE STREET TO KALIHI INTERCHANGE  
WESTBOUND LANES  
F.A.I. PROJ. NO. I-HI-1(187)  
SCALE: 3/4" = 1'-0"  
DATE: JUNE 1983  
SHEET NO. 25D OF 30 SHEETS



| FED. ROAD DIST. NO. | STATE | FED. AID PROJ. NO. | FISCAL YEAR | SHEET NO. | TOTAL SHEETS |
|---------------------|-------|--------------------|-------------|-----------|--------------|
| HAWAII              | HAW.  | I-HI-1(187)        | 1984        | 74        | 197          |

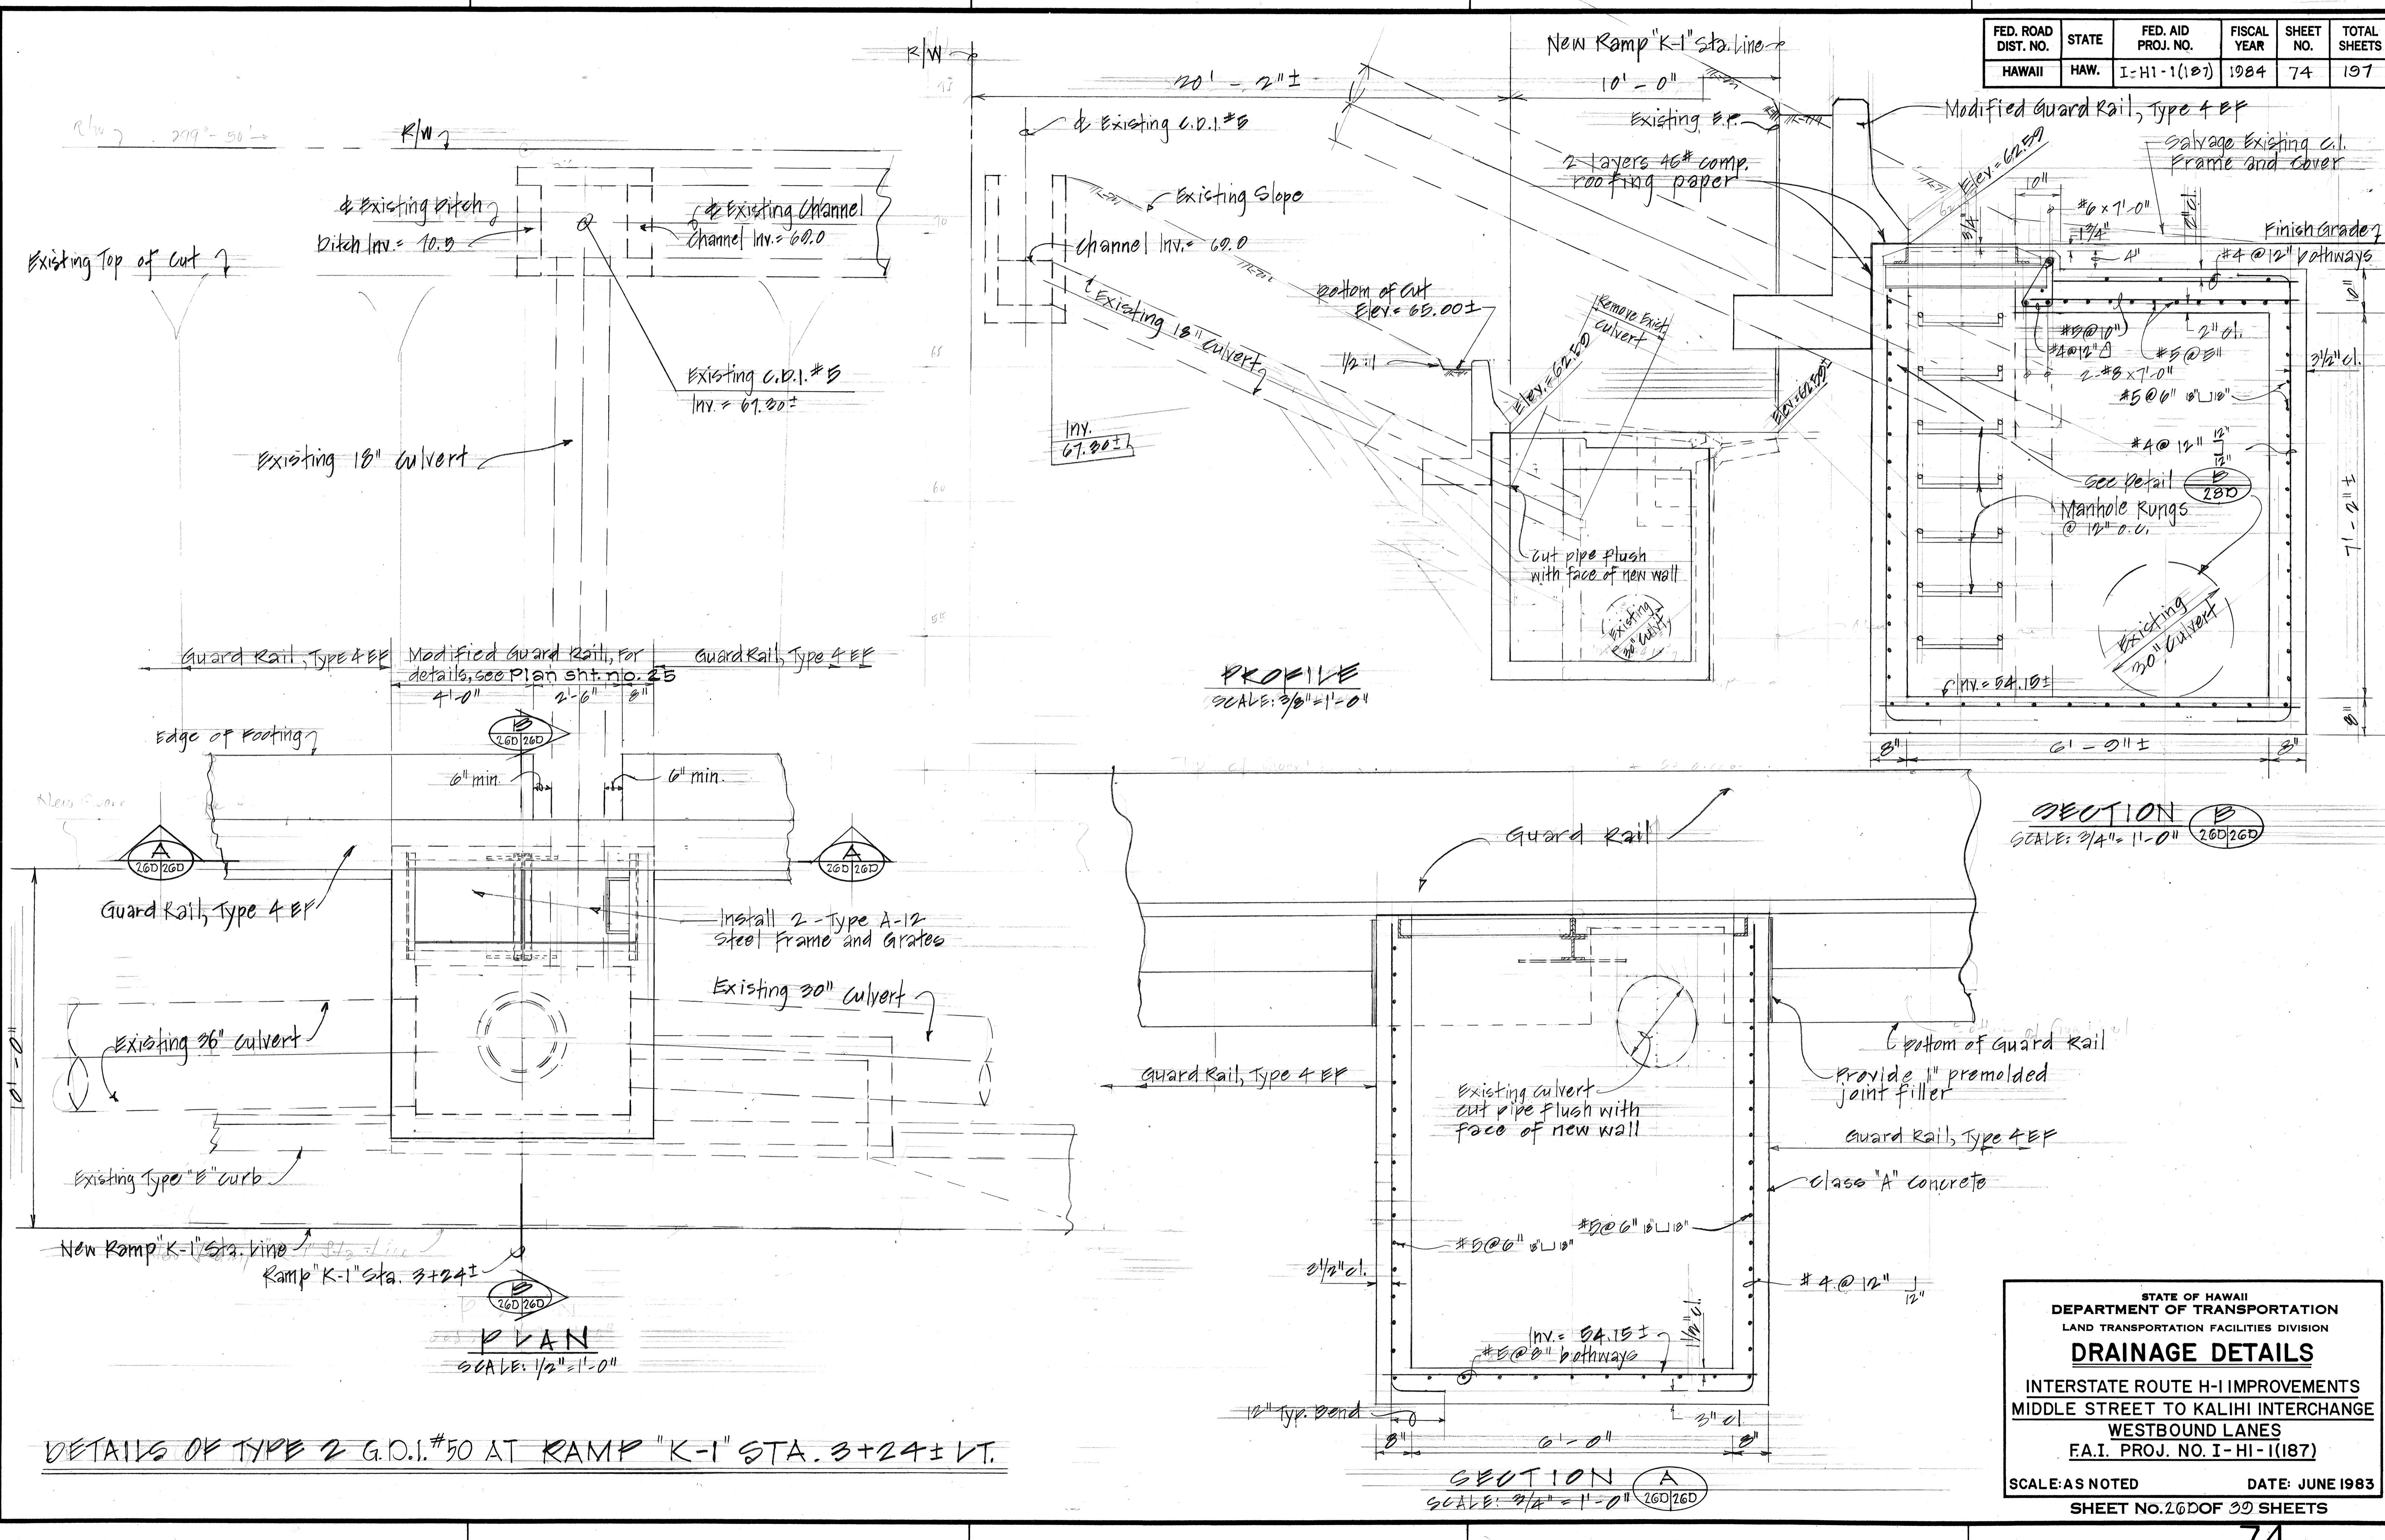


|               |                   |
|---------------|-------------------|
| ORIGINAL      | SUPPLY PLOTTED BY |
| PLANS         | DRAWN BY          |
| NOTE BOOK     | TECHNICAL         |
| QUANTITIES BY | DESIGNED BY       |
| NO.           | CHECkED BY        |

6-6-3

| FED. ROAD DIST. NO. | STATE | FED. AID PROJ. NO. | FISCAL YEAR | SHEET NO. | TOTAL SHEETS |
|---------------------|-------|--------------------|-------------|-----------|--------------|
| HAWAII              | HAW.  | I-HI-1(187)        | 1984        | 75        | 197          |

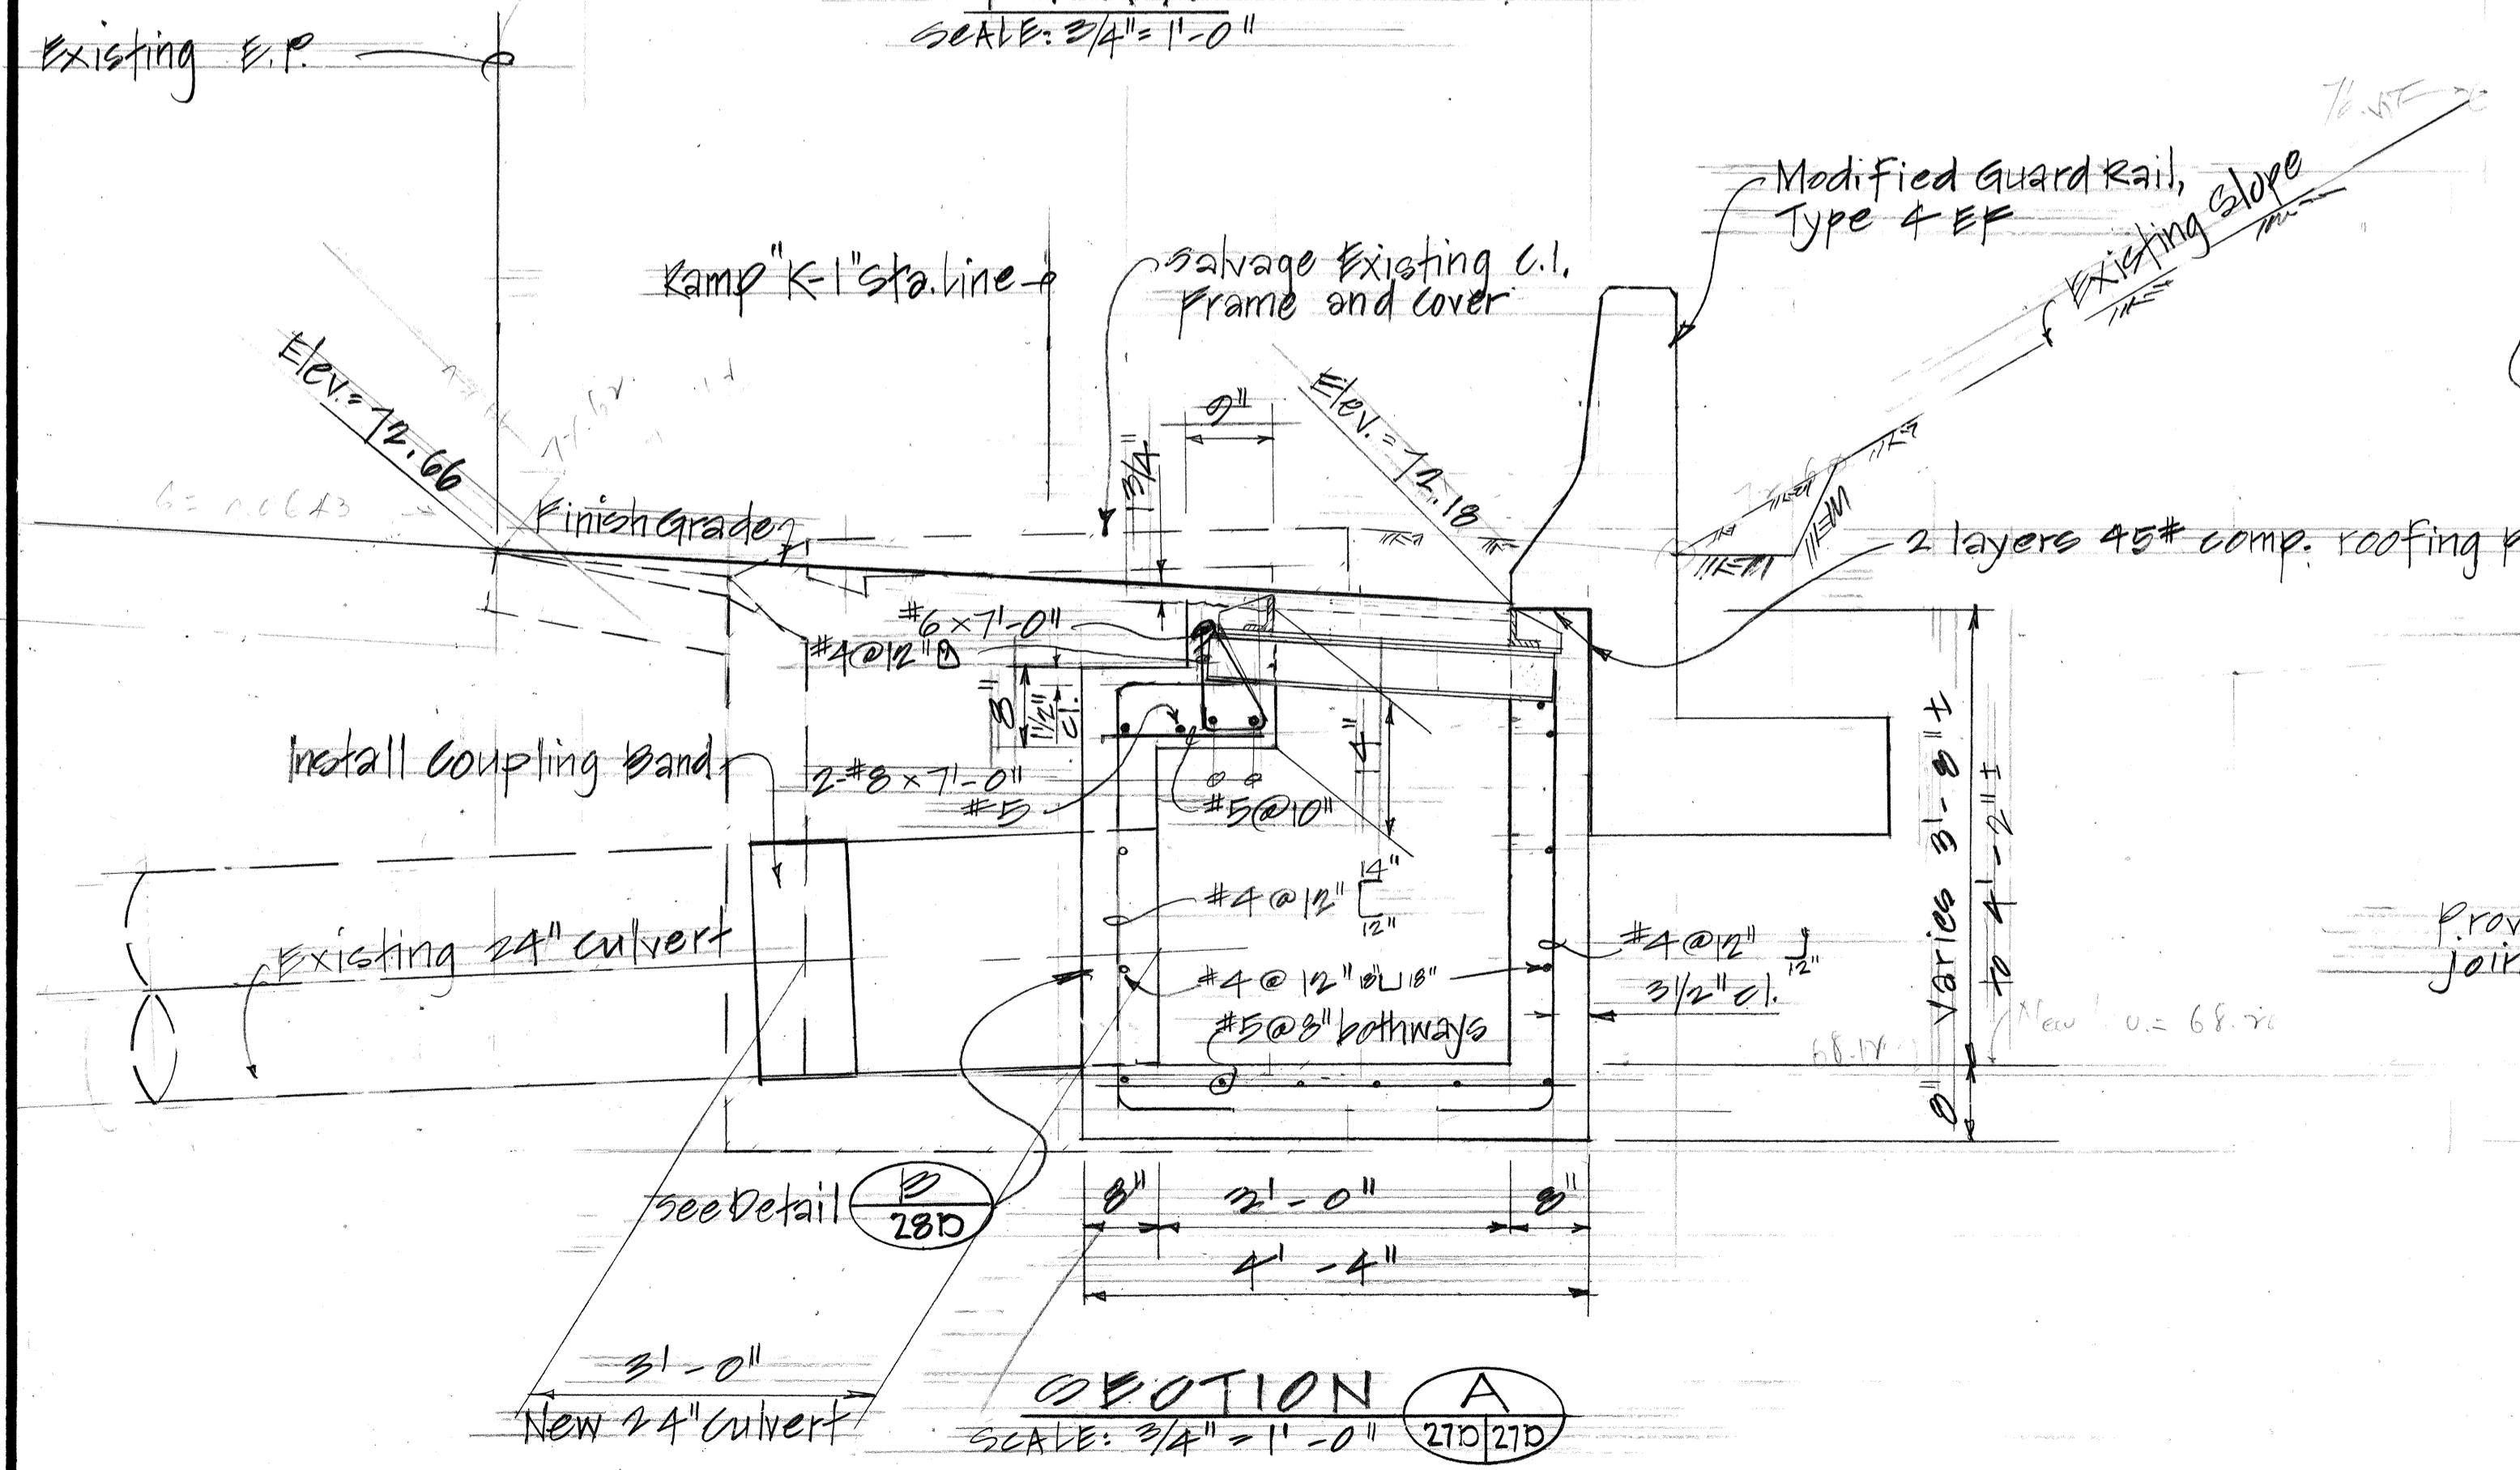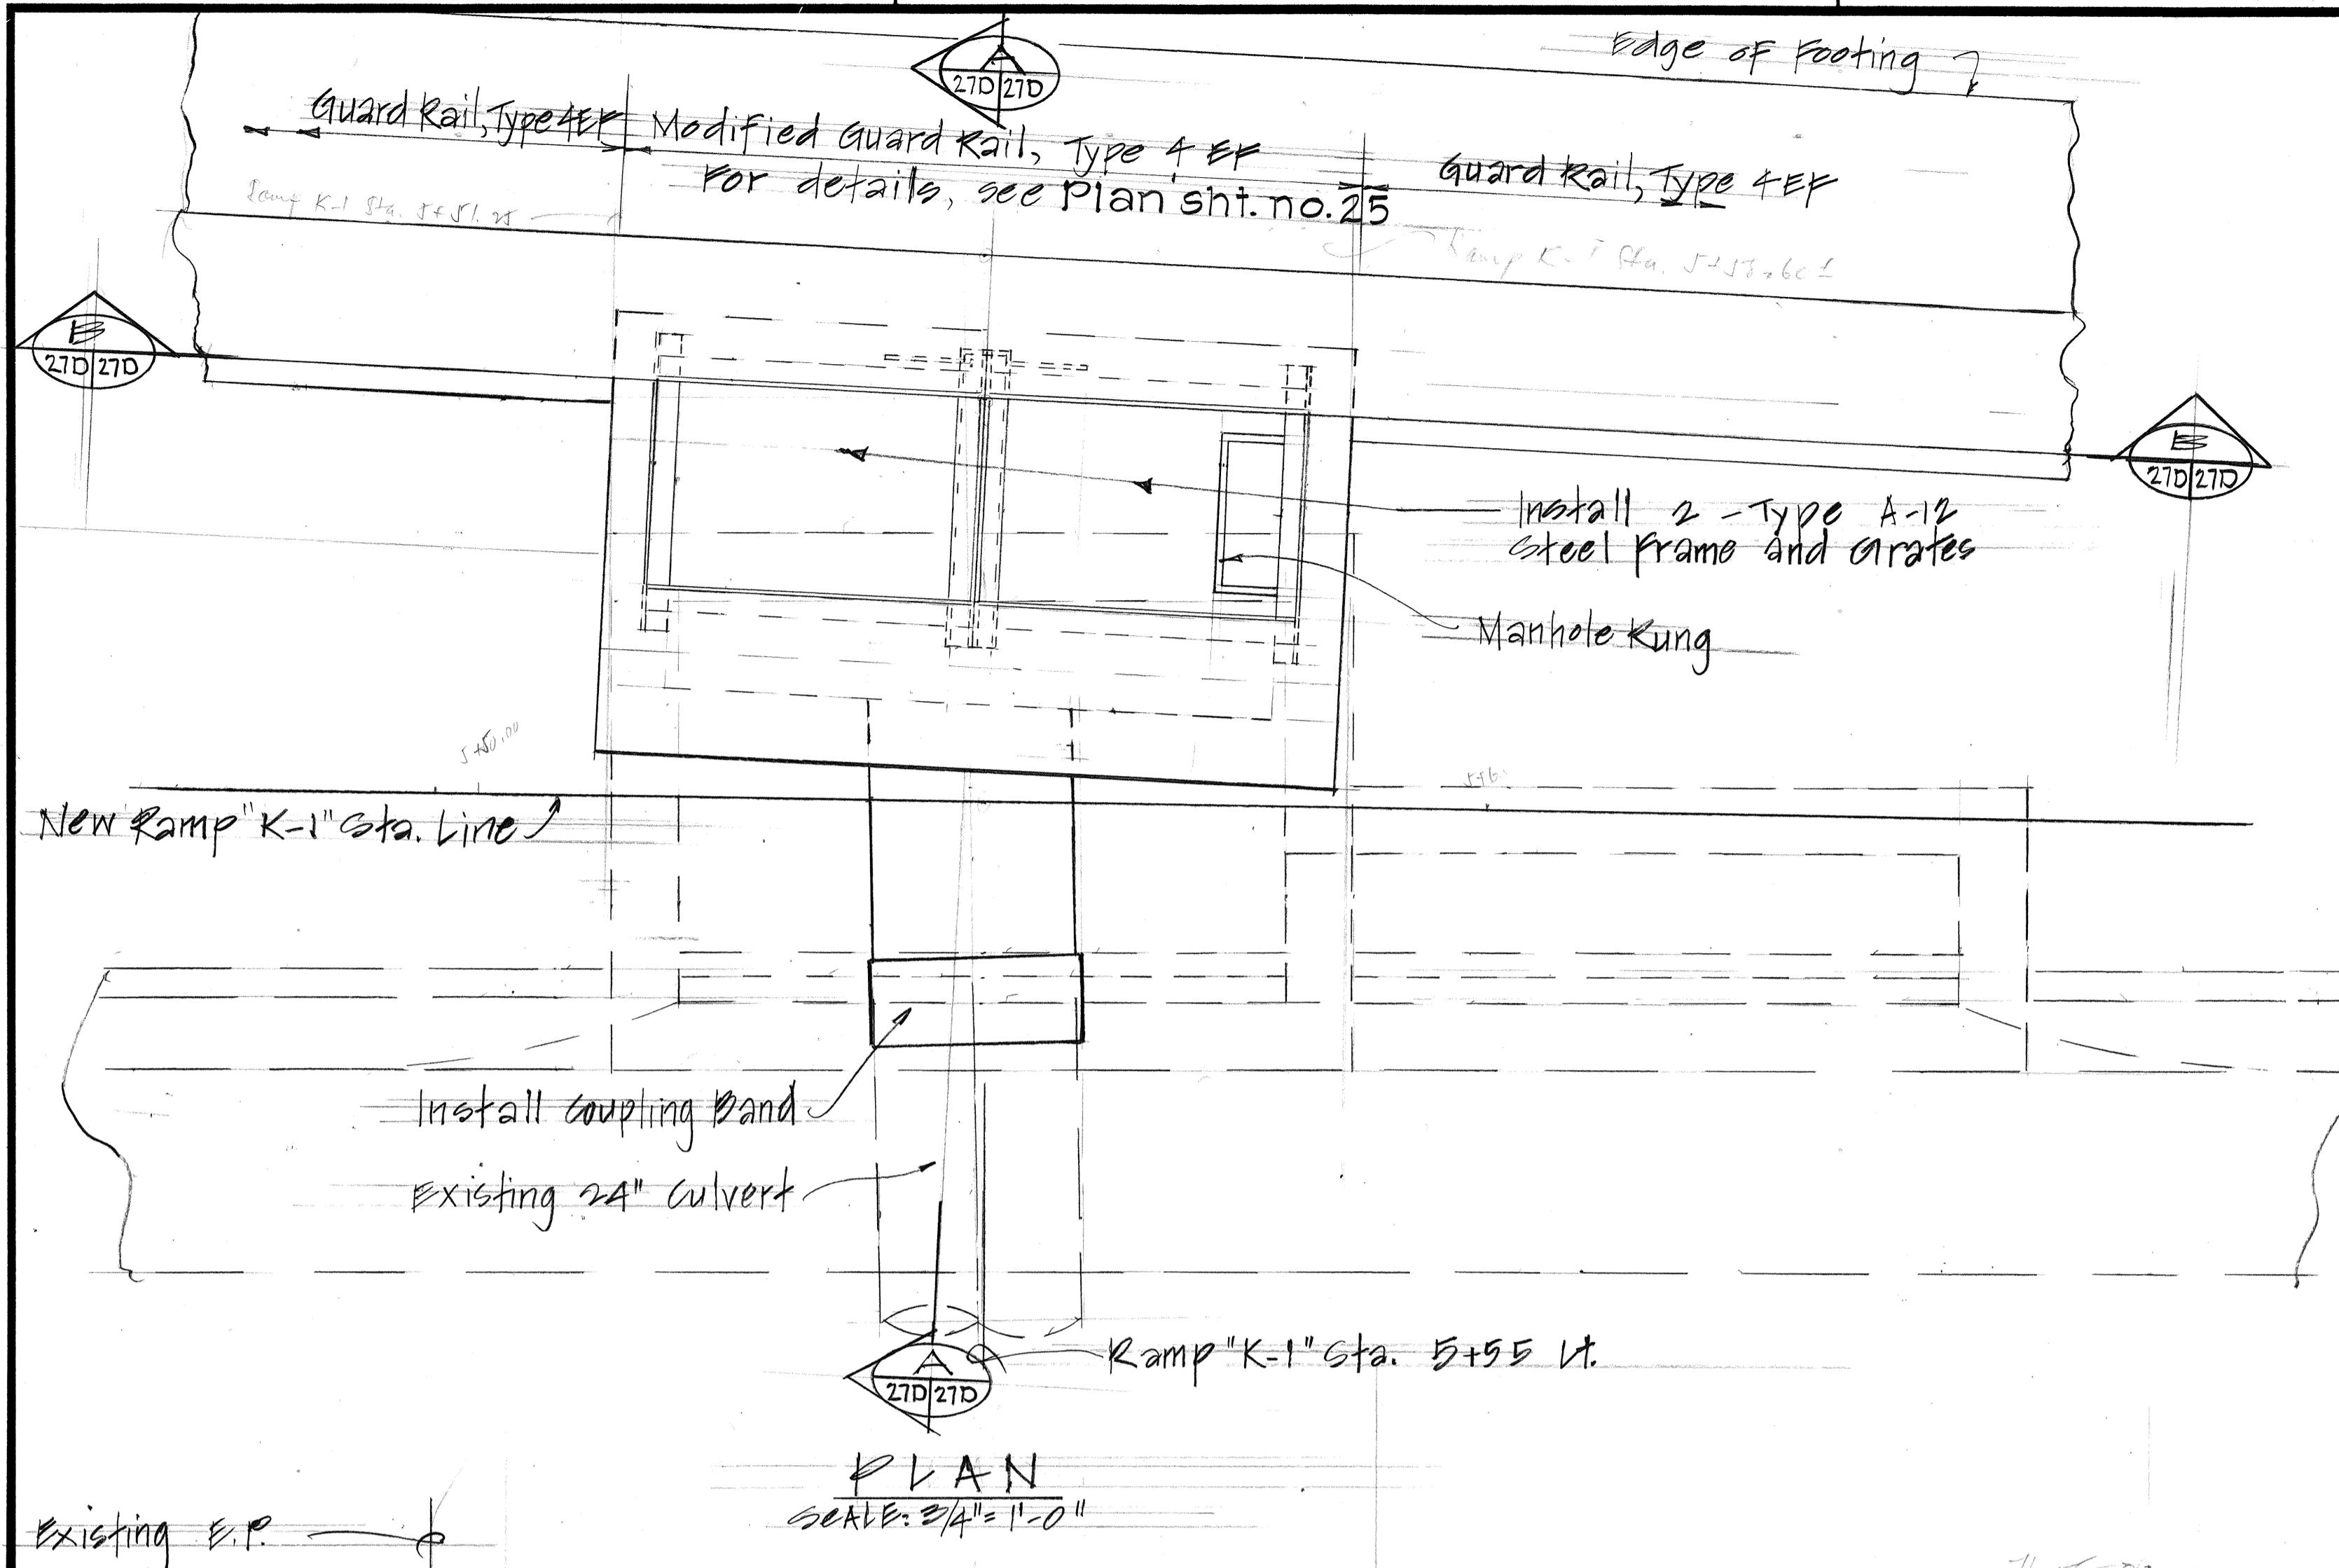


DETAILS OF TYPE 2 G.D.I. #51 AT RAMP "K-1" STA. 5+55 LT.

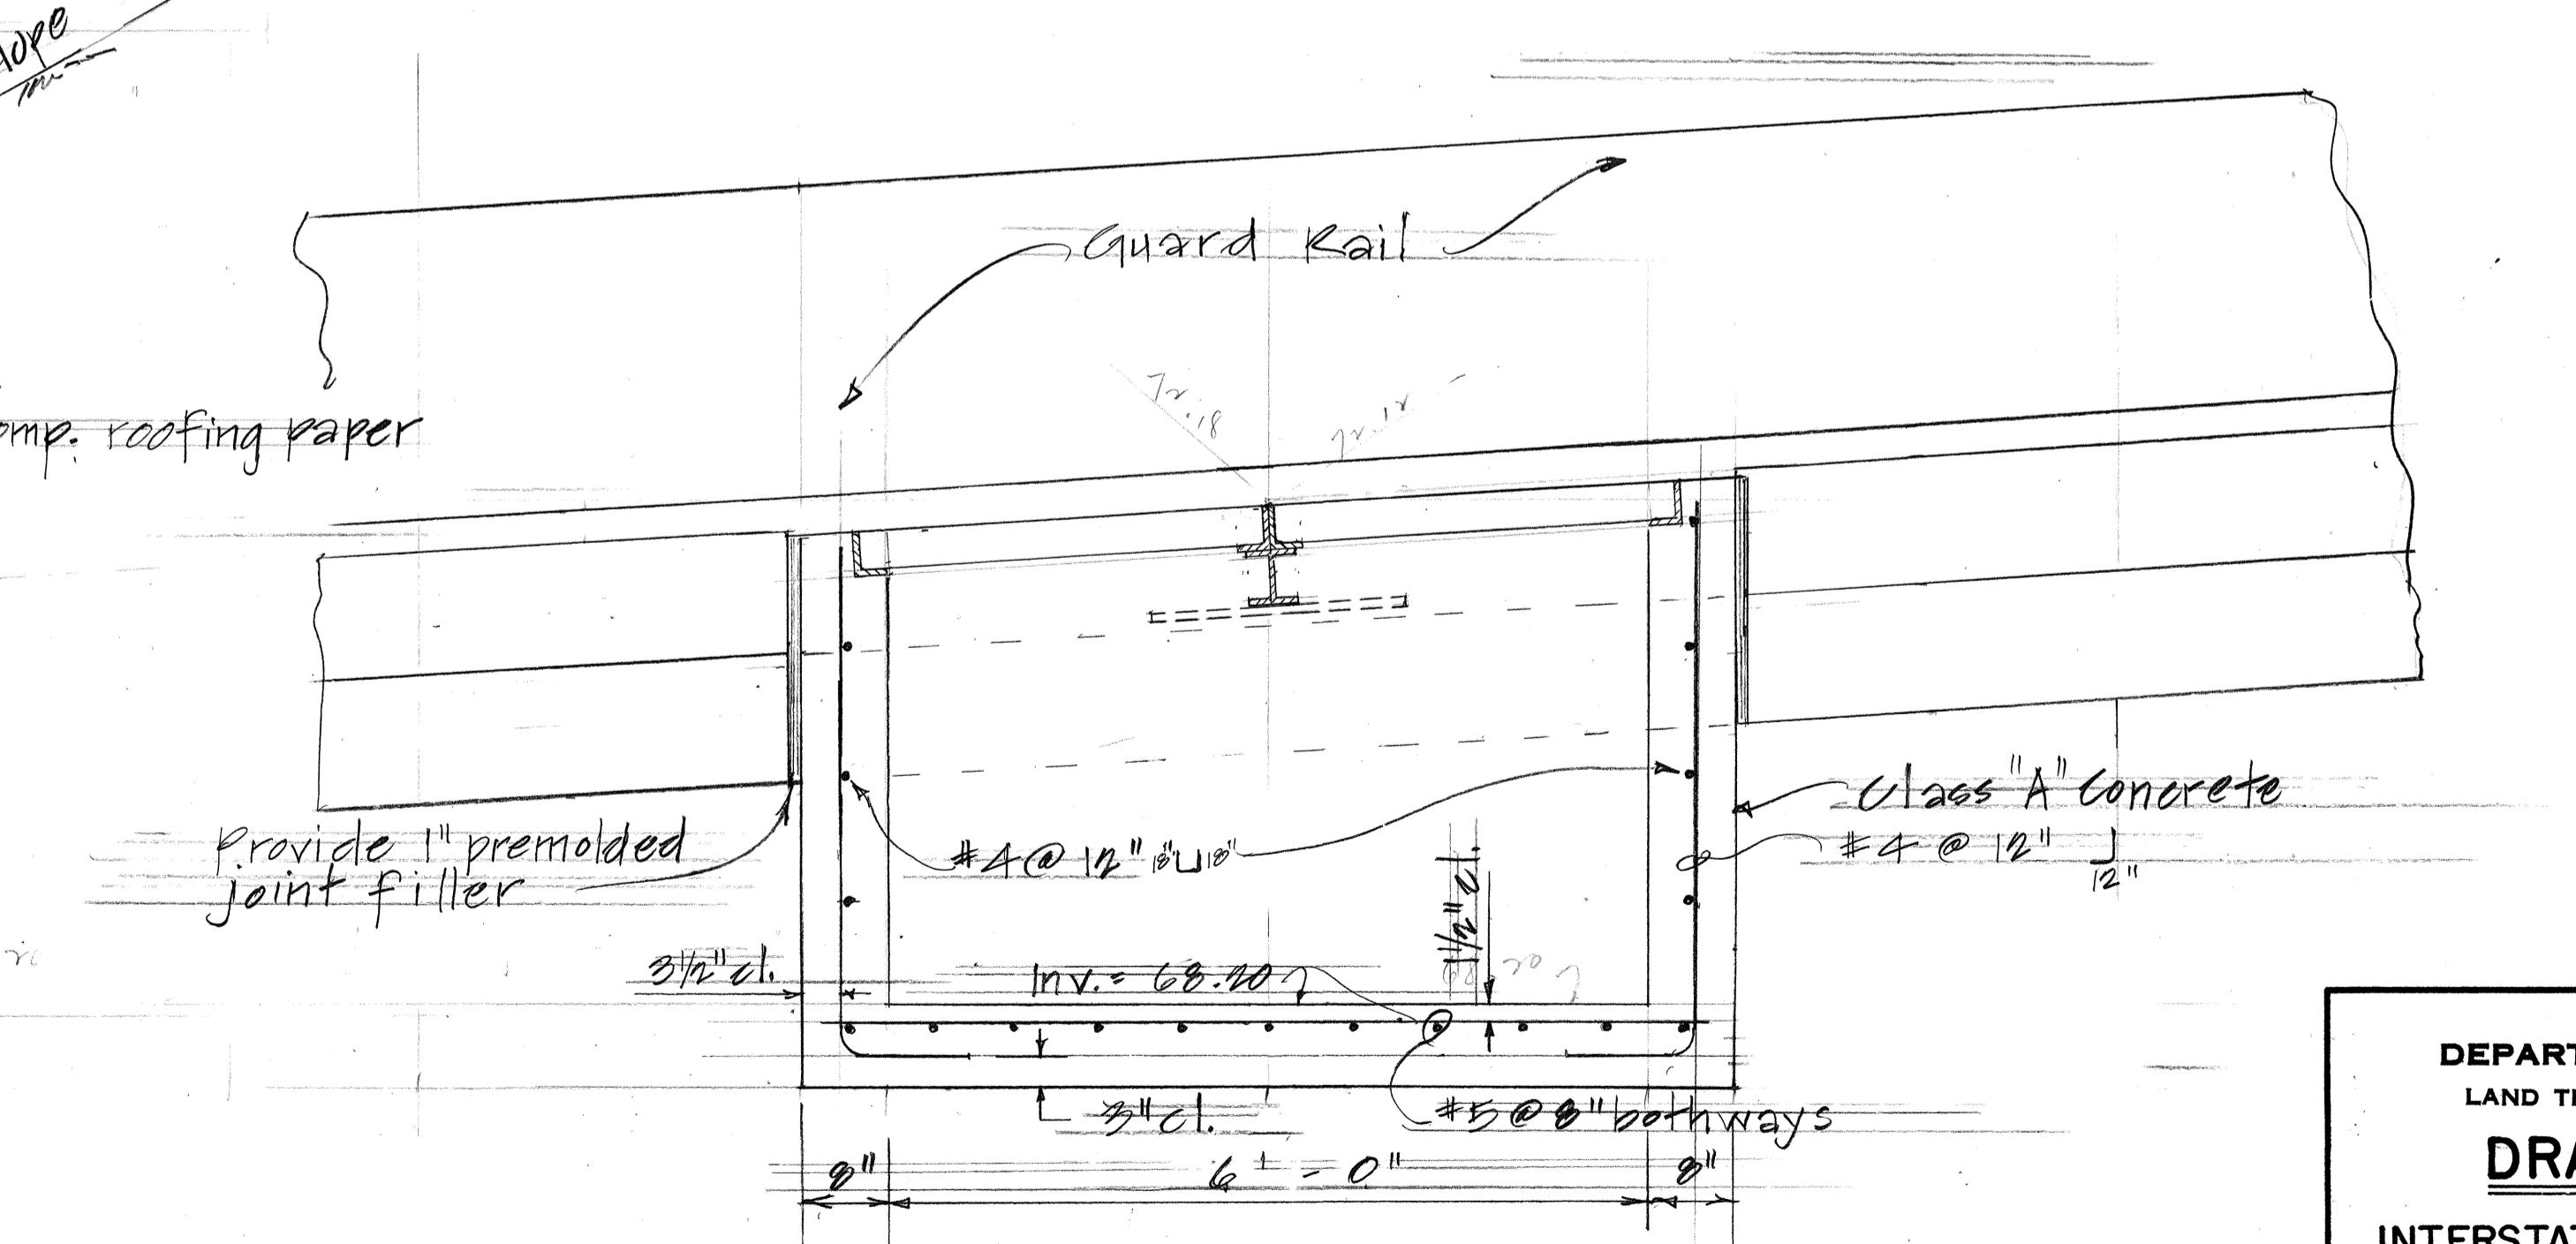

SECTION 28D  
SCALE: 3/4" = 1'-0" 27D 27D

STATE OF HAWAII  
DEPARTMENT OF TRANSPORTATION  
LAND TRANSPORTATION FACILITIES DIVISION  
**DRAINAGE DETAILS**  
INTERSTATE ROUTE H-1 IMPROVEMENTS  
MIDDLE STREET TO KALIHI INTERCHANGE  
WESTBOUND LANES  
F.A.I. PROJ. NO. I-HI-1(187)  
SCALE: 3/4" = 1'-0" DATE: JUNE 1983  
SHEET NO. 27D OF 30 SHEETS

| FED. ROAD DIST. NO. | STATE | FED. AID PROJ. NO. | FISCAL YEAR | SHEET NO. | TOTAL SHEETS |
|---------------------|-------|--------------------|-------------|-----------|--------------|
| HAWAII              | HAW.  | I-HI-1(187)        | 1984        | 76        | 197          |

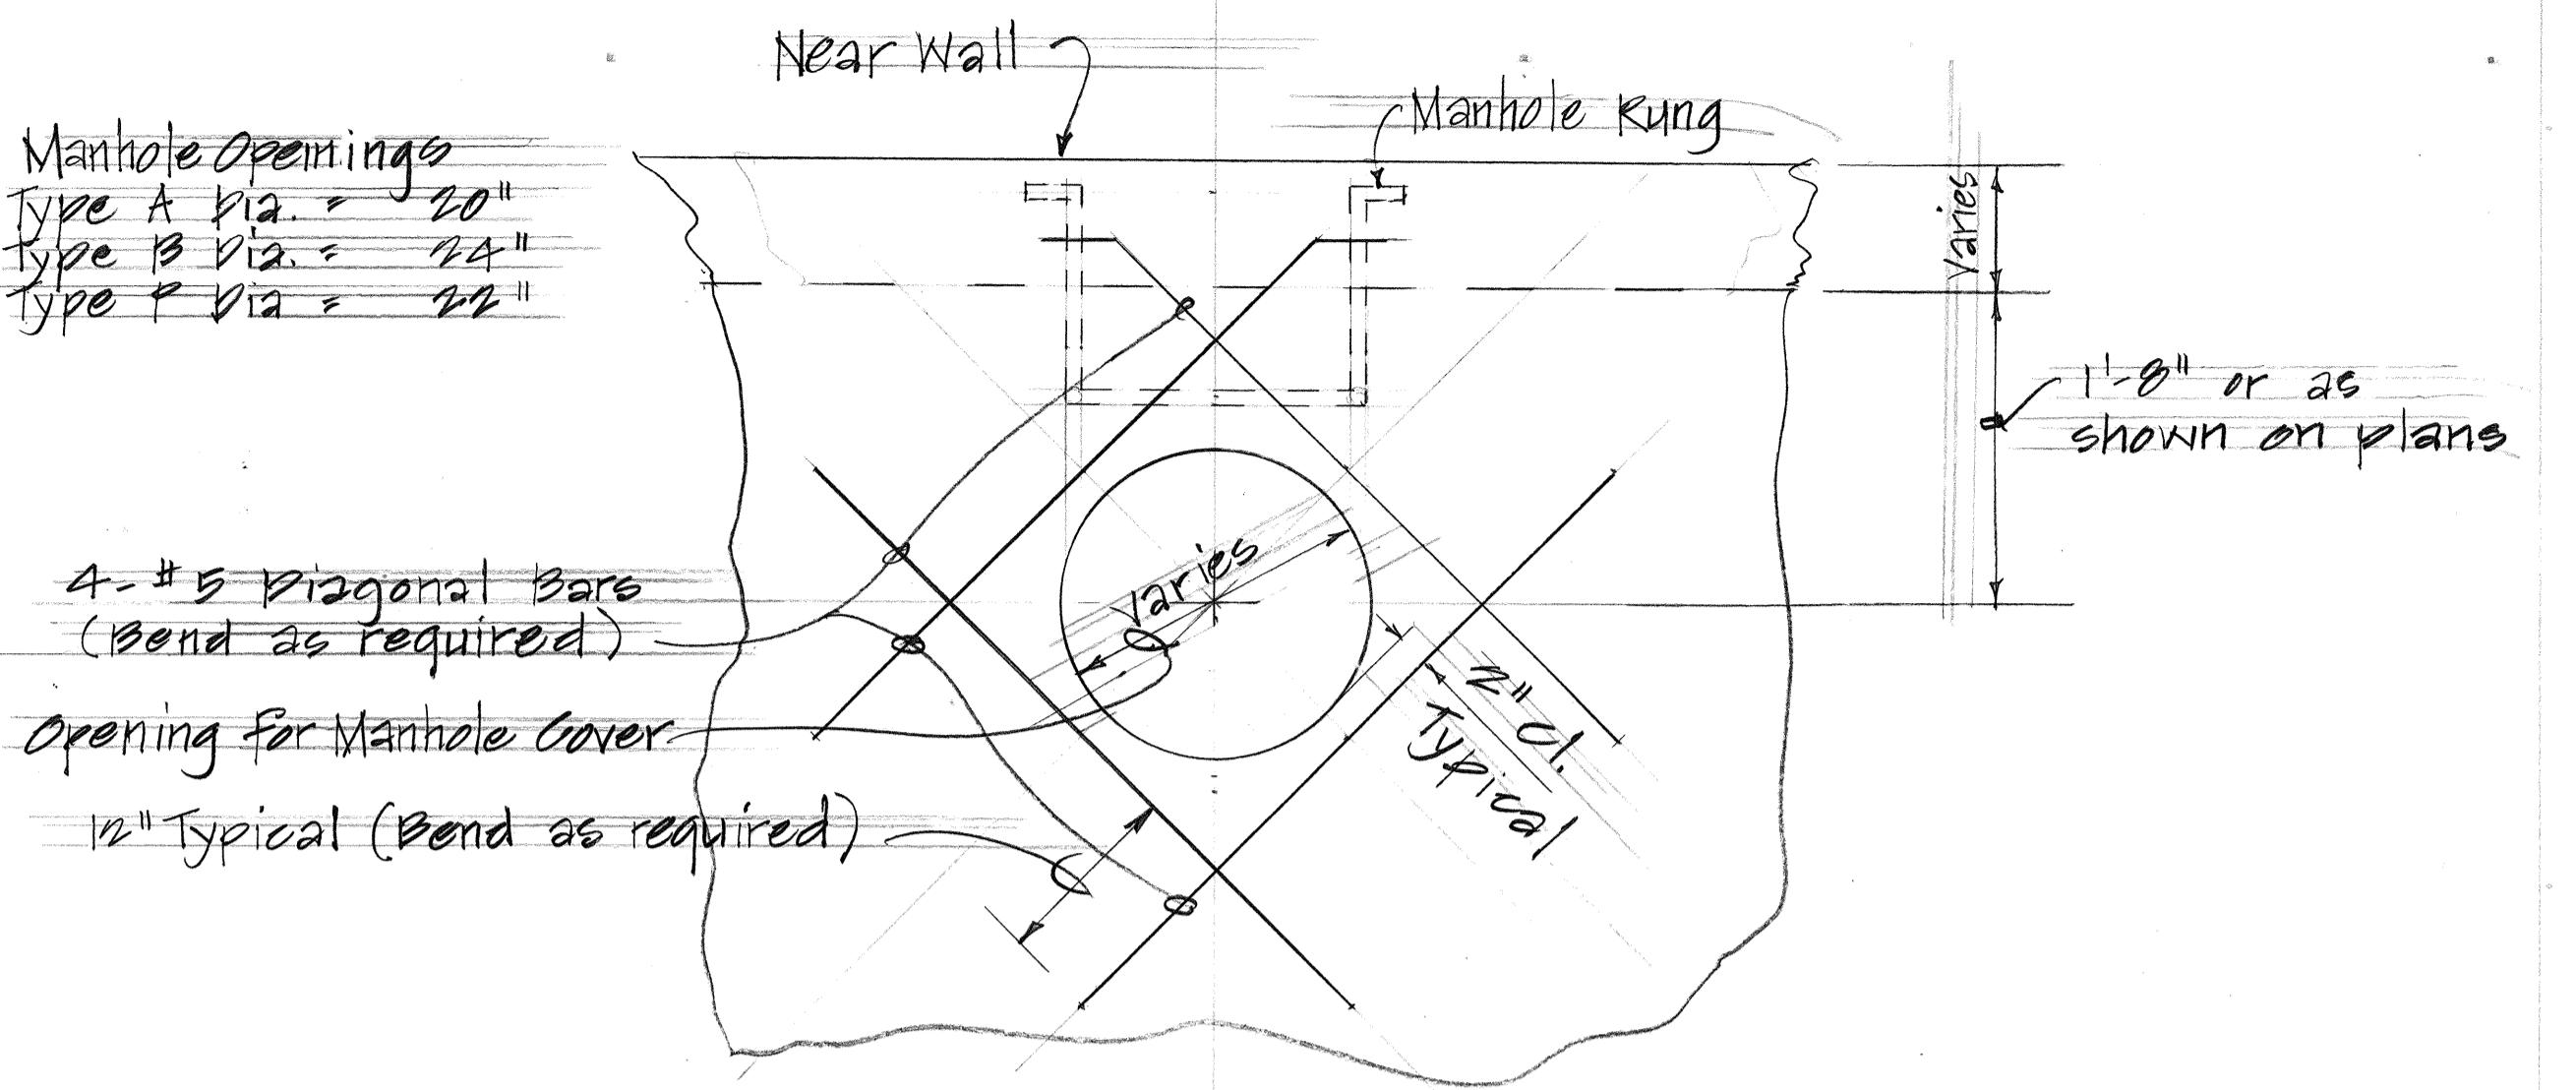


### ADDED REINFORCING

#### FOR MANHOLE OPENINGS

SCALE: 1" = 1'-0"

A 180

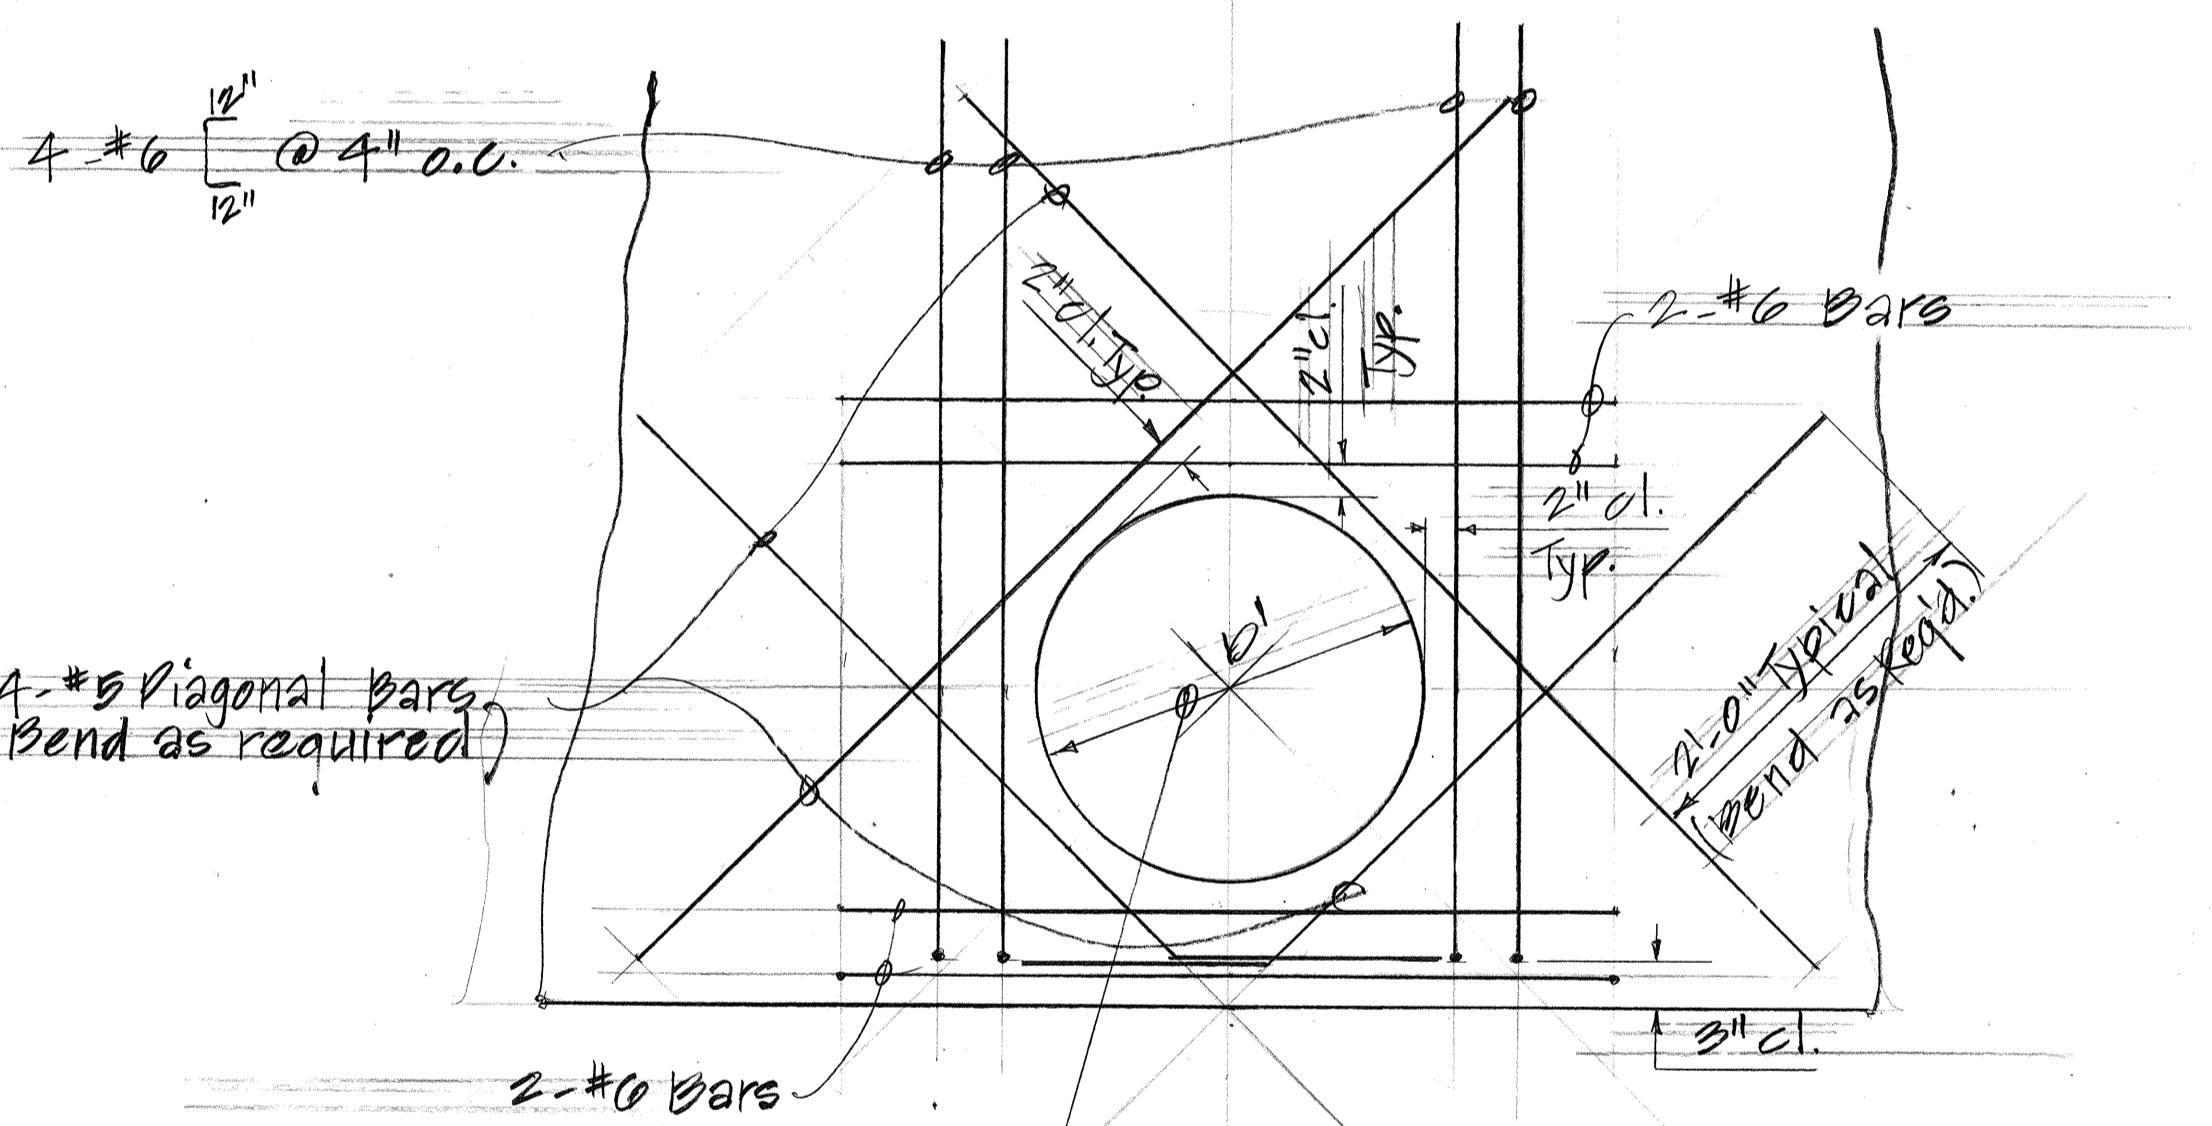

### ADDED REINFORCING

#### FOR CULVERT OPENINGS


SCALE: 1" = 1'-0"

B 180




|               |                   |
|---------------|-------------------|
| ORIGINAL PLAN | SURVEY PLOTTED BY |
| NOTE BOOK     | DRAWN BY          |
| No.           | TRACED BY         |
|               | DESIGNED BY       |
|               | QUANTITIES BY     |
|               | CHECKED BY        |

STATE OF HAWAII  
DEPARTMENT OF TRANSPORTATION  
LAND TRANSPORTATION FACILITIES DIVISION  
**DRAINAGE DETAILS**  
INTERSTATE ROUTE H-I IMPROVEMENTS  
MIDDLE STREET TO KALIHI INTERCHANGE  
WESTBOUND LANES  
F.A.I. PROJ. NO. I-HI-1(187)  
SCALE: 1" = 1'-0" DATE: JUNE 1983  
SHEET NO. 180 OF 30 SHEETS

| FED. ROAD<br>DIST. NO. | STATE | FED. AID<br>PROJ. NO. | FISCAL<br>YEAR | SHEET<br>NO. | TOTAL<br>SHEETS |
|------------------------|-------|-----------------------|----------------|--------------|-----------------|
| HAWAII                 | HAW.  | I-HI-1(187)           | 1984           | 77           | 197             |



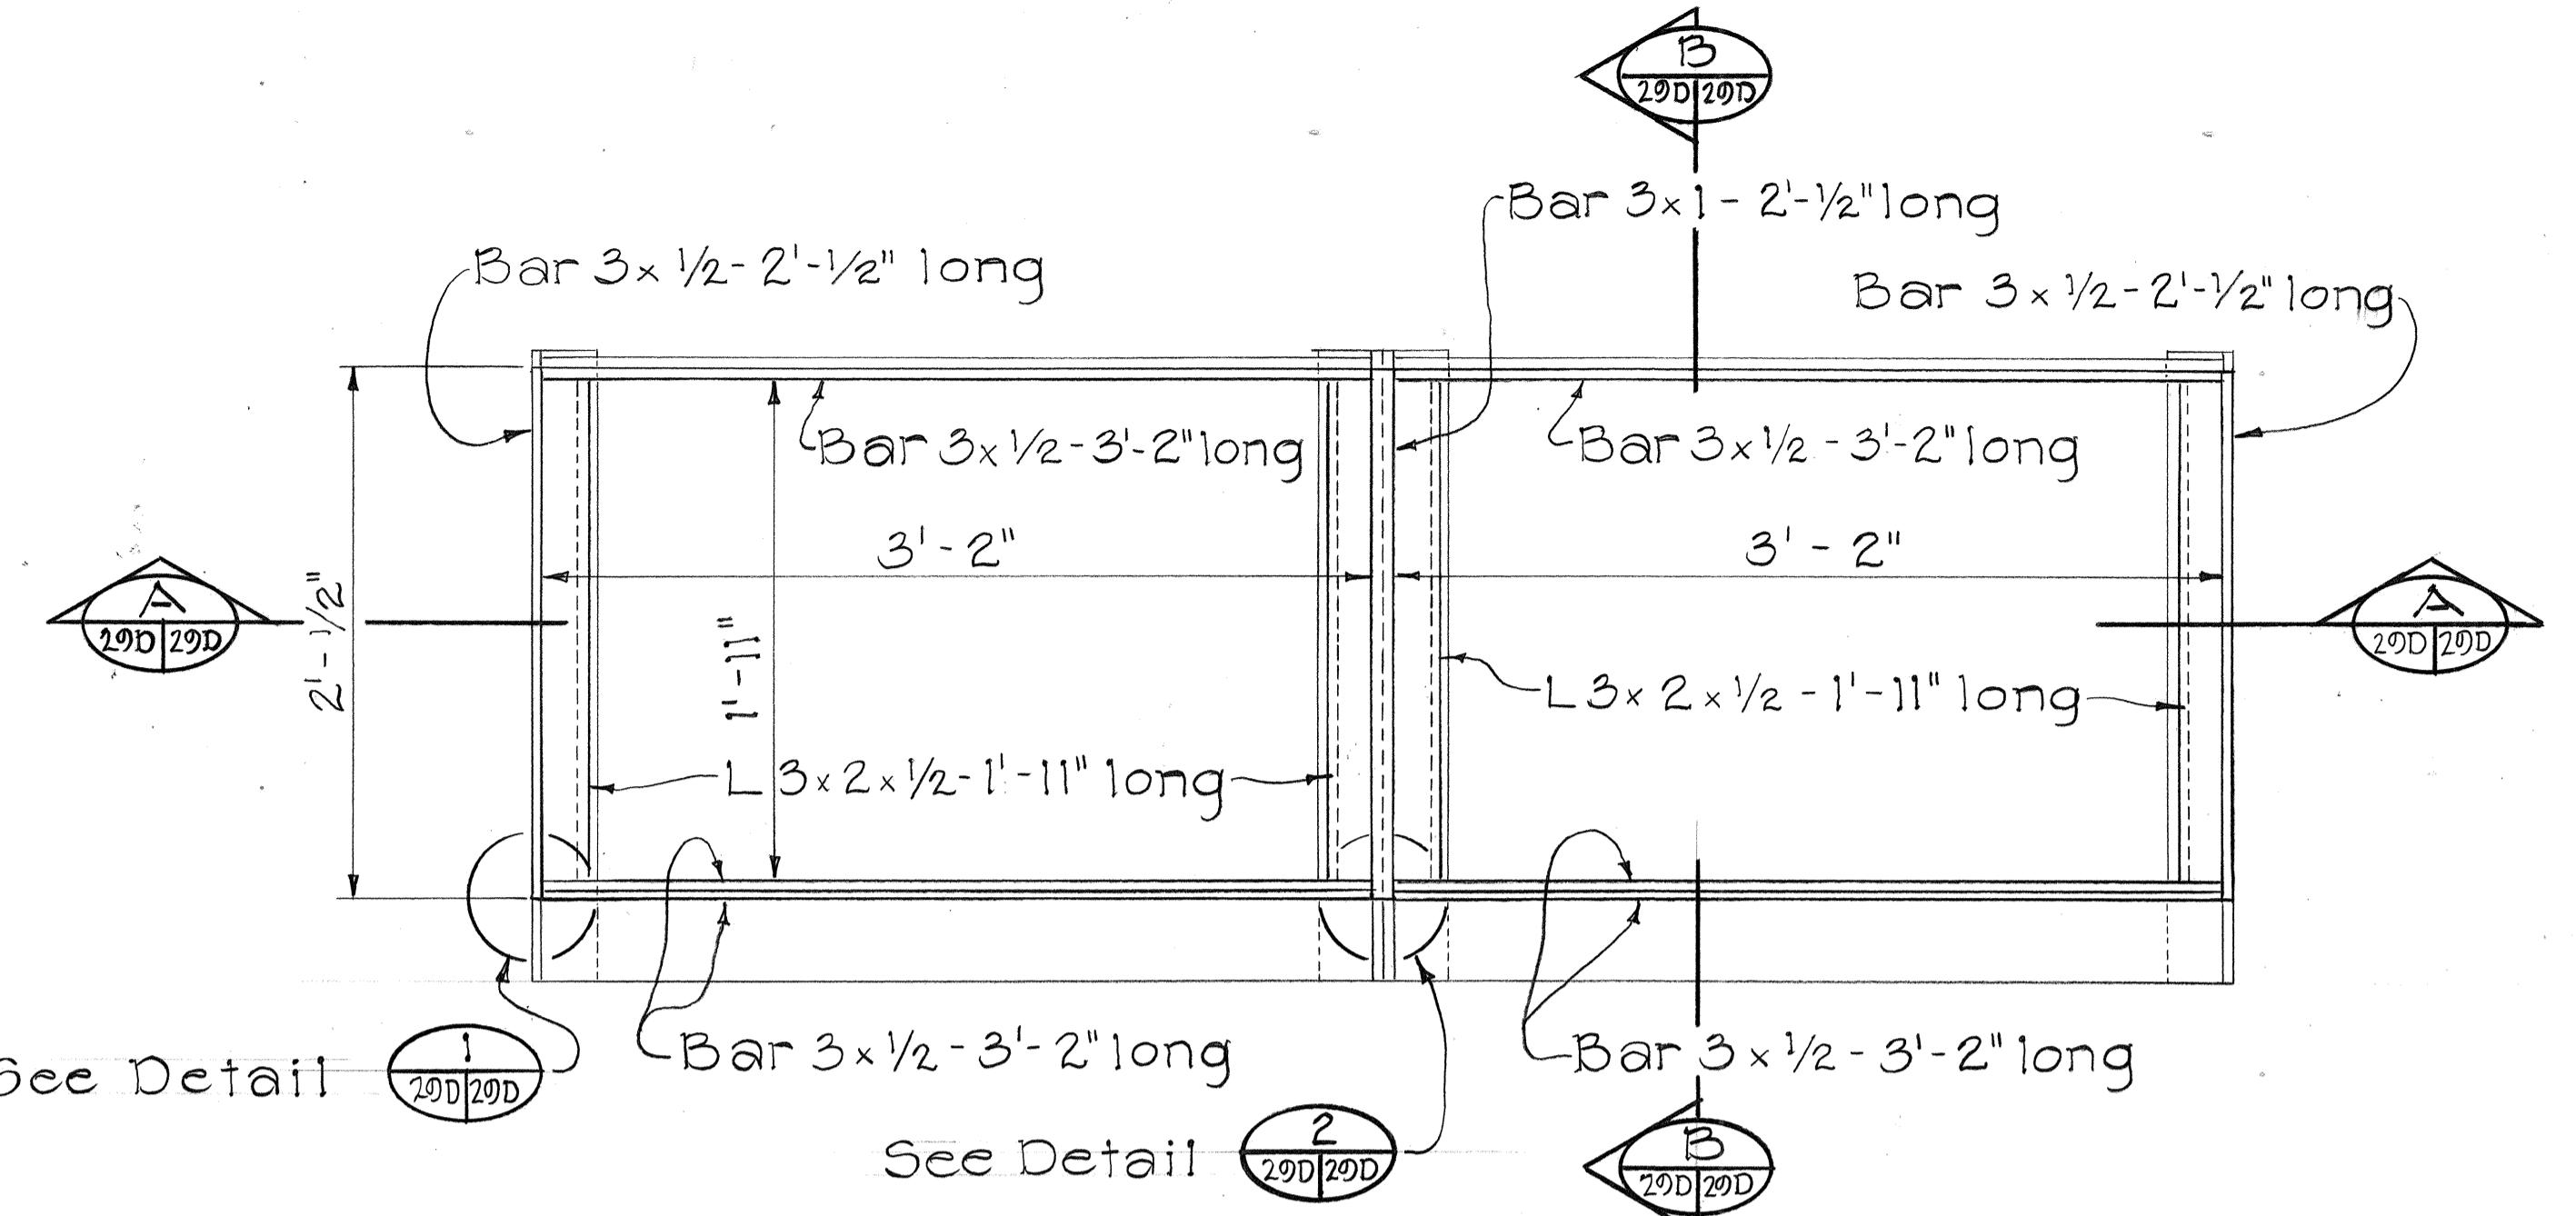


PLAN

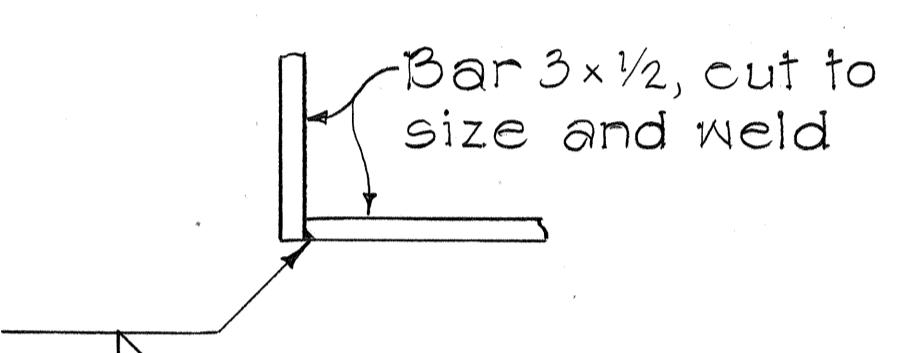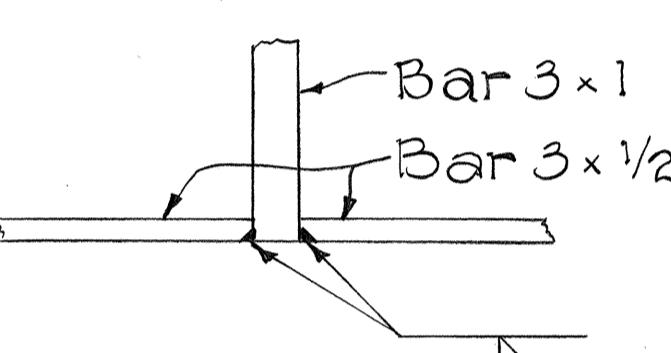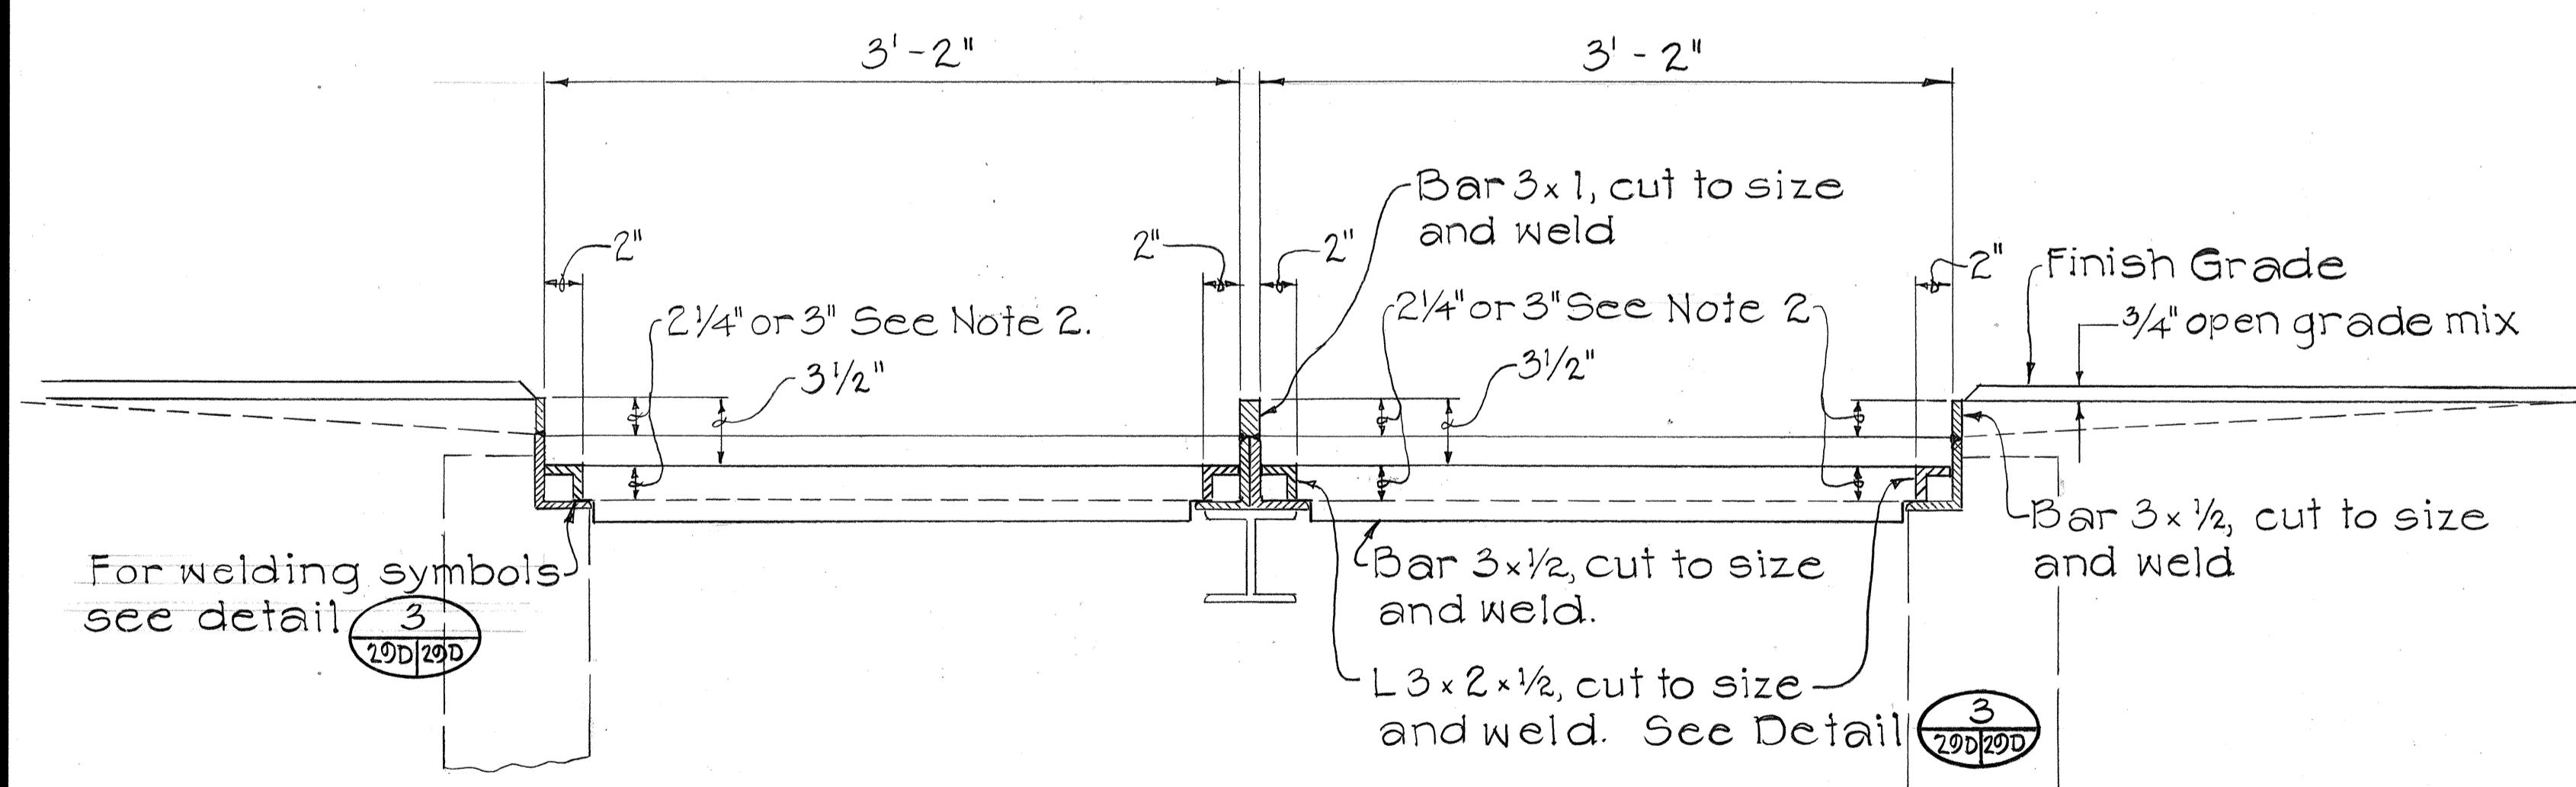DETAIL 1  
Scale: 3" = 1'-0" 20D 20DDETAIL 2  
Scale: 3" = 1'-0" 20D 20DSECTION A  
20D 20D



## NOTES:

1. All fillet welds,  $5/16"$
2. Height of adjustment varies. For structures located between Middle St. and Kalihi Stream adjustment shall be  $2\frac{1}{4}"$ . For structures located between Kalihi Stream and Kalihi Interchange adjustment shall be  $3"$ .

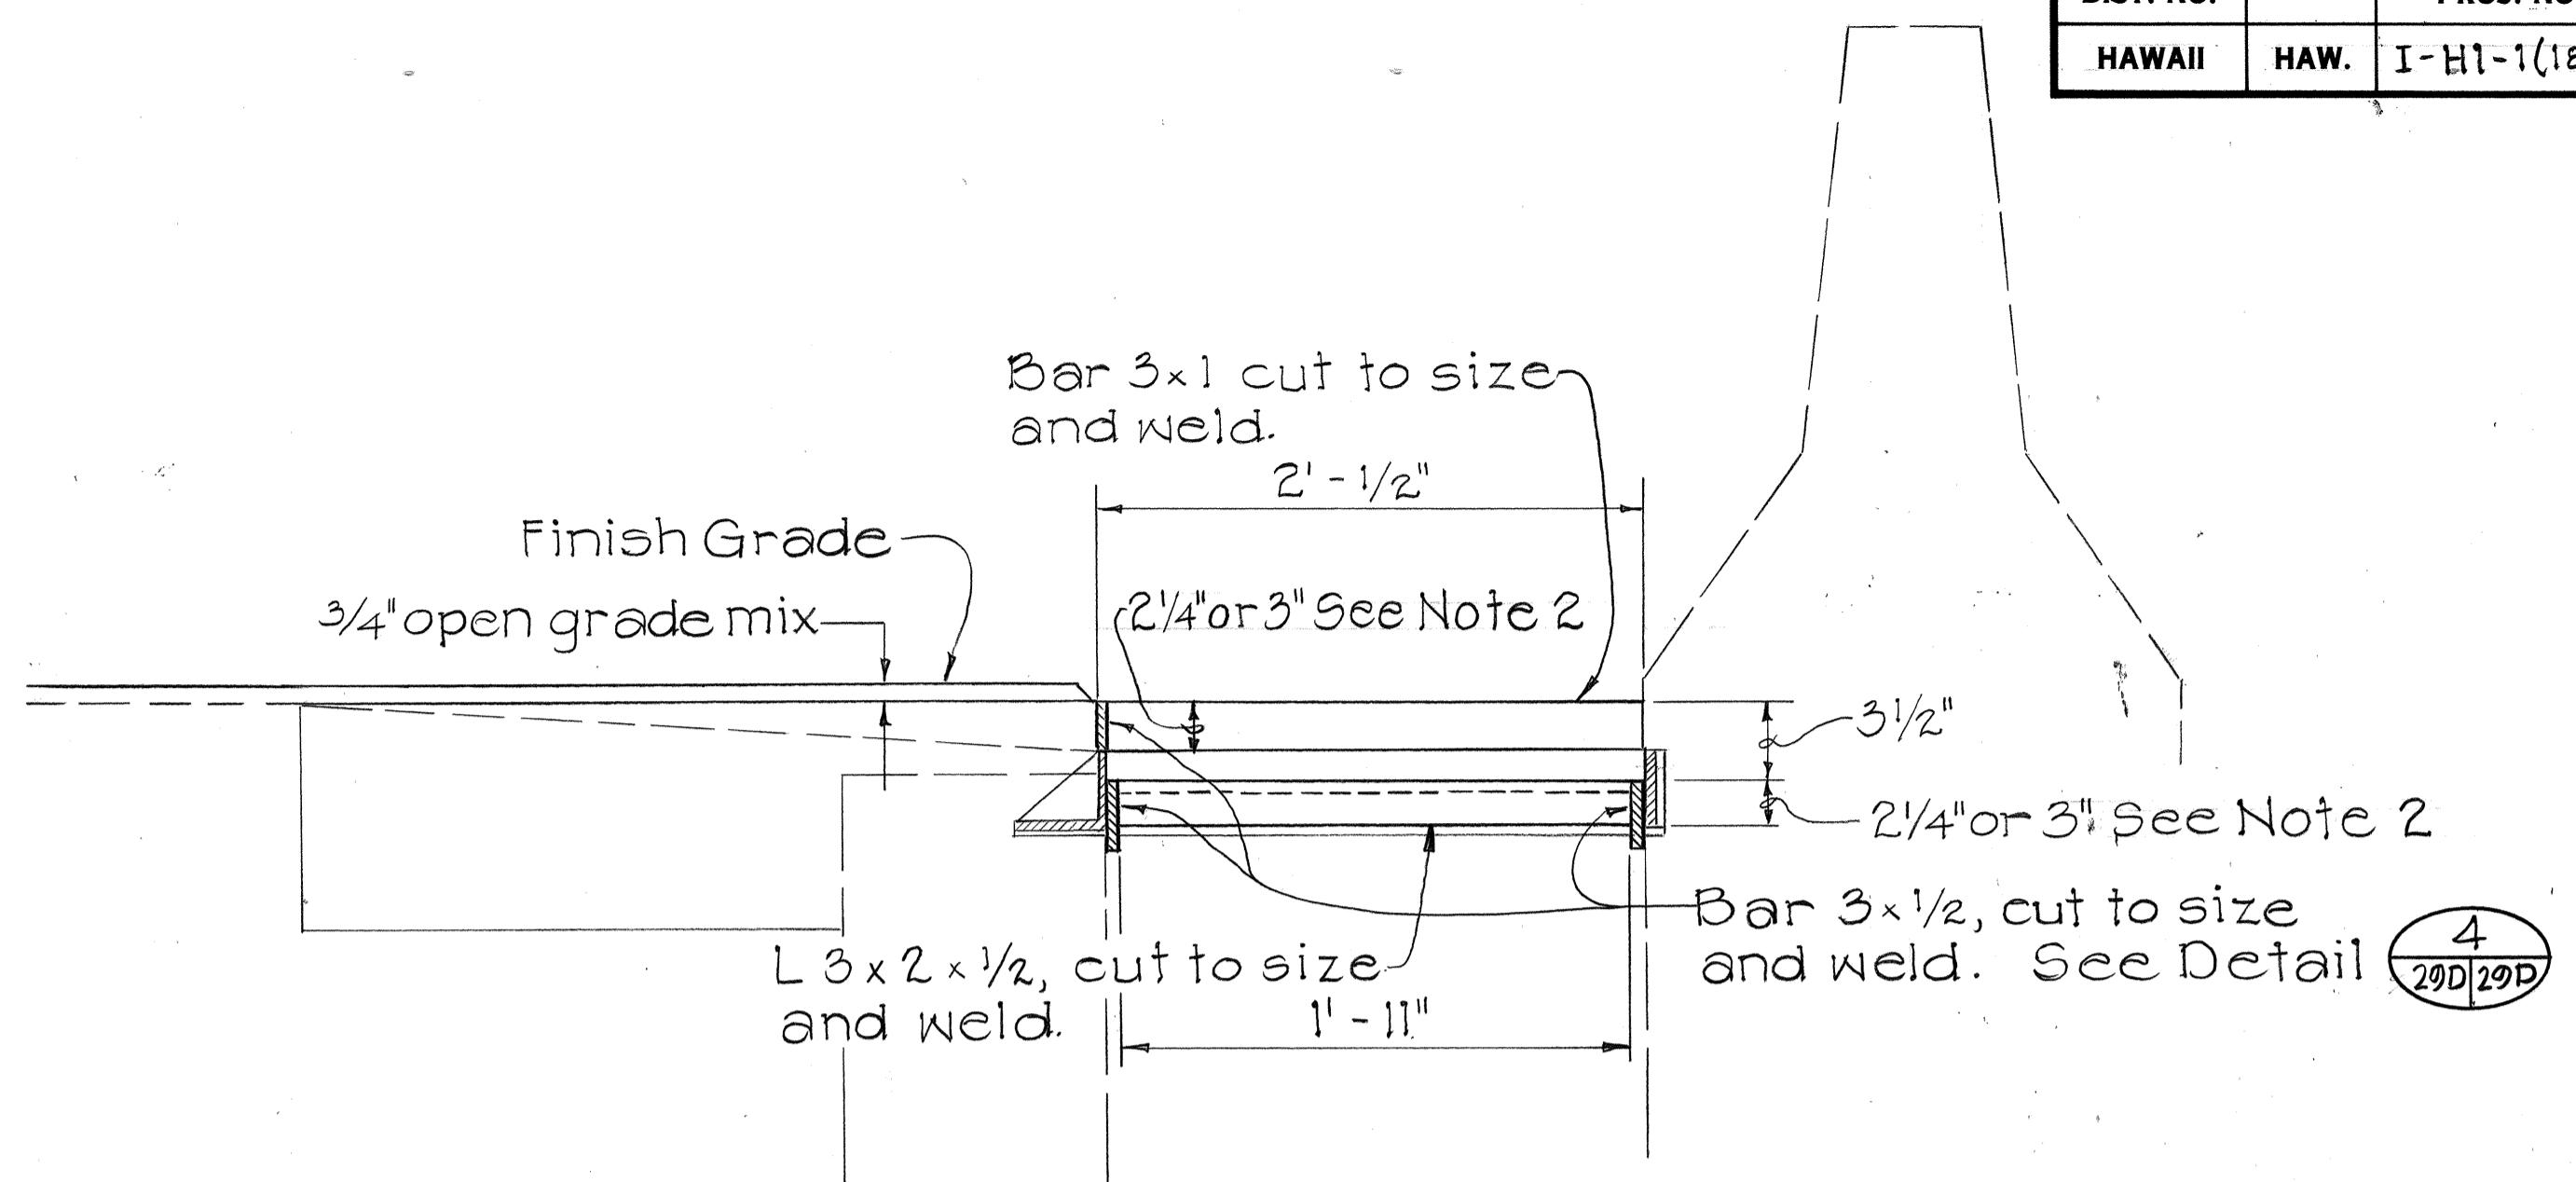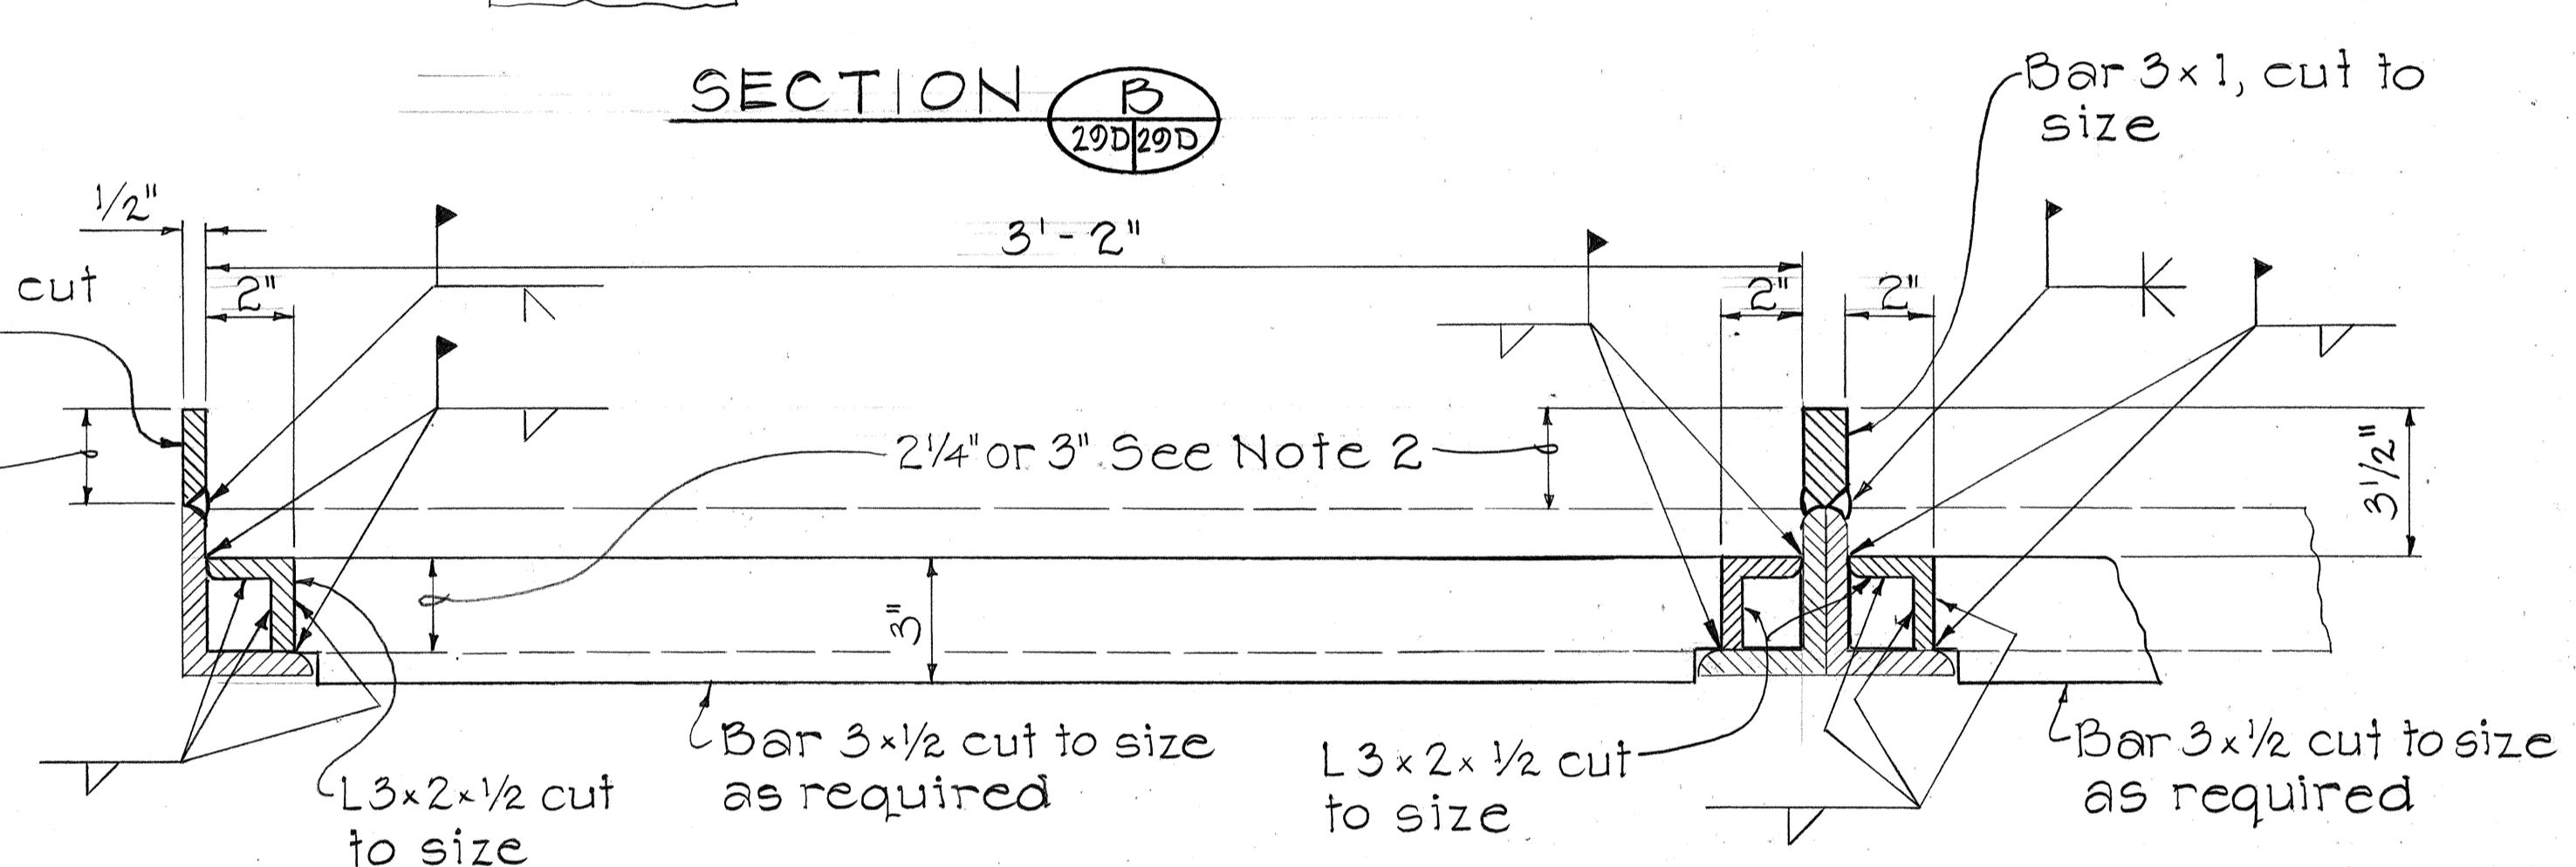
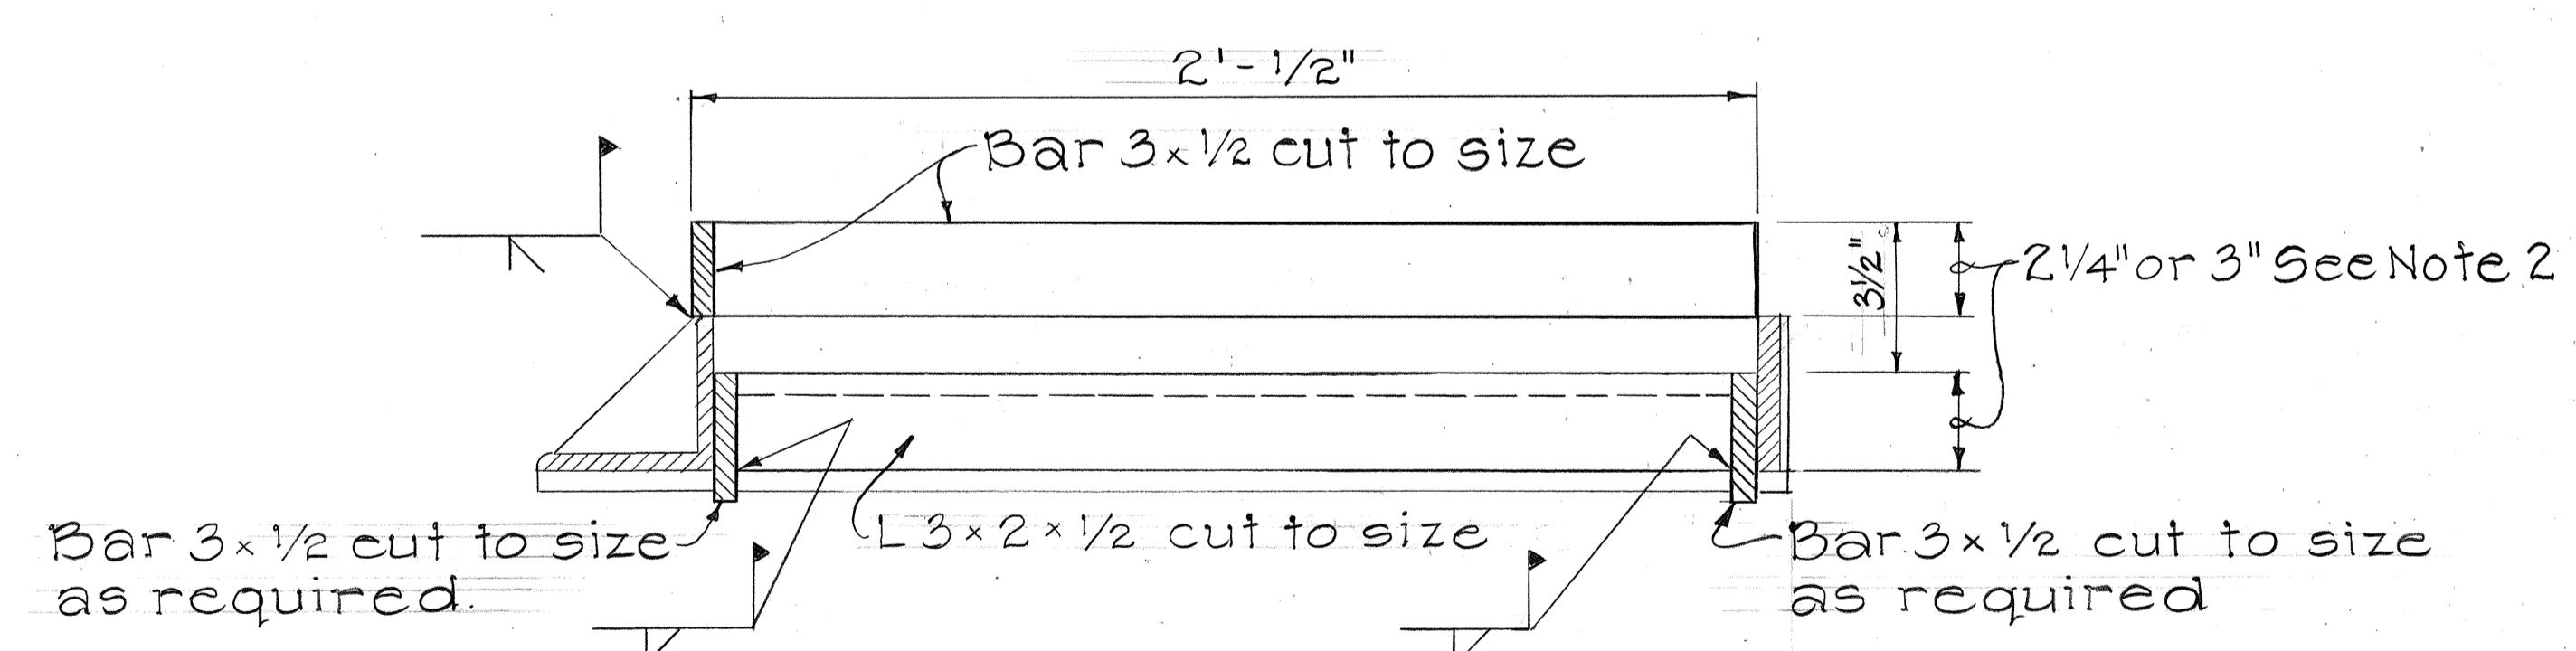
DETAILS TO ADJUST MEDIAN G.D.I. FRAMES AND GRATESScale:  $1\frac{1}{2}" = 1'-0"$ SECTION B  
20D 20DDETAIL 3  
Scale: 3" = 1'-0" 20D 20DDETAIL 4  
Scale: 3" = 1'-0" 20D 20D

|   |  |  |  |  |  |
|---|--|--|--|--|--|
| STATE OF HAWAII<br>DEPARTMENT OF TRANSPORTATION<br>HIGHWAYS DIVISION                        |  |  |  |  |  |
| <b>DRAINAGE DETAILS</b>   |  |  |  |  |  |
| INTERSTATE ROUTE H-I IMPROVEMENTS<br>MIDDLE STREET TO KALIHI INTERCHANGE<br>WESTBOUND LANES |  |  |  |  |  |
| F.A.I. PROJ. NO. I-HI-1(187)  |  |  |  |  |  |
| SCALE: AS NOTED DATE: JUNE 1983   |  |  |  |  |  |
| SHEET NO. 20D OF 30 SHEETS  |  |  |  |  |  |

| FED. ROAD DIST. NO. | STATE | FED. AID PROJ. NO. | FISCAL YEAR | SHEET NO. | TOTAL SHEETS |
|---------------------|-------|--------------------|-------------|-----------|--------------|
| HAWAII              | HAW.  | I-HI-1(187)        | 1984        | 78        | 191          |

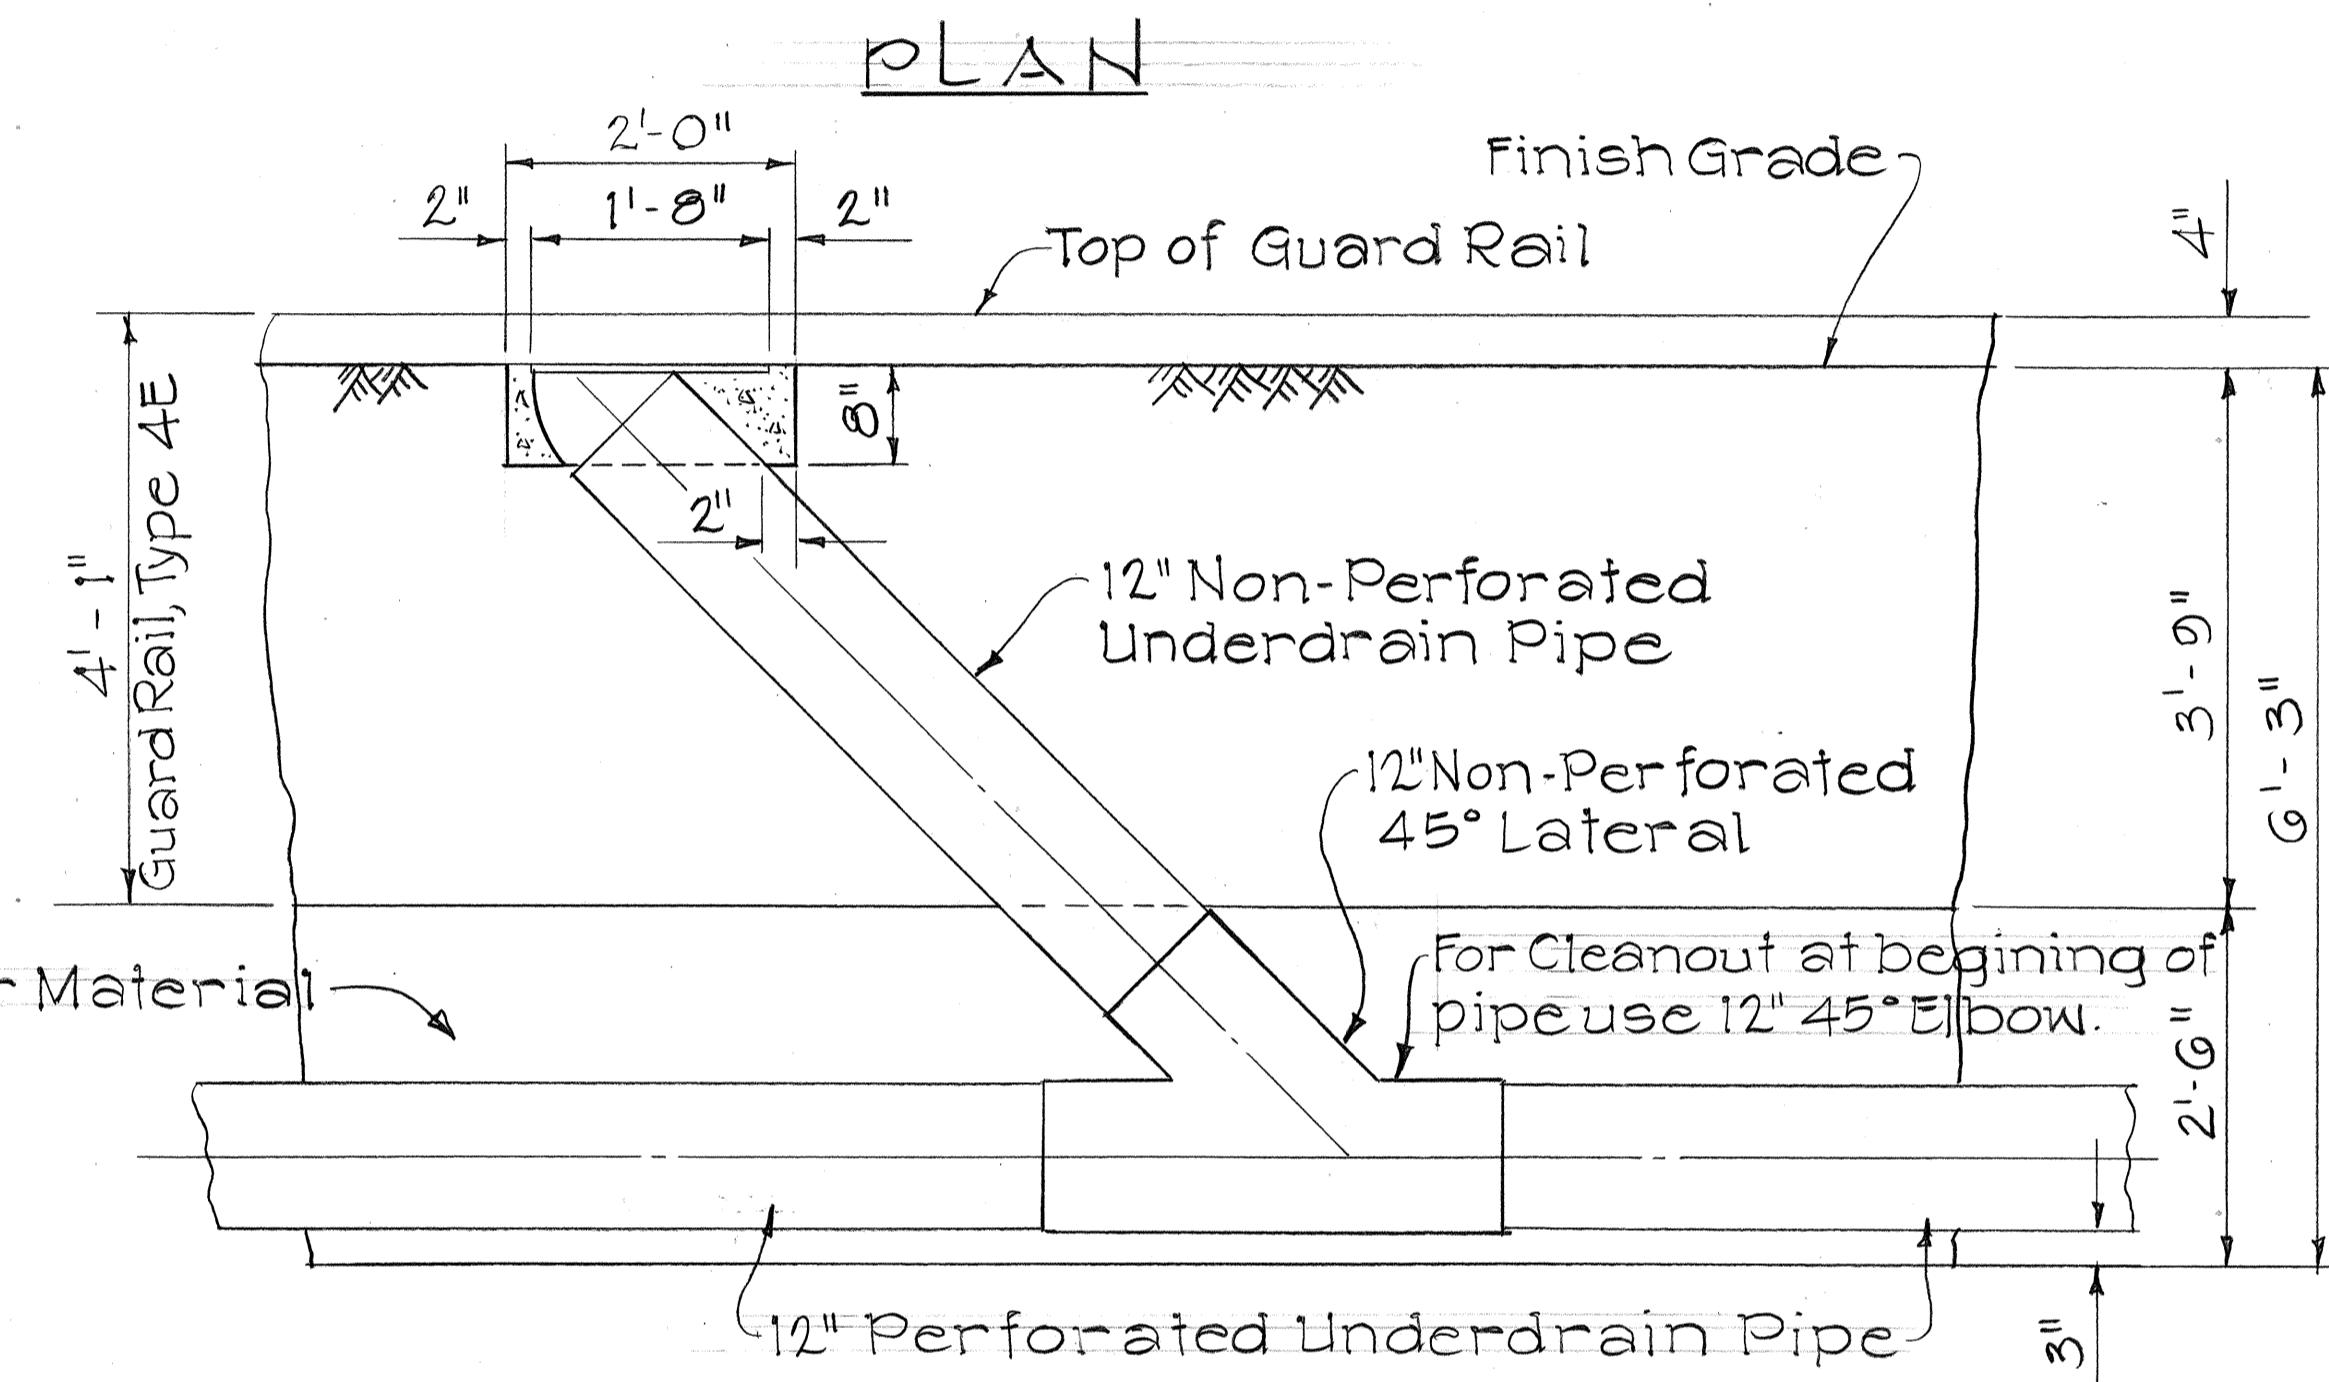
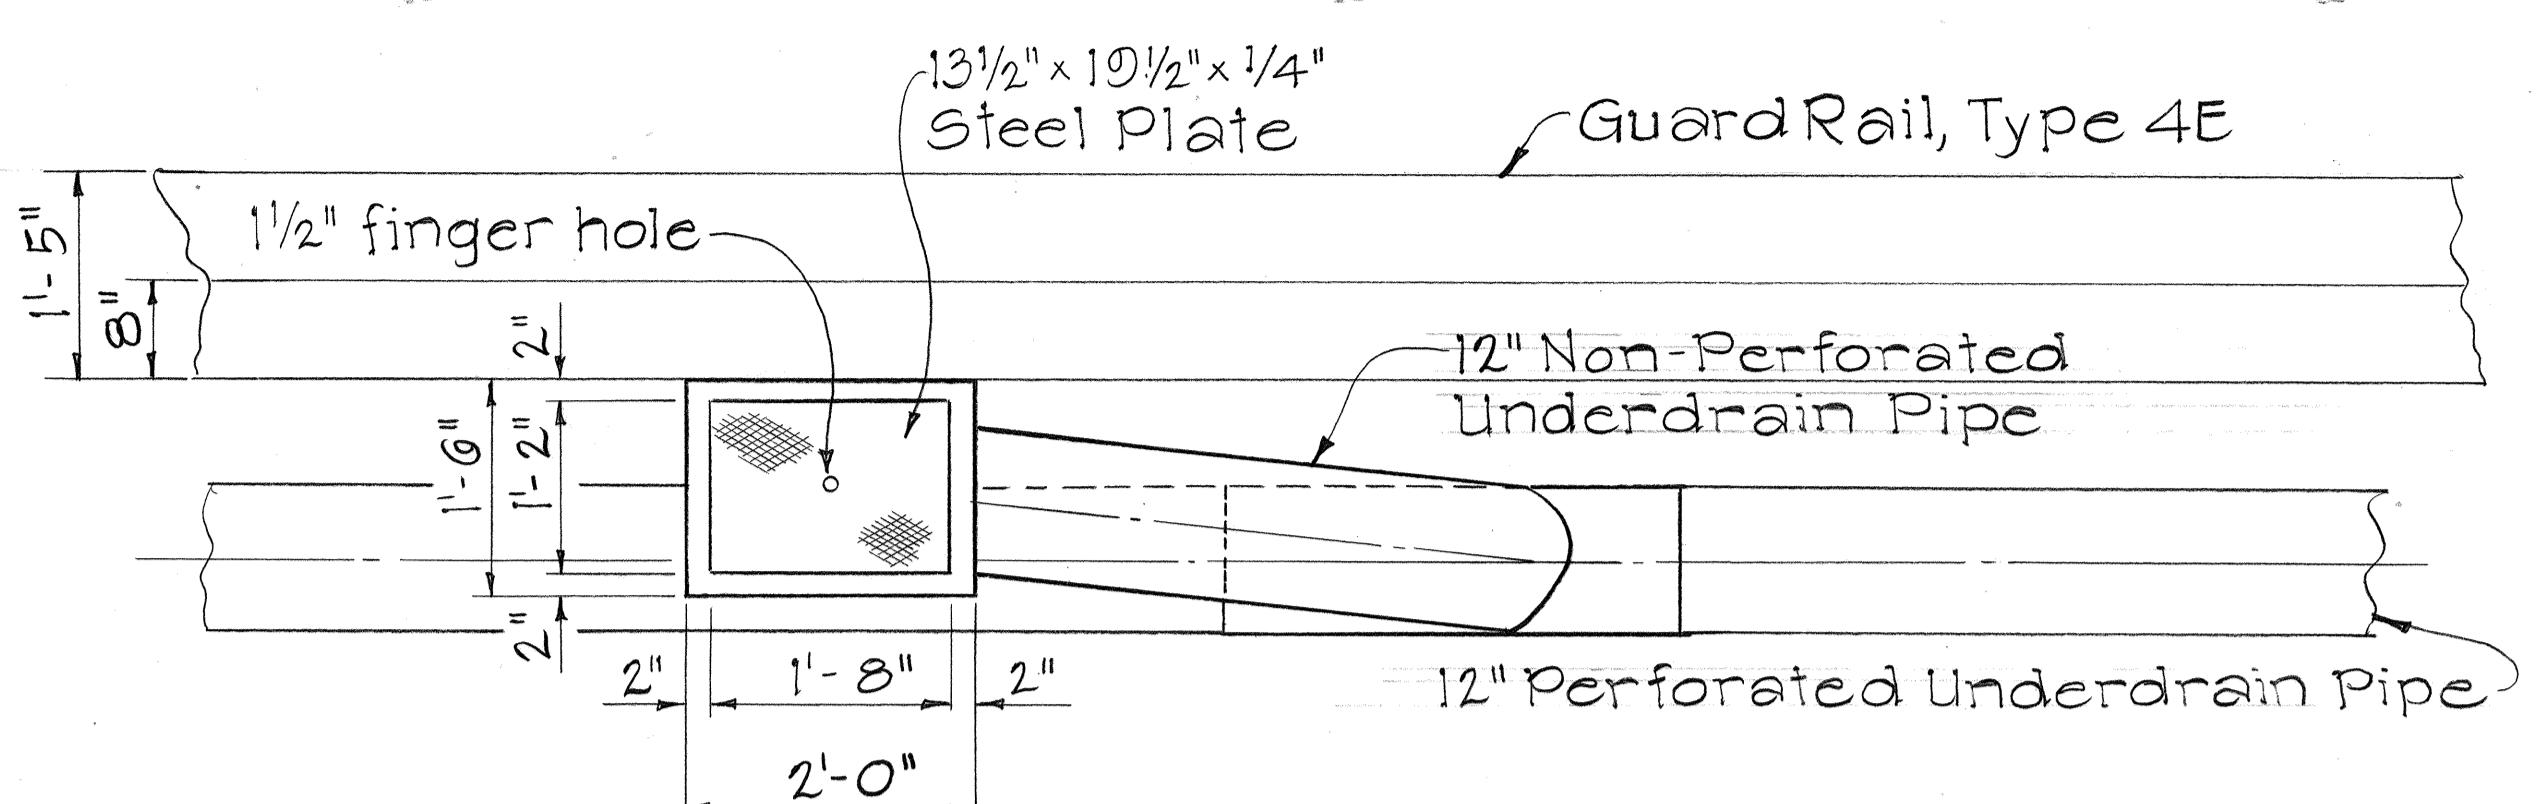


#### CLEANOUT AT INTERMEDIATE POINTS

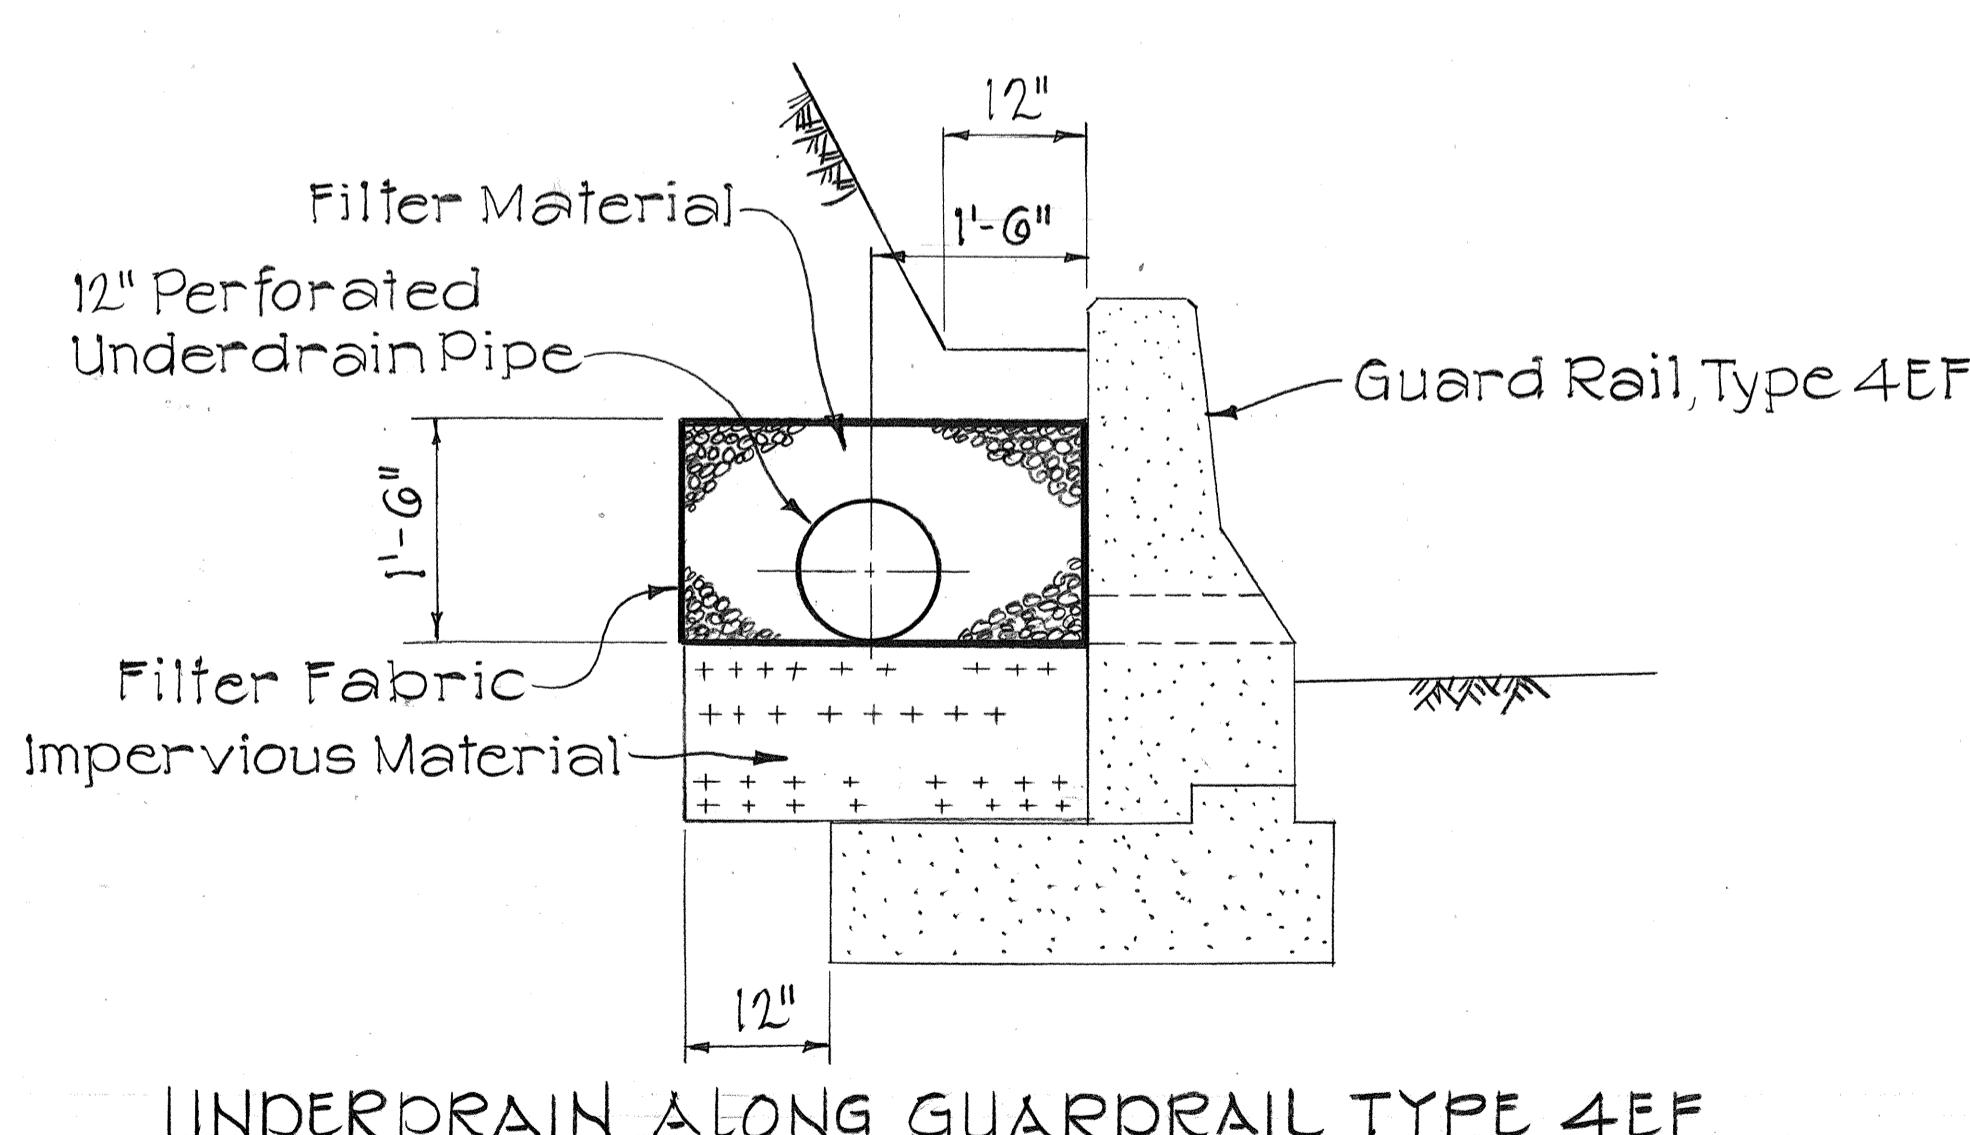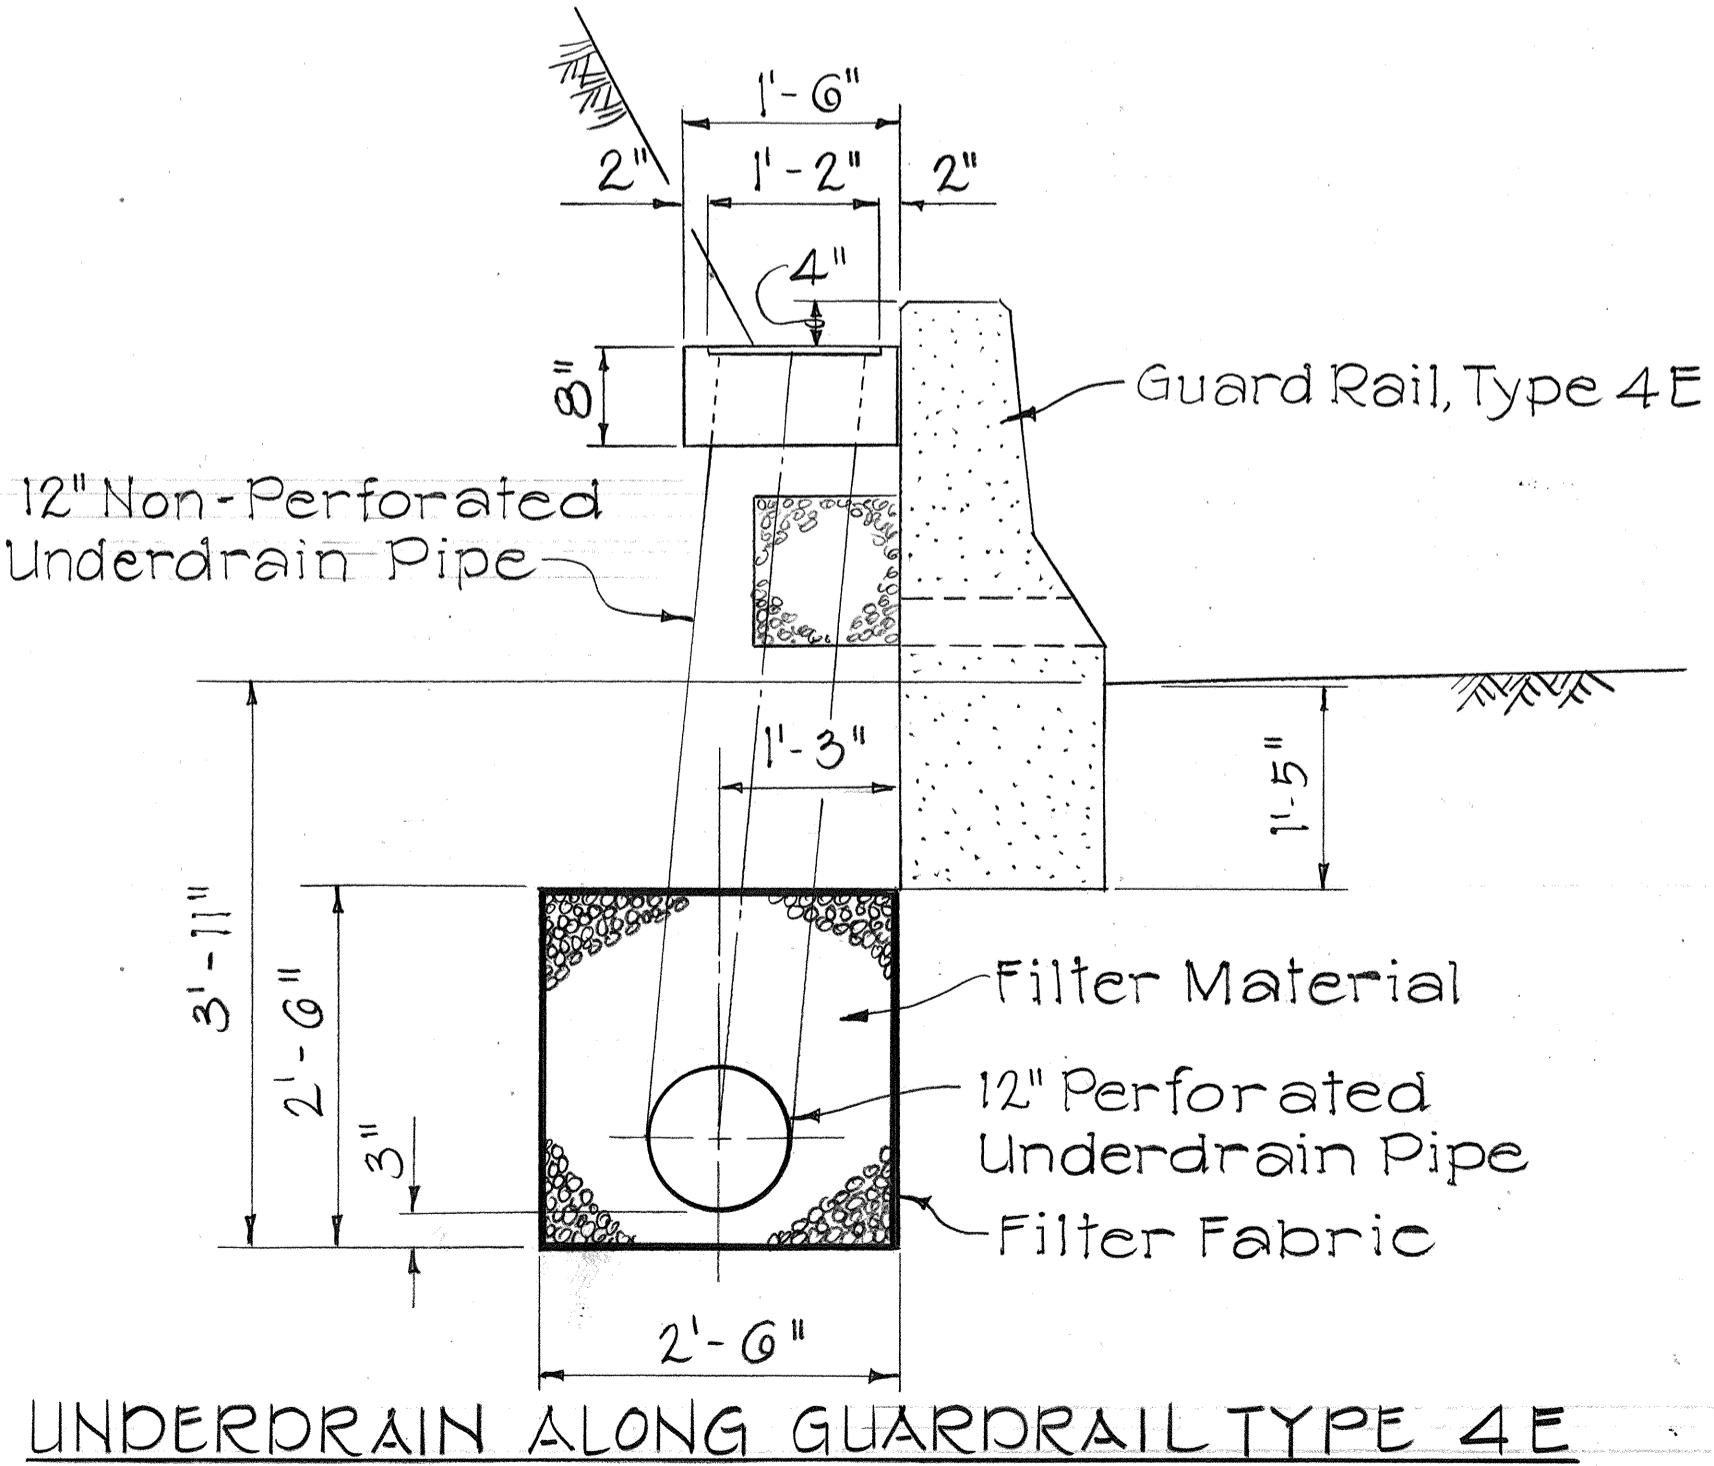


#### DETAIL FOR UNDERDRAIN PIPE SYSTEM

Scale: 3/4" = 1' - 0"

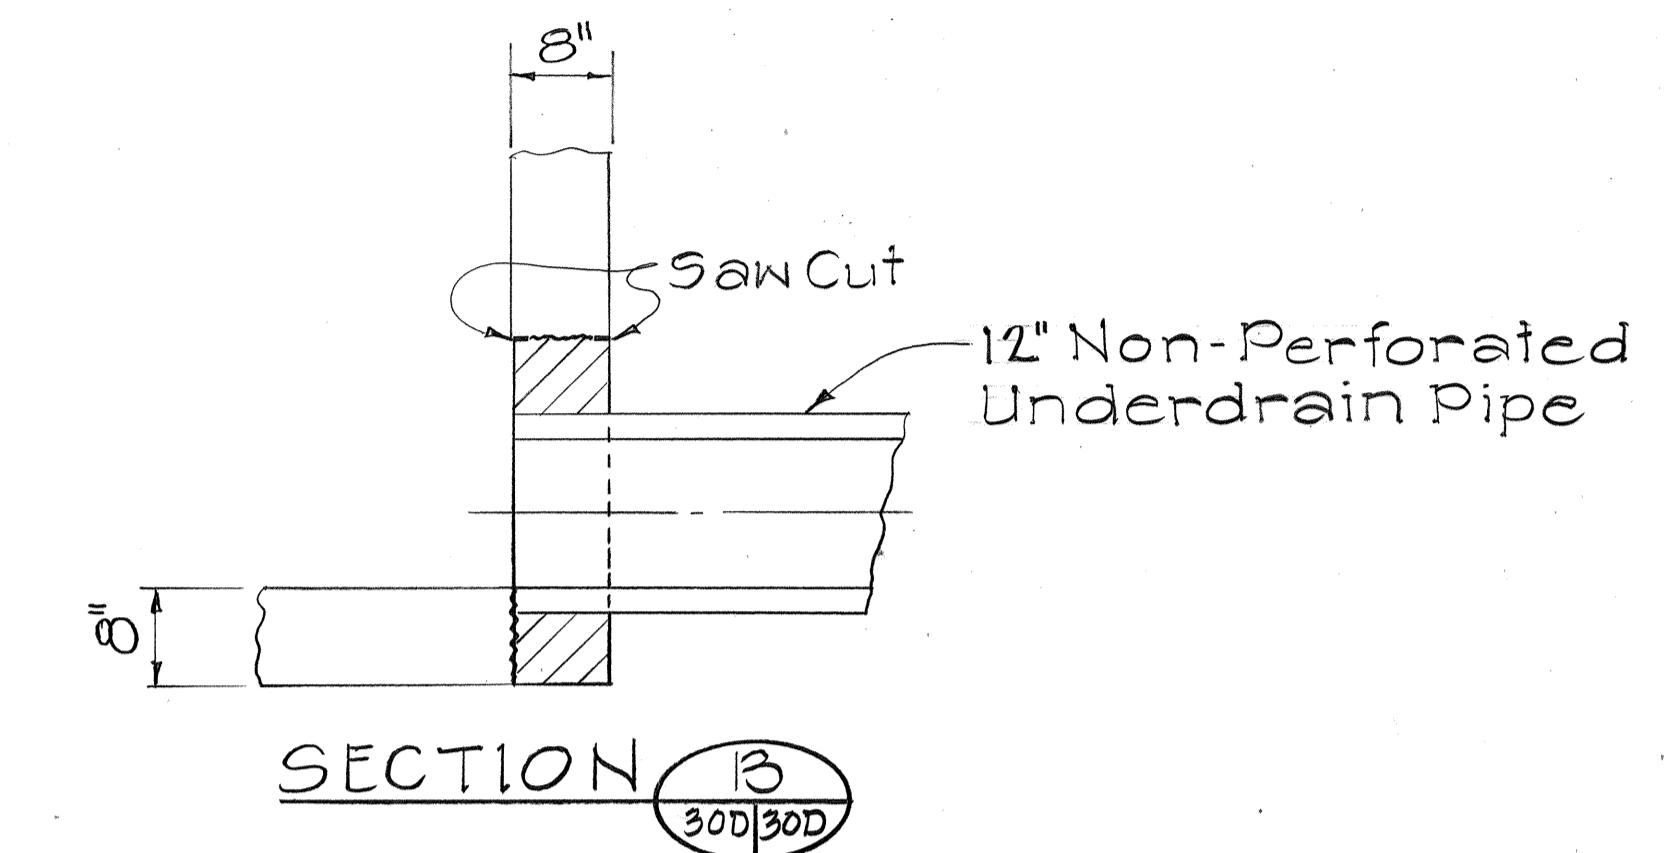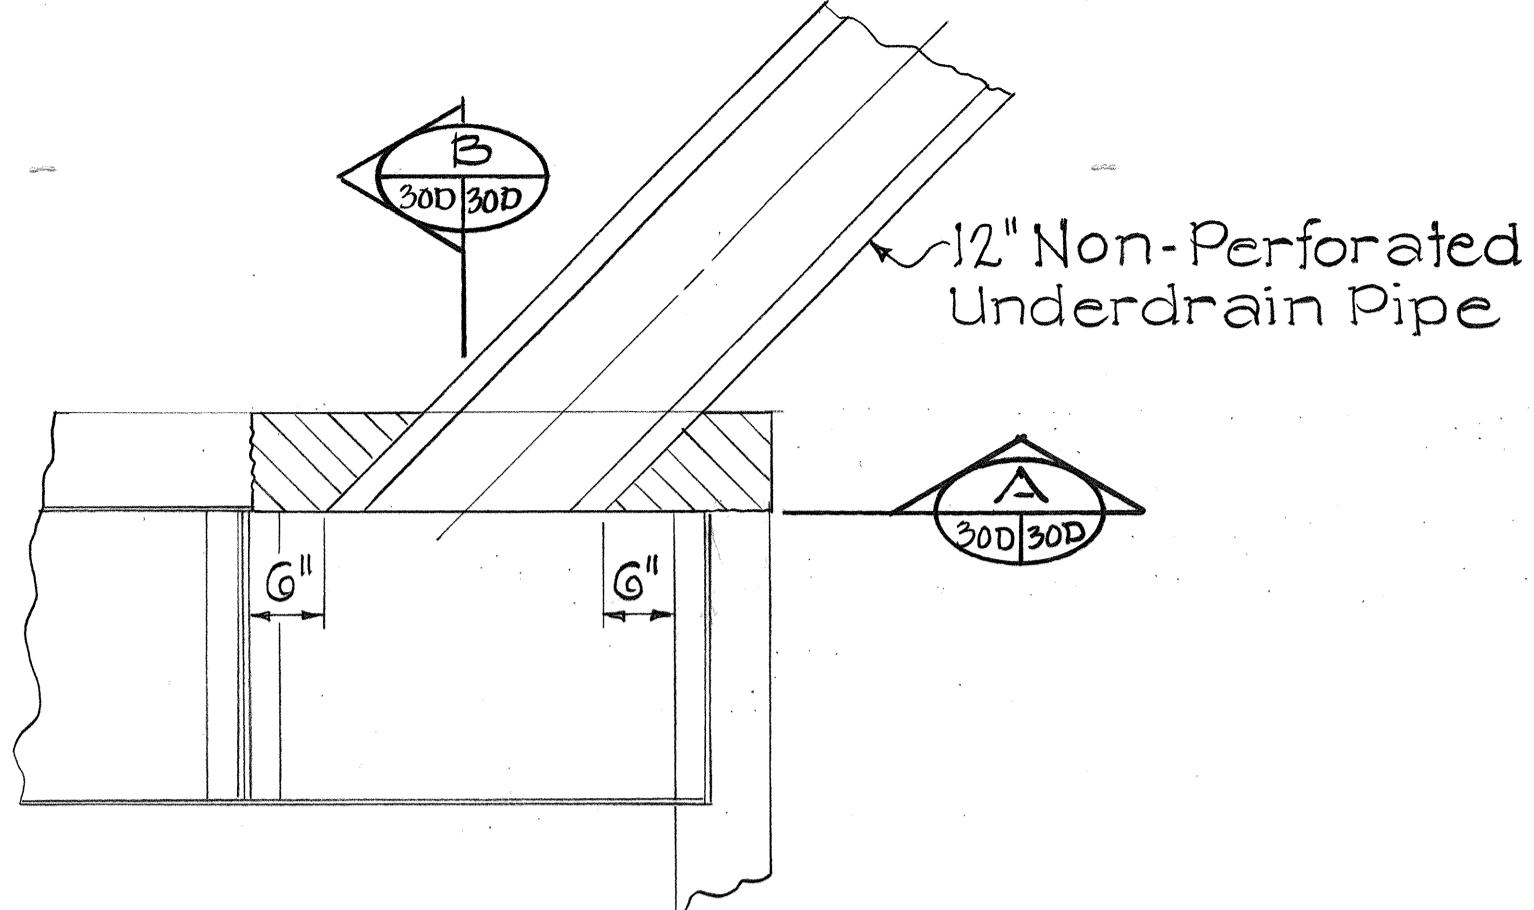


#### DETAIL OF UNDERDRAIN CONNECTION TO EXISTING G.D.I.

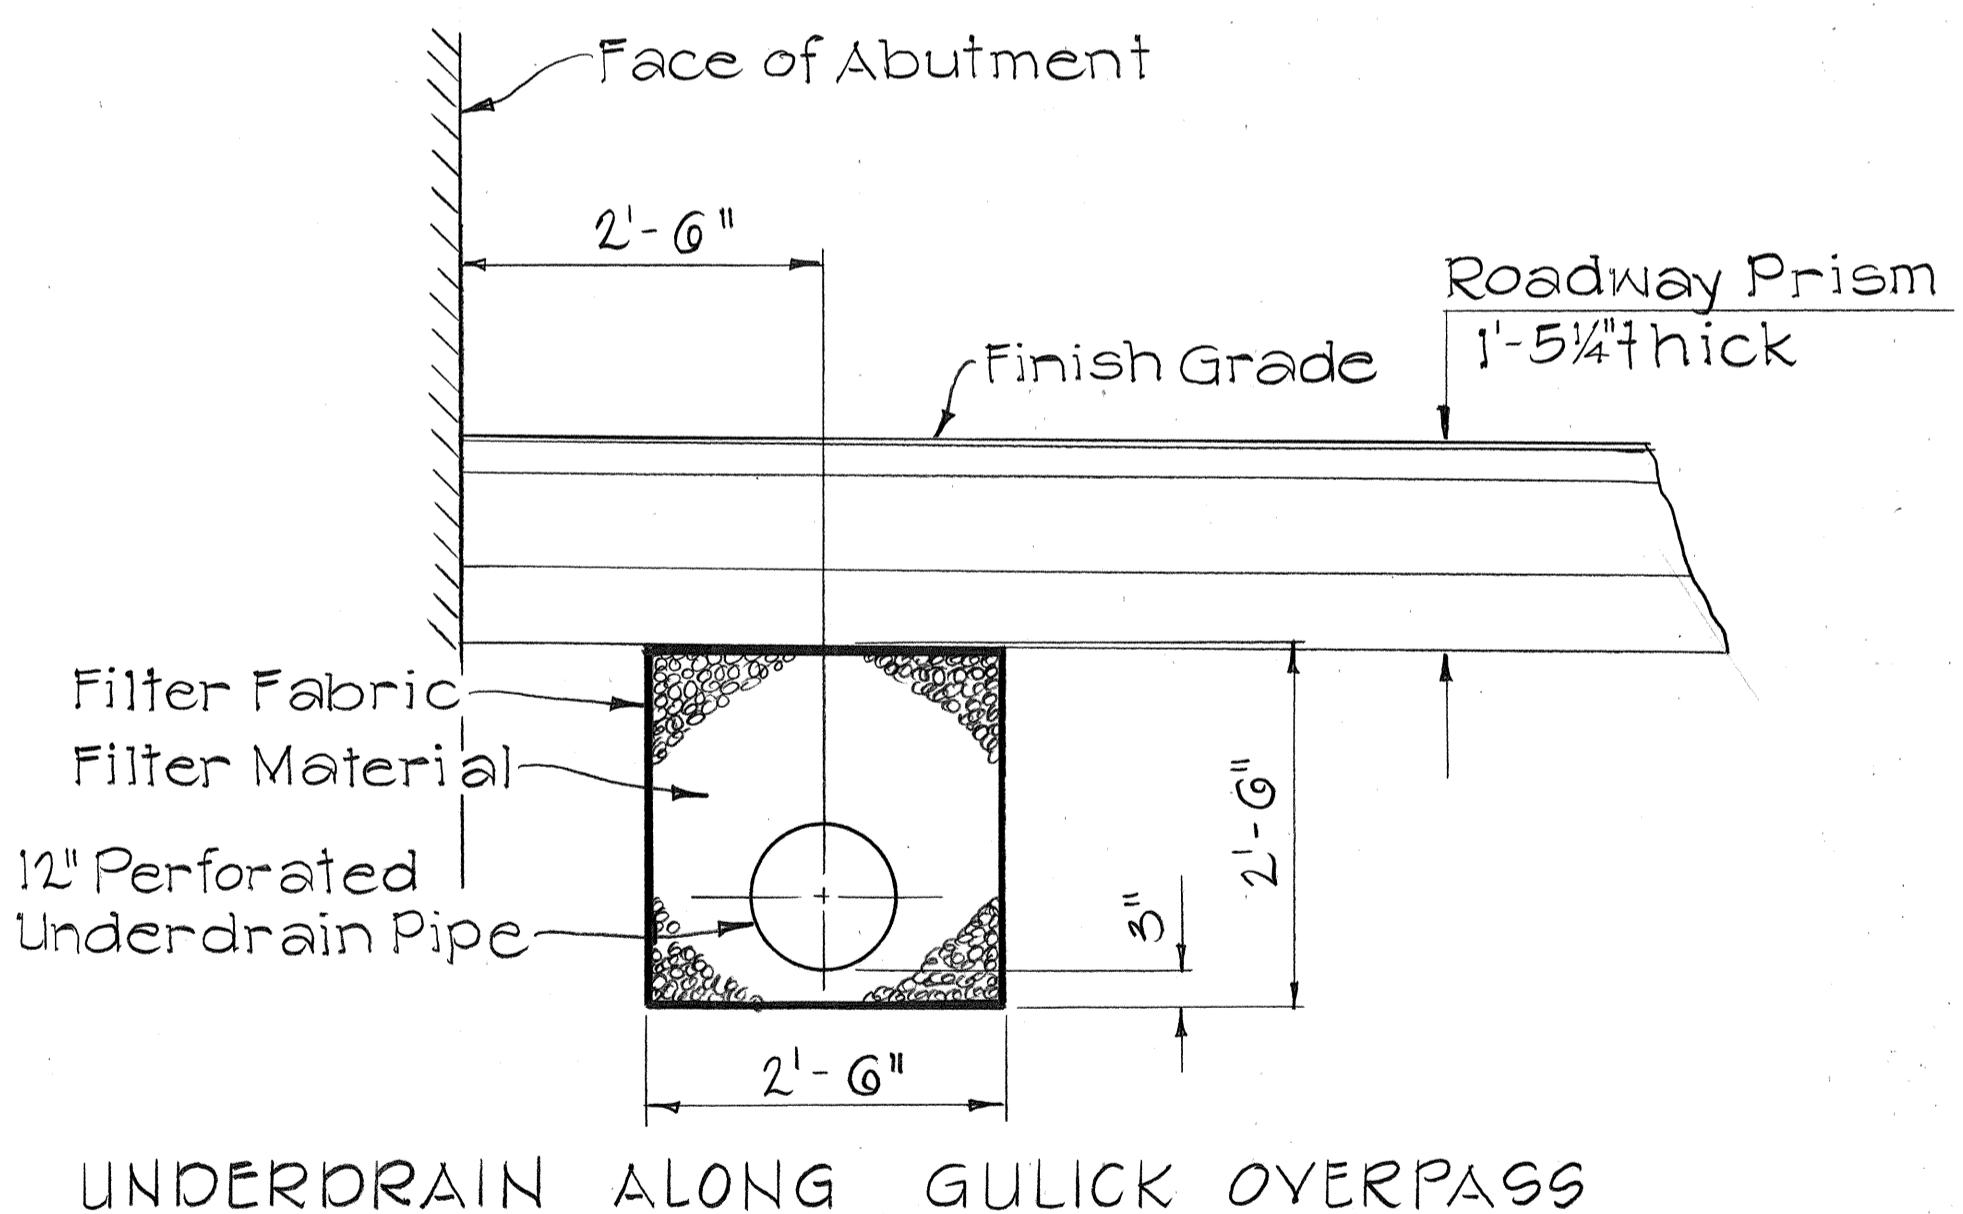

#### UNDERDRAIN ALONG GULICK OVERPASS

STATE OF HAWAII  
DEPARTMENT OF TRANSPORTATION  
HIGHWAYS DIVISION  
**DRAINAGE DETAILS**  
INTERSTATE ROUTE H-I IMPROVEMENTS  
MIDDLE STREET TO KALIHI INTERCHANGE  
WESTBOUND LANES  
F.A.I. PROJ. NO. I-HI-1(187)  
SCALE: 3/4" = 1'-0" DATE: JUNE 1983  
SHEET NO. 30 OF 30 SHEETS


| FED. ROAD DIST. NO. | STATE | FED. AID PROJ. NO. | FISCAL YEAR | SHEET NO. | TOTAL SHEETS |
|---------------------|-------|--------------------|-------------|-----------|--------------|
| HAWAII              | HAW.  | I-HI-1(187)        | 1984        | 79        | 197          |

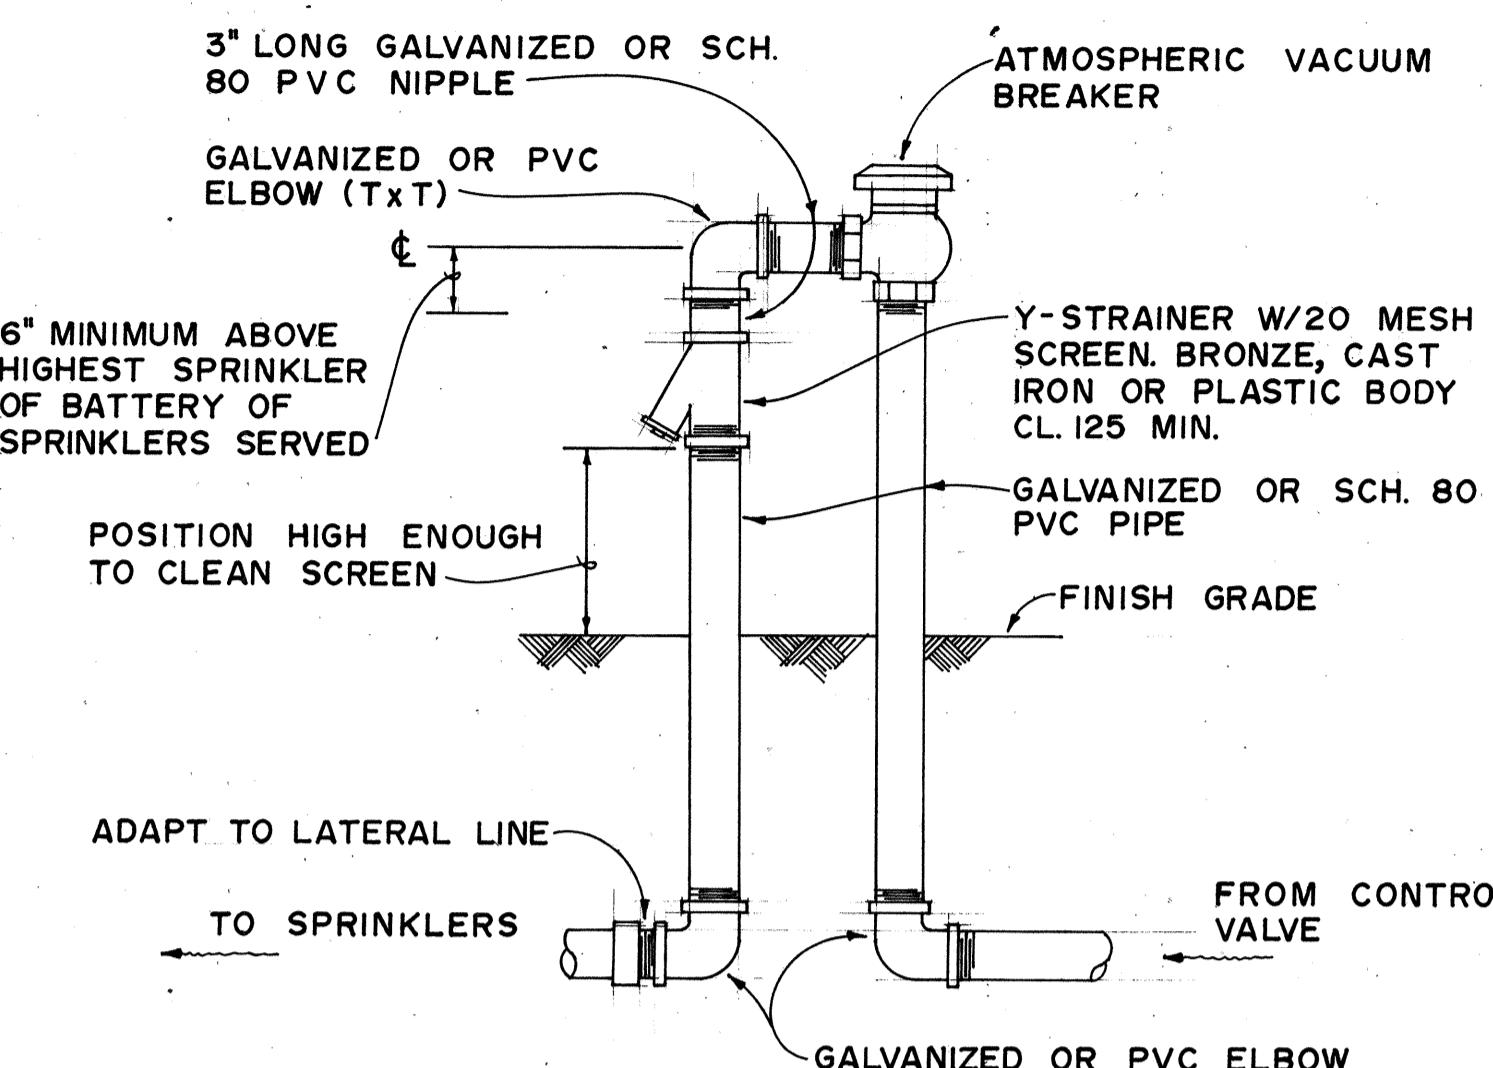

ATMOSPHERIC VACUUM BREAKER UNIT DETAIL

NOTES:


1. ATMOSPHERIC VACUUM BREAKER, Y-STRAINER AND PIPE ABOVE FINISH GRADE SHALL BE PRIME COATED AND PAINTED WITH TWO COATS OF DARK GREEN ENAMEL PAINT.
2. GALVANIZED PIPE BELOW FINISH GRADE SHALL BE PAINTED WITH TWO COATS OF ASPHALT PAINT.

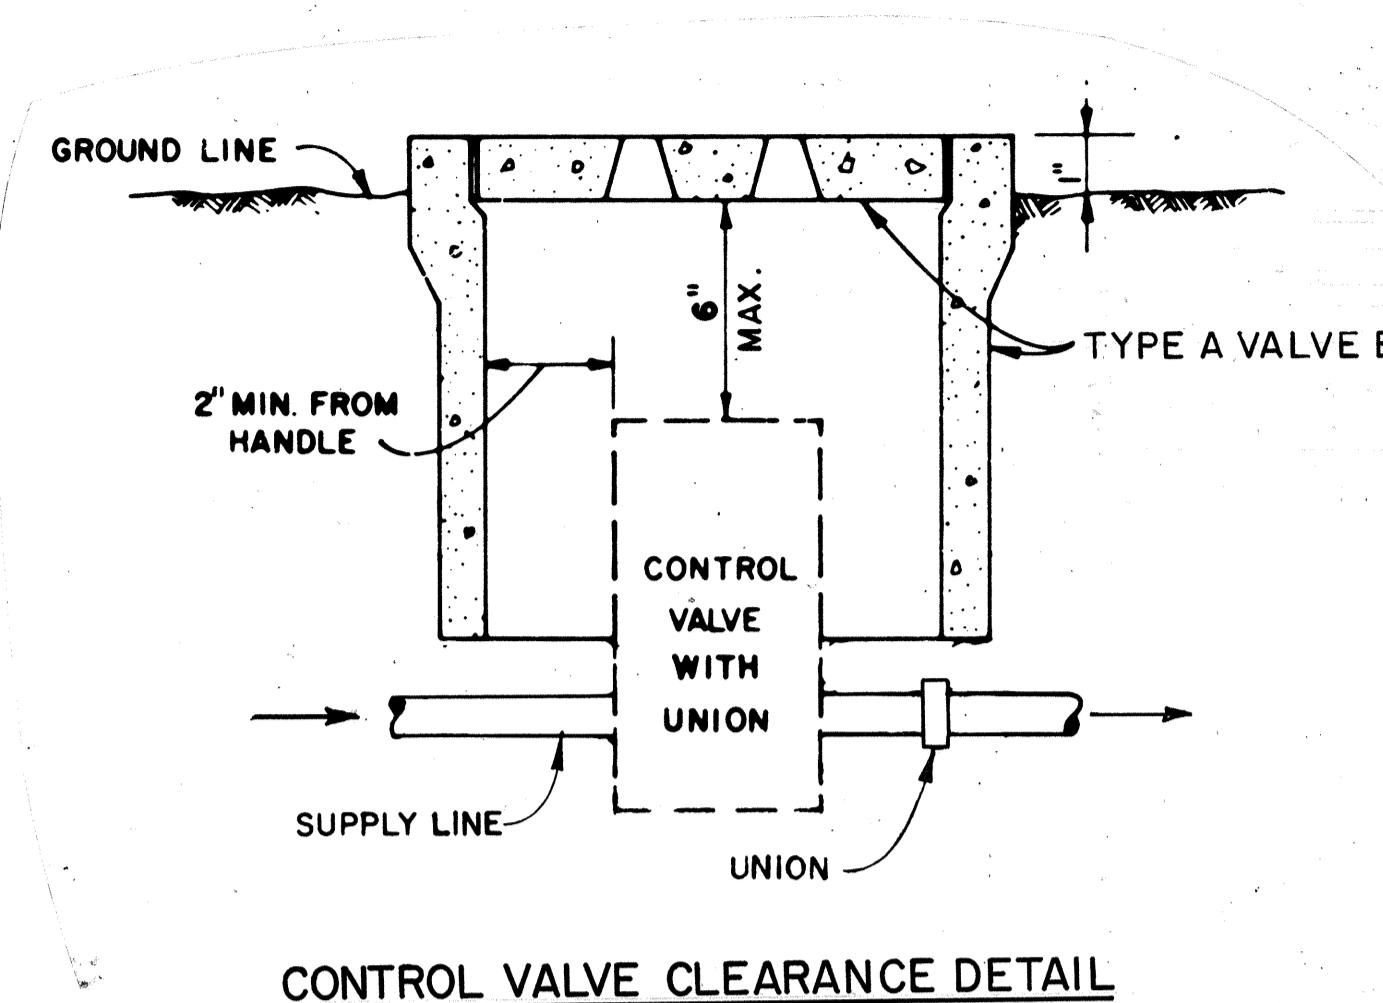

CONTROL VALVE CLEARANCE DETAIL

ESTIMATED QUANTITIES FOR SPRINKLER SYSTEM

|   |            |
|---|------------|
| Relocation of Existing Sprinkler Lines                  | = 88 L.F.  |
| Relocating Existing Valve with Valve Box                | = 3 Ea.    |
| 2½ -inch Copper Pipe                                    | = 40 L.F.  |
| 2½ -inch Galvanized Steel Pipe, Copper Pipe or PVC Pipe | = 20 L.F.  |
| 2 -inch Atmospheric Vacuum Breaker Unit                 | = 1 Ea.    |
| ½ -inch PVC Pipe  | = 260 L.F. |
| ¾ -inch Copper Pipe or PVC Pipe                         | = 180 L.F. |
| 1 -inch Copper Pipe or PVC Pipe                         | = 100 L.F. |
| 1¼ -inch Copper Pipe or PVC Pipe                        | = 100 L.F. |
| 1½ -inch Copper Pipe or PVC Pipe                        | = 40 L.F.  |
| 2 -inch Copper Pipe or PVC Pipe                         | = 100 L.F. |
| S-12 (Q, H, F) Sprinkler Head                           | = 26 Ea.   |
| I-35 (Q, H, F) Sprinkler Head                           | = 4 Ea.    |
| Emitter with 6 Multiple Outlets at 1 gph/outlet         | = 8 Ea.    |

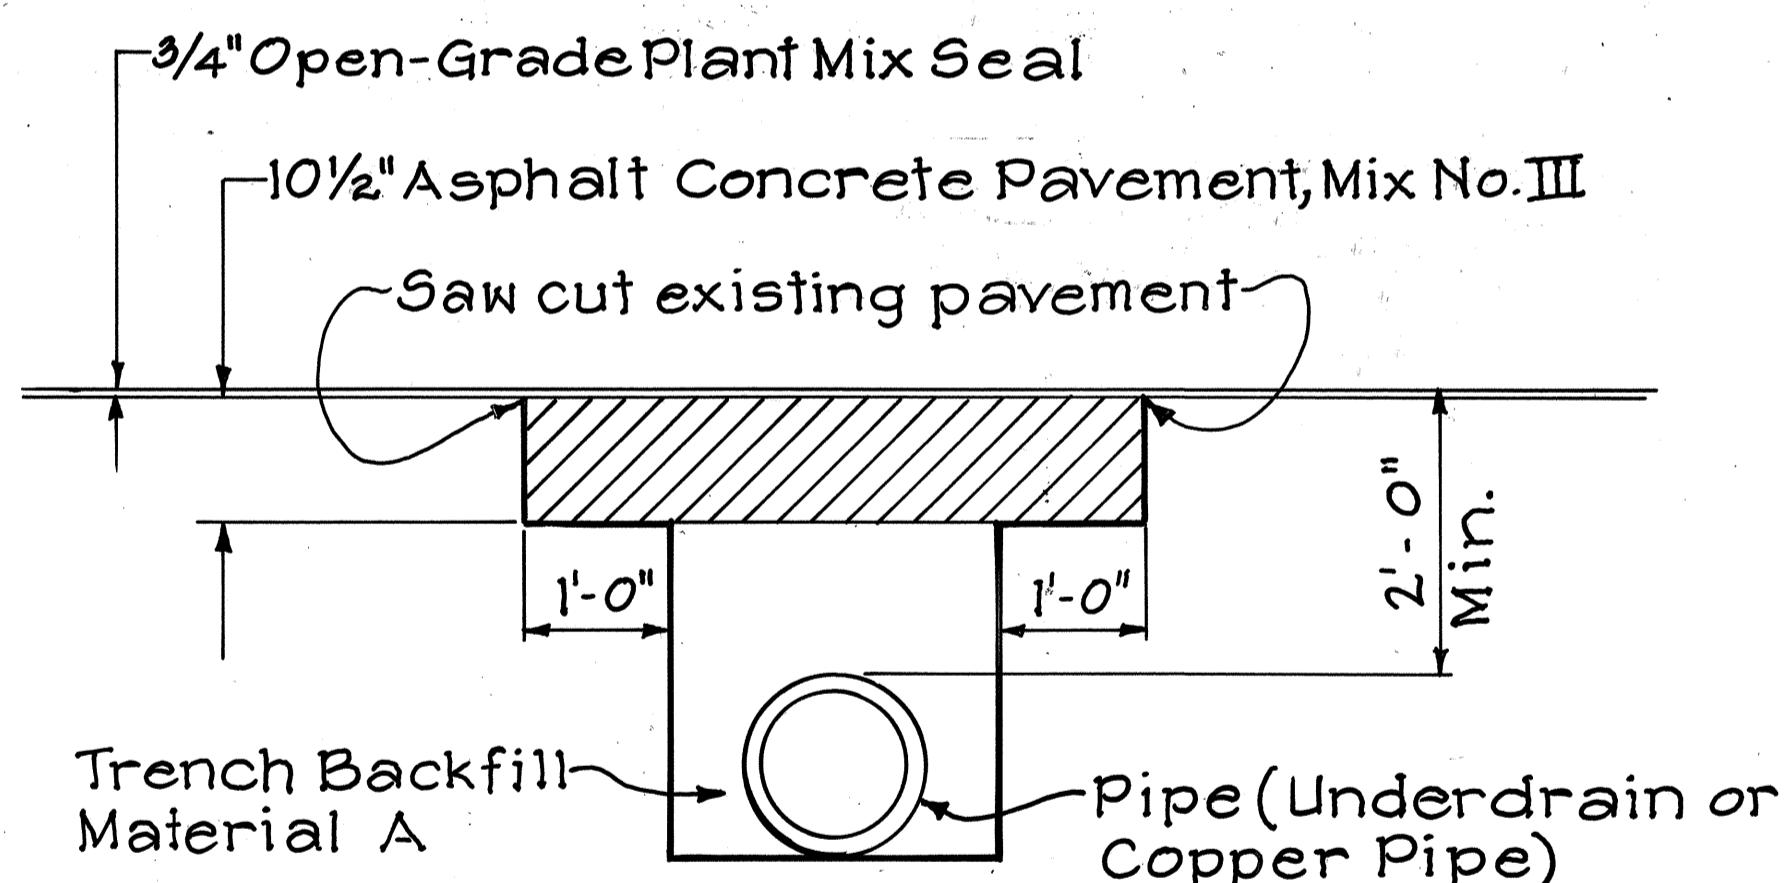

TRENCH DETAIL ROADWAY CROSSING

NOTE: Scale: ¾" = 1'-0"

1. The materials and construction requirements for pavement restoration shall conform to the applicable sections of the Standard Specifications. Payment for pavement restoration and other improvements shall be considered incidental to the various contract items.
2. The width of the trench shall be as narrow as practical to facilitate installation, approximately twice the outside diameter of the pipe with a minimum of 8 inches.


|                     |           |
|---------------------|-----------|
| SURVEYOR PLOTTED BY | DATE      |
| DRAFTER PLOTTED BY  |           |
| TRACED BY           |           |
| DESIGNED BY         |           |
| QUANTITY BY         |           |
| CHECKED BY          |           |
| NOTE BOOK           | No. _____ |

| SPRINKLER DETAILS   |   |
|---|---|
| INTERSTATE ROUTE H-I IMPROVEMENTS<br>MIDDLE STREET TO KALIHI INTERCHANGE<br>WESTBOUND LANES<br>F.A.I. PROJ. NO. I-HI-1(187) | SCALE: AS NOTED DATE: JUNE 1983                               |
| 11/30/83  | New items added to Estimated Quantities for Sprinkler System. |
| DATE  | REVISION  |


SHEET NO. 310 OF 30 SHEETS

ADD.79

| FED. ROAD DIST. NO. | STATE | FED. AID PROJ. NO. | FISCAL YEAR | SHEET NO.     | TOTAL SHEETS |
|---------------------|-------|--------------------|-------------|---------------|--------------|
| HAWAII              | HAW.  | I-HI-1(187)        | 1984        | ADD 79<br>S-1 | 197          |

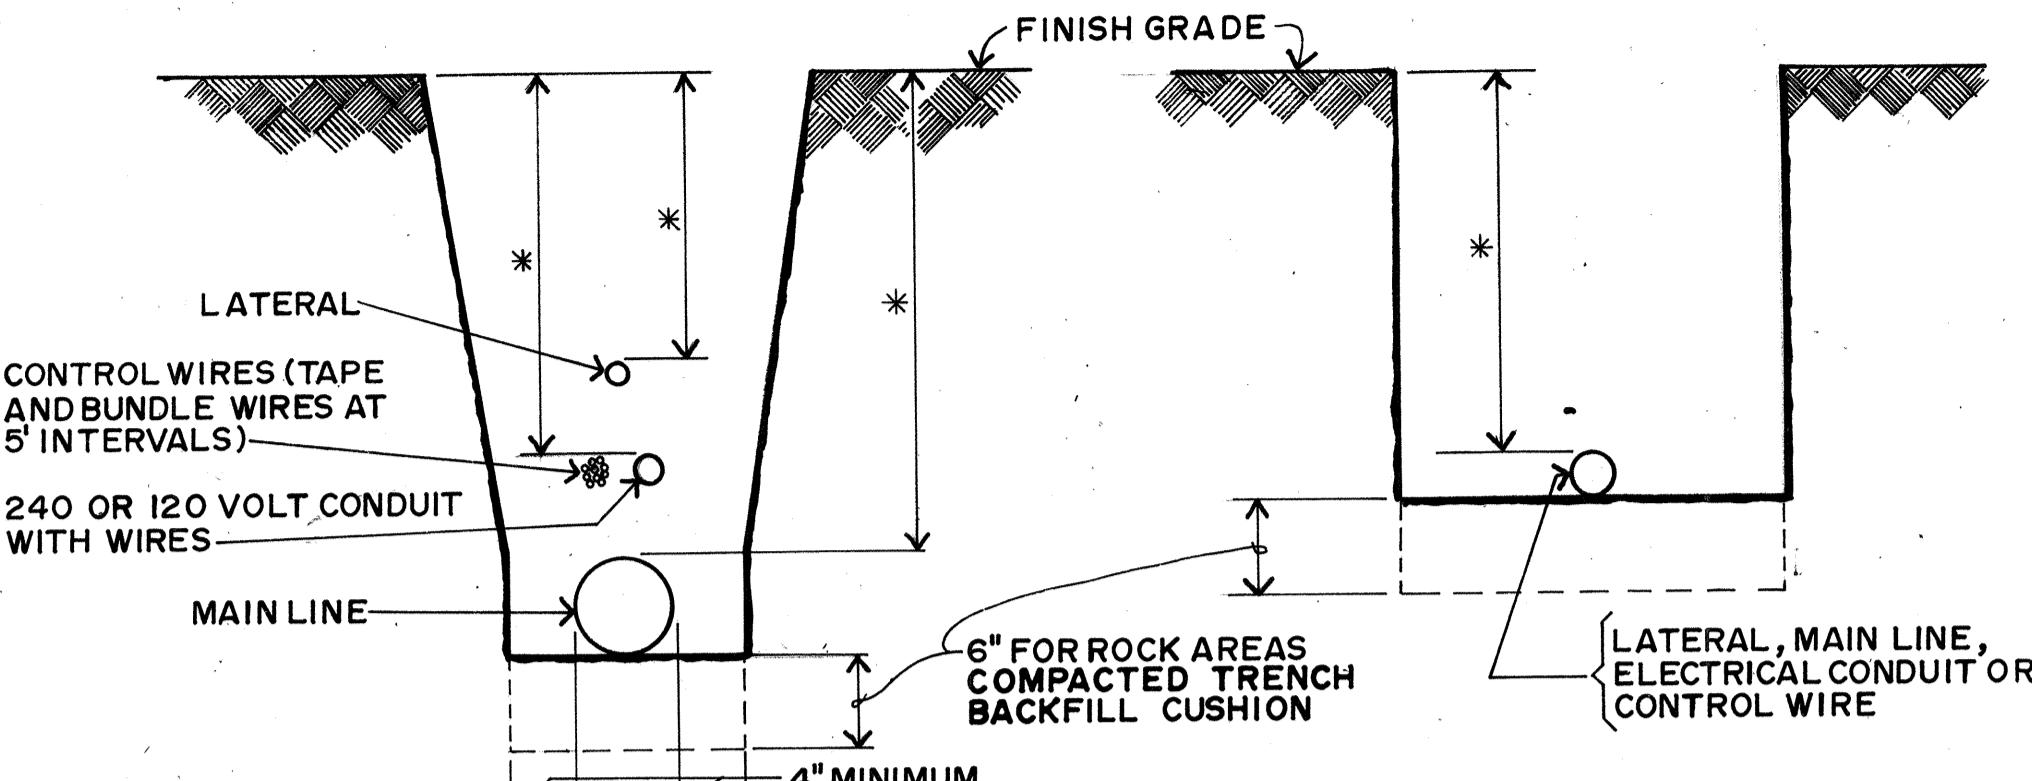


|                    | MINIMUM * COVER |
|--------------------|-----------------|
| SPRINKLER LATERALS | 12"             |
| SPRINKLER MAINS    |                 |
| 1/2" TO 2 1/2"     | 18"             |
| 3" OR 4"           | 24"             |
| OVER 4"            | 30"             |
| ELECTRICAL CONDUIT | 24"             |
| CONTROL WIRES      | 18"             |

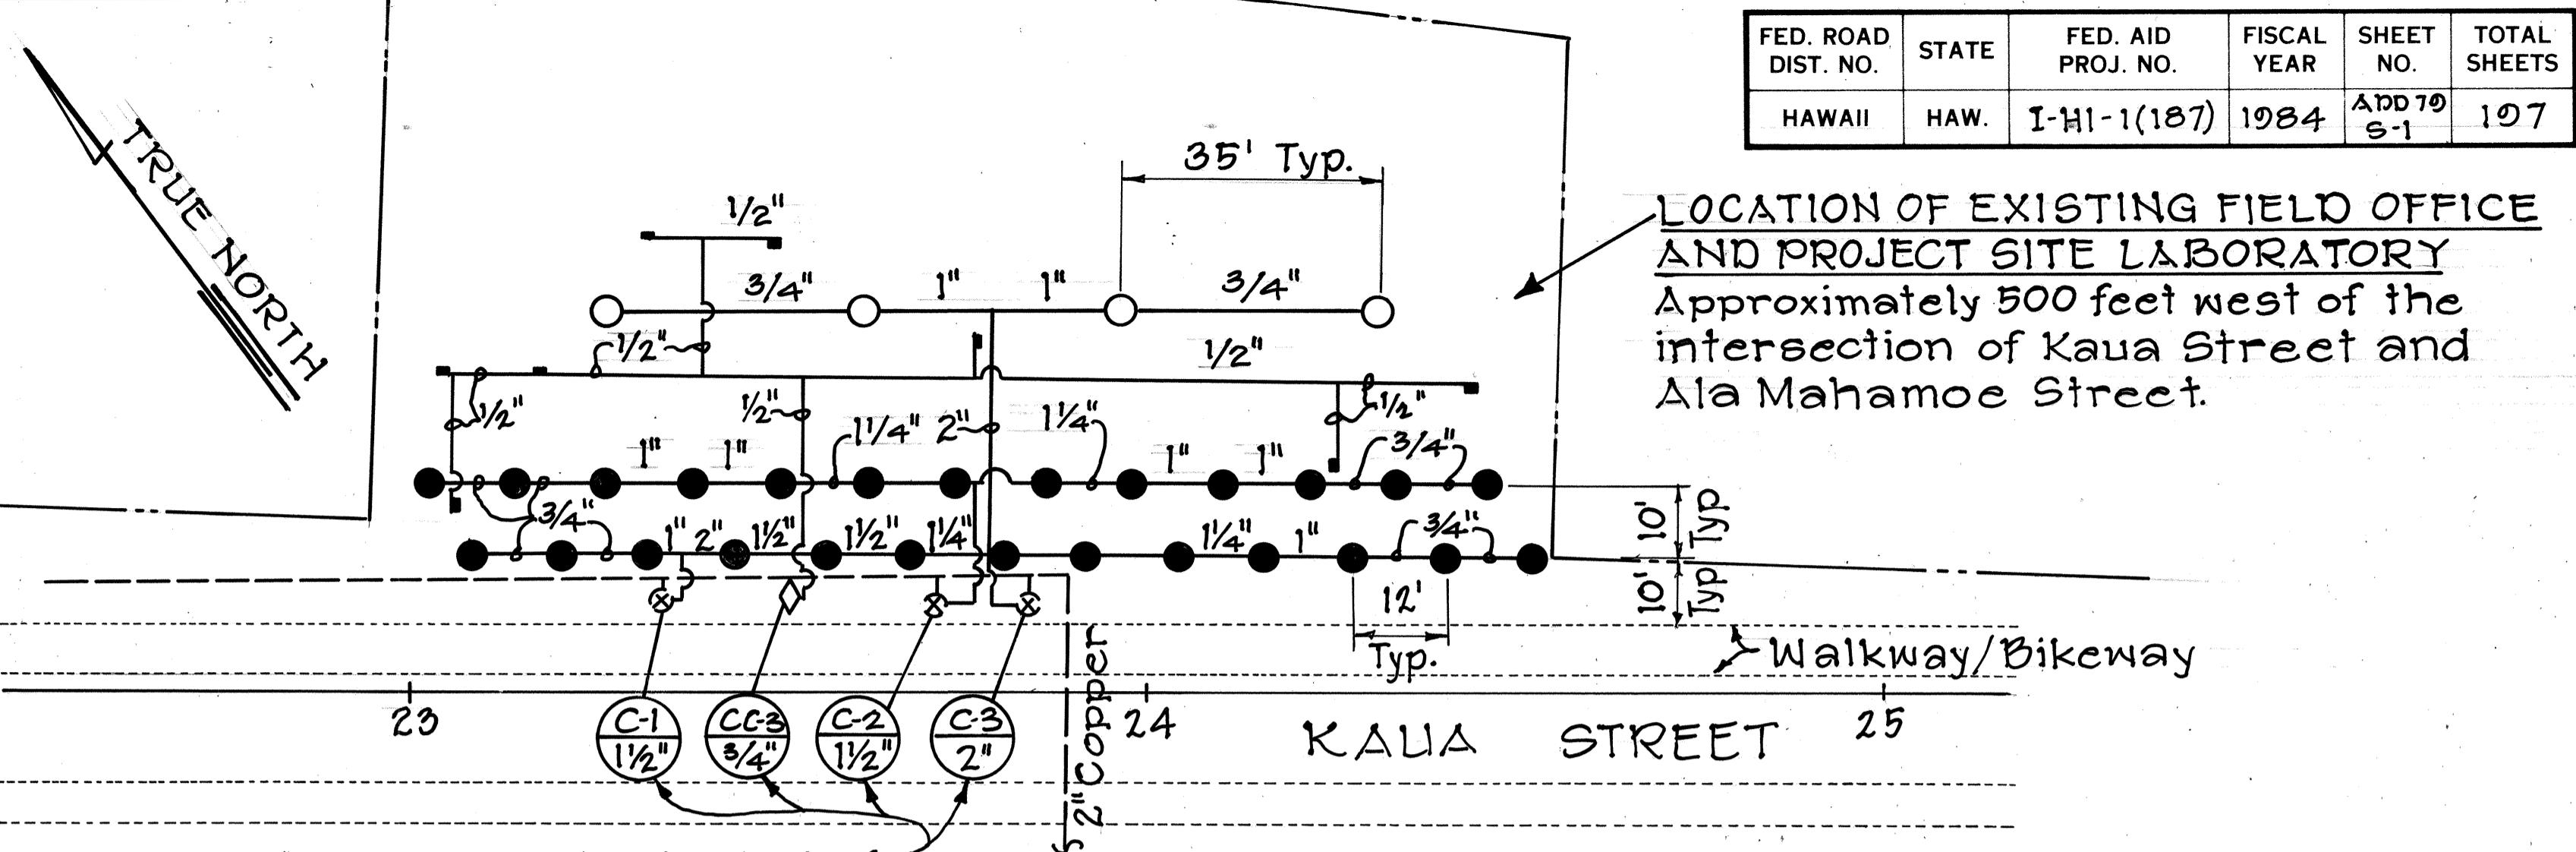



PLAN  
Scale: 1" = 20'

### SPRINKLER LEGEND


| SPRINKLER       | SYM | DESCRIPTION   | P.S.I. | COVERAGE FEET | G.P.M. | NOZZLE INCHES | RISER INCHES | SPECIAL FEATURES                                 |
|-----------------|-----|---|--------|---------------|--------|---------------|--------------|--|
| S-12            | ●   | Shrub Spray - Full  | 20     | 12 Rad.       | 3.0    |               | 1/2          | Plastic or Brass                                 |
| I-35 F          | ○   | Impact - Full   | 35     | 37 Rad.       | 6.4    | 3/16          | 1/2          | Brass or Bronze, Brass nozzle, with Break Up Pin |
|                 | —   | Emitter with 6 Multiple Outlet at 1gph each outlet              |        |               |        |               |              |  |
| (C-1)<br>1 1/2" | ◎   | Valve Station Number & (existing RCV)<br>Valve Size (in inches) |        |               |        |               |              |  |

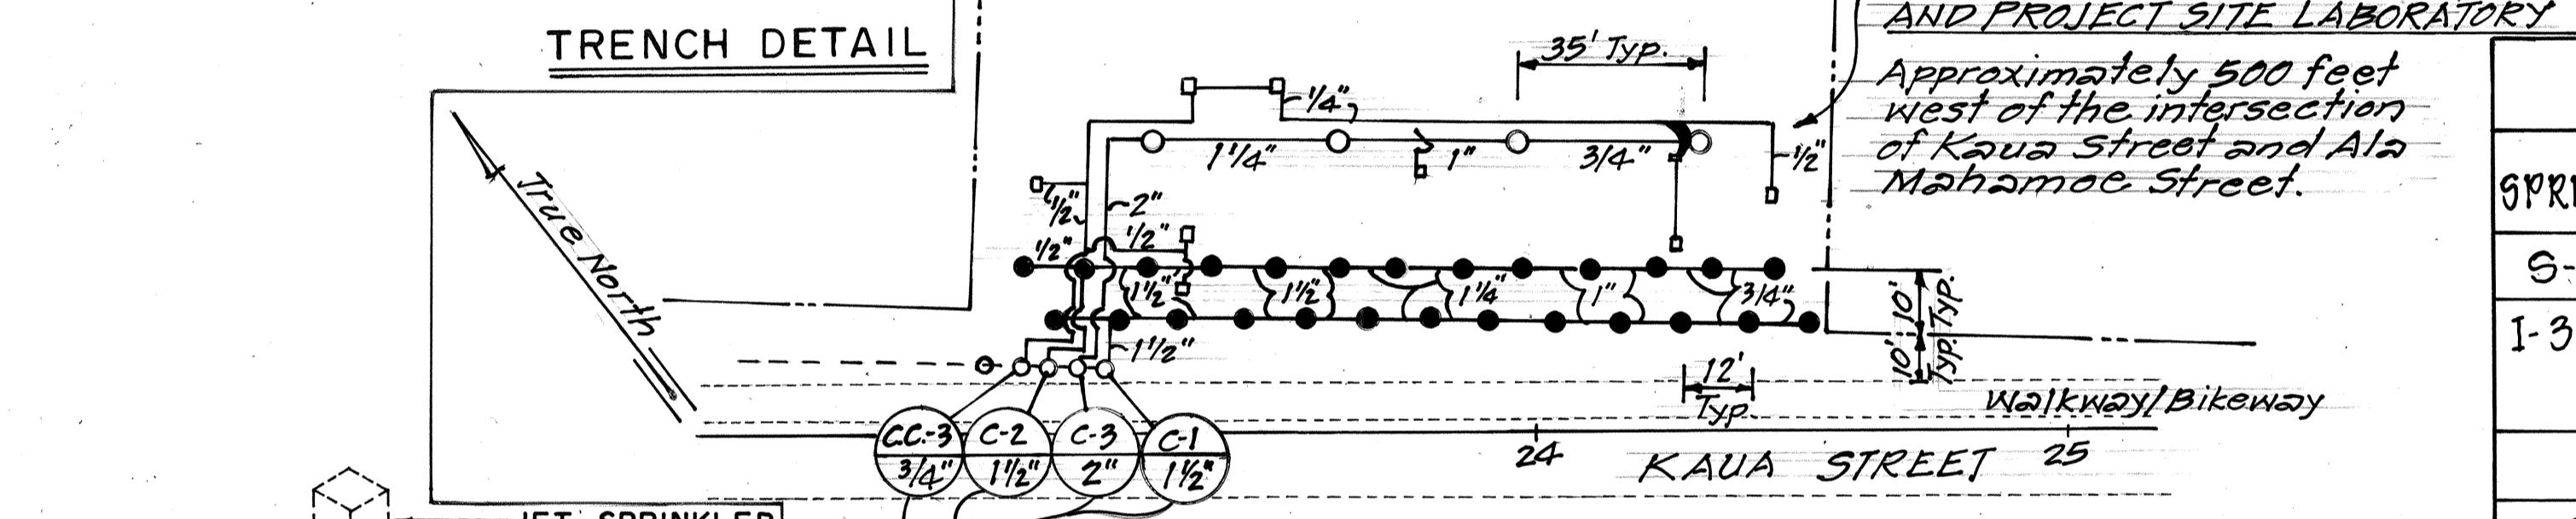

PLAN  
Scale: Not To Scale  
NOTE: This Tracing/Detail prepared during "As-Built" posting.

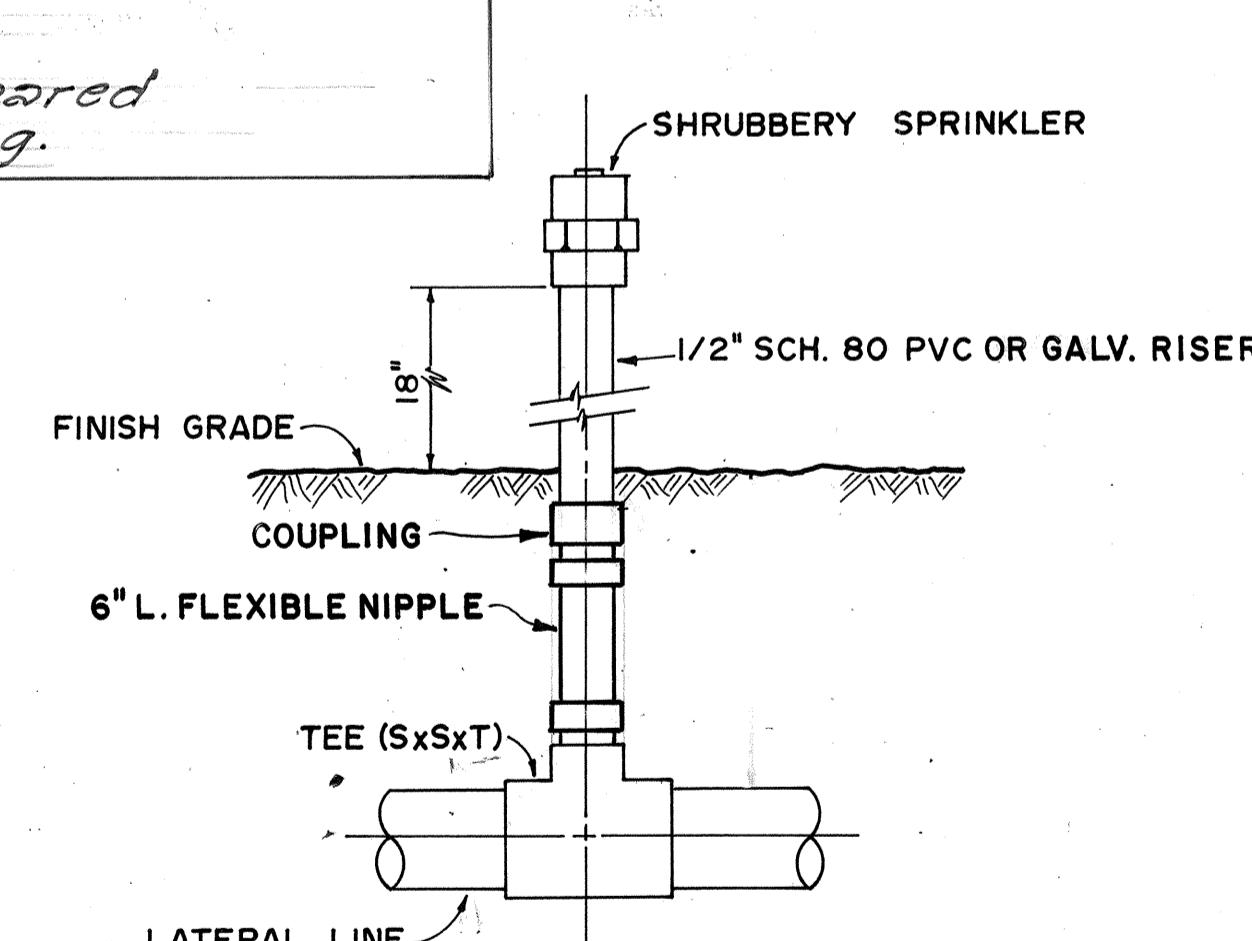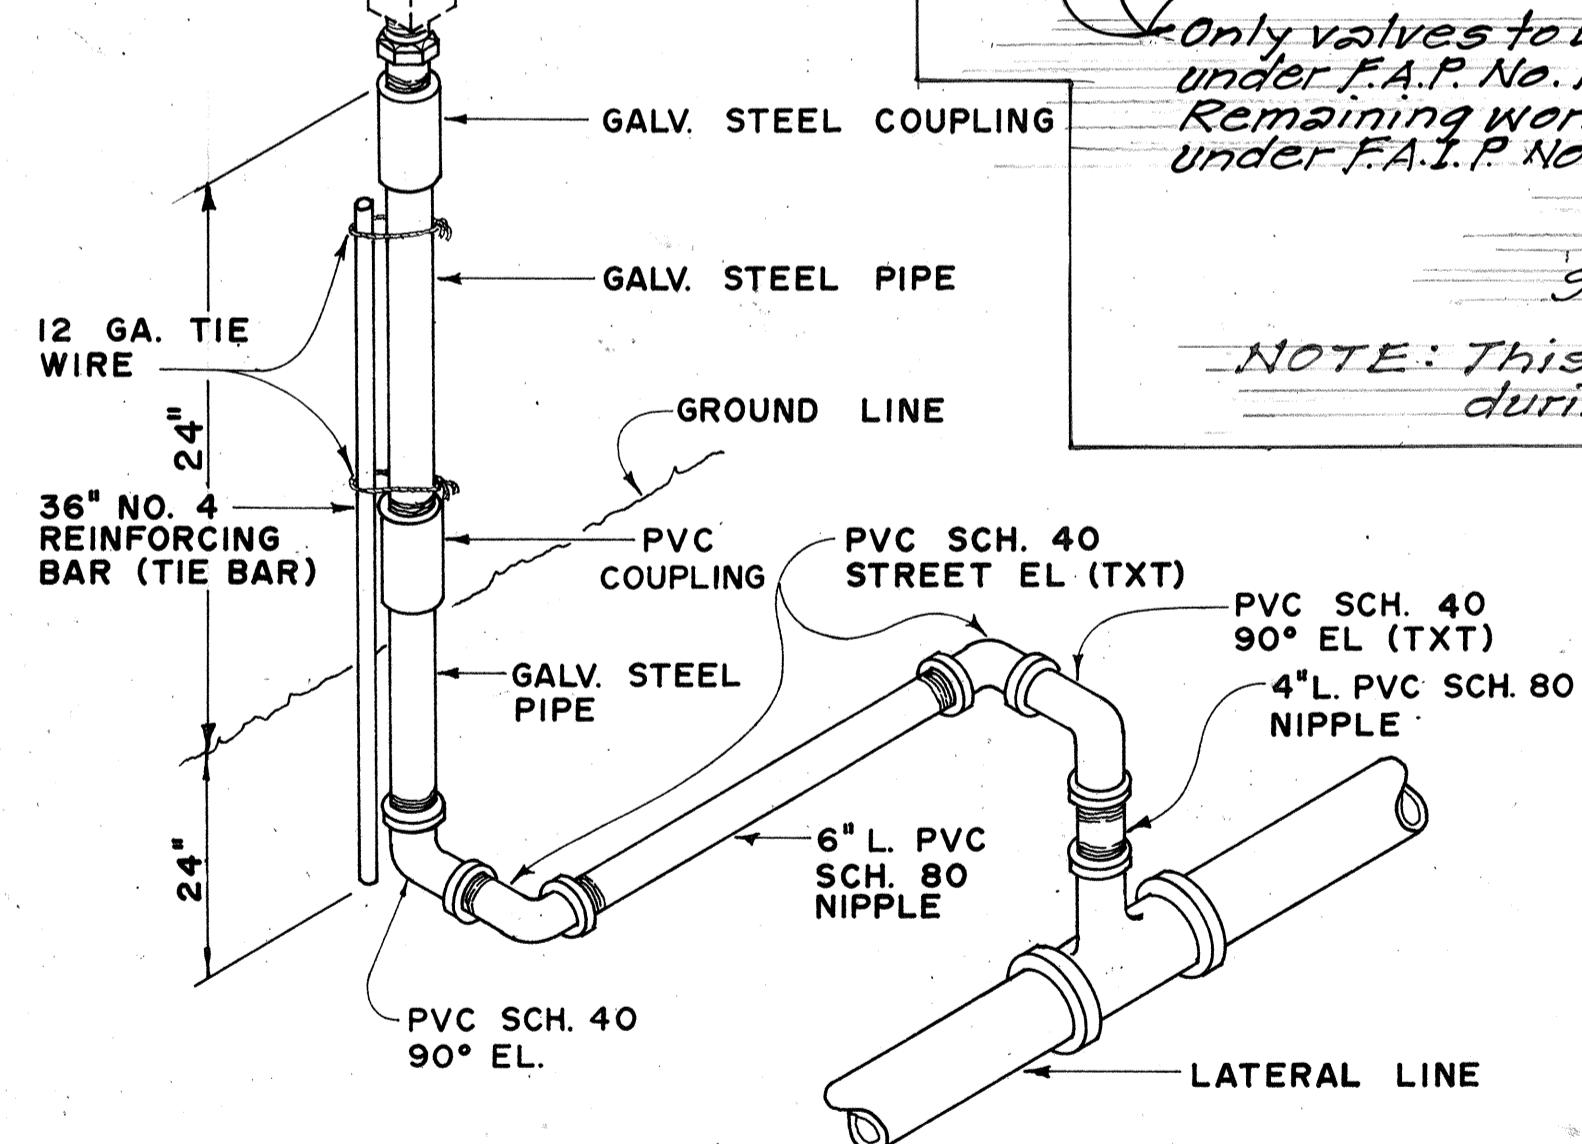

DETAIL OF SPRINKLER HEAD ON RISER

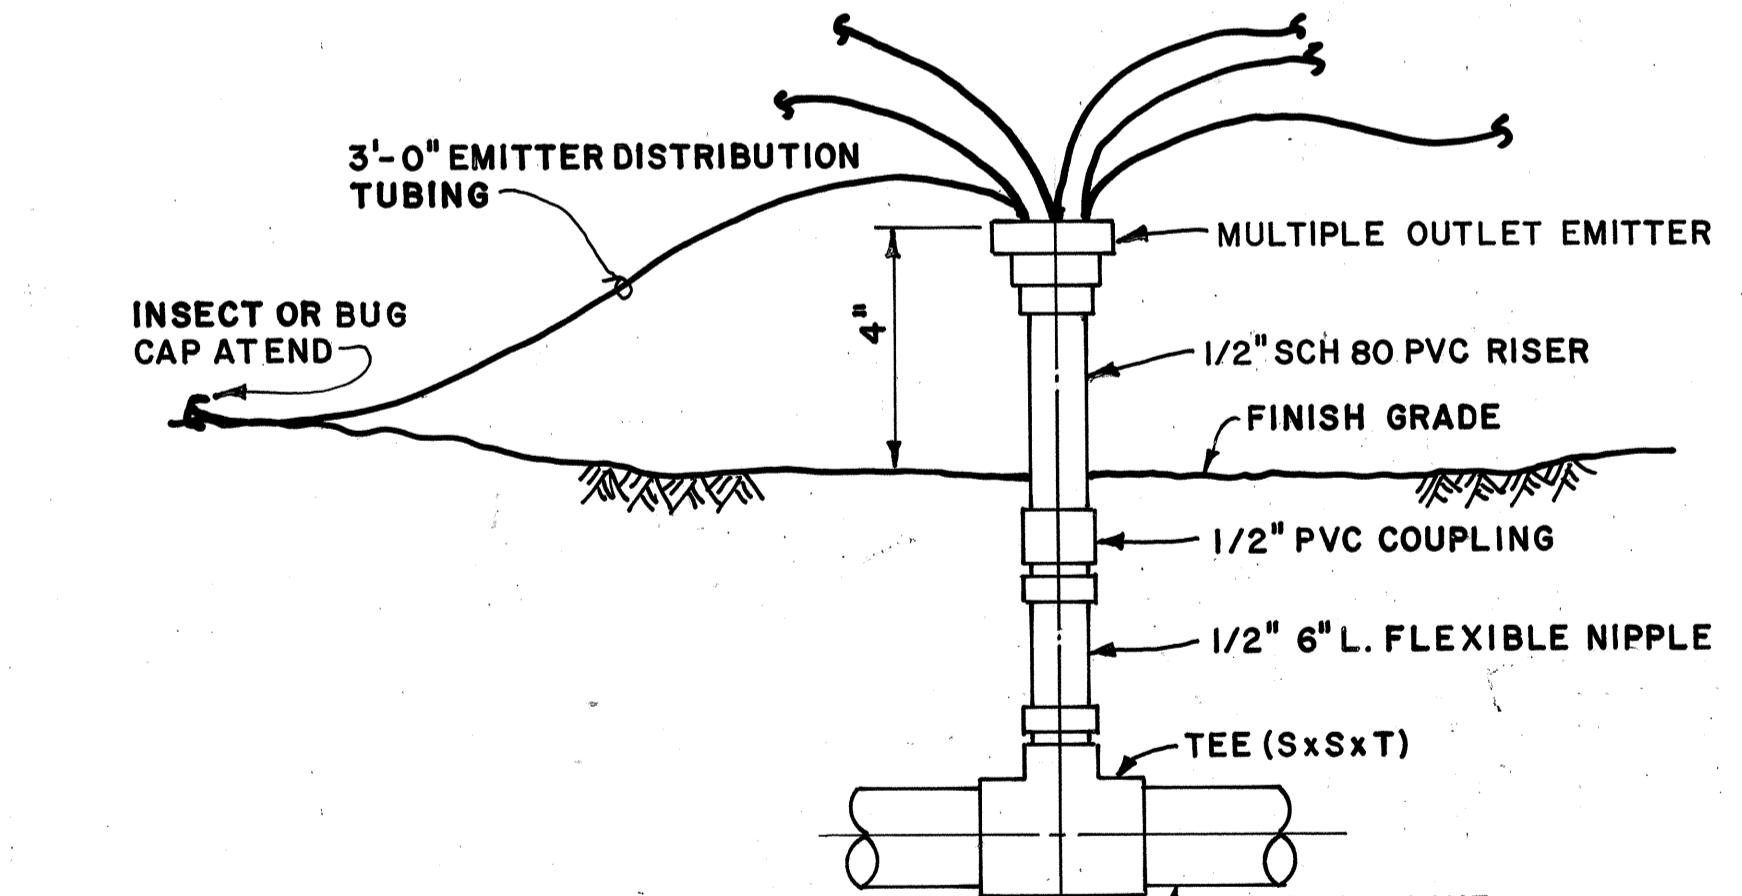

EMITTER (MULTIPLE OUTLET) DETAIL

PERSPECTIVE  
IMPACT SPRINKLER DETAIL

11/30/89 Additional sheet to show Sprinkler Plan and Details.


DATE

REVISION


|   |                |
|---|----------------|
| STATE OF HAWAII<br>DEPARTMENT OF TRANSPORTATION<br>HIGHWAYS DIVISION                        |                |
| <b>SPRINKLER DETAILS</b>  |                |
| INTERSTATE ROUTE H-I IMPROVEMENTS<br>MIDDLE STREET TO KALIHI INTERCHANGE<br>WESTBOUND LANES |                |
| F.A.I. PROJ. NO. I-HI-1(187)  |                |
| NOT TO SCALE  | DATE: NOV 1983 |
| SHEET NO. 31A-10 OF 30 SHEETS   |                |

ADD.79 S-1

| FED. ROAD DIST. NO. | STATE | FED. AID PROJ. NO. | FISCAL YEAR | SHEET NO. | TOTAL SHEETS |
|---------------------|-------|--------------------|-------------|-----------|--------------|
| HAWAII              | HAW.  | I-H1-1(181)        | 1984        | 80        | 101          |




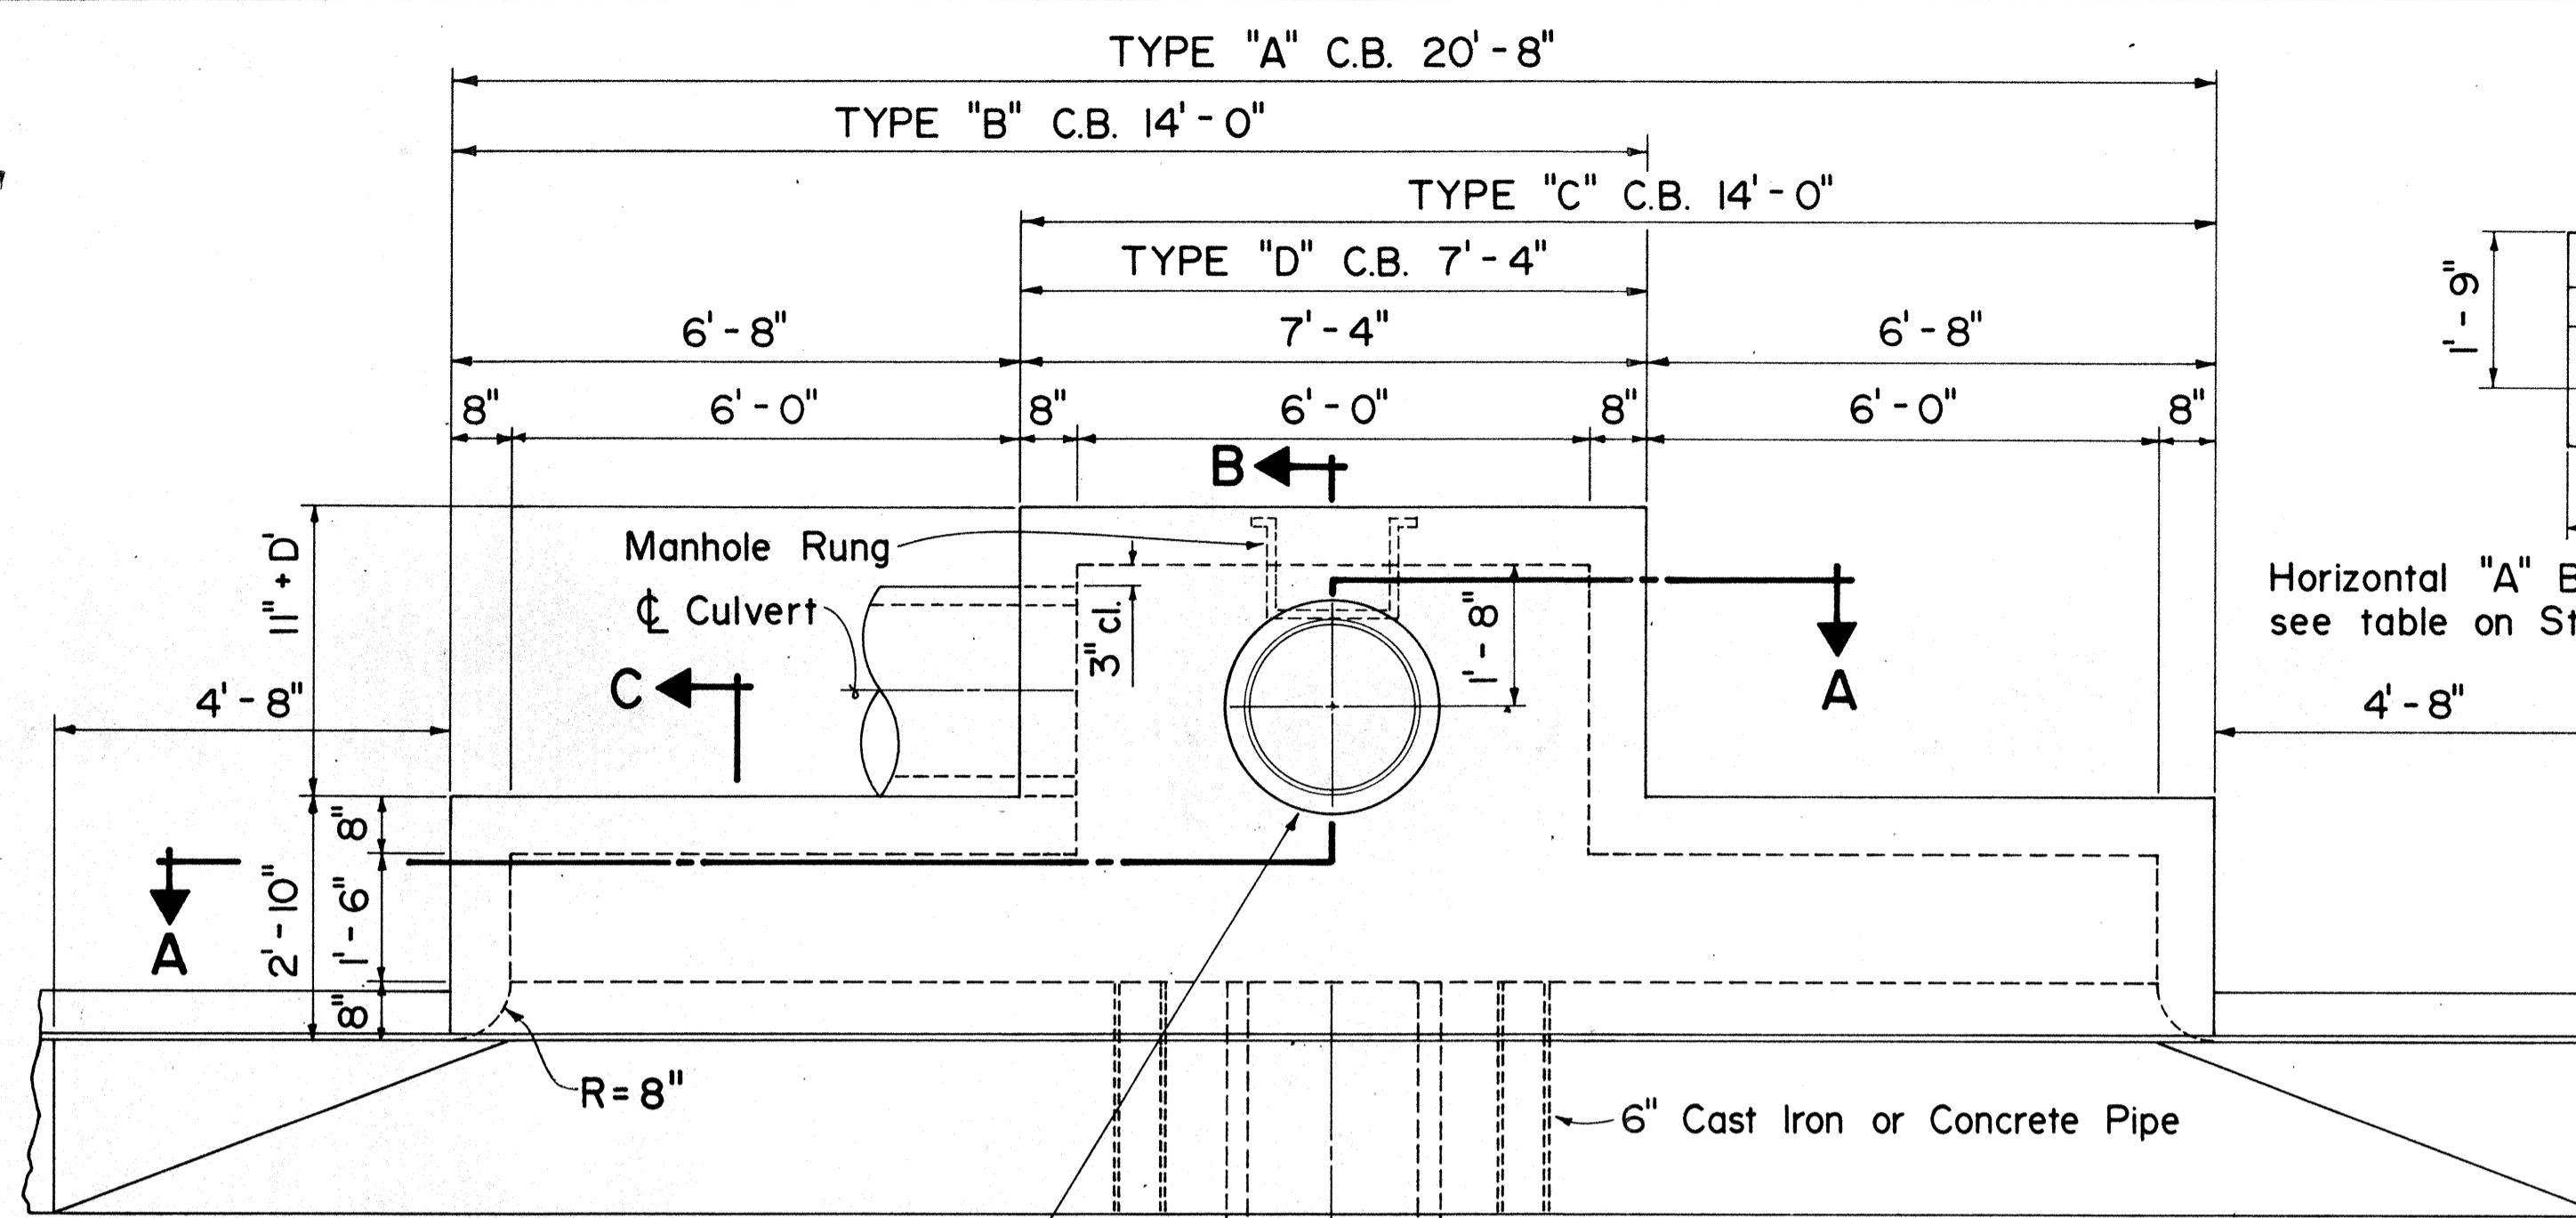


Opening for Type "B" Cast Iron Frame and Cover. For added reinforcing around hole see Standard Details sheet DH 4

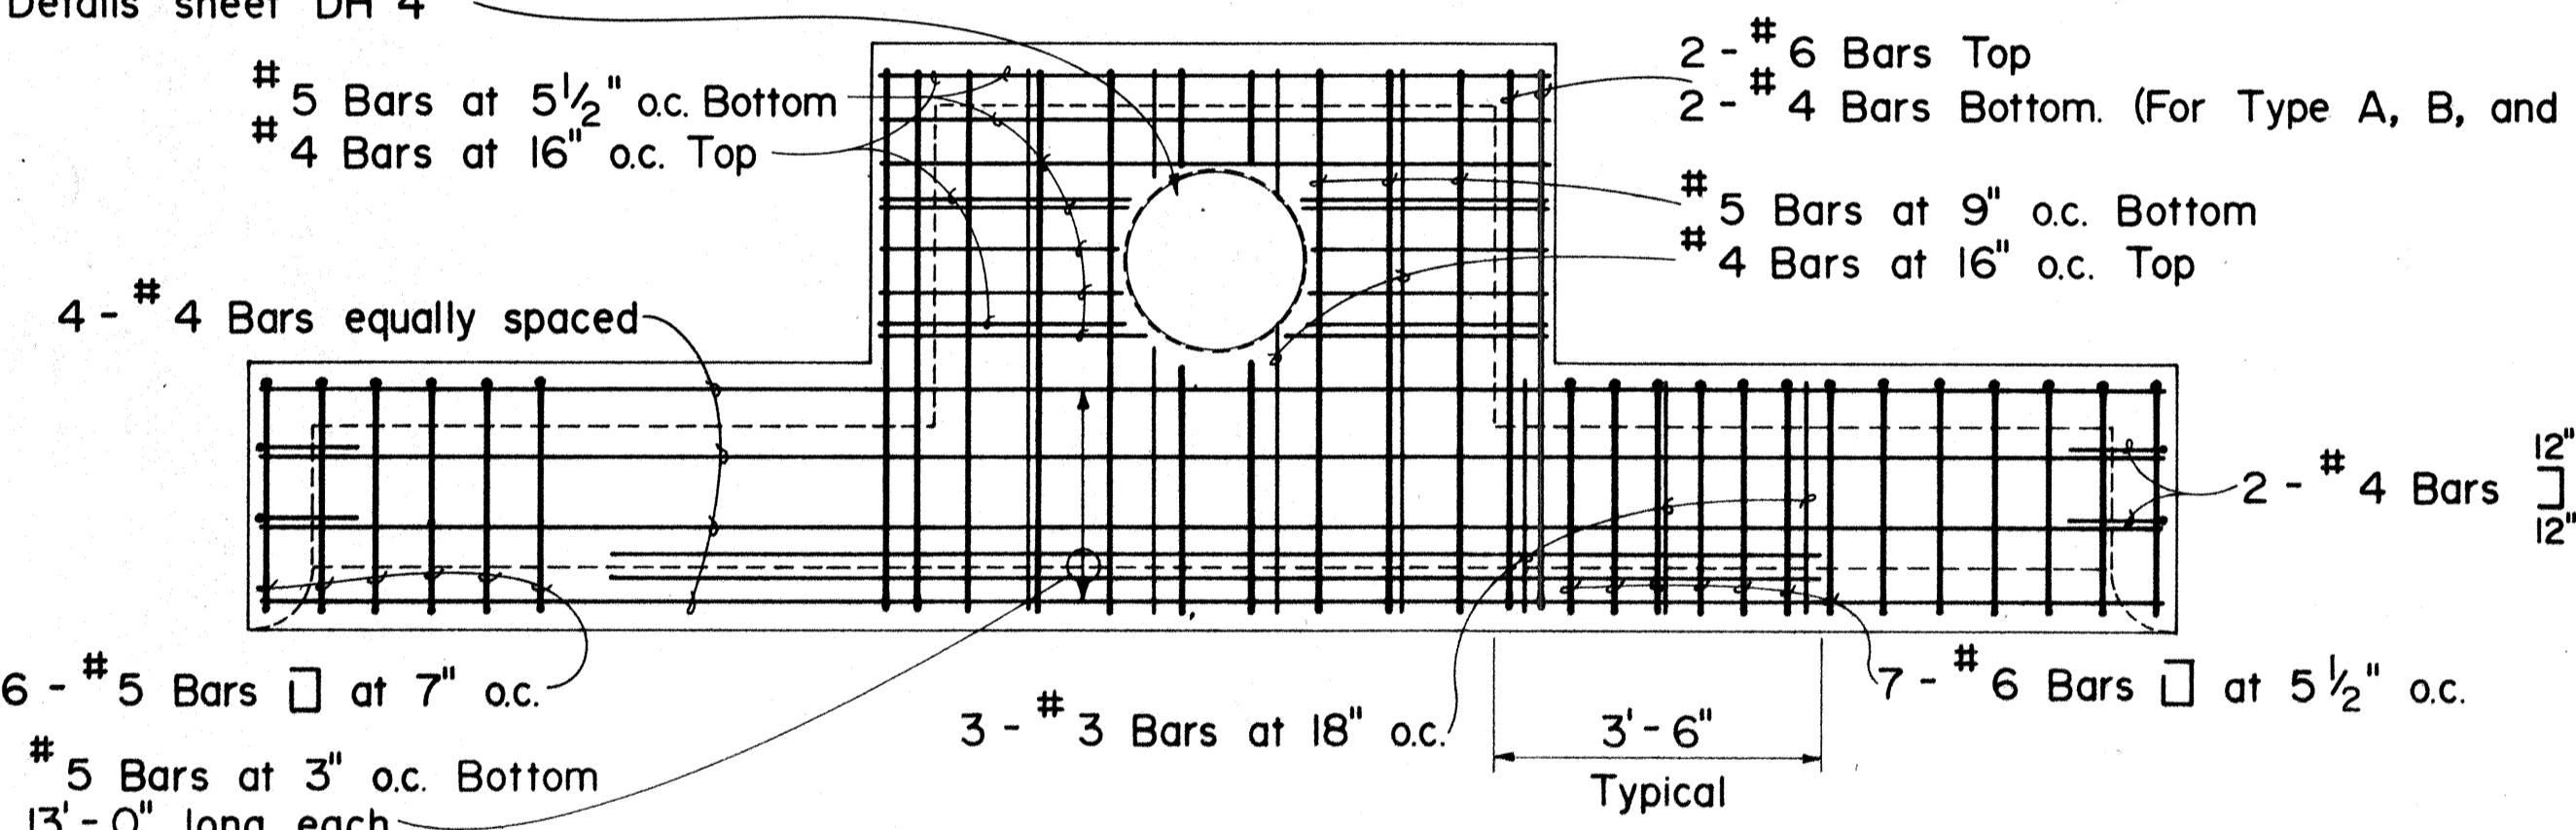

PLAN VIEW OF REINFORCING STEEL

### TYPE "A", "B", "C" & "D" CATCH BASIN

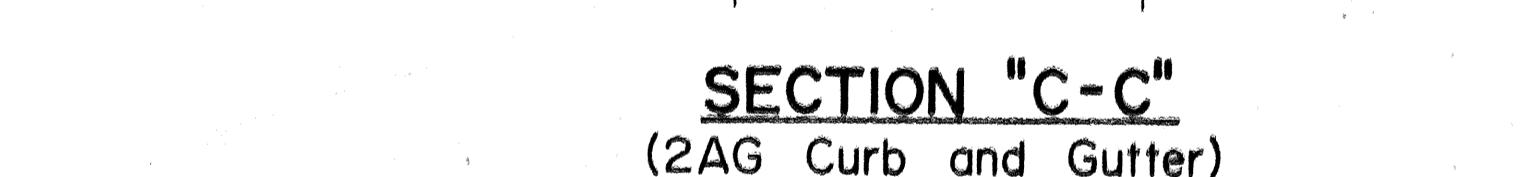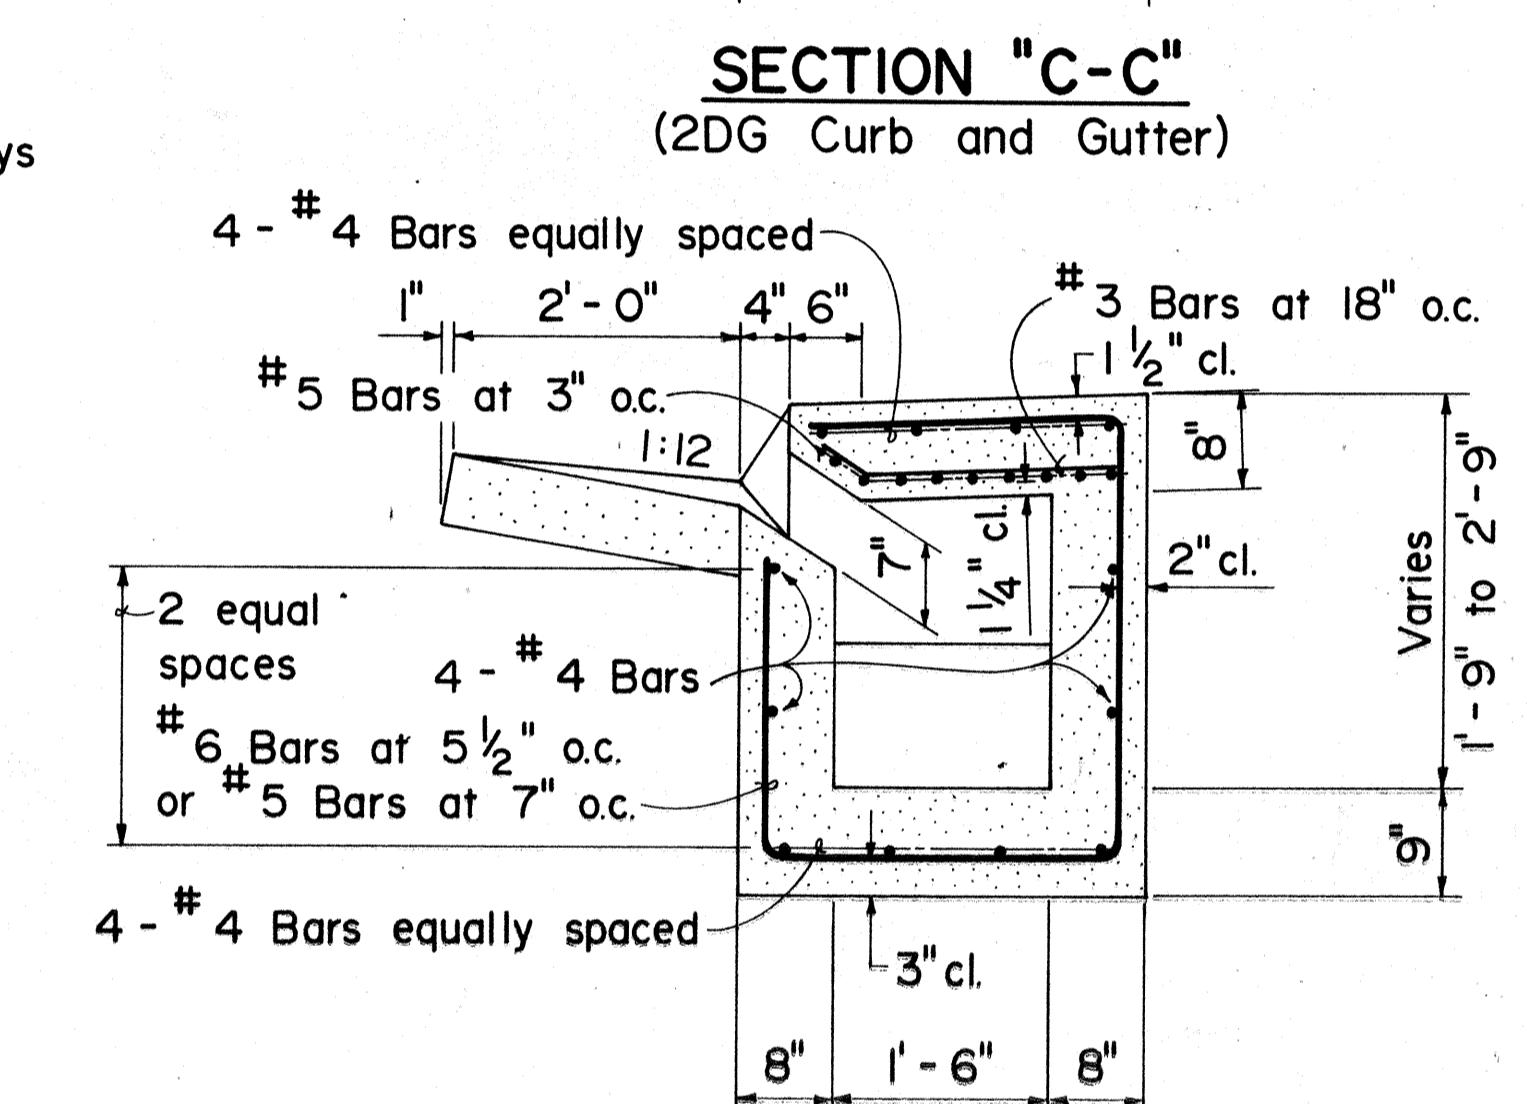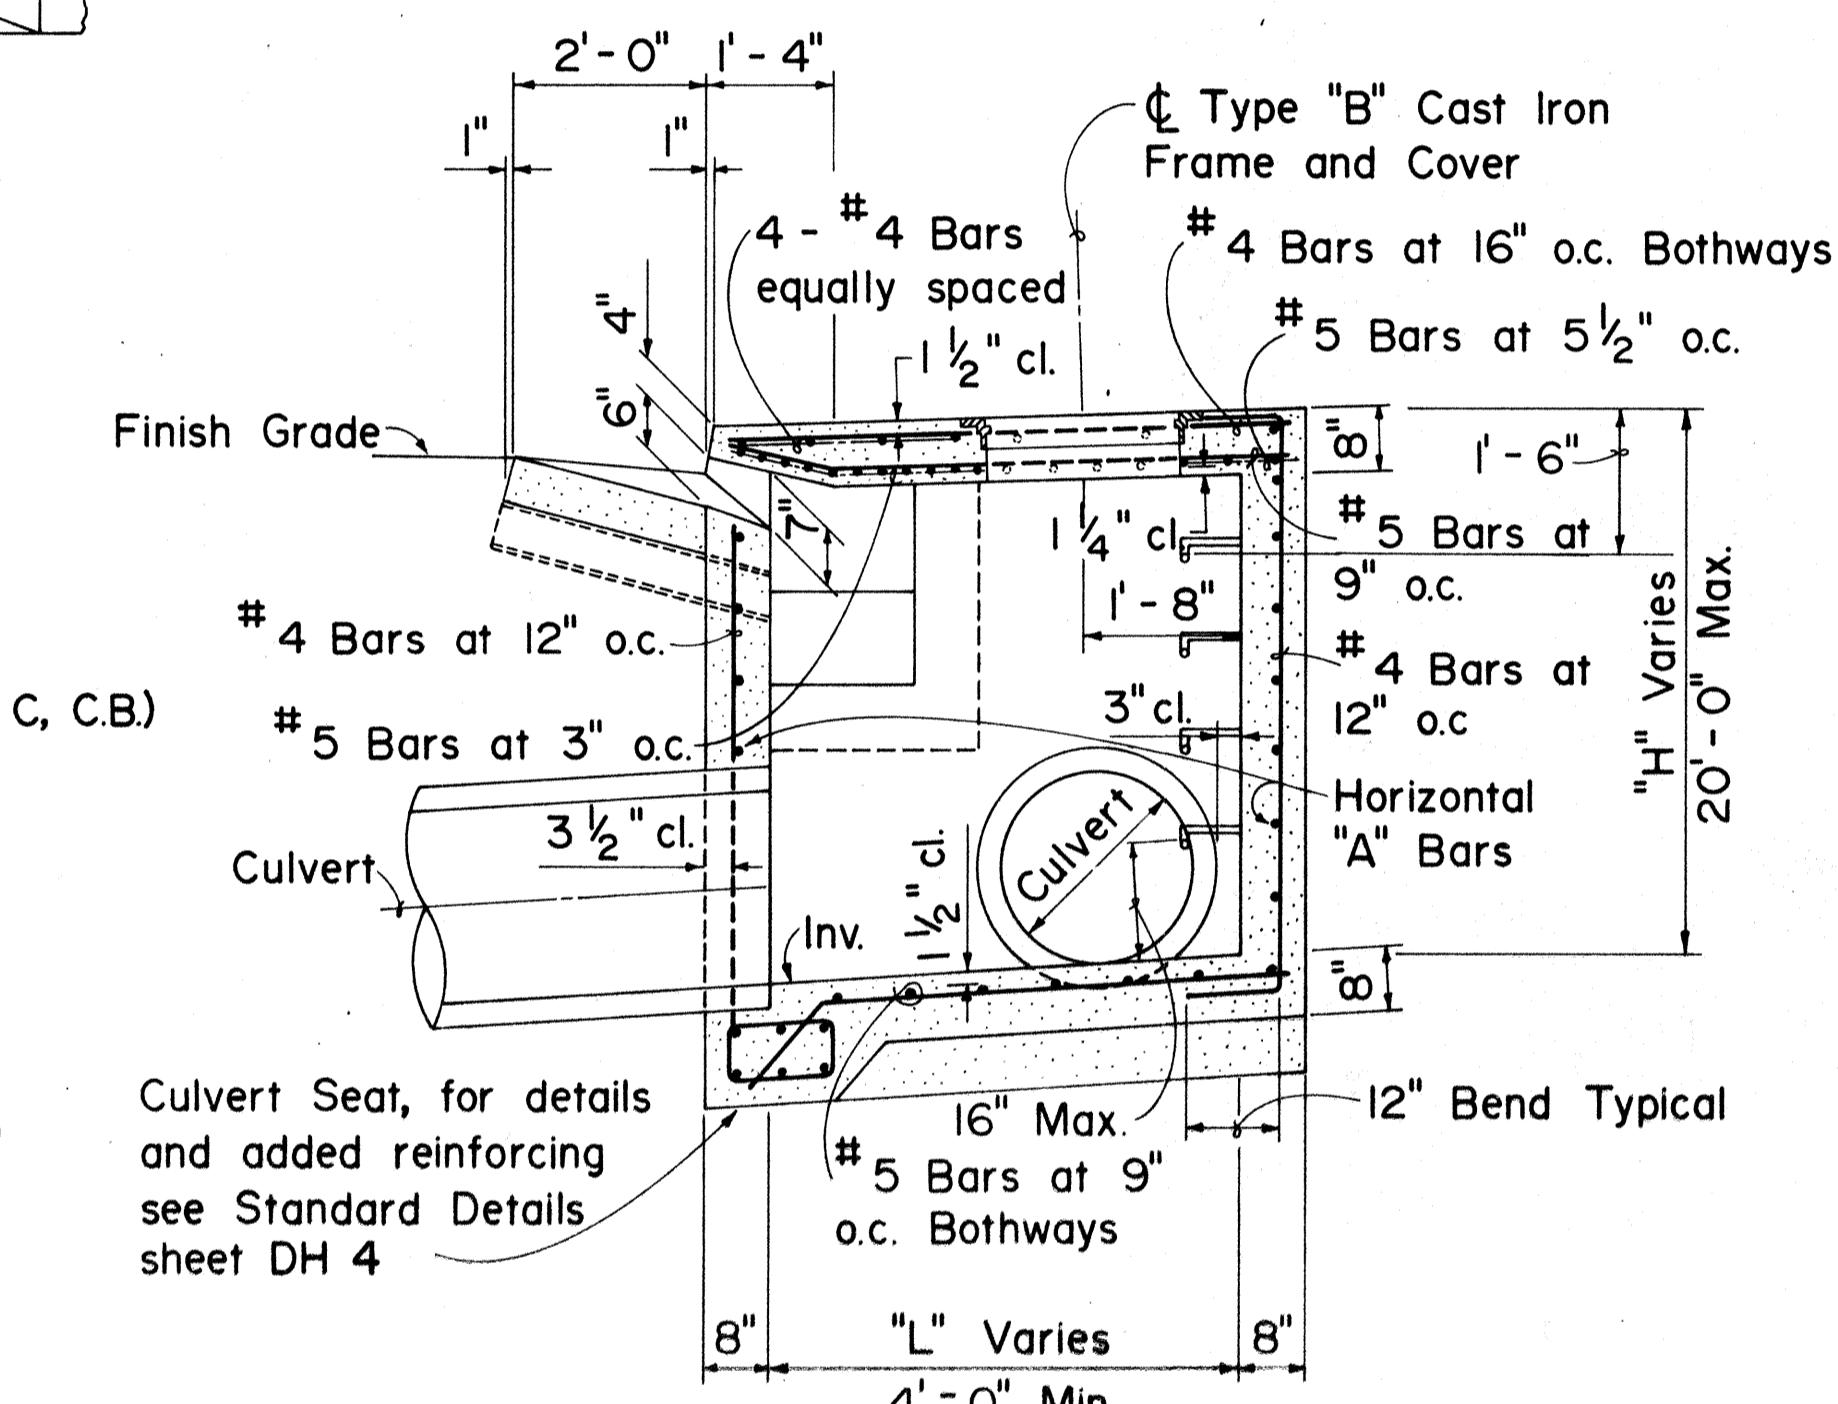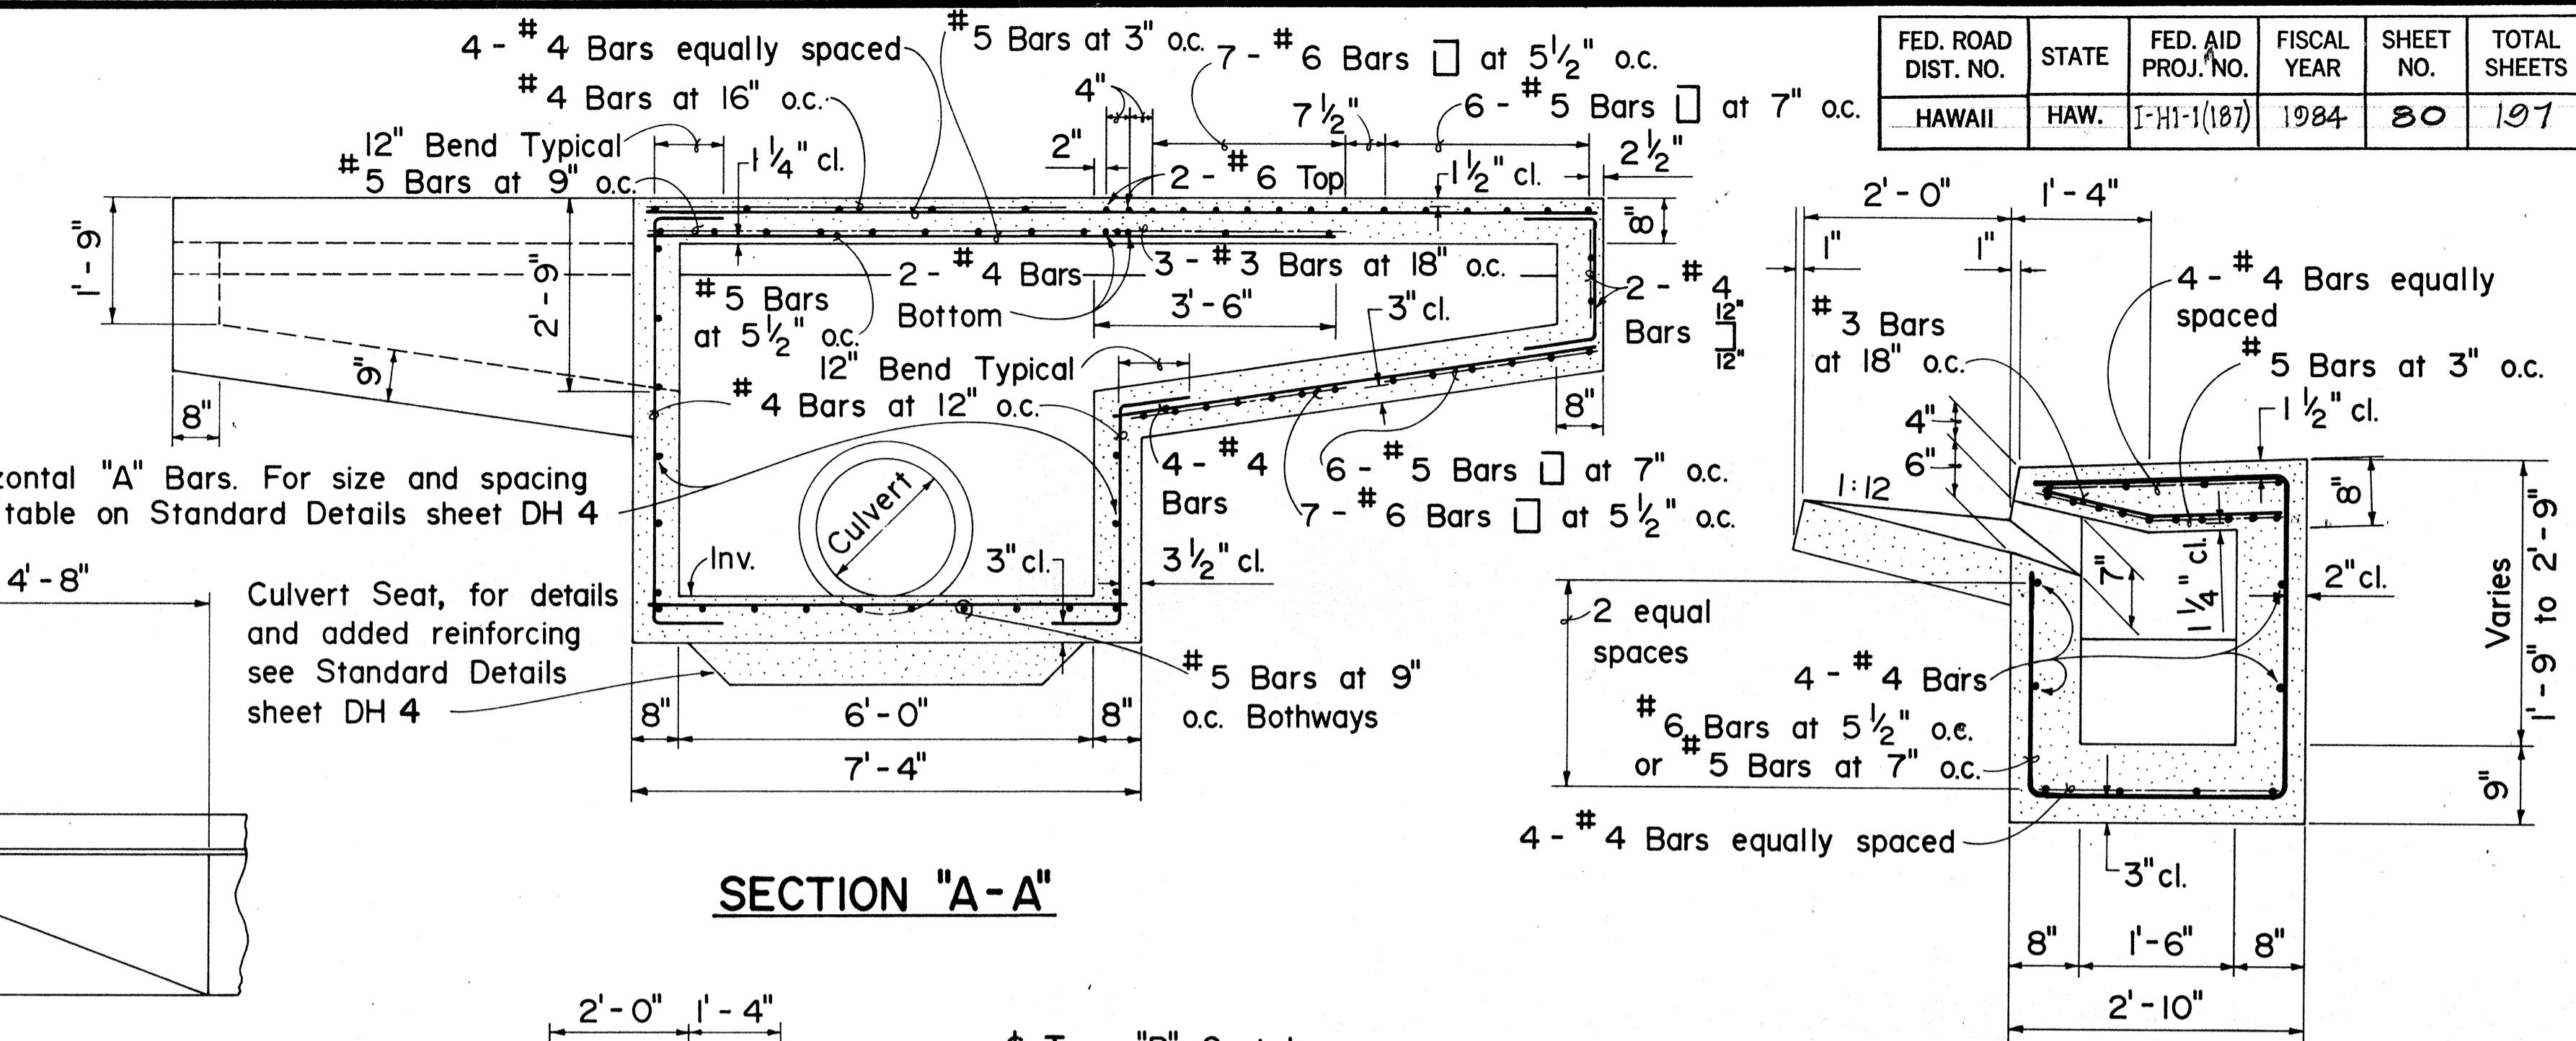

APPROVAL RECOMMENDED:

*John M. de*  
HYDRAULIC DESIGN ENGINEER

12/3/80  
DATE

APPROVED:

*Robert Zaleski*  
ASSISTANT CHIEF, ENGINEERING

12/4/80  
DATE

| NO. | REVISION                               | APPROVED BY | DATE    |
|-----|--|-------------|---------|
| I   | Supersedes Sht. DH 1 approved 12/17/69 | N.R.        | 12/4/80 |

STATE OF HAWAII  
DEPARTMENT OF TRANSPORTATION  
HIGHWAYS DIVISION



STANDARD DETAILS

TYPE A, B, C, & D  
CATCH BASIN


Not To Scale Date: Dec. 1980

SHEET NO. 32 OF 30 SHEETS DH 1




| FED. ROAD<br>DIST. NO. | STATE | FED. AID<br>PROJ. NO. | FISCAL<br>YEAR | SHEET<br>NO. | TOTAL<br>SHEETS |
|------------------------|-------|-----------------------|----------------|--------------|-----------------|
| HAWAII                 | HAW.  | I-H1-1(107)           | 1984           | 81           | 107             |

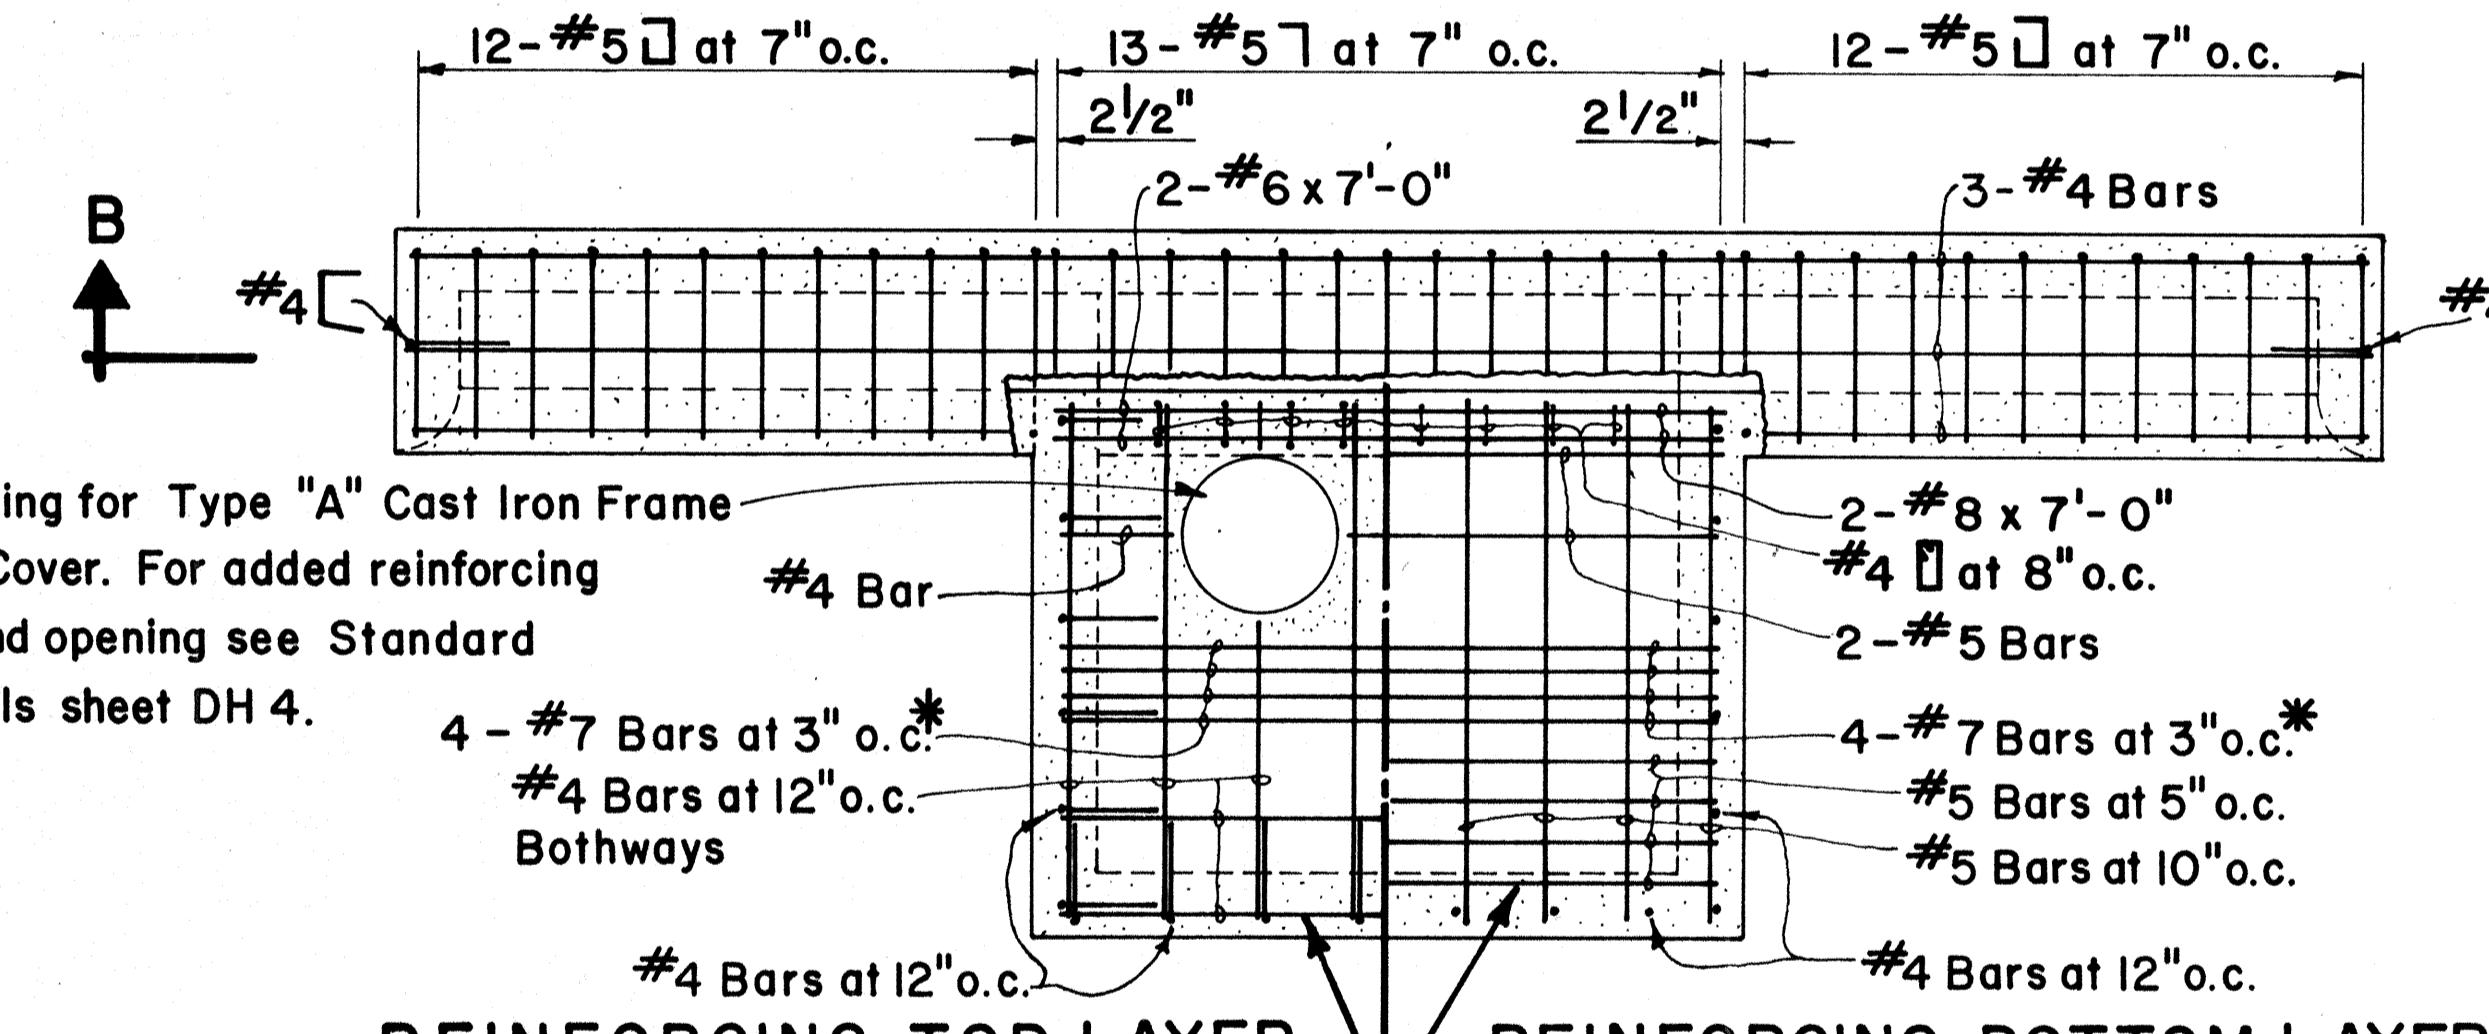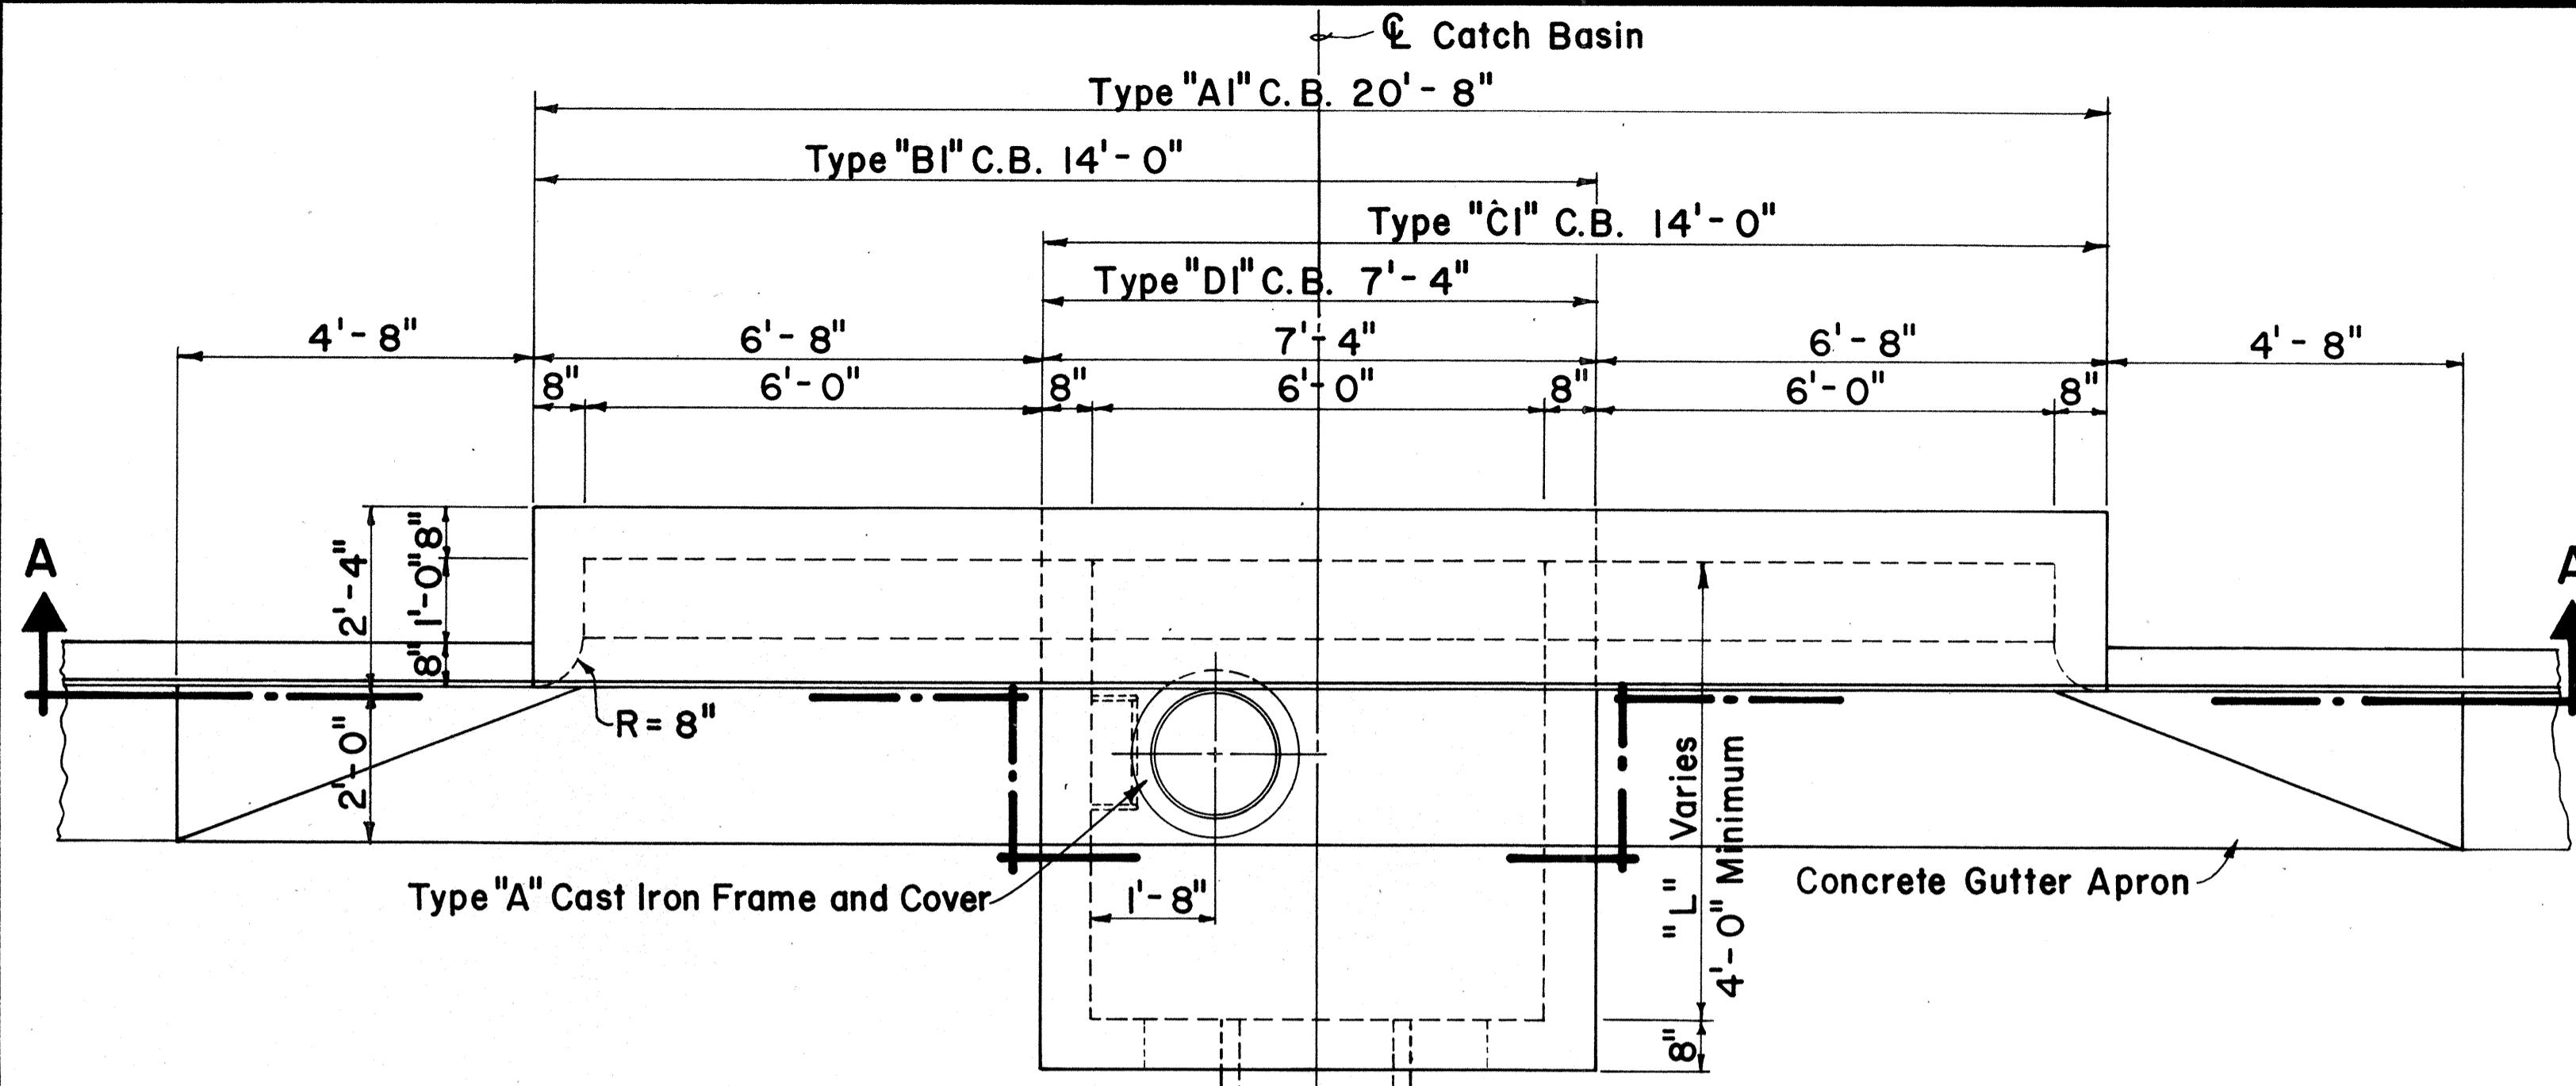

PLAN VIEW OF REINFORCING STEEL

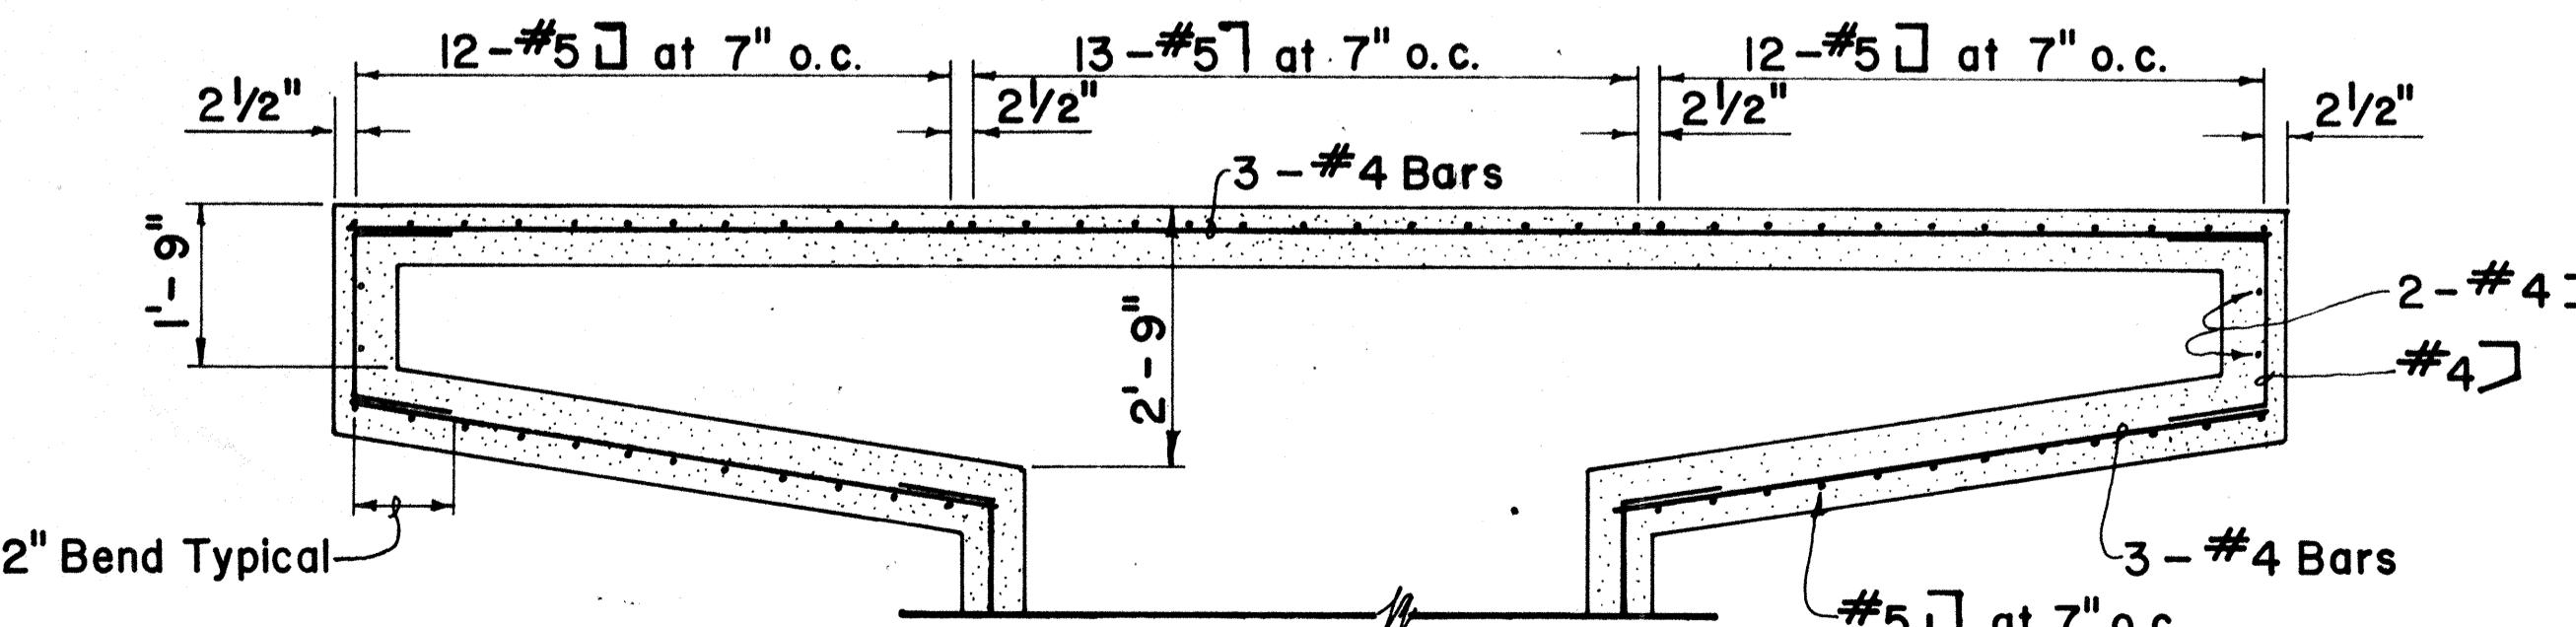

TYPE "AI", "BI", "CI" & "DI" CATCH BASIN

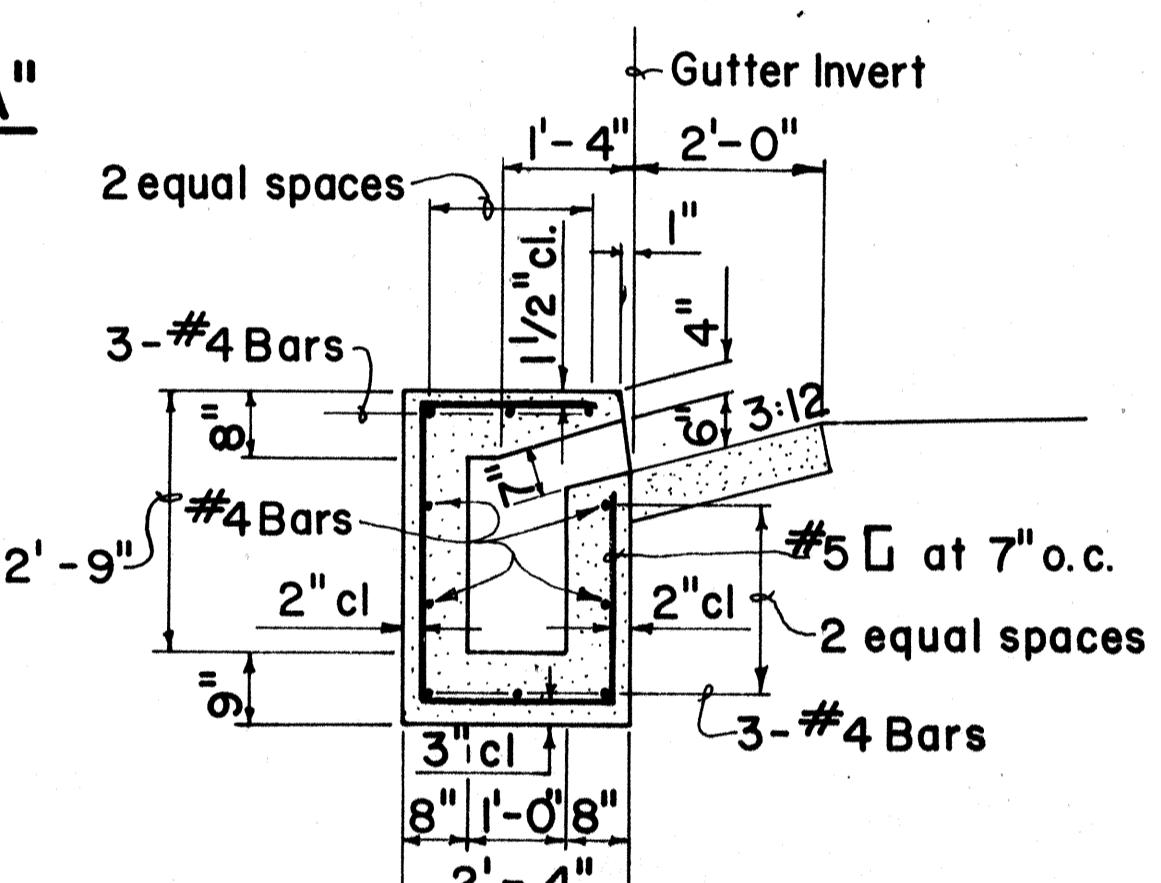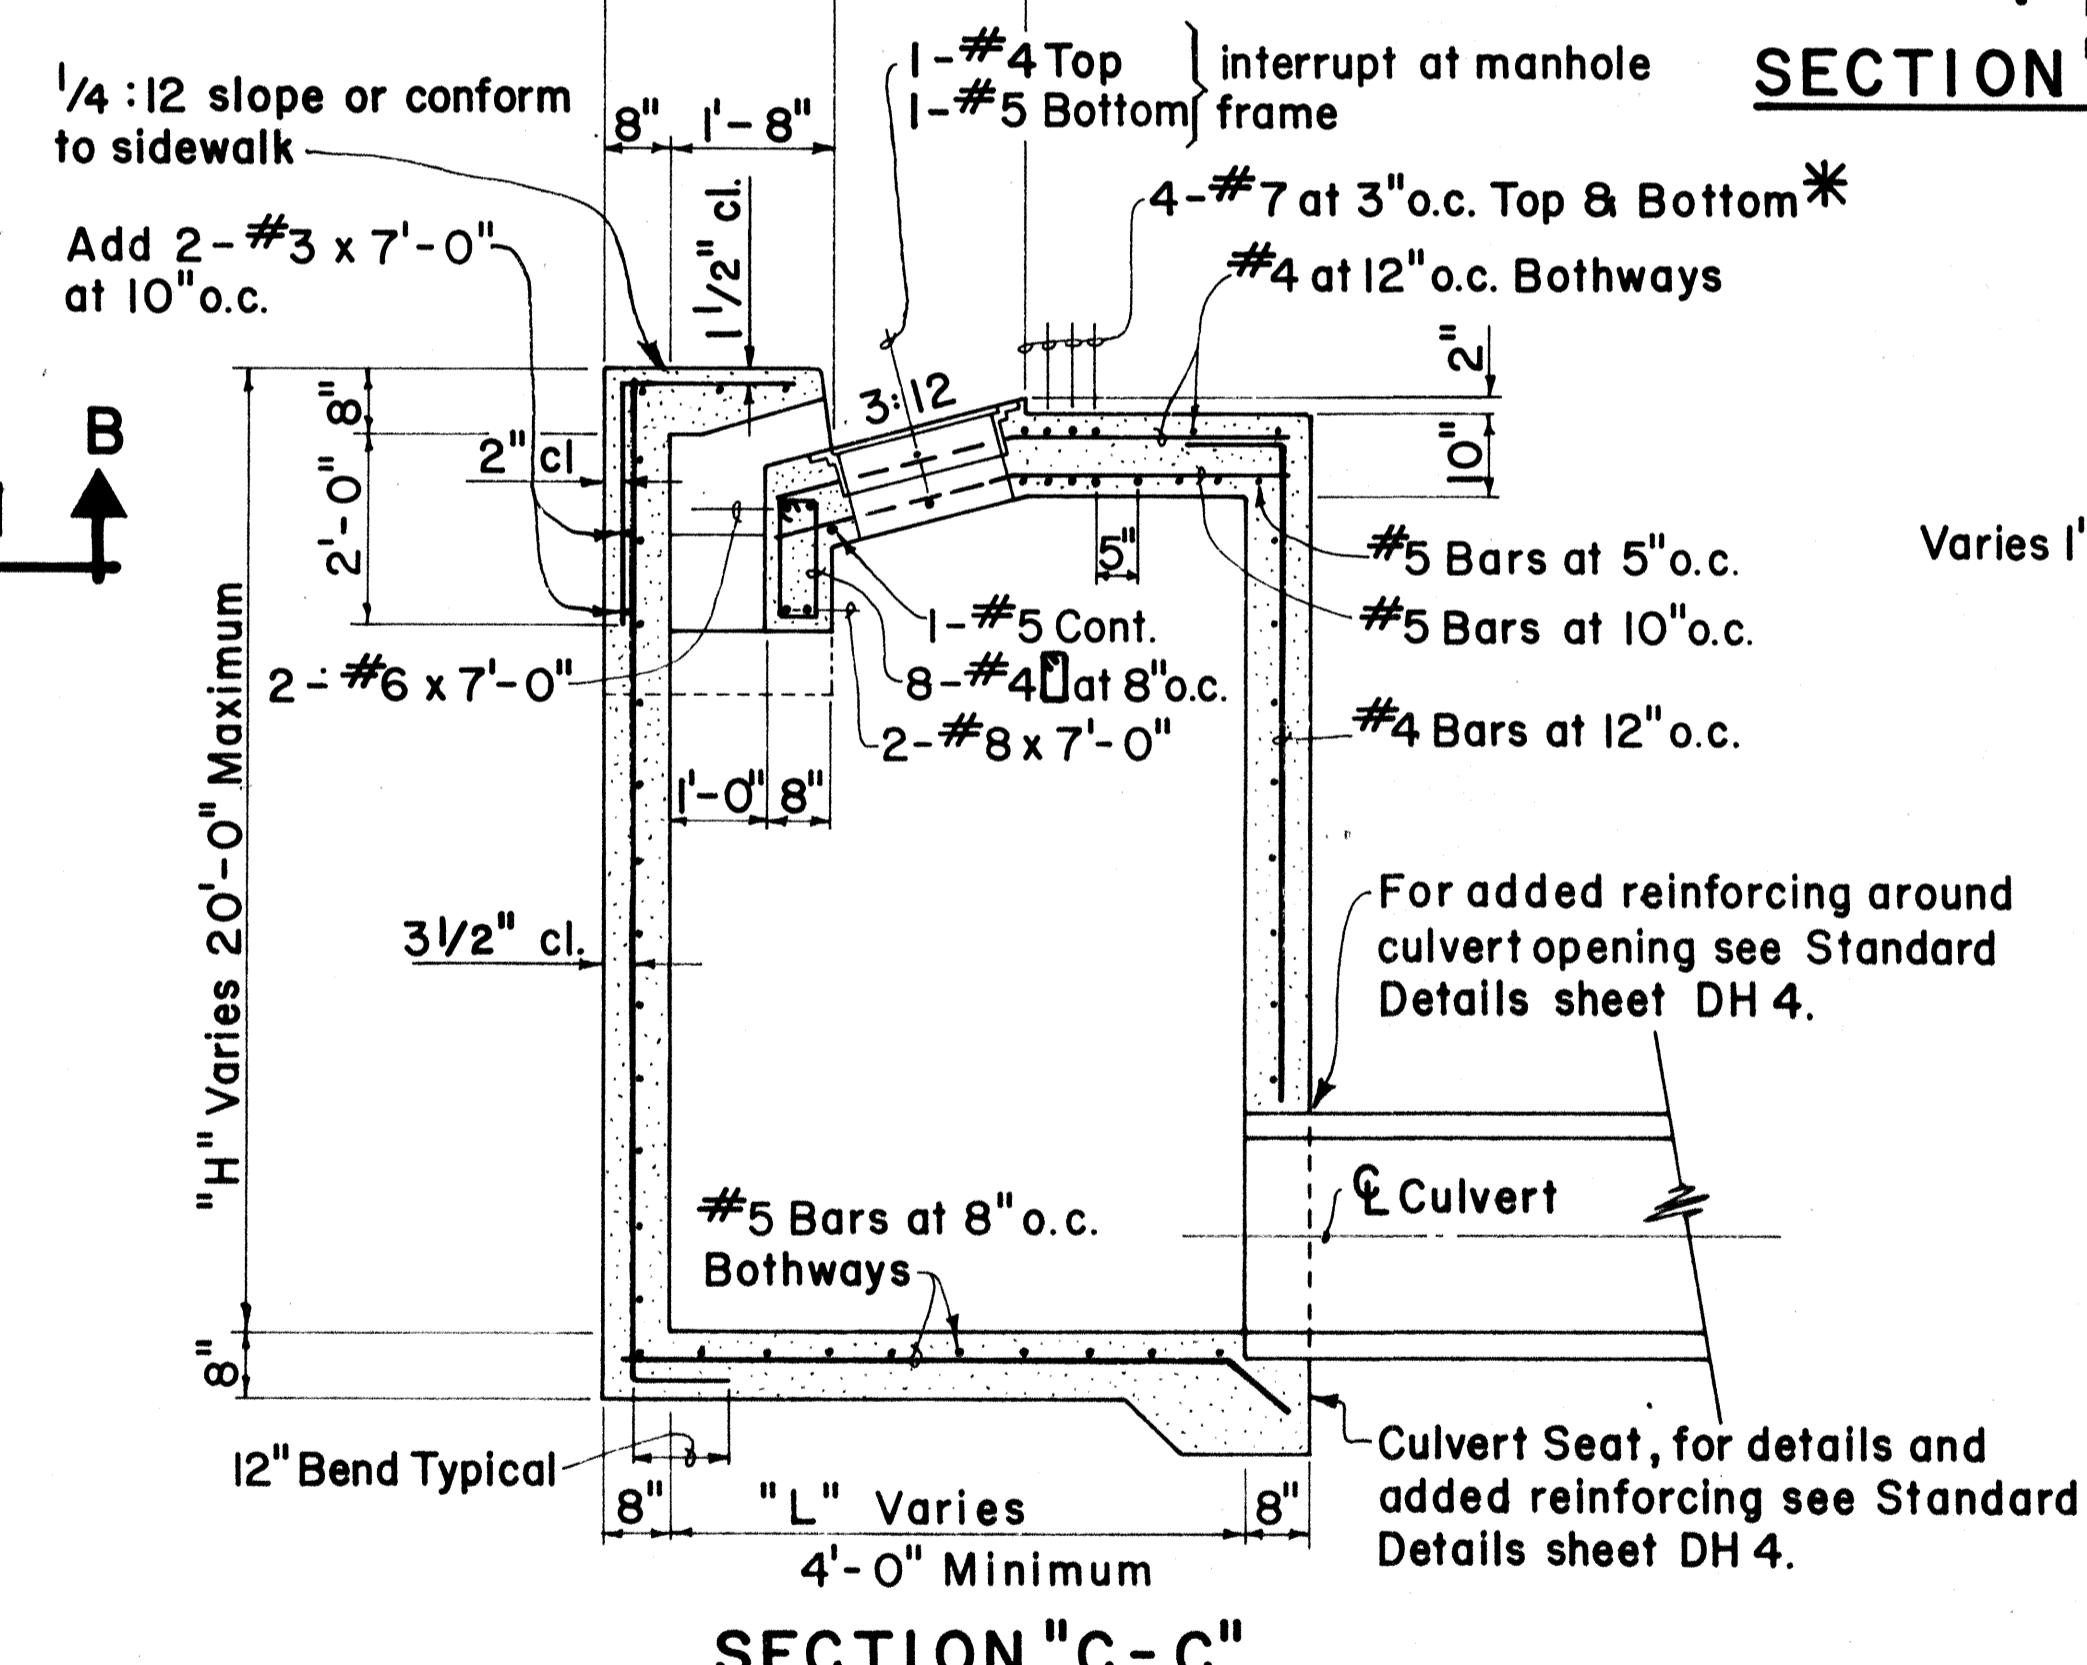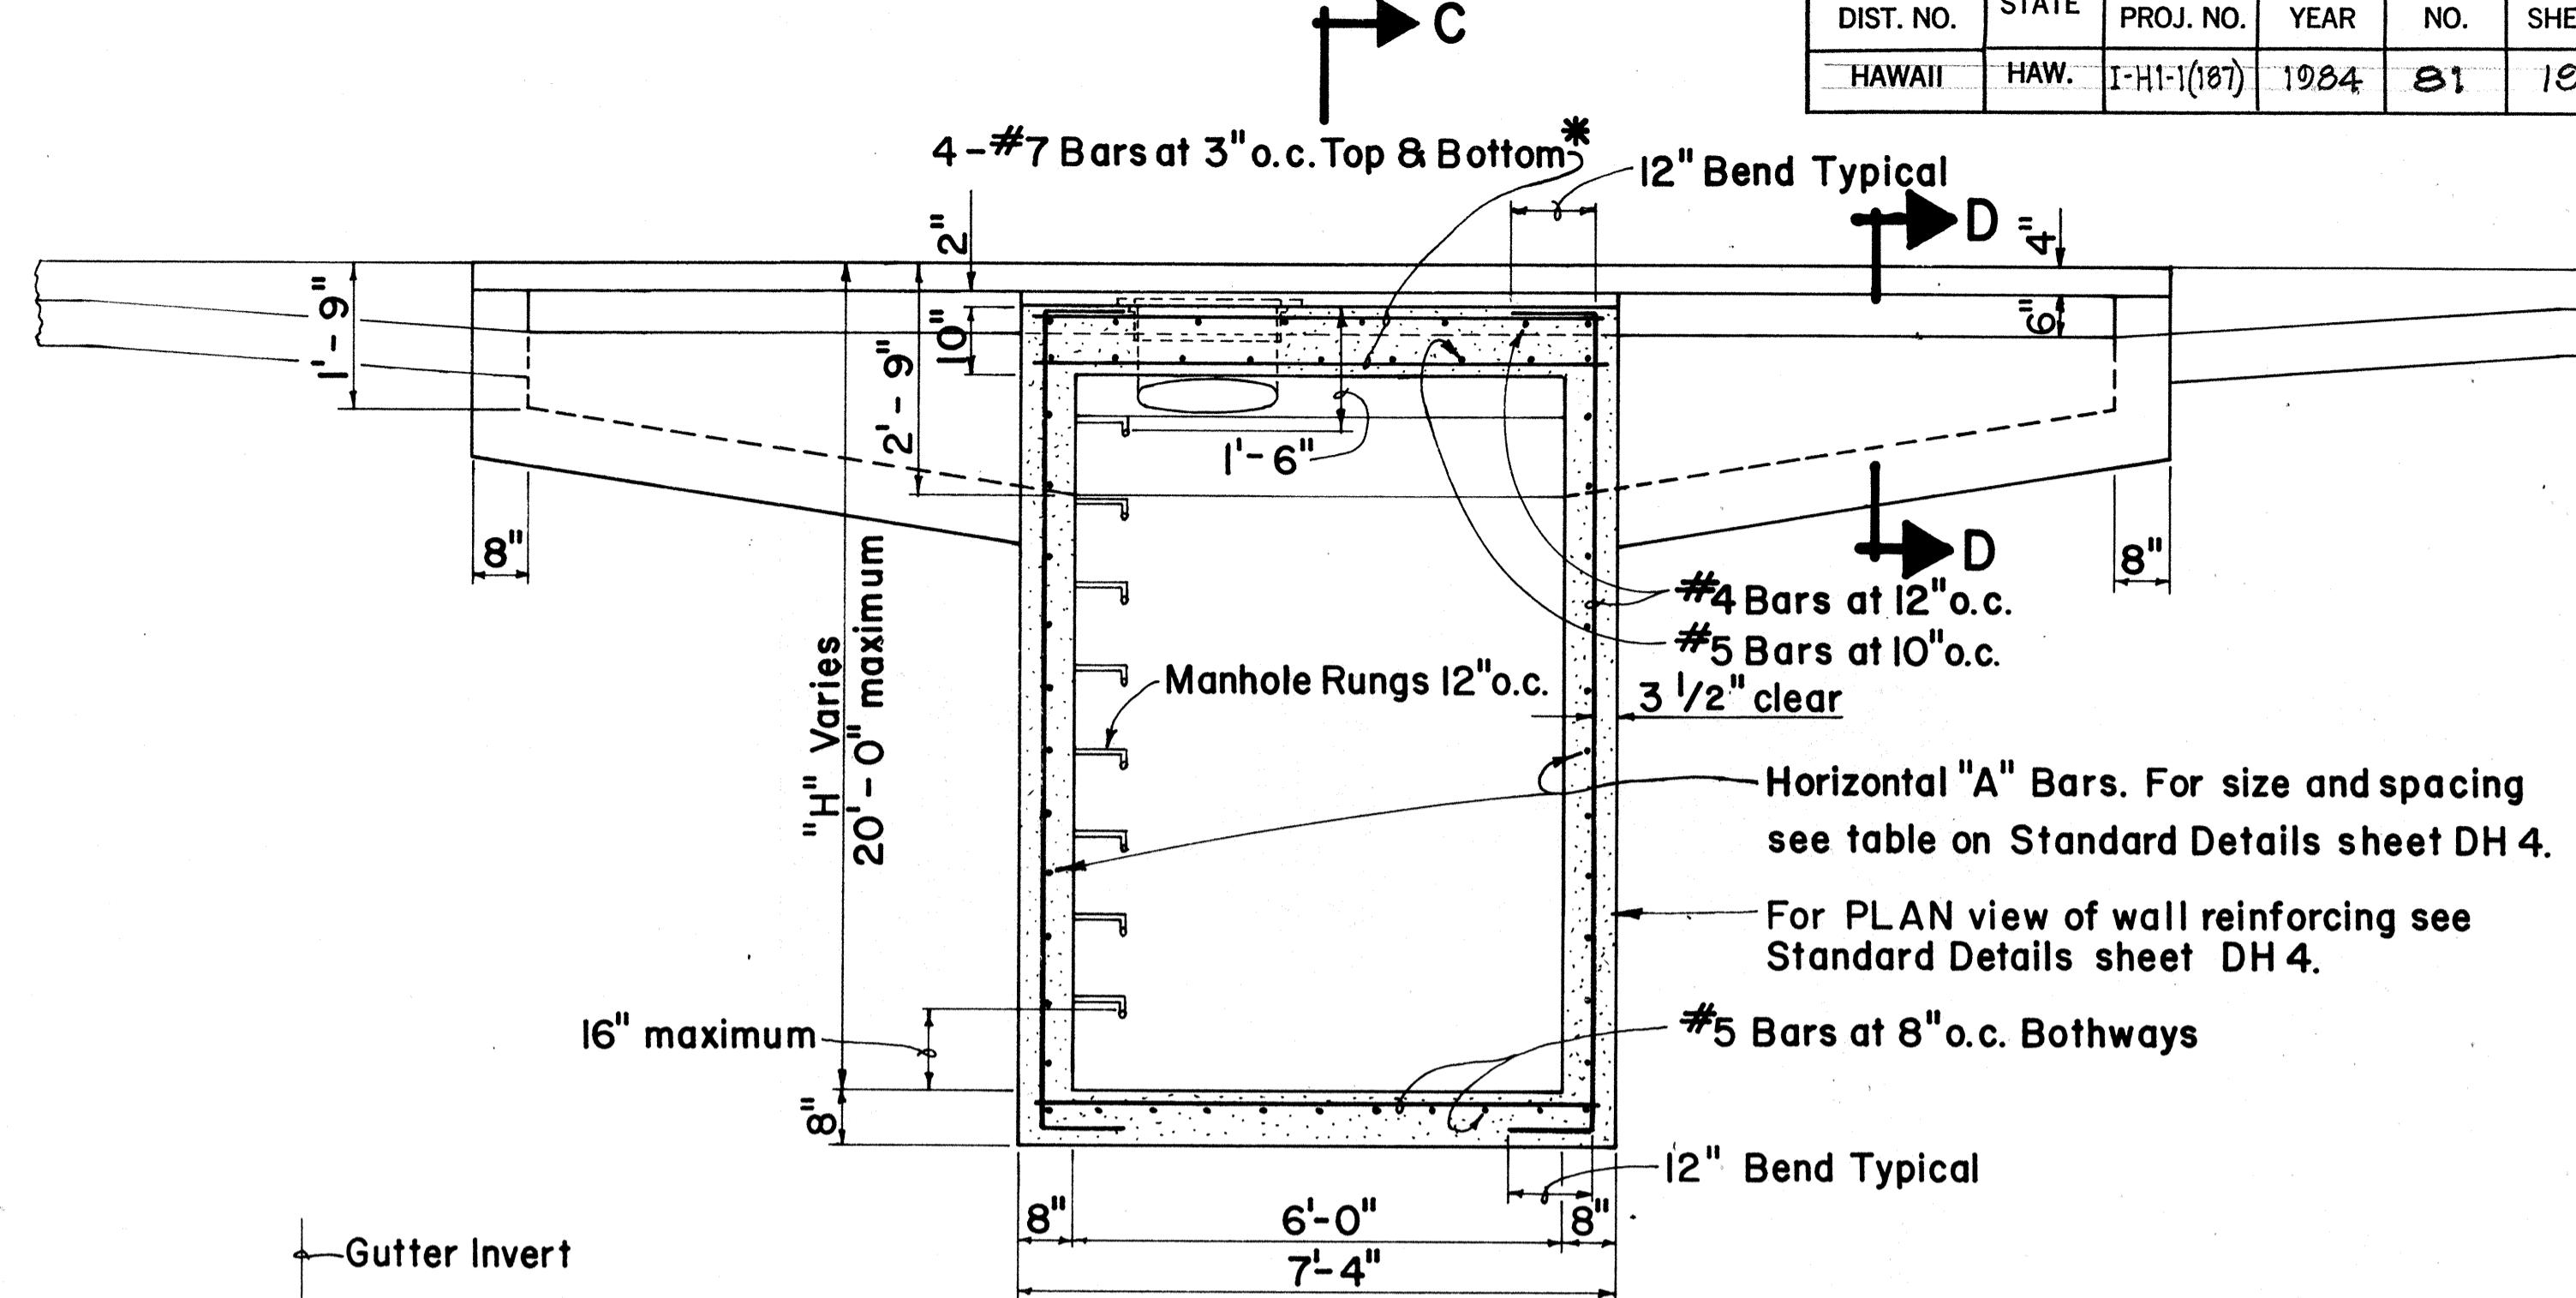

APPROVAL RECOMMENDED:

*John M. Le*  
HYDRAULIC DESIGN ENGINEER

12/3/80

DATE

APPROVED:

*Robert Z. Kishi*  
ASSISTANT CHIEF, ENGINEERING

12/4/80

DATE

\*Replace these bars with #4 Bars at 12" o.c. Top and #5 Bars at 5" o.c. Bottom for "L" less than 5'-0".

| NO. | REVISION  | APPROVED BY | DATE    |
|-----|---|-------------|---------|
| I.  | Supersedes Sht. DH 3 approved 12-17-69 and replaces Sht. DH2 approved 12-17-69. | H.C.        | 12/4/80 |

STATE OF HAWAII  
DEPARTMENT OF TRANSPORTATION  
HIGHWAYS DIVISION




STANDARD DETAILS

TYPE AI, BI, CI AND DI  
CATCH BASIN



Not To Scale Date: Dec. 1980

SHEET NO. 33 OF 39 SHEETS DH 2

| FED. ROAD<br>DIST. NO. | STATE | FED. AID<br>PROJ. NO. | FISCAL<br>YEAR | SHEET<br>NO. | TOTAL<br>SHEETS |
|------------------------|-------|-----------------------|----------------|--------------|-----------------|
| HAWAII                 | HAW.  | I-HI-1(187)           | 1984           | 82           | 197             |

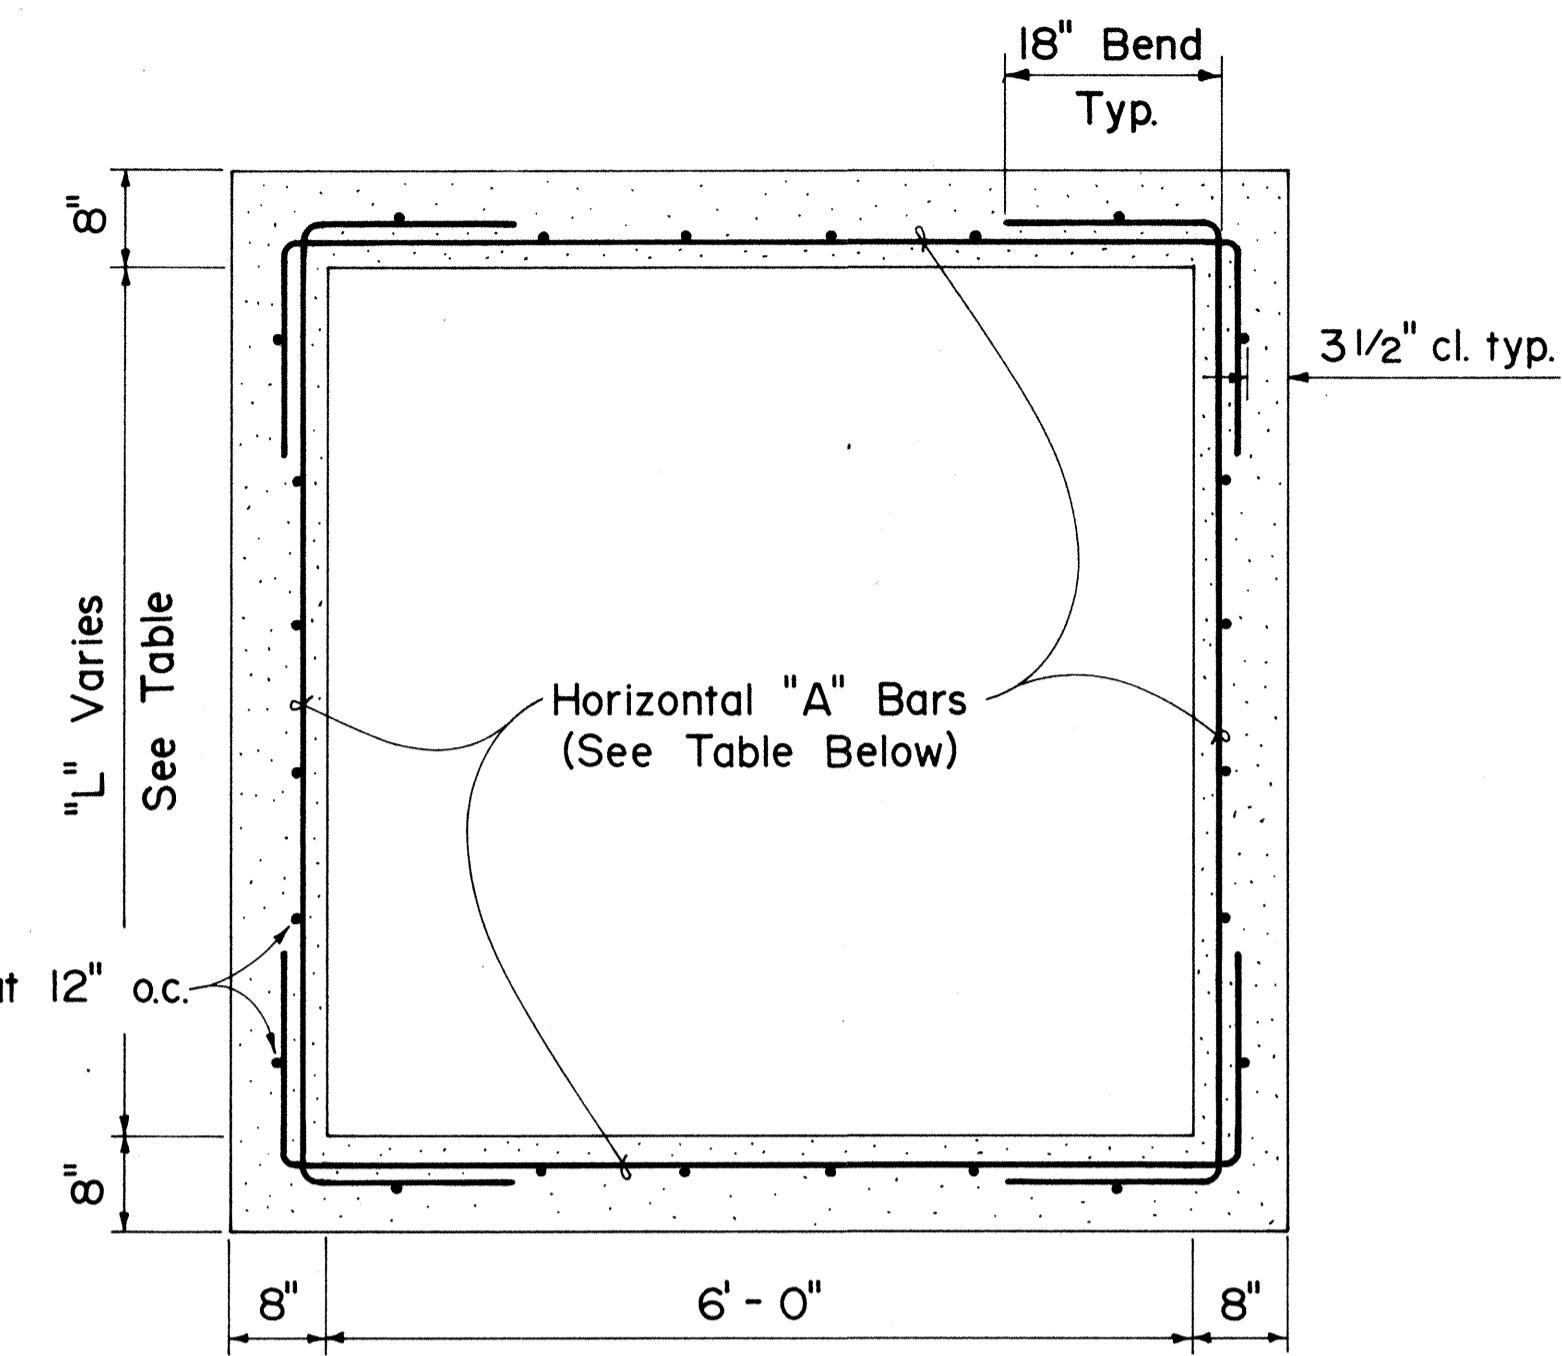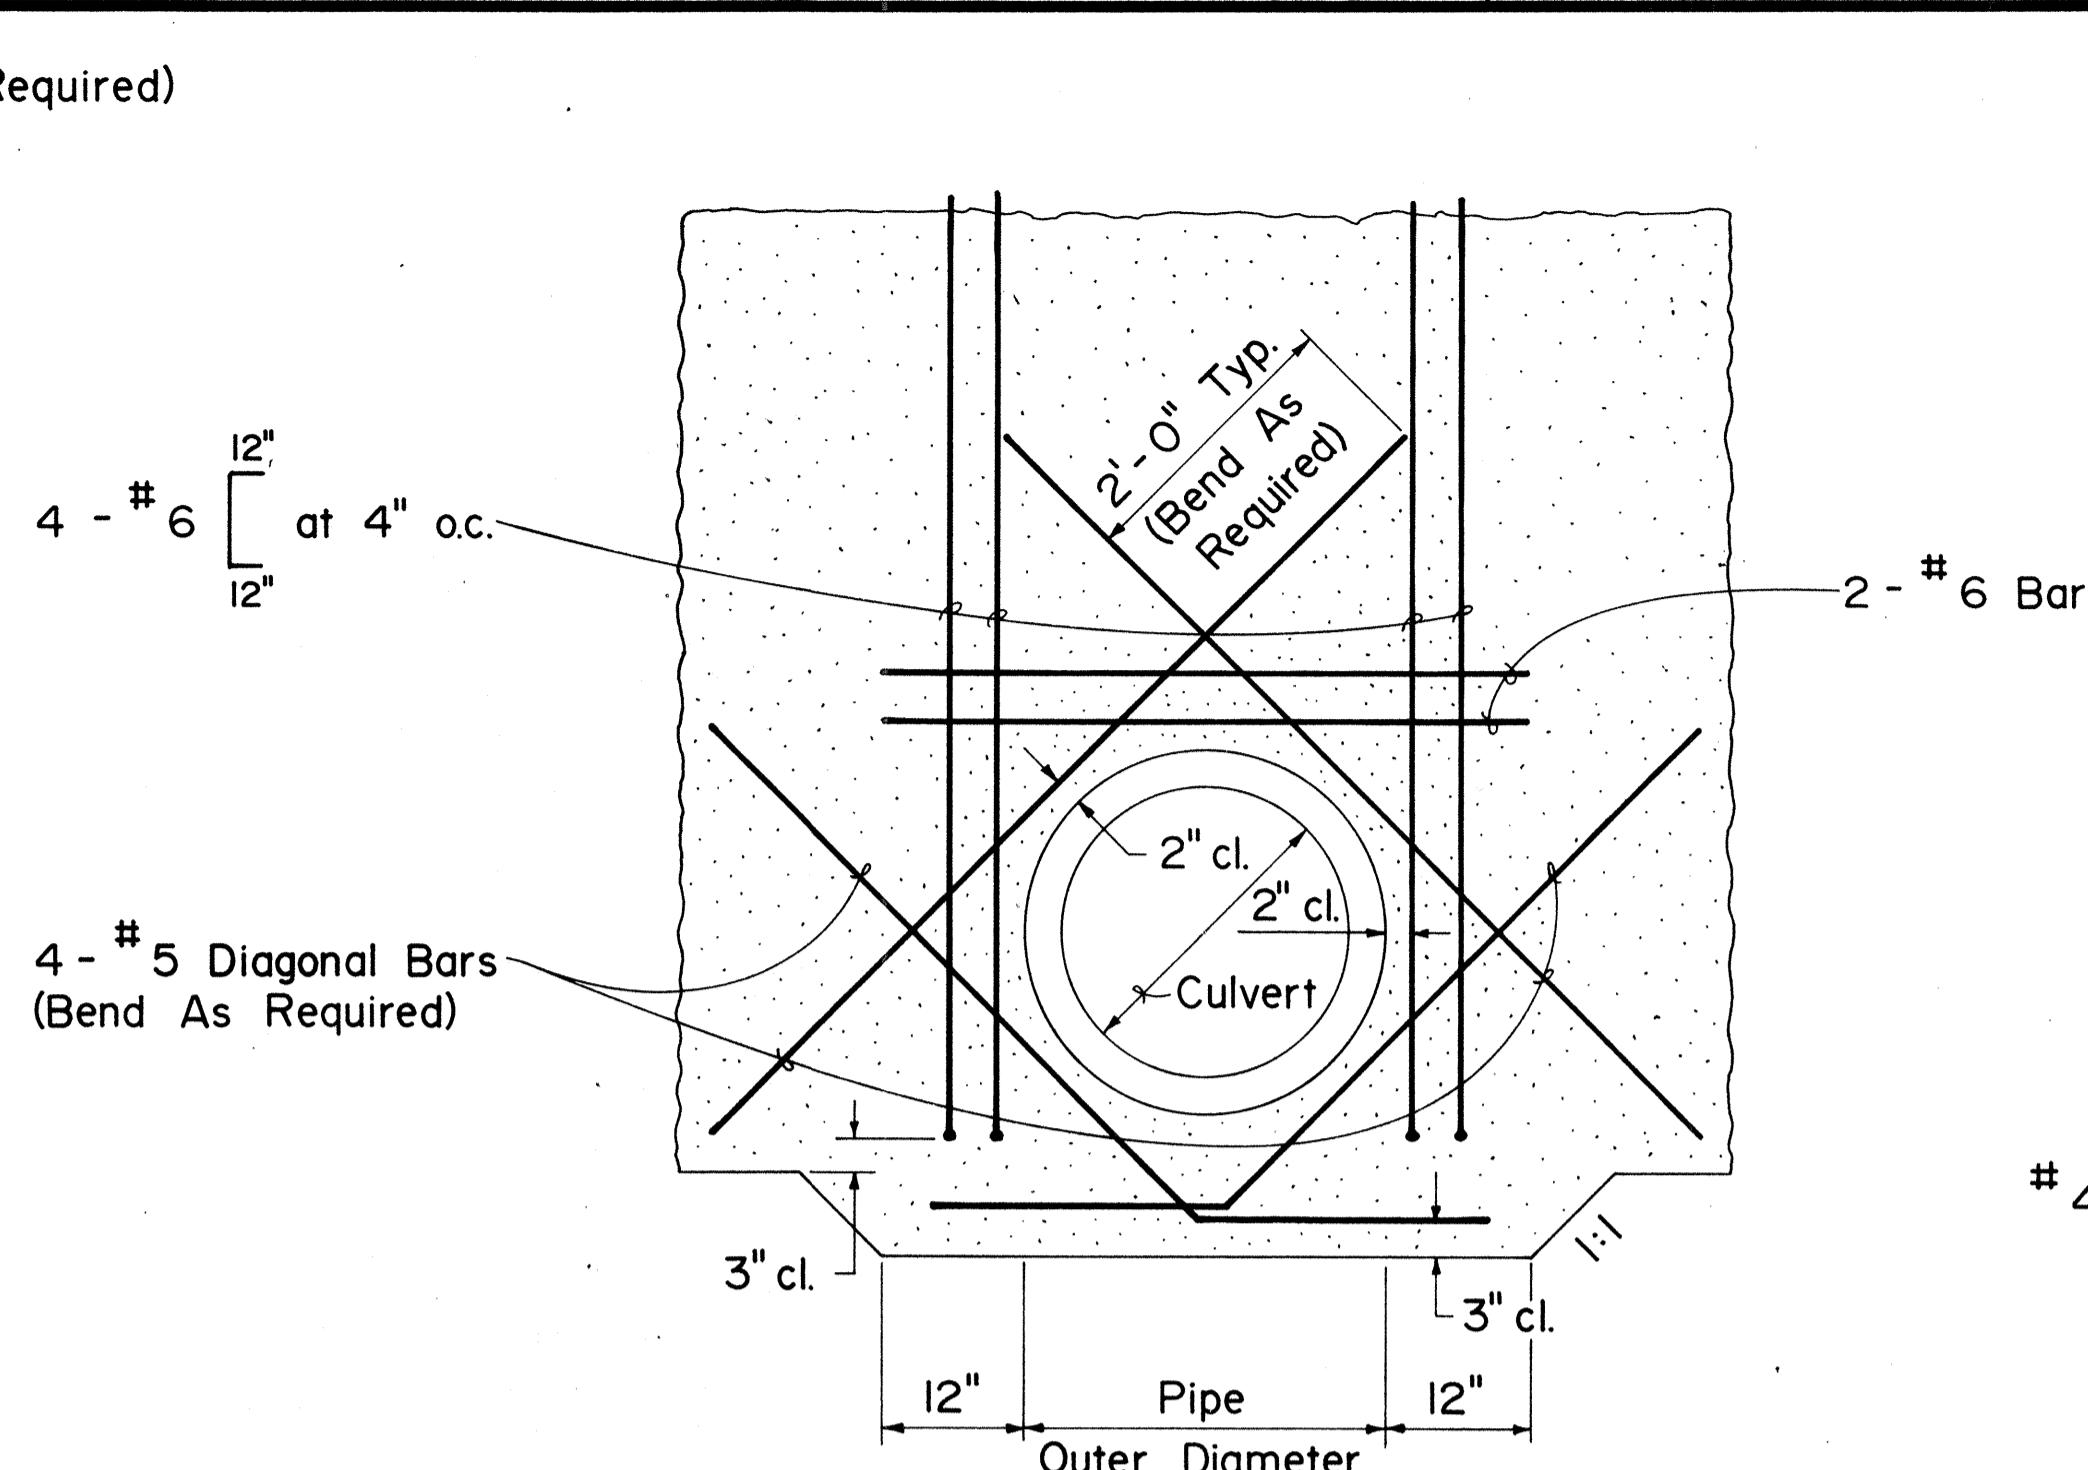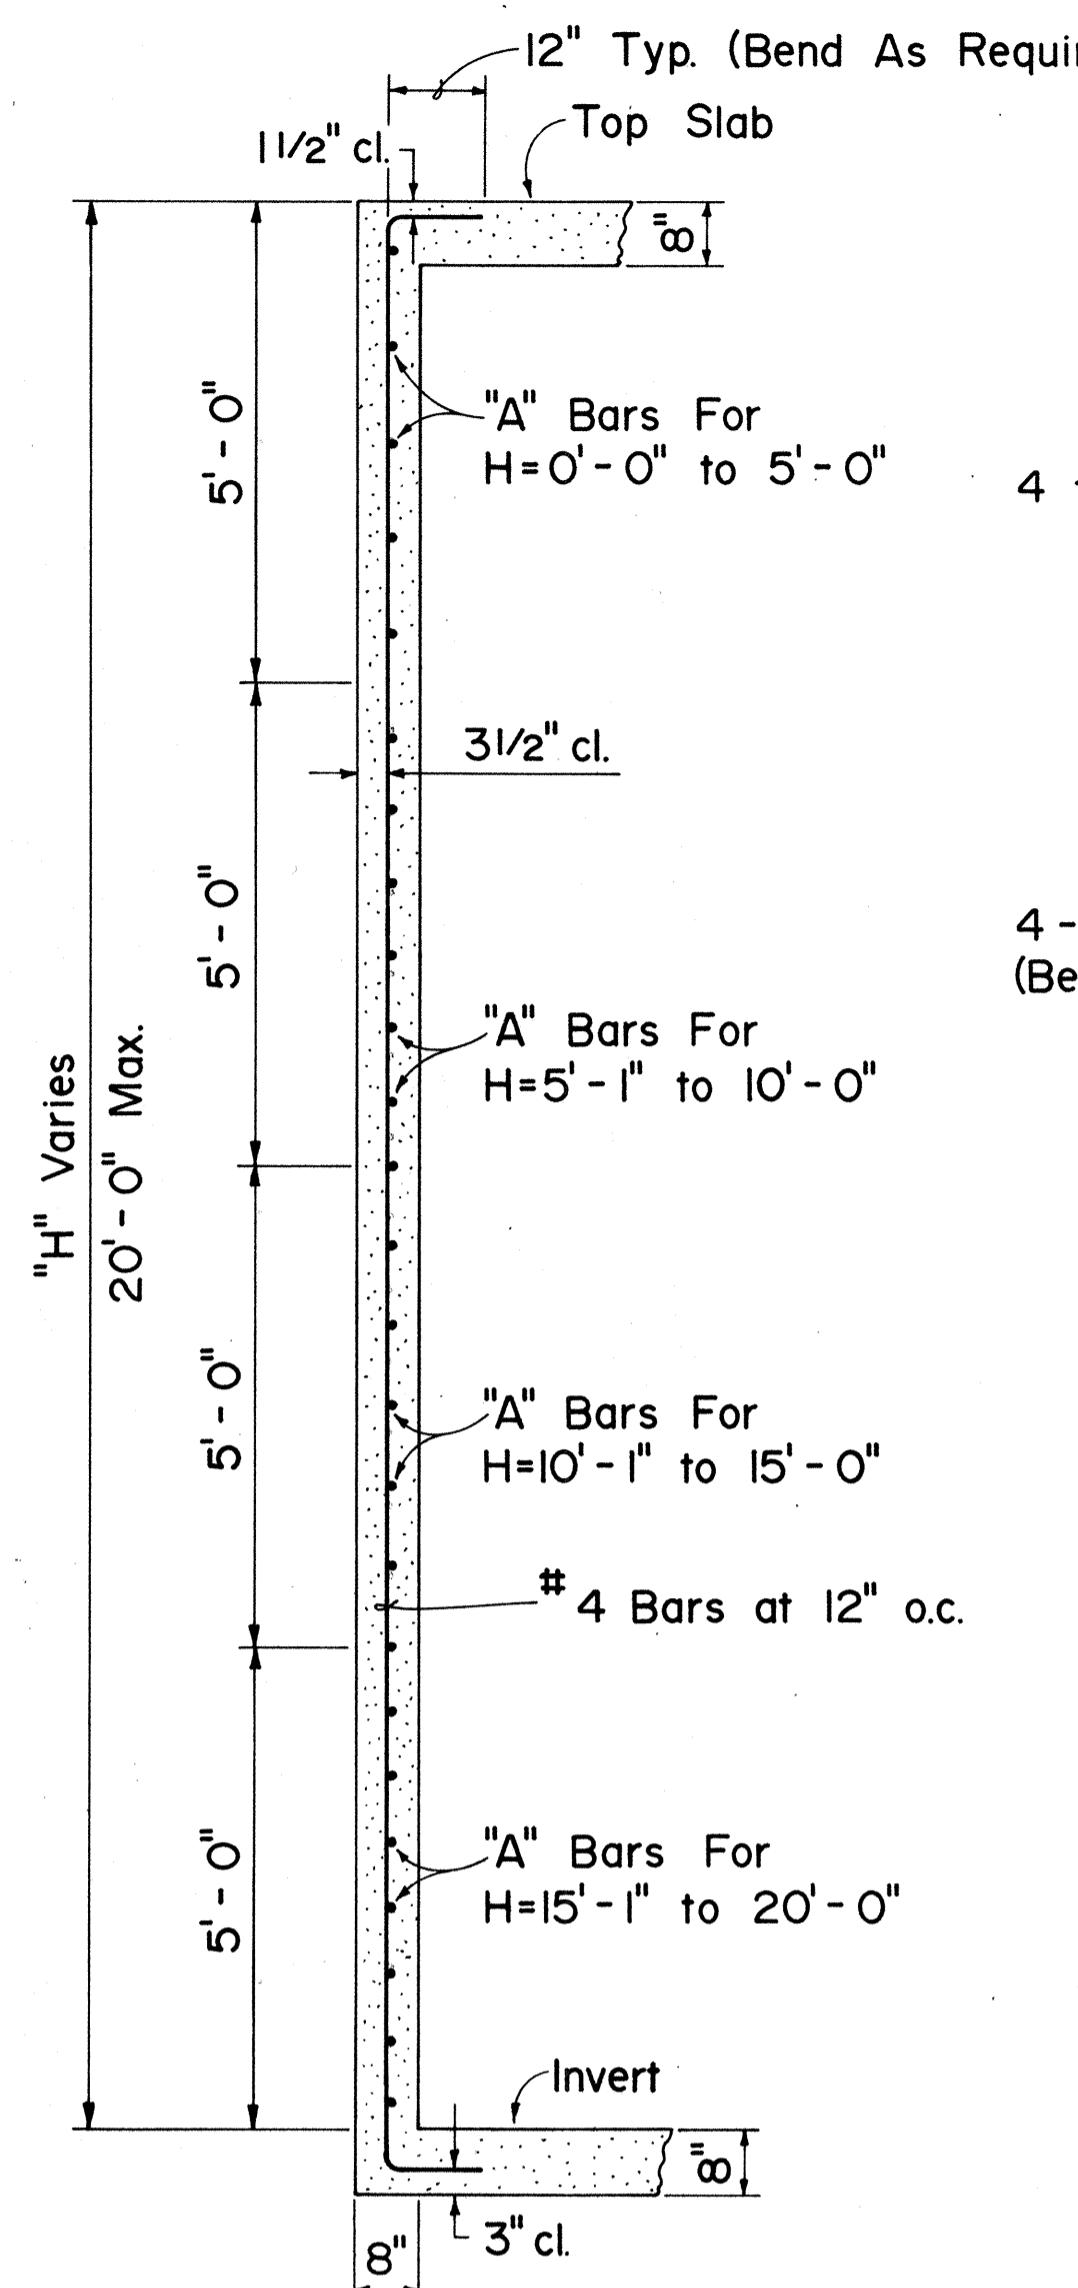

### ADDED REINFORCING FOR CULVERT OPENINGS

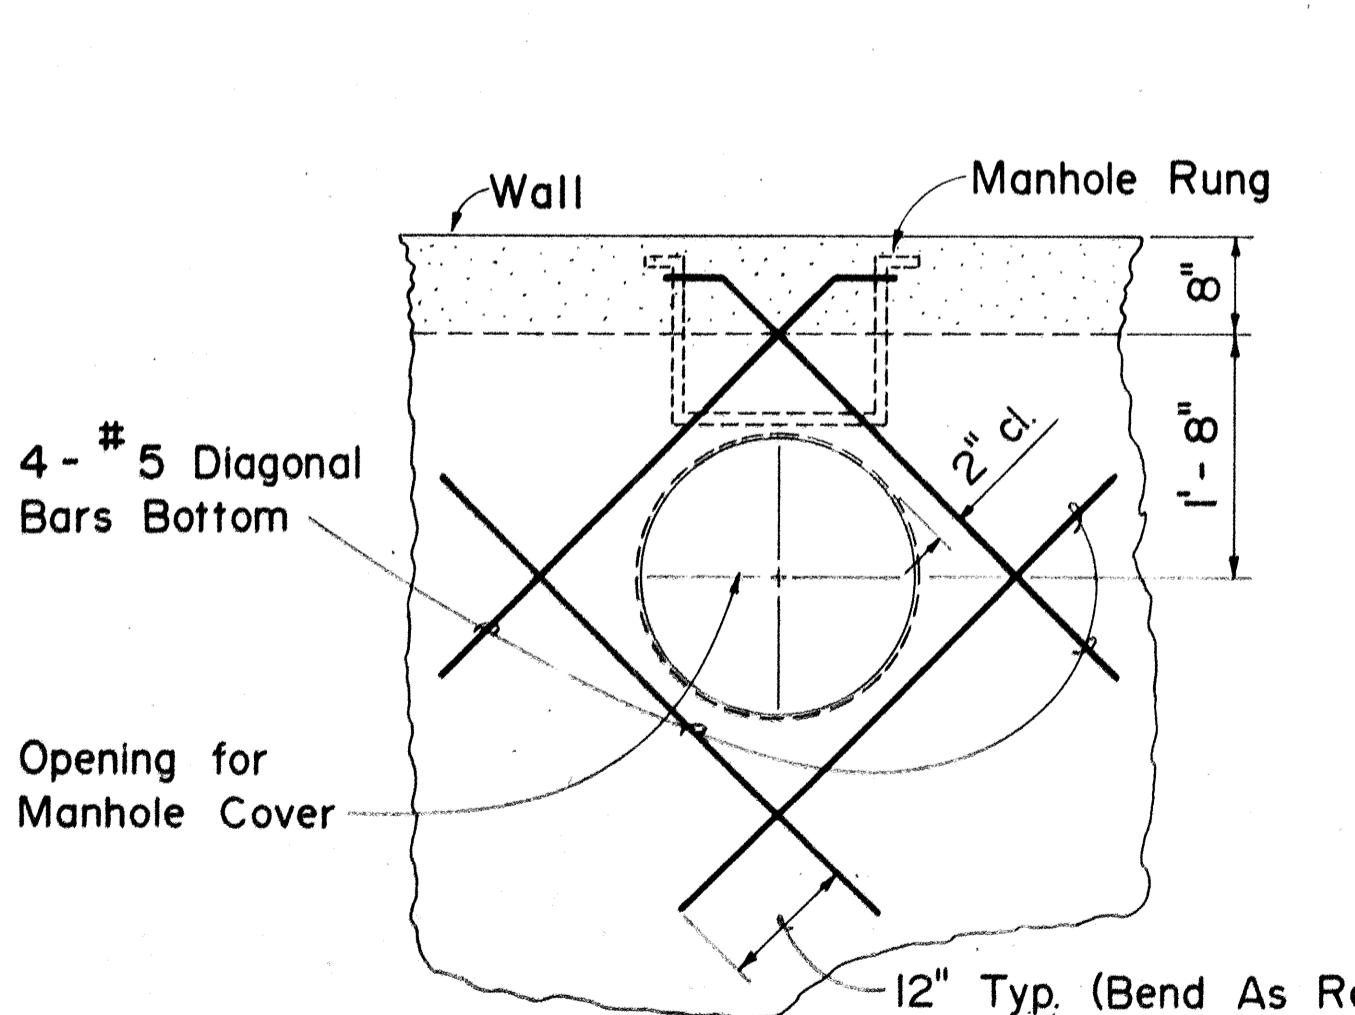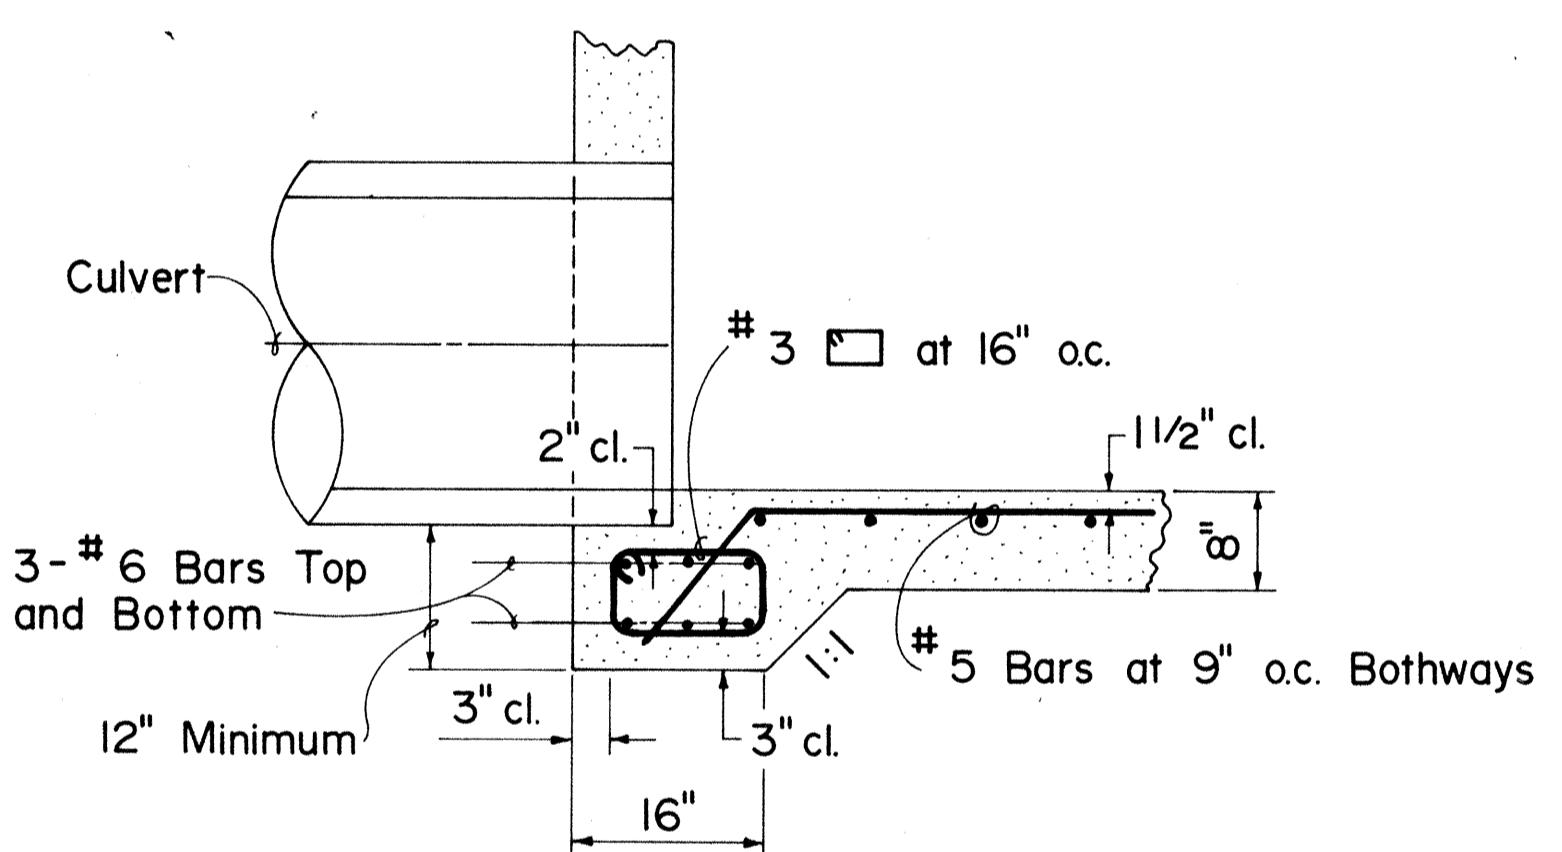

### HORIZONTAL "A" BARS

| "H" MAX. (FT.)   | "L" MAX. (FT.)  |                 |                 |                |
|------------------|-----------------|-----------------|-----------------|----------------|
|                  | 4'-0"           | 6'-0"           | 7'-4"           | 8'-4"          |
| 0'-0" to 5'-0"   | # 4 at 12" o.c. | # 4 at 10" o.c. | # 5 at 10" o.c. | # 5 at 8" o.c. |
| 5'-1" to 10'-0"  | # 4 at 9" o.c.  | # 5 at 9" o.c.  | # 5 at 6" o.c.  | N.A.           |
| 10'-1" to 15'-0" | # 5 at 10" o.c. | # 5 at 6" o.c.  | N.A.            | N.A.           |
| 15'-1" to 20'-0" | # 5 at 8" o.c.  | N.A.            | N.A.            | N.A.           |

| NO. | REVISION                             | APPROVED BY | DATE    |
|-----|--------------------------------------|-------------|---------|
| I.  | Replaces Sht. DH 4 approved 12-17-69 | H.C.        | 12/4/80 |

APPROVAL RECOMMENDED:  
Hydraulic Design Engineer  
DATE

APPROVED:  
Assistant Chief, Engineering  
DATE

STATE OF HAWAII  
DEPARTMENT OF TRANSPORTATION  
HIGHWAYS DIVISION


STANDARD DETAILS

### TYPICAL REINFORCING DETAILS FOR CATCH BASINS


Not To Scale Date: Dec. 1980

SHEET NO. 041 OF 30 SHEETS DH 4


| FED. ROAD<br>DIST. NO. | STATE | FED. AID<br>PROJ. NO. | FISCAL<br>YEAR | SHEET<br>NO. | TOTAL<br>SHEETS |
|------------------------|-------|-----------------------|----------------|--------------|-----------------|
| HAWAII                 | HAW.  | I-H1-1(187)           | 1984           | 83           | 197             |

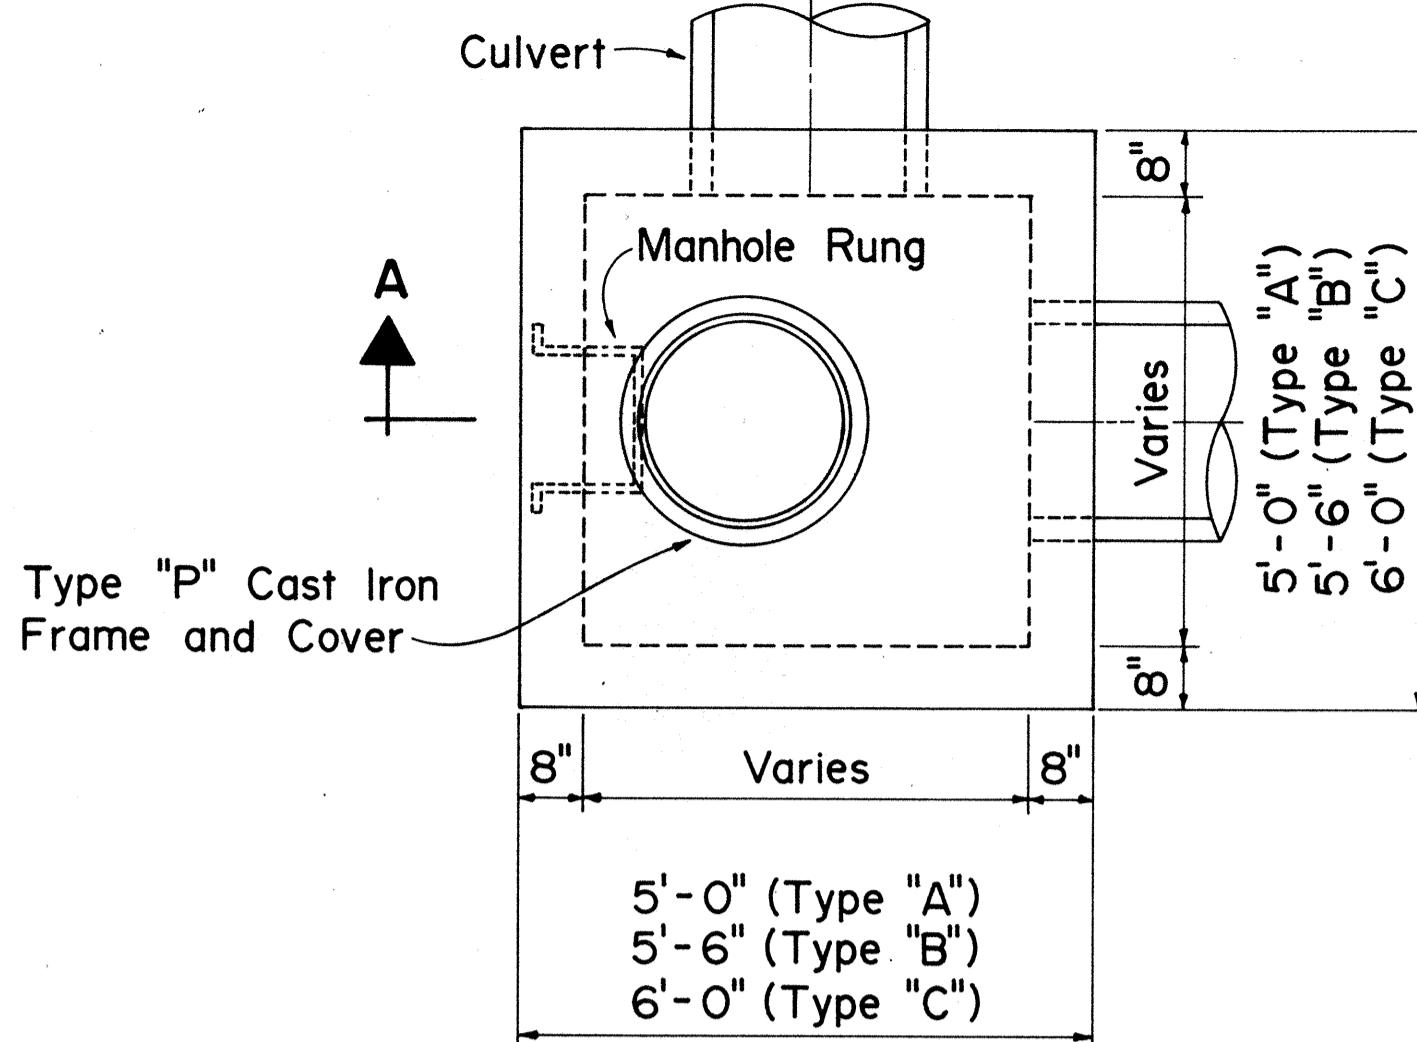

PLAN

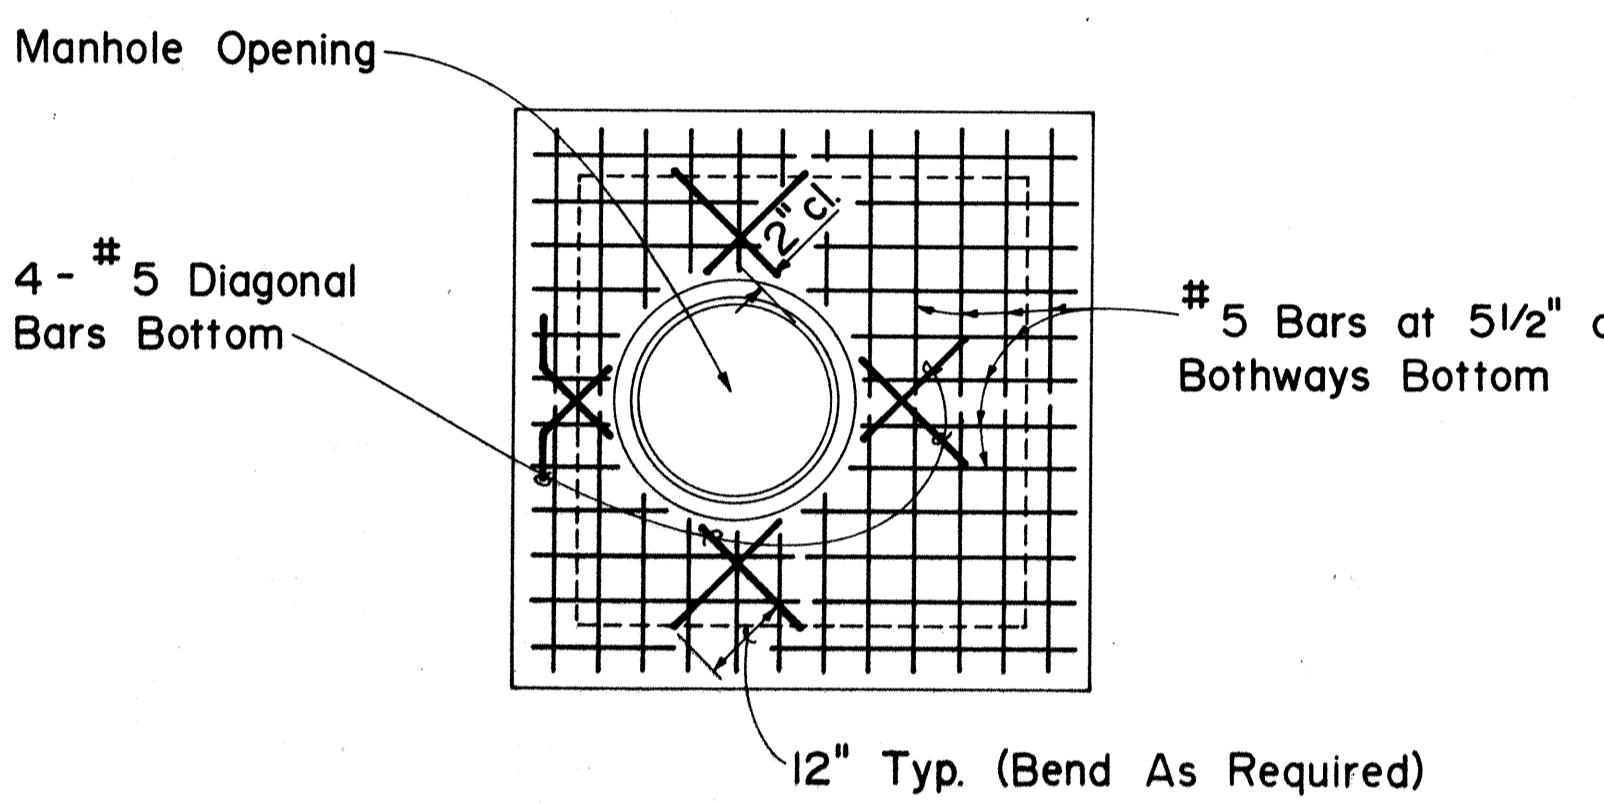


PLAN  
(Top Slab Reinforcing)

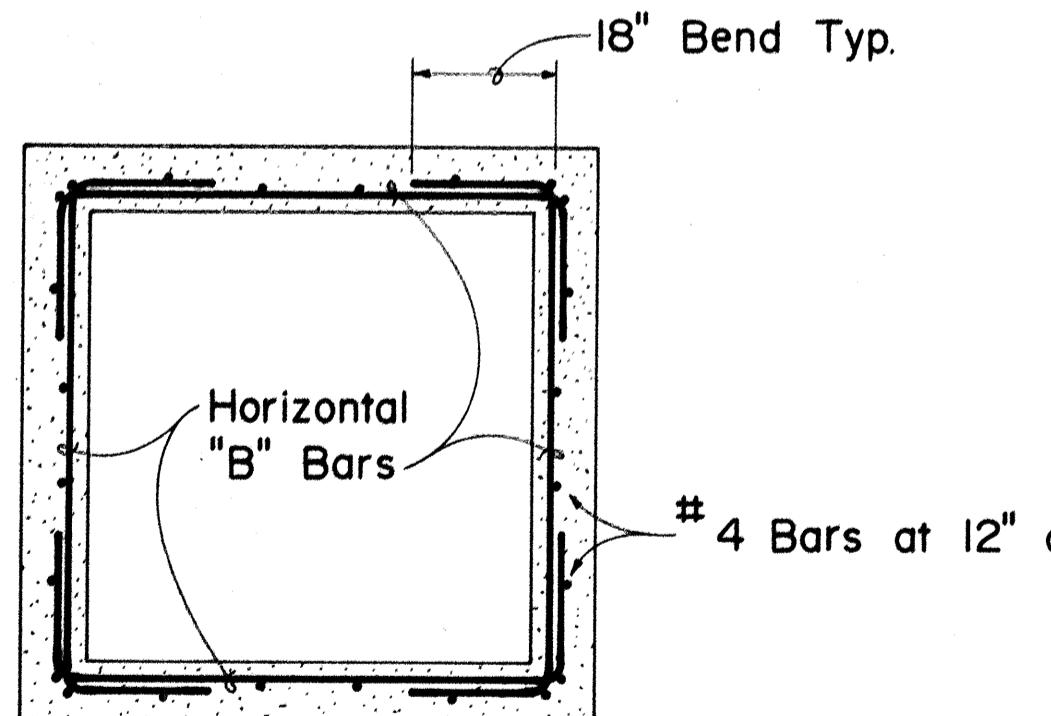


SECTION "B-B"

### TYPE "A", "B", & "C" STORM DRAIN MANHOLE


| "H" MAX. (FT.)   | HORIZONTAL "B" BARS |
|------------------|---------------------|
| 0'-0" to 5'-0"   | #4 at 12" o.c.      |
| 5'-1" to 10'-0"  | #4 at 9" o.c.       |
| 10'-1" to 15'-0" | #4 at 6" o.c.       |
| 15'-1" to 20'-0" | #5 at 6" o.c.       |

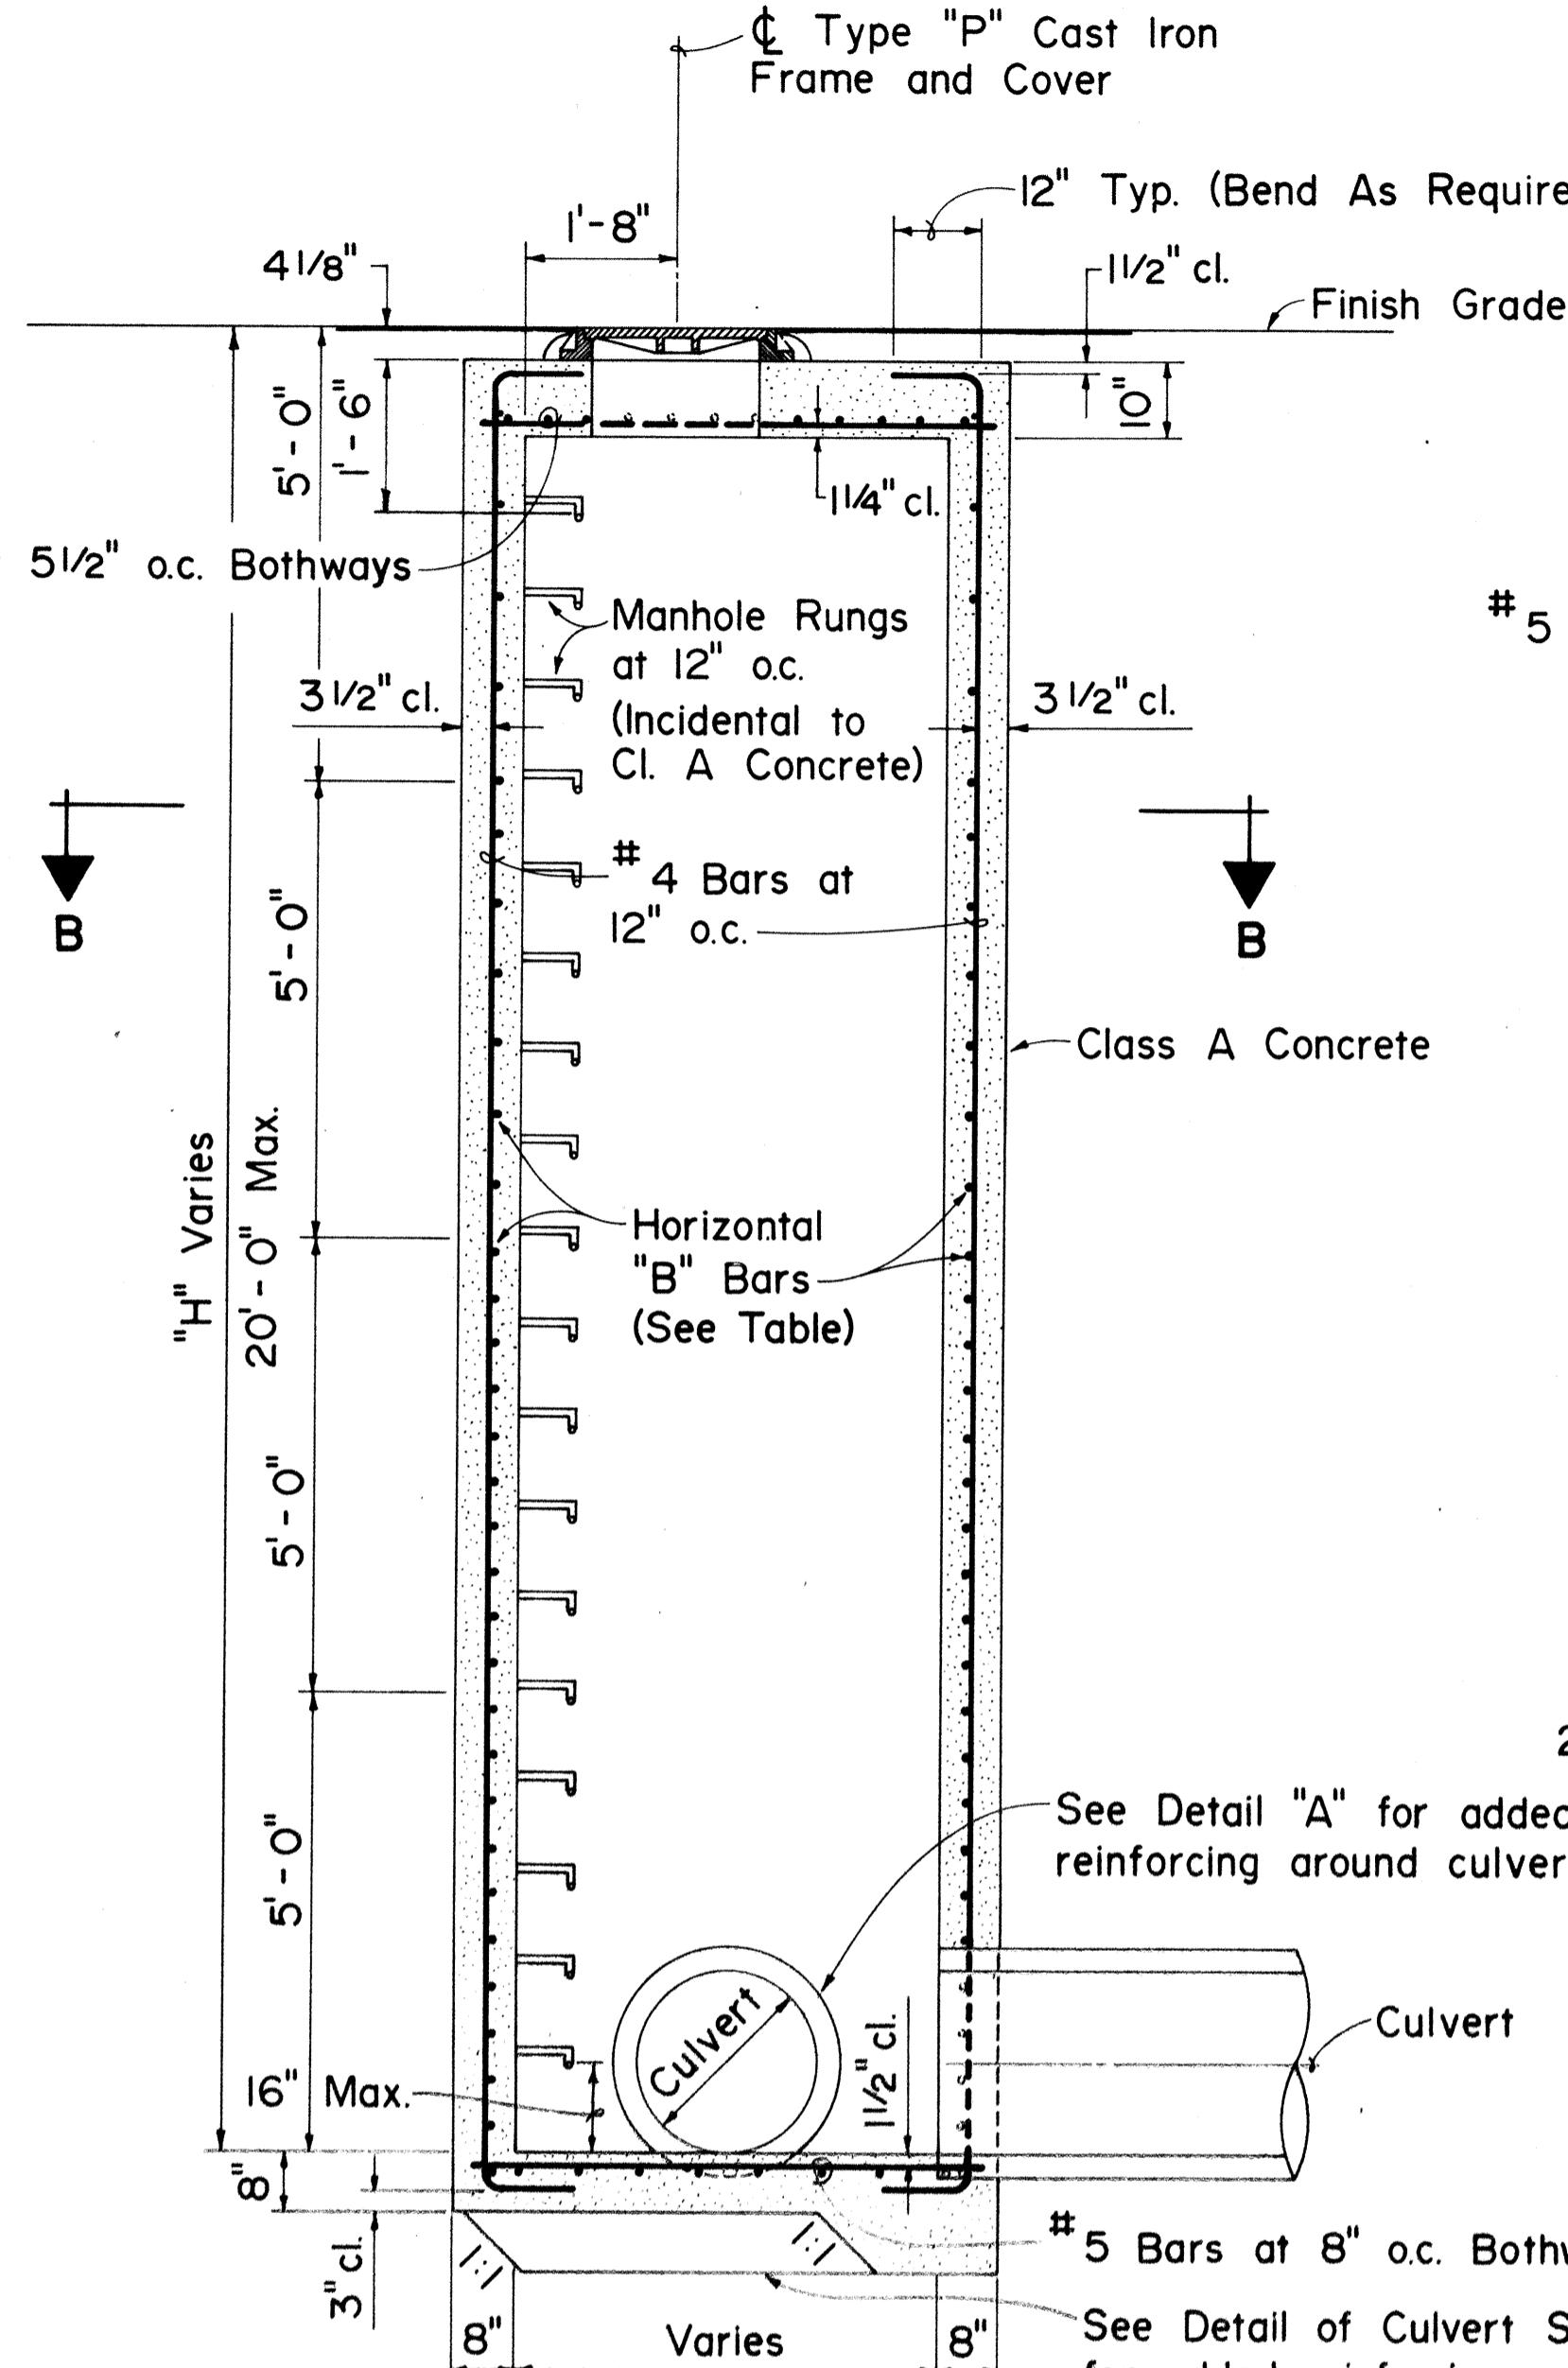

SECTION "A-A"

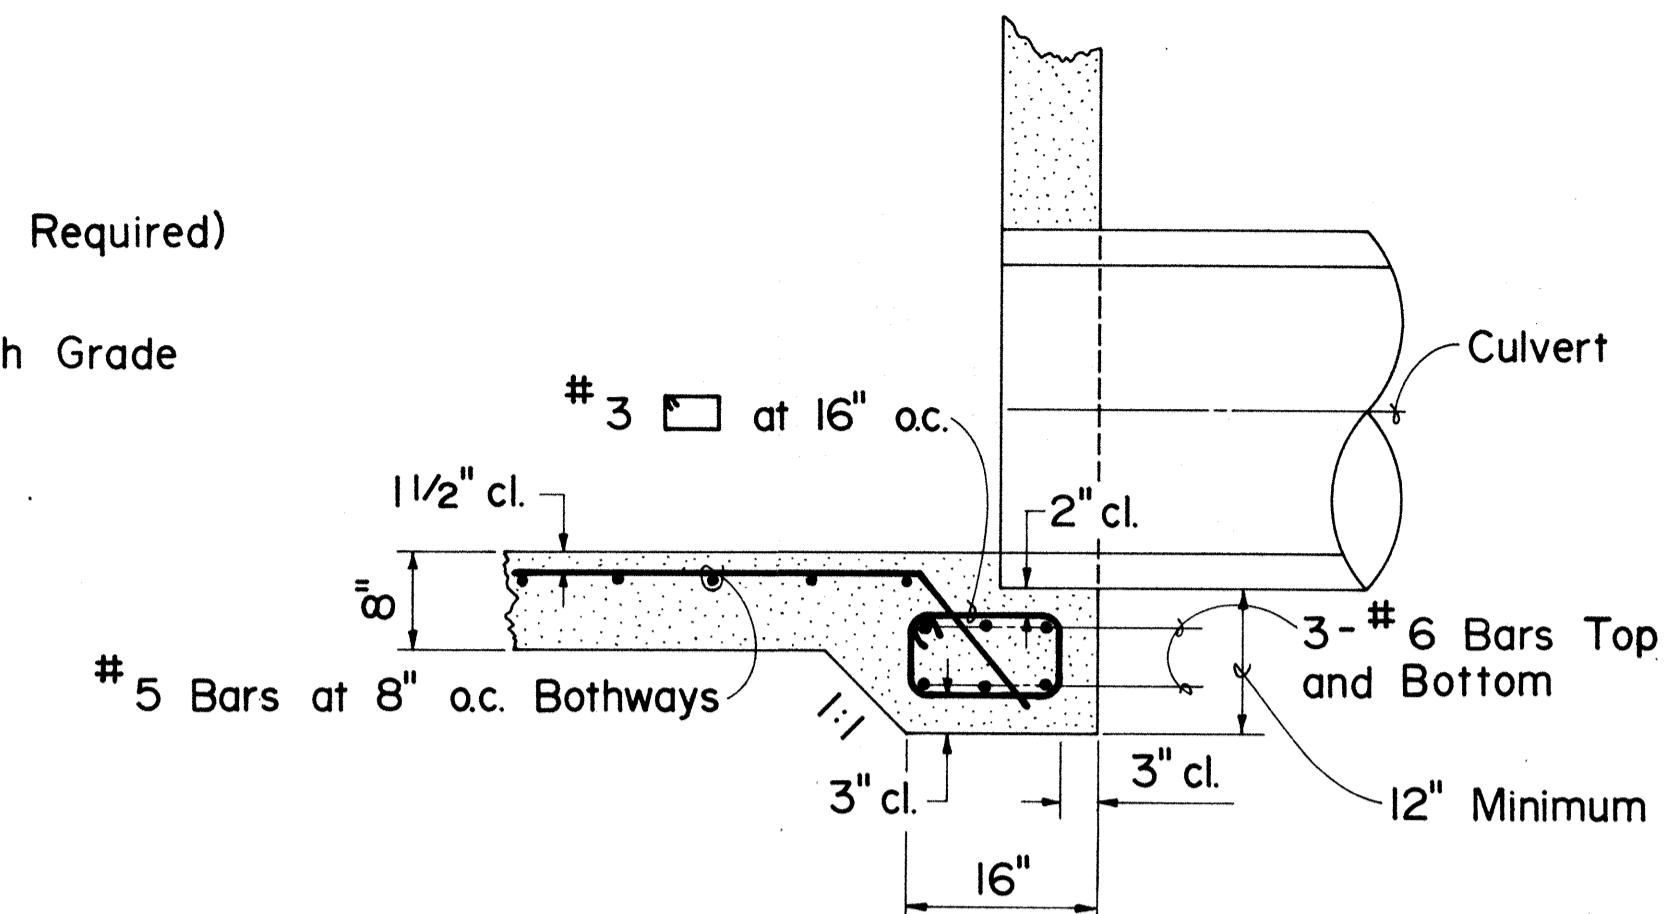

TYPICAL DETAIL OF CULVERT SEAT

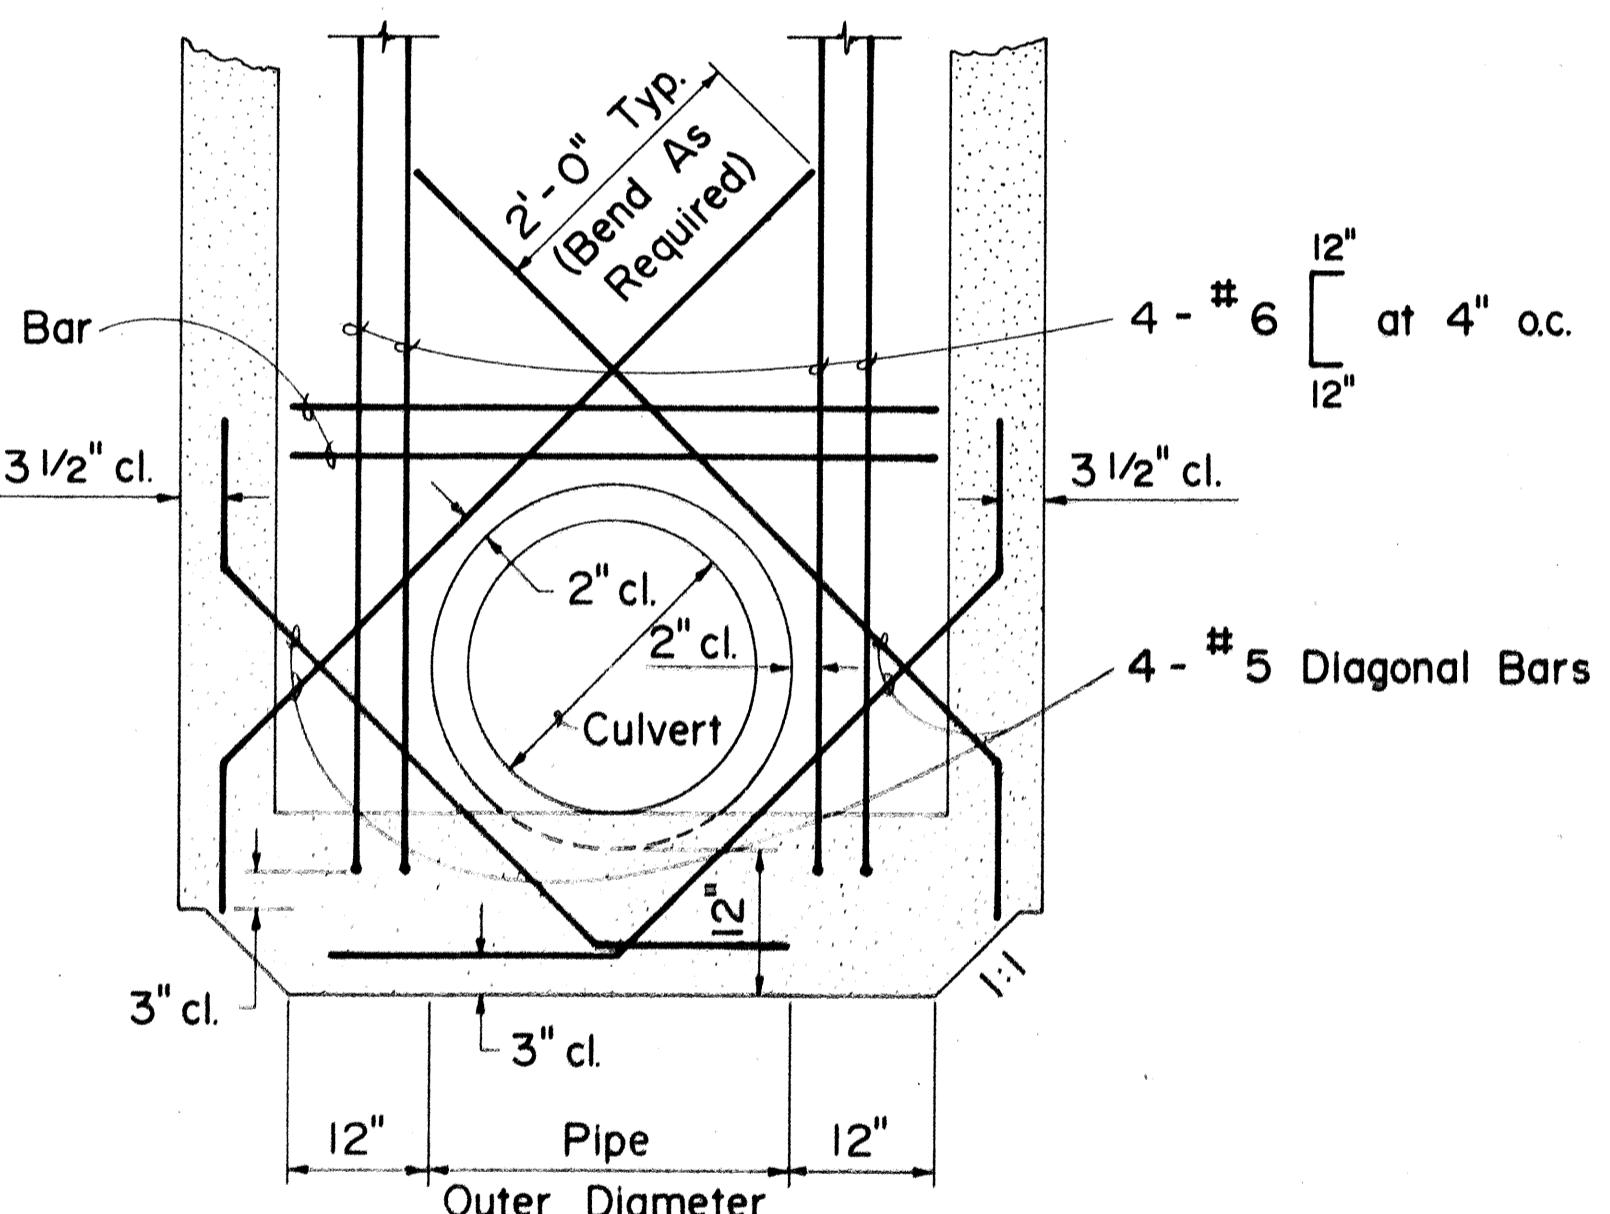

DETAIL "A"

| NO. | REVISION                                      | APPROVED BY | DATE    |
|-----|---|-------------|---------|
| 1.  | Supersedes Sht. DH 5 approved 12-17-69        | H.C.        | 8/20/80 |
| 2.  | Revise horizontal bar table and detail notes. | H.C.        | 4/21/82 |

APPROVAL RECOMMENDED:  
*Yakano*  
HYDRAULIC DESIGN ENGINEER  
DATE: 8-20-80

APPROVED:  
*Yakano*  
ASSISTANT CHIEF, ENGINEERING  
DATE: 8-20-80

STATE OF HAWAII  
DEPARTMENT OF TRANSPORTATION  
HIGHWAYS DIVISION


### STANDARD DETAILS

### TYPE A, B, AND C STORM DRAIN MANHOLE


Not To Scale Date: August 1980

SHEET NO. 35D OF 30 SHEETS DH5


| FED. ROAD DIST. NO. | STATE | FED. AID' PROJ. NO. | FISCAL YEAR | SHEET NO. | TOTAL SHEETS |
|---------------------|-------|---------------------|-------------|-----------|--------------|
| HAWAII              | HAW.  | I-HI-1(107)         | 1984        | 84        | 197          |

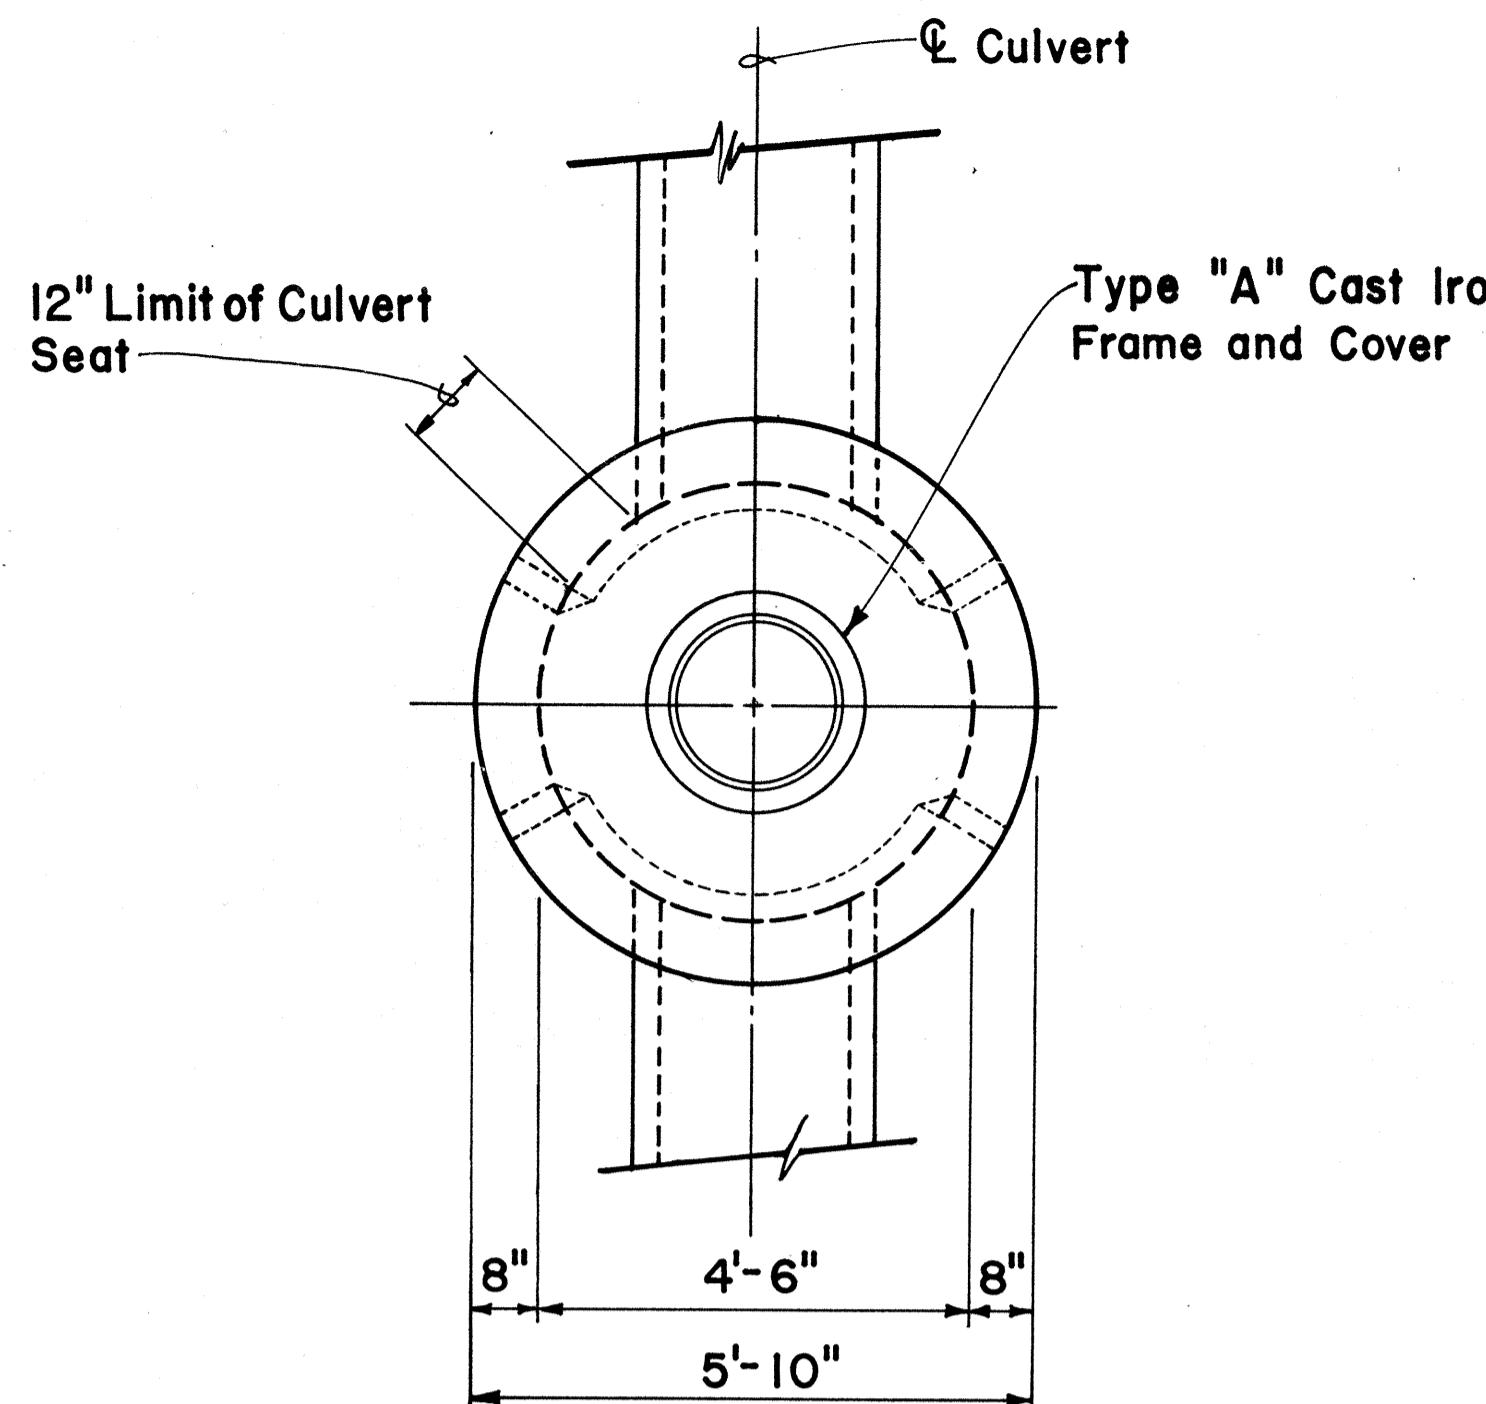

**PLAN TYPE "D" OR "E"  
STORM DRAIN MANHOLE**

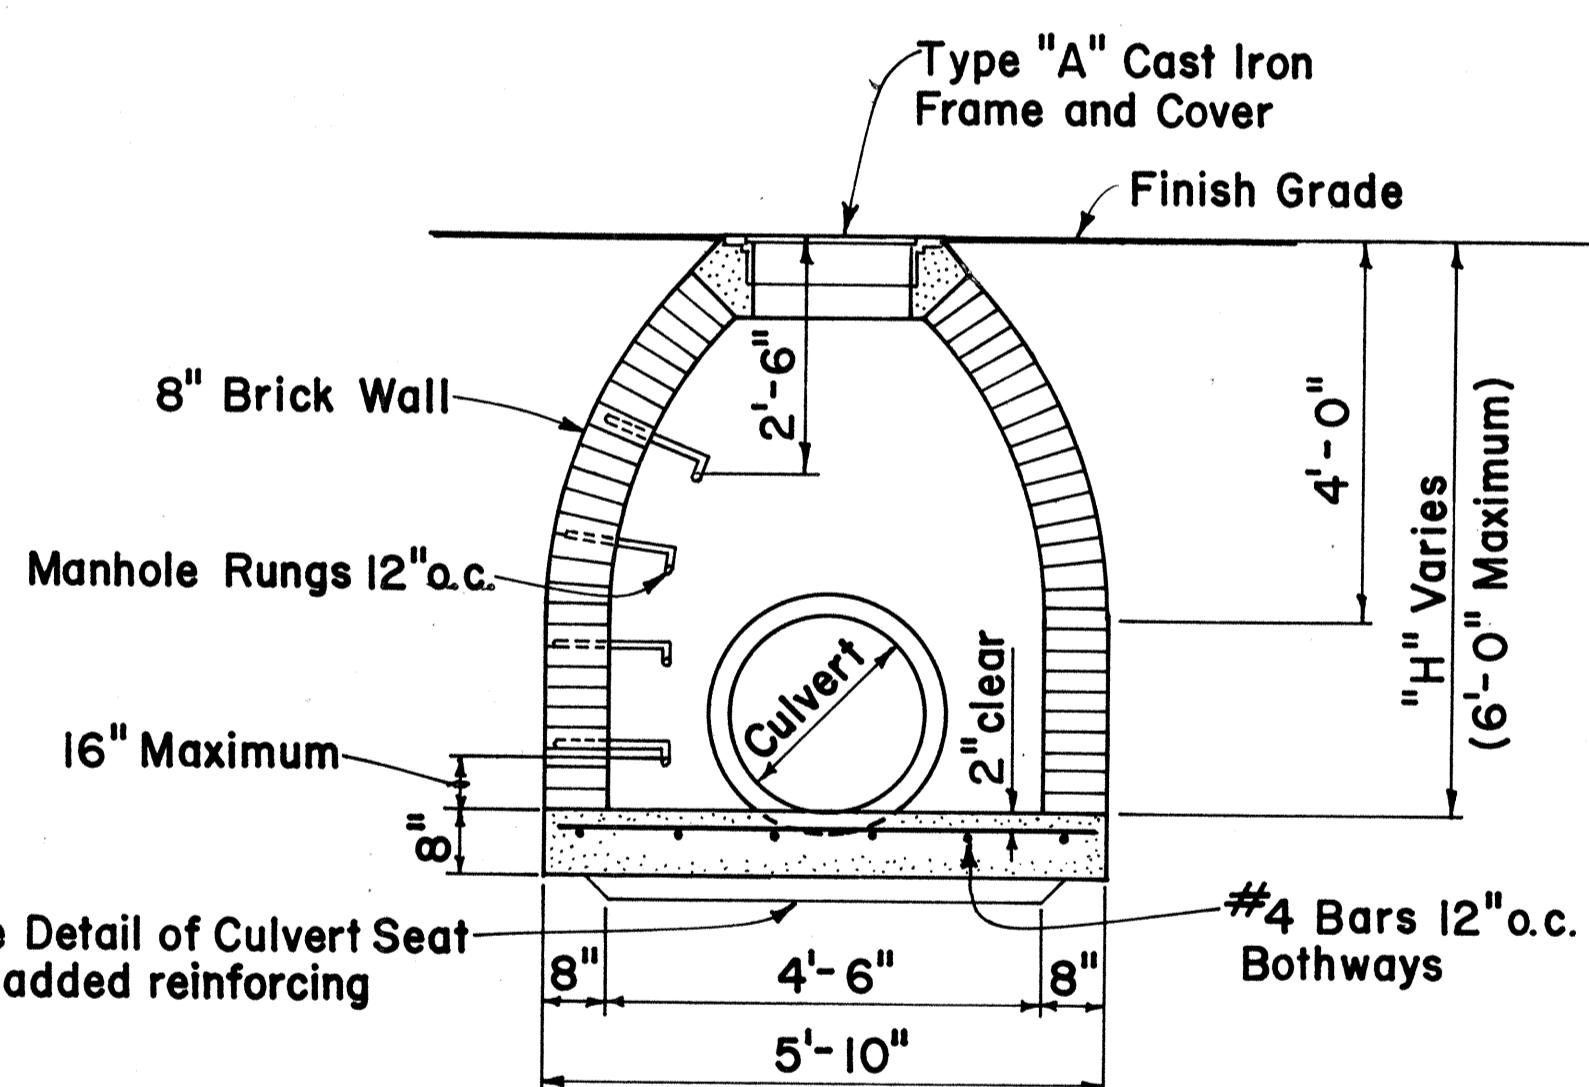


**ELEVATION**

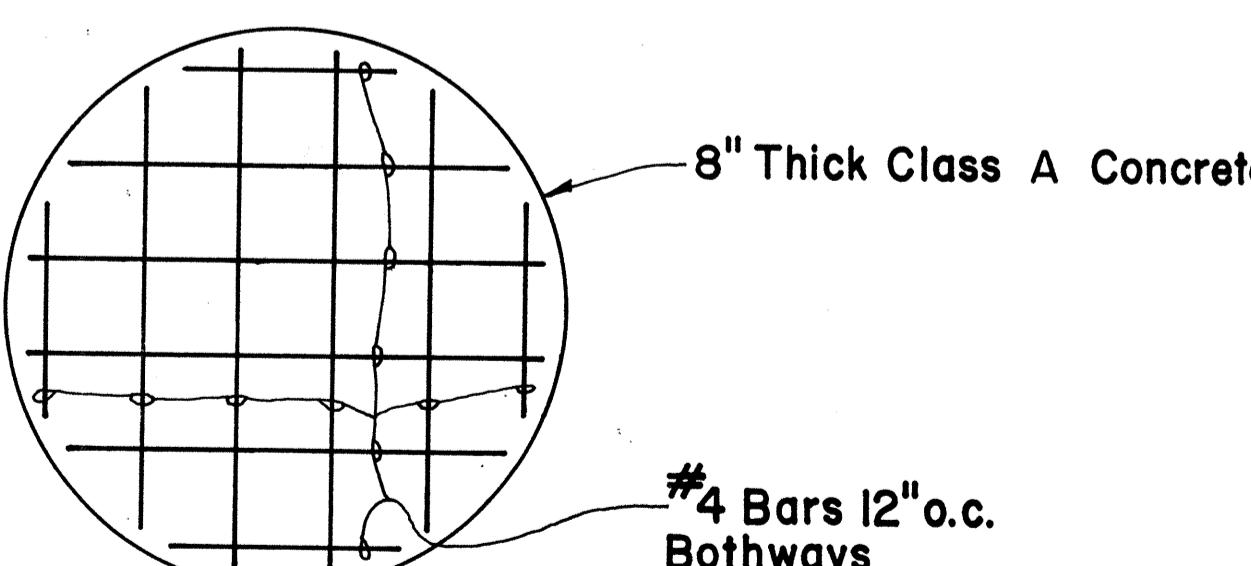


**PLAN-CONCRETE BASE**

**TYPE "D" STORM DRAIN MANHOLE**

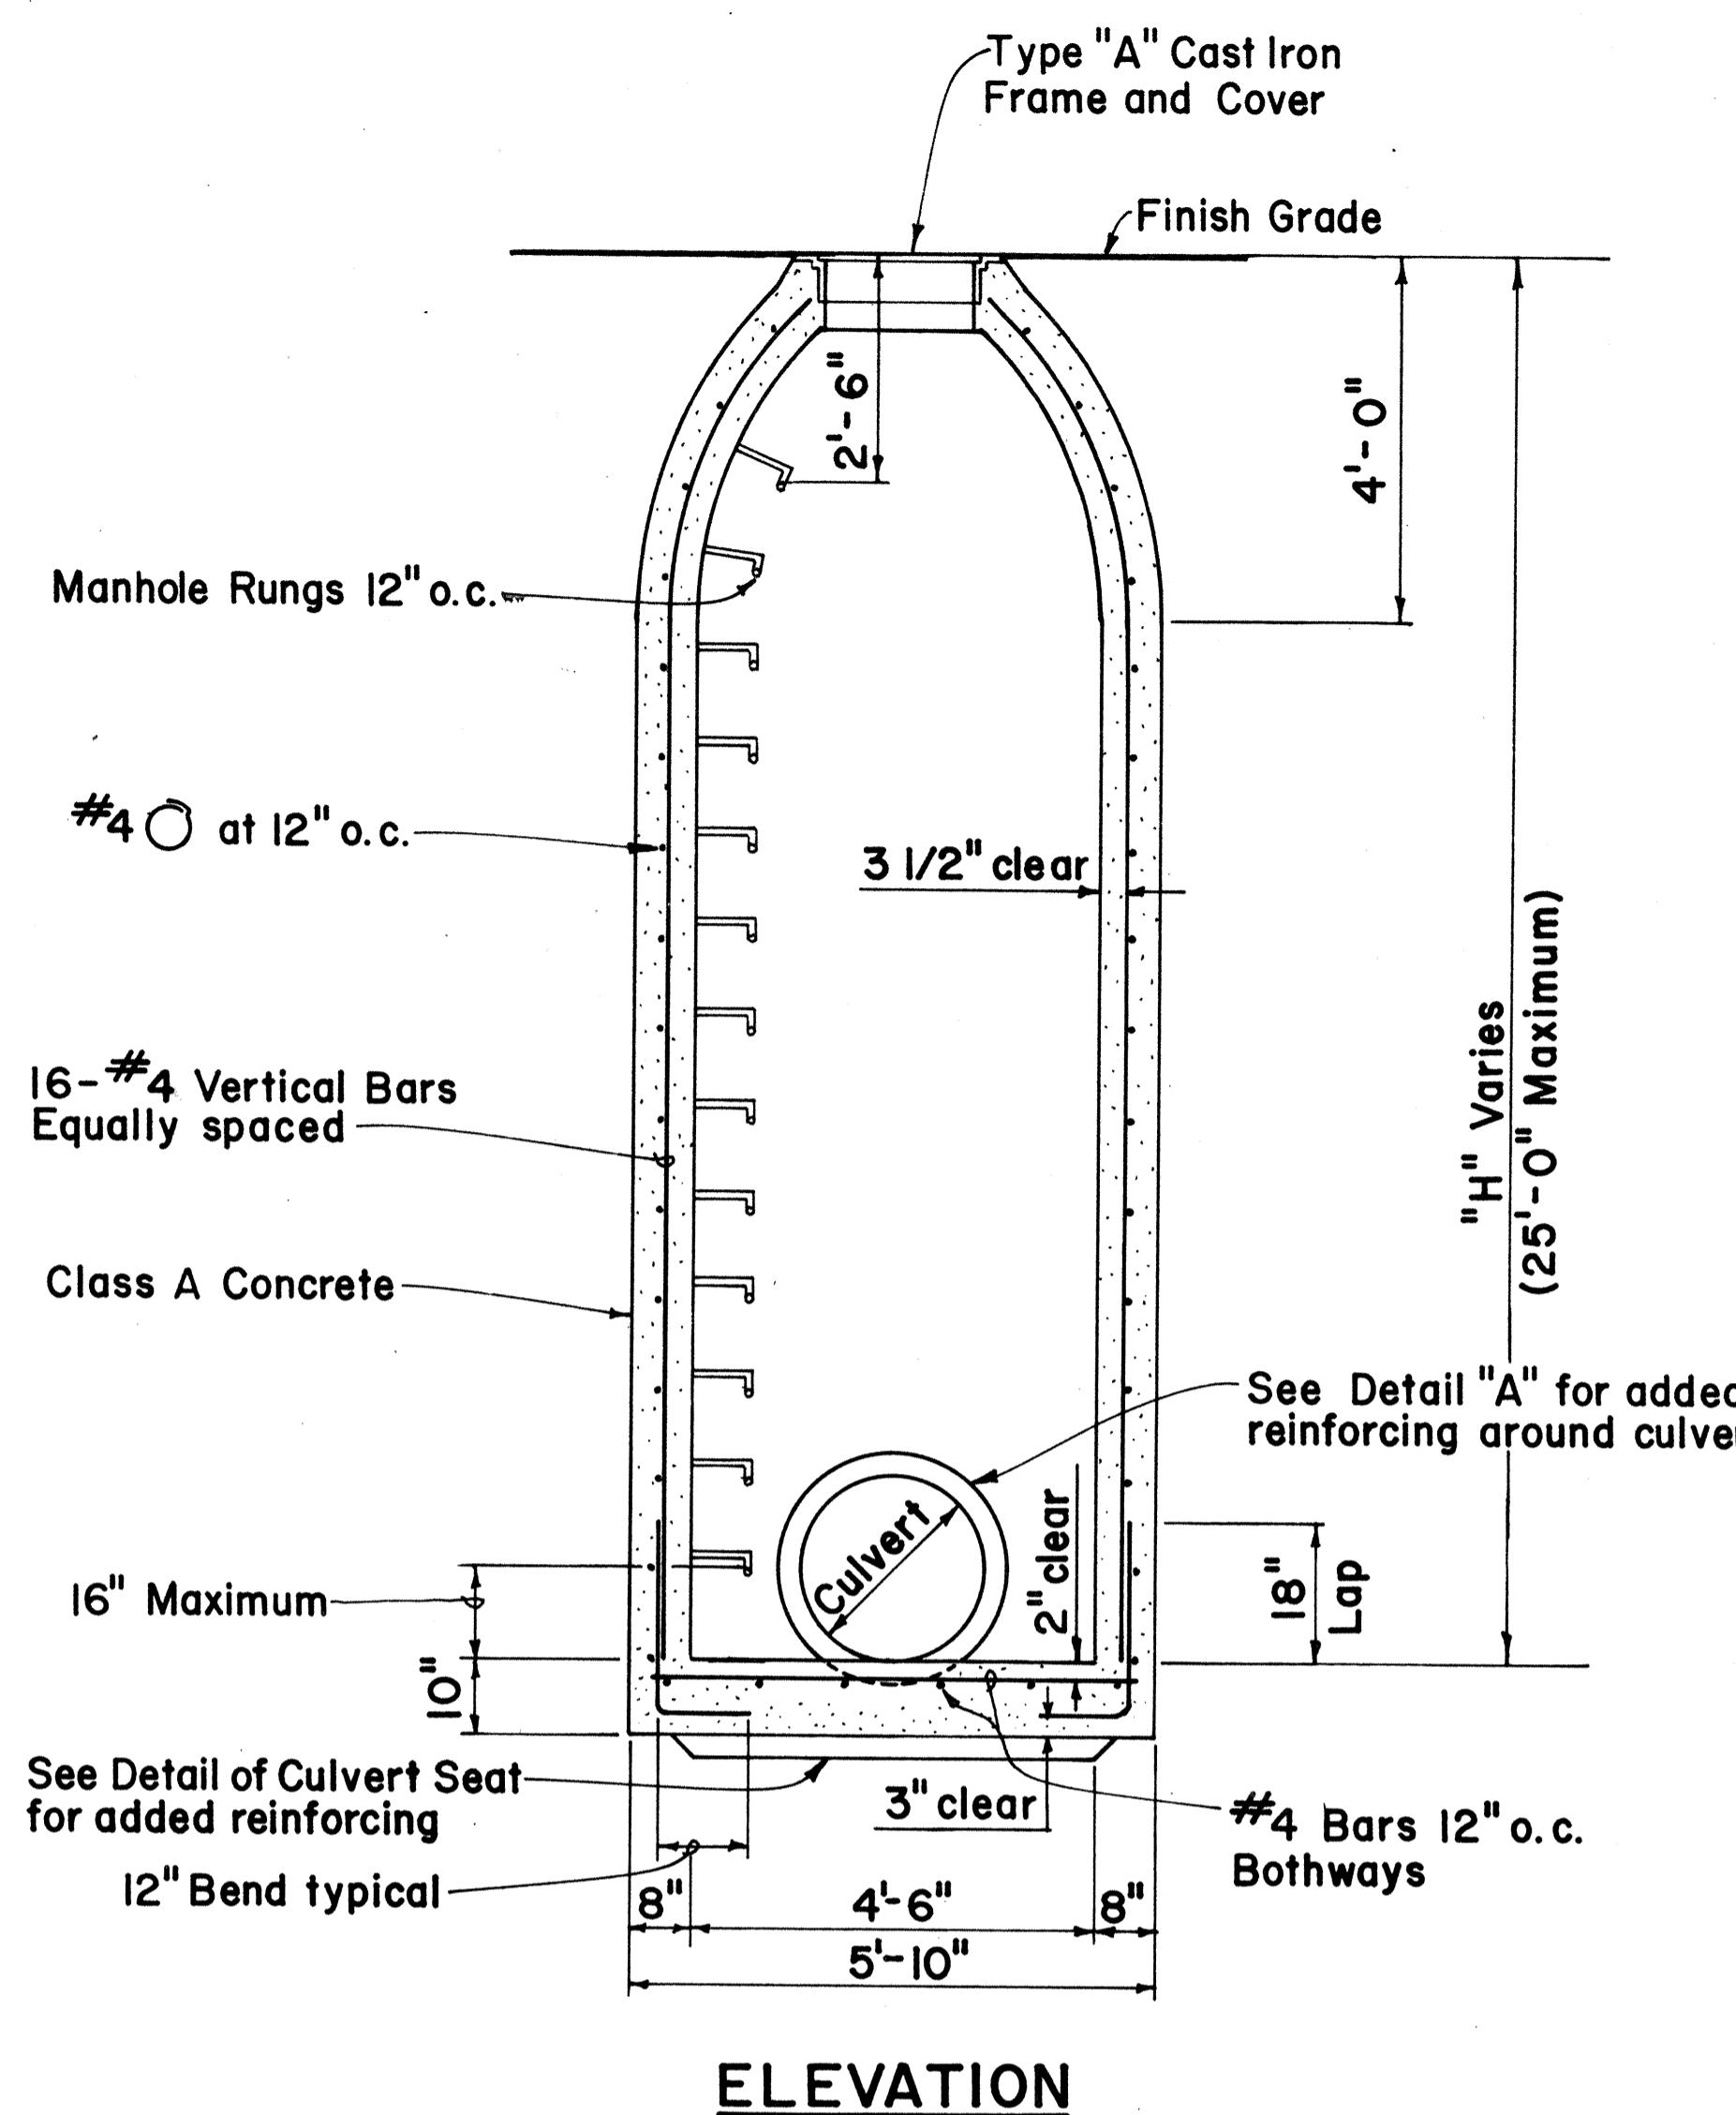


**ELEVATION**

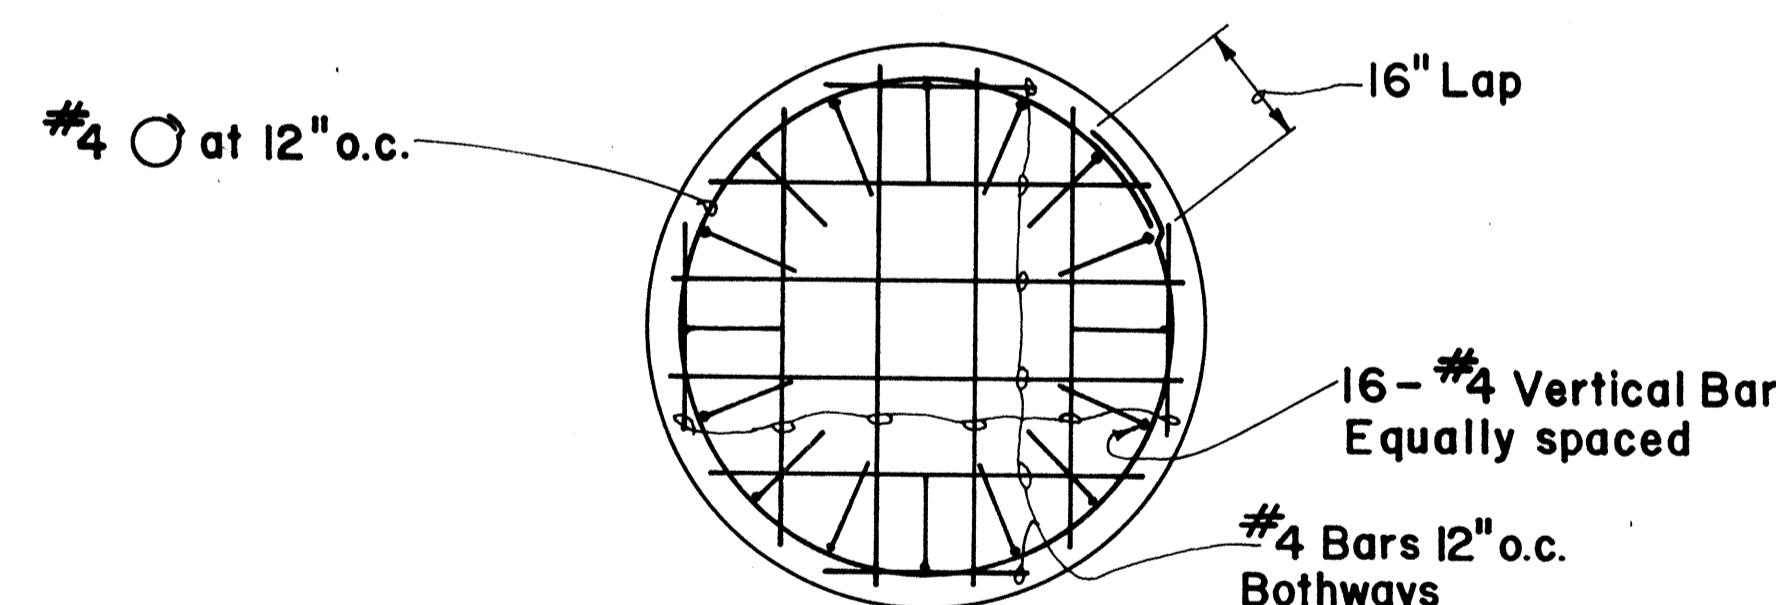


**PLAN-CONCRETE BASE**

**TYPE "E" STORM DRAIN MANHOLE**

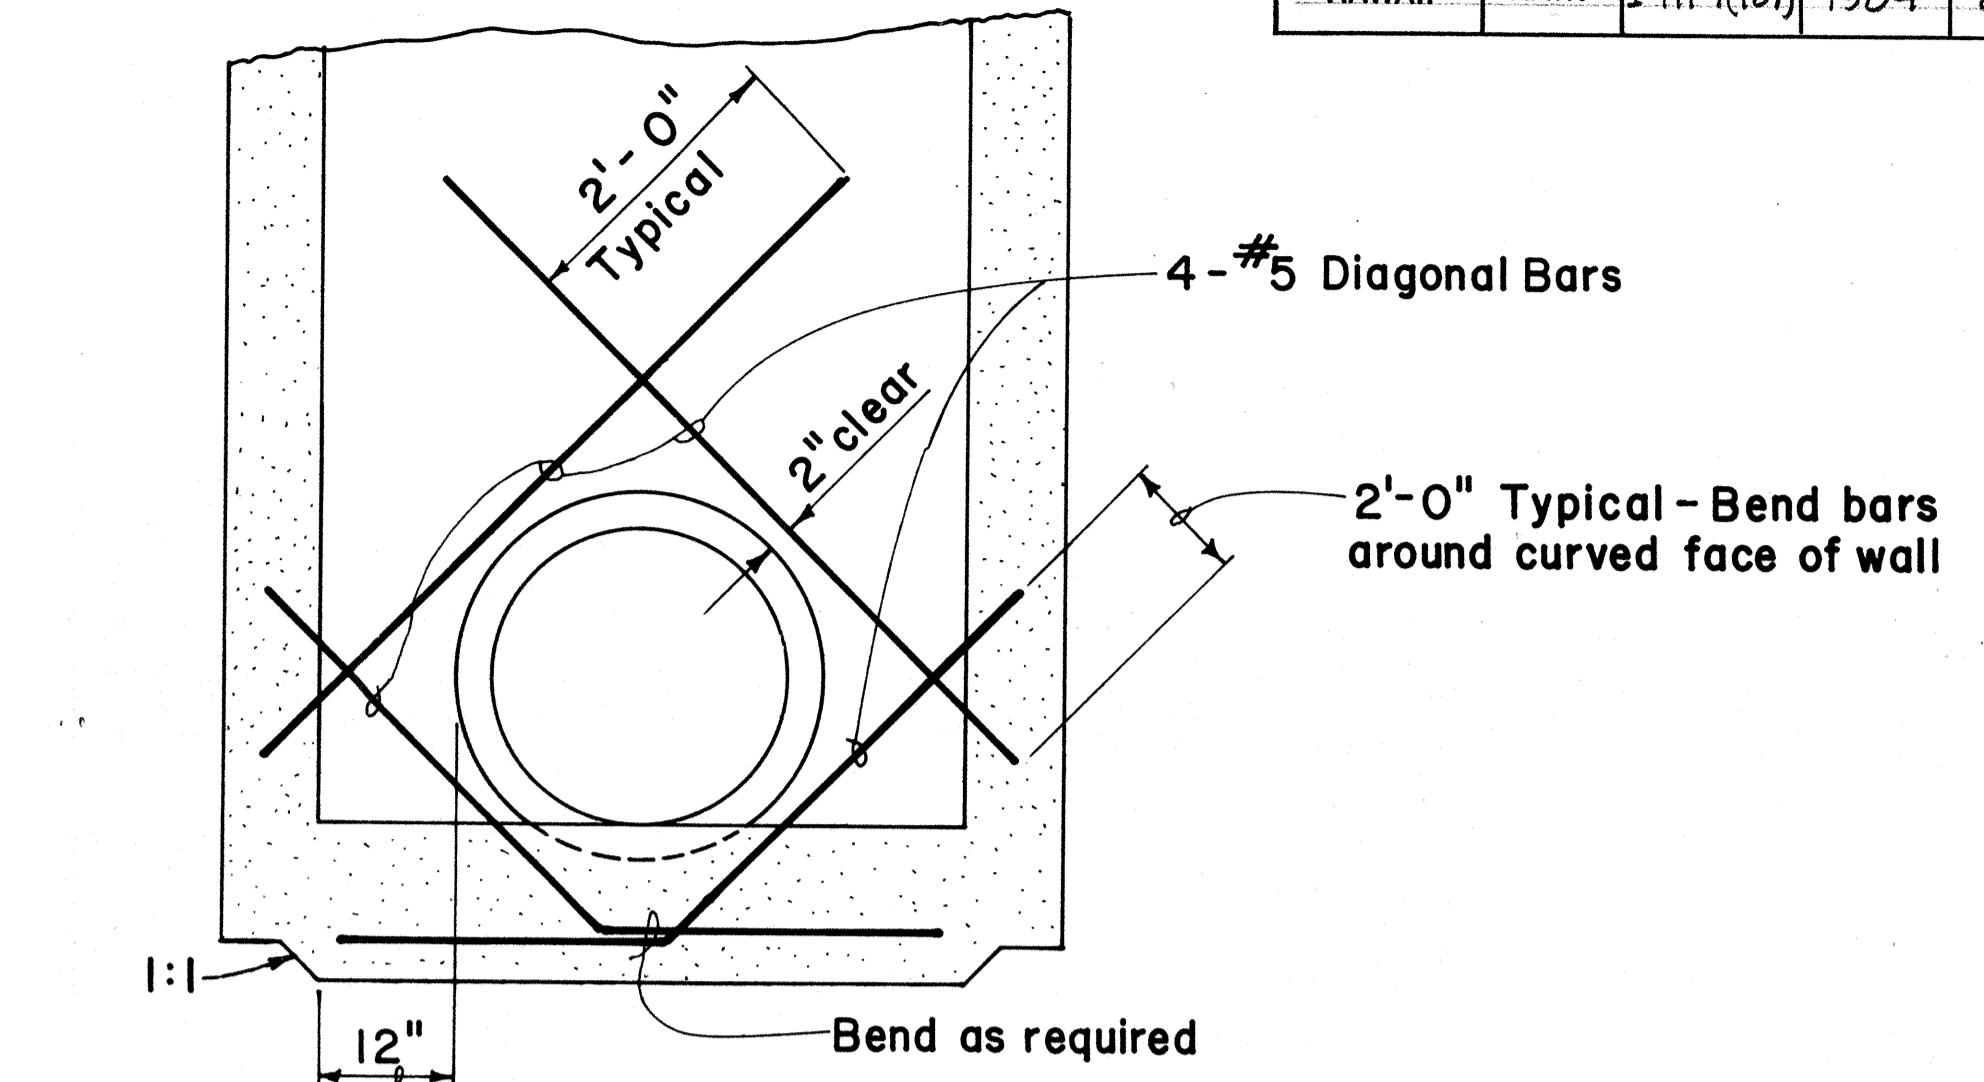

**DETAIL "A"**

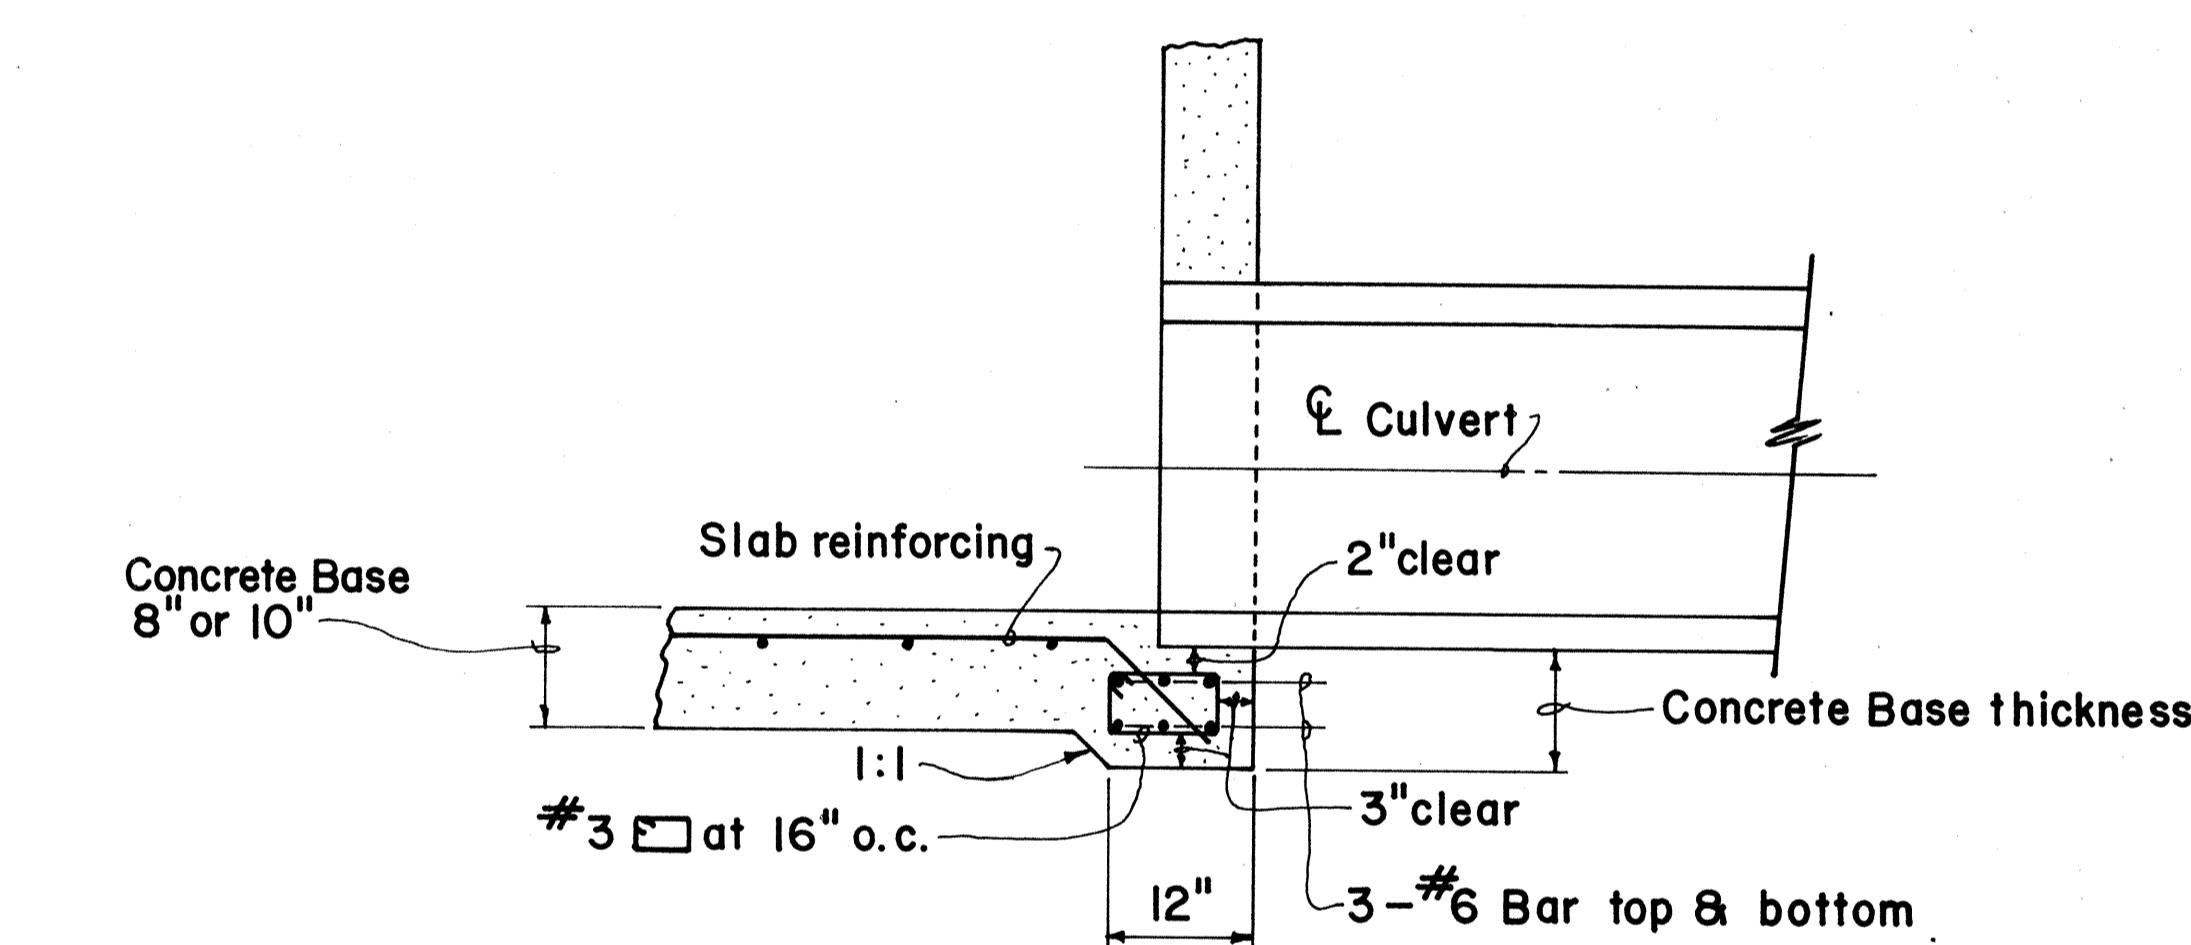

**DETAIL OF CULVERT SEAT**

APPROVAL RECOMMENDED:

*Y. Takano*  
HYDRAULIC DESIGN ENGINEER

8-20-80  
DATE

APPROVED:

*Robert Takishi*  
ASSISTANT CHIEF, ENGINEERING


8-20-80  
DATE

| NO. | REVISION                               | APPROVED BY | DATE    |
|-----|--|-------------|---------|
| 1.  | Supersedes Sht. DH 5 approved 12-17-69 | H.F.        | 8/20/80 |
| 2.  | Change Class of concrete               | H.F.        | 12/4/80 |


|  |  |                   |  |
|--|--|-------------------|--|
| STATE OF HAWAII<br>DEPARTMENT OF TRANSPORTATION<br>HIGHWAYS DIVISION |  |                   |  |
| STANDARD DETAILS   |  |                   |  |
| TYPE D AND E<br>STORM DRAIN MANHOLE                                  |  |                   |  |
| Not To Scale   |  | Date: August 1980 |  |

SHEET NO. 56 OF 30 SHEETS DH5A


| FED. ROAD<br>DIST. NO. | STATE | FED. AID<br>PROJ. NO. | FISCAL<br>YEAR | SHEET<br>NO. | TOTAL<br>SHEETS |
|------------------------|-------|-----------------------|----------------|--------------|-----------------|
| HAWAII                 | HAW.  | I-HI-1(187)           | 1984           | 85           | 197             |

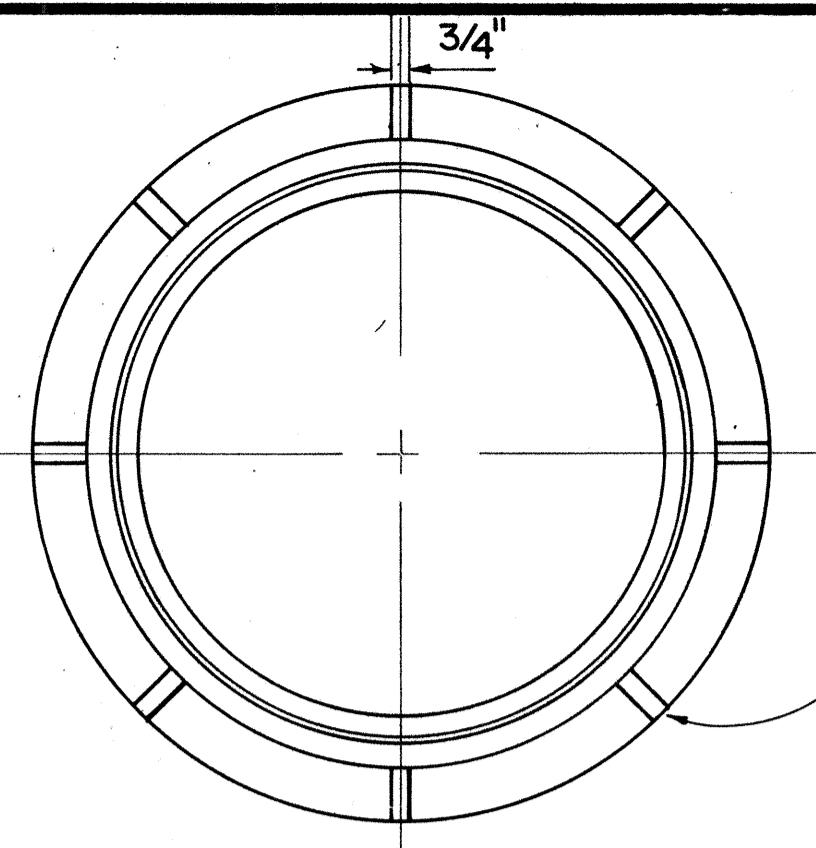


PLAN OF FRAME

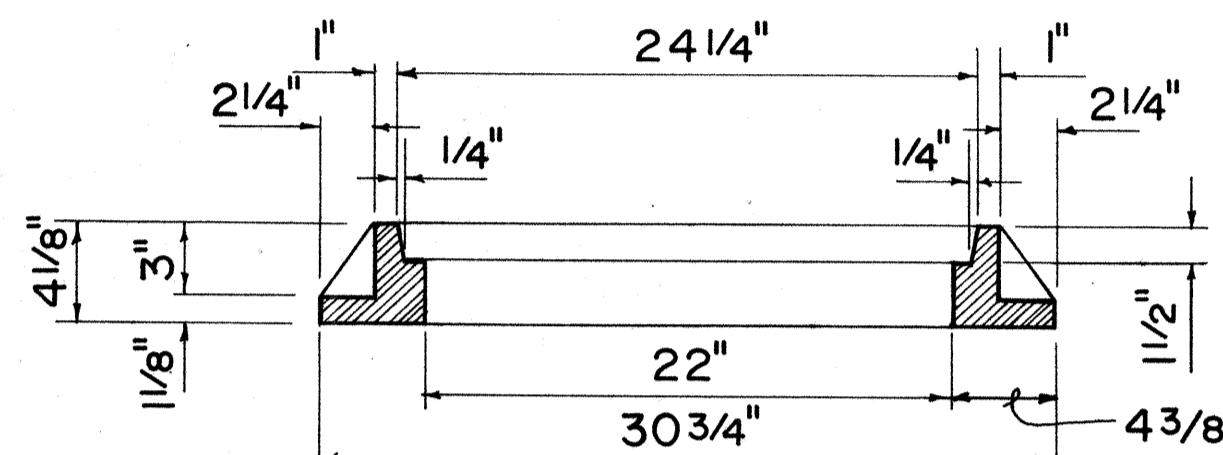


SECTION OF FRAME

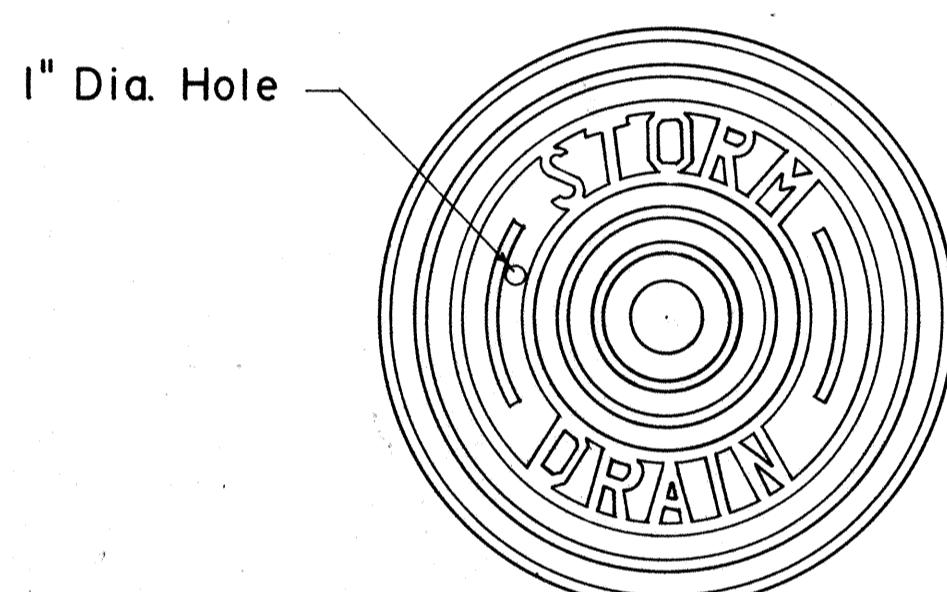

TOP VIEW OF COVER

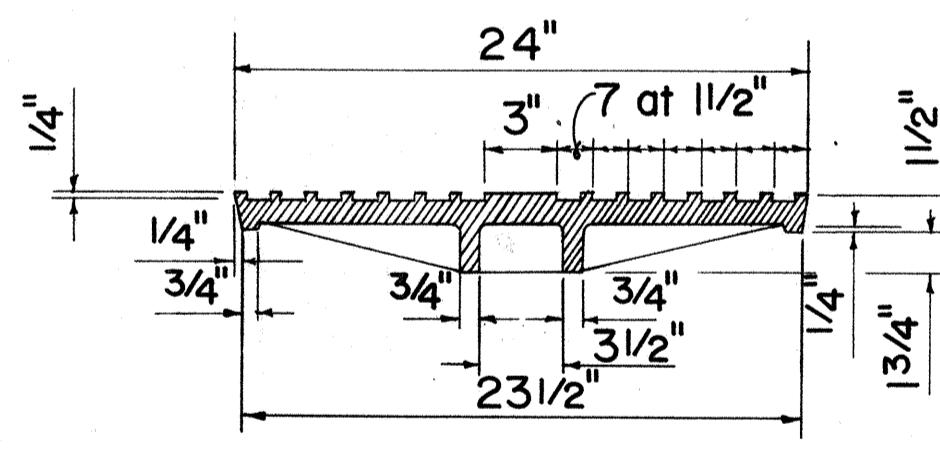


SECTION

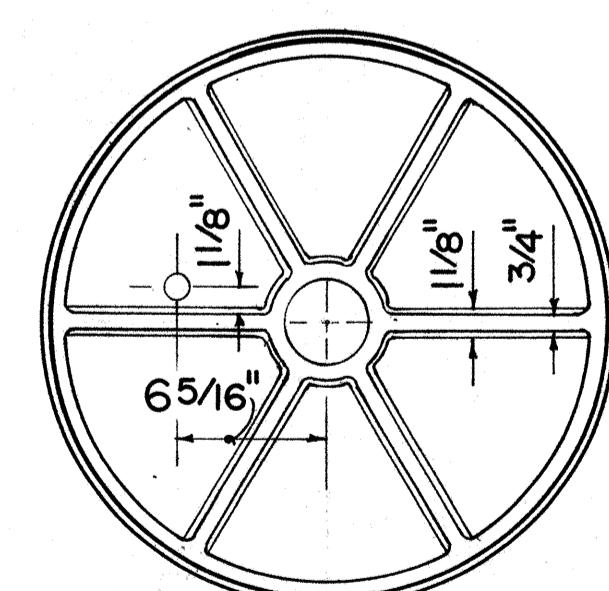


BOTTOM VIEW OF COVER

**TYPE "P" CAST IRON  
FRAME AND COVER**

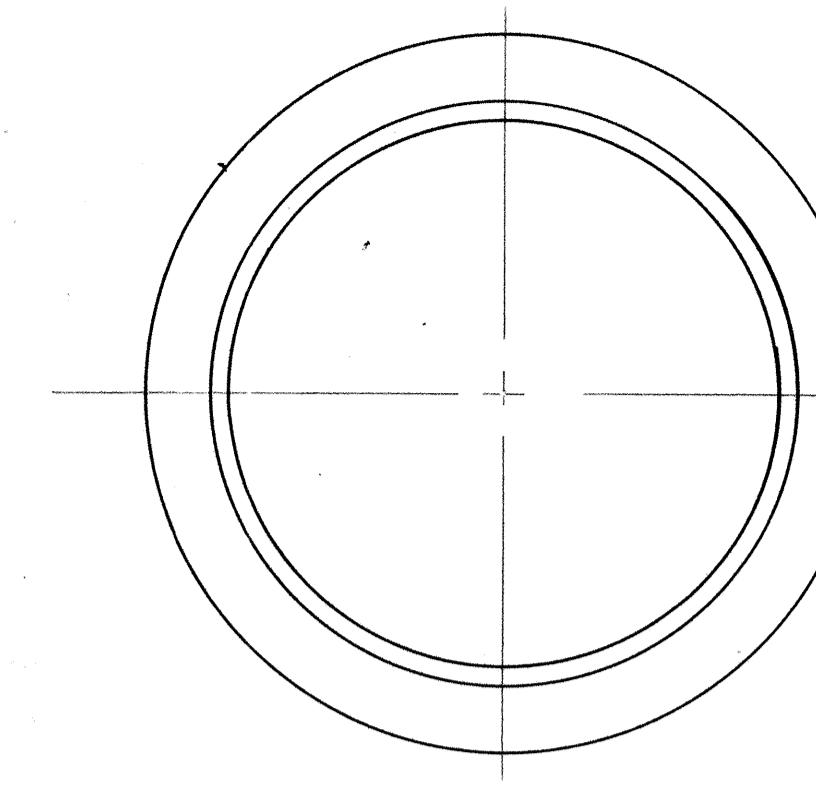


PLAN OF FRAME

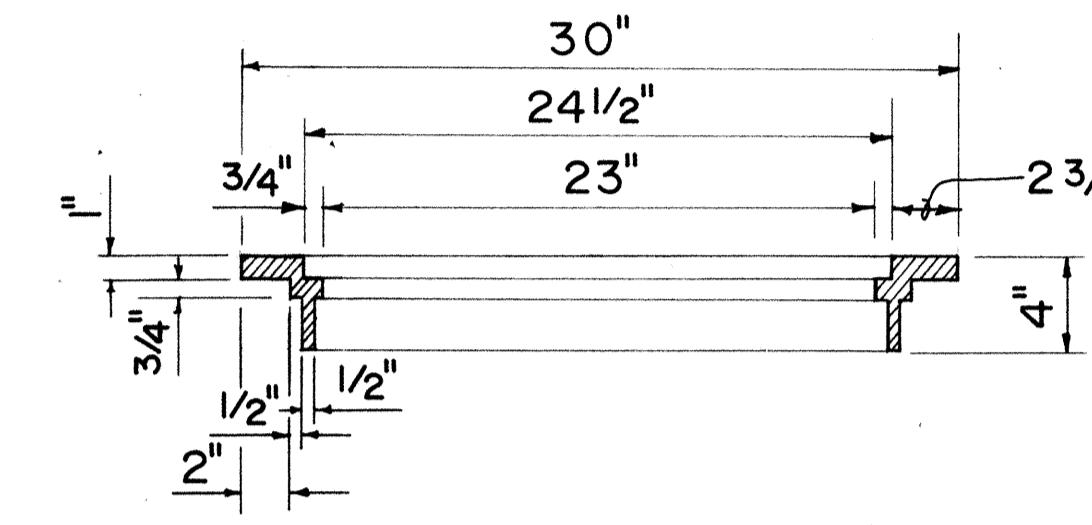


SECTION OF FRAME



TOP VIEW OF COVER

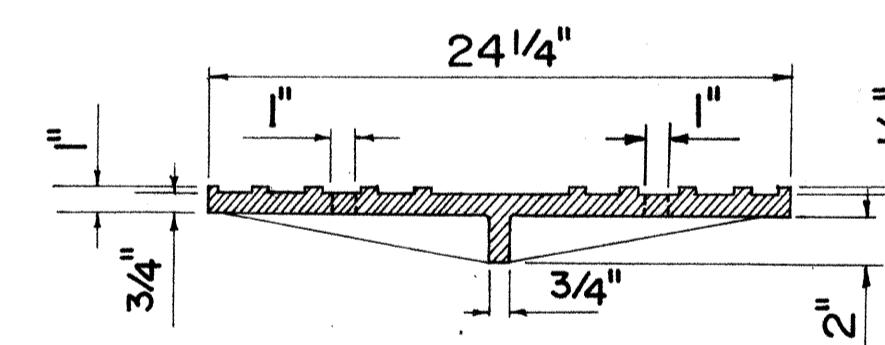


SECTION

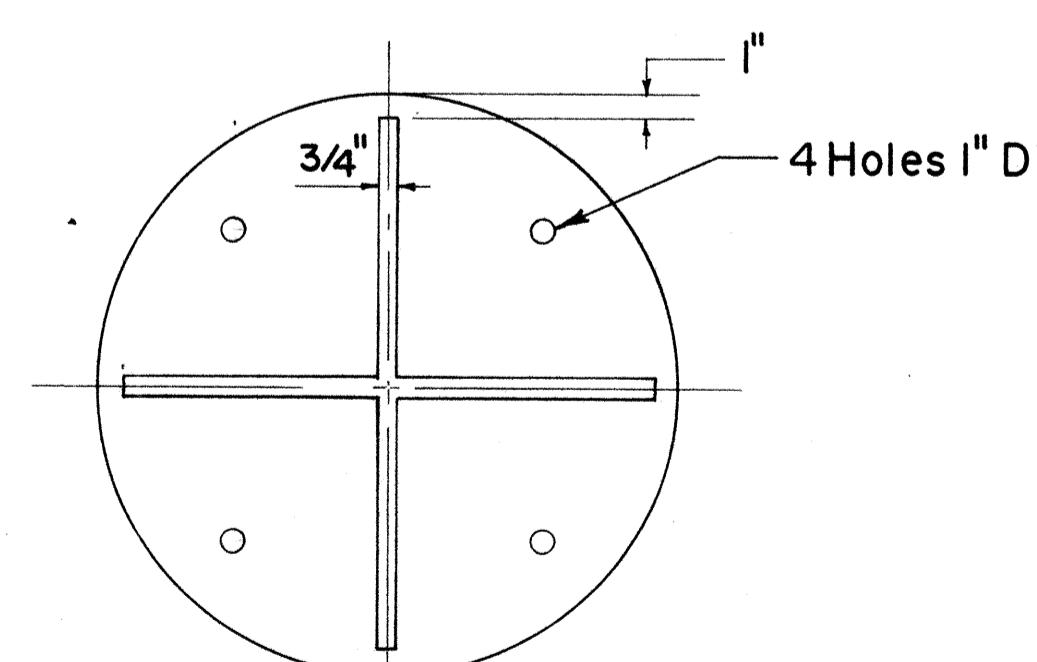


BOTTOM VIEW OF COVER


**TYPE "B" CAST IRON  
FRAME AND COVER**

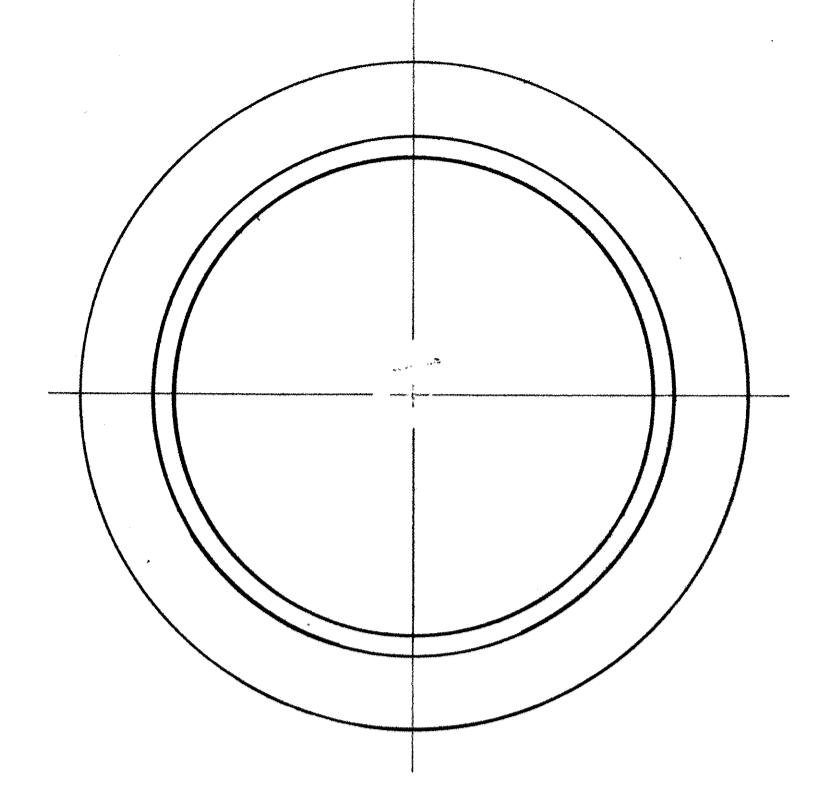


PLAN OF FRAME

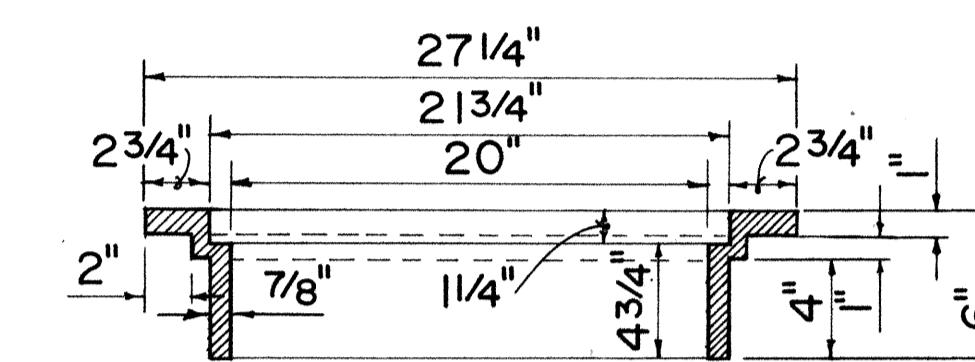


SECTION OF FRAME

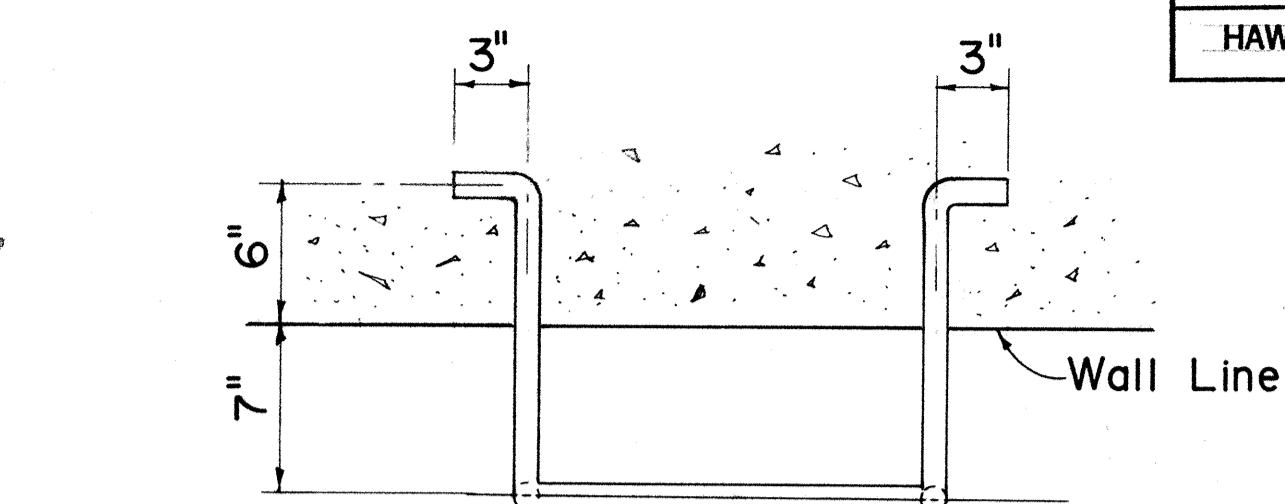


PLAN

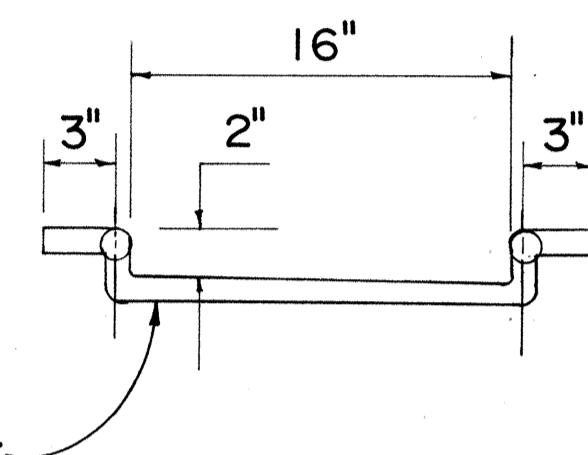


FRONT VIEW

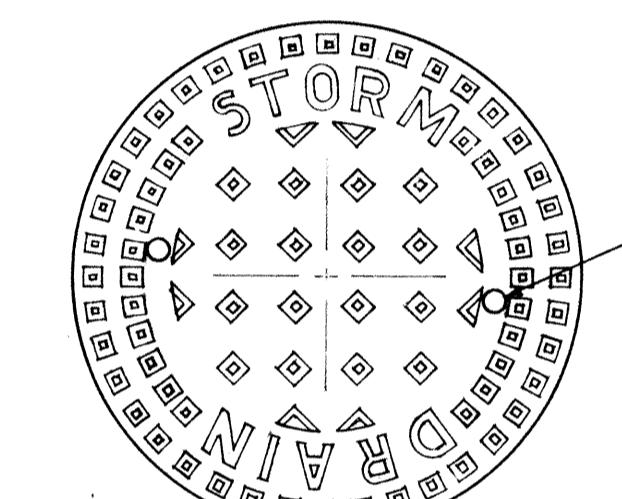


TOP VIEW OF COVER

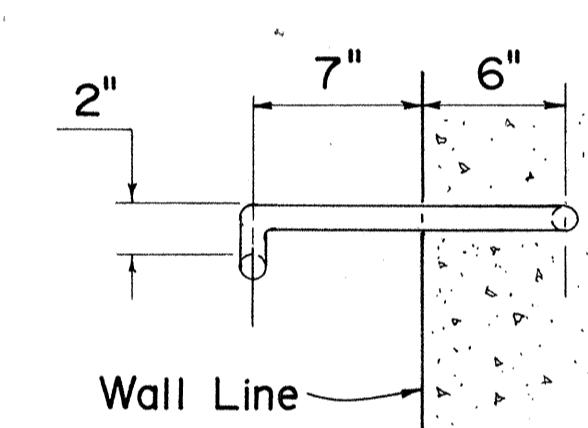

SIDE VIEW

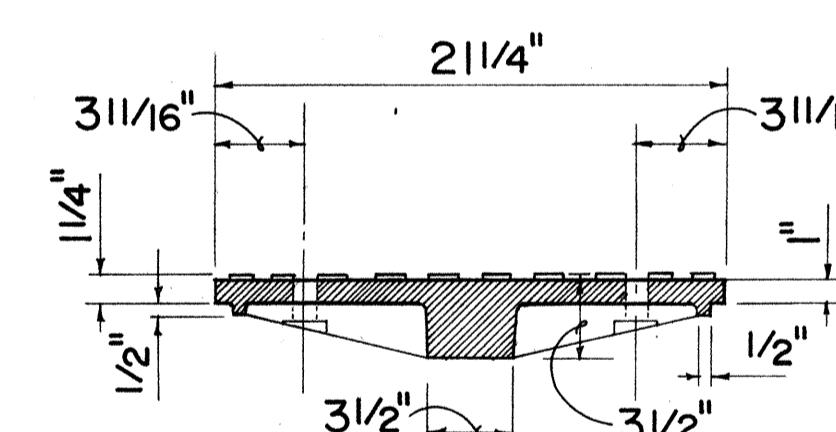

SECTION

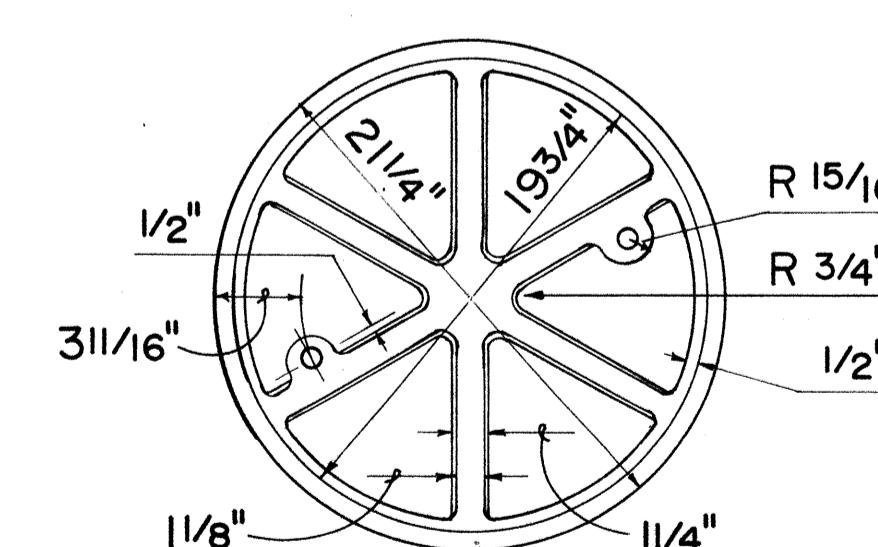

BOTTOM VIEW OF COVER

**TYPE "A" CAST IRON  
FRAME AND COVER**

|                            |       |
|----------------------------|-------|
| ORIGINAL SURVEY PLOTTED BY | _____ |
| DRAWN BY                   | _____ |
| TRACED BY                  | _____ |
| DESIGNED BY                | _____ |
| QUANTITY BY                | _____ |
| CHECKED BY                 | _____ |
| NOTE BOOK                  | _____ |
| PLAN                       | _____ |
| NO.                        | _____ |





APPROVAL RECOMMENDED:  
*Takano* 6-19-79  
HYDRAULIC DESIGN ENGINEER  
DATE

APPROVED:  
*Herbert Takemoto* 6-22-79  
ASSISTANT CHIEF, ENGINEERING  
DATE




| NO. | REVISION                               | APPROVED BY | DATE    |
|-----|--|-------------|---------|
| I.  | Supersedes Sht. DH 6 approved 12-17-69 | H.P.        | 6/22/79 |

STATE OF HAWAII  
DEPARTMENT OF TRANSPORTATION  
HIGHWAYS DIVISION  
STANDARD DETAILS  
**CATCH BASIN AND  
MANHOLE CASTINGS**  
Not To Scale Date: Dec. 1977  
SHEET NO. 310 OF 30 SHEETS DH 6


| FED. ROAD<br>DIST. NO. | STATE | FED. AID<br>PROJ. NO. | FISCAL<br>YEAR | SHEET<br>NO. | TOTAL<br>SHEETS |
|------------------------|-------|-----------------------|----------------|--------------|-----------------|
| HAWAII                 | HAW.  | I-H1-1(107)           | 1984           | 86           | 197             |

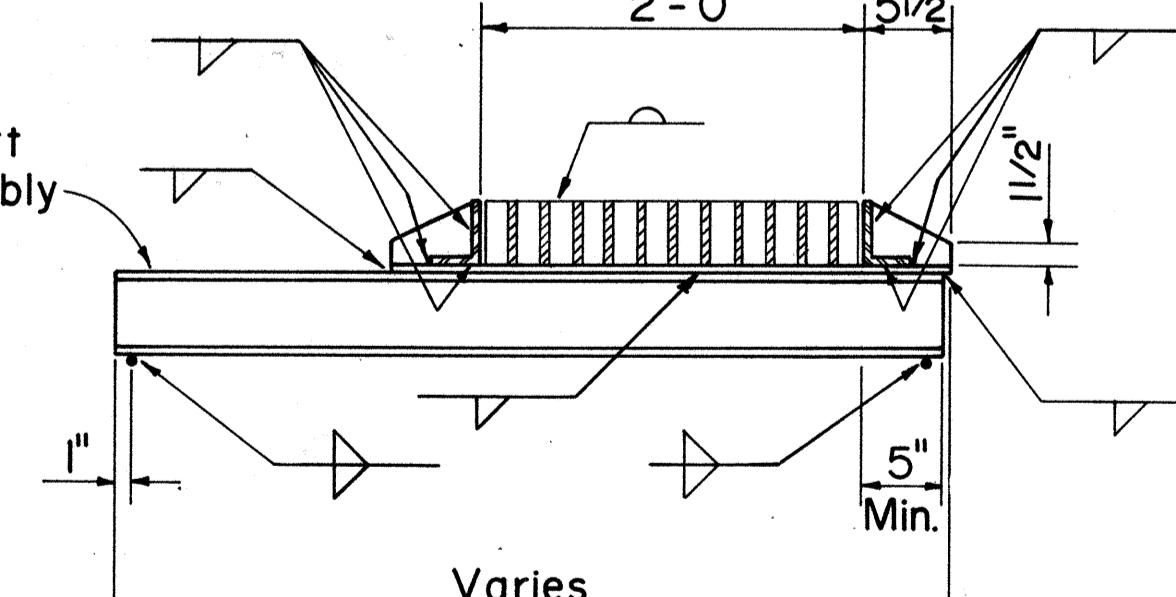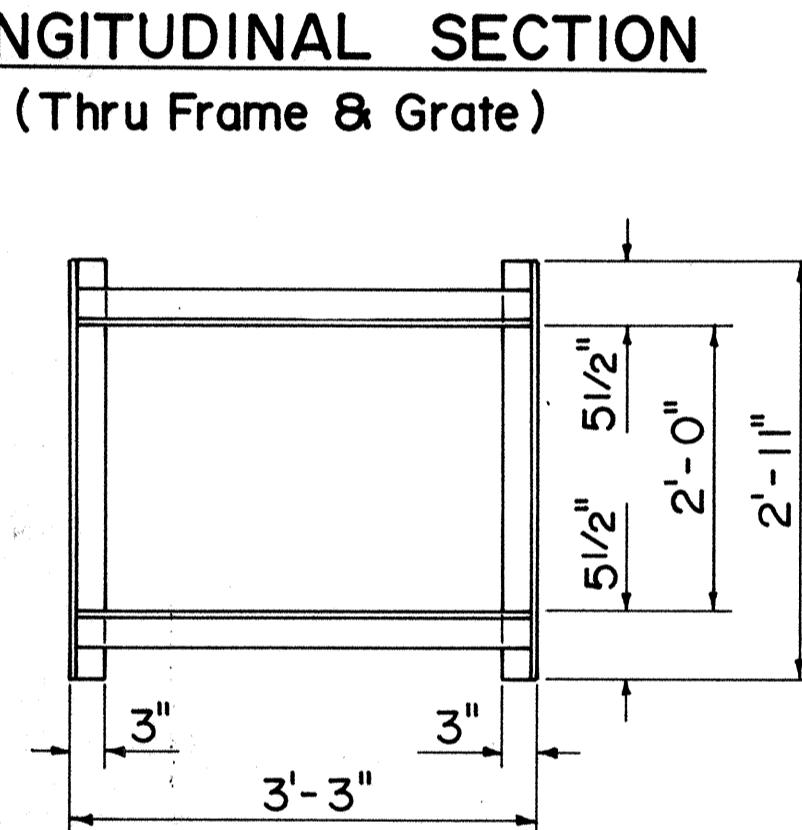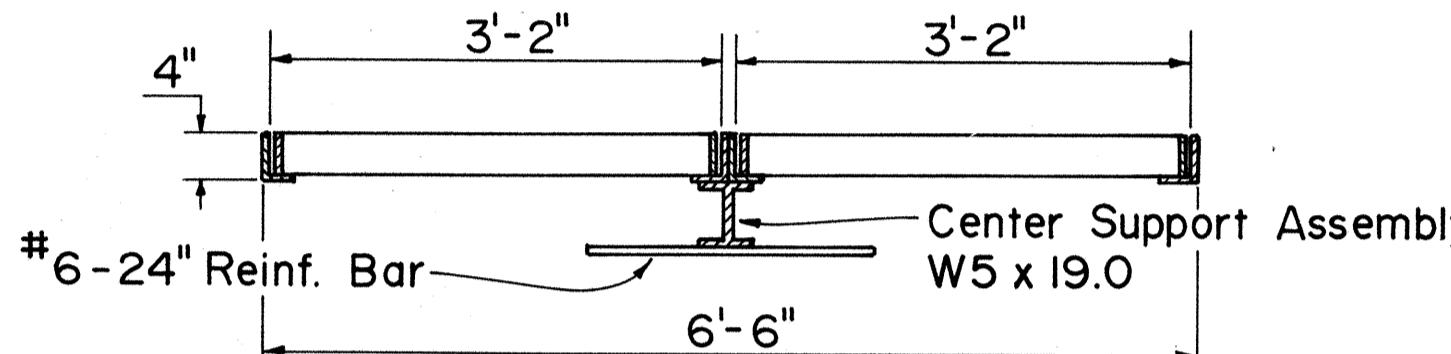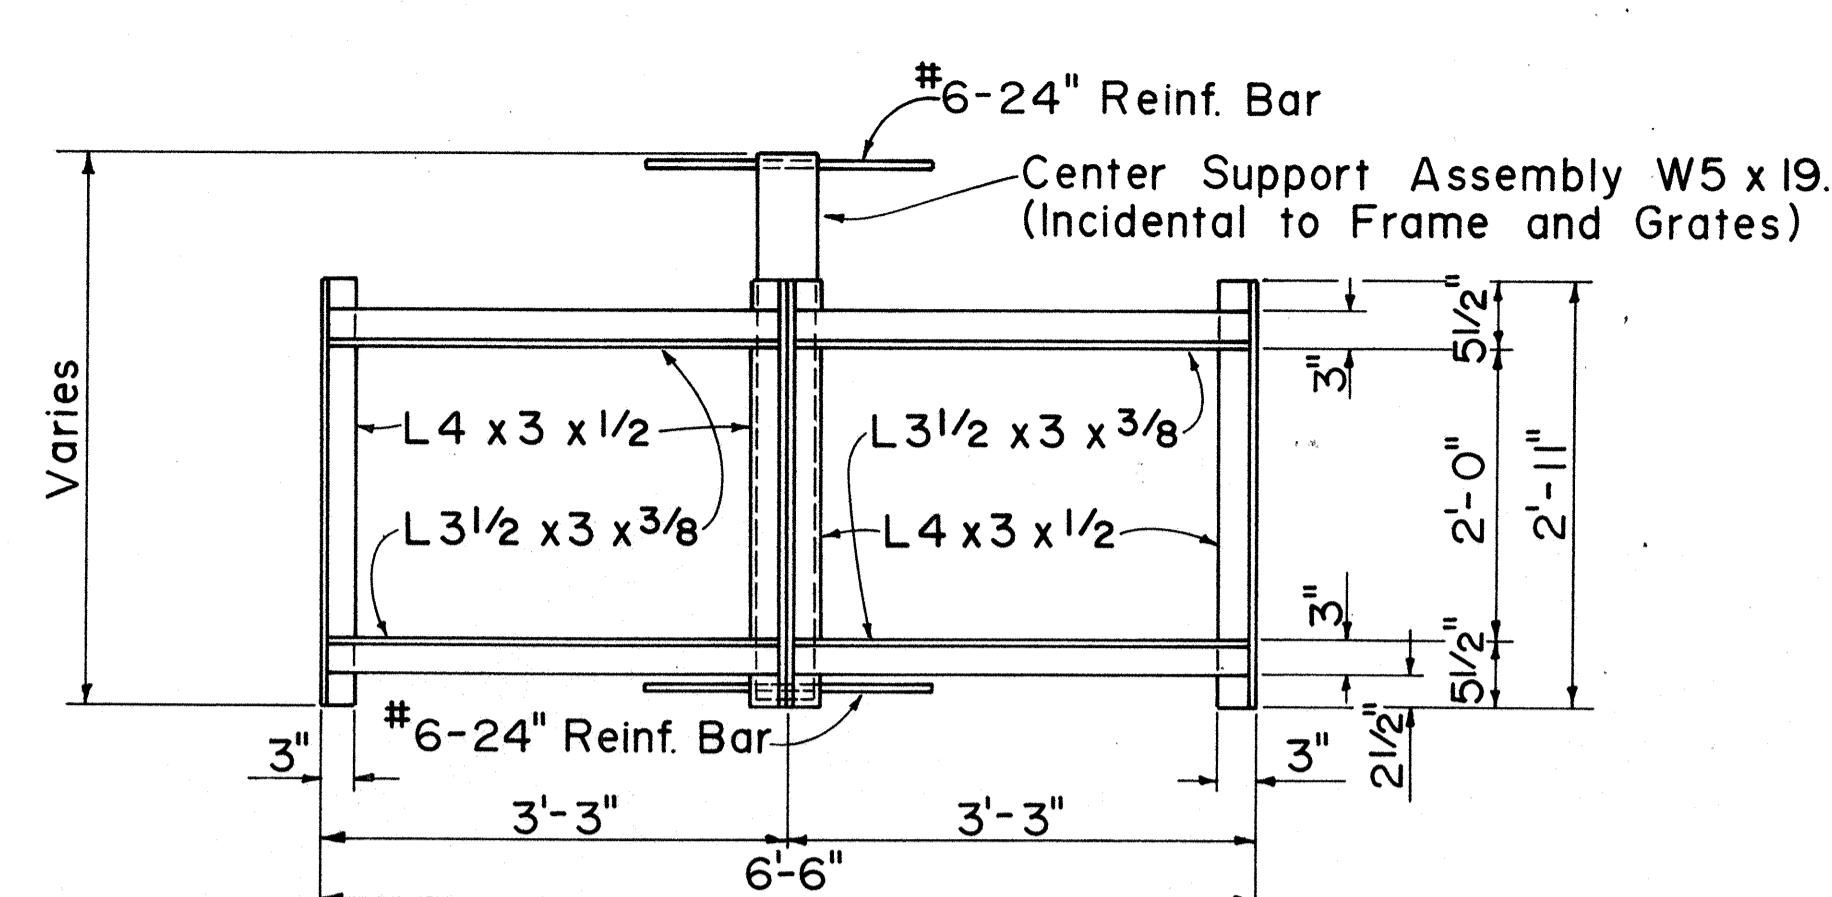



### FRAME DETAILS

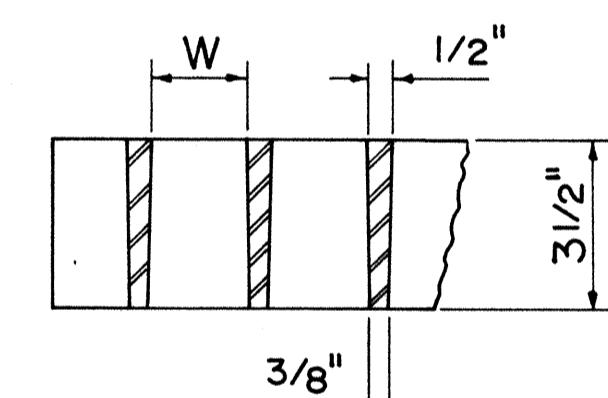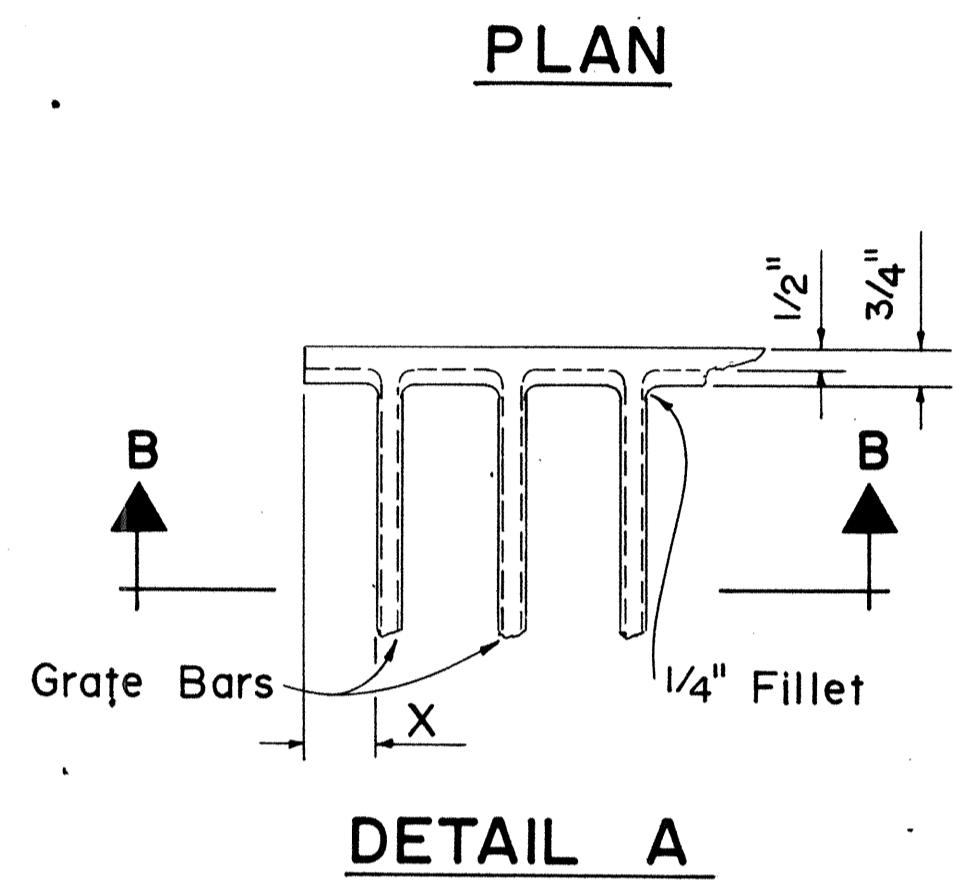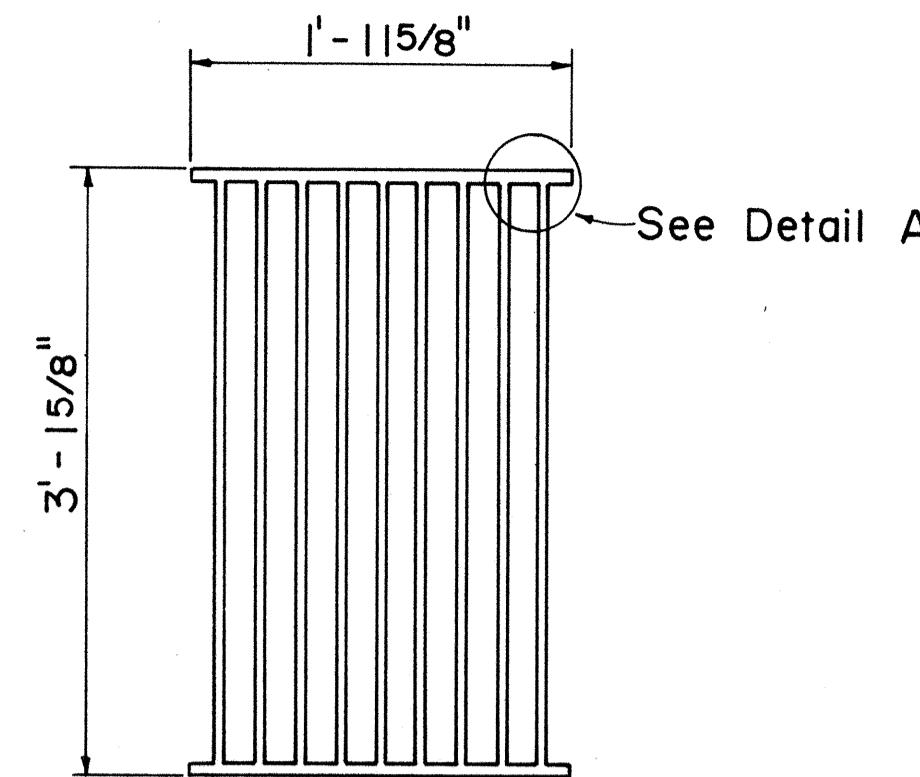


### ALTERNATIVE CAST MALLEABLE IRON OR CAST STEEL GRATE

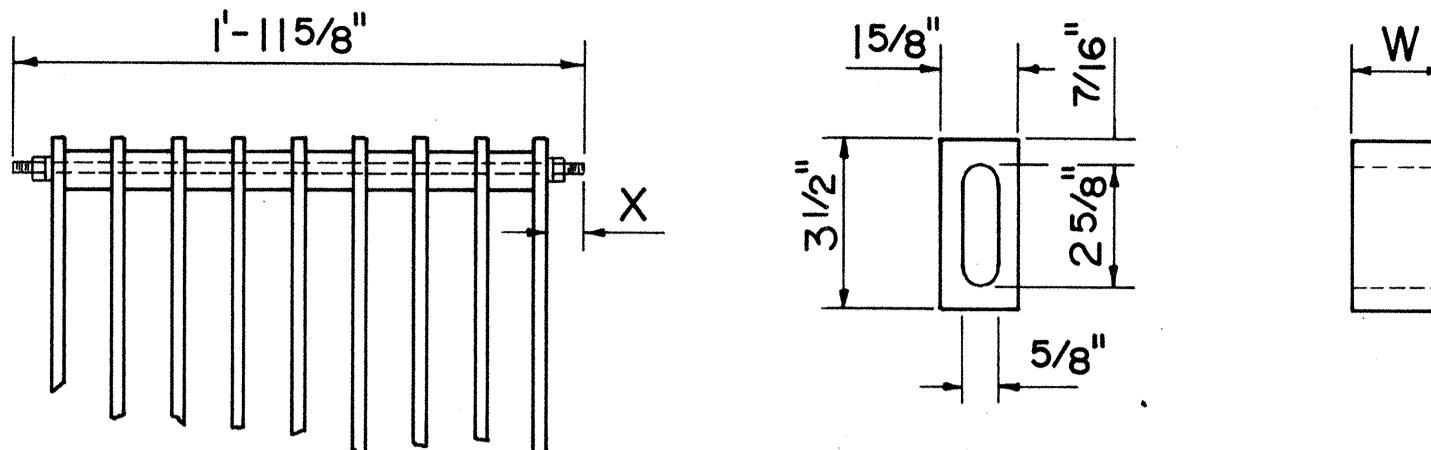

### BAR SPACER

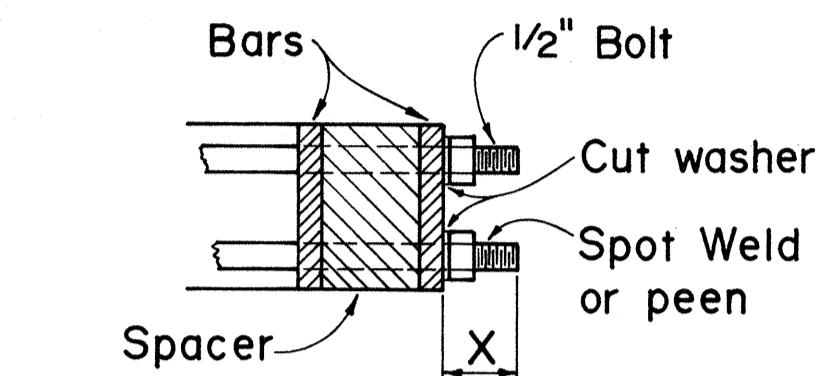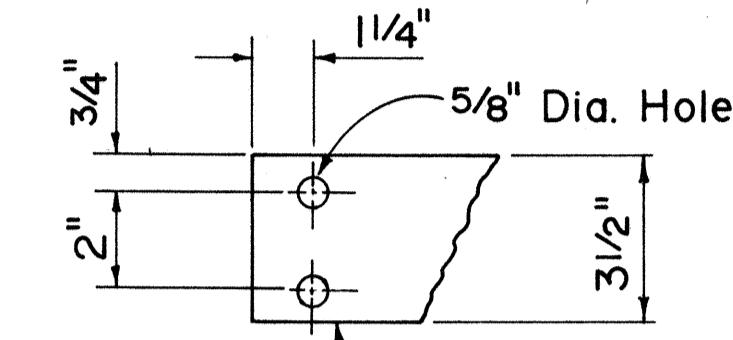

### ALTERNATIVE BOLTED GRATE

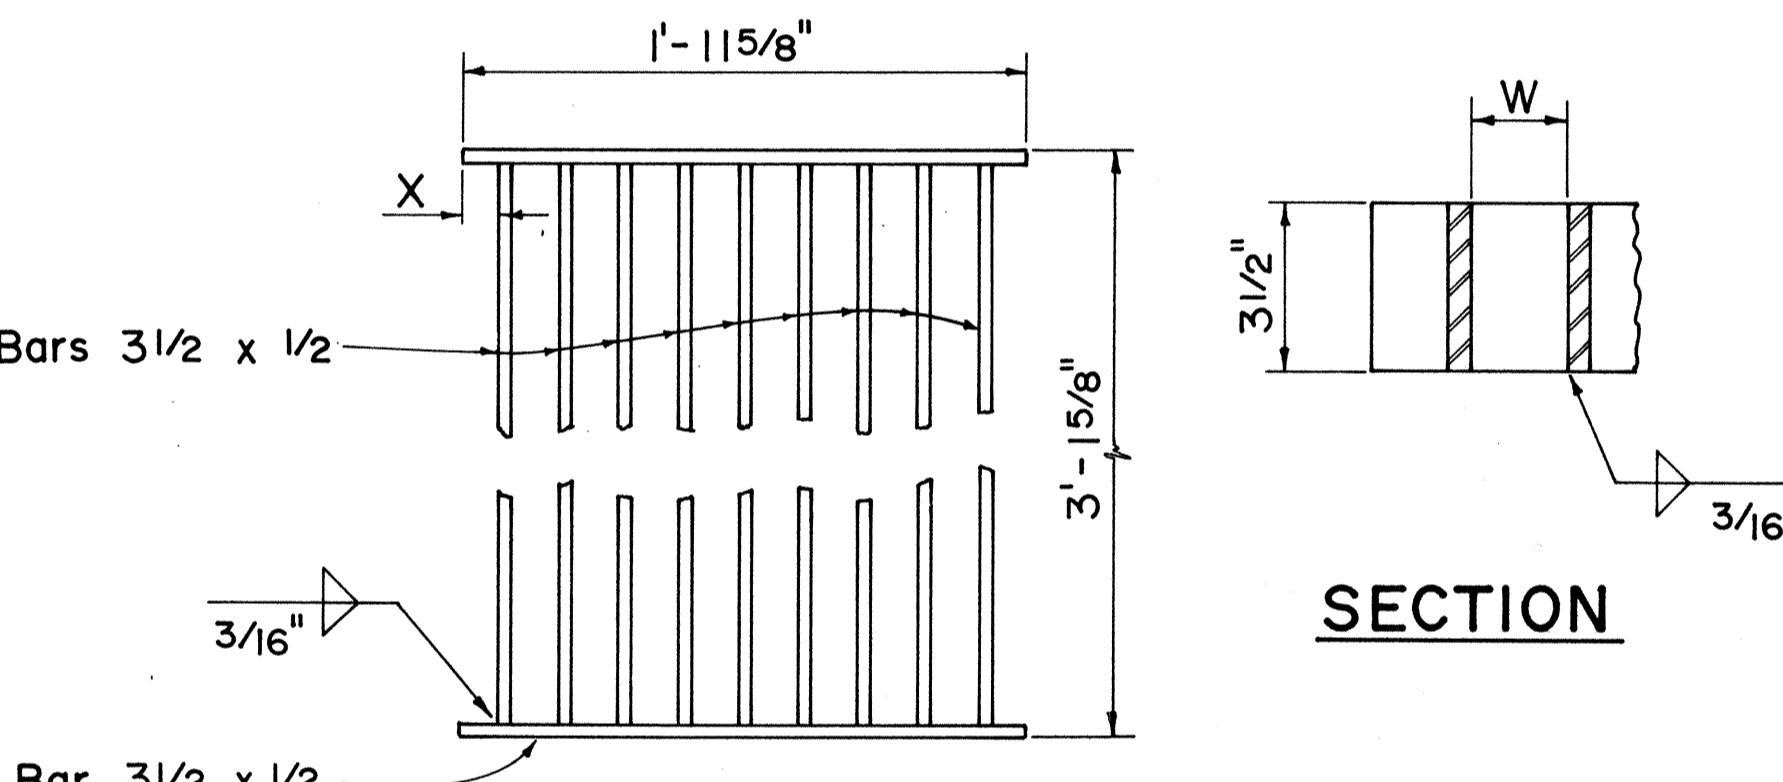

### PLAN

### ALTERNATIVE WELDED GRATE

| GRATE BAR SPACING TABLE |          |                     |         |
|-------------------------|----------|---------------------|---------|
| TYPE                    | NO. BARS | CLEAR BAR SPACING-W | X       |
| A-9                     | 9        | 2"                  | 1 9/16" |
| A-12                    | 12       | 1 3/8"              | 1 1/4"  |



| NO. | REVISION  | APPROVED BY | DATE    |
|-----|---|-------------|---------|
| 1.  | Supersedes Sht. DH 7 approved 12-17-69                | H.I.        | 6/22/79 |
| 2.  | Revise standard nomenclature for rolled steel shapes. | H.I.        | 4/21/82 |

APPROVAL RECOMMENDED:  
*J. Takano*  
HYDRAULIC DESIGN ENGINEER  
DATE: 6-19-79



APPROVED:  
*Robert Zalewski*  
ASSISTANT CHIEF, ENGINEERING  
DATE: 6-22-79

STATE OF HAWAII  
DEPARTMENT OF TRANSPORTATION  
HIGHWAYS DIVISION  
STANDARD DETAILS  
TYPE A-9 AND A-12  
FRAMES AND GRATES  
Not To Scale Date: Dec. 1977  
SHEET NO. 30 OF 30 SHEETS DH 7

| FED. ROAD<br>DIST. NO. | STATE | FED. AID<br>PROJ. NO. | FISCAL<br>YEAR | SHEET<br>NO. | TOTAL<br>SHEETS |
|------------------------|-------|-----------------------|----------------|--------------|-----------------|
| HAWAII                 | HAW.  | I-HI-1(07)            | 1984           | 87           | 197             |

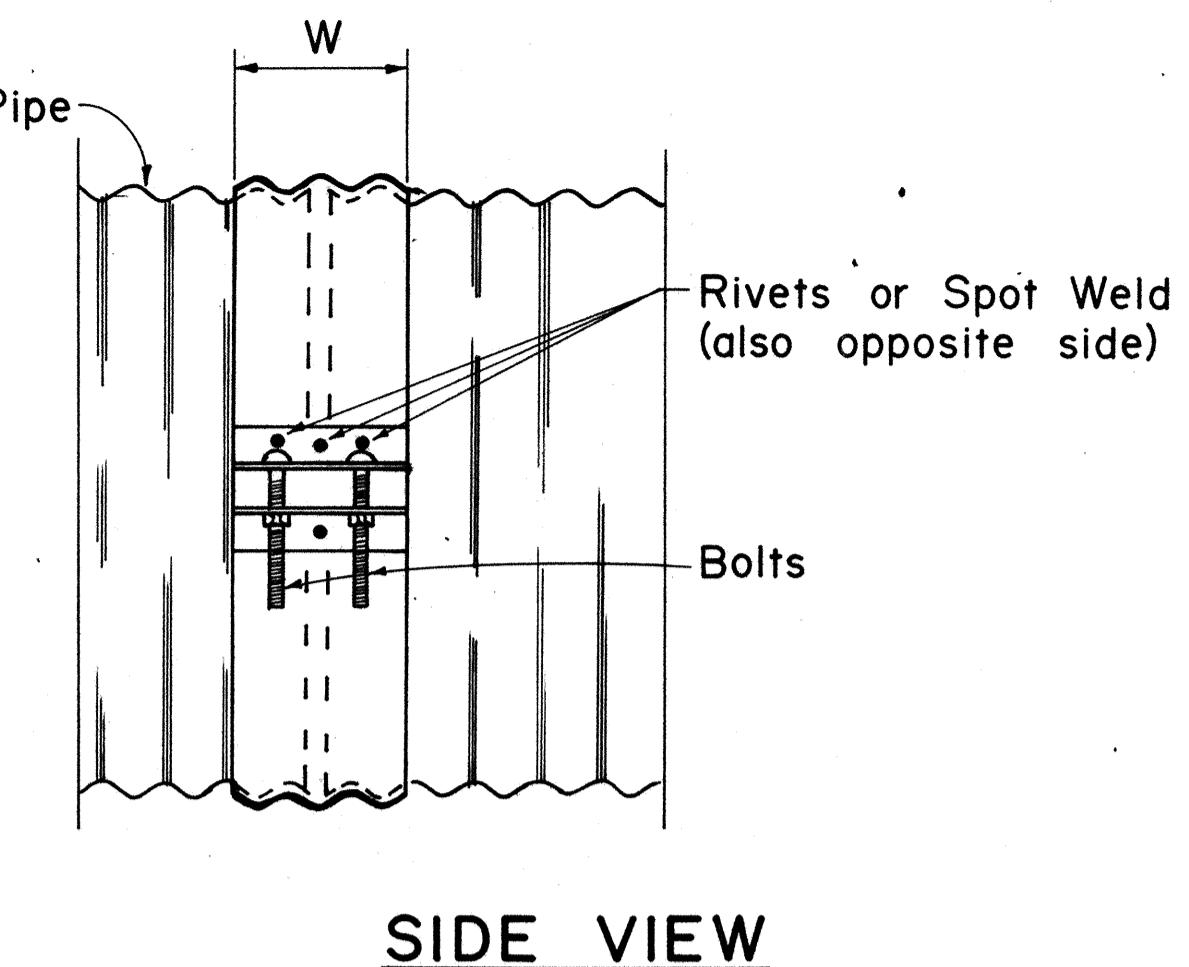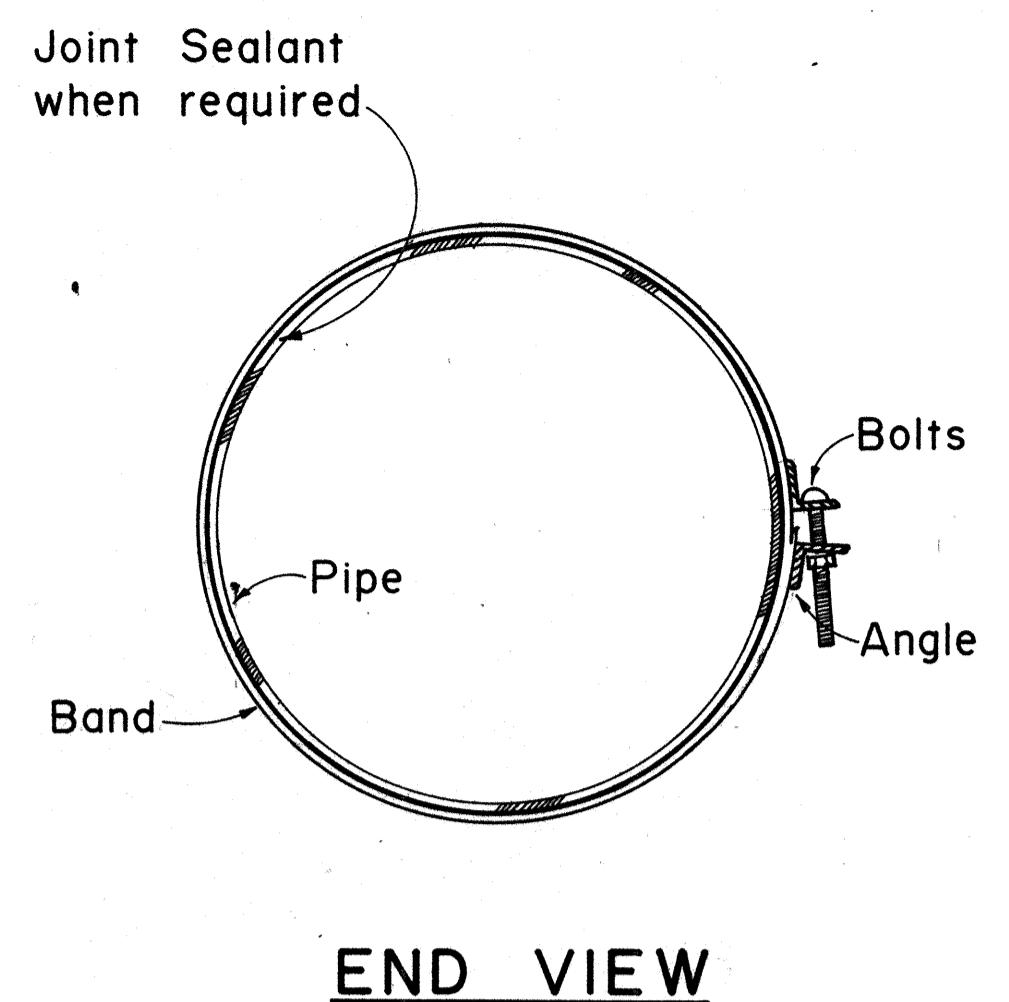

### ANNULAR COUPLING BAND

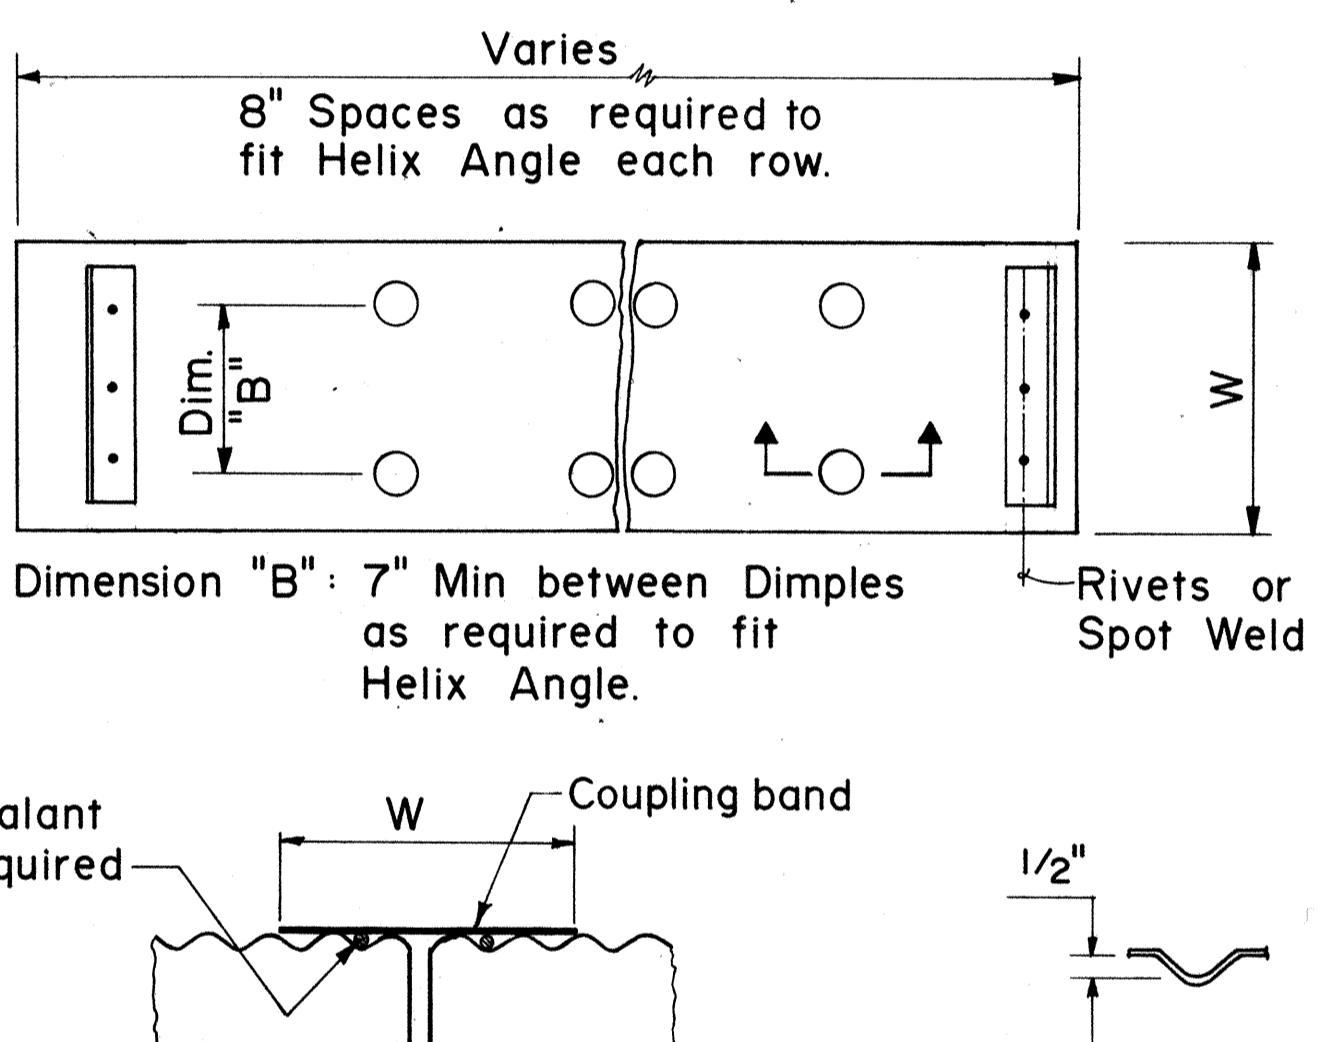
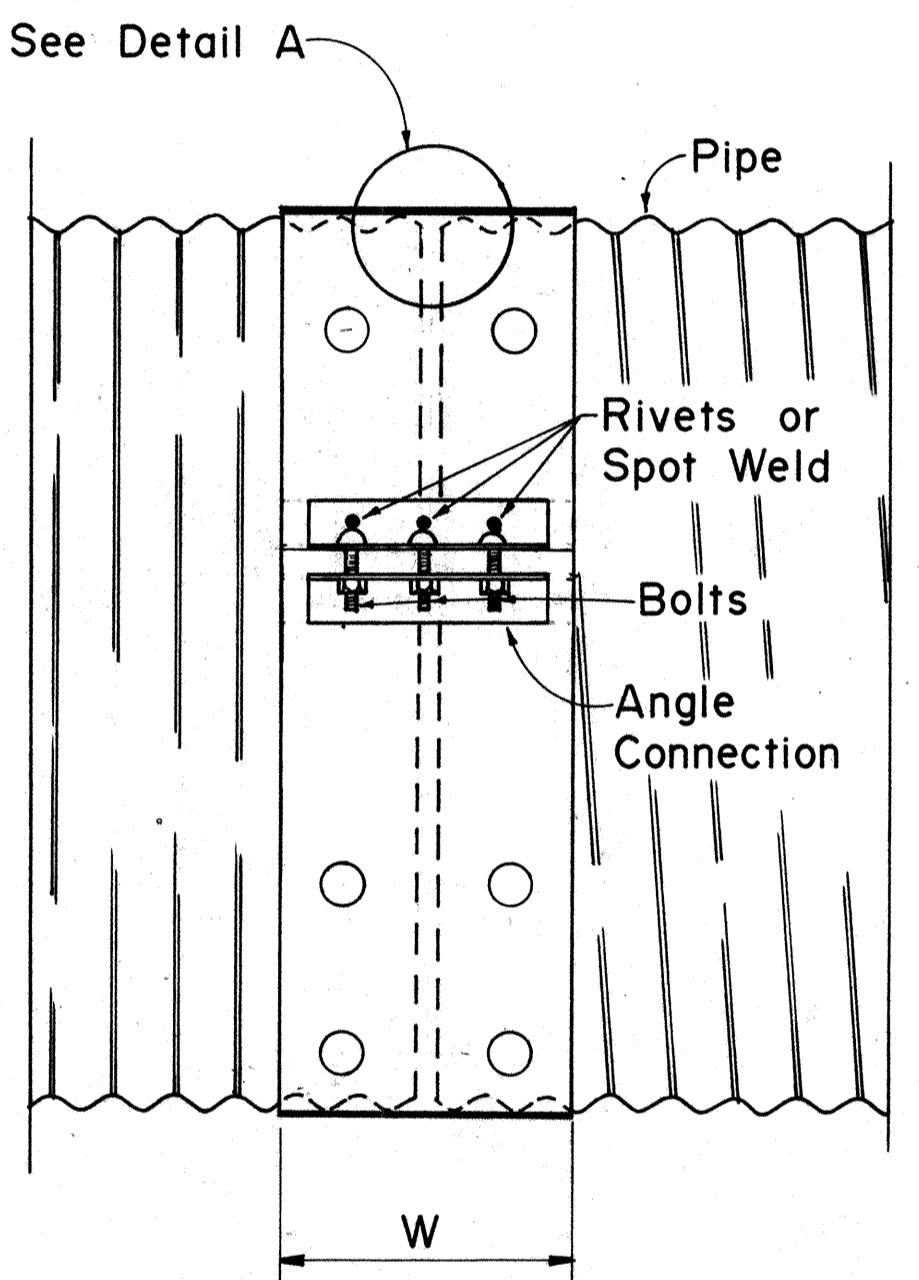


DETAIL A

SECTION THRU  
DIMPLES

### UNIVERSAL COUPLING BAND ANGLE CONNECTION

### CHANNEL COUPLING BAND FOR USE ON REFORMED END C.M.P.

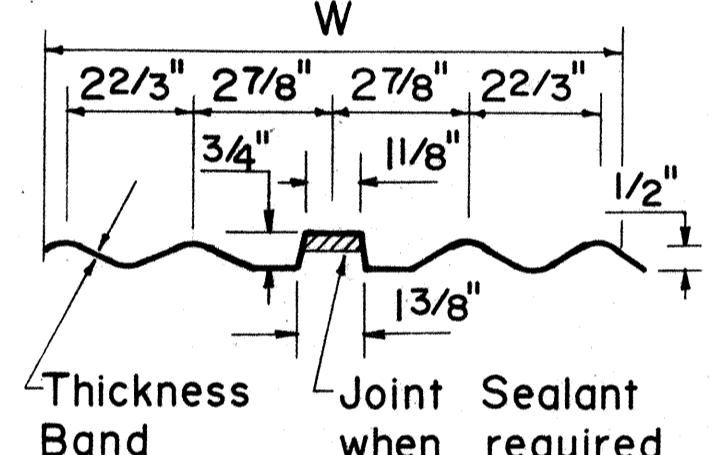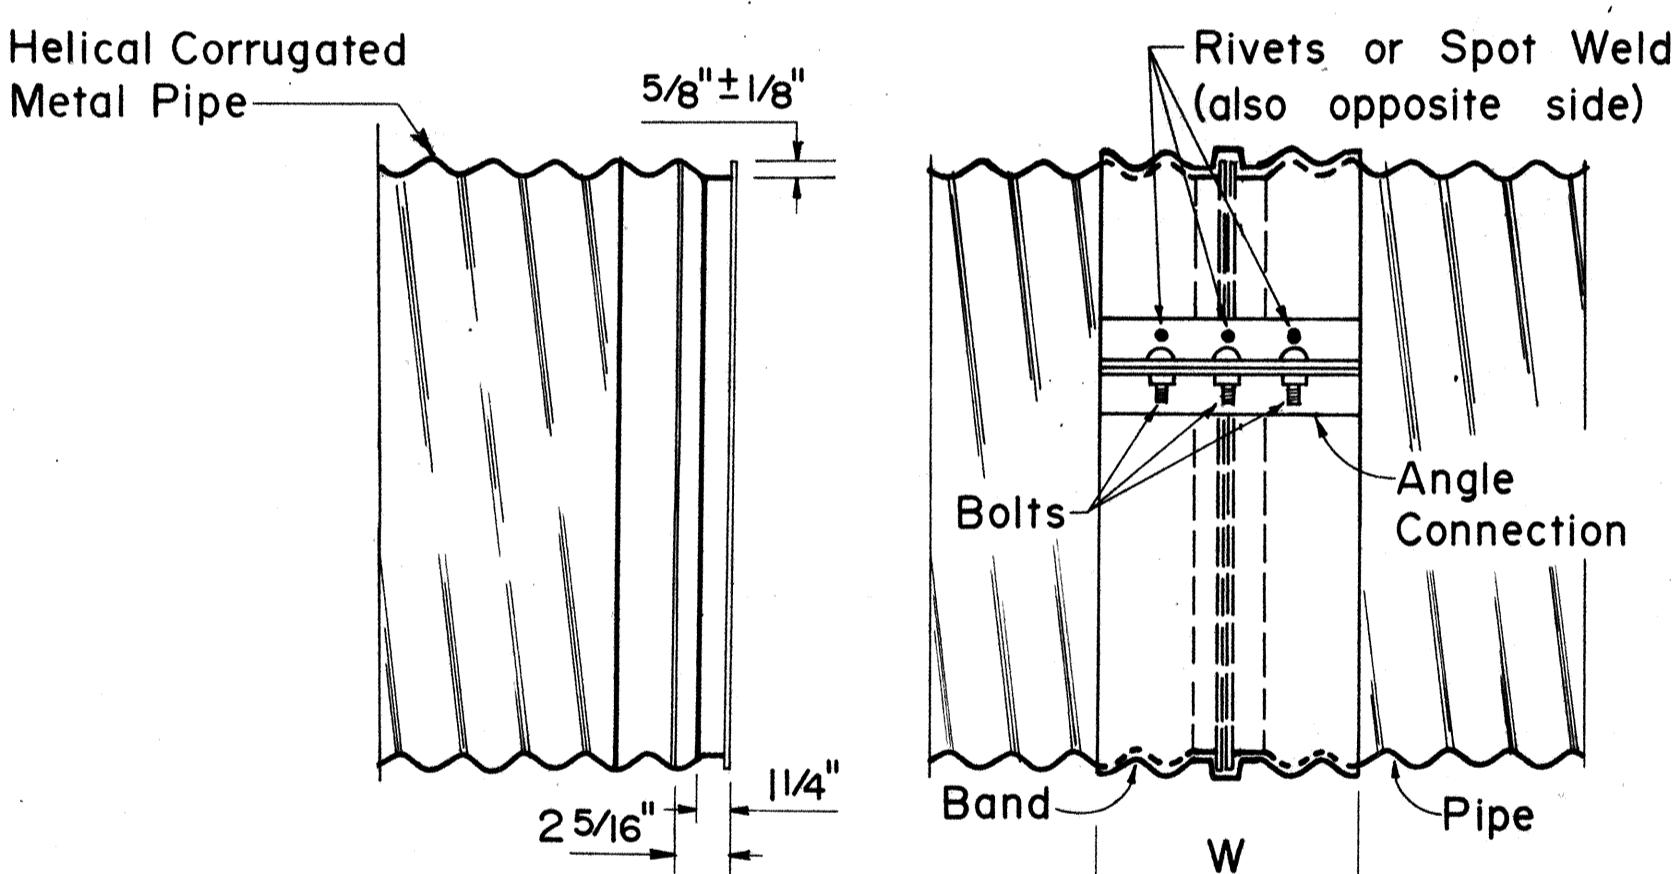

SECTION

REFORMED END SIDE VIEW

### WING CHANNEL COUPLING BAND FOR REFORMED END H.C.M.P.

| COUPLING TYPE | CORRUGATION  | PIPE SIZE | W      | PIPE WALL THICKNESS | ANGLE CONNECTIONS - QUANTITIES PER CONNECTION |              |                  |
|---------------|--------------|-----------|--------|---------------------|---|--------------|------------------|
|               |              |           |        |                     | DIMENSIONS                                    | BOLTS        | RIVETS/SPOT WELD |
| UNIVERSAL     | 22 3/8 x 1/2 | 12 - 36   | 10 1/2 | 0.075-0.138         | 2ea 2x2x3/16x7                                | 2 ea 1/2 x 6 | 3ea 3/8 3ea 1/2  |
|               |              | 42 - 60   | 16 1/2 | 0.164-0.168         | 2ea 2x2x3/16x12                               | 3 ea 1/2 x 6 | 4ea 3/8 5ea 1/2  |
|               |              | 66 - 84   | 16 1/2 | 0.164-0.168         | 2ea 2x2x3/16x12                               | 3 ea 1/2 x 6 | 4ea 3/8          |
|               | 3 x 1        | 36 - 72   | 10 1/2 | 0.075-0.138         | 2ea 2x2x3/16x7                                | 2 ea 1/2 x 6 | 3ea 3/8          |
|               |              | 78 - 120  | 16 1/2 | 0.075-0.138         | 2ea 2x2x3/16x12                               | 3 ea 1/2 x 6 | 4ea 3/8          |
|               |              |           |        |                     |   |              |                  |
| ANNUAL        | 22 3/8 x 1/2 | 12 - 36   | 7      | 0.075-0.138         | 2ea 2x2x3/16x7                                | 2 ea 1/2 x 6 | 3ea 3/8 3ea 1/2  |
|               |              | 42 - 72   | 12     | 0.075-0.168         | 2ea 2x2x3/16x12                               | 3 ea 1/2 x 6 | 4ea 3/8 5ea 1/2  |
|               |              | 78 - 84   | 12     | 0.164-0.168         | 2ea 2x2x3/16x12                               | 3 ea 1/2 x 6 | 4ea 3/8 5ea 1/2  |
|               |              |           |        |                     |   |              |                  |
|               | 3 x 1        | 36 - 42   | 14     | 0.075-0.109         | 2ea 2x2x3/16x12                               | 3 ea 1/2 x 6 | 4ea 3/8          |
|               |              | 48 - 84   | 14     | 0.075-0.109         | 2ea 2x2x3/16x12                               | 3 ea 1/2 x 6 | 4ea 3/8 5ea 1/2  |
|               |              | 90 - 120  | 14     | 0.075-0.109         | 2ea 2x2x3/16x12                               | 3 ea 1/2 x 6 | 4ea 3/8          |
|               |              |           |        |                     |   |              |                  |

| COUPLING TYPE | CORRUGATION  | PIPE SIZE | W  | PIPE WALL THICKNESS | LUG TYPE CONNECTORS - QUANTITIES PER CONNECTION |              |          |
|---------------|--------------|-----------|----|---------------------|---|--------------|----------|
|               |              |           |    |                     | DIMENSIONS                                      | BOLTS        | SPOTWELD |
| CHANNEL       | 22 3/8 x 1/2 | 12 - 72   |    | 0.075-0.138         | 2ea Lugs  | 1 ea 1/2 x 6 | 4ea 1/2  |
|               |              | 36 - 72   |    | 0.075-0.138         | 2ea Lugs  | 1 ea 1/2 x 6 | 4ea 1/2  |
| WING          | 22 3/8 x 1/2 | 12 - 72   | 12 | 0.075-0.138         | 6ea Lugs  | 3 ea 1/2 x 6 | 12ea 1/2 |
|               |              | 78 - 84   | 12 | 0.164-0.168         | 6ea Lugs  | 3 ea 1/2 x 6 | 12ea 1/2 |
|               | 3 x 1        | 36 - 120  | 12 | 0.075-0.109         | 6ea Lugs  | 3 ea 1/2 x 6 | 12ea 1/2 |

| NO. | REVISION  | APPROVED BY | DATE   |
|-----|---|-------------|--------|
| 1.  | Revise pipe wall thickness from table and delete note #6. | 8/10        | 4-7-83 |

APPROVAL RECOMMENDED:  
*J. Takano*  
HYDRAULIC DESIGN ENGINEER  
DATE 9-7-79

APPROVED:  
*Z. Zelenka*  
ASSISTANT CHIEF, ENGINEERING  
DATE 9-14-79

STATE OF HAWAII  
DEPARTMENT OF TRANSPORTATION  
HIGHWAYS DIVISION  
STANDARD DETAILS  
C.M.P. COUPLING DETAILS  
STANDARD JOINT

Not To Scale Date: Sept. 1979

SHEET NO. 39D OF 39 SHEETS DH 18