



FED. ROAD DIST. NO.	STATE	FED. AID PROJ. NO.	FISCAL YEAR	SHEET NO.	TOTAL SHEETS
HAWAII	HAW.	I-HI-1(187)	1984	20	197

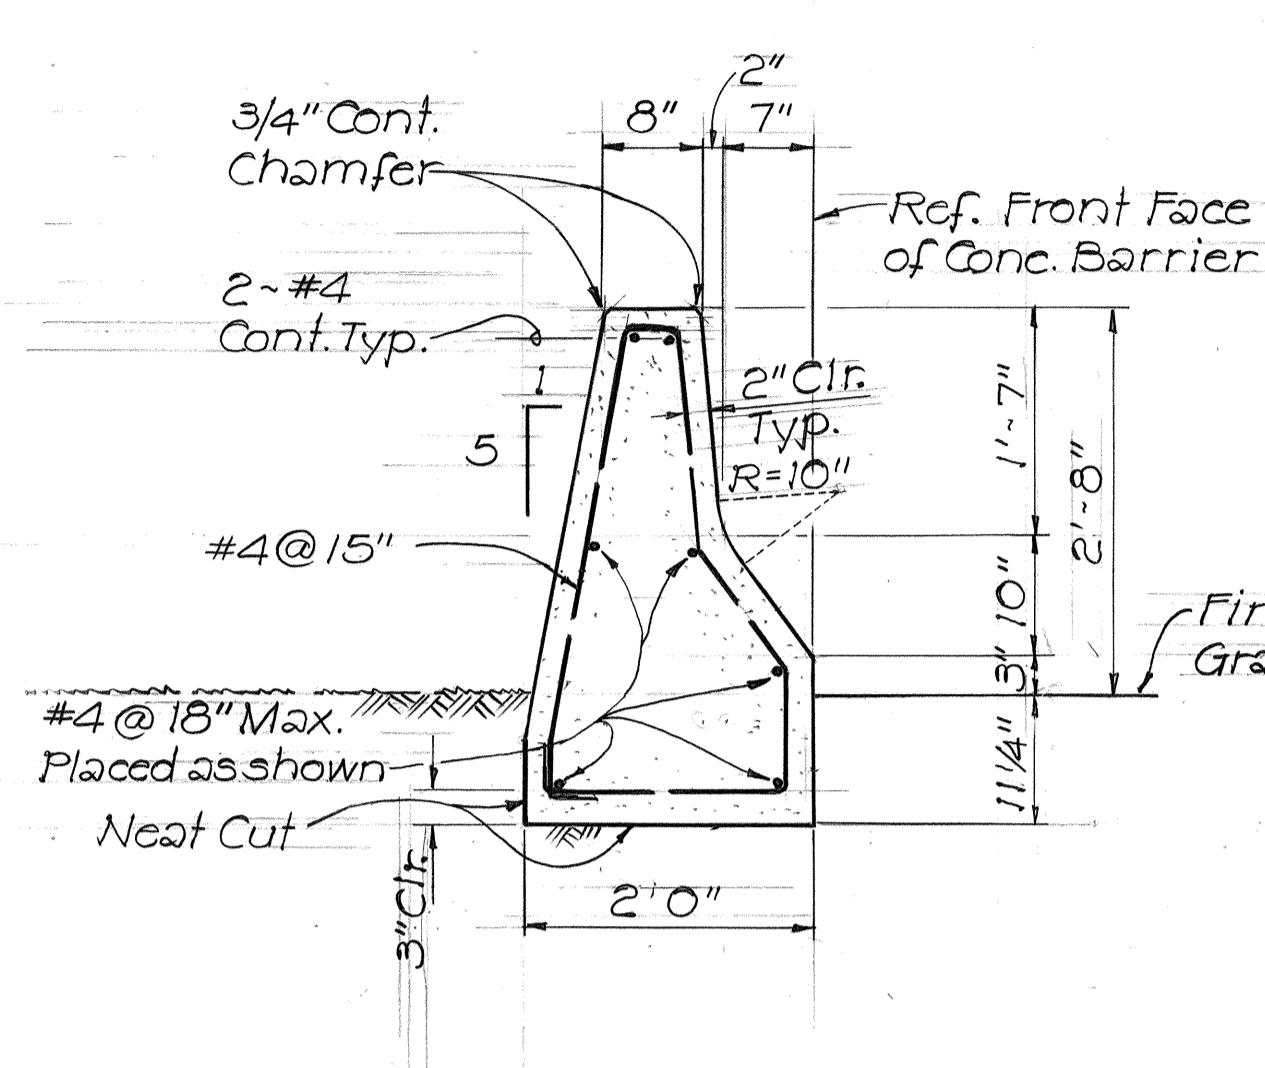


GUARD RAIL TYPE 4F
CONCRETE RIGID BARRIER

SCALE: 3/4" = 1'-0"

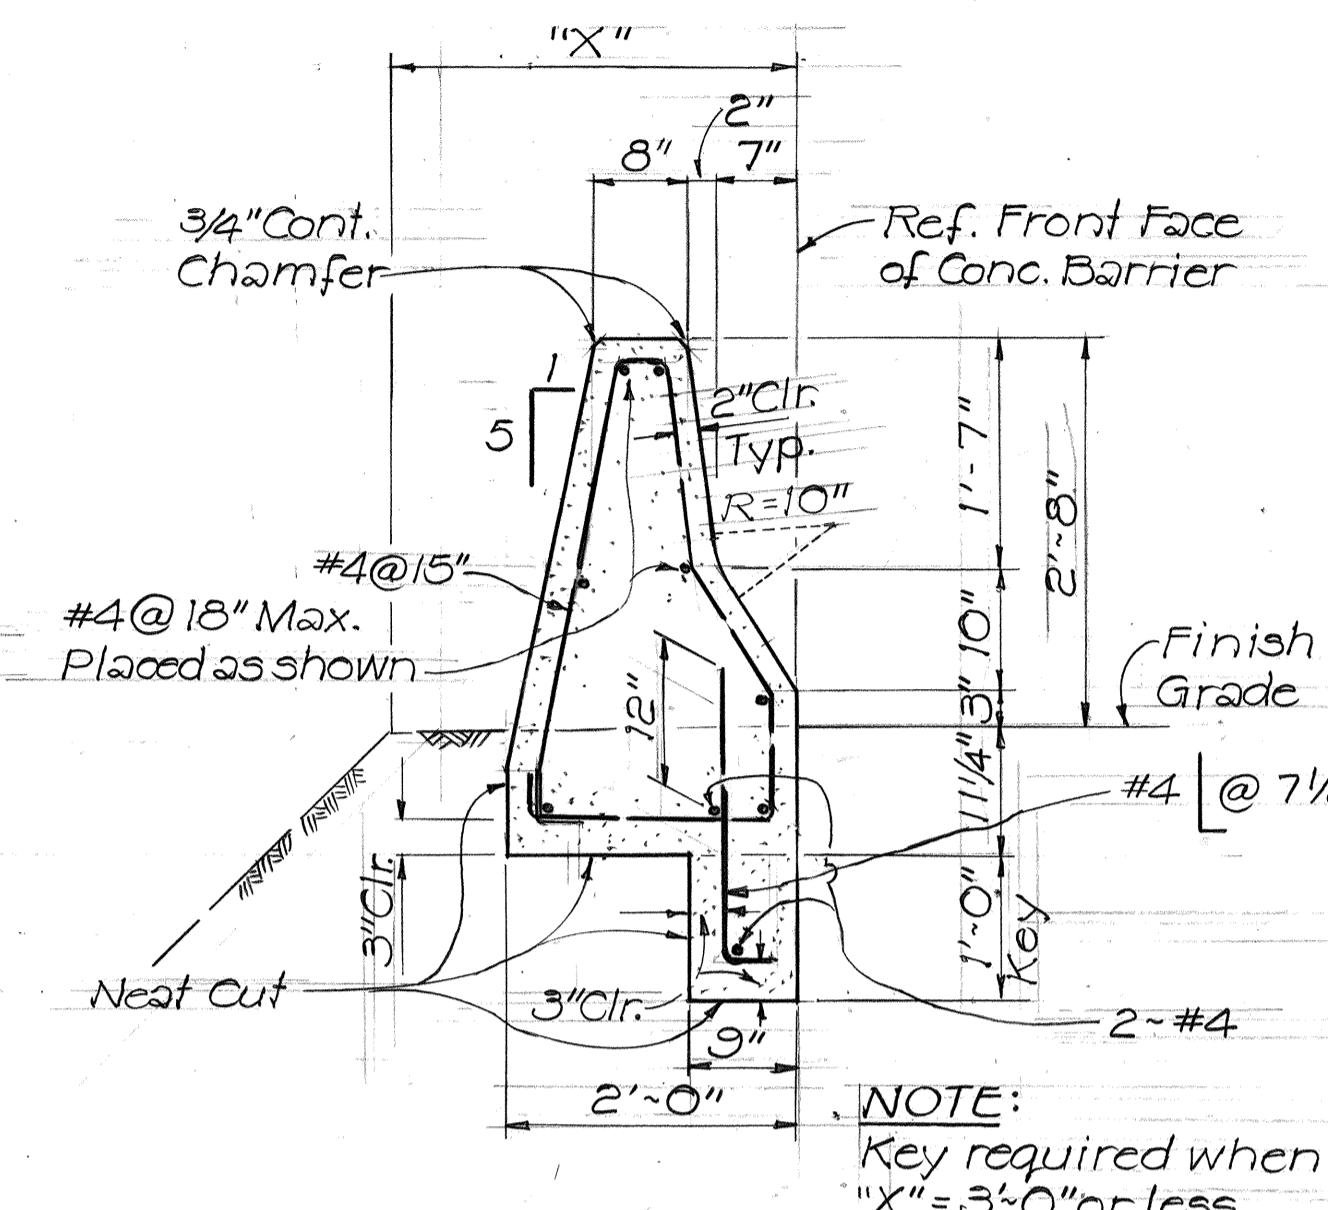


GUARD RAIL TYPE 4F
CONCRETE RIGID BARRIER
WITH KEY

SCALE: 3/4" = 1'-0"

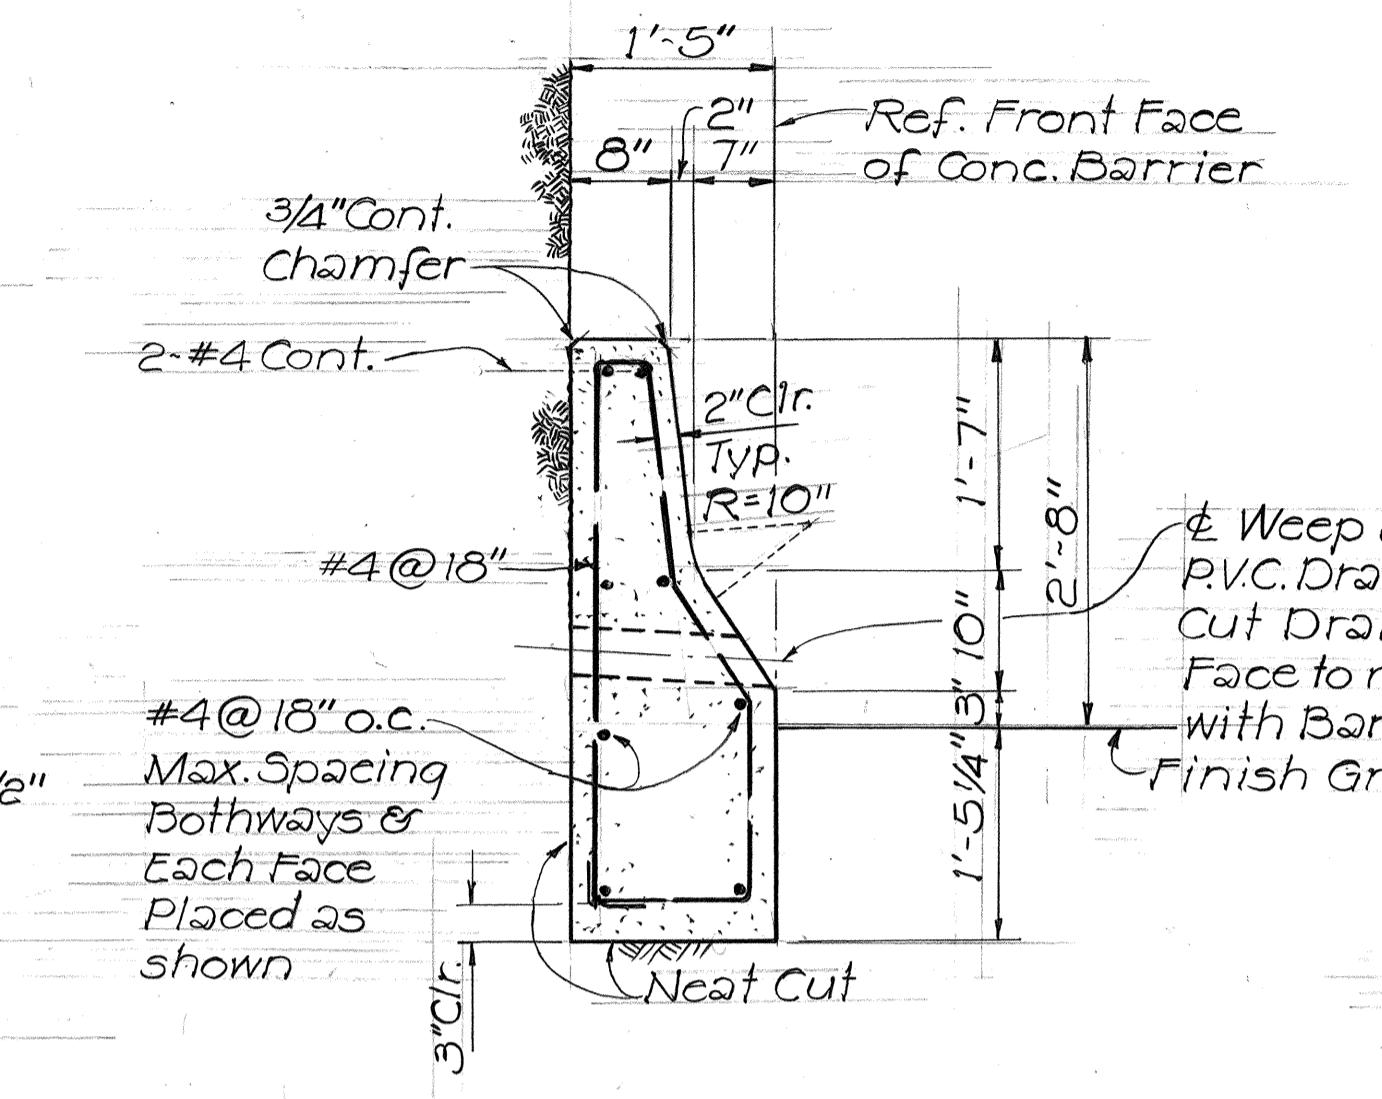

GUARD RAIL TYPE 4E
CONCRETE RIGID BARRIER


SCALE: 3/4" = 1'-0"

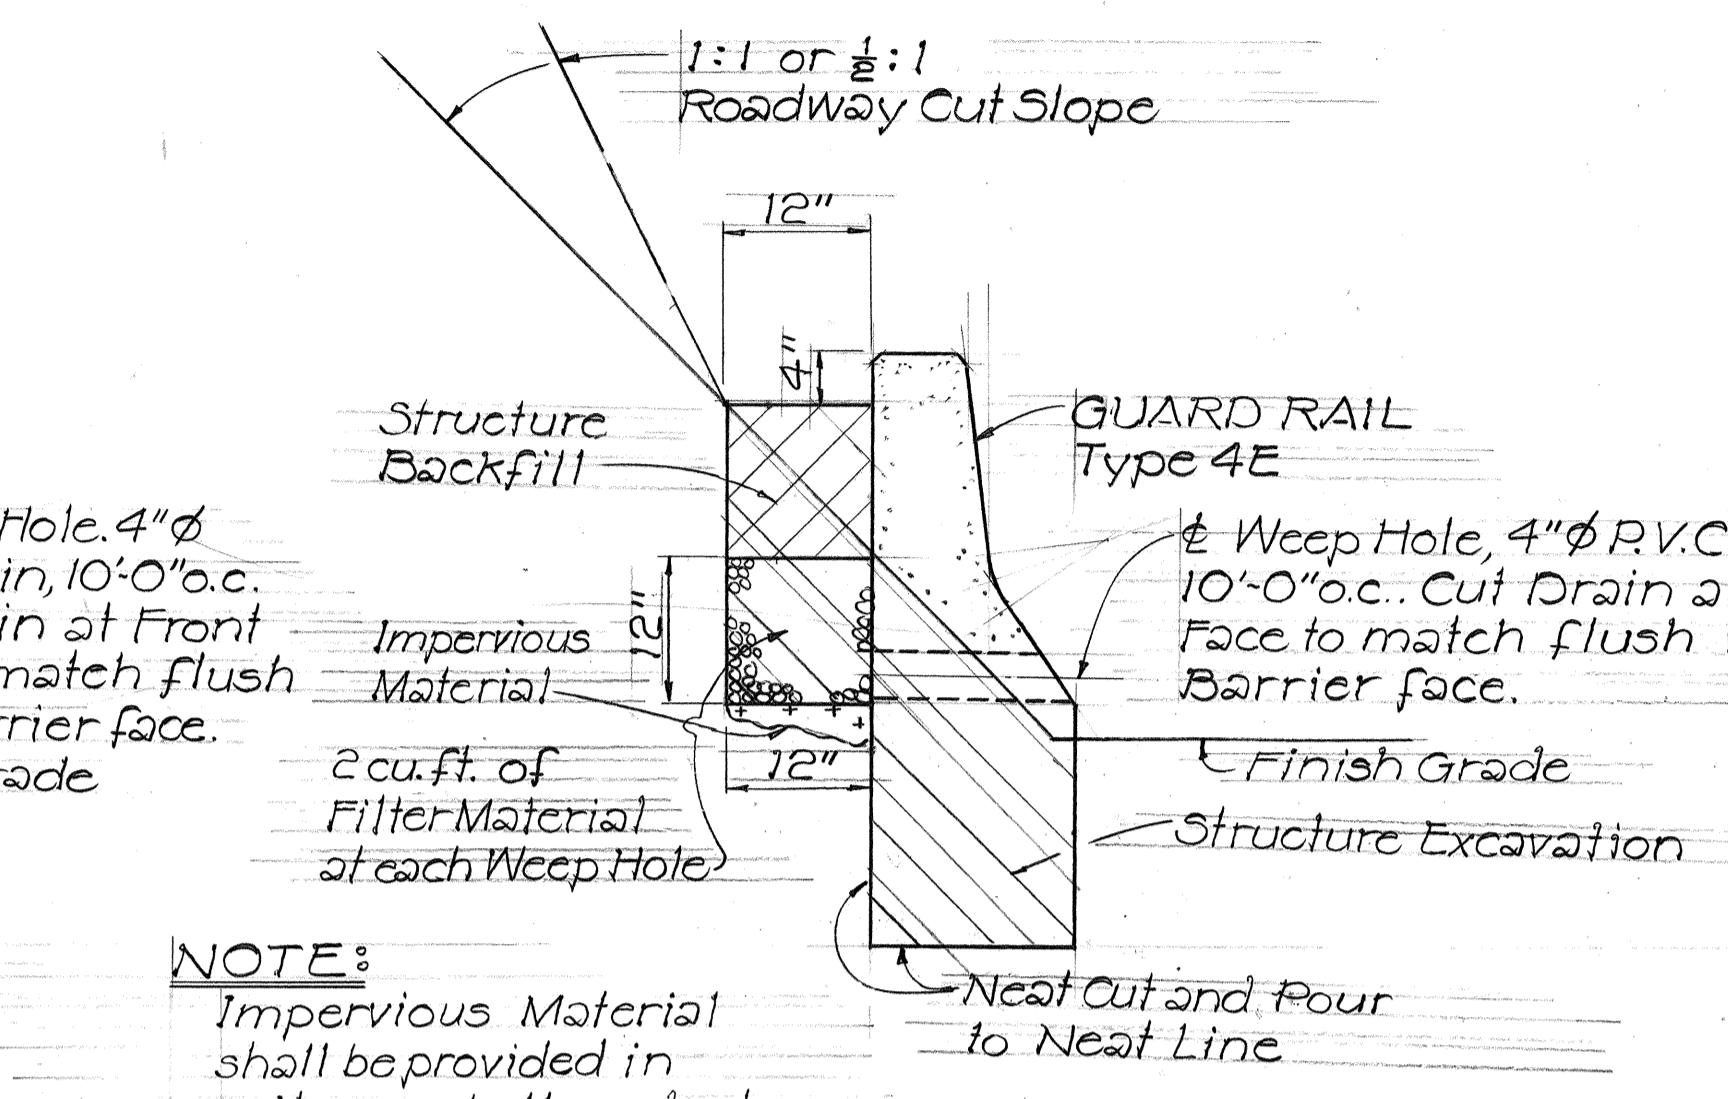

GUARD RAIL TYPE 4E, CONCRETE RIGID
BARRIER AT LOCATIONS WHERE ROADWAY


CUT SLOPE IS 1:1 OR $\frac{1}{2}:1$

SCALE: 3/4" = 1'-0"

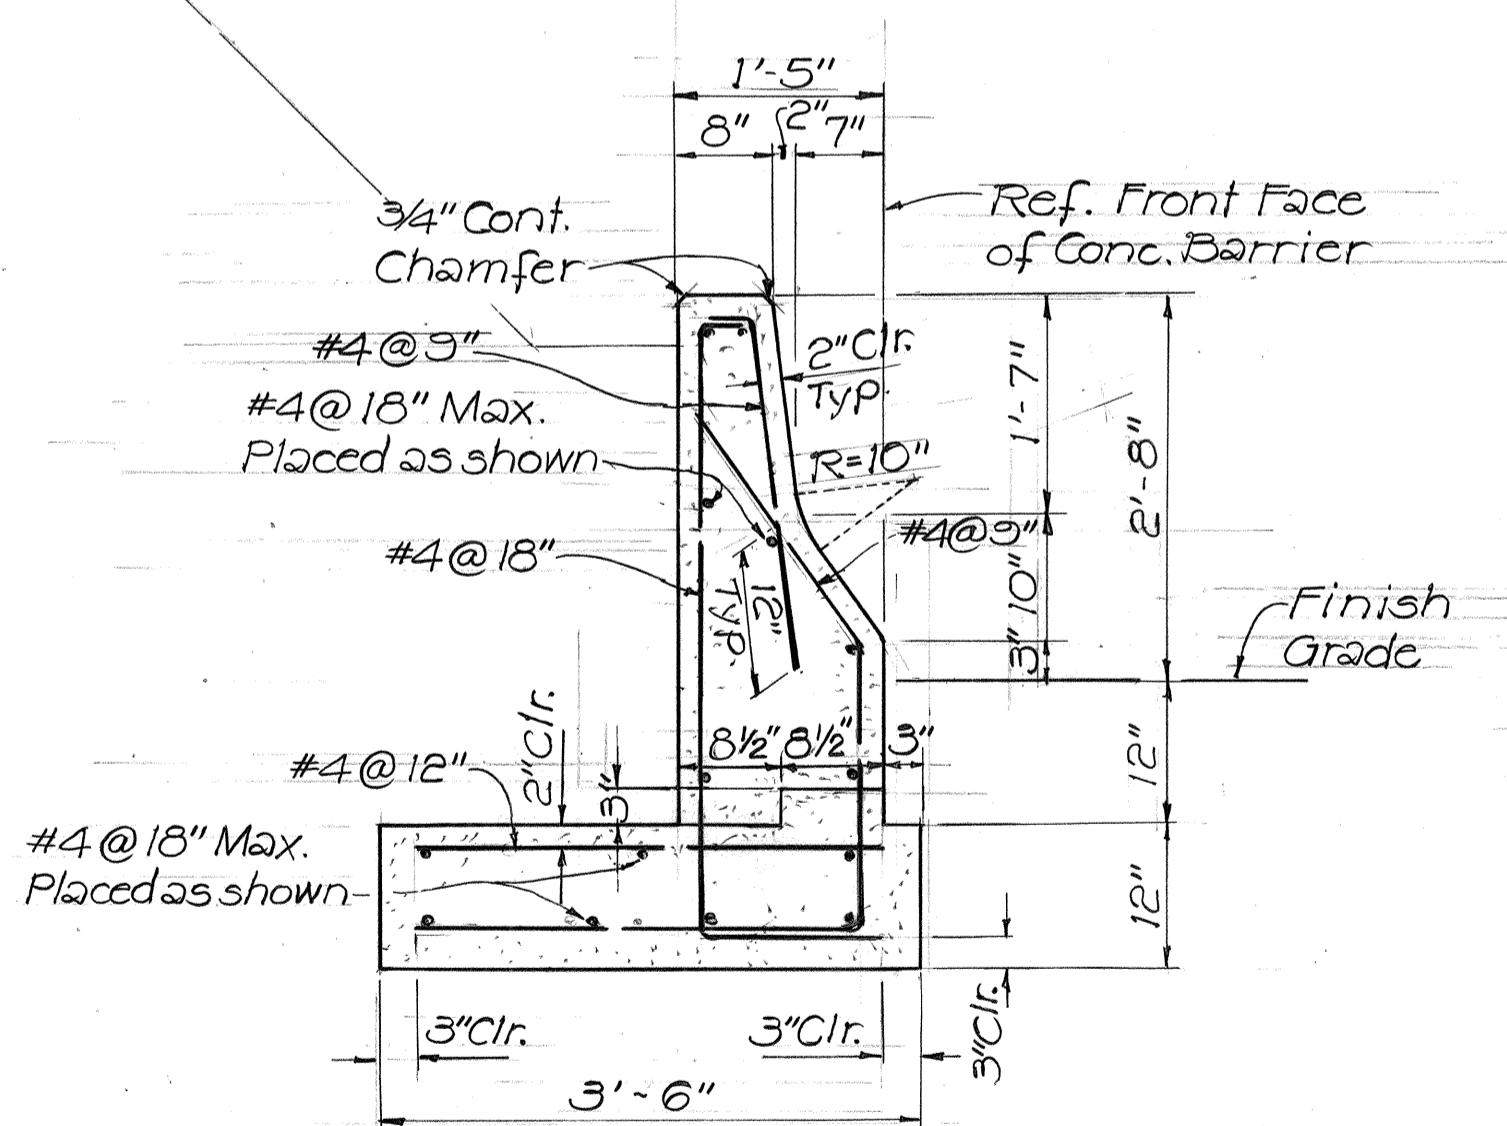

GUARD RAIL TYPE 4EF
CONCRETE RIGID BARRIER

SCALE: 3/4" = 1'-0"

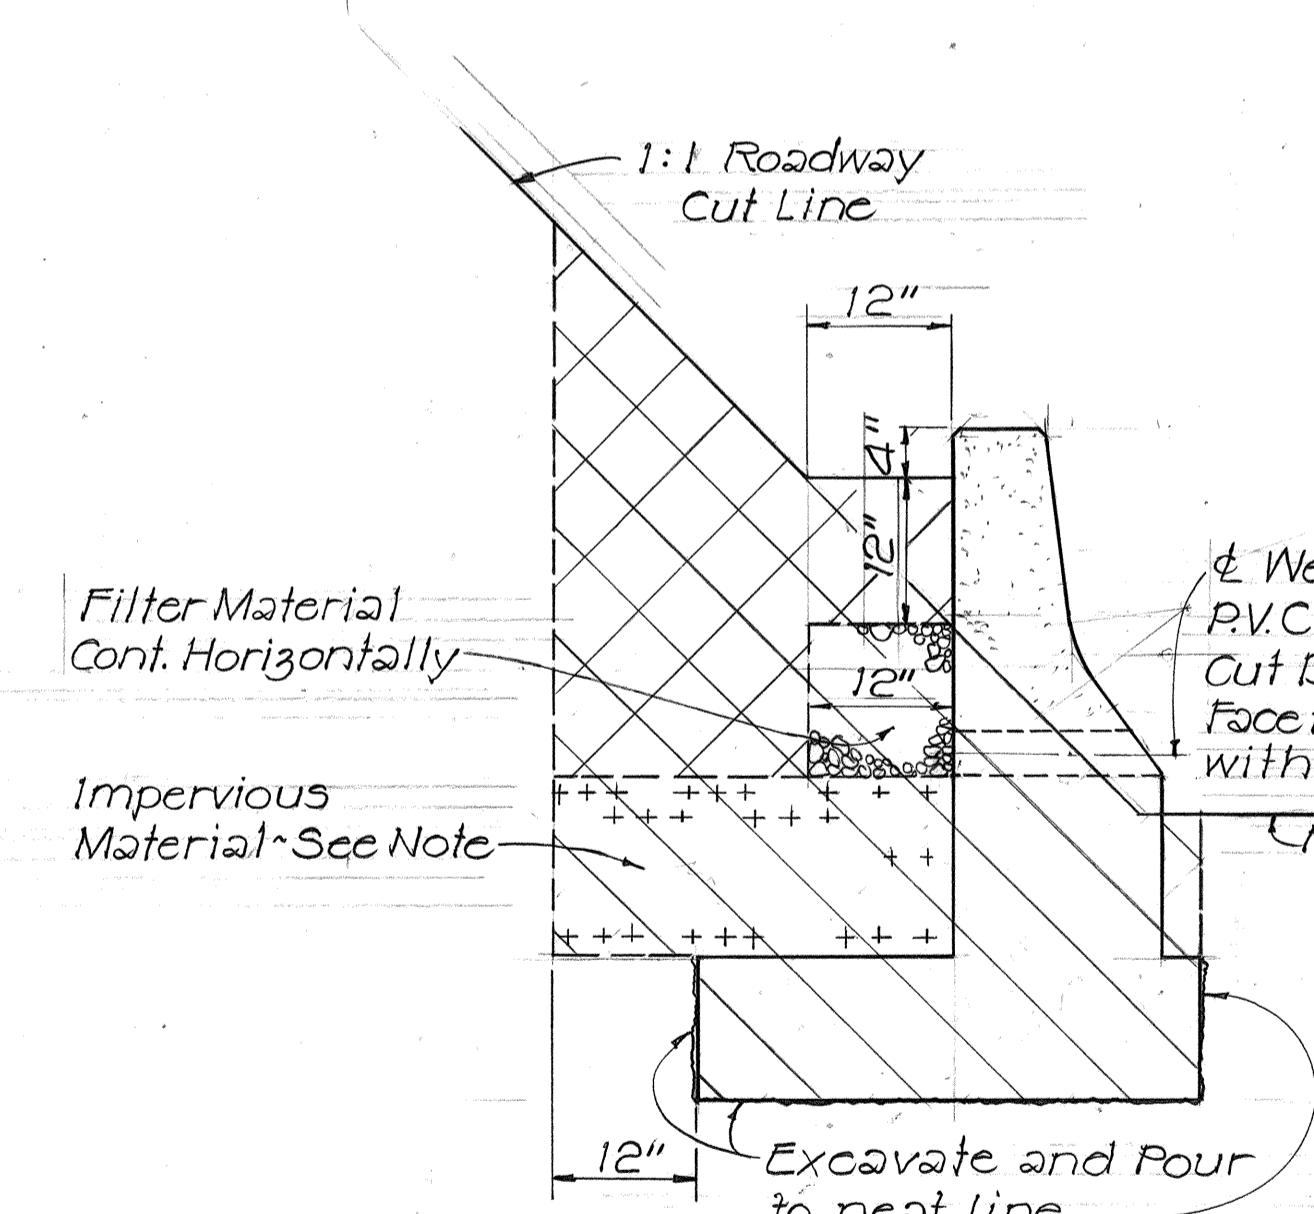

STRUCTURE EXCAVATION & DRAINAGE DETAIL
GUARD RAIL TYPE 4EF~CONCRETE RIGID BARRIER

SCALE: 3/4" = 1'-0"

NOTE:

HATCHED AREA



1. Hatched area shown thus denotes limits of structure excavation. All other excavation shall be roadway excavation.
2. Hatched area shown thus denotes limits of structure backfill.

IMPERVIOUS MATERIAL




1. Impervious material as selected by the Engineer shall be incidental to roadway excavation.
2. The subgrade upon which filter material is to be placed shall be made as impervious as possible by pneumatic tamping or other approved methods.

STATE OF HAWAII DEPARTMENT OF TRANSPORTATION HIGHWAYS DIVISION
<u>GUARD RAIL TYPE 4</u> CONCRETE RIGID BARRIER DETAILS INTERSTATE ROUTE H-I IMPROVEMENTS MIDDLE STREET TO KALIHI INTERCHANGE WESTBOUND LANES F.A.I. PROJ. NO. I-HI-1(187)
SCALE: As Shown
SHEET NO. 1 OF 10 SHEETS

FED. ROAD DIST. NO.	STATE	FED. AID PROJ. NO.	FISCAL YEAR	SHEET NO.	TOTAL SHEETS
HAWAII	HAW.	I-HI-1(187)	1984	21	197

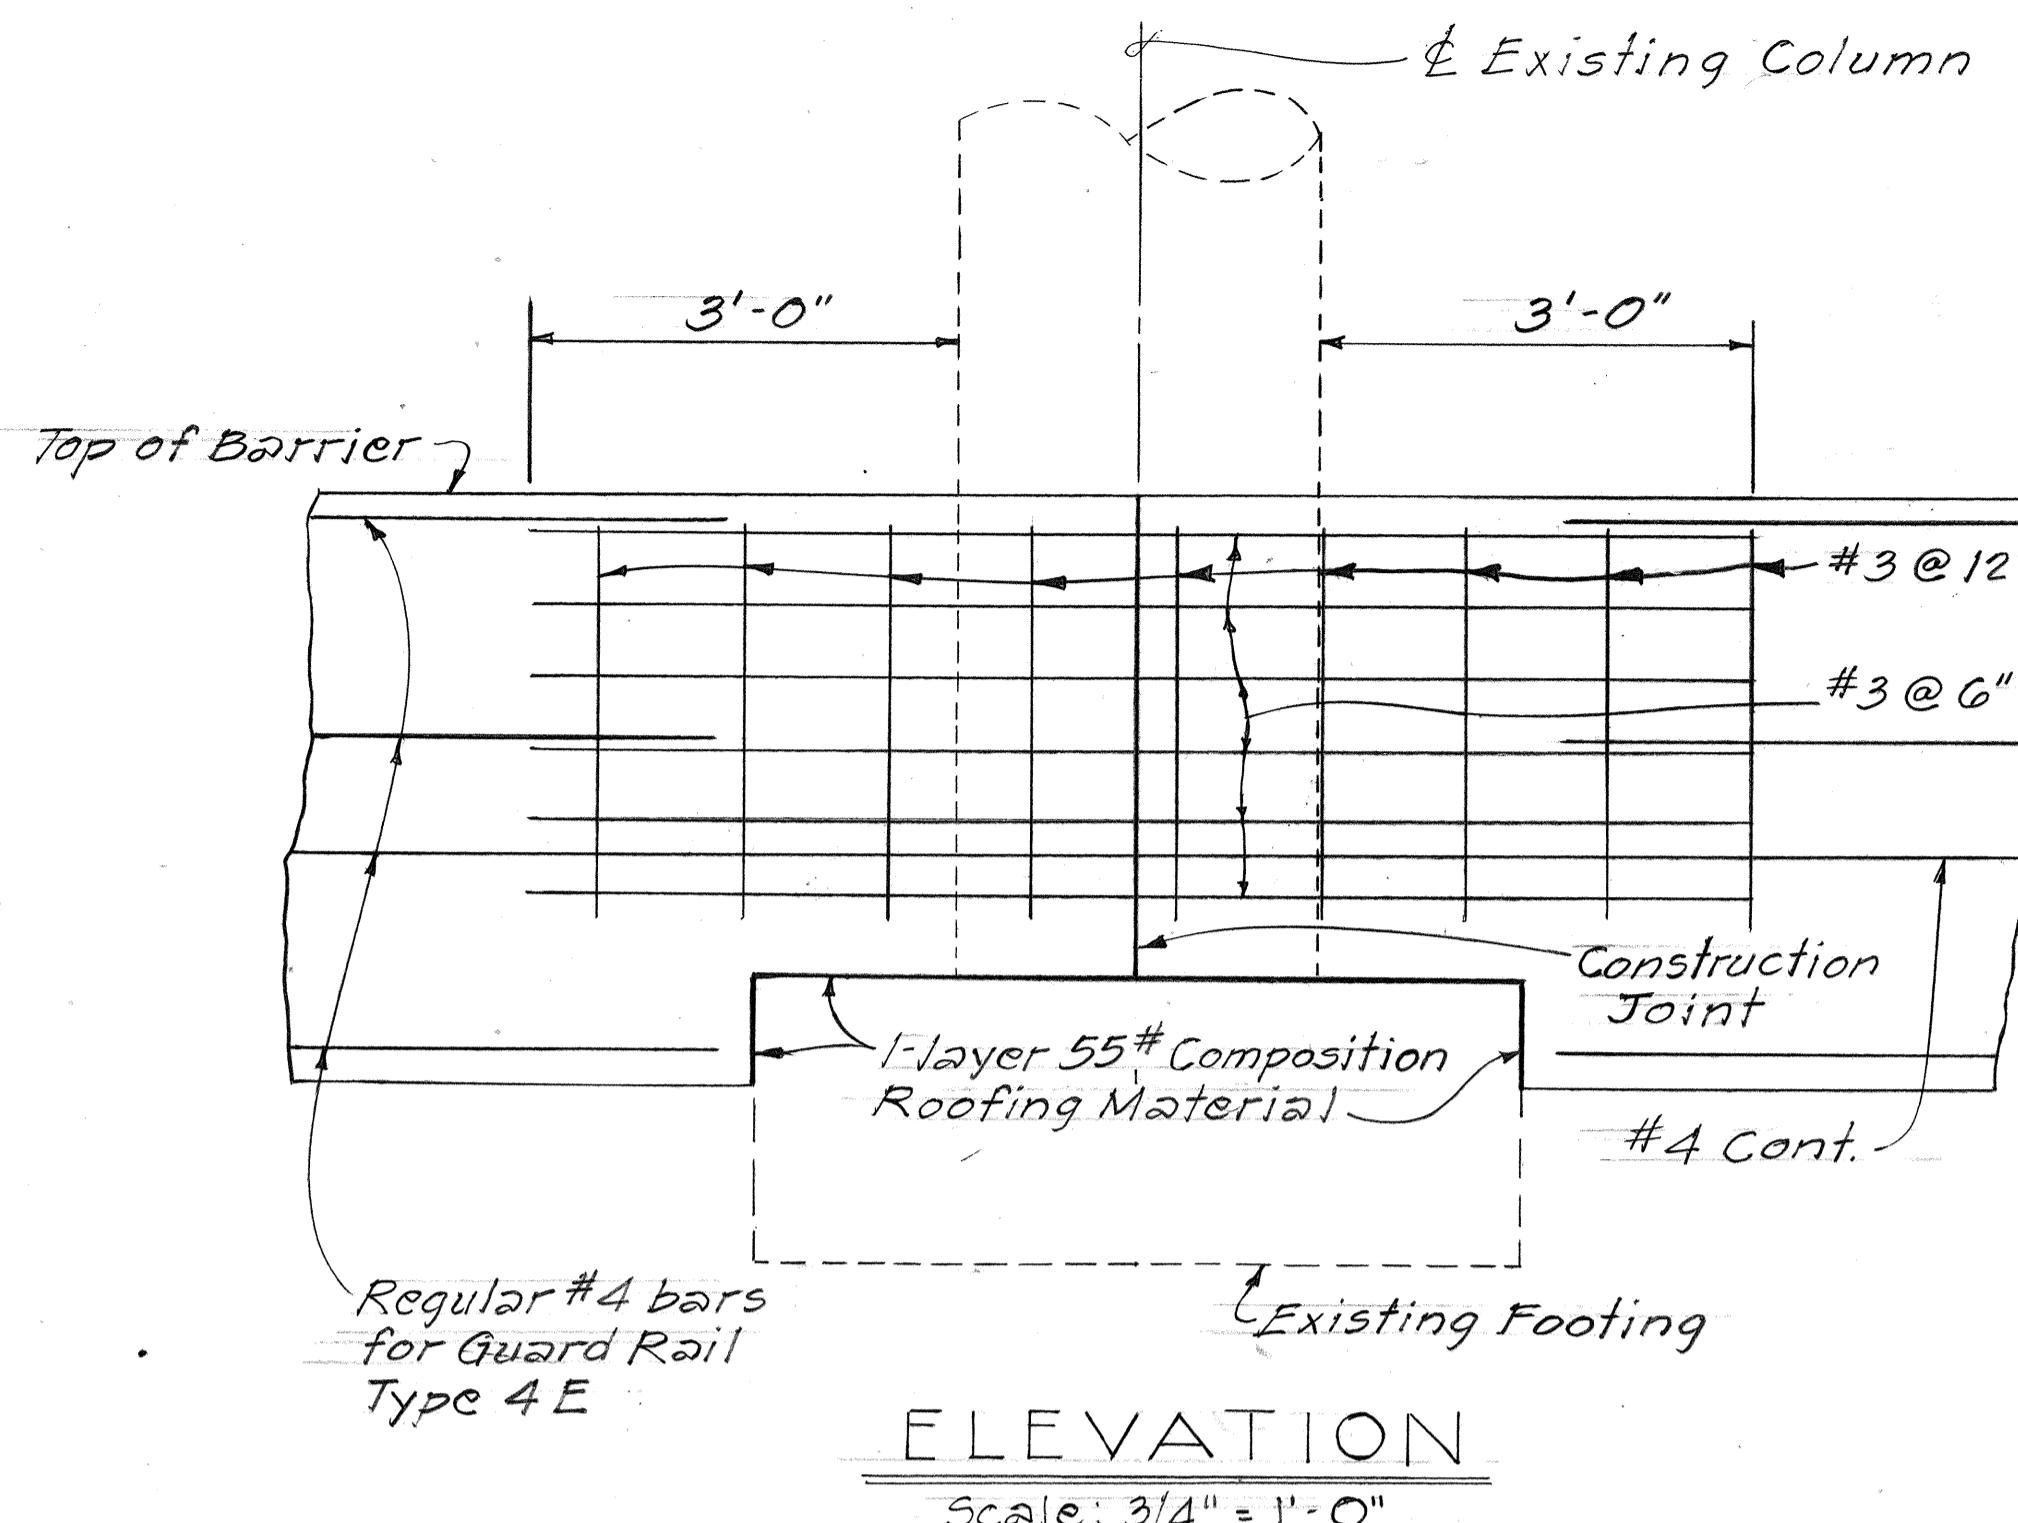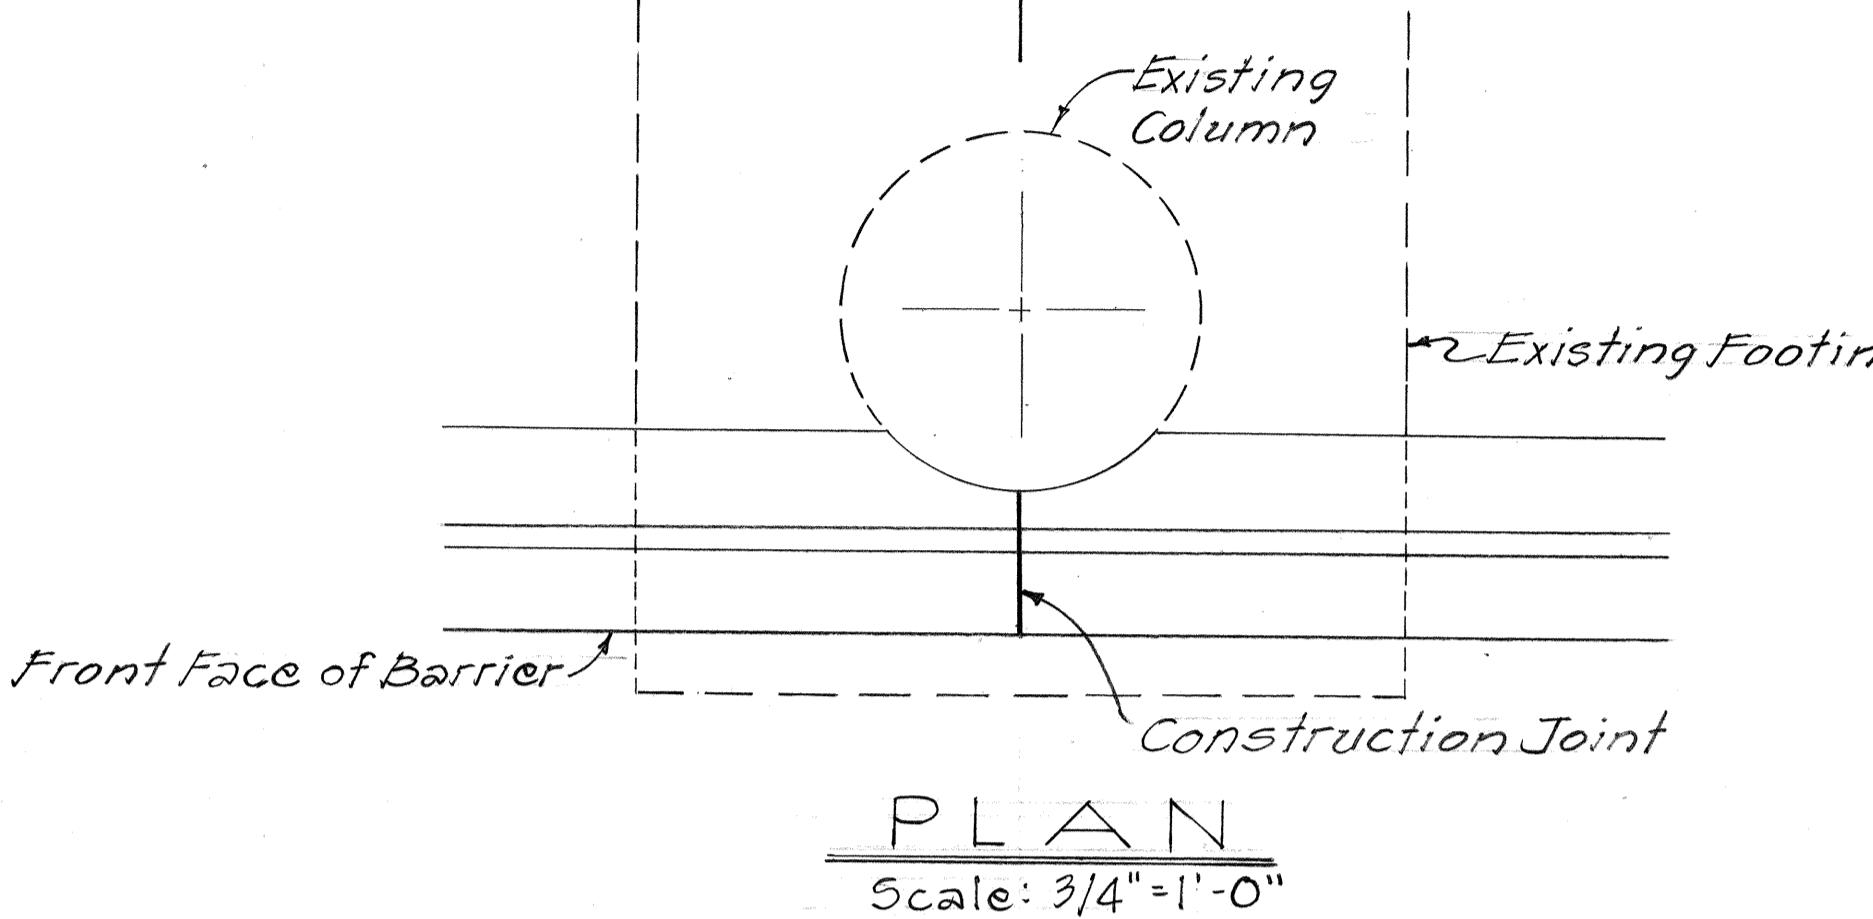



GUARD RAIL TYPE 4E AT EXISTING PIER COLUMN

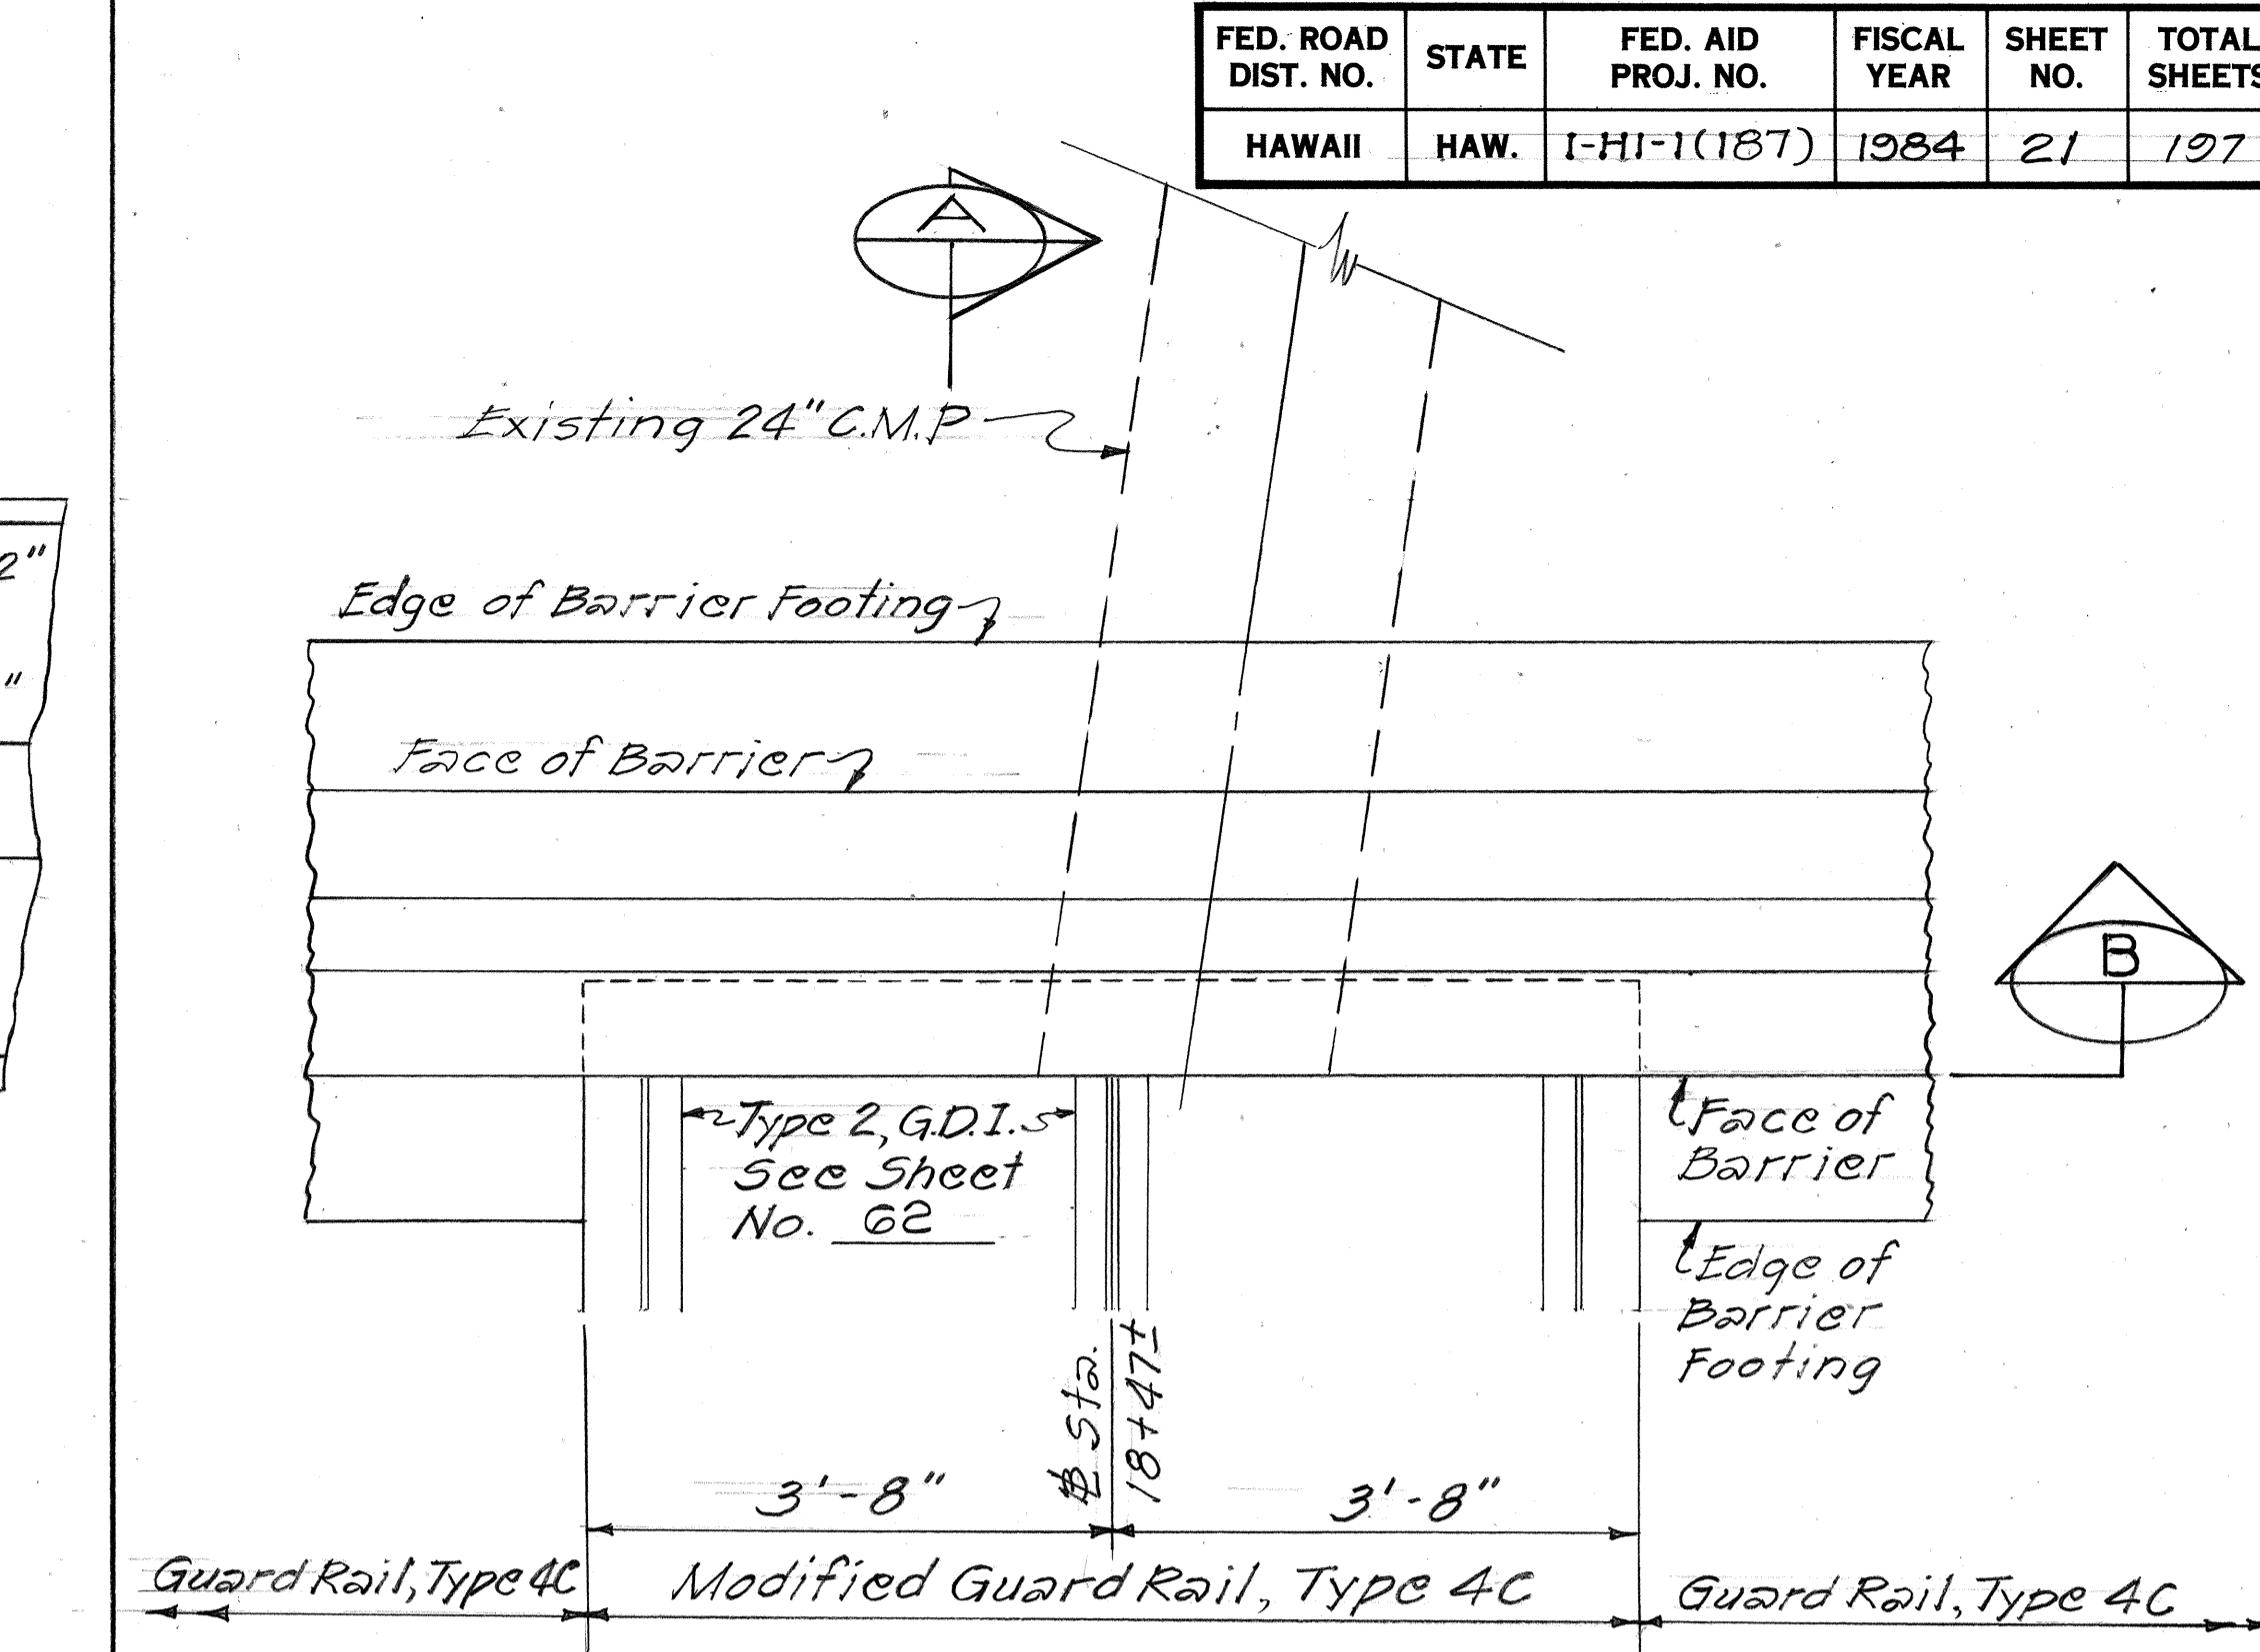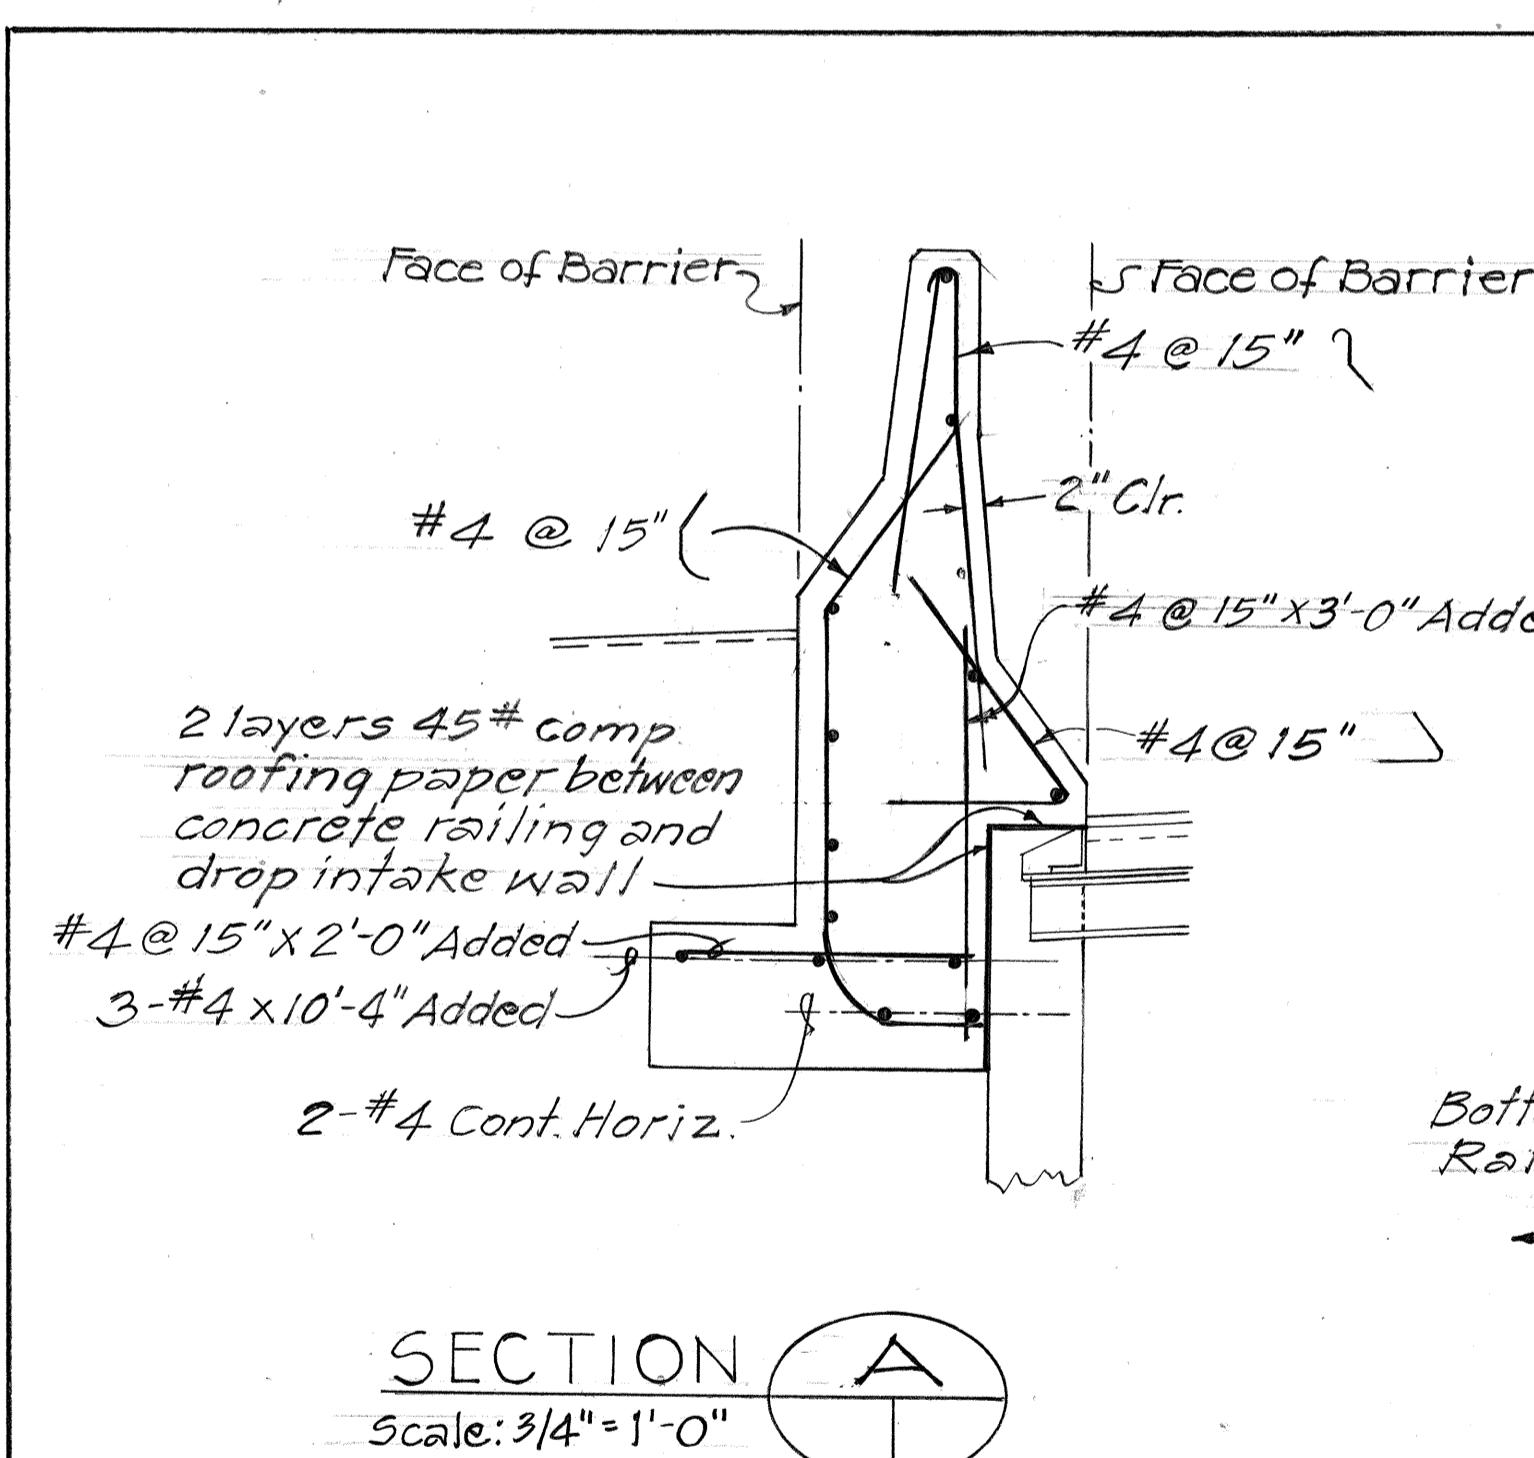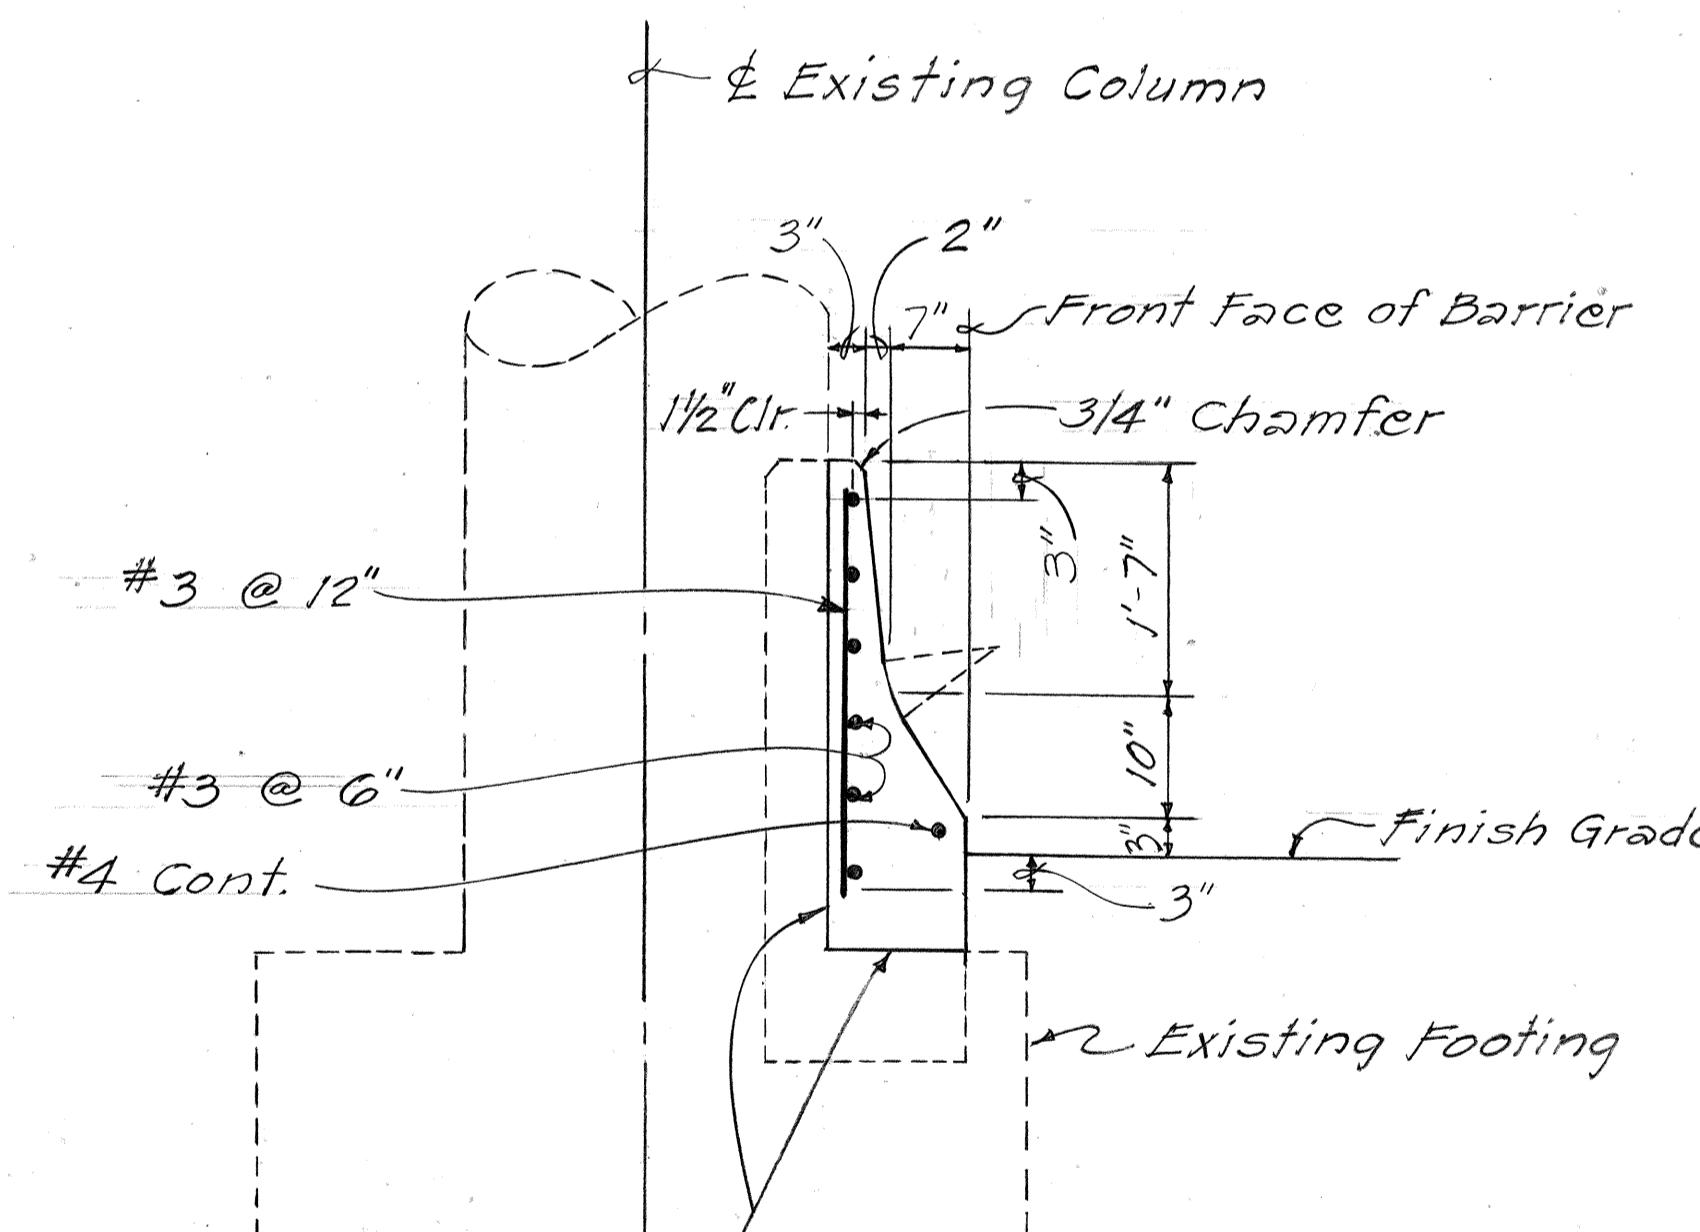

MODIFIED GUARD RAIL, TYPE 4C - B STA. 18+47±

STATE OF HAWAII
DEPARTMENT OF TRANSPORTATION
HIGHWAYS DIVISION
GUARD RAIL TYPE 4
CONCRETE RIGID BARRIERS
INTERSTATE ROUTE I-HI
IMPROVEMENTS
MIDDLE STREET TO KALIHI INTERCHANGE
WESTBOUND LANES
FAI PROJECT NO. I-HI-1(187)
SCALE: AS SHOWN DATE
SHEET NO. 2 OF 10 SHEETS

FED. ROAD DIST. NO.	STATE	FED. AID PROJ. NO.	FISCAL YEAR	SHEET NO.	TOTAL SHEETS
HAWAII	HAW.	I-HI-1(187)	1984	22	197

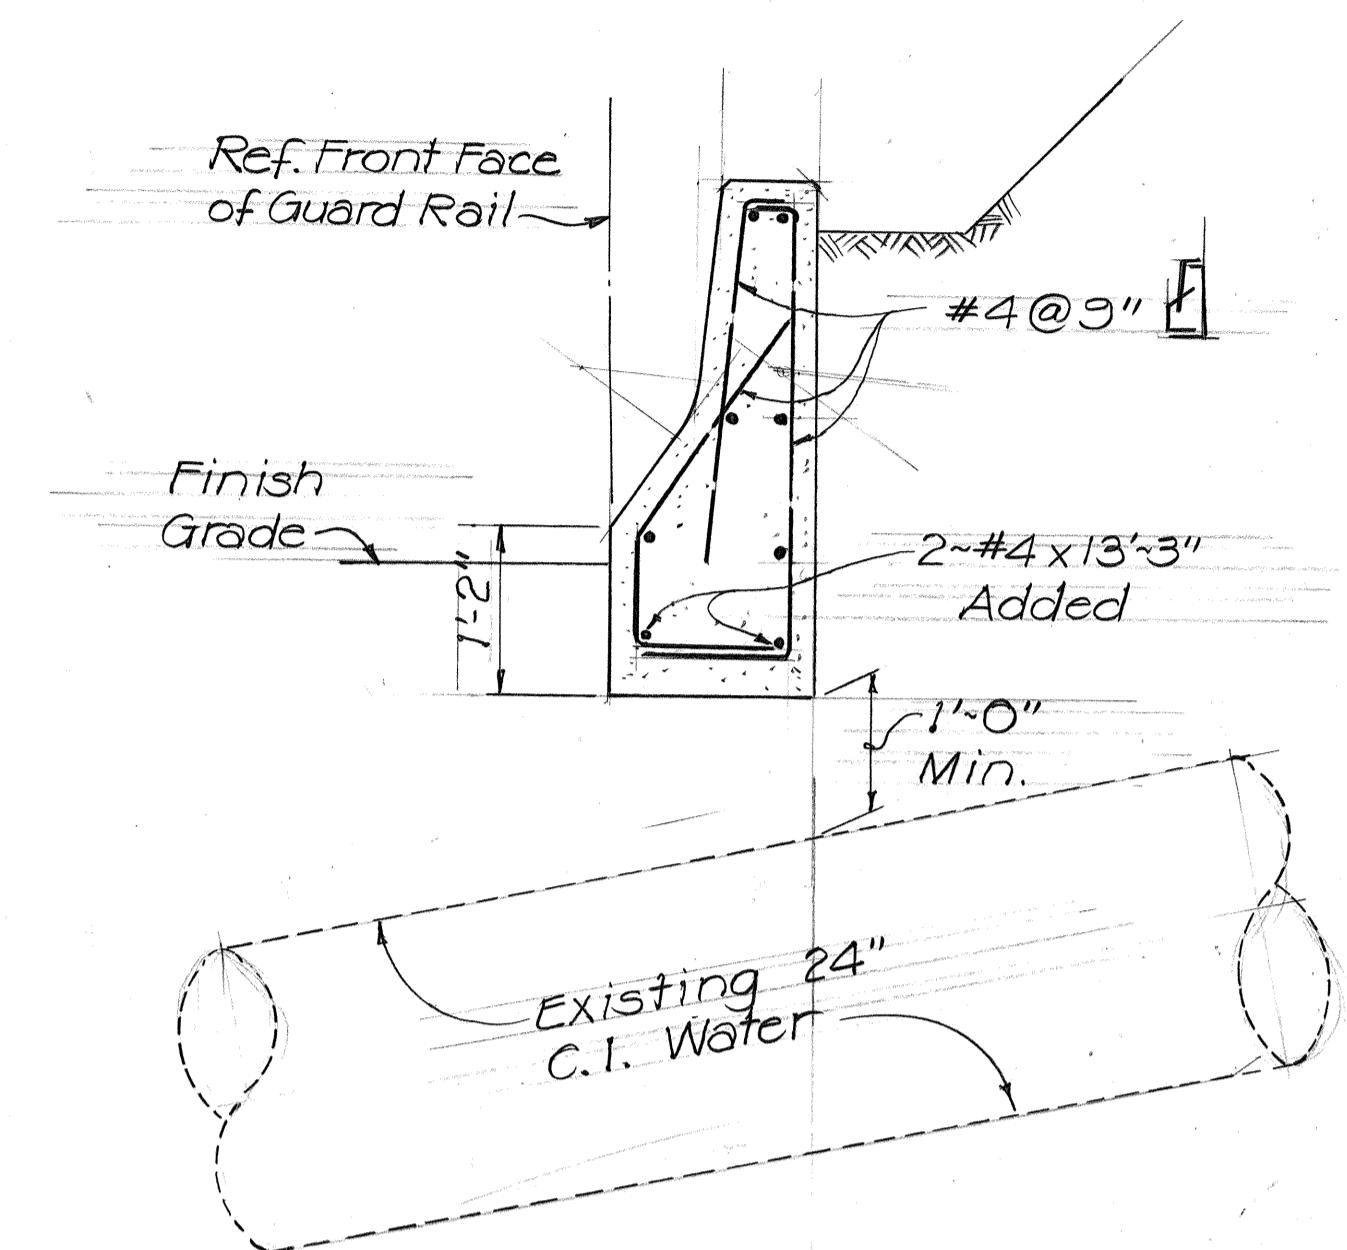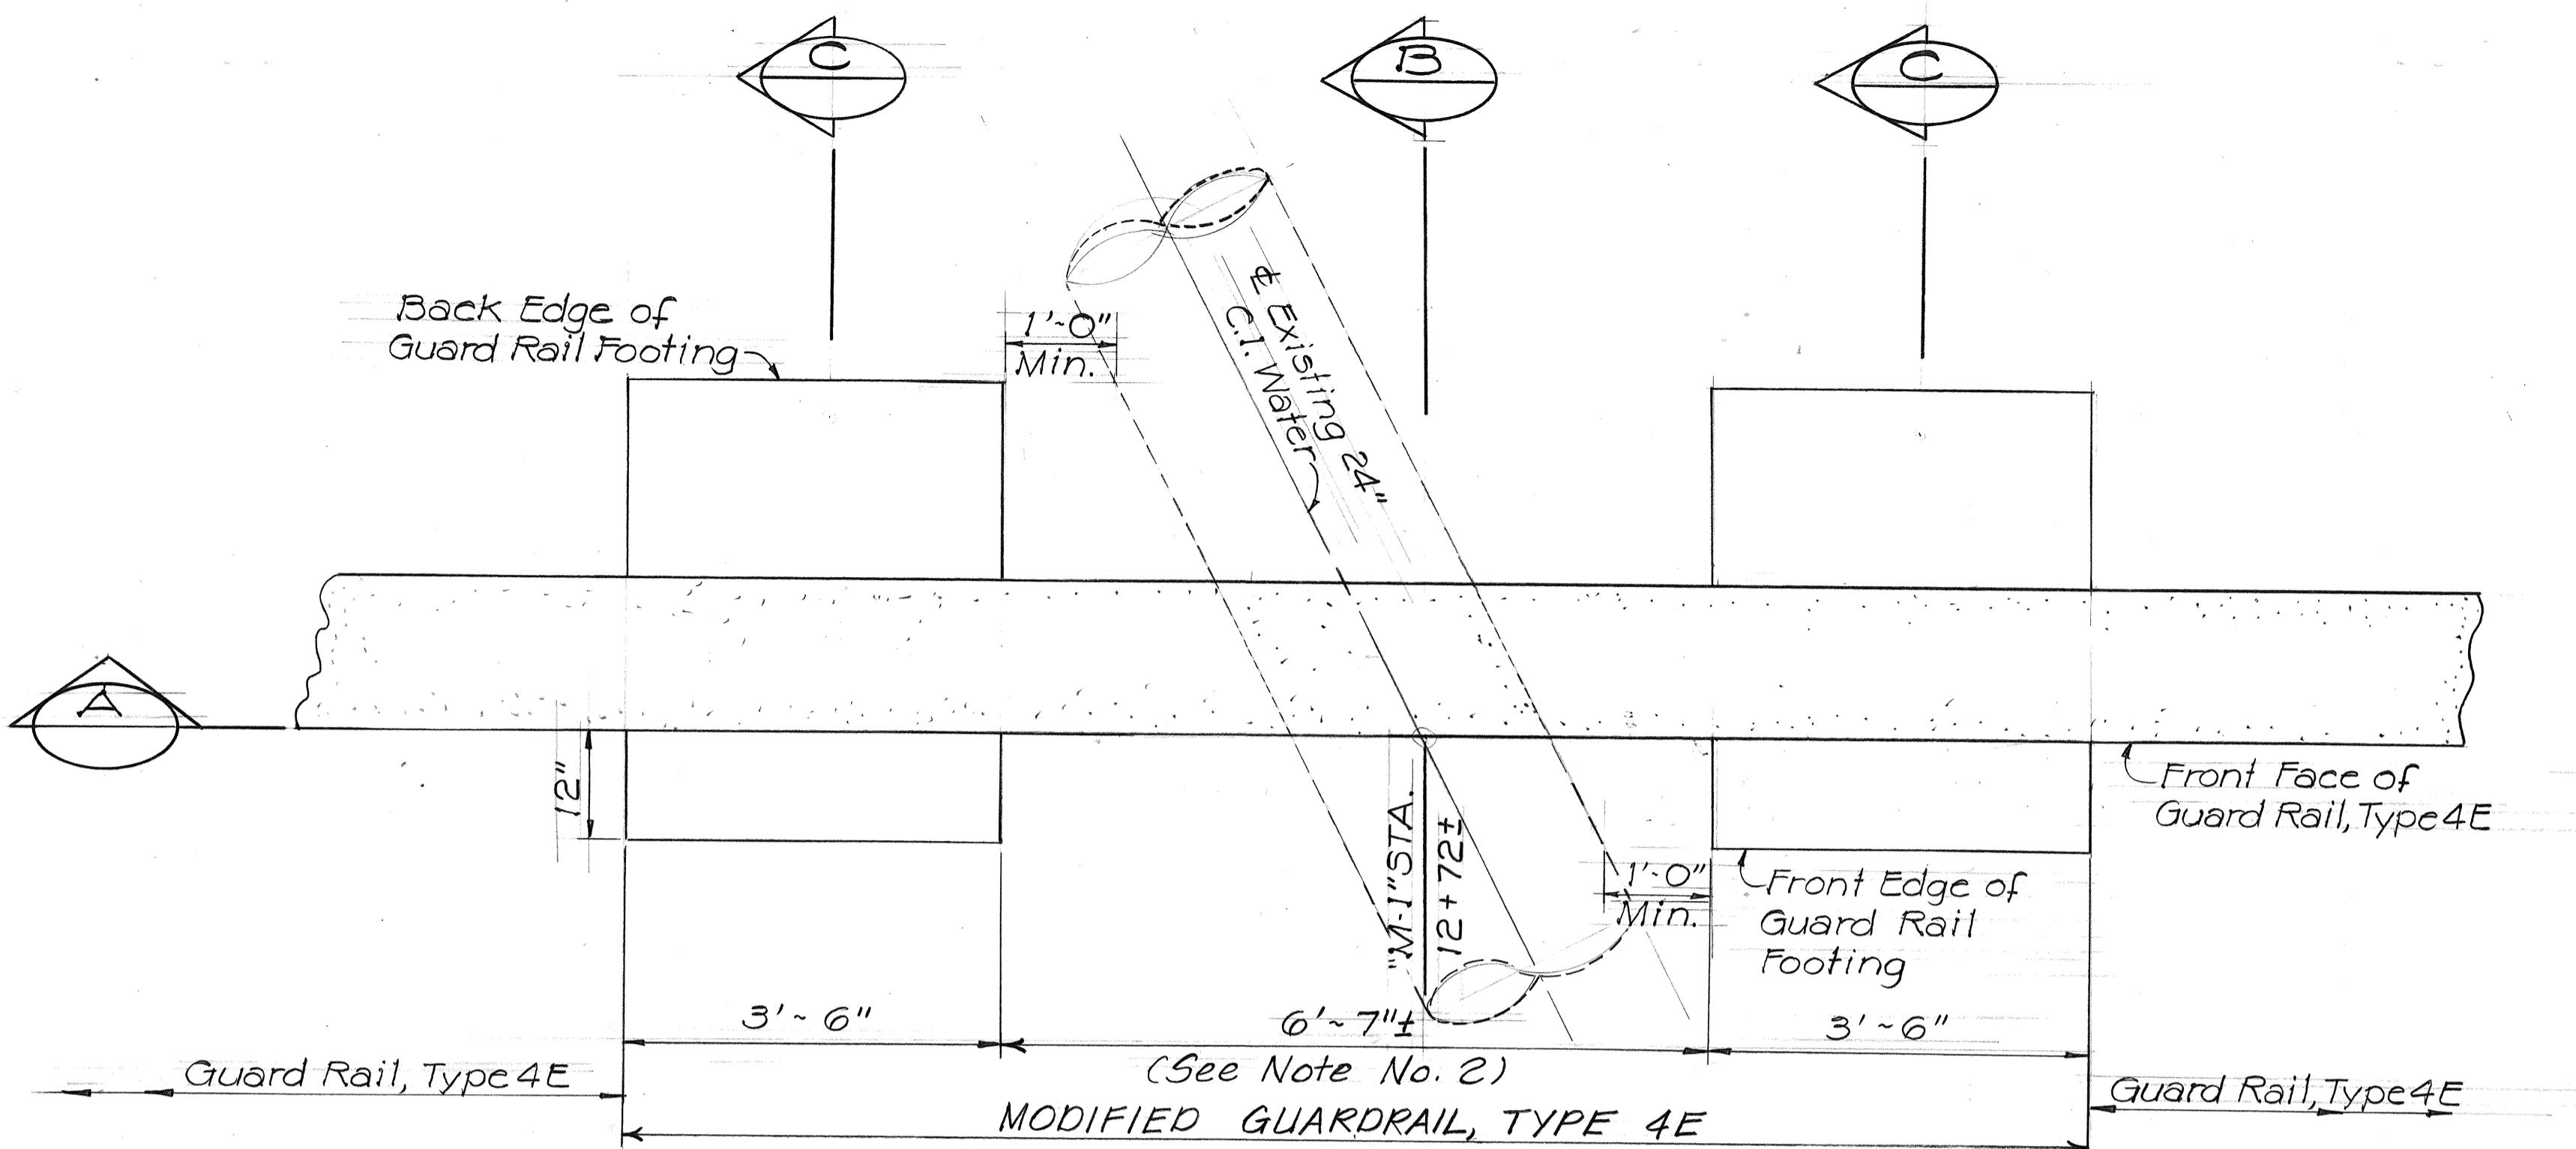


NOTES:

1. See Sheet No. 18 for General Water Notes.
2. The Maximum spacing between footings shall be 10 feet. If spacing must exceed this dimension, the Contractor shall notify the Engineer for redesign.


PLAN

Scale: 3/4" = 1'-0"

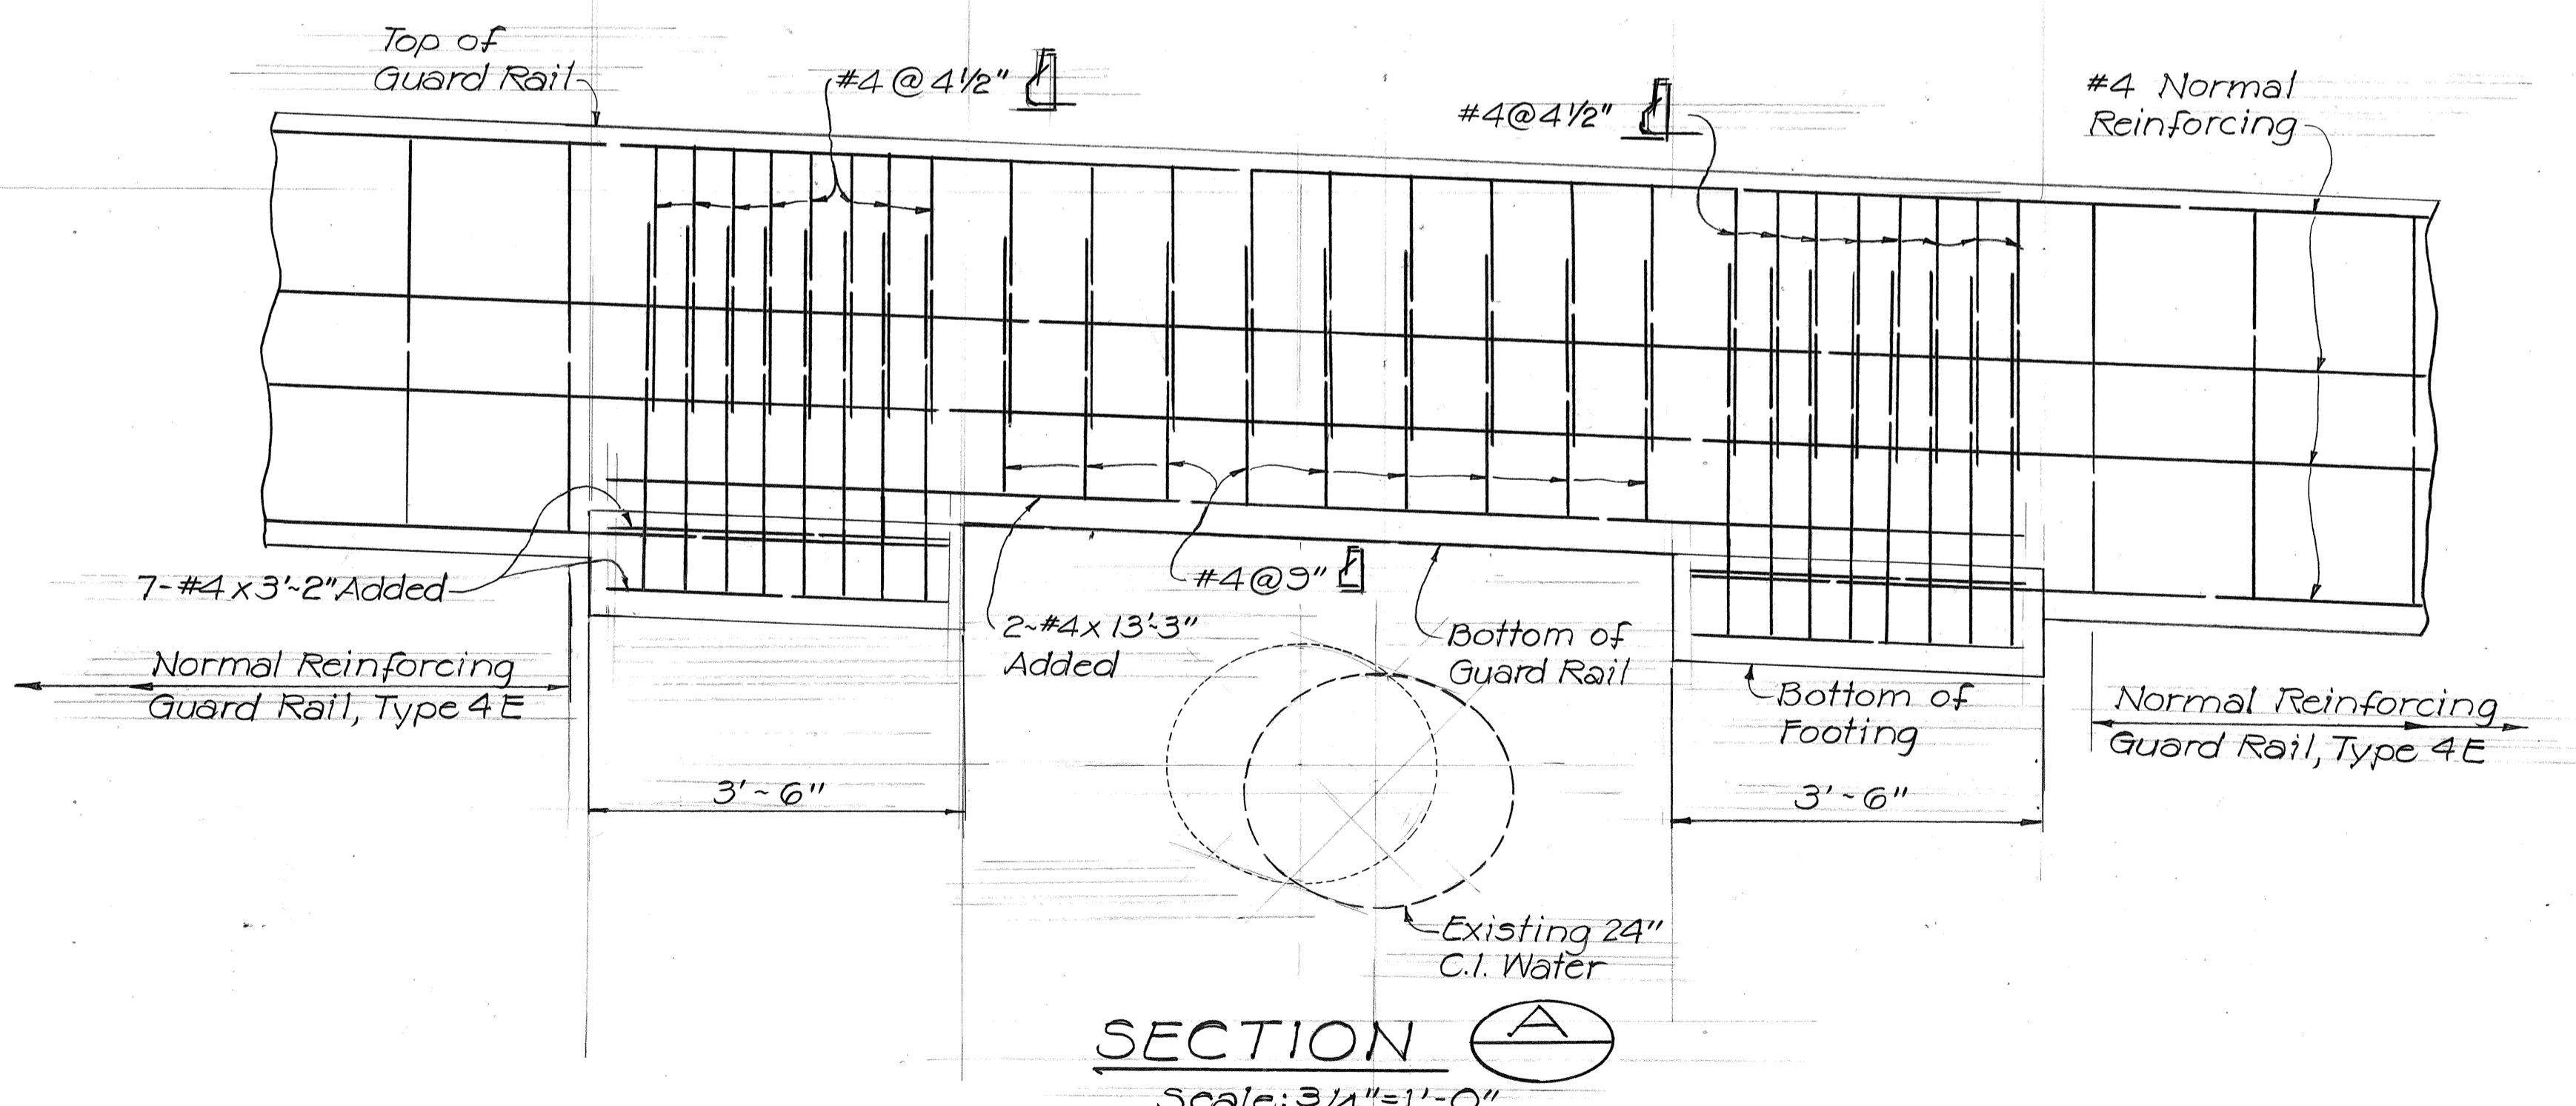

SECTION B

Scale: 3/4" = 1'-0"

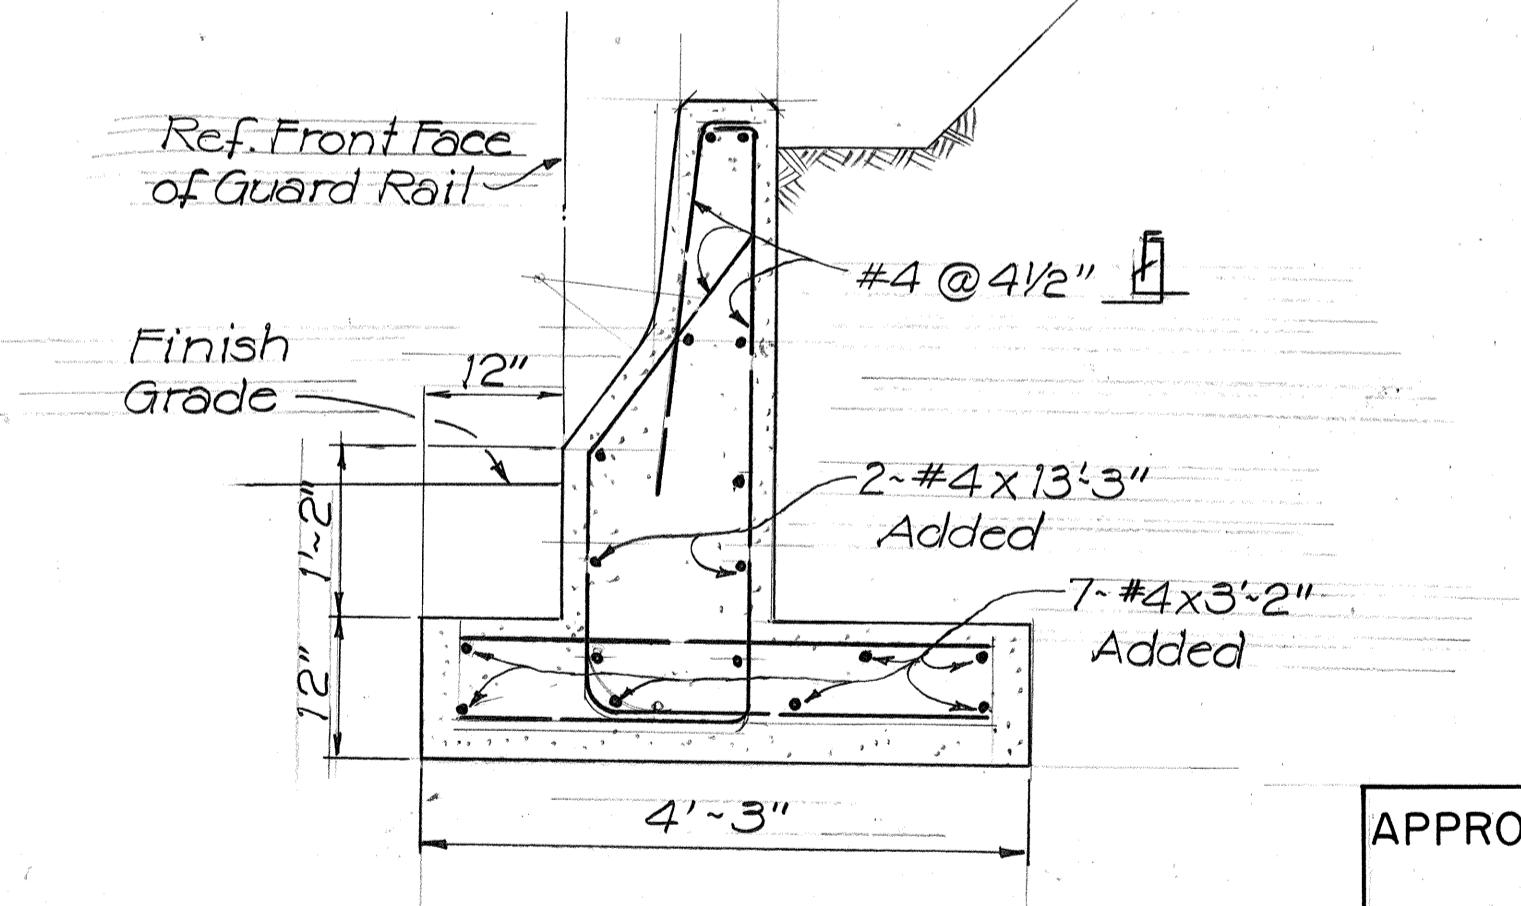

APPROVED: DATE 7-12-85

R. Hayes
CHIEF, PLANNING & ENGINEERING, BWS

SECTION C

Scale: 3/4" = 1'-0"



MODIFIED GUARD RAIL, TYPE 4E ~ "M-1" STA. 12+72± RT.

STATE OF HAWAII
DEPARTMENT OF TRANSPORTATION
HIGHWAYS DIVISION



GUARD RAIL TYPE 4, CONCRETE
RIGID BARRIER DETAILS
INTERSTATE ROUTE H-1 IMPROVEMENTS
MIDDLE STREET TO KALIHI INTERCHANGE
WESTBOUND LANES
F.A.I. PROJ. NO. I-HI-1(187)
Scale: As Shown

SHEET NO. 3 OF 10 SHEETS

FED. ROAD DIST. NO.	STATE	FED. AID PROJ. NO.	FISCAL YEAR	SHEET NO.	TOTAL SHEETS
HAWAII	HAW.	I-HI-1(187)	1984	23	197

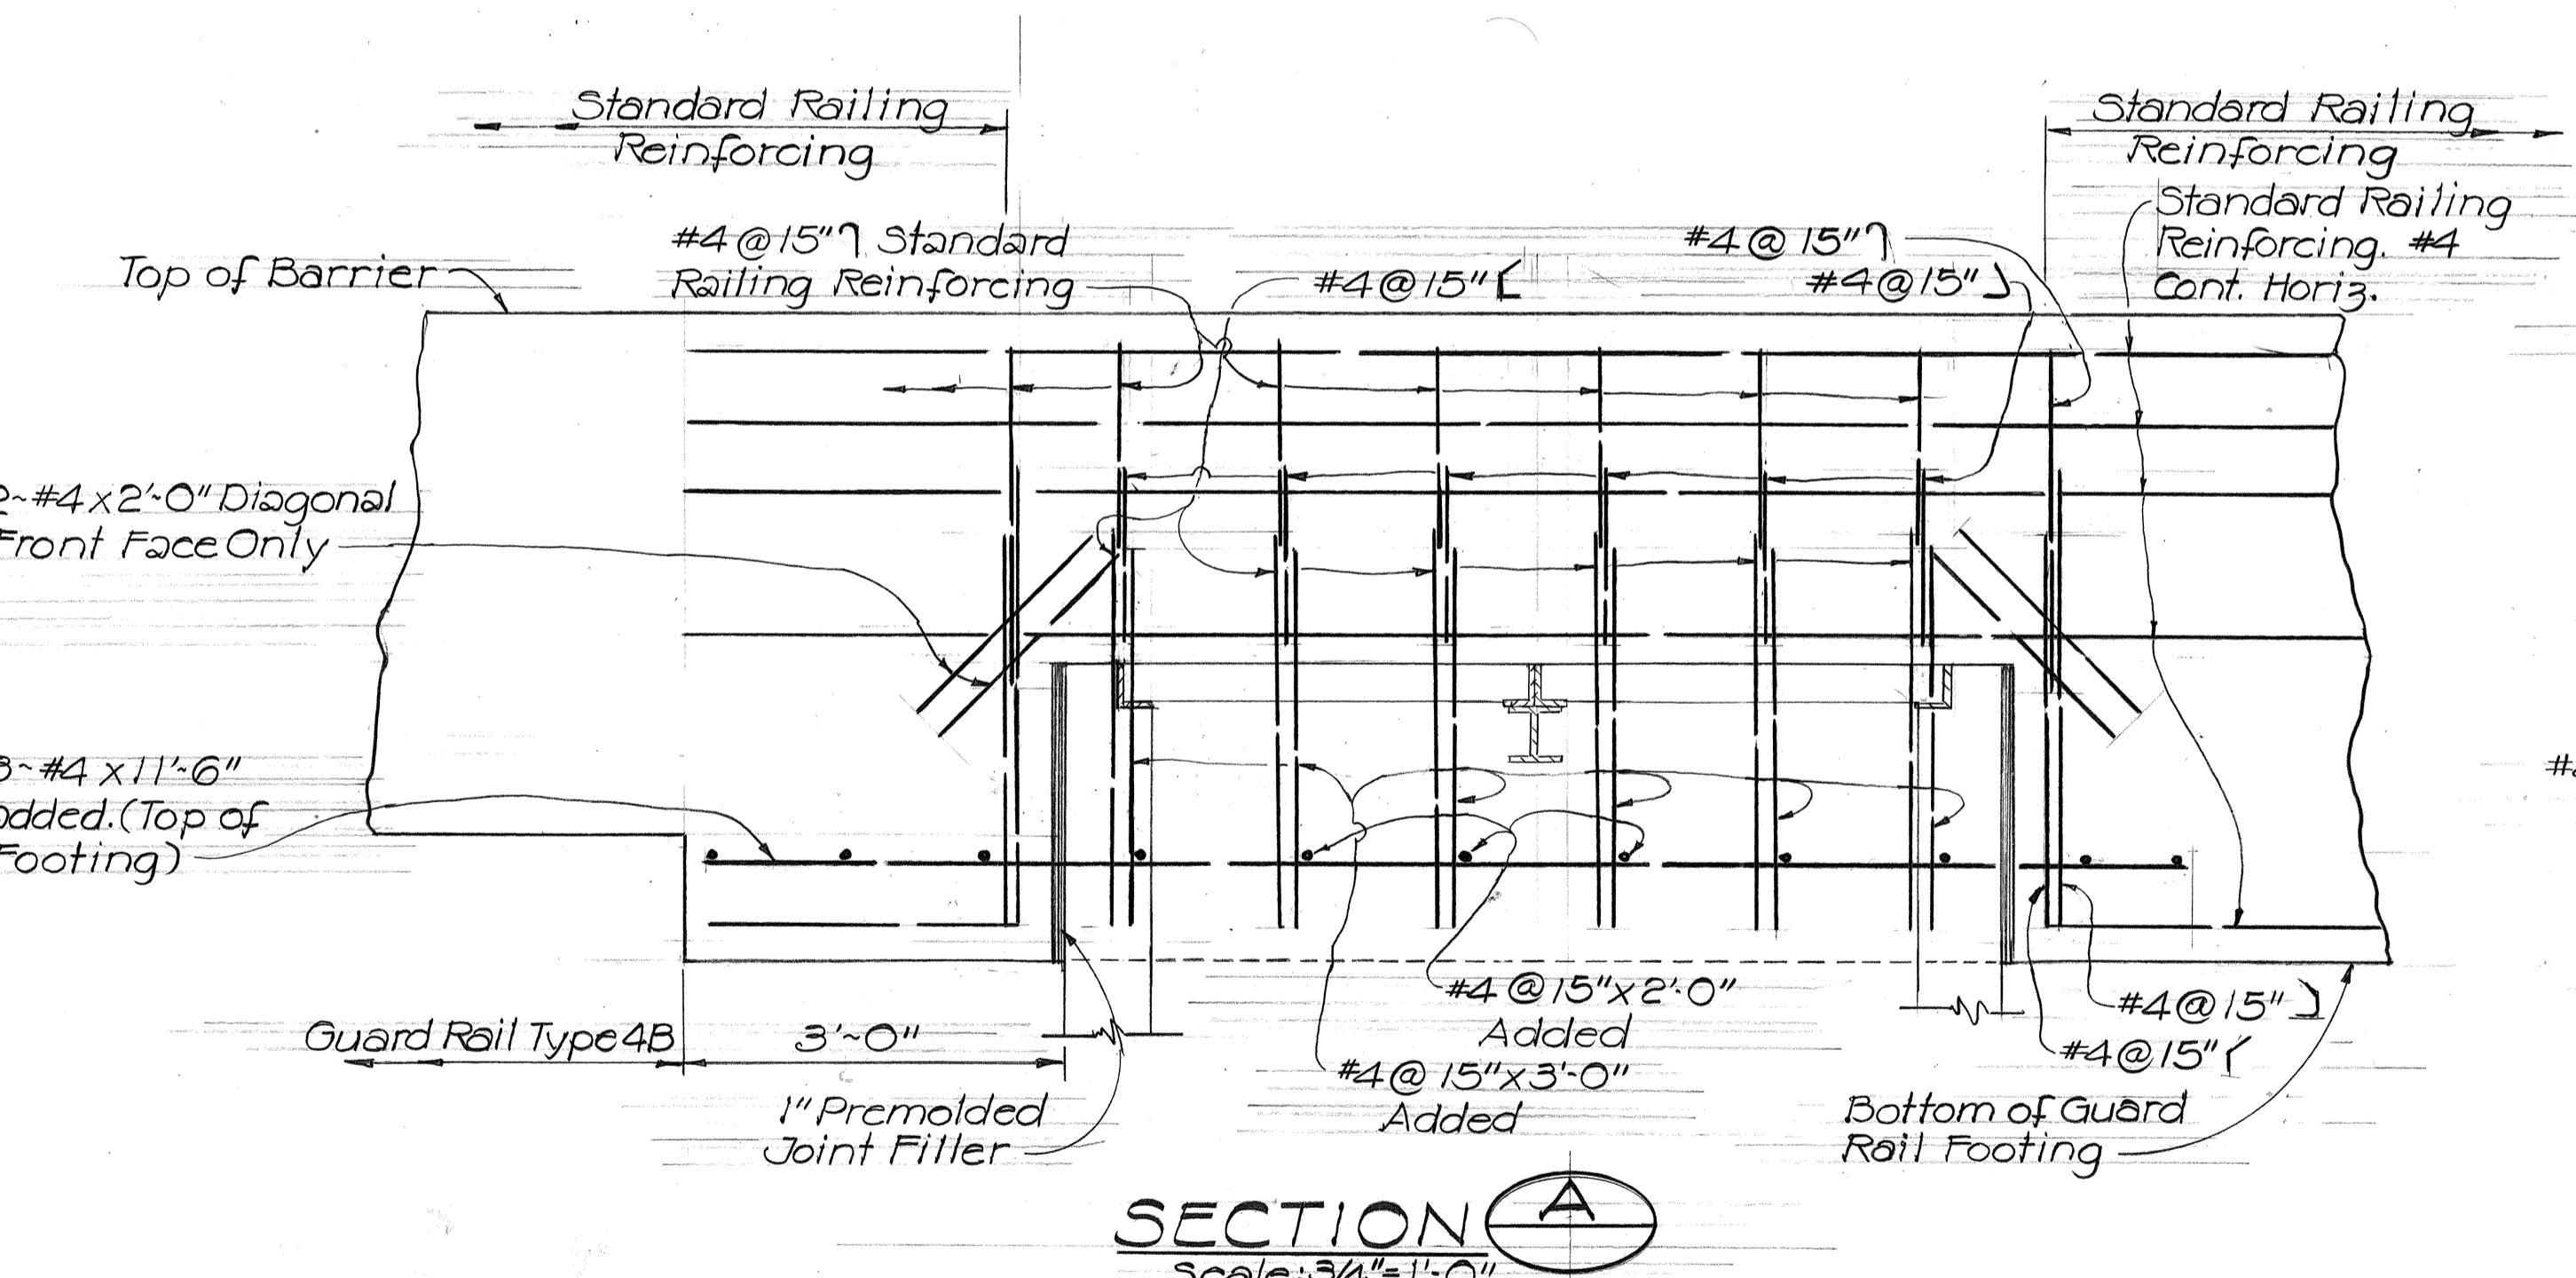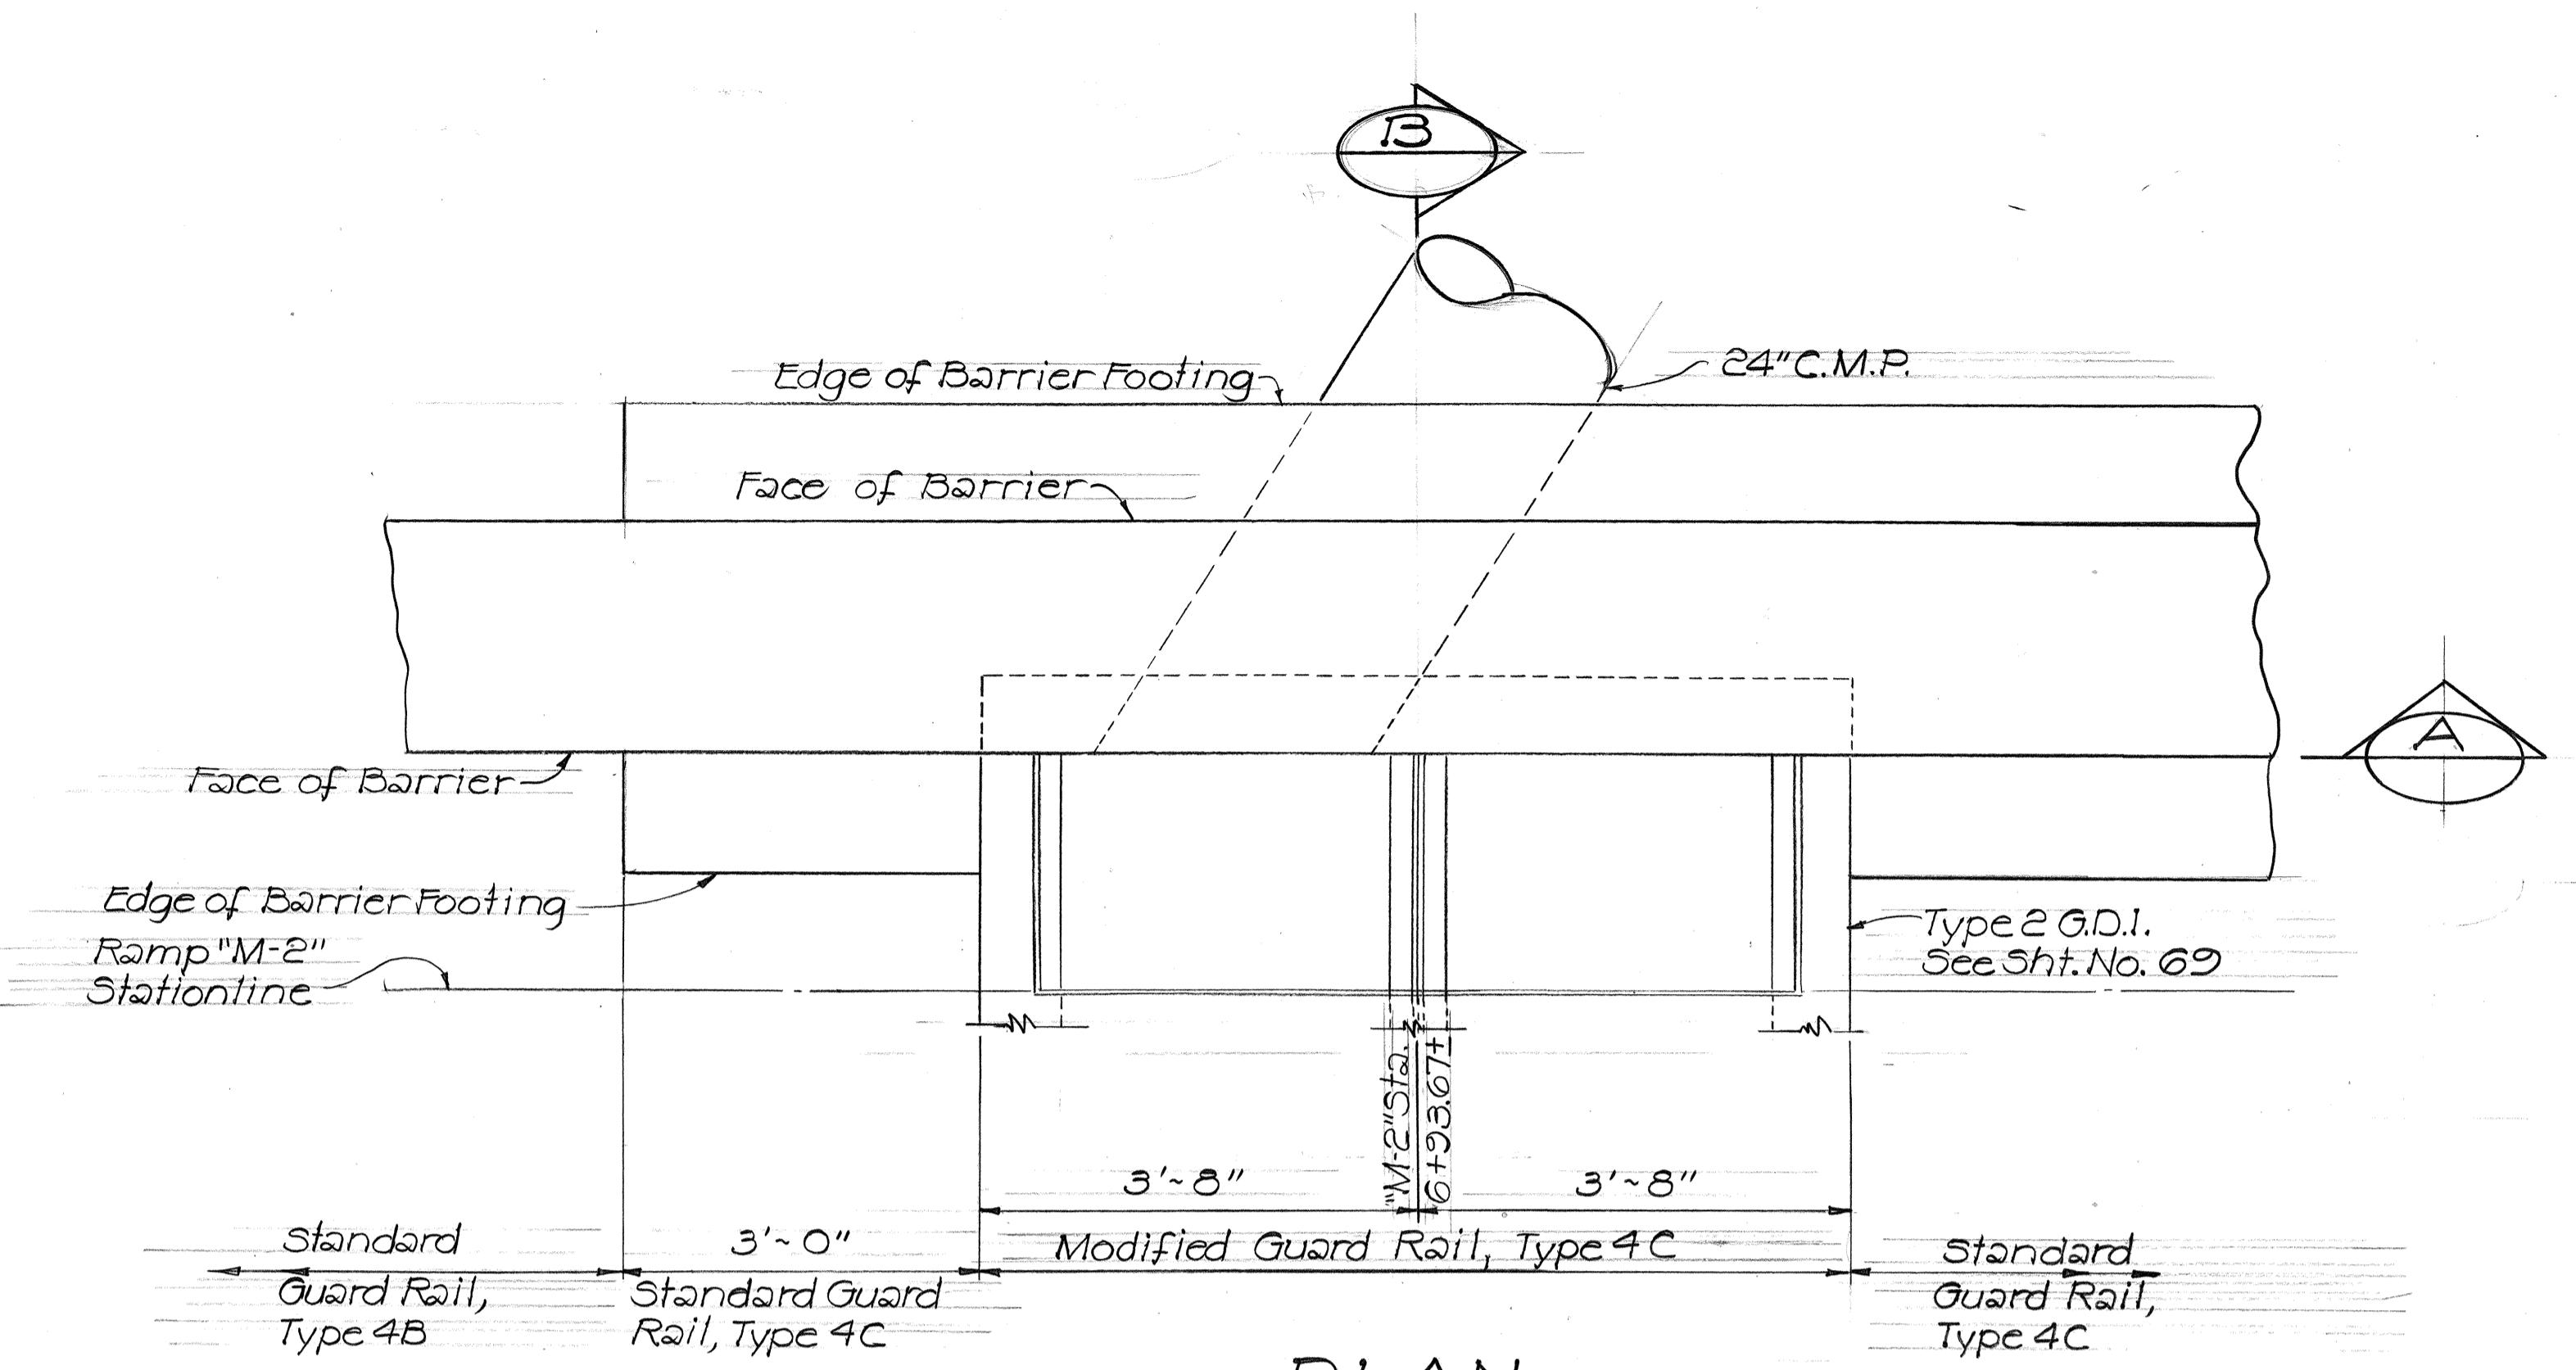


MODIFIED GUARD RAIL, TYPE 4C ~ "M-2" STA. 6+93.67± LT.

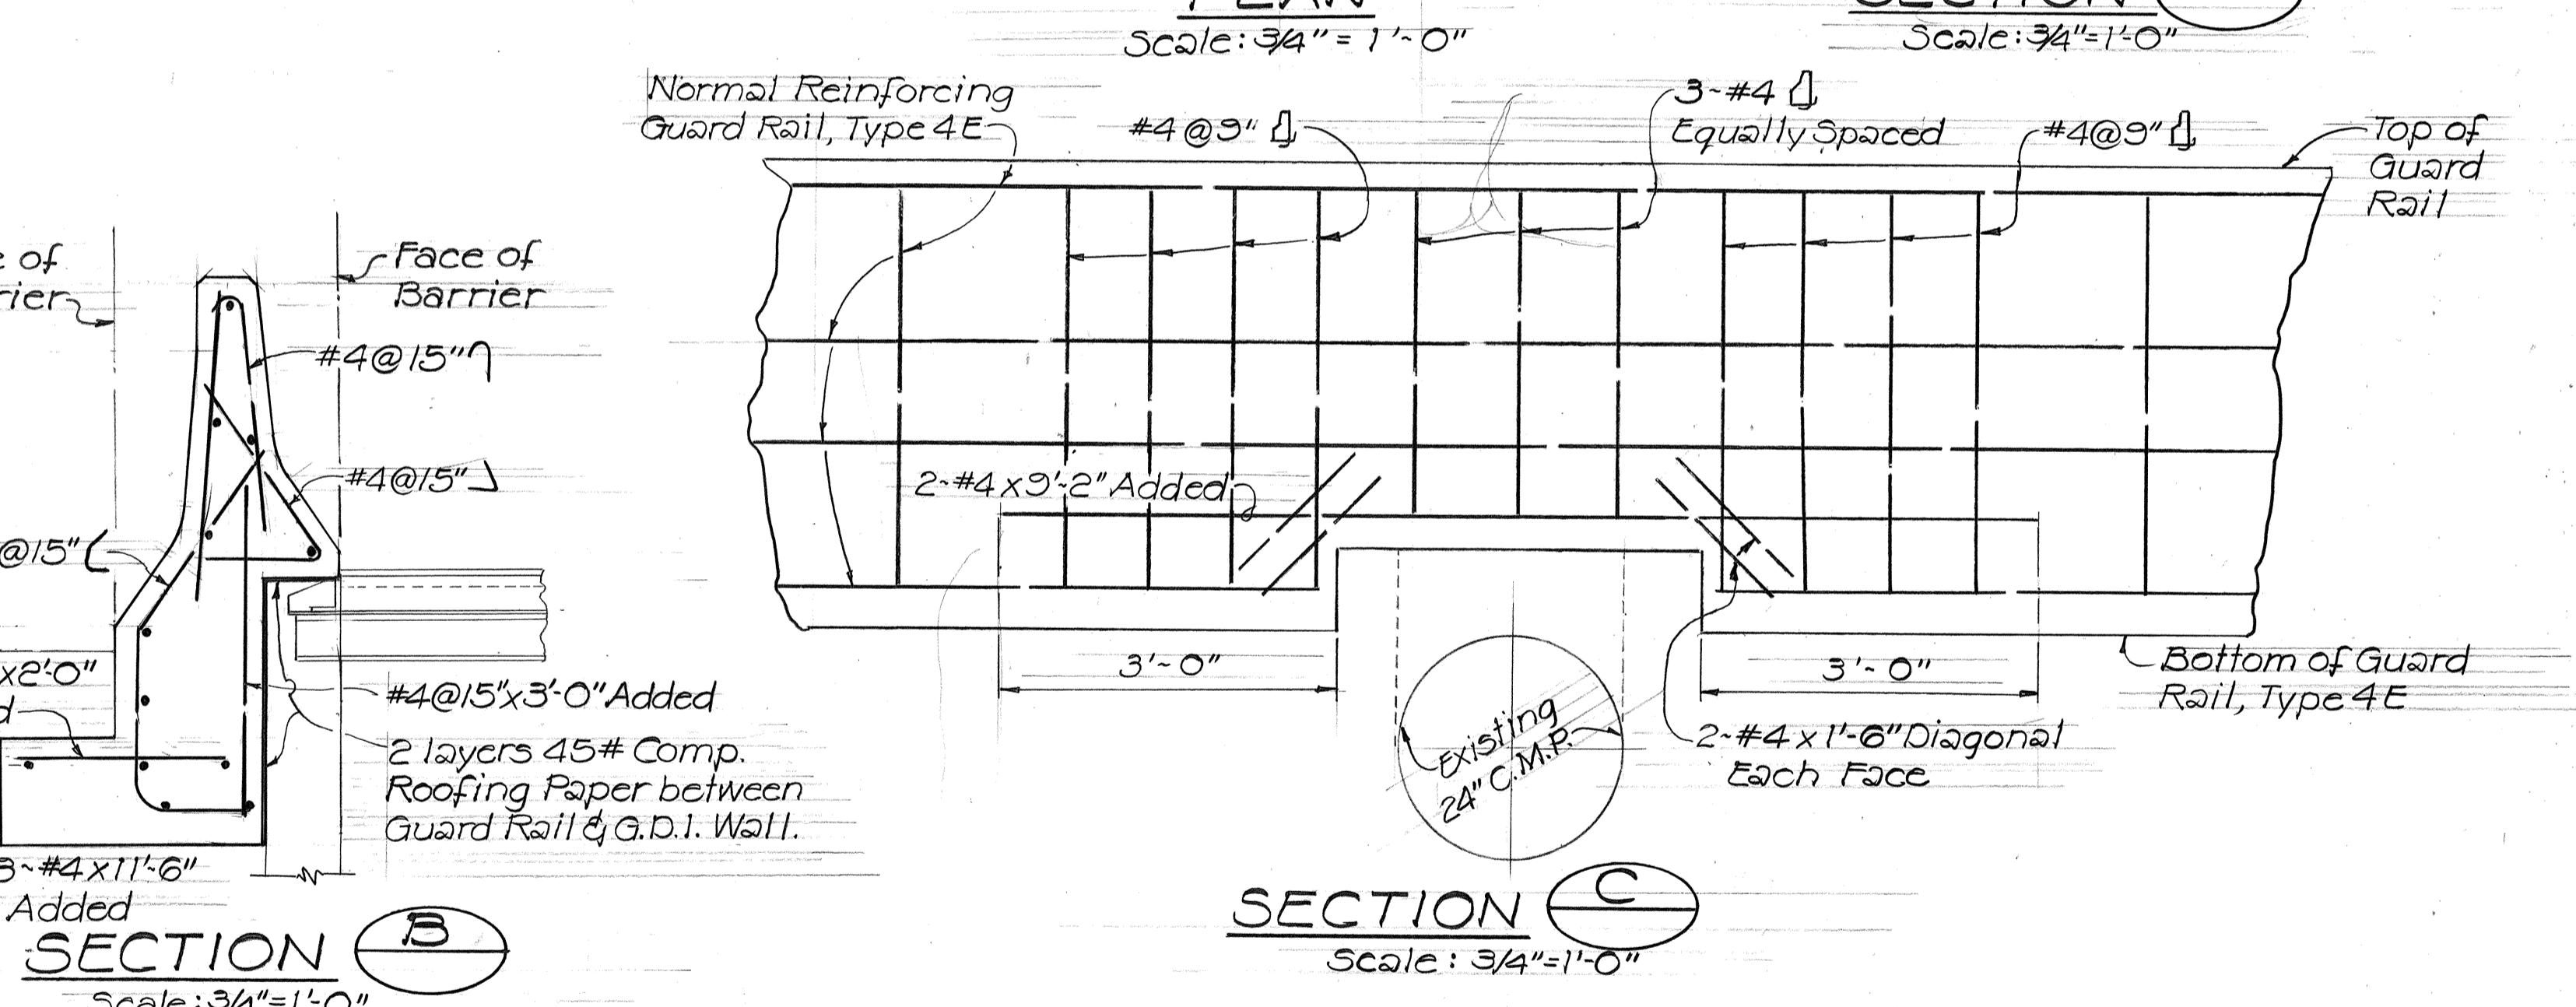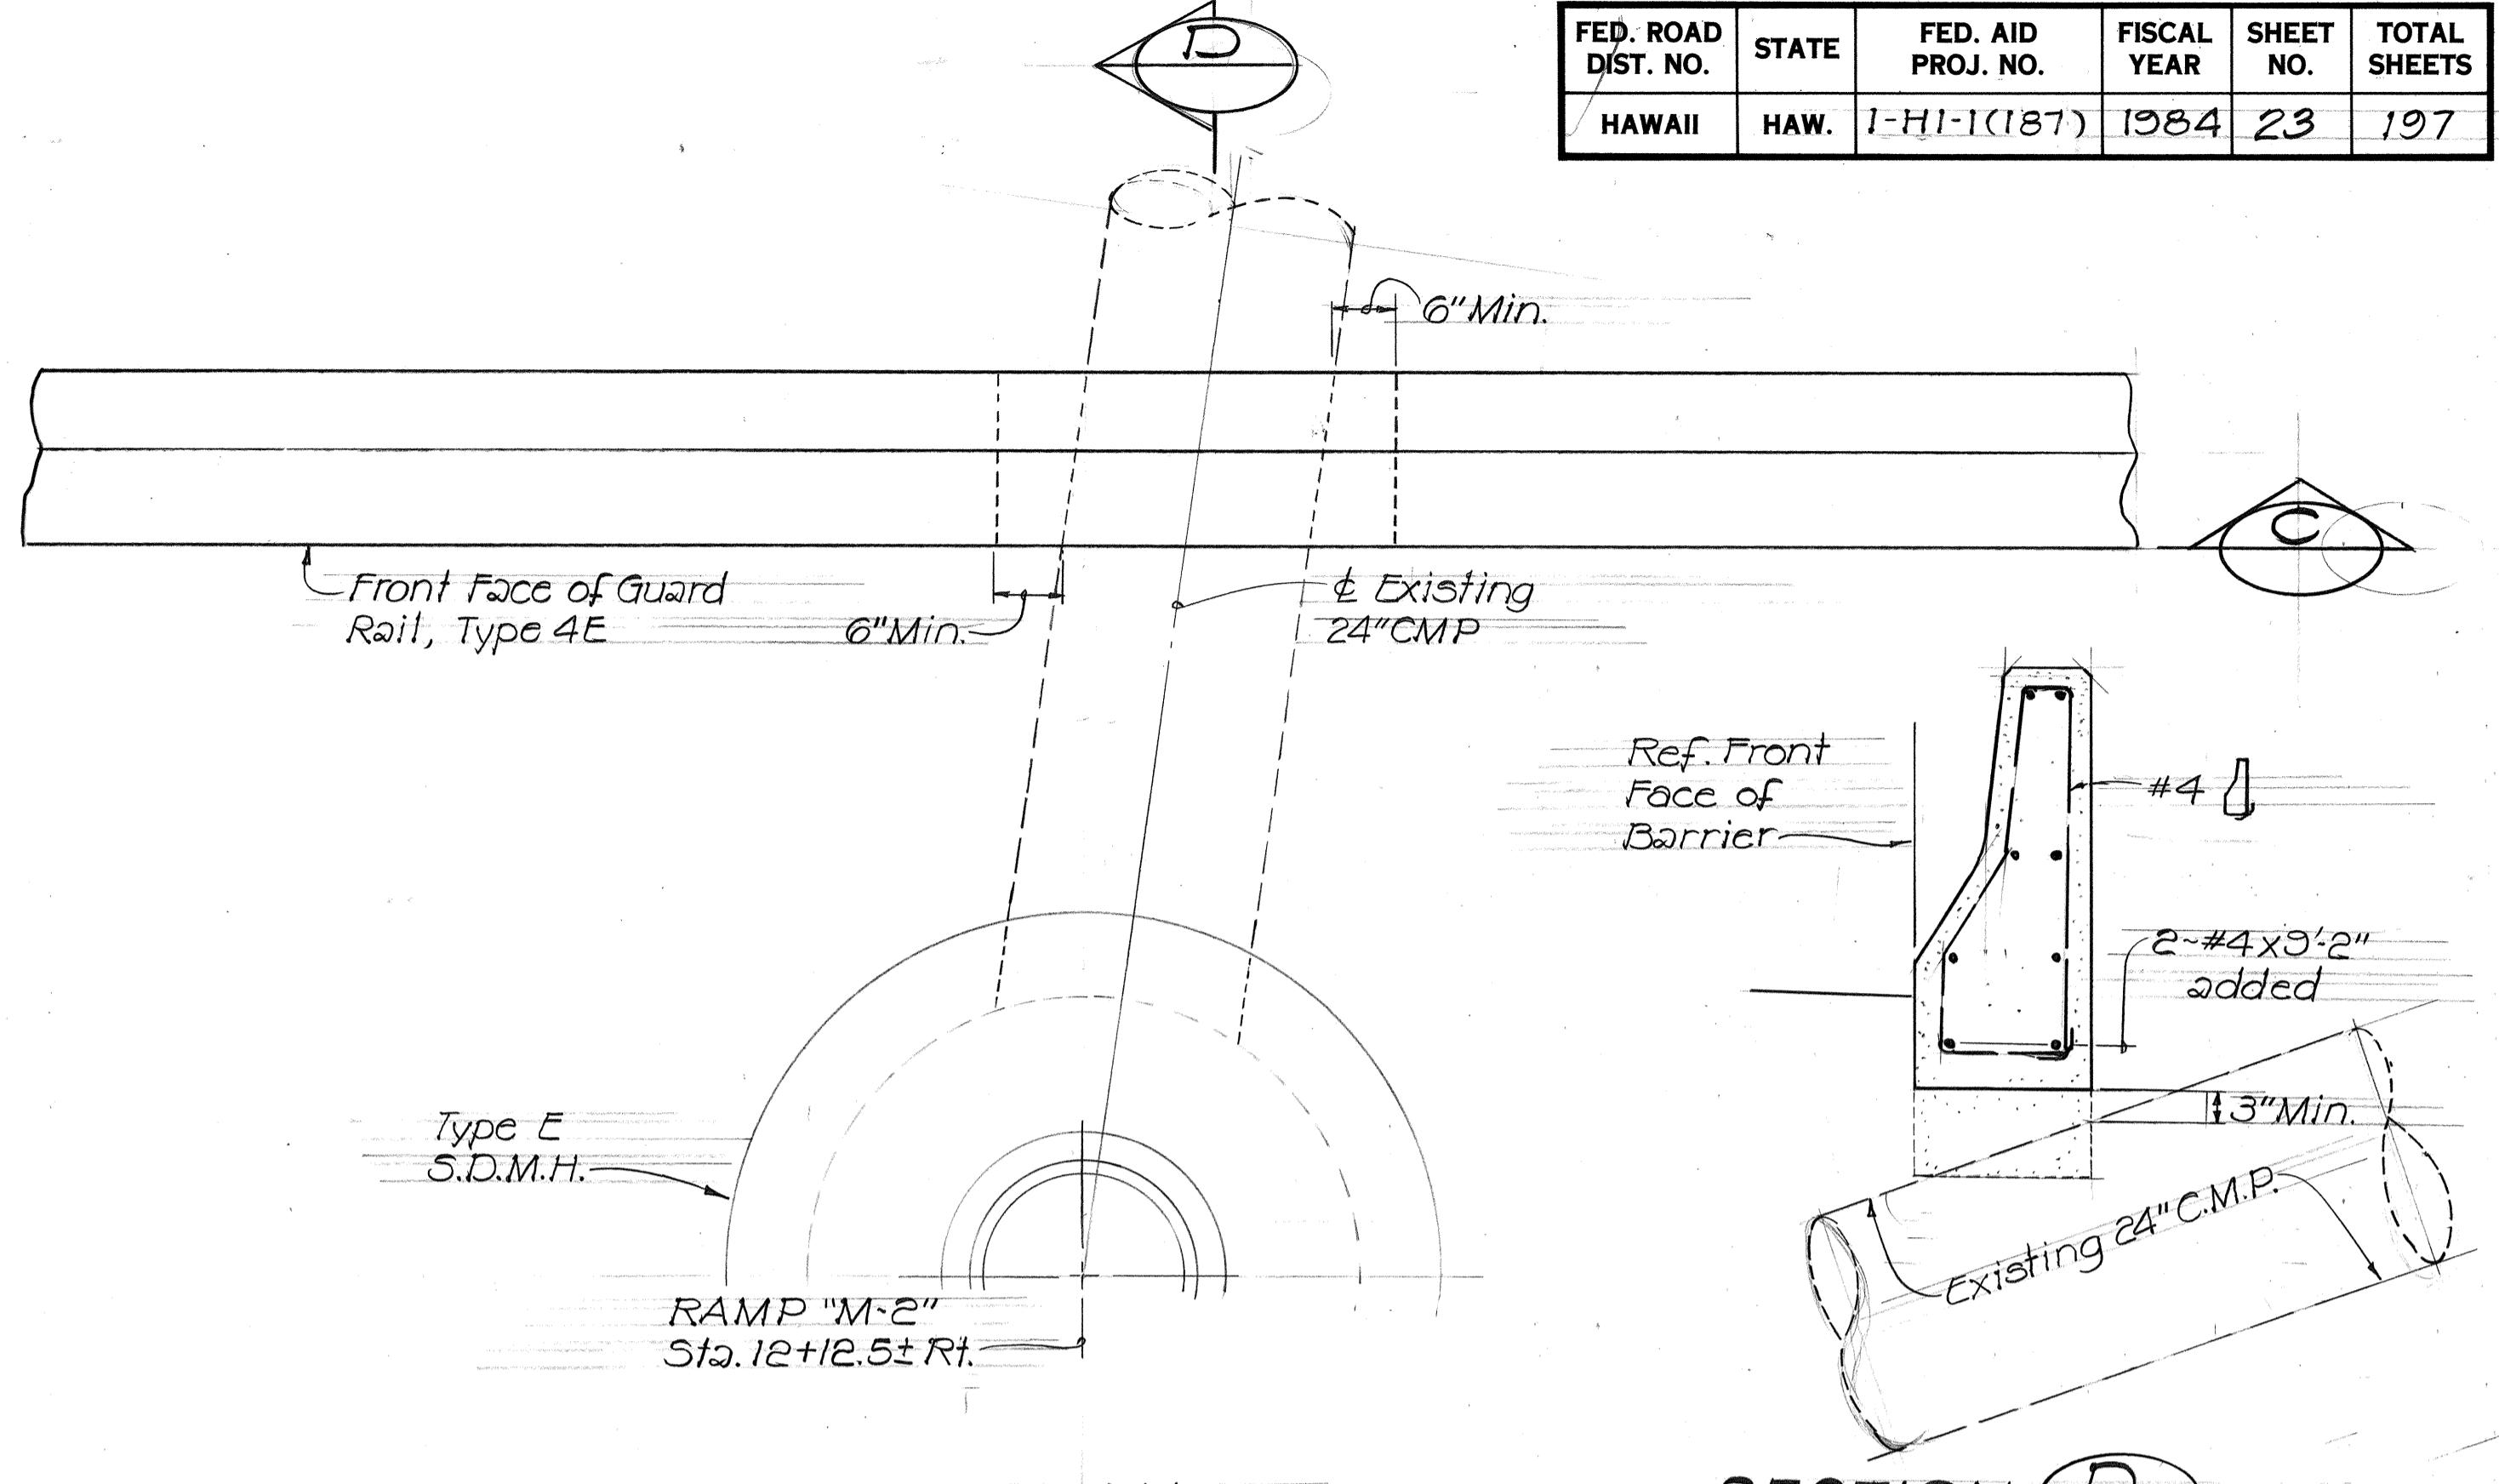


MODIFIED GUARD RAIL, TYPE 4E
"M-2" STA. 12+12.5± RT.

STATE OF HAWAII
DEPARTMENT OF TRANSPORTATION
HIGHWAYS DIVISION
GUARD RAIL TYPE 4
CONCRETE RIGID BARRIER DETAILS
INTERSTATE ROUTE H-1 IMPROVEMENTS
MIDDLE STREET TO KALIHI INTERCHANGE
WESTBOUND LANES
F.A.I. PROJ. NO. I-HI-1(187)
SCALE: As Shown
SHEET NO. 4 OF 10 SHEETS


FED. ROAD DIST. NO.	STATE	FED. AID PROJ. NO.	FISCAL YEAR	SHEET NO.	TOTAL SHEETS
HAWAII	HAW.	1-HI-1(187)	1984	24	197

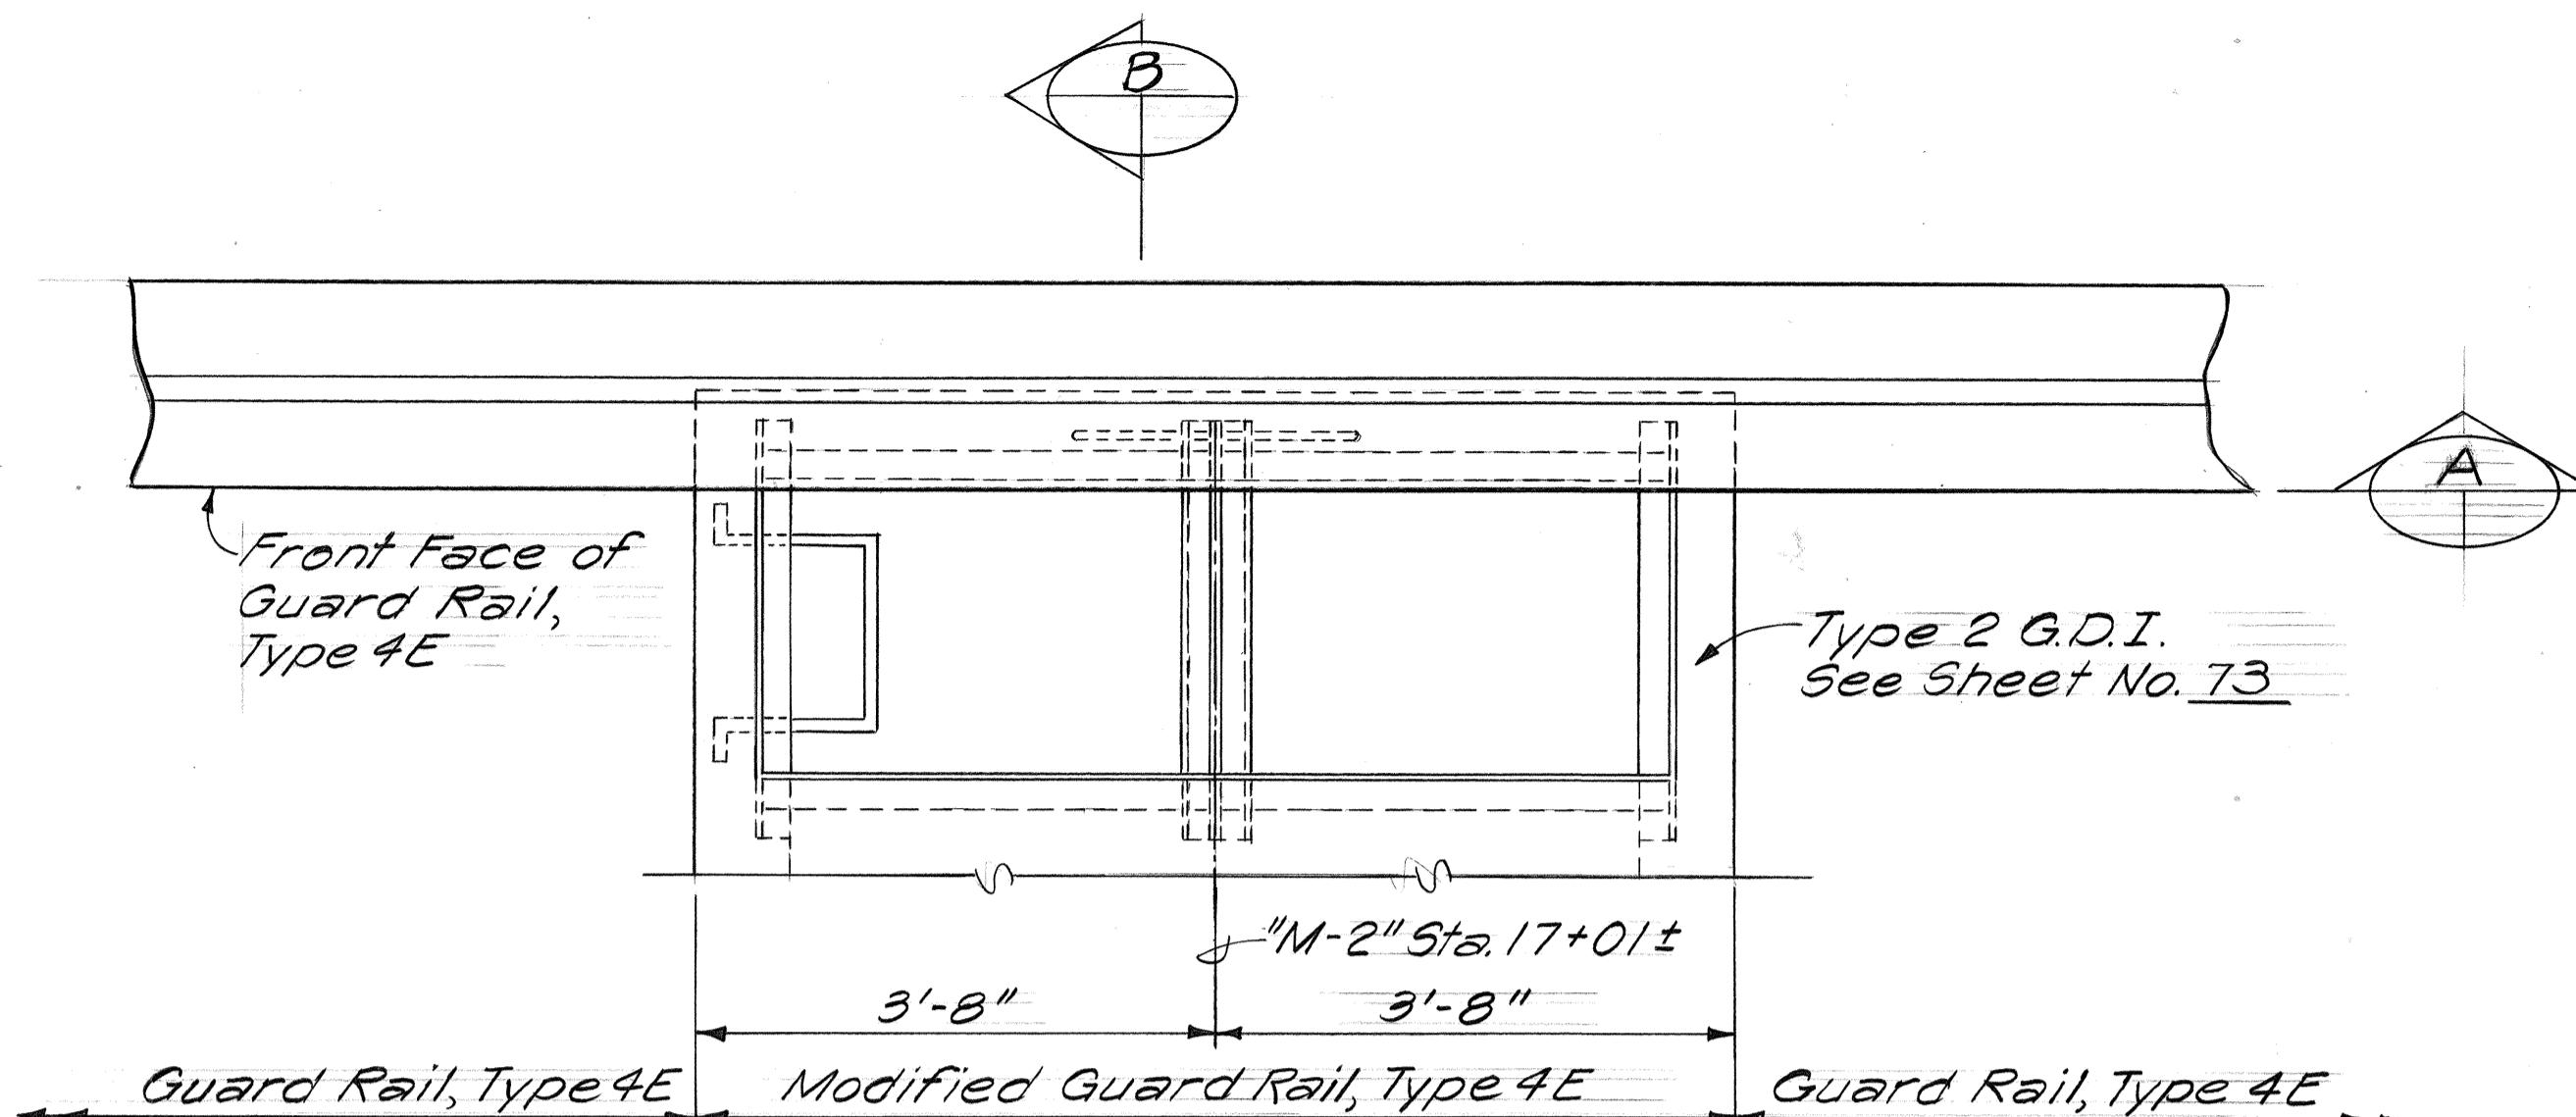

PLAN

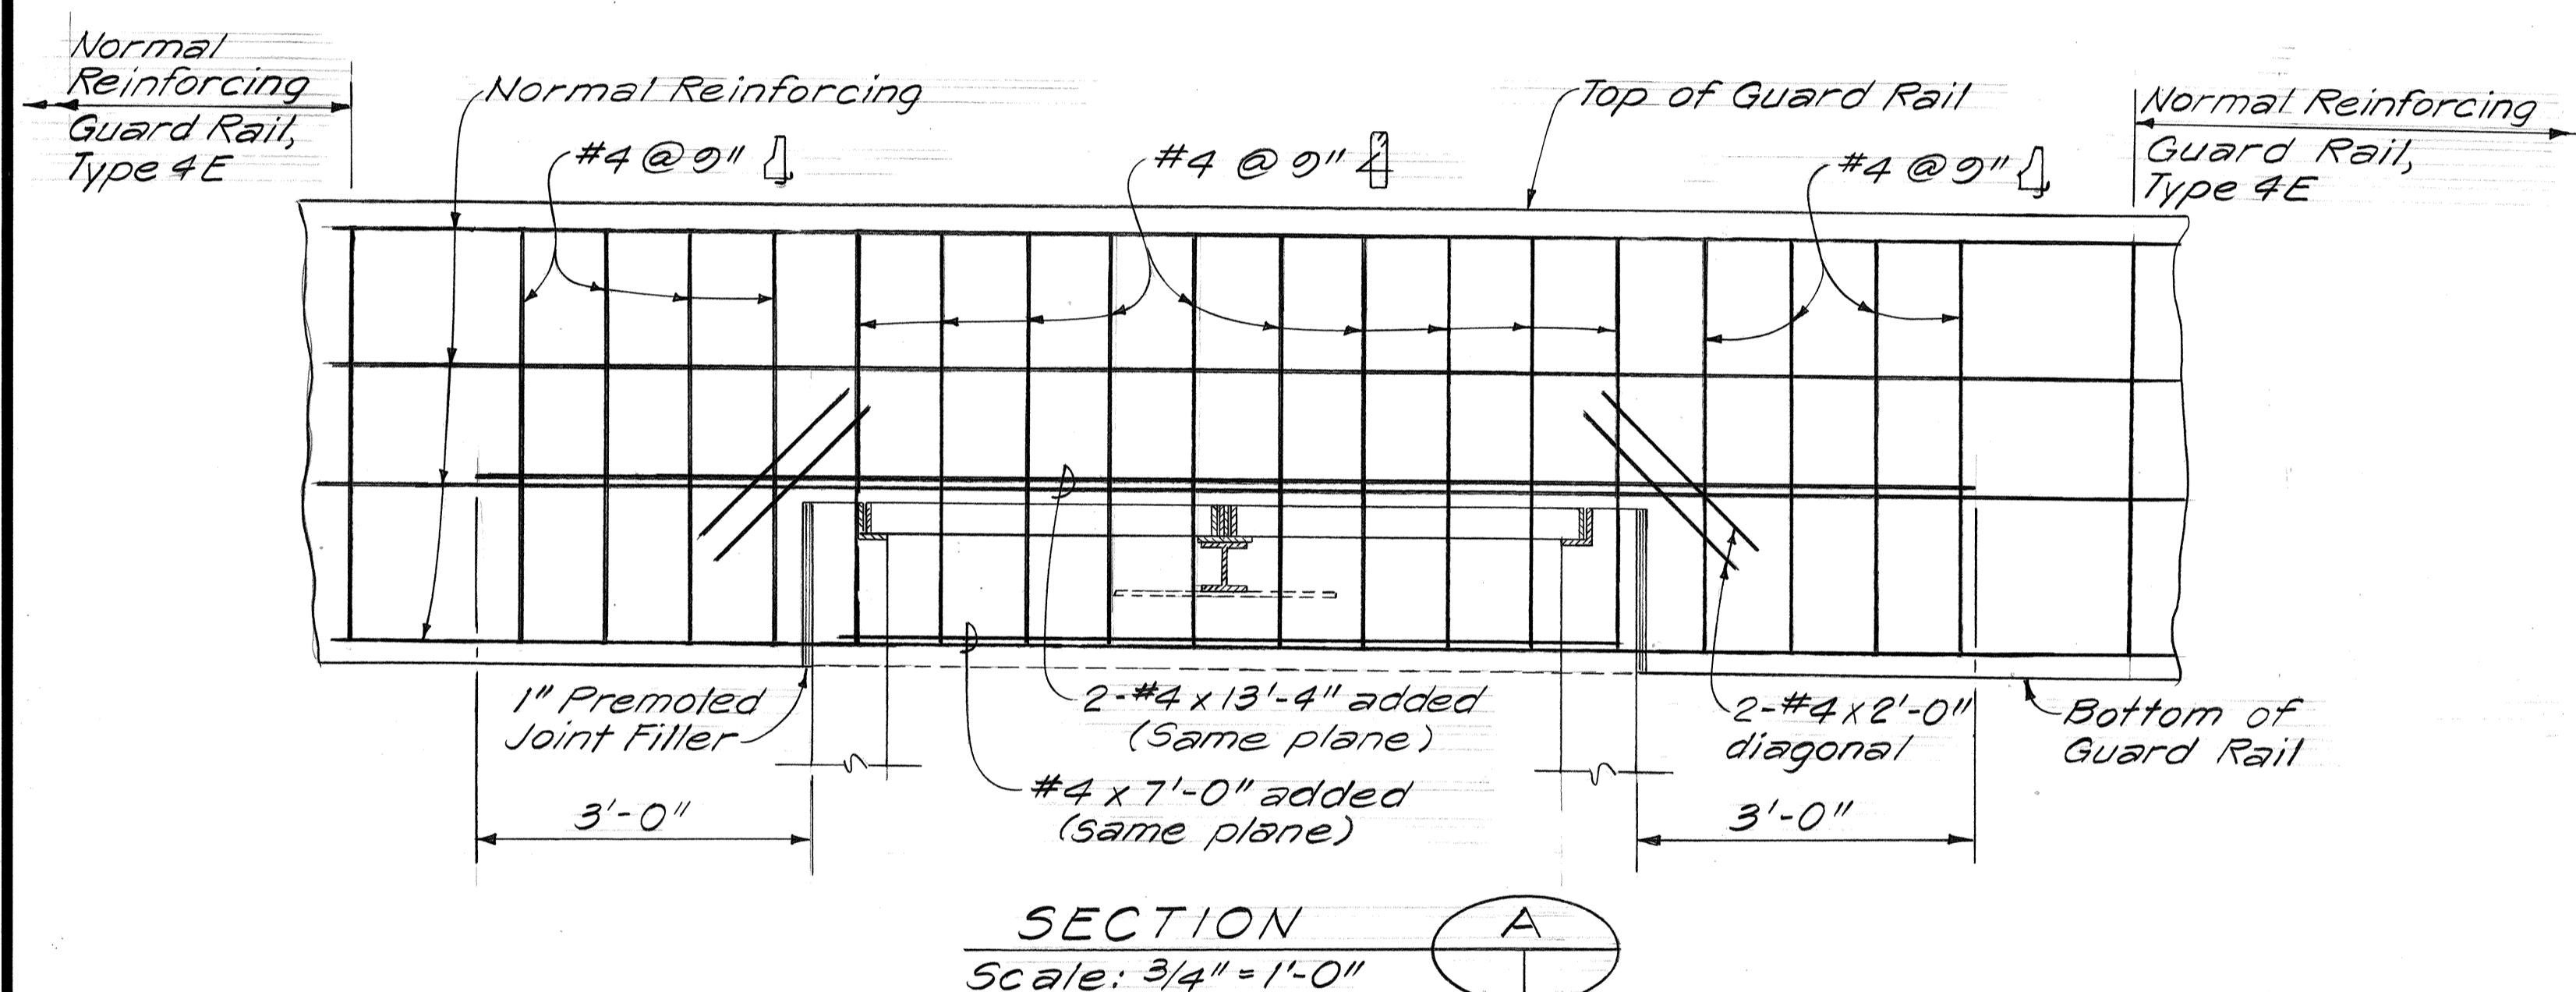


SECTION

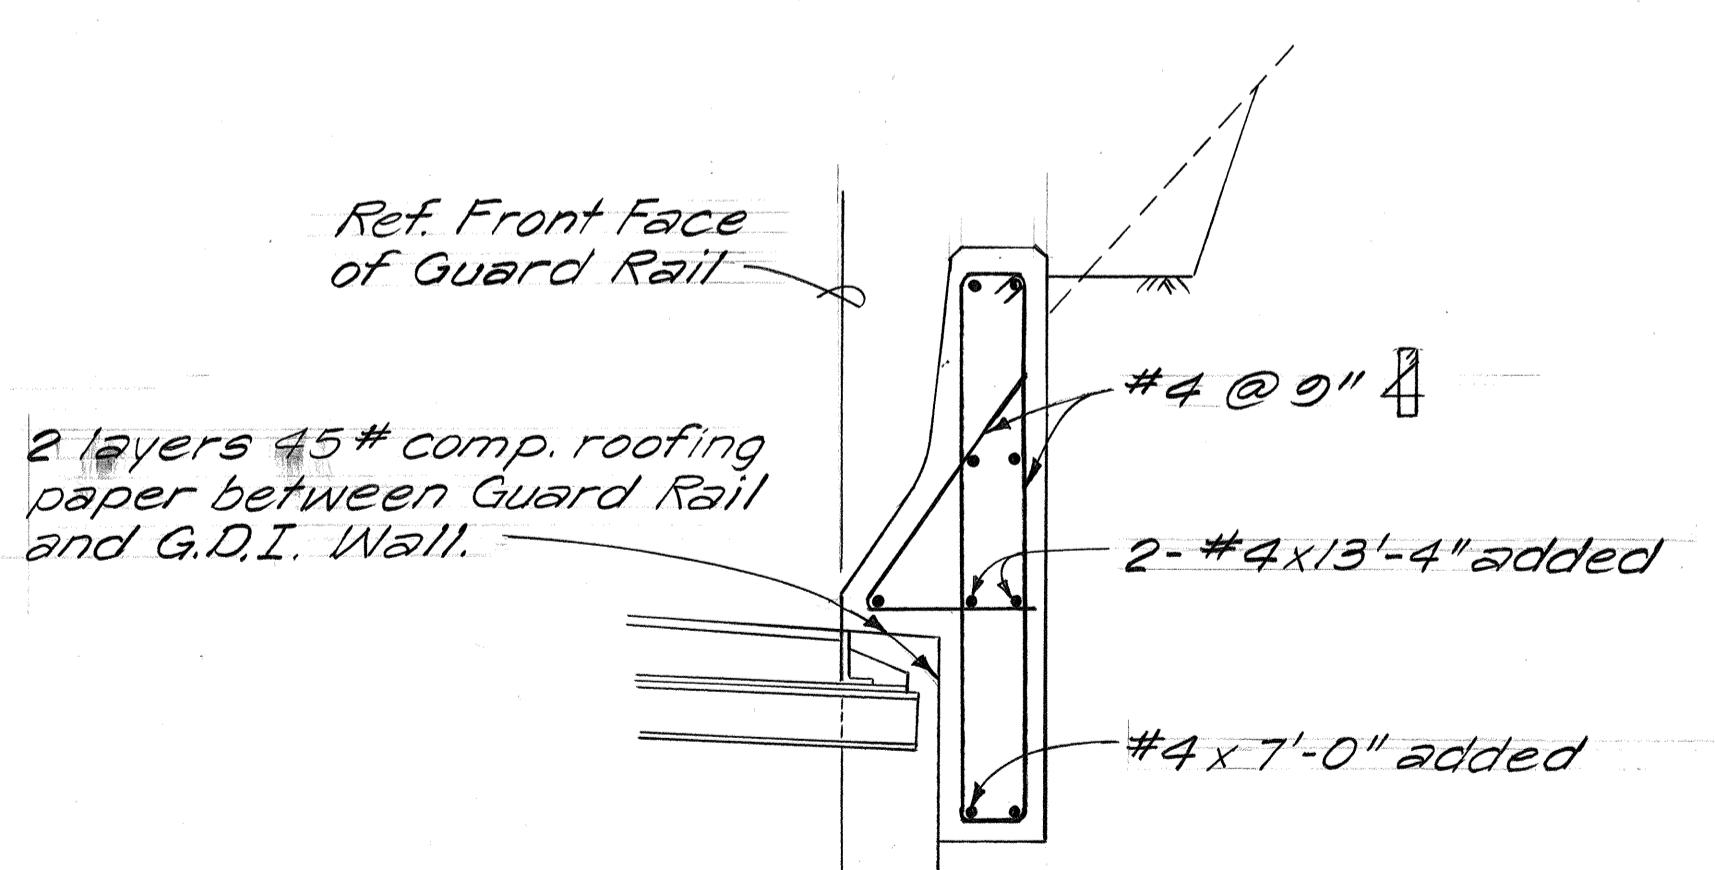


SECTION
Scale: $3\frac{1}{4}'' = 1'$


MODIFIED GUARD RAIL, TYPE 4E - "M-2" STA. 17+01 ± RT.

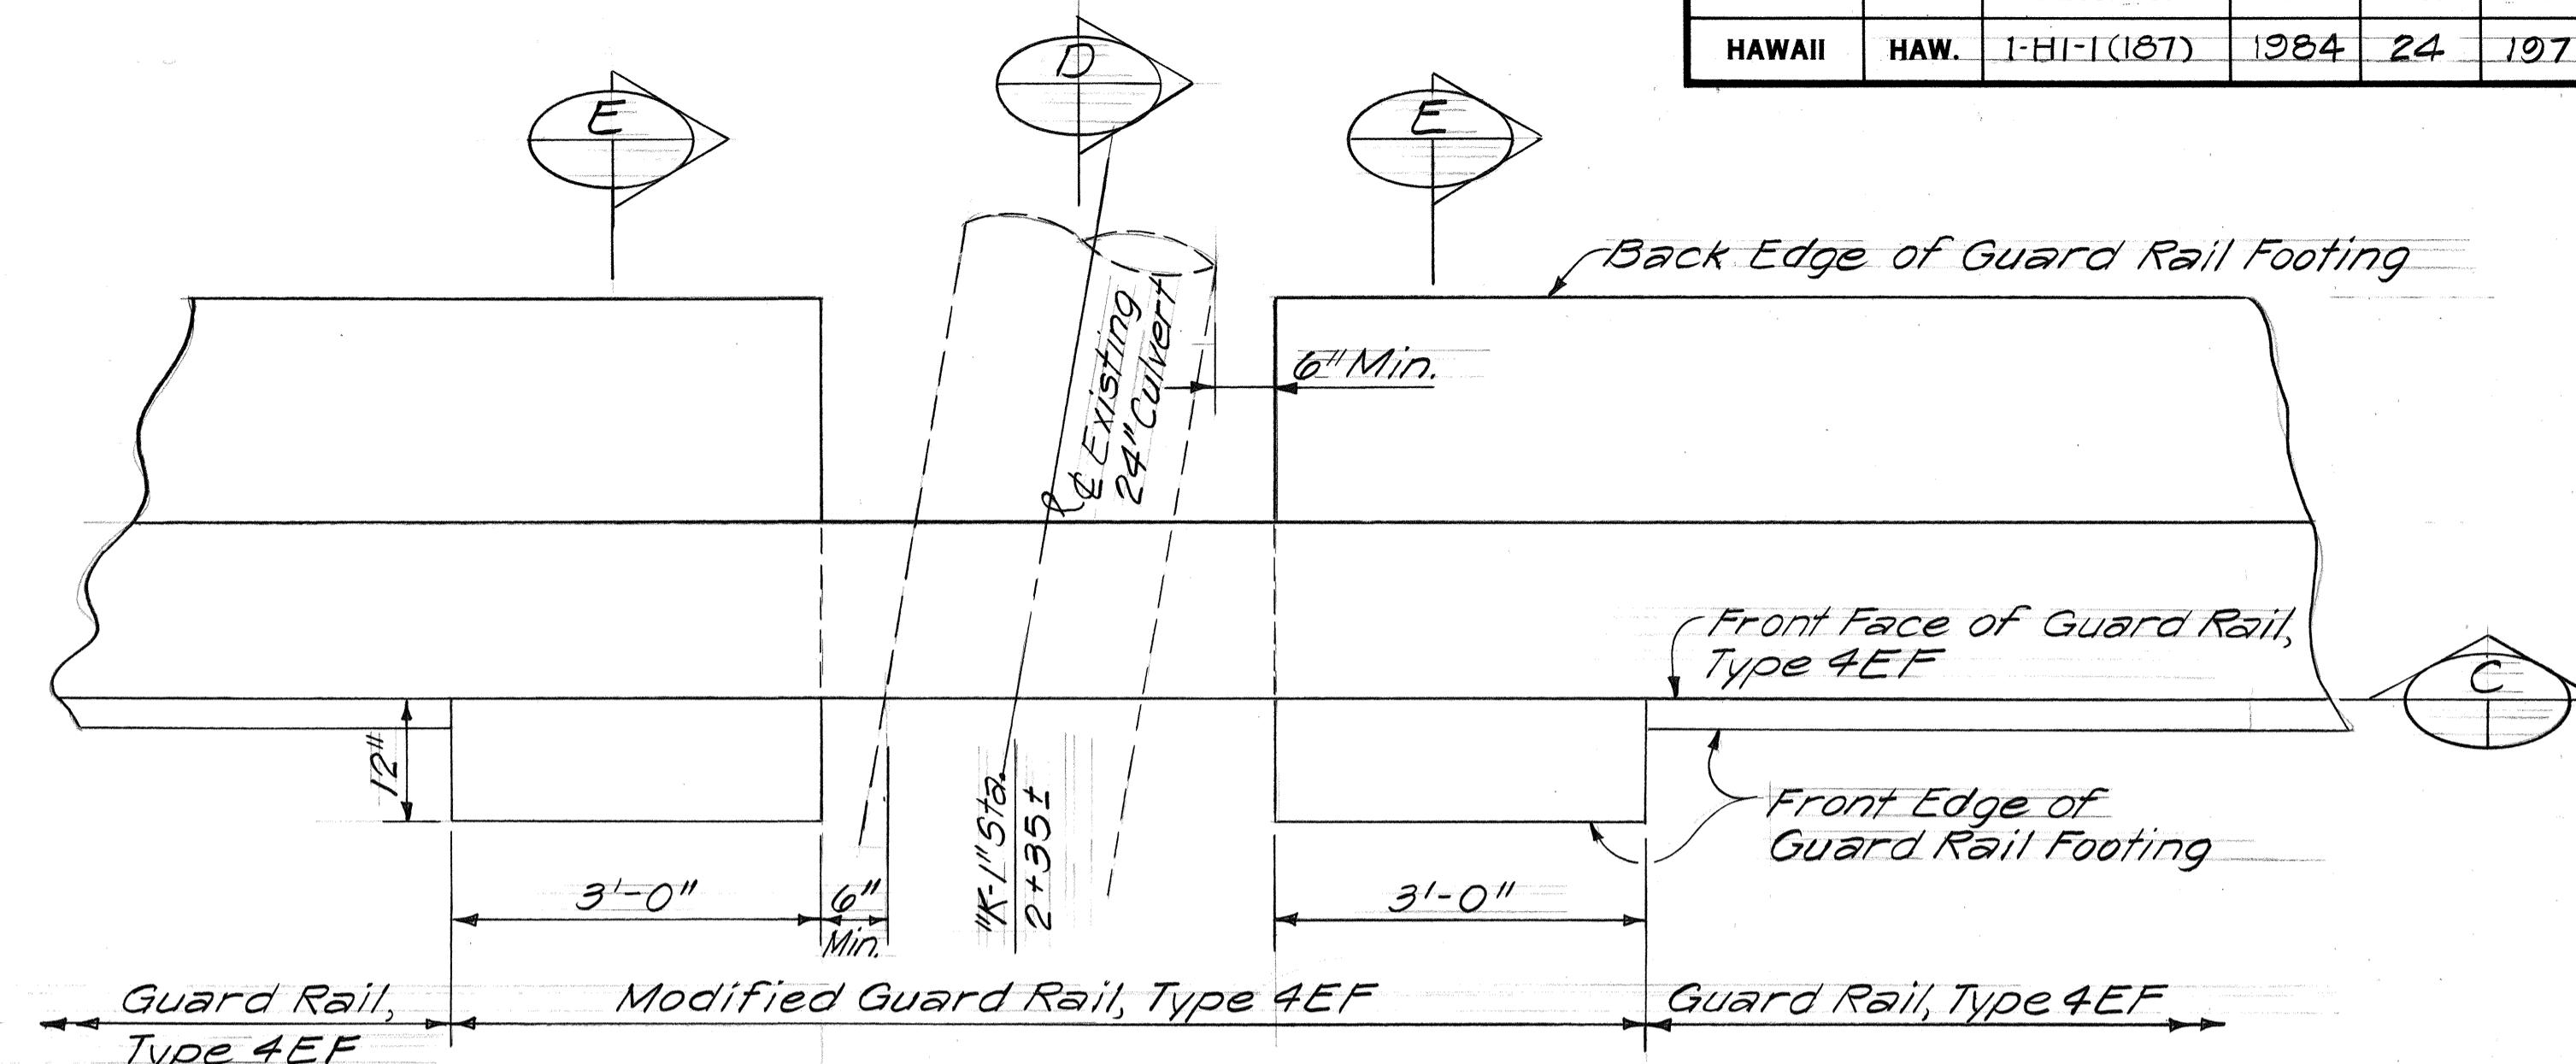


PLAN
Scale: $\frac{3}{4}'' = 1'-0''$

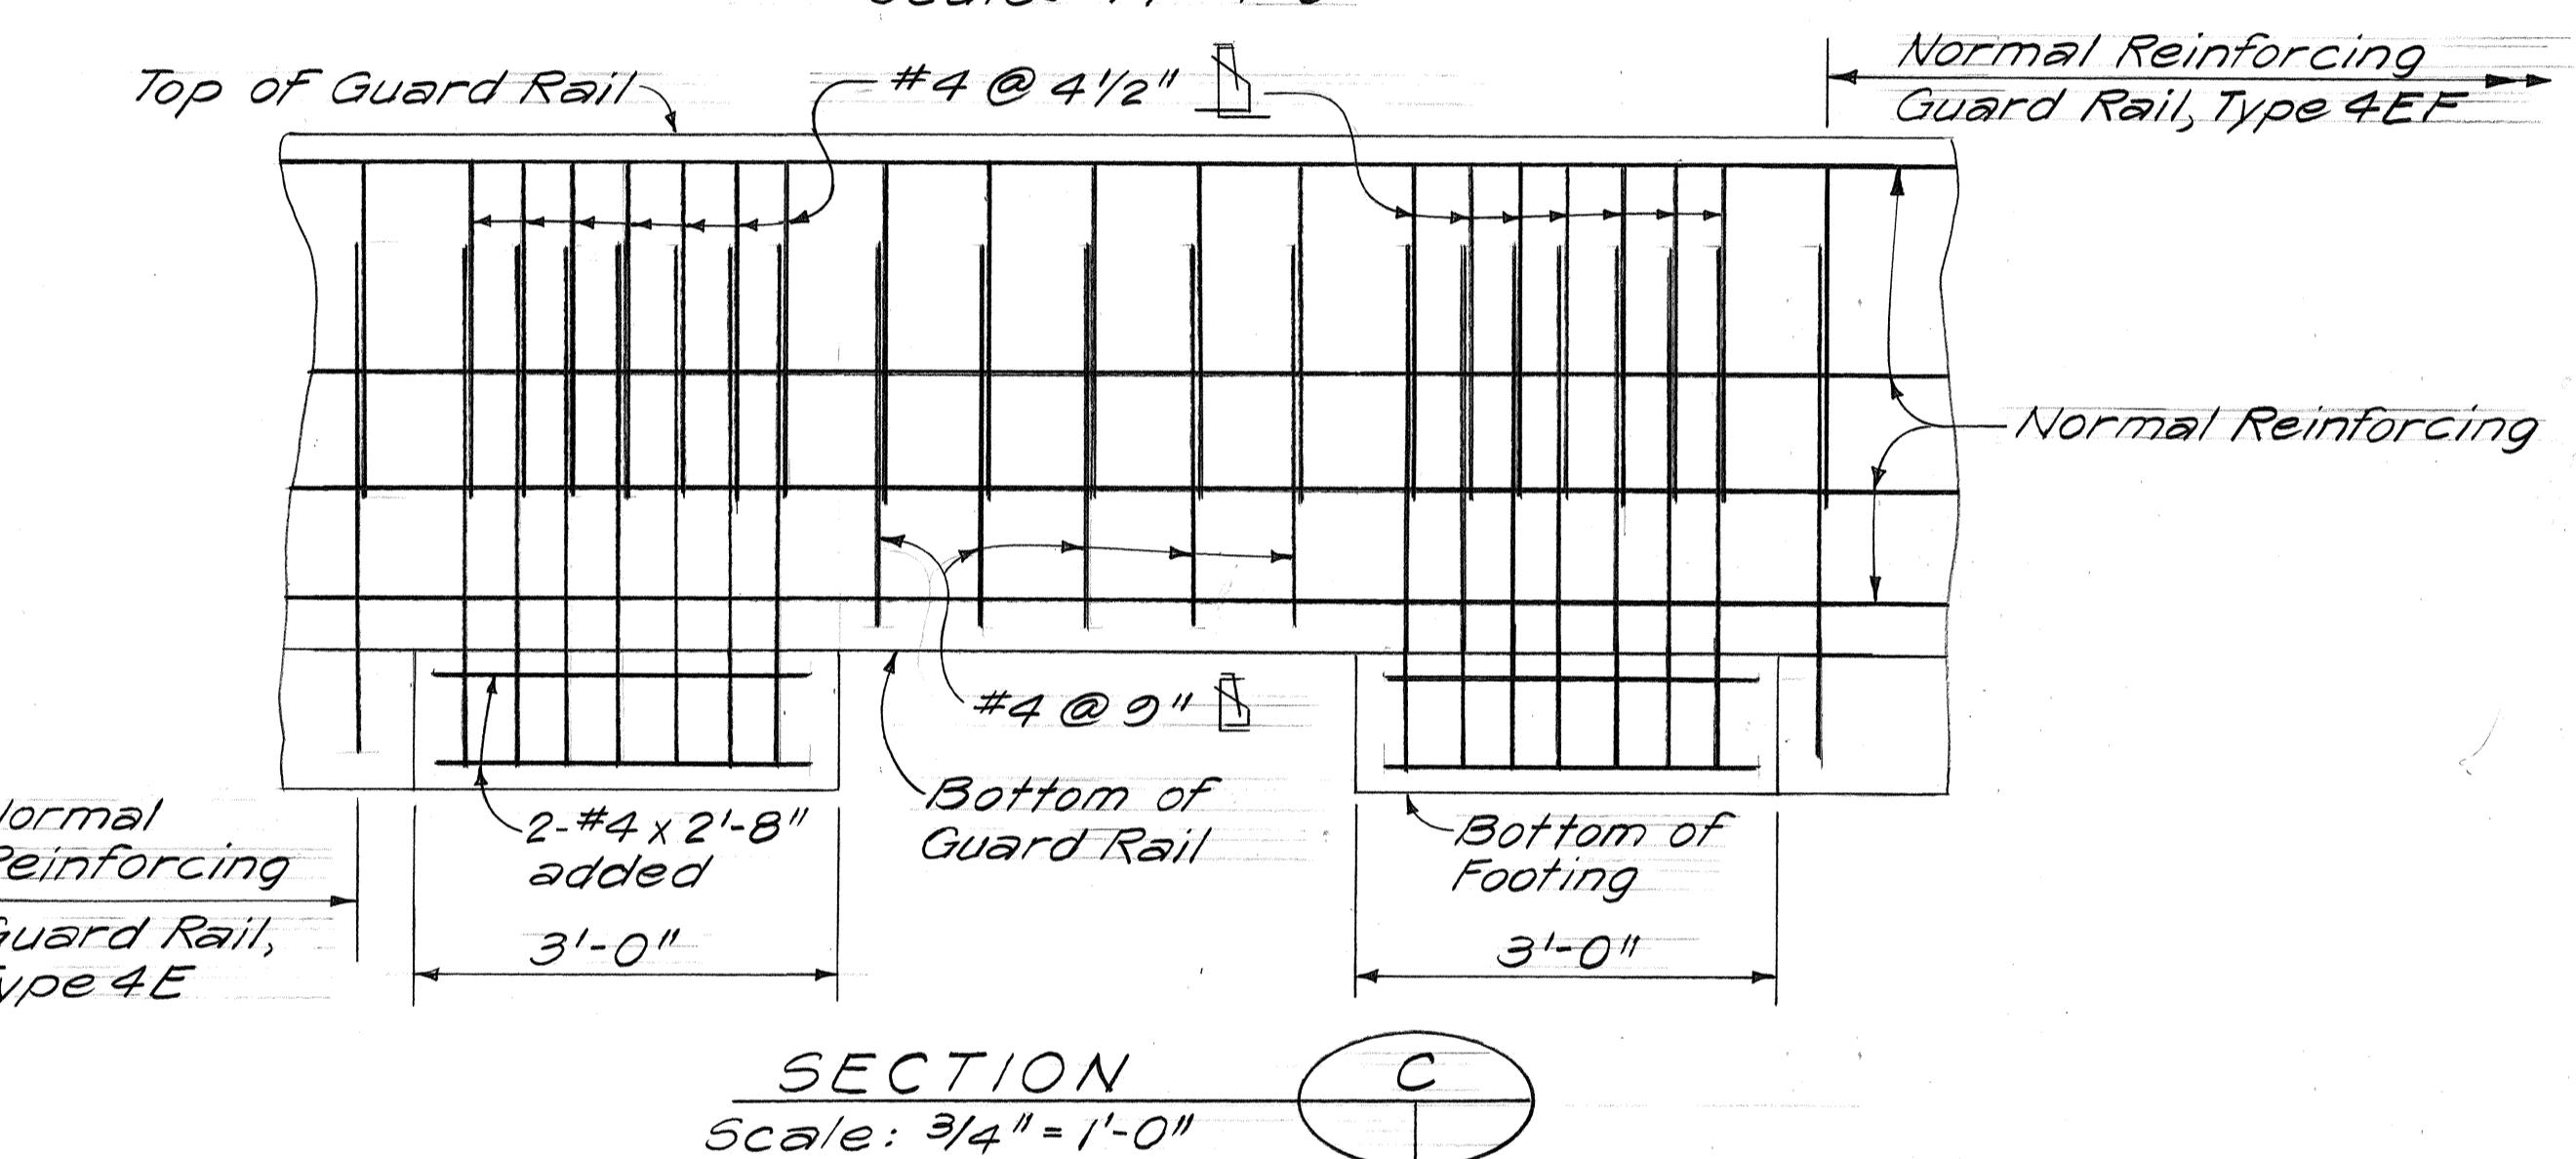

SECTION

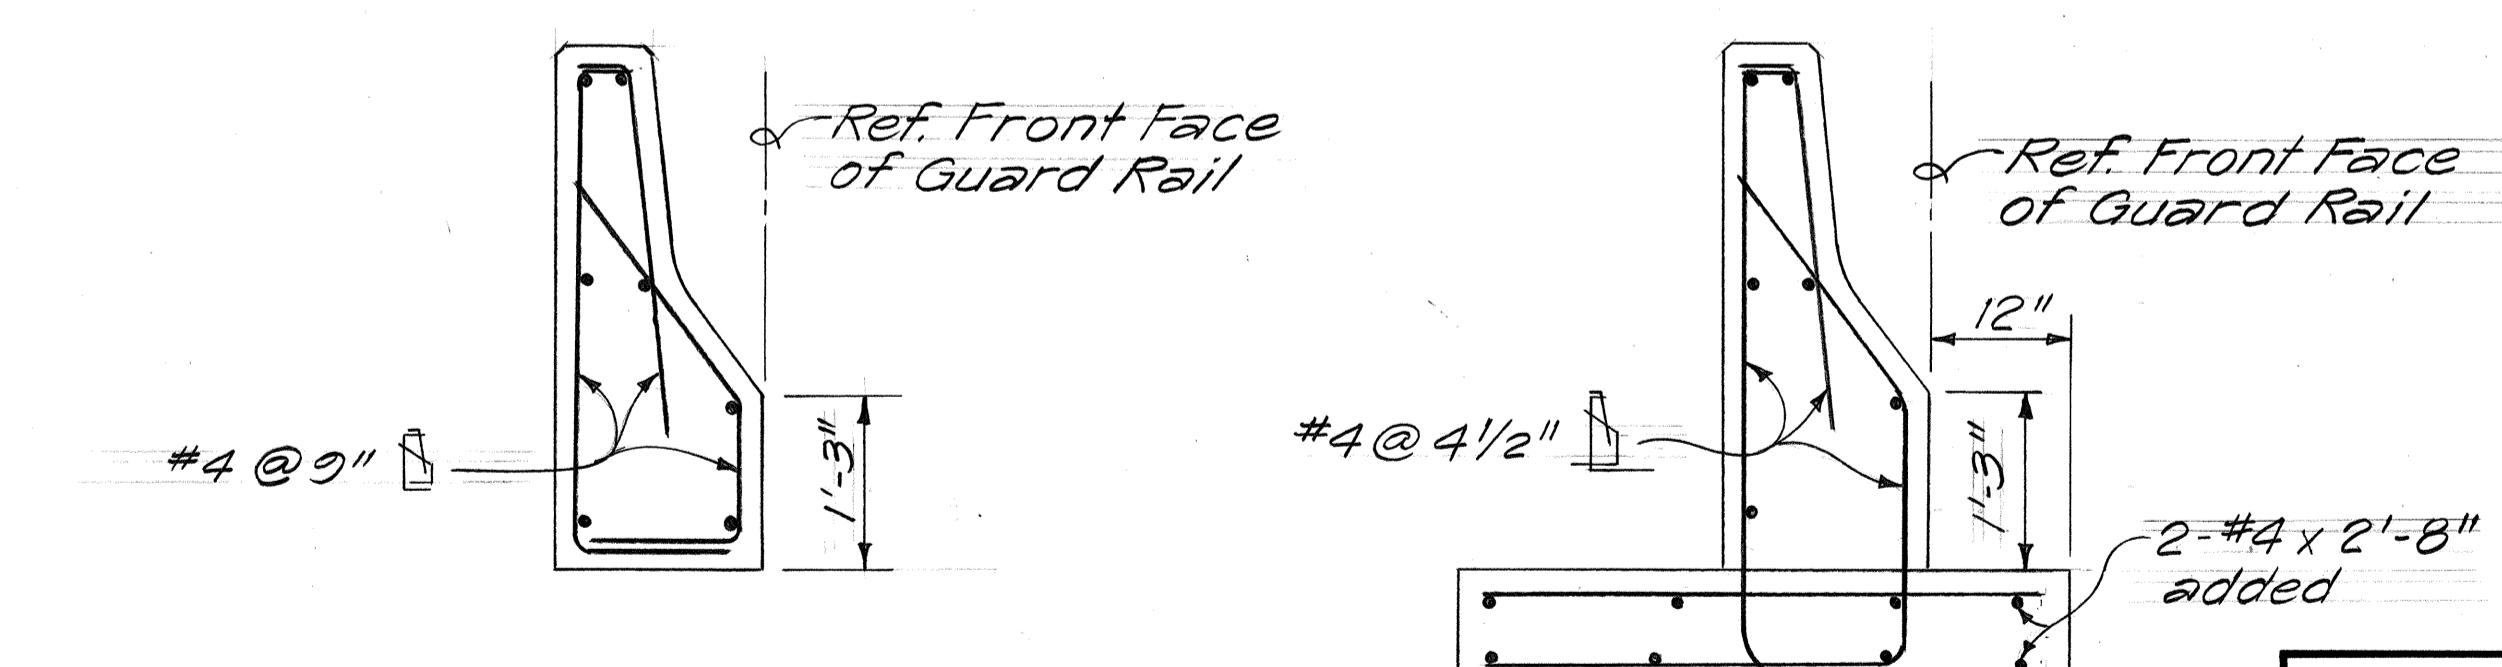

SECTION

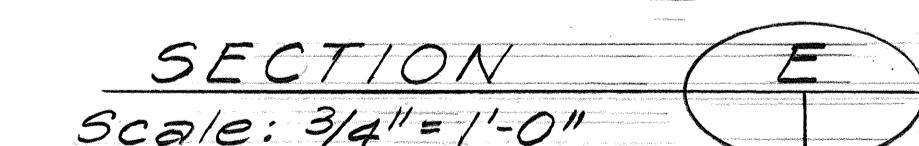


MODIFIED GUARD RAIL, TYPE 4EF


"K-1" STA. 2 + 35 ± LT.

STATE OF HAWAII
DEPARTMENT OF TRANSPORTATION
HIGHWAYS DIVISION

FED. ROAD DIST. NO.	STATE	FED. AID PROJ. NO.	FISCAL YEAR	SHEET NO.	TOTAL SHEETS
HAWAII	HAW.	I-HI-1(187)	1984	25	197

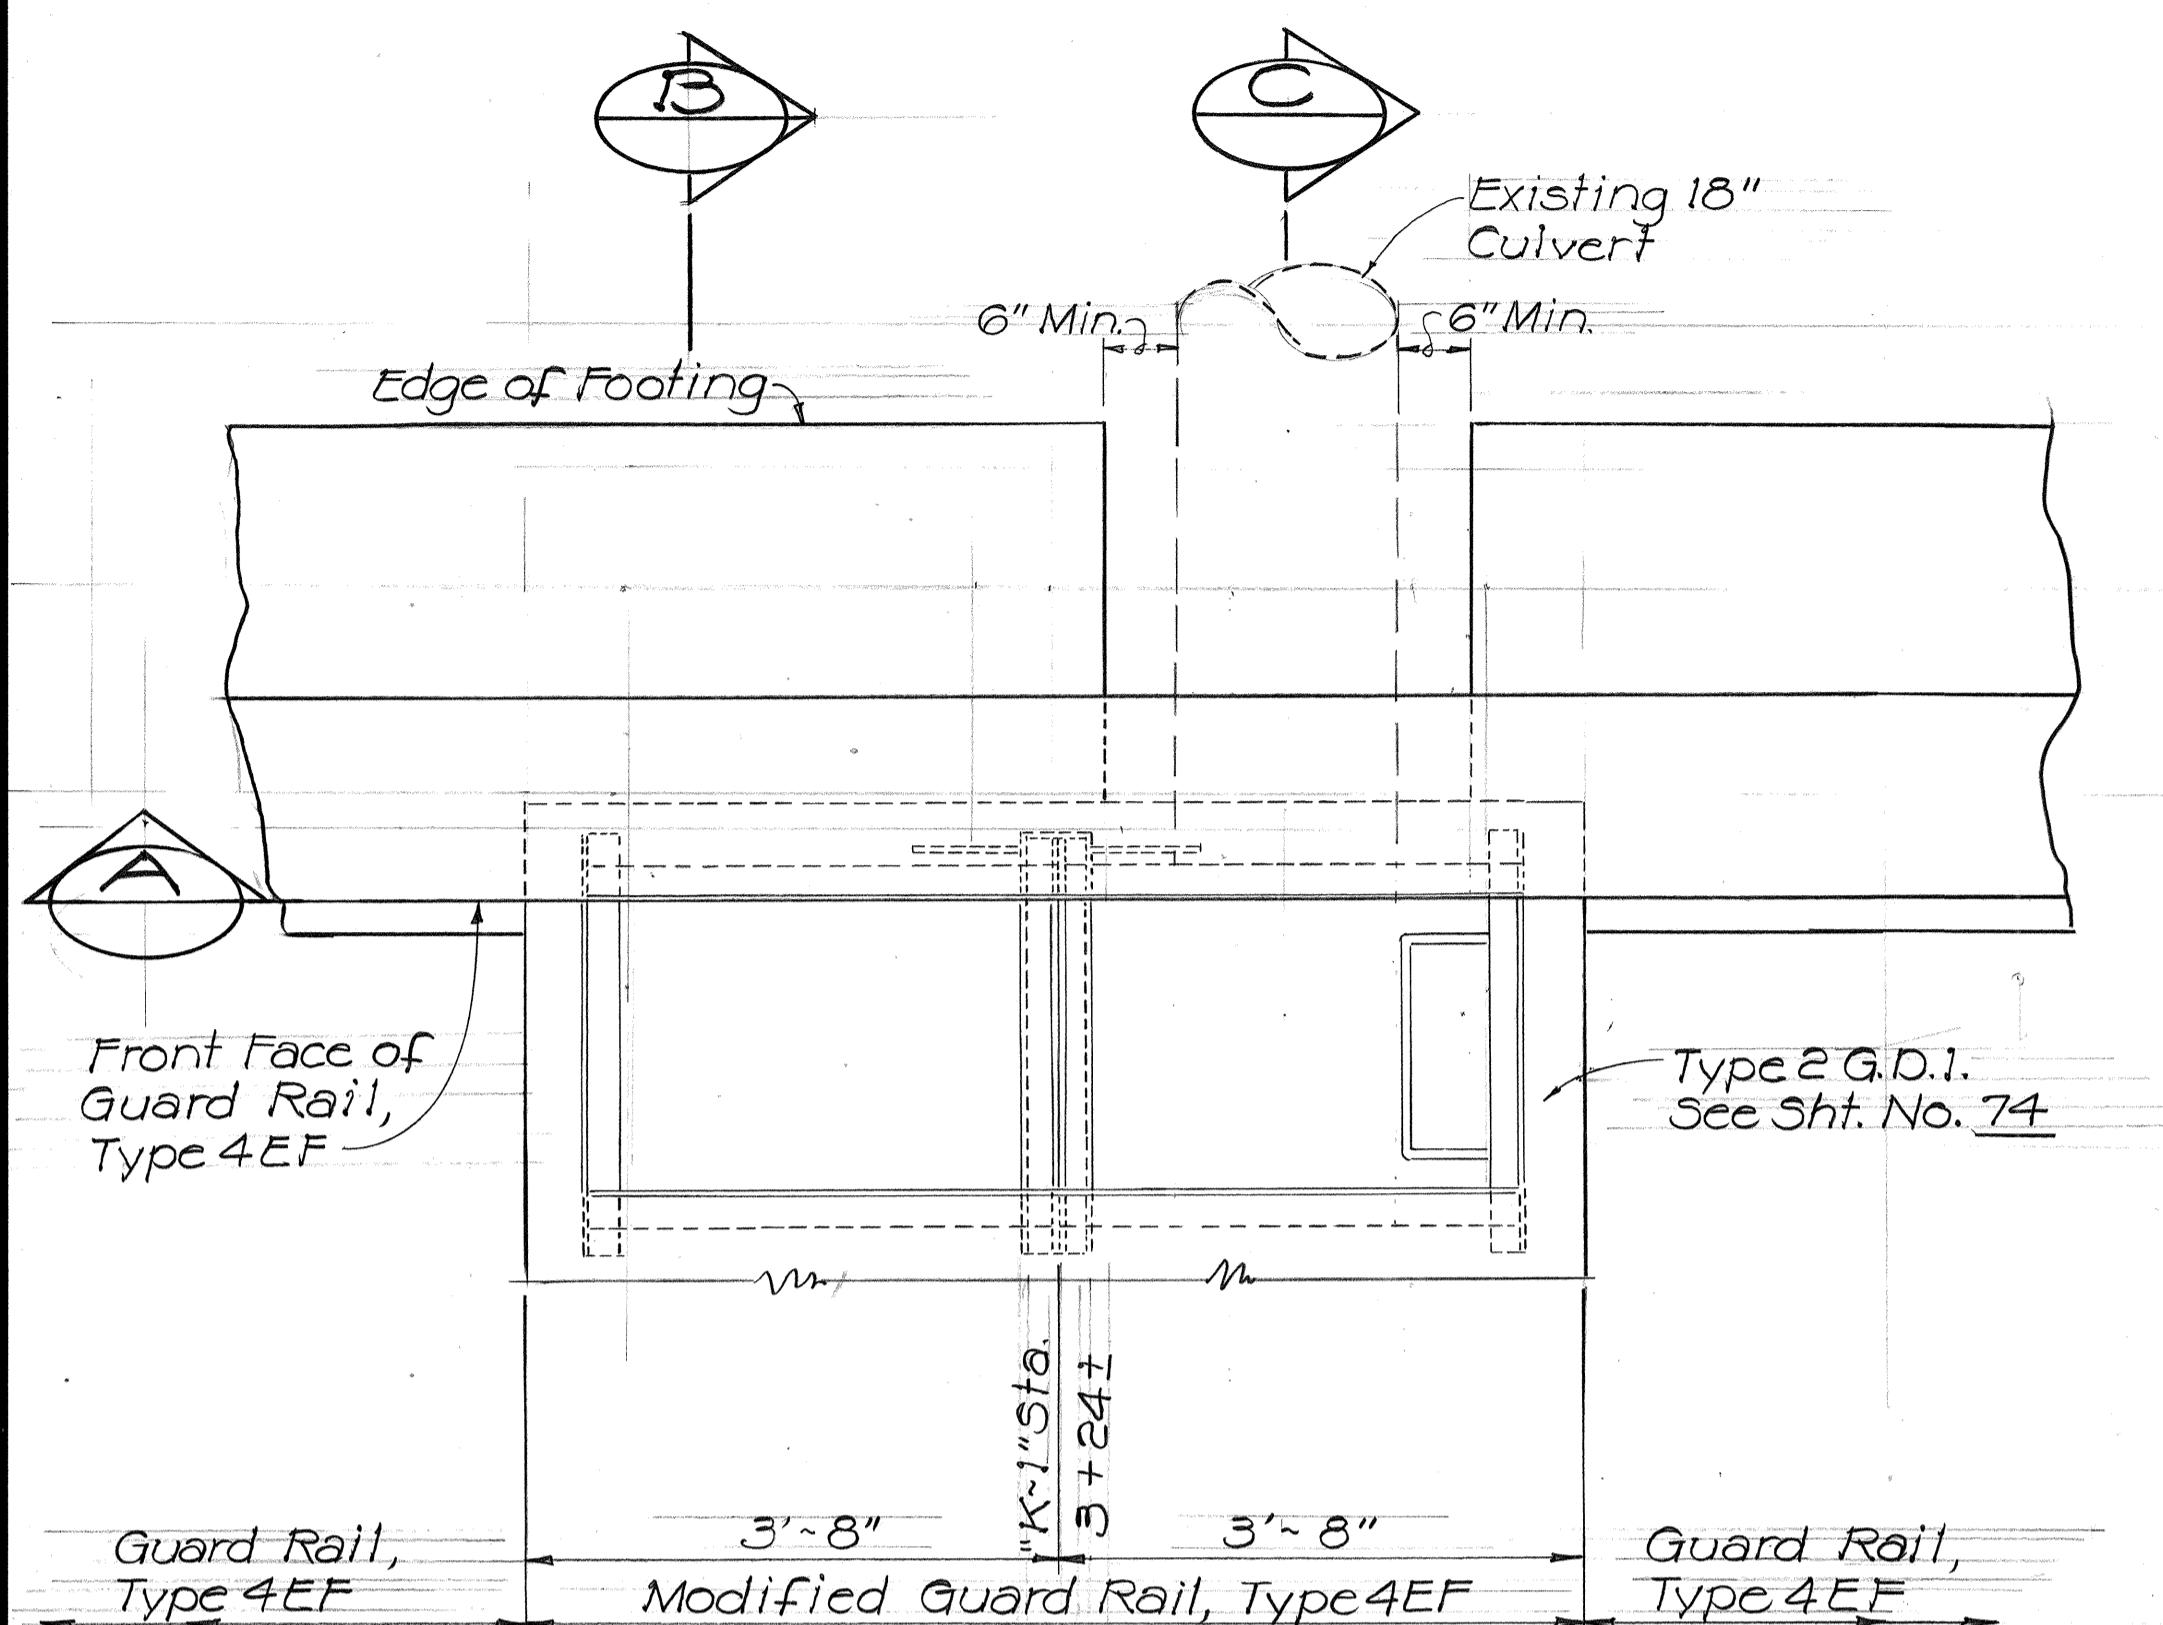


PLAN

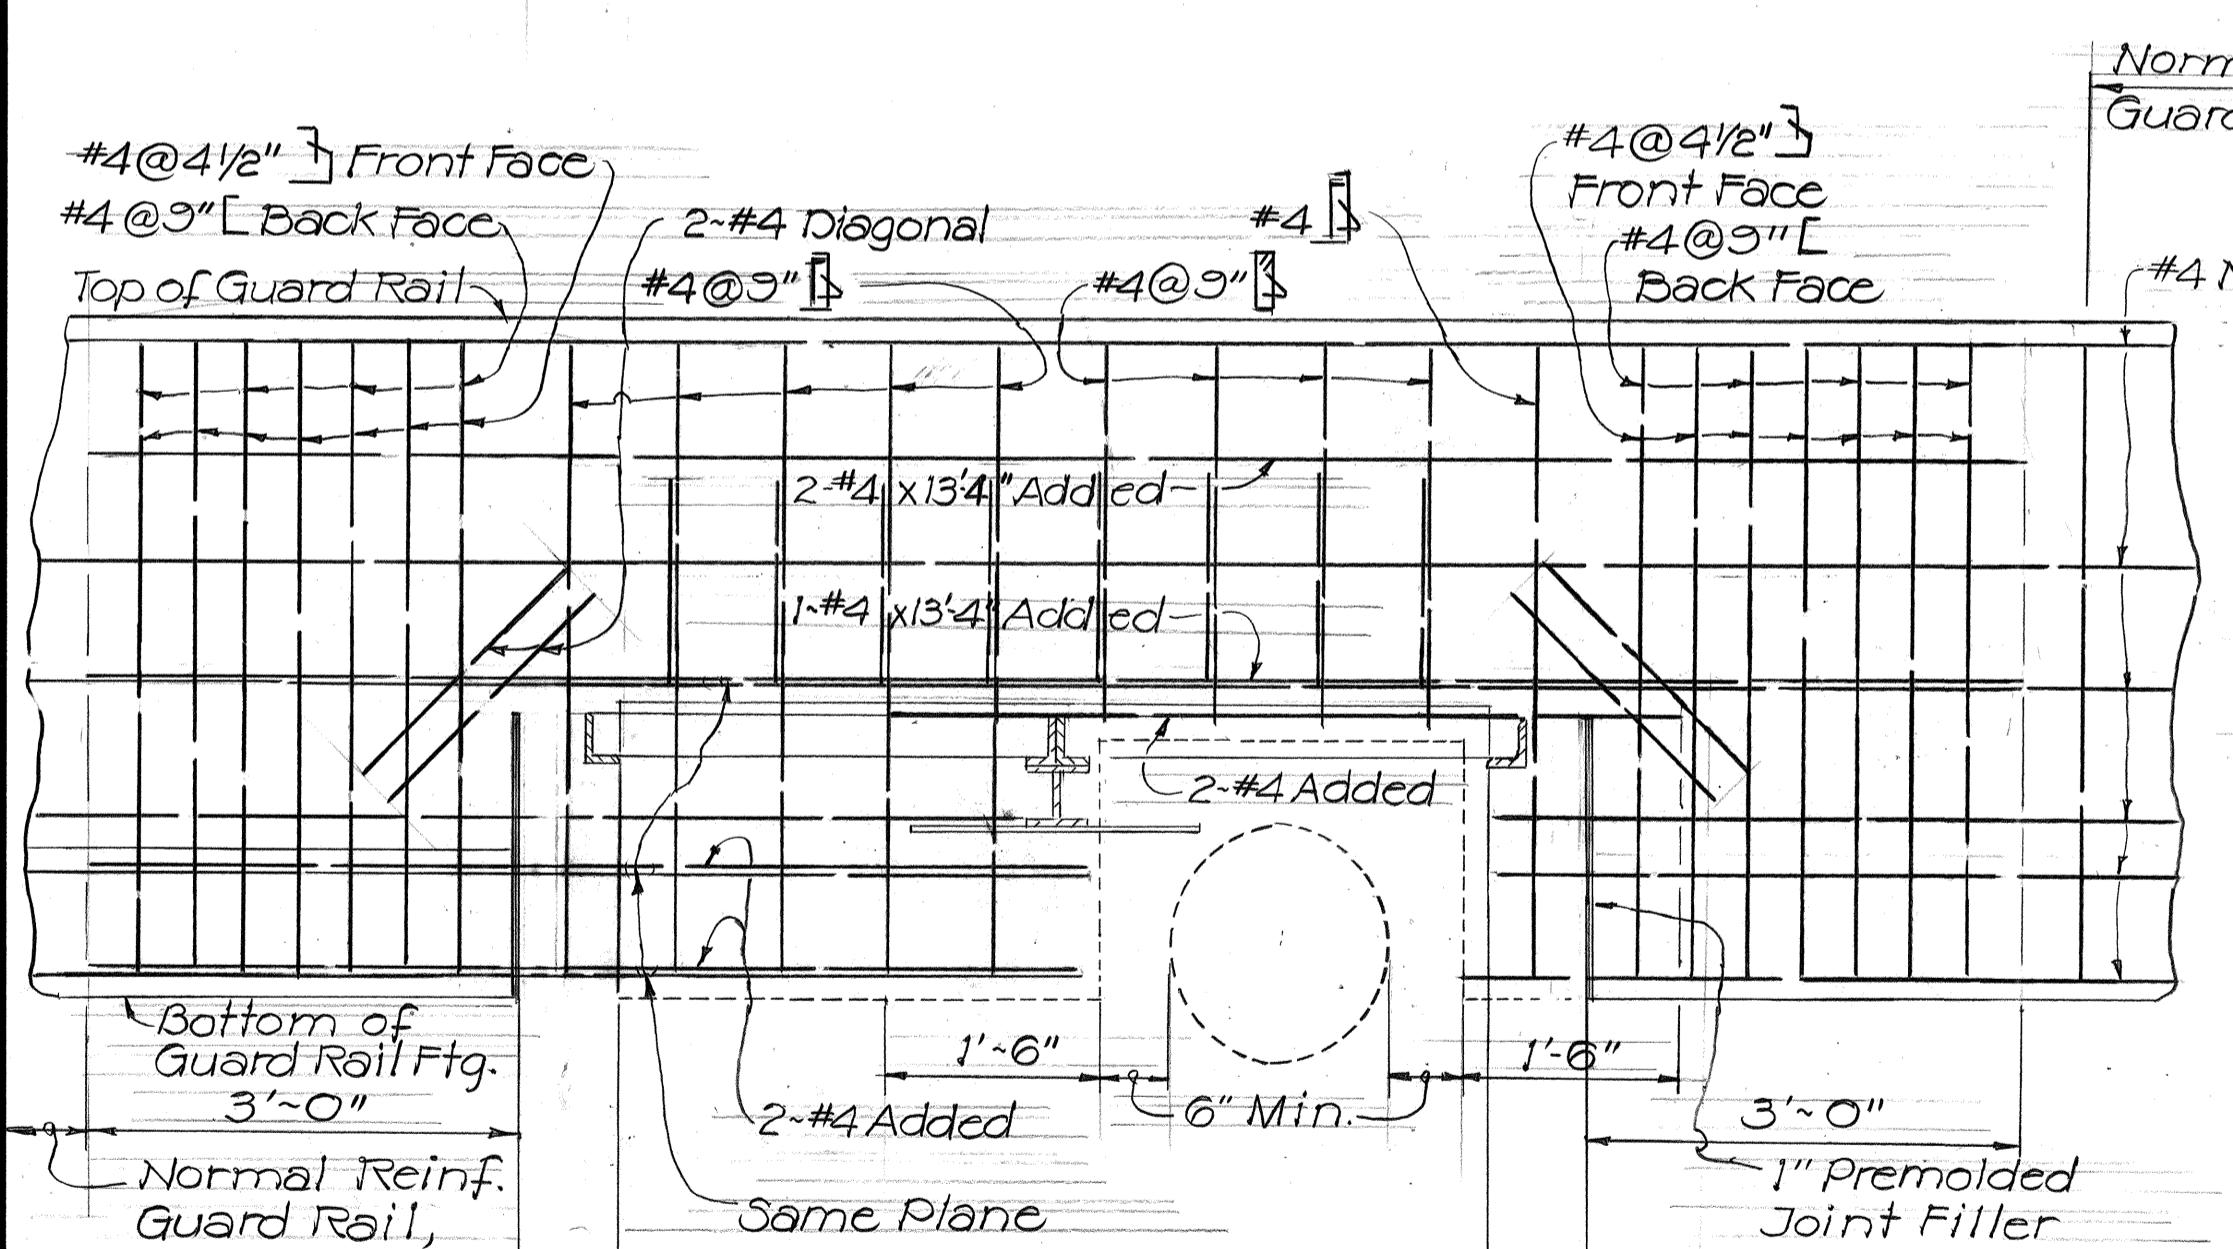


SECTION A


MODIFIED GUARD RAIL, TYPE 4EF "K-1" STA. 3 + 24 ± LT.

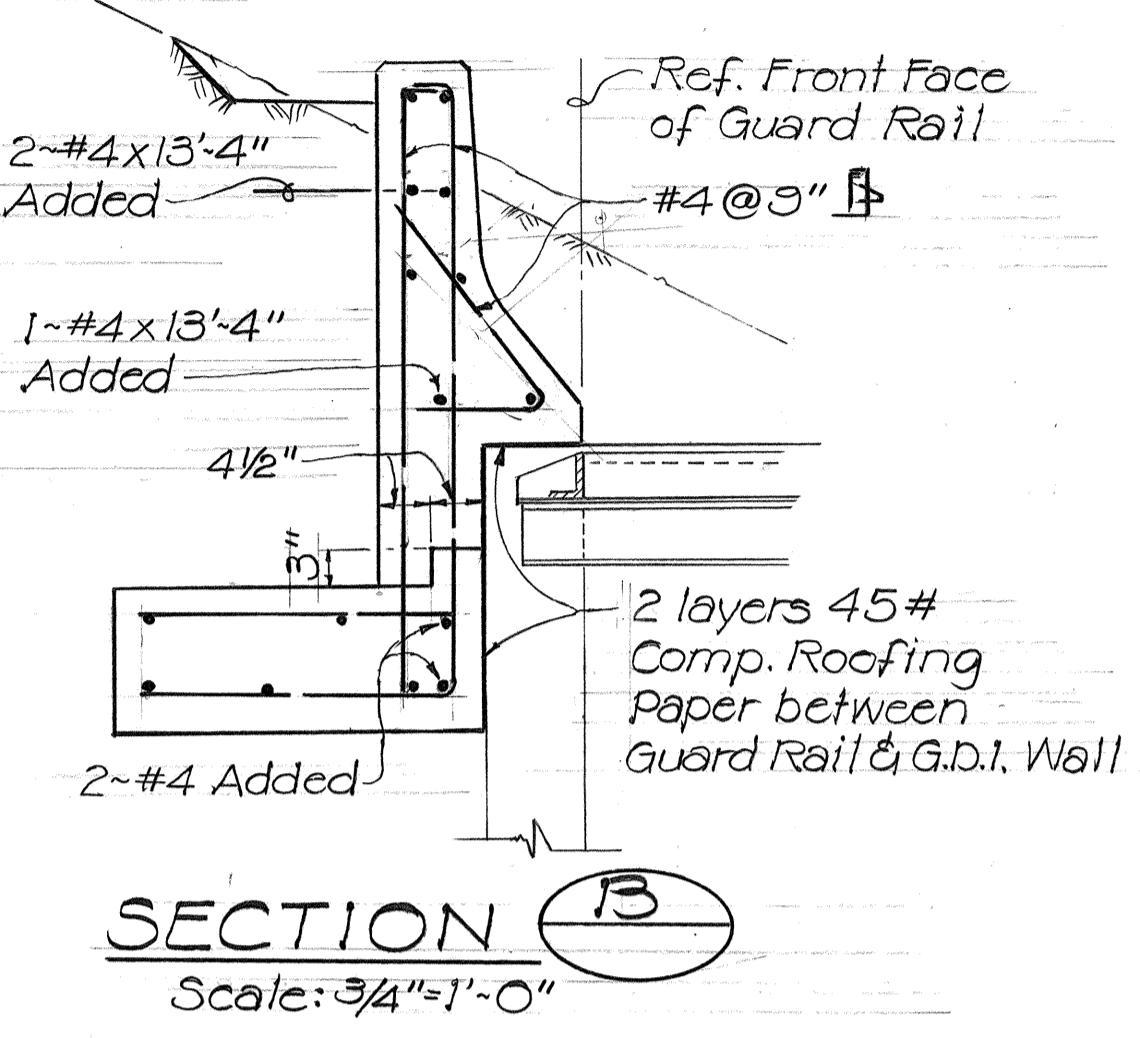



SECTION B

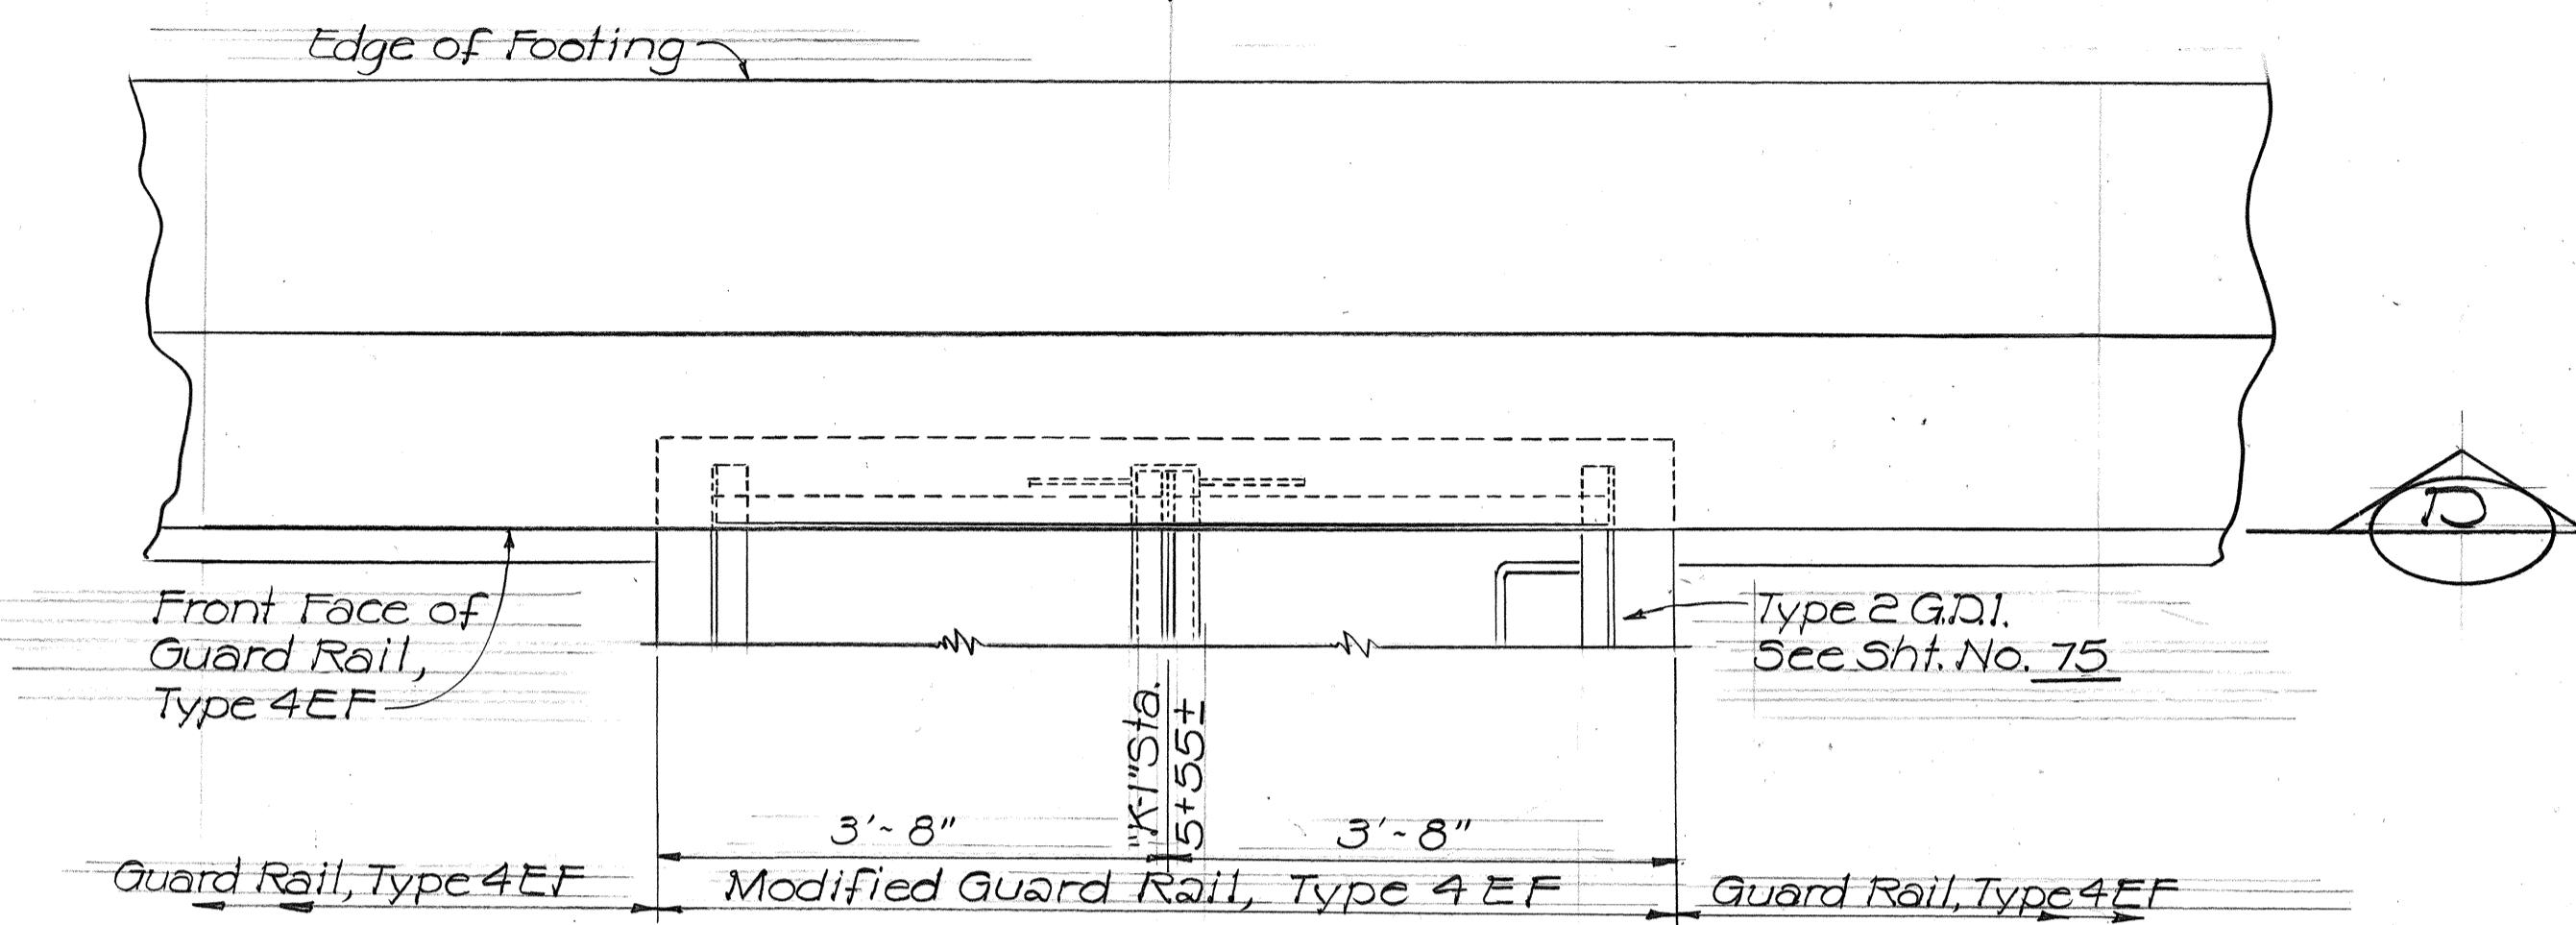









PLAN

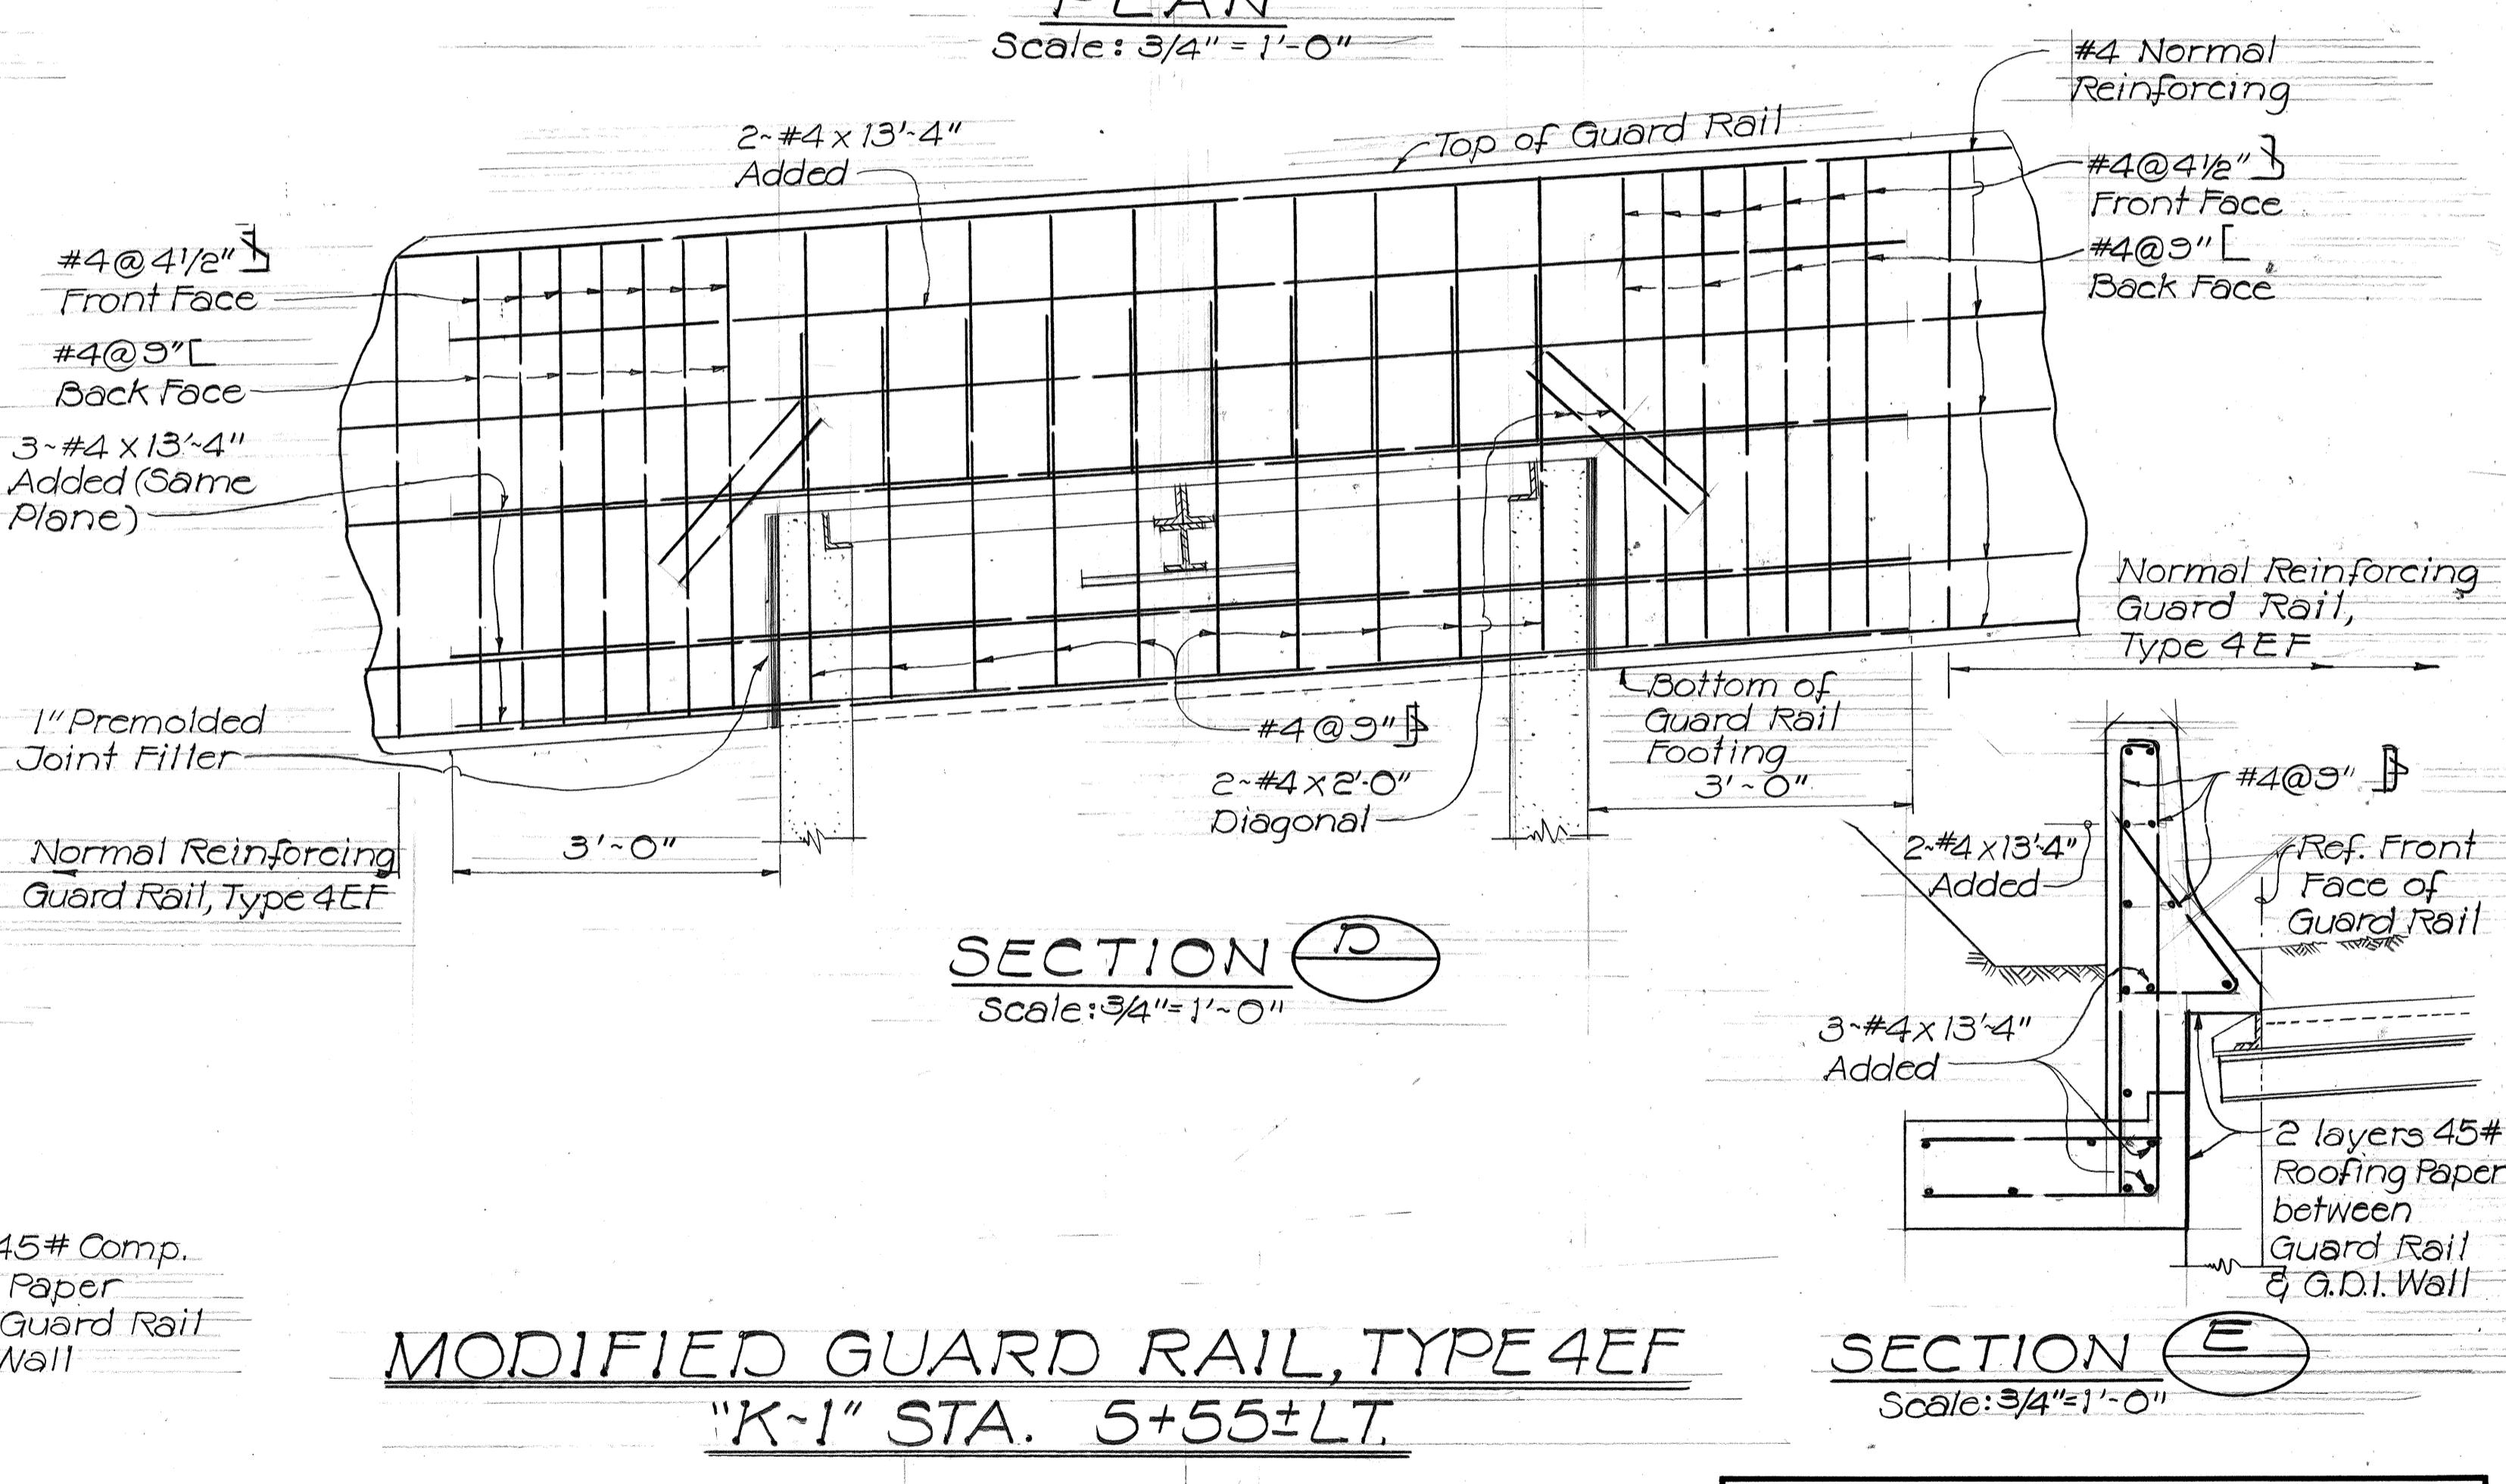

MODIFIED GUARD RAIL, TYPE 4EF
"K-1" STA. 5+55±LT.

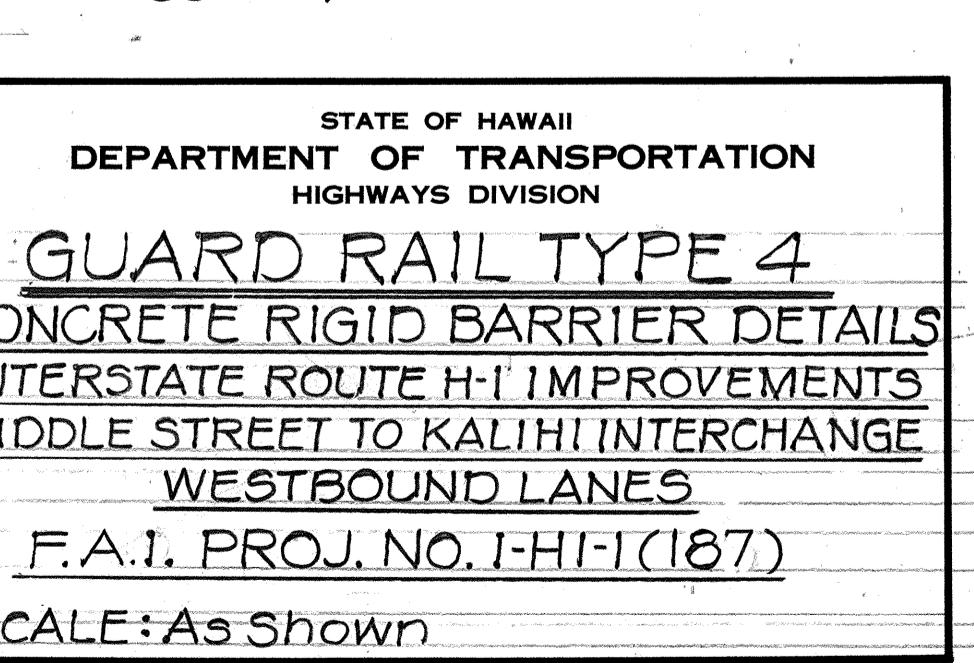
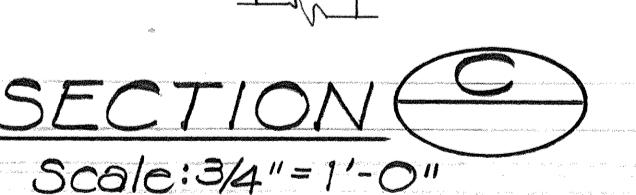


FED. ROAD DIST. NO.	STATE	FED. AID PROJ. NO.	FISCAL YEAR	SHEET NO.	TOTAL SHEETS
HAWAII	HAW.	I-HI-I(187)	1984	26	197

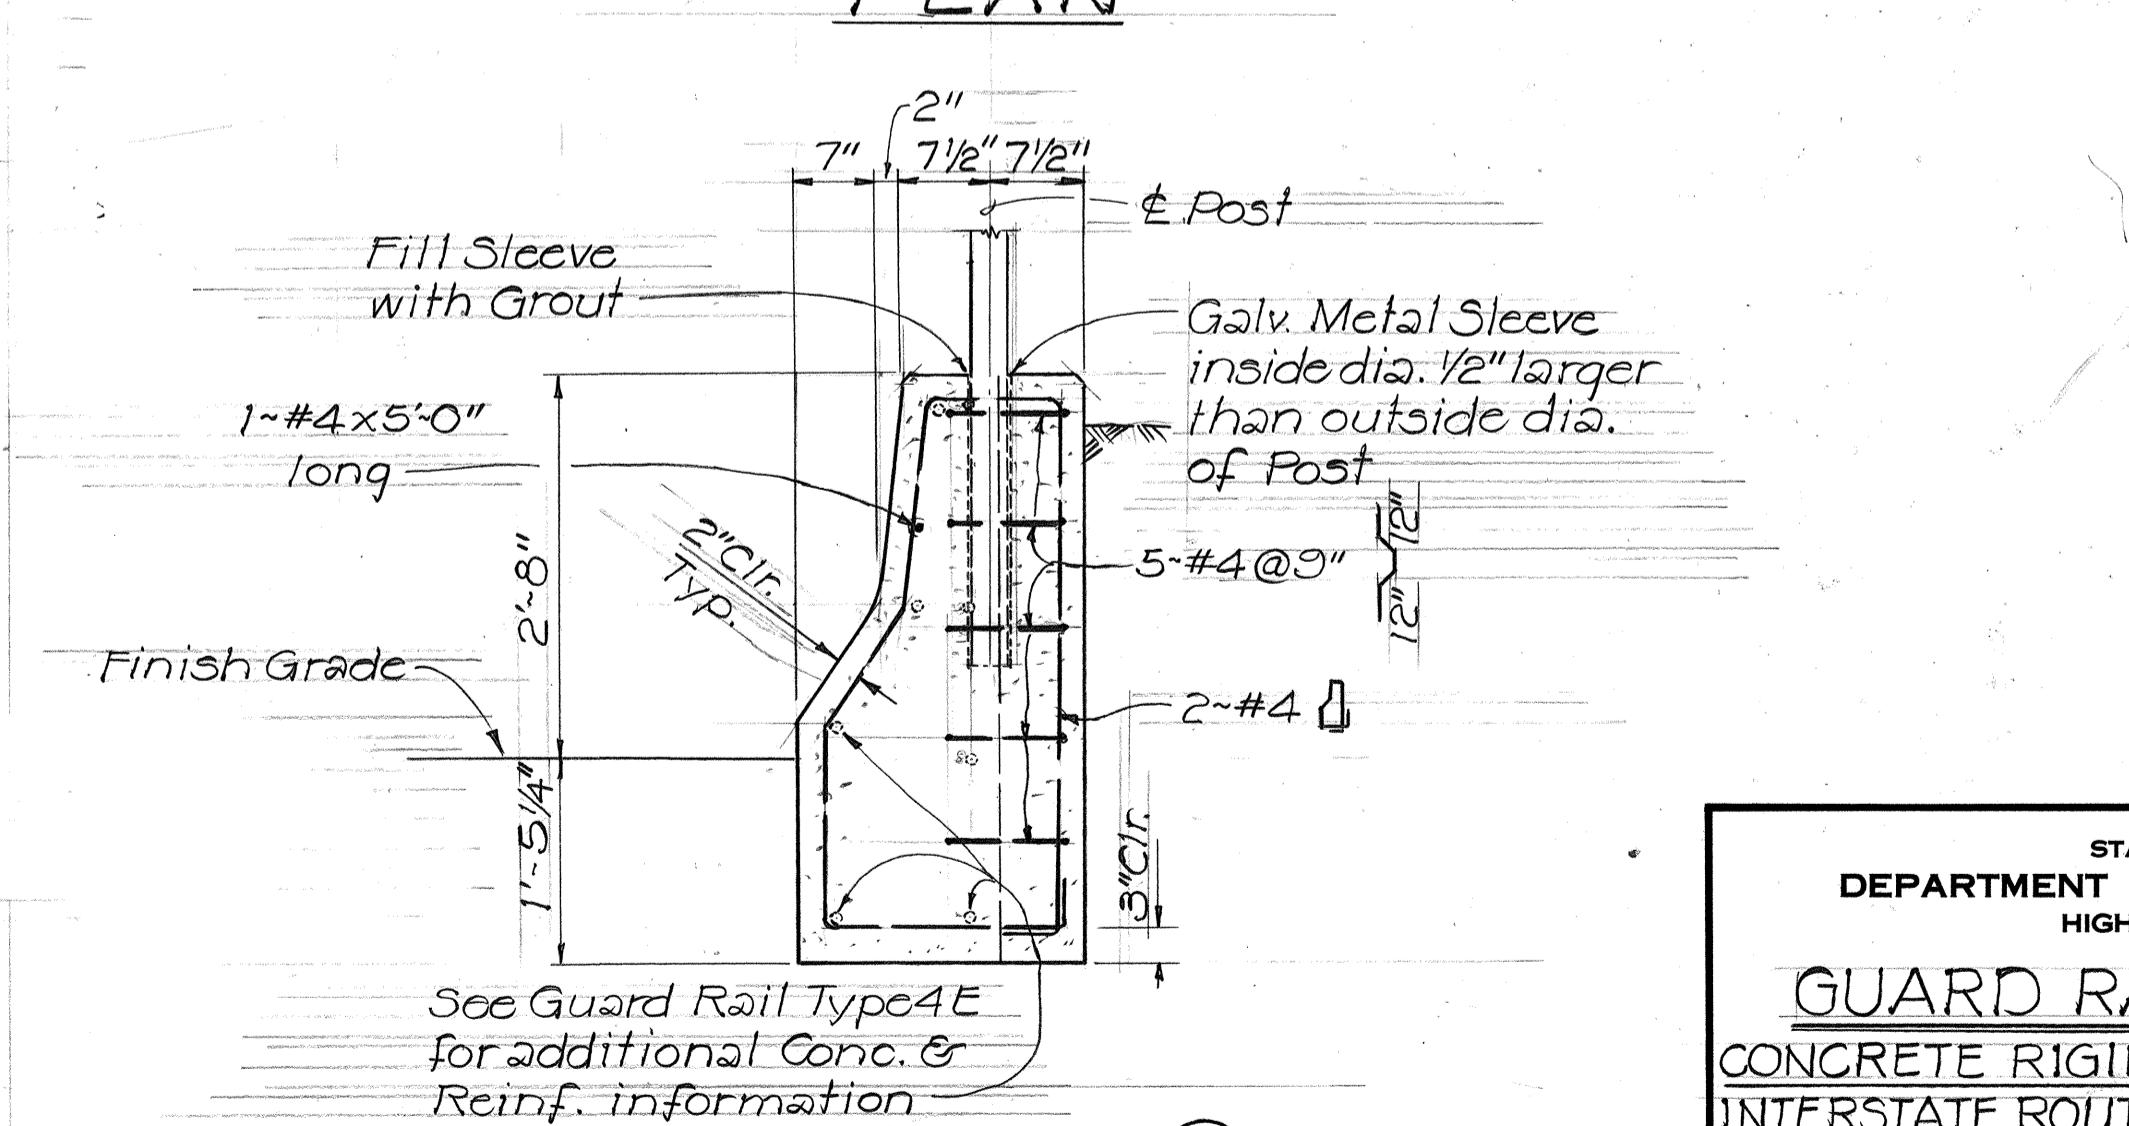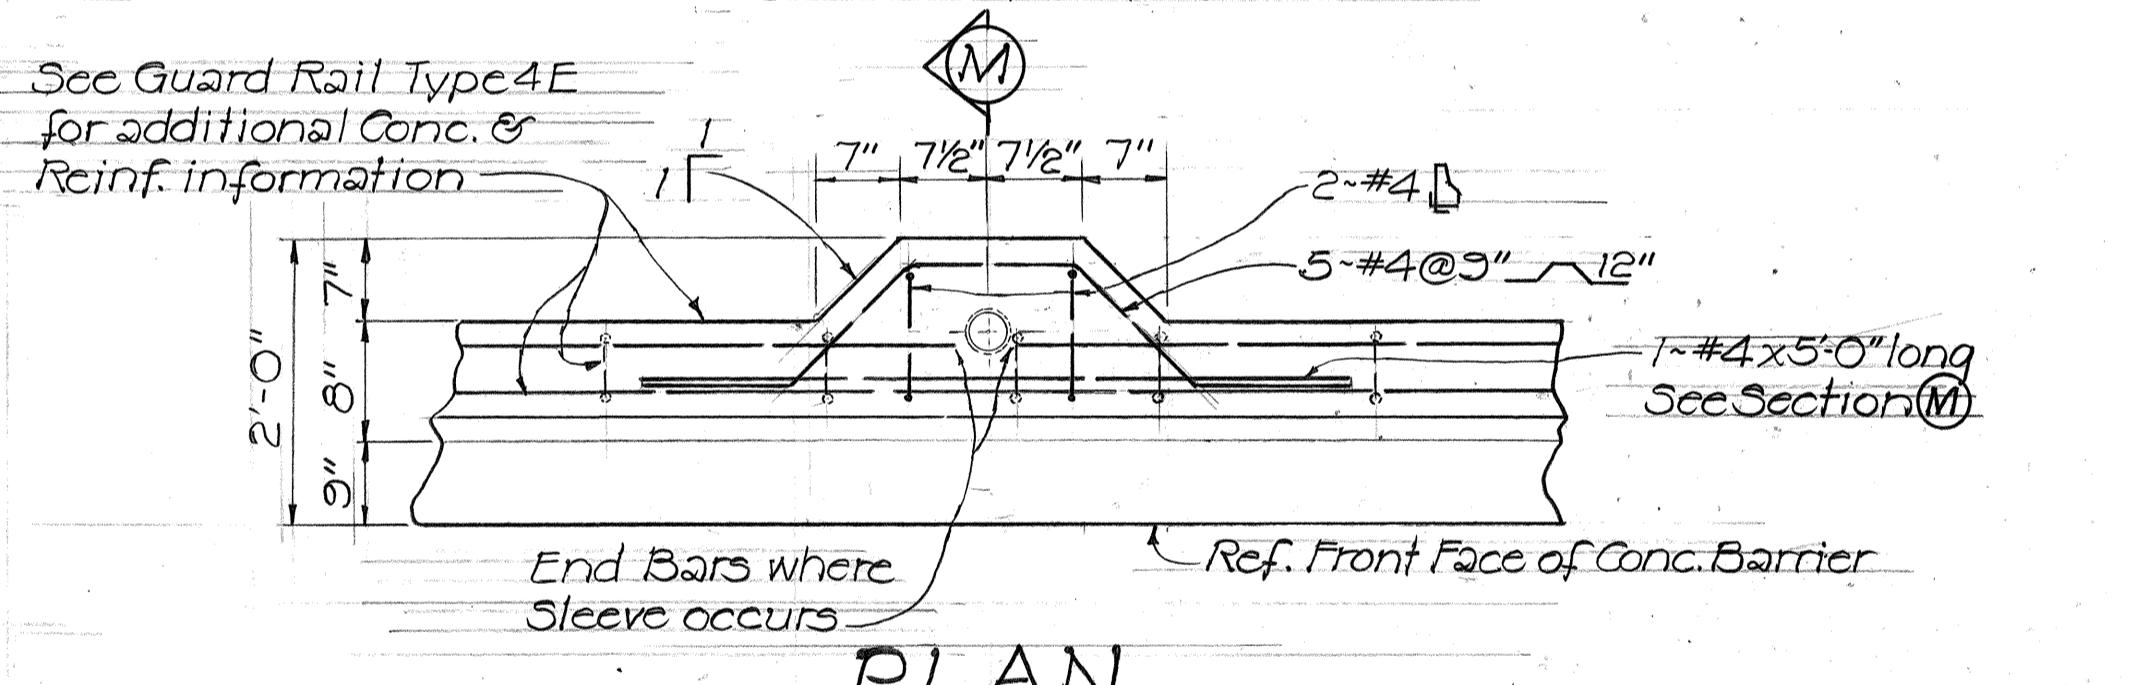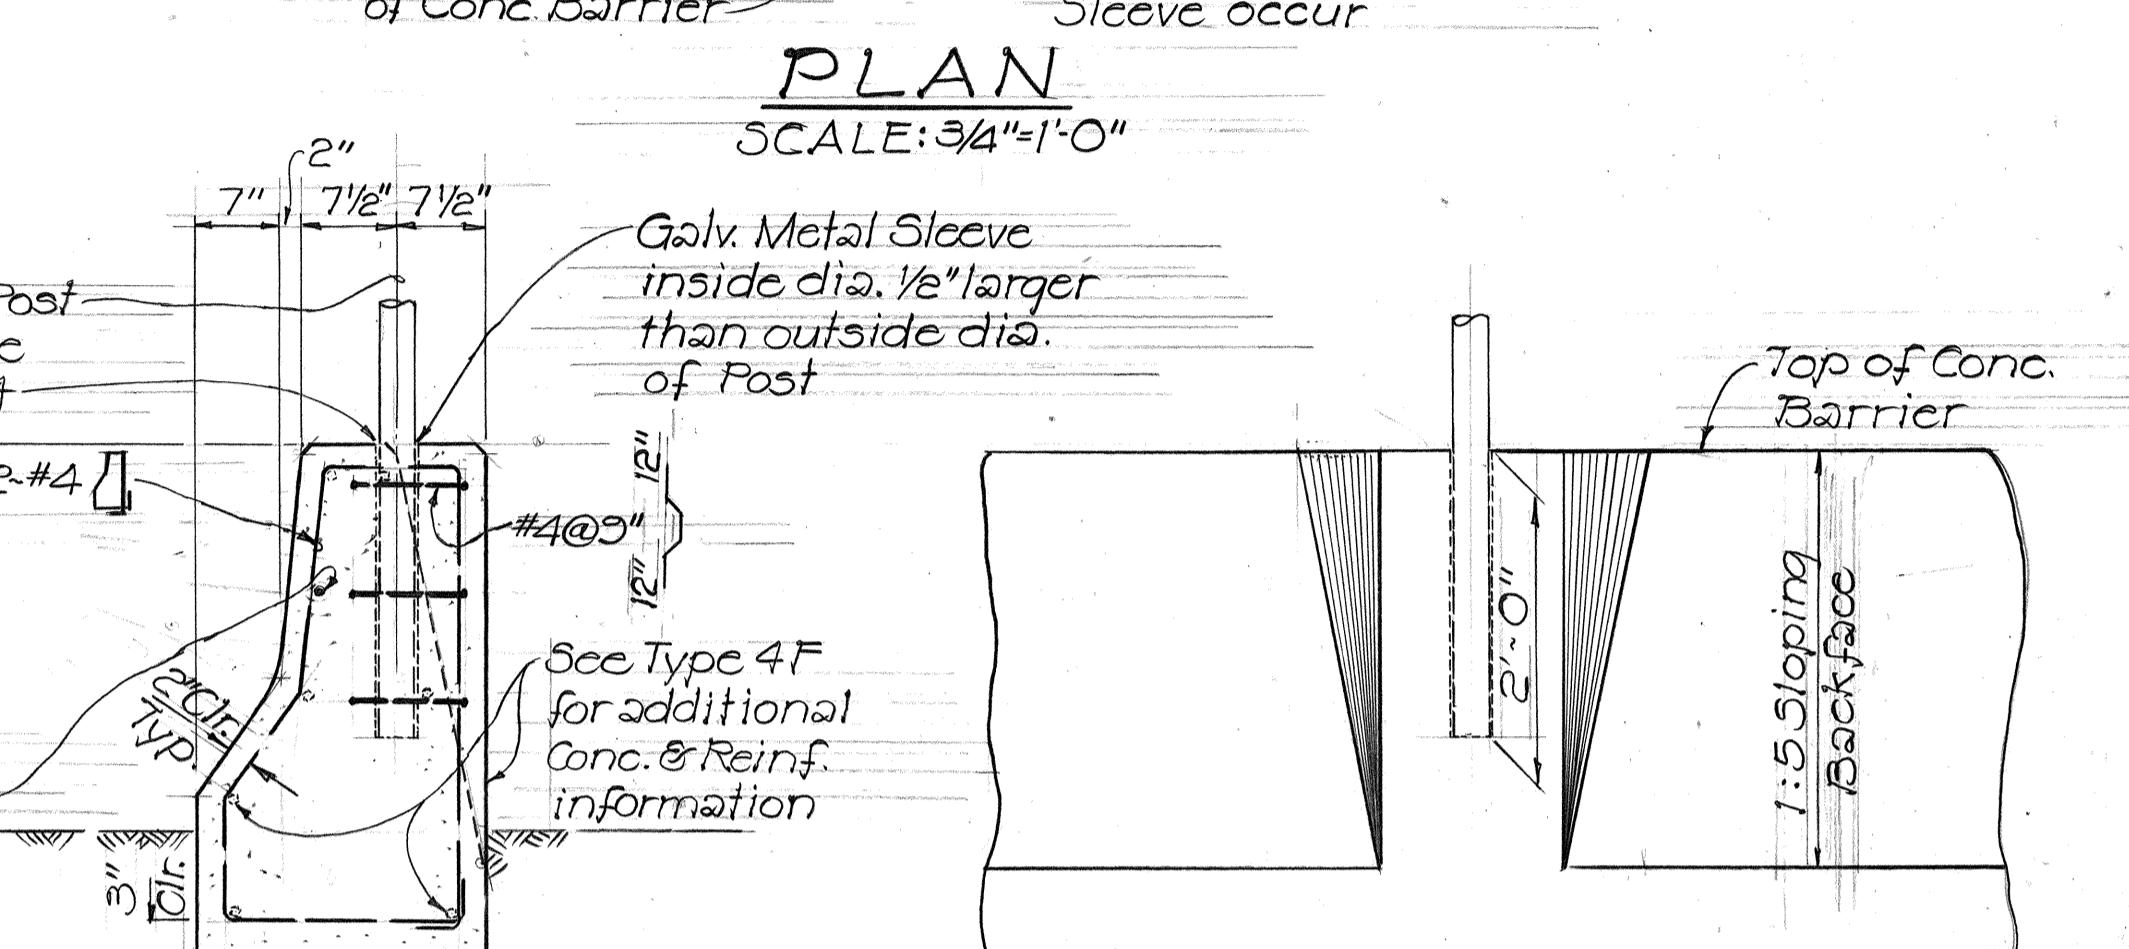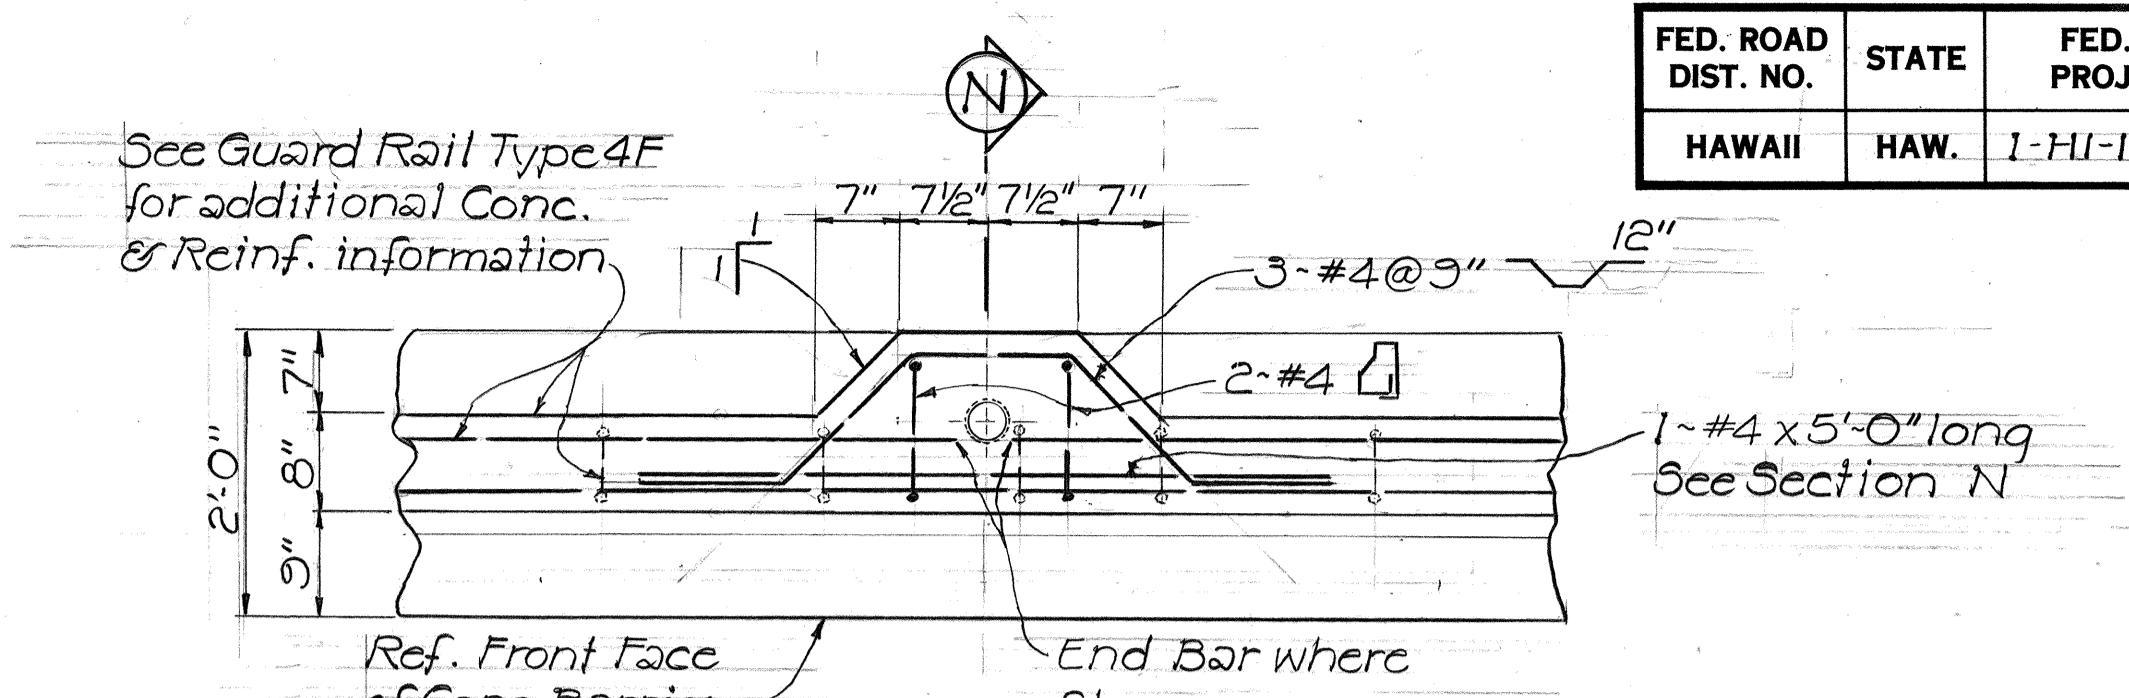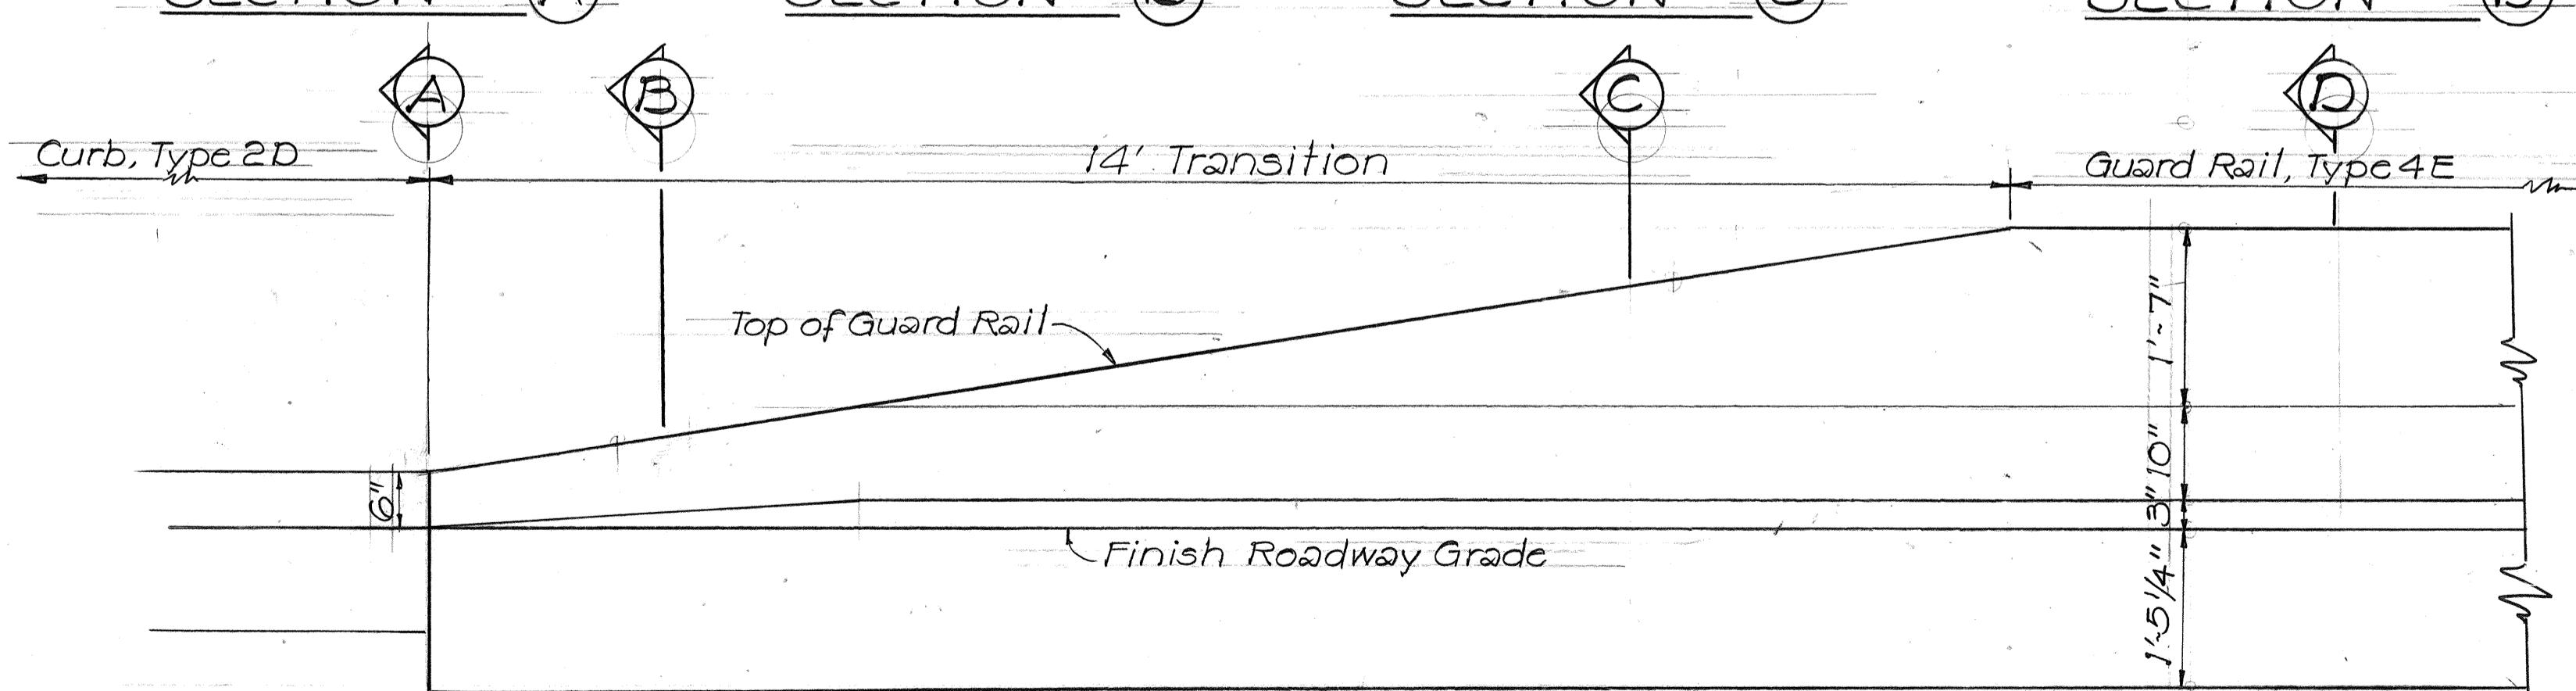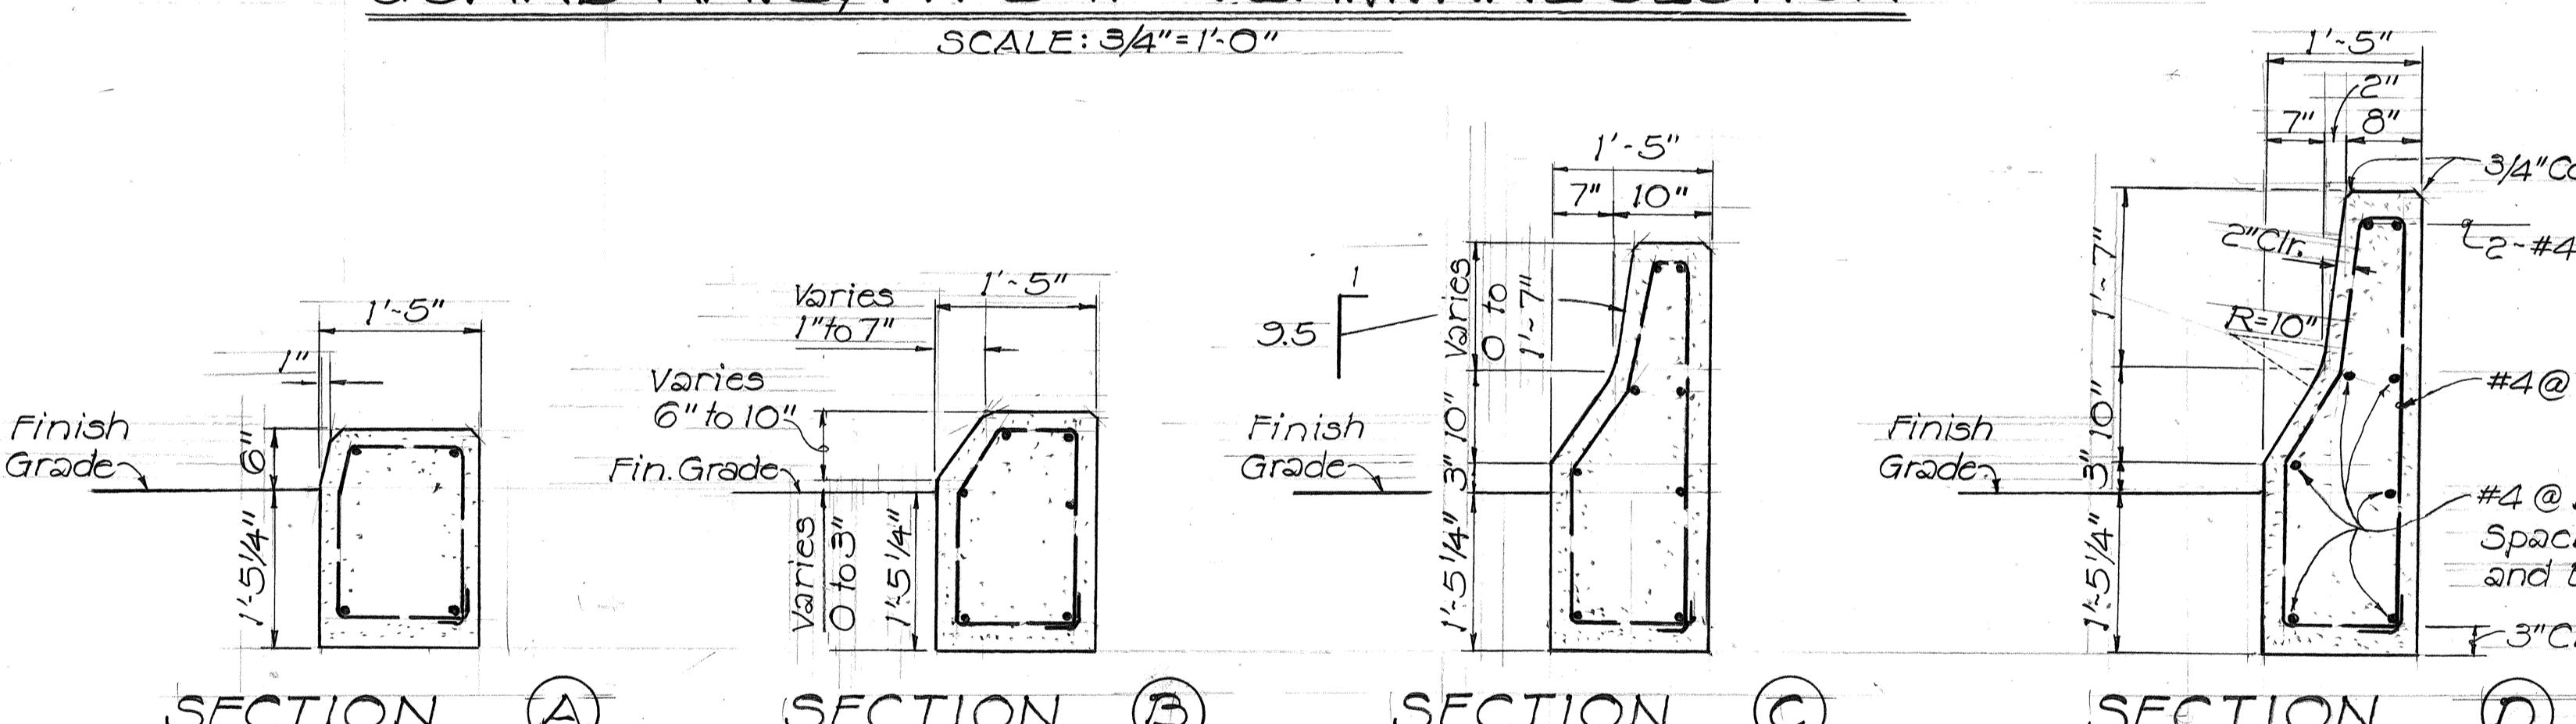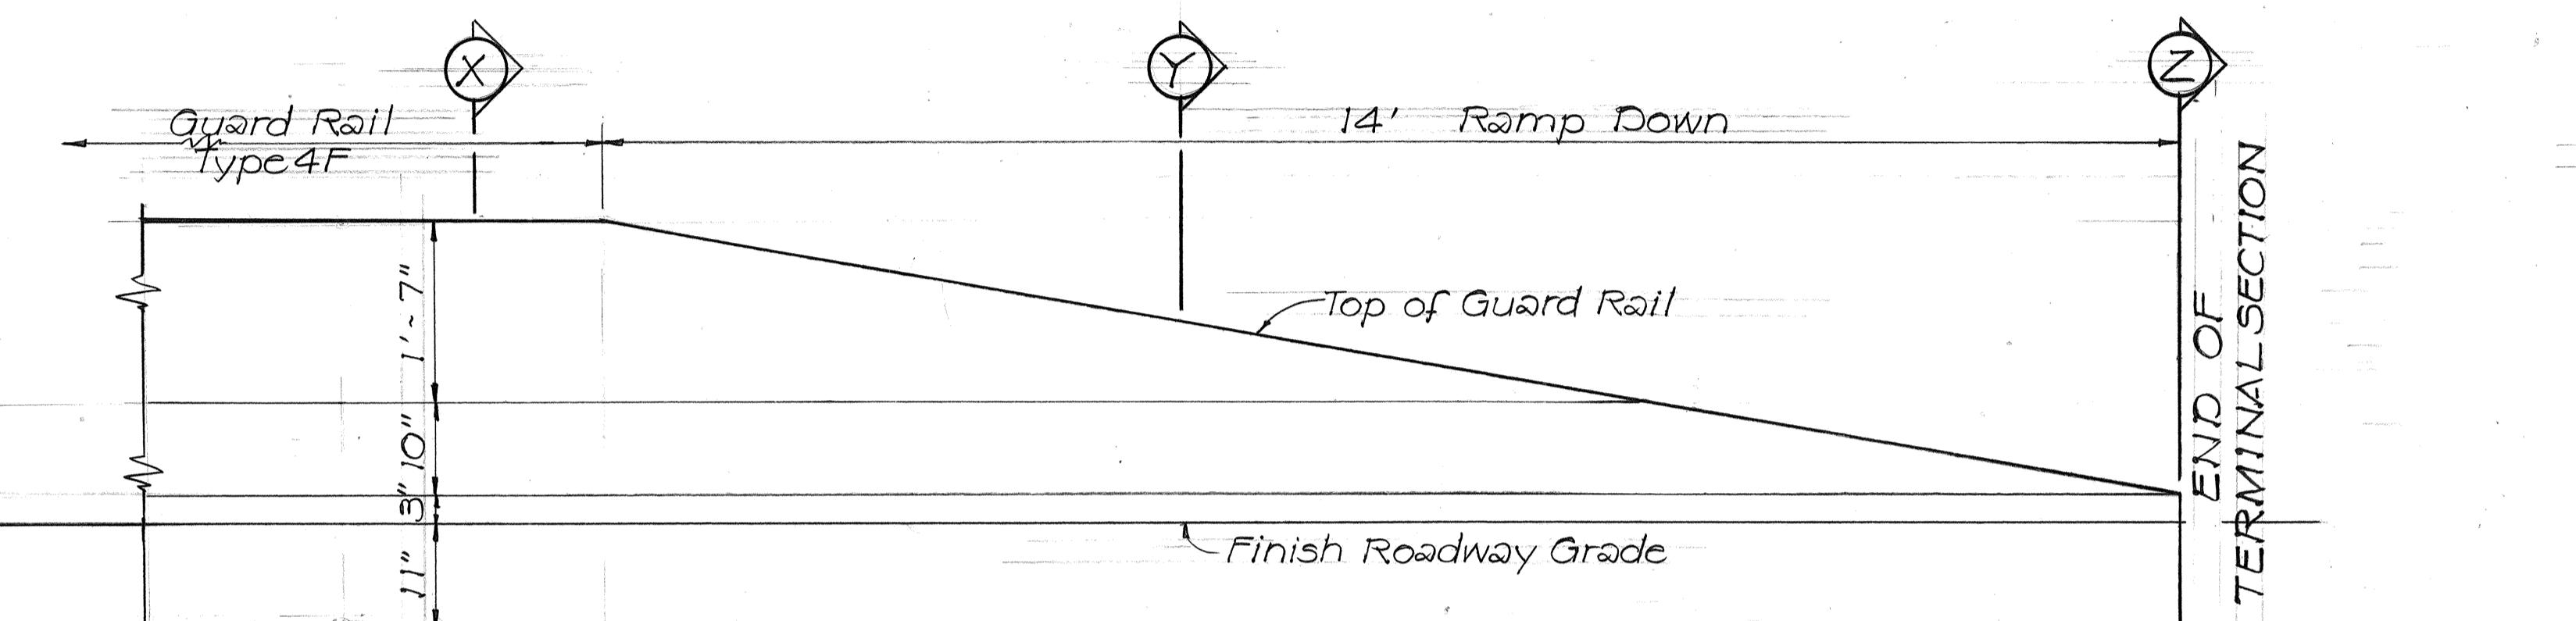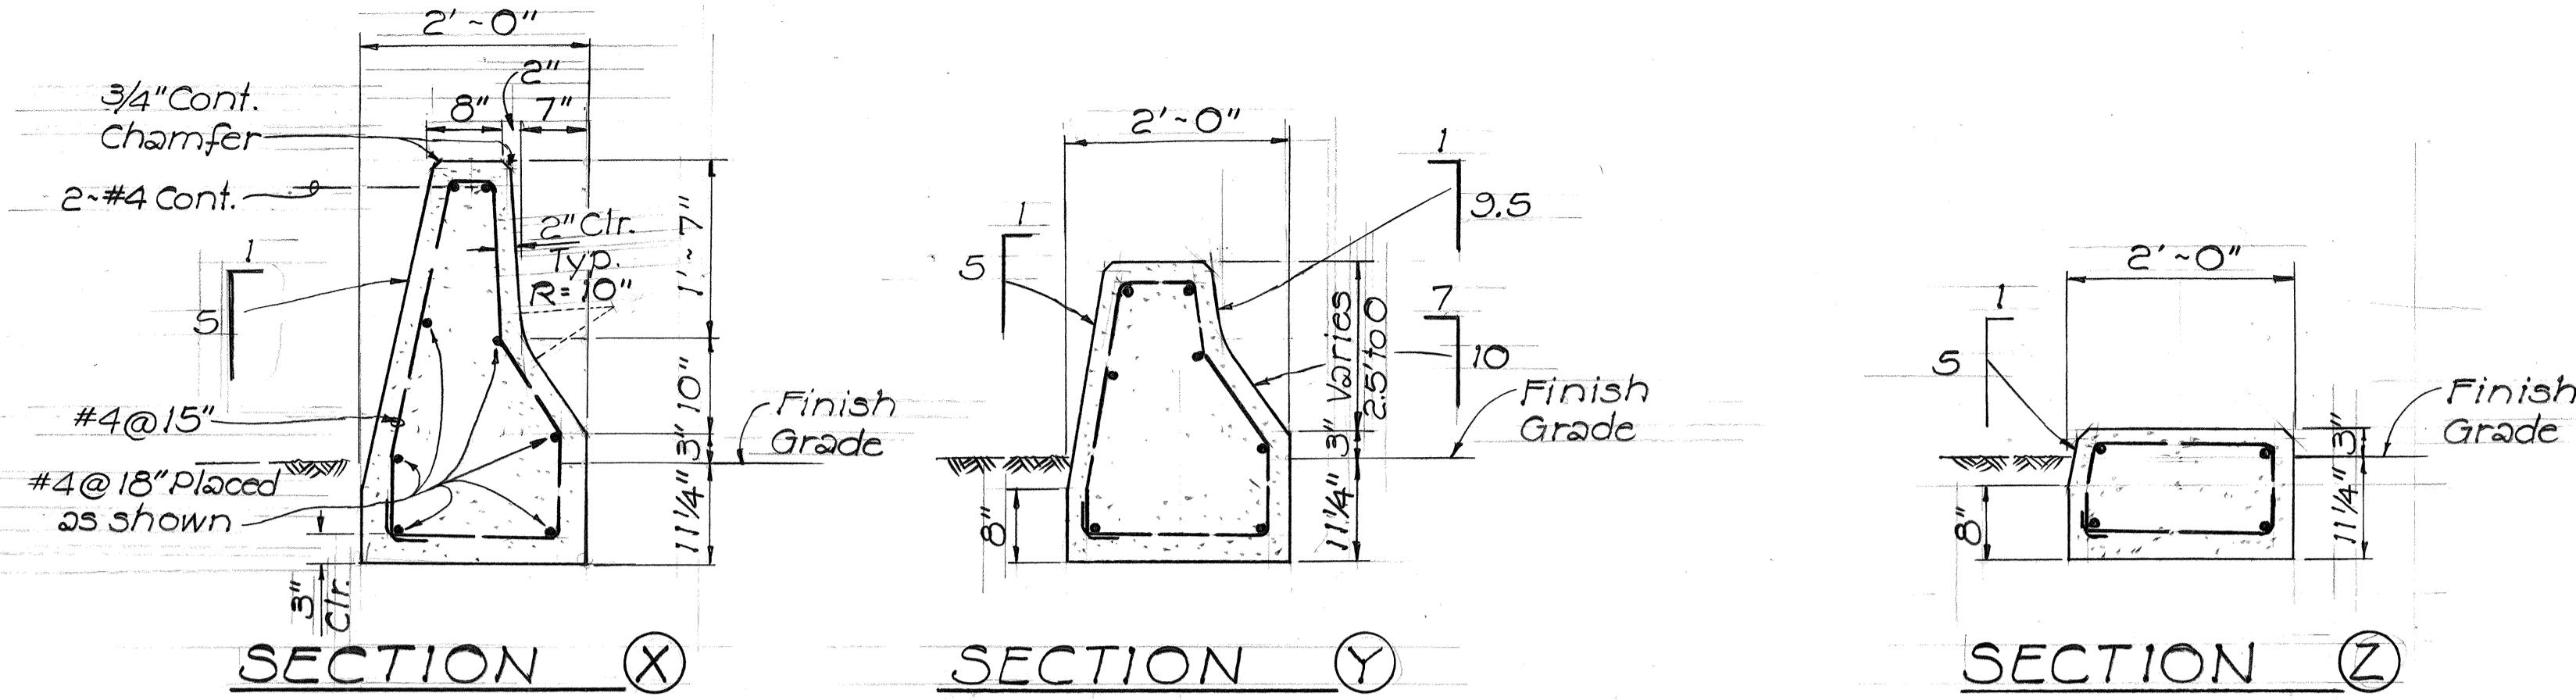


STATE OF HAWAII
DEPARTMENT OF TRANSPORTATION
HIGHWAYS DIVISION
GUARD RAIL TYPE 4
CONCRETE RIGID BARRIER DETAILS
INTERSTATE ROUTE I-I IMPROVEMENTS
MIDDLE STREET TO KALIHI INTERCHANGE
WESTBOUND LANES
F.A.I. PROJ. NO. I-HI-I(187)
SCALE: As Shown
SHEET NO. 7 OF 10 SHEETS

FED. ROAD DIST. NO.	STATE	FED. AID PROJ. NO.	FISCAL YEAR	SHEET NO.	TOTAL SHEETS
HAWAII	HAW.	I-HI-1(187)	1984	27	197

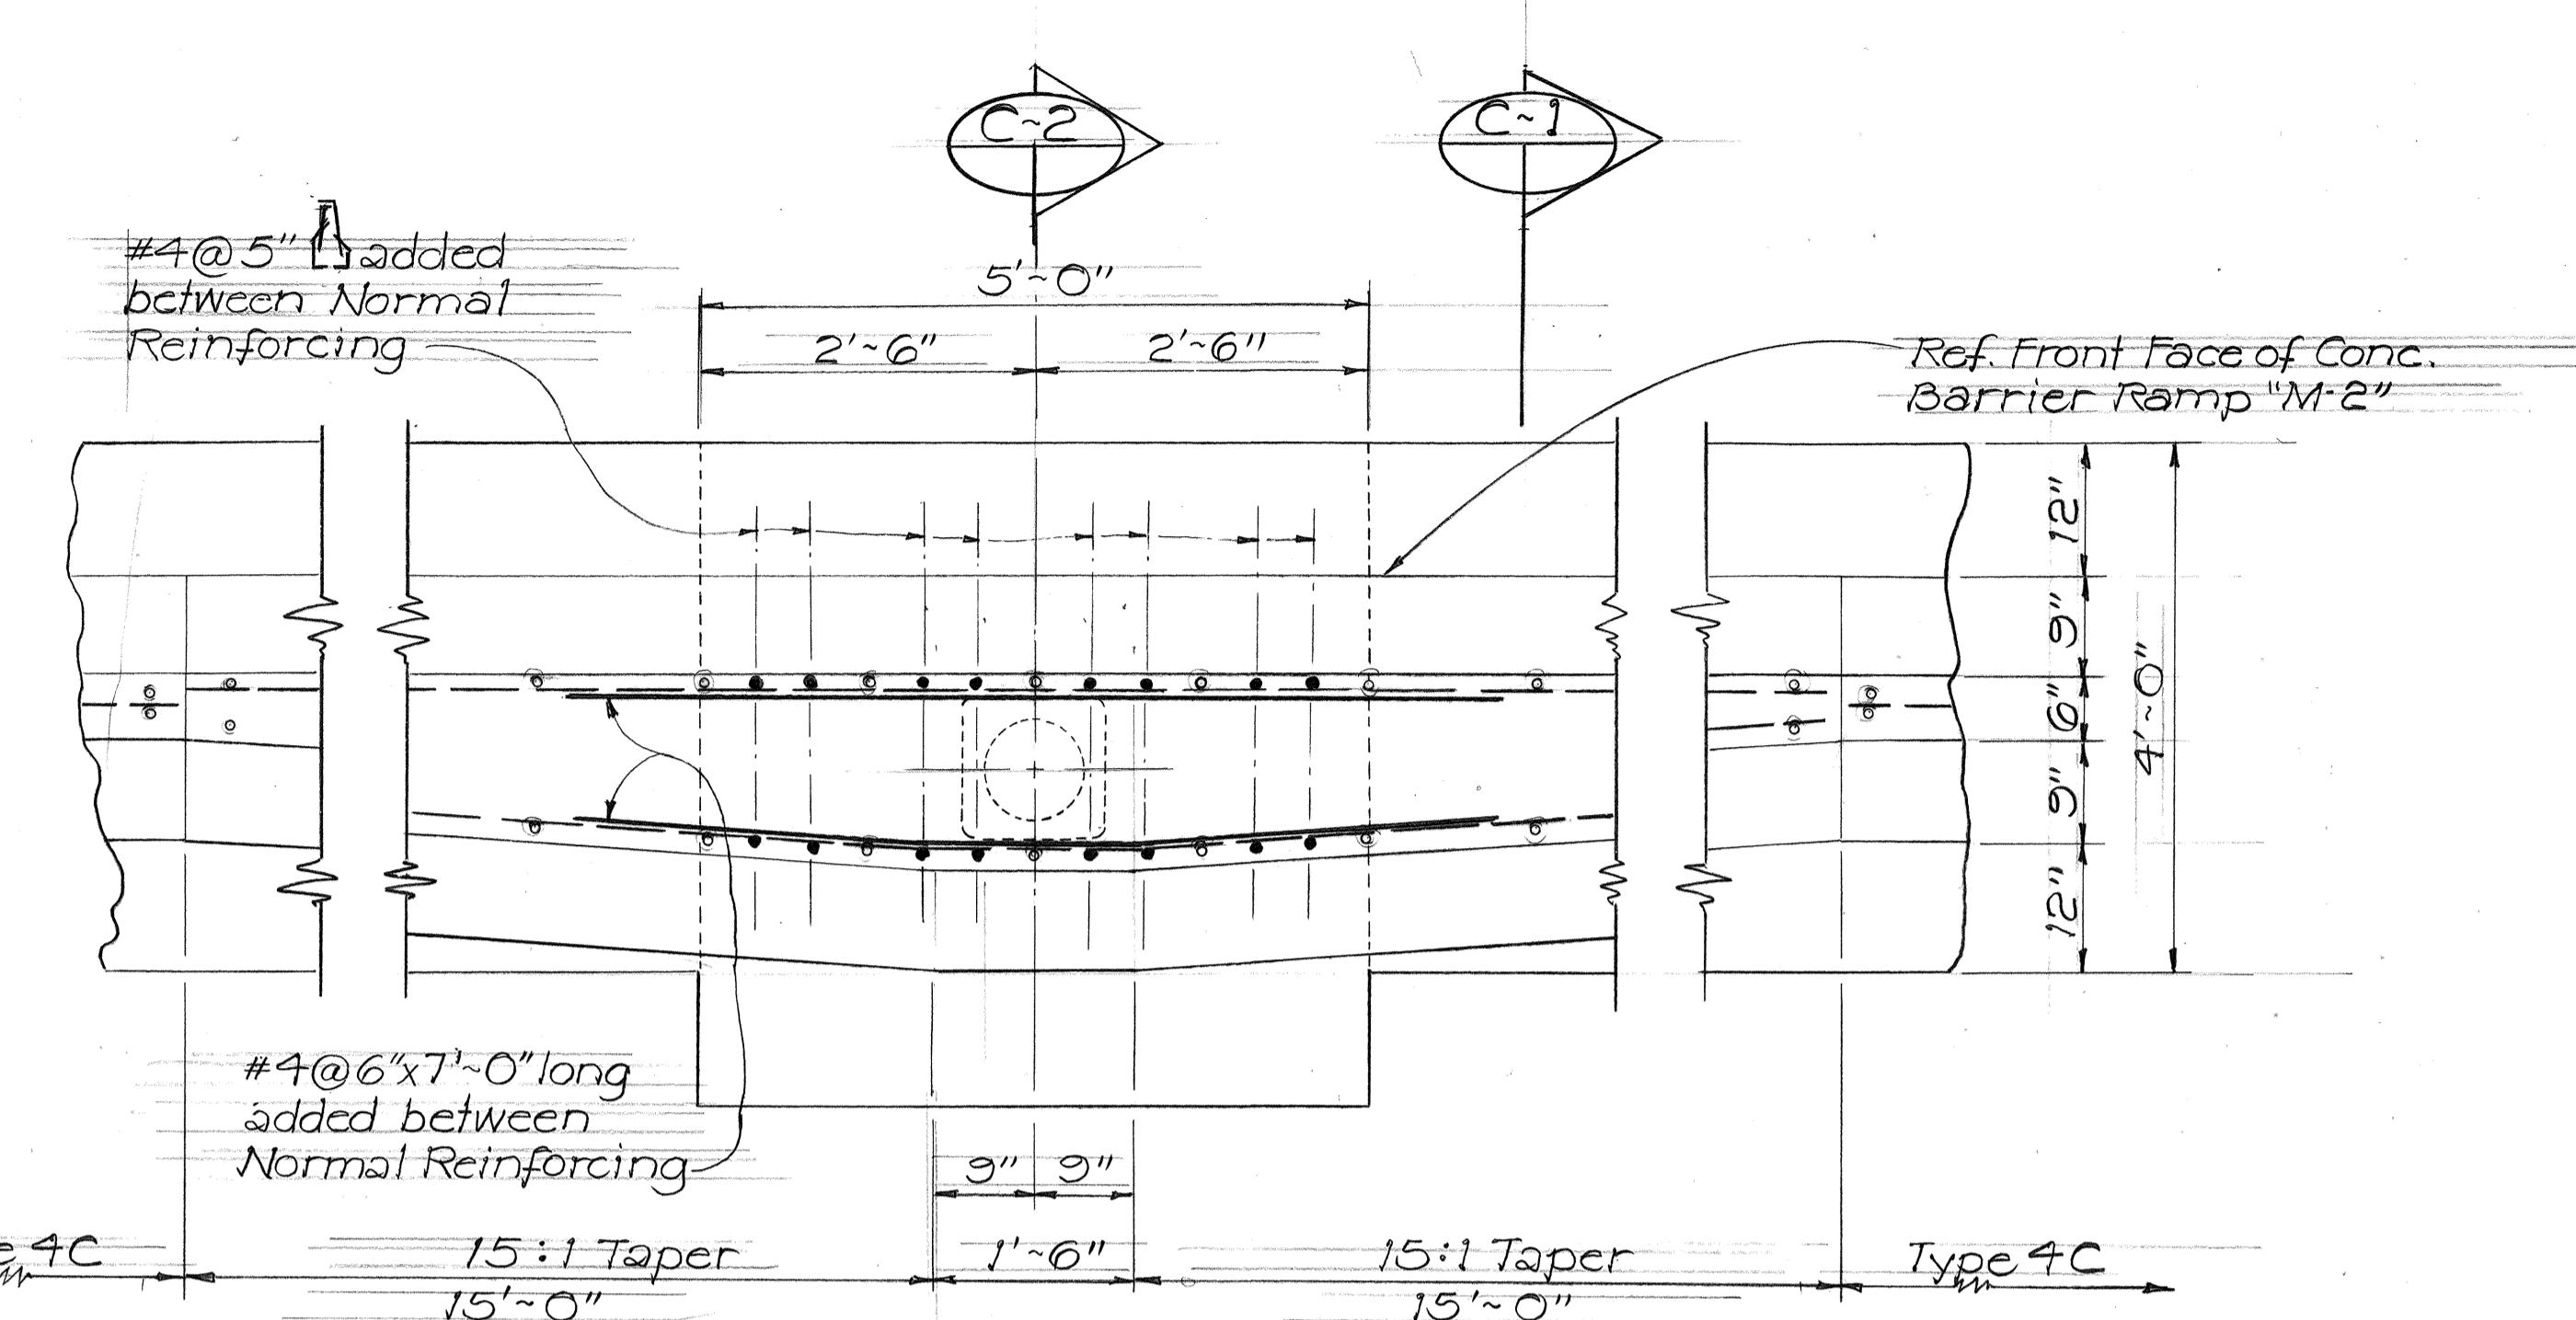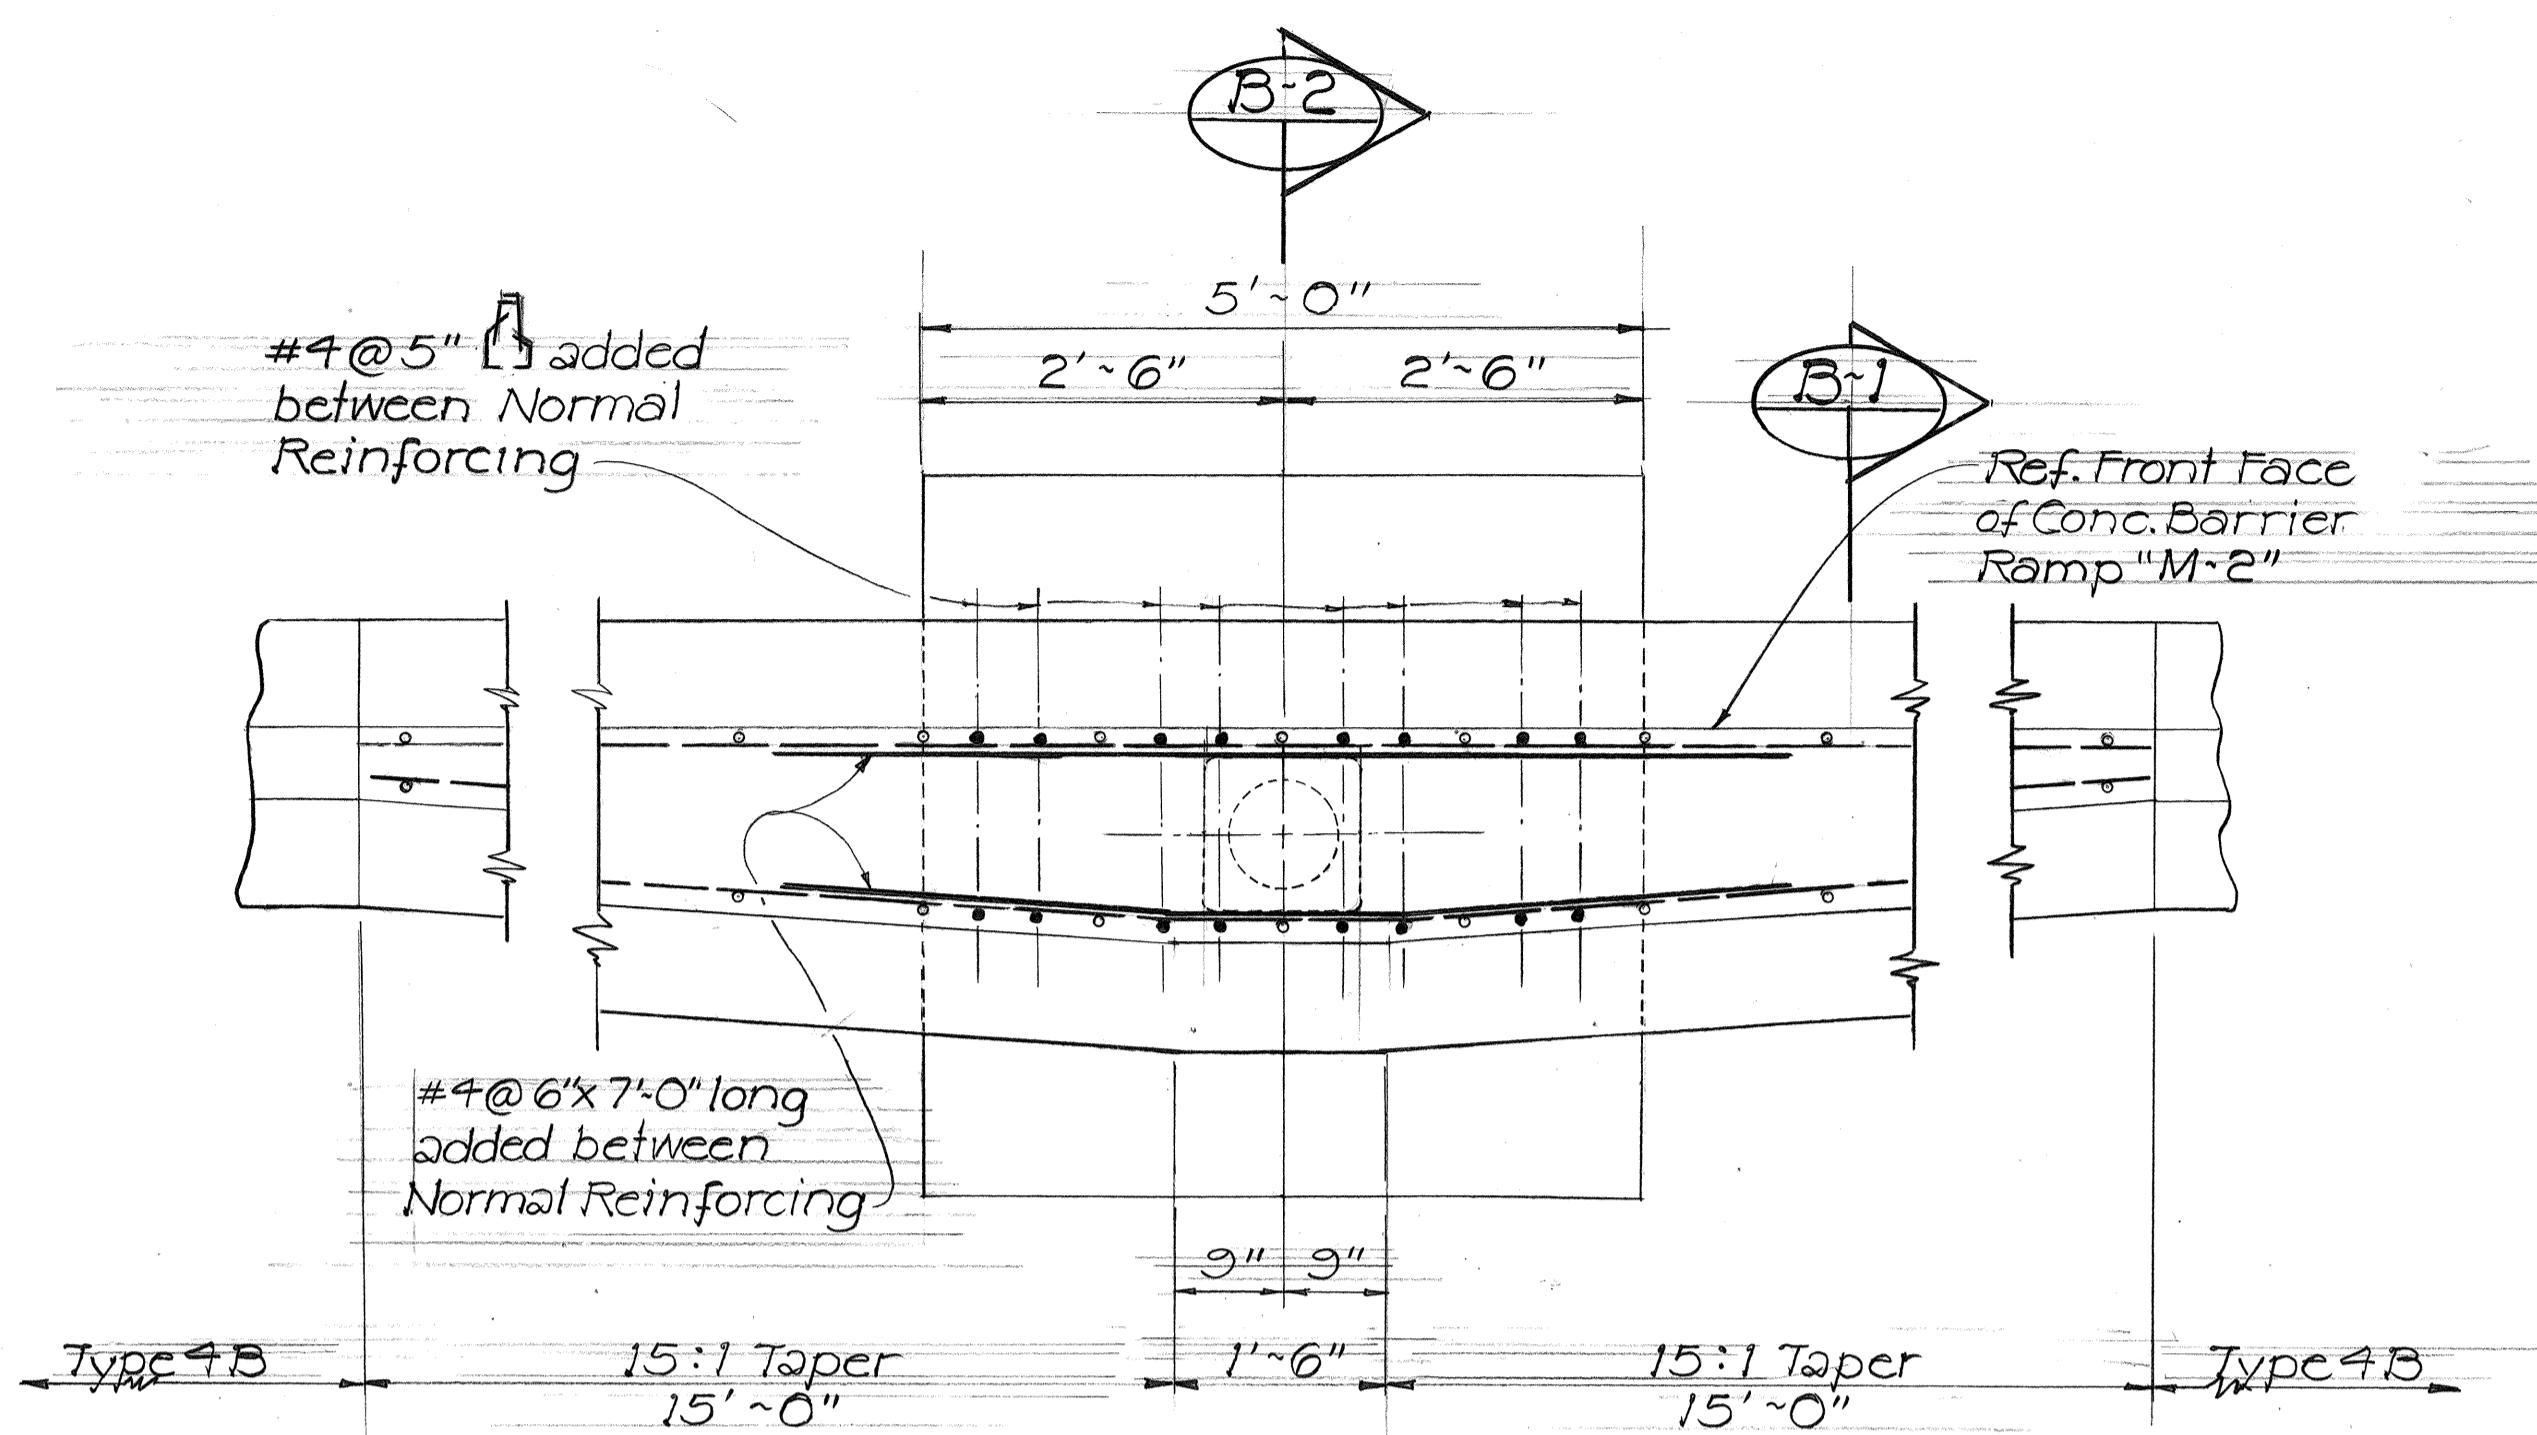

PLAN

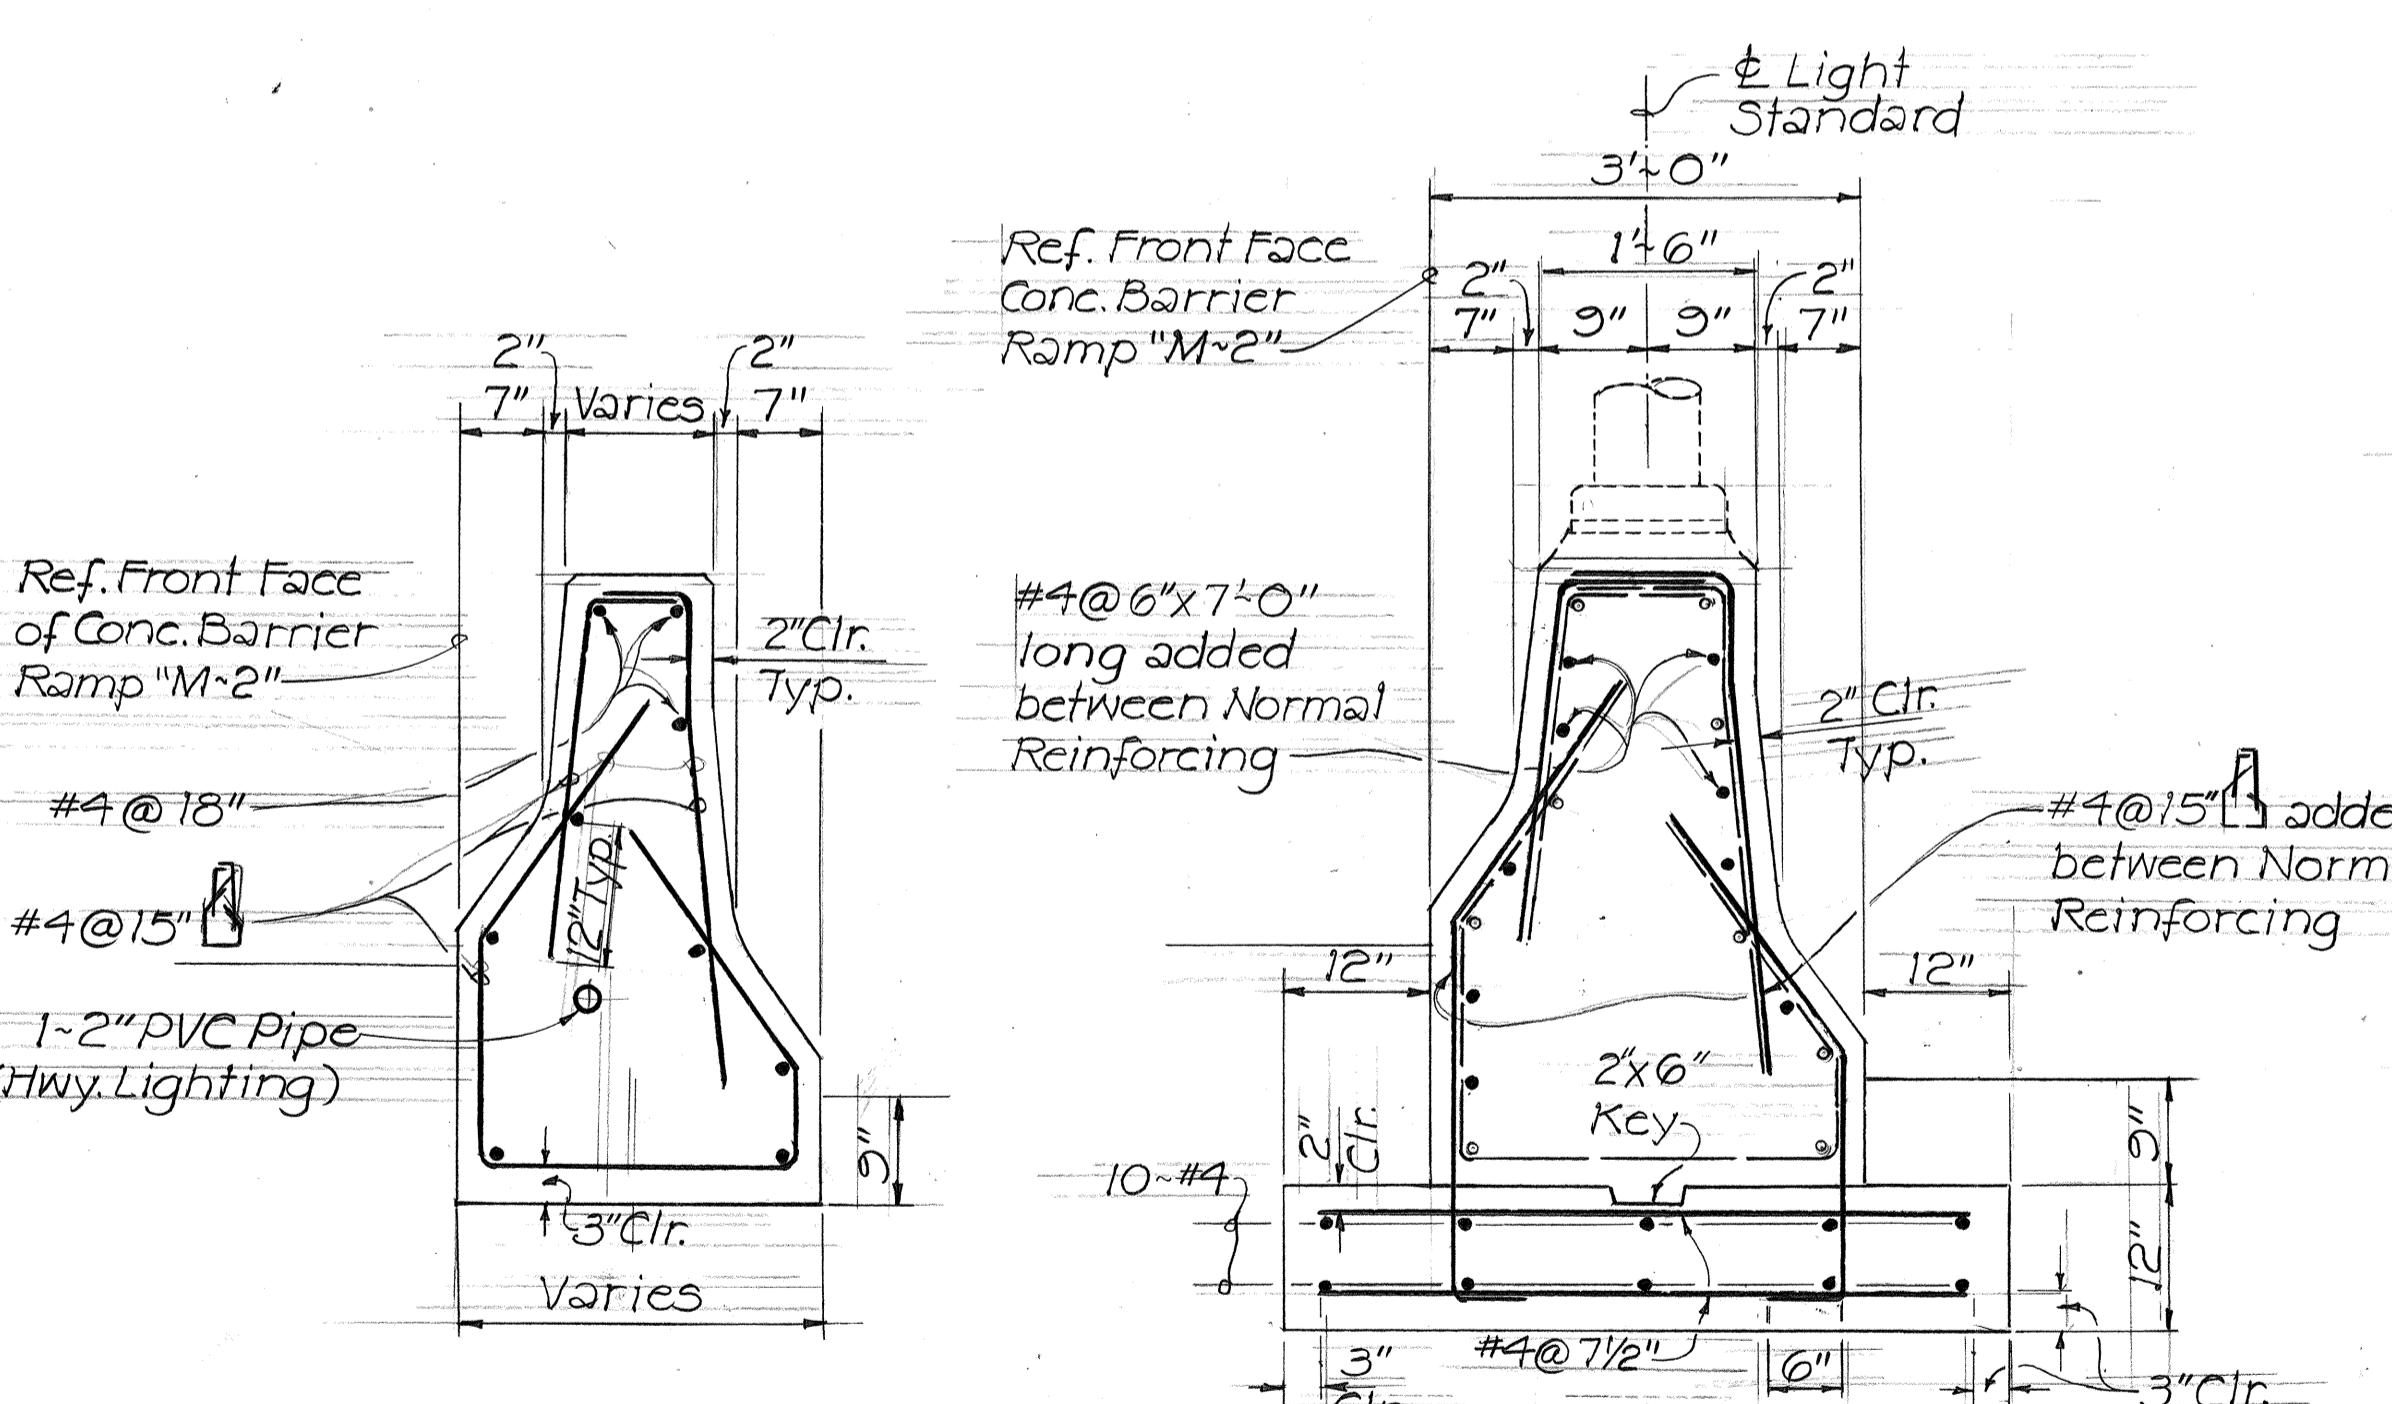


TYPICAL SECTION
AT FLARE (B-1)

LIGHT STANDARD ON GUARD RAIL

TYPE 4B

Scale: 3/4" = 1'-0"

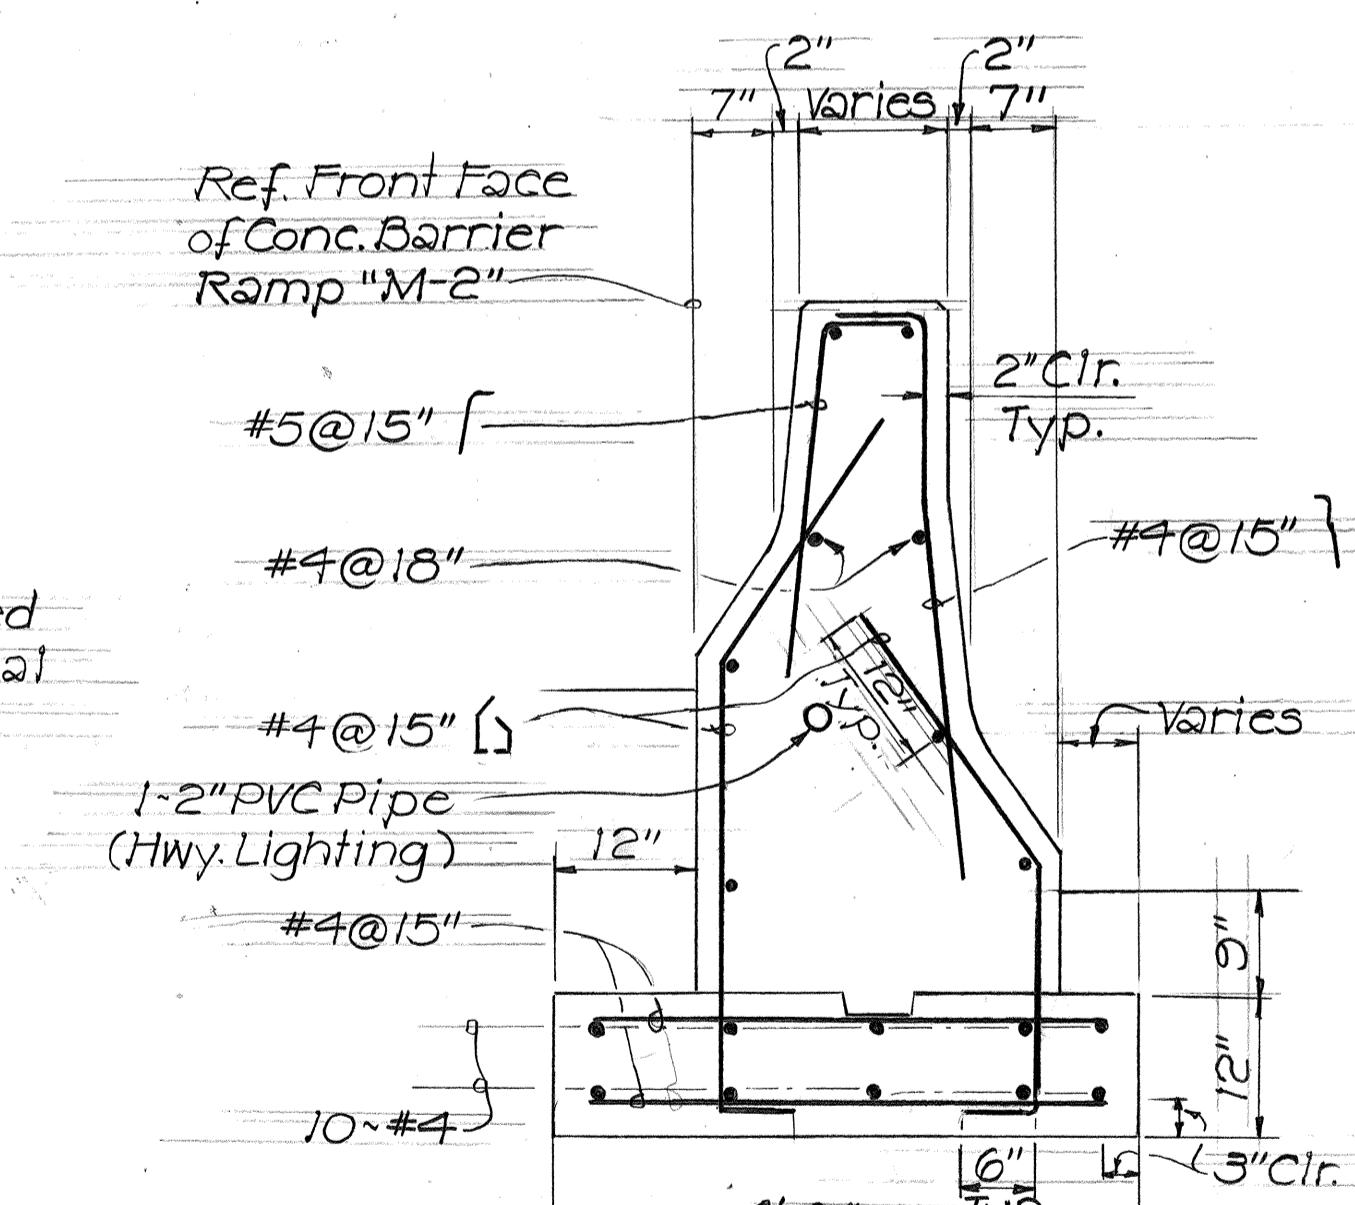


SECTION AT LIGHT STANDARD (B-2)

SECTION AT FLARE (C-1)

LIGHT STANDARD ON GUARD RAIL

TYPE 4C


Scale: 3/4" = 1'-0"

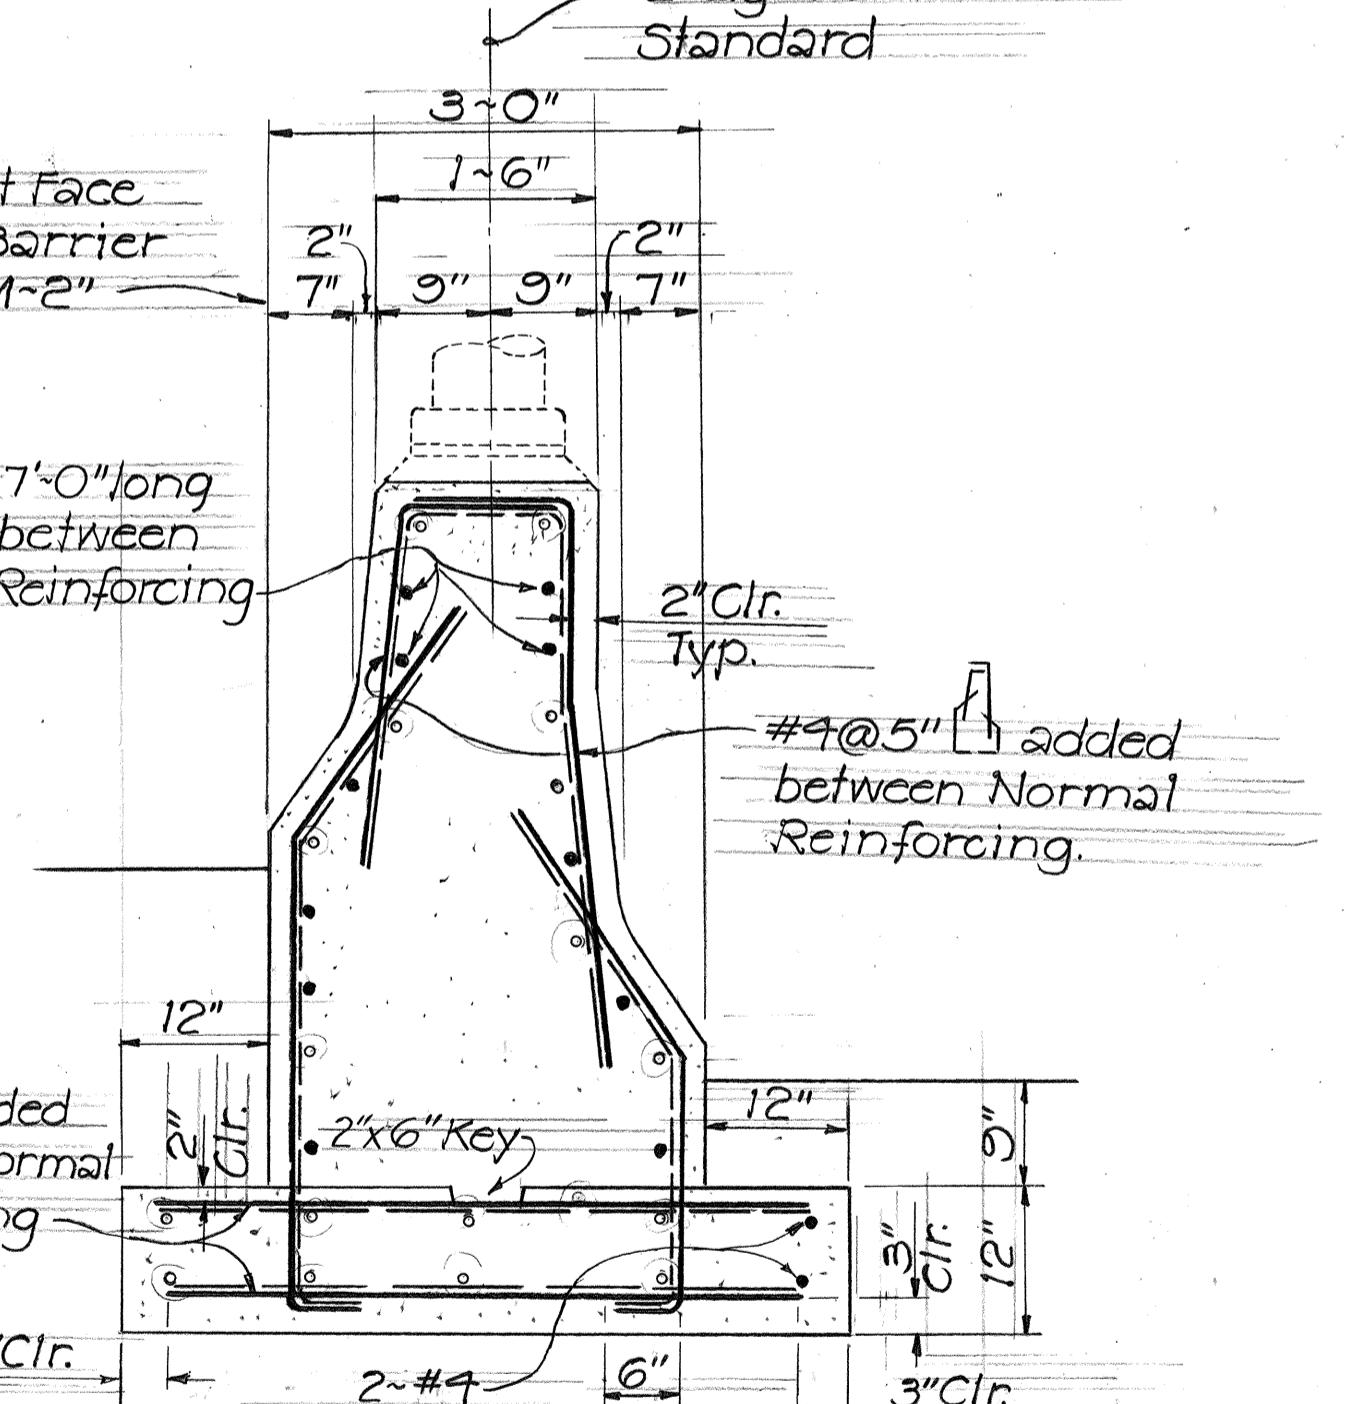


SECTION AT LIGHT STANDARD (C-2)

STATE OF HAWAII
DEPARTMENT OF TRANSPORTATION
LAND TRANSPORTATION FACILITIES DIVISION
GUARD RAIL TYPE 4, CONCRETE
RIGID BARRIER DETAILS
INTERSTATE ROUTE H-I IMPROVEMENTS
MIDDLE STREET TO KALIHI INTERCHANGE
WESTBOUND LANES
F.A.I. PROJ. NO. I-HI-1(187)
Scale: As Shown
SHEET NO. 8 OF 10 SHEETS

FED. ROAD DIST. NO.	STATE	FED. AID PROJ. NO.	FISCAL YEAR	SHEET NO.	TOTAL SHEETS
HAWAII	HAW.	I-HI-1(187)	1984	28	197

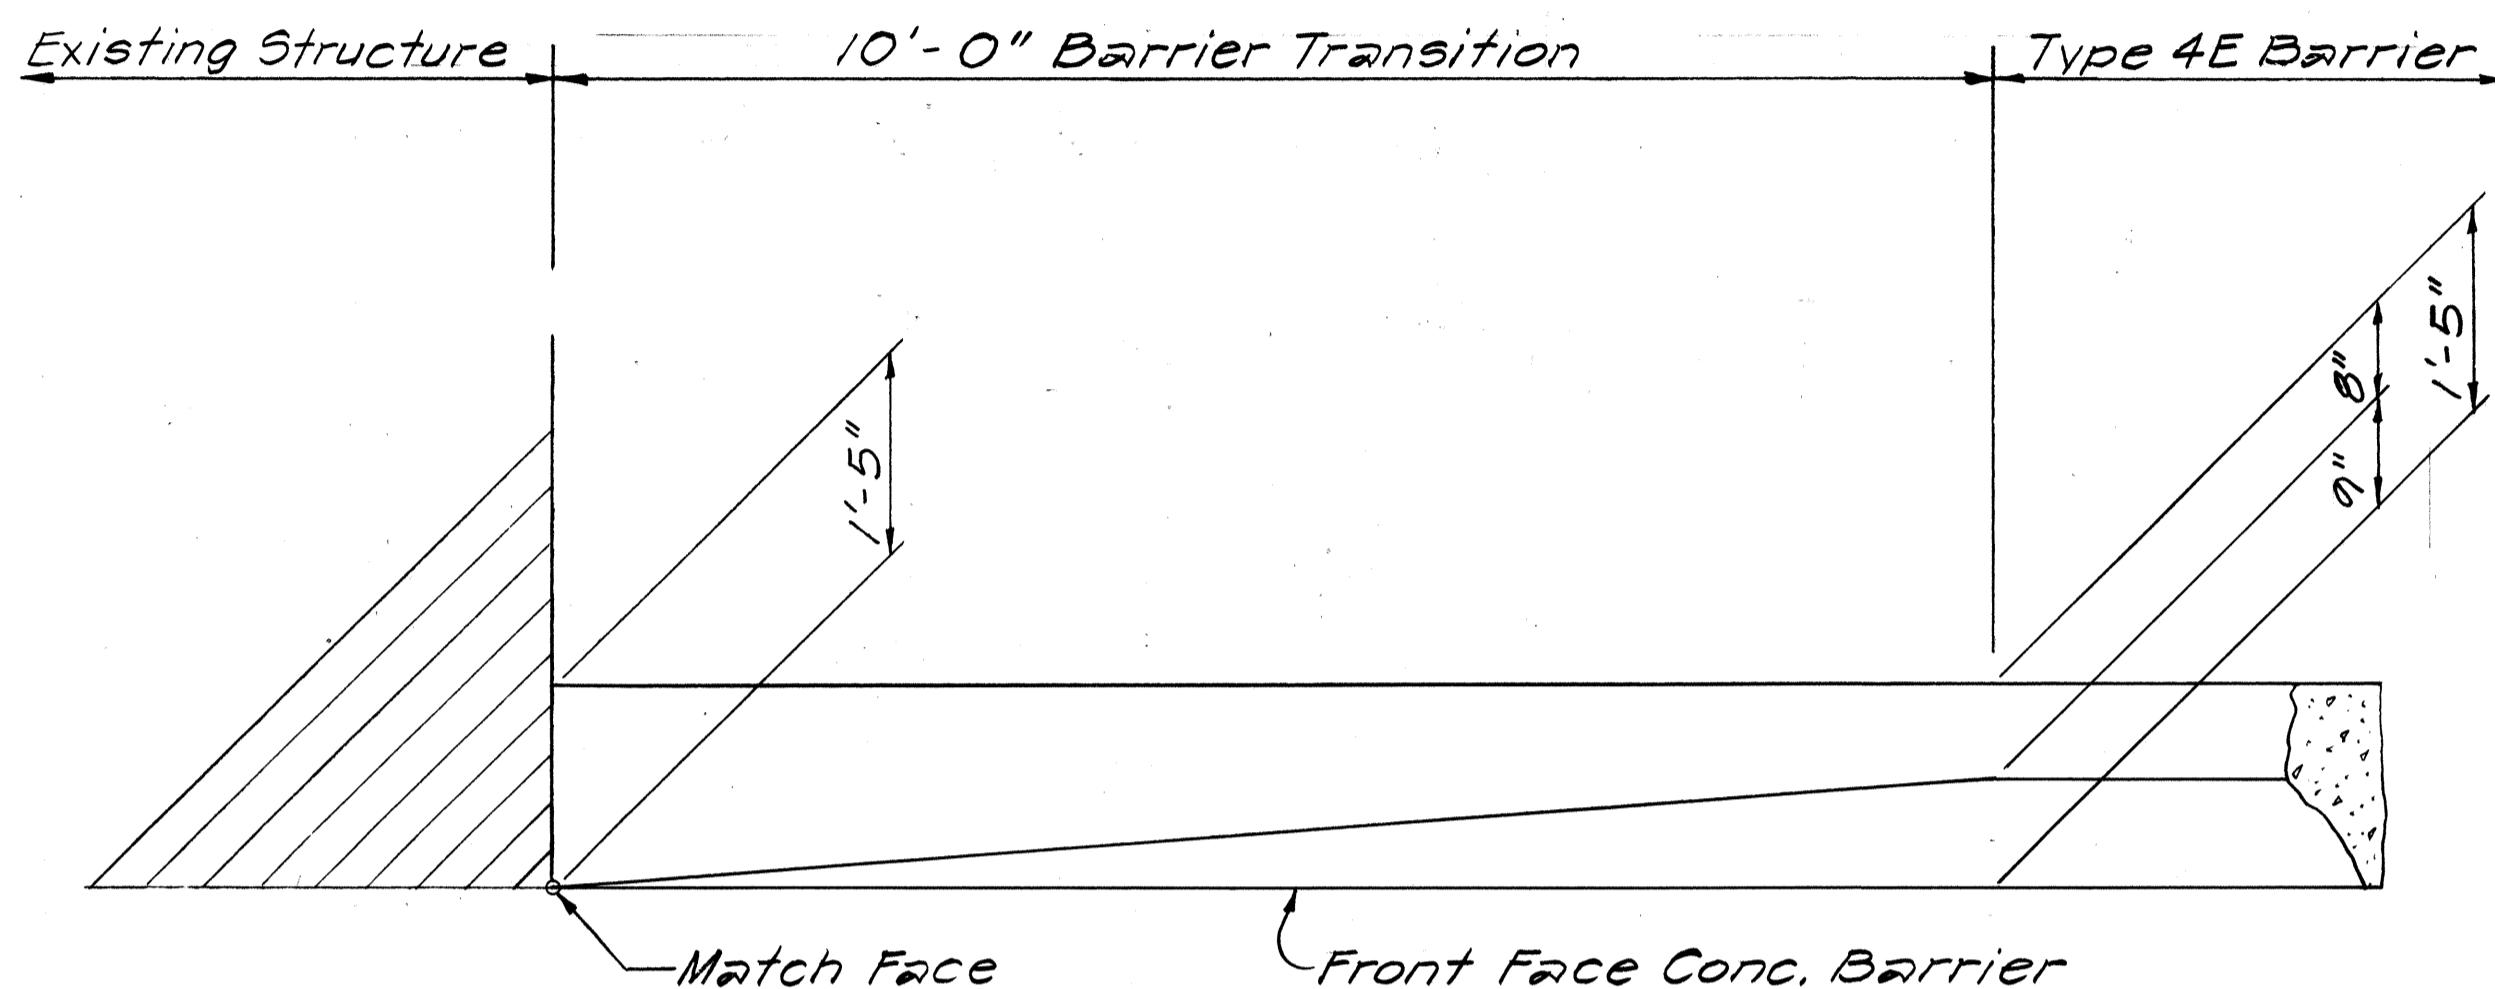

PLAN

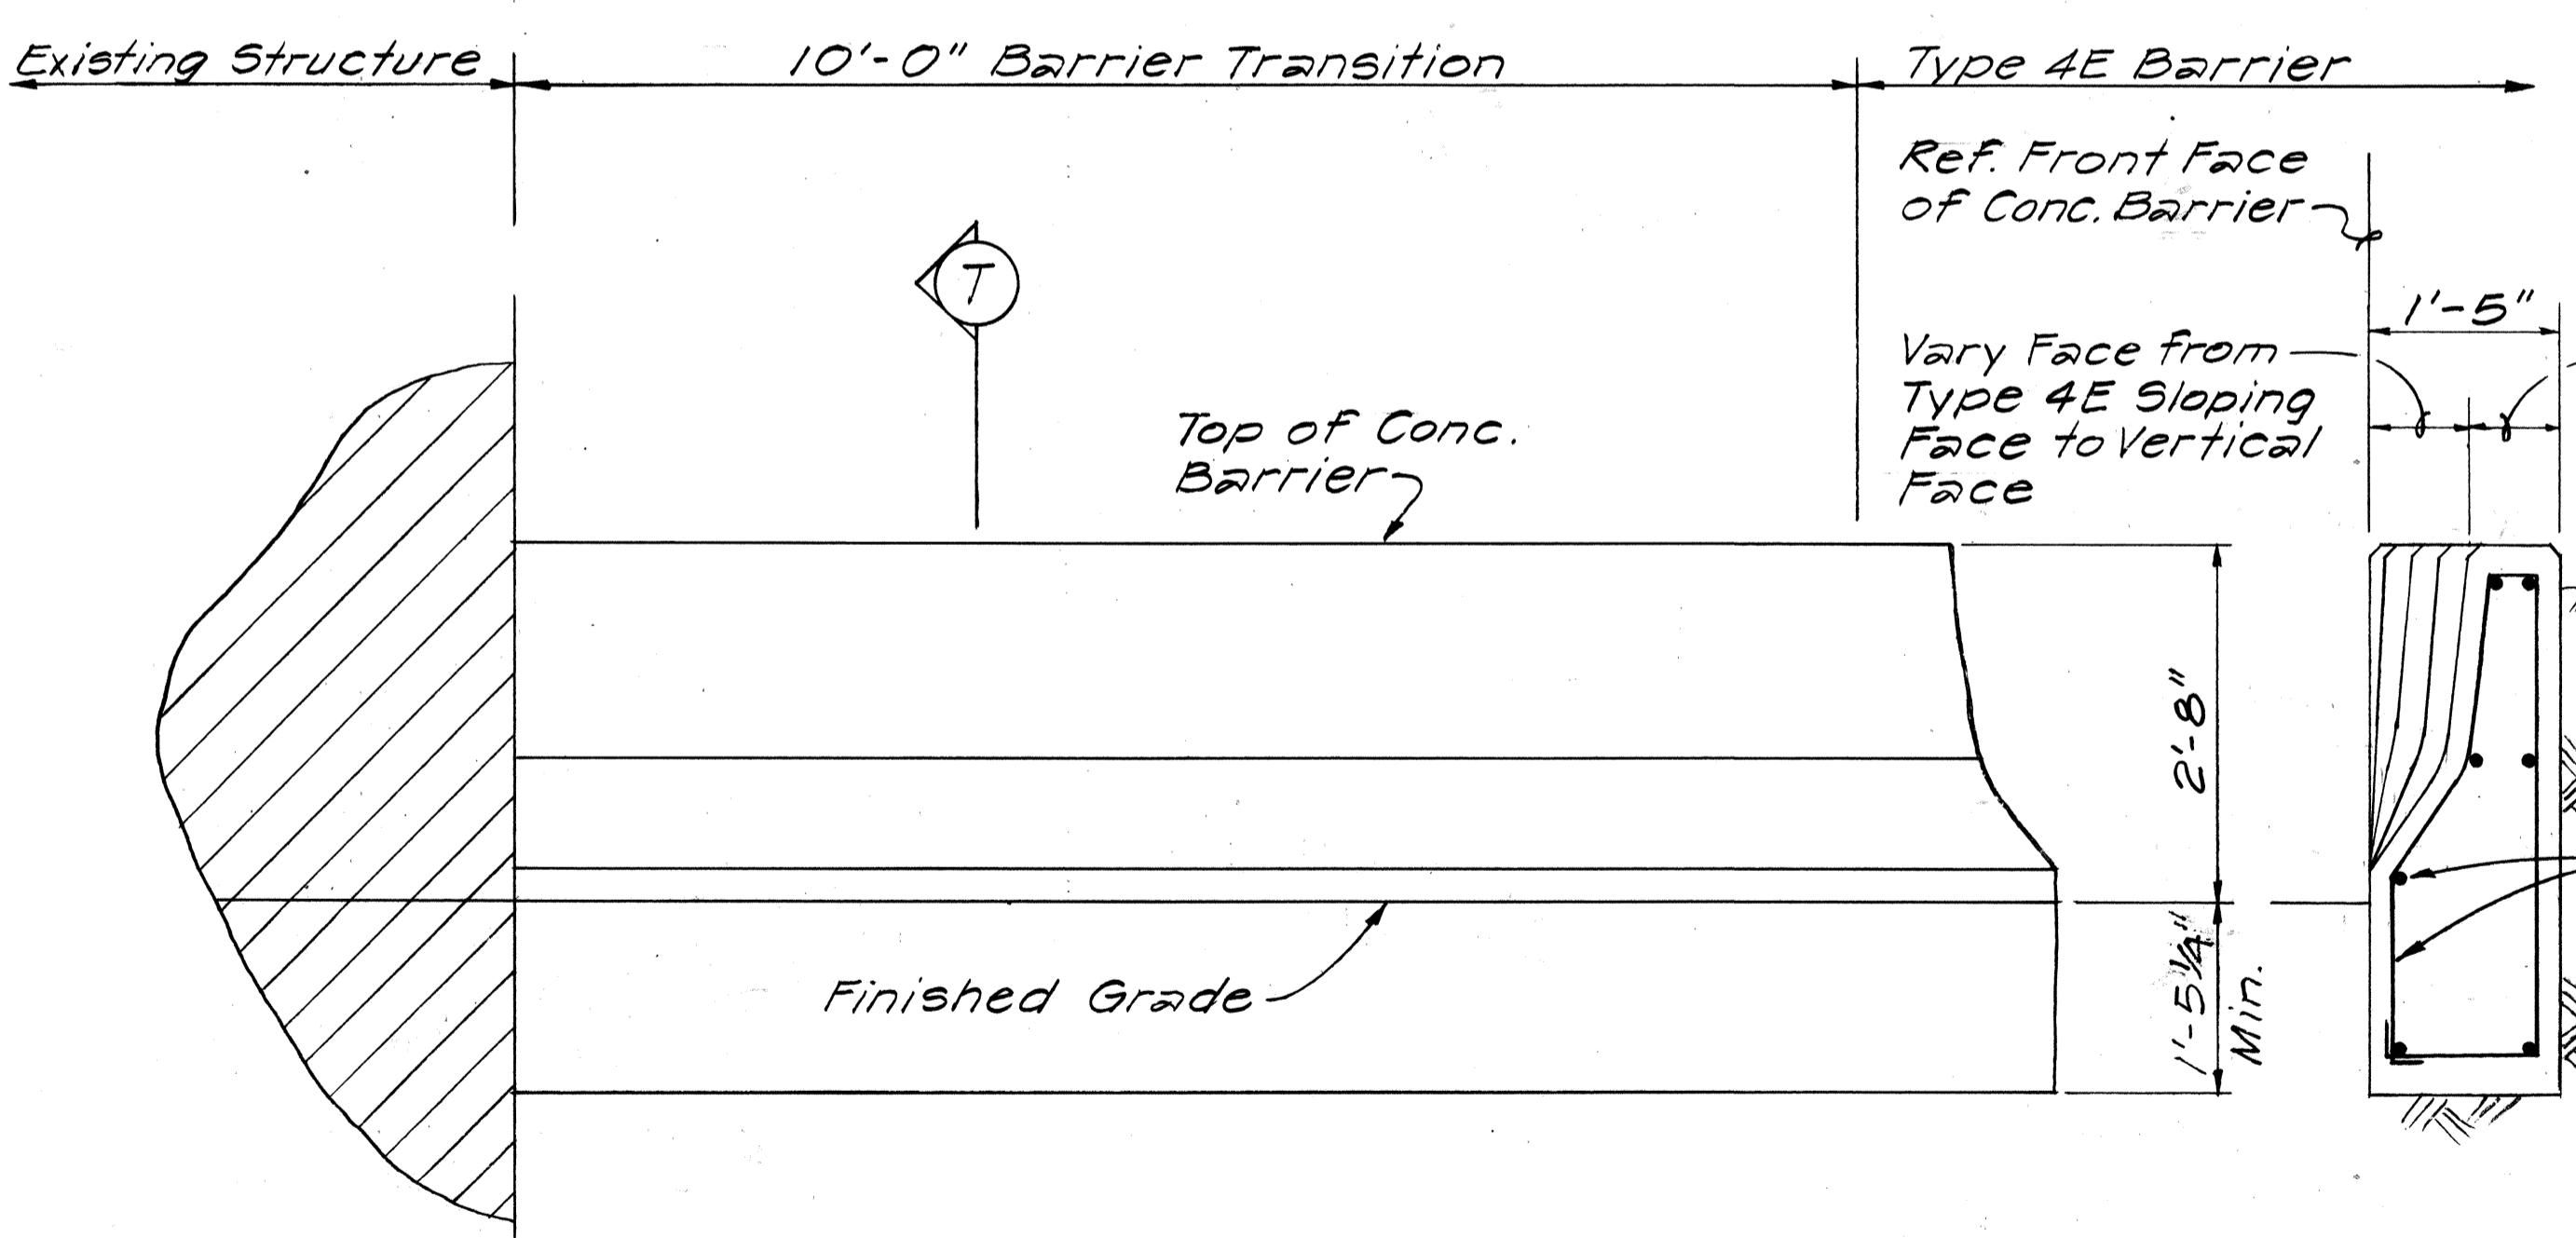


SECTION T


*NOTE: See Typical Section thru Type 4E
Barrier for additional information.*

TYPICAL CONCRETE BARRIER TRANSITION DETAILS

SCALE: $3/4'' = 1'-0''$

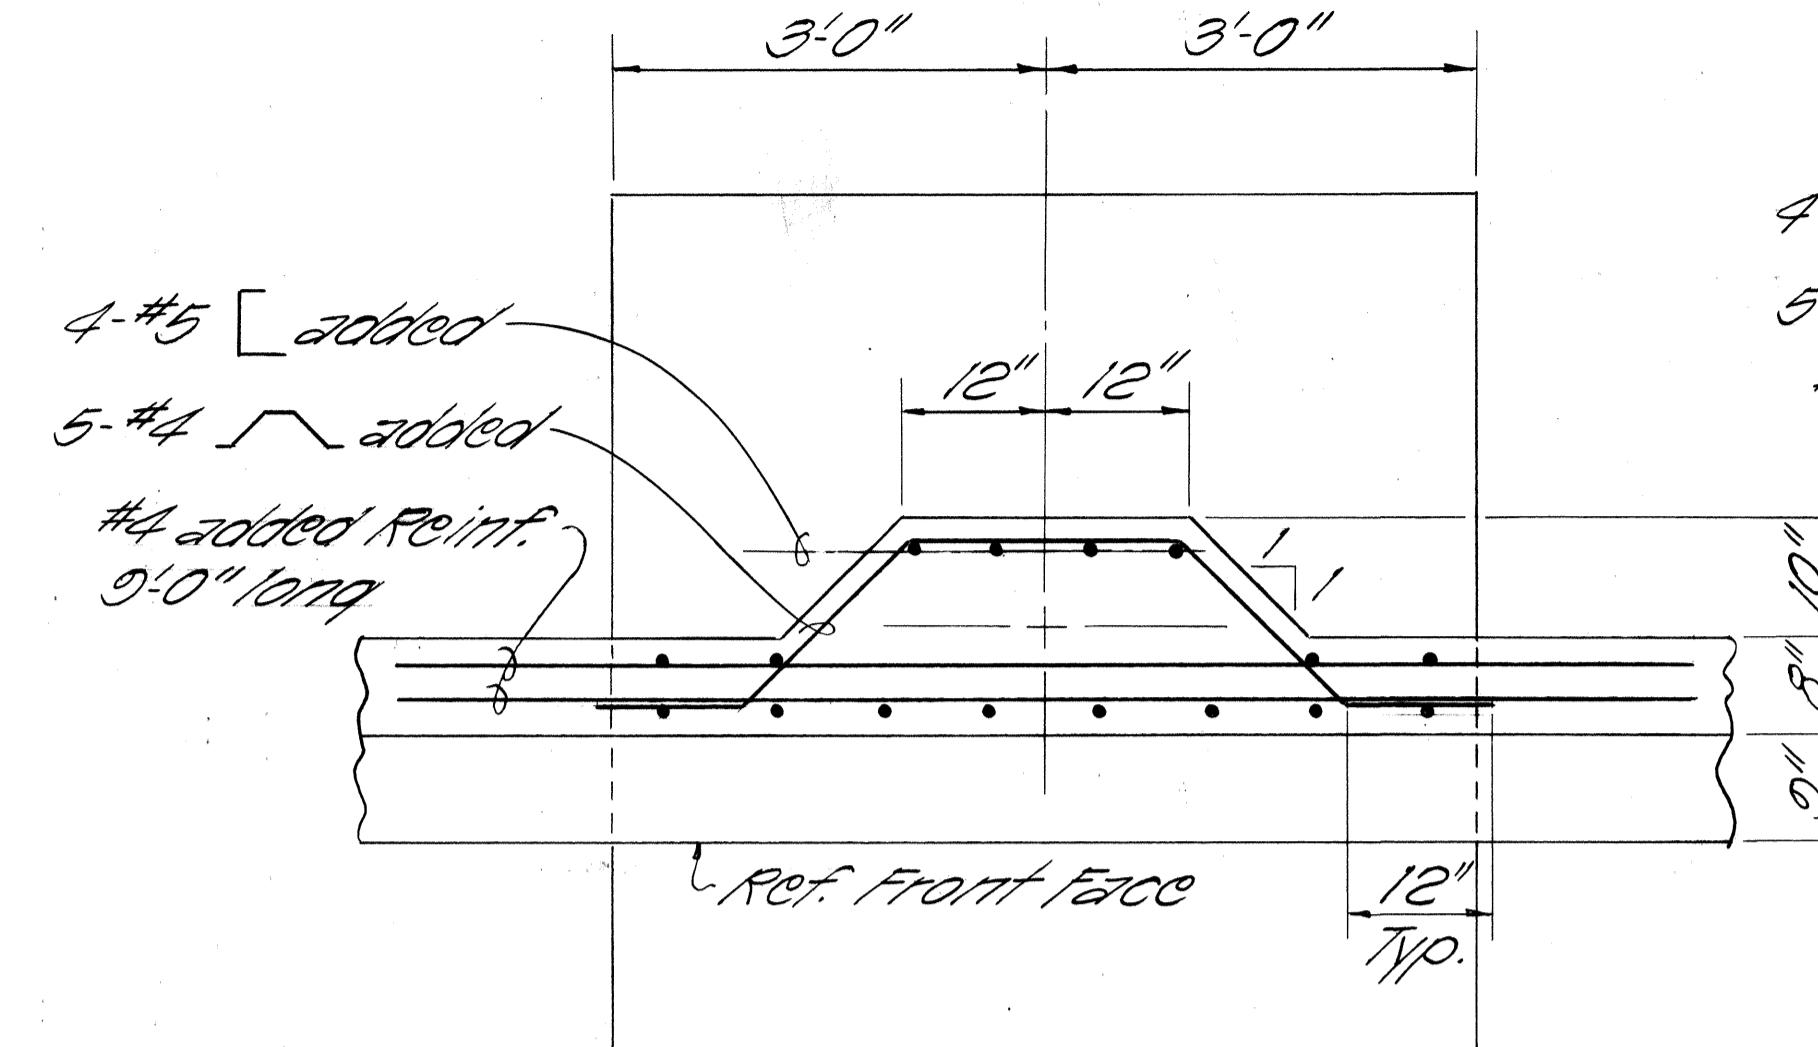


PLAN

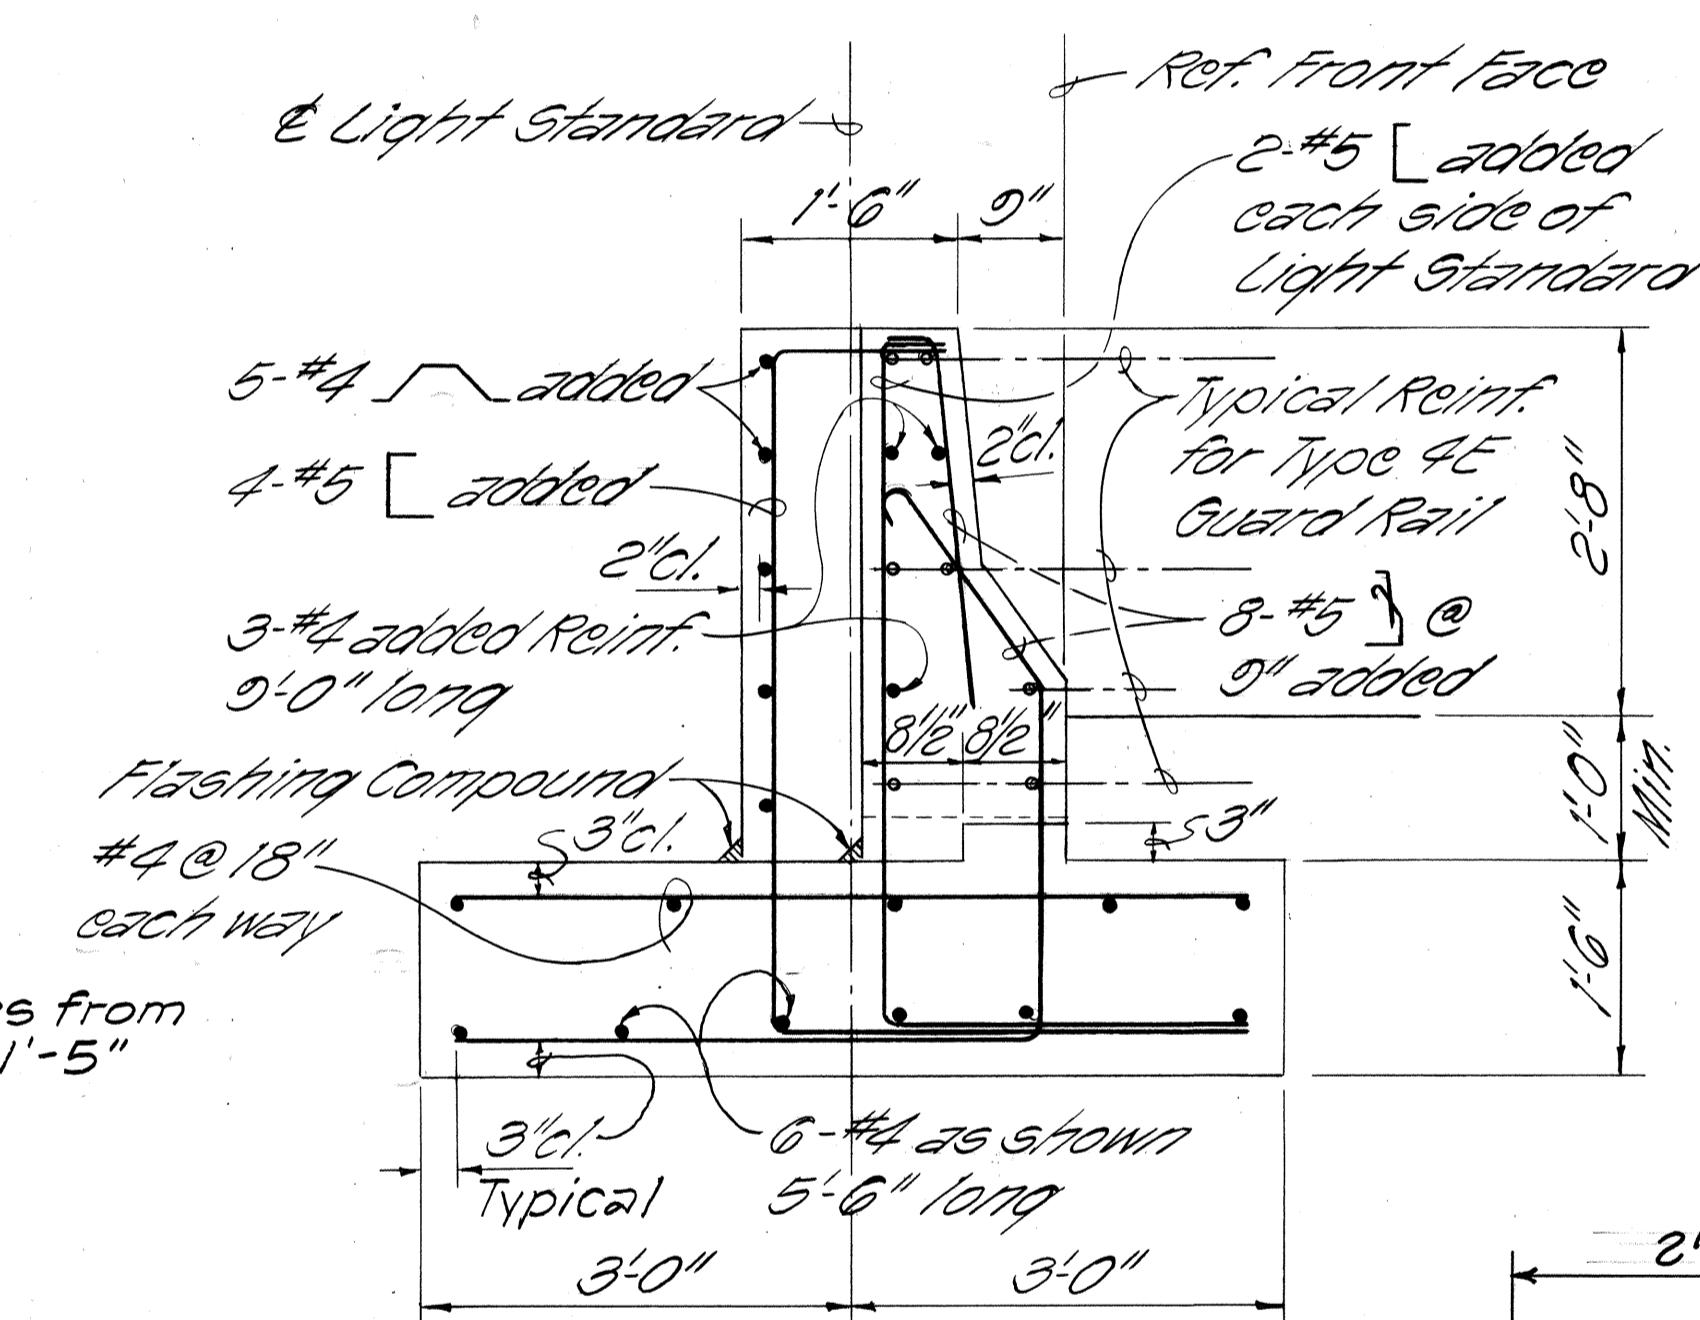

SECTION


LIGHT STANDARD ON TYPE 4E GUARD RAIL

SCALE: $\frac{3}{4}'' = 1'-0''$

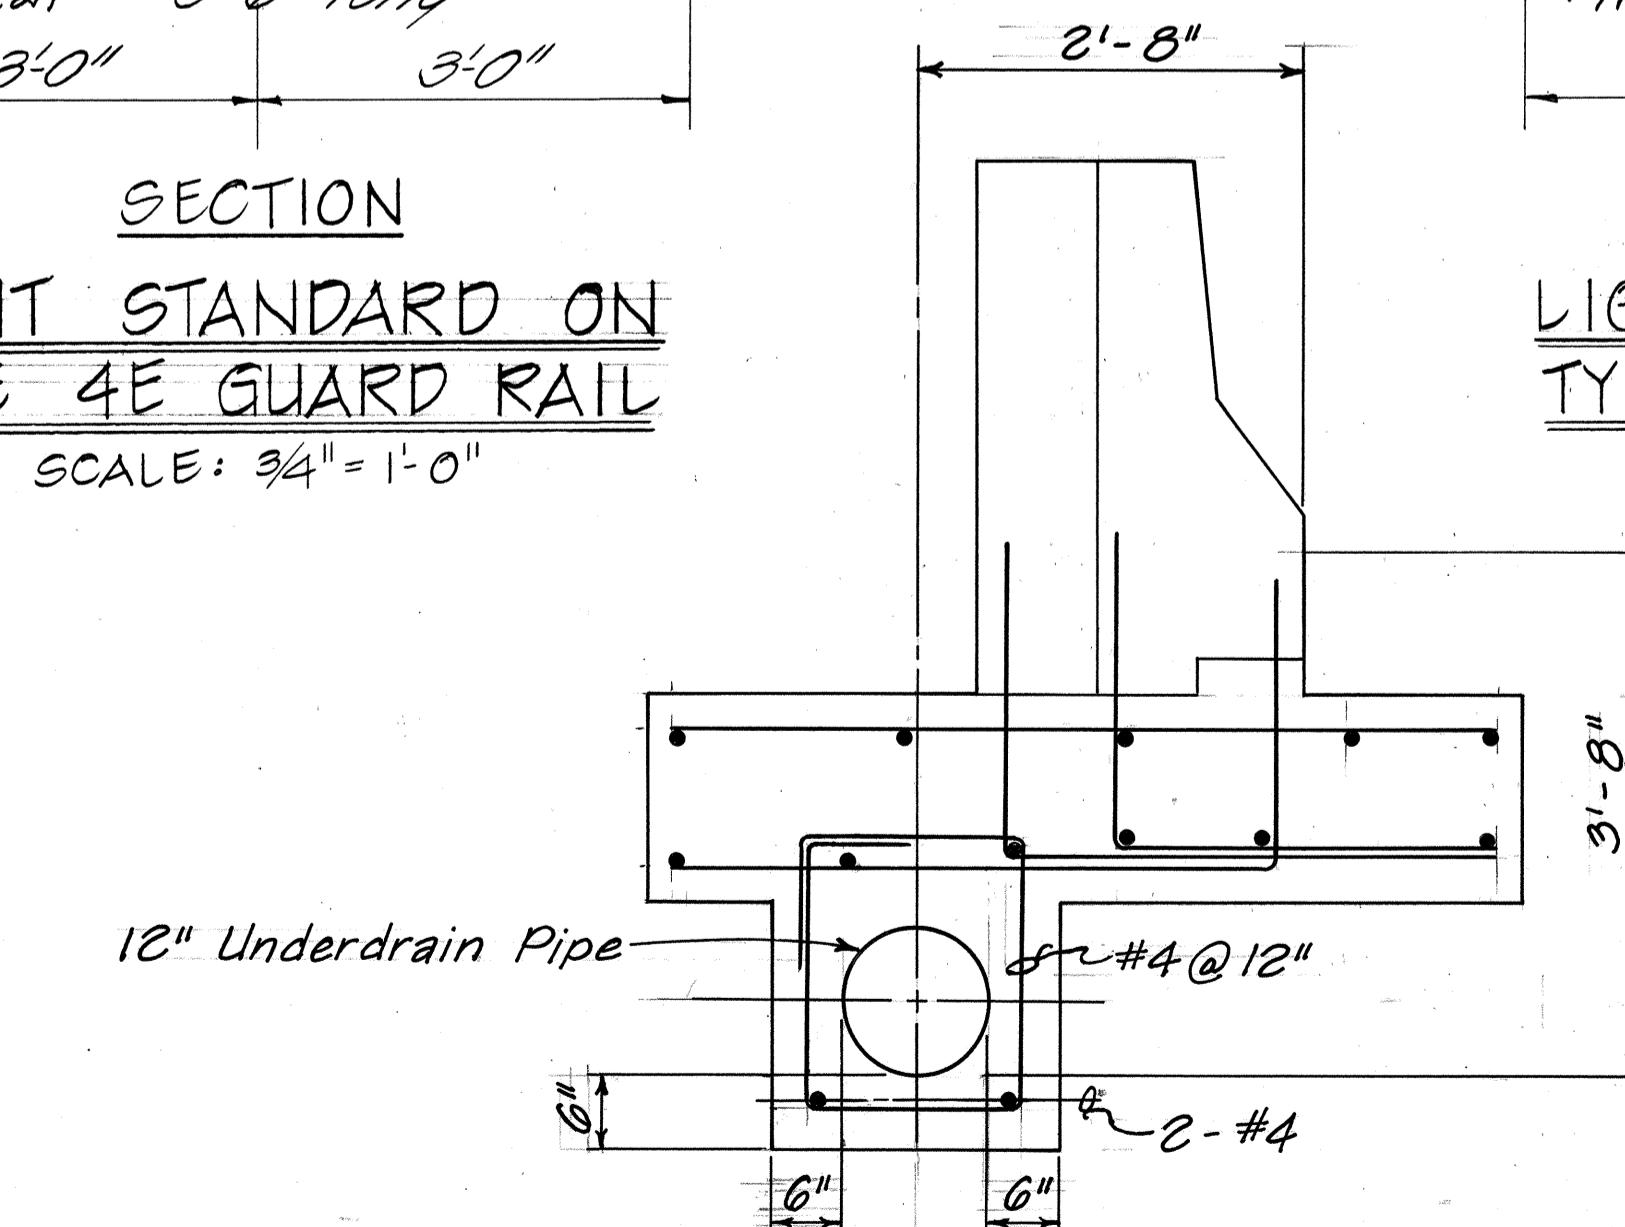


LIGHT STANDARD SECTION AT UNDERDRAIN

SCALF: $\frac{3}{4}'' = 1'-0''$

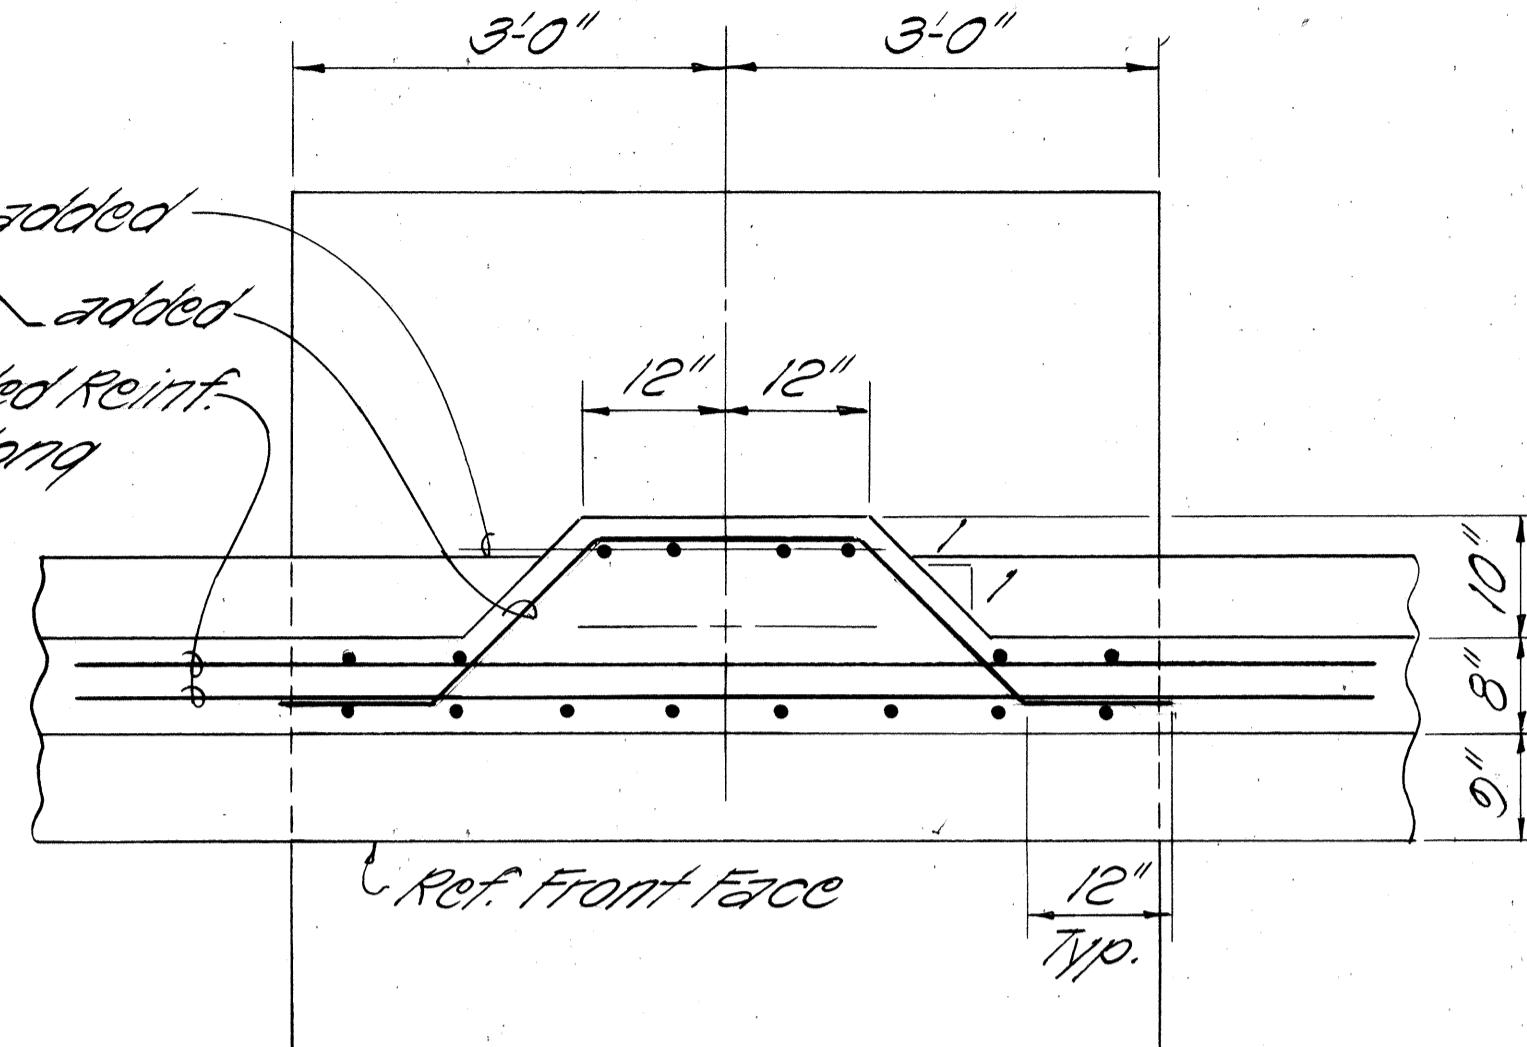

PLAN

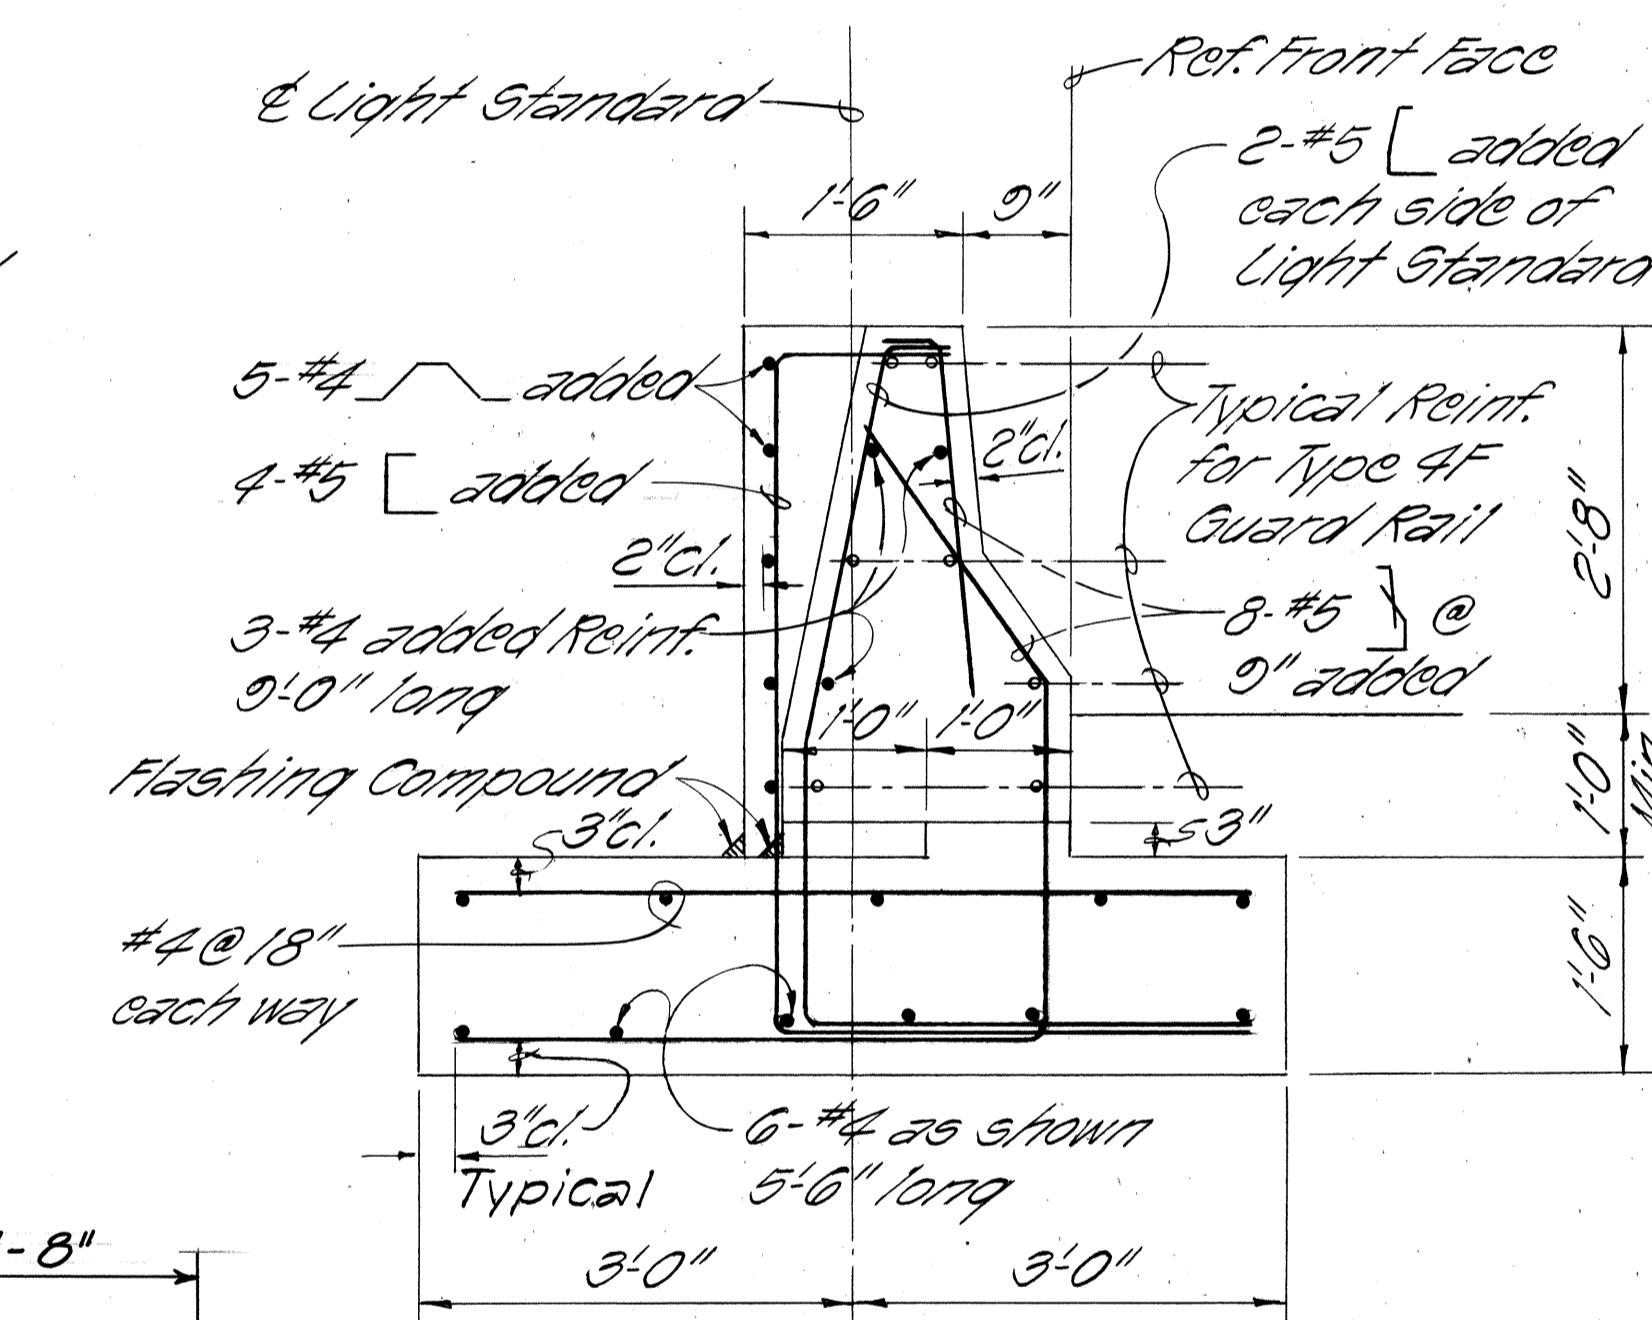

SECTION

LIGHT STANDARD ON TYPE GF GUARD RAIL

SCALE: $\frac{3}{4}'' = 1'-0''$

**STATE OF HAWAII
DEPARTMENT OF TRANSPORTATION**

GUARD RAIL TYPE 4, CONCRETE RIGID BARRIER DETAILS

INTERSTATE H-1 IMPROVEMENTS


MIDDLE STREET TO KAI IHI INTERCHANGE

WESTBOUND LANES


F. A. I. PROJECT NO. I-HI-1(187)

Scale: As Shown Date: August, 1983

ED. ROAD DIST. NO.	STATE	FED. AID PROJ. NO.	FISCAL YEAR	SHEET NO.	TOTAL SHEETS
HAWAII	HAW.	I-HI-1(187)	1984	29	197

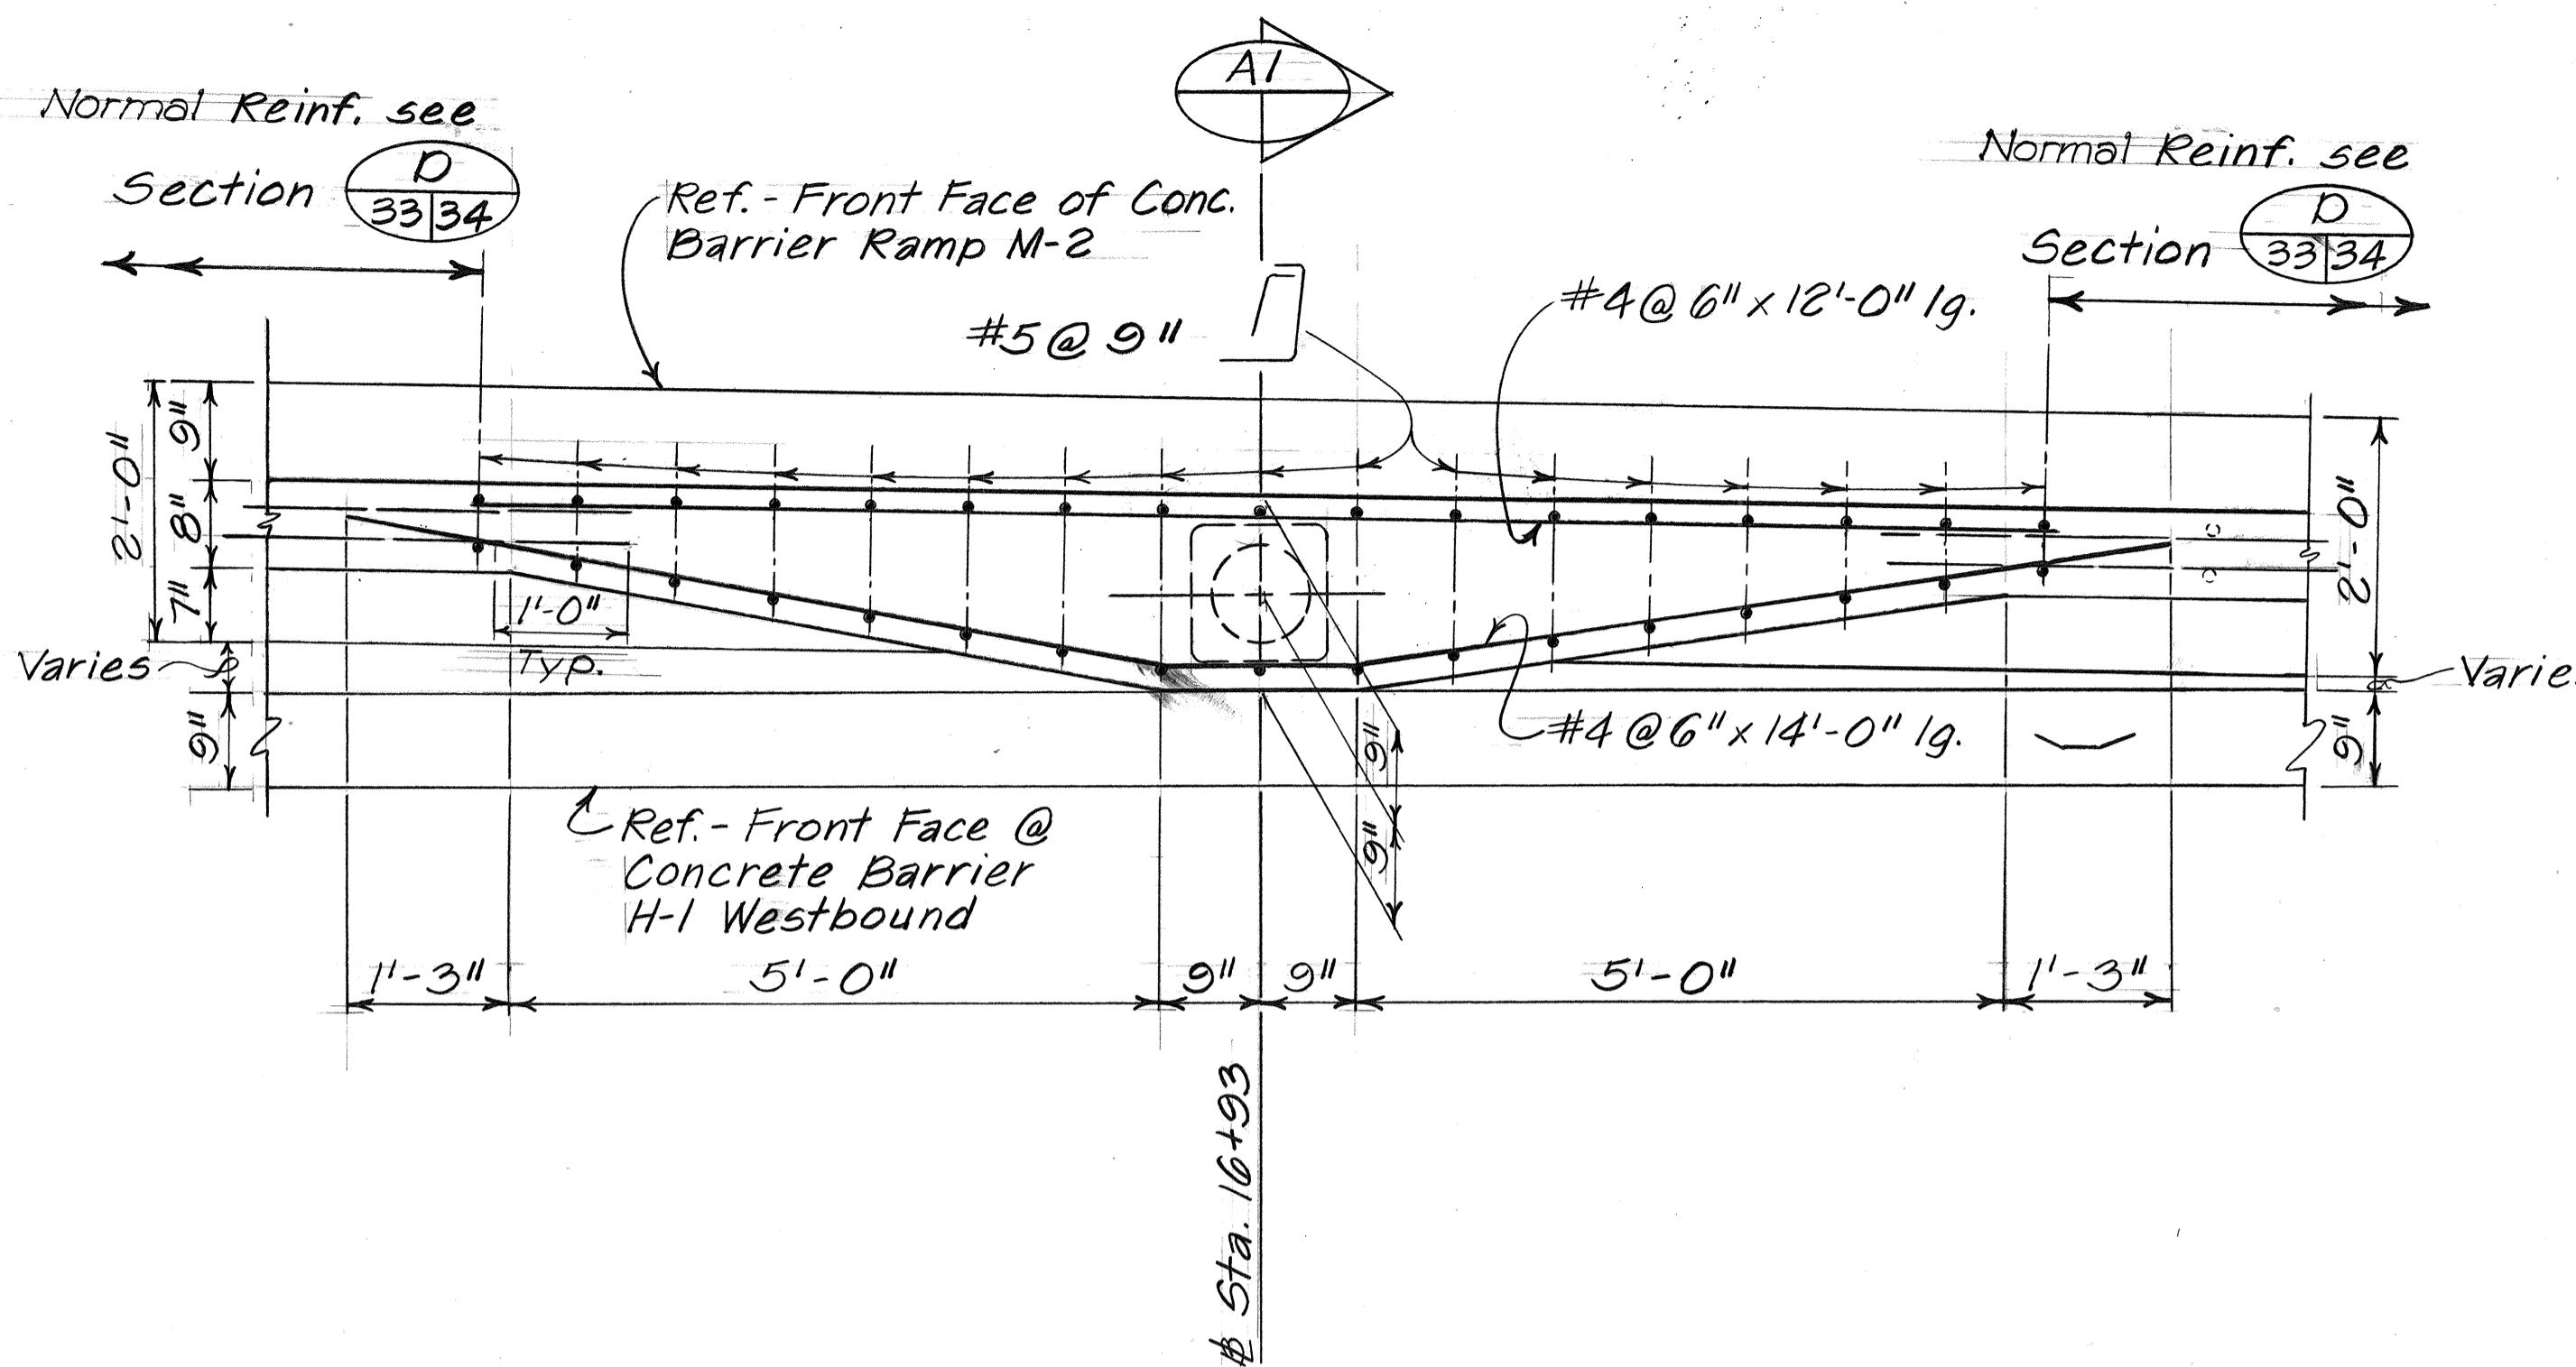


PLAN

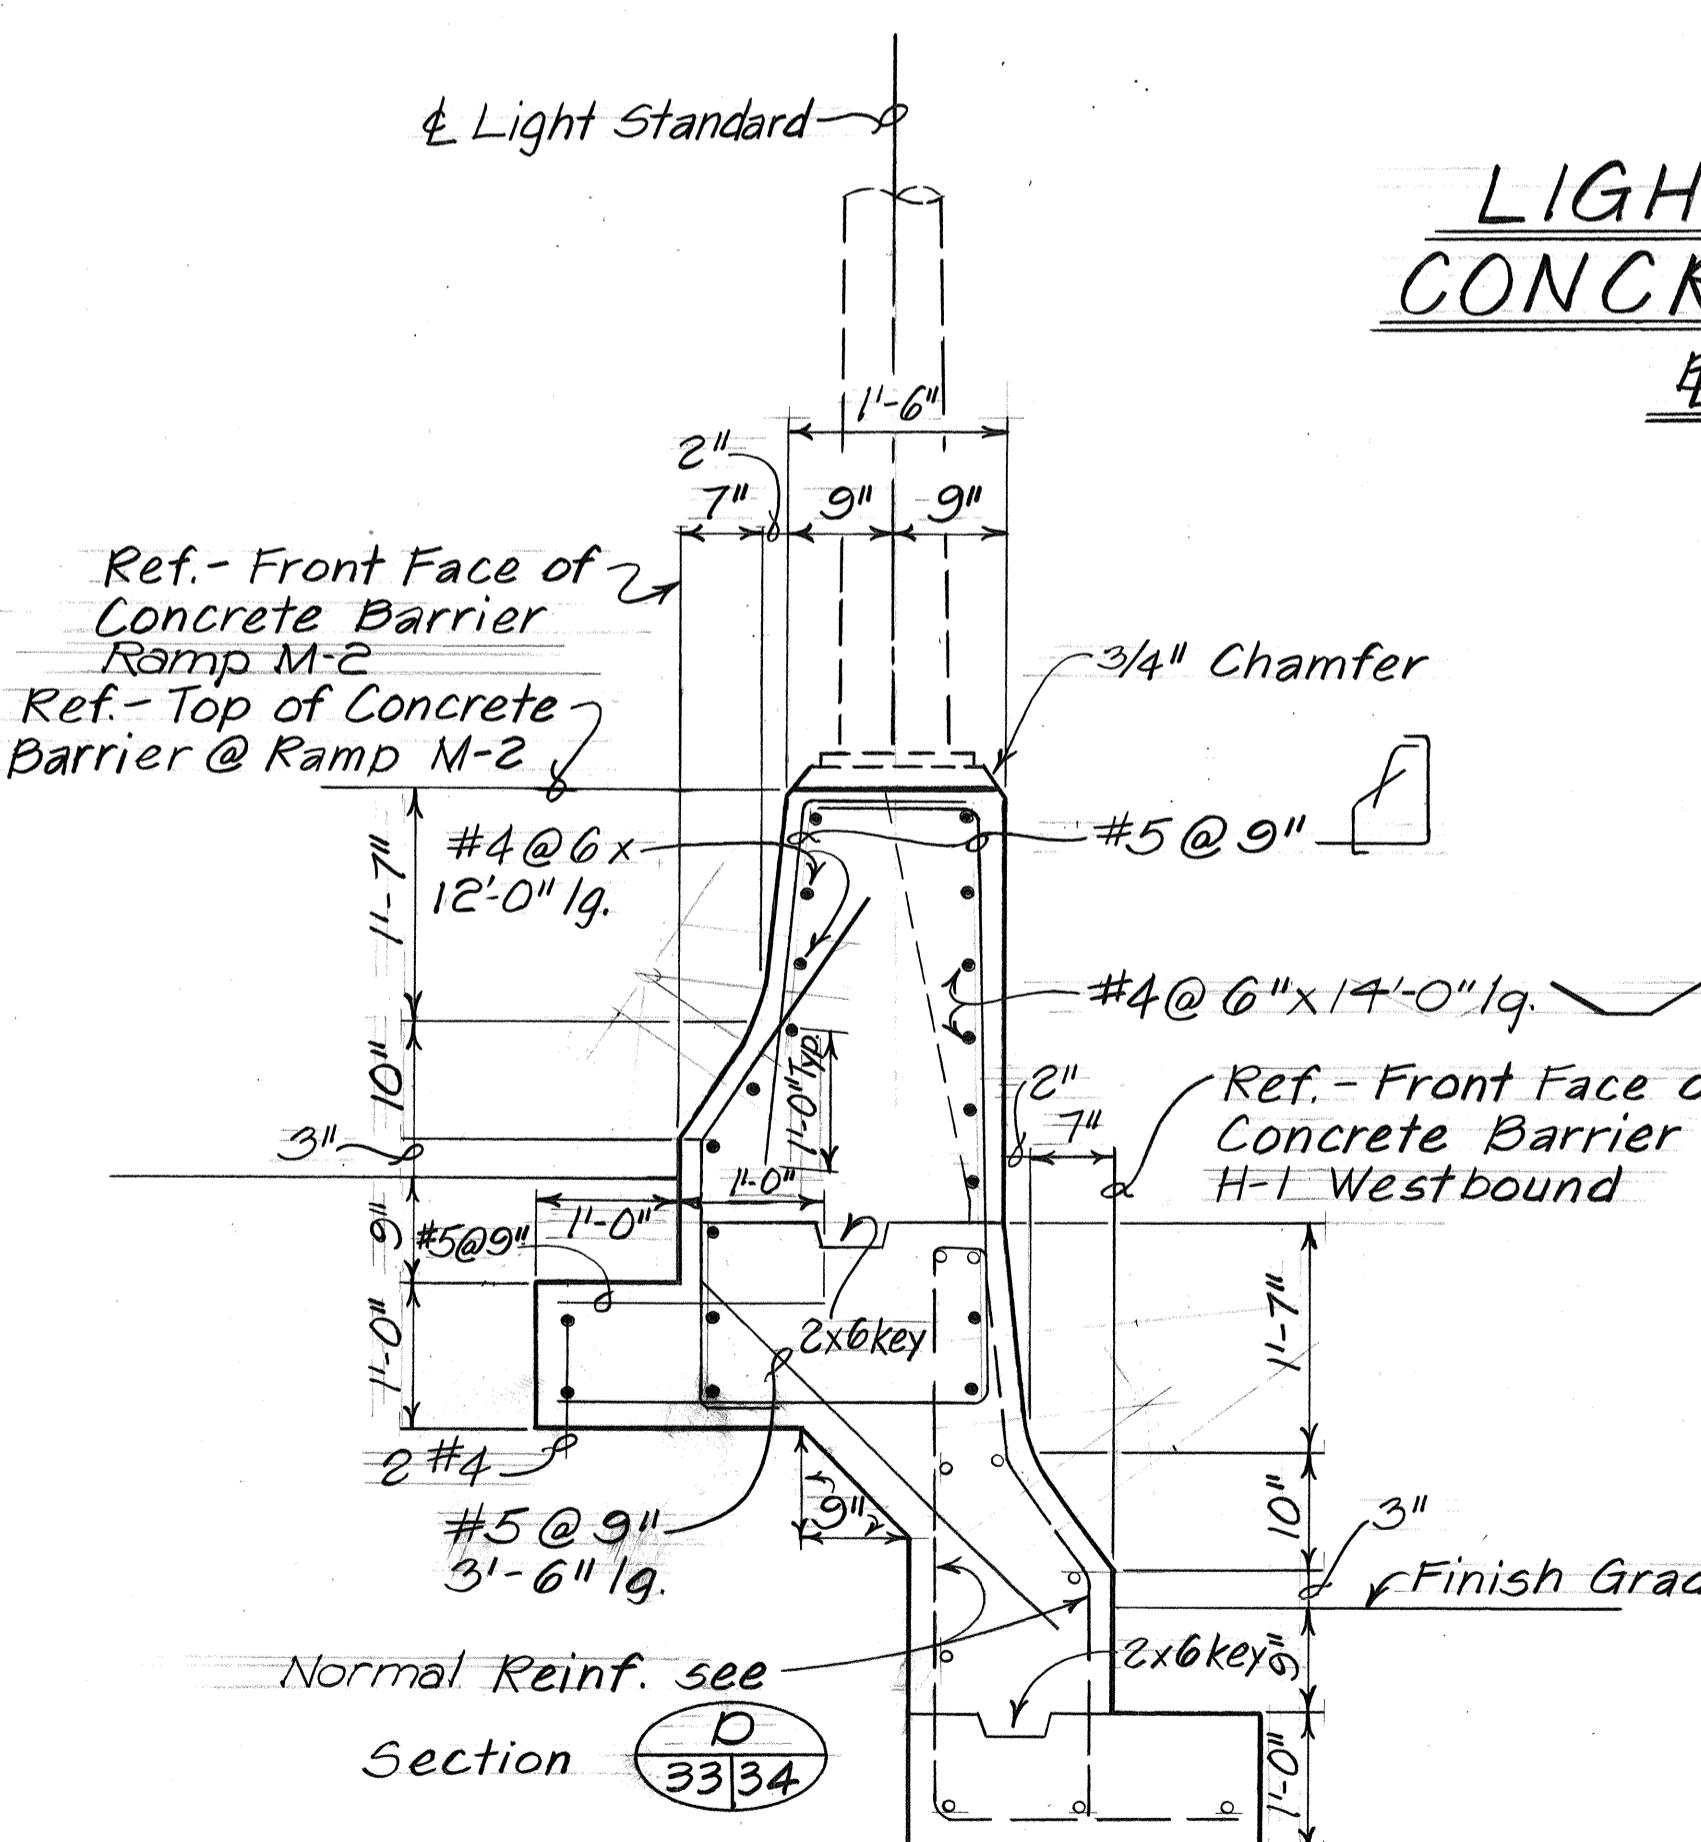


SECTION

Scale: $\frac{3}{4}'' = 1'-0''$

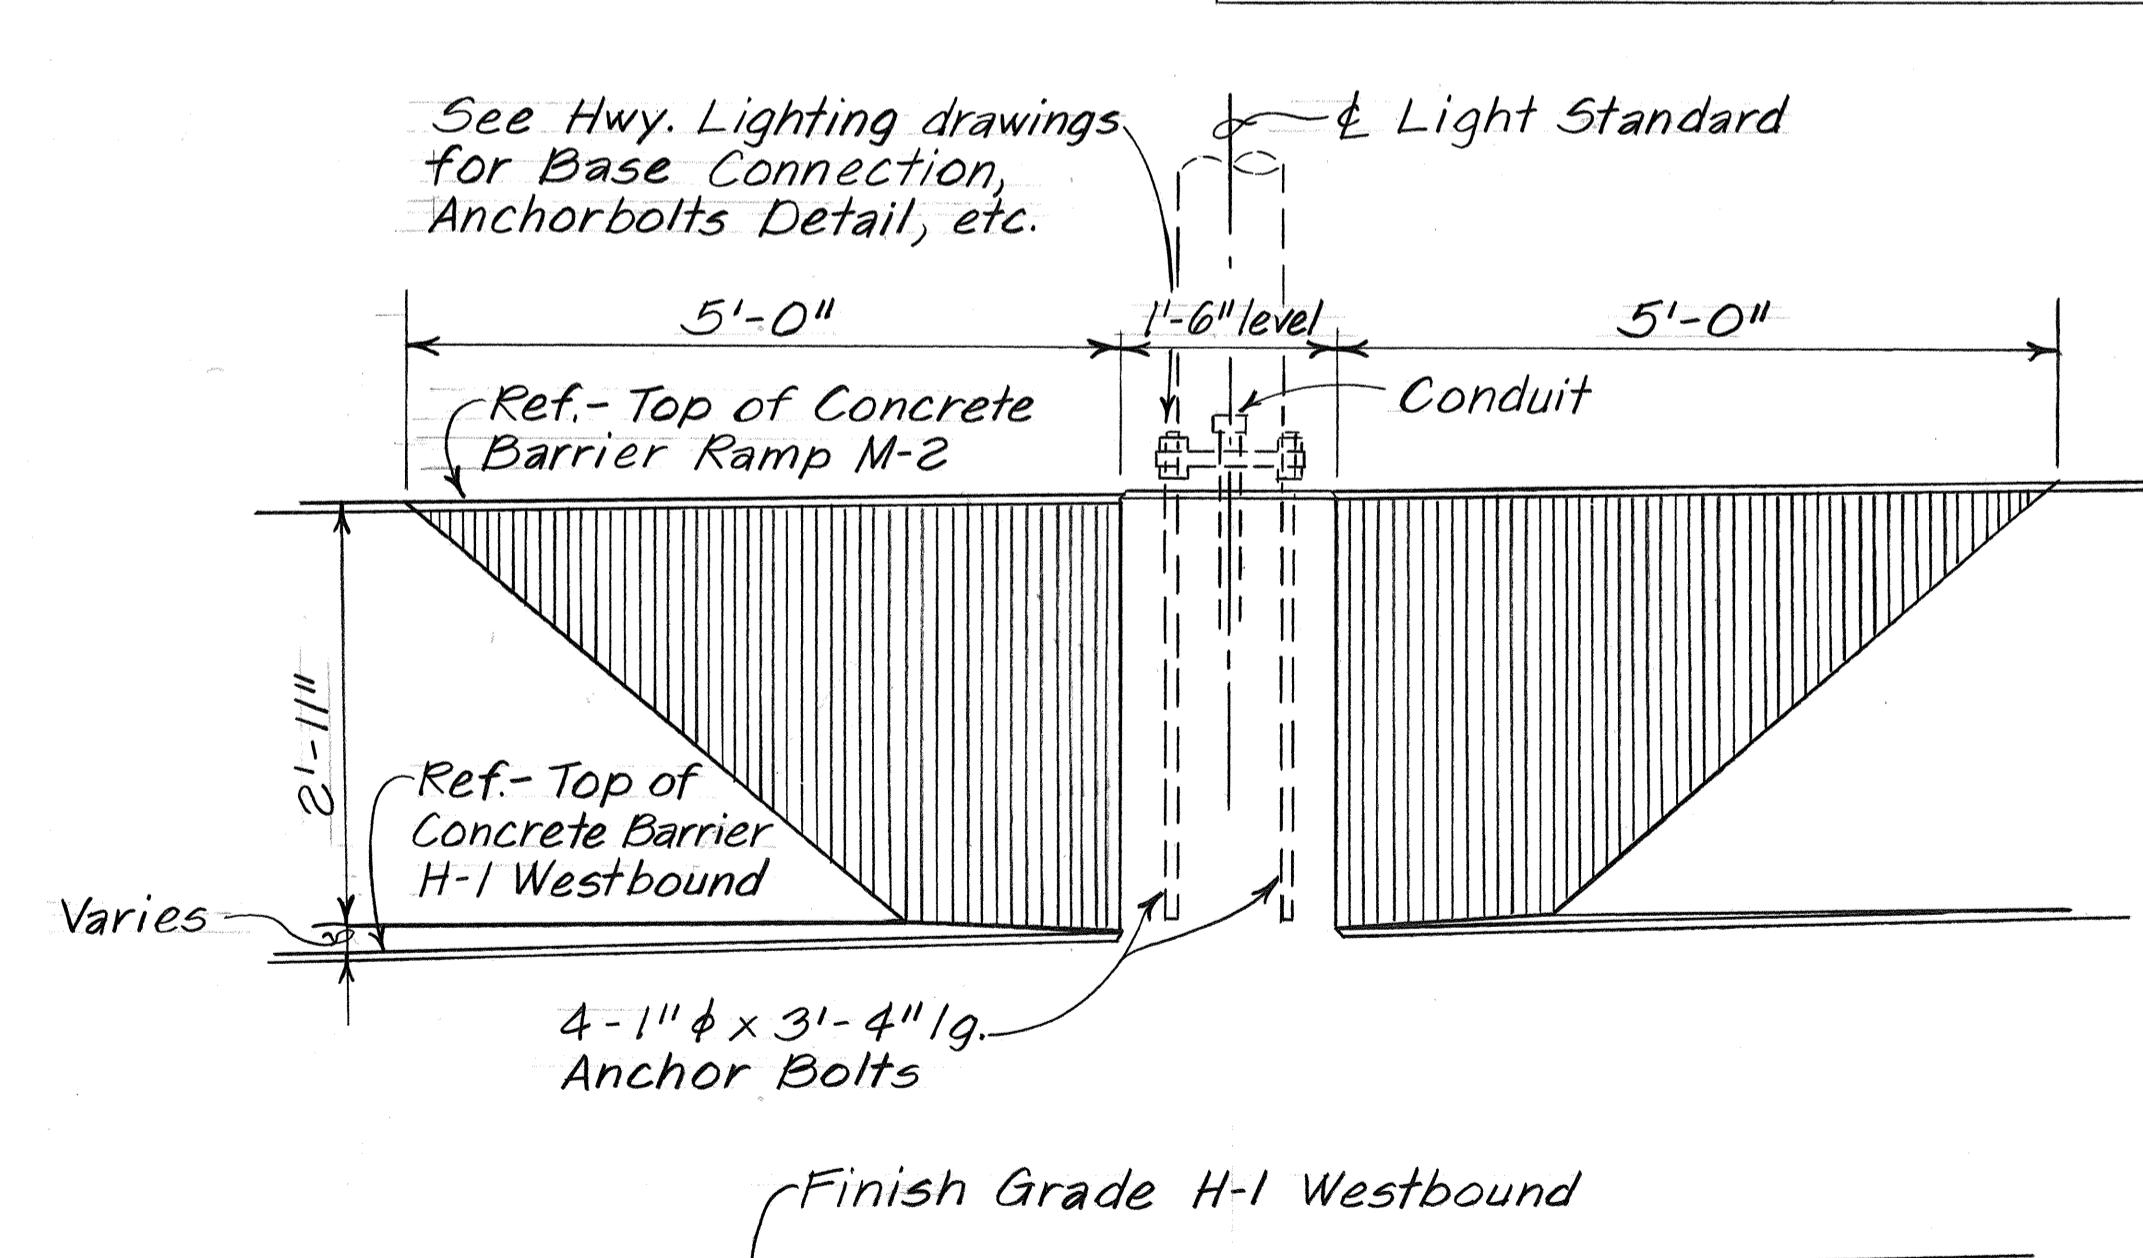

ELEVATION

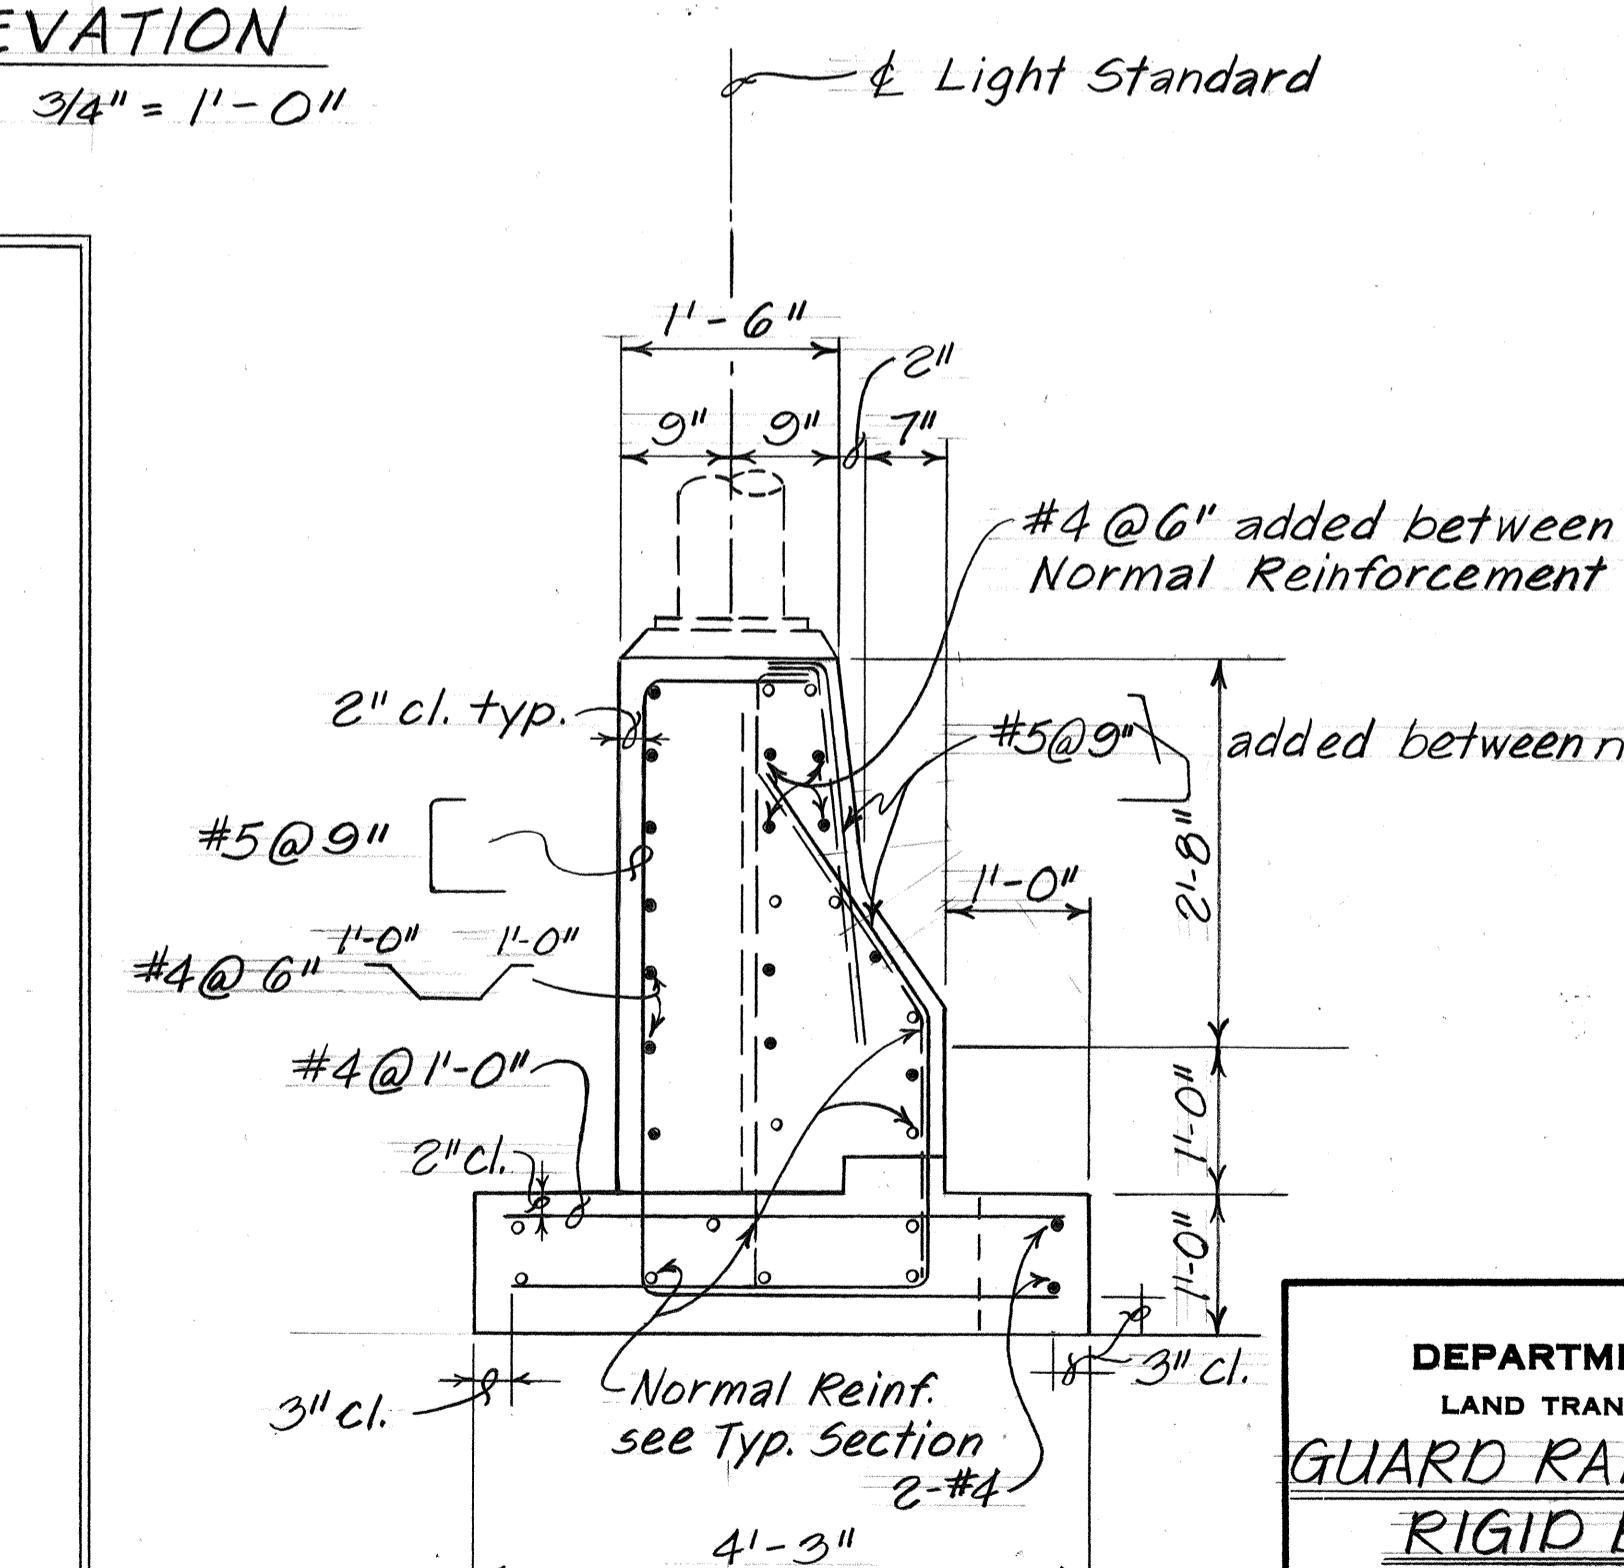


SECTION

Scale: $\frac{3}{4}'' = 1'-0''$


STATE OF HAWAII
DEPARTMENT OF TRANSPORTATION
LAND TRANSPORTATION FACILITIES DIVISION
GUARD RAIL TYPE 4, CONCRETE
RIGID BARRIER DETAILS
INTERSTATE ROUTE H-1 IMPROVEMENTS
MIDDLE STREET TO KALIHI INTERCHANGE
WESTBOUND LANES
F.A.I. PROJ. NO. I-HI-1(187)

D. ROAD ST. NO.	STATE	FED. AID PROJ. NO.	FISCAL YEAR	SHEET NO.	TOTAL SHEETS
HAWAII	HAW.	I-HI-1(187)	1984	30	197

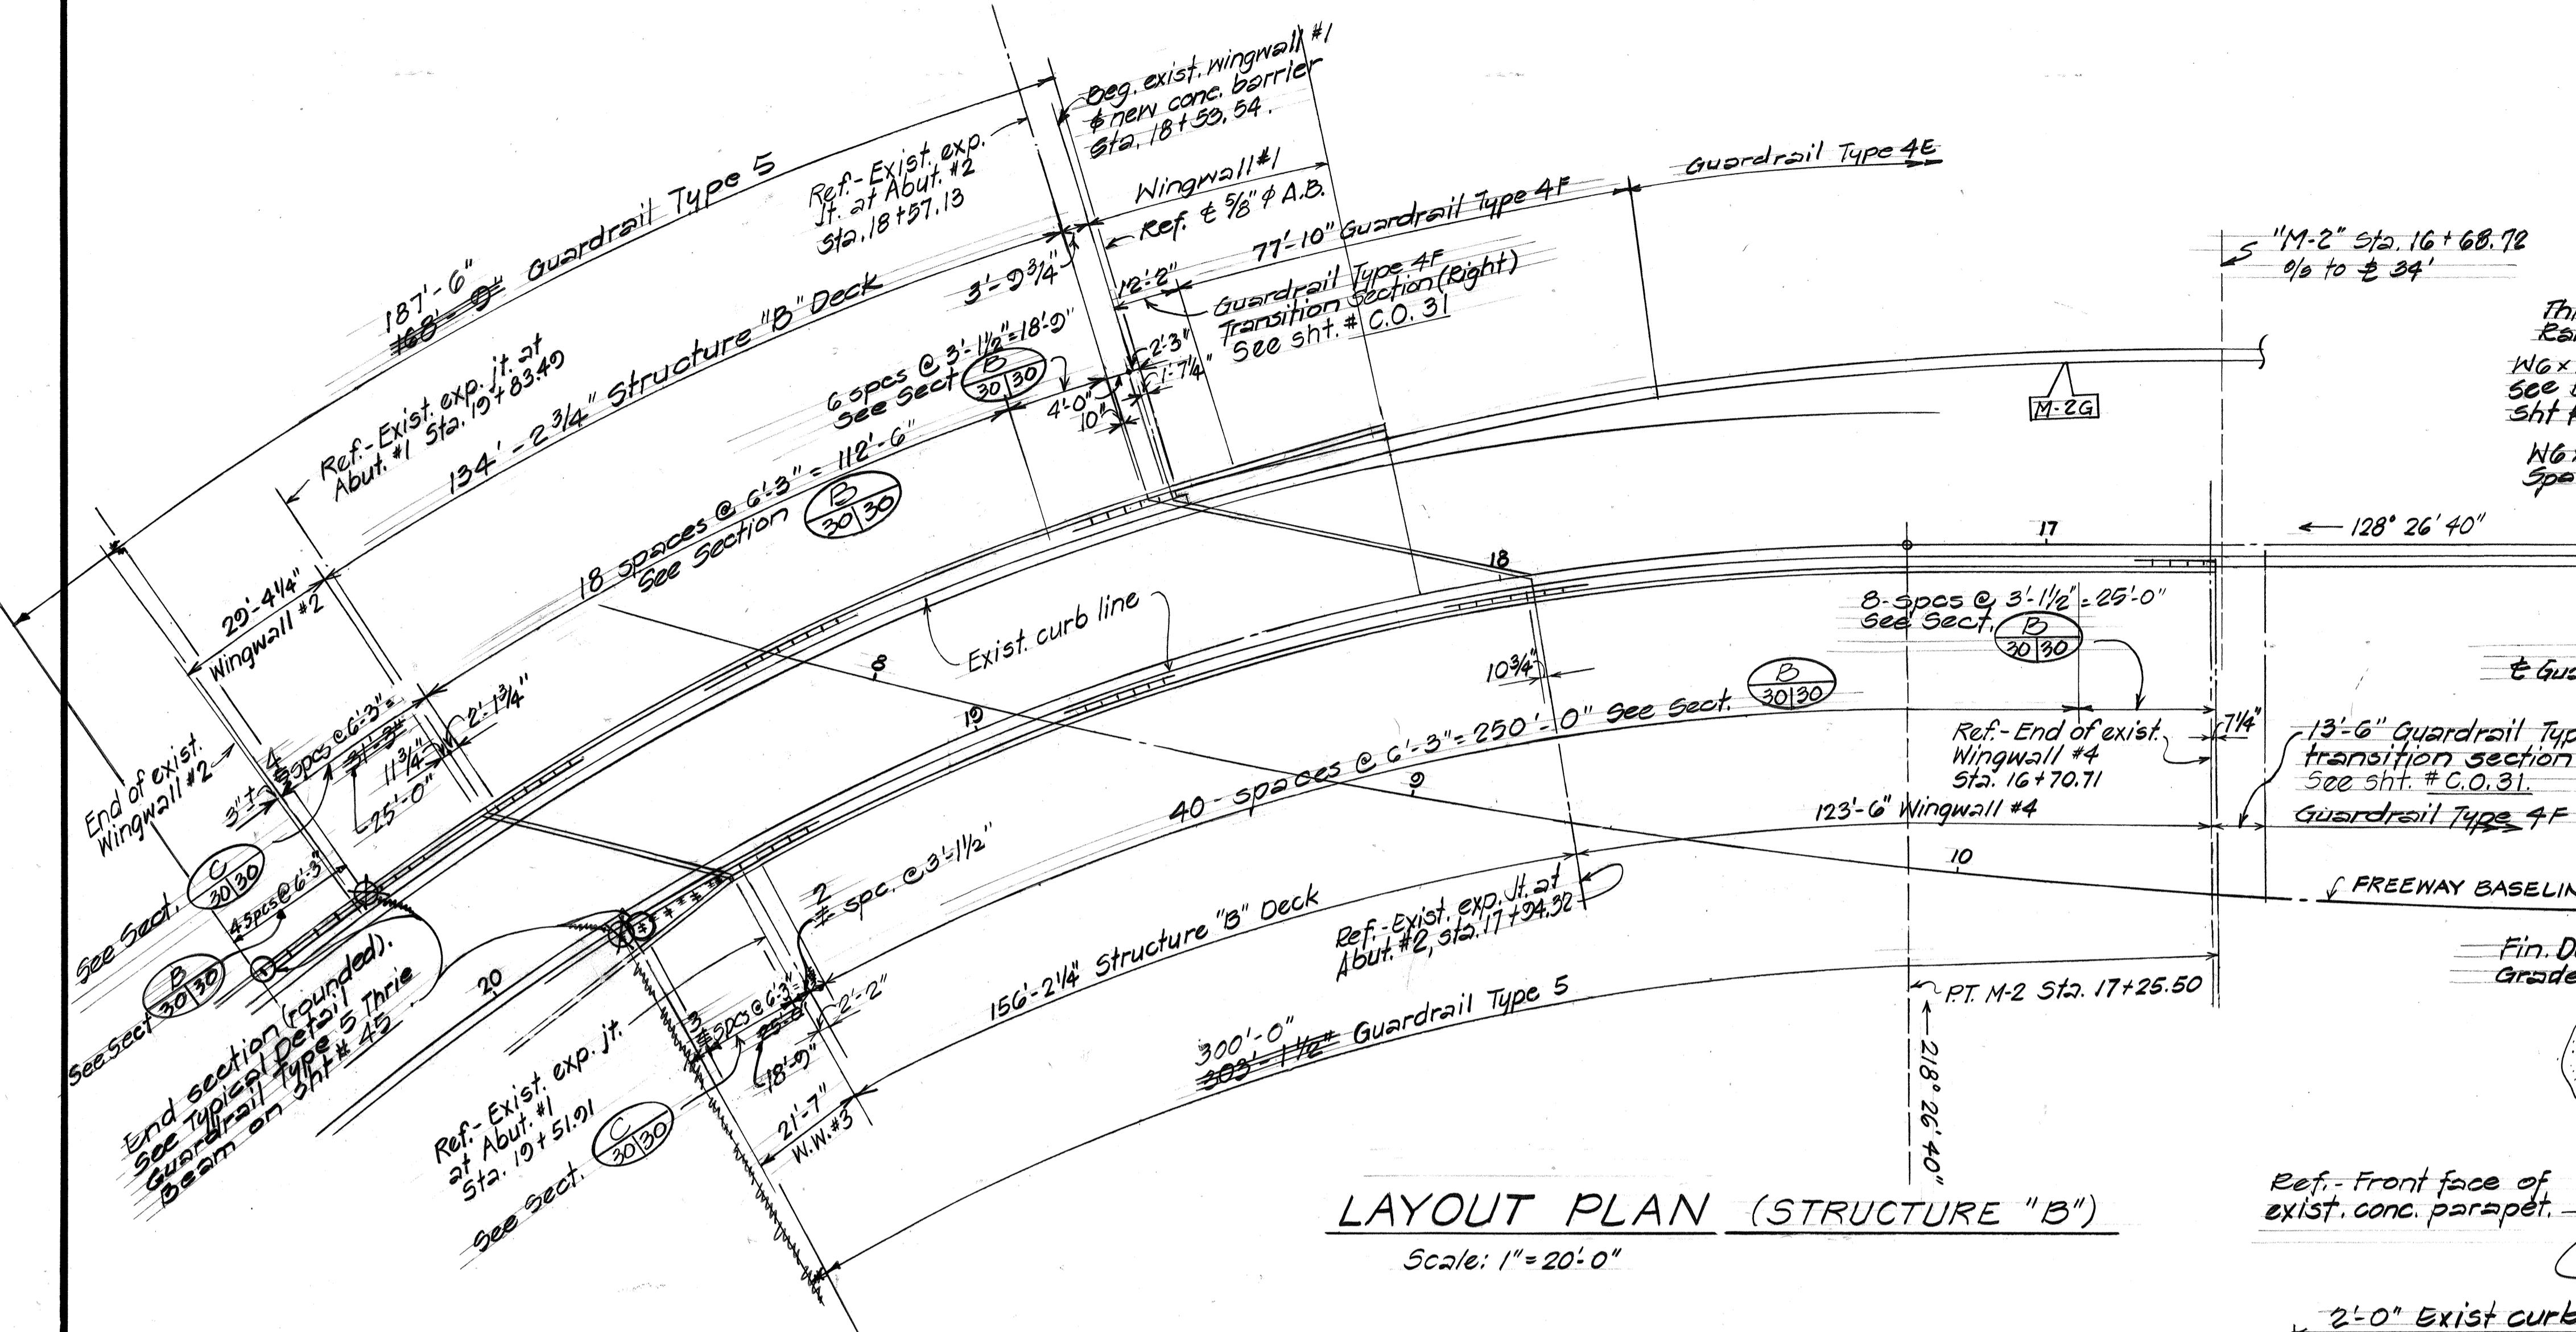

AYOUT PLAN (STRUCTURE "B")

Scale: 1" = 20'-0"

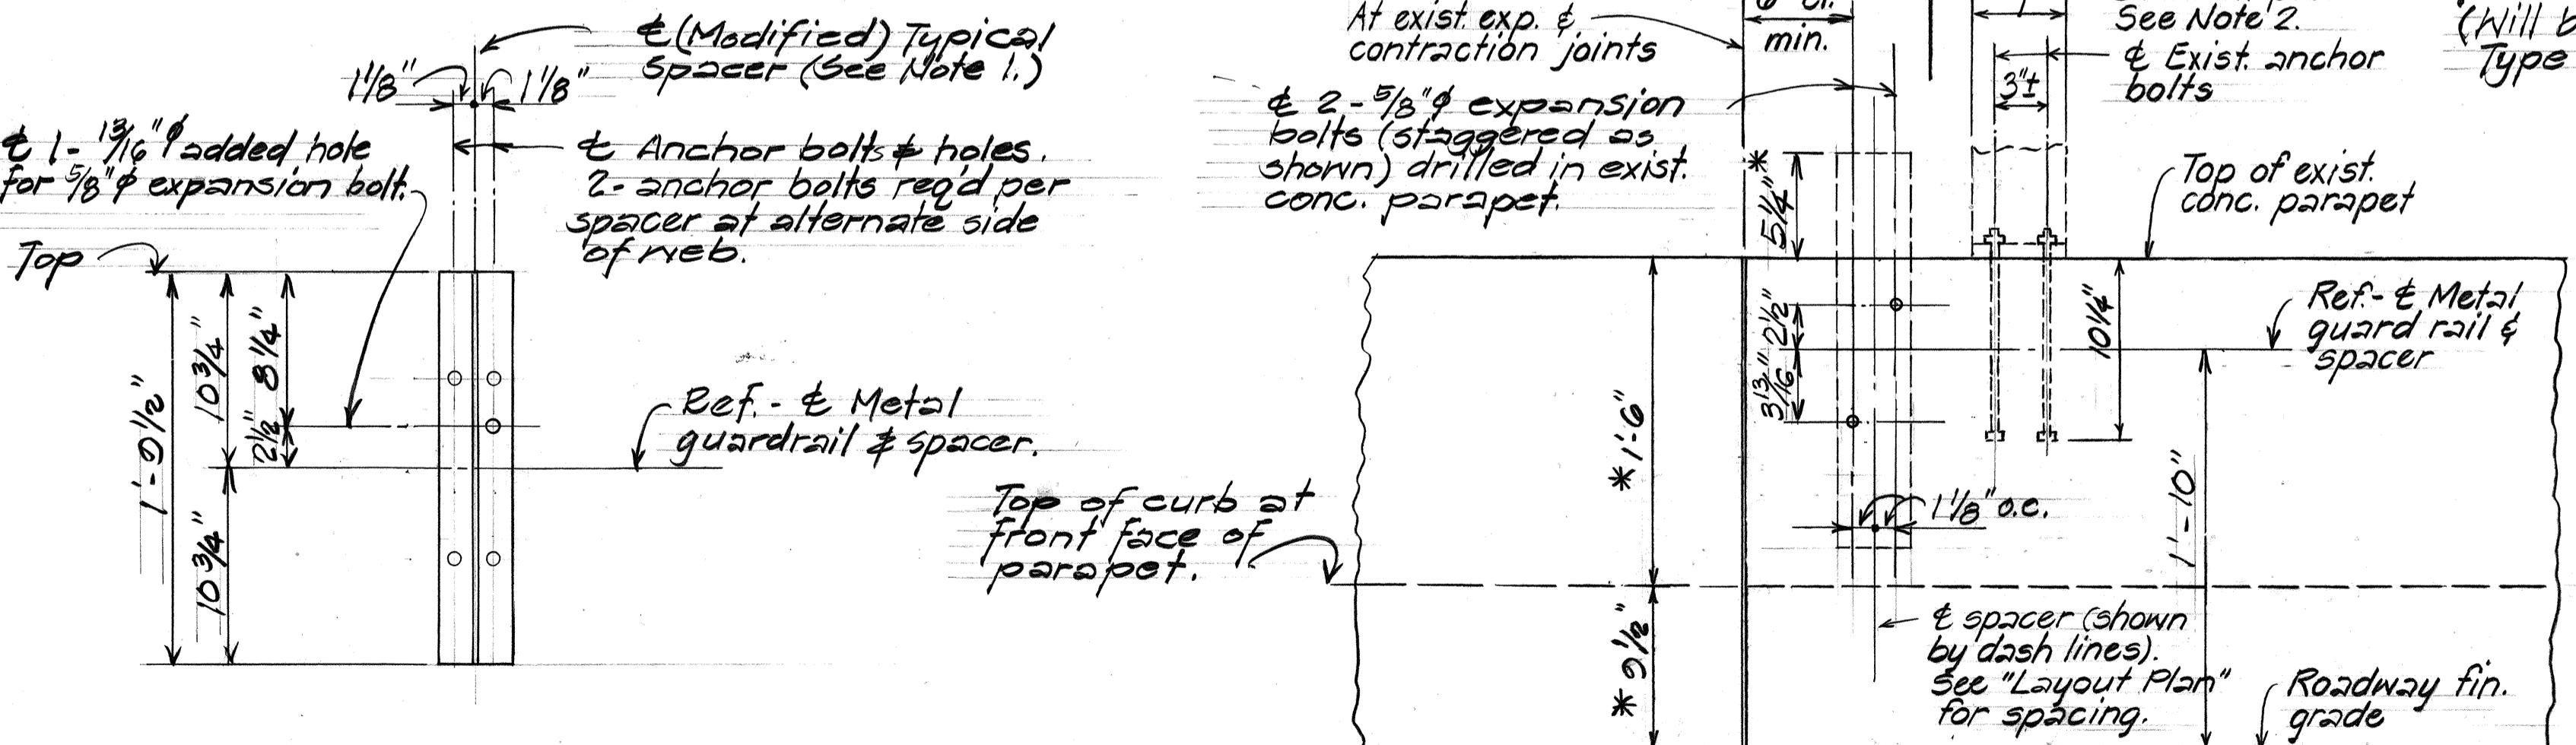


SECTION A-A

FRONT VIEW

TYPICAL SPACER AND PLACEMENT DETAIL

Scale: $1\frac{1}{2}'' = 1'-0''$

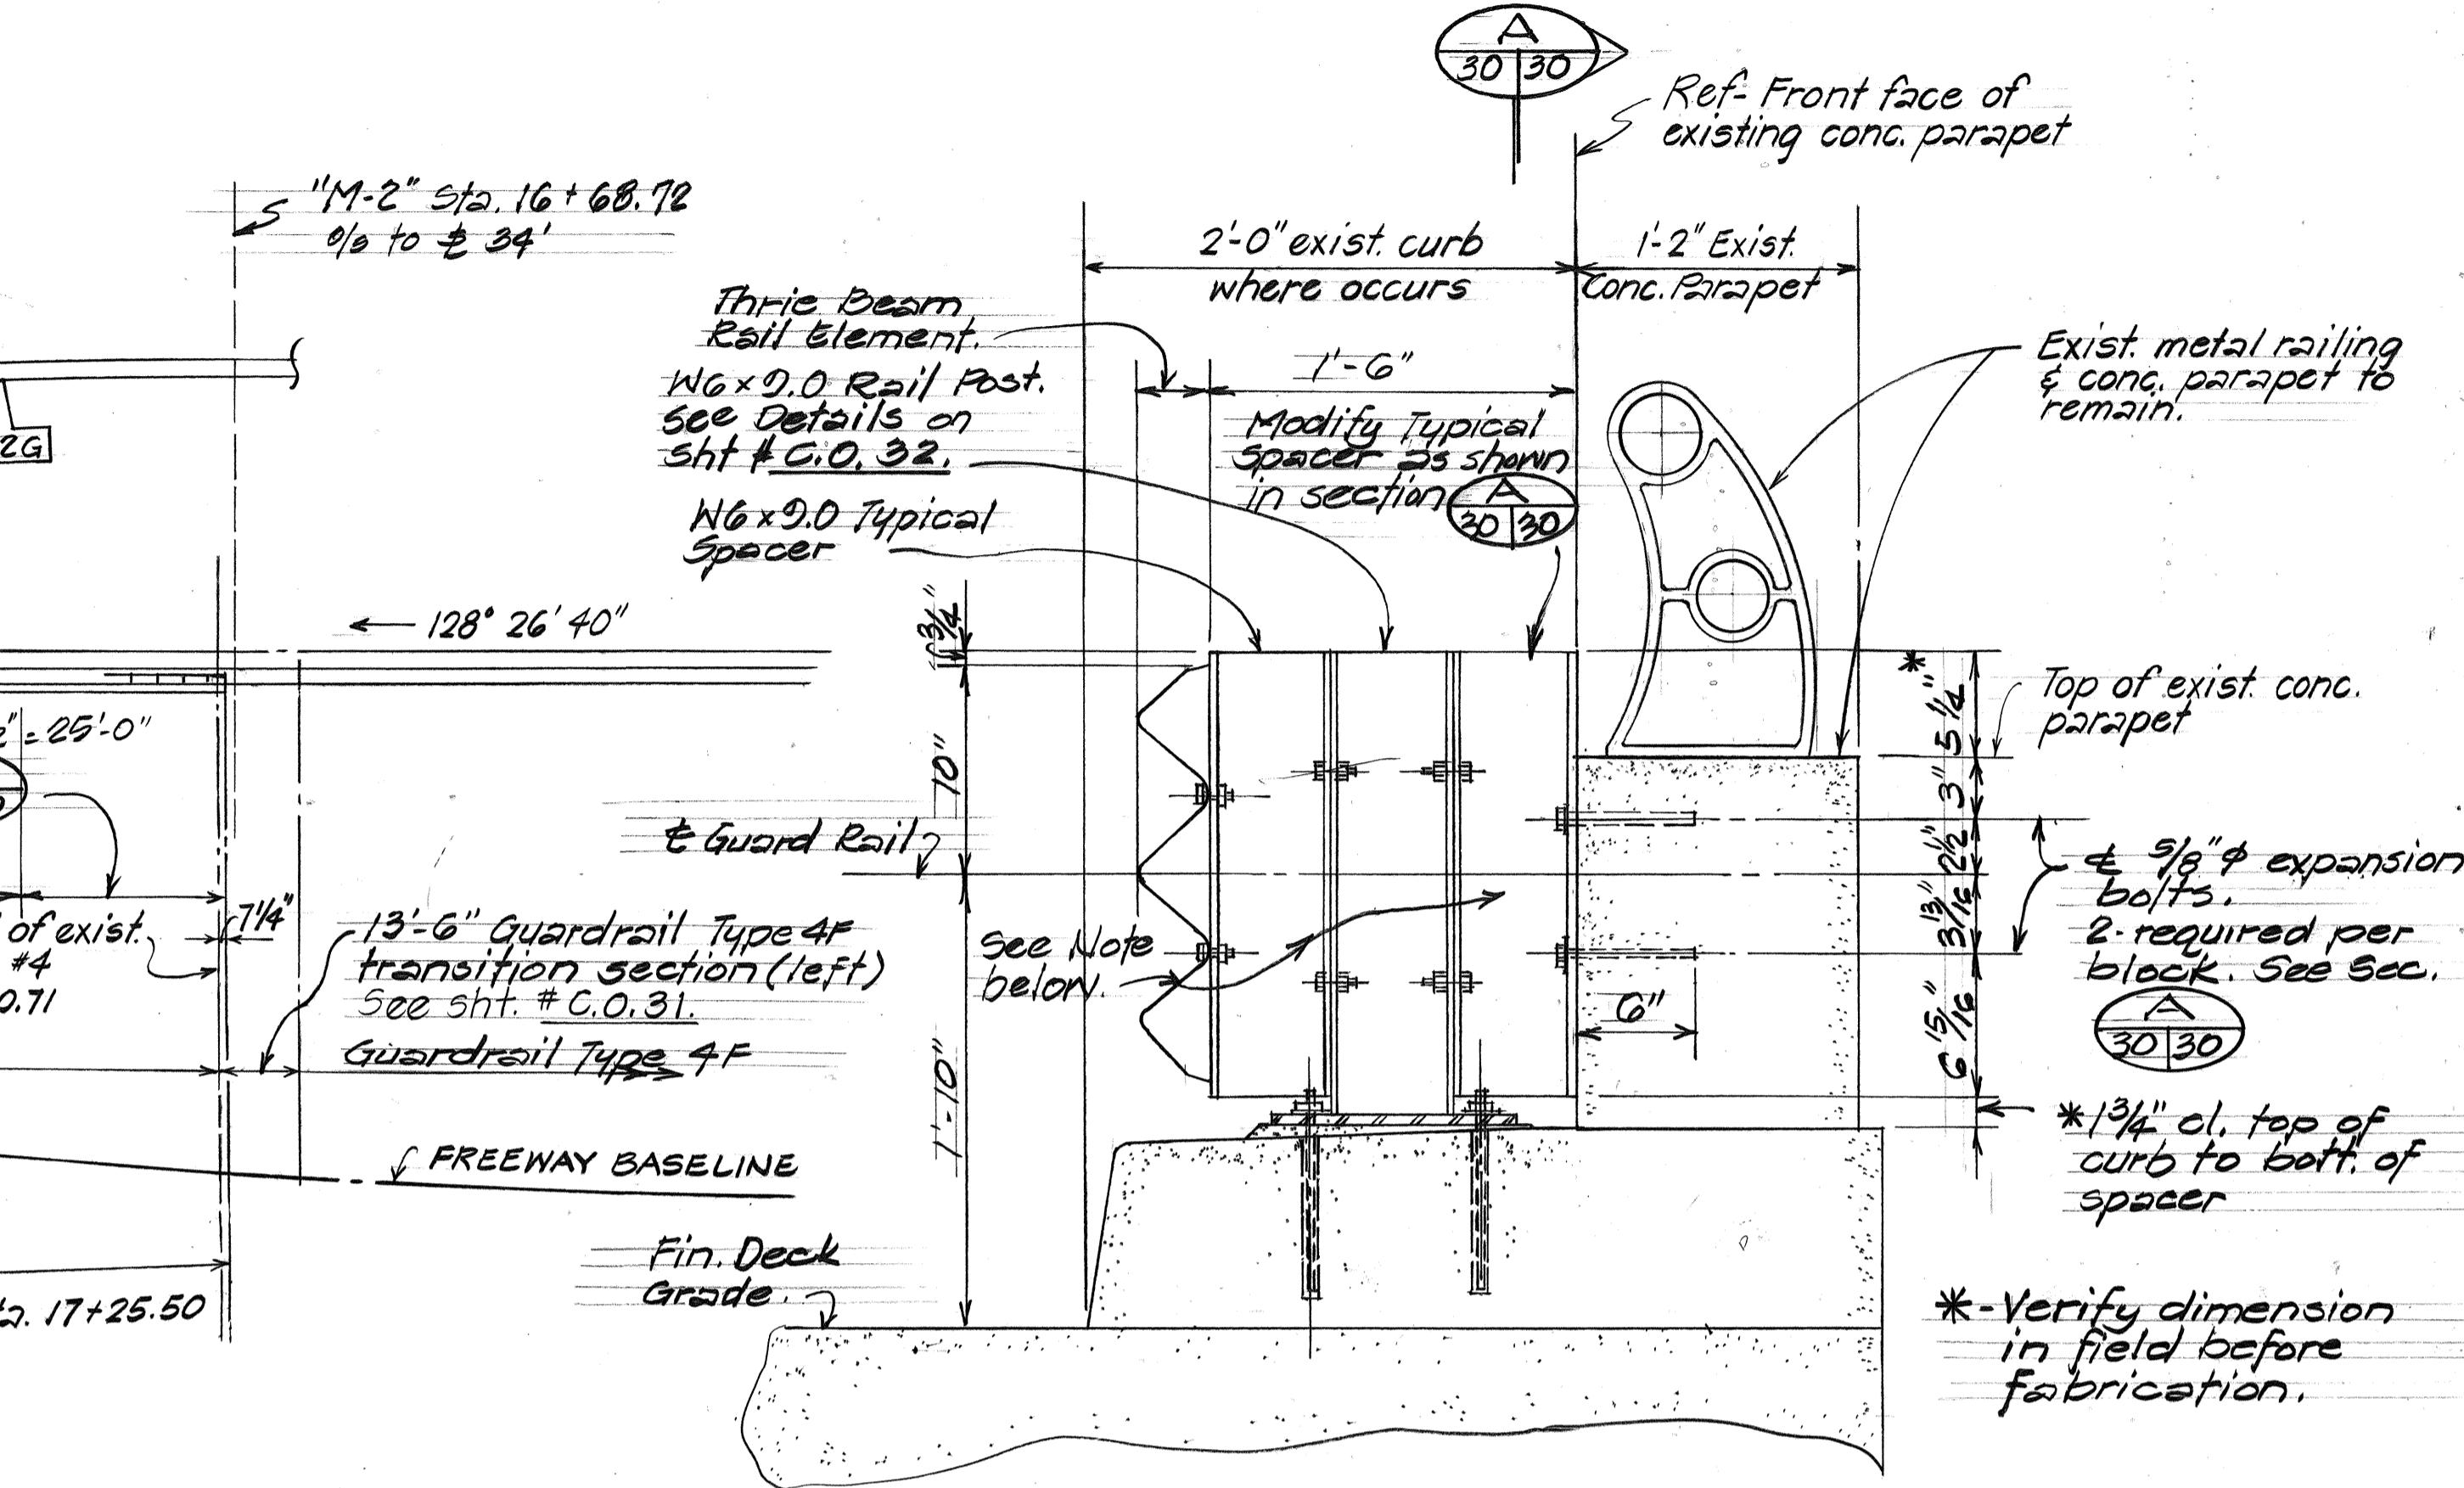


SECTION

~~2/3~~/ ϵ : $1\frac{1}{2}'' = 1\frac{1}{2}0''$

Notes:

1. For additional Thrie Beam details and information, see Sht # 45.
2. Care shall be taken when drilling next to existing rail post so as not to damage the existing anchor bolts.

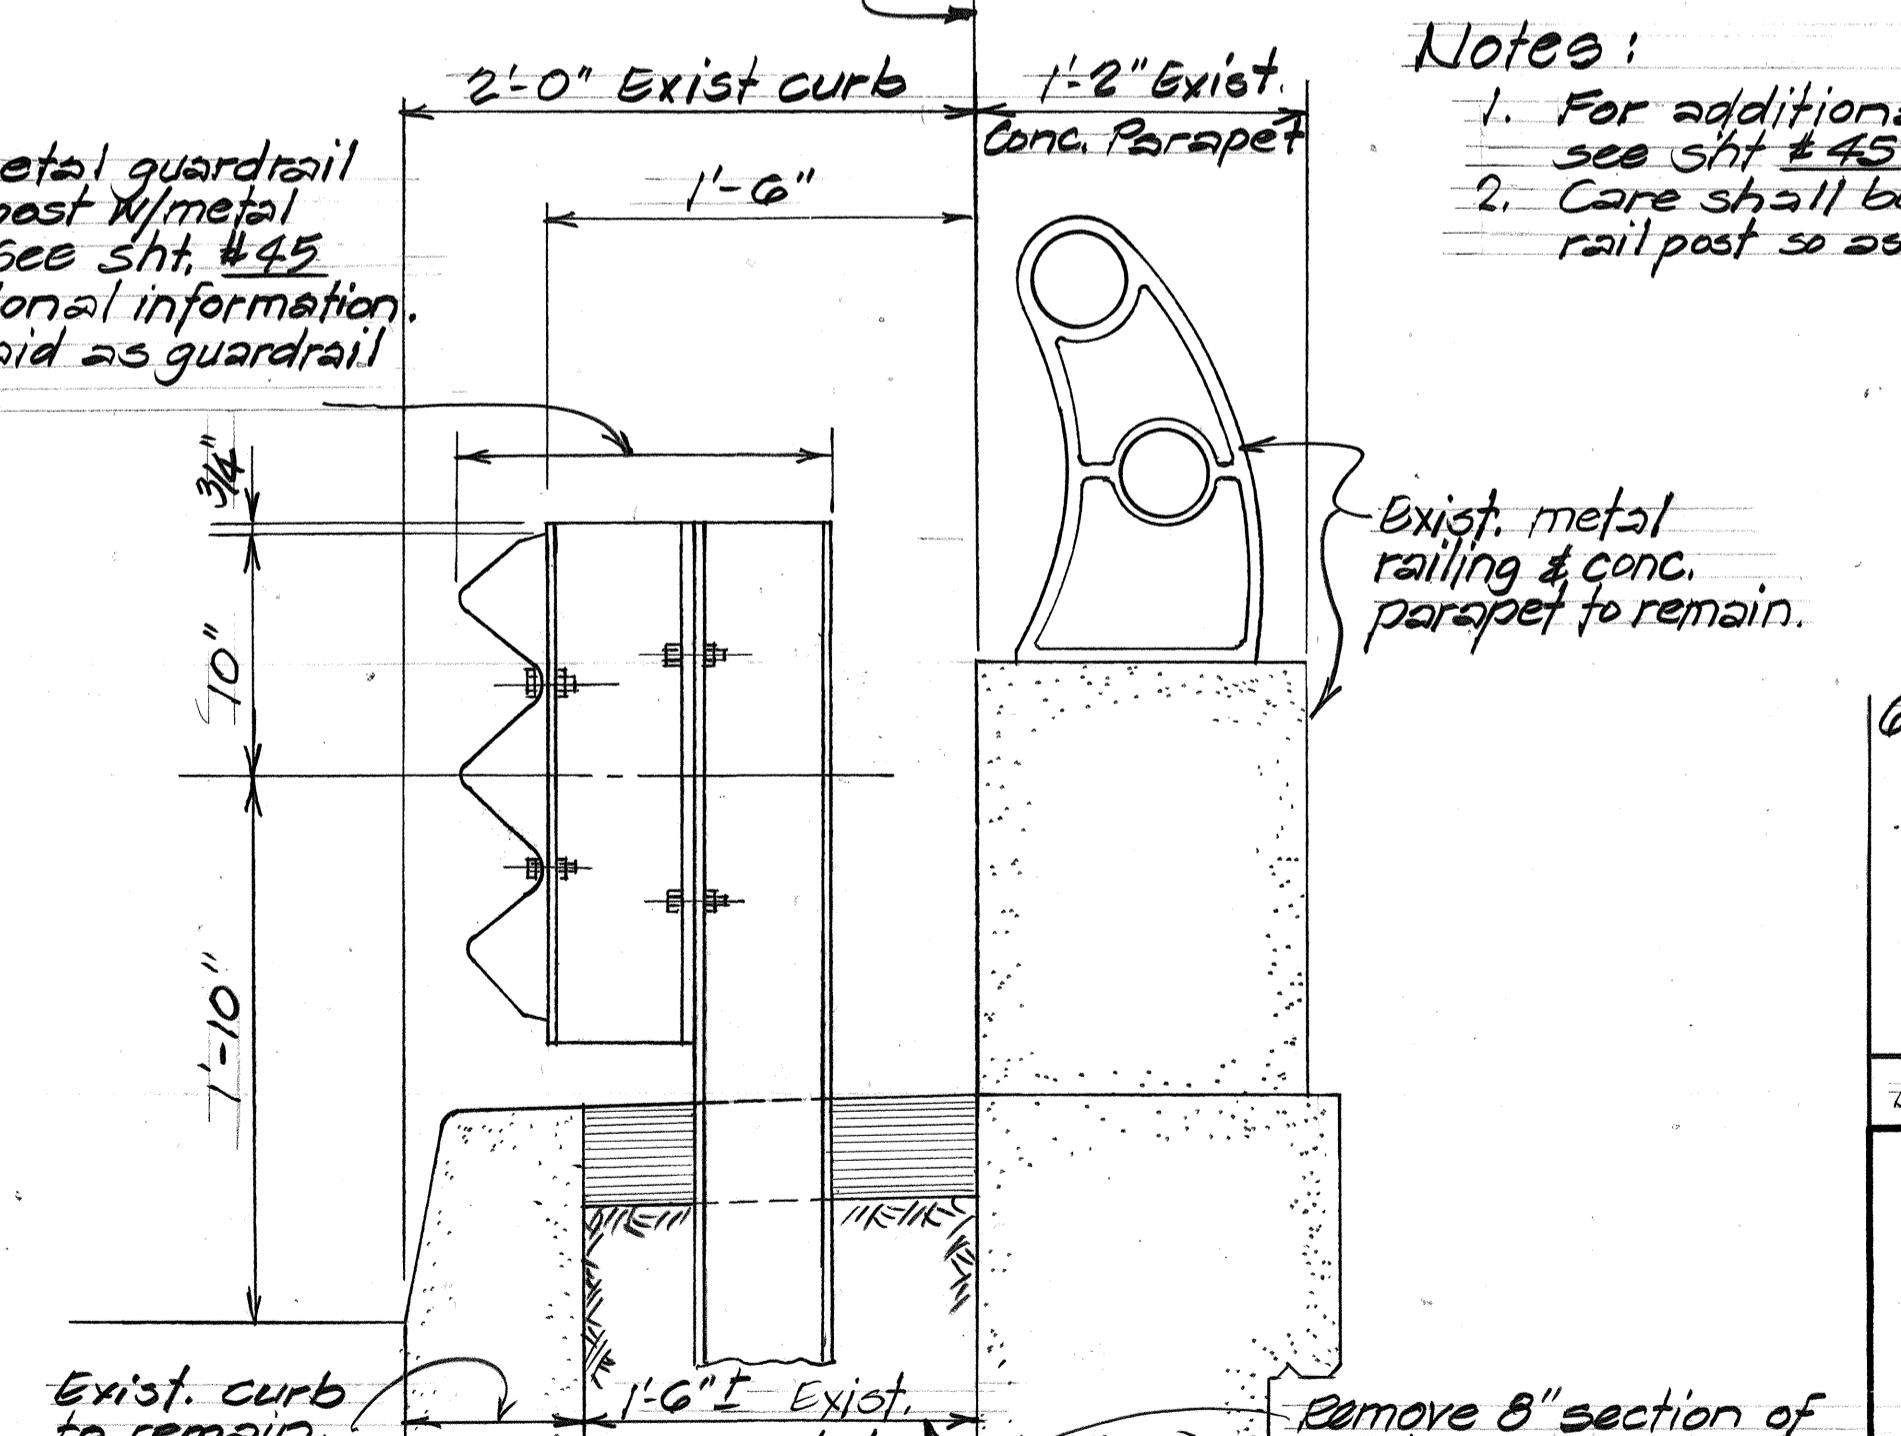

SECTION C

remove 8" section of
exist. conc. slab at
each rail post. Fill &
dress resulting depression
with A.C. to match
exist. curb finish grade
incidental to guardrail
Type 5).

12/84 W Beam metal guardrail changed to Three Beam, and alignment, spacing & mounting of guardrail revised. Also section C added.

30 | 30

Revised

STATE OF HAWAII
DEPARTMENT OF TRANSPORTATION
LAND TRANSPORTATION FACILITIES DIVISION

GUARDRAIL TYPE 5

LAYOUT PLAN & DETAILS

INTERSTATE HI IMPROVEMENTS
MIDDLE STREET TO KALIHI INTERCHANGE
WESTBOUND LANES


F.A.I. PROJ. NO. I-HI-1(187)

As Shown Date: June 1983

SHEET NO. OF SHEETS


FED. ROAD DIST. NO.	STATE	FED. AID PROJ. NO.	FISCAL YEAR	SHEET NO.	TOTAL SHEETS
HAWAII	HAW.	I-HI-1(187)	1984	31	197

exist. holes. Fill holes w/mortar
Finish smooth & flush w/exist.
end post face.

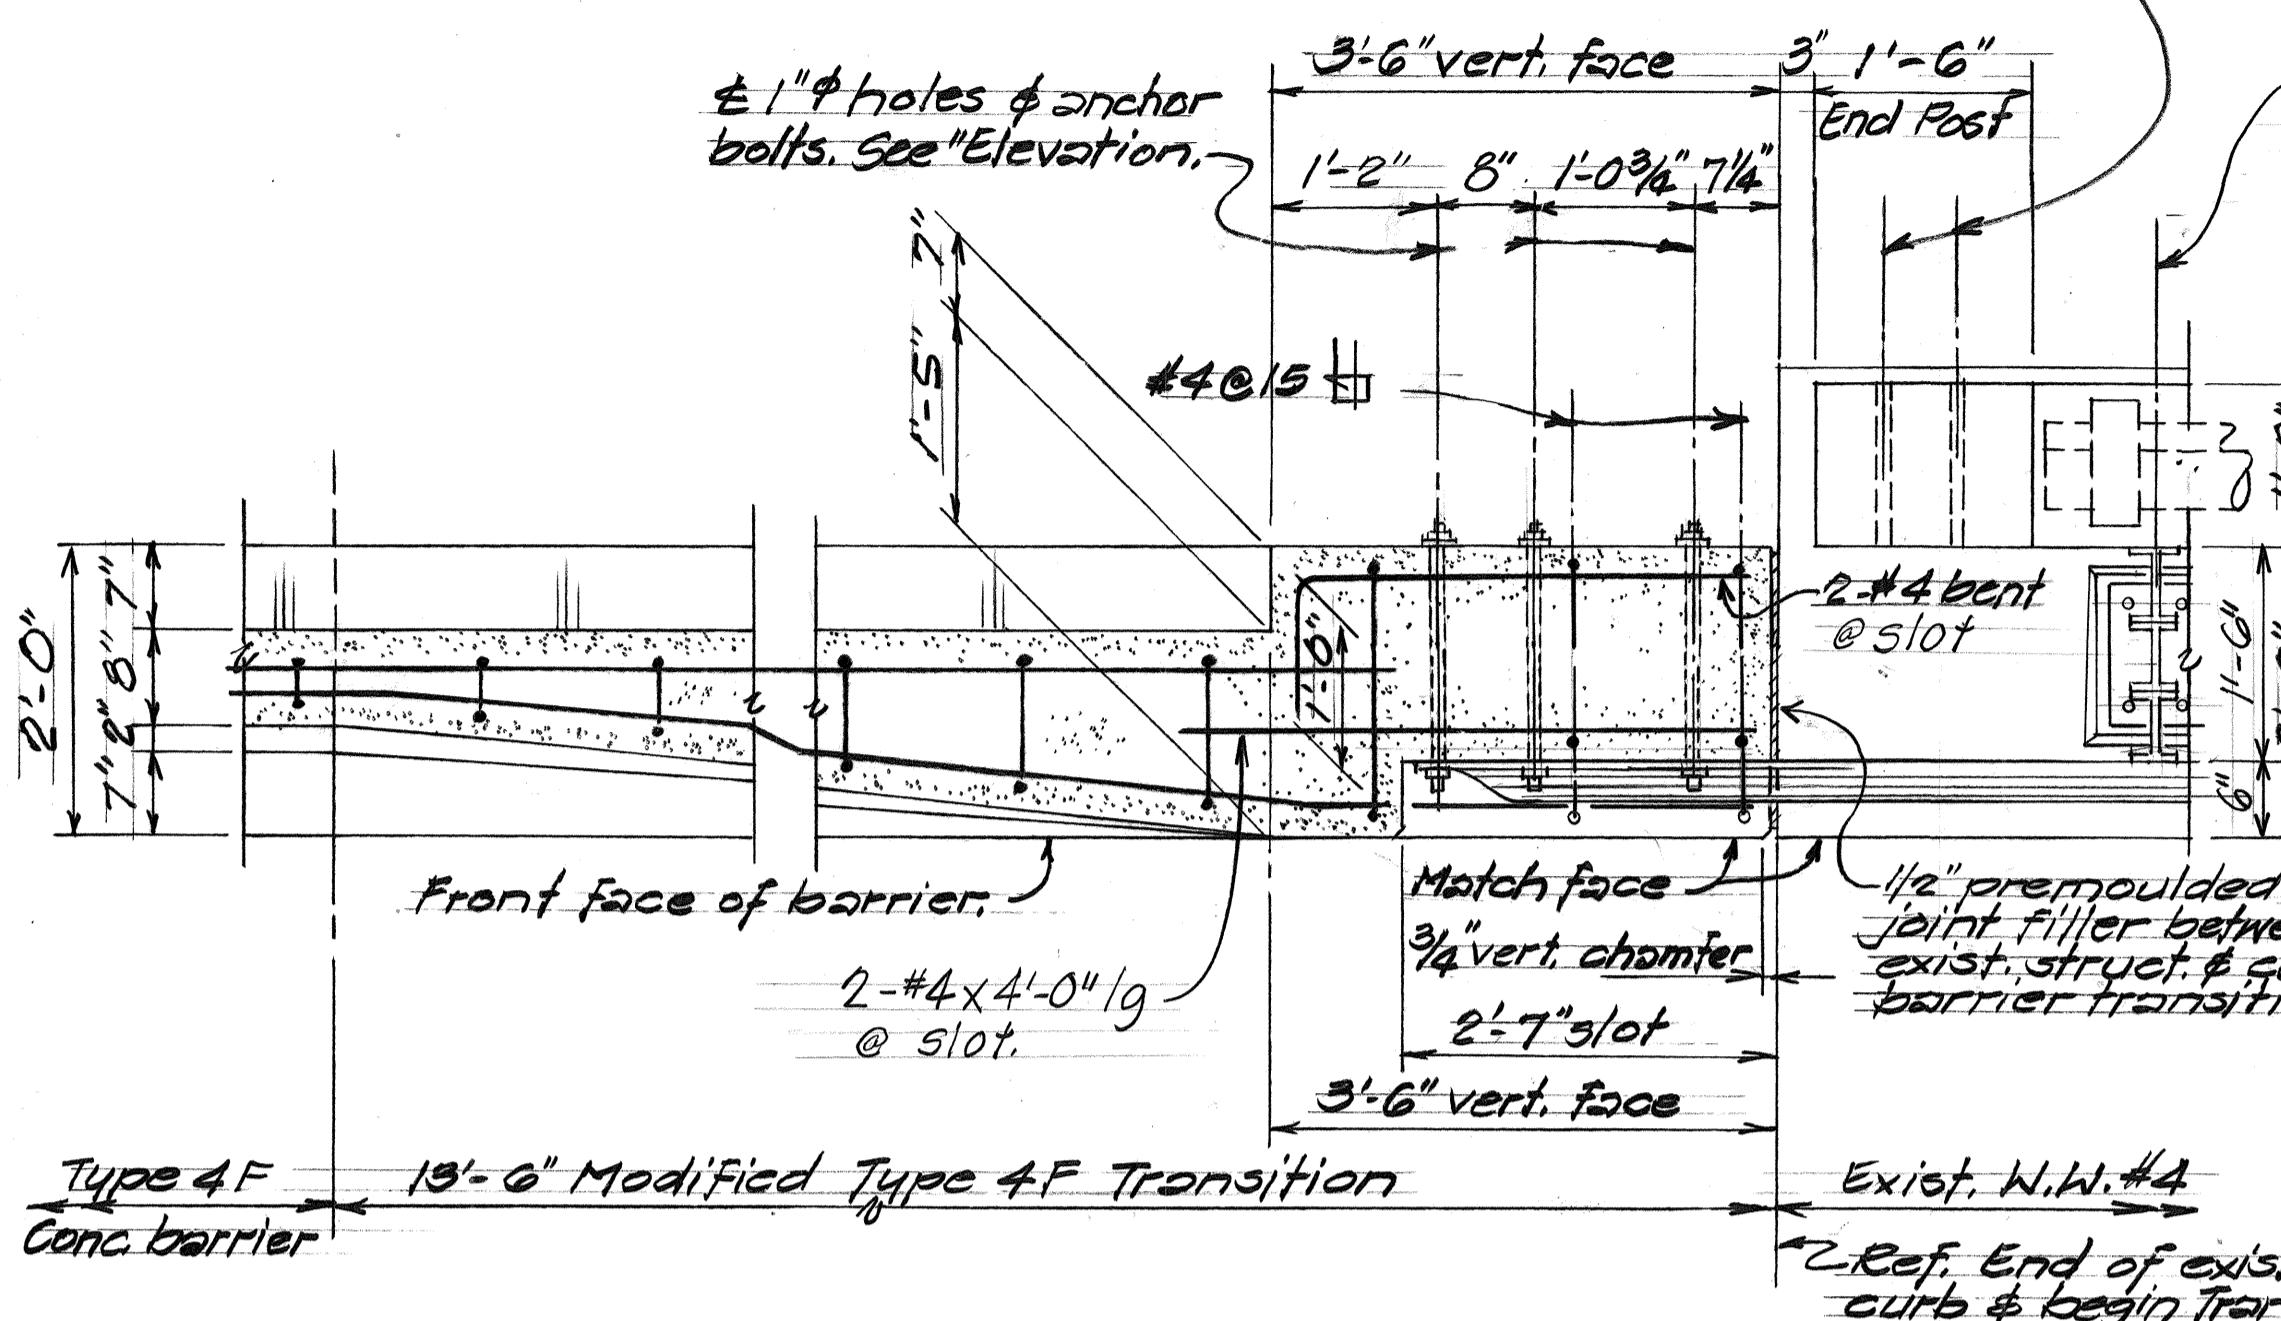

PLAN ~ (LEFT)

Ref. exist. abut.
#2 exp. jt. line Exist. bridge curb to remain. Remove exist. curb.
Sta. 18+57.13.

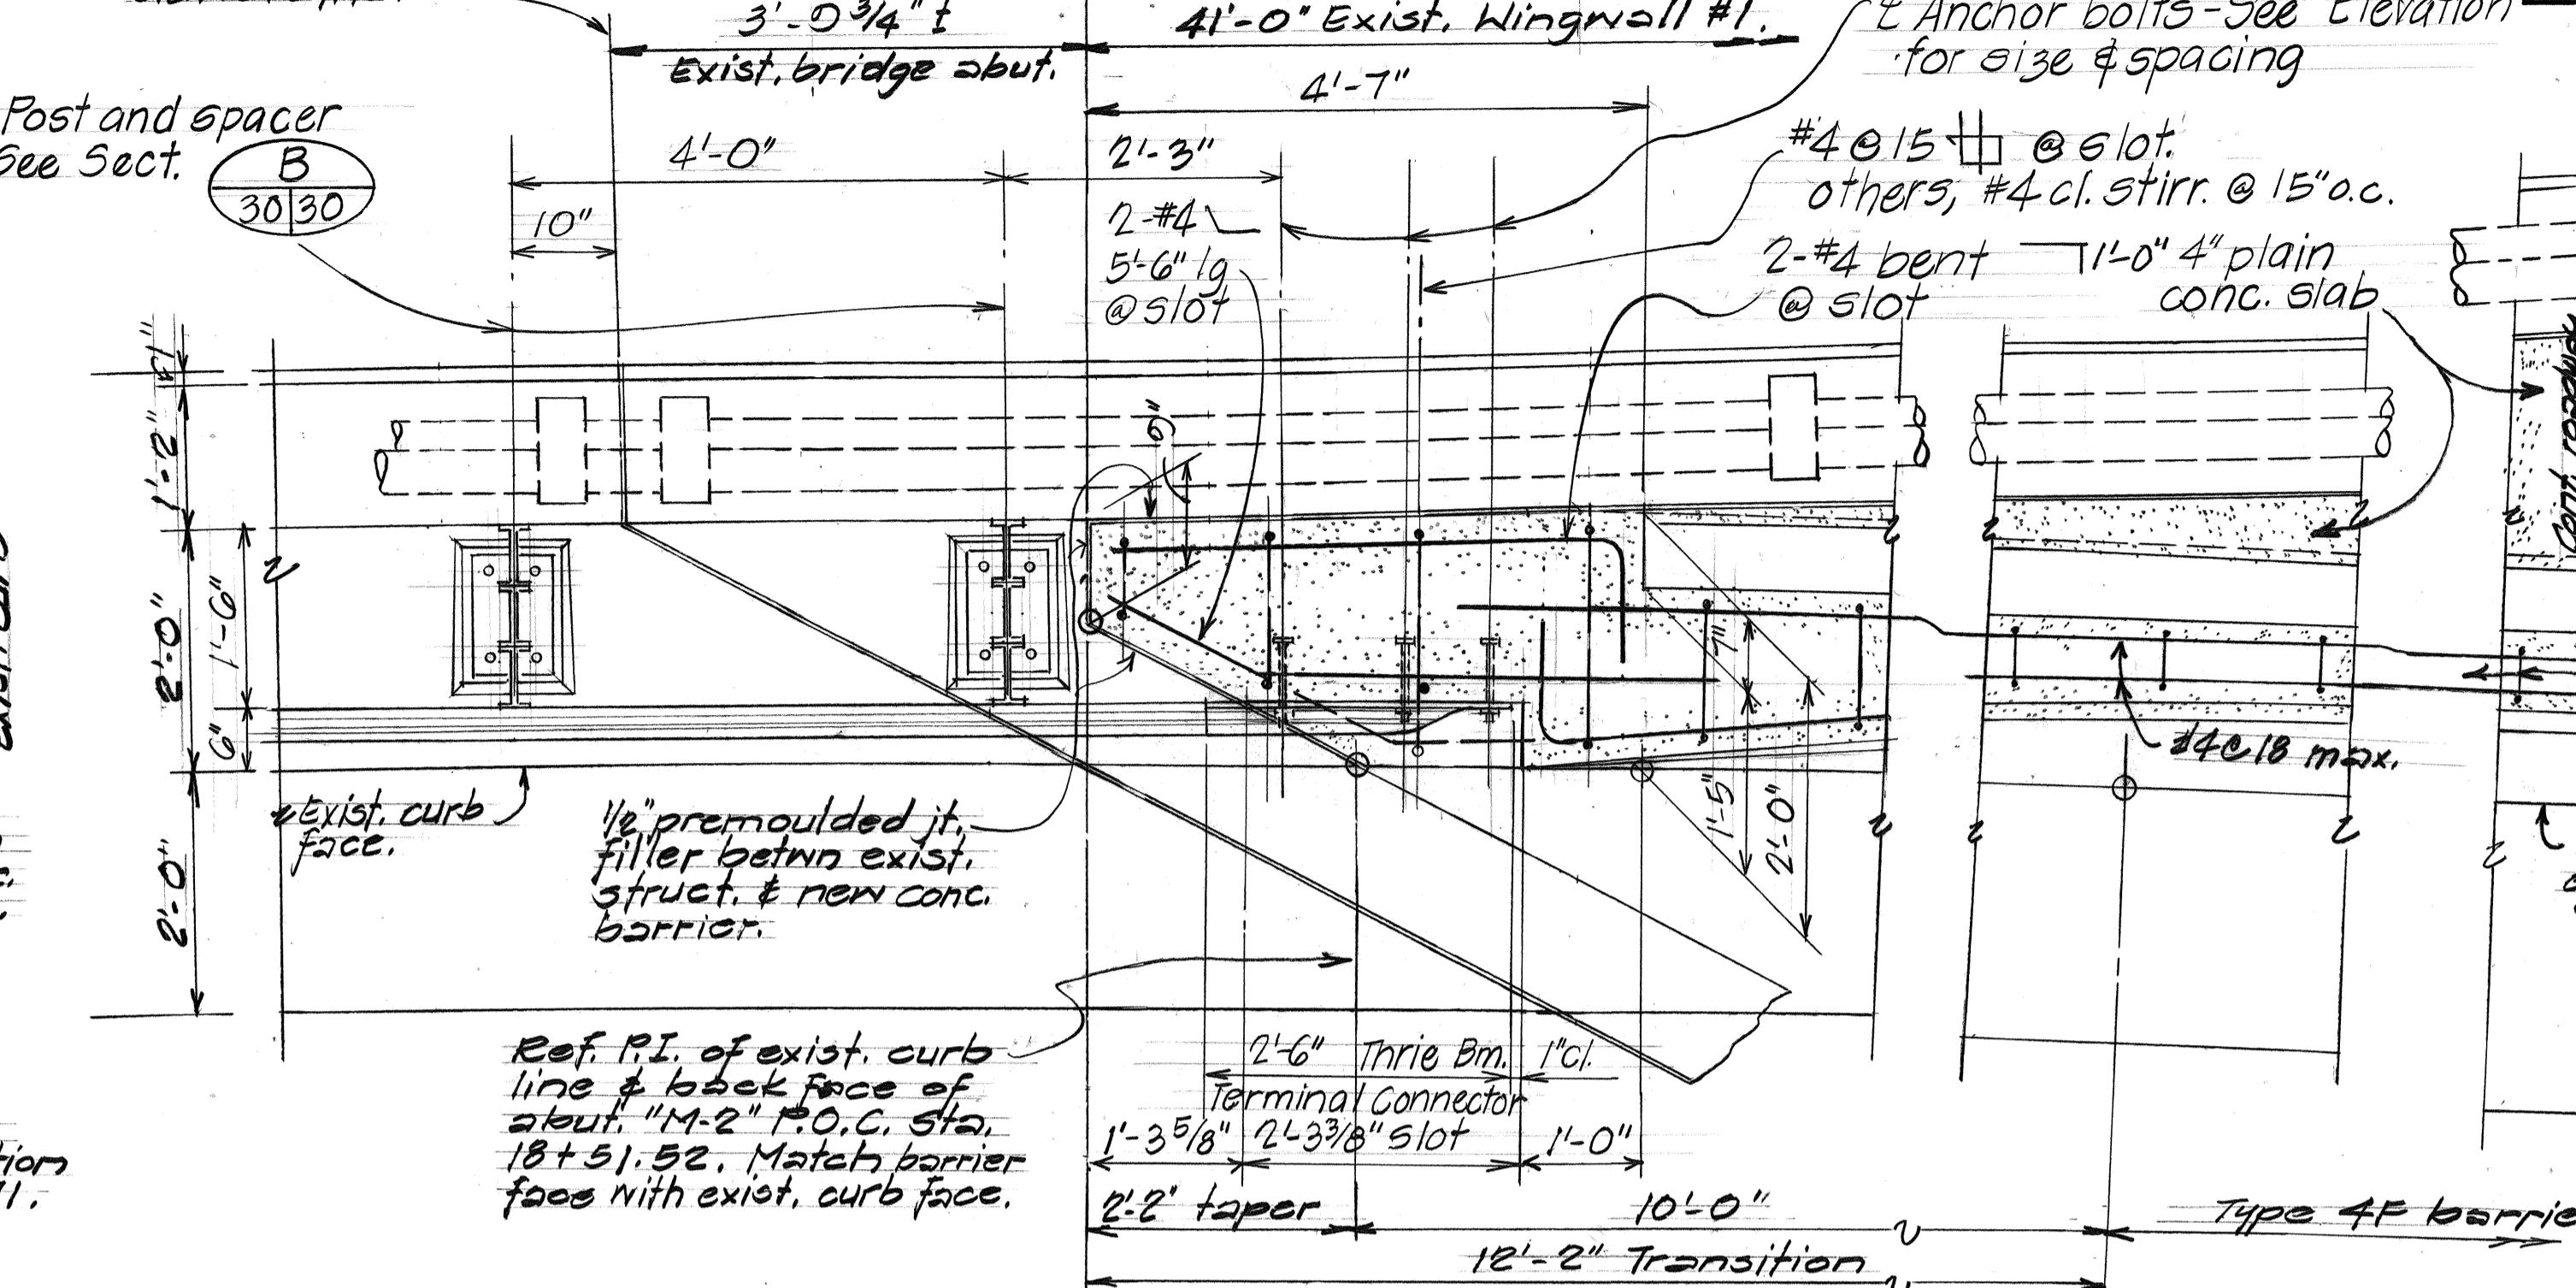

PLAN ~ (RIGHT)

B
31 32

A
31 32

Ref. End of exist. W.W. #4

Guardrail Type 4P

*13'-6" Modified Type 4F Transition section

Exist. W.W. #4

10'-0" varying face

3'-6" vert. face

3" 1'-0"

End Post

3'-1 1/2"

Top of barrier

Ref. & metal guardrail.


Thrie Bm. Terminal Connector

1/2" Premolded Joint filler

ELEVATION ~ (LEFT)

Ref. exist. abut. #2
exp. j/f. line. "M2"
5ft. 18 + 57.13. ↗

"M.2" 5ft. 18 + 53.54
Beg. exist. NW #1. ↗

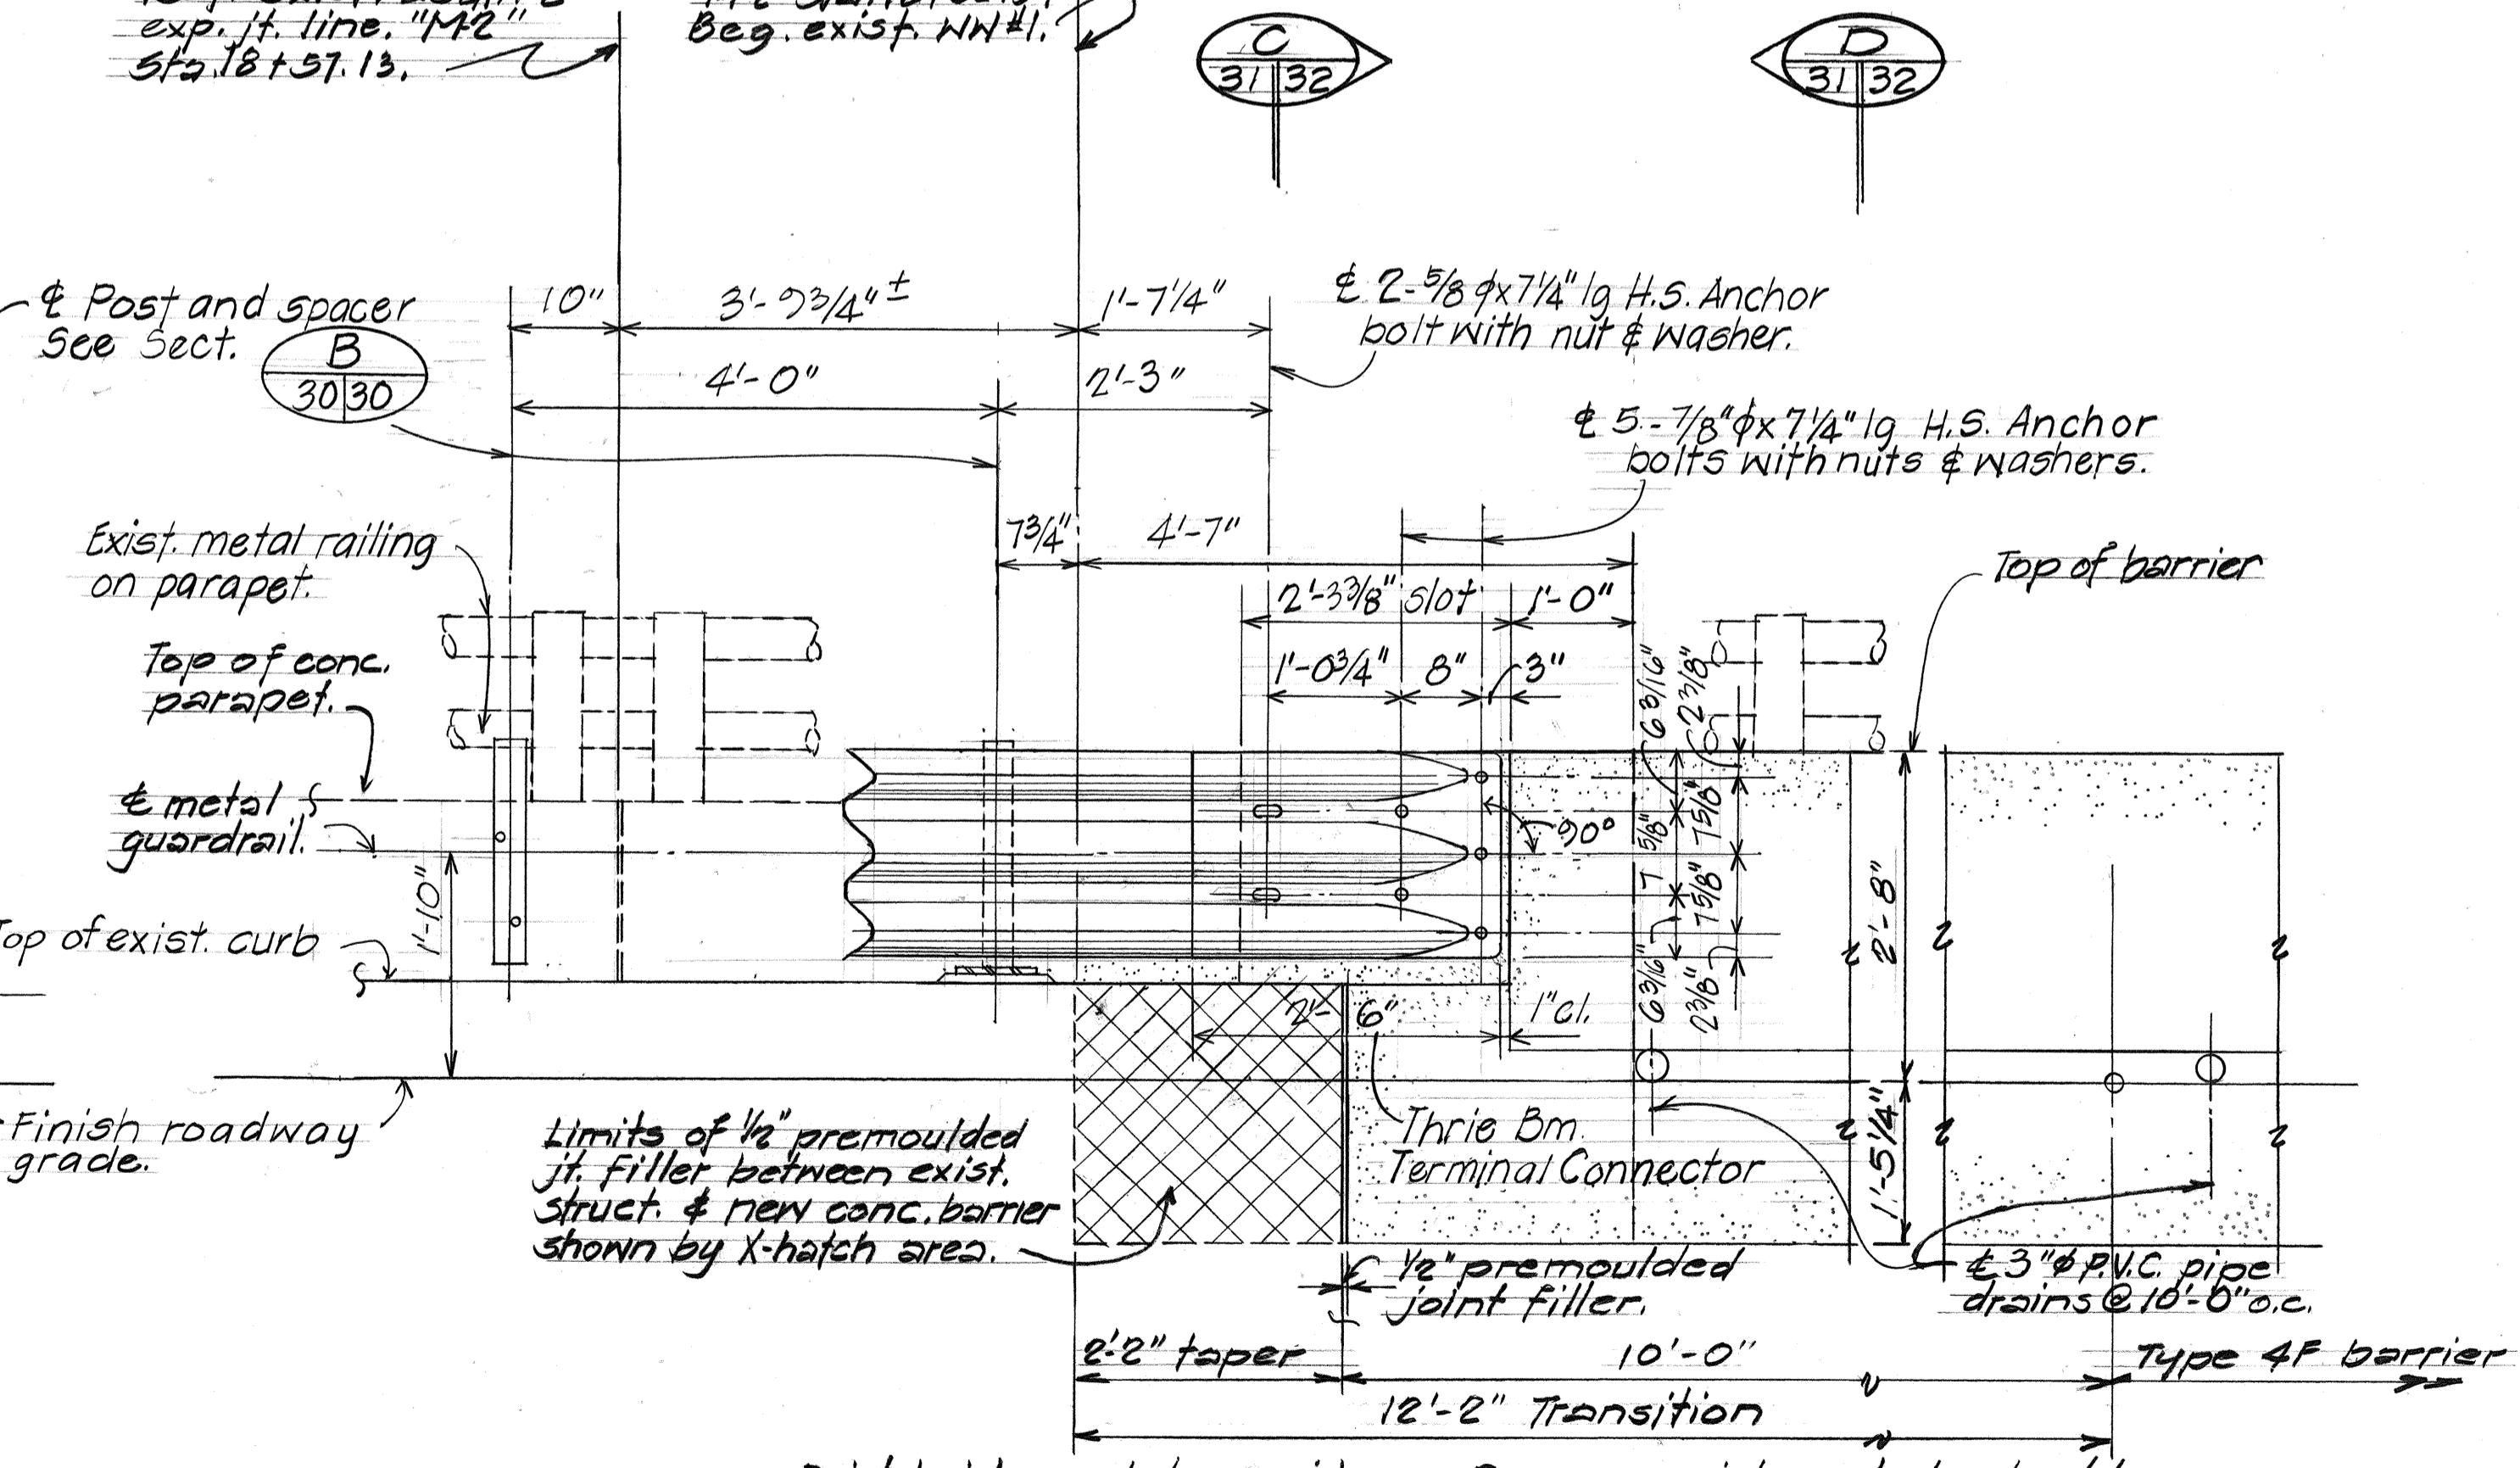

ELEVATION ~ (RIGHT)

6/12/84 (Left & right) "Plan" & "Elevation" revised to accomodate change in metal guard rail alignment, spacing & configurations.

Date	Revision
------	----------

**STATE OF HAWAII
DEPARTMENT OF TRANSPORTATION**

**DEPARTMENT OF TRANSPORTATION
LAND TRANSPORTATION FACILITIES DIVISION**

DETAILS ~ GUARDRAIL TYPE 4

TRANSITION SECTION

INTERSTATE HI IMPROVEMENTS

MIDDLE STREET TO KAI'IHI INTERCHANGE

WESTBOUND LANES

F.A.T. PROJ. NO T-44-1(187)

Scale: $\frac{3}{4}'' = 1'-0''$ Date: June 1989

SHEET NO. OF SHEETS


SHEET NO. OF SHEETS

COOL


Digitized by srujanika@gmail.com

DETAILS - GUARDRAIL TYPE 4F TRANSITION SECTION ("M-2" STA. 16 + 70 ± & 18 + 51 ±) scale: 3₁" = 1'-0"

ED. ROAD DIST. NO.	STATE	FED. AID PROJ. NO.	FISCAL YEAR	SHEET NO.	TOTAL SHEETS
HAWAII	HAW.	I-HI-1(187)	1984	32	197

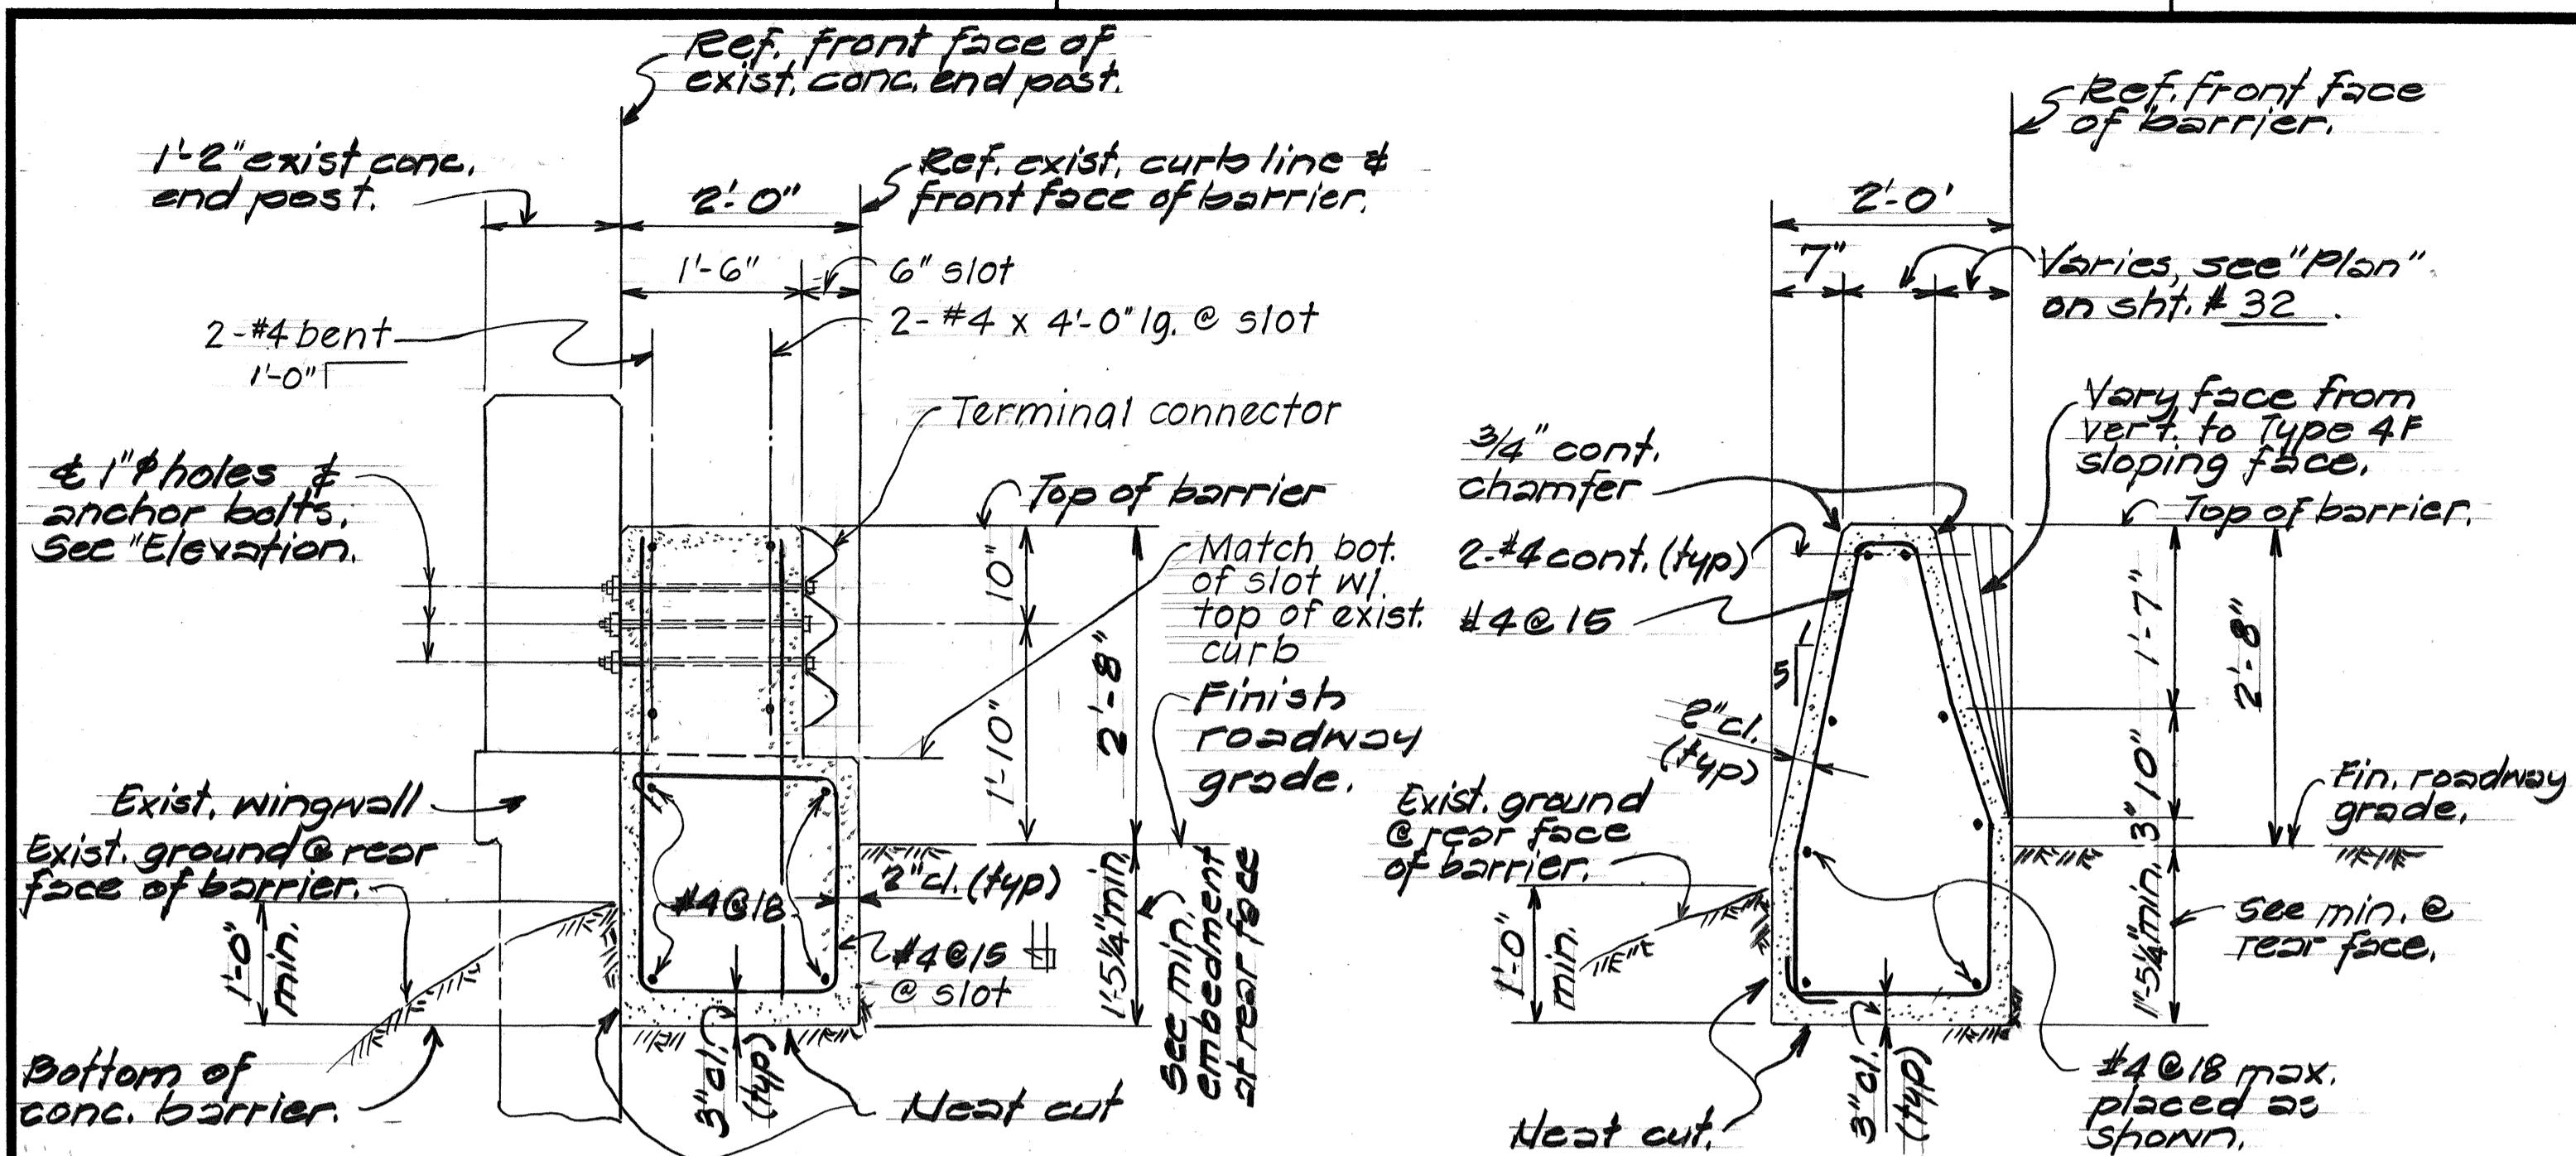

SECTION

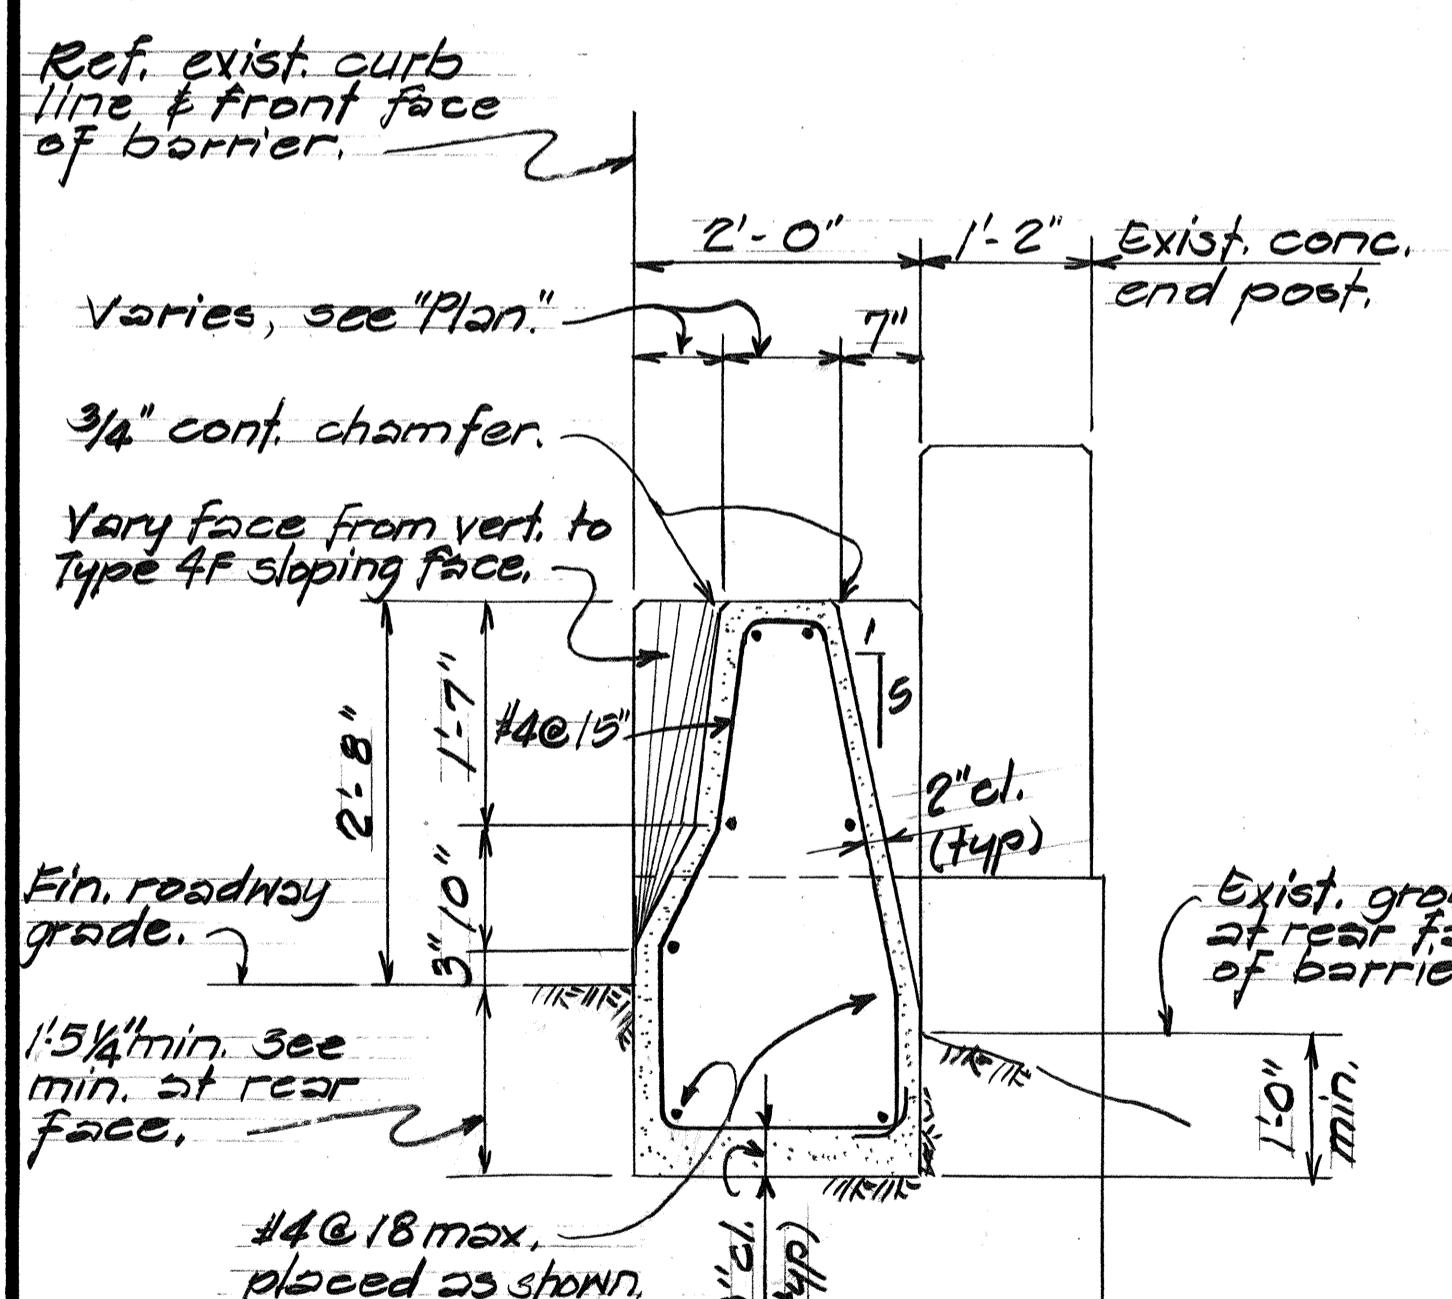


SECTION E
32 | 32

GUARDRAIL TYPE 4F TRANSITION SECTION


(RAMP "K-2" STA. 2 + 69 ±)

Scal/e: 3/4 = 1'-0"

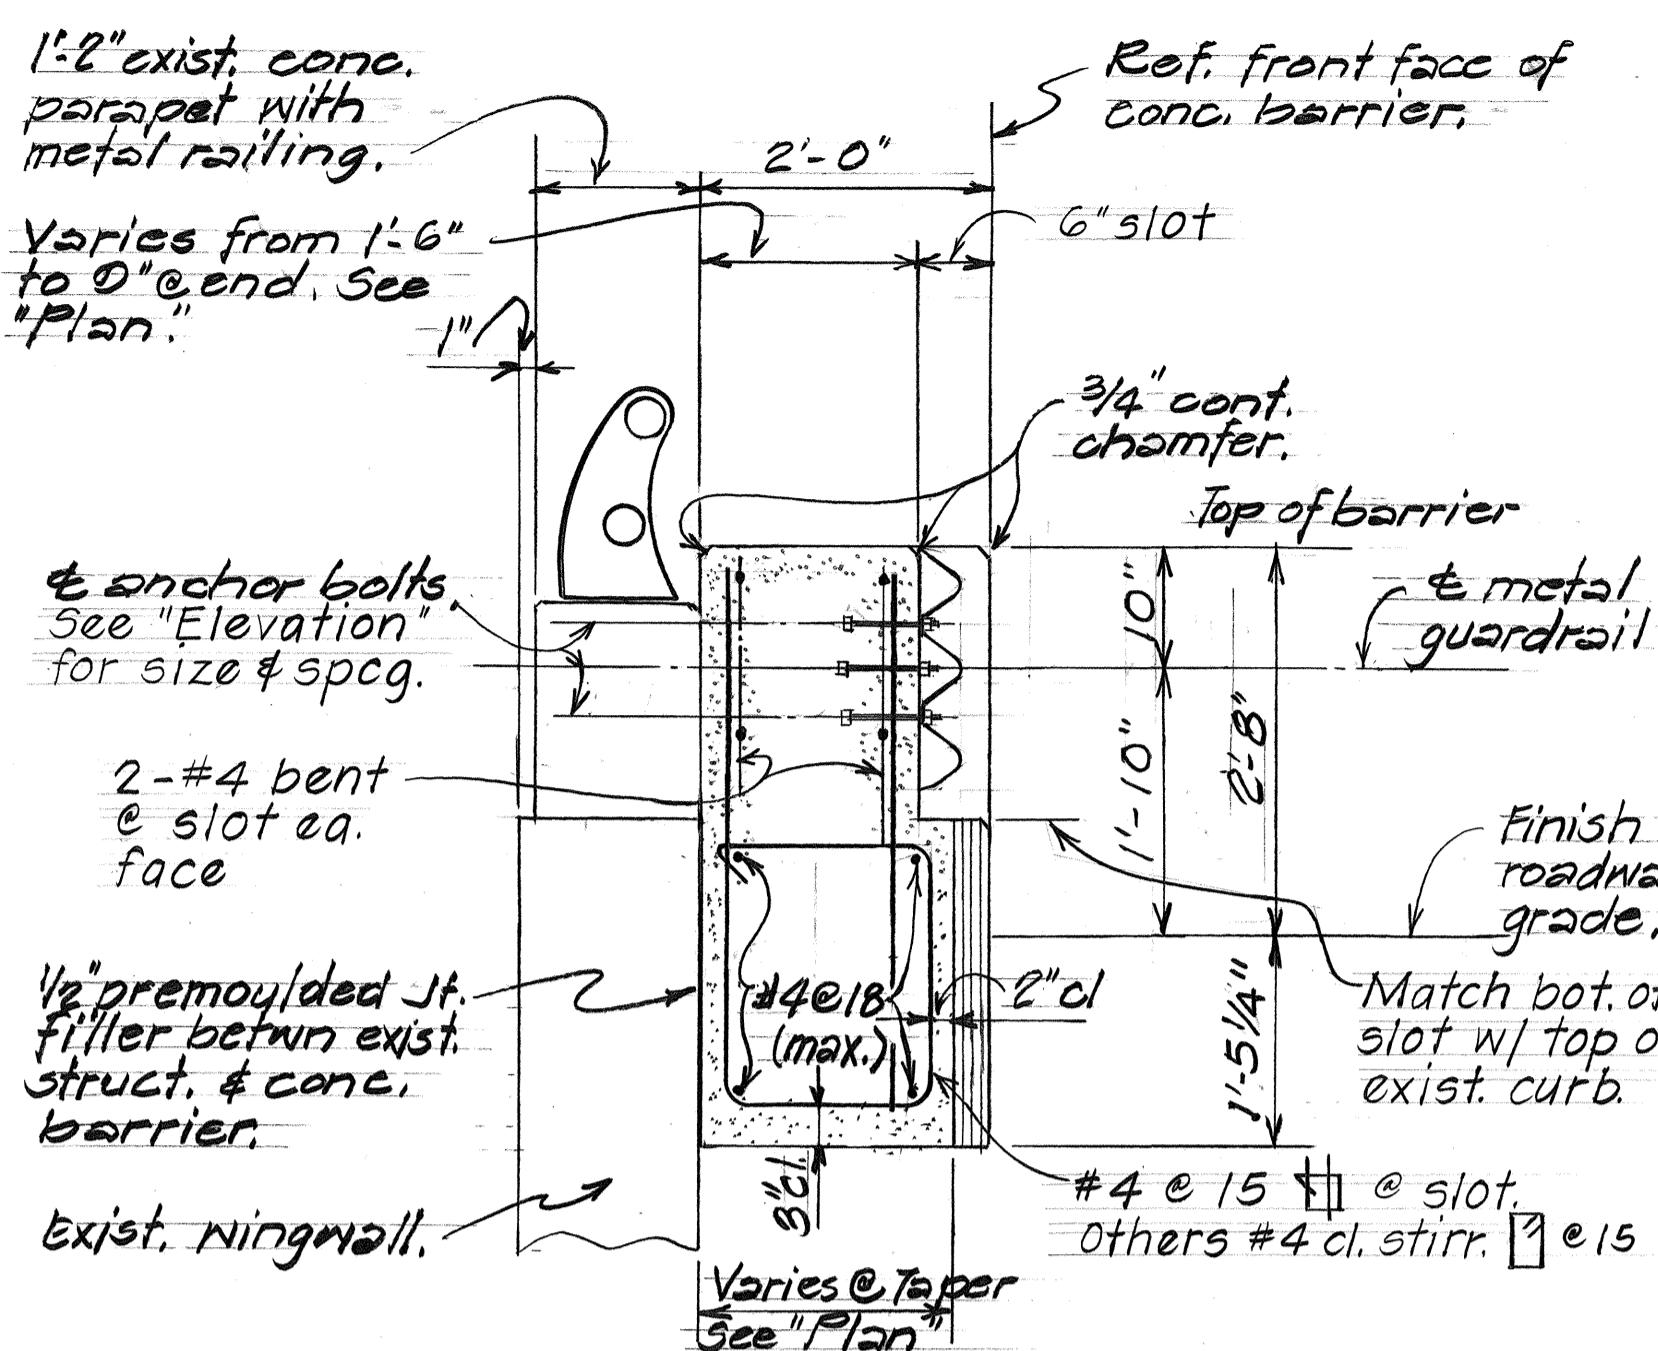


SECTION C
31 32


Scale: $\frac{3}{4}'' = 1'-0''$

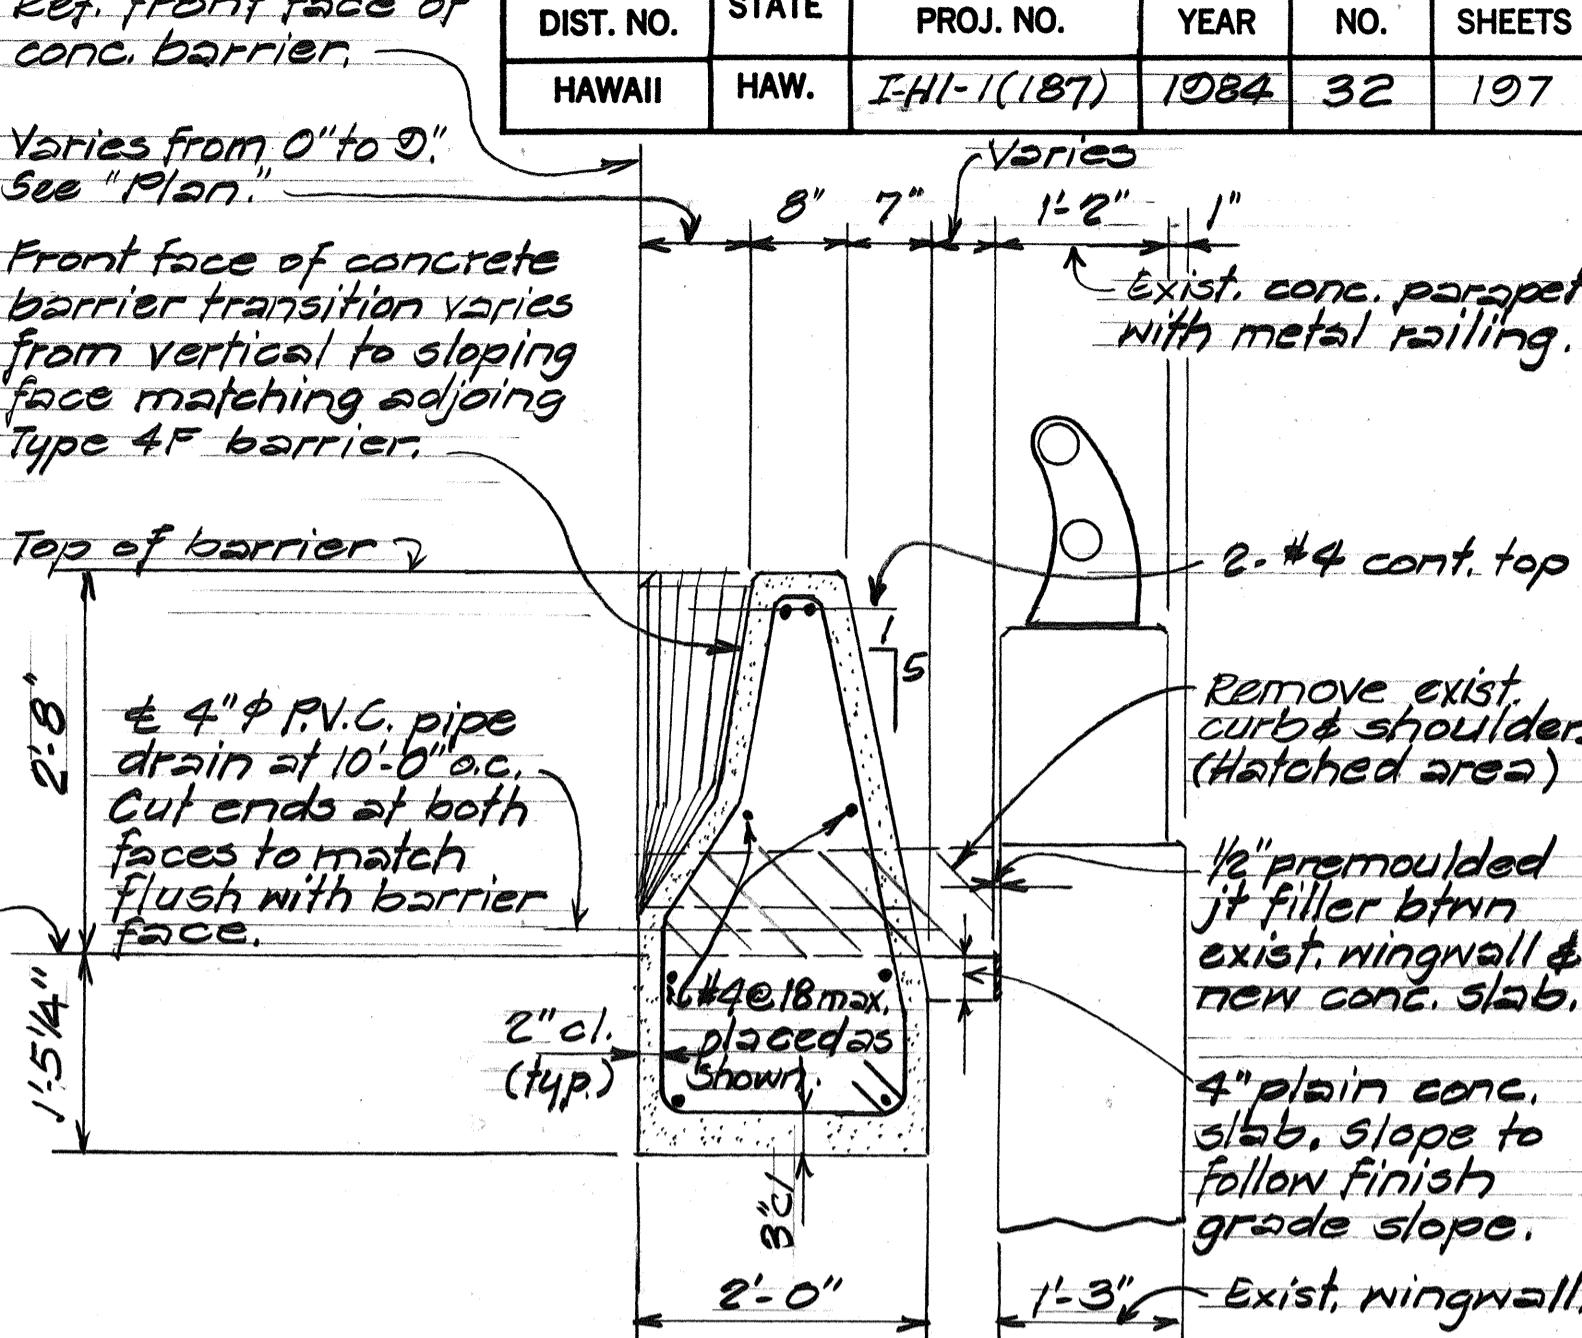

SECTION

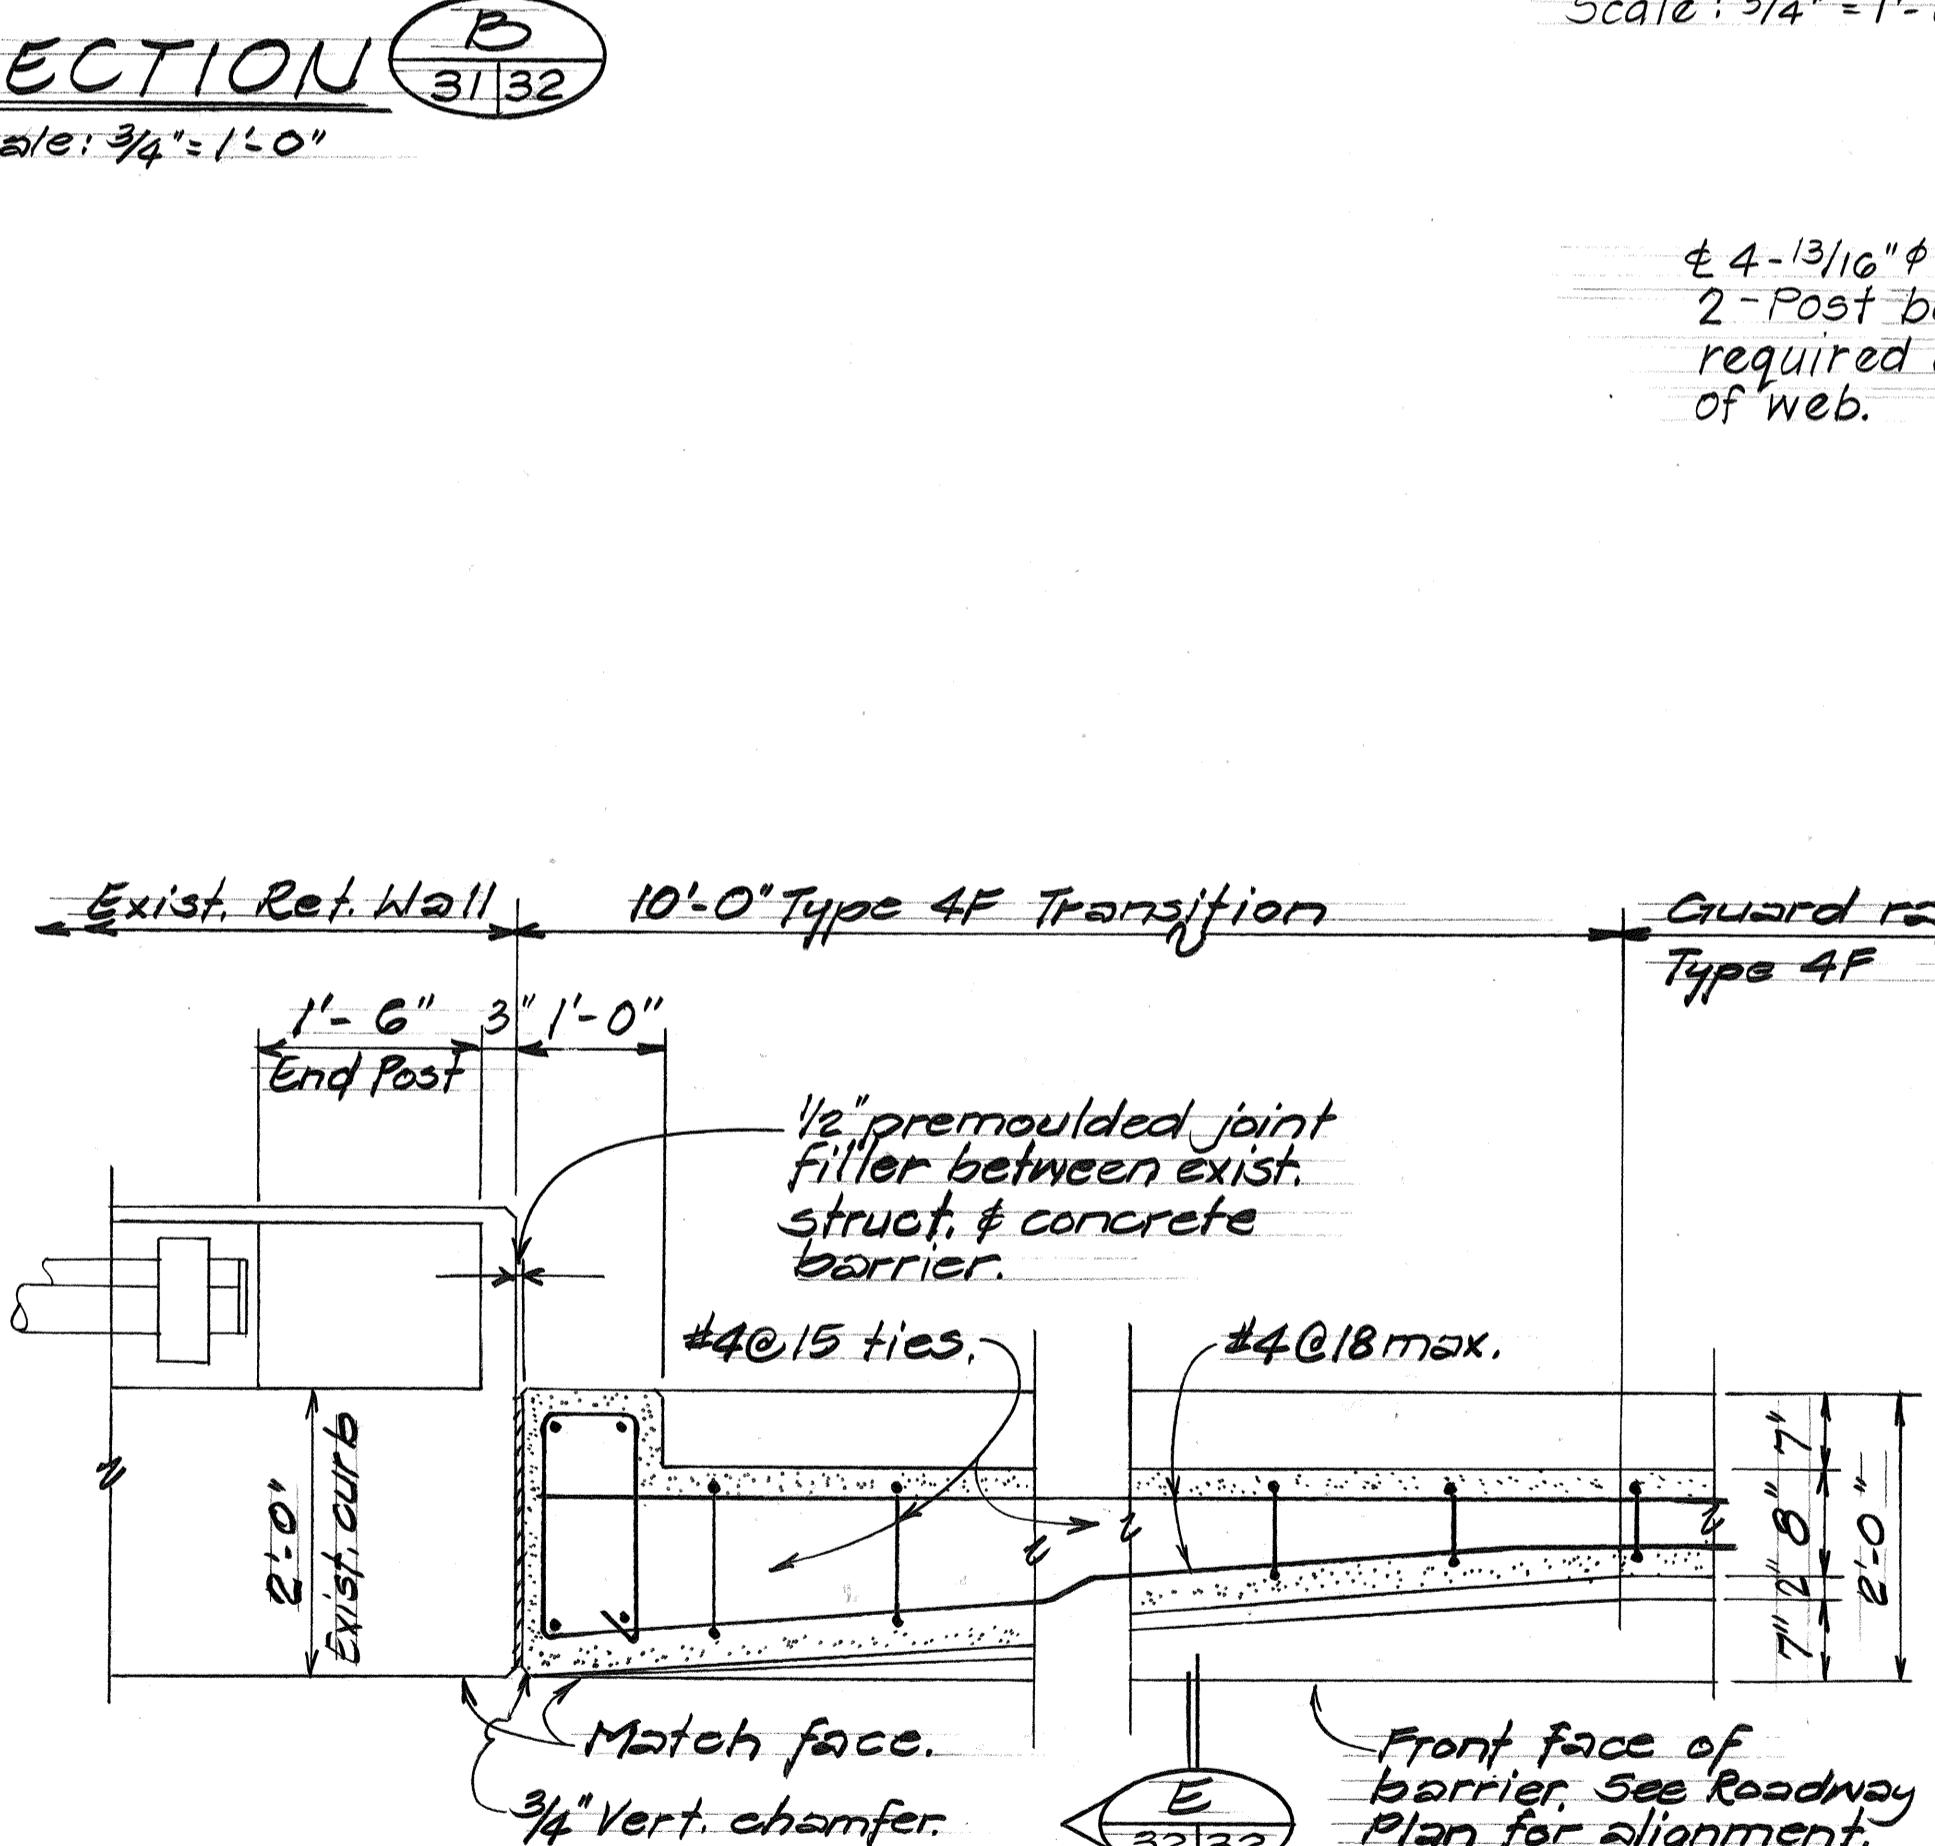

PLAN

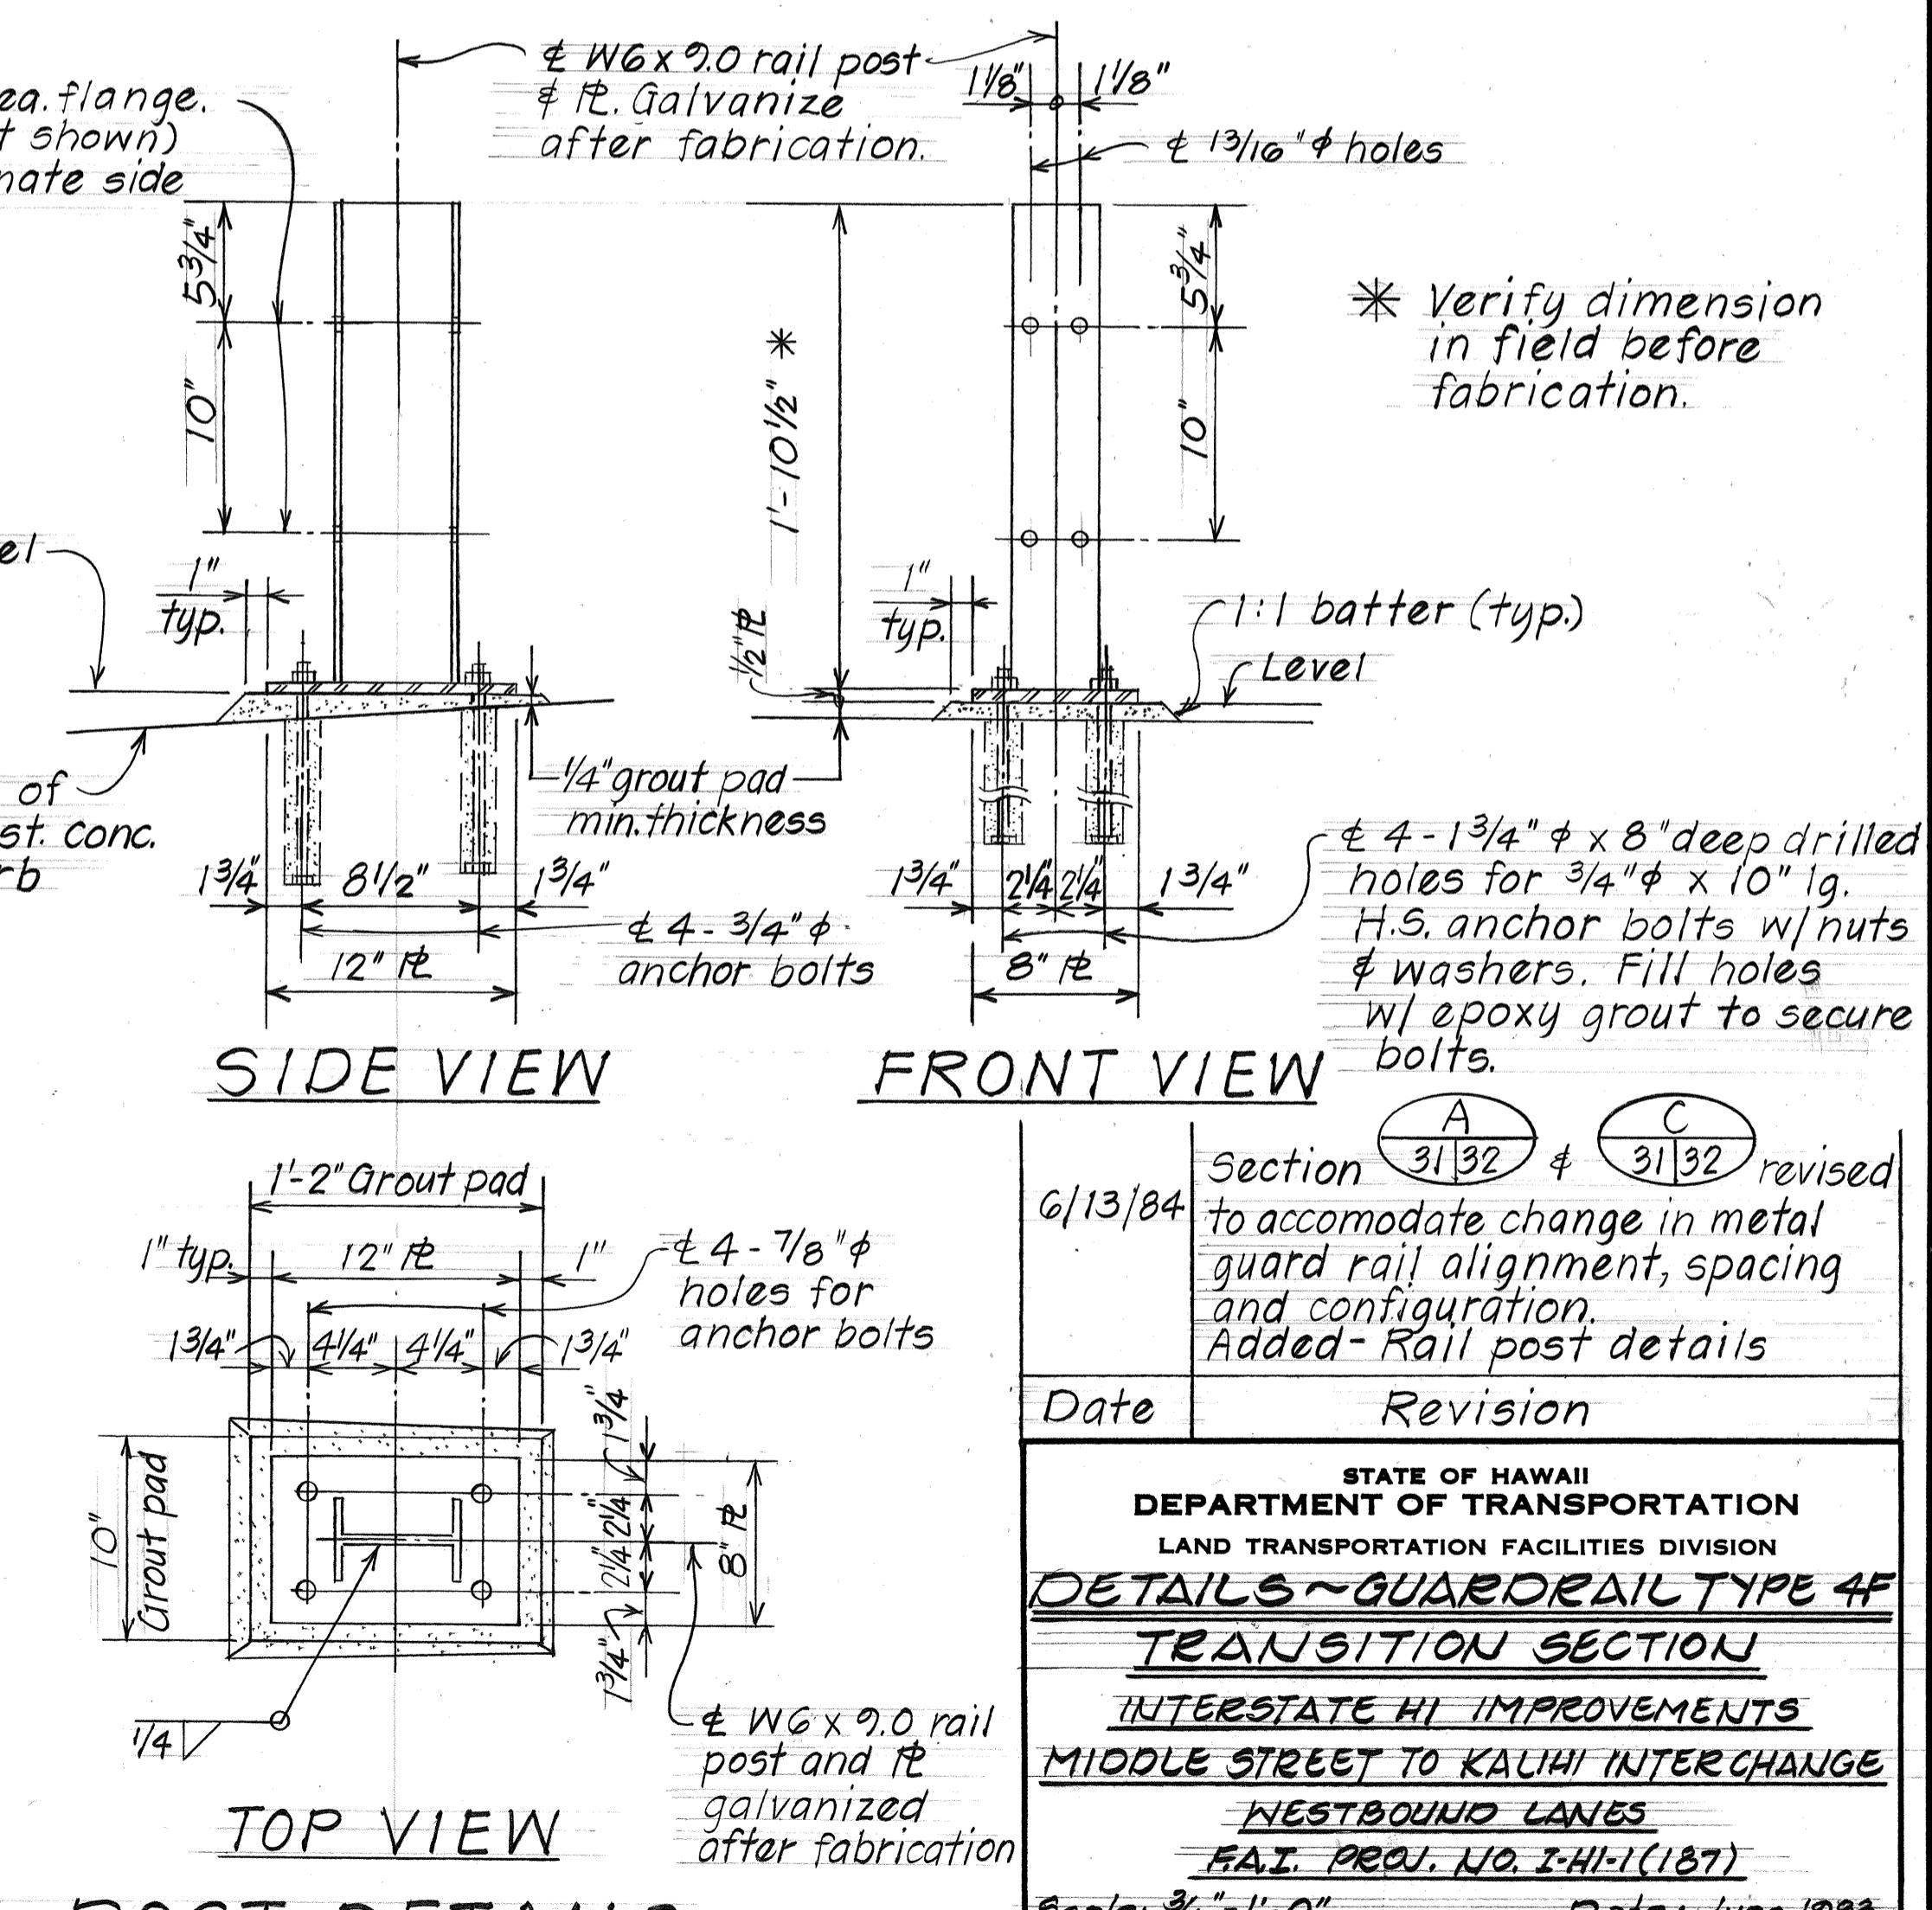

RAIL POST DETAILS Scale: 1/2" = 1'-0"

Locate

SHEET NO. 2 OF 2 SHEETS


SHEET NO. OF SHEETS

60 32

6032



C.O. 32

FED. ROAD DIST. NO.	STATE	FED. AID PROJ. NO.	FISCAL YEAR	SHEET NO.	TOTAL SHEETS
HAWAII	HAW.	I-HI-1(187)	1984	33	197

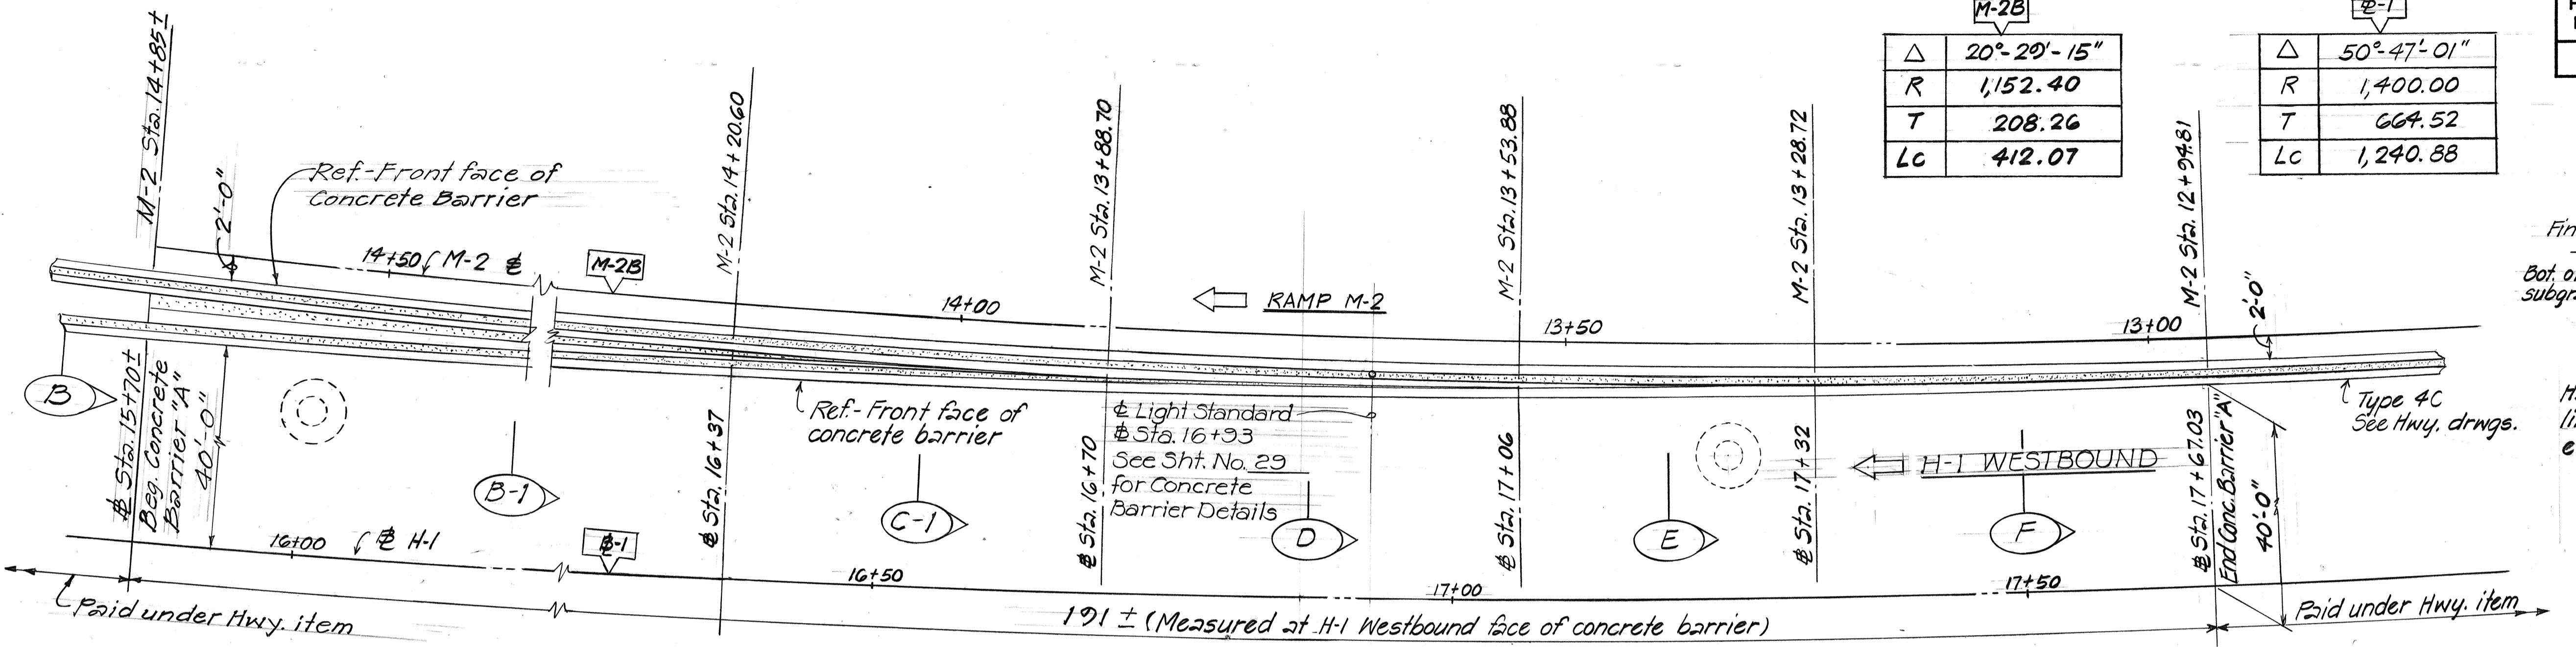


PLAN

Scale: $\frac{1}{8}$ " = 1'-0"

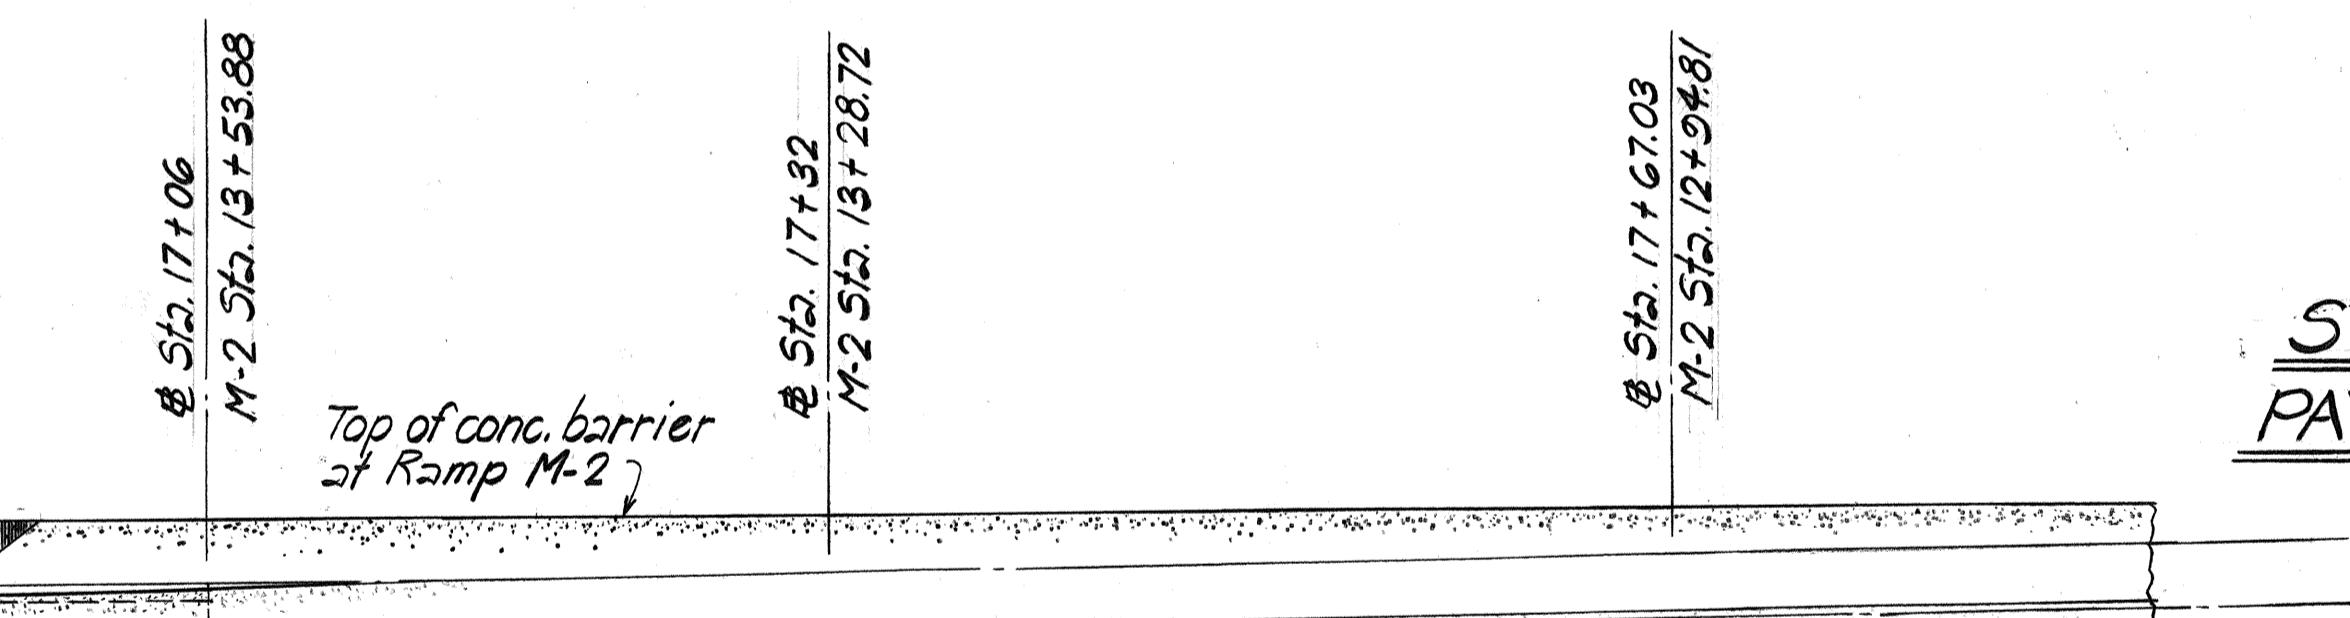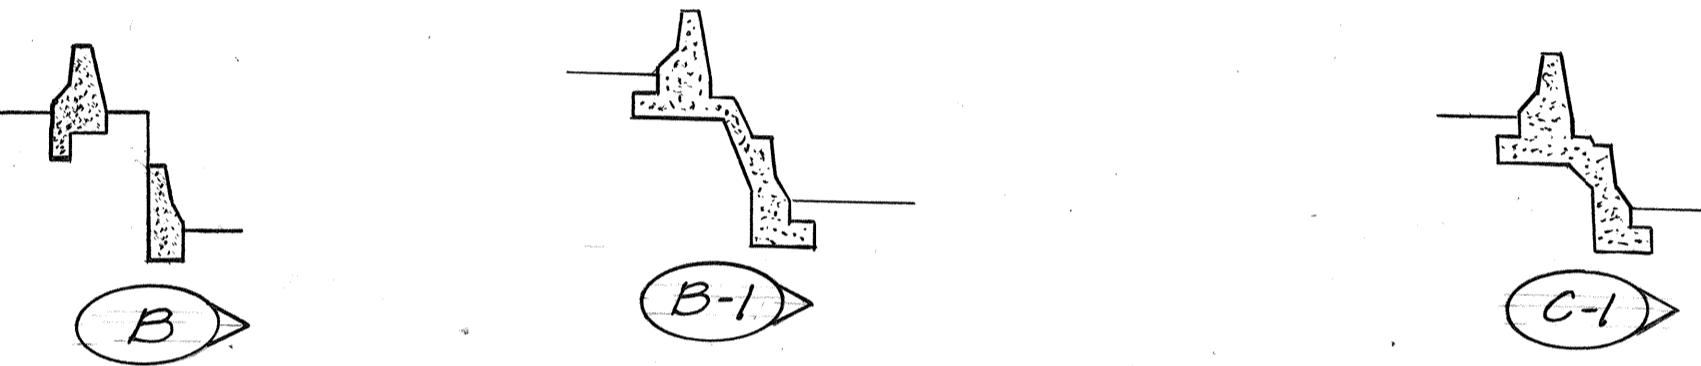

STRUCTURE EXCAVATION PAY LIMITS AT CONC. BARRIER
Not to Scale

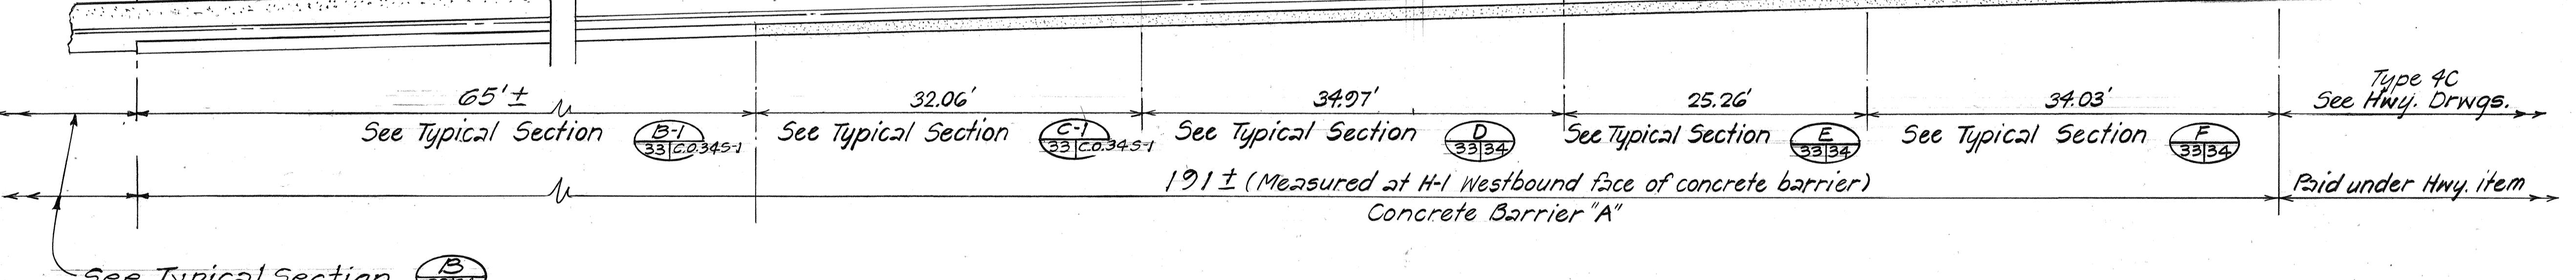

ELEVATION

Scale: $\frac{1}{8}$ " = 1'-0"

ESTIMATED QUANTITIES			
ITEM NO.	ITEM	UNIT	QUANTITY
606.4160	Concrete Barrier "A"	L.F.	191
206.5200	Structure Excavation for Concrete Barrier "A"	C.Y.	85


CONCRETE BARRIER "A"

STA. 15+70± TO STA. 17+67.03
M-2 STA. 14+85± TO STA. 12+94.81

8-1-84 Concrete Barrier "A" extended approximately 65 linear feet. Typical Sections from # Sta. 15+70± to 16+70 revised.
DATE REVISION

STATE OF HAWAII
DEPARTMENT OF TRANSPORTATION
LAND TRANSPORTATION FACILITIES DIVISION
CONCRETE BARRIER "A"
INTERSTATE HI IMPROVEMENTS
MIDDLE STREET TO KALIHI INTERCHANGE
WESTBOUND LANES
F.A.I. PROJ. NO. I-HI-1(187)
Scale: As Shown Date:
SHEET NO. 1 OF 2 SHEETS

FED. ROAD DIST. NO.	STATE	FED. AID PROJ. NO.	FISCAL YEAR	SHEET NO.	TOTAL SHEETS
HAWAII	HAW.	I-HI-1(187)	1984	34	107

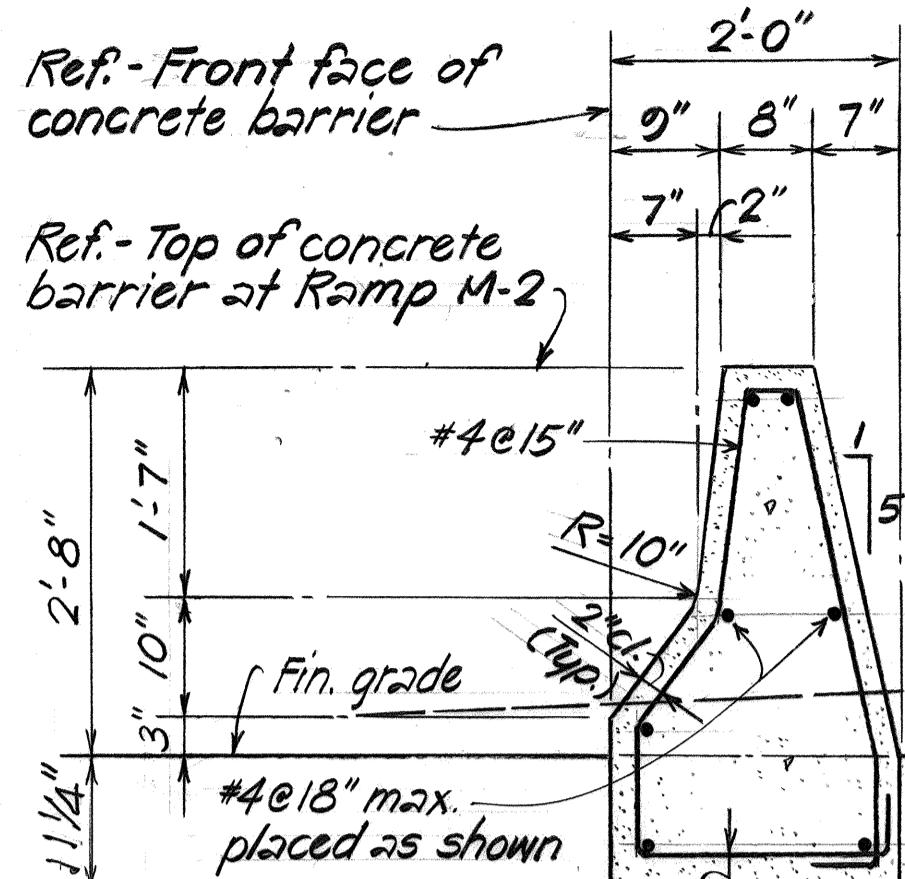

TYPE 4F



#4@18" max.
placed as shown

TYPE 4E

#4@18" max.
placed as shownTYPICAL SECTION

SEE HWY. DRAWINGS

Scale: 3/4" = 1'-0"

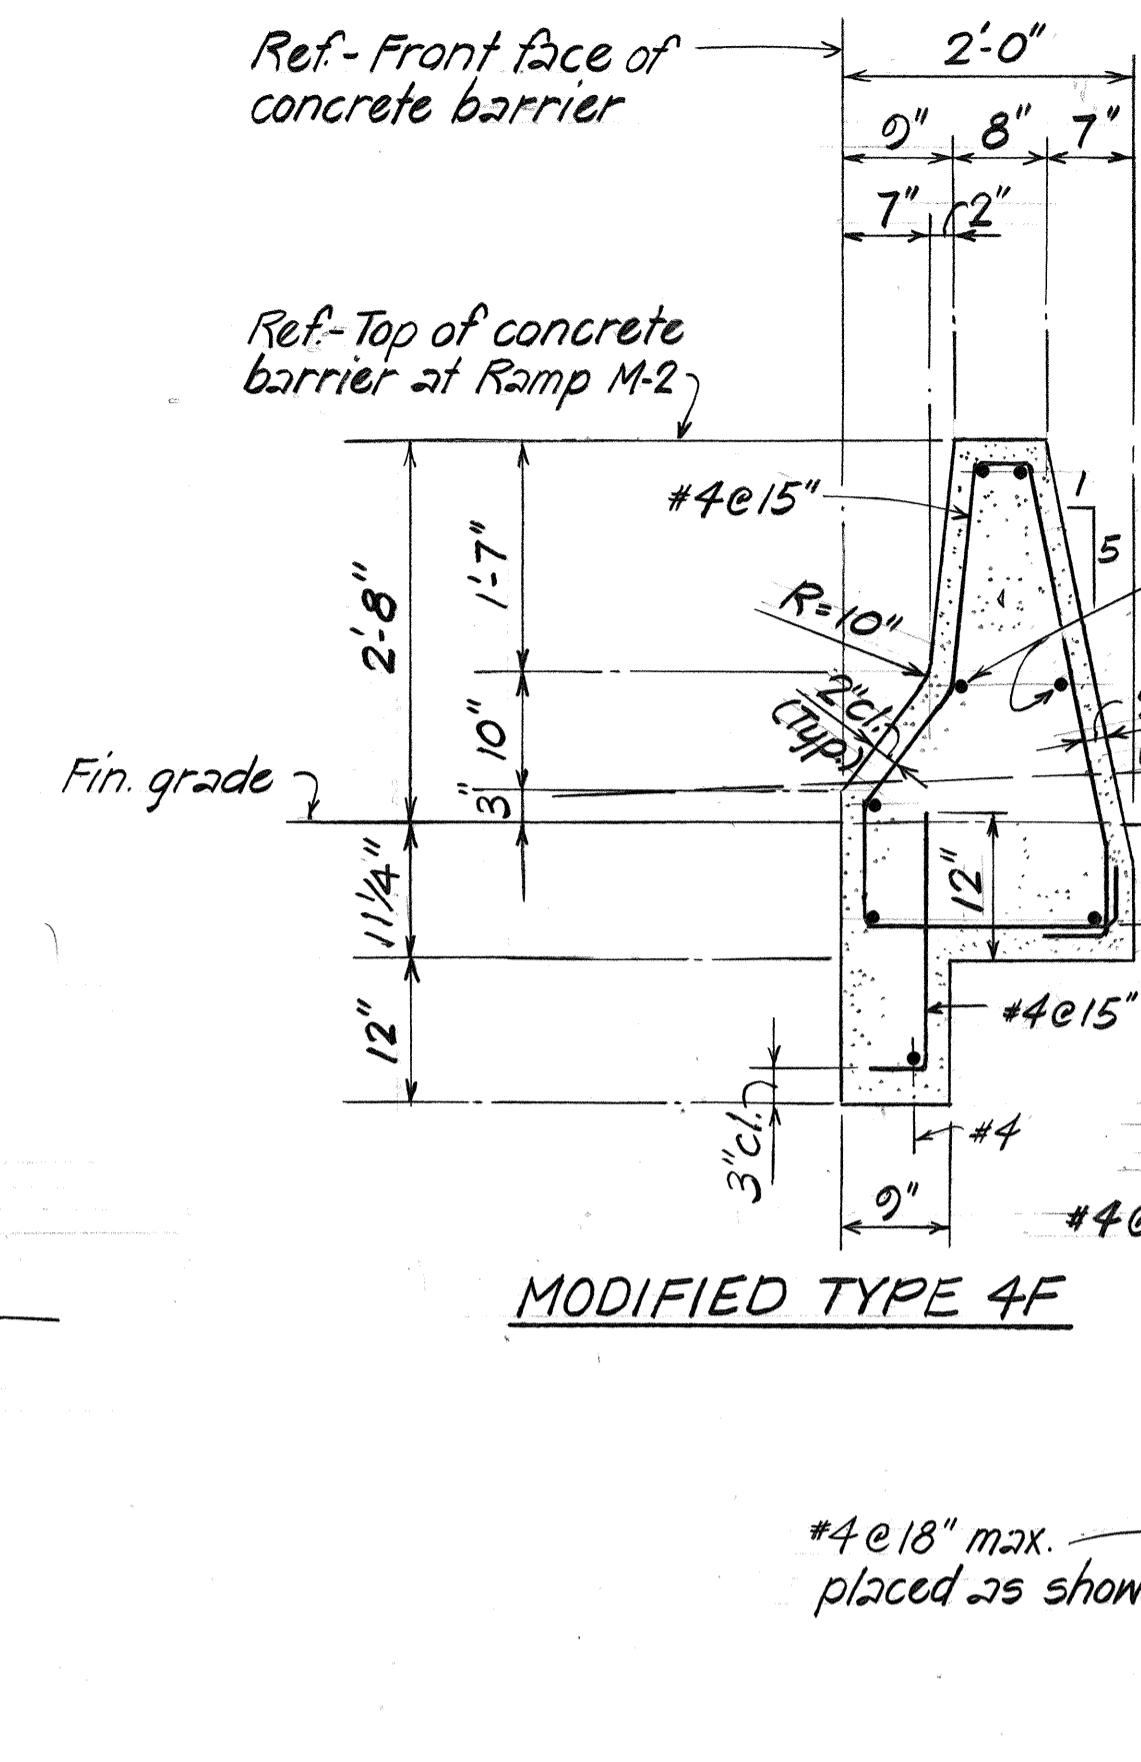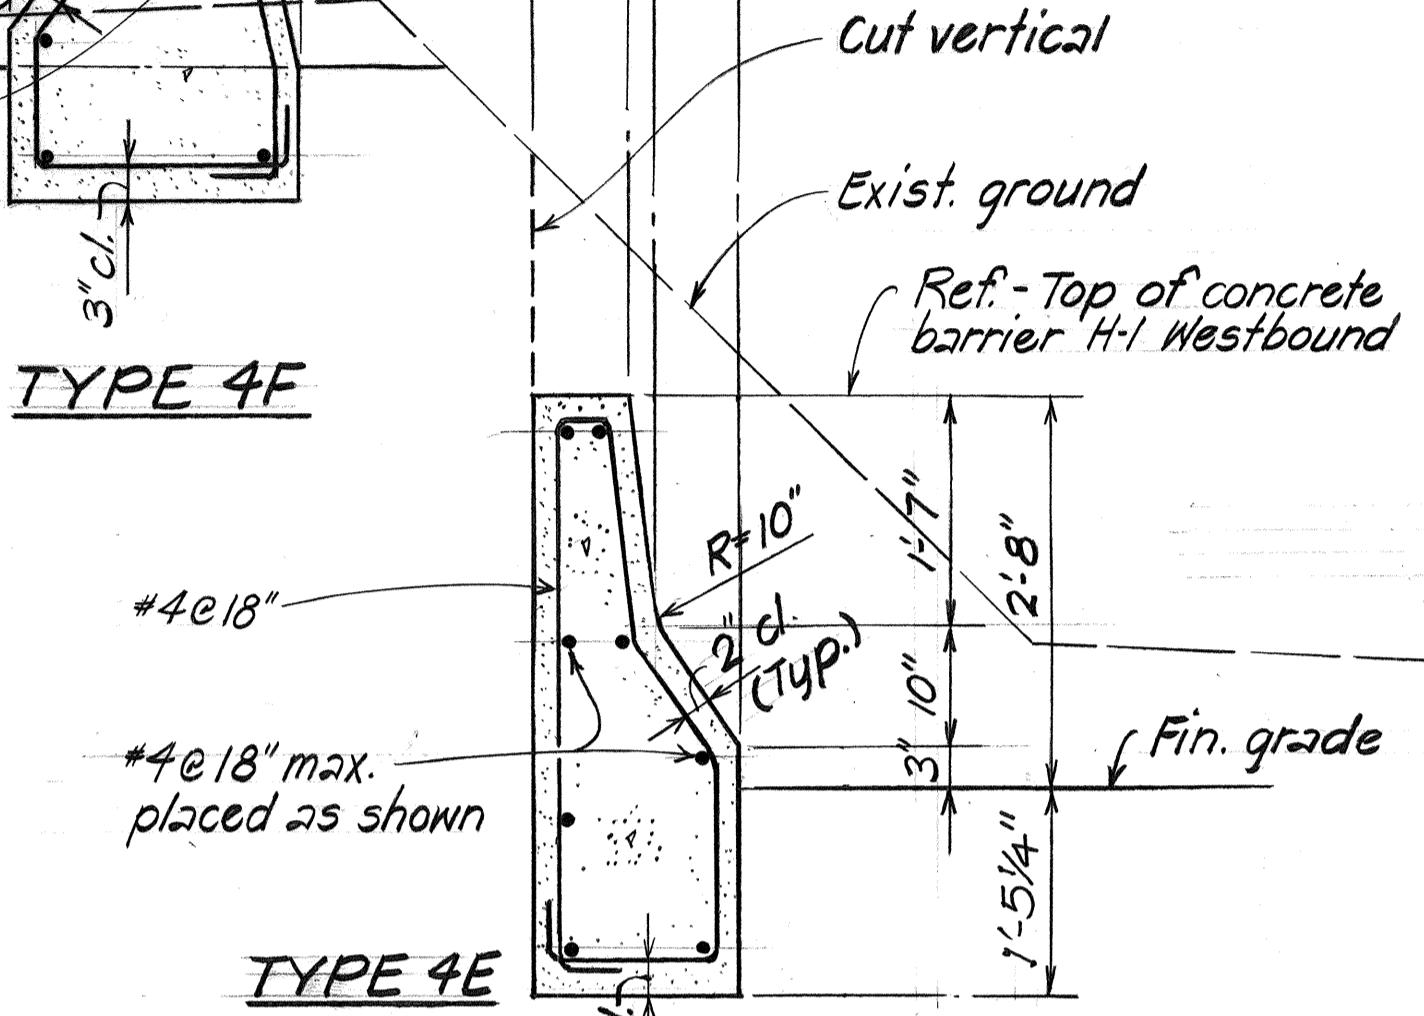


MODIFIED TYPE 4F

#4@18" max.
placed as shown

TYPE 4E


TYPICAL SECTION

Scale: 3/4" = 1'-0"

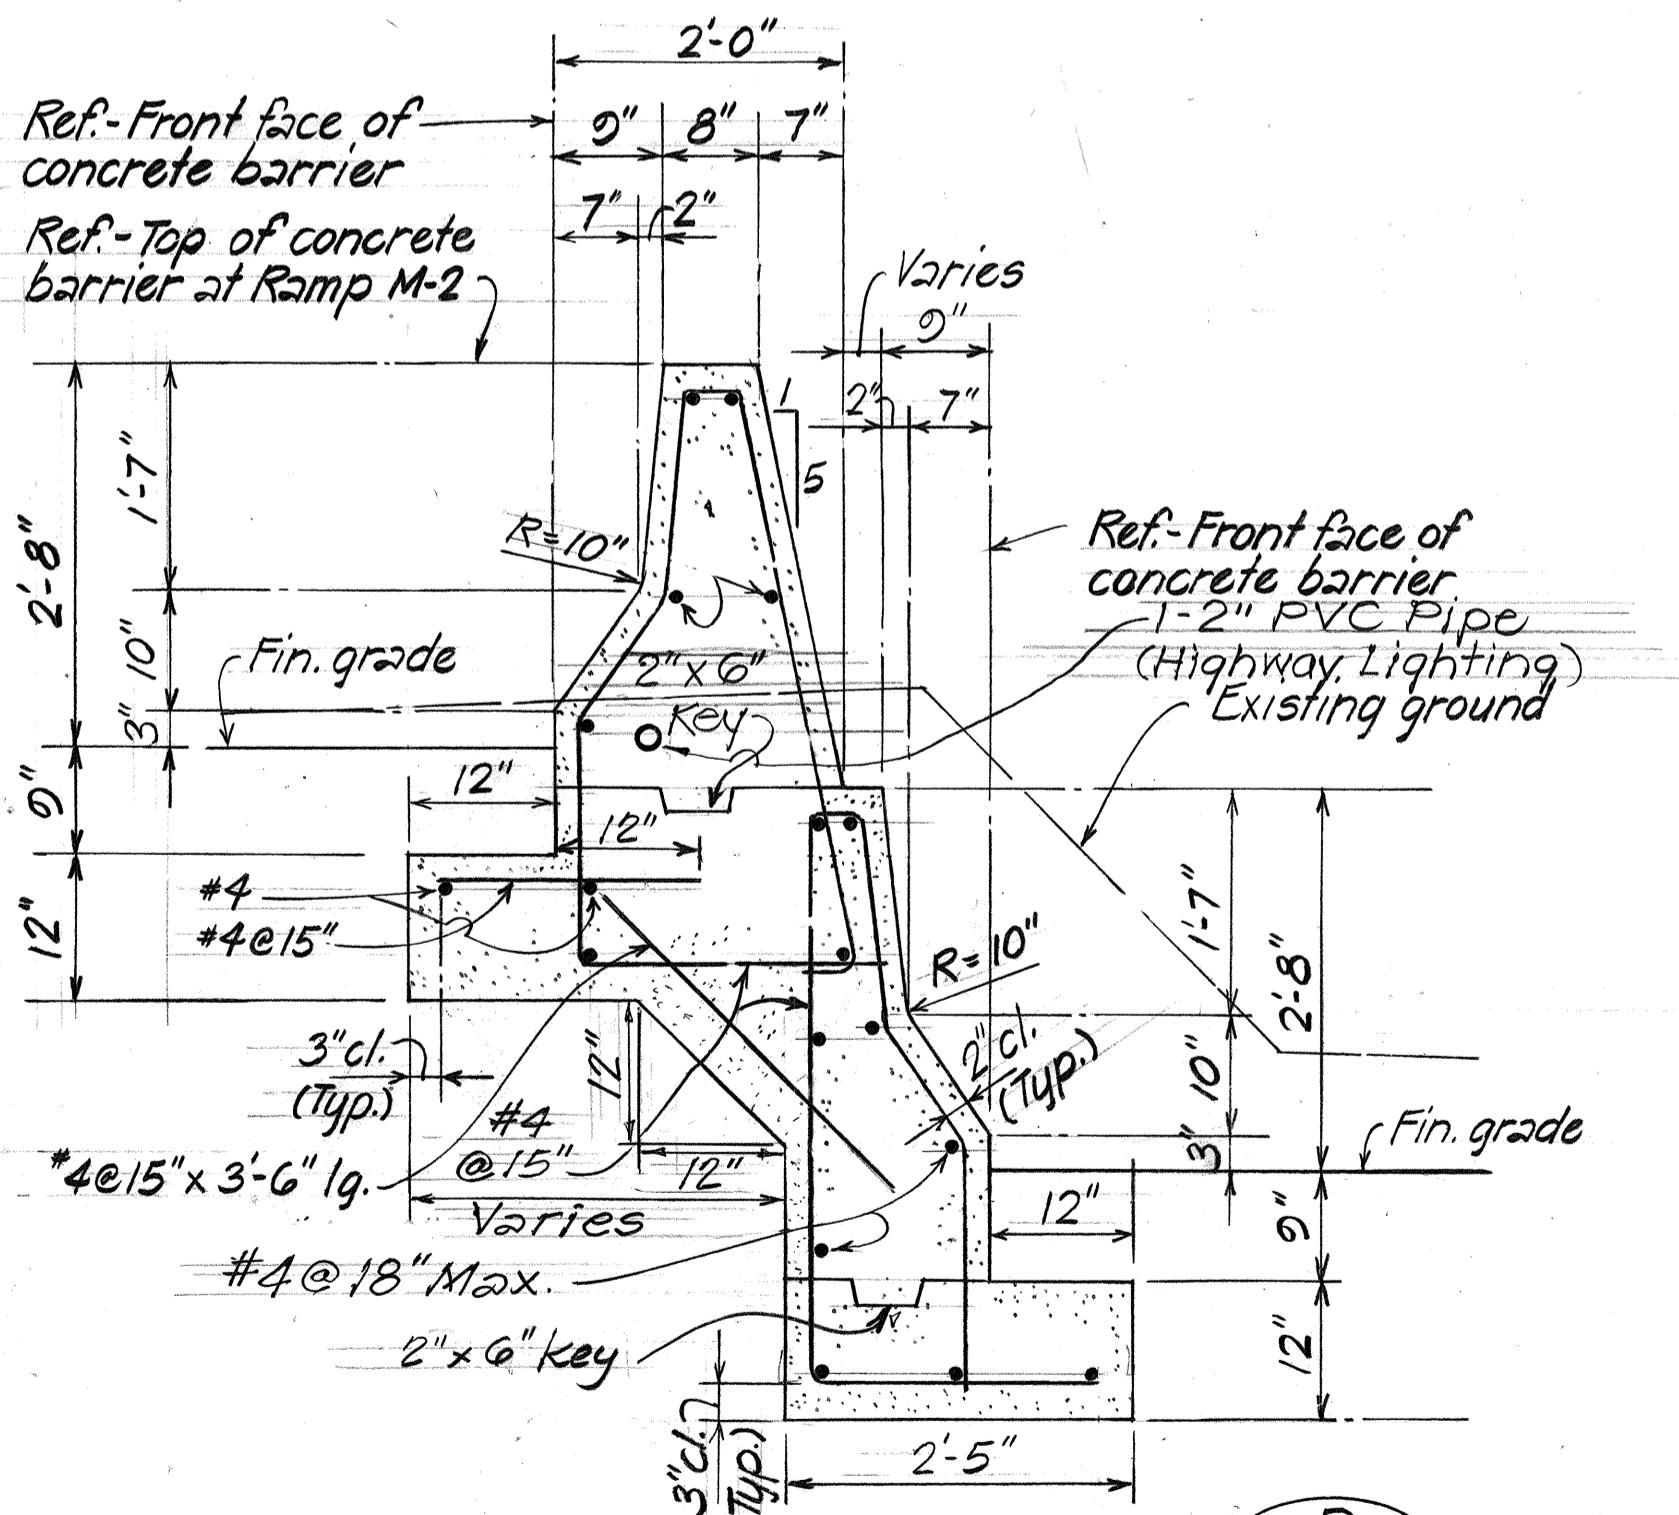


TYPICAL SECTION

STA. 16 + 70 TO # STA. 17 + 06
M-2 STA. 13 + 88.70 TO M-2 STA. 13 + 53.88
Scale: 3/4" = 1'-0"

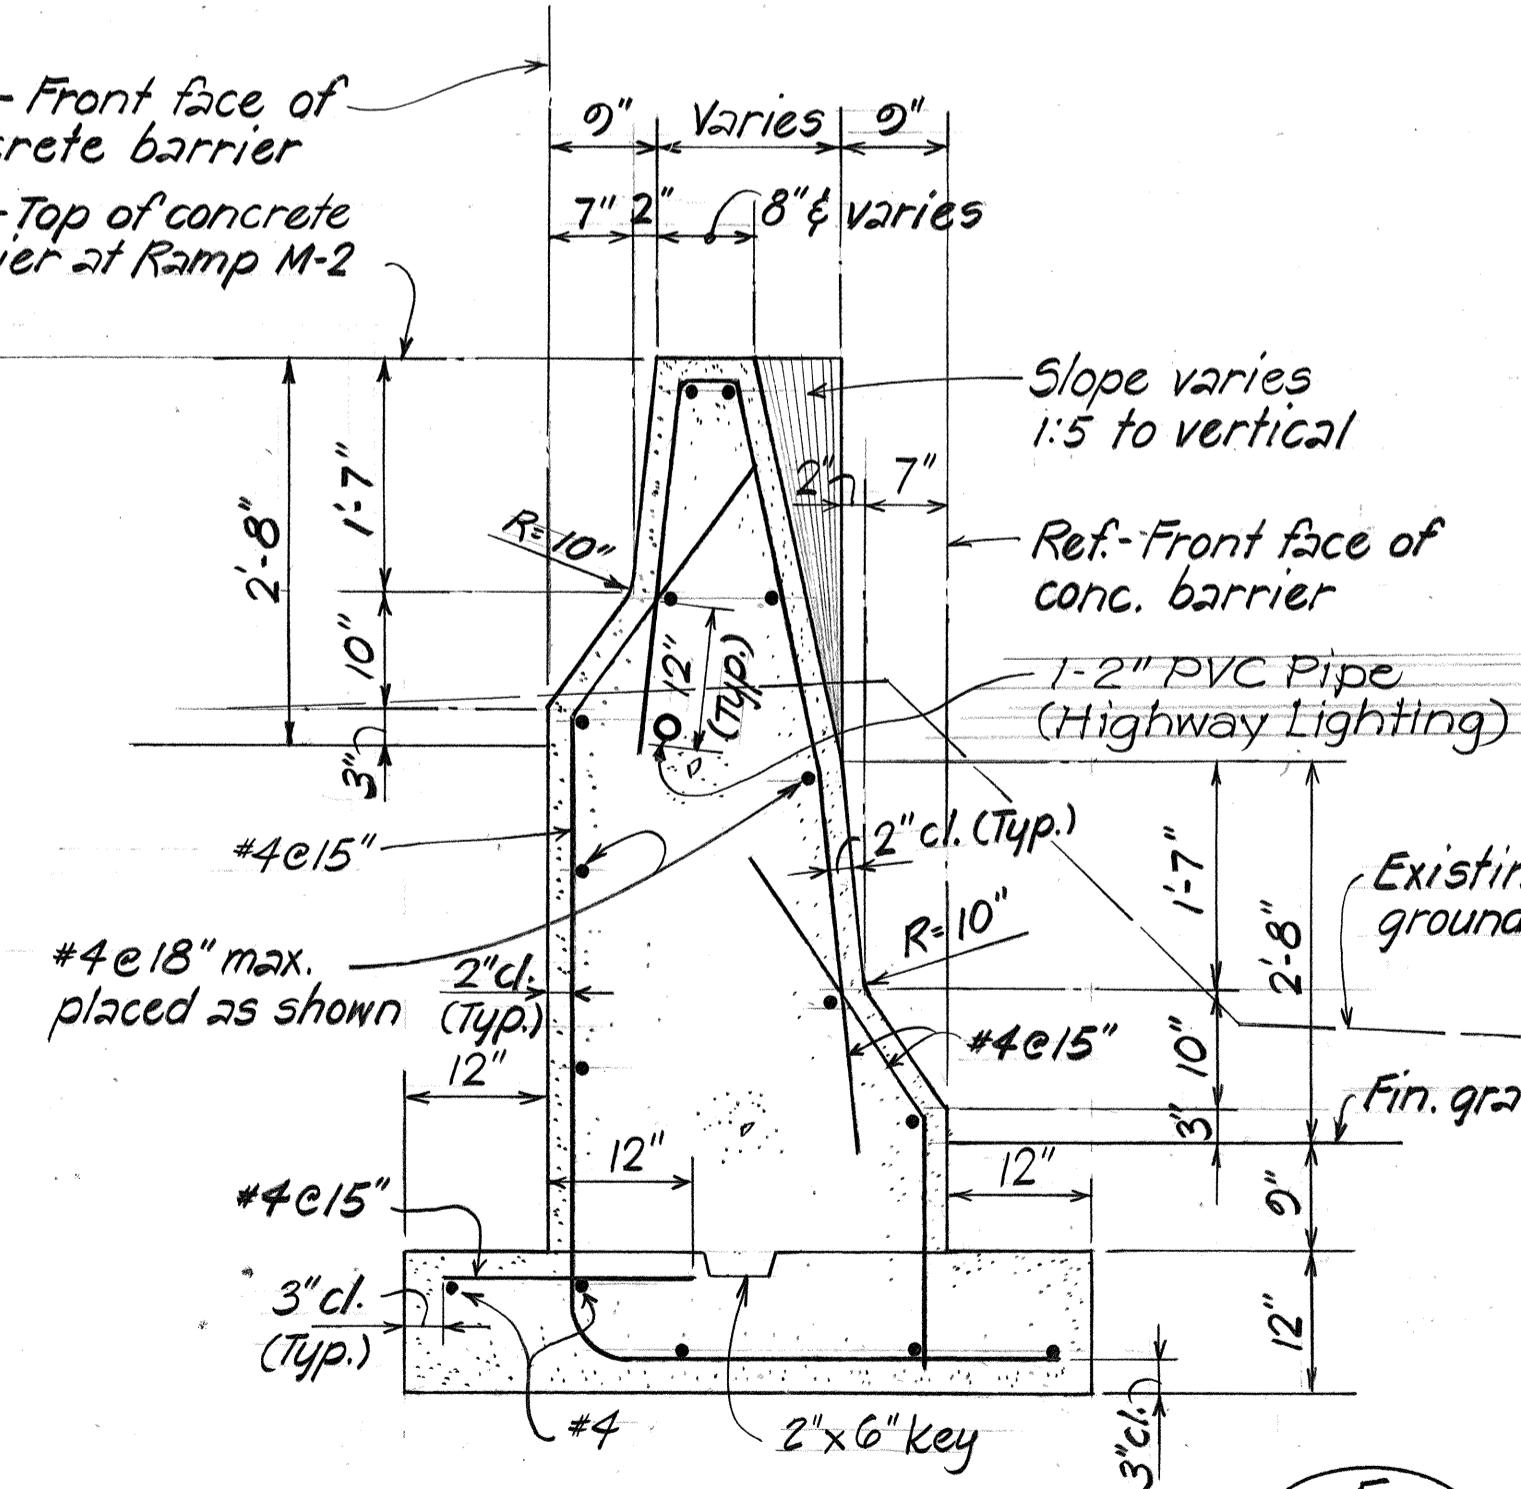

TYPICAL SECTION

STA. 17 + 06 TO # STA. 17 + 32
M-2 STA. 13 + 53.88 TO M-2 STA. 13 + 28.72
Scale: 3/4" = 1'-0"

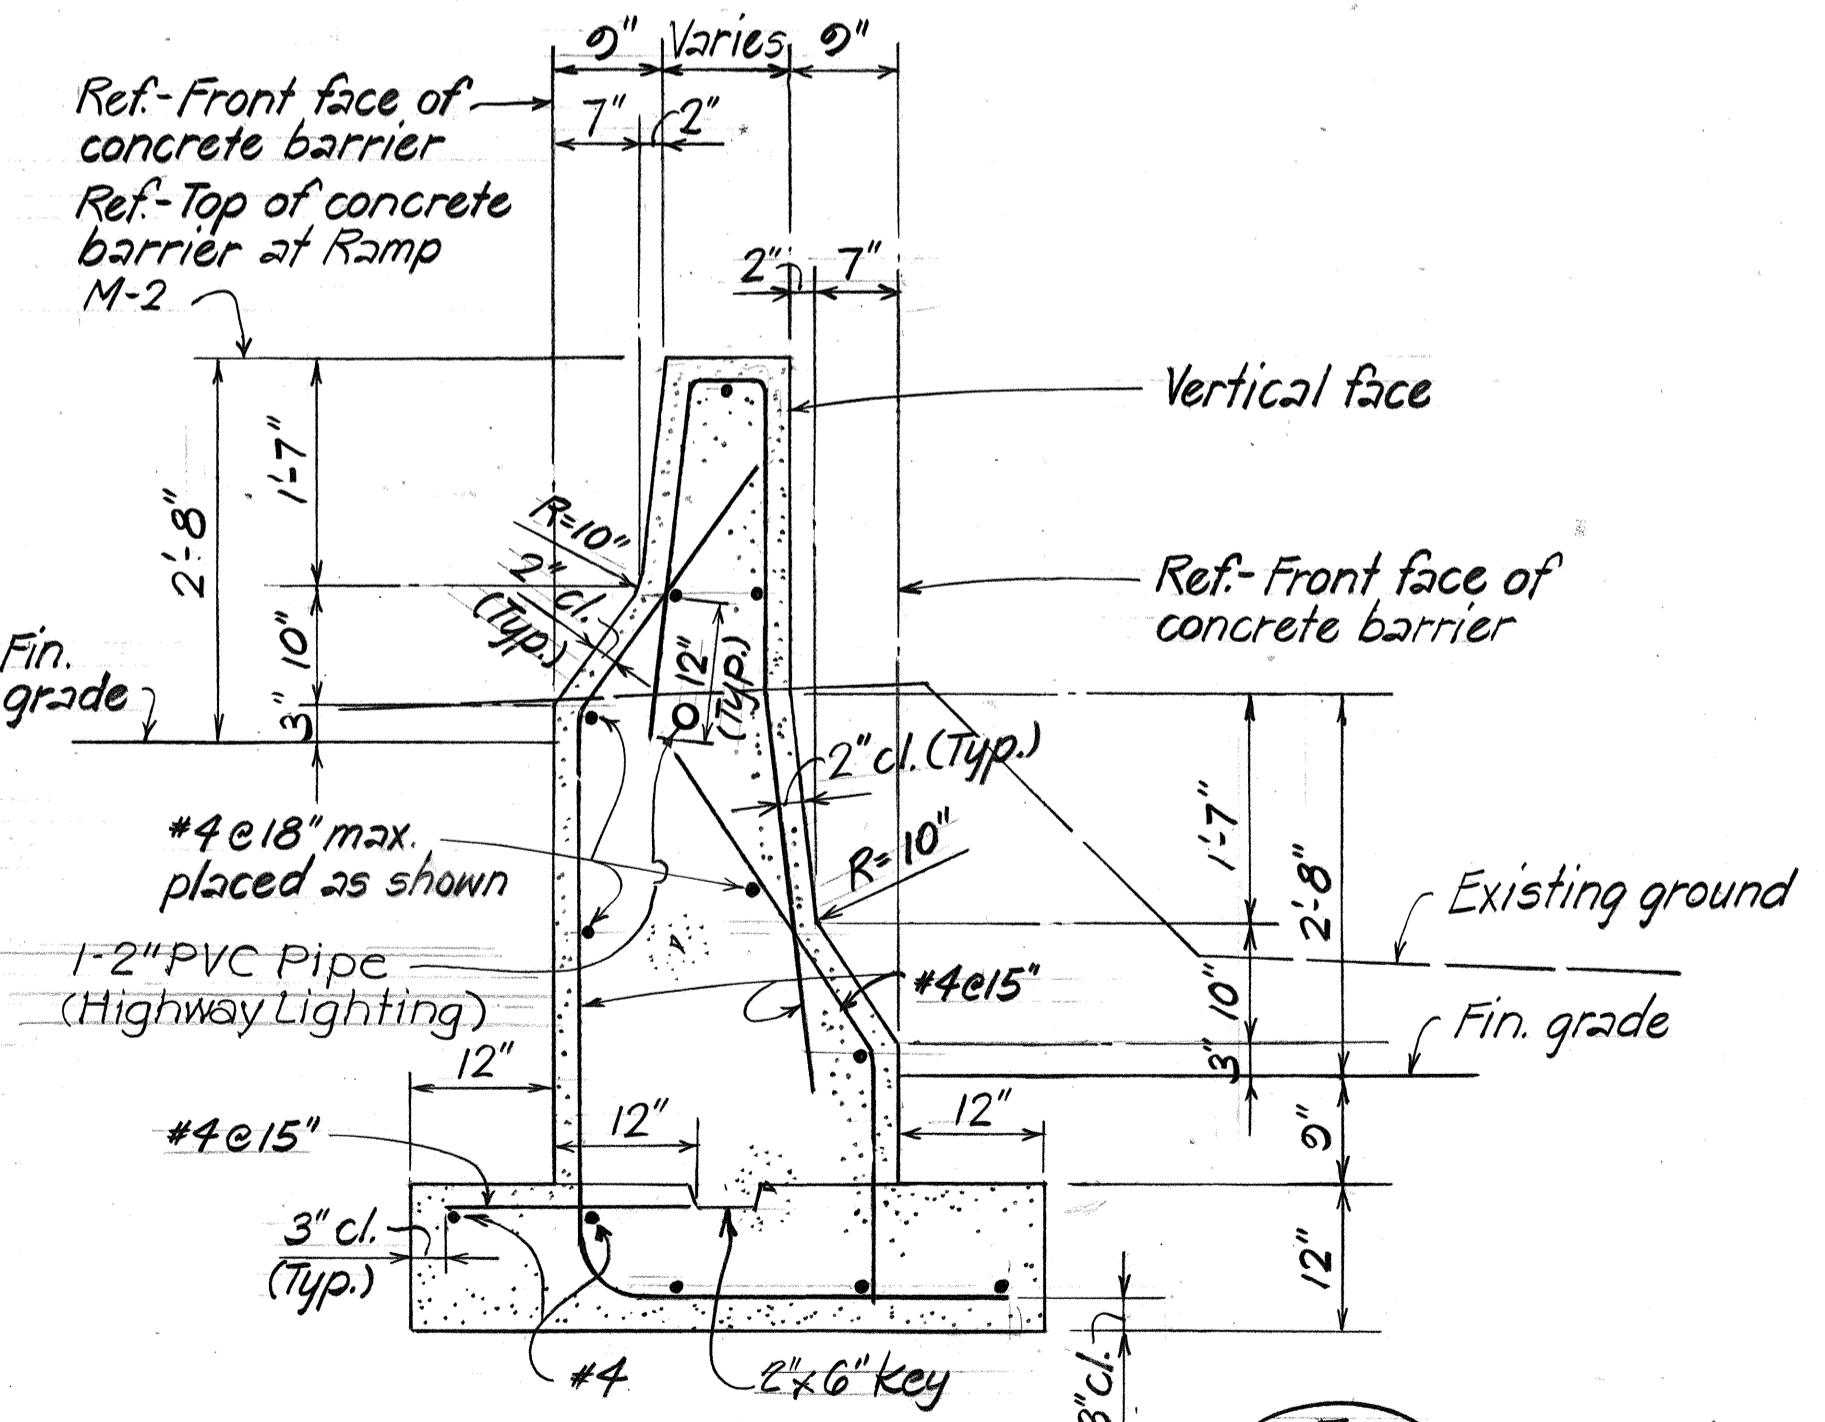

TYPICAL SECTION

STA. 17 + 32 TO # STA. 17 + 67.03
M-2 STA. 13 + 28.72 TO M-2 STA. 12 + 94.81
Scale: 3/4" = 1'-0"

8-184 Fillet between adjoining Barrier Sections shown on Typical Section "C" and "D" revised from 9" to 12". See Sheet No. C.0.345-1 for Revised Typical Sections from # Sta. 15+70± to 16+70.

DATE _____


REVISION _____

STATE OF HAWAII
DEPARTMENT OF TRANSPORTATION
LAND TRANSPORTATION FACILITIES DIVISION
CONCRETE BARRIER "A"
INTERSTATE HI IMPROVEMENTS
MIDDLE STREET TO KALIHI INTERCHANGE
WESTBOUND LANES
F.A.I. PROJ. NO. I-HI-1(187)
Scale: As Shown Date:
SHEET NO. 2 OF 2 SHEETS

C.O. 34

ORIGINAL SURVEY PLOTTED BY	Z.K.M.
DRAWN BY	Z.K.M.
TRACED BY	Z.K.M.
DESIGNED BY	N.Y.
QUANTITIES BY	L.A.
CHECKED BY	L.A.

ED. ROAD DIST. NO.	STATE	FED. AID PROJ. NO.	FISCAL YEAR	SHEET NO.	TOTAL SHEETS
HAWAII	HAW.	I-HI-1 (187)	1984	345-1	107

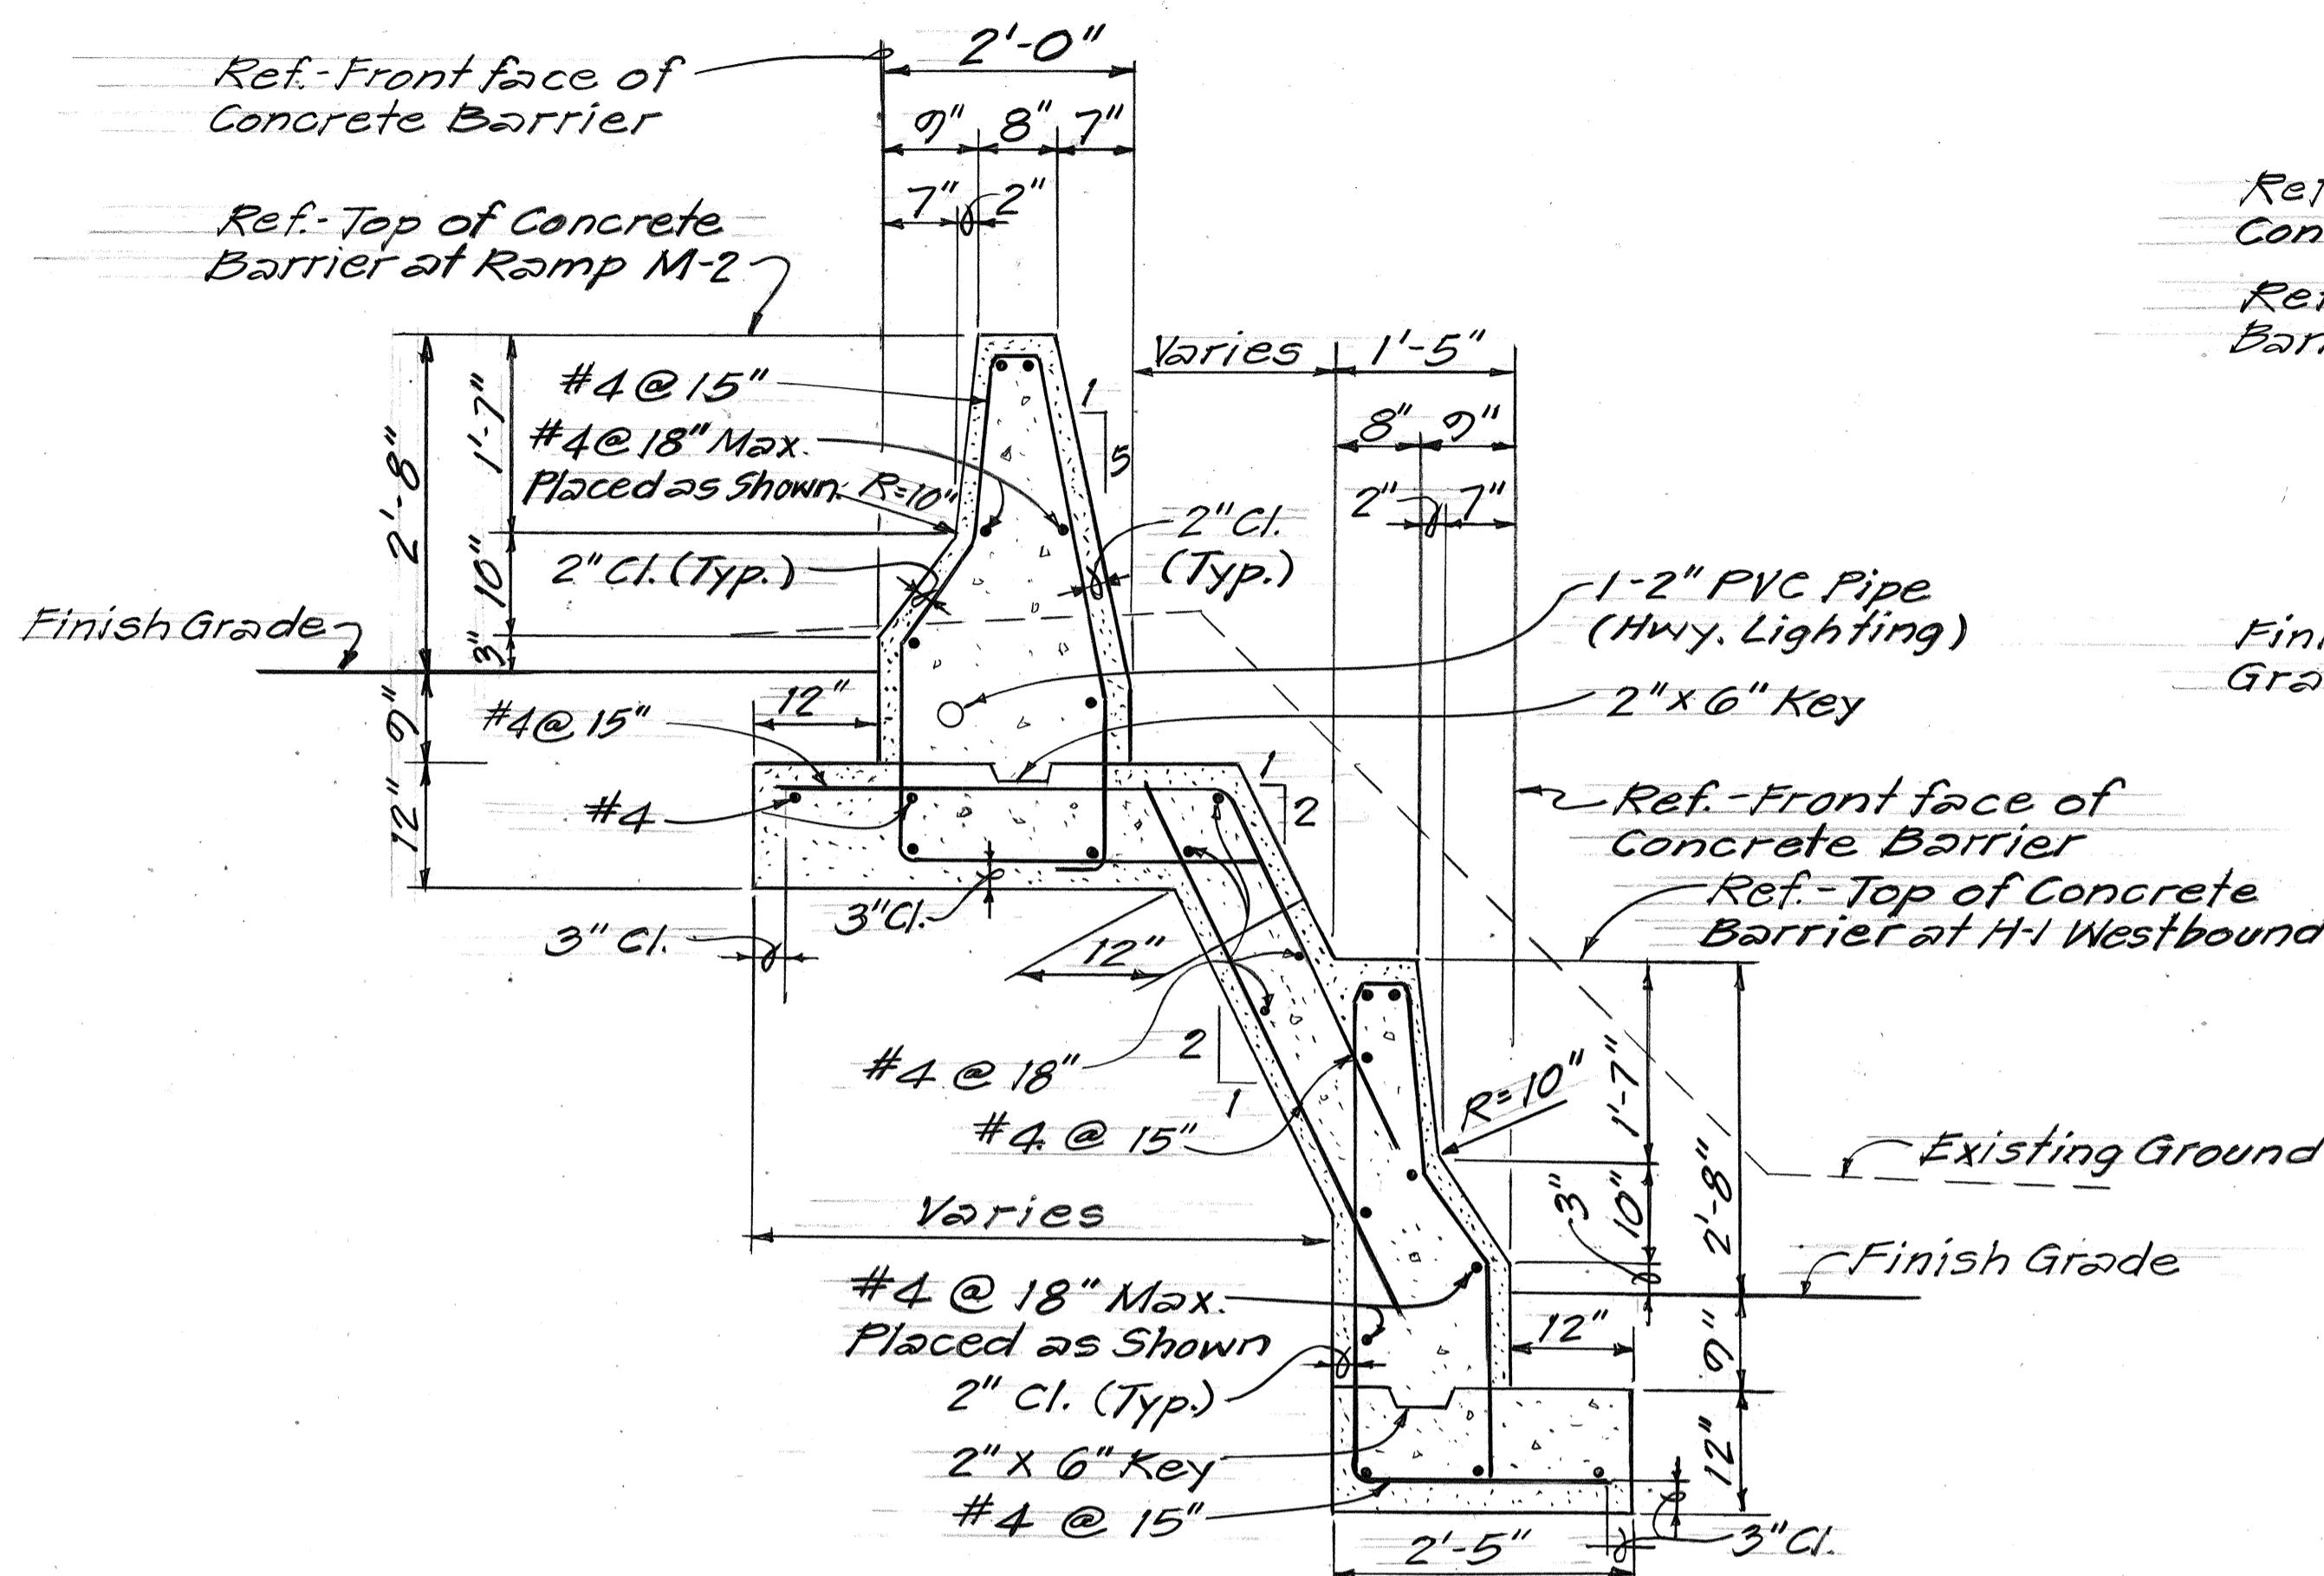


TYPICAL SECTION B-1
33 C.O. 345-

~~STA. 15+70 ± 70~~ STA. 16+37

M-2 STA. 14+85 ± TO M-2 STA. 14+20.60

Scale: $3/4'' = 1'-0''$

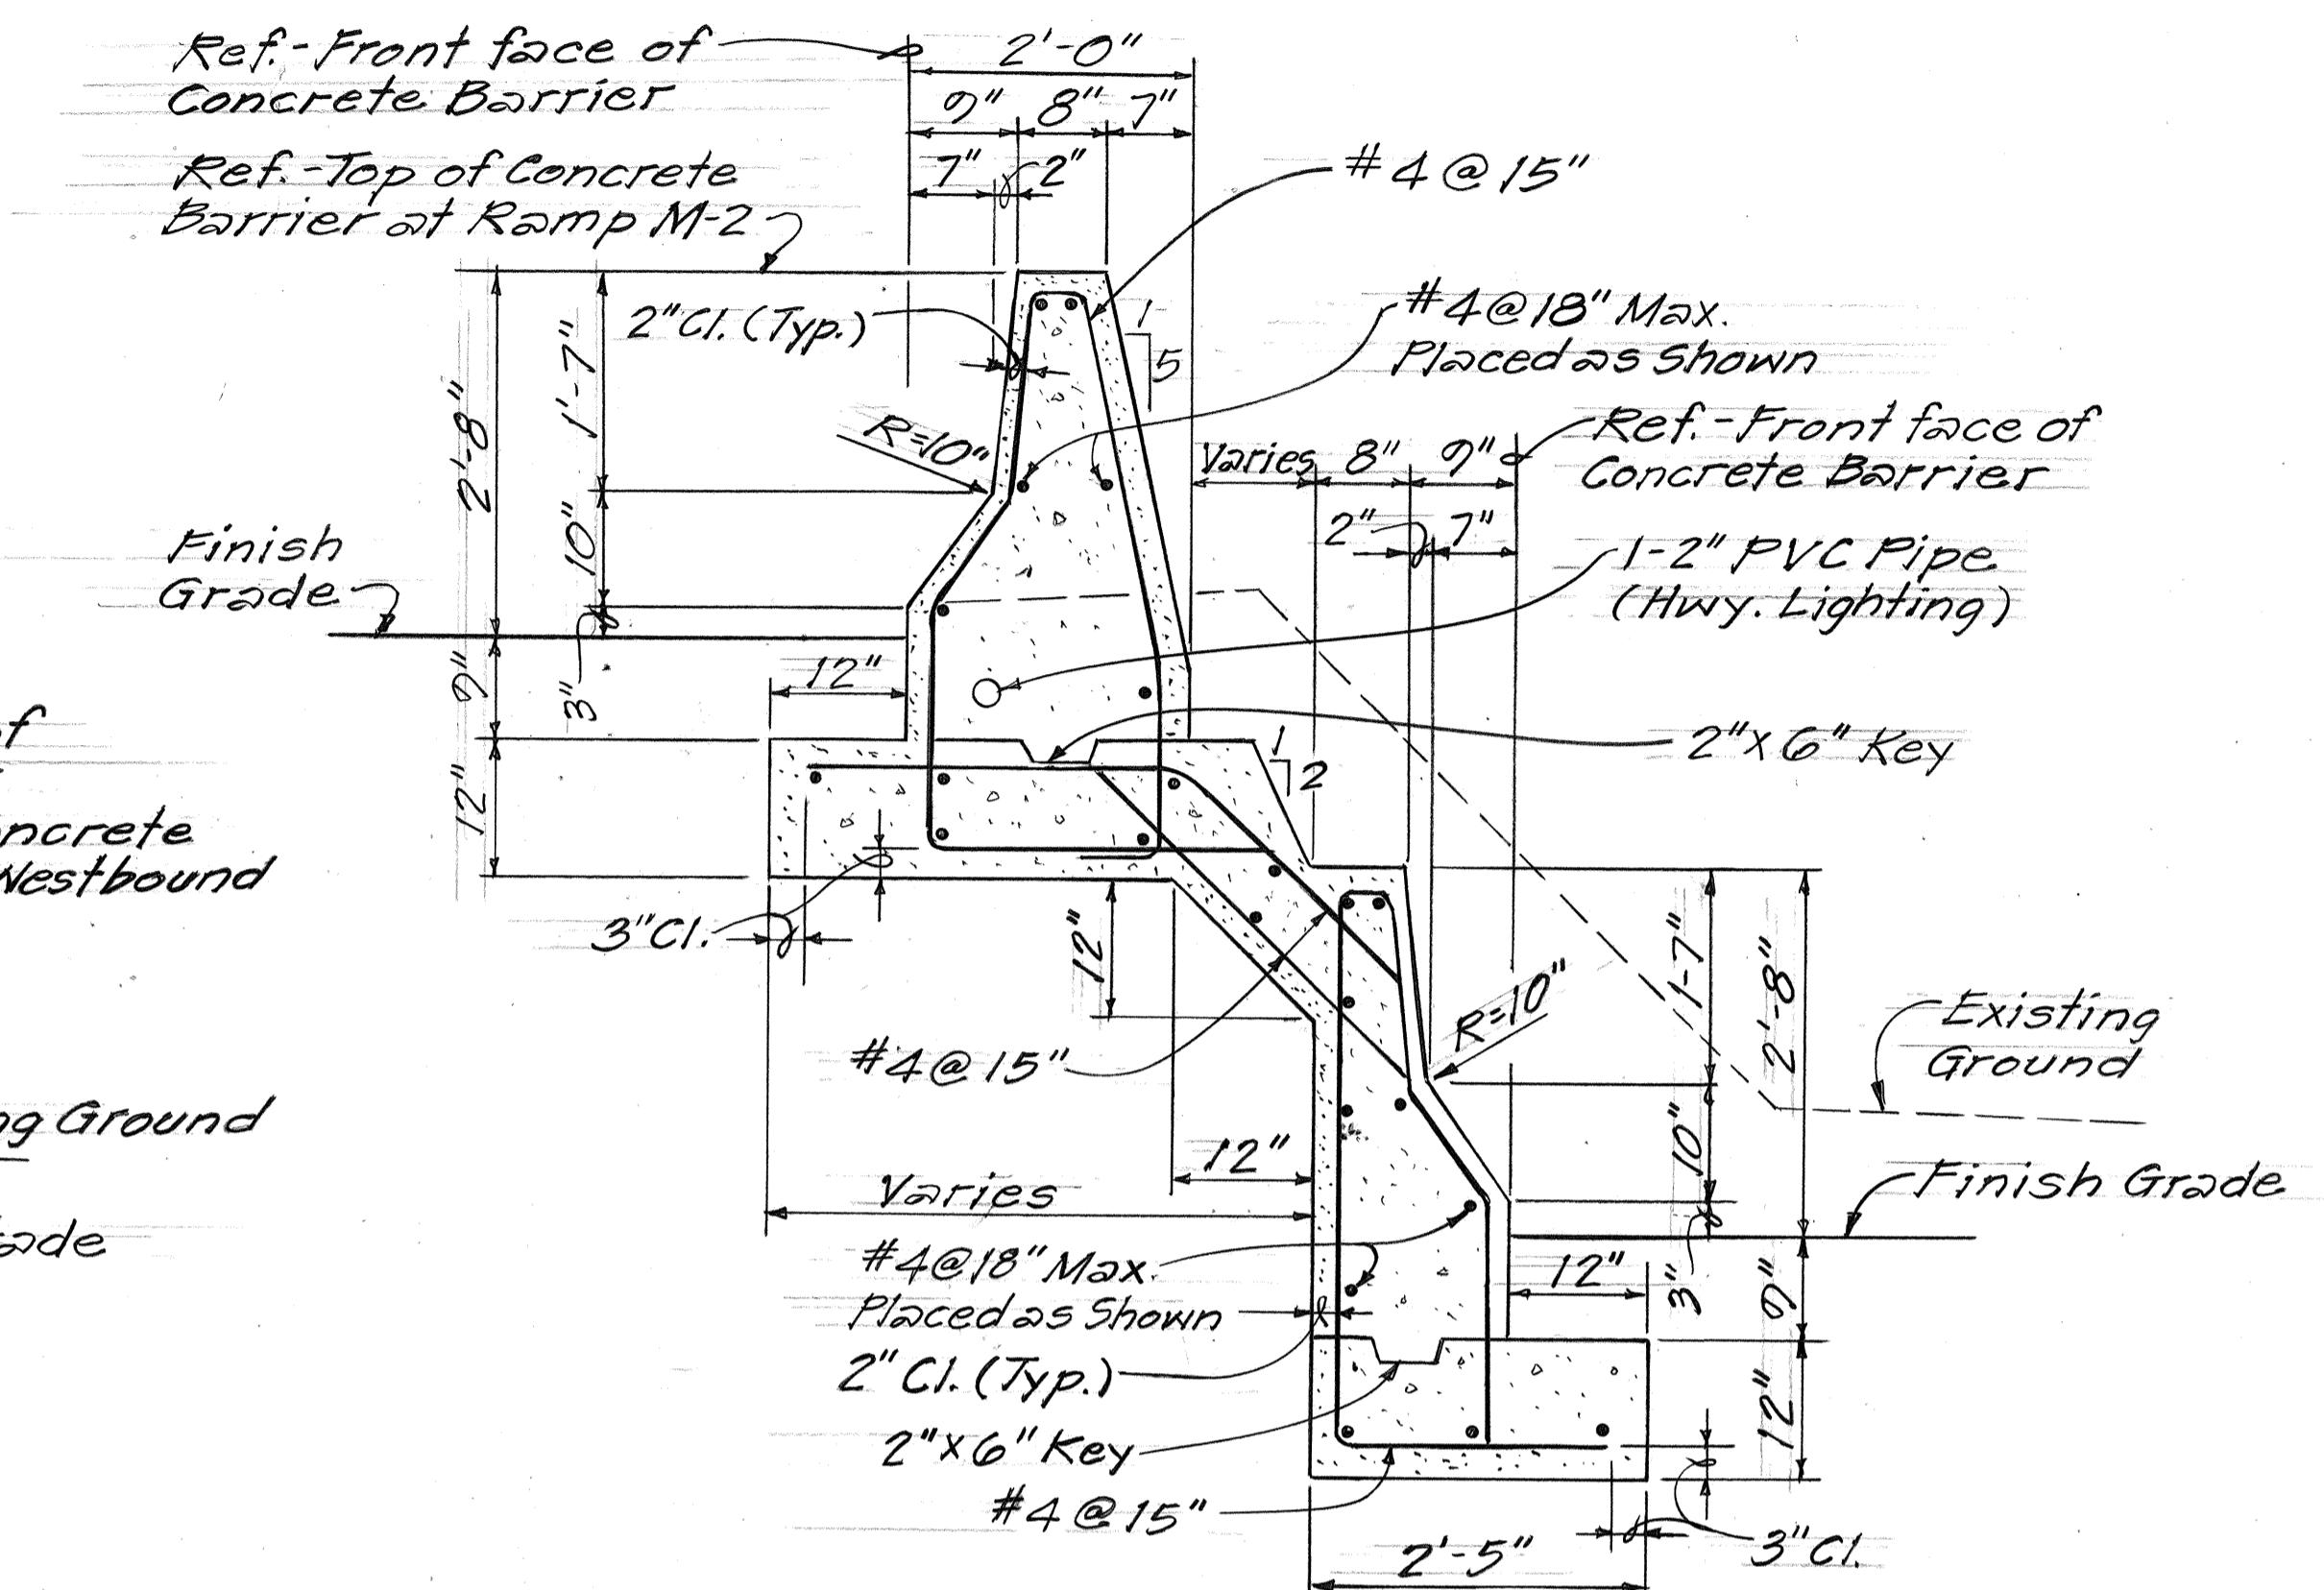

TYPICAL SECTION C-1
33 C.O. 345-1

~~STA. 16+37 TO STA. 16+70~~

M-2 STA. 14+20.60 TO M-2 STA. 13+88.70

Scale: $3/4'' = 1'-0''$

ORIGINAL PLAN	SURVEY PLOTTED BY _____ DRAWN BY _____ TRACED BY _____ DESIGNED BY _____ QUANTITIES BY _____ CHECKED BY _____	DATE _____ " _____ " _____ " _____ " _____ " _____
NOTE BOOK No. _____		

-1-84 Revised Typical Sections
from ~~#~~ Sta. 15+70± to 16+70
added.

DATE REVISION

**STATE OF HAWAII
DEPARTMENT OF TRANSPORTATION**

HIGHWAYS DIVISION

CONCRETE BARRIER "A"

INTERSTATE HI IMPROVEMENTS

MIDDLE STREET TO KALIHI INTERCHA

WESTBOUND LANES

F.A.I PROJ NO. I-HI-1(187)

scale: As Shown Date:


SHEET NO. OF SHEETS

SHEET NO. OF SHEETS
60348


C.O.34 S-1

10. The following table gives the number of hours per week spent by students in various activities.

FED. ROAD DIST. NO.	STATE	FED. AID PROJ. NO.	FISCAL YEAR	SHEET NO.	TOTAL SHEETS
HAWAII	HAW.	1-HI-1(187)	1984	35	197

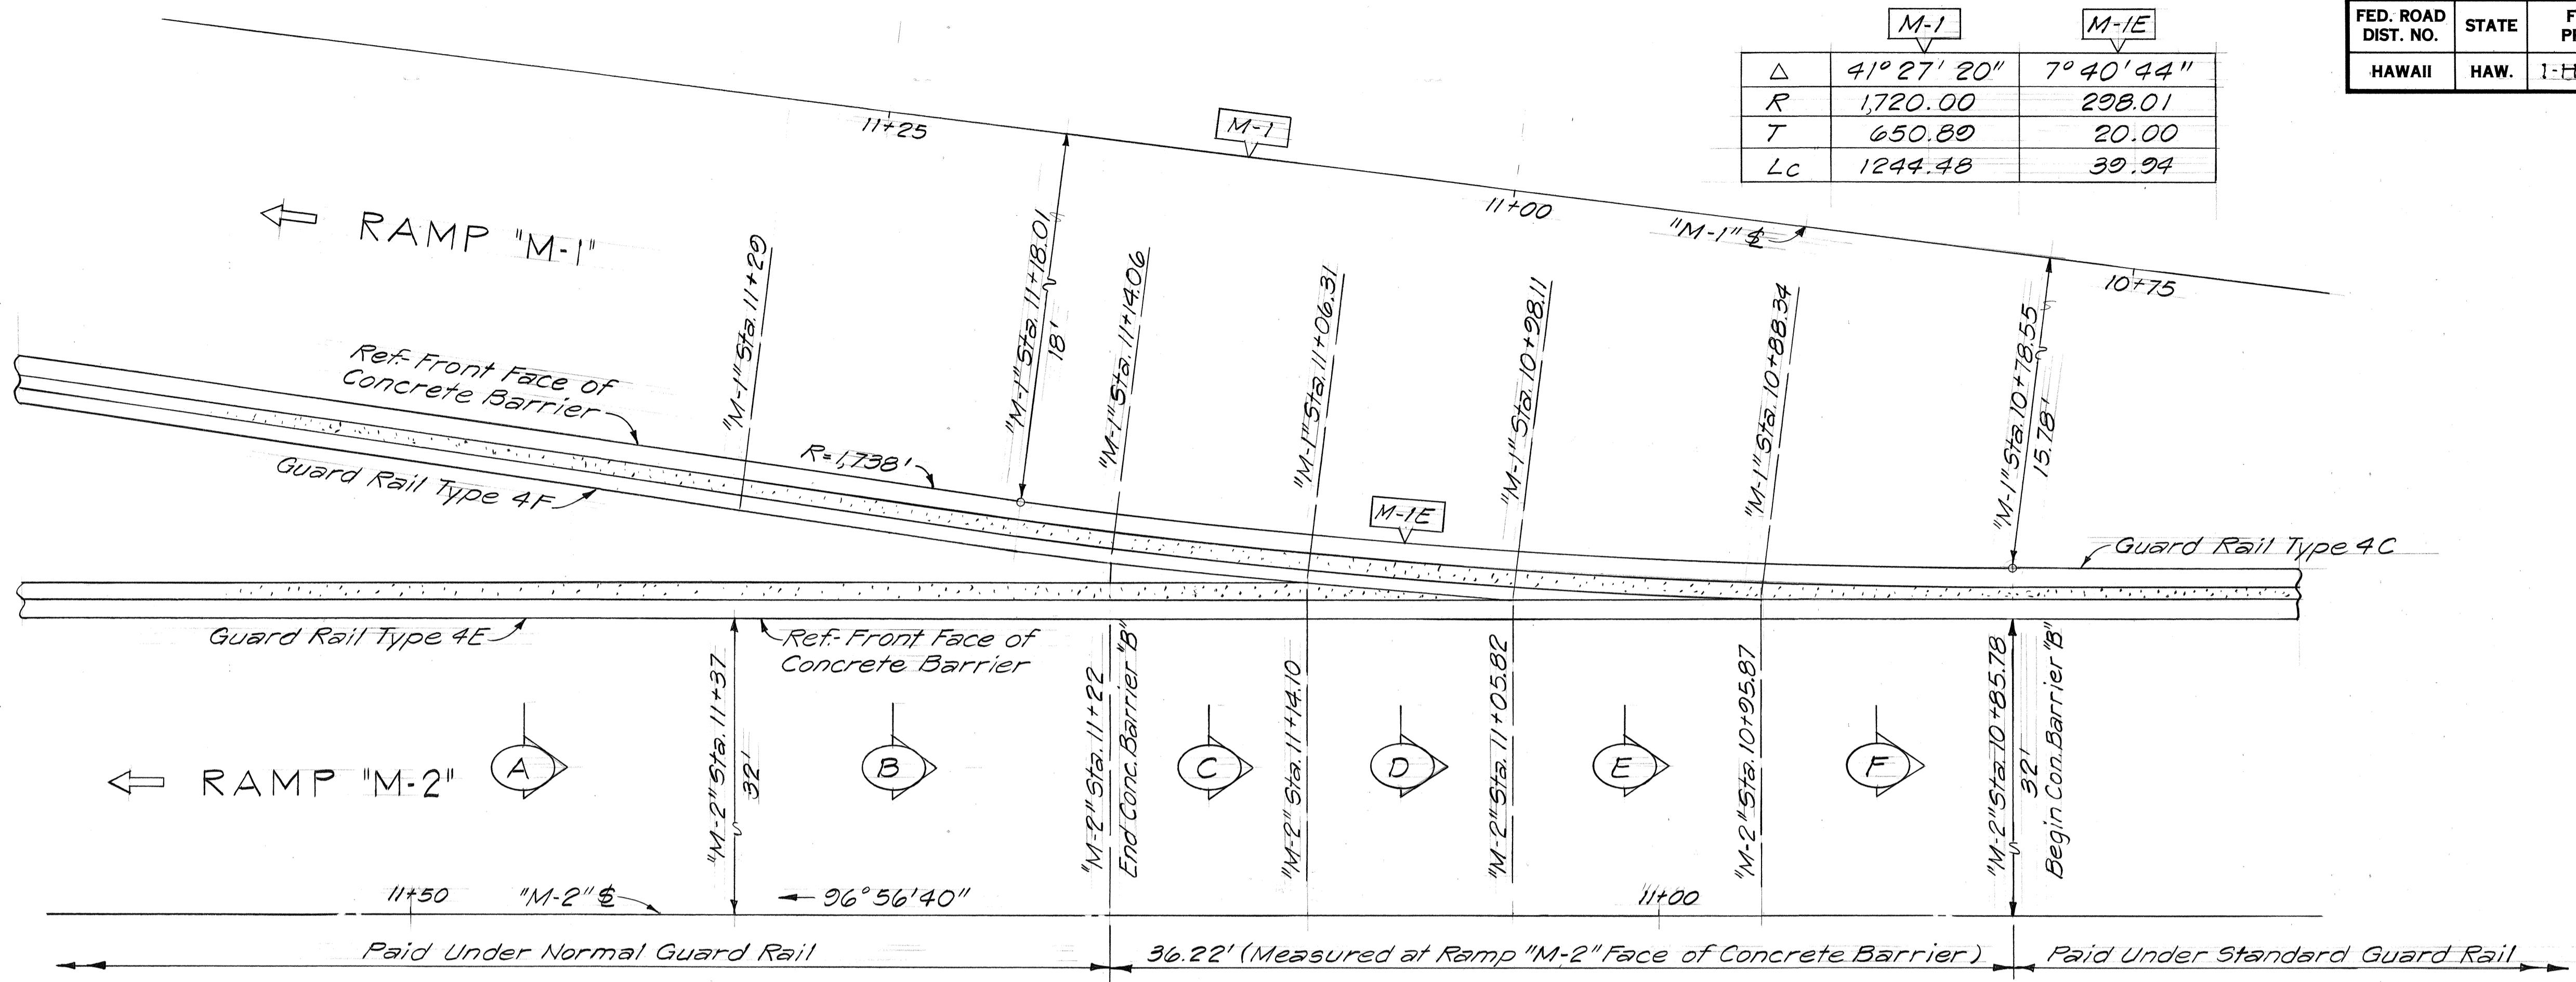

ORIGINAL PLAN	SURVEY PLOTTED BY _____ DRAWN BY _____ TRACED BY _____	DATE _____ " _____ " _____
NOTE BOOK	DESIGNED BY _____ QUANTITIES BY _____ CHECKED BY _____	NO. _____

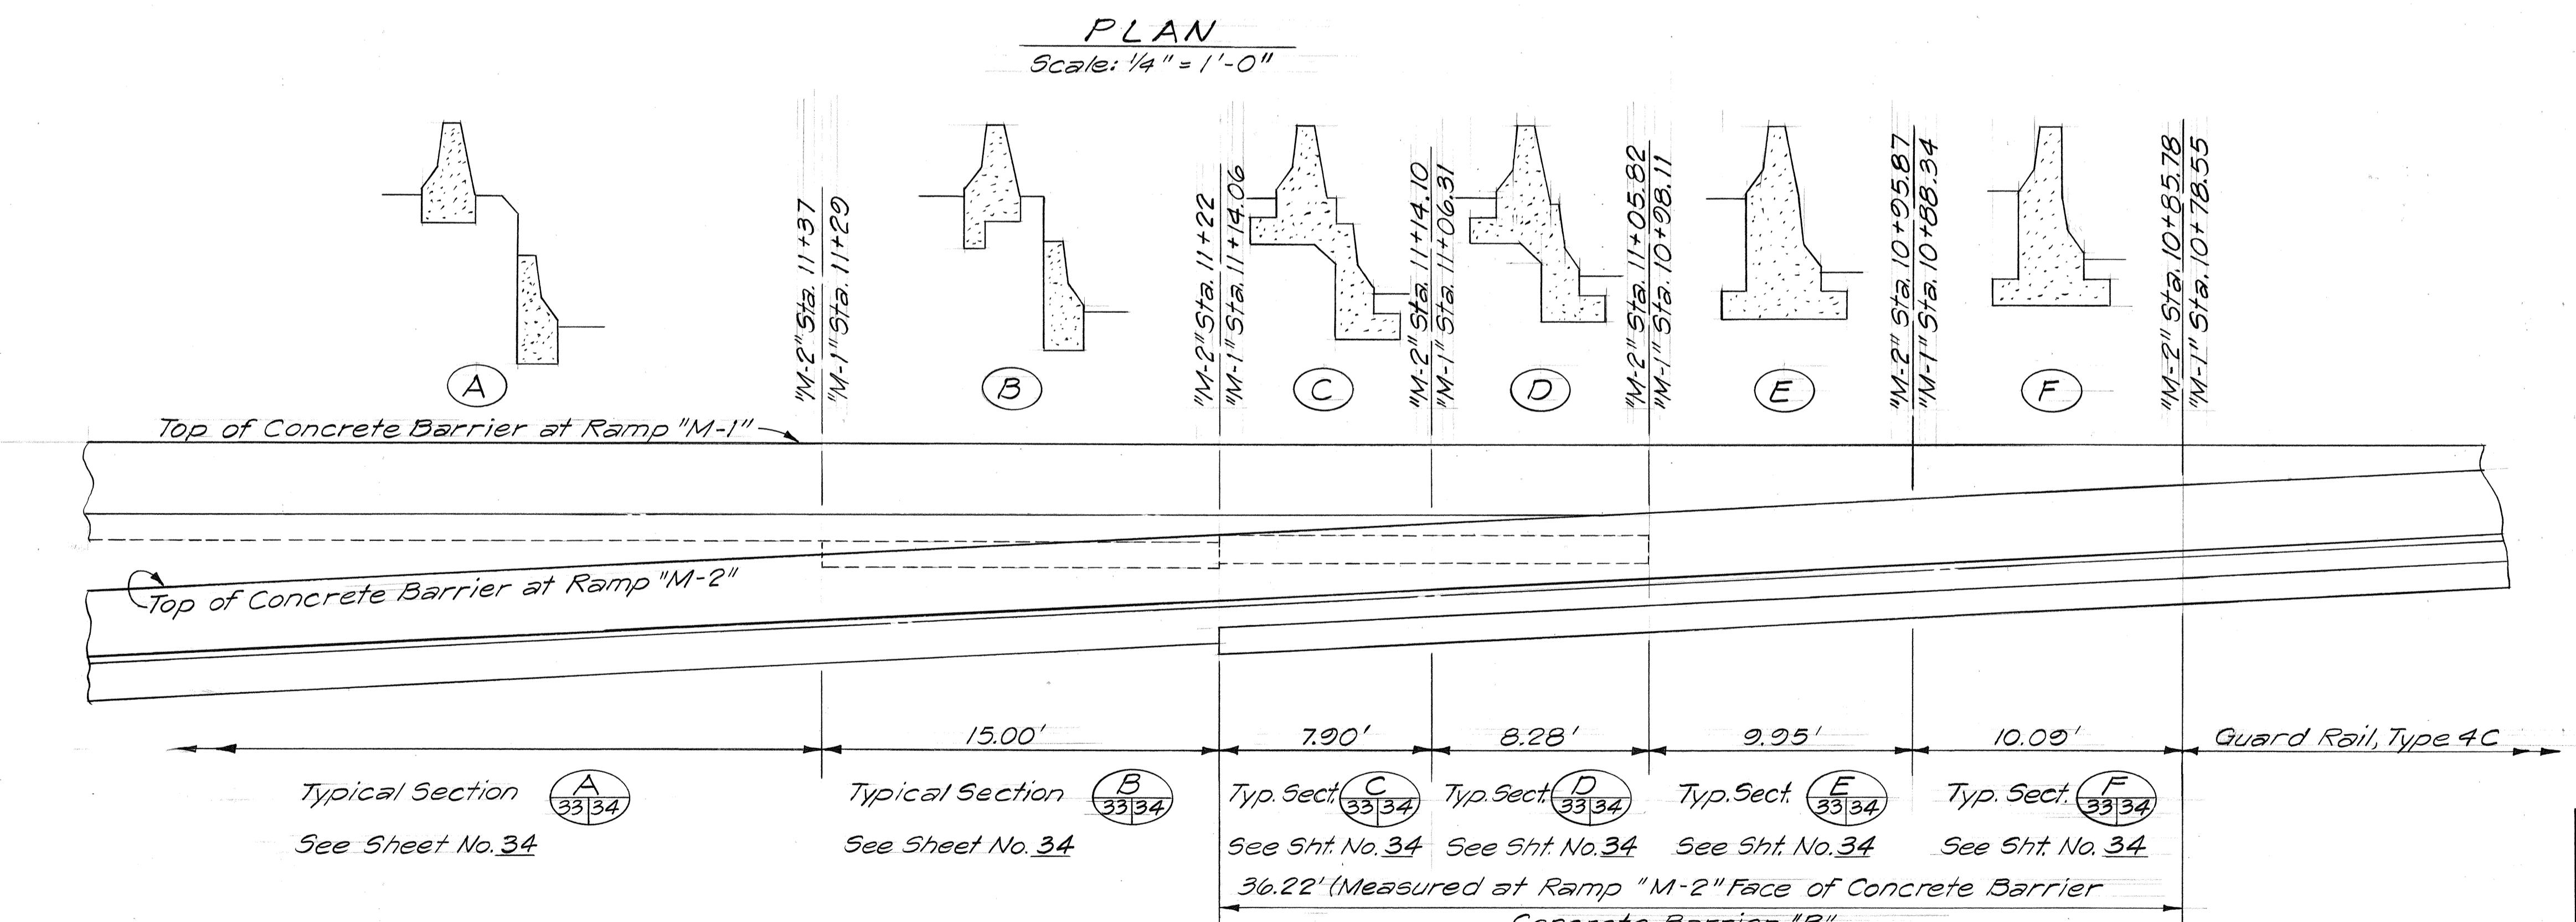

ELEVATION
Scale: $\frac{1}{4}$ " = 1'-0"


CONCRETE BARRIER "B"

"M-2" STA. 10+85.78 TO "M-2" STA. 11+22

"M-1" STA. 10+78.55 TO "M-1" STA. 11+14.06


STATE OF HAWAII
DEPARTMENT OF TRANSPORTATION
HIGHWAYS DIVISION

FED. ROAD DIST. NO.	STATE	FED. AID PROJ. NO.	FISCAL YEAR	SHEET NO.	TOTAL SHEETS
HAWAII	HAW.	I-HI-1(187)	1984	36	197

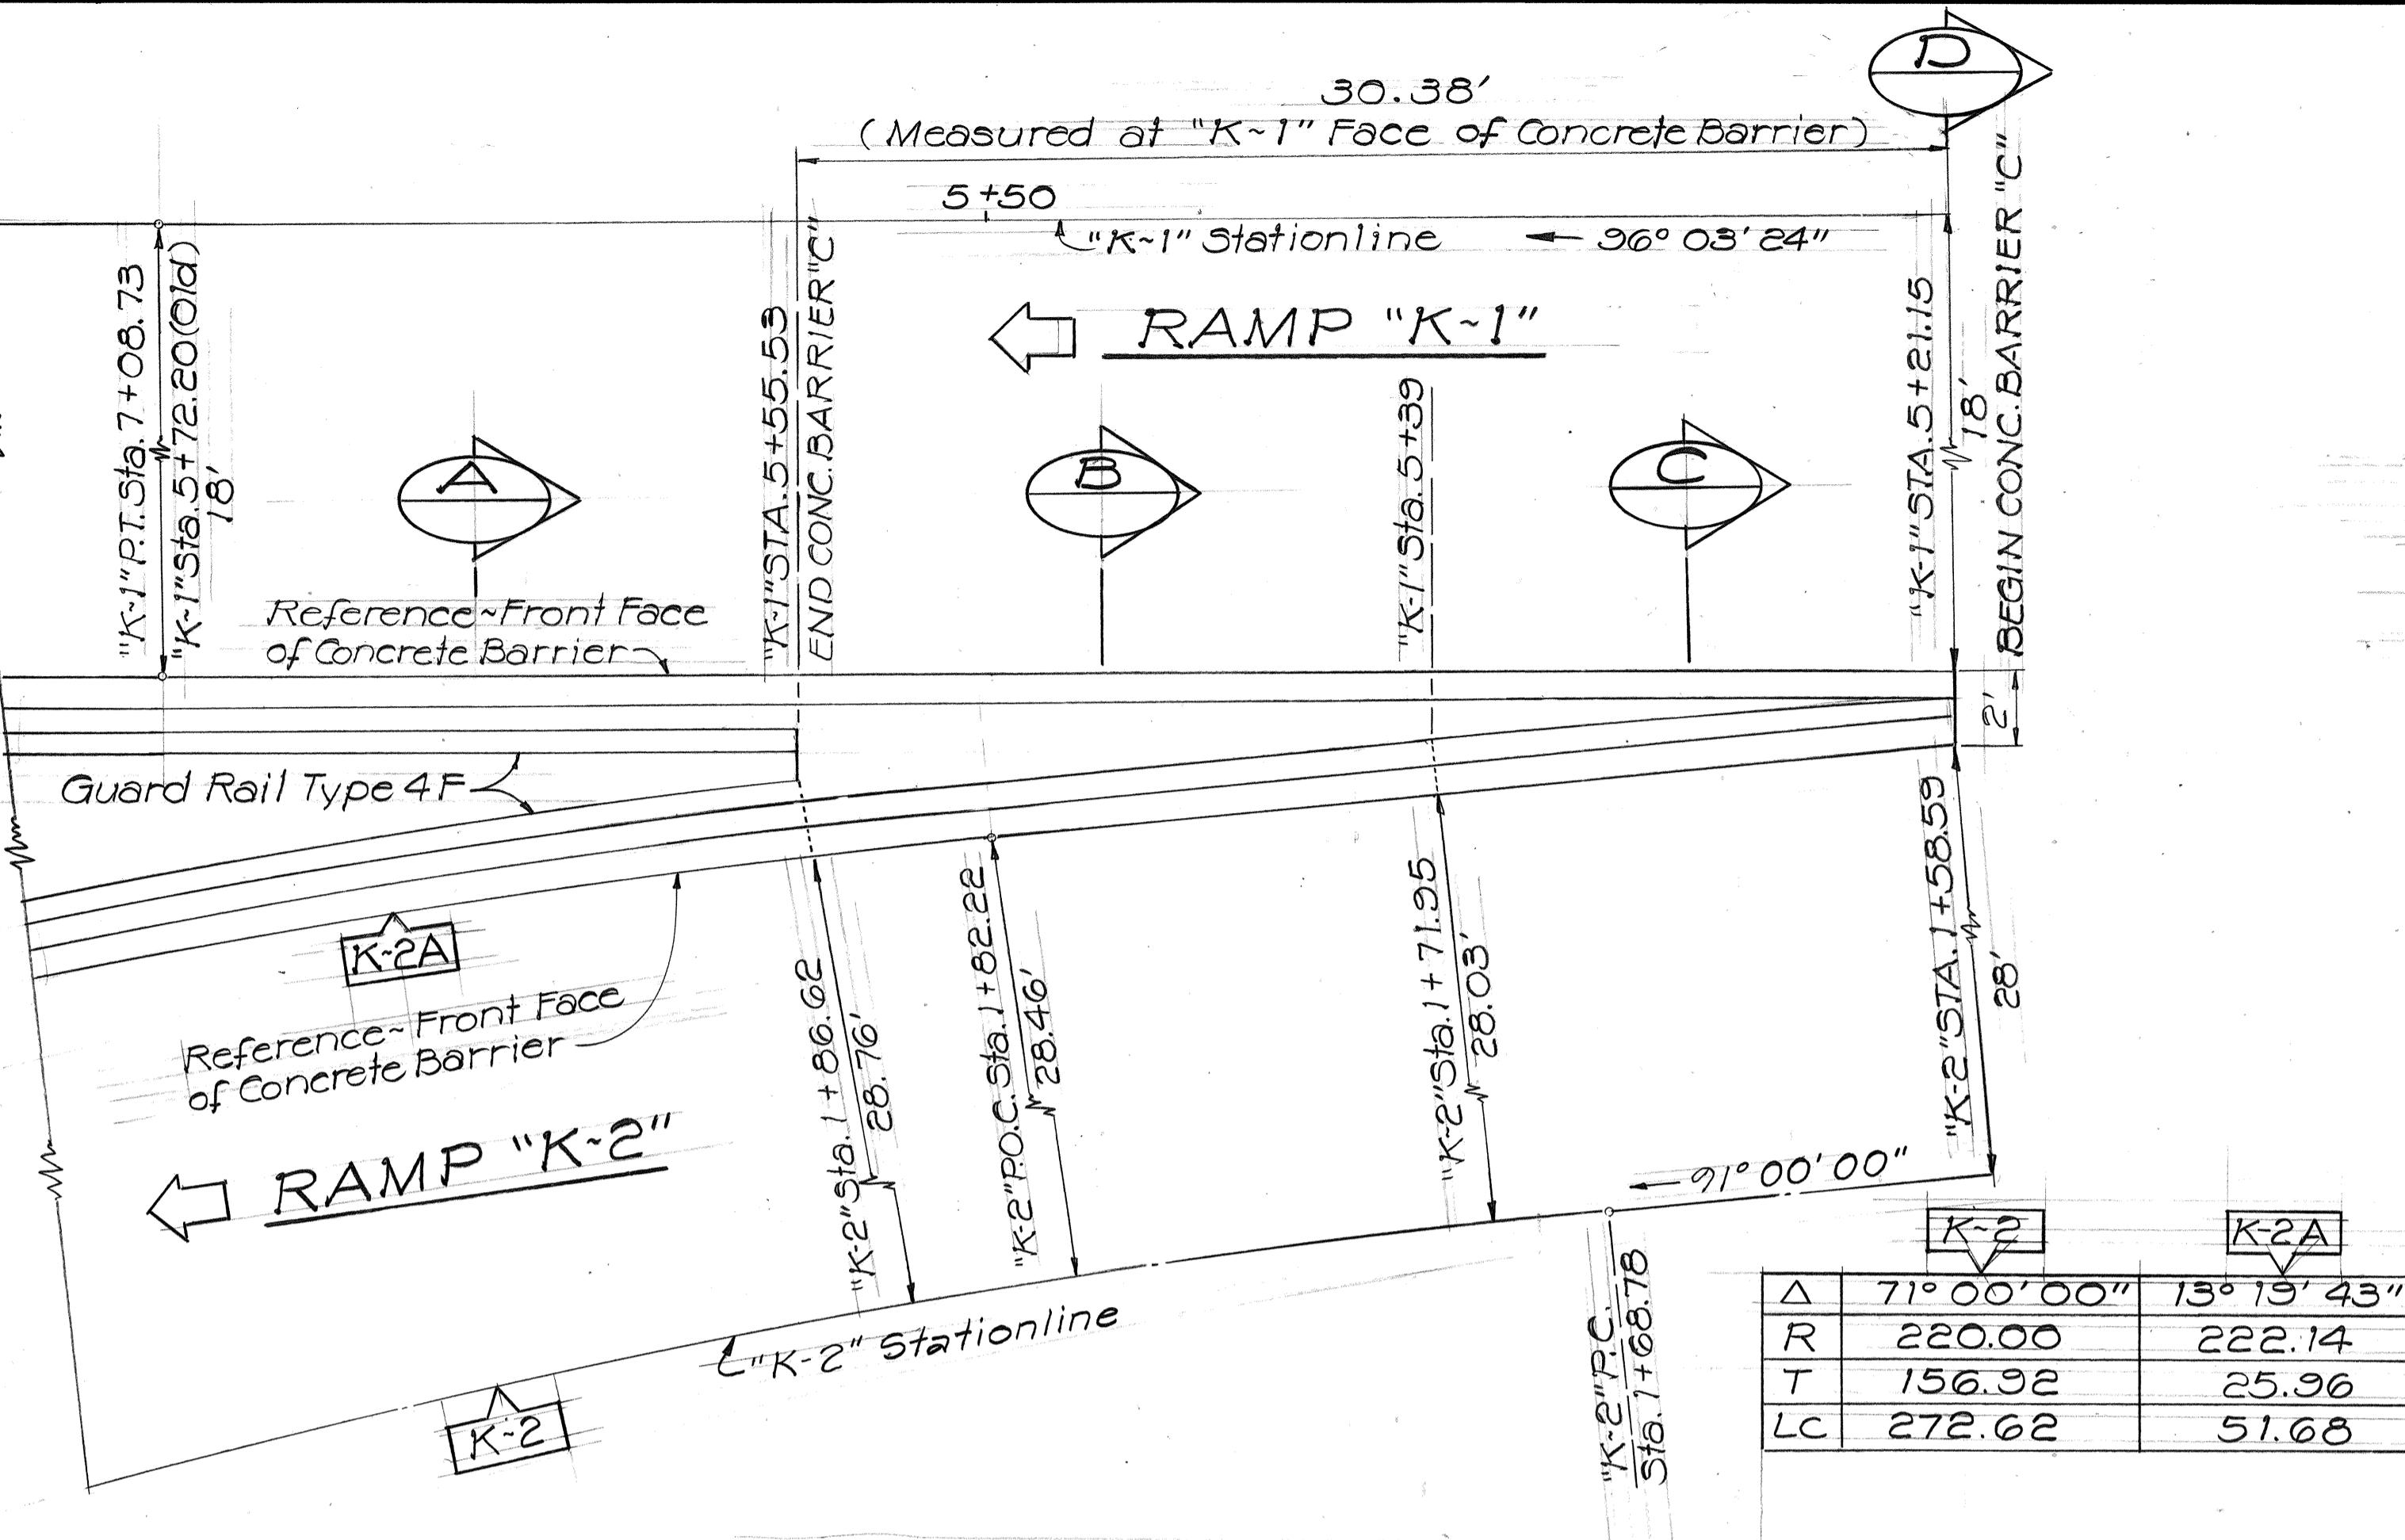


TYPICAL SECTION

Scale: $\frac{3}{4}'' = 1'-0''$

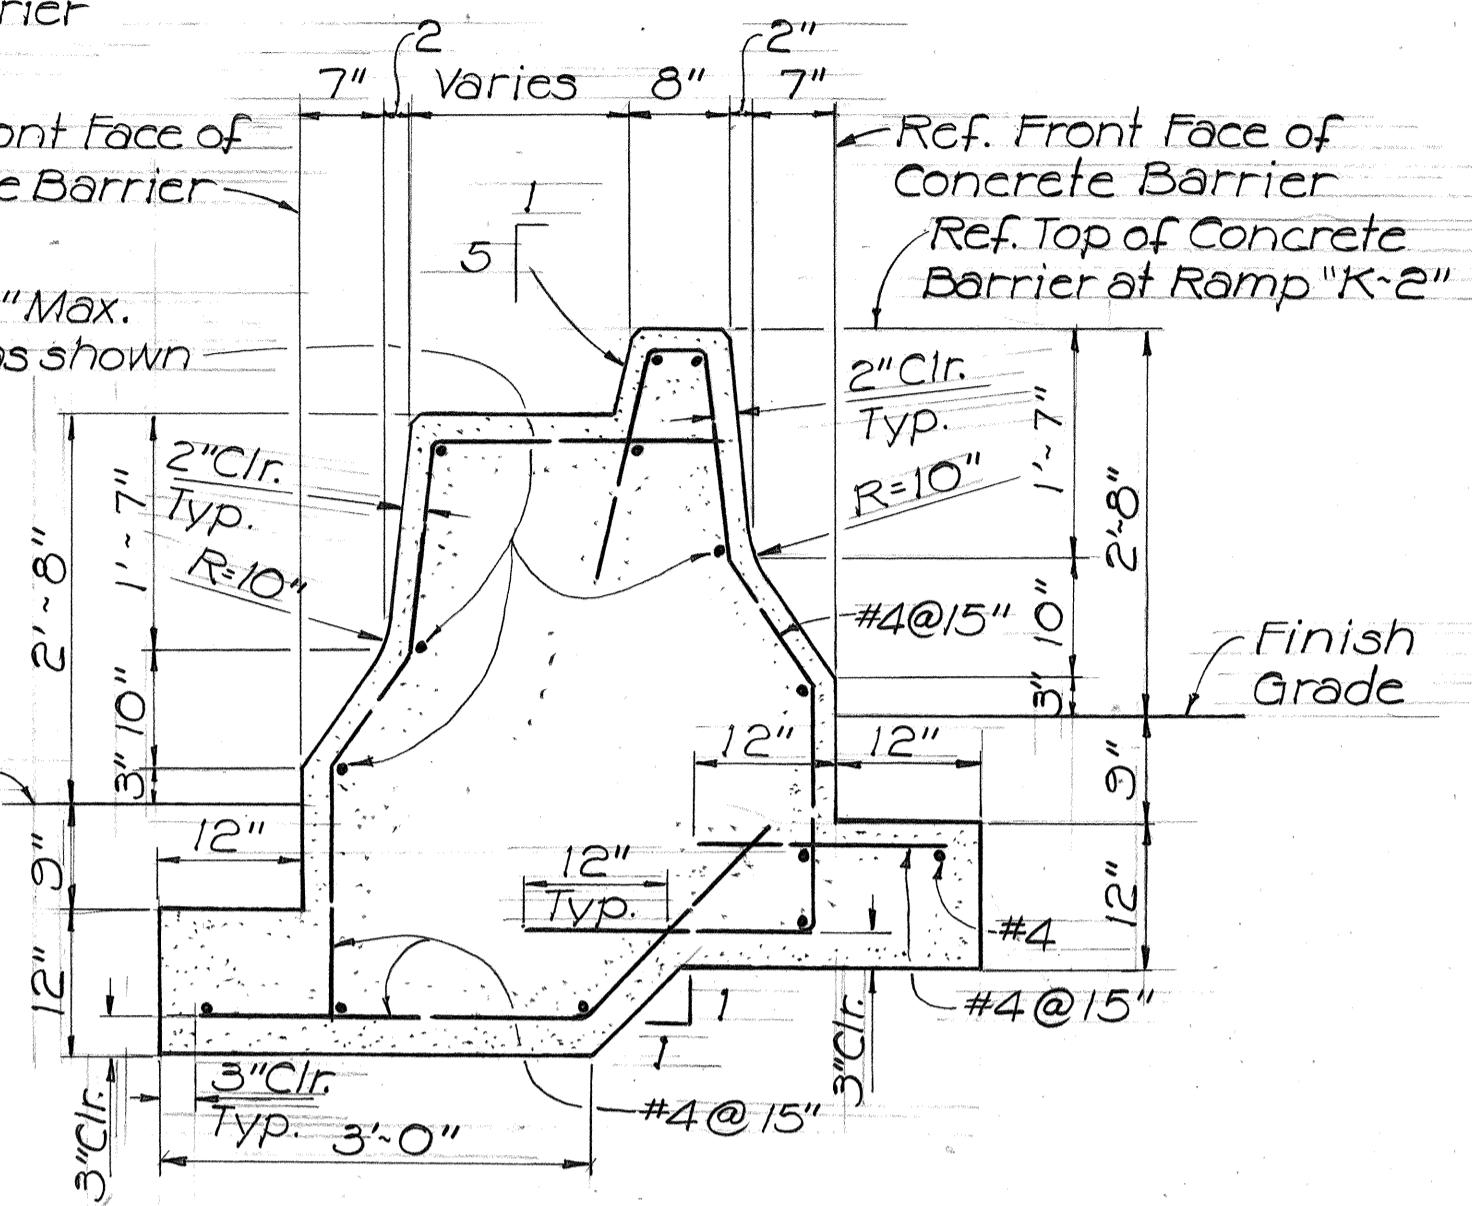


TYPICAL SECTION

Scale: $3/4'' = 1' \sim 0''$

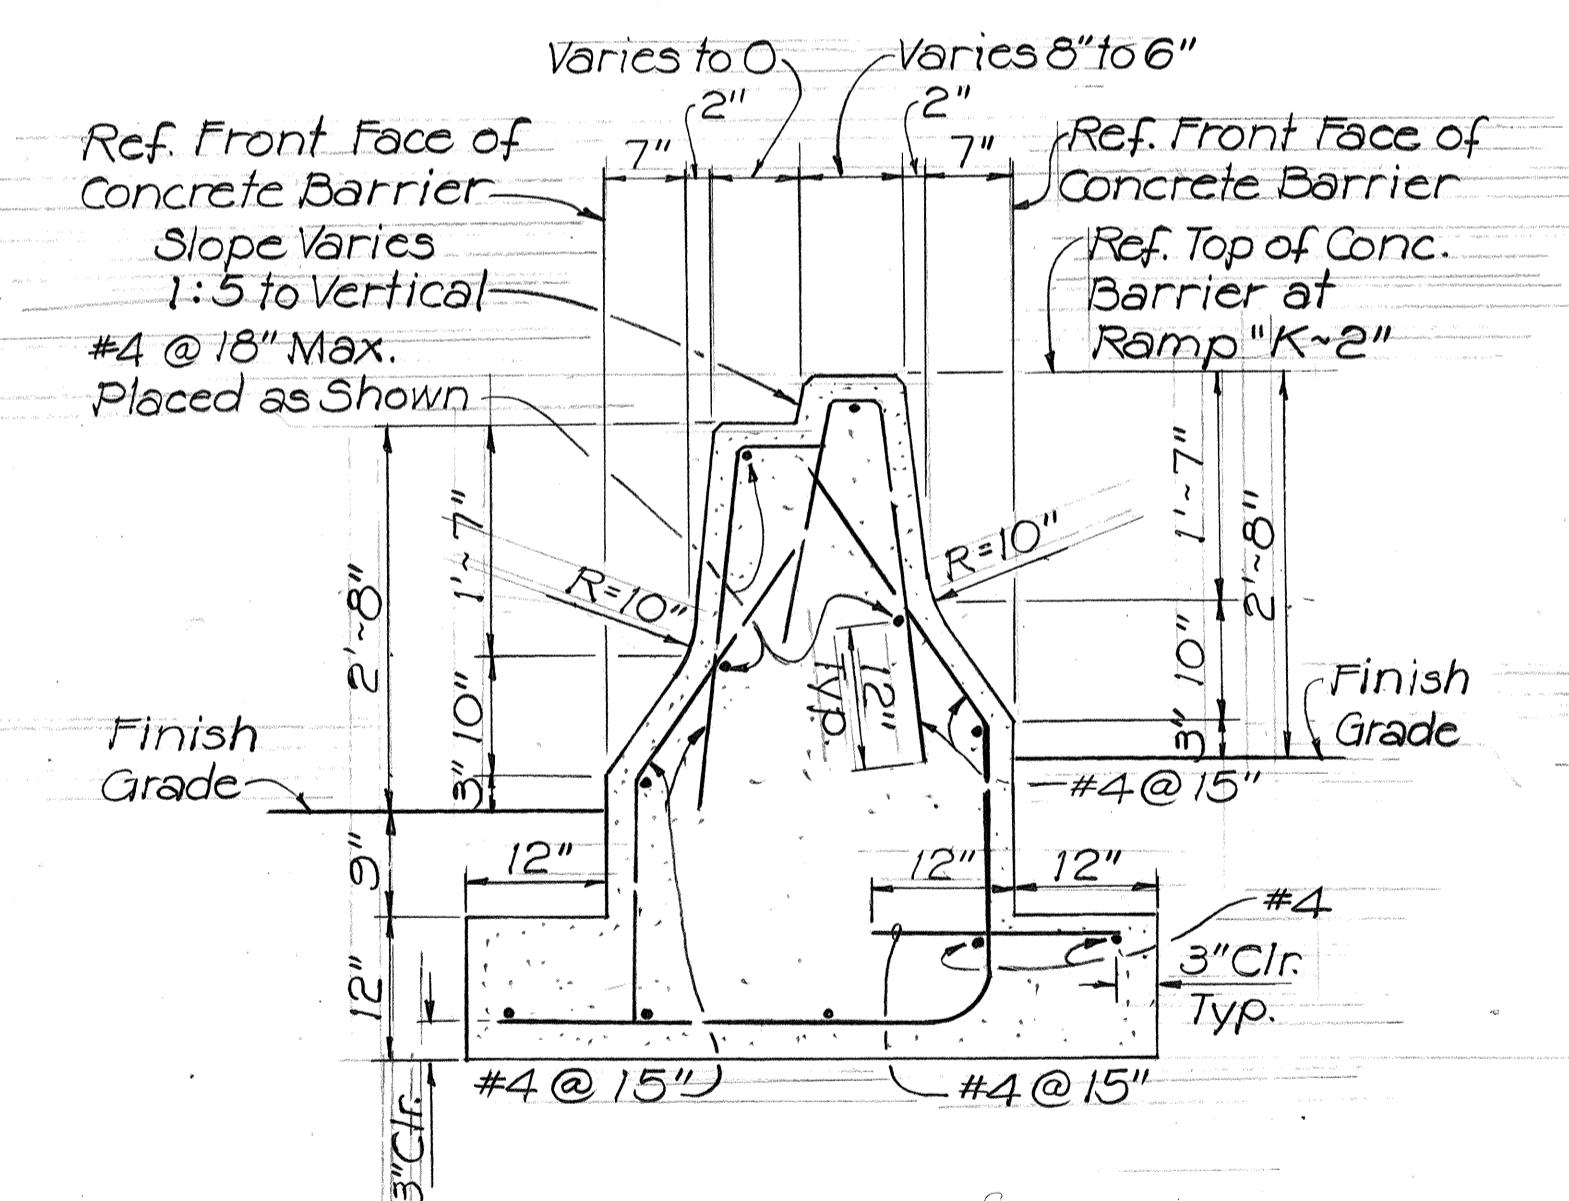

TYPICAL SECTION


Scale: $\frac{3}{4} = 1'-0''$

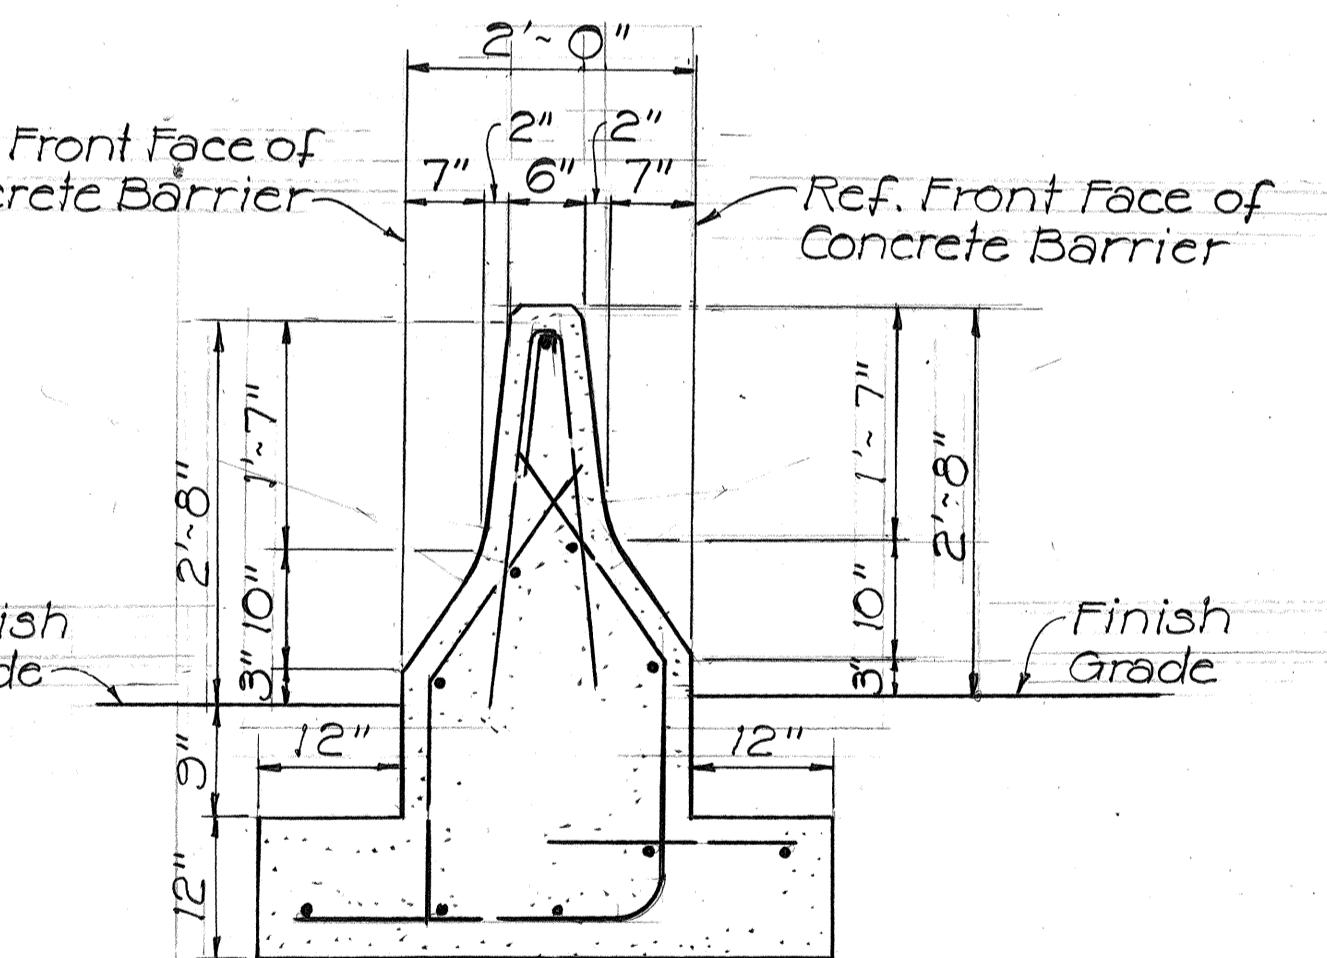

SECTION

Scale: $\frac{3}{4}'' = 1' \sim 0''$

ORIGINAL PLAN	SURVEY PLOTTED BY _____ DRAWN BY _____ TRACED BY _____	DATE _____ " _____ " _____
NOTE BOOK No. _____	DESIGNED BY _____ QUANTITIES BY _____ CHECKED BY _____	" _____ " _____ " _____

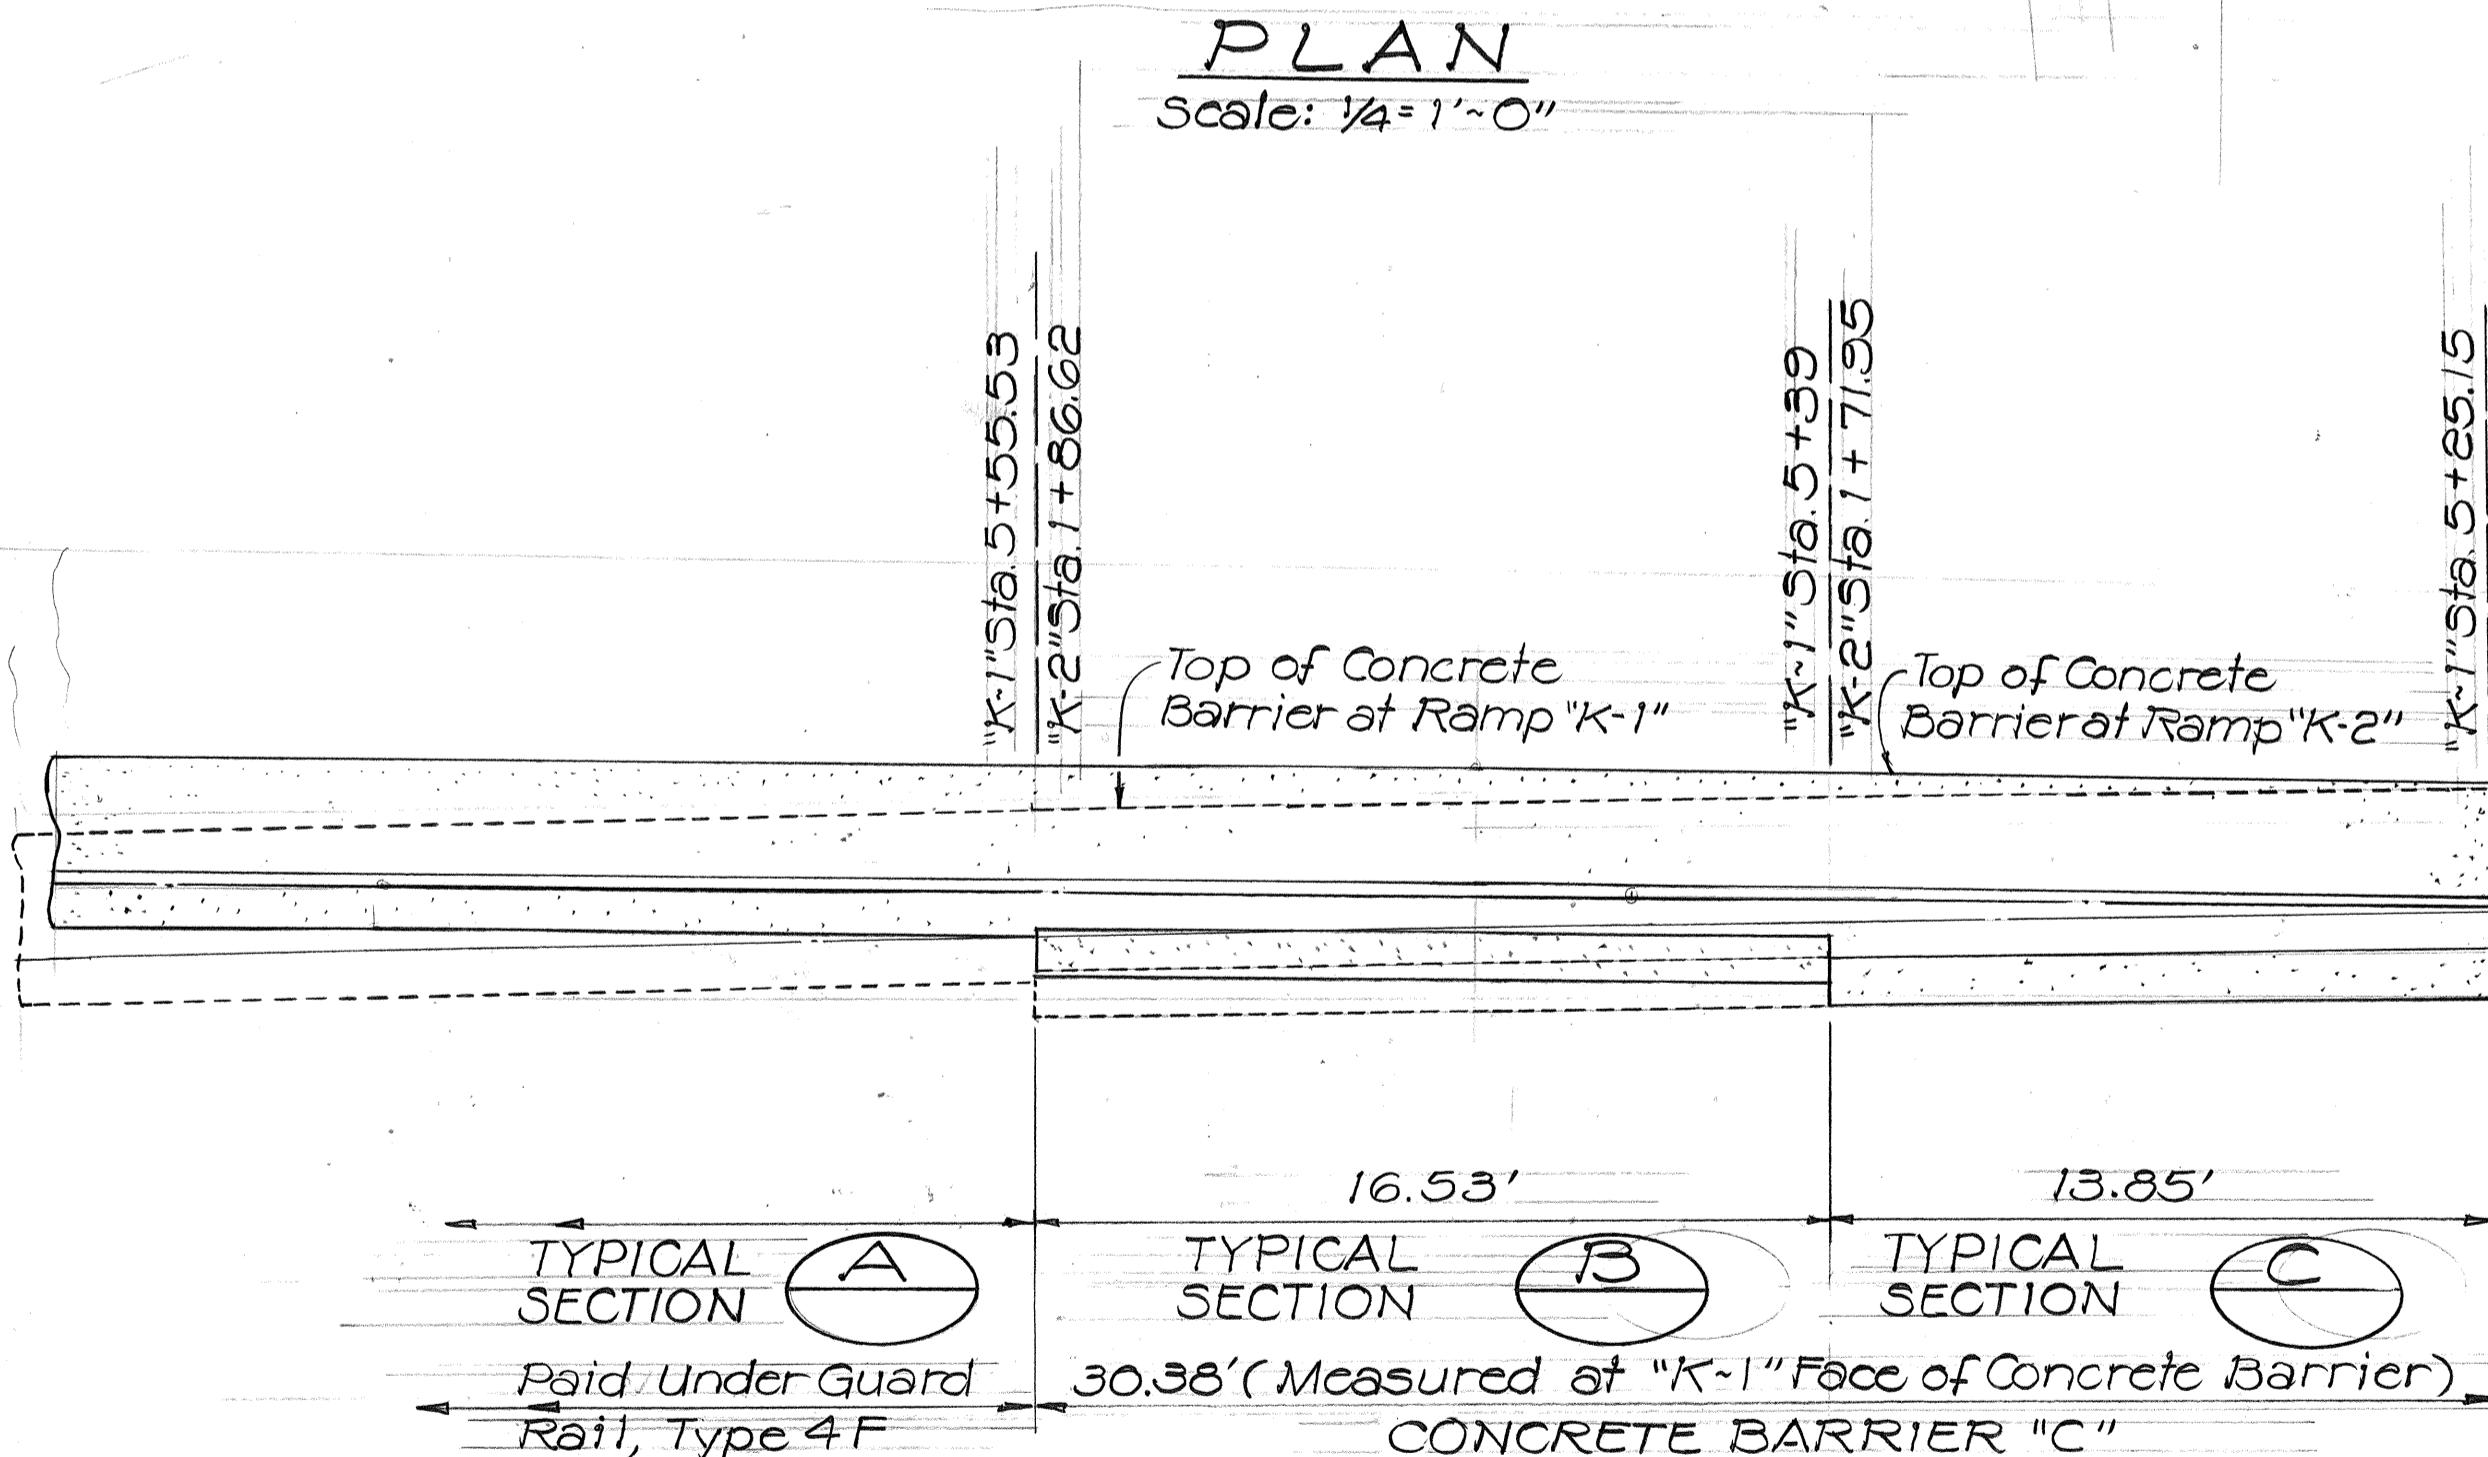

ELEVATION

Scale: $\frac{1}{4}$ " = 1'-0"


CONCRETE BARRIER "C"

"K-1" STA. 5 + 25.15 TO "K-1" STA. 5 + 55.53


"K-2" STA. 1 + 58.59 TO "K-2" STA. 1 + 86.62

STATE OF HAWAII
DEPARTMENT OF TRANSPORTATION
HIGHWAYS DIVISION
CONCRETE BARRIER "C"
INTERSTATE ROUTE H-1 IMPROVEMENTS
MIDDLE STREET TO KALIHI INTERCHANGE
WESTBOUND LANES
F.A.I. PROJ. NO. I-HI-1(187)
SCALE: As Shown
SHEET No. / OF / SHEETS


ED. ROAD DIST. NO.	STATE	FED. AID PROJ. NO.	FISCAL YEAR	SHEET NO.	TOTAL SHEETS
HAWAII	HAW.	I-HI-1(187)	1984	C0.365-1	

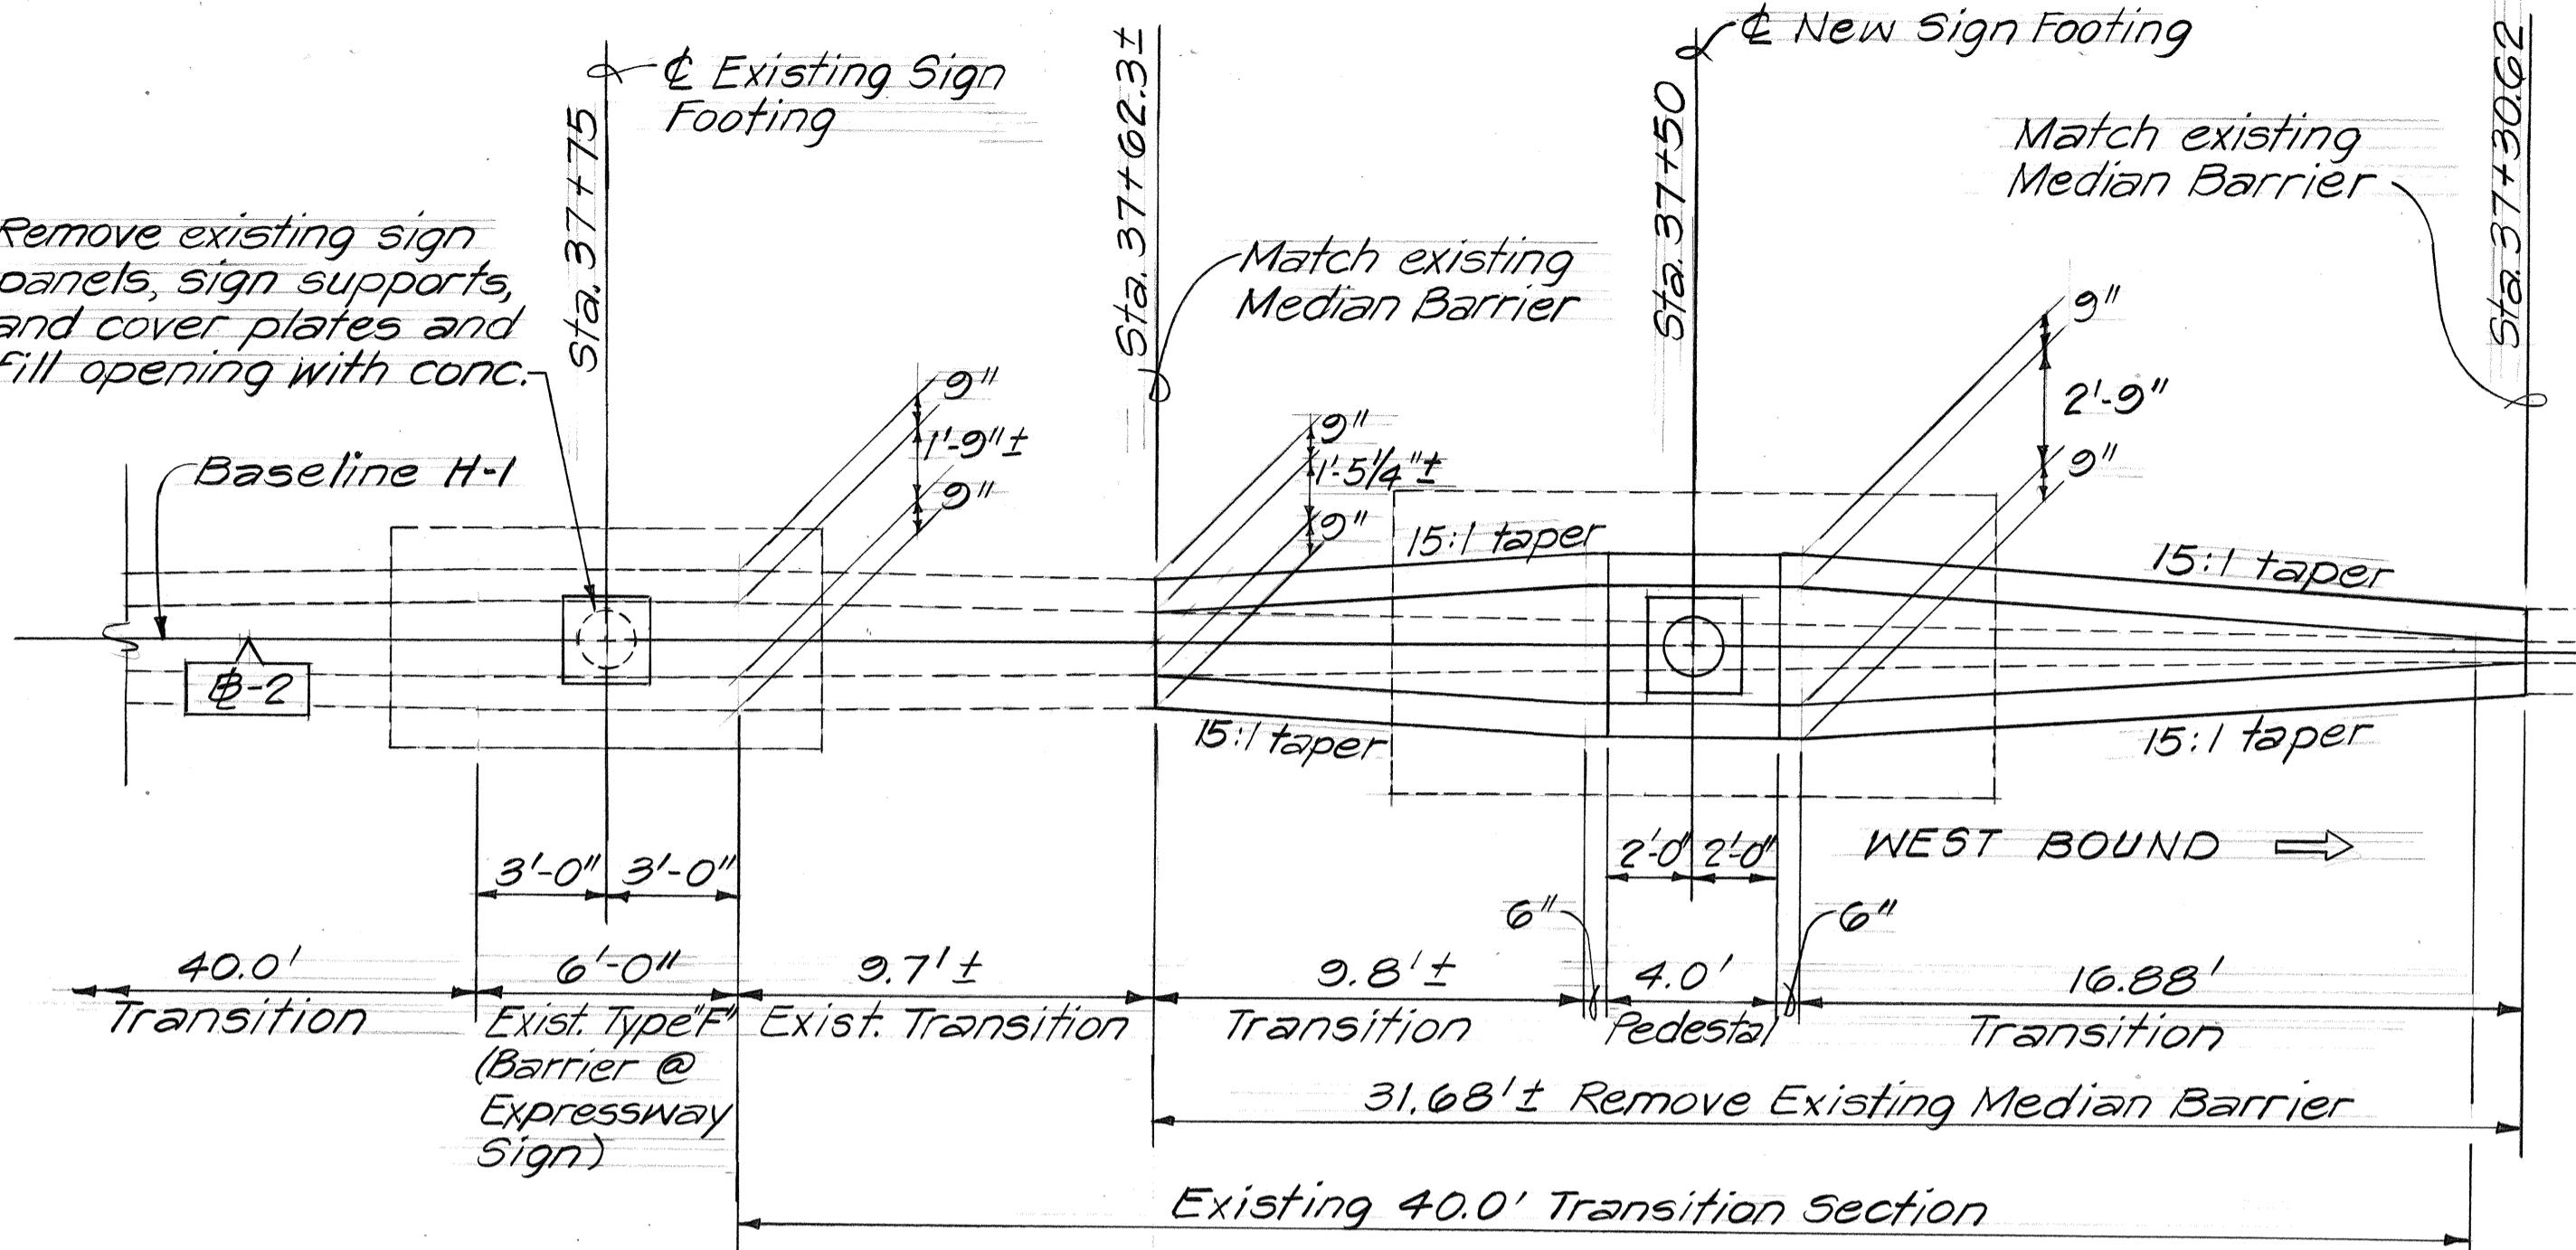


PLAN

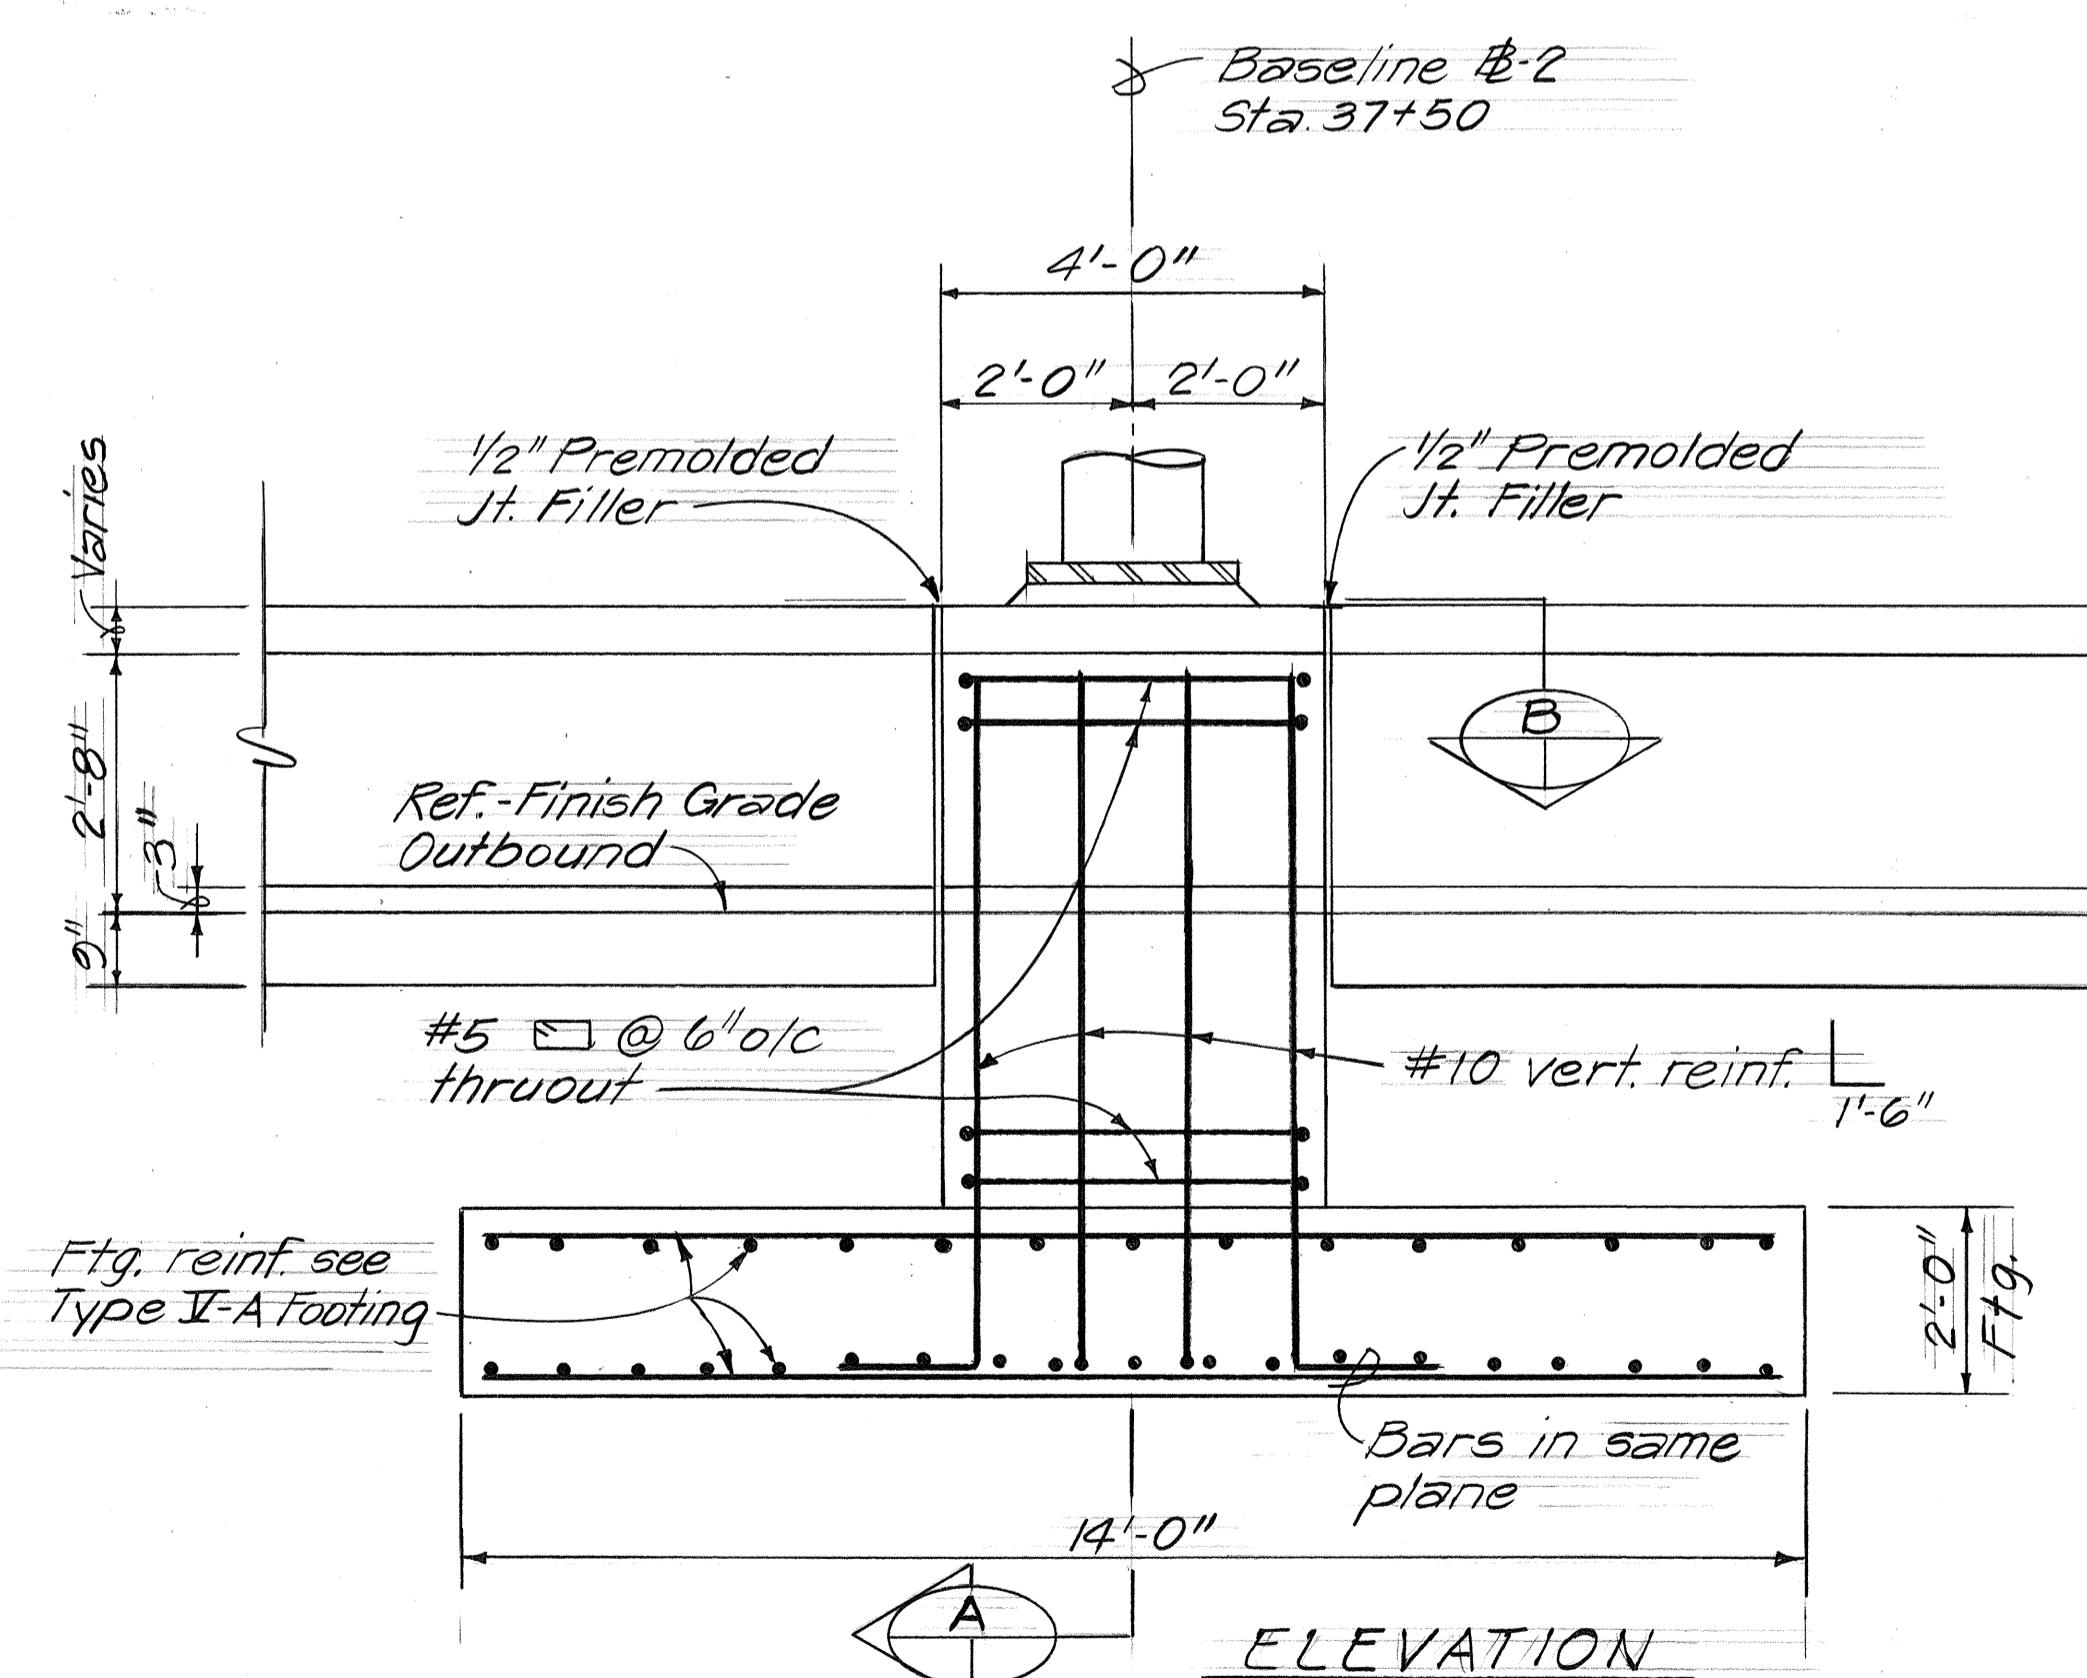

B STA. 37+30.62 TO B STA. 37+62.30 ±
GUARD RAIL TYPE 4B TRANSITION SECTION, SIG.
PEDESTAL AND SIGN FOOTING DETAILS

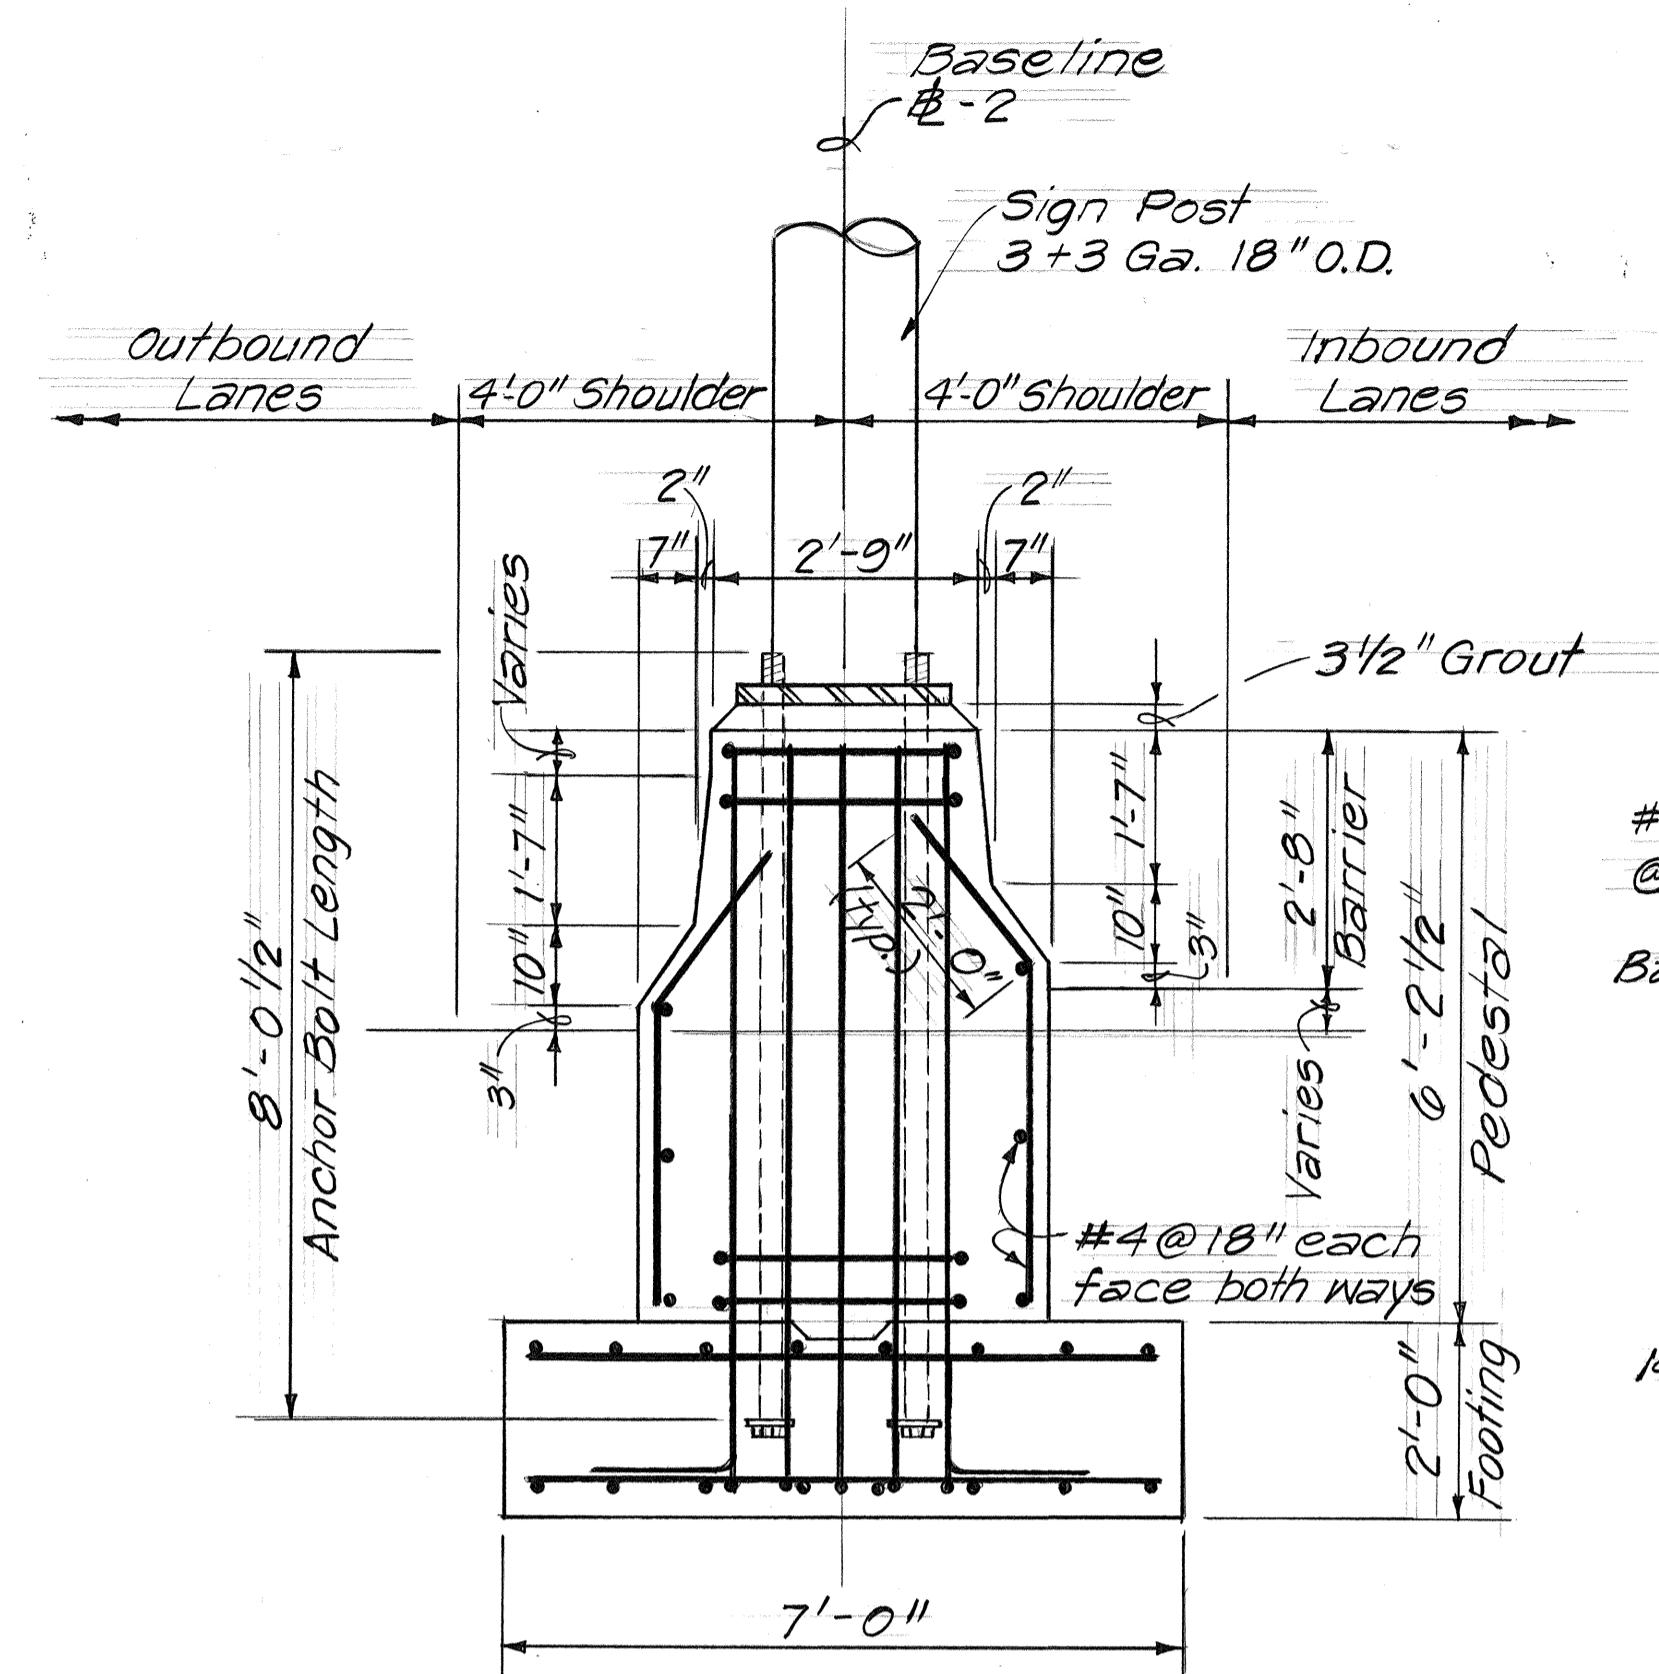


SECTION

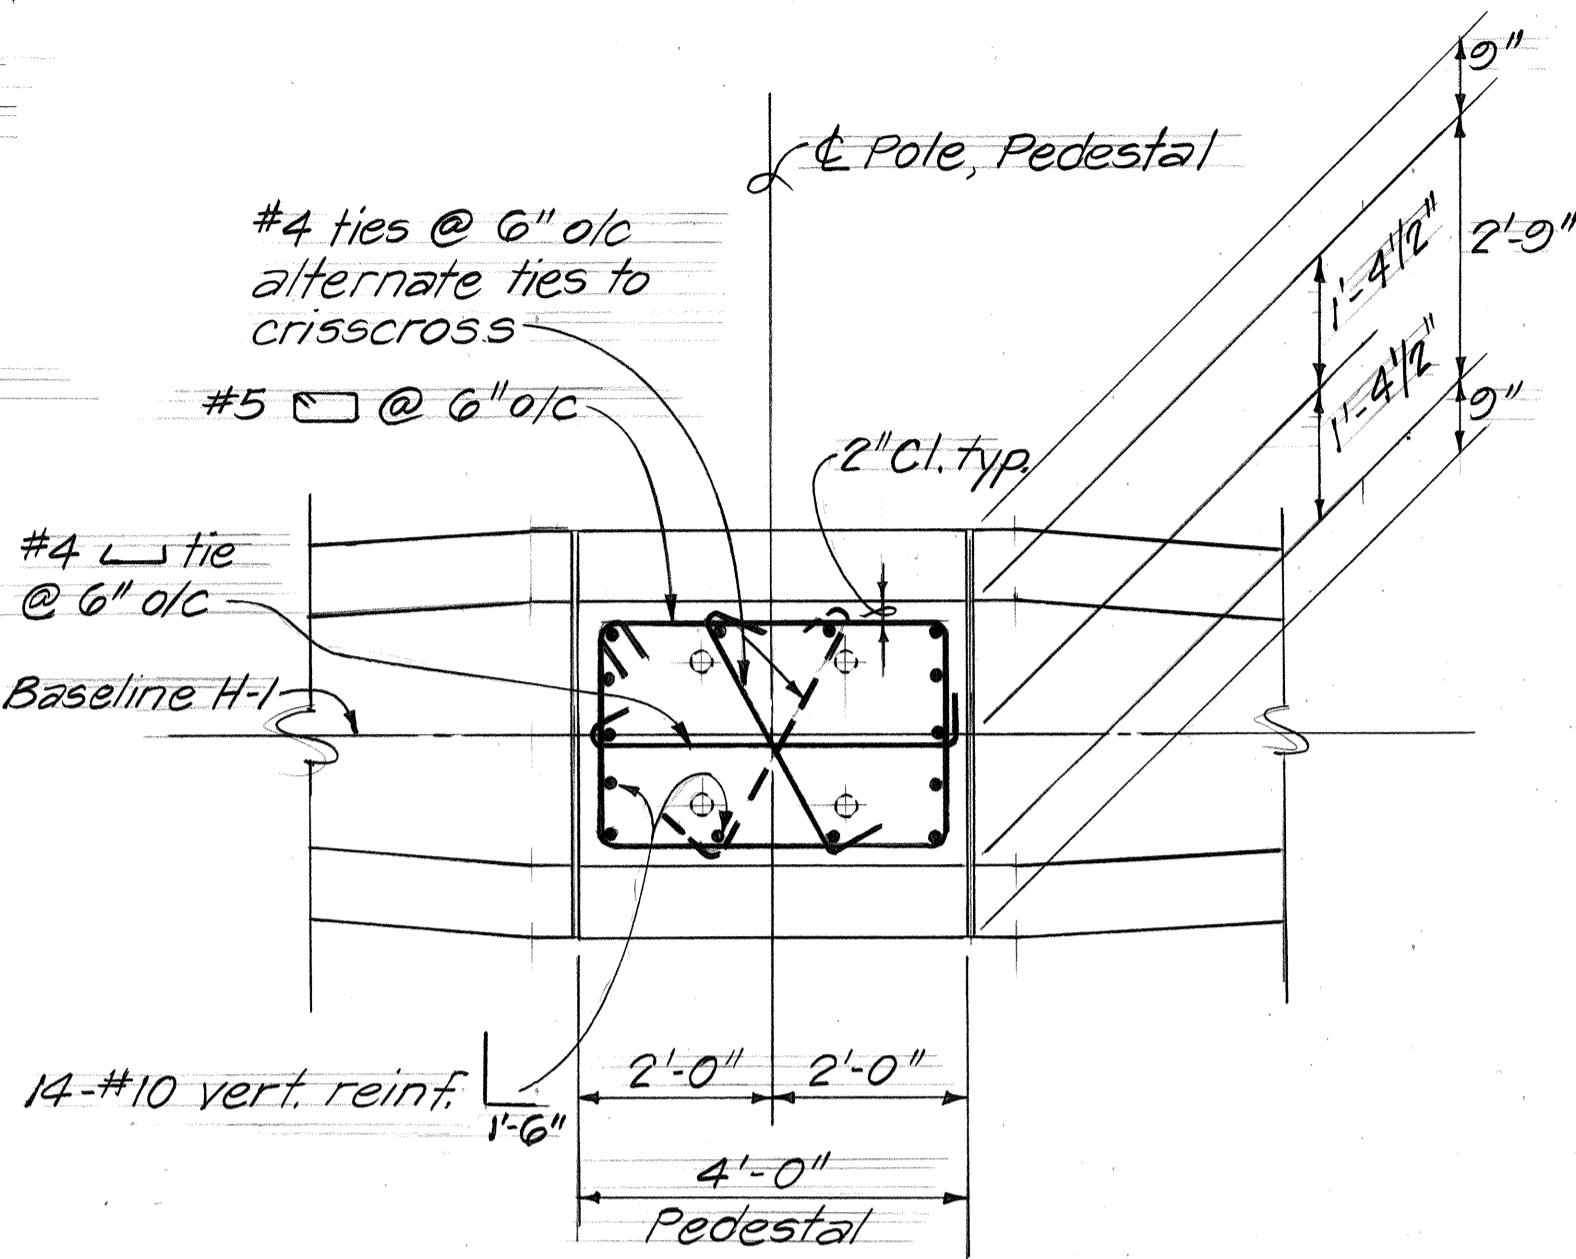

SECTION

Scale: $\frac{1}{2}$ " = 1'-0"



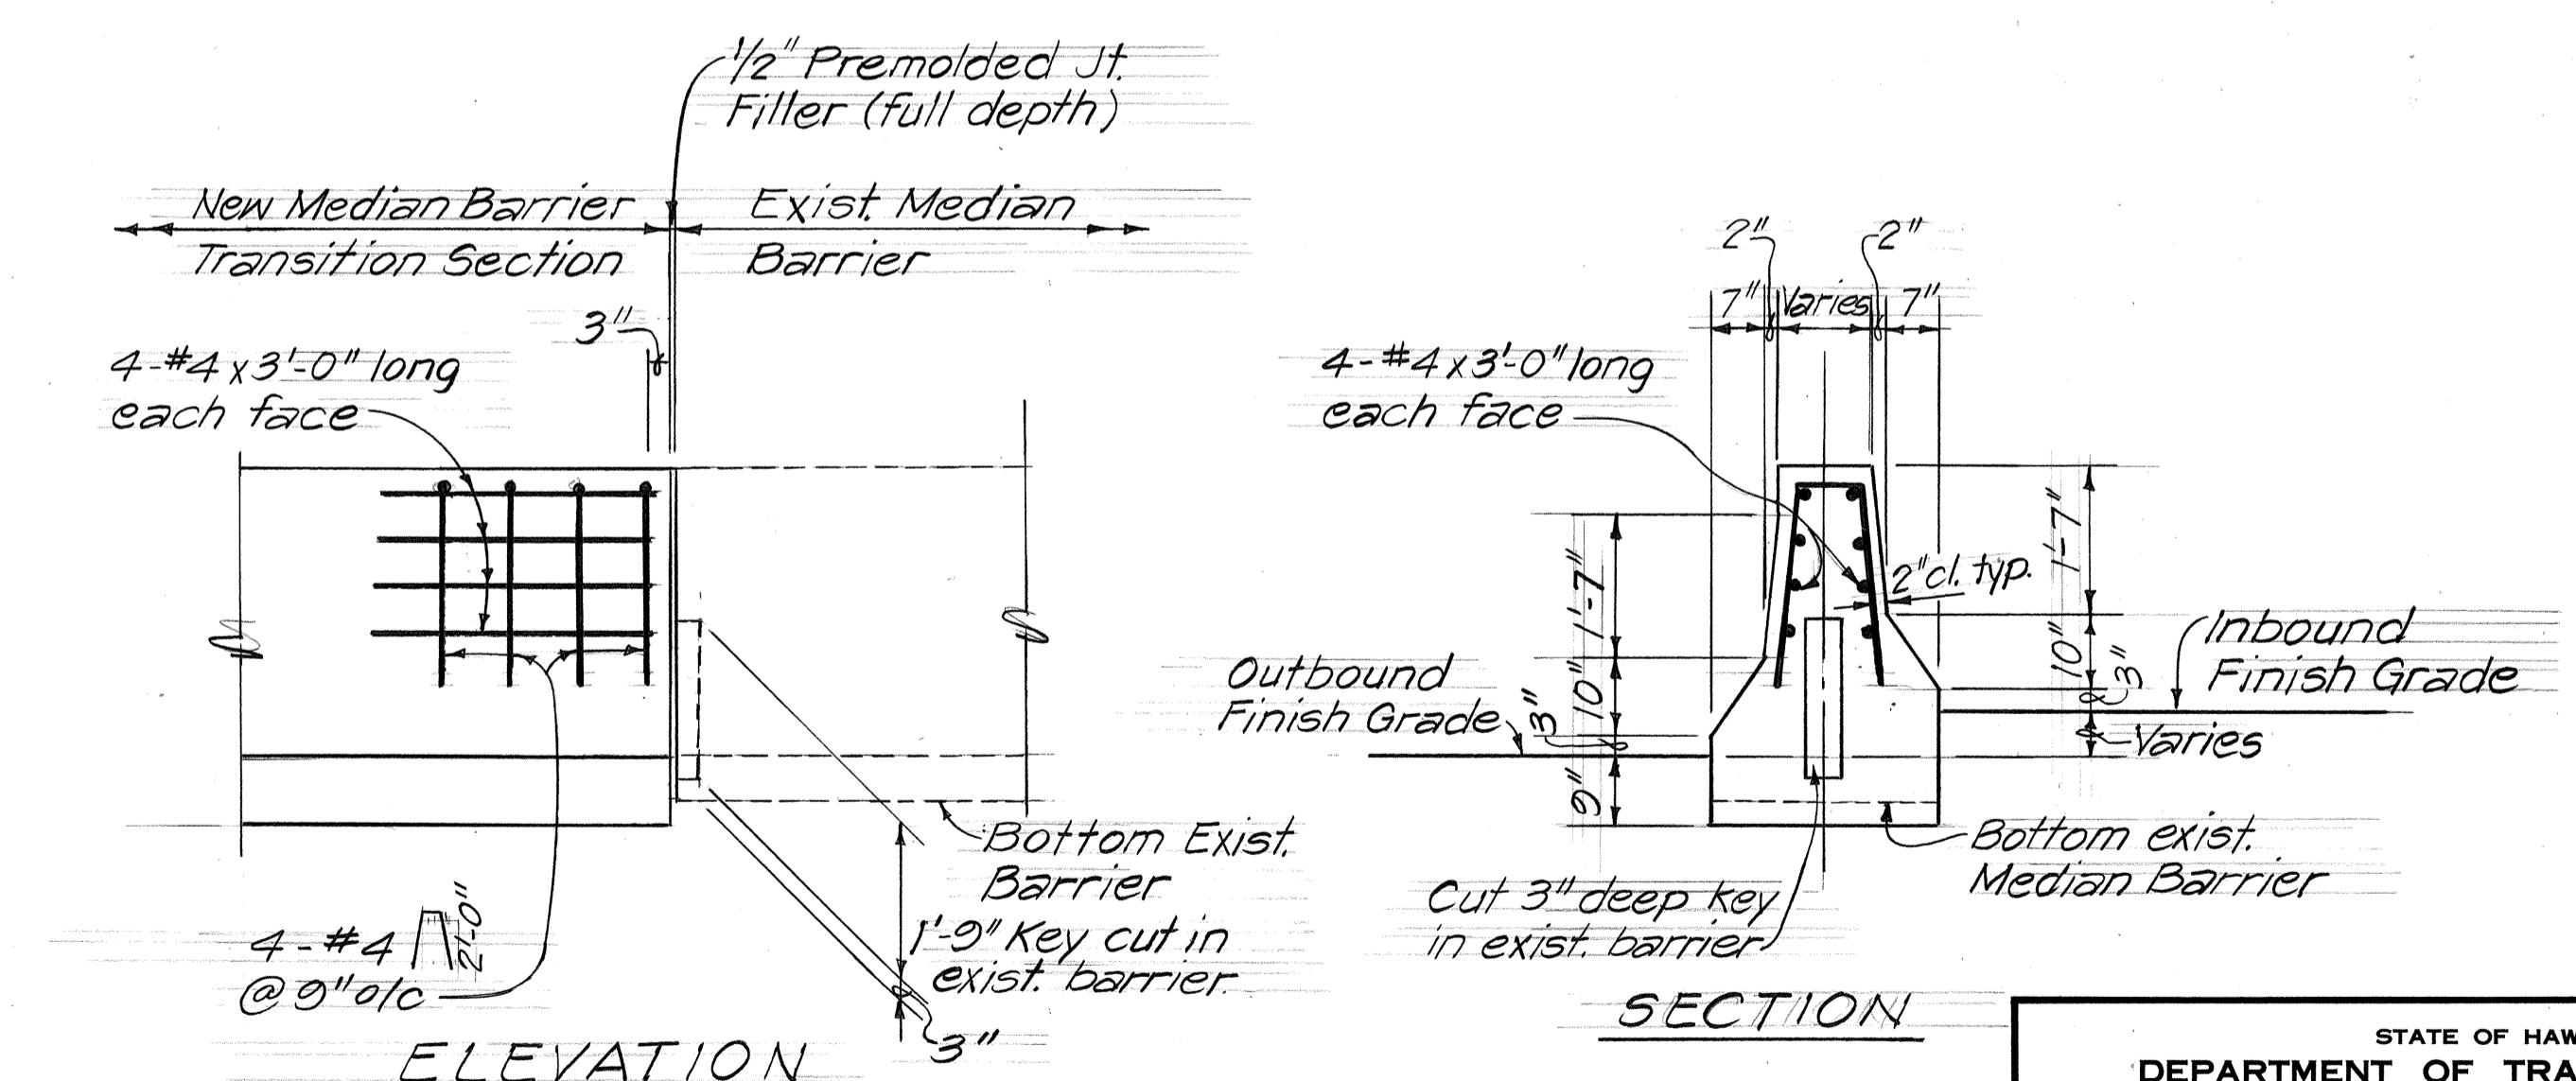

EXPANSION JOINT DETAIL @ MEDIAN BARRIER


Scale: $1/2'' = 1''-0$

4-4-84 Detail for Guard Rail Type 4B Transition
Section added, @ Sta. 37+30.62 to @ Sta.
37+62.3±. Revised Sign Pedestal and
Anchor Bolt Detail.

STATE OF HAWAII
DEPARTMENT OF TRANSPORTATION
HIGHWAYS DIVISION
DETAIL PLAN
TA. 37+30.62 TO B STA. 37+62.3±
INTERSTATE ROUTE HI IMPROVEMENTS
OLE STREET TO KALIHI INTERCHANGE
WESTBOUND LANES
F.A.I. PROJ. No. I-HI-1(187)
e, As Noted Date: Apr. 1984
SHEET NO. OF SHEETS

C036S-1

FED. ROAD DIST. NO.	STATE	FED. AID PROJ. NO.	FISCAL YEAR	SHEET NO.	TOTAL SHEETS
HAWAII	HAW.	EHI-1(87)	1984	37	197

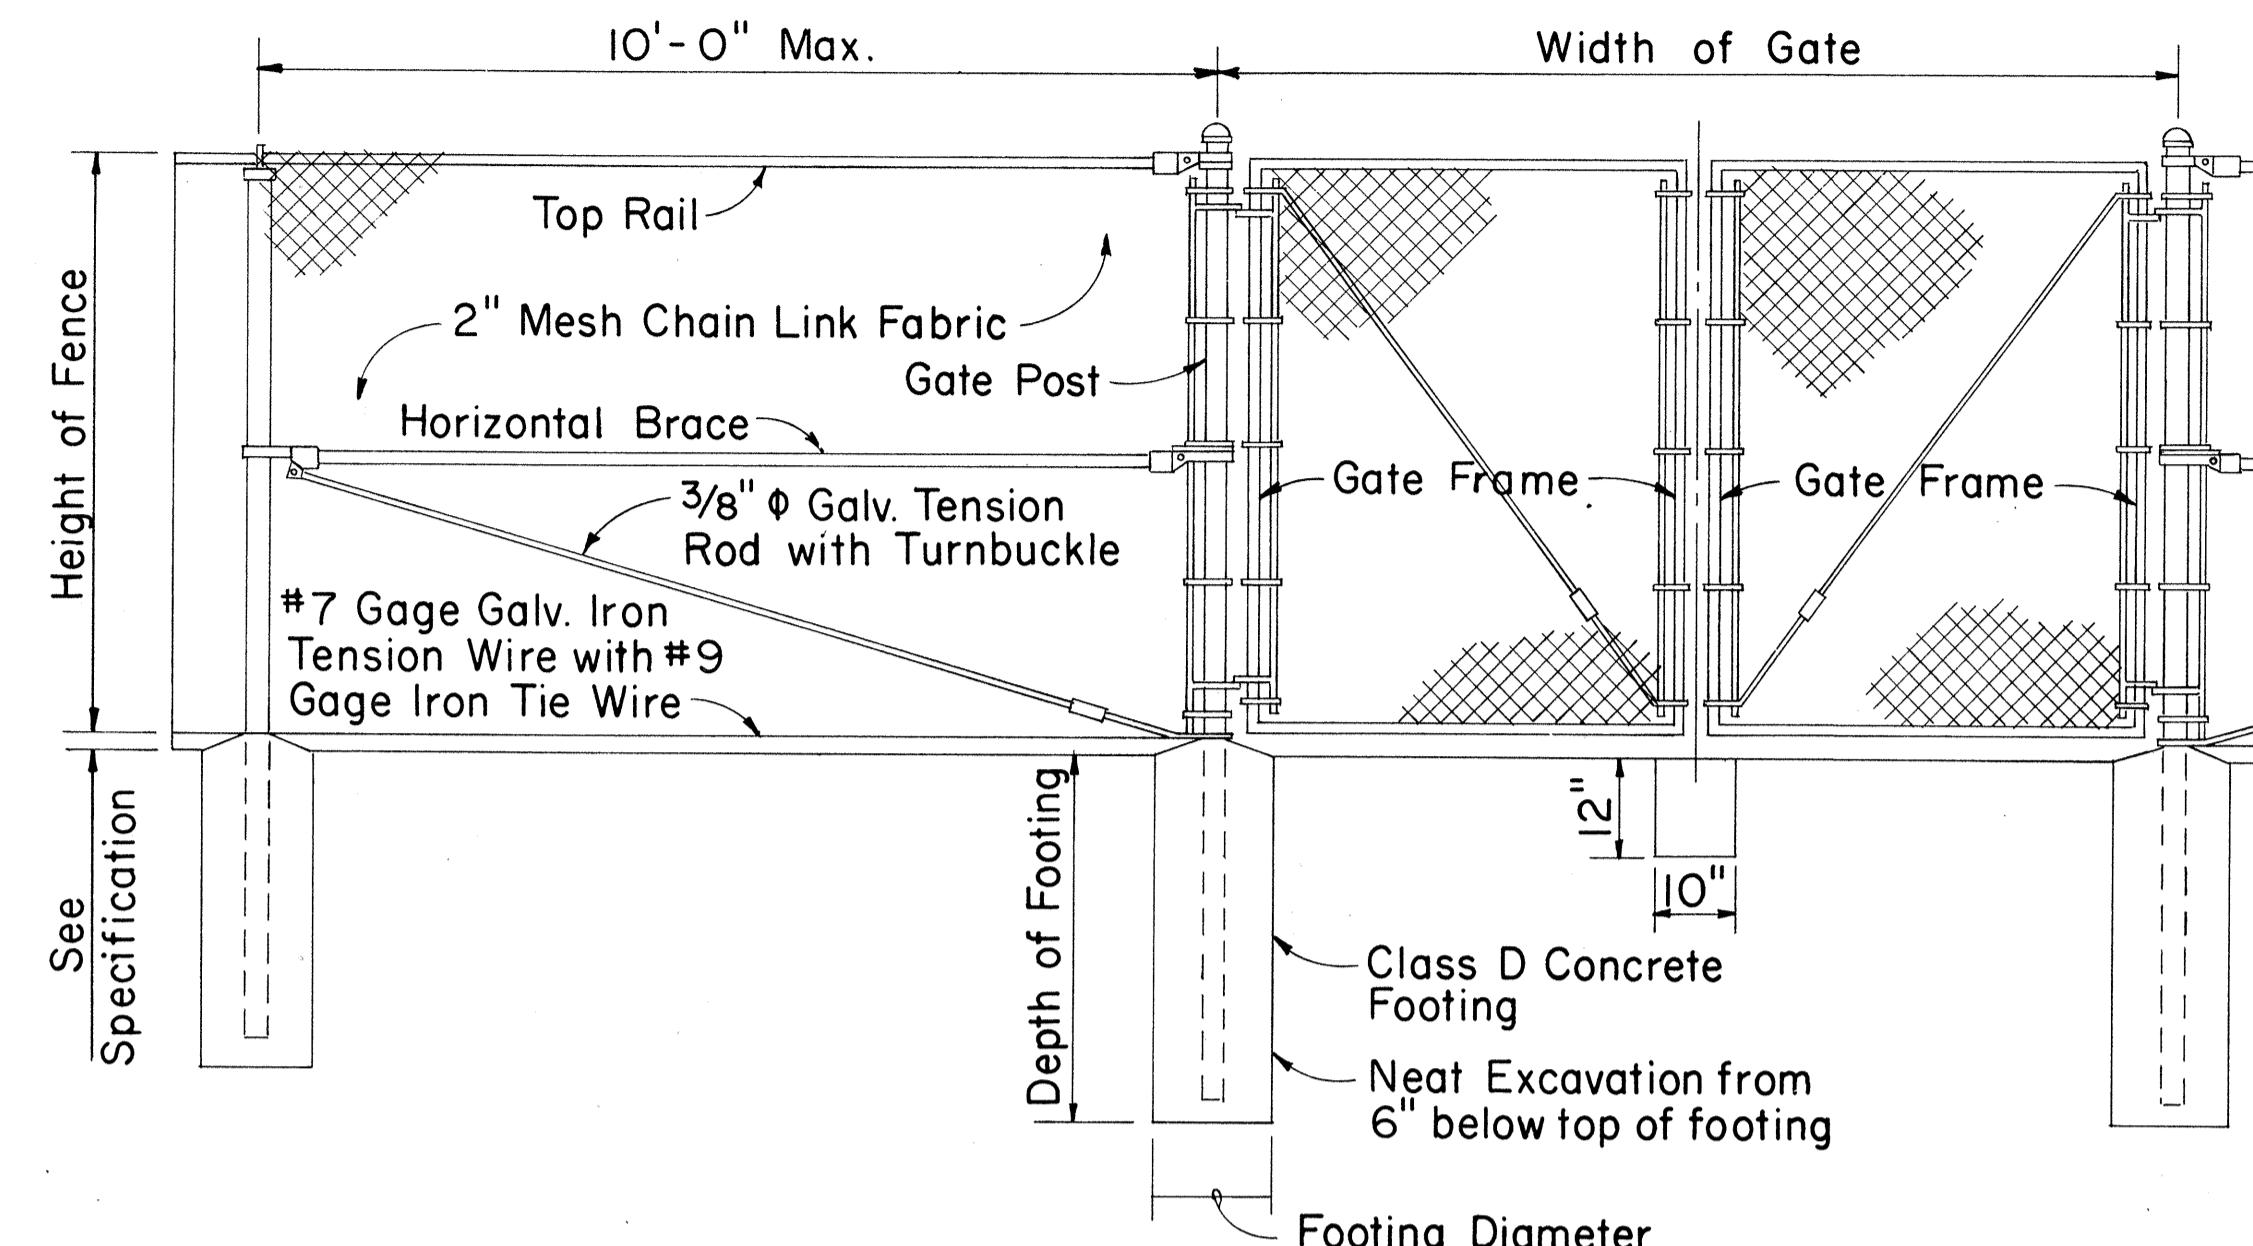


LINE POST

GATE POST

GATE POST


DETAIL OF CHAIN LINK GATE

NOTE: 1. Gate fork latch and lock, flush plate and anchor, and plunger shall be installed with Gates, and shall be considered as incidental to Chain Link Fence Gate.
2. Gate frames shall be mitered and welded at corners.
3. Fence detail not shown shall be in accordance with the Standard Specifications.

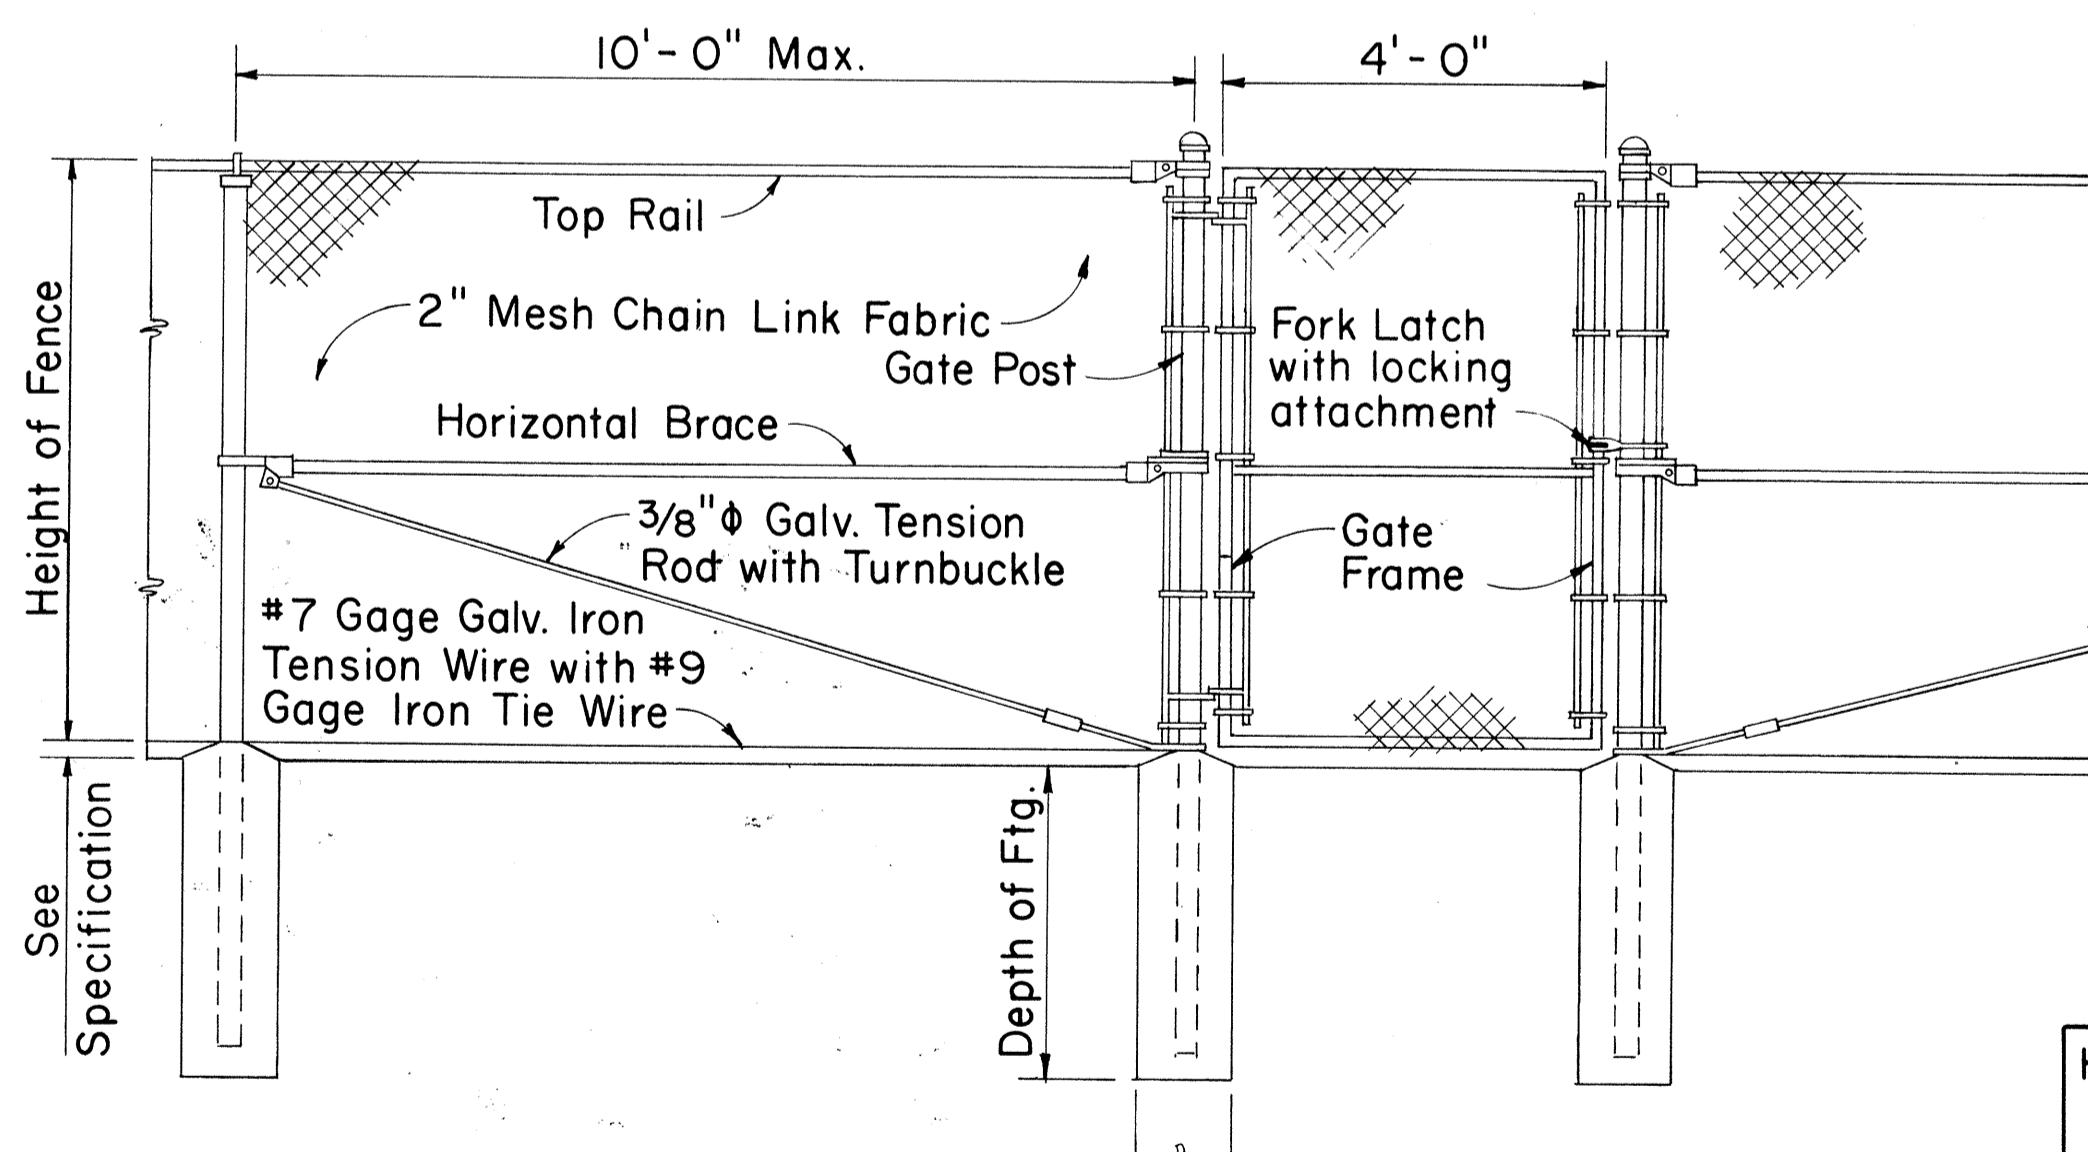

LINE POST


GATE POST GATE POST

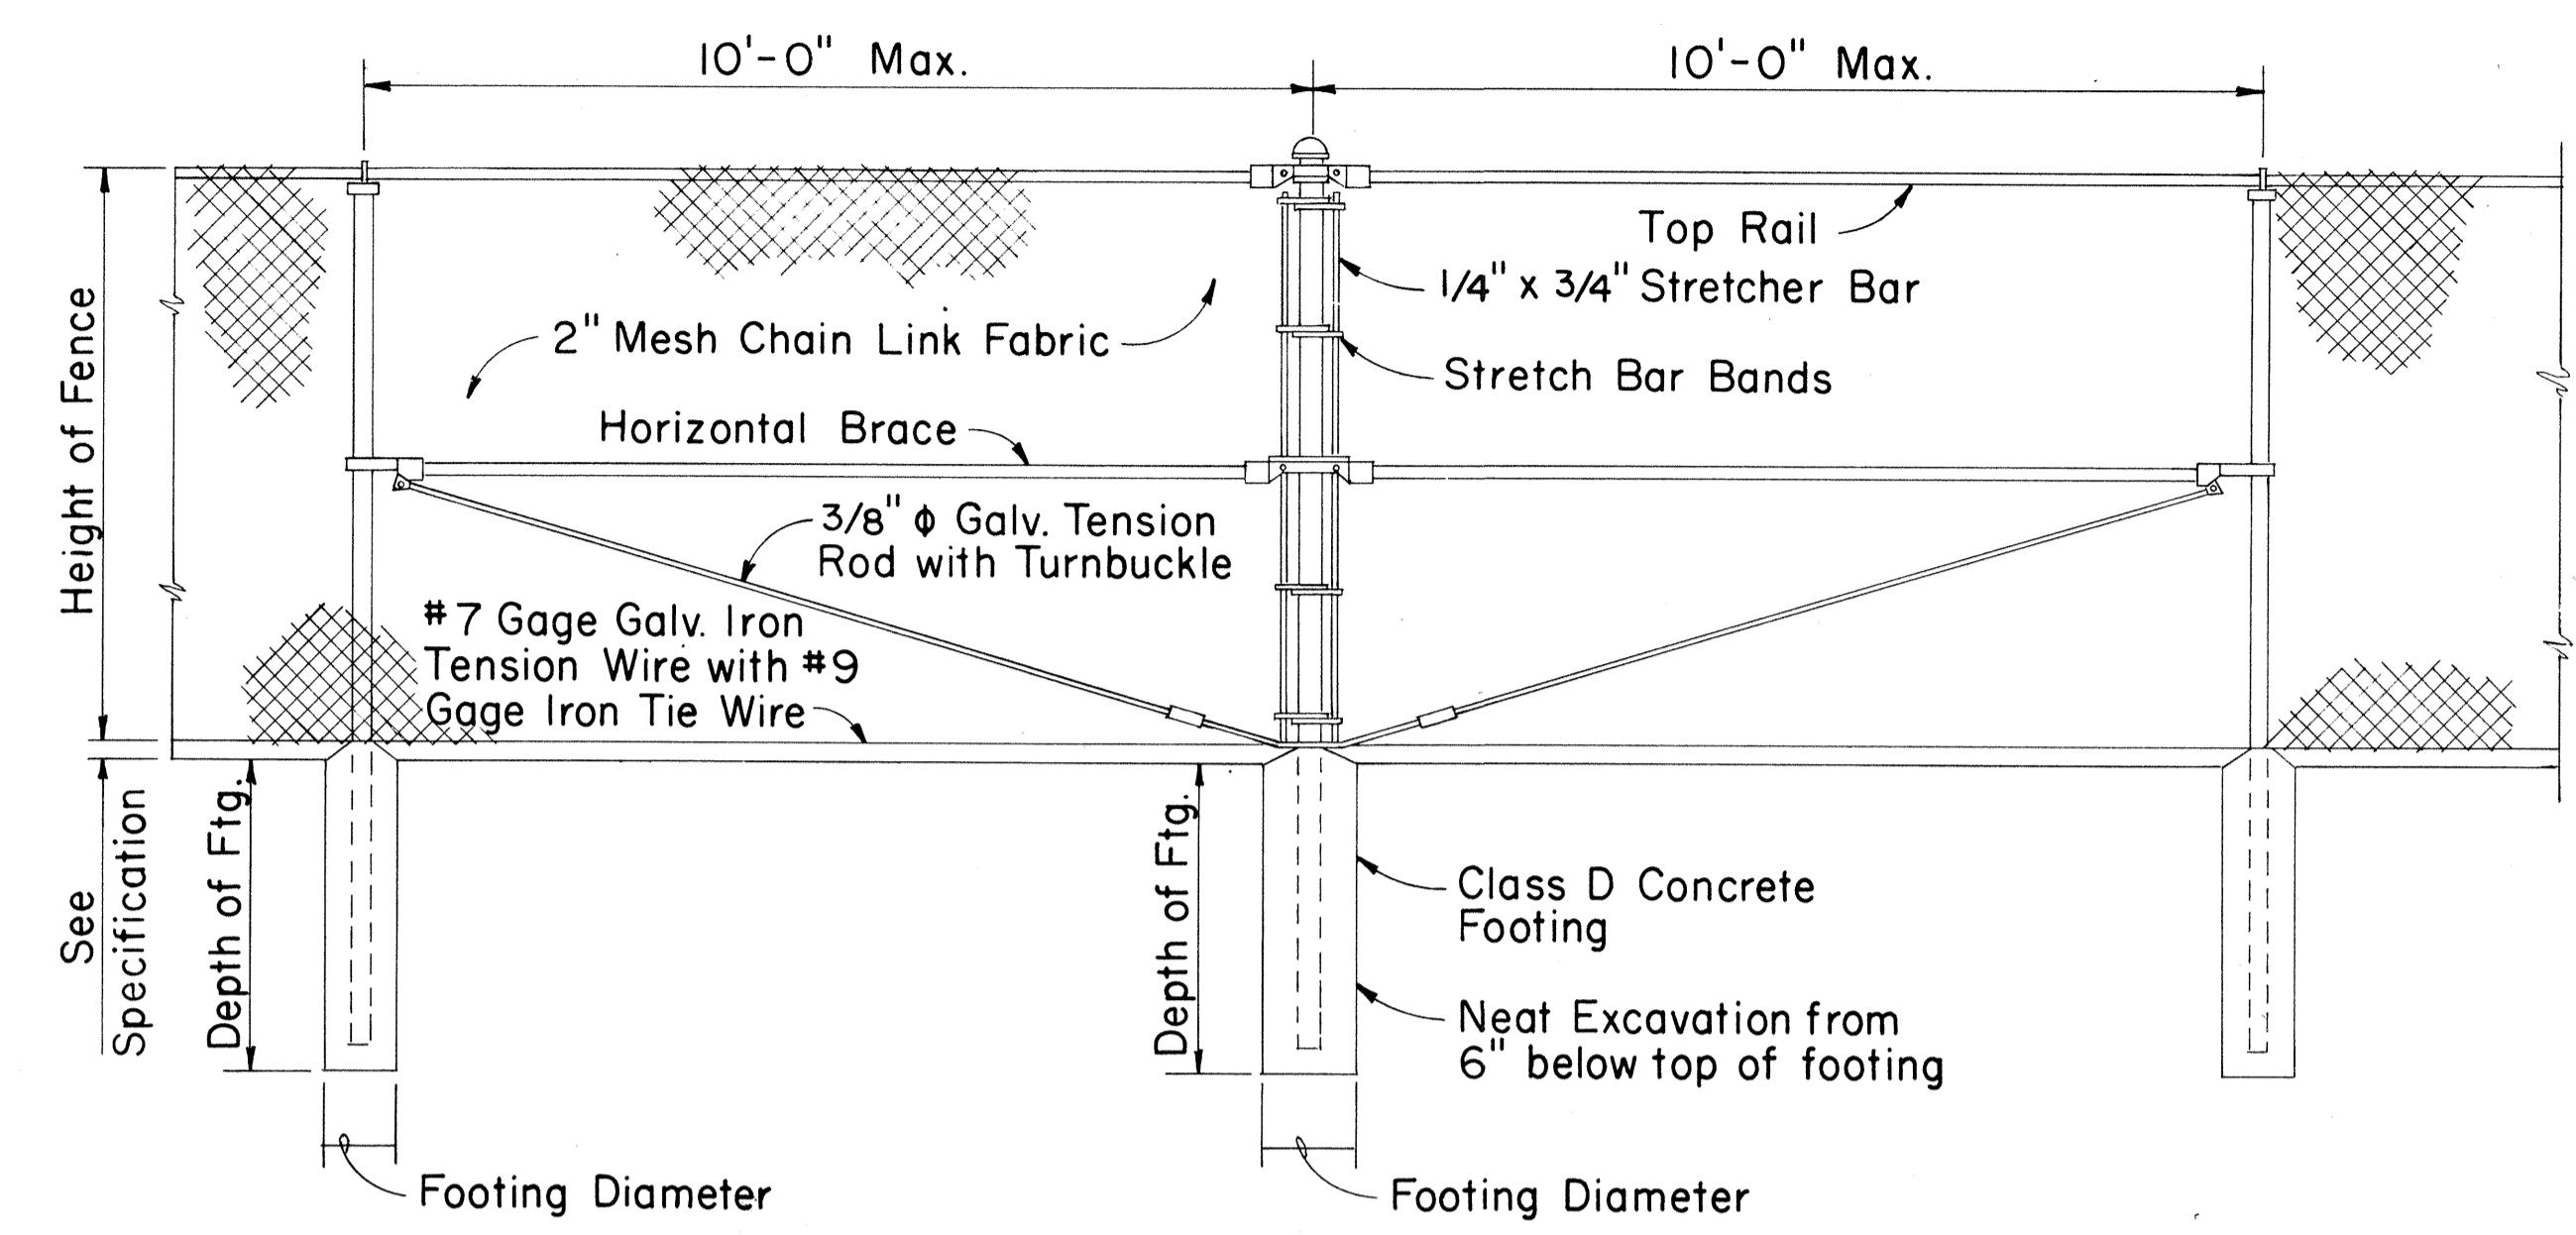DETAIL OF 4 FT. CHAIN LINK GATE

LINE POST

PULL POST


LINE POST

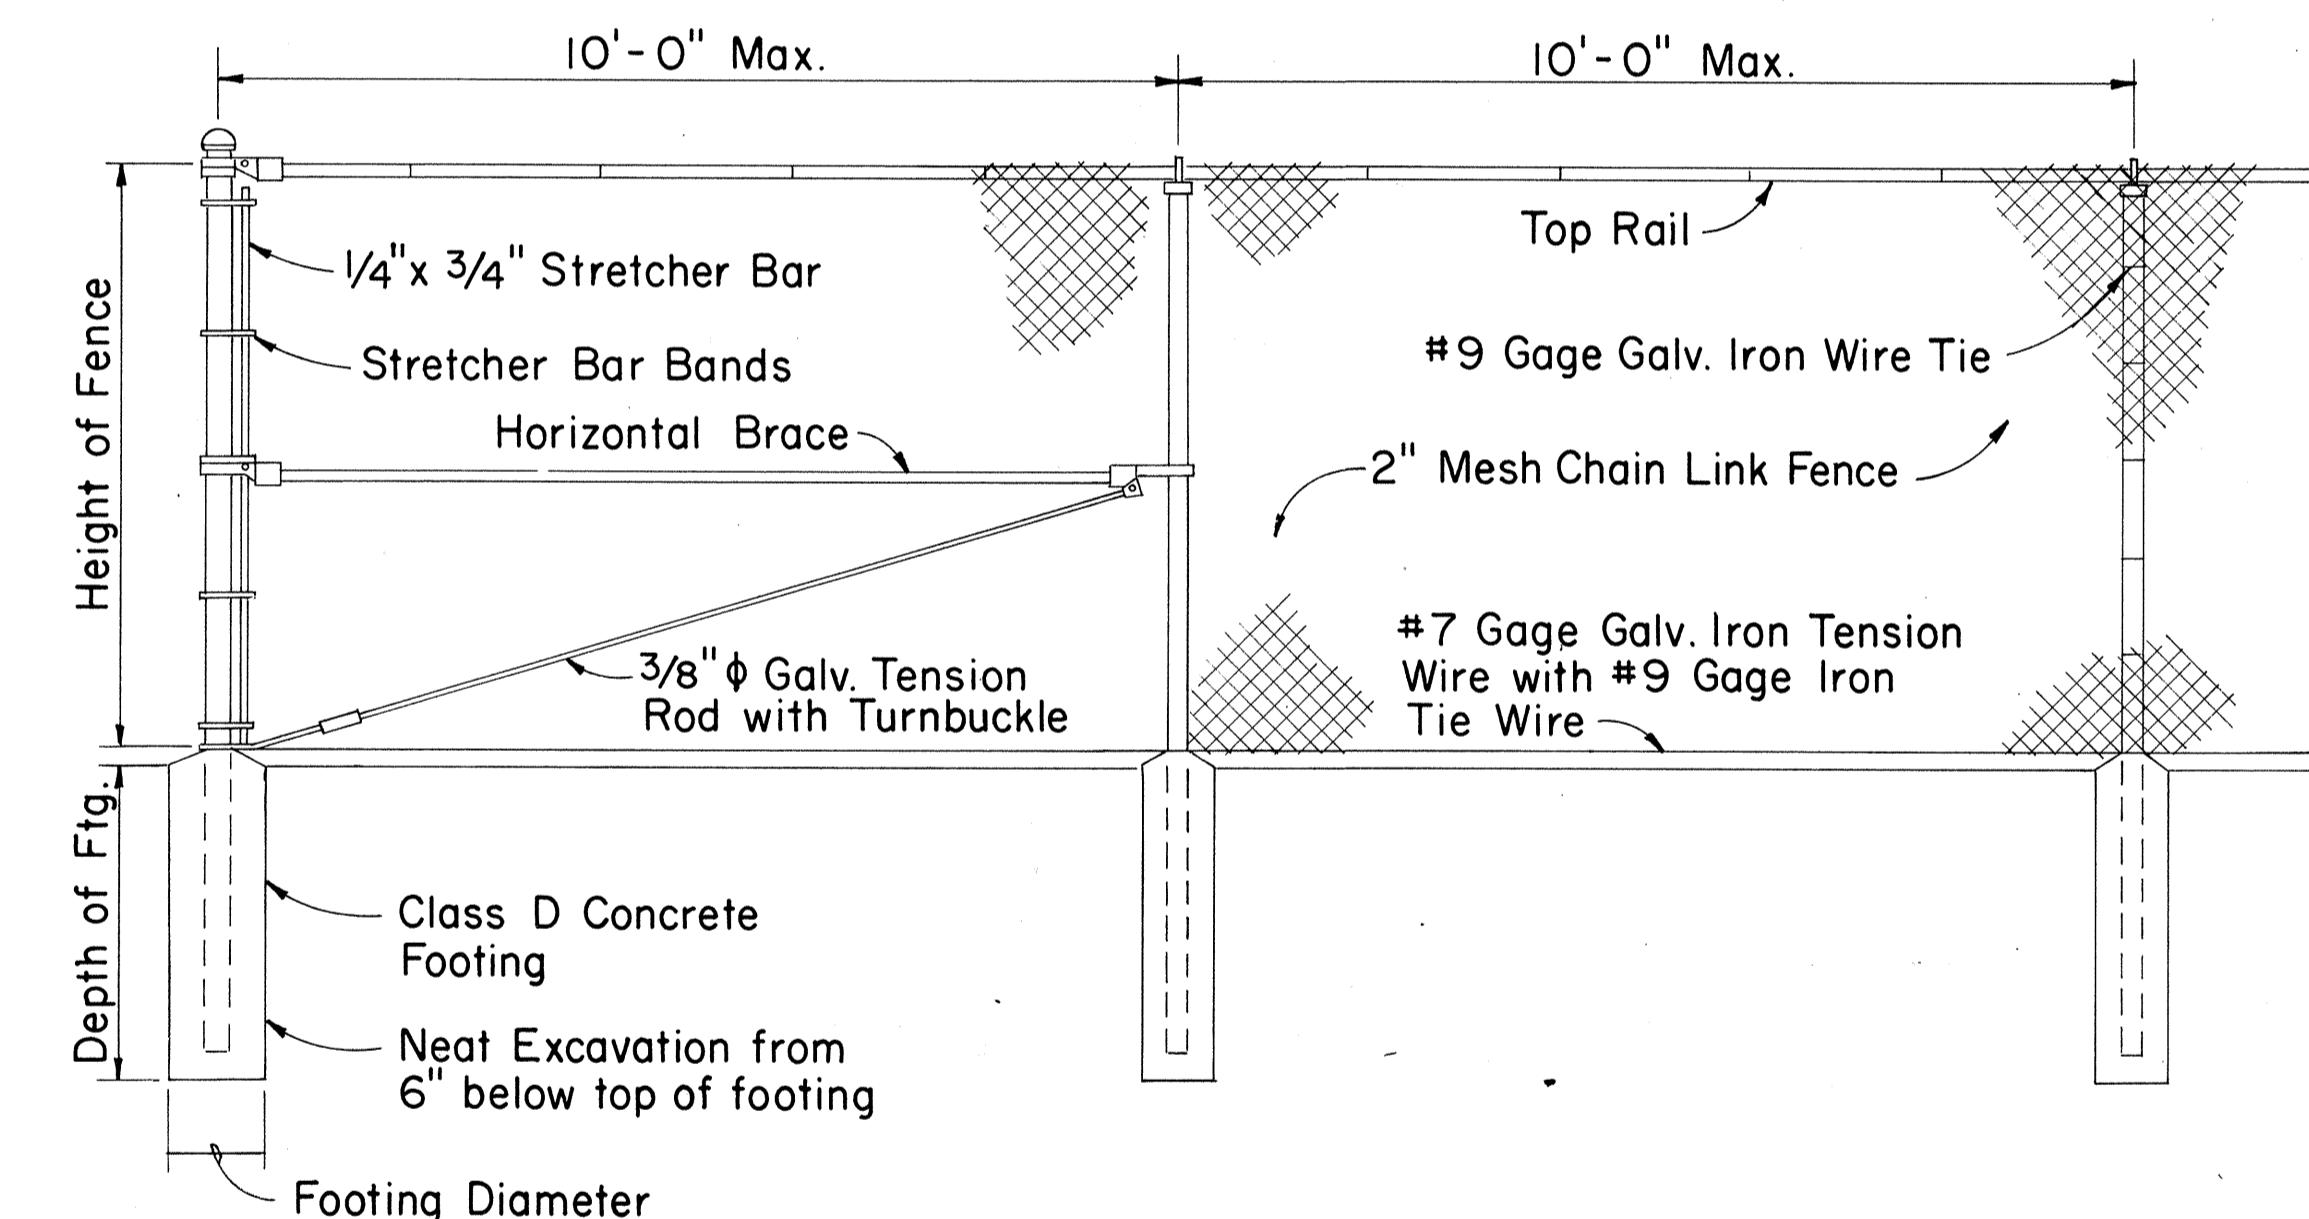TYPICAL SECTION (WITH CONCRETE FOOTING)

END POST

LINE POST

LINE POST

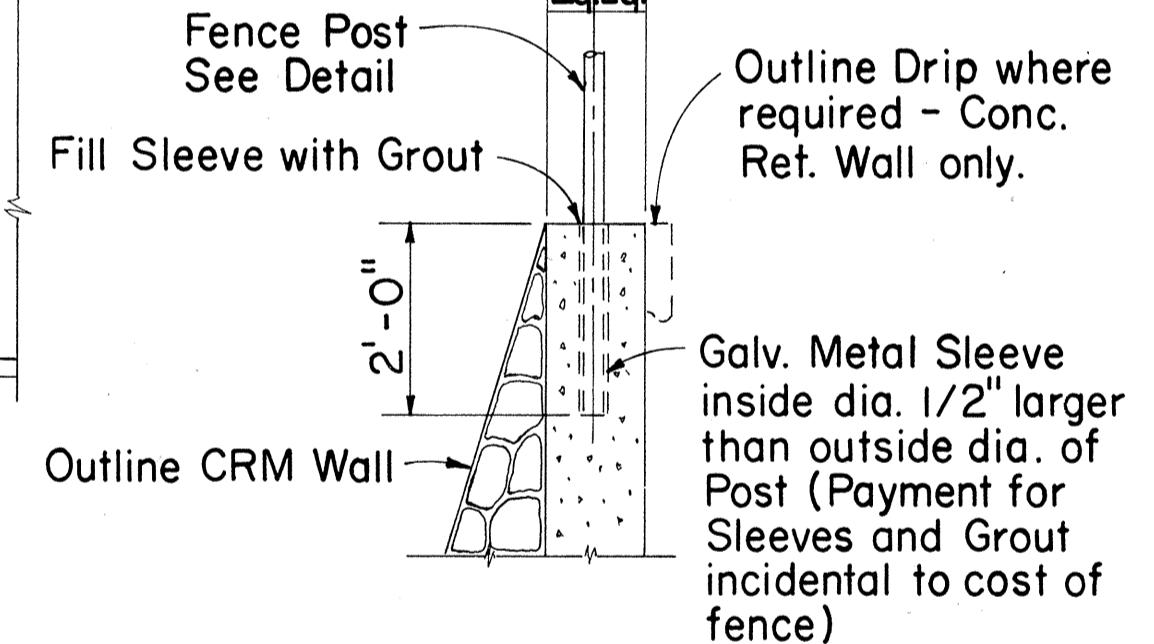TYPICAL SECTION (ON CRM & CONC. RET. WALL)

APPROVAL RECOMMENDED:
M. J. Hayes
HIGHWAY DESIGN ENGINEER

12-4-69
DATE

APPROVED:
A. S. Bodal
ASSISTANT CHIEF, ENGINEERING

12-10-69
DATE

CHAIN LINK FENCE DETAILS

Height of Fence	Minimum Depth of Footing		Minimum Footing Diameter	
	Line Post	Corner, Pull, End and Gate Posts	Line Post	Corner, Pull and End Posts
3'	2'-0"	2'-6"	8"	8"
4'	2'-6"	2'-6"	8"	8"
5'	3'-0"	3'-0"	8"	8"
6'	3'-0"	3'-0"	8"	9"

NO	REVISION	APPROVED BY	DATE

STATE OF HAWAII
DEPARTMENT OF TRANSPORTATION
HIGHWAYS DIVISION

STANDARD DETAILSCHAIN LINK FENCE (WITH TOPRAIL)


Scale: 1/2" = 1'-0" Date:

SHEET No. OF SHEETS DD 607.1


FED. ROAD DIST. NO.	STATE	FED. AID PROJ. NO.	FISCAL YEAR	SHEET NO.	TOTAL SHEETS
HAWAII	HAW.	I-HI-1(187)	1984	39	107

GENERAL NOTES

- Both of the alternate type posts may be used on any one project however, only one type of post shall be used in any single run of guardrail.
- All hardware, posts and blocks shall be galvanized. No punching, drilling or cutting will be permitted after galvanizing.
- Connection details for bent plate post and block shall be similar to the details shown for structural shape post, and block.
- Where conditions require, special post lengths in increments of 6 inches may be specified.
- For details of rail elements, bolts and nuts, see sheet DT 501.

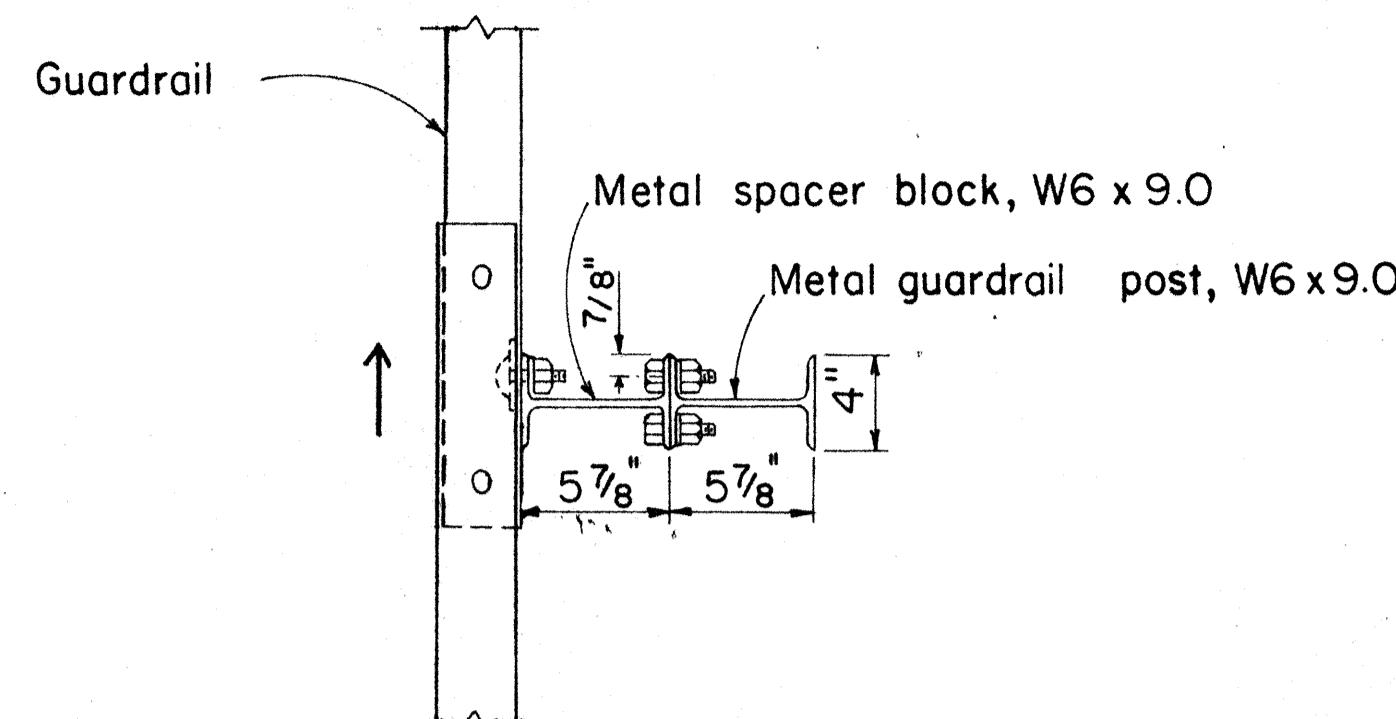


PLAN

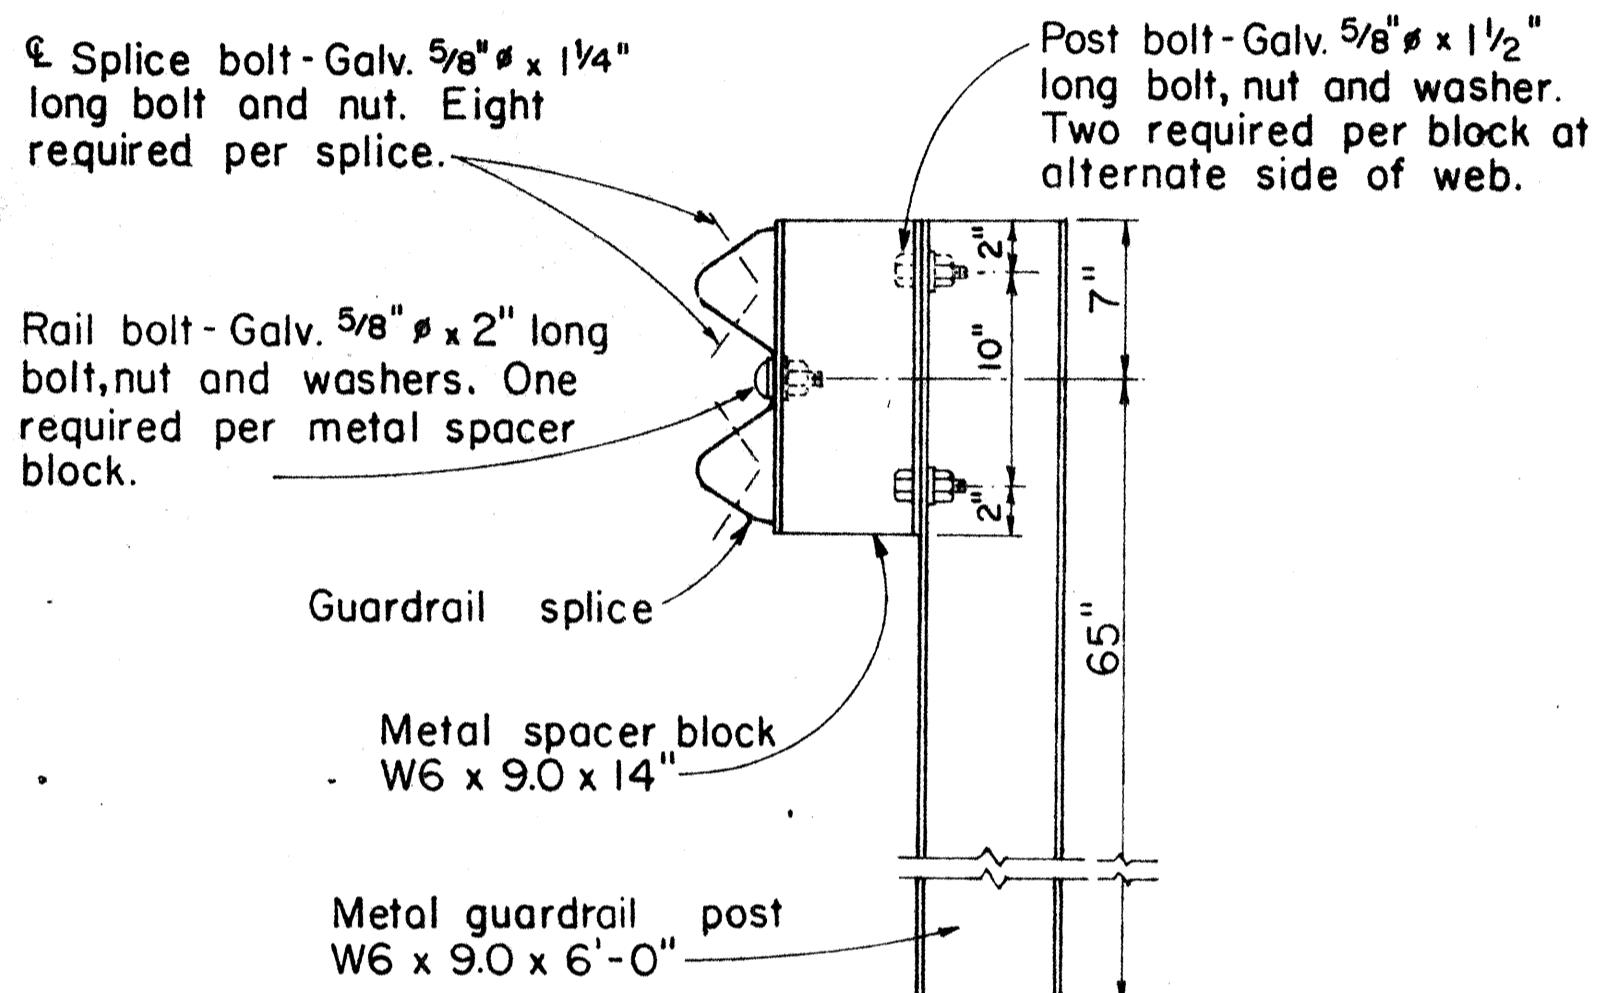

ELEVATION

SINGLE METAL GUARDRAIL ON METAL POST WITH METAL SPACER BLOCK


SCALE: 1 1/2" = 1'-0"

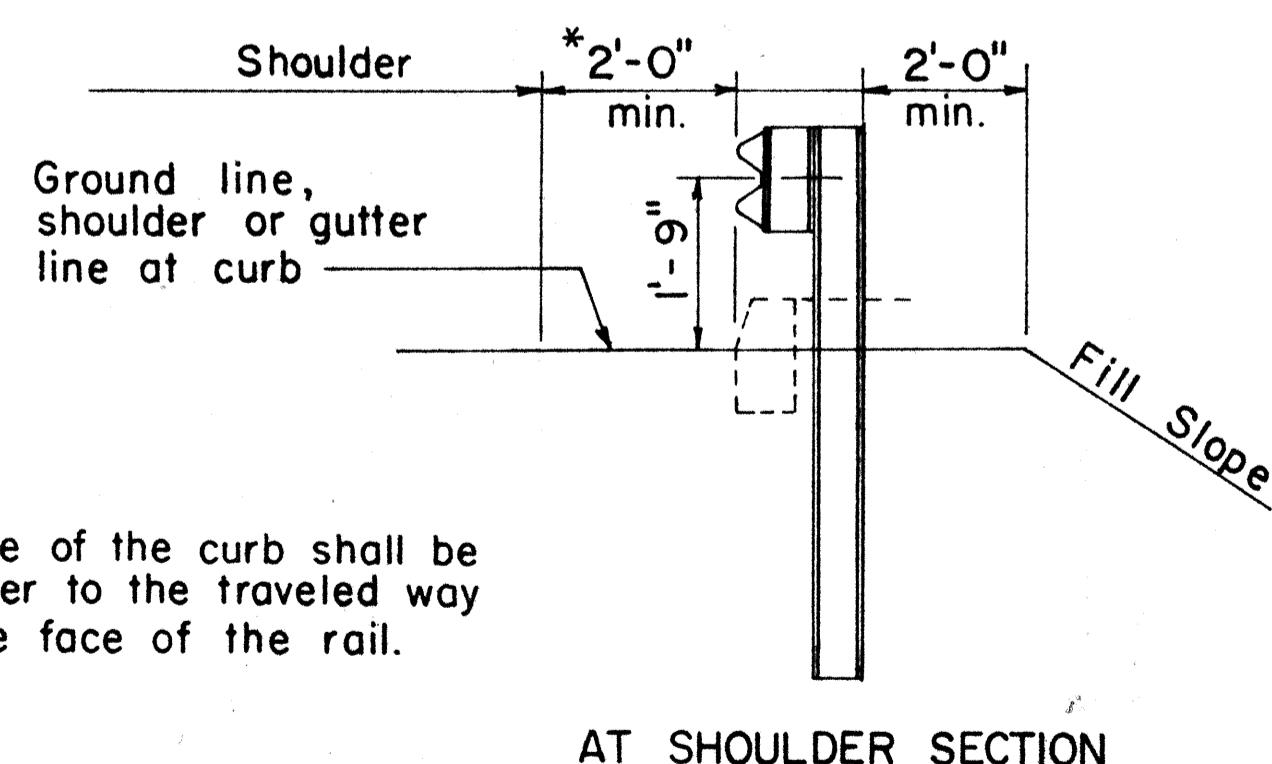

Note:
The face of the curb shall be no closer to the traveled way than the face of the rail.

TYPICAL METAL GUARDRAIL DETAIL

SCALE: 1/2" = 1'-0"

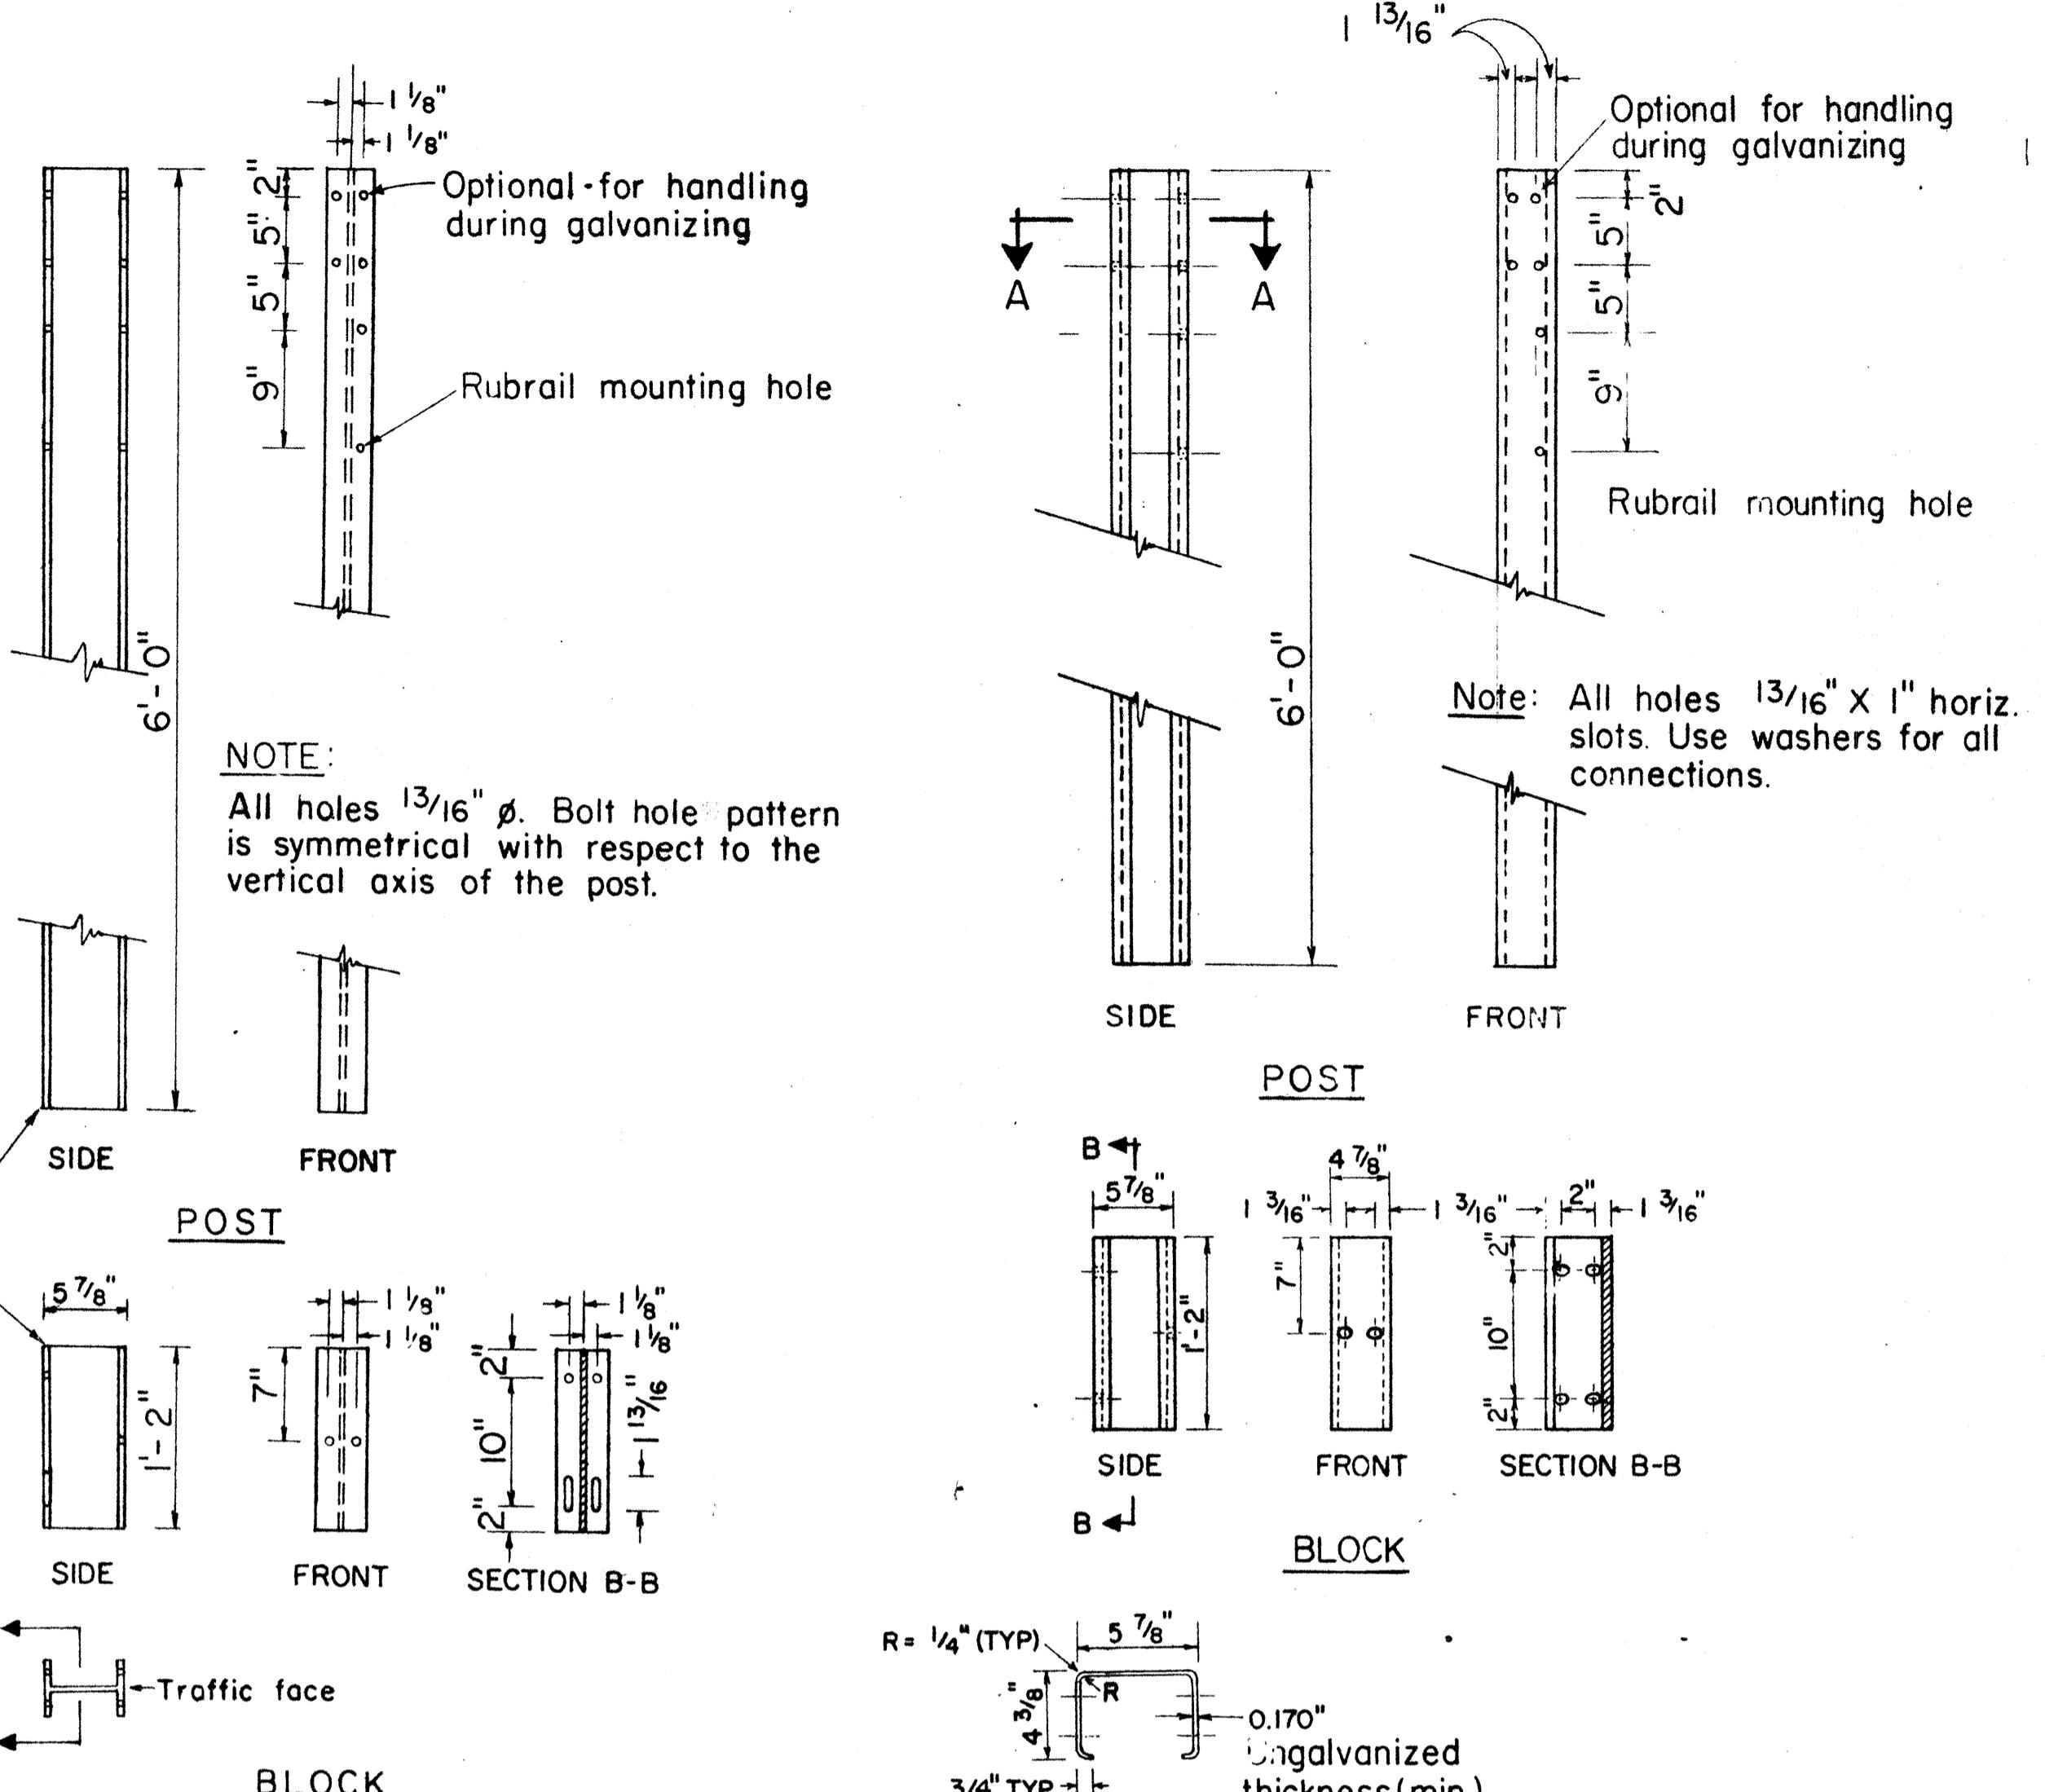


STRUCTURAL SHAPE POST AND BLOCK

SCALE: 1" = 1'-0"

SECTION A-A N.T.S.

BENT PLATE POST AND BLOCK

SCALE: 1" = 1'-0"

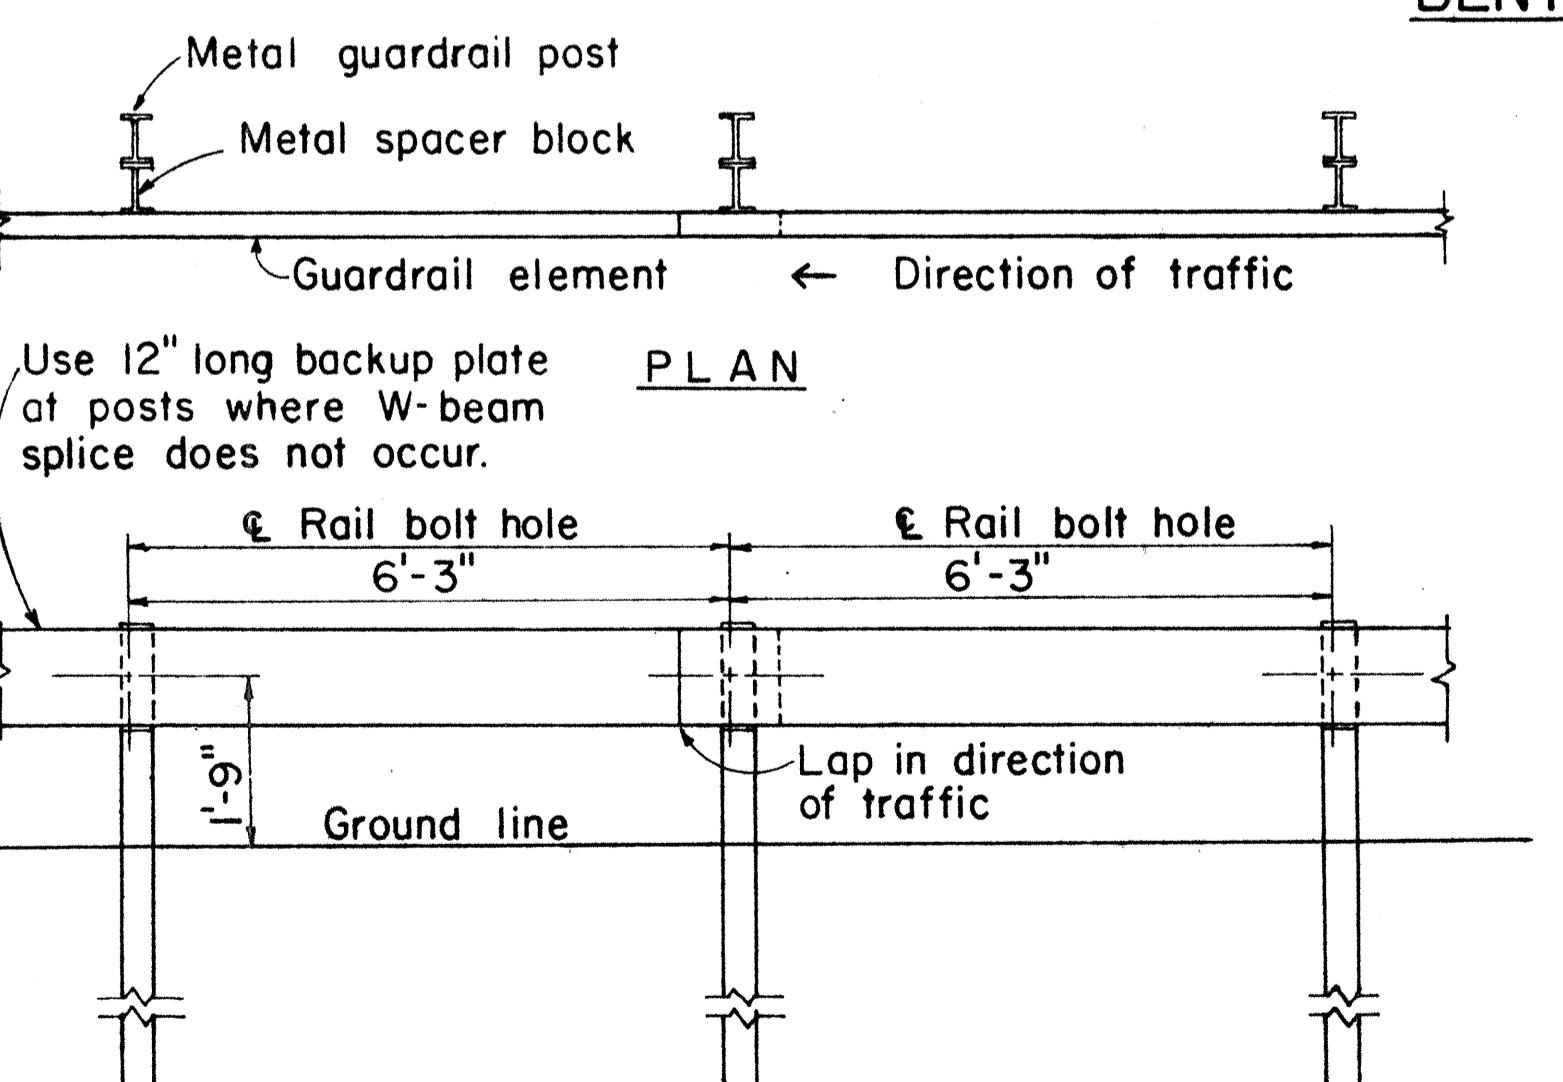

ELEVATION

METAL GUARDRAIL ON METAL POST WITH METAL SPACER BLOCK

SCALE: 1/2" = 1'-0"

APPROVAL RECOMMENDED:
Erica Tanaka
TRAFFIC ENGINEER

9/1/82

APPROVED:
Robert Zaleski
ASSISTANT CHIEF, ENGINEERING

9/22/82


STATE OF HAWAII
DEPARTMENT OF TRANSPORTATION
HIGHWAYS DIVISION

STANDARD DETAILS

METAL GUARDRAIL

Scale: As Shown
SHEET NO. OF SHEETS DT 500




FED. ROAD DIST. NO.	STATE	FED. AID PROJ. NO.	FISCAL YEAR	SHEET NO.	TOTAL SHEETS
HAWAII	HAW.	I-H-I(187)	1984	40	197

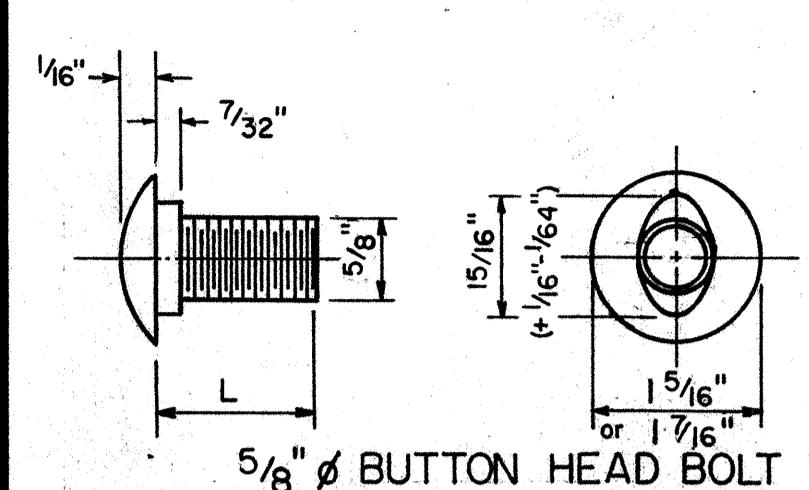

L	Thread Length	Intended Use
1 1/4"	Full length thread	Splice rail elements
2"	1 1/2" min. thread len.	Fasten rails to posts


**5/8" BUTTON HEAD BOLT
AND RECESS NUT**

Scale: NTS

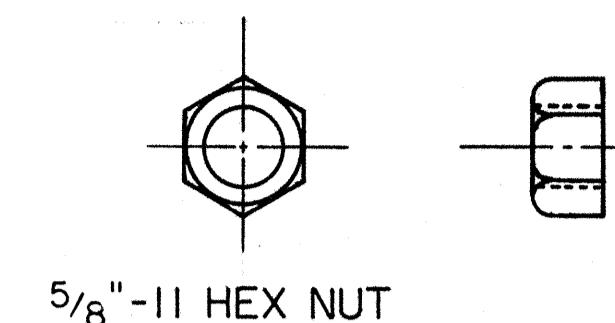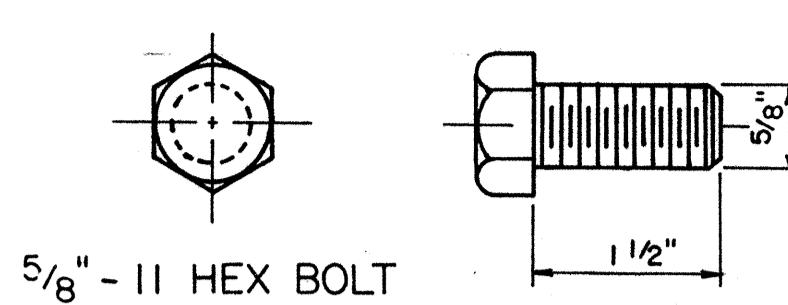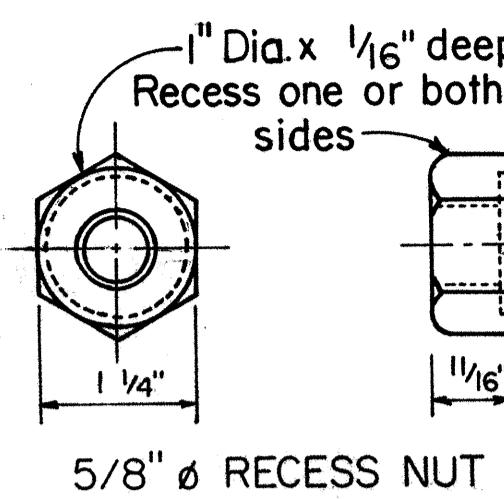


5/8" HEX POST BOLT AND NUT

Scale: NTS.

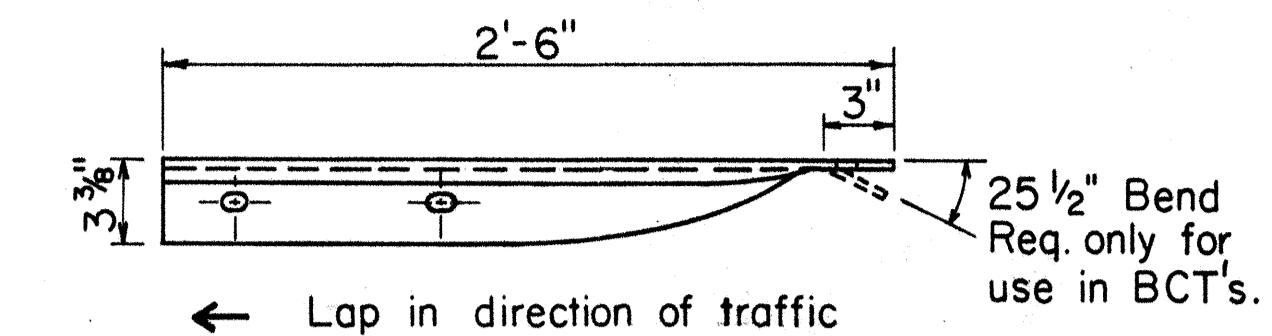



3/4" x 2 1/2" Rail bolt slot (bolt as required.)
4-1" dia. holes for 7/8" dia. x 7 1/4" long H.S. Anchor bolts (length under head) H.S. nut and washer.

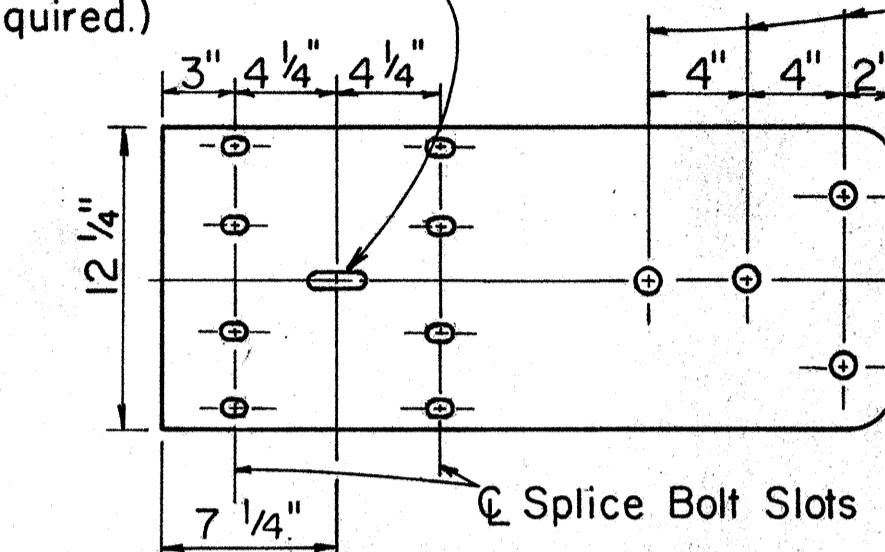

W BEAM TERMINAL CONNECTOR



Scale: 1 1/2" = 1'-0"

← Lap in direction of traffic

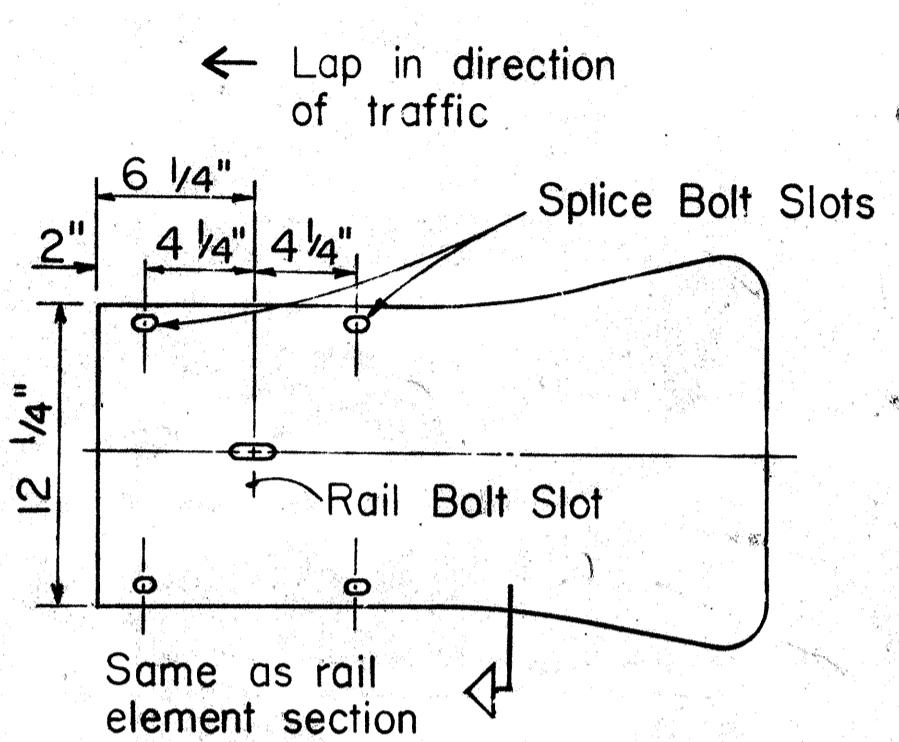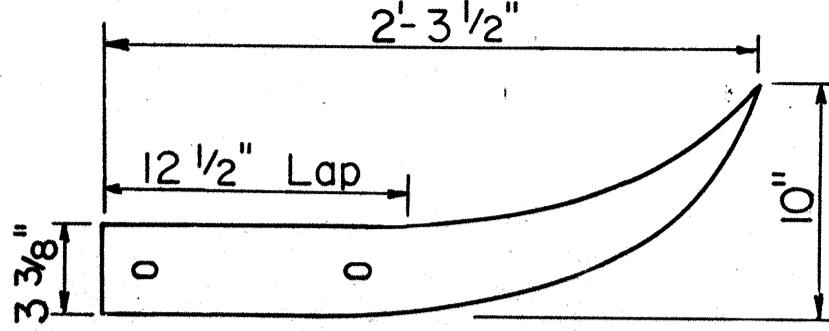

W BEAM END SECTION (FLARED)

Scale: 1 1/2" = 1'-0"

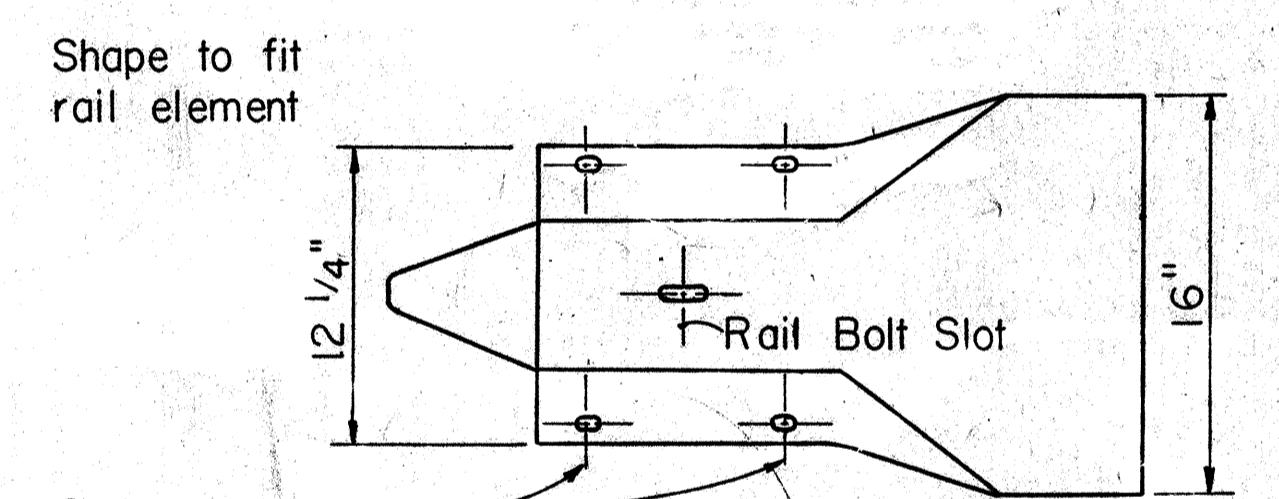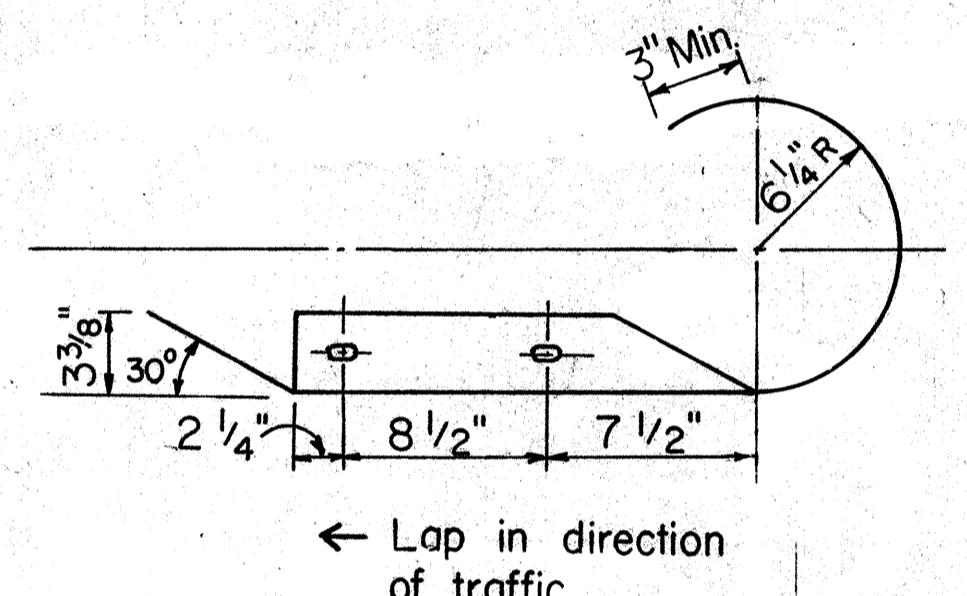

W BEAM END SECTION (ROUNDED)


Scale: 1 1/2" = 1'-0"

APPROVAL RECOMMENDED:
Eiichi Tanaka
TRAFFIC ENGINEER

9/20/82
DATE


APPROVED:
Shuler Schlesinger
ASSISTANT CHIEF, ENGINEERING

9/22/82
DATE

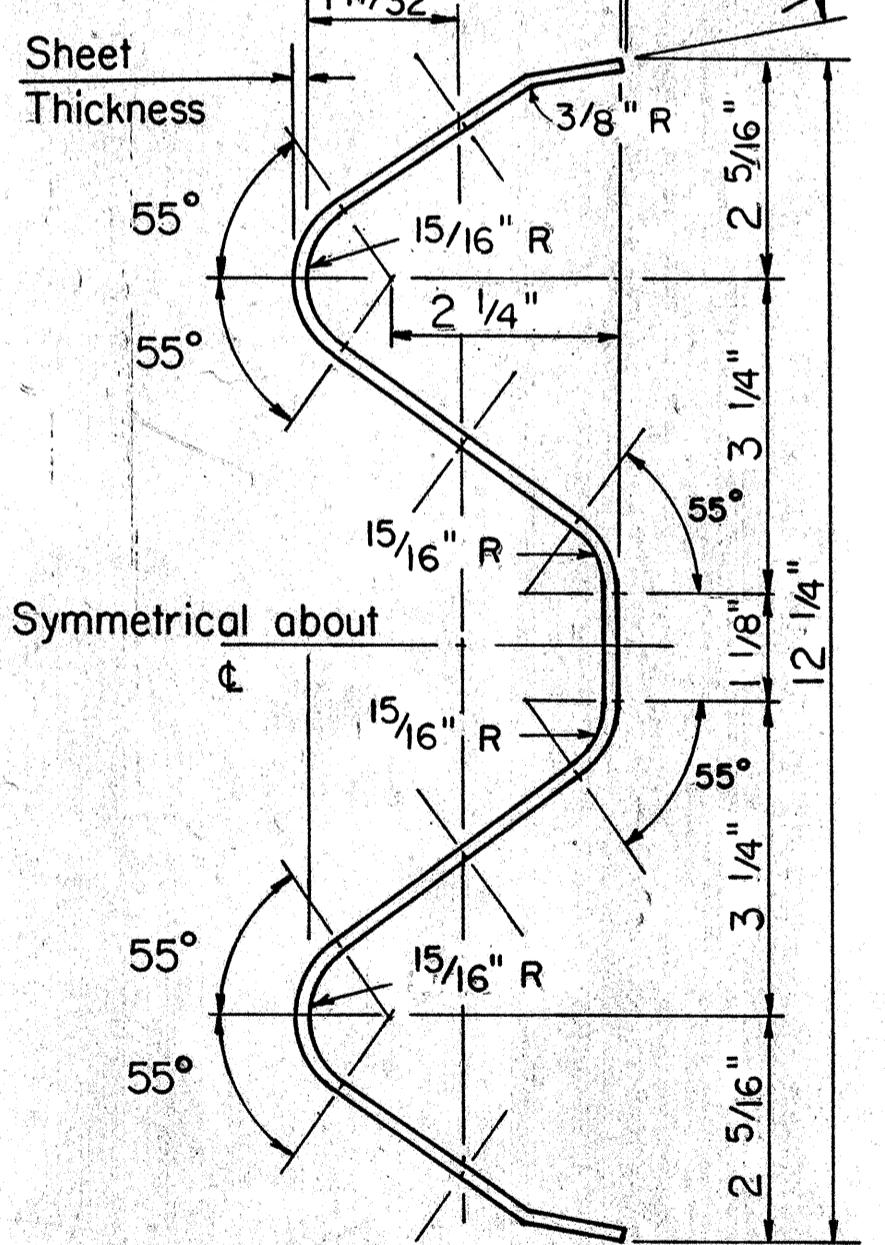


RAIL ELEMENT SECTION

Scale: 6" = 1'-0"

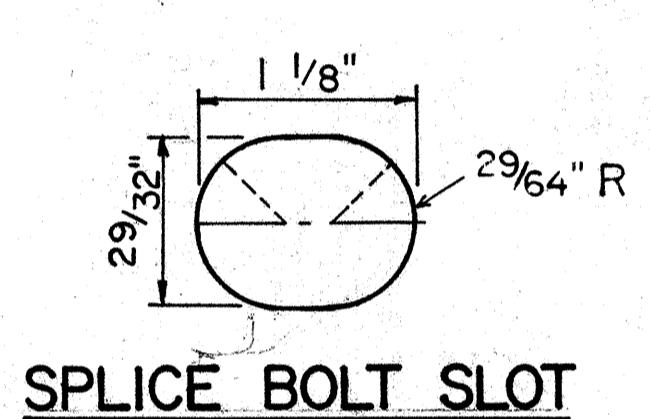


**SPICE BOLT SLOT
FOR ALL ENDS**

Scale: Full Size

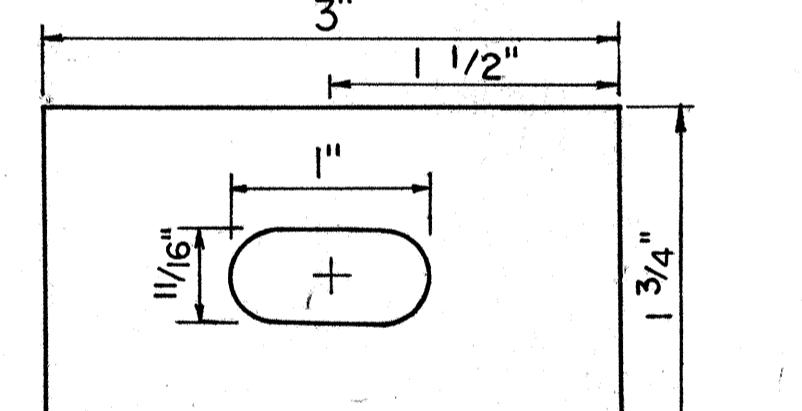


RAIL BOLT SLOT

RAIL BOLT WASHER

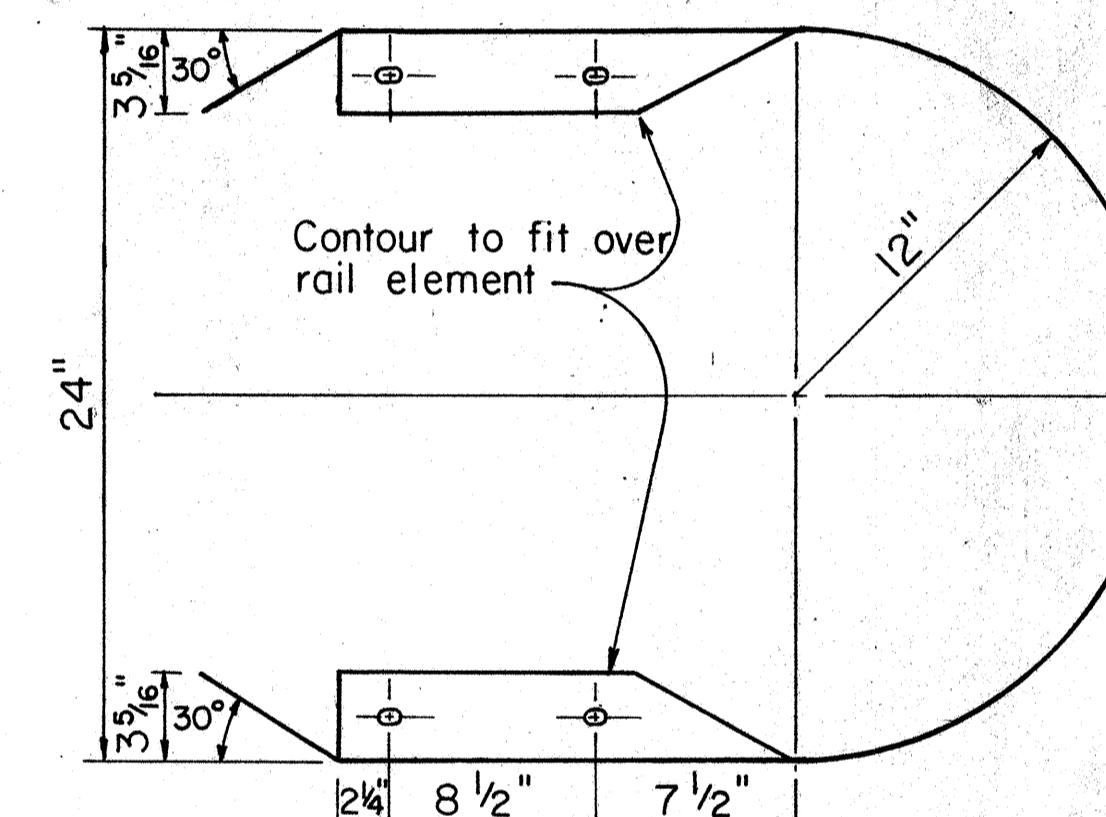


Shape to fit rail element

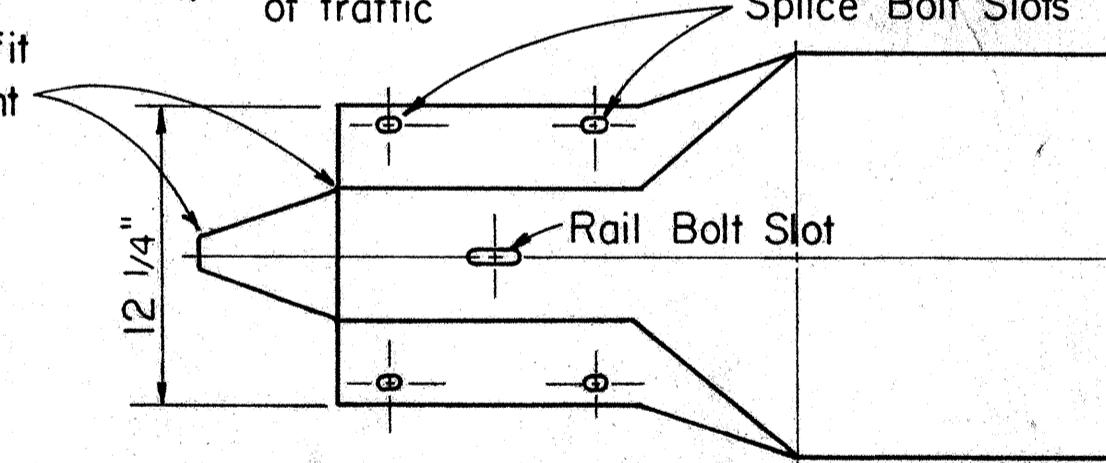

W BEAM END SECTION (BUFFER)

Scale: 1 1/2" = 1'-0"

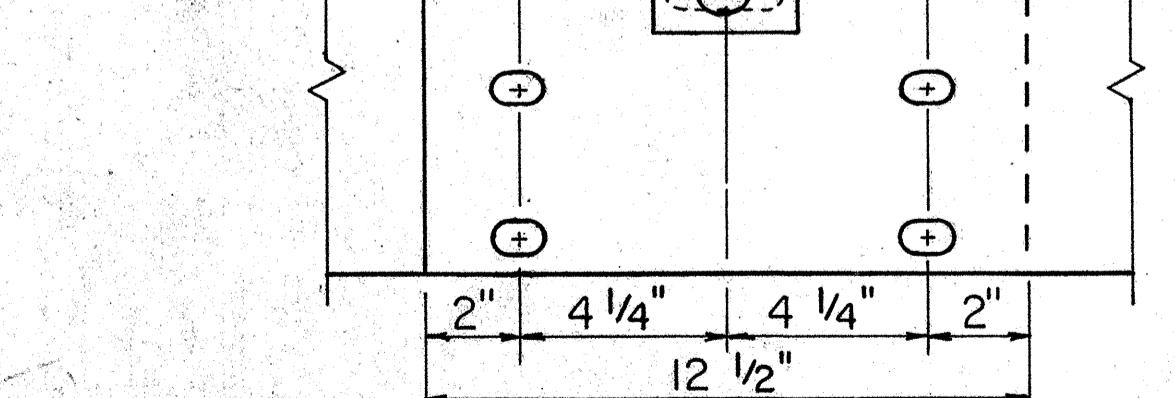


RAIL SPICE

Scale: 3" = 1'-0"

NO.	REVISION	APPROVED BY	DATE
1	Supersedes sh. DT 501 approved 12/30/69	H.F.	9/22/82

STATE OF HAWAII DEPARTMENT OF TRANSPORTATION HIGHWAYS DIVISION	STANDARD DETAILS METAL GUARDRAIL
Scale: As Noted	July, 1982
SHEET NO. OF SHEETS DT 501	40






FED. ROAD DIST. NO.	STATE	FED. AID PROJ. NO.	FISCAL YEAR	SHEET NO.	TOTAL SHEETS
HAWAII	HAW.	IHH(187)	1984	41	197

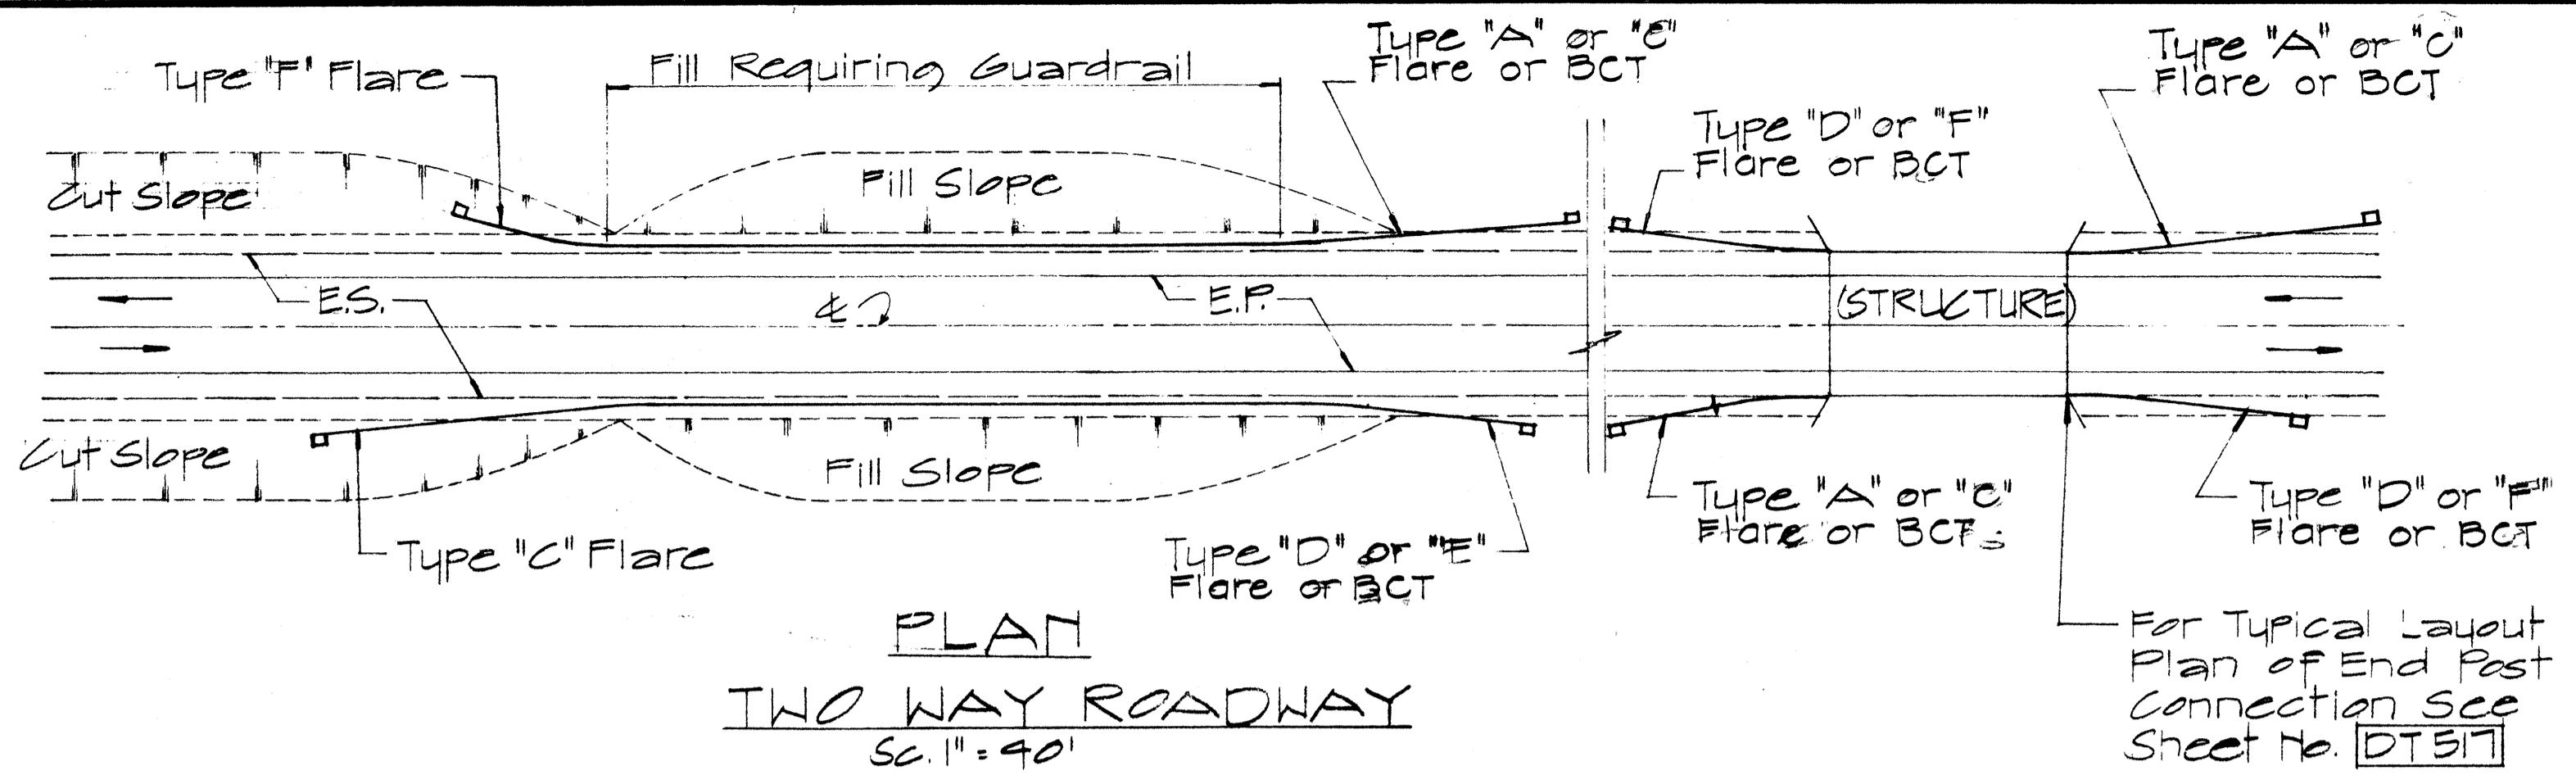

NOTE:

1. Metal guard rail connection to structures requires End Post Connection. See structure plans.
2. For detail of Breakaway Cable Terminal (BCT) see sheet No. DT 519

For Typical Layout Plan of End Post Connection See Sheet No. DT 517

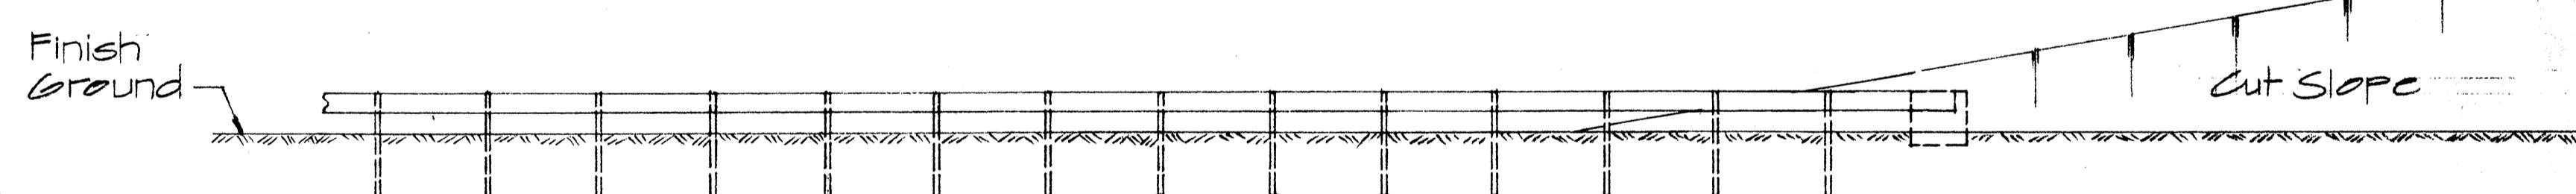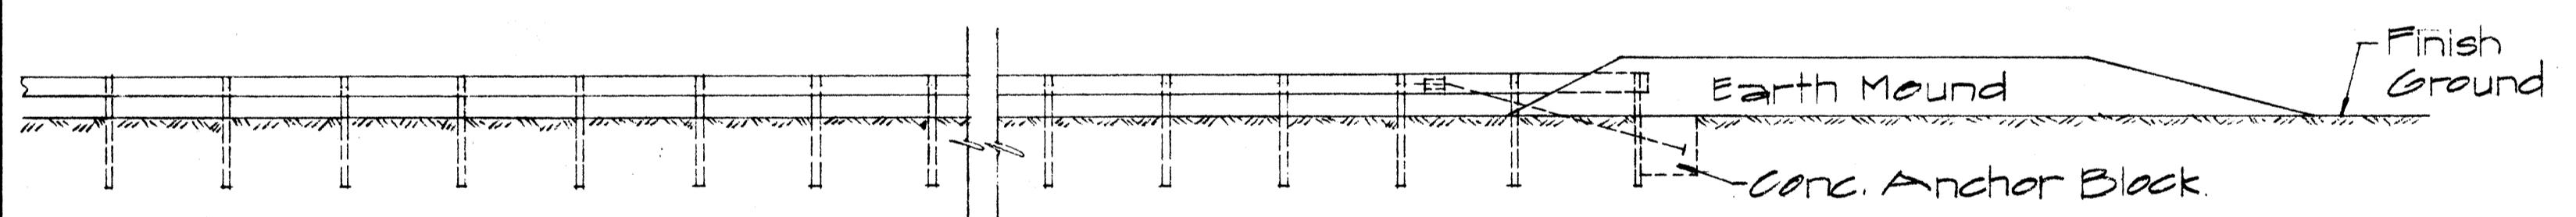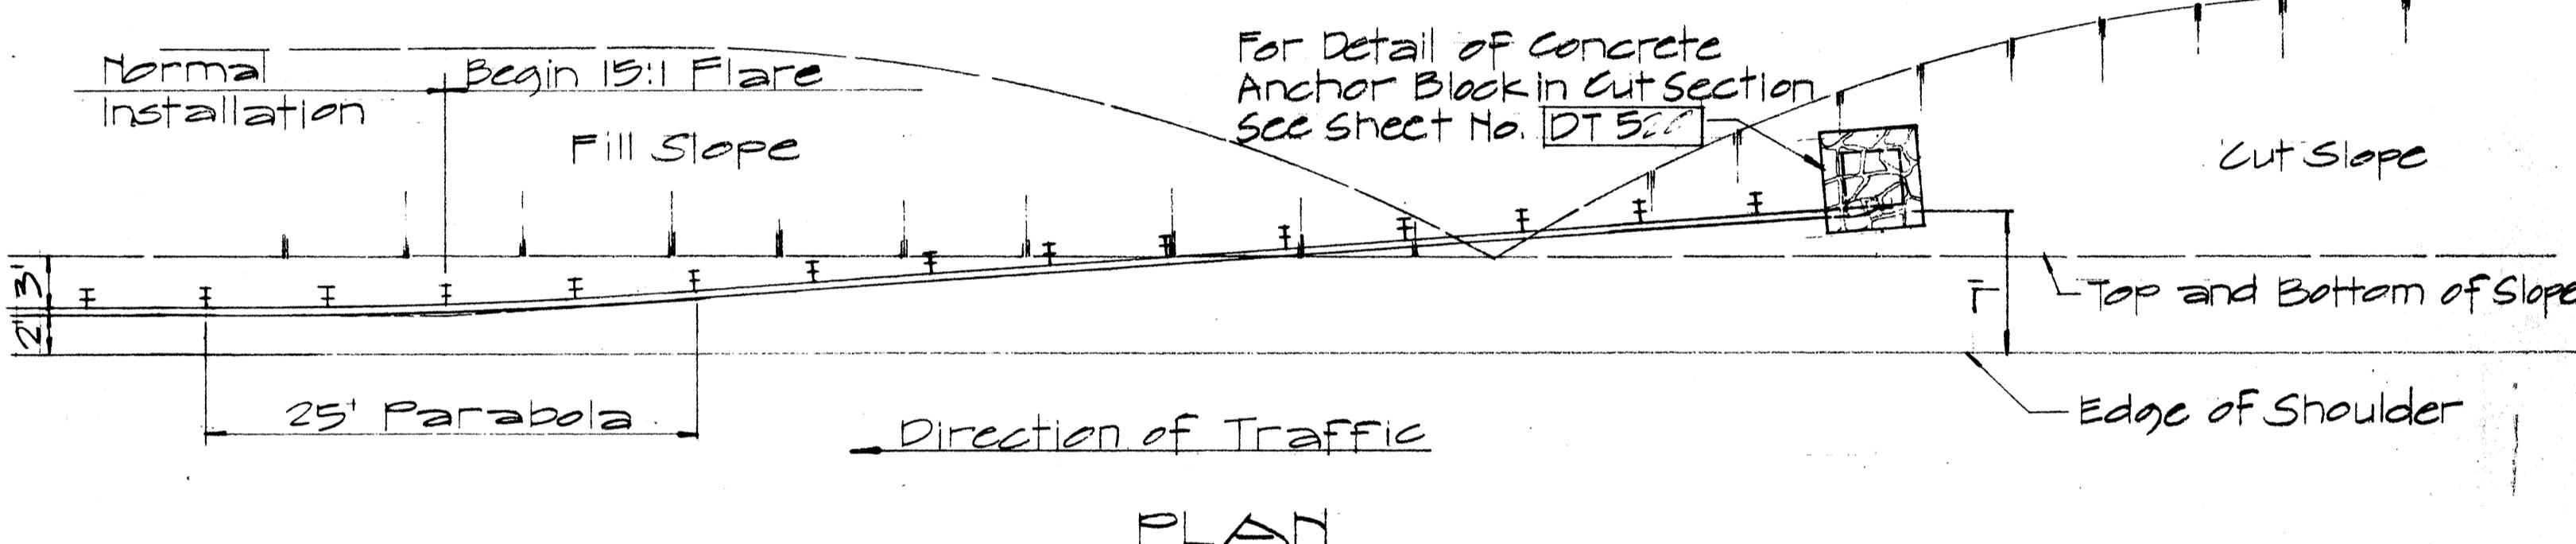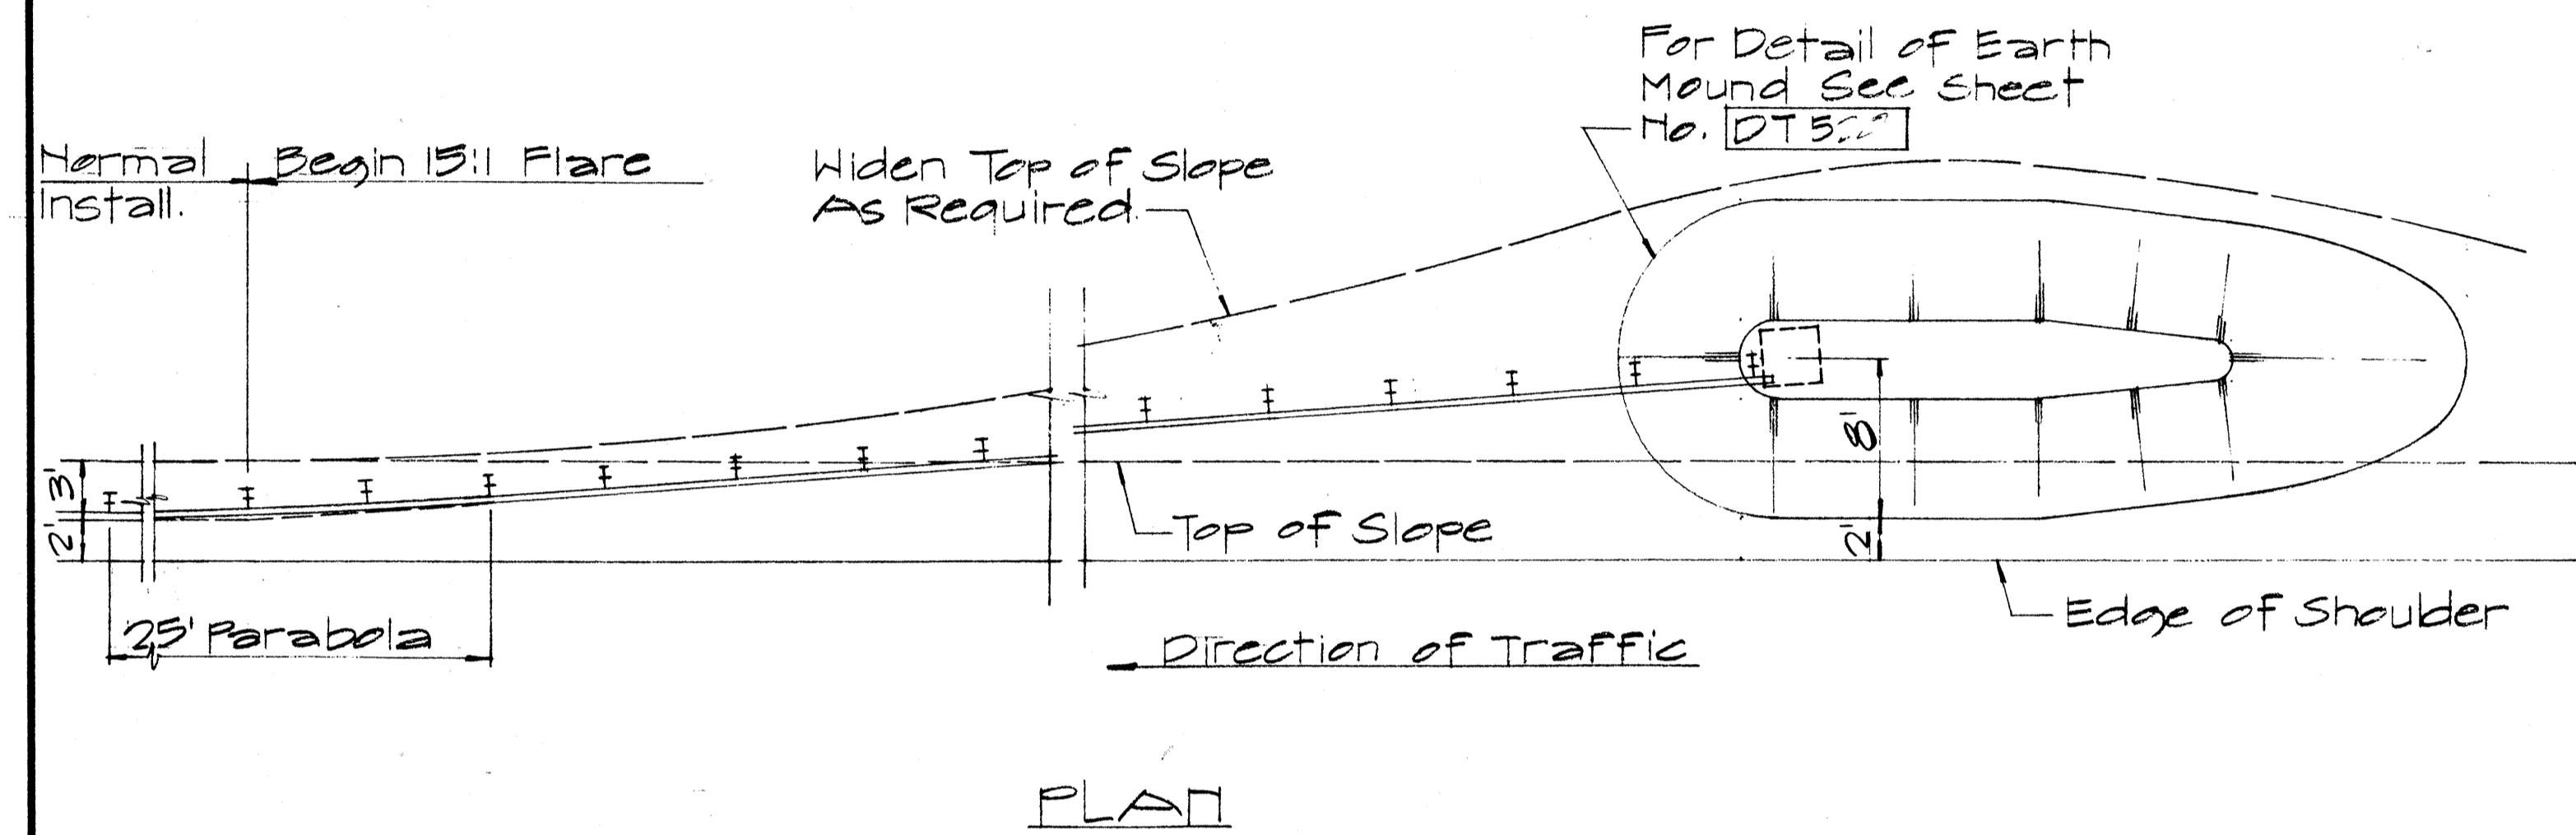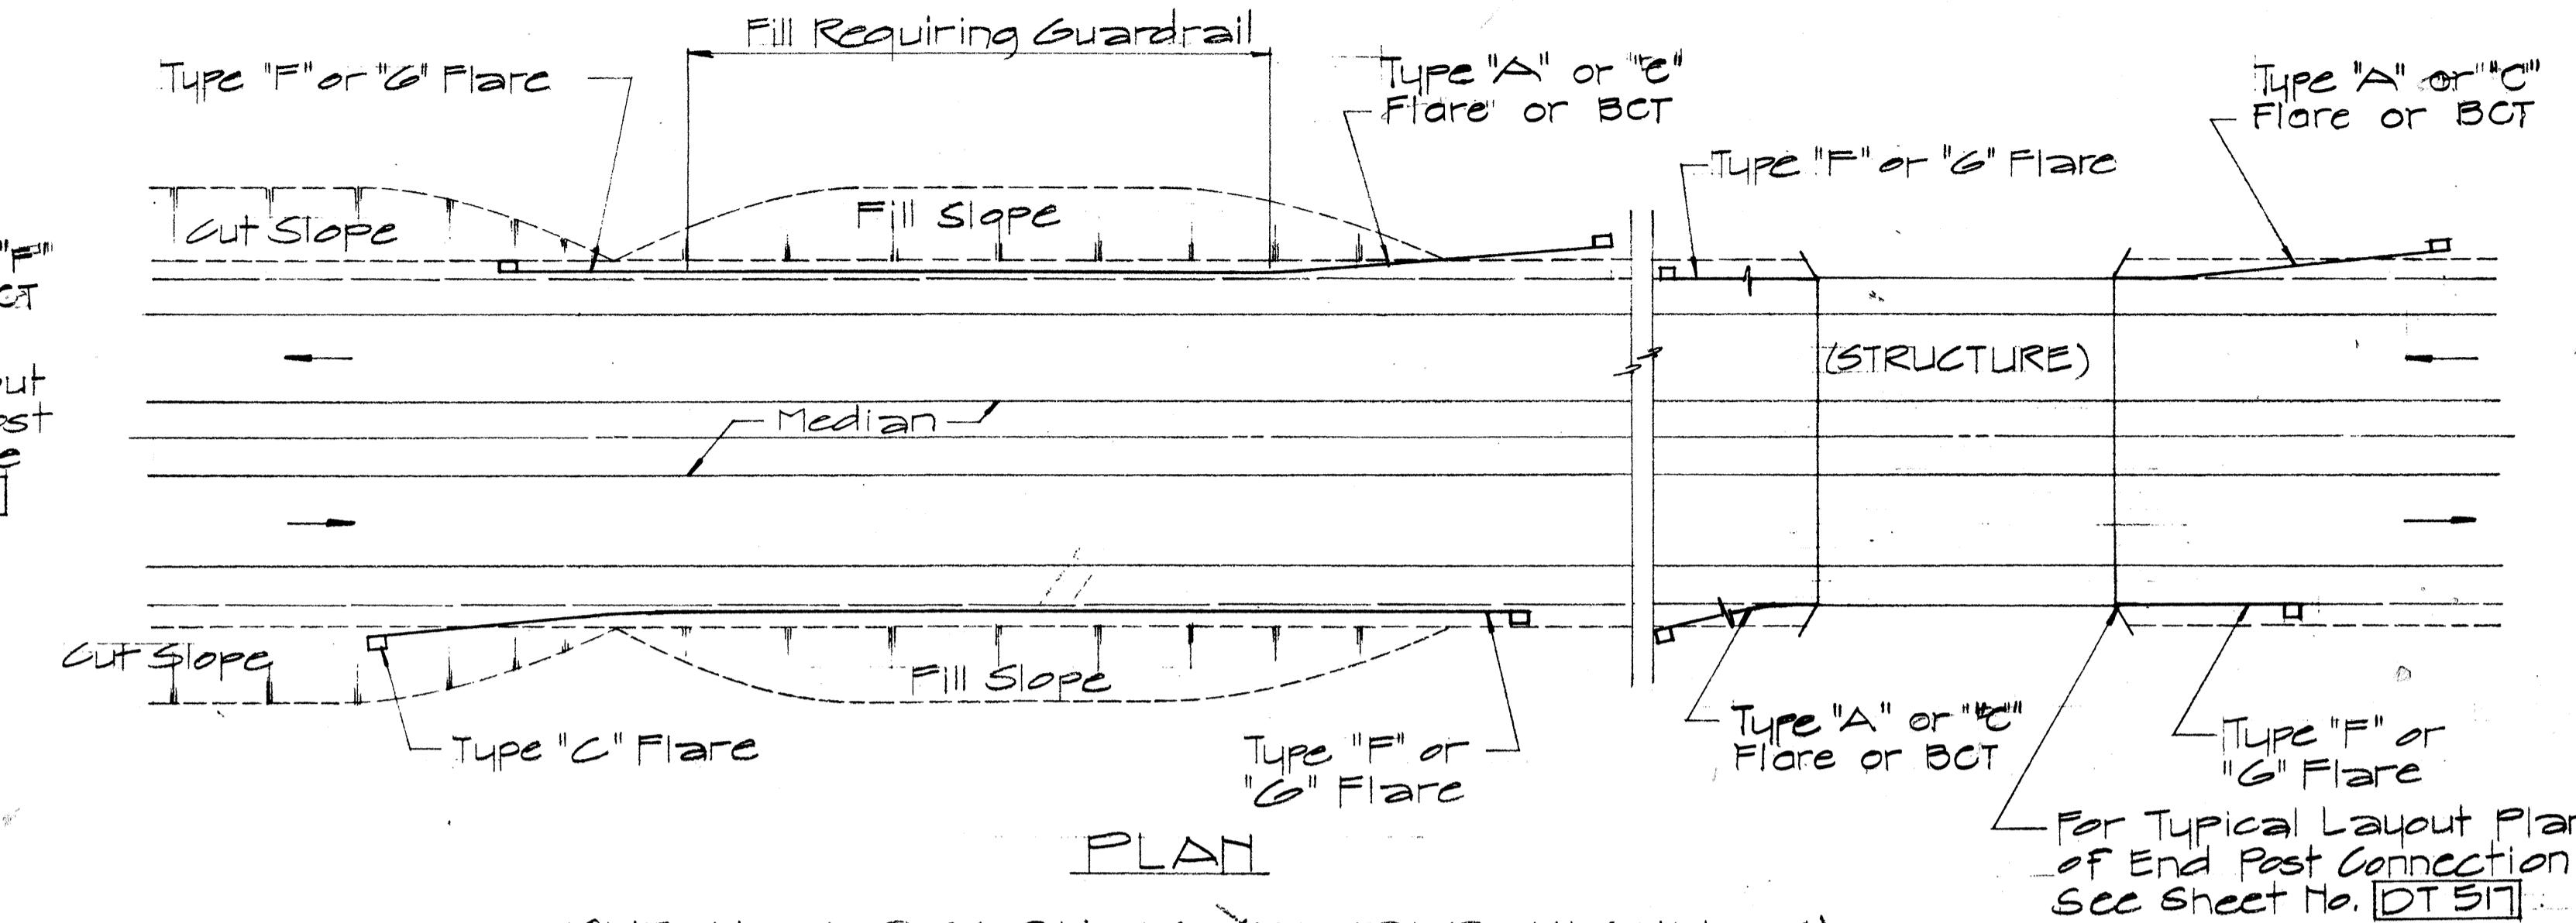

ELEVATION
TYPE "A" FLARE
Sc. 1/8"=1'-0"

ELEVATION
TYPE "C" FLARE
Sc. 1/8"=1'-0"

APPROVAL RECOMMENDED:
Etsushi Tanaka
TRAFFIC ENGINEER
DATE: 12/29/69

APPROVED:
John S. Saito
ASSISTANT CHIEF, ENGINEERING
DATE: 12-30-69

NO.	REVISION	APPROVED BY	DATE
1	Delete Type "B" Flare and Type "E" Flare	H.T. G/15/68	


STATE OF HAWAII
DEPARTMENT OF TRANSPORTATION
HIGHWAYS DIVISION

**STANDARD DETAILS
OF APPROACH END
FLARE - ONE & TWO
WAY ROADWAY**



Sc. As Noted April 1969
SHEET NO. OF SHEETS DT 516

FED. ROAD DIST. NO.	STATE	FED. AID PROJ. NO.	FISCAL YEAR	HEET NO.	TOTAL SHEETS
HAWAII	HAW.	I-H-1(187)	1984	42	197

For Detail of Earth Mound
See Sheet No. DT 500

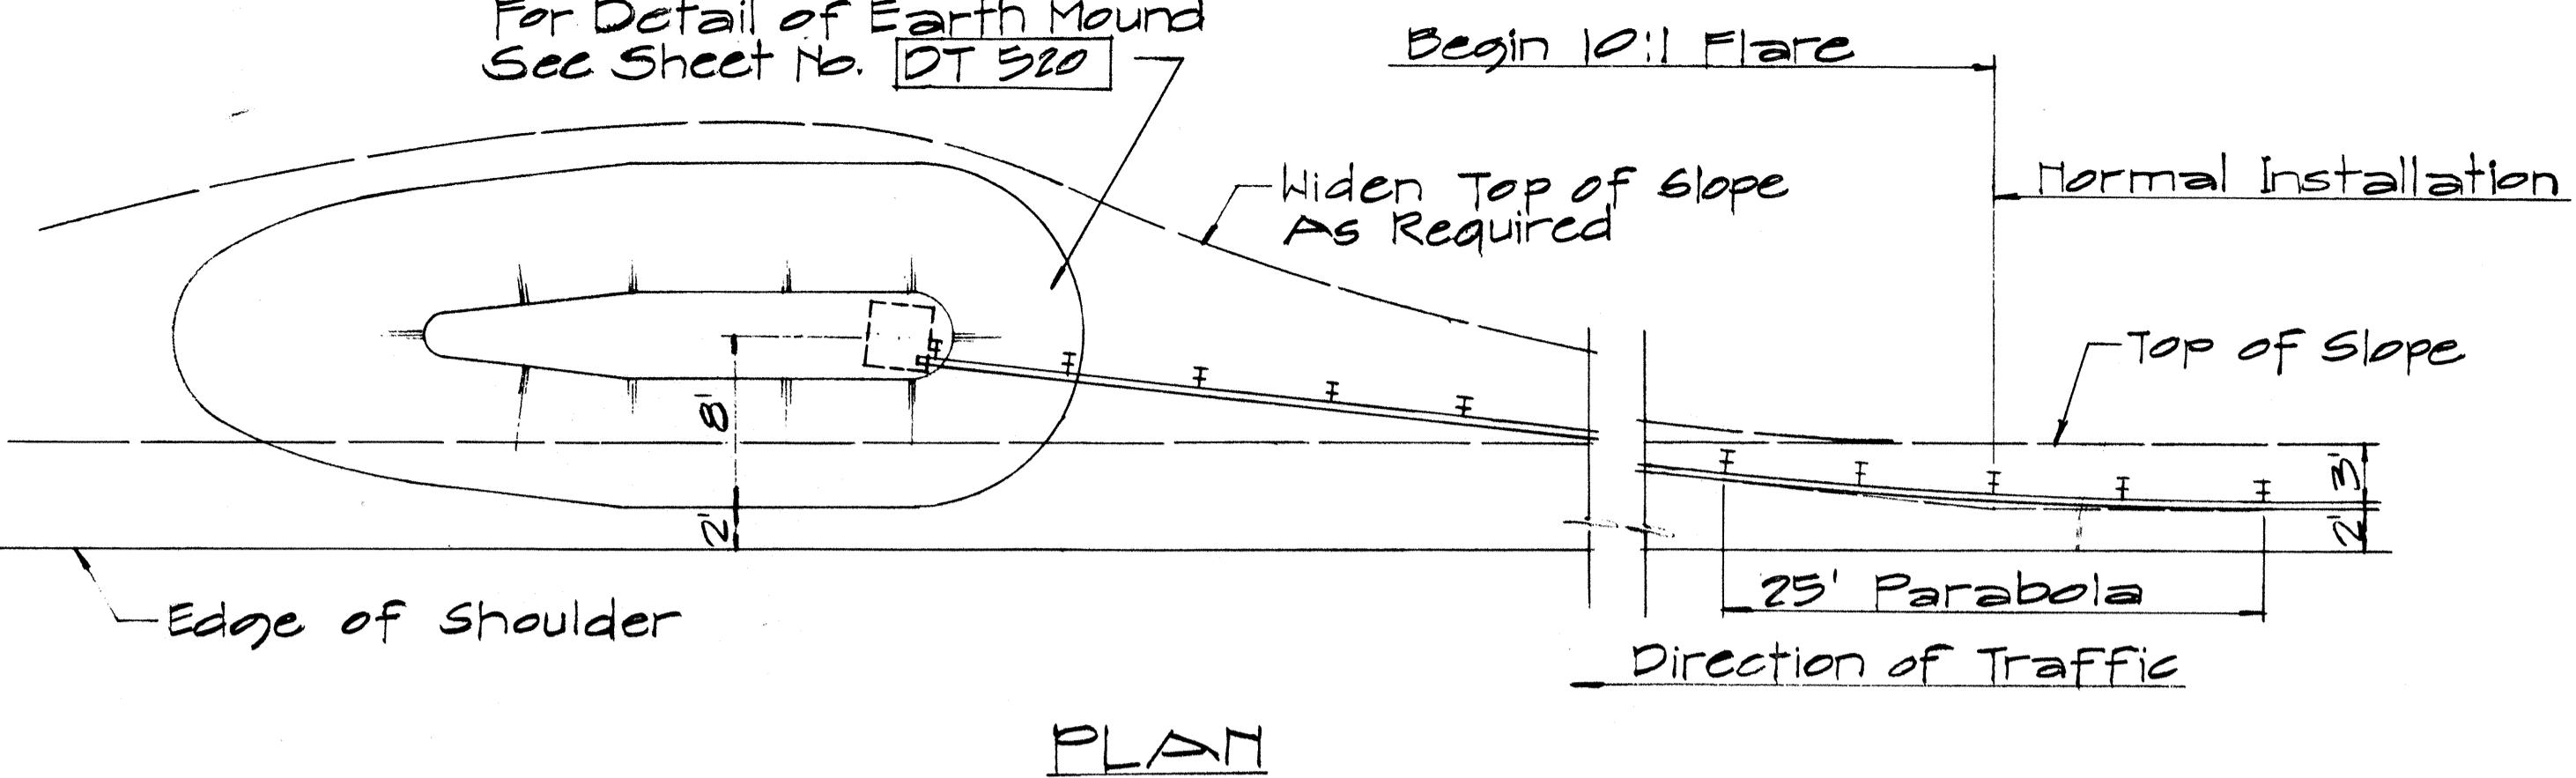


For Details of Concrete
Anchor Block in Cut Section
See Sheet No. DT 500

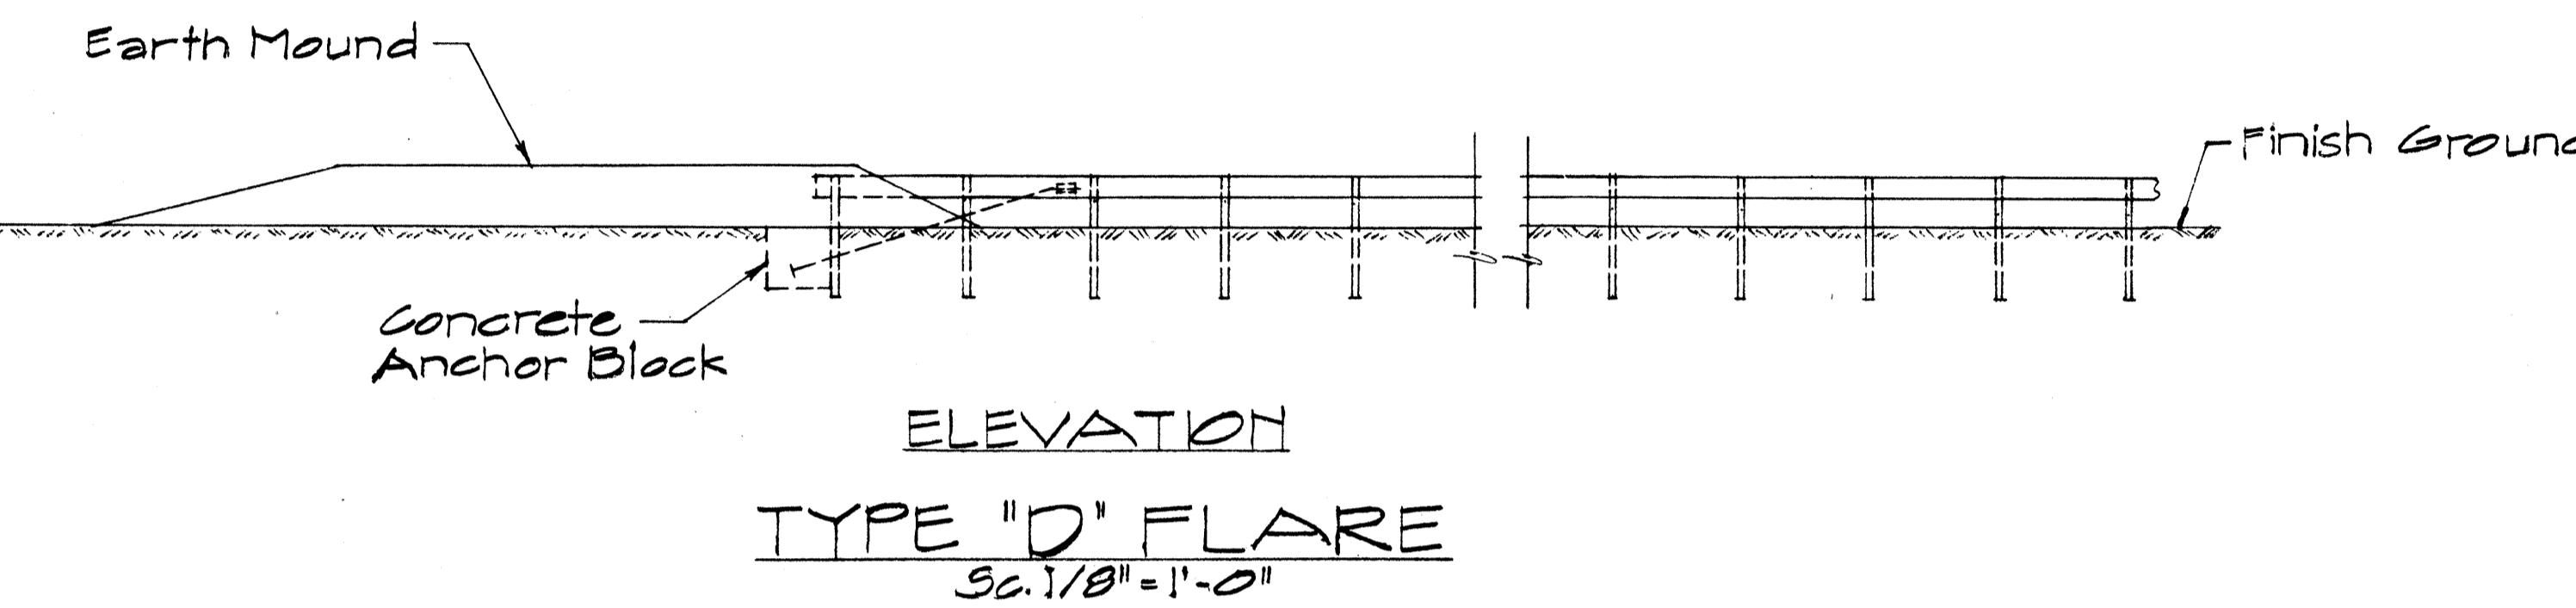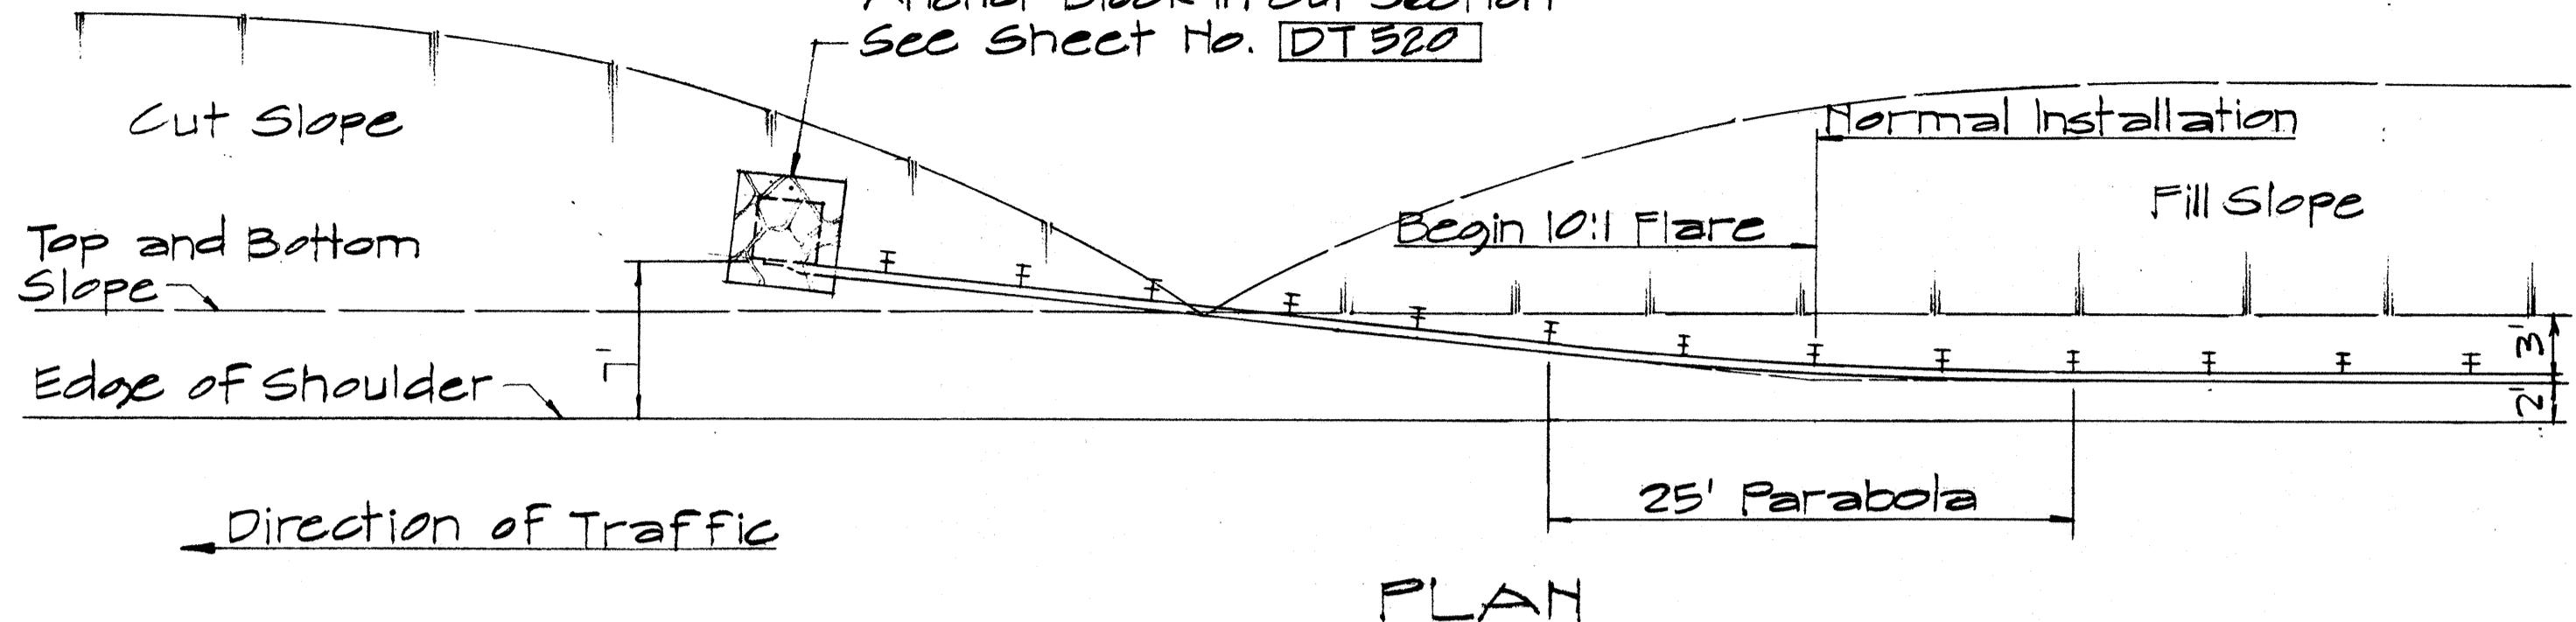

ELEVATION
TYPE "F" FLARE
Sc. 1/8" = 1'-0"


For Details of Concrete
Anchor Block in Ground
See Sheet No. DT 500

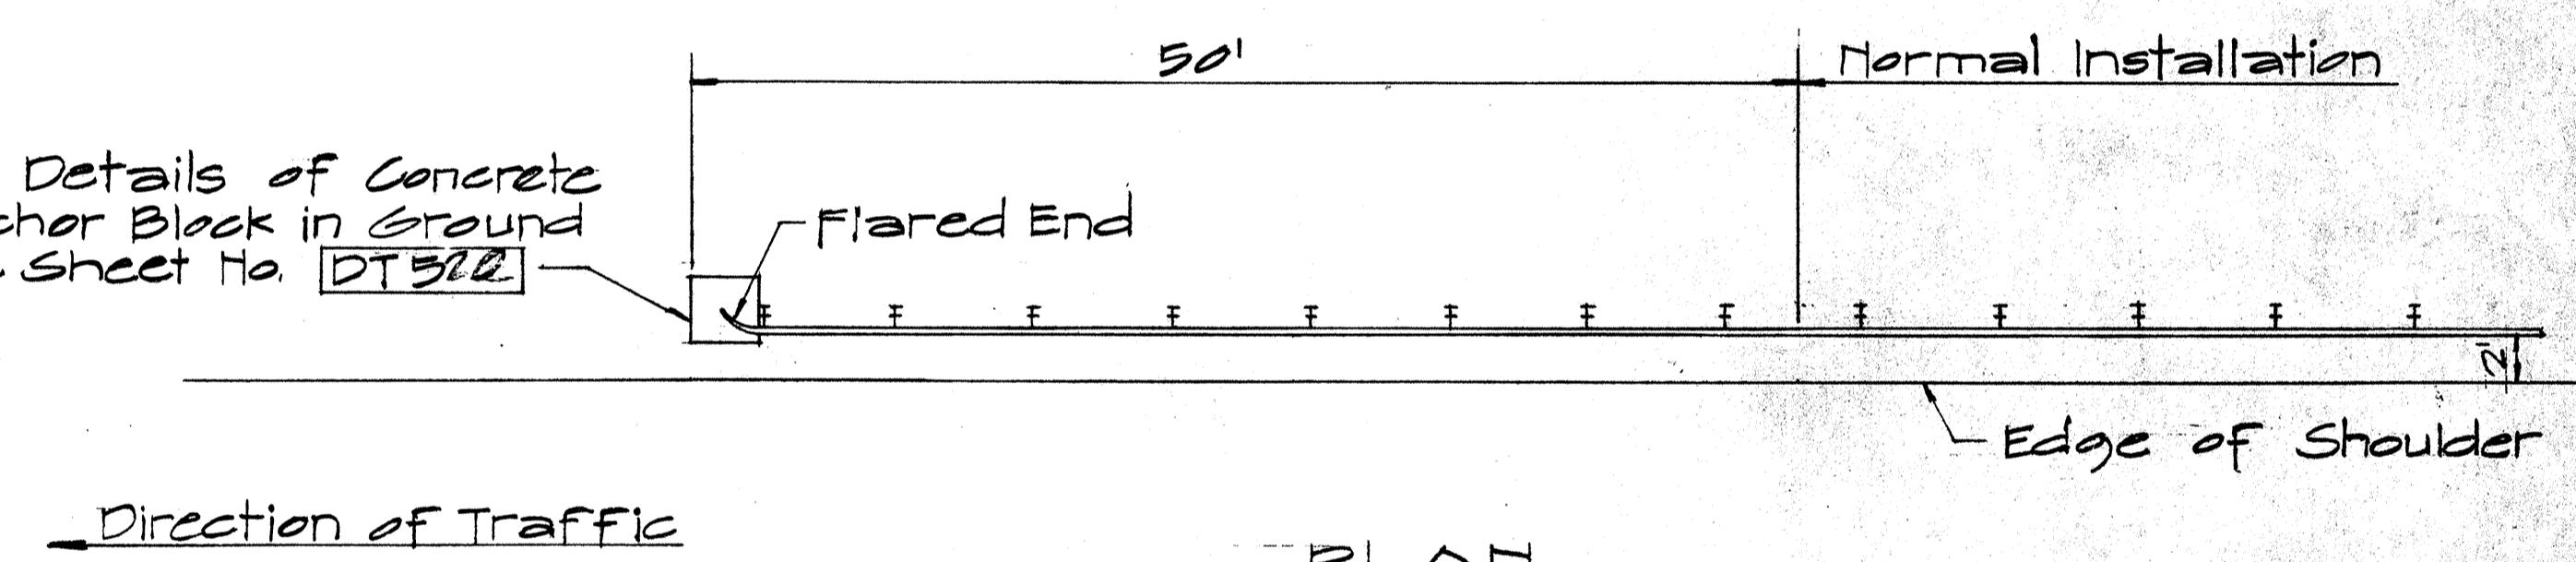

NOTE:

For detail of Breakaway Cable
Terminal (BCT) See Sheet No. DT 510

Typical Conc. 1-23/4"
Parapet

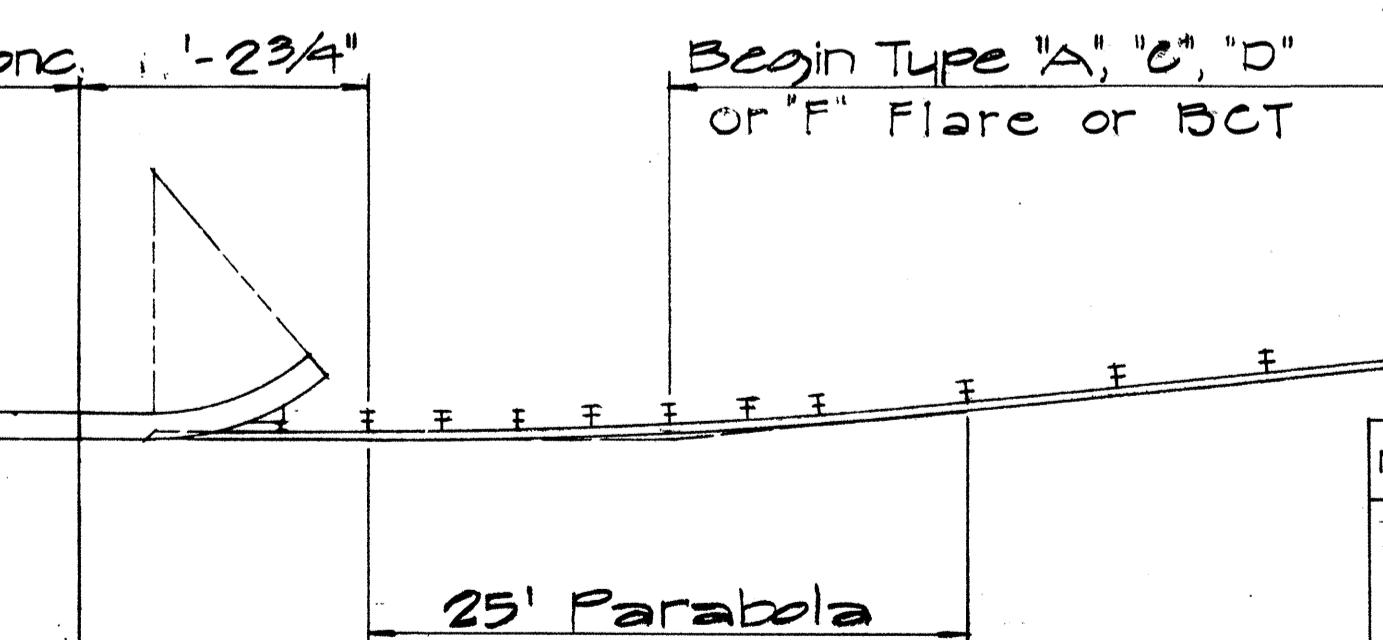

TYPE "G" FLARE
Sc. 1/8" = 1'-0"

APPROVAL RECOMMENDED:
Etsushi Tanaka
TRAFFIC ENGINEER
DATE: 12/29/69

APPROVED:
John S. S. Kal
ASSISTANT CHIEF, ENGINEERING
DATE: 12/30/69

TYPICAL LAYOUT PLAN OF
END POST CONNECTION
Sc. 1/8" = 1'-0"

NO.	REVISION	APPROVED BY	DATE
1	Additional Posts Added to Typical Layout Plan Of End Post Connection	H.C.	4-12-72
2	Delete Type "B" Flare and Type "E" Flare	H.C.	6-15-78

STATE OF HAWAII
DEPARTMENT OF TRANSPORTATION


HIGHWAYS DIVISION

STANDARD DETAILS
TRAILING END
FLARE - ONE & TWO
WAY ROADWAY


Scale: As Noted
April 1969
SHEET NO. OF SHEETS DT 517

ORIGINAL	PLATE
SURVEY PLOTTED BY	
TAPE READ BY	
DESIGNED BY	
QUANTITIES BY	
CHECKED BY	
NOTE BOOK	
NO.	


FED. ROAD DIST. NO.	STATE	FED. AID PROJ. NO.	FISCAL YEAR	SHEET NO.	TOTAL SHEETS
HAWAII	HAW.	I-HI-1(187)	1984	44	197

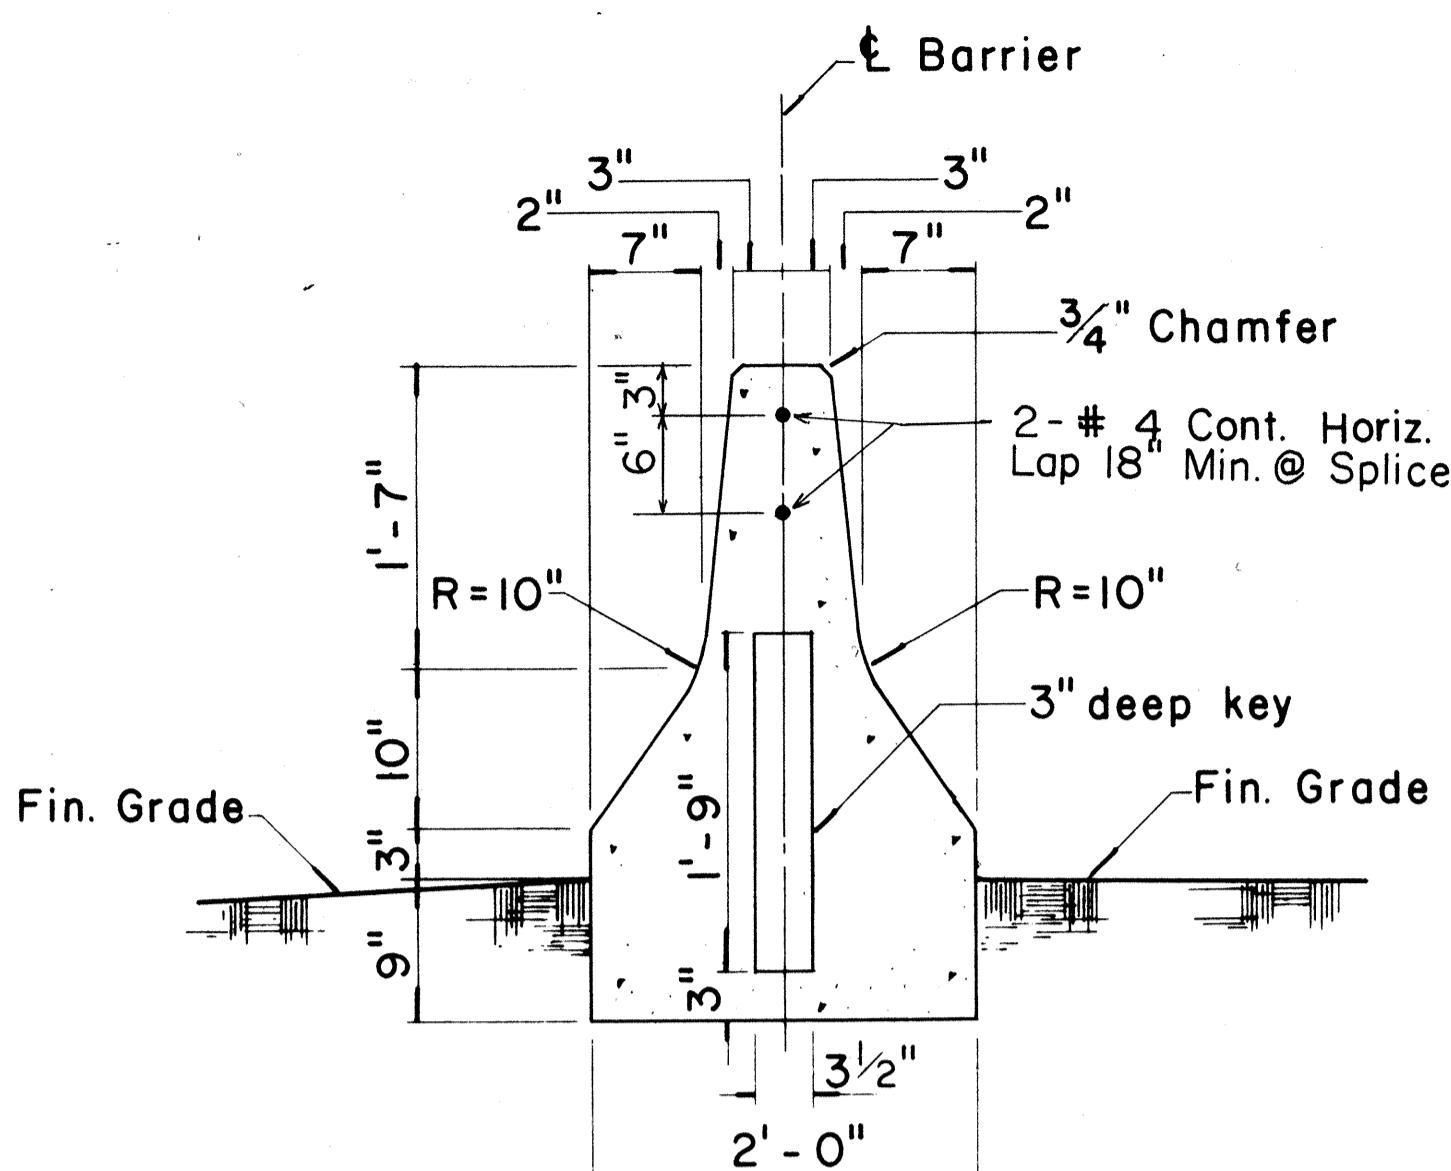


Scale: 1" = 1'-0"

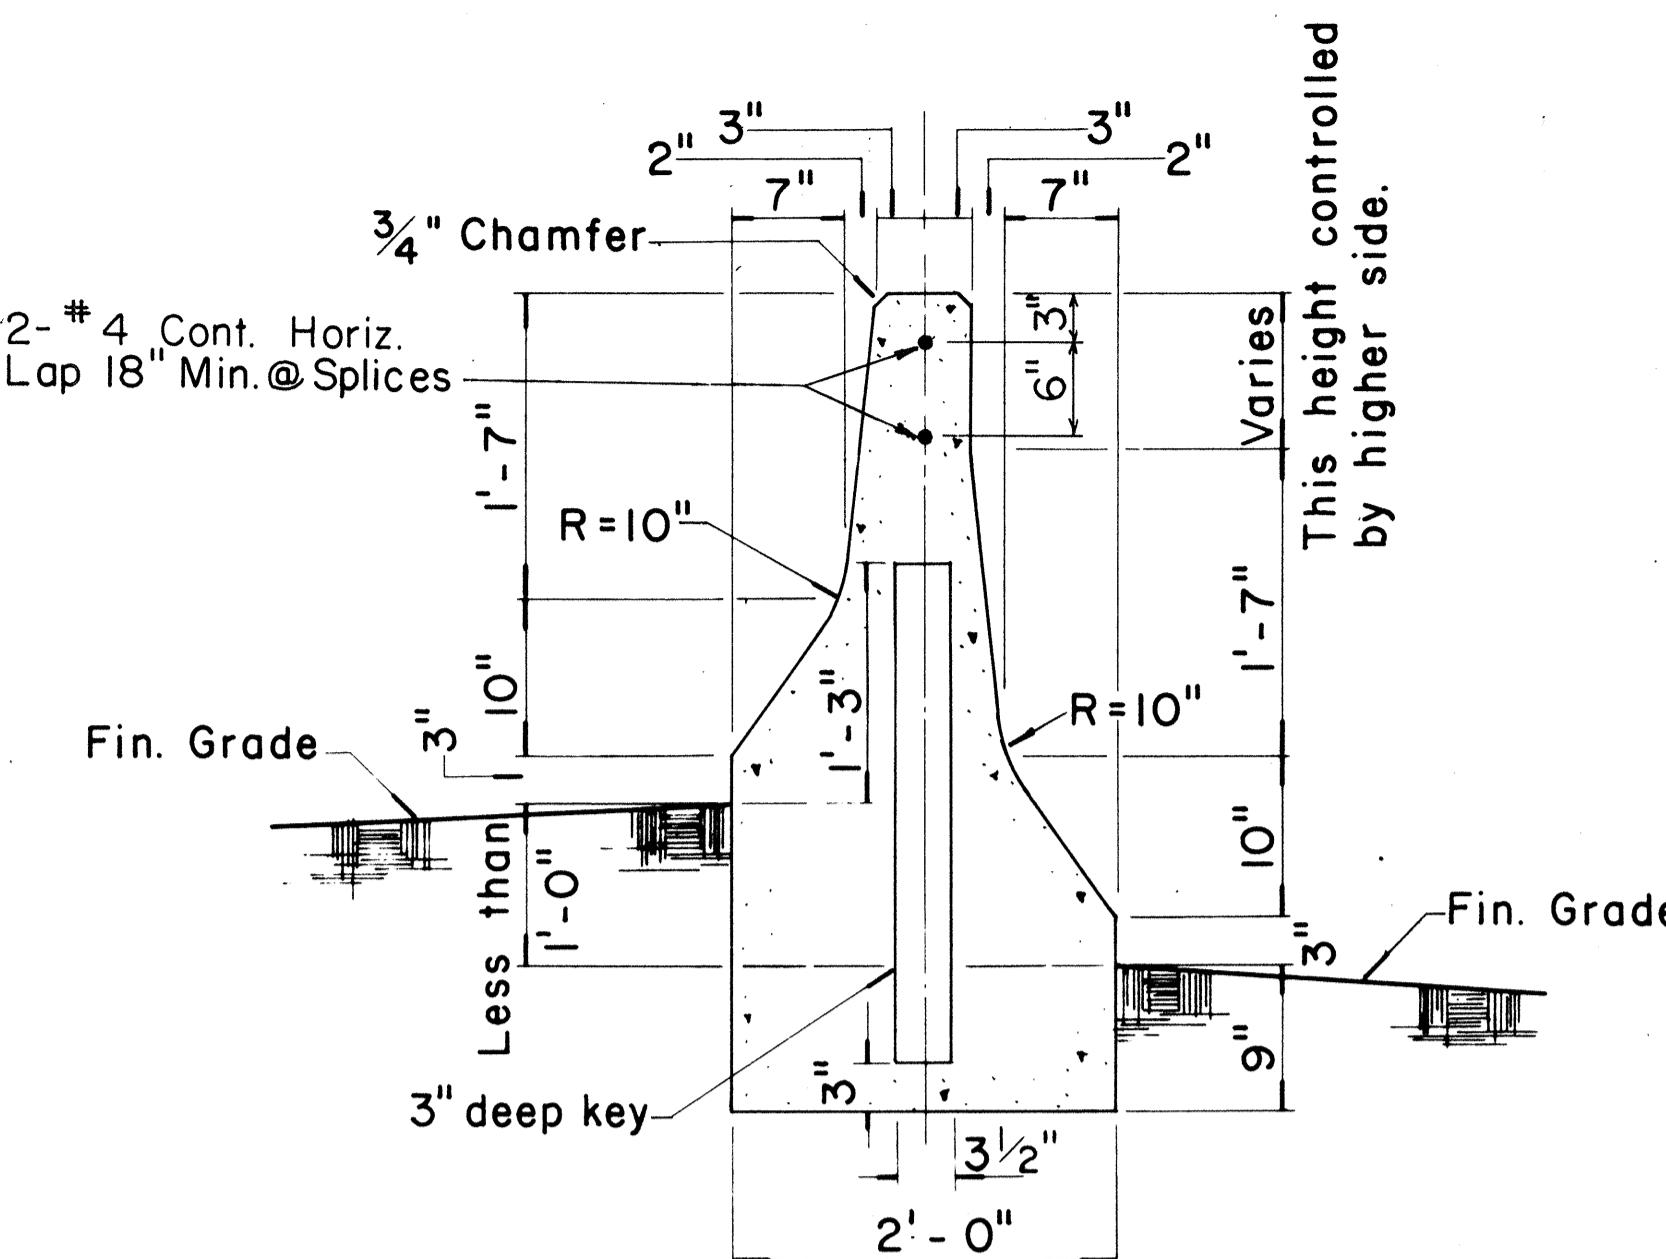

Scale: 1" = 1'-0"

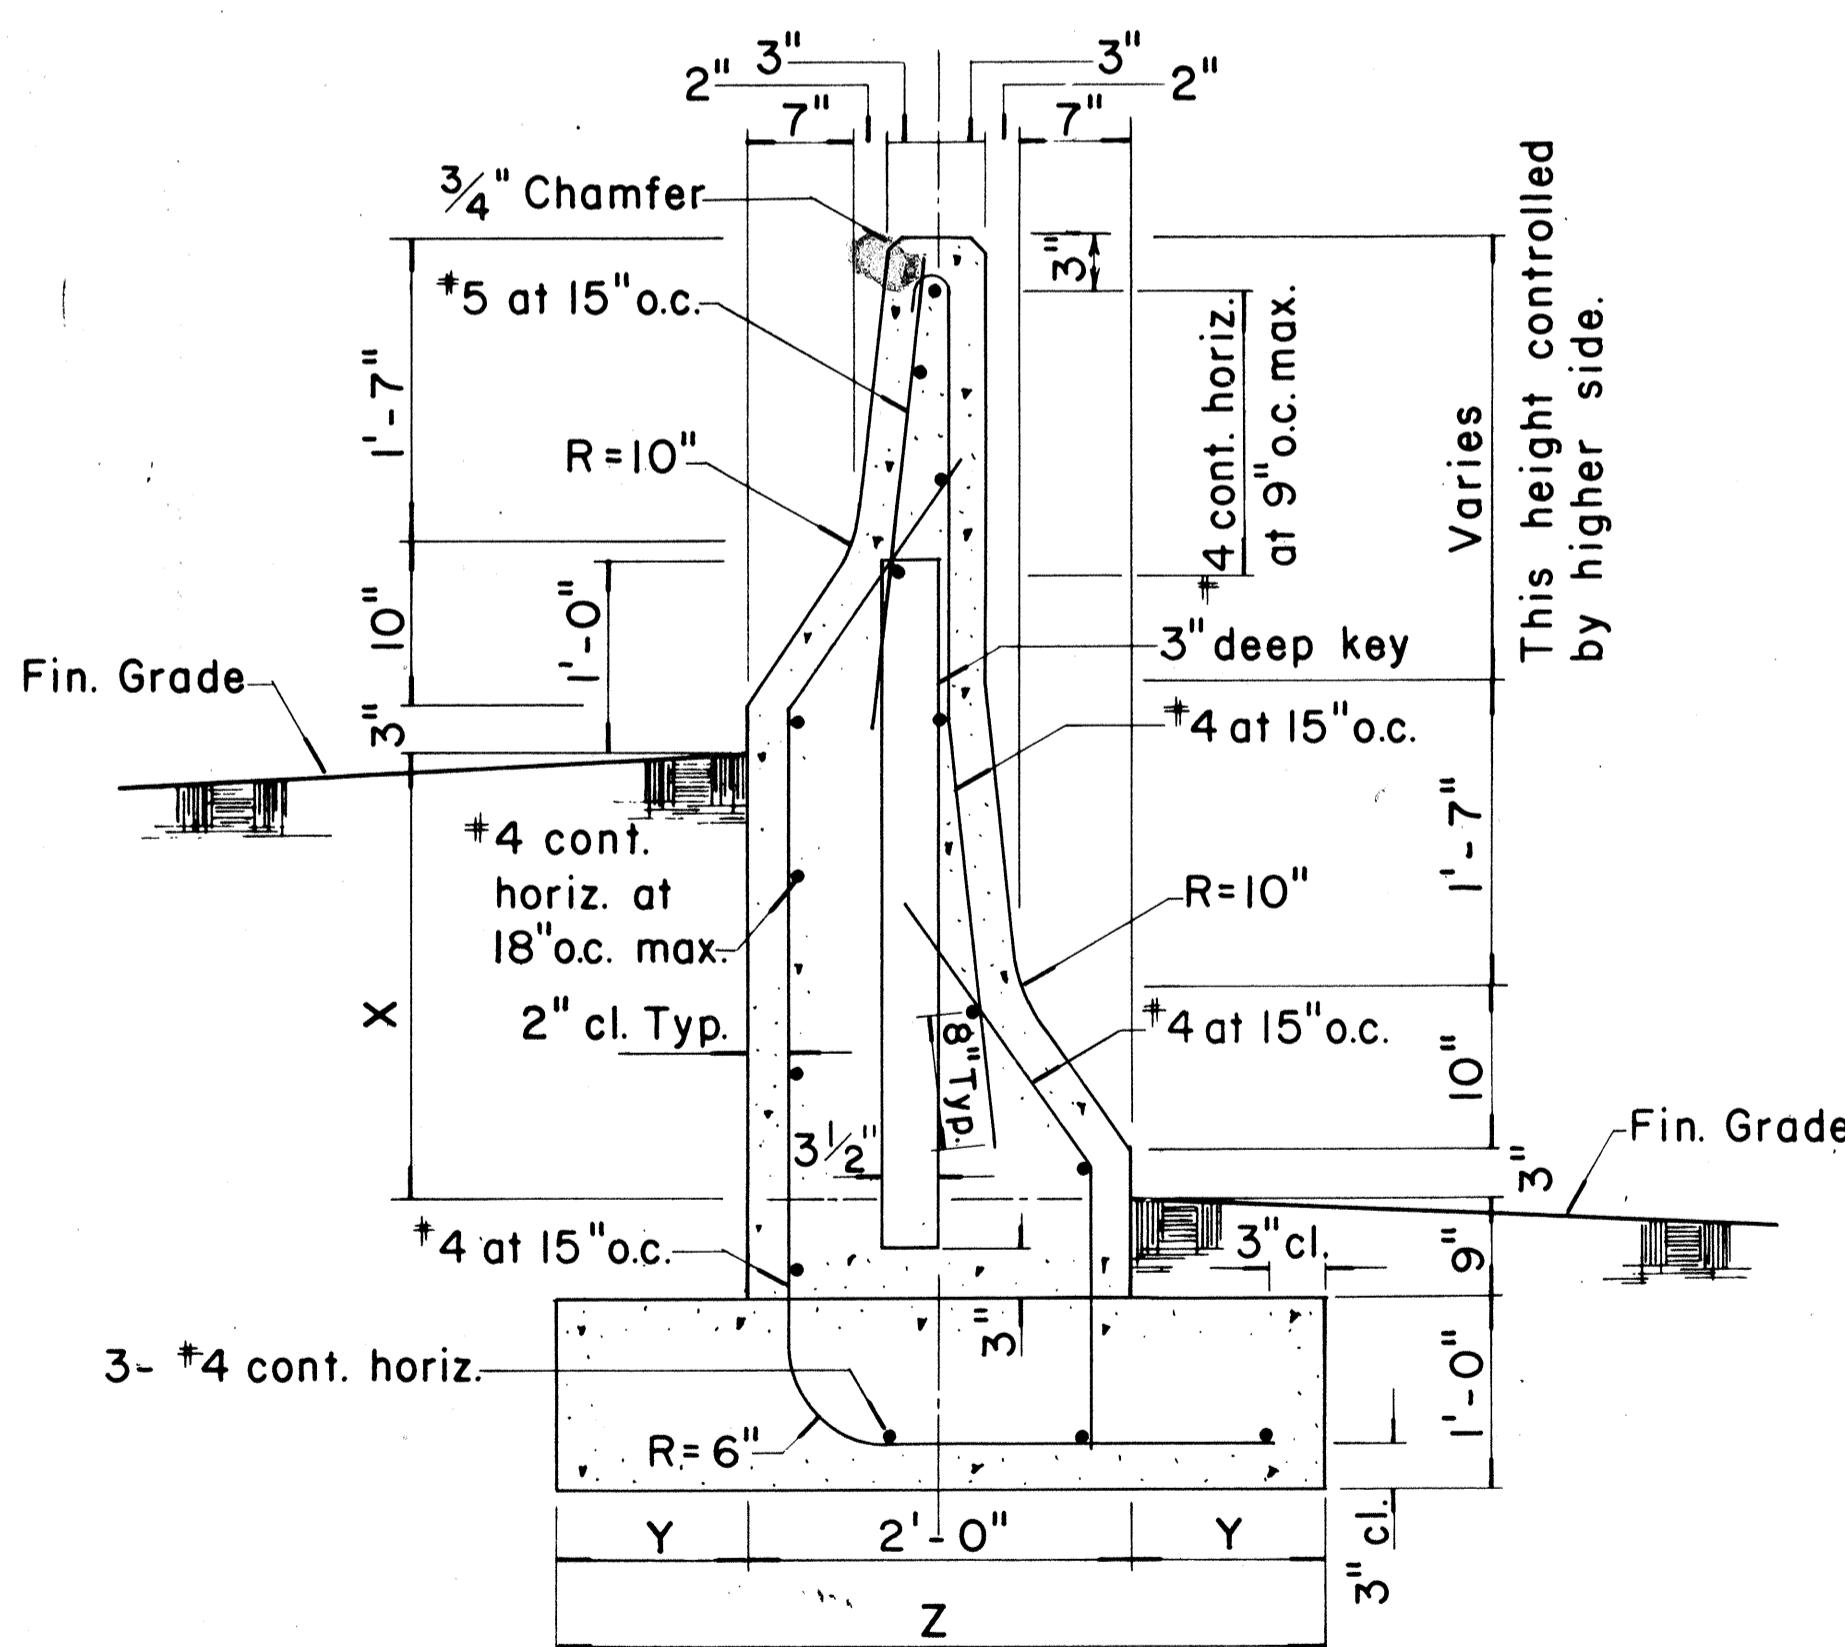

Scale: 1" = 1'-0"

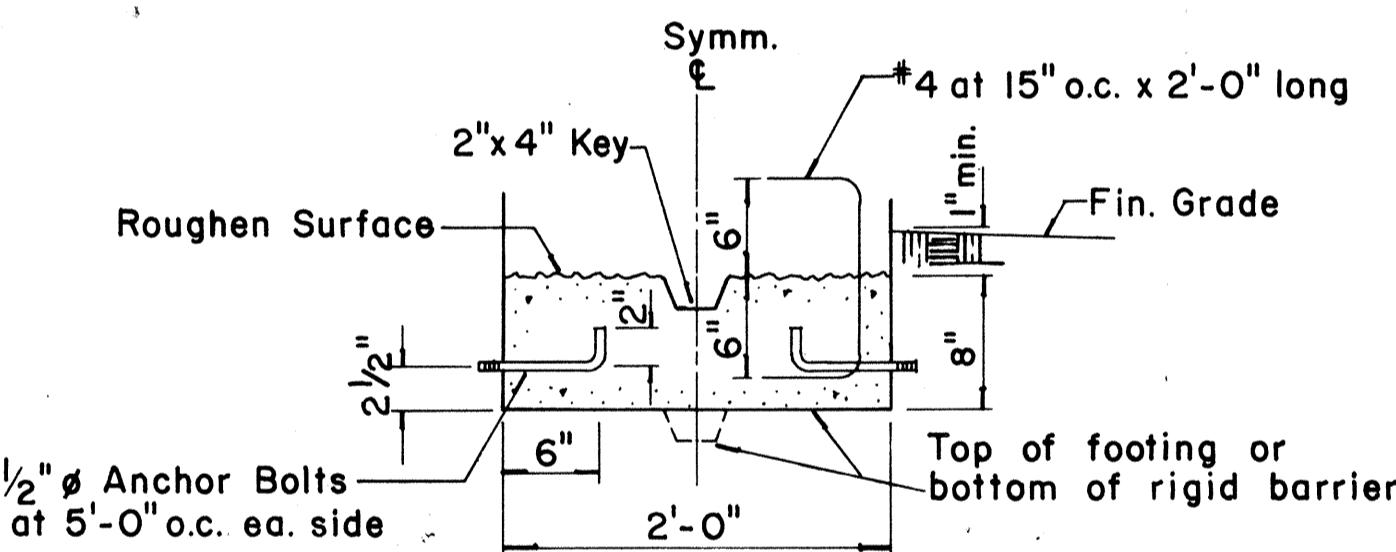

OPTIONAL CONSTRUCTION JOINT DETAILS

Scale: 1" = 1'-0"

NOTE:

The intent of the optional construction joint details for the Type 4 Rigid Barrier Guard Rail is to provide a method of securing the forms and preventing uplift so that the barrier will have a uniform and presentable appearance.



The Contractor may submit an alternate method of constructing the barrier for the approval of the Engineer and for use on a trial basis. Any unsatisfactory work shall be removed or corrected as directed by the Engineer and at the Contractor's expense.

TYPE 4C & TYPE 4D

Scale: 1" = 1'-0"

NOTE:
Except where noted all dimensions shall be the same for Type 4C and Type 4D.


TYPE	DIFFERENCE IN FIN. GRADE / FOOTING		
	X	Y	Z
4C	1'-0" min., 2'-4" max.	1'-0"	4'-0"
4D	Greater than 2'-4", 4'-4" max.	1'-3"	4'-6"

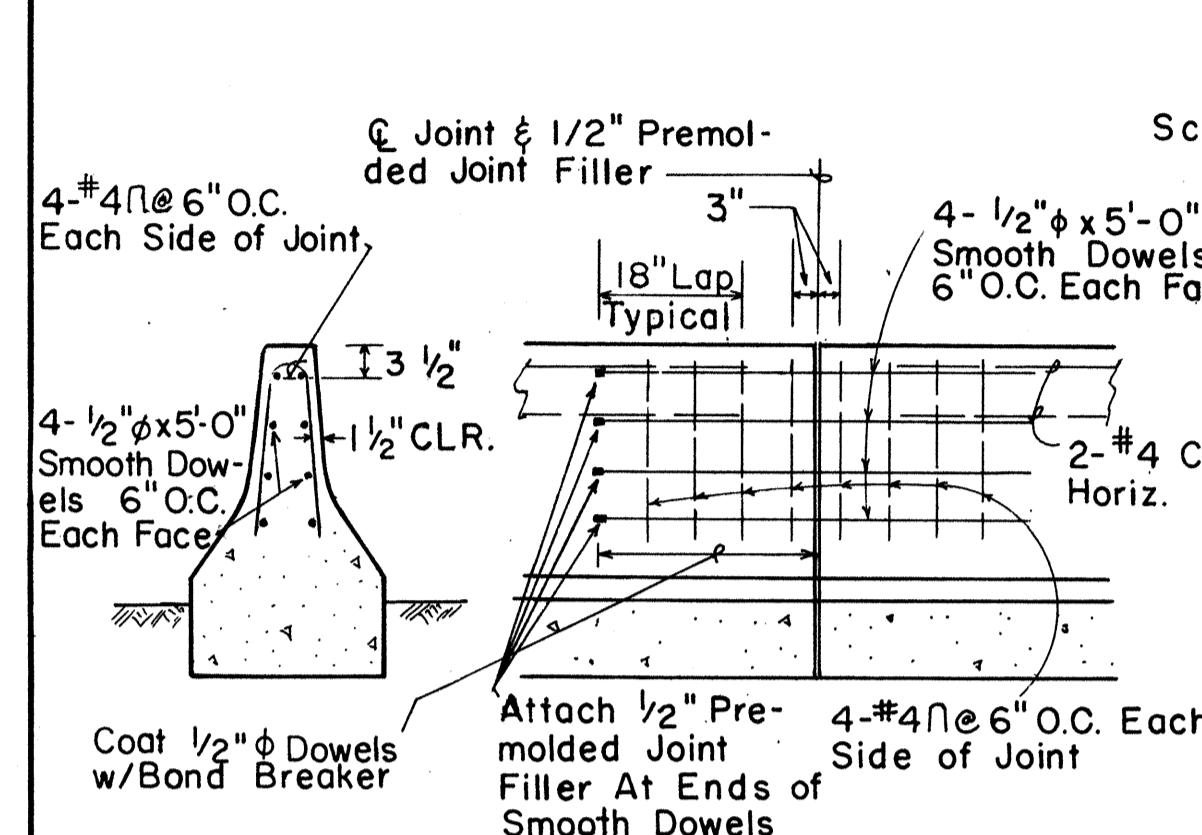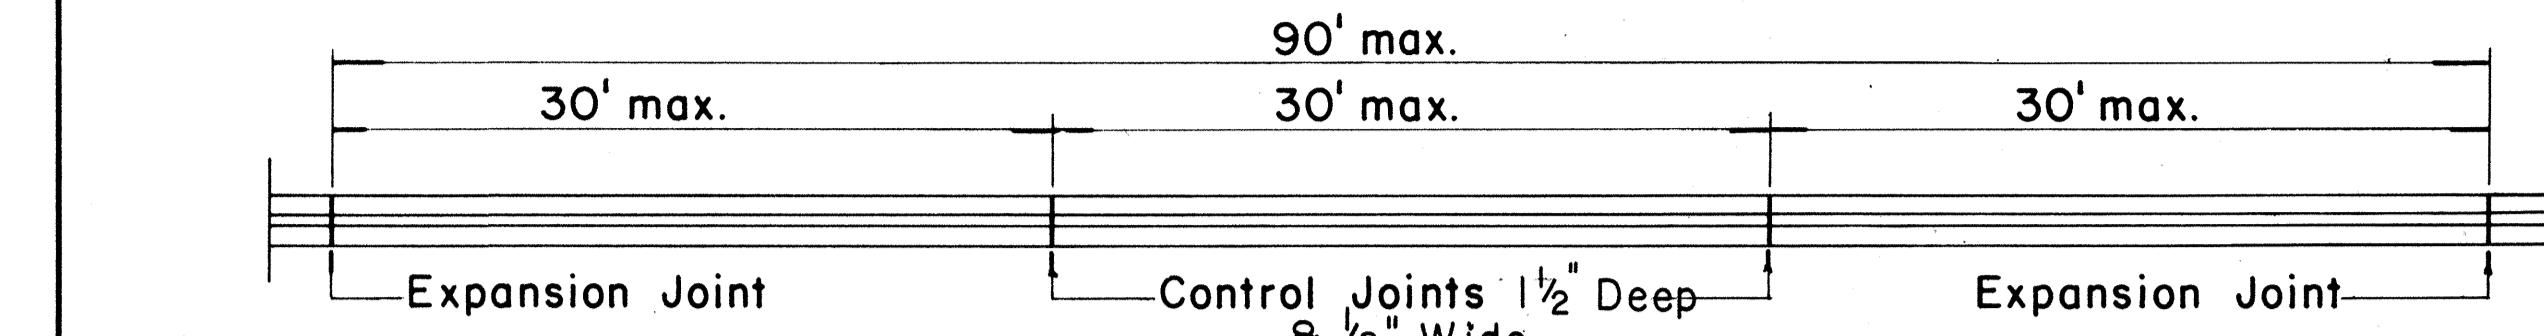

ELEVATION

EXPANSION JOINT DETAIL

SCALE: 1/2" = 1'-0"

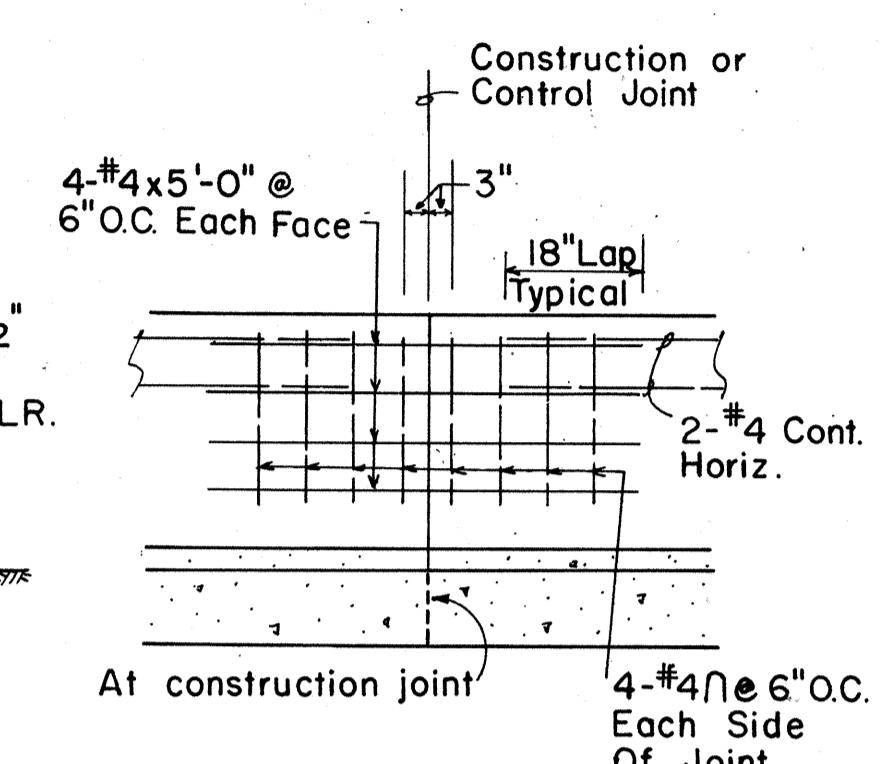


ELEVATION

CONSTRUCTION & CONTROL JOINT DETAIL

SCALE: 1/2" = 1'-0"

NOTE: 1/2" PREMOLDED JOINT FILLER IS NOT REQUIRED AT CONSTRUCTION JOINTS.

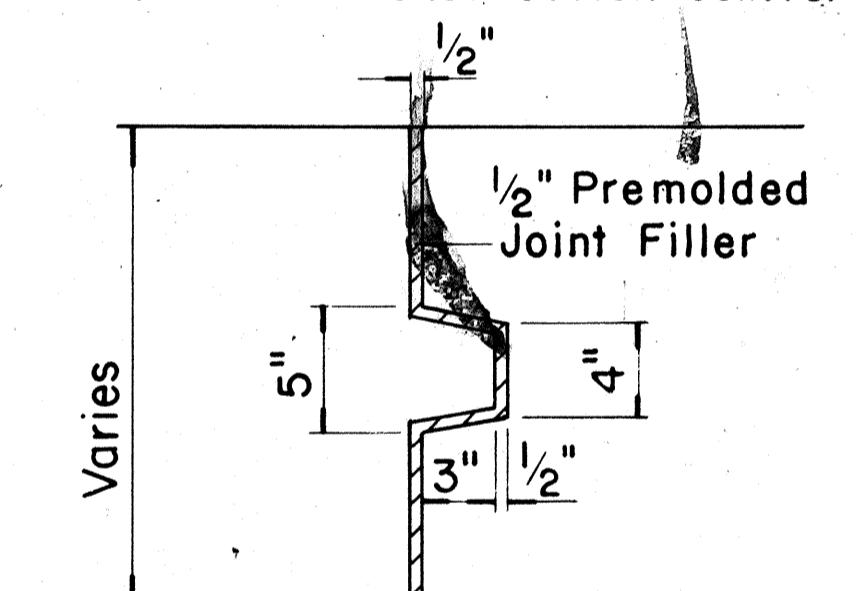

SECTION THRU KEY AT EXPANSION JOINT

Scale: 1 1/2" = 1'-0"

APPROVAL RECOMMENDED:

Erica Hanaka
TRAFFIC ENGINEER

DATE
1/20/81

APPROVED:

Robert Daisaki
ASSISTANT CHIEF, ENGINEERING

DATE
1/21/81


STATE OF HAWAII
DEPARTMENT OF TRANSPORTATION
HIGHWAYS DIVISION

STANDARD DETAILS


GUARD RAIL TYPE 4 (RIGID BARRIER)

Scale: As Shown
SHEET No. OF SHEETS DT 521


FED. ROAD DIST. NO.	STATE	FED. AID PROJ. NO.	FISCAL YEAR	SHEET NO.	TOTAL SHEETS
HAWAII	HAW.	I-HI-1(87)	1984	45	197

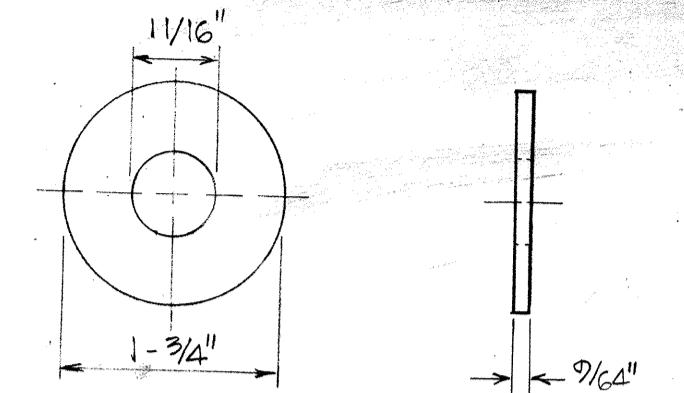


STEEL WASHER FOR 5/8" BOLT

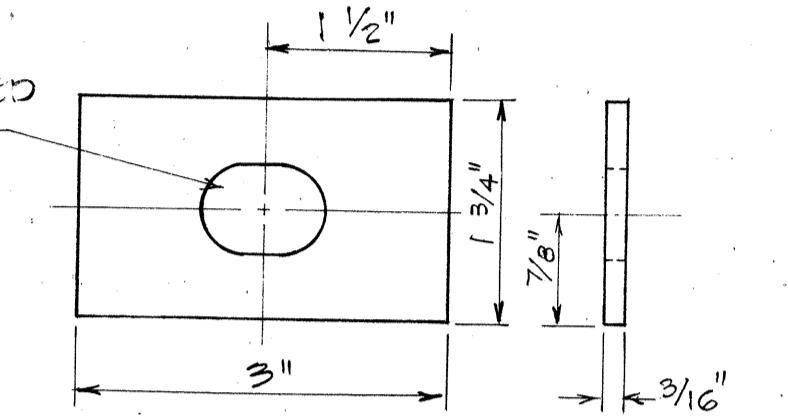


RECTANGULAR PLATE WASHER

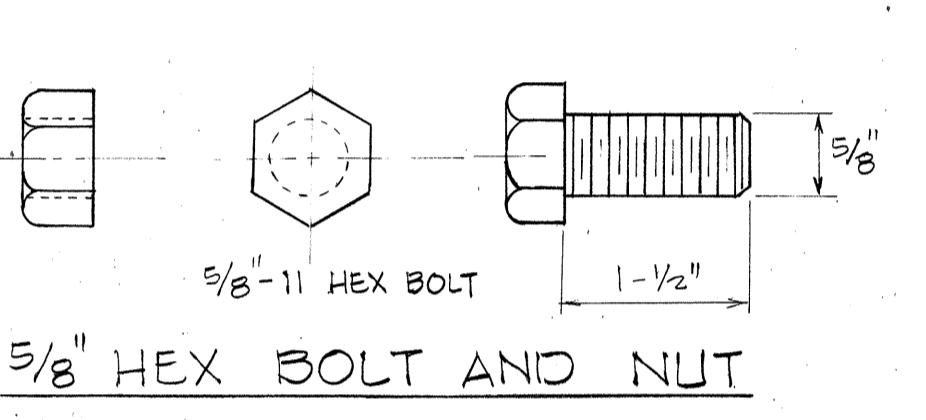


5/8" HEX BOLT AND NUT

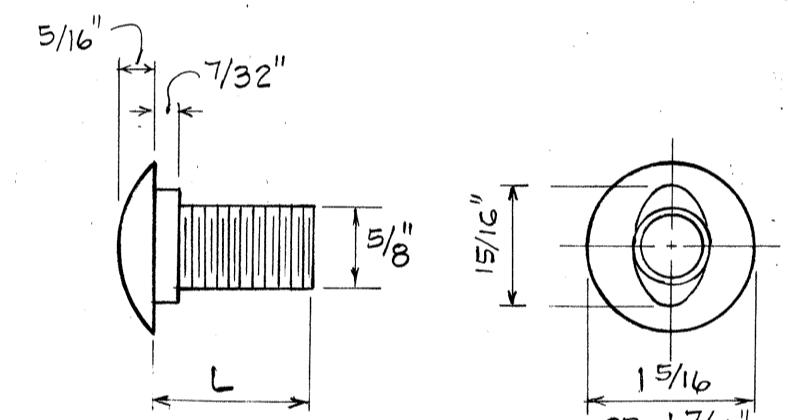

BACKUP PLATE

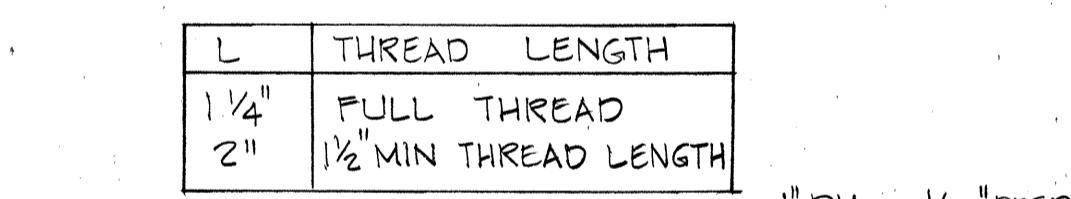


TRANSITION SECTION

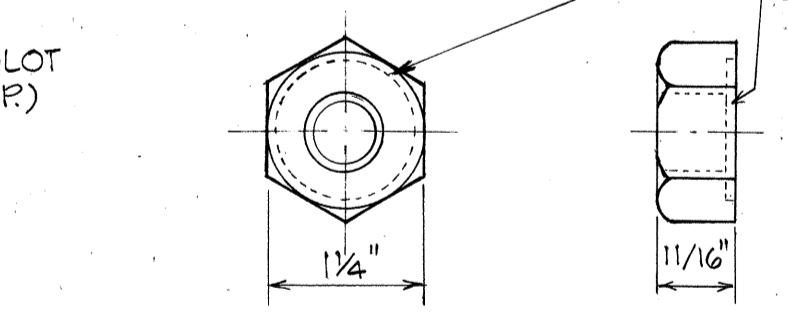


5/8" BUTTON HEAD BOLTS
AND RECESS NUT

* REPLACED WG X 8.5, WHICH IS ACCEPTABLE AS AN ALTERNATE.


STATE OF HAWAII DEPARTMENT OF TRANSPORTATION LAND TRANSPORTATION FACILITIES DIVISION	
<u>TYPICAL DETAIL</u>	
<u>GUARD RAIL TYPE 3</u>	
<u>THRIE BEAM</u>	
Scale: As Shown	Date: April, 1980
SHEET NO. 1 OF 1 SHEETS	

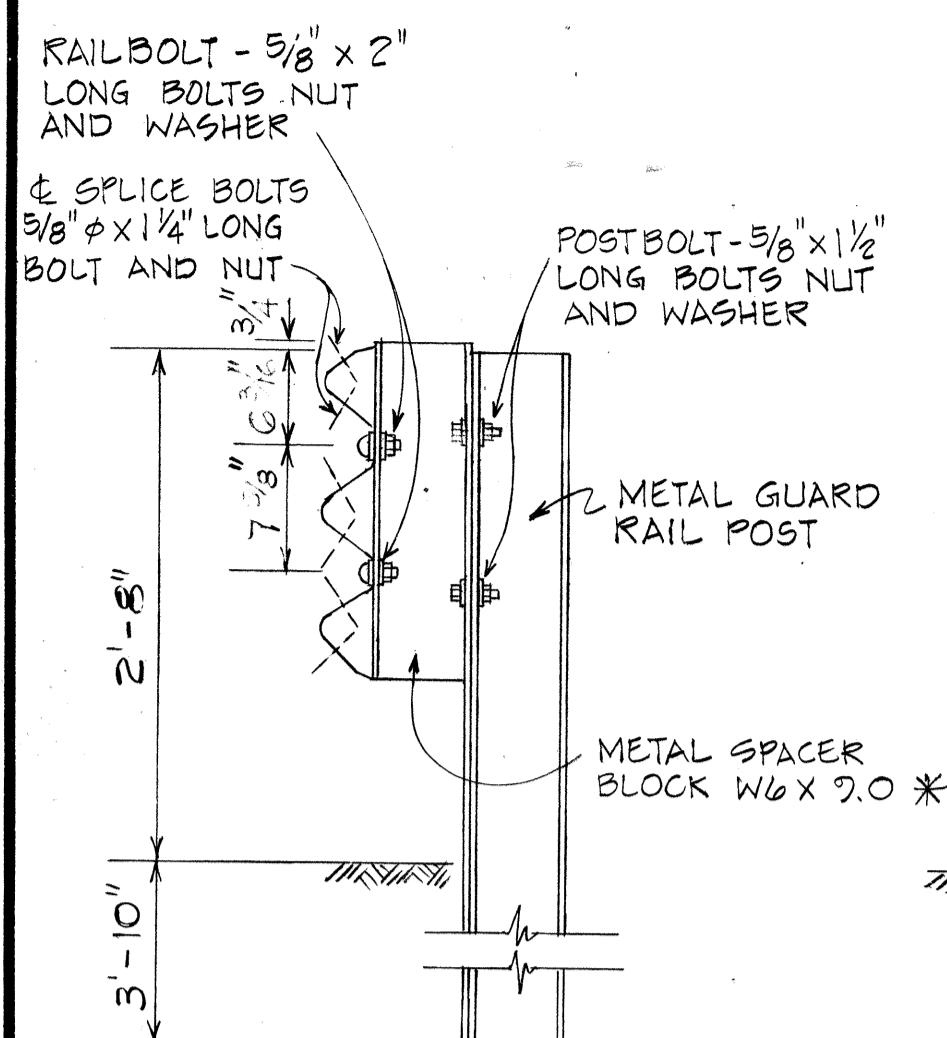

SINGLE METAL GUARD RAIL
ON METAL POST W/METAL SPACER BLK.

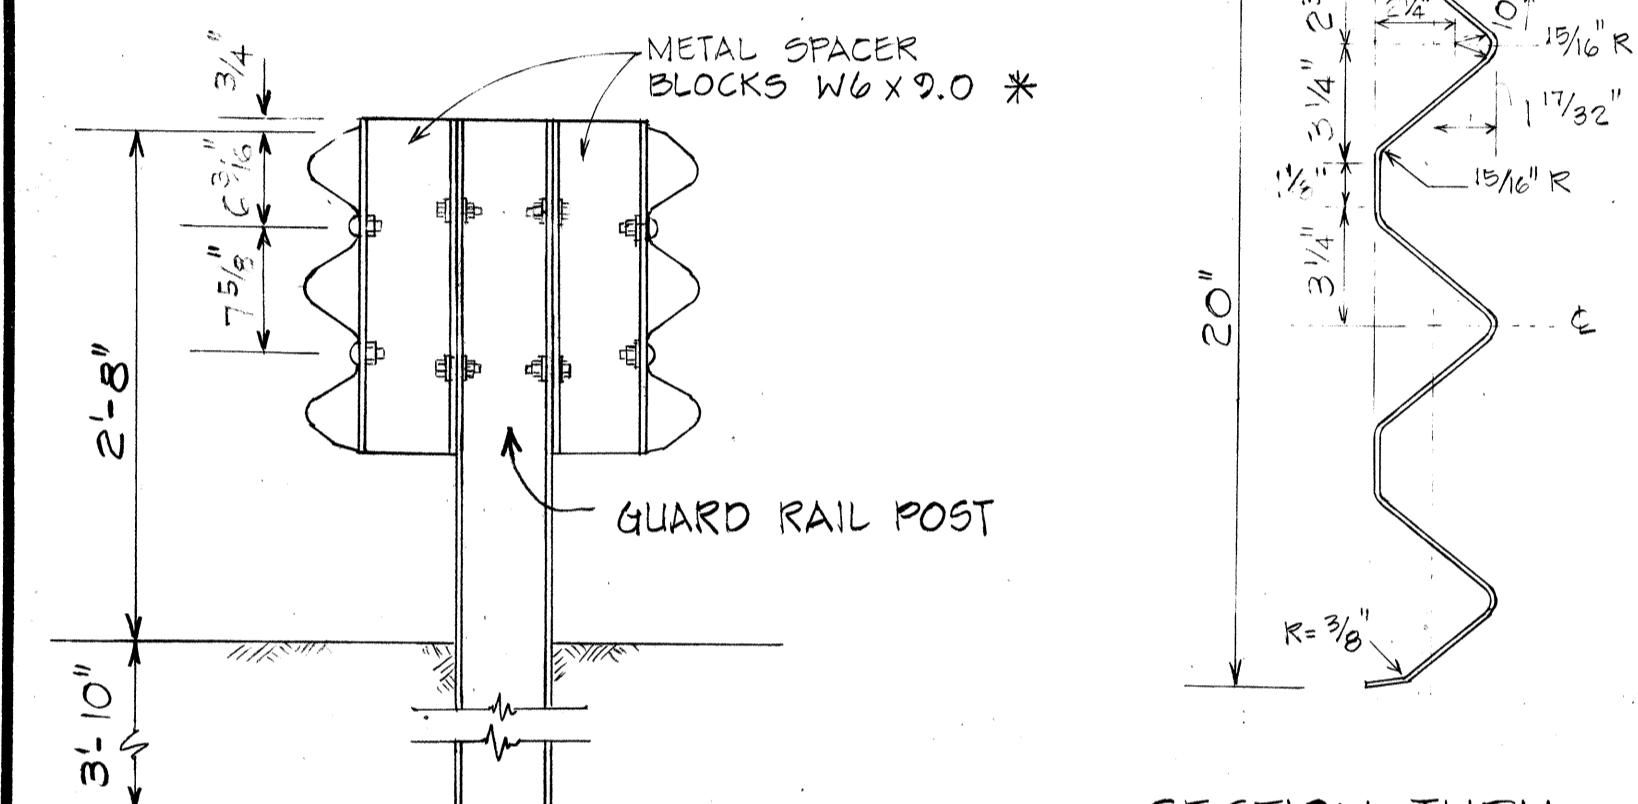


DOUBLE METAL GUARD
RAIL ON METAL POST WITH
METAL SPACER BLOCK

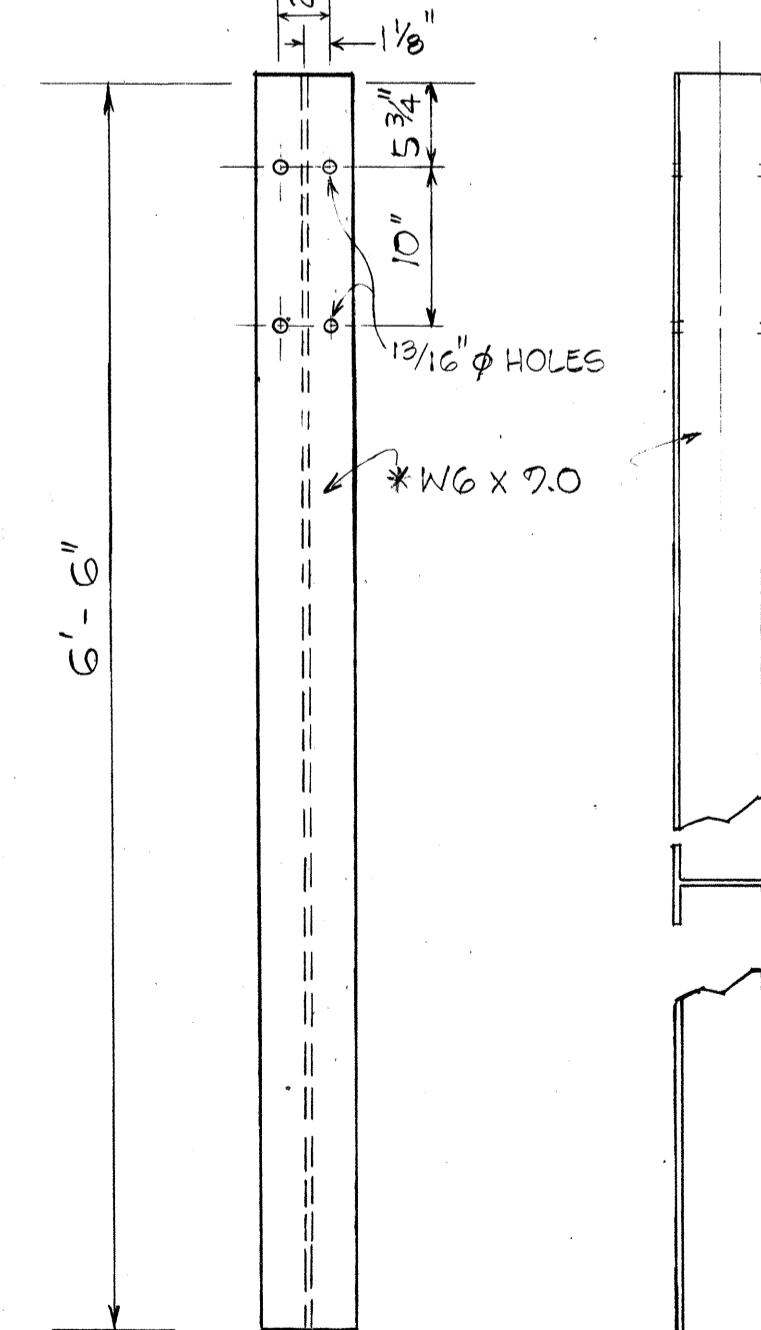

POST DETAILS


1" = 1'-0"

SECTION THRU
RAIL ELEMENT
Not to Scale

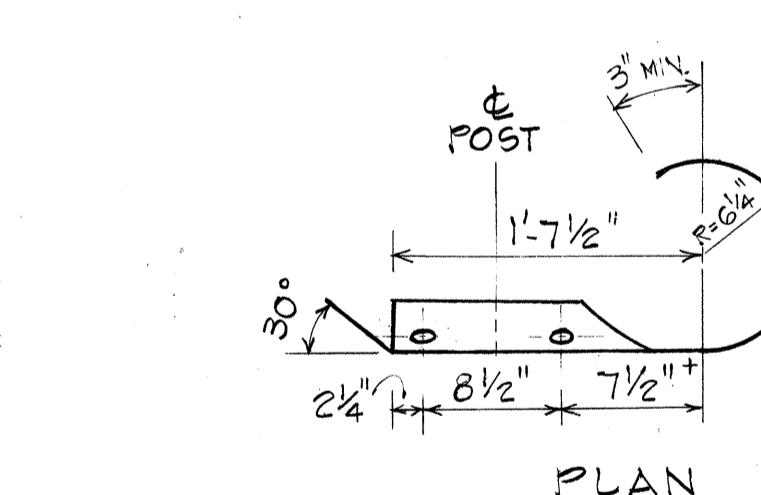


END SECTION (ROUNDED)

1" = 1'-0"

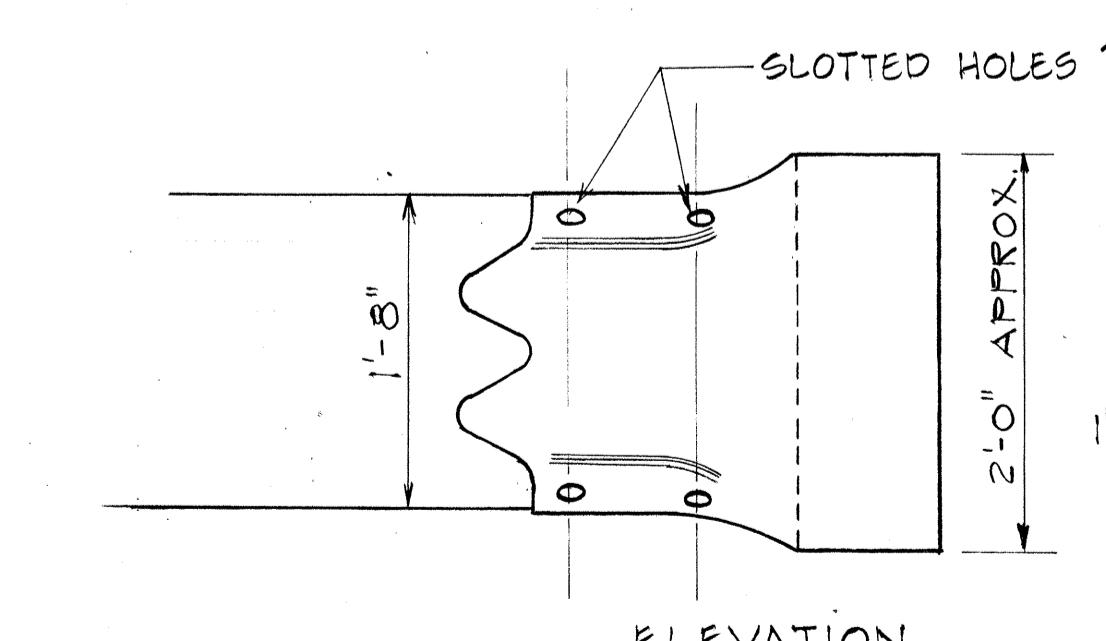

END SECTION (BUFFER)


Scale: 1" = 1'-0"

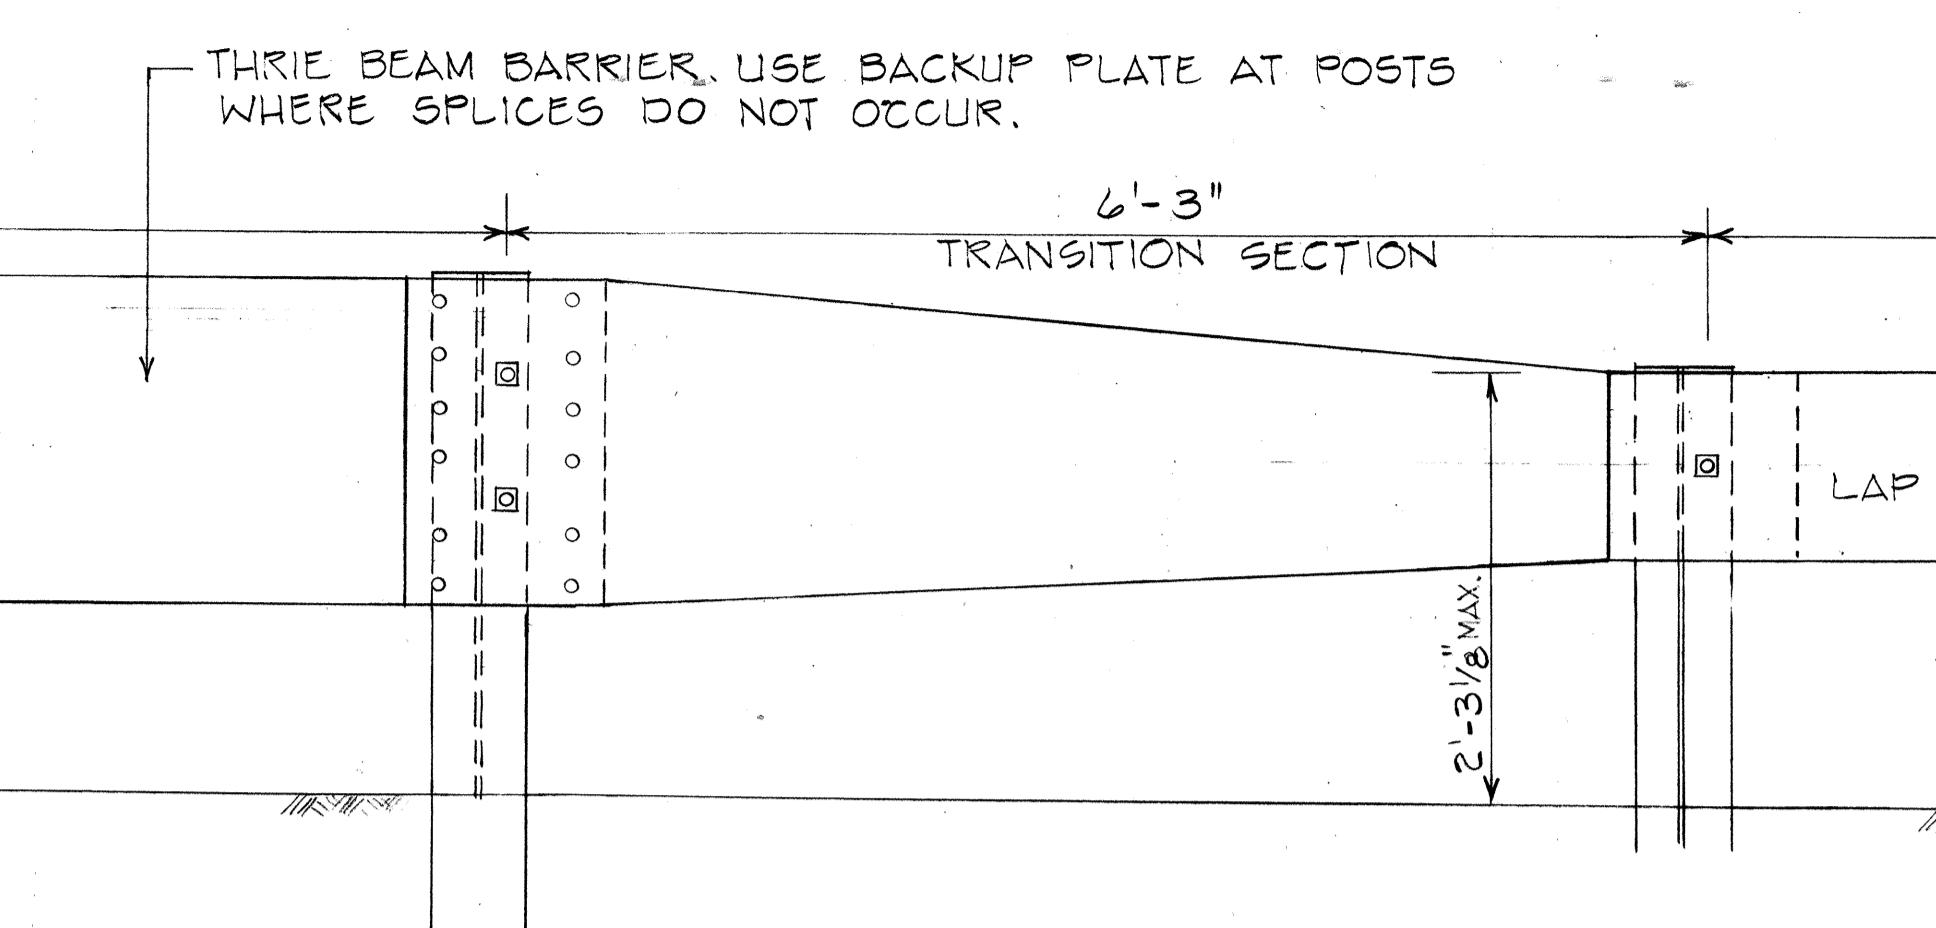

THRIE BEAM BARRIER. USE BACKUP PLATE AT POSTS
WHERE SPLICES DO NOT OCCUR.

6'-3"


TRANSITION SECTION

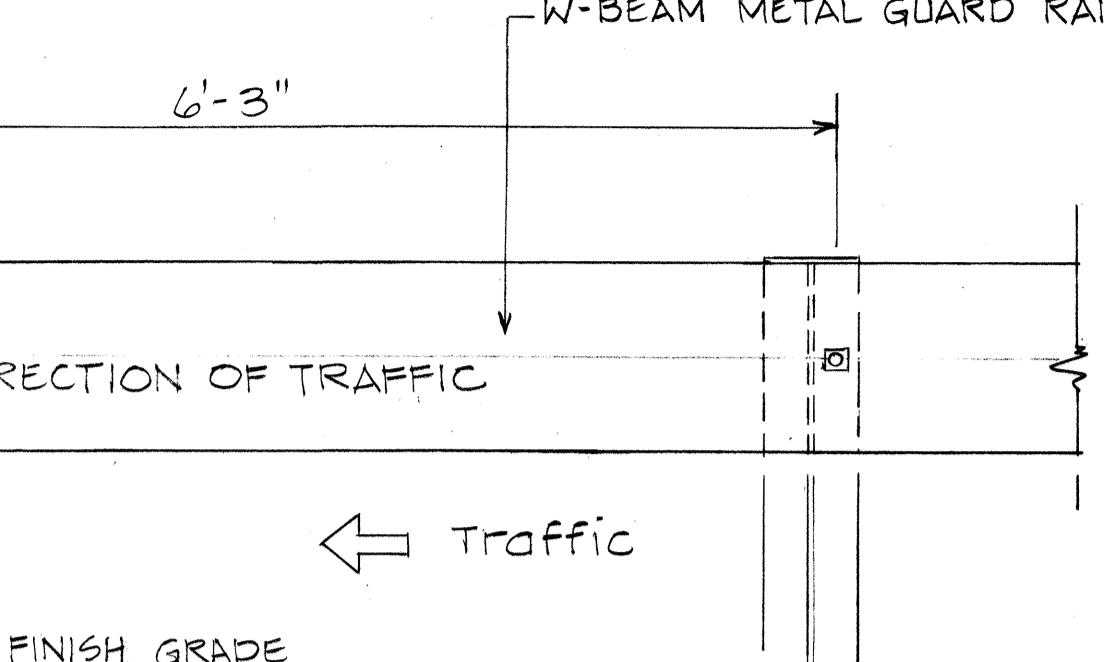

LAP IN DIRECTION OF TRAFFIC


TRAFFIC

FINISH GRADE

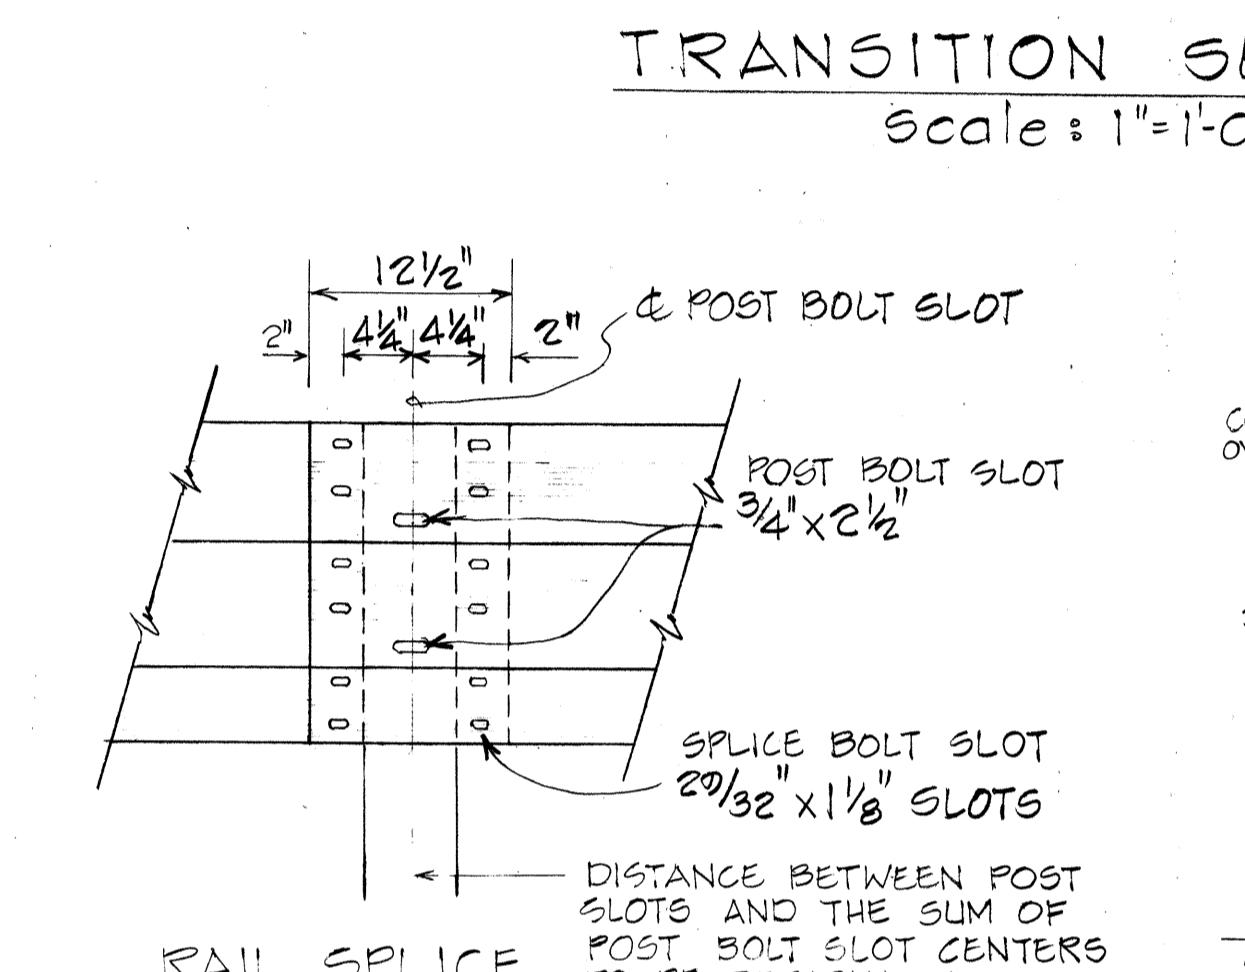

RAIL SPLICE
1" = 1'-0"

DISTANCE BETWEEN POST SLOTS AND THE SUM OF POST BOLT SLOT CENTERS TO BE DESIGNATED.

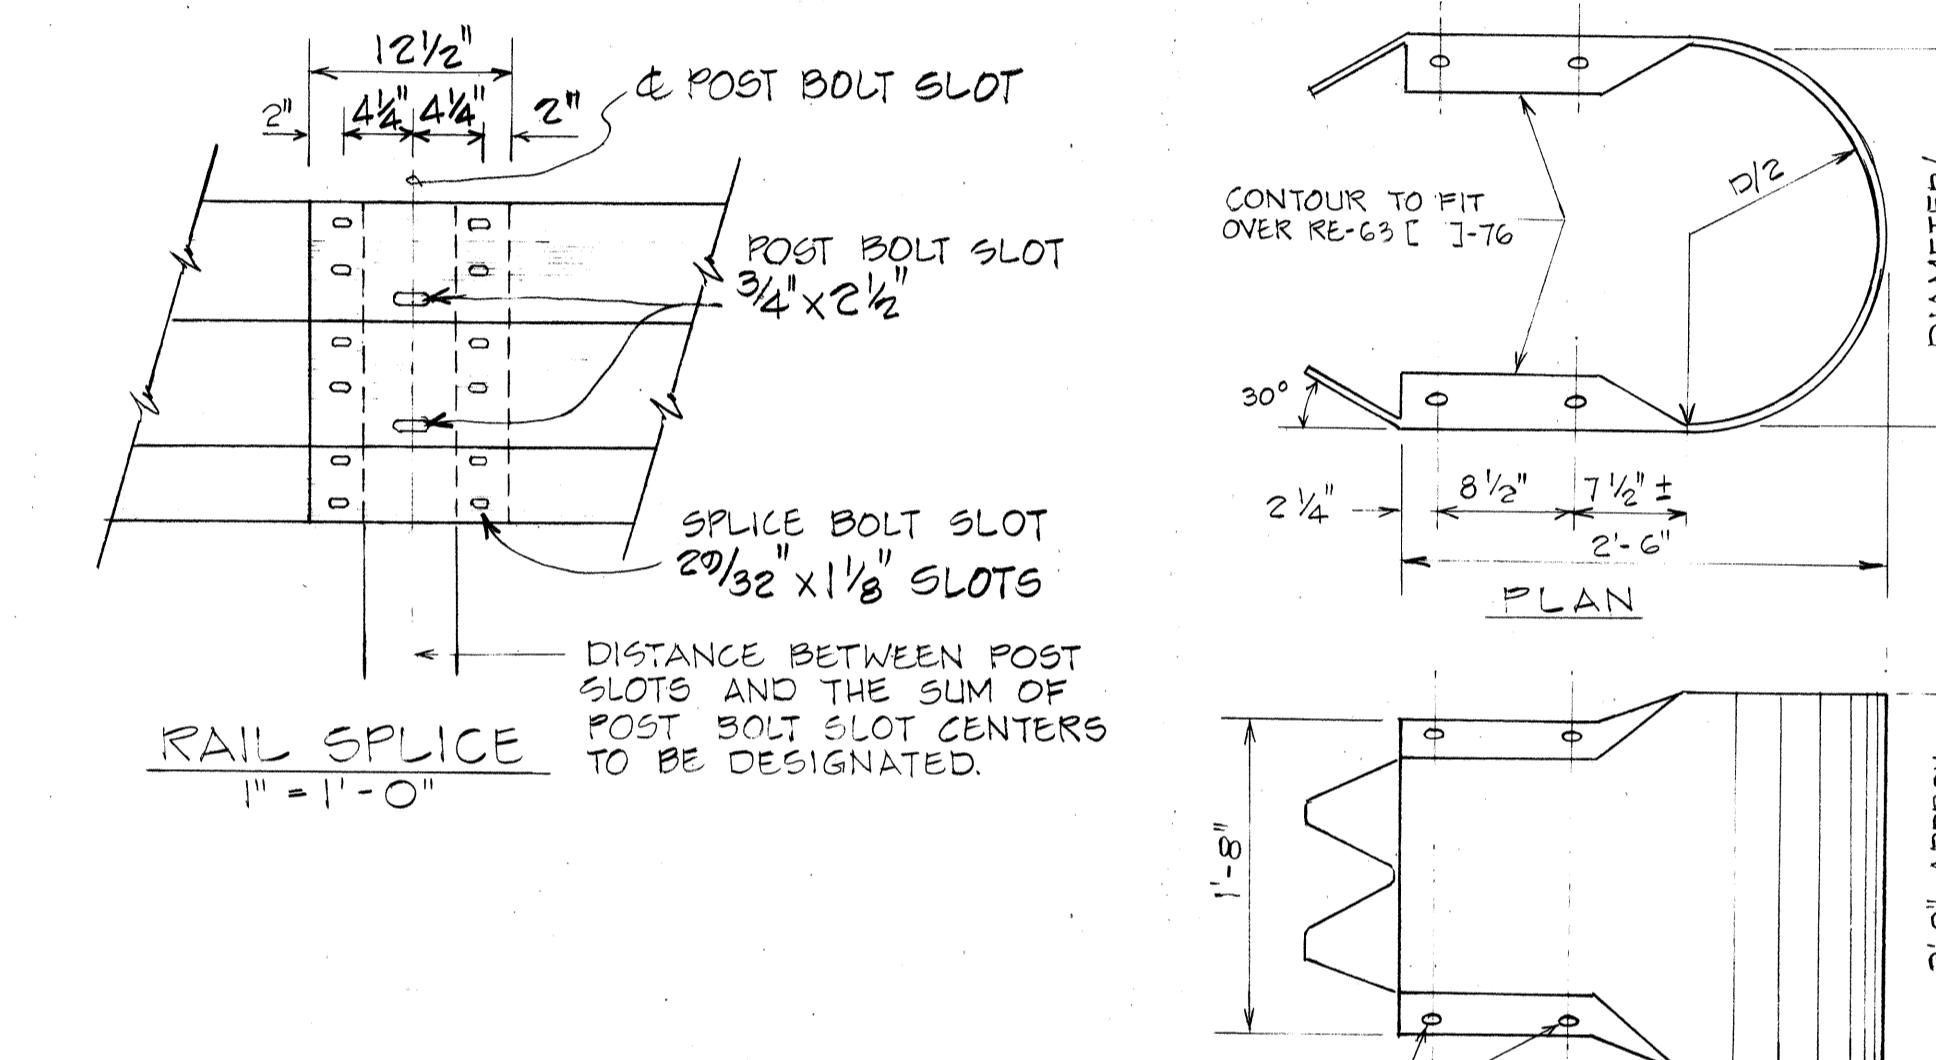

POST BOLT SLOT
3/4" x 2 1/2"

SPLICE BOLT SLOT
2 1/32" x 1 1/8" SLOTS

POST BOLT SLOT
3/4" x 2 1/2"

PLAN

CONTOUR TO FIT OVER RE-63 C I-TG


DIA. 1/2" AND 3/4" ARE TYPICAL

2 1/4" 8 1/2" 7 1/2" ± 2' - 6"

2 1/4" APPROX

2' - 0" APPROX

FED. ROAD DIST. NO.	STATE	FED. AID PROJ. NO.	FISCAL YEAR	HEET NO.	TOTAL SHEETS
HAWAII	HAW.	I-HI-(187)	1984	46	197

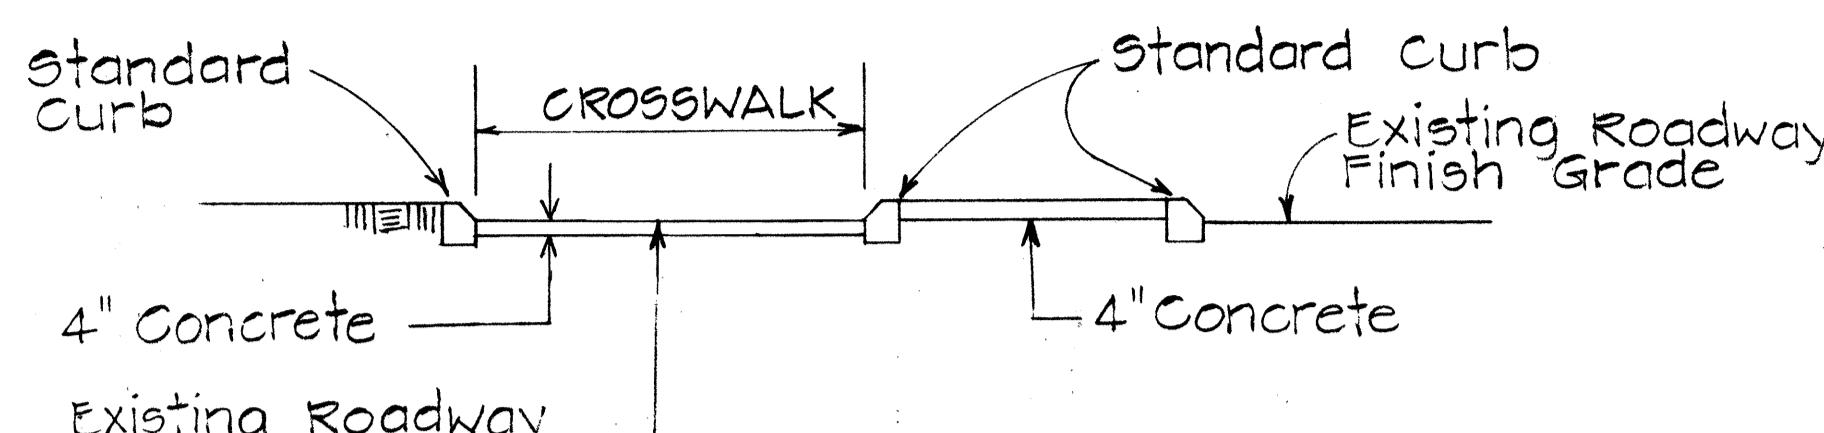


SECTION "A-A"

Use at Median Nose Crossings


Scale: 1" = 5'

For Additional Details, See Type C Wheel Chair Ramp

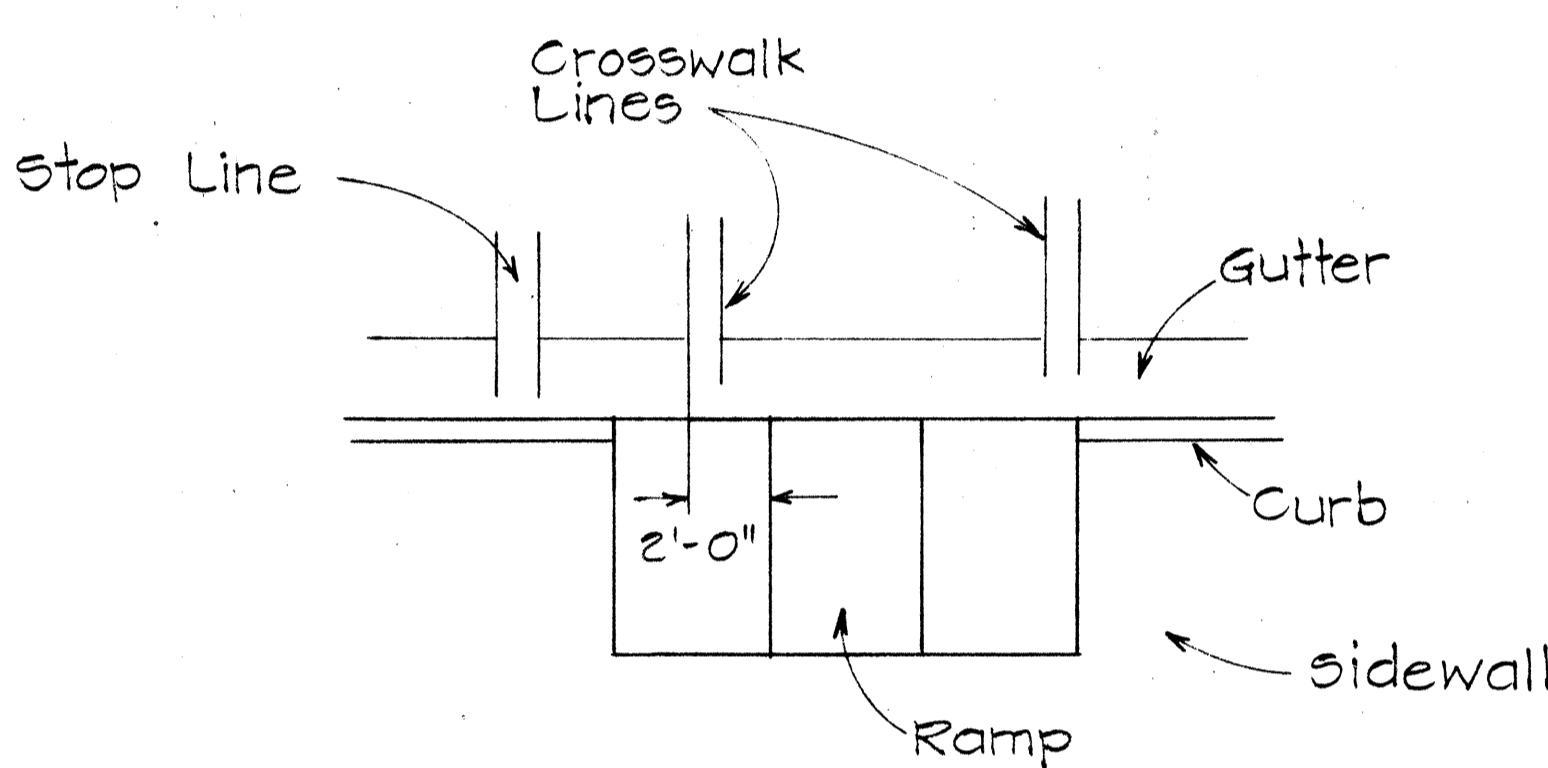

TYPICAL INSTALLATION AT CROSSWALKS

Scale: 1" = 5'

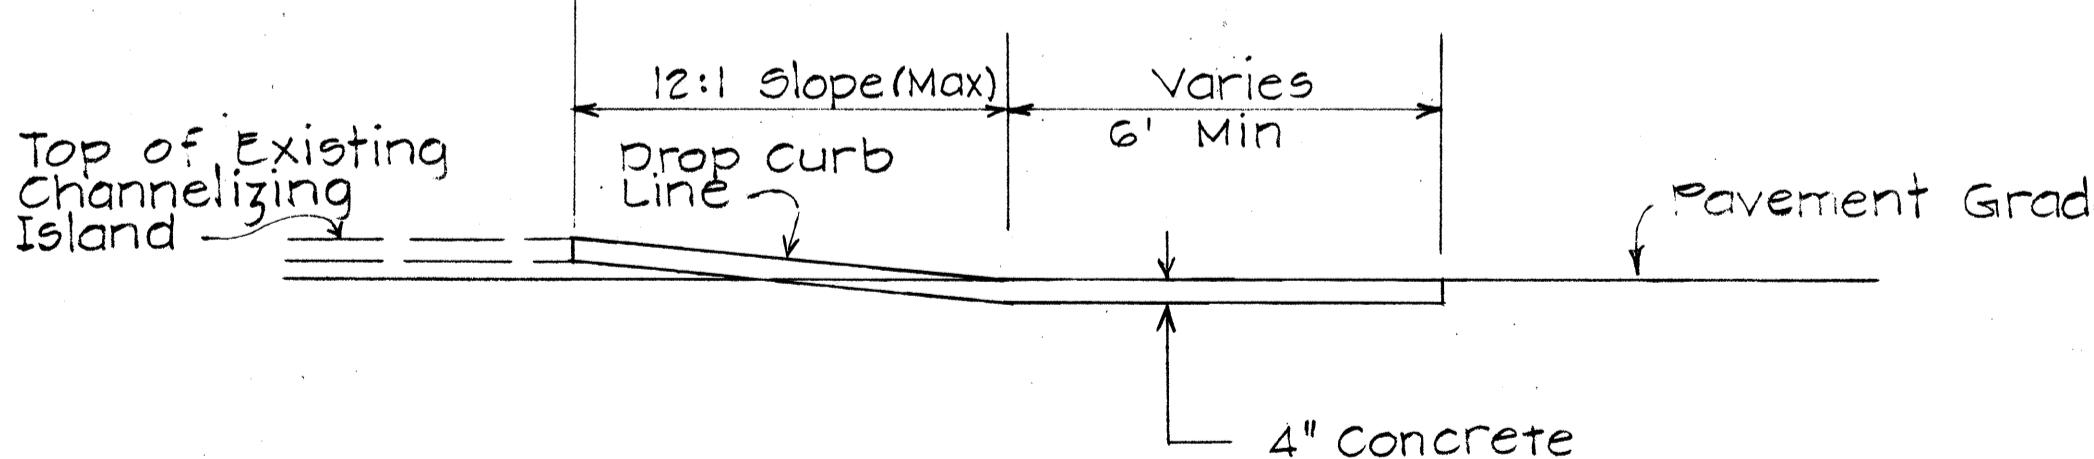

SECTION "B-B"

TYPE "B" MODIFIED WHEEL CHAIR RAMP


Use at Intersection of 2 Crosswalks on Channelizing Island

Scale: 3/8" = 1'

For Additional Details See Type "B" Wheelchair Ramp

NOTES

- When necessary by existing physical conditions, alternate Wheel Chair Ramps may be used subject to Engineer's approval.
- Subject to field conditions, the Engineer shall determine final location of Wheel chair Ramp.
- Where necessary pullboxes, handholes manholes etc. shall be adjusted to match Wheel Chair Ramp grade. Adjustments shall be considered incidental to Wheel Chair Ramp construction, unless otherwise noted.

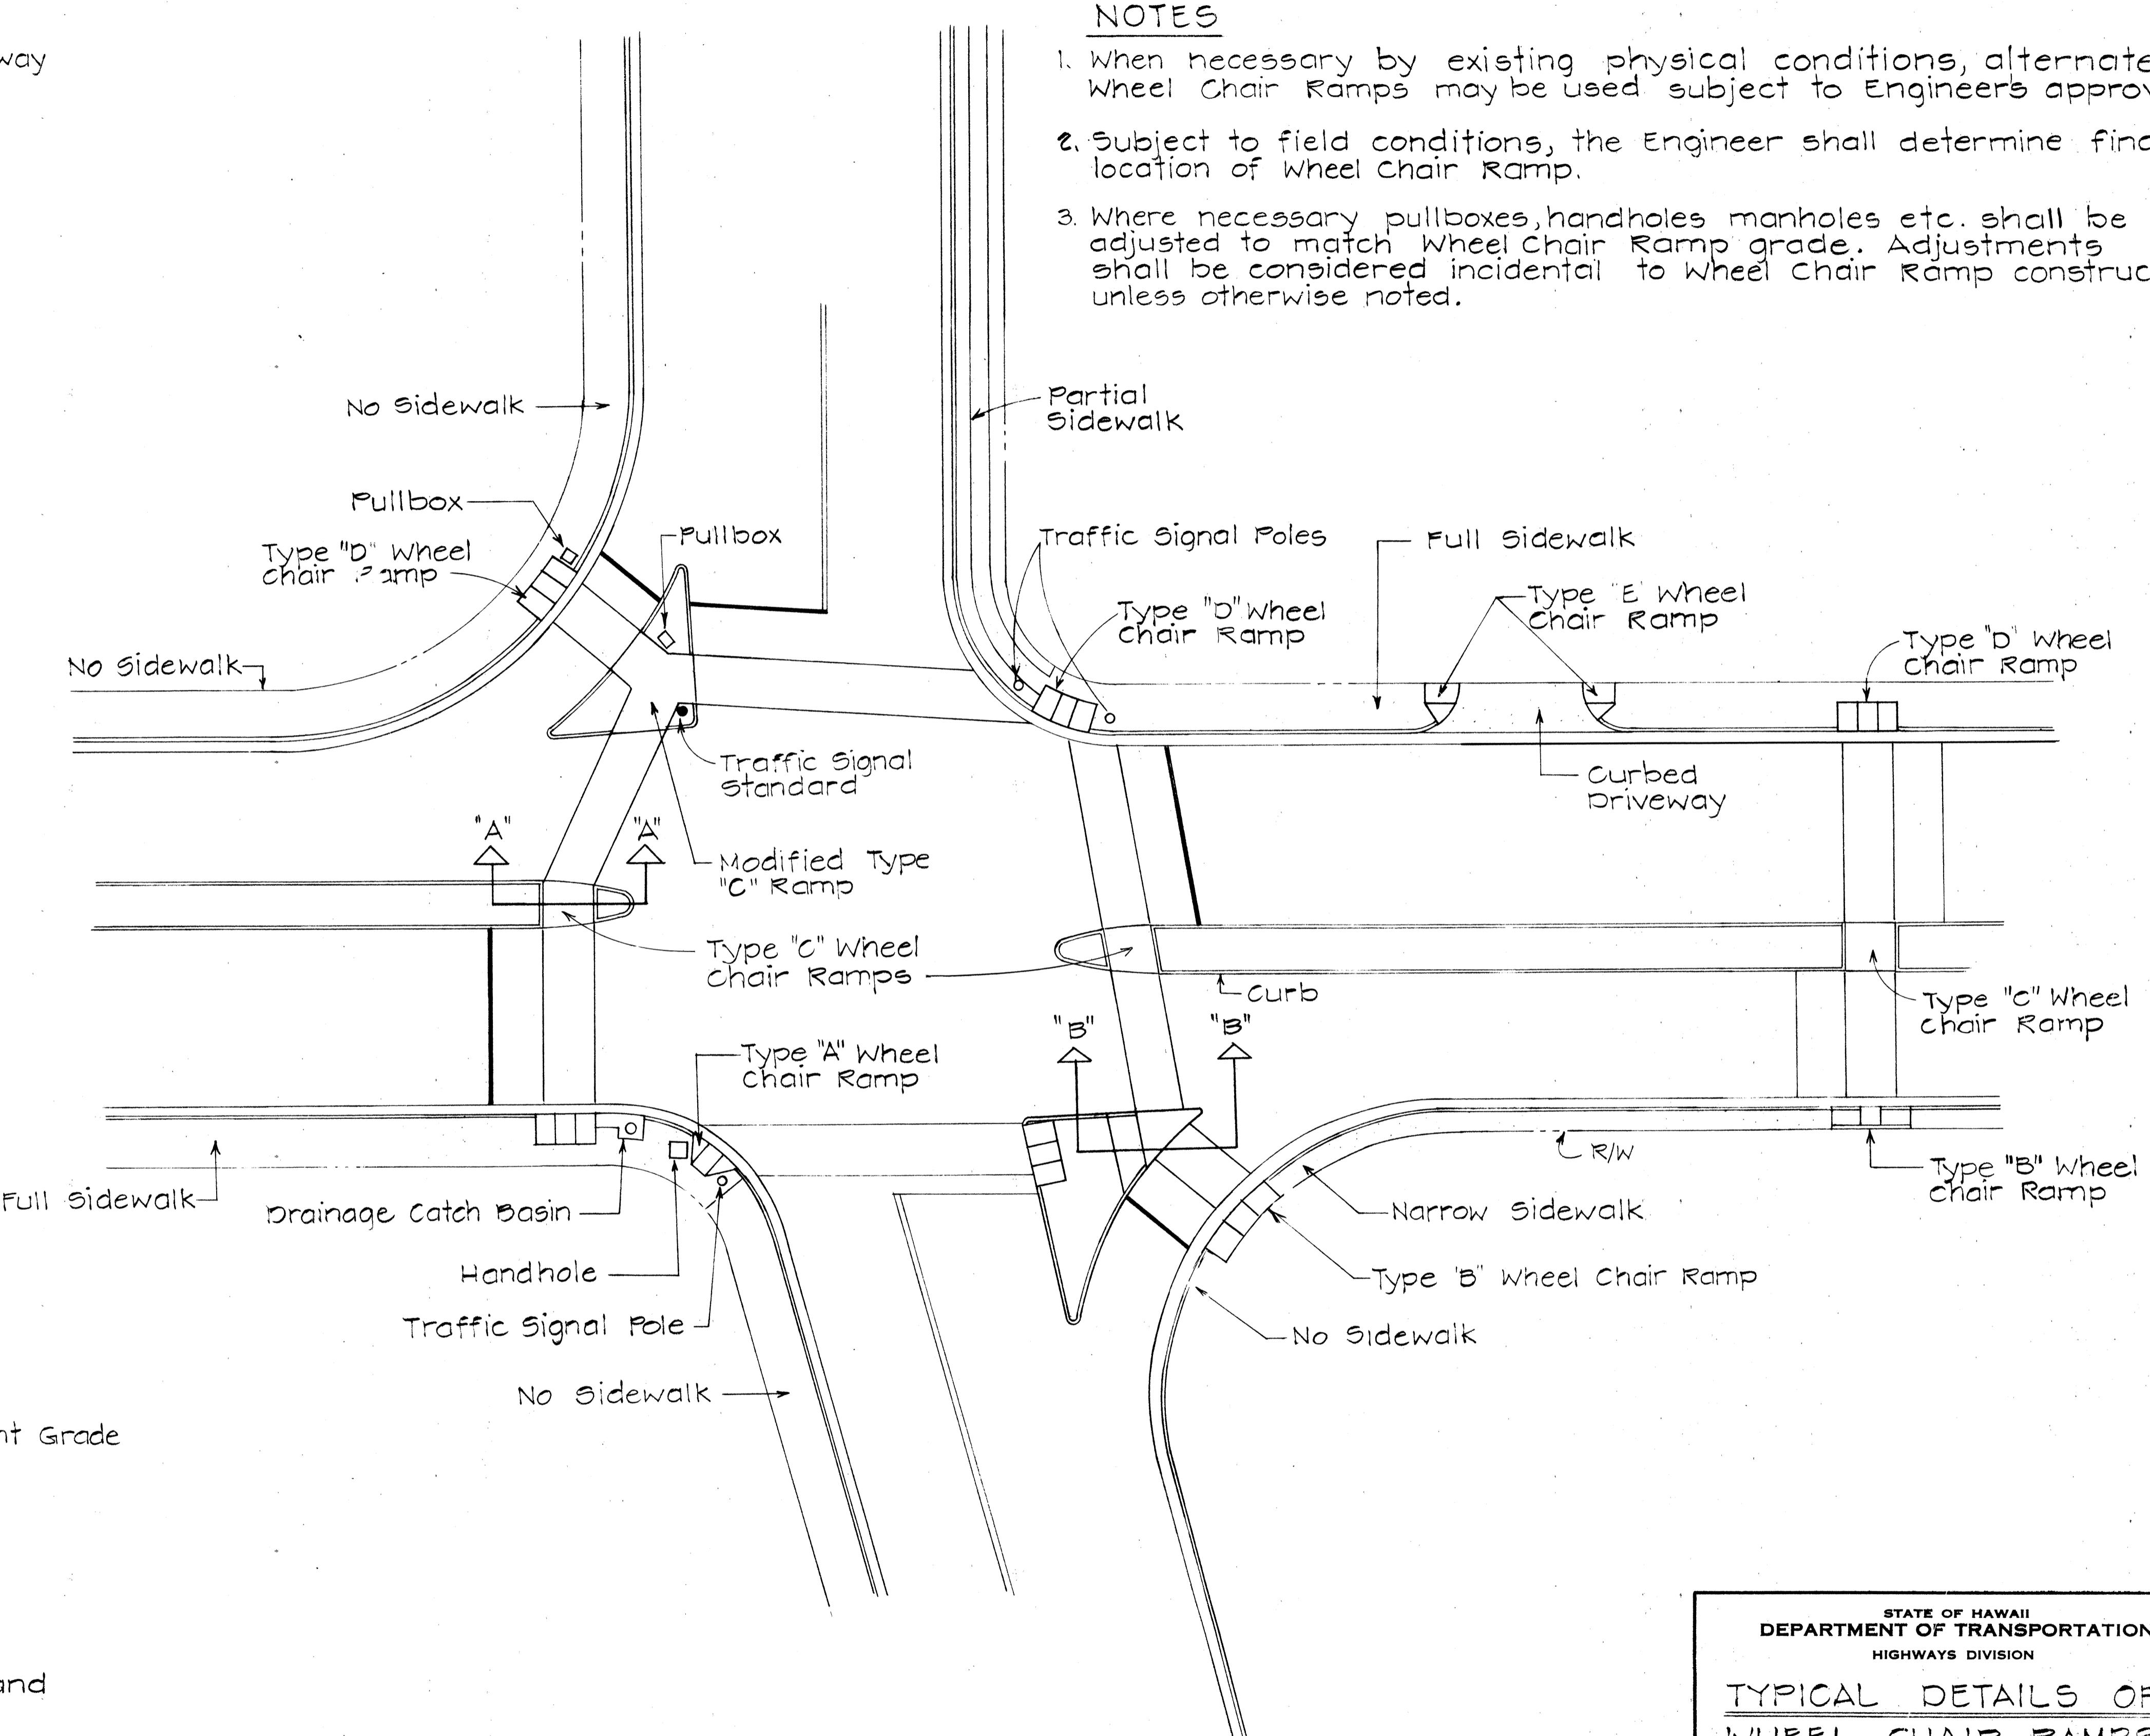







TYPICAL WHEEL CHAIR RAMPS
scale: 1" = 20'

STATE OF HAWAII
DEPARTMENT OF TRANSPORTATION
HIGHWAYS DIVISION

TYPICAL DETAILS OF WHEEL CHAIR RAMPS

Scale: As Shown
May, 1978
SHEET NO. 1 OF 2 SHEETS





FED. ROAD DIST. NO.	STATE	FED. AID PROJ. NO.	FISCAL YEAR	SHEET NO.	TOTAL SHEETS
HAWAII	HAW.	I-HI-1(187)	1984	47	197

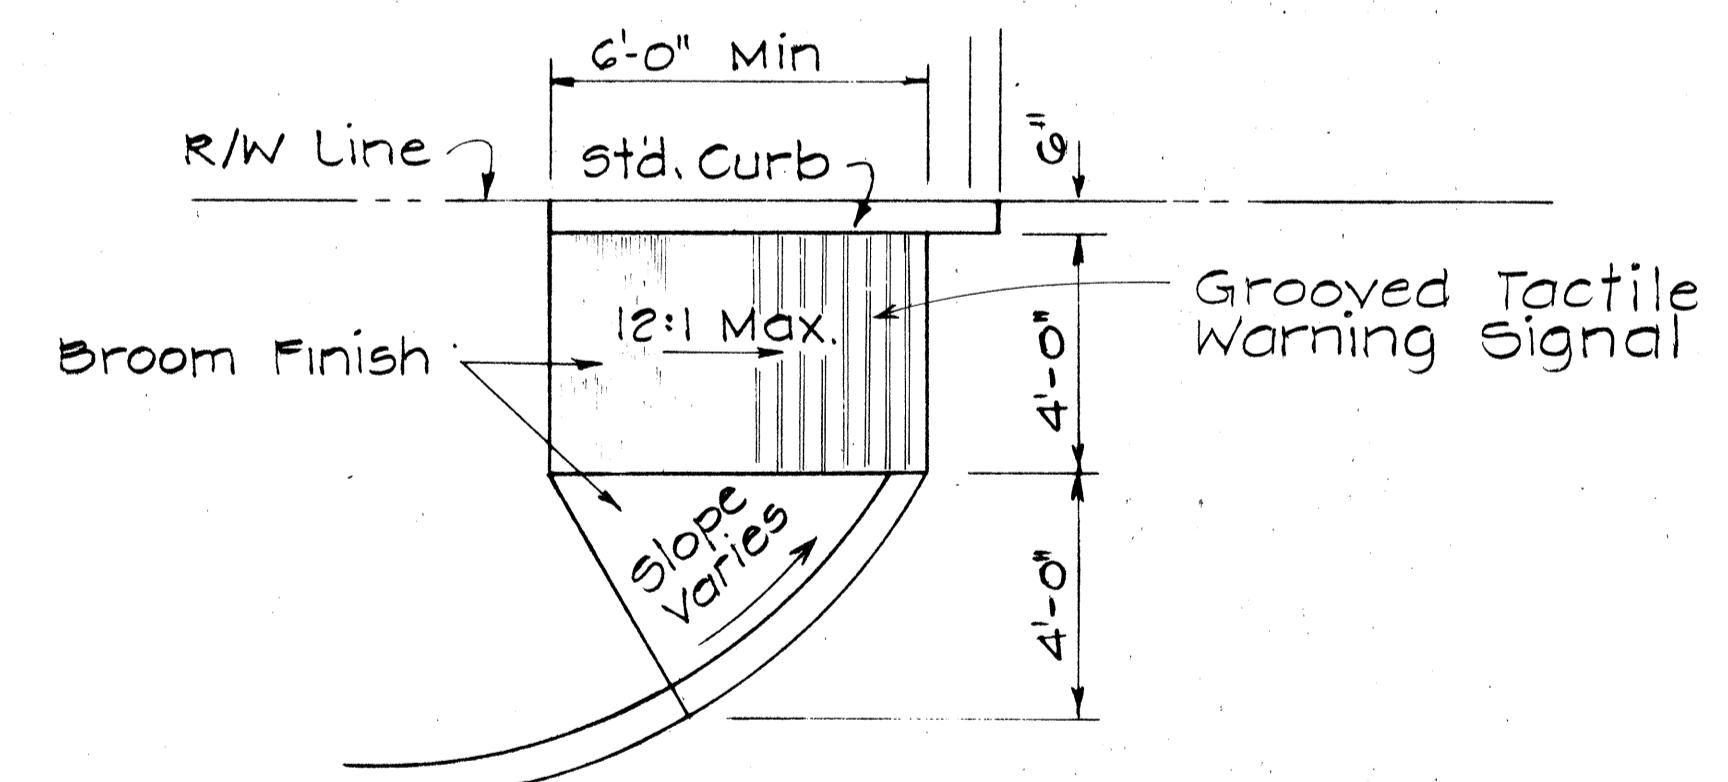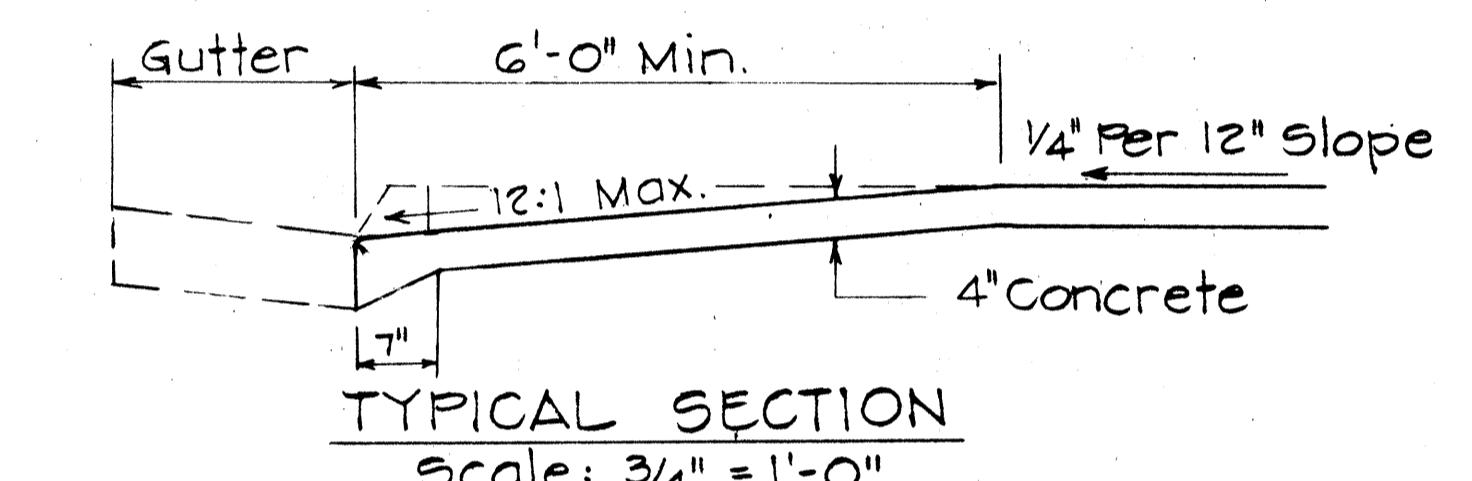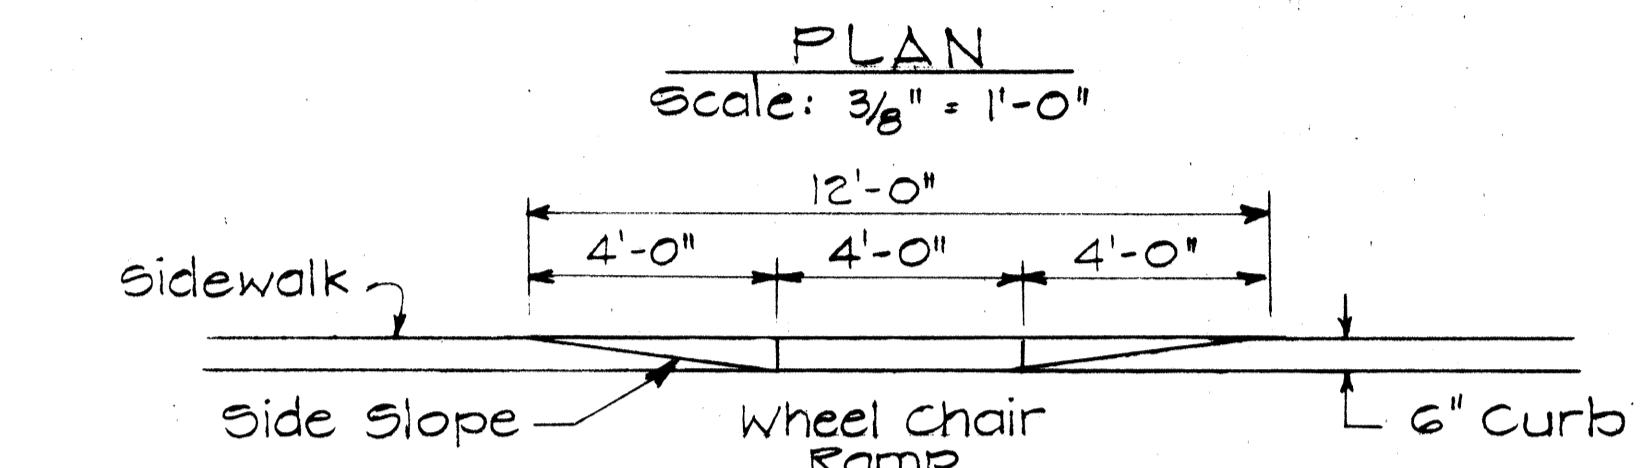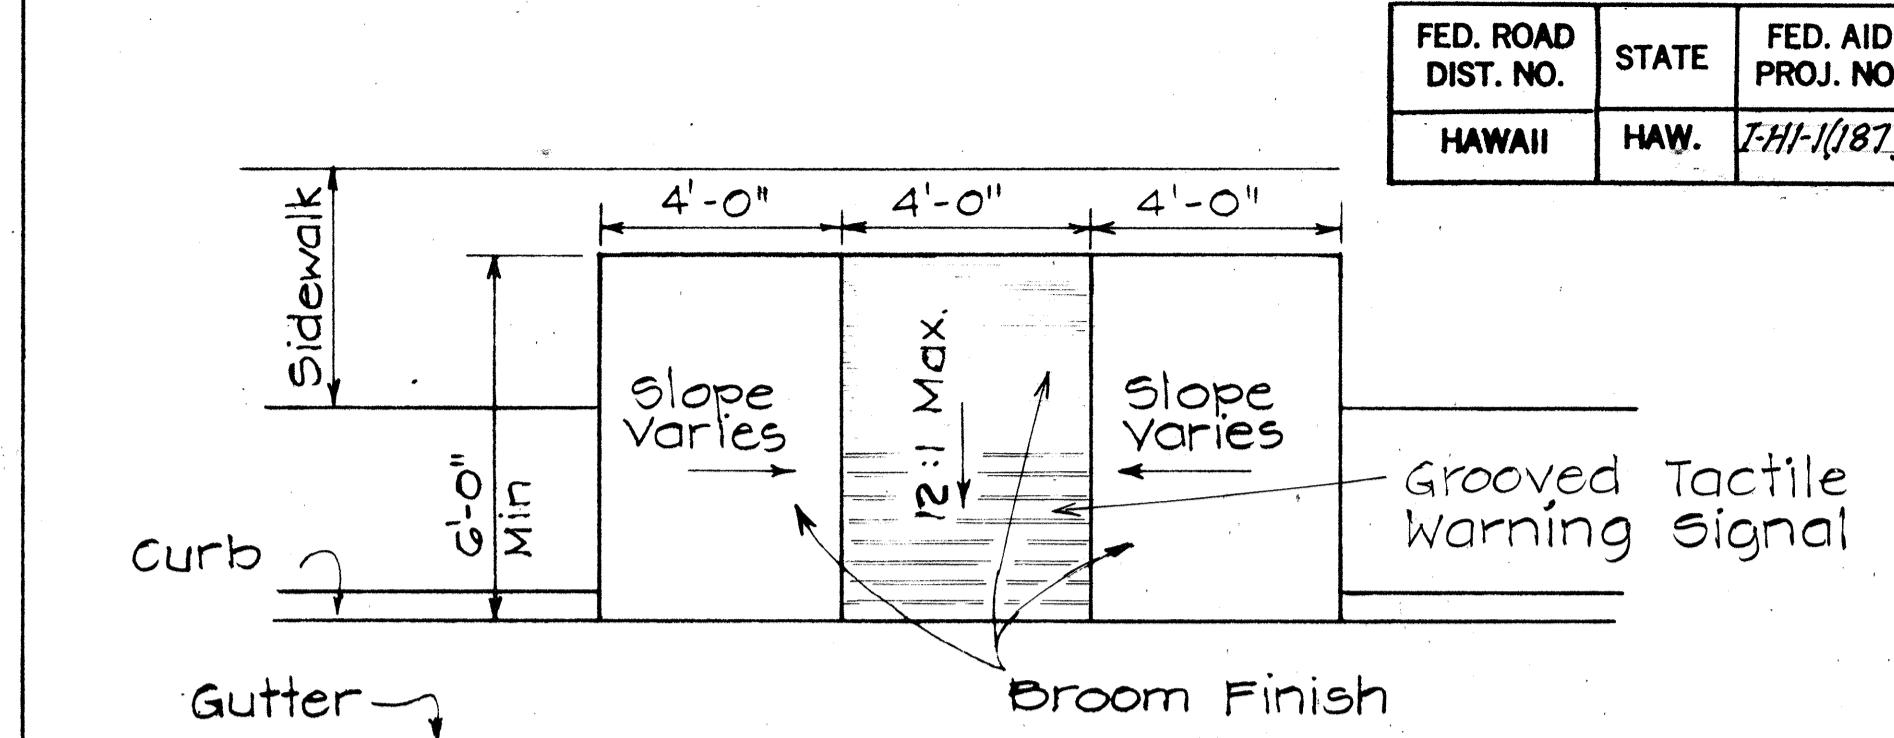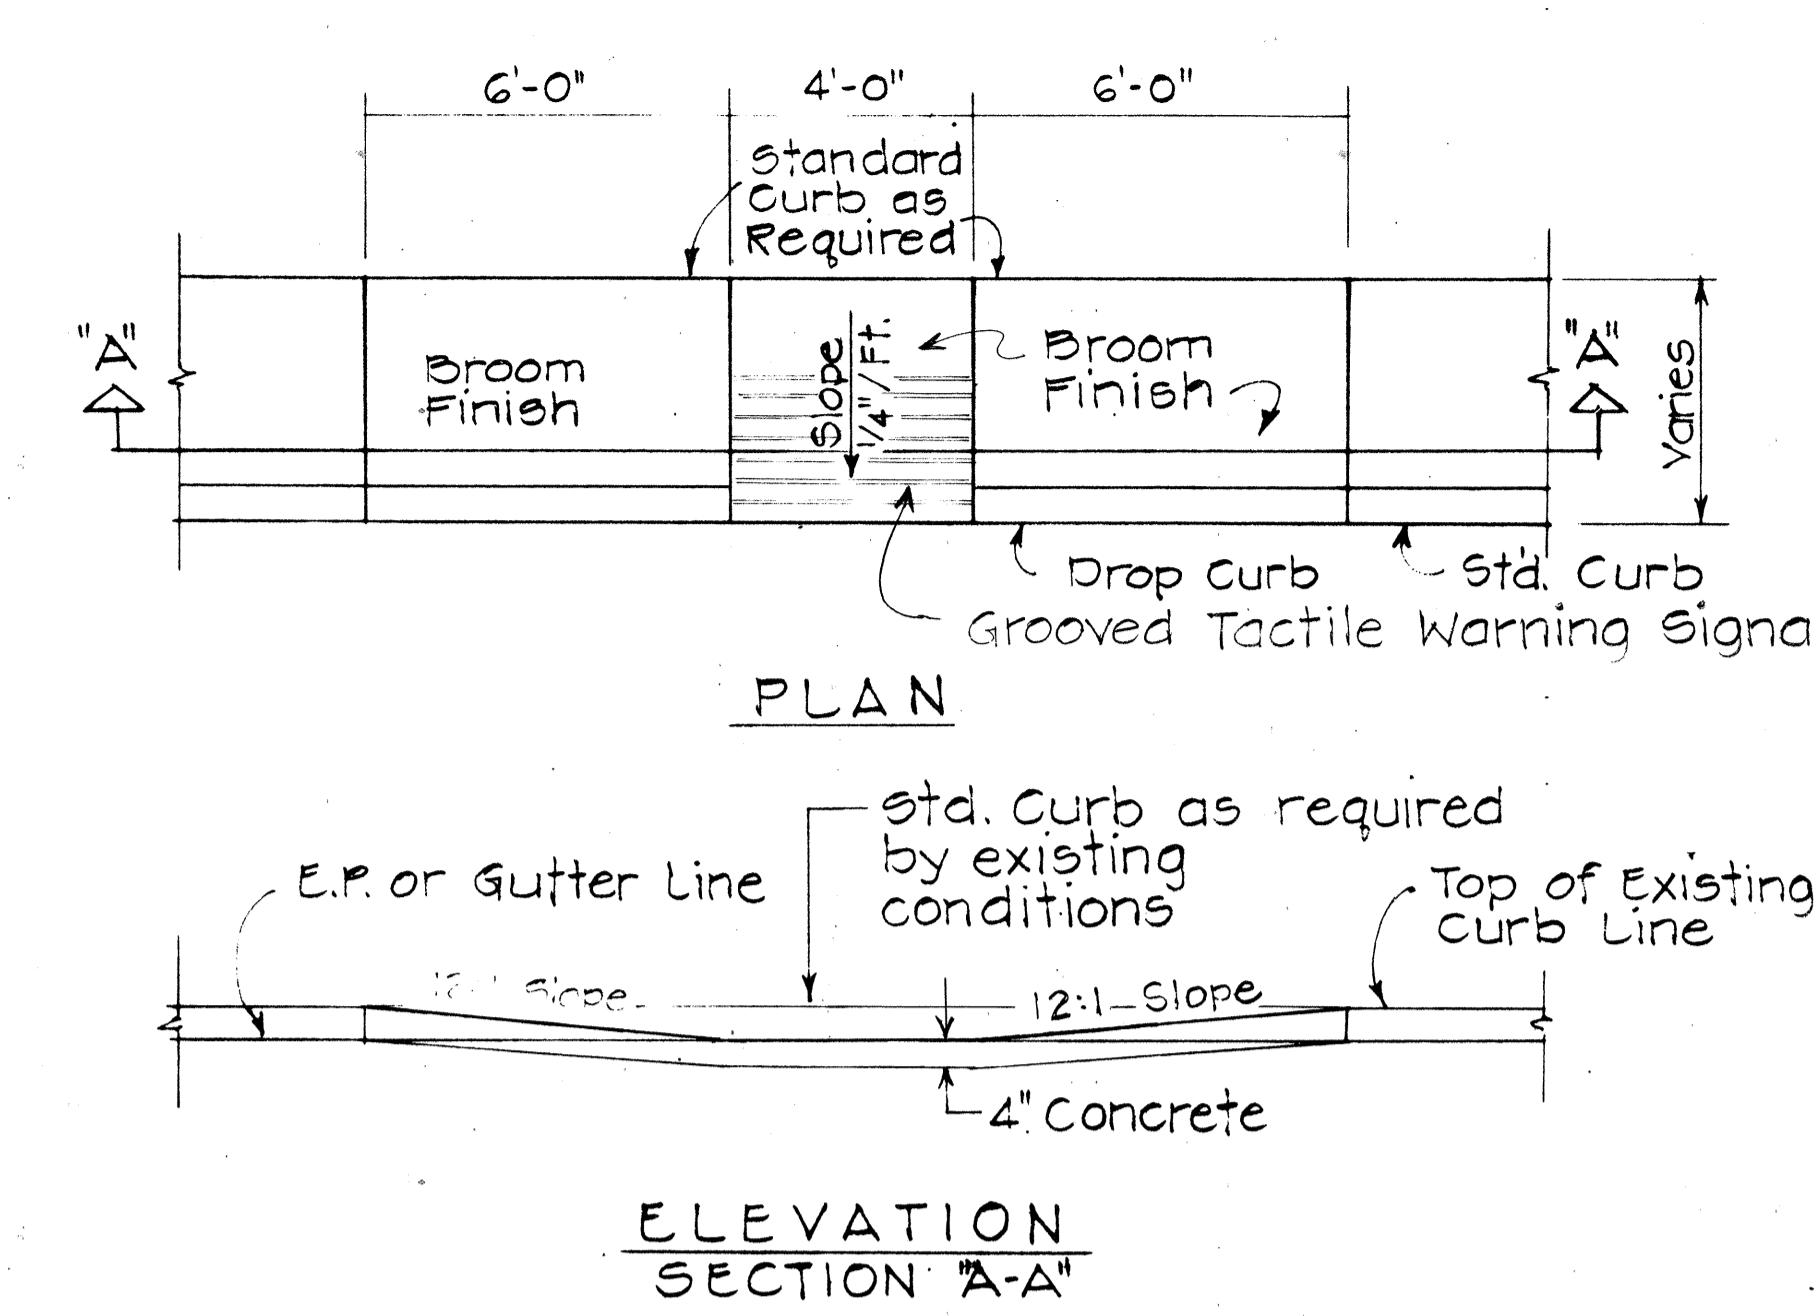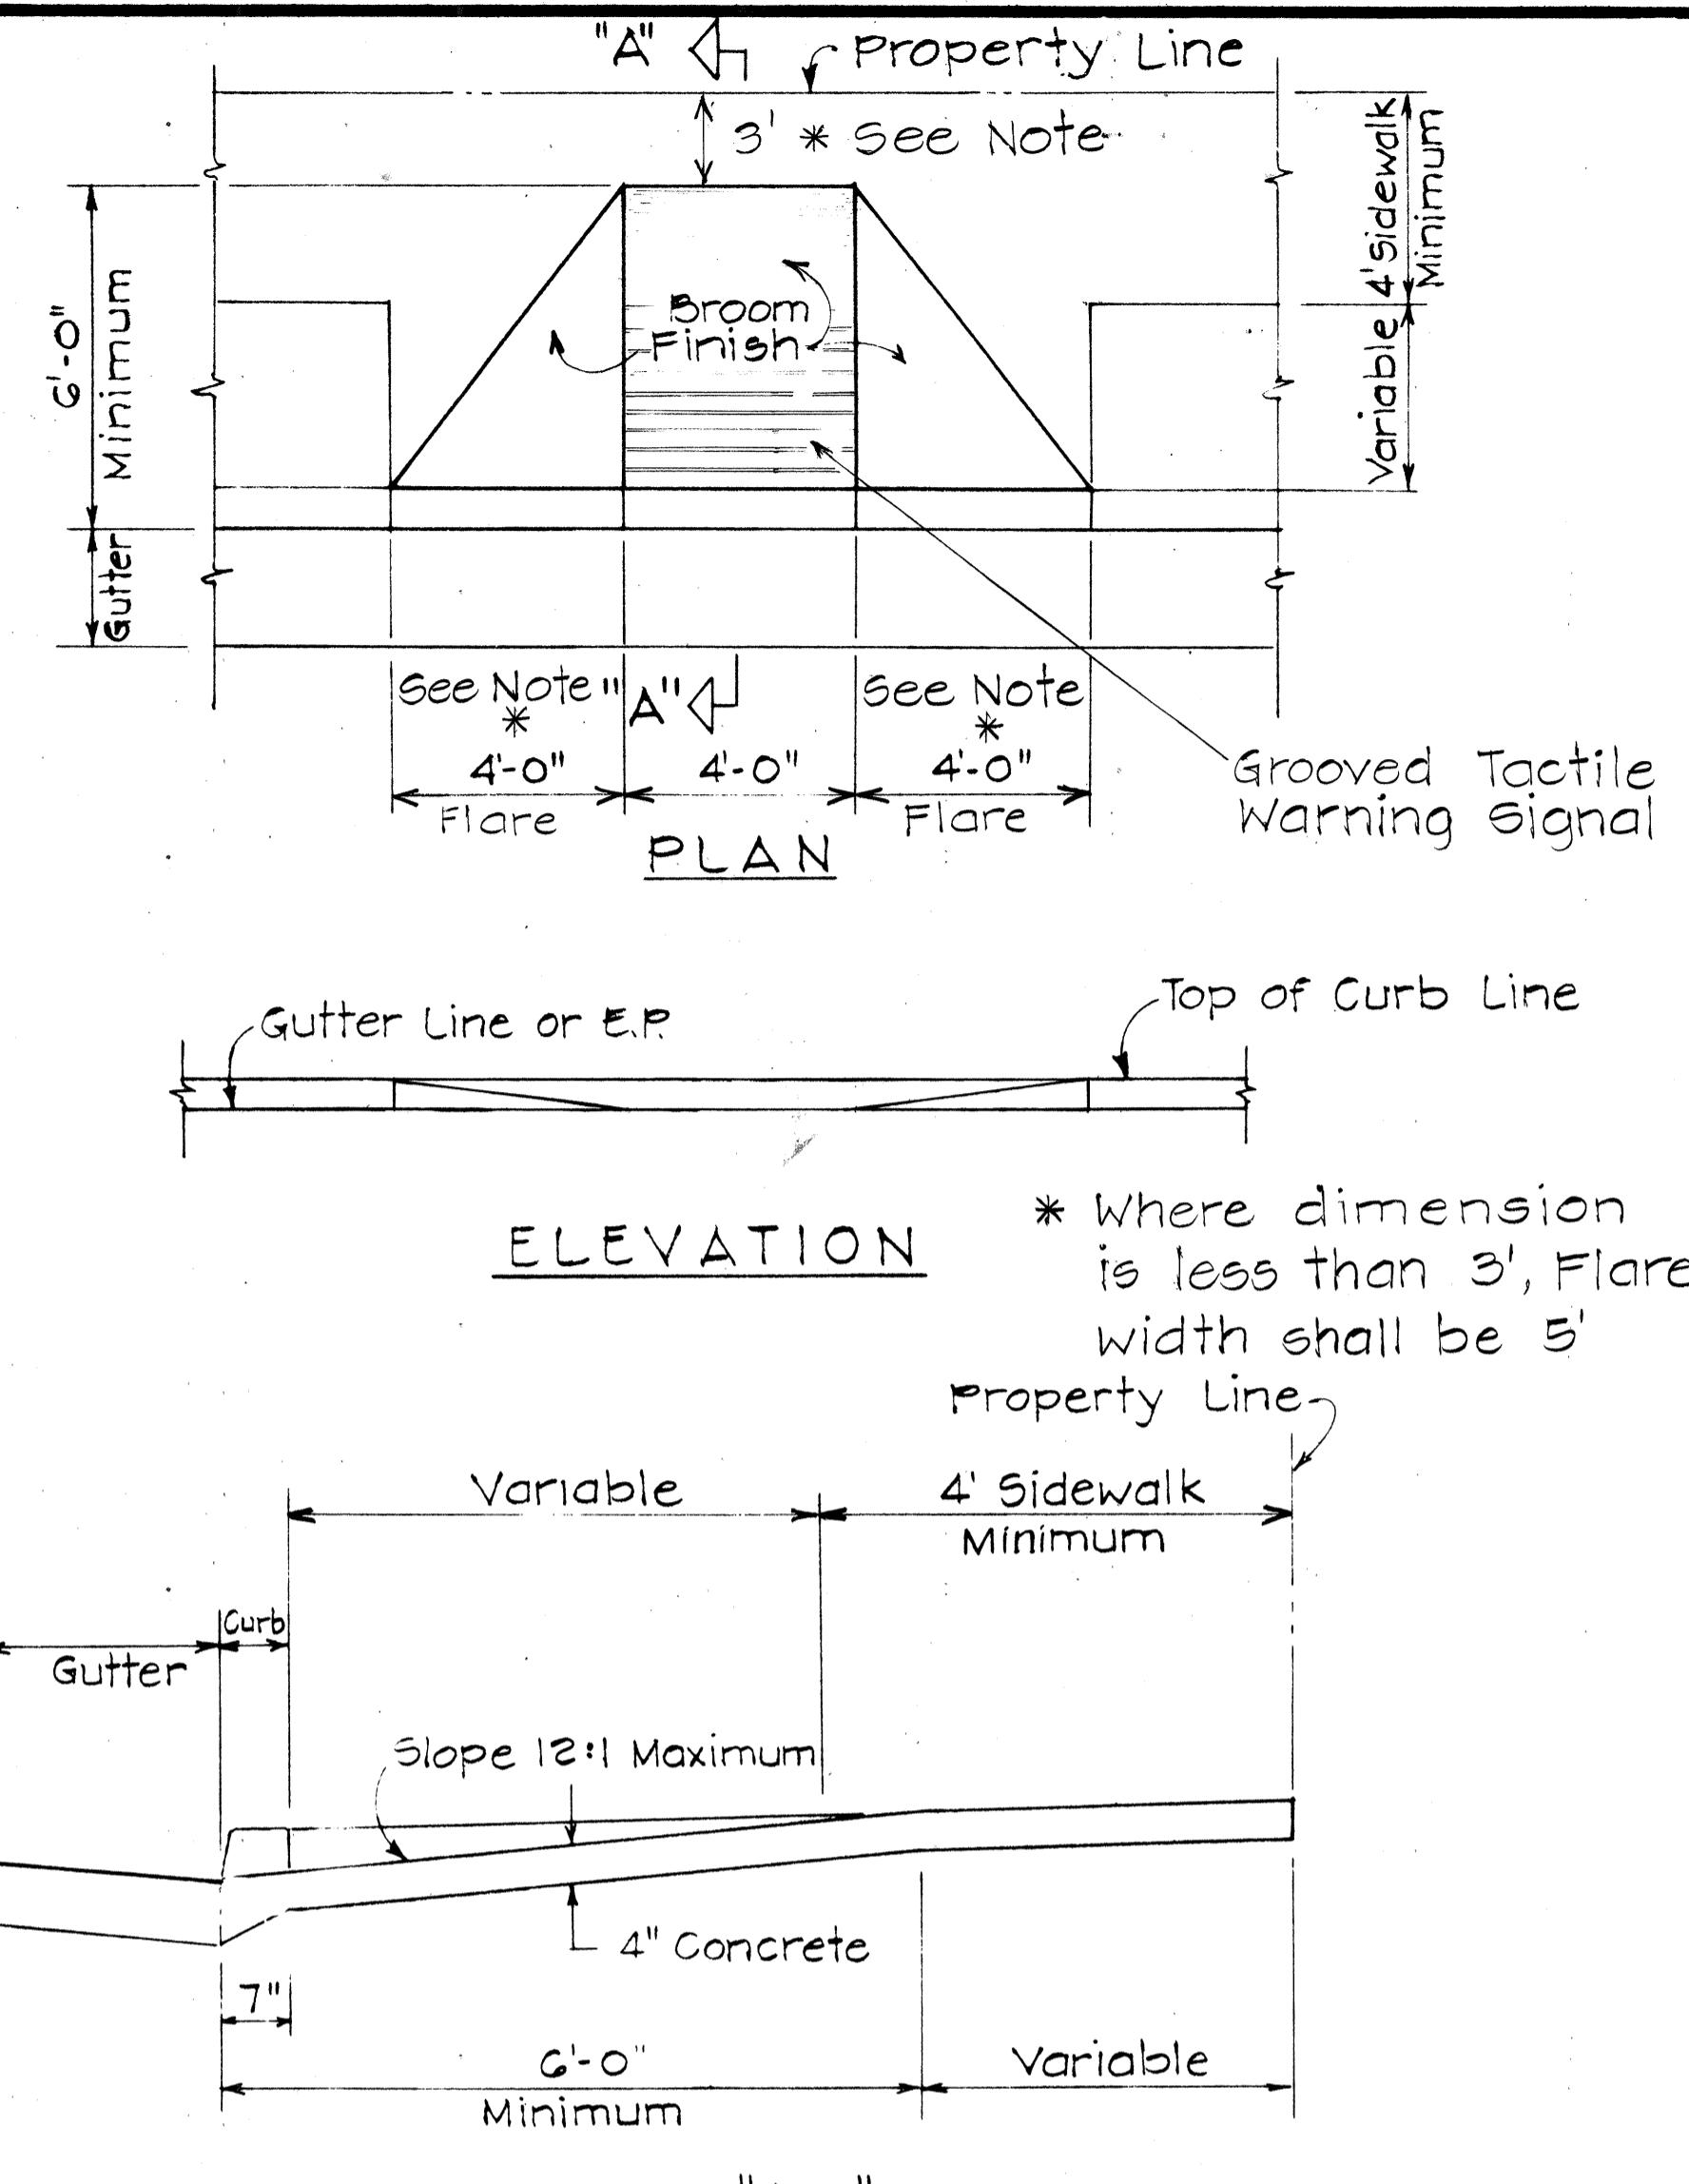


USE AT CURBED DRIVEWAYS
Scale: $3/8"$ = $1'-0"$

STATE OF HAWAII
DEPARTMENT OF TRANSPORTATION
HIGHWAYS DIVISION

GROOVED TACTILE WARNING SIGNAL

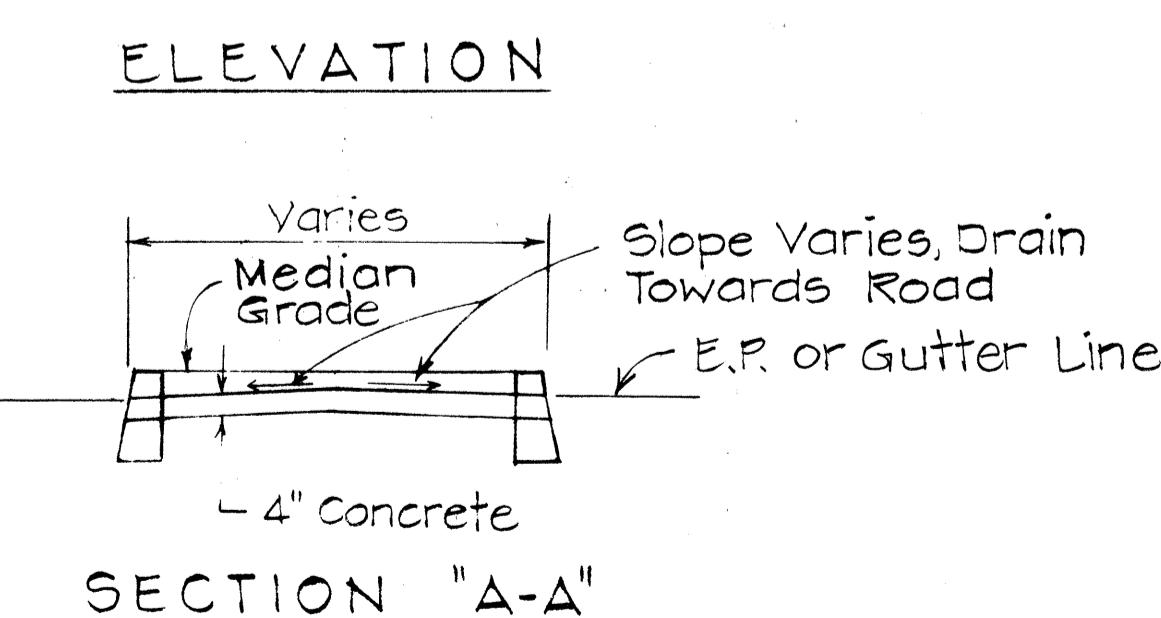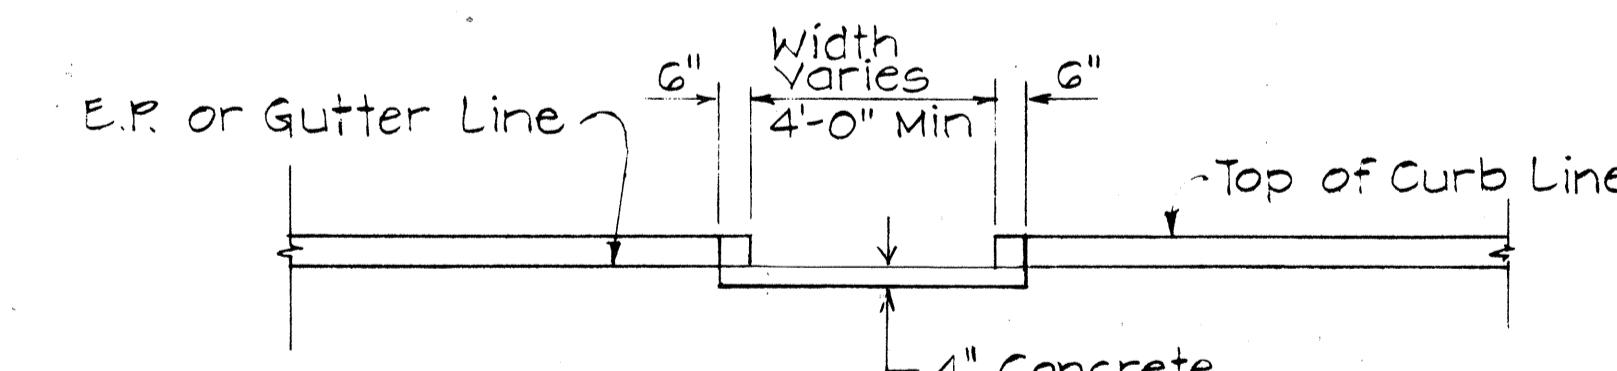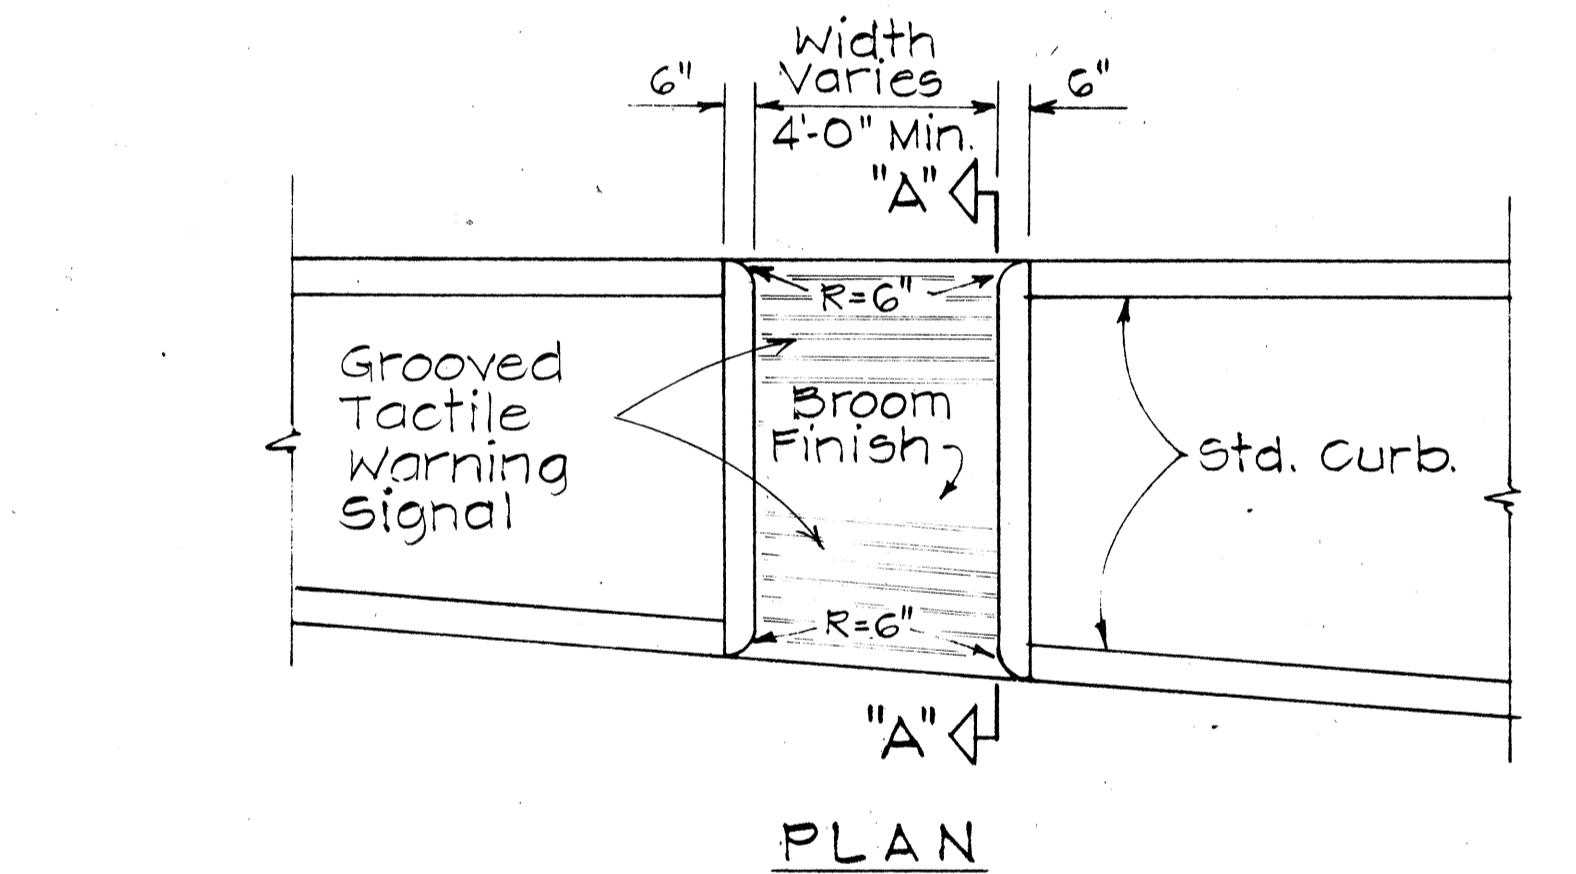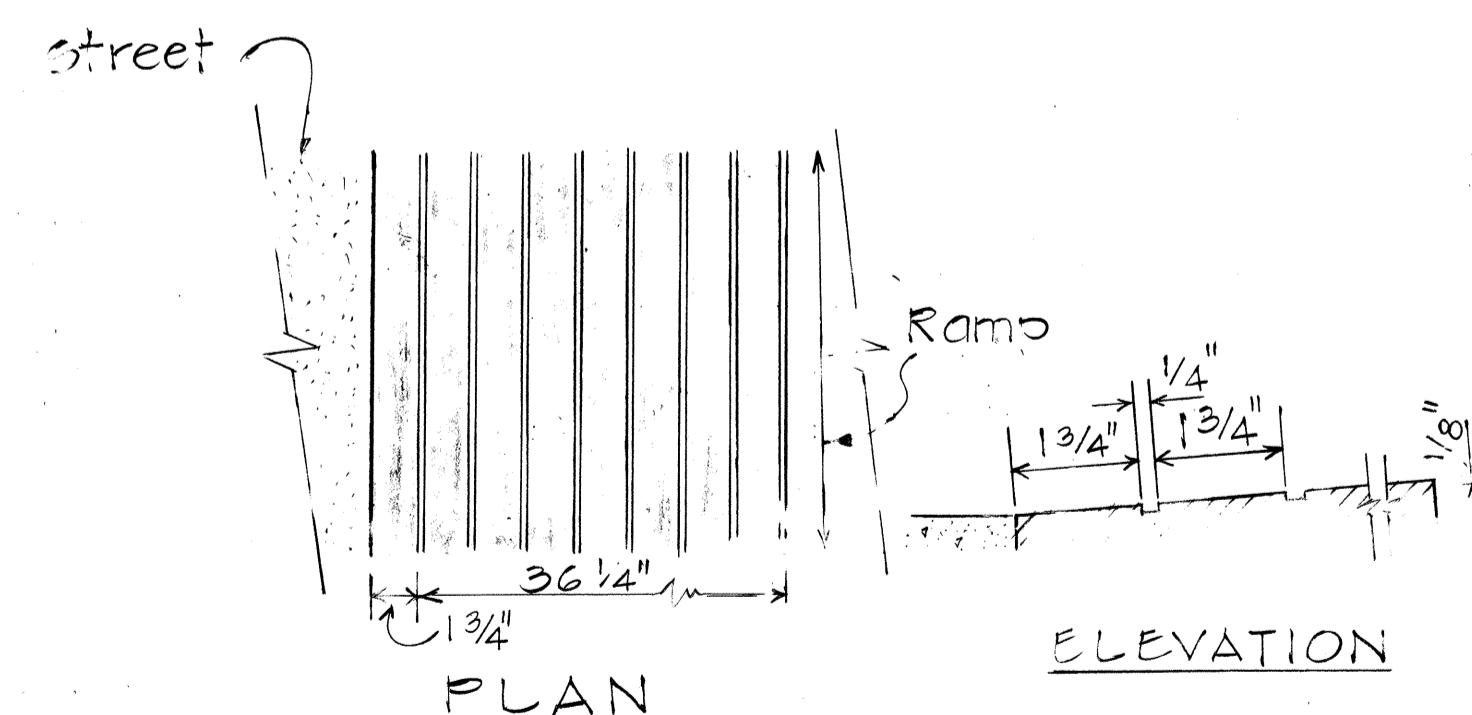

FED. ROAD DIST. NO.	STATE	FED. AID PROJ. NO.	FISCAL YEAR	SHEET NO.	TOTAL SHEETS
HAWAII	HAW.	1-HI-1(187)	1984	48	197

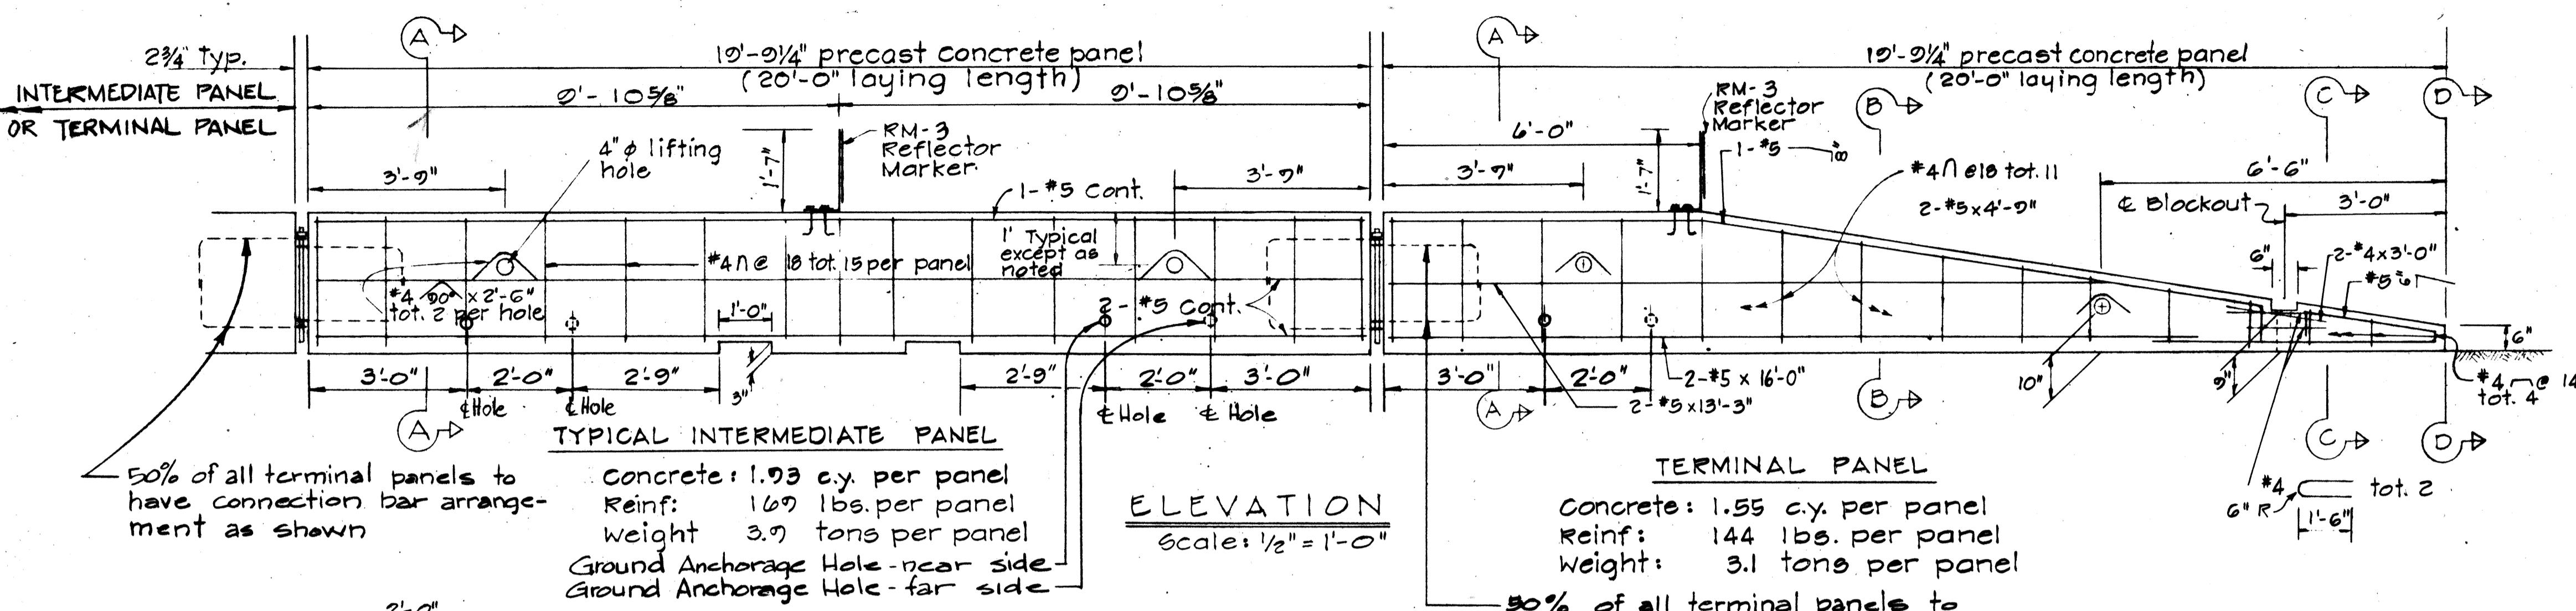

50% of all terminal panels to have connection bar arrangement as shown

Concrete: 1.93 c.y. per panel
Reinf: 169 lbs. per panel
Weight 3.9 tons per panel


Ground Anchorage Hole - near side
Ground Anchorage Hole - far side

ELEVATION


TERMINAL PANEL

Concrete: 1.55 c.y. per panel
Reinf: 144 lbs. per panel
Weight: 3.1 tons per pane


- 50% of all terminal panels to have connection bar arrangement as shown

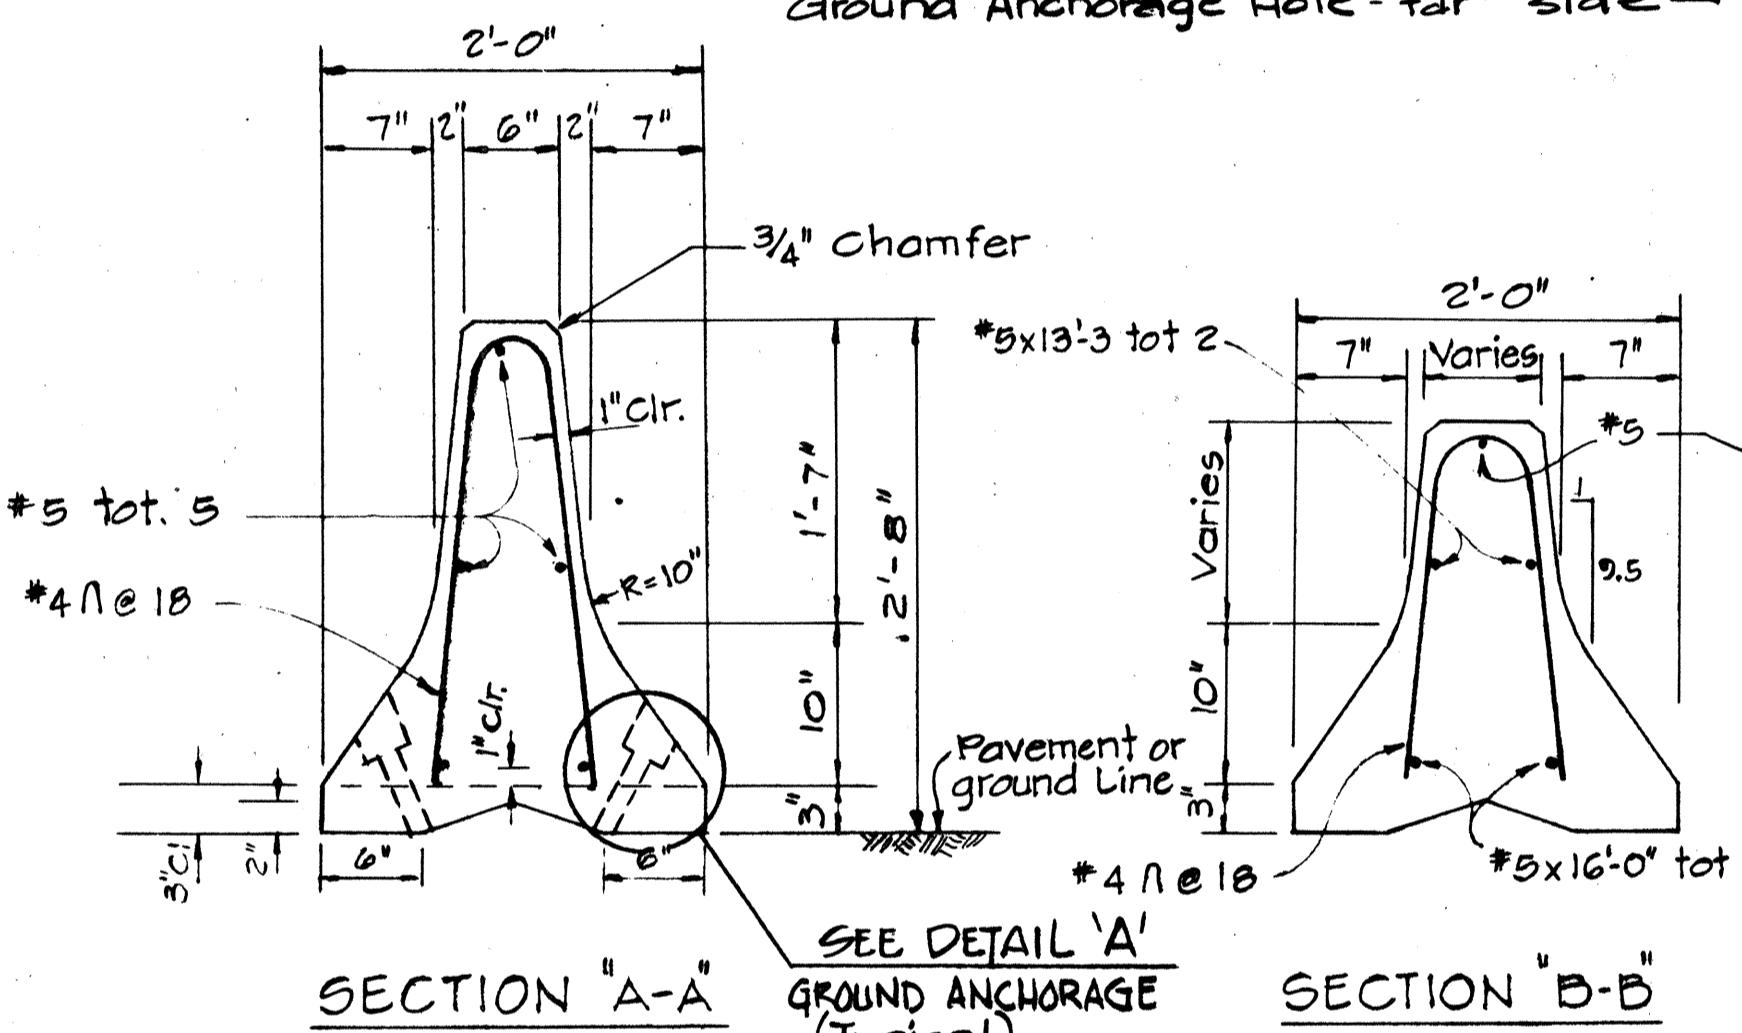


SECTION "A-A" SEE DETAIL A

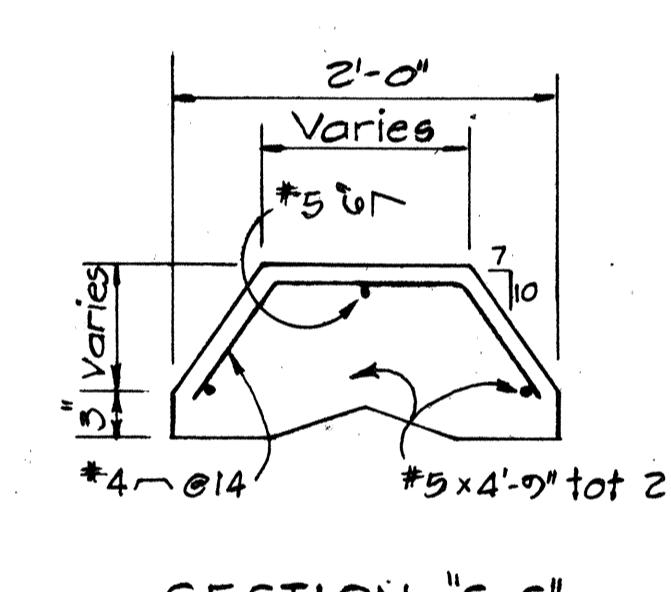

SECTION "C-C

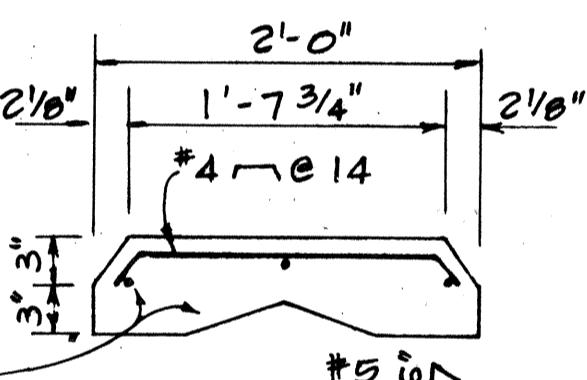


SECTION "D-D"

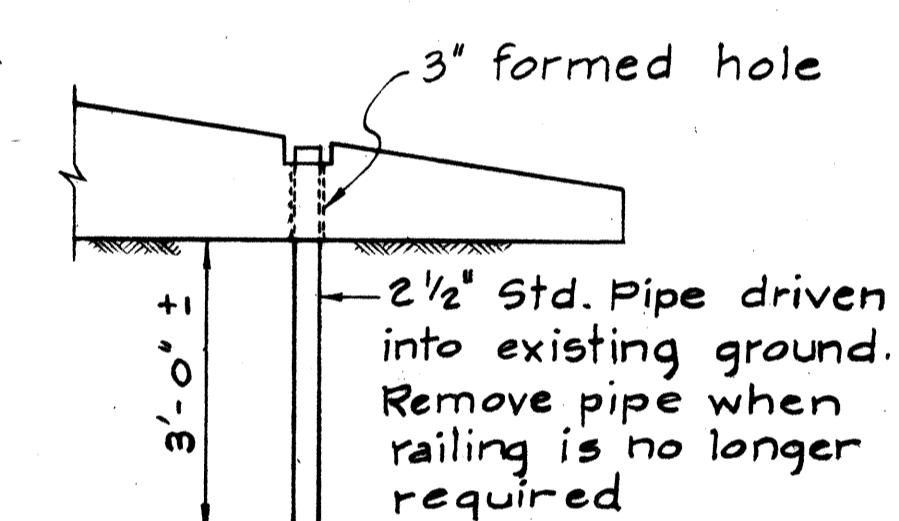


GROUND ANCHORAGE FOR
RAMPED END OF TERMINAL PANEL

1. For details not shown in Sections BB, C-C, & D-D, see Section A-A
2. Reflector Marker shall not be paid for separately but shall be considered incidental to "Portable Concrete Guard Rail."
3. Concrete shall be class "A".
4. All bolts to have cut washers unless otherwise noted.

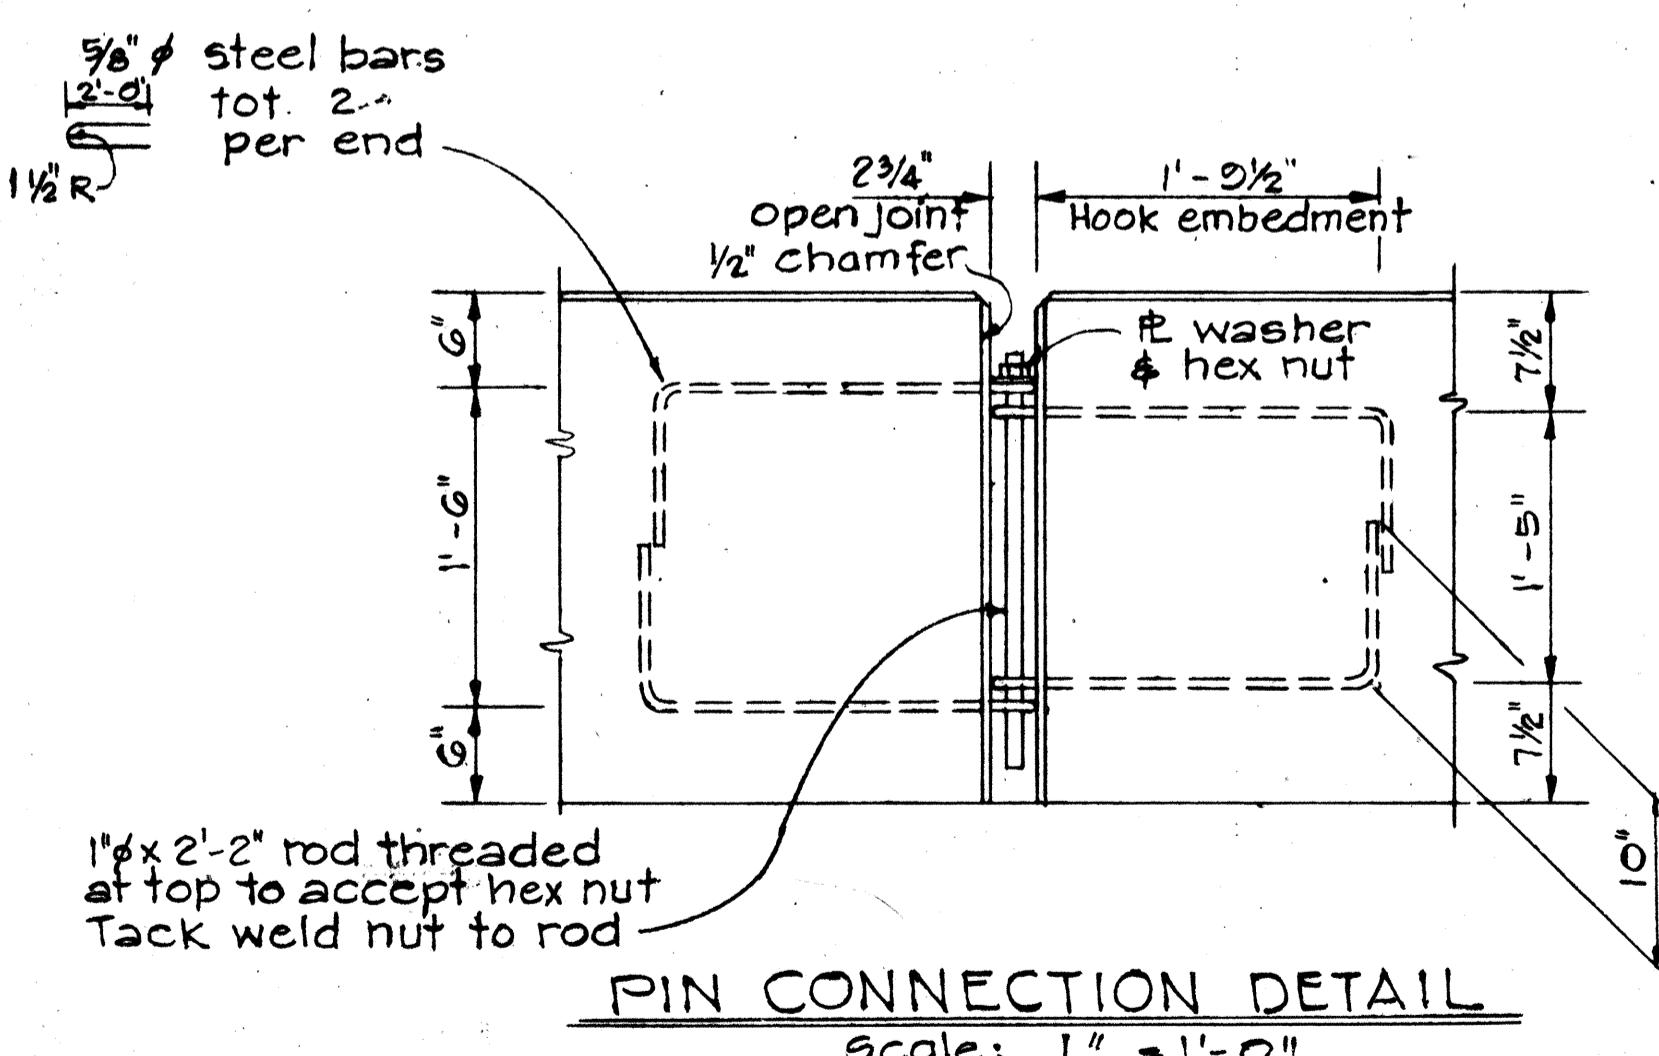


PIN CONNECTION DETAIL

Scale: 1" = 1'-0"

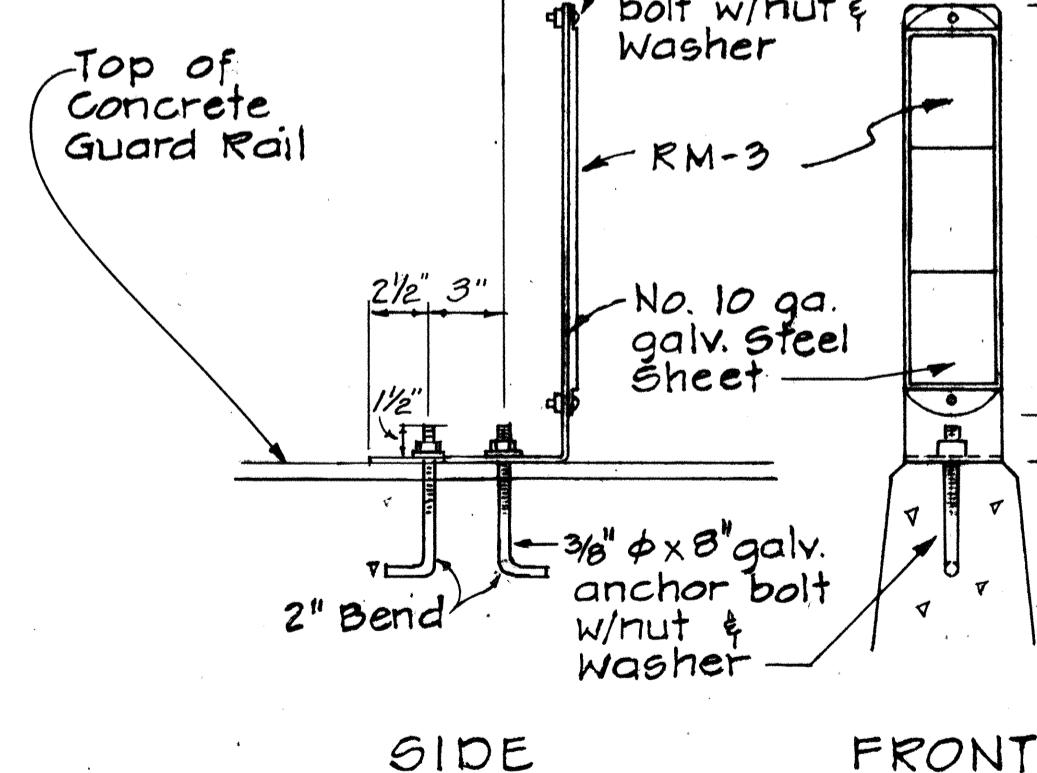

REFLECTOR MARKER
MOUNTING DETAIL

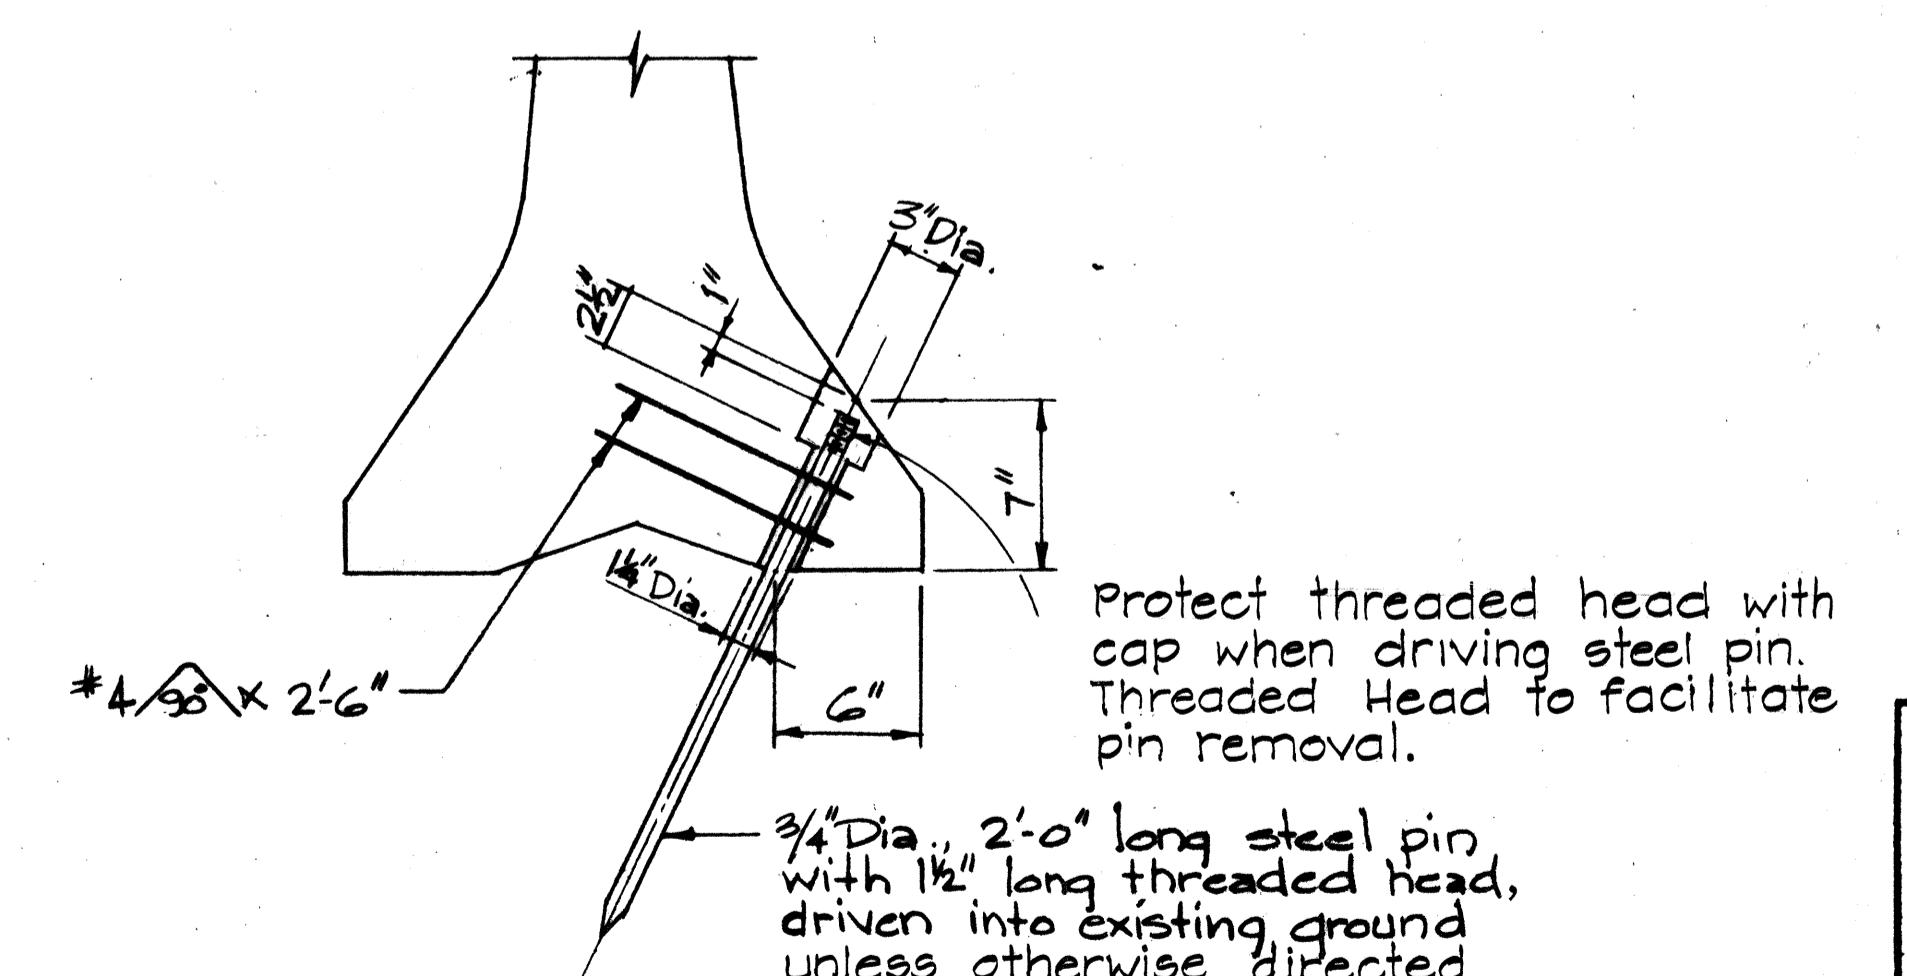

DETAIL A - GROUND ANCHORAGE

Protect threaded head with cap when driving steel pin.
Threaded Head to facilitate pin removal.

0" long steel pin
long threaded head,
existing ground
otherwise directed


**STATE OF HAWAII
DEPARTMENT OF TRANSPORTATION
HIGHWAYS DIVISION**

Scale: As Noted Date: _____
SHEET No. OF SHEETS

PLANT LIST (EXCLUDING PLANTS TO BE RELOCATED)

QUANTITY	NAME	SIZE
8	GOLD TREE - TABEBUIA DONNELL-SMITHII	25 g.c., 8' HIGH
13	SILVER TRUMPET - TABEBUIA ARGENTEA	25 g.c., 8' HIGH
0	WILI WILI - ERYTHRINA SANDWICENSIS	5 g.c., 4' HIGH
-1	RAINBOW SHOWER - CASSIA JAVX S. FIST.	25 g.c., 8' HIGH
0	AFRICAN TULIP - SPATHODEA SAMBONULATA	5 g.c., 4' HIGH
63	BE STILL - THEVETIA PERUVIANA	5 g.c., 4' HIGH
12	BOTTLE BRUSH - CALLISTEMON LANCEOLATUS	10 g.c., 5' HIGH
33	ARECA PALM - CHRYSALEOCARPUS LUTESCENS	5 g.c., 4' HIGH CLUMP
250	RED OLEANDER - NERIUM OLEANDER	1 g.c., 2' HIGH
35	PINK OLEANDER - NERIUM OLEANDER	1 g.c., 2' HIGH
35	ORANGE OLEANDER - NERIUM OLEANDER	1 g.c., 2' HIGH
64	BOUGAINVILLEA SP.	2 1/2 GC 2' LONG STEM
57	HUAFALA VINE - PYROSTEGIA TONEA	2 1/2 g.c., 2' LONG STEM
64	RED BAUHINIA VINE - BAUHINIA GALPINI	1 g.c., 1' LONG STEM
2000	LANTANA "SUNBURST" - LANTANA SP.	1 ft. & 1 1/2 g.c.
3330±SF	TRAILING LANTANA - LANTANA SELLIVIANA	1 ft. & 1 1/2 g.c.
8660±SF	WEDELIA - WEDELIA TRILOBATA	9" LONG ROOTED CUTTINGS @ 1" G.C.
270±SF	MARIGOLD - GYNDON DACTYLON	SEED OR SPRIGS
1500±SF	BEACH NEED - DIMORPHOTHECA SPP	4 POTS @ 1" G.C.

FED. ROAD DIST. NO.	STATE	FED. AID PROJ. NO.	FISCAL YEAR	SHEET NO.	TOTAL SHEETS
HAWAII	HAW	I-HI(187)	1984	ADD 48S-1	197

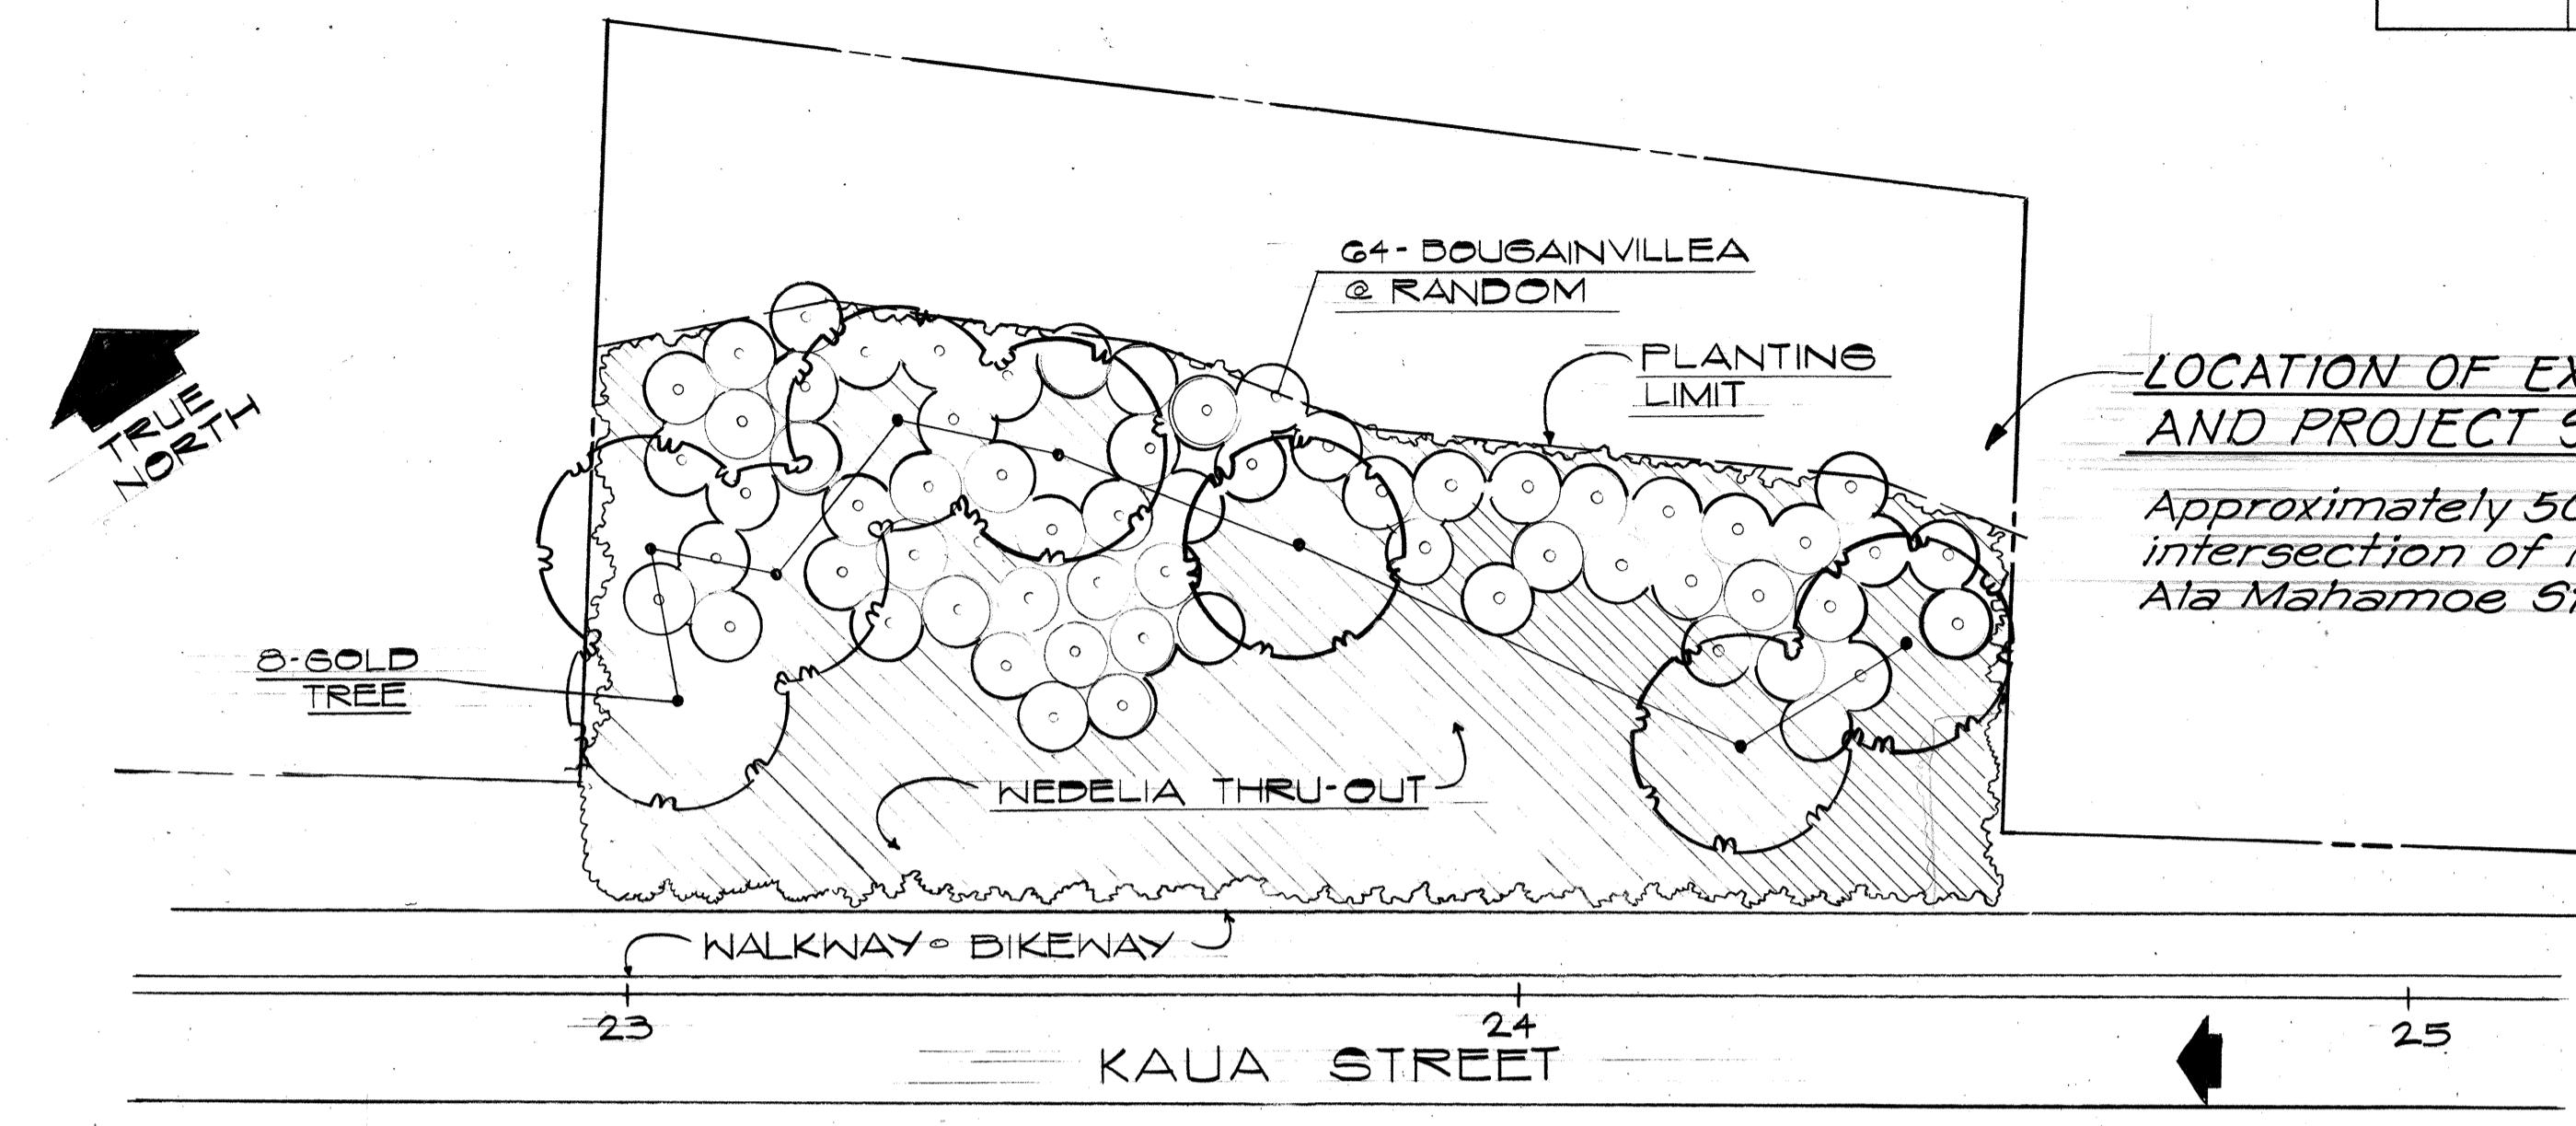


LOCATION OF EXISTING FIELD OFFICE AND PROJECT SITE LABORATORY

Approximately 500 feet west of the intersection of Kaua Street and Ala Mahamoe Street.


NOTE:

- CONTRACTOR SHALL VERIFY ALL QUANTITIES, MEASUREMENTS & SITE CONDITIONS.
- GROUND COVER PLANTING:
PRIOR TO PLANTING NEW PLANTS, ERADICATE ALL EXISTING VEGETATION WITH "KOUNDP" HERBICIDE OR APPROVED EQUAL. COST SHALL BE INCIDENTAL TO VARIOUS CONTRACT ITEMS.
- VERIFY EXISTING SIZES & LOCATIONS OF ALL TREES TO BE RELOCATED.
- MINIMUM CLEARANCE FROM EDGE OF PAVEMENT LINE SHALL BE 30 FEET FOR TREES AND 15 FEET FOR SHRUBS. WHERE THERE ARE SLOPES, BARRIERS, DEFLECTORS, CURB & GUTTERS, DEVIATION FROM THESE REQUIREMENTS SHALL BE APPROVED BY THE ENGINEER.

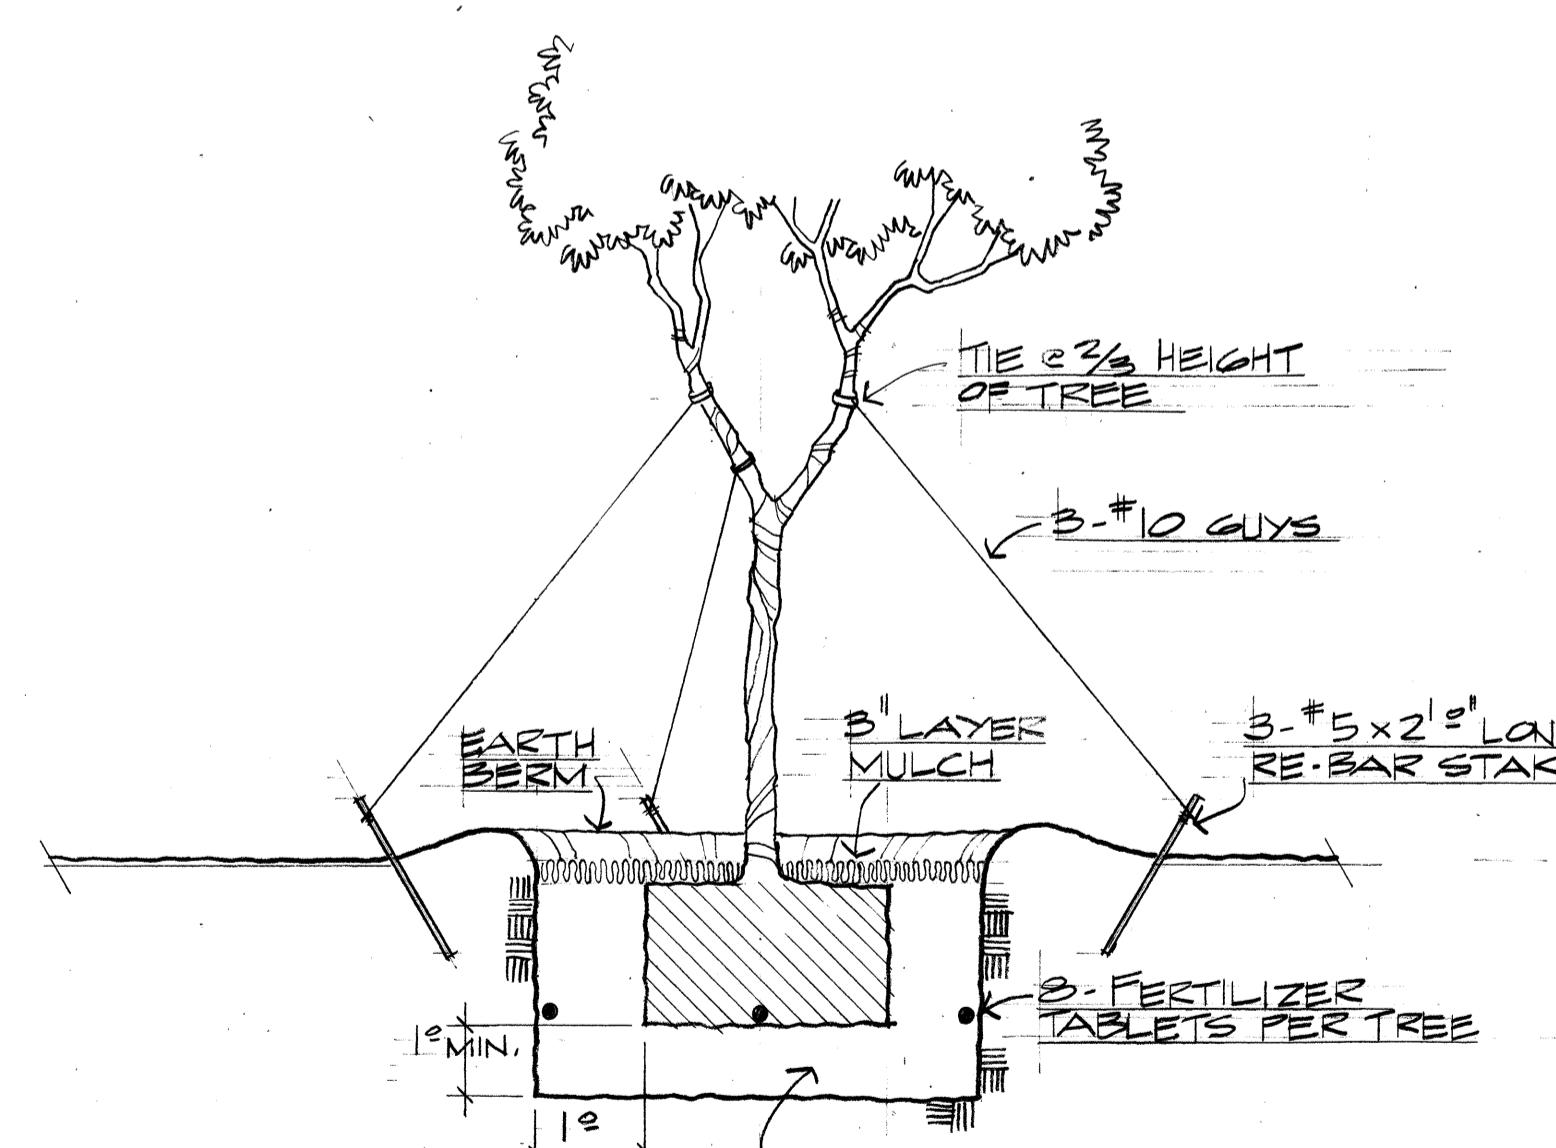

TYP. PLANTING DETAIL FOR
25 G.C. & RELOCATED TREES
NO SCALE

NOTE:
BACKFILL MIX SHALL CONSIST OF 4 PARTS SOIL & 1 PART MANURE. FERTILIZER TABLETS SHALL BE 20-10-15 ANALYSIS, 2 GRAM SIZE.

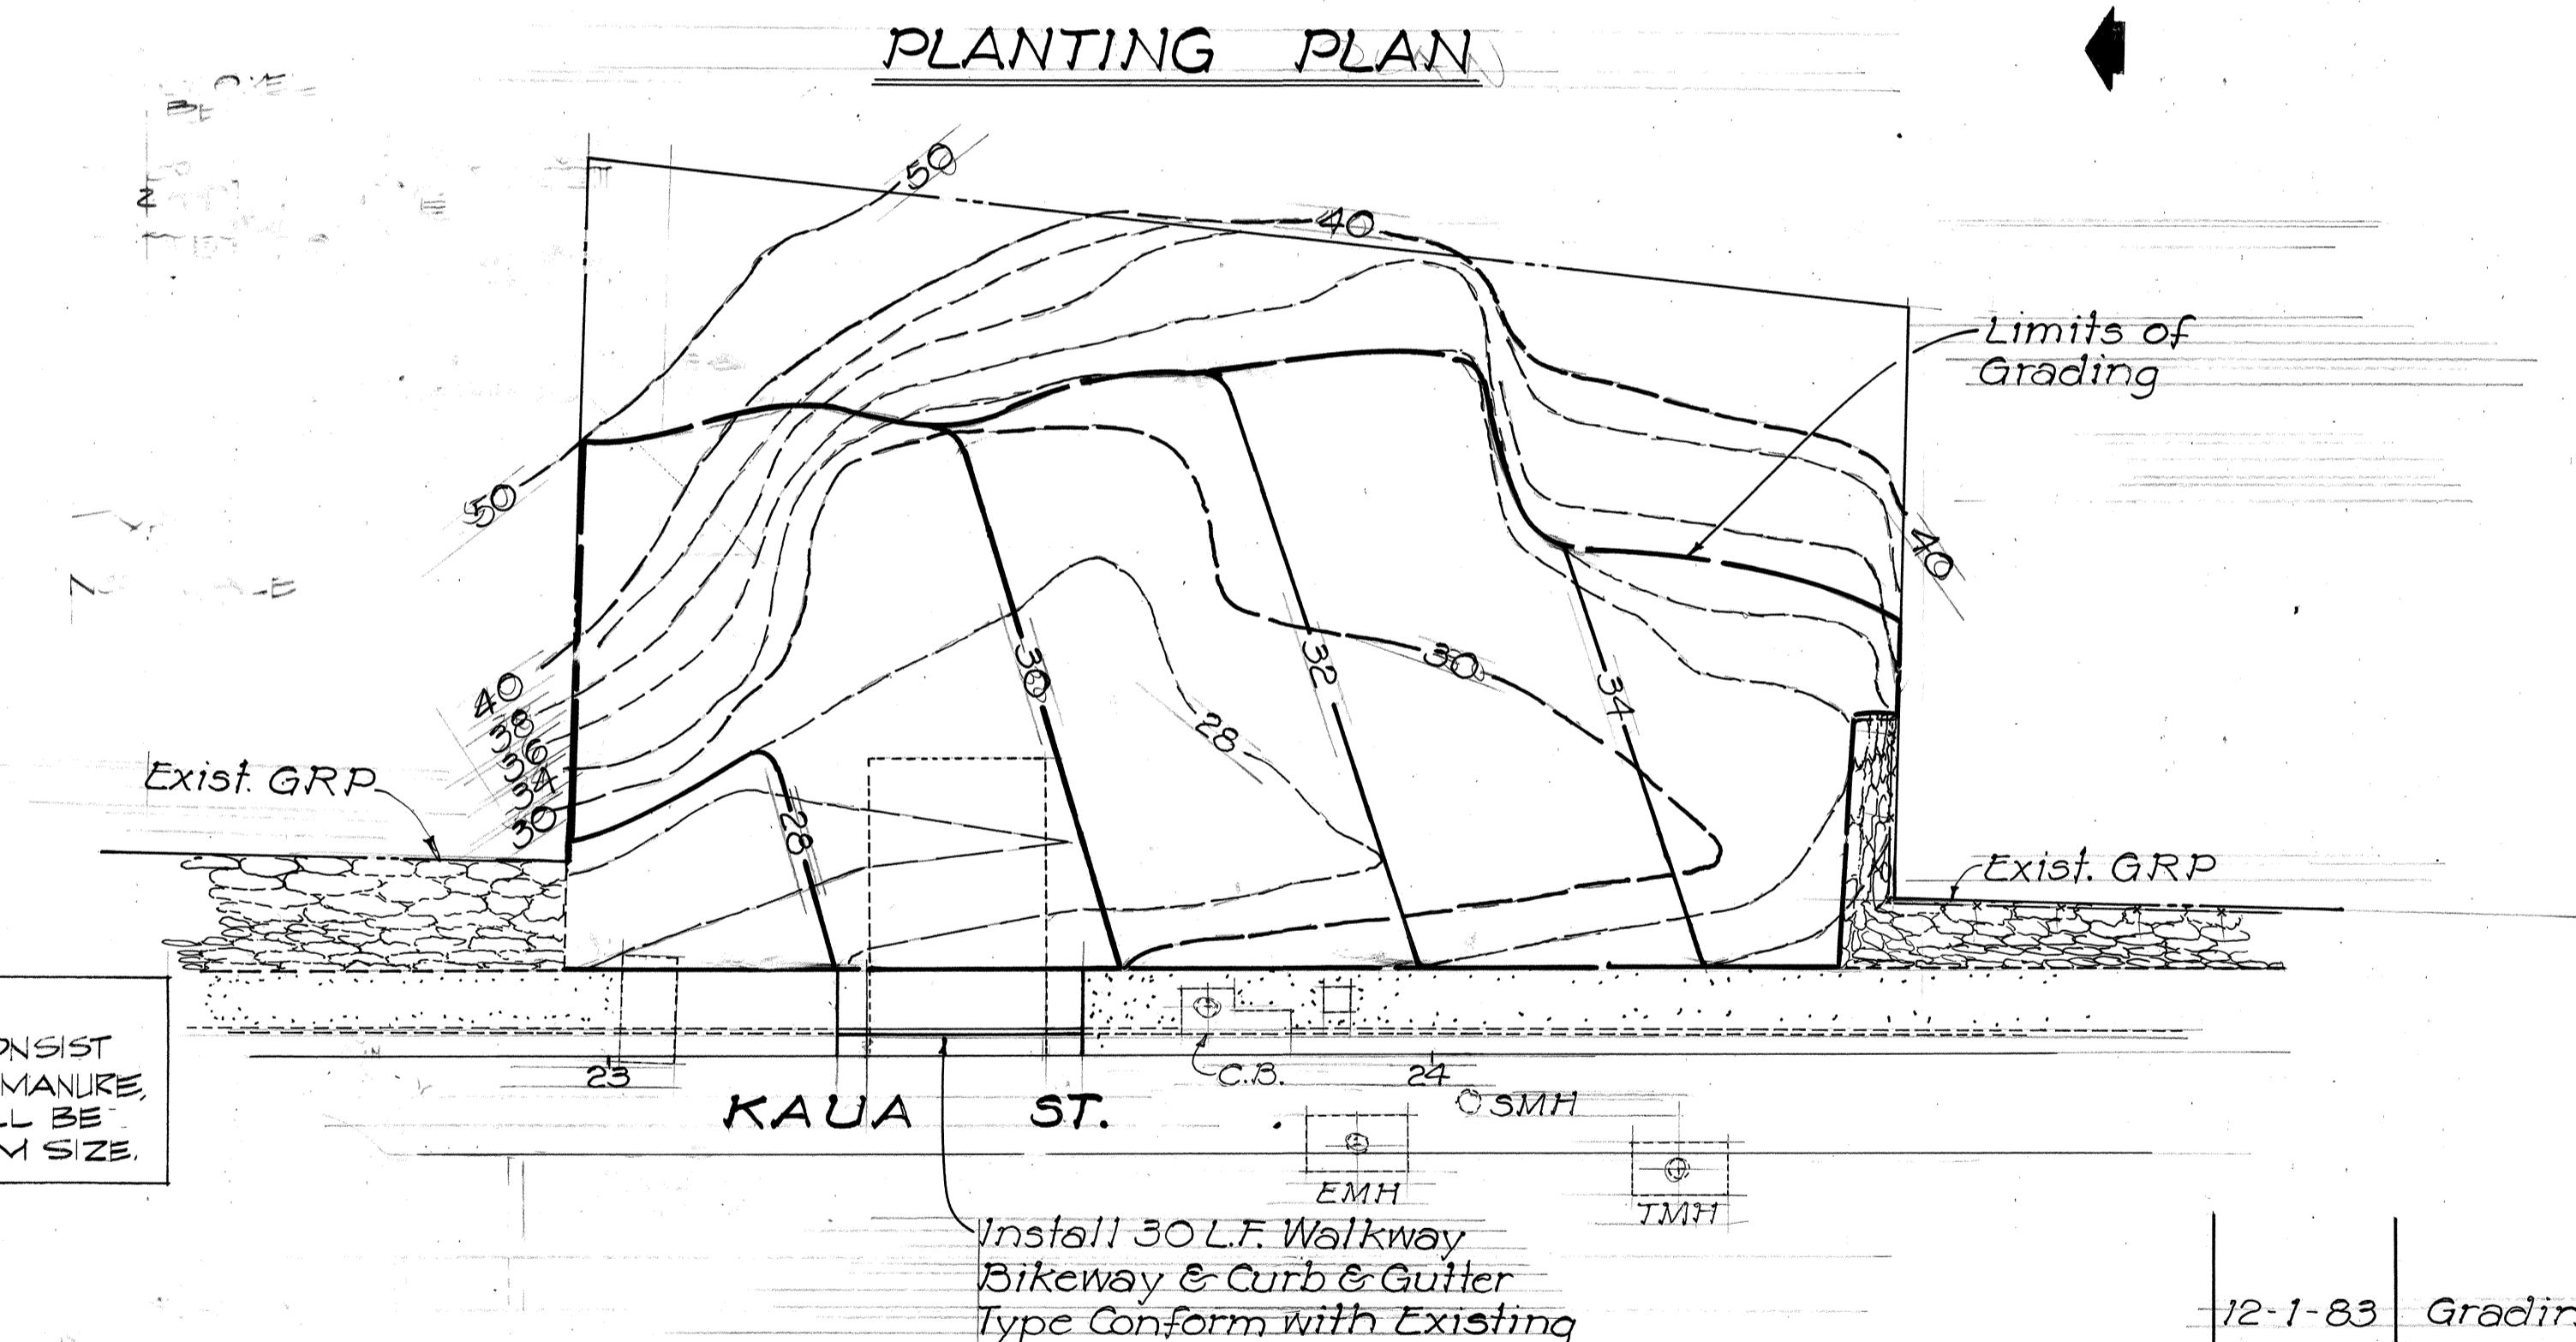

GRADING PLAN

Scale: 1" = 20'

12-1-83 Grading Plan added
11-21-83 Landscaping work added for existing project field office site.

DATE REVISION



STATE OF HAWAII
DEPARTMENT OF TRANSPORTATION
HIGHWAYS DIVISION

PLANTING PLAN

INTERSTATE ROUTE H-I IMPROVEMENTS
MIDDLE STREET TO KALIHI INTERCHANGE
WESTBOUND LANES

F.A.I. PROJ. NO. I-HI-1(187)
SCALE 1" = 20' DATE NO. 078

HL-K7 Jan

SHEET NO. 1 OF 1 SHEETS

ADD 48S-1