


FED. ROAD DIST. NO.	STATE	FED. AID PROJ. NO.	FISCAL YEAR	SHEET NO.	TOTAL SHEETS
HAWAII	HAW.	I-HI-1(187)	1984	16	127

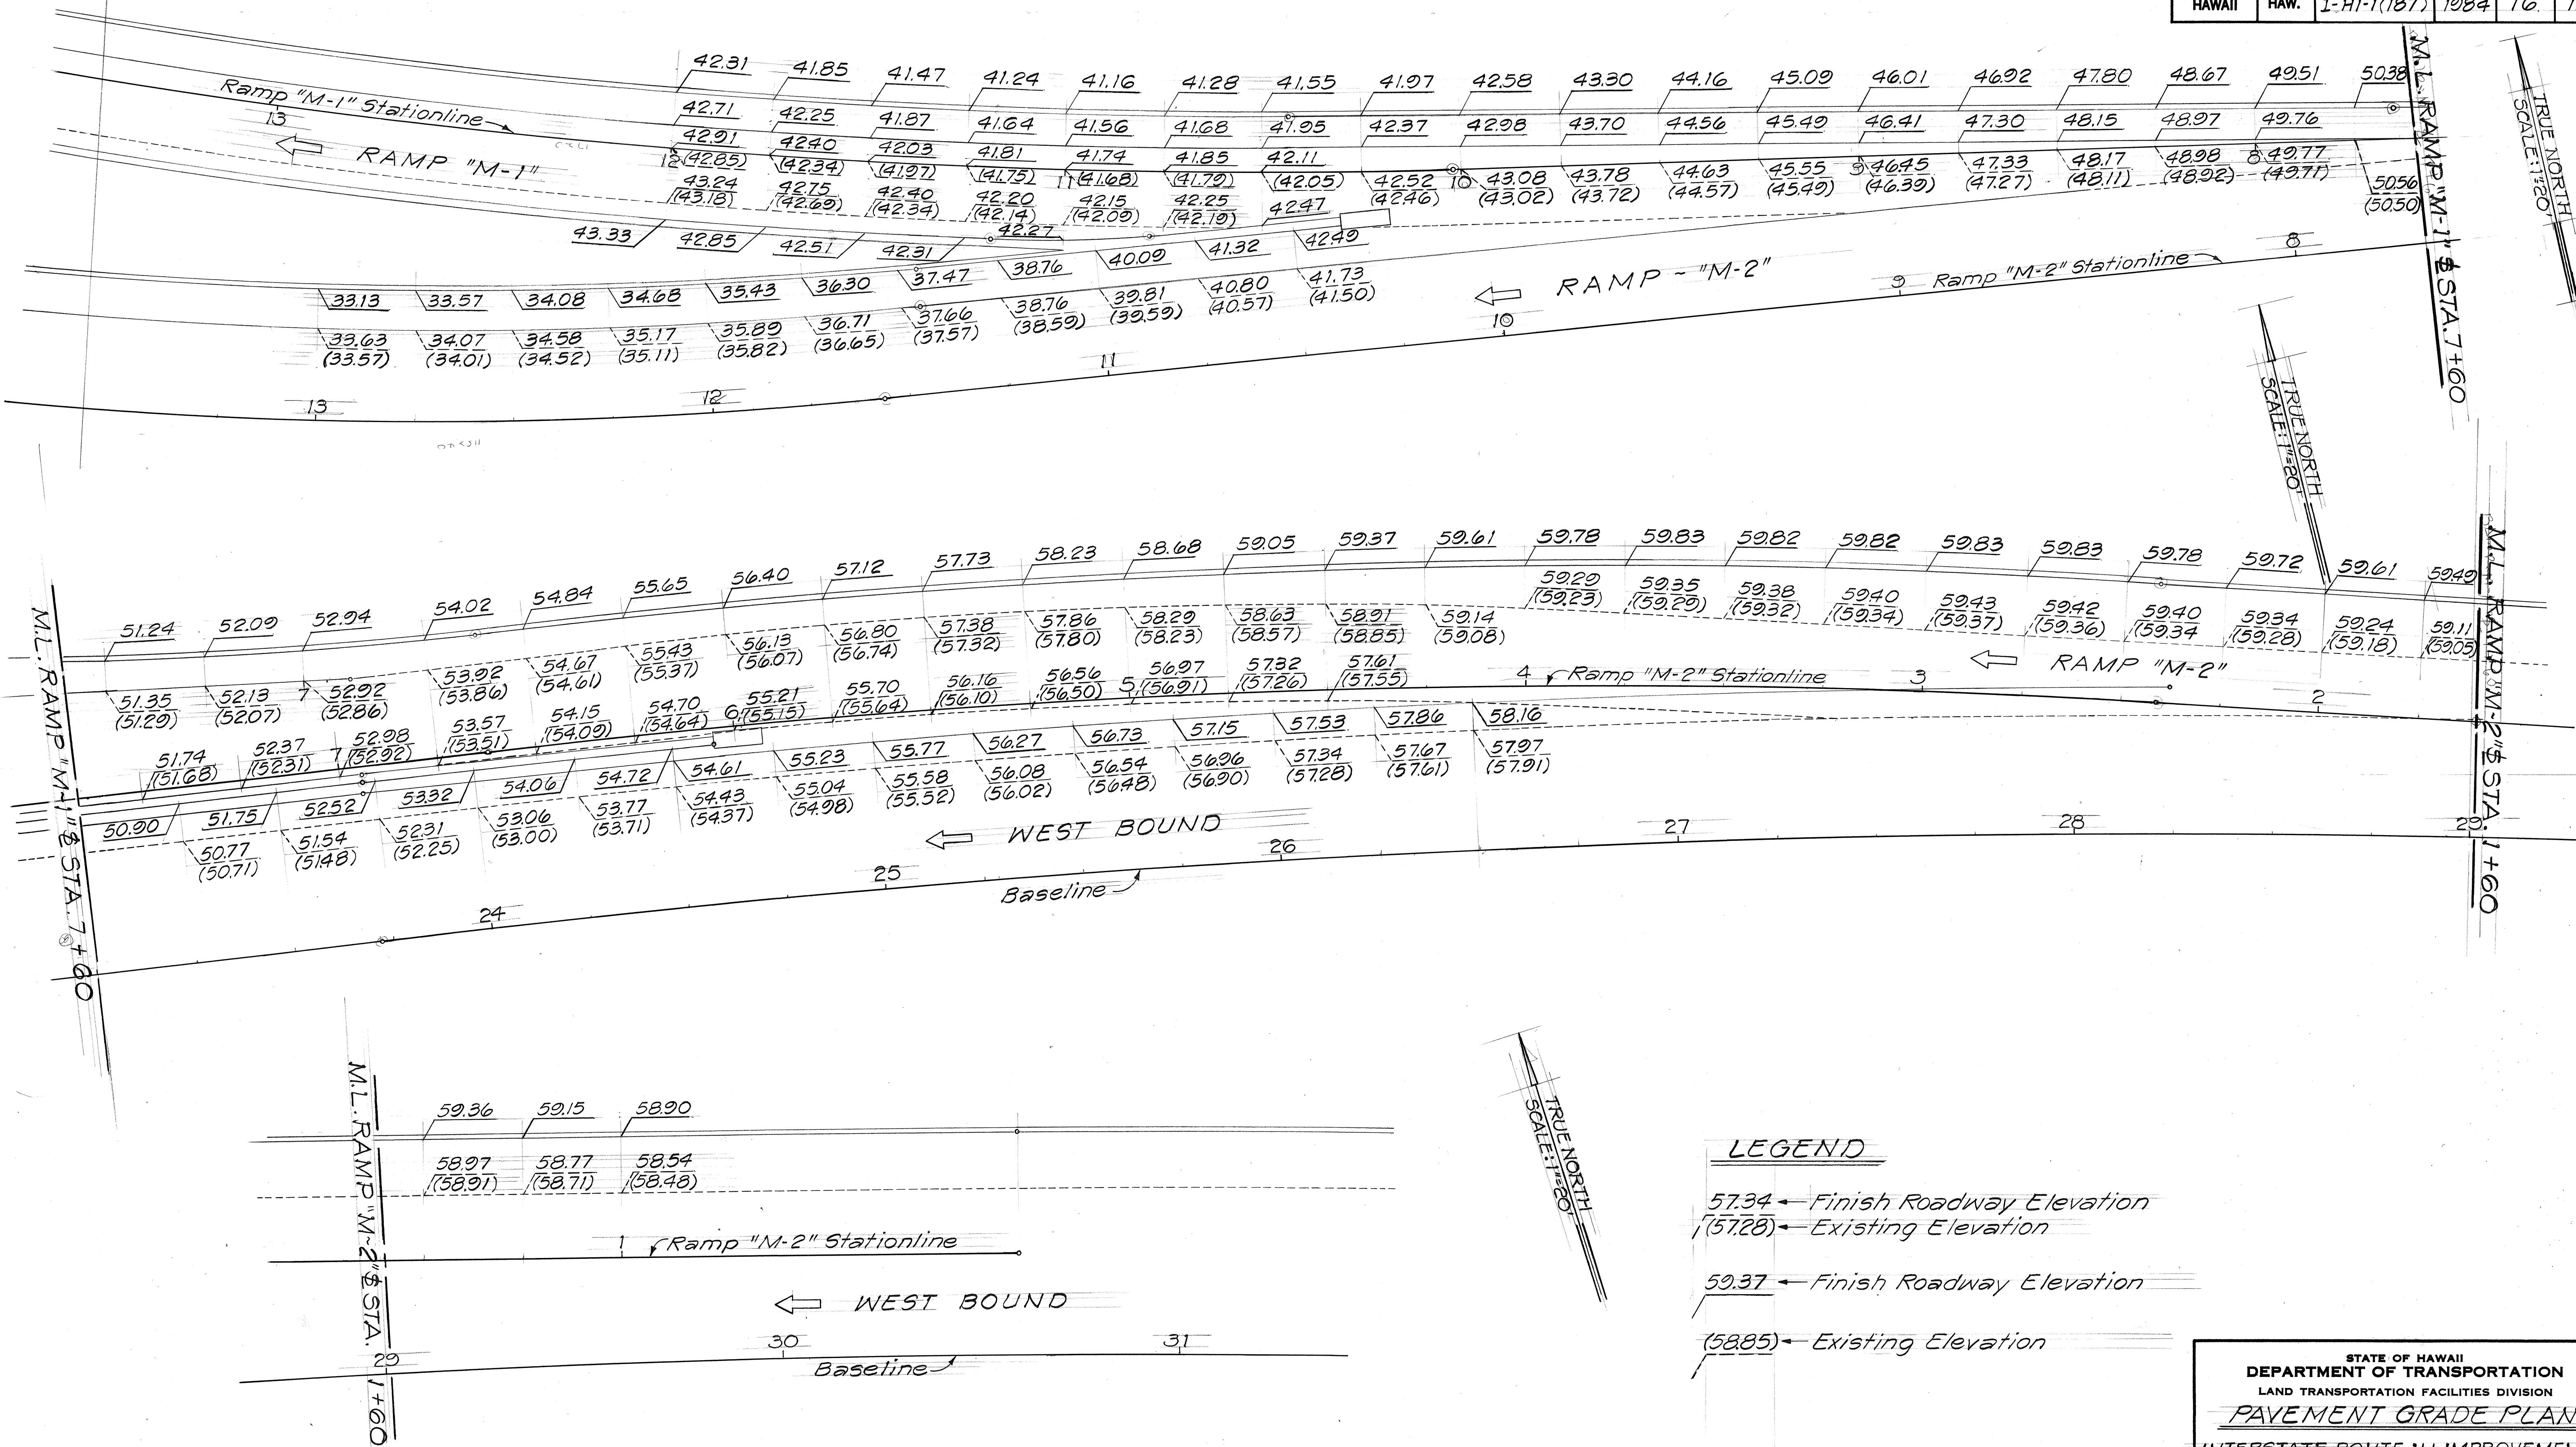

SURVEY PLOTTED BY	DATE
DRAWN BY	
TRACED BY	
NOTED BY	
CHECKED BY	
ORIGINAL PLAN	
NOTE BOOK	
No.	

LEGEND

- 57.34 ← Finish Roadway Elevation
- (57.28) ← Existing Elevation
- 59.37 ← Finish Roadway Elevation
- (58.85) ← Existing Elevation

STATE OF HAWAII
DEPARTMENT OF TRANSPORTATION
LAND TRANSPORTATION FACILITIES DIVISION

PAYEMENT GRADE PLAN
INTERSTATE ROUTE HI IMPROVEMENTS
MIDDLE STREET TO KALIHI INTERCHANGE
WESTBOUND LANES
F.A.I. PROJ. NO. I-HI-1(187)
SCALE: As Shown
SHEET NO. 1 OF 2 SHEETS


FED. ROAD DIST. NO.	STATE	FED. AID PROJ. NO.	FISCAL YEAR	SHEET NO.	TOTAL SHEETS
HAWAII	HAW.	I-HI-1(187)	1984	17	197

LEGEND

77.71 ← Finish Roadway Elevation
(77.65) ← Existing Elevation

73.12 ← Finish Roadway Elevation
(73.12) ← Existing Elevation

TRUE NORTH
Scale: 1" = 20'

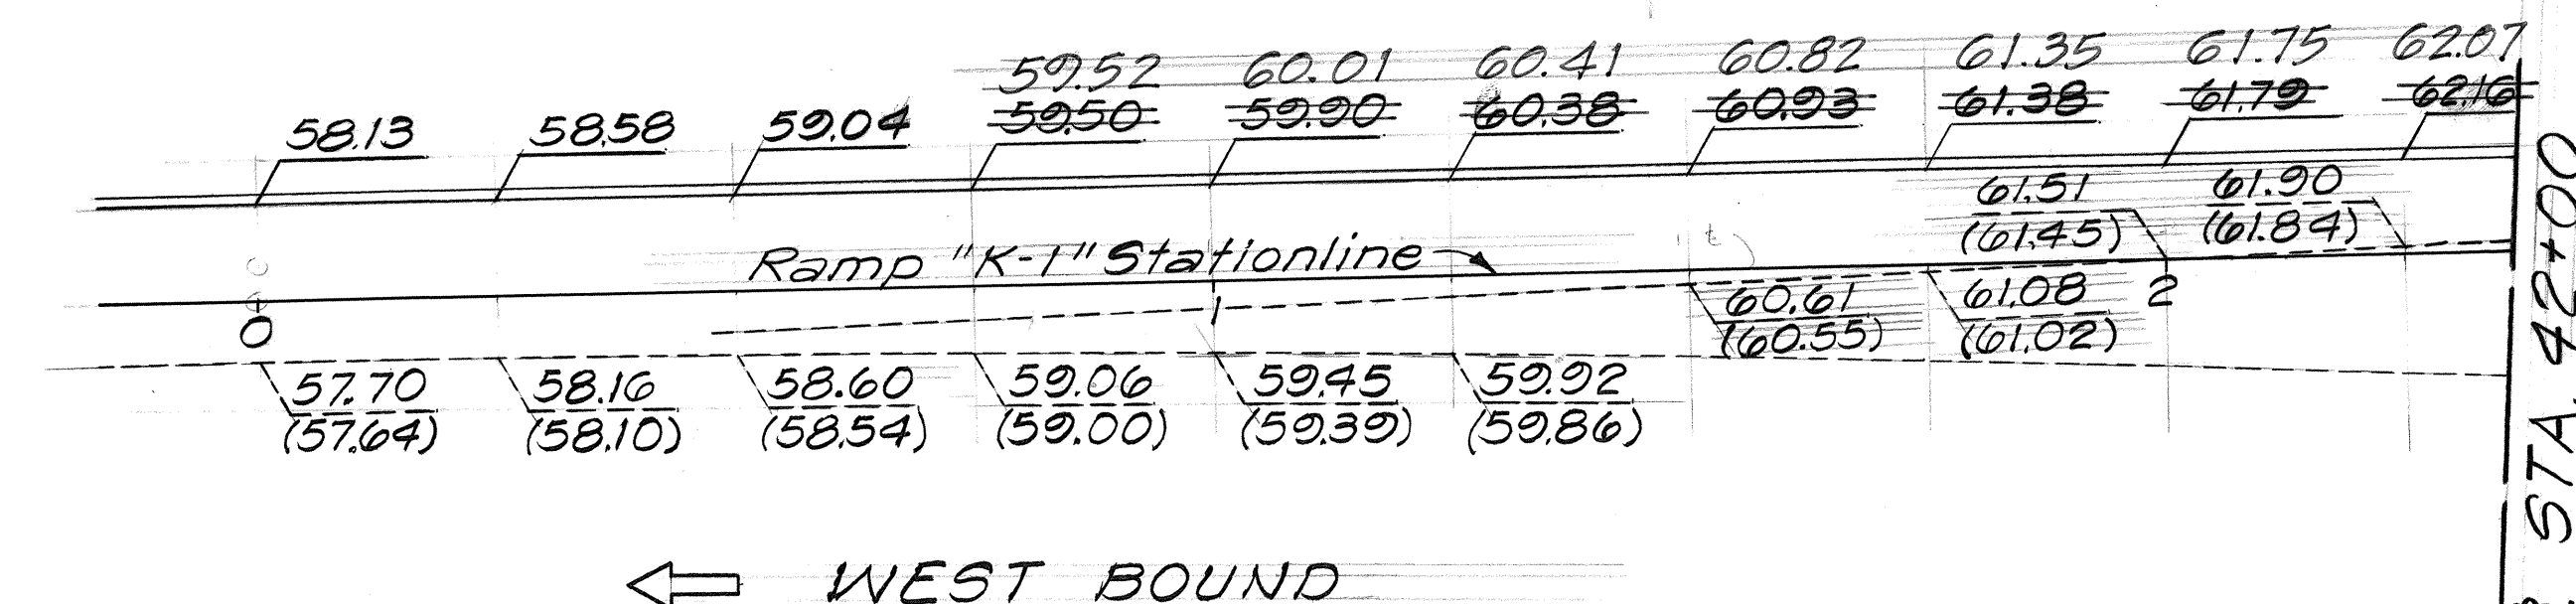


← WEST BOUND

40 Baseline 41


TRUE NORTH
Scale: 1" = 20'

M.L. @ STA. 42+00

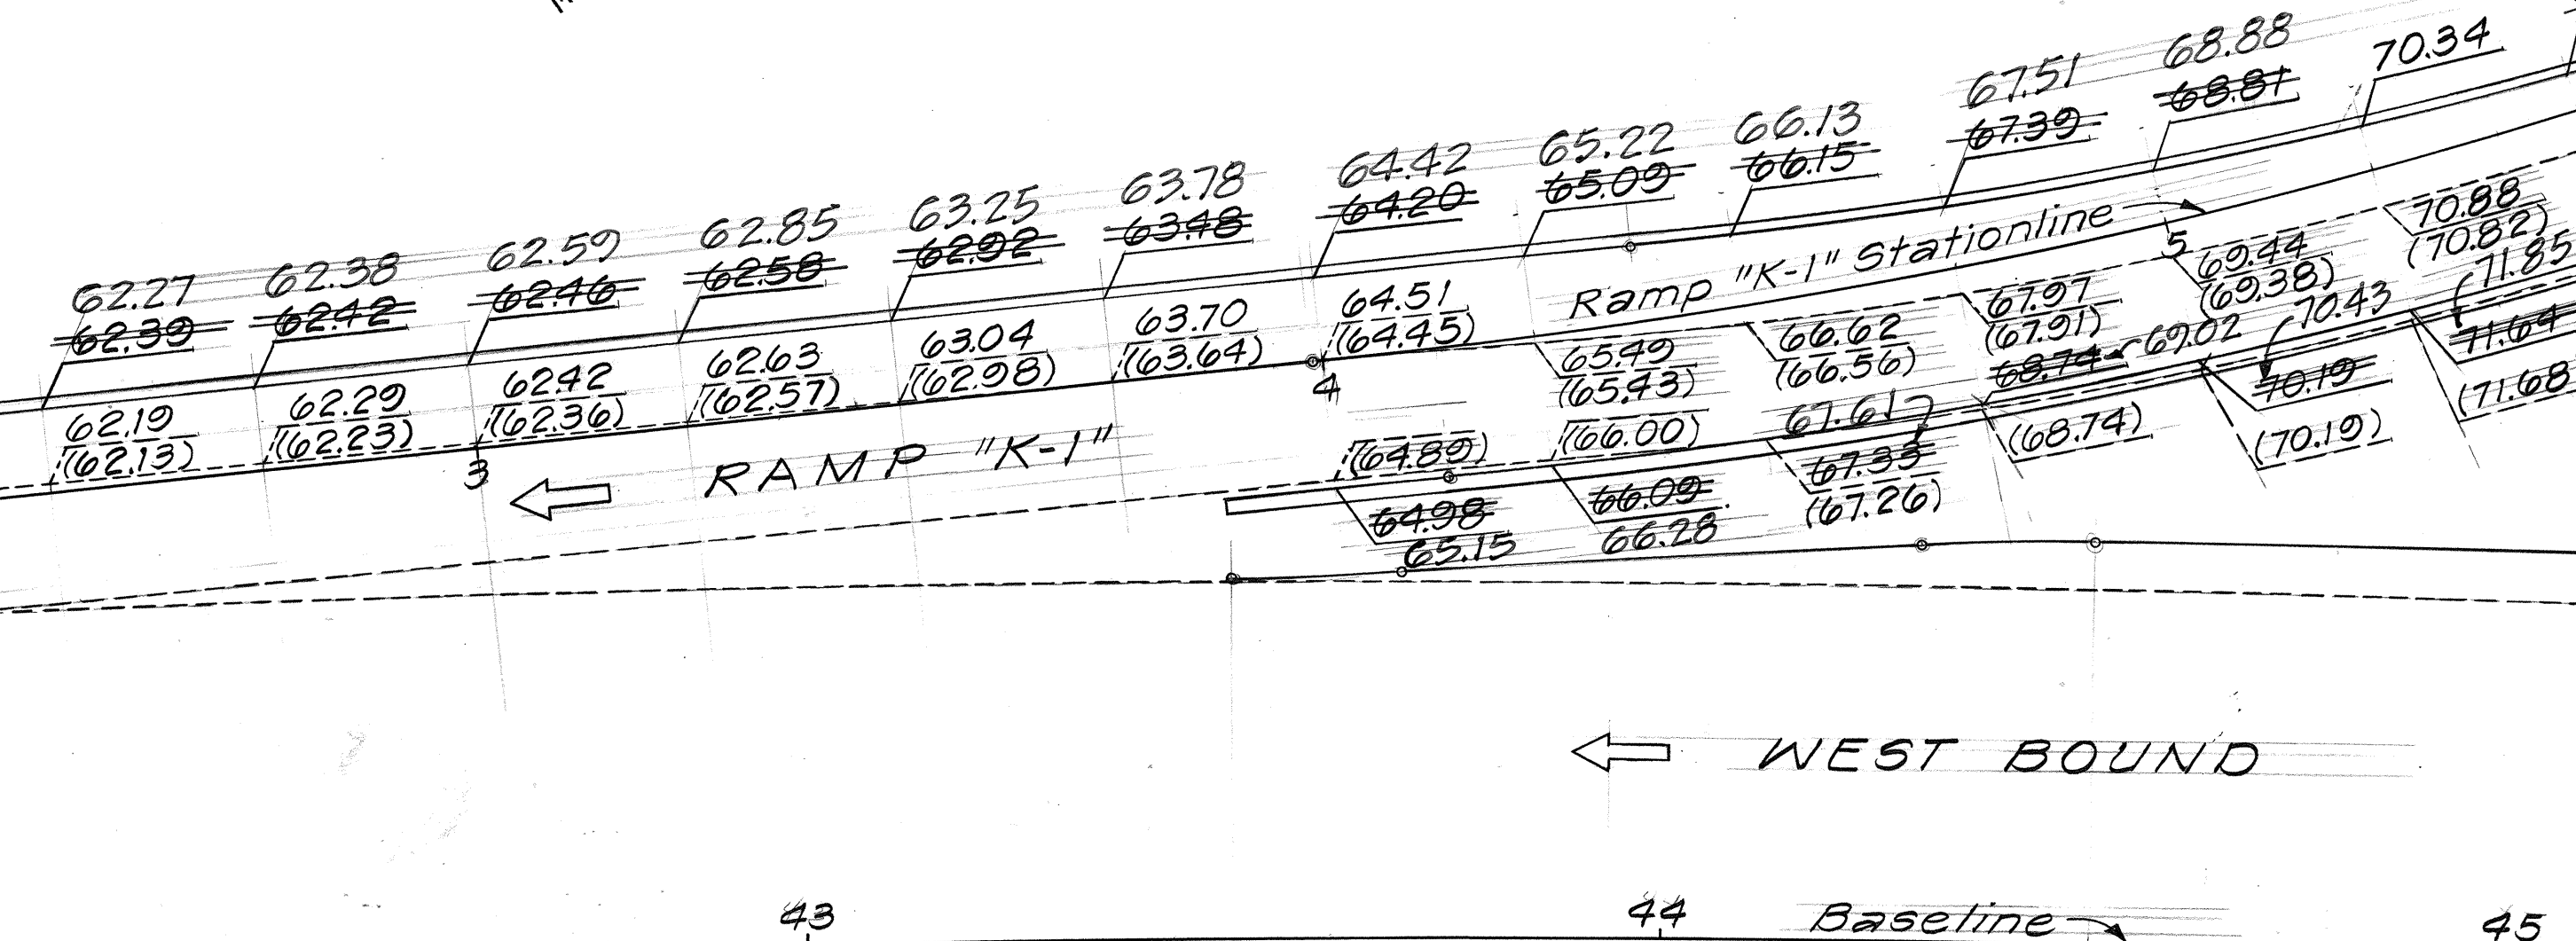

← WEST BOUND

43 Baseline 44 45

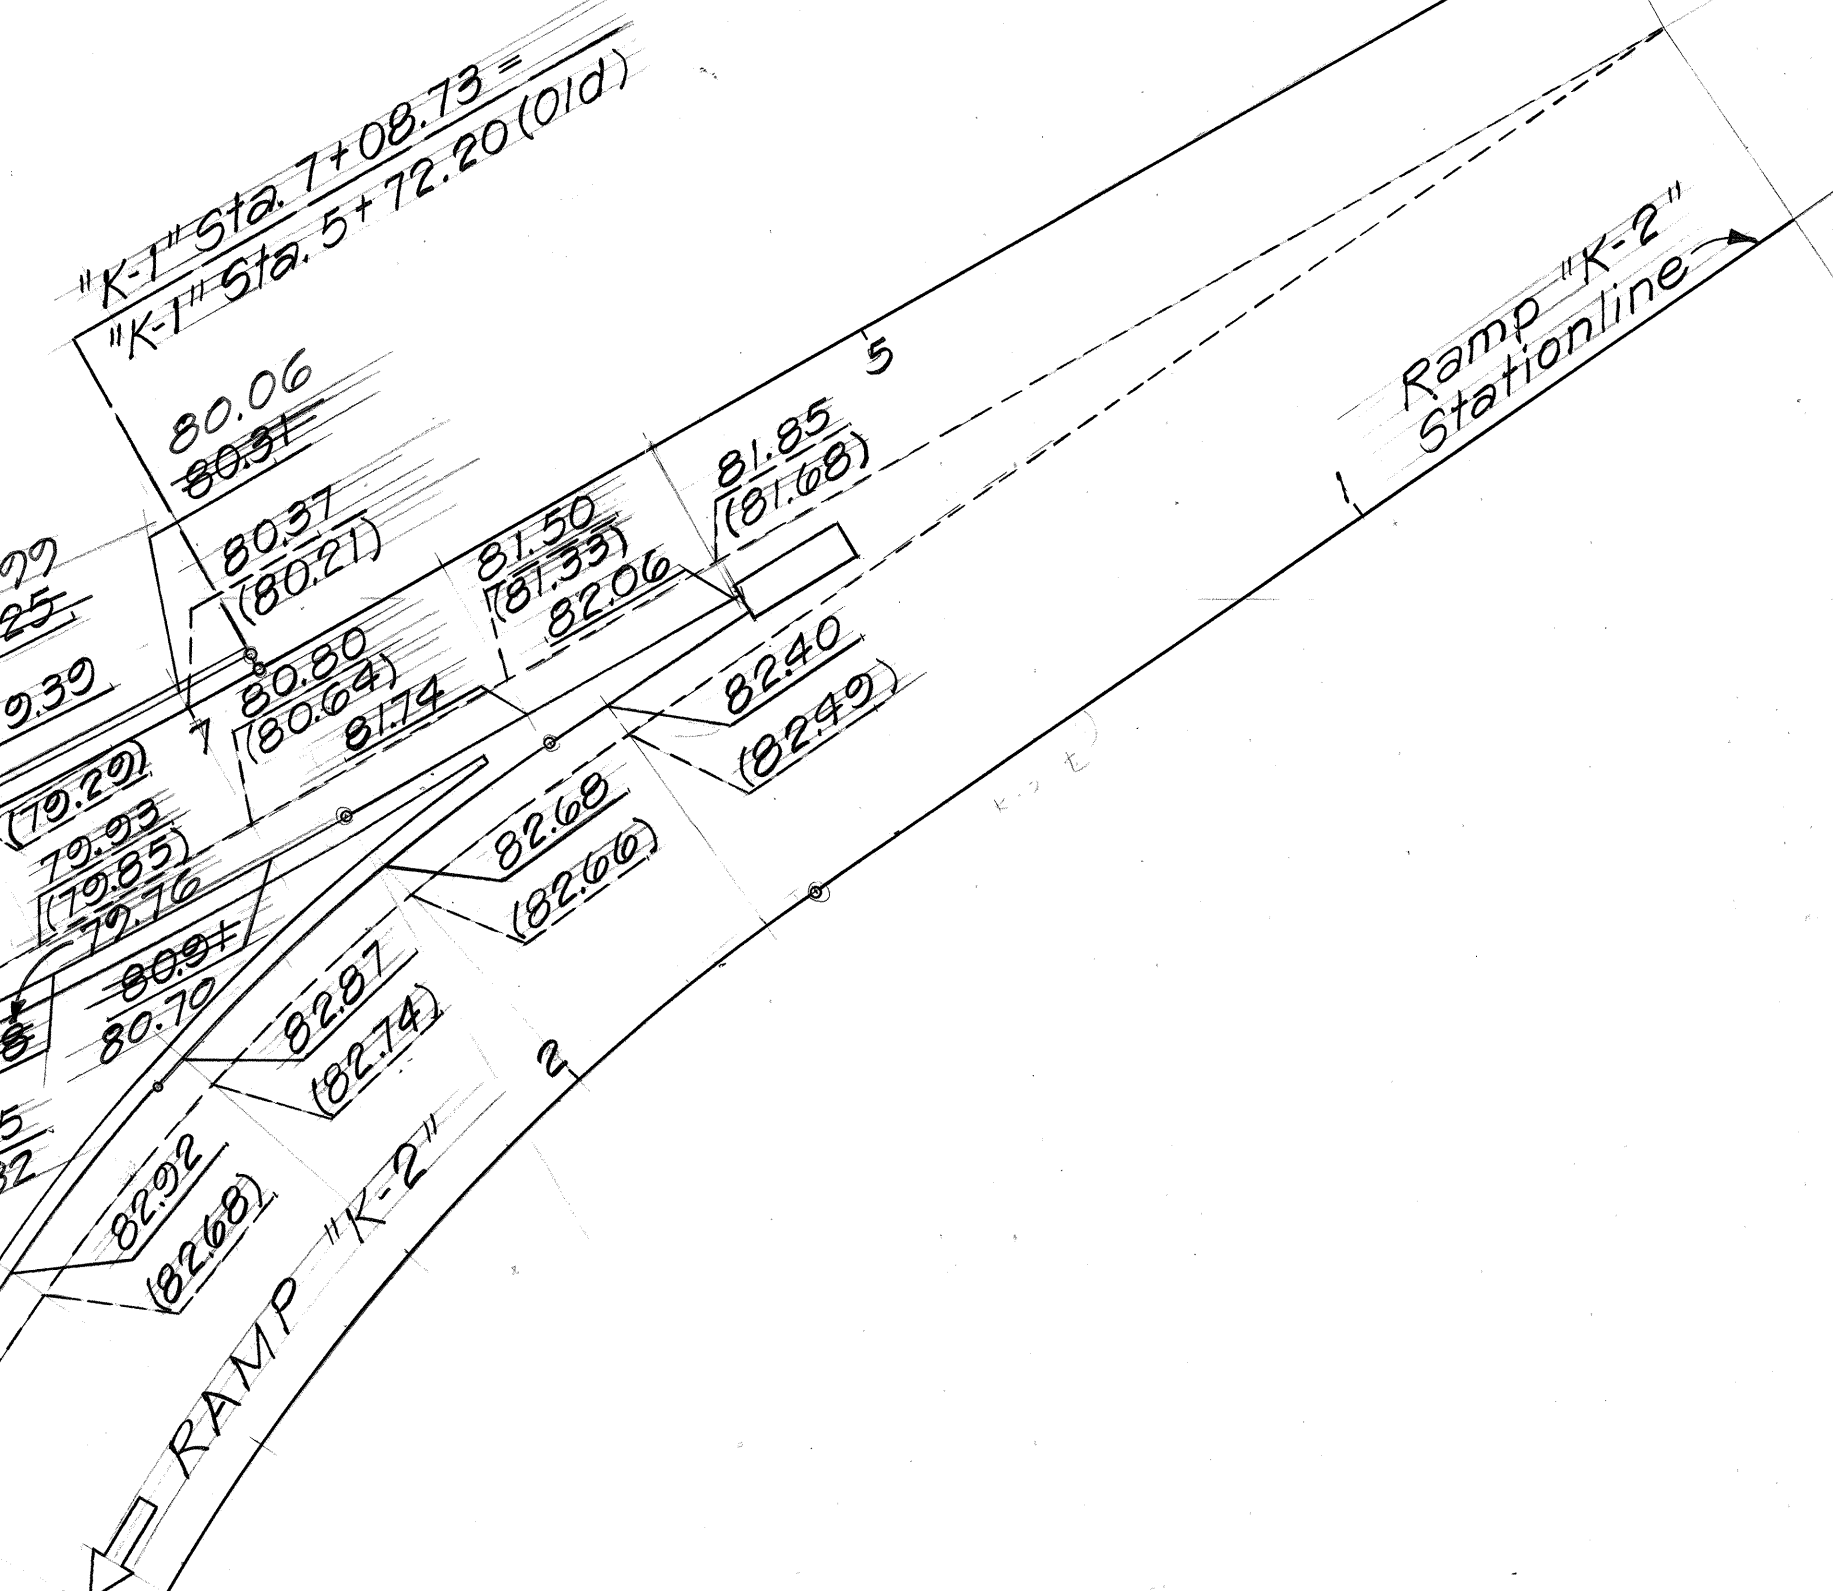

SURVEY PLOTTED BY	DATE
DRAWN BY	
CHECKED BY	
NOTED BY	
QUANTITIES BY	
CHECKED BY	

STATE OF HAWAII
DEPARTMENT OF TRANSPORTATION
LAND TRANSPORTATION FACILITIES DIVISION
PAVEMENT GRADE PLAN
INTERSTATE ROUTE HI IMPROVEMENTS
MIDDLE STREET TO KALIHI INTERCHANGE
WESTBOUND LANES
F.A.I. PROJ. NO. I-HI-1(187)
SCALE: As Shown
SHEET NO. 2 OF 2 SHEETS