

FED. ROAD DIST. NO.	STATE	FED. AID PROJ. NO.	FISCAL YEAR	SHEET NO.	TOTAL SHEETS
HAWAII	HAW.	1R-HI-1(184)	1984	8	114

Ramp WL-I Sta. 5+60 to 6+25 Lt.
Construct Concrete Barrier, Type 4E

Ramp WL-I Sta. 6+25 to 7+35.39 Lt.
Construct Concrete Barrier, Type 4F

For Type 4E and Type 4F
Concrete Barrier Details,
See Sht. No. 2

Install 6' Chain Link Fence
End Post. Notch Concrete
Barrier Footing to Construct
Fence Footing.

Remove Existing
Chain Link Fence

Ramp WL-I Sta. 5+90 to 8+19 Rt.
Install Metal Guard Rail, Type 3
Single and Type 3 Thrie Beam
with Steel Post

Note:
Ramp WL-I Sta. 6+50 Lt.
Existing Highway Light
Mounted on New
Barrier Wall

Construct Concrete
Barrier End Post.
For Details, See Sht. No. 3

Ramp WL-I Sta. 7+35.39 to 10+05 Lt.
Install Metal Guard Rail, Type 3
Single and Type 3 Thrie Beam
with Steel Post

RAMP (WL-I)

Connect to Conc. End Post
with Special End Shoe
Connection. For Details,
See Sht. No. 25

RAMP (T)

Meter No. 3355409HO9
Service No. 722-11461
Saw Cut Existing
Pavement, Curb &
Gutter and Sidewalk

Remove Existing
Guard Rail
Adjust Water Manholes

Connect to Existing
Conc. End Post with
Type "MS-6A" Connection
See Sht. No. 103 for Details

INBOUND

LANES

OUTBOUND

Connect to Existing
Conc. Wall with
Terminal Connector
For Details, See Sht. No. 24

Construct Concrete
Barrier Type 4F

New Metal Guard
Rail with Steel Post

Remove Existing
Metal Guard Rail

Existing Curb and
Gutter to remain

Remove Existing A.C. Pavement as
required. (Existing pavement
thickness 4")

TYPICAL SECTION RAMP WL-I

Scale: 1/4" = 1'-0"

Ramp WL-O Sta. 6+32 to 8+42 Rt.
Install Metal Guard Rail, Type 3
Single and Type 3 Thrie Beam
with Steel Post.

Ramp WL-O Sta. 4+70 to 7+57 Lt.
Install Metal Guard Rail, Type 3
Single with Steel Post

Ramp WL-O Sta. 8+40 to 8+75 Lt.
Construct New End Block W/Chain
Link Fence. For Details, See Sht. No. 24

Ramp WL-O Sta. 8+78 to 11+20 Rt.
Modify Bridge Railings and Repair
Wall Expansion Joint. For Details,
See Sht. No. 24

Ramp WL-O Sta. 4+65 Lt.

Relocate Existing Type III WM Box and Meter, and
Type B Meter Box and Valve. Meter No. 21801935.
Service No. 722-115112. (Work to be done by Contractor).

Delete
Core Area at Old Waialae Rd. & Ramp WL-O
Remove Existing Curb, Curb & Gutter
and Conc. Island.
Pave Hatched Area with 2" Asphalt
Concrete Pavement Mix No. IV 8" Aggregate
Base Course and 6" Aggregate Subbase

CURVE DATA		
	WL-I-1	WL-I-81
Δ	54° 11' 11"	54° 11' 11"
R	150.00'	174.23'
T	76.74'	89.13'
L	141.86'	164.78'

For Concrete End Post
and 6' Chain Link Fence
Details, See Sht. No. 21

Construct Conc.
End Post. For Details, See Sht. No. 21

Install 6'
Chain Link Fence

APPROVED:
DATE 4-4-83
R. Nagato
for CHIEF, PLANNING & ENGINEERING, BWS

STATE OF HAWAII
DEPARTMENT OF TRANSPORTATION
LAND TRANSPORTATION FACILITIES DIVISION
PLAN
RAMP WL-I & RAMP WL-O
INTERSTATE ROUTE H-1
SAFETY IMPROVEMENTS
KALO LANE TO AINAKOA AVE.
F.A.I. PROJECT NO. 1R-HI-1 (184)
SCALE: 1" = 20' Date: March, 1983
SHEET NO. OF SHEETS

FED. ROAD DIST. NO.	STATE	FED. AID PROJ. NO.	FISCAL YEAR	SHEET NO.	TOTAL SHEETS
HAWAII	HAW.	IR-HI-1(184)	1984	8	114

Ramp WL-I Sta. 5+60 to 6+25 Lt.
Construct Concrete Barrier, Type 4E

Ramp WL-I Sta. 6+25 to 7+35.39 Lt.
Construct Concrete Barrier, Type 4F

For Type 4E and Type 4F
Concrete Barrier Details,
See Sht. No. 9

Install 6' Chain Link Fence
End Post. Notch Concrete
Barrier Footing to Construct
Fence Footing.

Remove Existing
Chain Link Fence

Ramp WL-I Sta. 5+90 to 6+18 Rt.
Install Metal Guard Rail, Type 3
Single and Type 3 Thrie Beam
with Steel Post

Ramp WL-I Sta. 7+35.39 to 10+05 Lt.
Install Metal Guard Rail, Type 3
Single and Type 3 Thrie Beam
with Steel Post

Ramp WL-I
Sta. 9+13.47
to 9+13.47

Construct Concrete
Barrier End Post.
For Details, See Sht. No. 9

Thrie Beam-44 L.F.

RAMP (WL-I)

Connect to Conc. End Post
with Special End Shoe
Connection. For Details,
See Sht. No. 25

Connect to Conc.
End Post with
Terminal Connector

Install BCT

LANES

INBOUND

LANES

OUTBOUND

Connect to Existing
Conc. Wall with
Terminal Connector
For Details, See Sht. No. 24

Construct Concrete
Barrier Type 4F

New Metal Guard
Rail with Steel Post

Remove Existing
Metal Guard Rail

Existing Curb and
Gutter to remain

Remove Existing A.C. Pavement as
required. (Existing pavement
thickness 4")

Asphalt Concrete
Pavement, Mix No. I

Remove Existing
Concrete Curb

Remove Existing
Metal Guard Rail

TYPICAL SECTION RAMP WL-I

Scale: 1/4" = 1'-0"

Ramp WL-O Sta. 6+32 to 8+42 Rt.
Install Metal Guard Rail, Type 3
Single and Type 3 Thrie Beam
with Steel Post.

Ramp WL-O Sta. 4+70 to 7+57 Lt.
Install Metal Guard Rail, Type 3
Single with Steel Post

Ramp WL-O Sta. 4+65 Lt.

Relocate Existing Type III WM Box and Meter, and
Type B Meter Box and Valve, Meter No. 21801935.
Service No. 722-115112. (Work to be done by Contractor).

Ramp WL-O Sta. 8+40 to 8+75 Rt.
Construct New End Block W/Chain
Link Fence. For Details, See Sht. No. 24

Ramp WL-O Sta. 8+75 to 11+20 Rt.
Modify Bridge Railings and Repair
Wall Expansion Joint. For Details,
See Sht. No. 24

APPROVED:
DATE 4-4-82
R. Nagata
for CHIEF, PLANNING & ENGINEERING, BWS

STATE OF HAWAII
DEPARTMENT OF TRANSPORTATION
LAND TRANSPORTATION FACILITIES DIVISION
PLAN
RAMP WL-I & RAMP WL-O
INTERSTATE ROUTE H-1
SAFETY IMPROVEMENTS
KALO LANE TO AINAKOA AVE.
F.A.I. PROJECT NO. IR-HI-1(184)
SCALE: 1" = 20'
SHEET NO. 8 OF 8 SHEETS

CURVE DATA		
	WL-I-1	WL-I-B1
Δ	54° 11' 11"	54° 11' 11"
R	150.00'	174.23'
T	76.74'	89.13'
L	141.86'	164.78'

Gore Area at Old Wai'alae Rd & Ramp WL-O

Remove Existing Curb, Curb & Gutter
and Conc. Island.
Pave Hatched Area with 2 1/2" Asphalt
Concrete Pavement Mix No. II, 8" Aggregate
Base Course and 6" Aggregate Subbase

For Concrete End Post
and 6' Chain Link Fence
Details, See Sht. No. 21

Construct Conc.
End Post. For Details, See Sht. No. 21

Install 6'
Chain Link Fence

Remove Existing Guard Rail
Provide 10' Curb
Ramp Down

Connect to Conc. End
Post with Type "X"
Connection. See Sht. No. 103
for Details

Begin Paving

Adjust Water Manholes

Remove Existing
Guard Rail

Connect to Existing
Conc. End Post with
Type "MS-6A" Connection
See Sht. No. 103 for Details

Connect to Conc.
End Post with
Terminal Connector

Connect to Conc.
End Post with
Terminal Connector

10' Transition

10' Transition


10' Transition

10' Transition


10' Transition

10' Transition

FED. ROAD DIST. NO.	STATE	FED. AID PROJ. NO.	FISCAL YEAR	SHEET NO.	TOTAL SHEETS
HAWAII	HAW.	1R-H-1(184)	1984	9	114

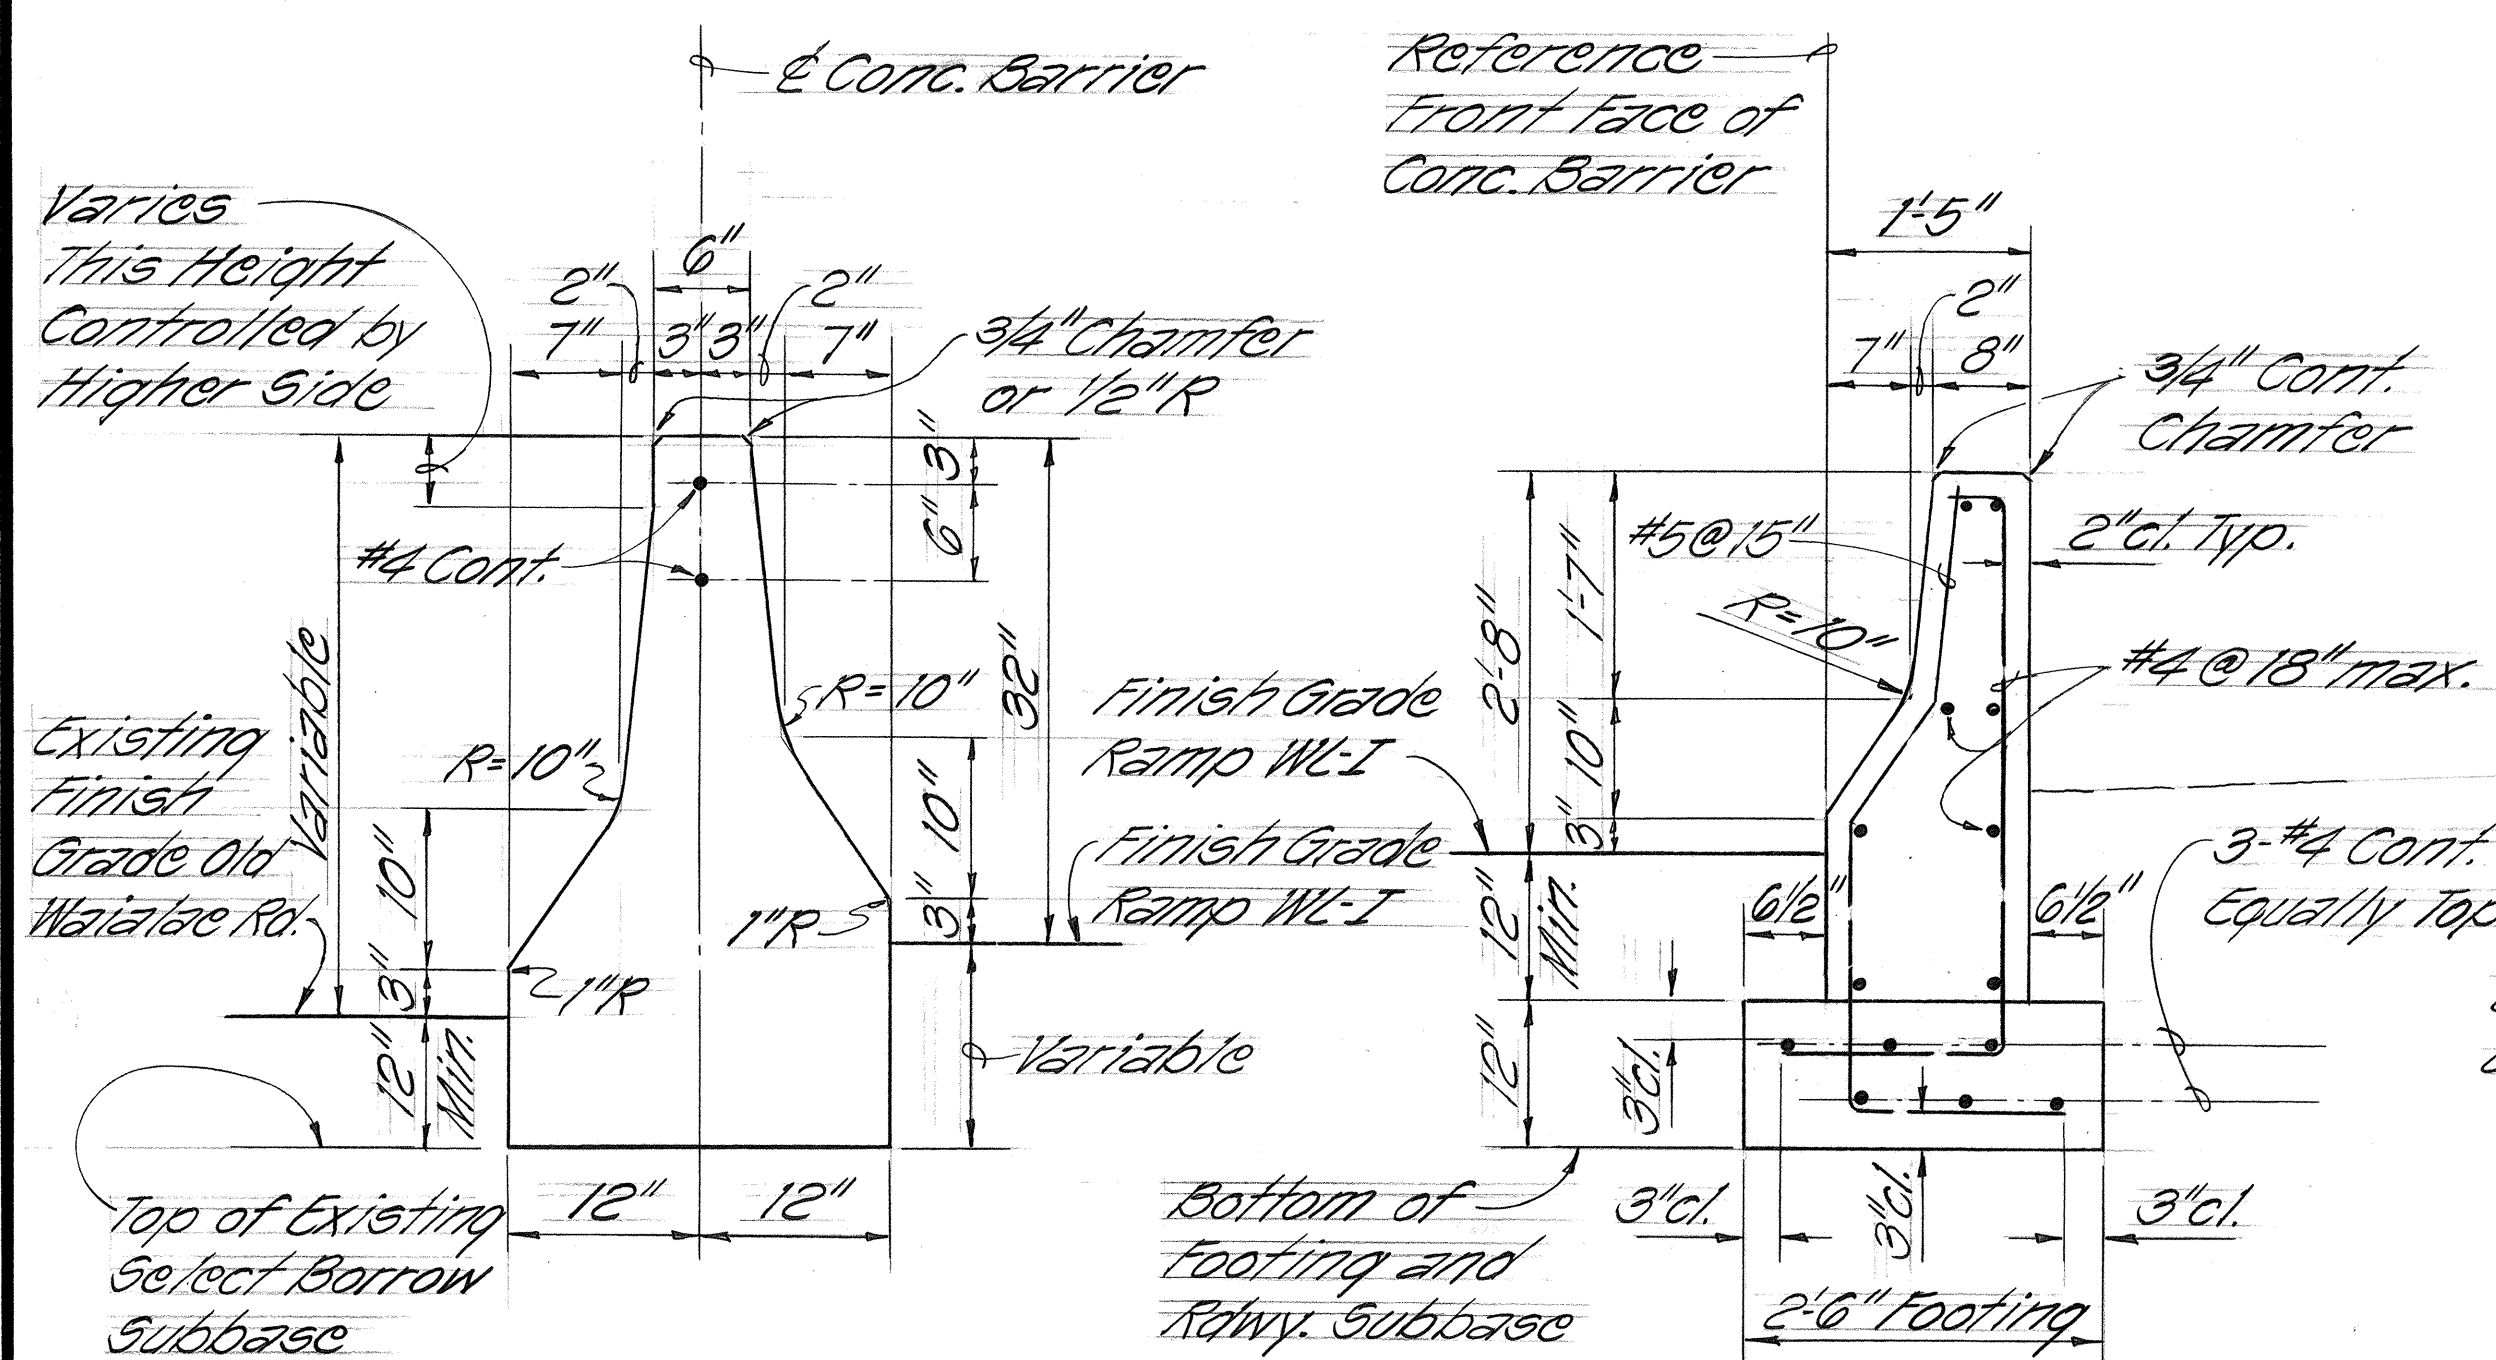


**TYPE 4E
CONCRETE BARRIER**
Scale: 1"=1'-0"

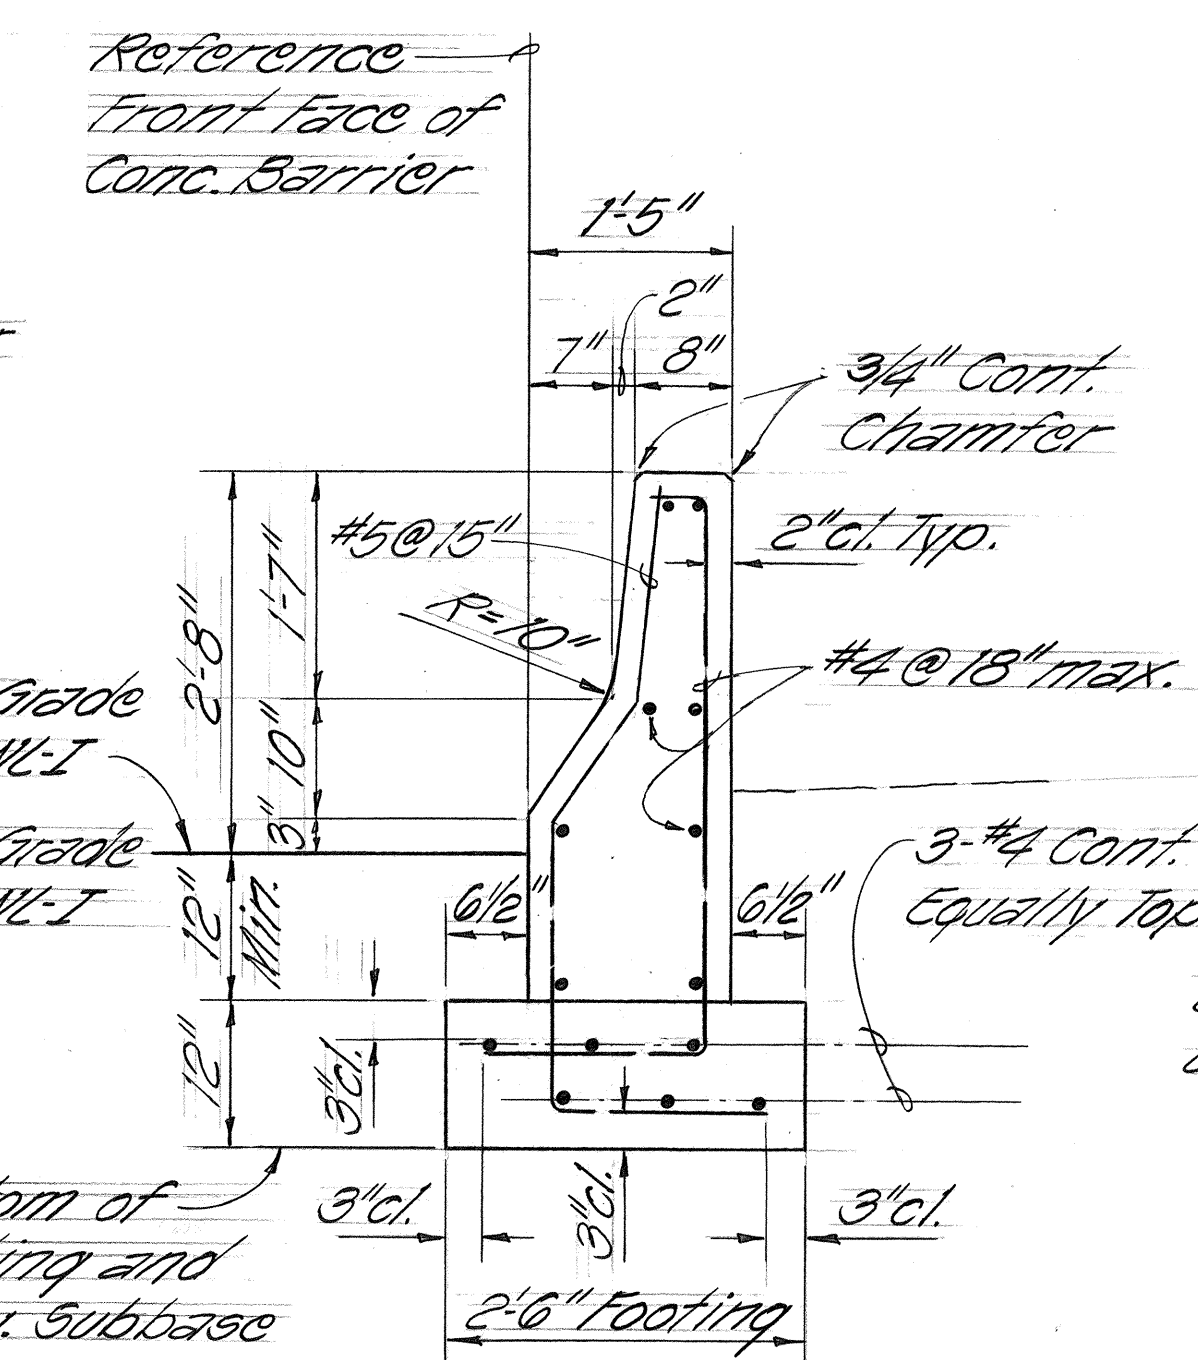


**TYPE 4F
CONCRETE BARRIER**

- NOTES: Scale: 3/4"=1'-0"
1. All anchor bolts shall be high strength bolts conforming to the requirements of ASTM A 325.
 2. Anchor bolt length given from under bolt head.
 3. All anchor bolts, nuts and washers, shall be galvanized.

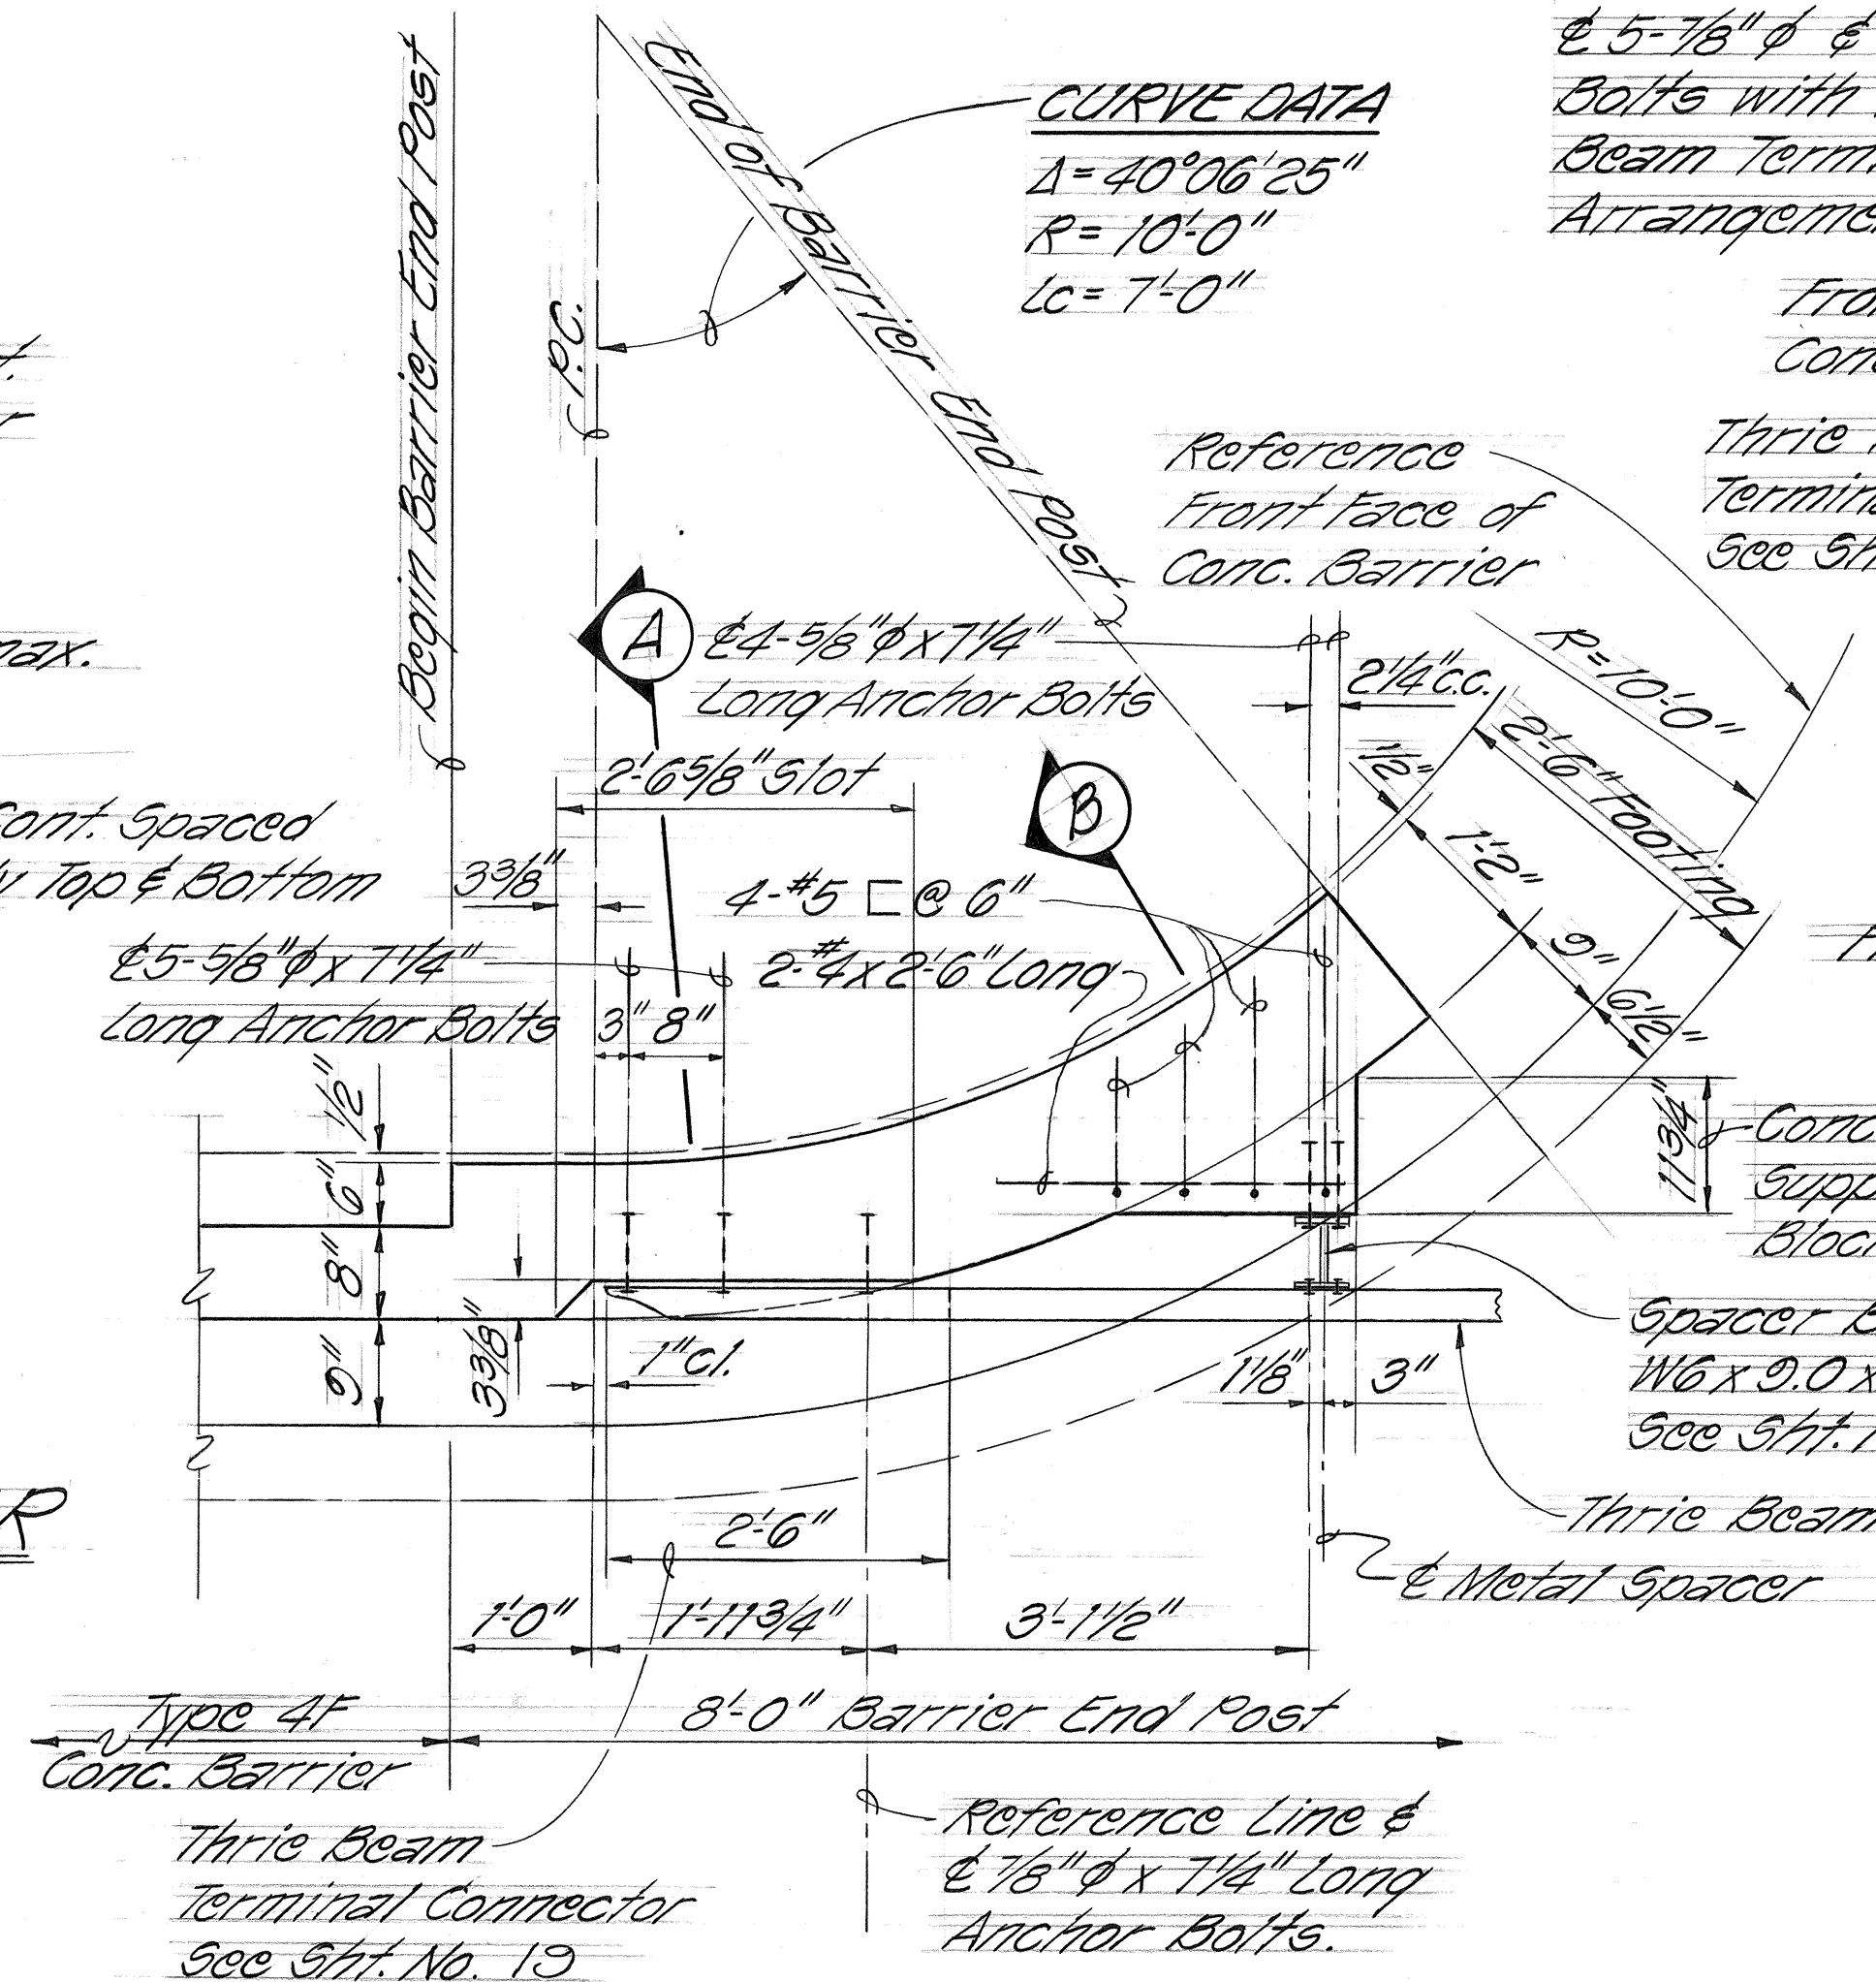

CONCRETE BARRIER END POST PLAN
Scale: 3/4"=1'-0"


CURVE DATA
A=40°06'25"
R=10'-0"
Lc=7'-0"

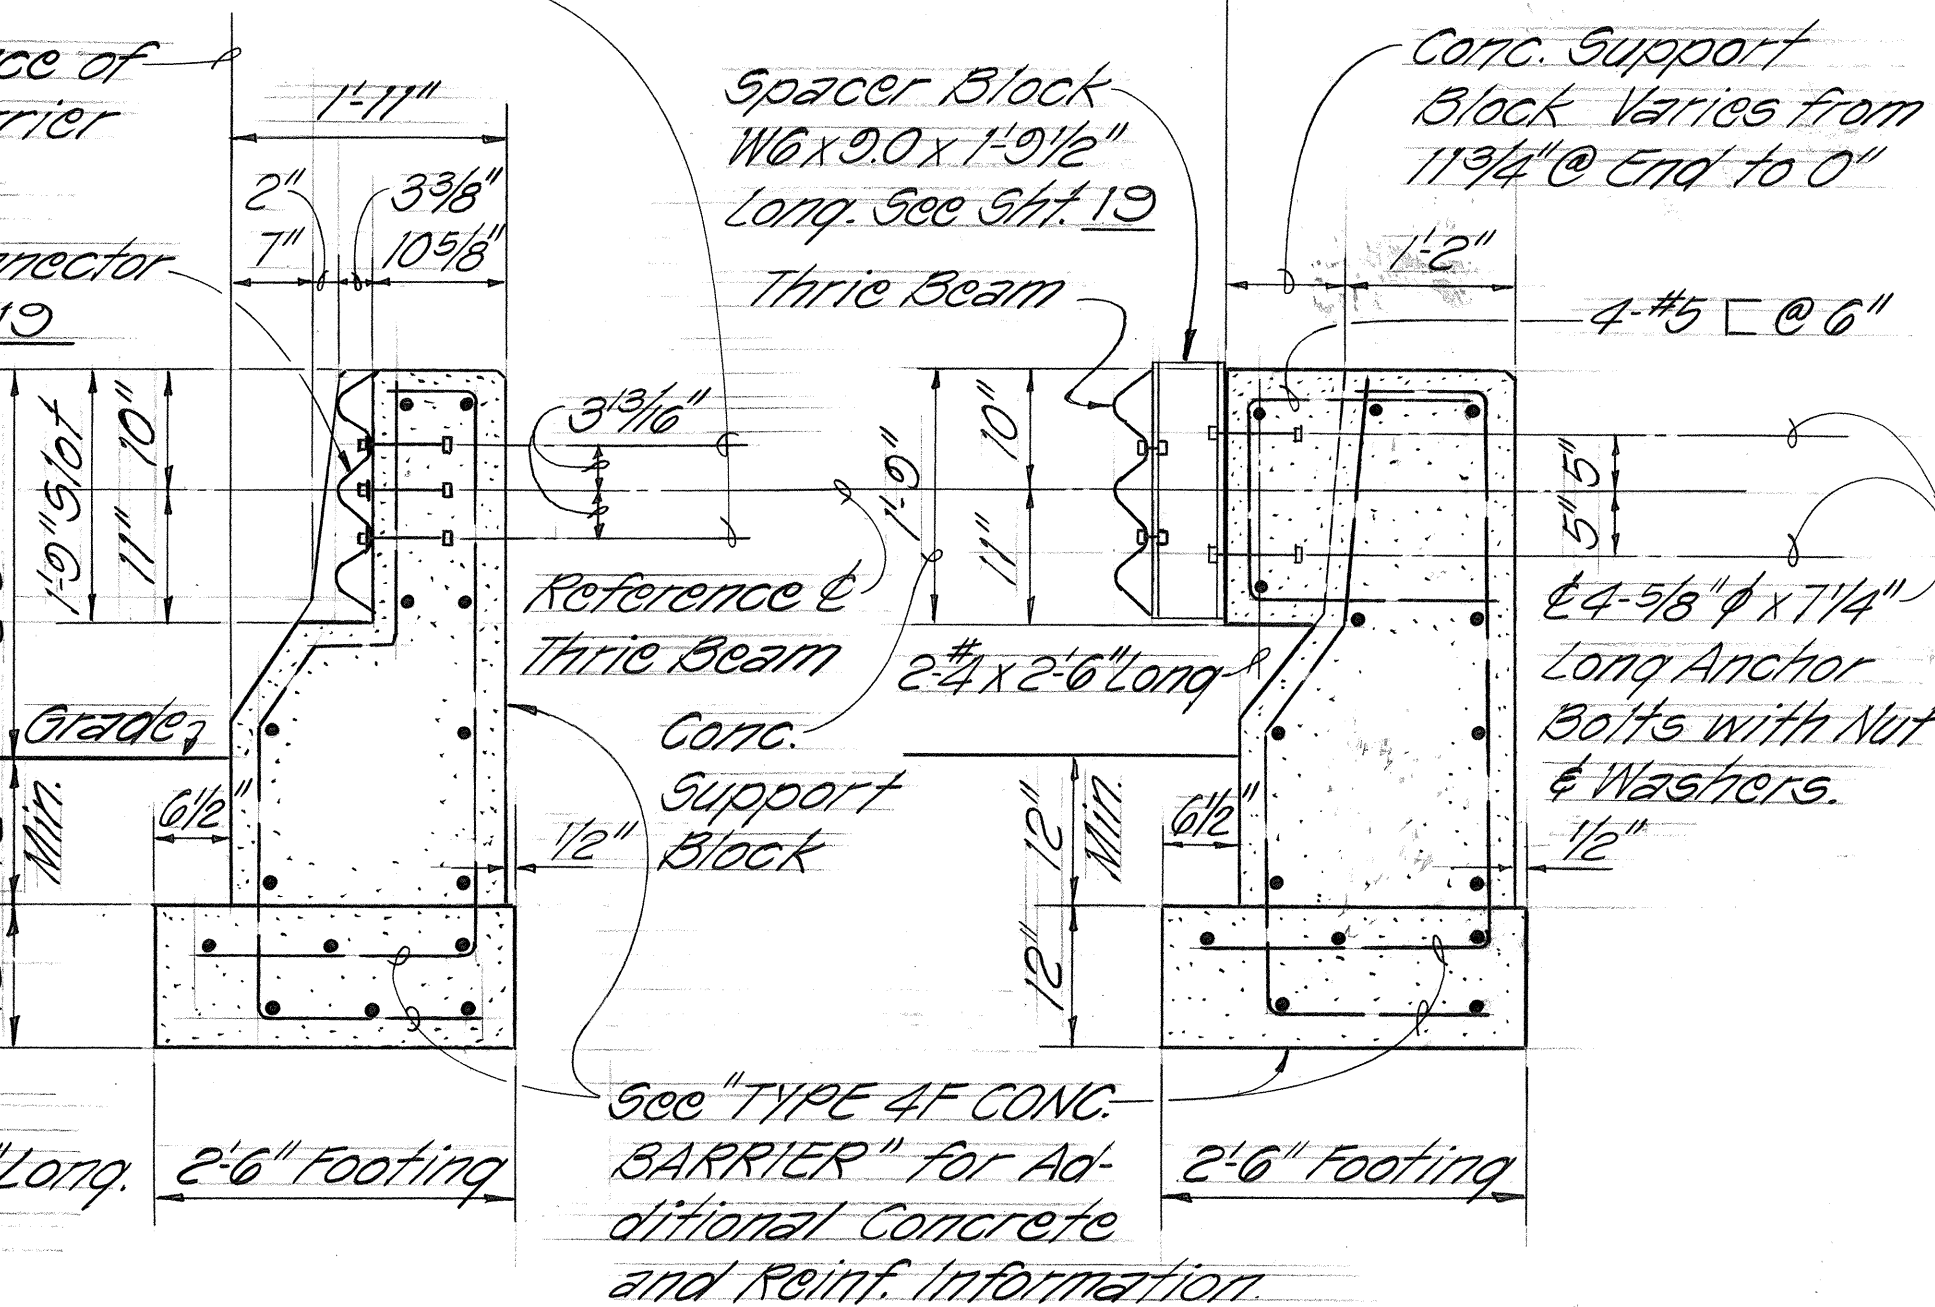

SECTION A
Scale: 3/4"=1'-0"

SECTION B
Scale: 3/4"=1'-0"

NOTE: For Expansion and Construction Joint Details see "Standard Details Guard Rail, Type 4 (Rigid Barrier)".

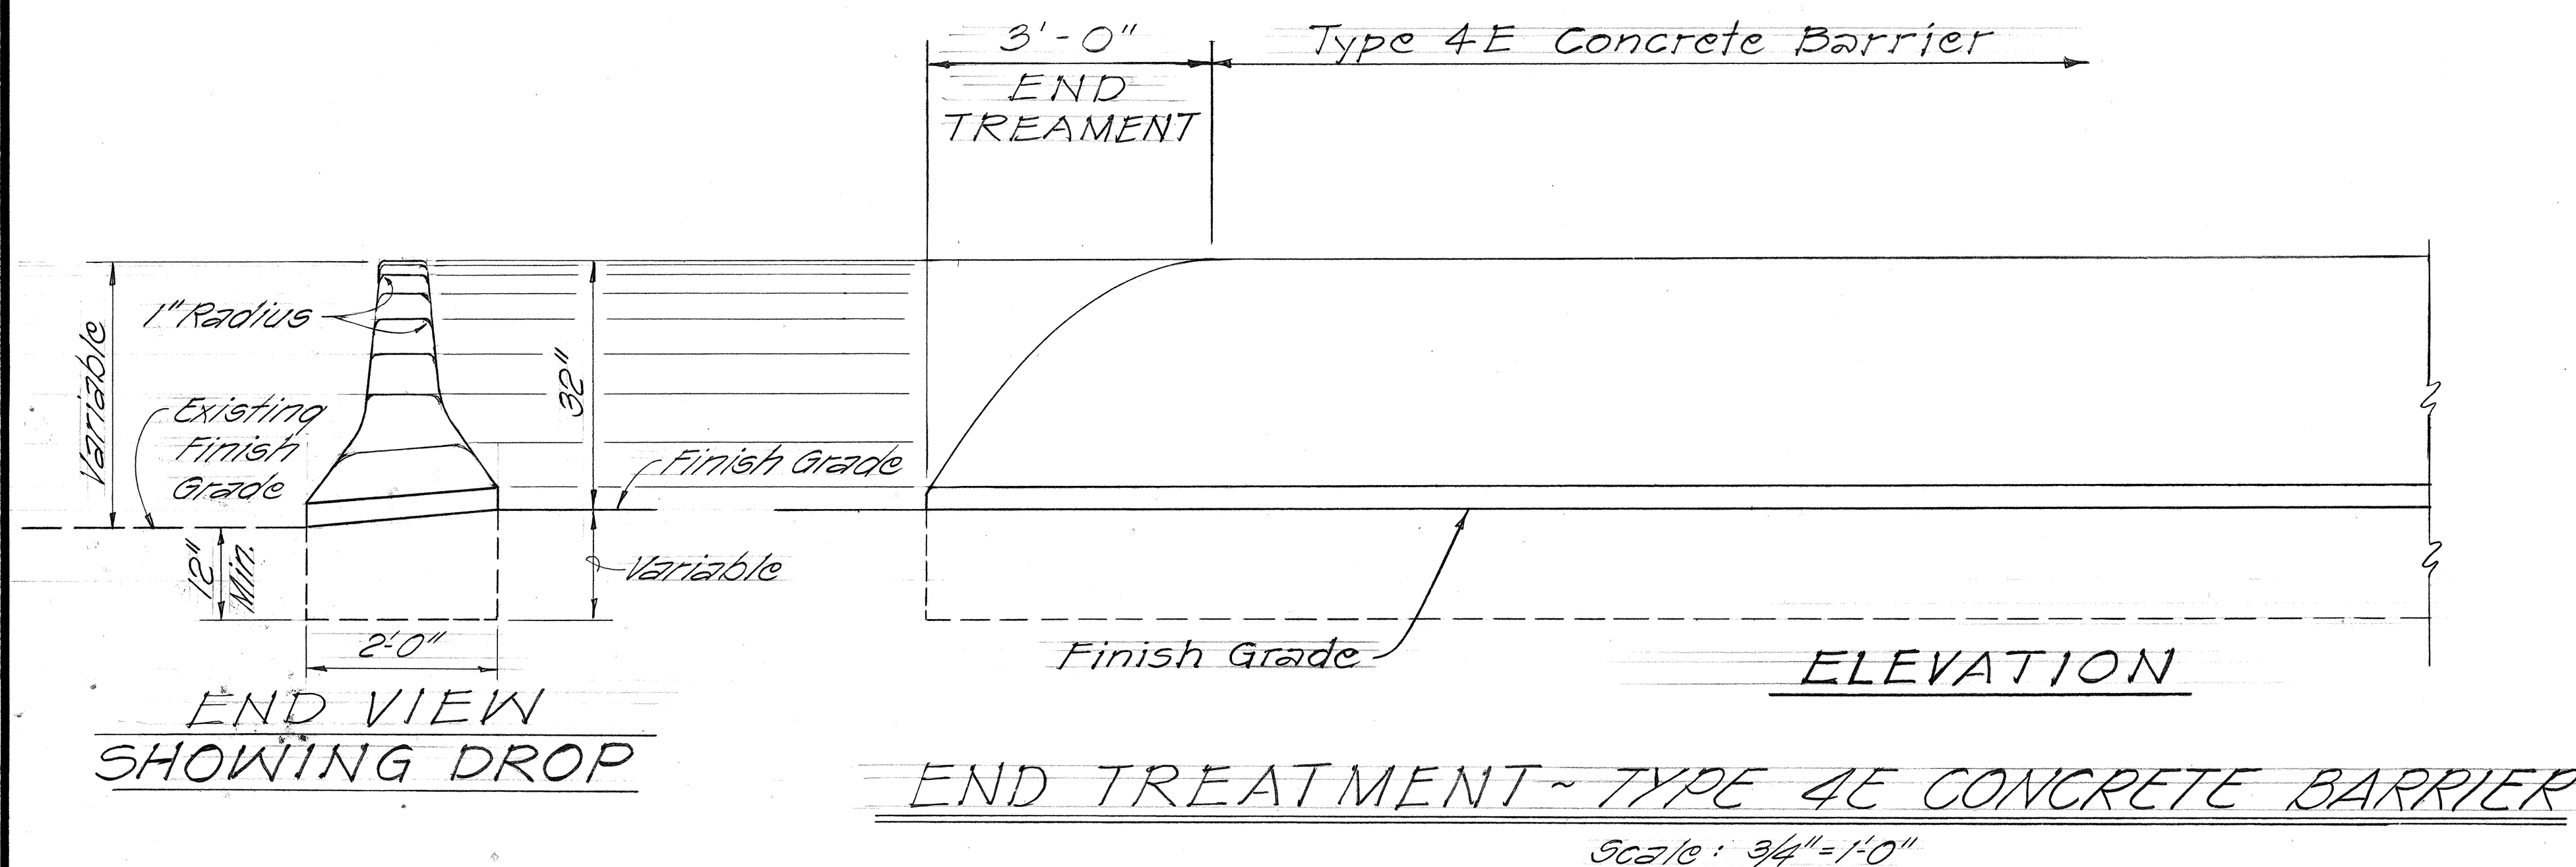

**END VIEW
SHOWING DROP**

END TREATMENT - TYPE 4E CONCRETE BARRIER
Scale: 3/4"=1'-0"

STATE OF HAWAII DEPARTMENT OF TRANSPORTATION LAND TRANSPORTATION FACILITIES DIVISION	
GUARD RAIL, TYPE 4E & 4F	
RAMP WL-1 & RAMP WL-0	
INTERSTATE ROUTE H-1	
SAFETY IMPROVEMENTS	
KALO LANE TO AINAKOA AVE.	
F.A.I. PROJECT NO. 1R-H-1(184)	
Scale: As Shown	Sept. 1983
SHEET NO.	OF SHEETS