



FED. ROAD DIST. NO.	STATE	FED. AID PROJ. NO.	FISCAL YEAR	SHEET NO.	TOTAL SHEETS
HAWAII	HAW.	IR-HI-1(184)	1984	2	114

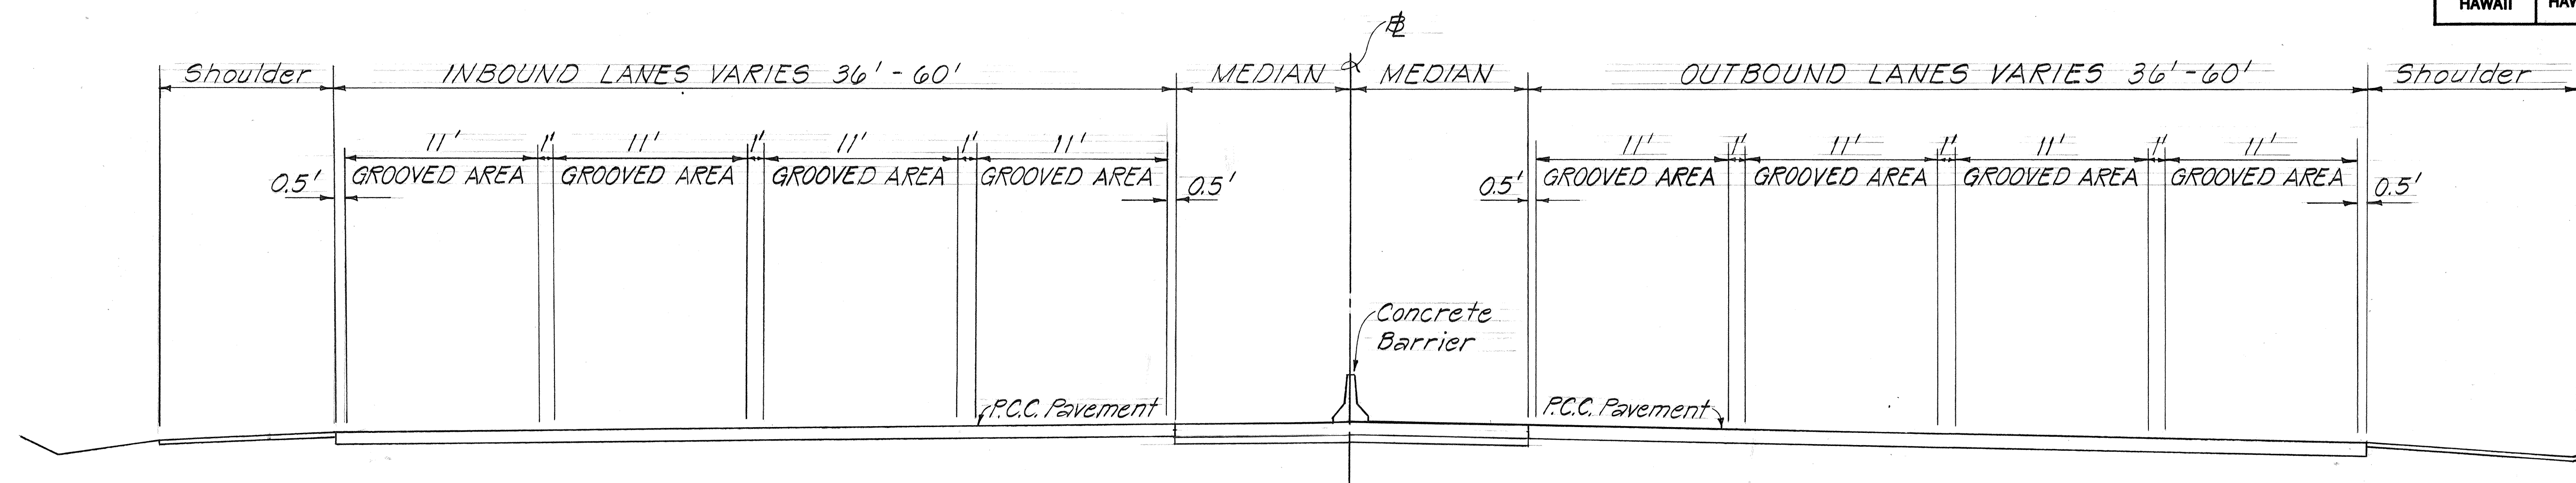

TYPICAL PAVEMENT GROOVING DETAIL

Scale: 3/16" = 1'-0"



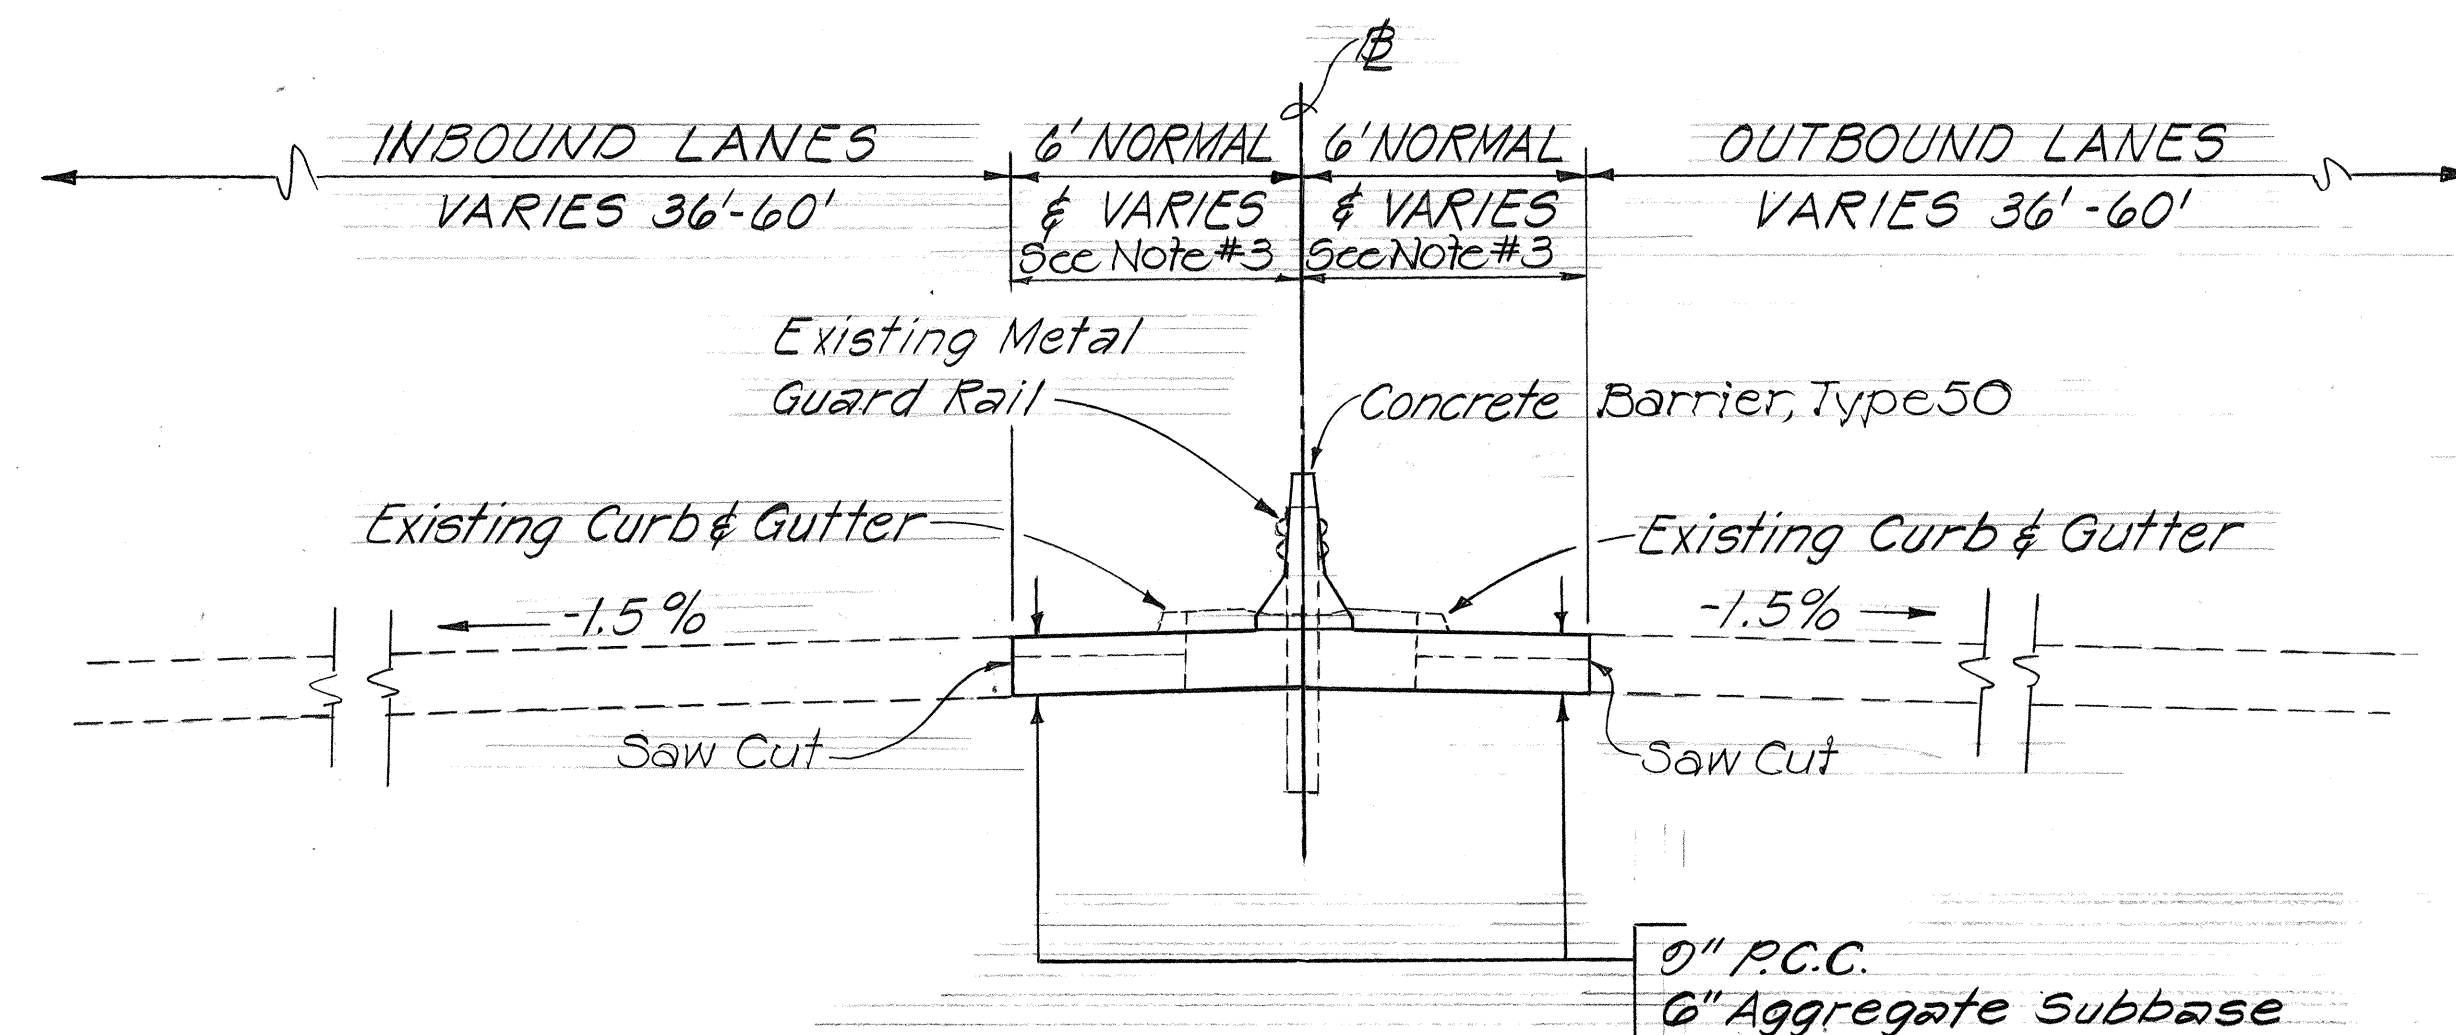


TYPICAL TANGENT SECTION

Scale: 1/4" = 1'-0"

NOTE:

1. Installing Metal Guard Rail Post on Catch Basin (Plan Sheet No. 100) and the removing of Existing Metal Guard Rails will not be paid for separately, but shall be considered to be incidental to Guard Rails.
2. Removing existing Median Curb and Gutter and Raised Median for the Construction of Type 50 and 50C Concrete Barrier shall be paid for by the Sq. Yd. under Item No. 203.0800, Roadway Excavation. Lower limit of payment shall be the subgrade.
3. From Sta. 72+75± to Sta. 82+00, Concrete Barrier shall vary 0' to 1' Offset Left from Baseline. The exact location will be determined in the field by the Engineer. From Sta. 82+00 to Sta. 101+24.28, Concrete Barrier shall be Offset 1' Left from $\pm$.

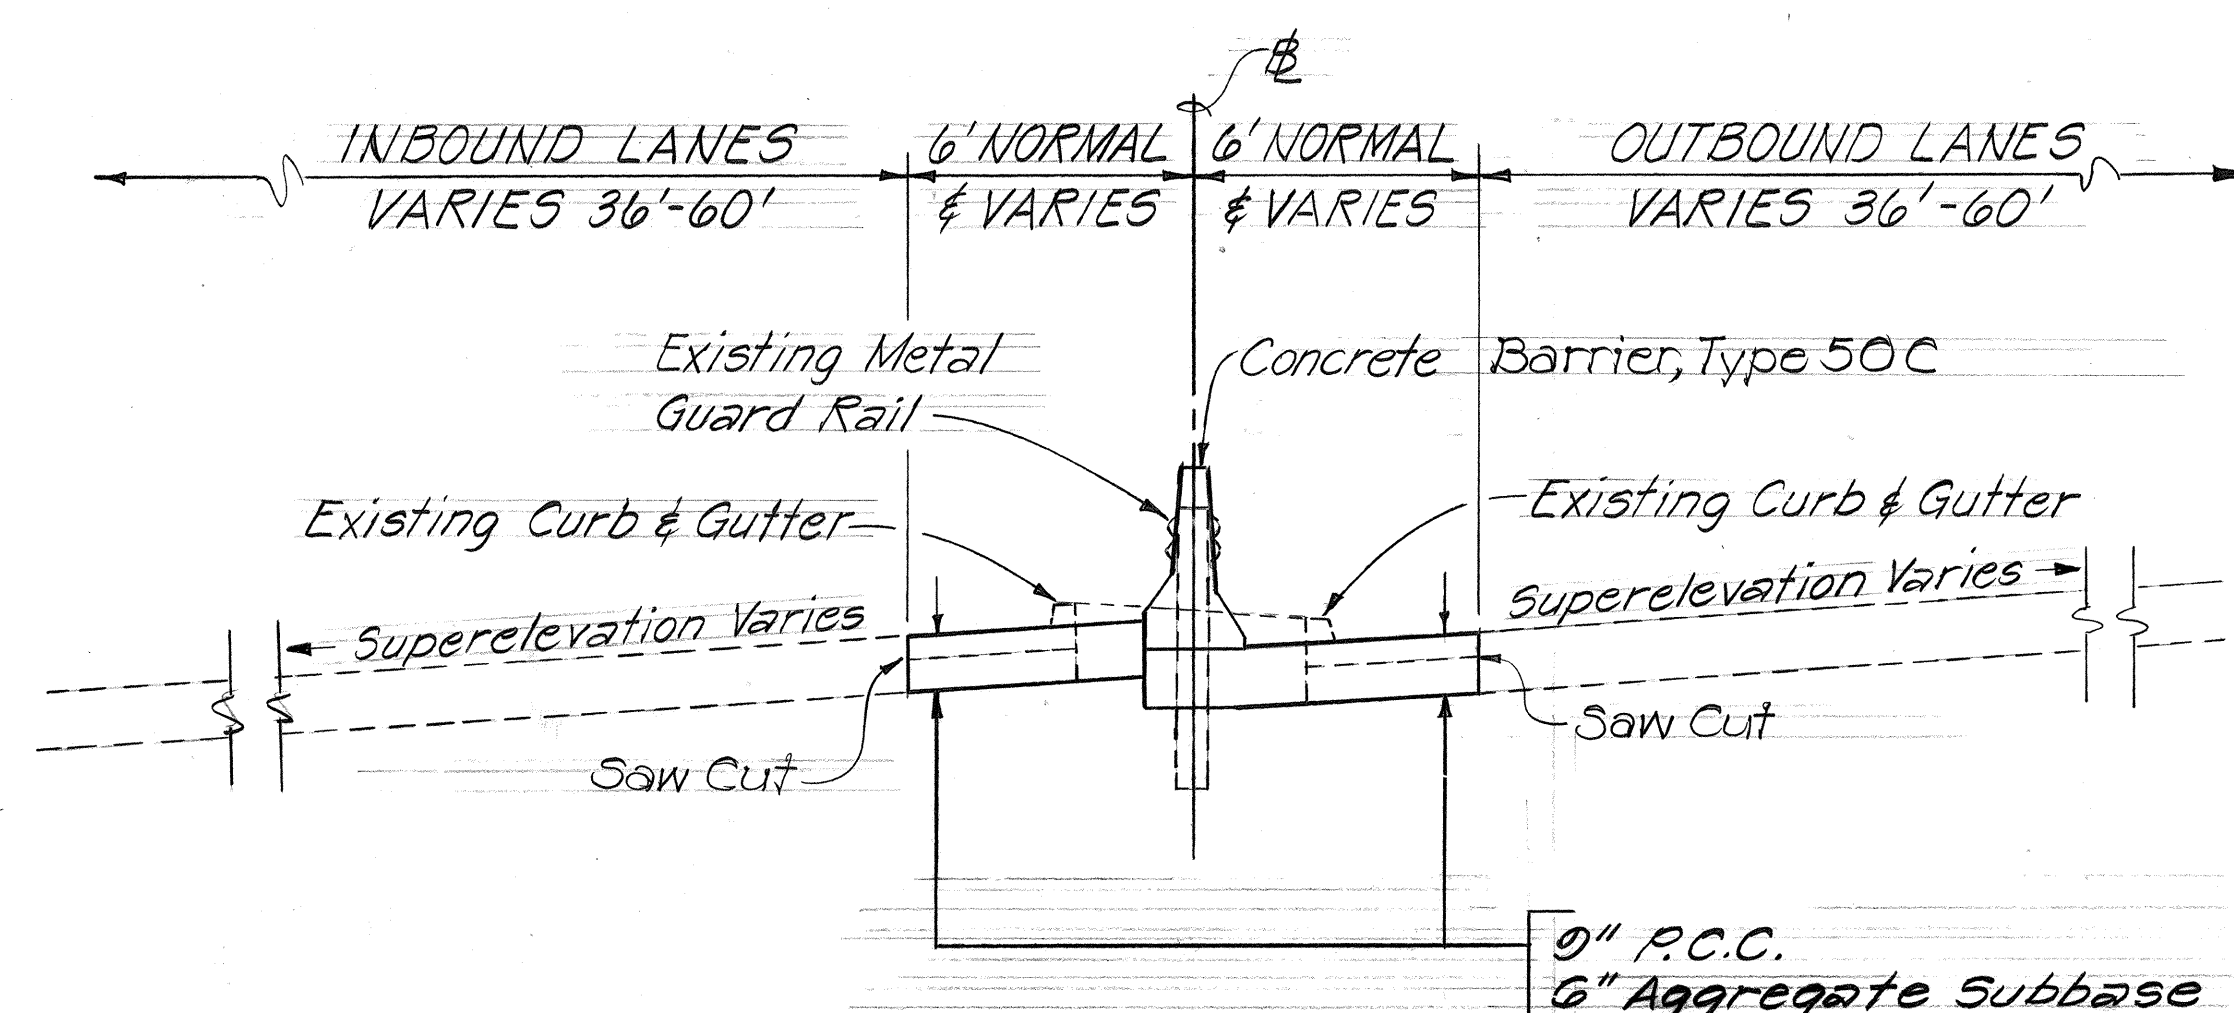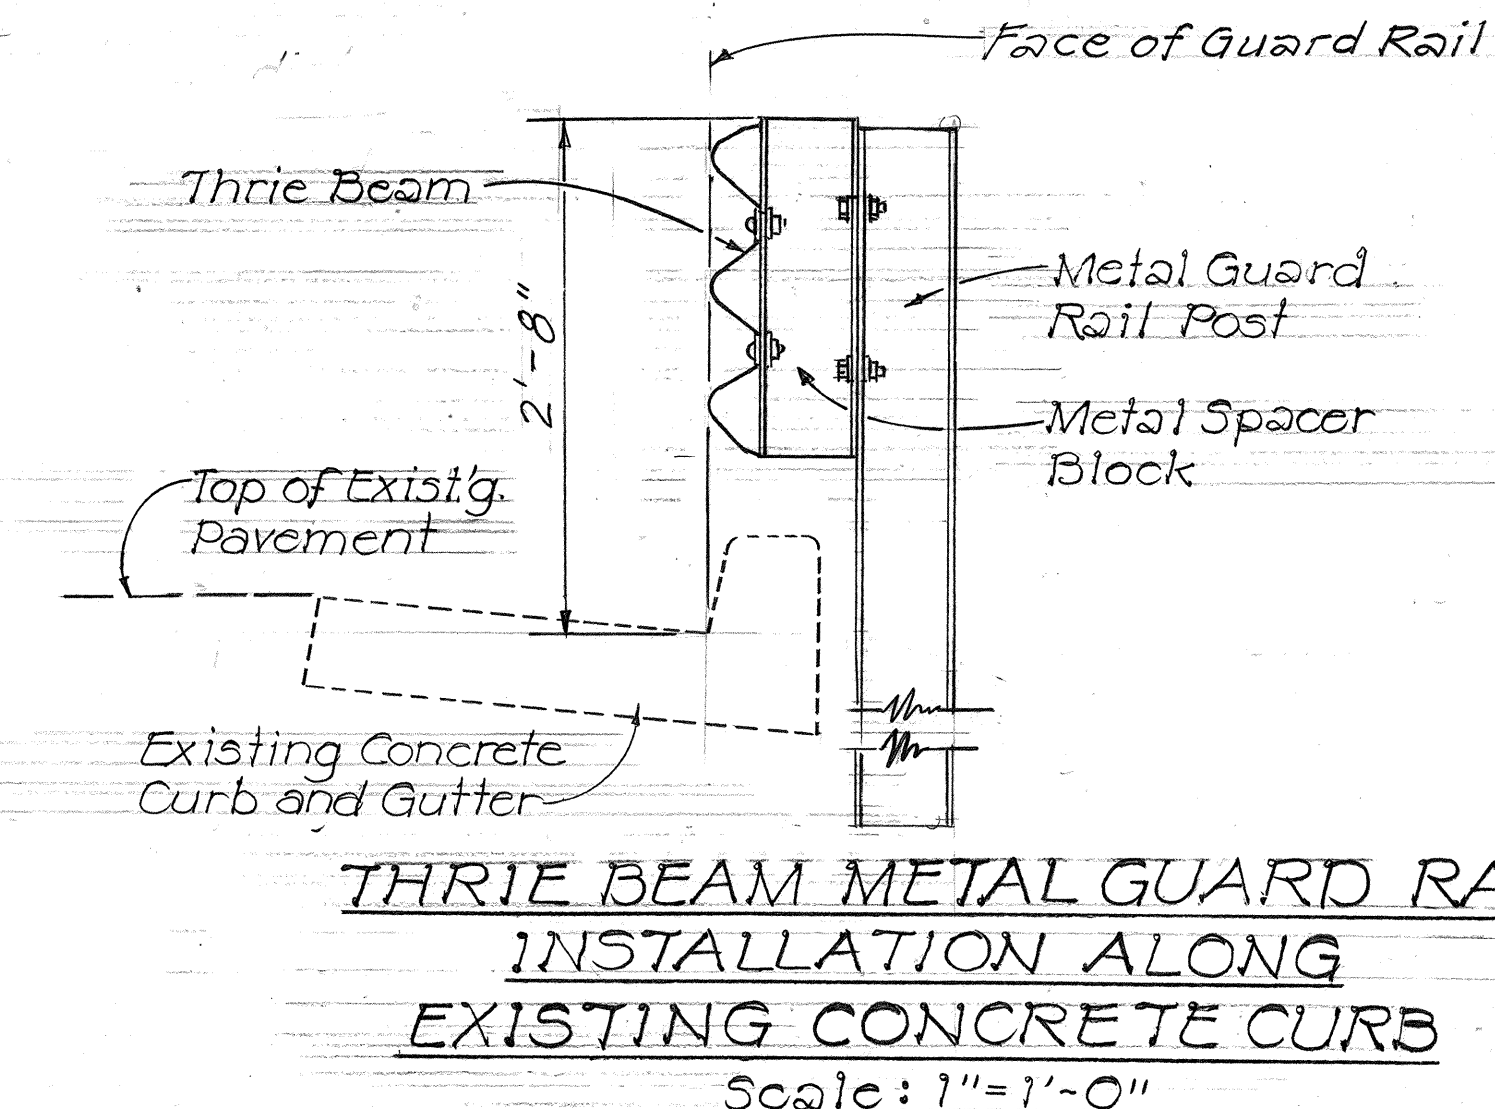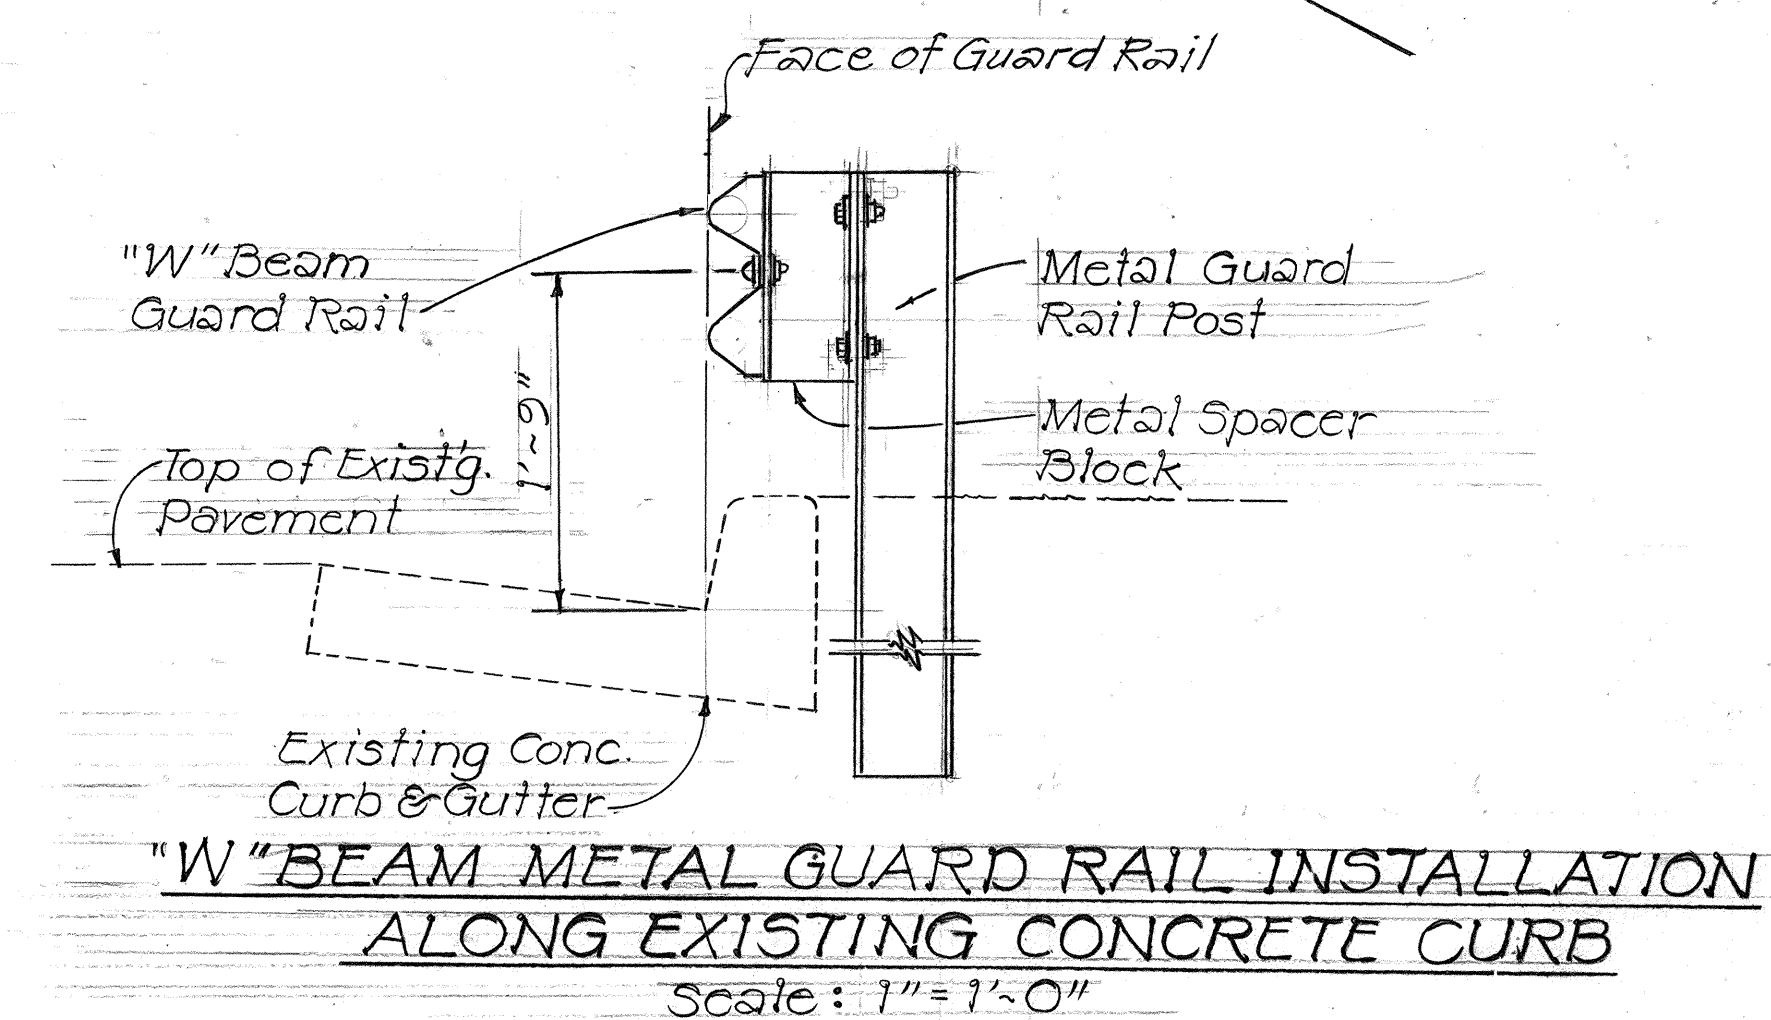

TYPICAL SUPERELEVATION SECTION

Scale: 1/4" = 1'-0"

2/6/84	Added Note 3, Revised Metal Guard Rail Typical, Typical Tangent Section and Notes 1 & 2
1/9/84	Added Notes, Revised Typical by adding "Saw Cut"
DATE	REVISION


STATE OF HAWAII
DEPARTMENT OF TRANSPORTATION
HIGHWAYS DIVISION

TYPICAL SECTIONS


INTERSTATE ROUTE H-1
SAFETY IMPROVEMENTS
KALO LANE TO AINAKOA AVE.
F.A.I. PROJECT NO. IR-HI-1(184)

SHEET NO. OF SHEETS


FED. ROAD DIST. NO.	STATE	FED. AID PROJ. NO.	FISCAL YEAR	SHEET NO.	TOTAL SHEETS
HAWAII	HAW.	IR-HI-1(184)	1984	3	114

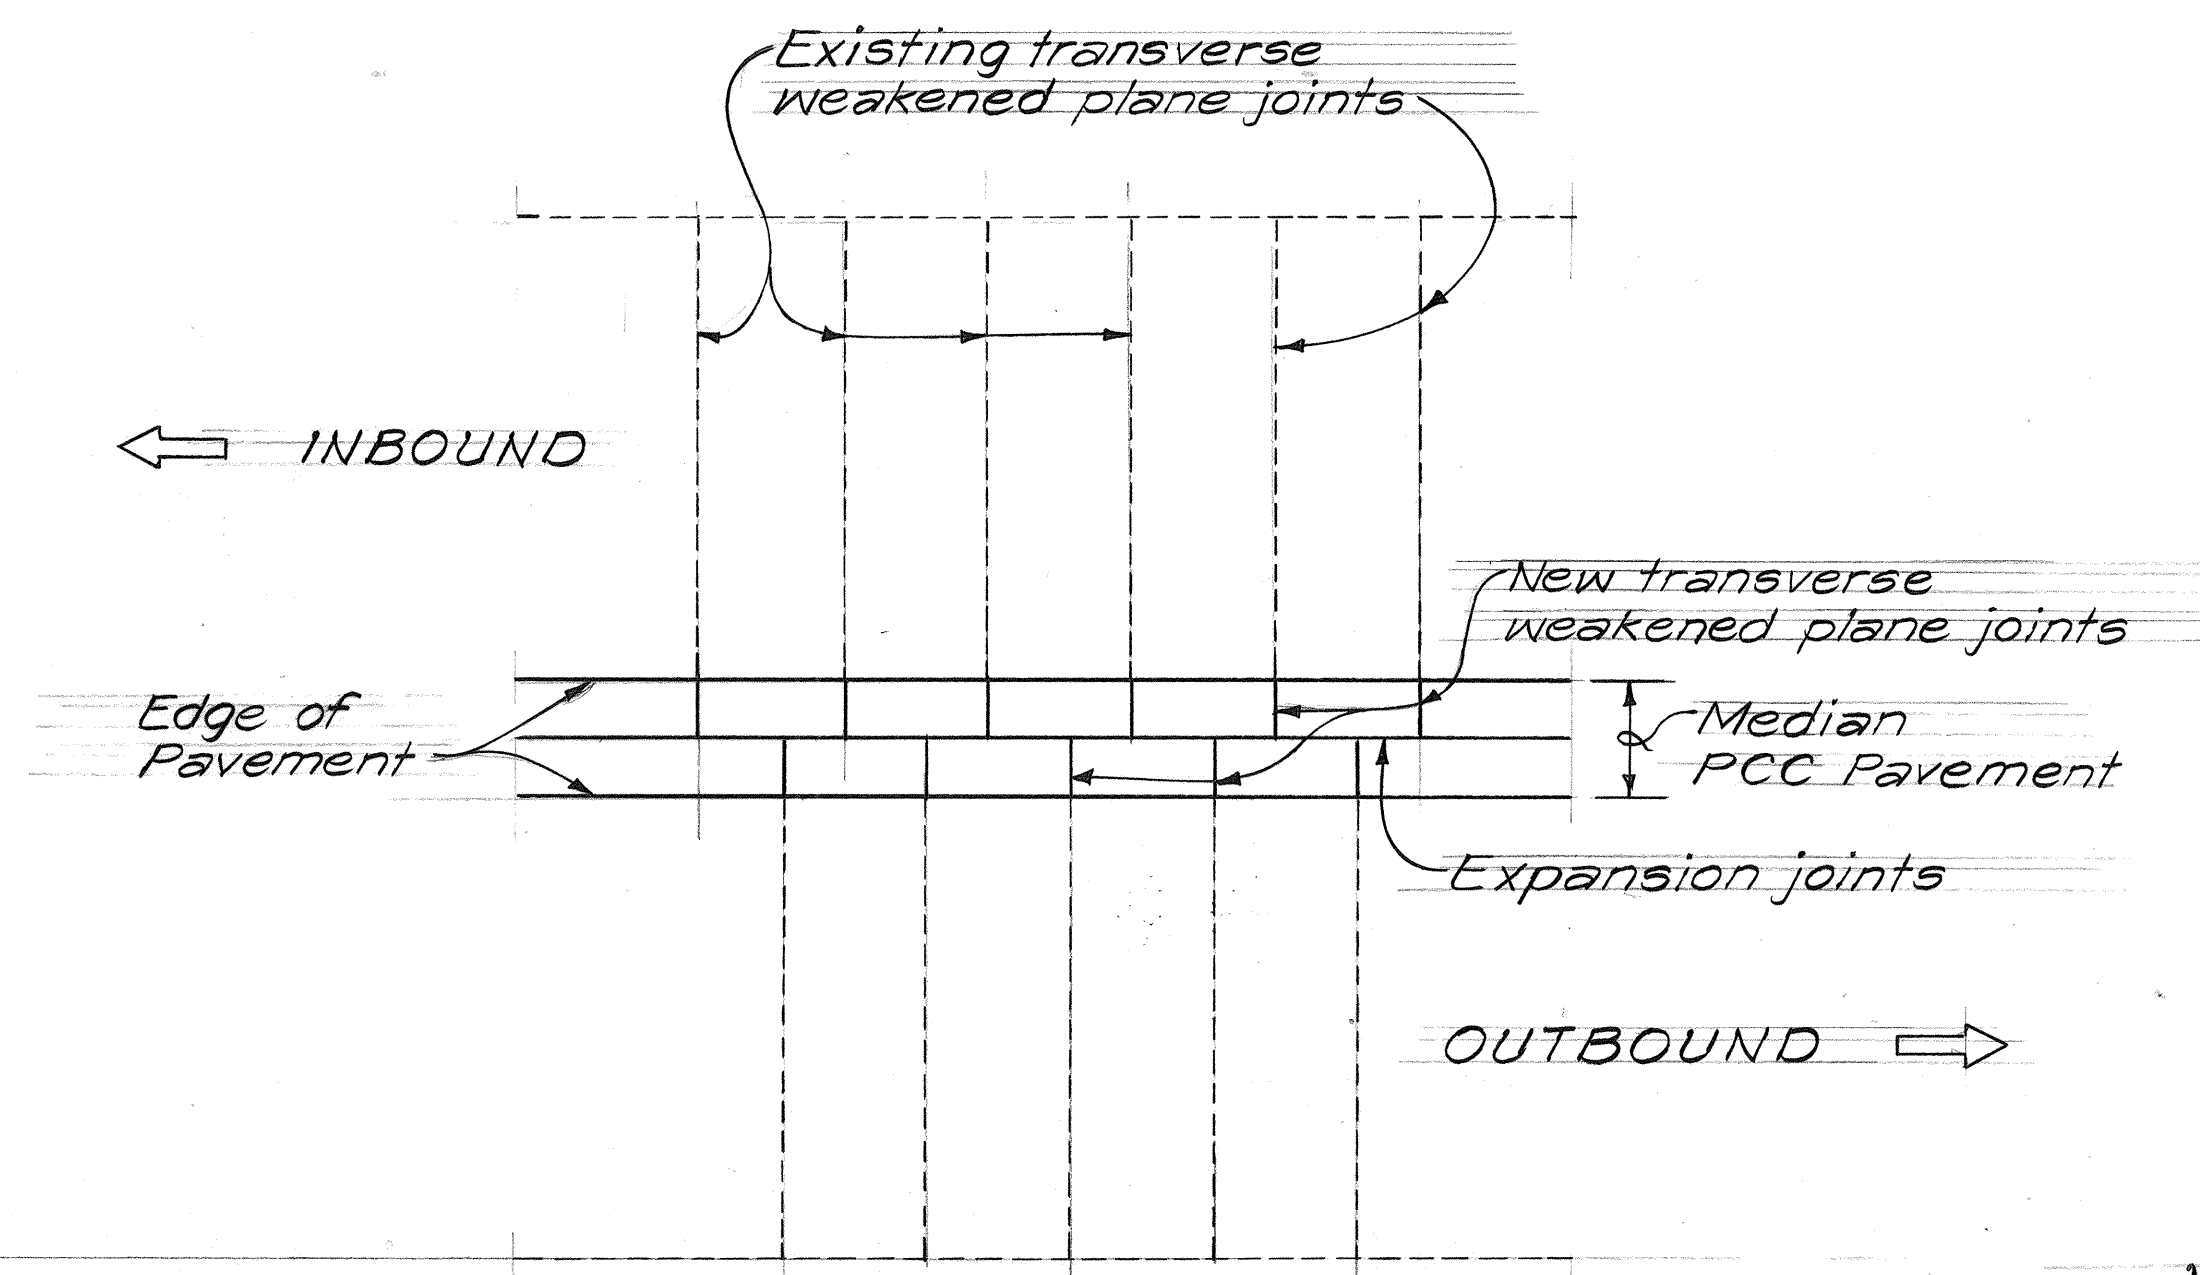


TYPICAL JOINT LOCATION AT MEDIAN
Scale: 1" = 20'

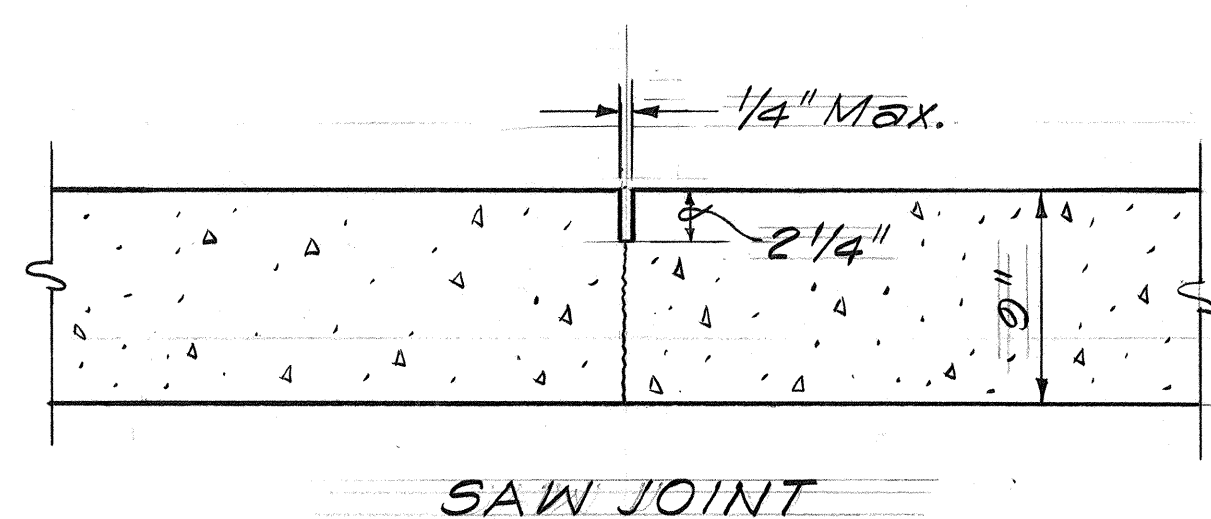


TRANSVERSE WEAKENED PLANE CONTRACTION JOINT
Scale: 1 1/2" = 1'-0"

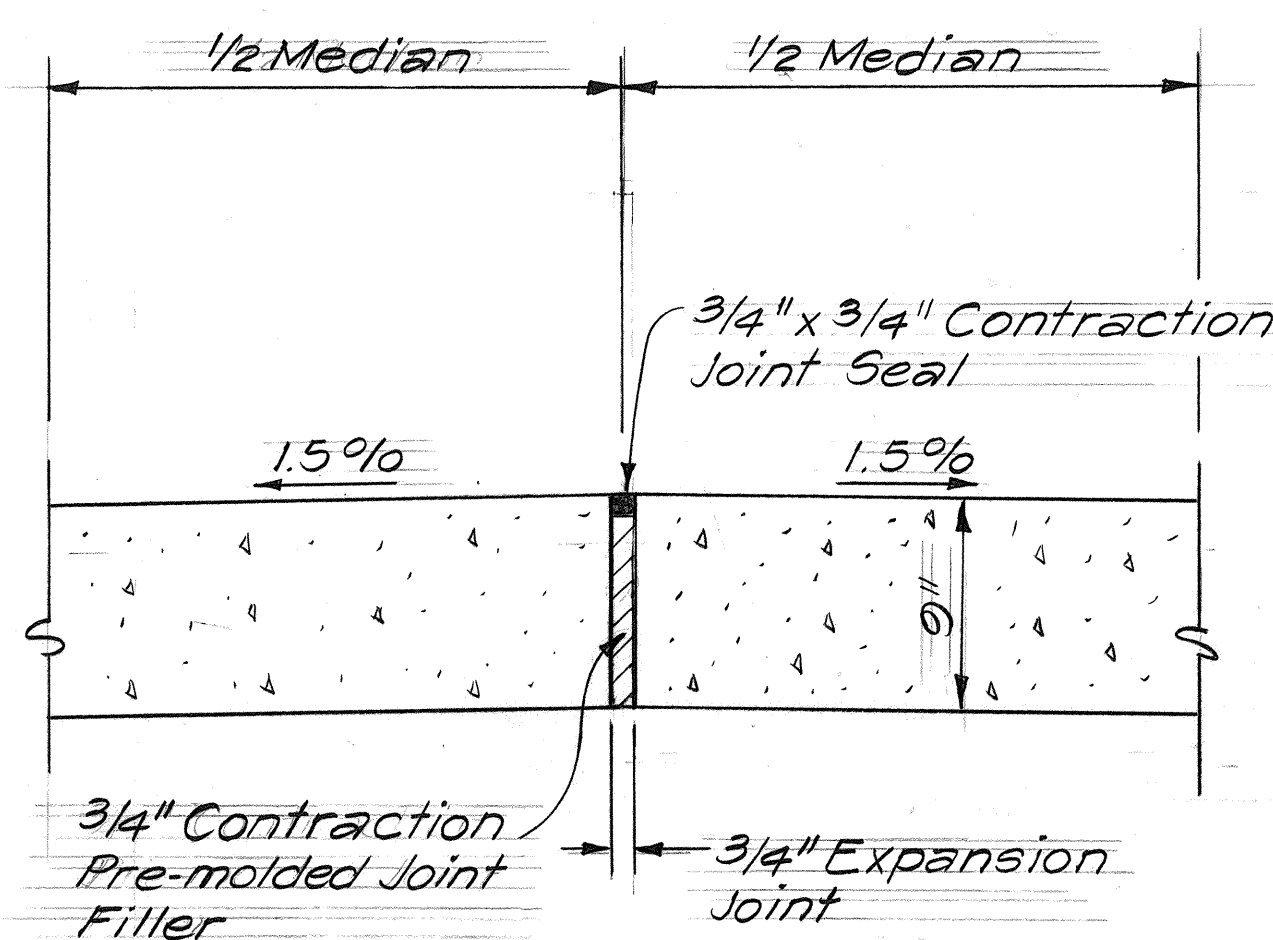

**EXPANSION JOINT DETAIL
MEDIAN - TANGENT SECTION**
Scale: 1 1/2" = 1'-0"

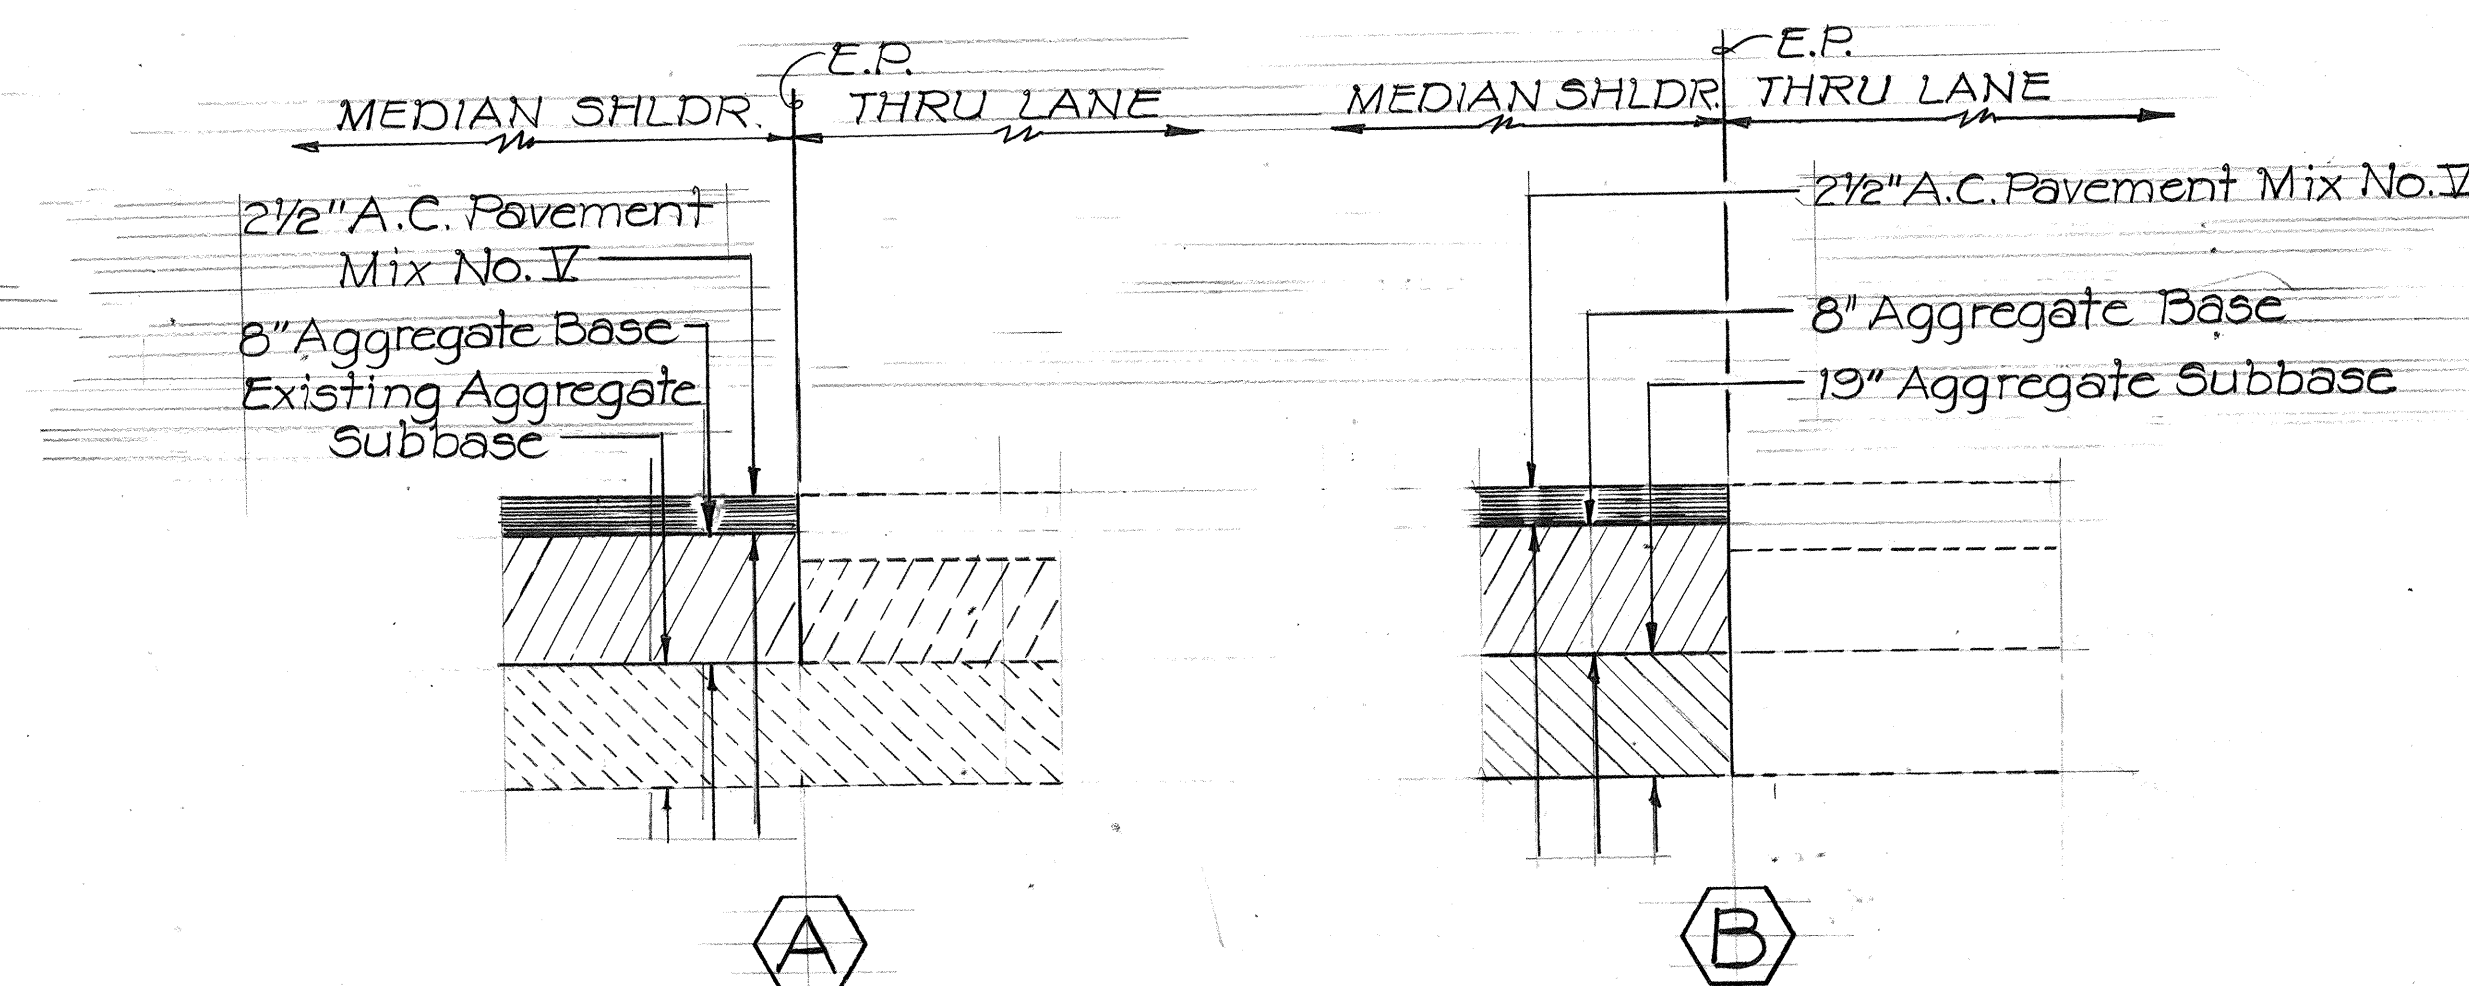

**TYPICAL ASPHALT CONCRETE
PAVEMENT SECTION**
STA. 31+38 TO STA. 34+88
STA. 35+45 TO STA. 36+50
STA. 41+10 TO STA. 42+50

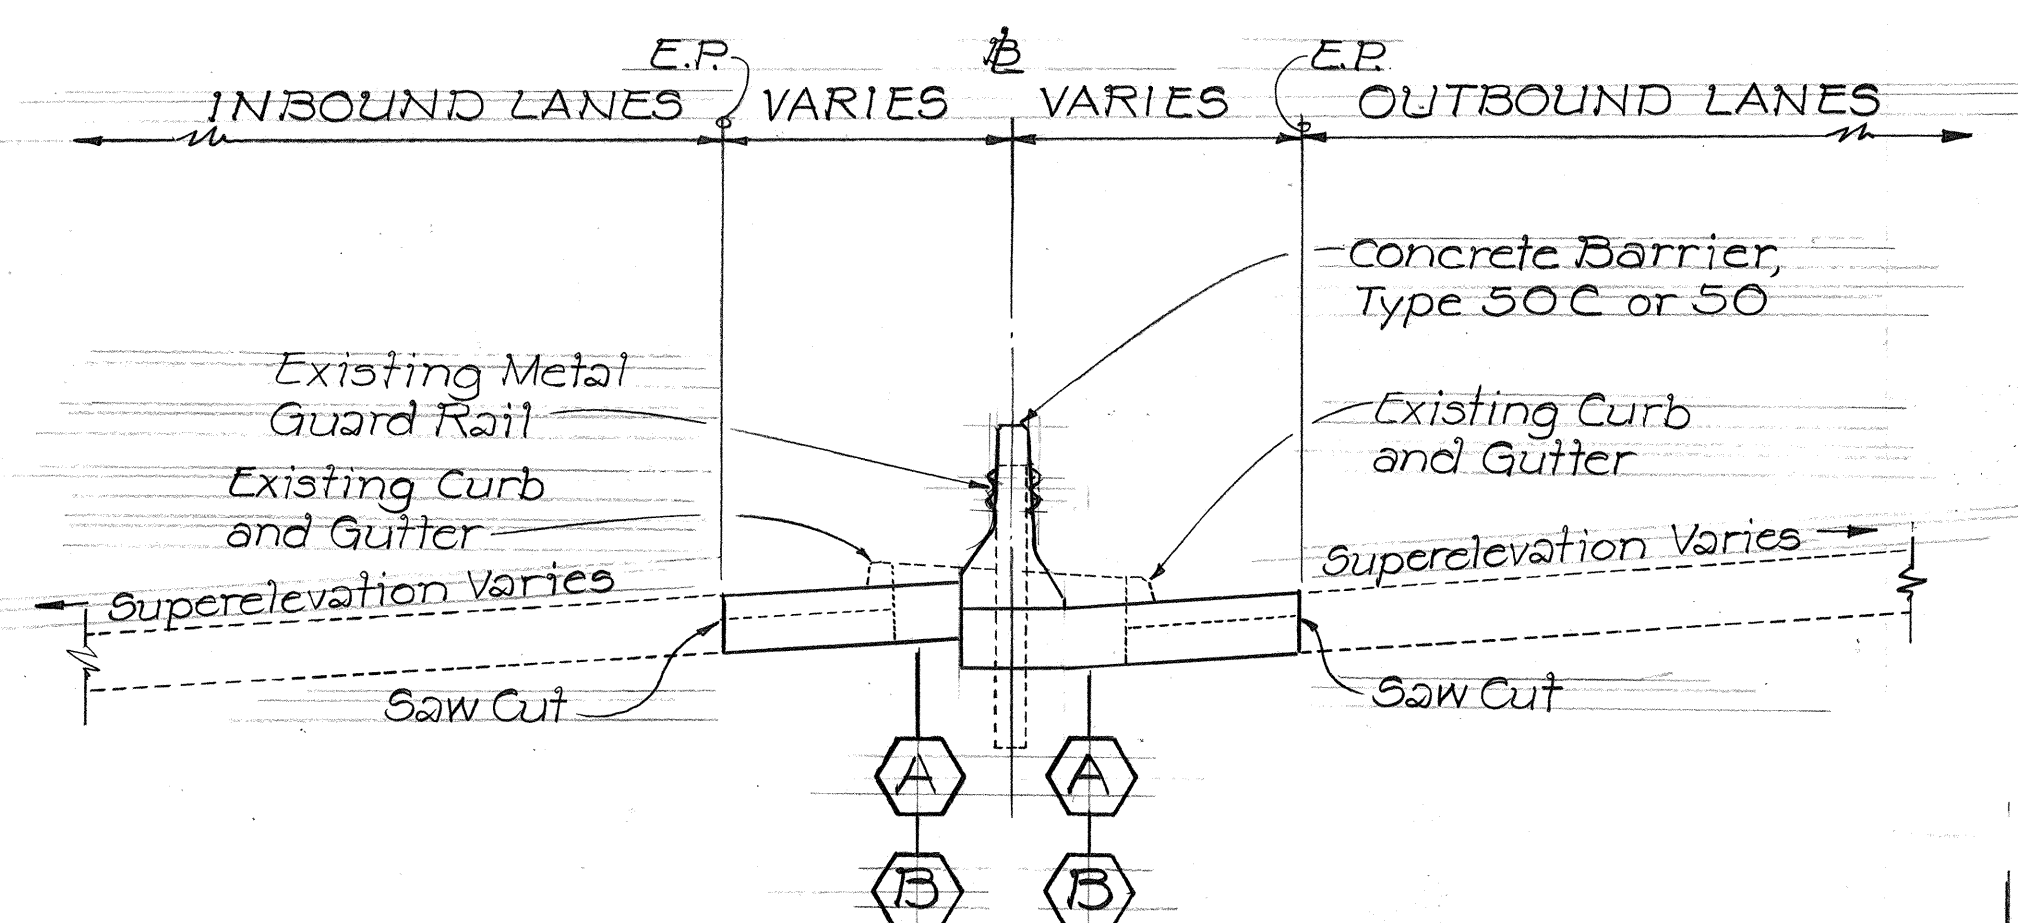

**TYPICAL ASPHALT CONCRETE
PAVEMENT SECTION**
STA. 25+09 TO STA. 45+38±
Scale: 1/4" = 1'-0"

2/6/84 Added Typical Section.
Added "Contraction" to
Transverse Joint Detail

DATE REVISION

STATE OF HAWAII
DEPARTMENT OF TRANSPORTATION
HIGHWAYS DIVISION

TYPICAL SECTION
INTERSTATE ROUTE H-1
SAFETY IMPROVEMENTS
Kalo Lane To Ainakoa Ave.
F.A.I. Project No. IR-HI-1(184)
Scale: As Noted

SHEET NO. OF SHEETS