

FED. ROAD DIST. NO.	STATE	FED. AID PROJ. NO.	FISCAL YEAR	SHEET NO.	TOTAL SHEETS
HAWAII	HAW.	11RHI-1(169):17	1983	46	280

CURB SLOT LOCATIONS	
LOCATION	TYPE
Makai Fr. Rd. Sta. 248+65 Rt.	IV
249+30 Rt.	IV
250+55 Rt.	IV
250+55 Rt.	IV
251+50 Rt.	IV
Middle St. (SB) Sta. 11+38, 26' Rt.	I
12+10, 26' Rt.	II
12+86, 26' Rt.	II
Nimitz Conn. (WB) Sta. 41+55, Lt.	II
41+75, Lt.	II
42+20, Lt.	II
42+80, Lt.	II
Ramp C Sta. 25+85, Rt.	II
26+85, Rt.	II
27+50, Rt.	IV
28+35, Rt.	II
Ramp D Sta. 23+00, Lt.	II
24+10, Lt.	II
25+20, Lt.	II
26+30, Lt.	II
26+80, Lt.	II
27+15, Lt.	II
27+50, Lt.	II
27+90, Lt.	II
28+30, Lt.	II
Ramp E Sta. 17+30, Lt.	II
18+45, Lt.	II
19+60, Lt.	II
20+75, Lt.	II
21+90, Lt.	II
22+35, Lt.	I

LEGEND

- Drain line
- Existing Drainline, Pipe Size
- ⑤ Drainage Structure
- ☒ Underdrain Cleanout
- 6" Non-Perf. Und. Pipe
- 6" Perf. Und. Pipe
- Existing 6" Und. Pipe
- Lined Ditch
- Grouted Rubble Paving (GRP) 9" thick, unless otherwise shown
- Right-of-Way Line
- Easement Line
- Limit of Grading
- Curb Slot
- New Pier
- Existing Pier
- Contour for Grading
- Existing Contour
- Side Slope, Existing Soil Consolidation Embankment
- ▶▶▶▶ Temporary Vee Ditch with 2:1 Side Slopes (Payment incidental to various Contract Items)
- Existing Swale on Ditch

ABBREVIATIONS

RCP	Reinforced Concrete Pipe
ACP	Asbestos Cement Pipe
Cl.	Class
Inv.	Invert
CB	Catch Basin
DI	Drop Intake
MH	Manhole
TMH	Telephone Manhole
Perf. Und.	Perforated Underdrain
Irr. Sl.	Irrigation Sleeve
N.I.C.	Not in Contract

NOTE

See Sheet D-3 for General Notes.

2/24/86	Changed location of Bikeway 'X' and revised grading in vicinity of Bikeway 'X'
---------	--

DATE	REVISION
------	----------

STATE OF HAWAII
DEPARTMENT OF TRANSPORTATION
LAND TRANSPORTATION FACILITIES DIVISION

DRAINAGE AND GRADING PLAN

INTERSTATE ROUTE H-1
PROJECT NO. I-IR-HI-1(169):17


SCALE: 1" = 50' DATE: 3/15/82
SHEET NO. D-1 OF D-25 SHEETS



THIS WORK WAS PREPARED BY ME
OR UNDER MY SUPERVISION.


"AS-BUILT"

C.O. 46


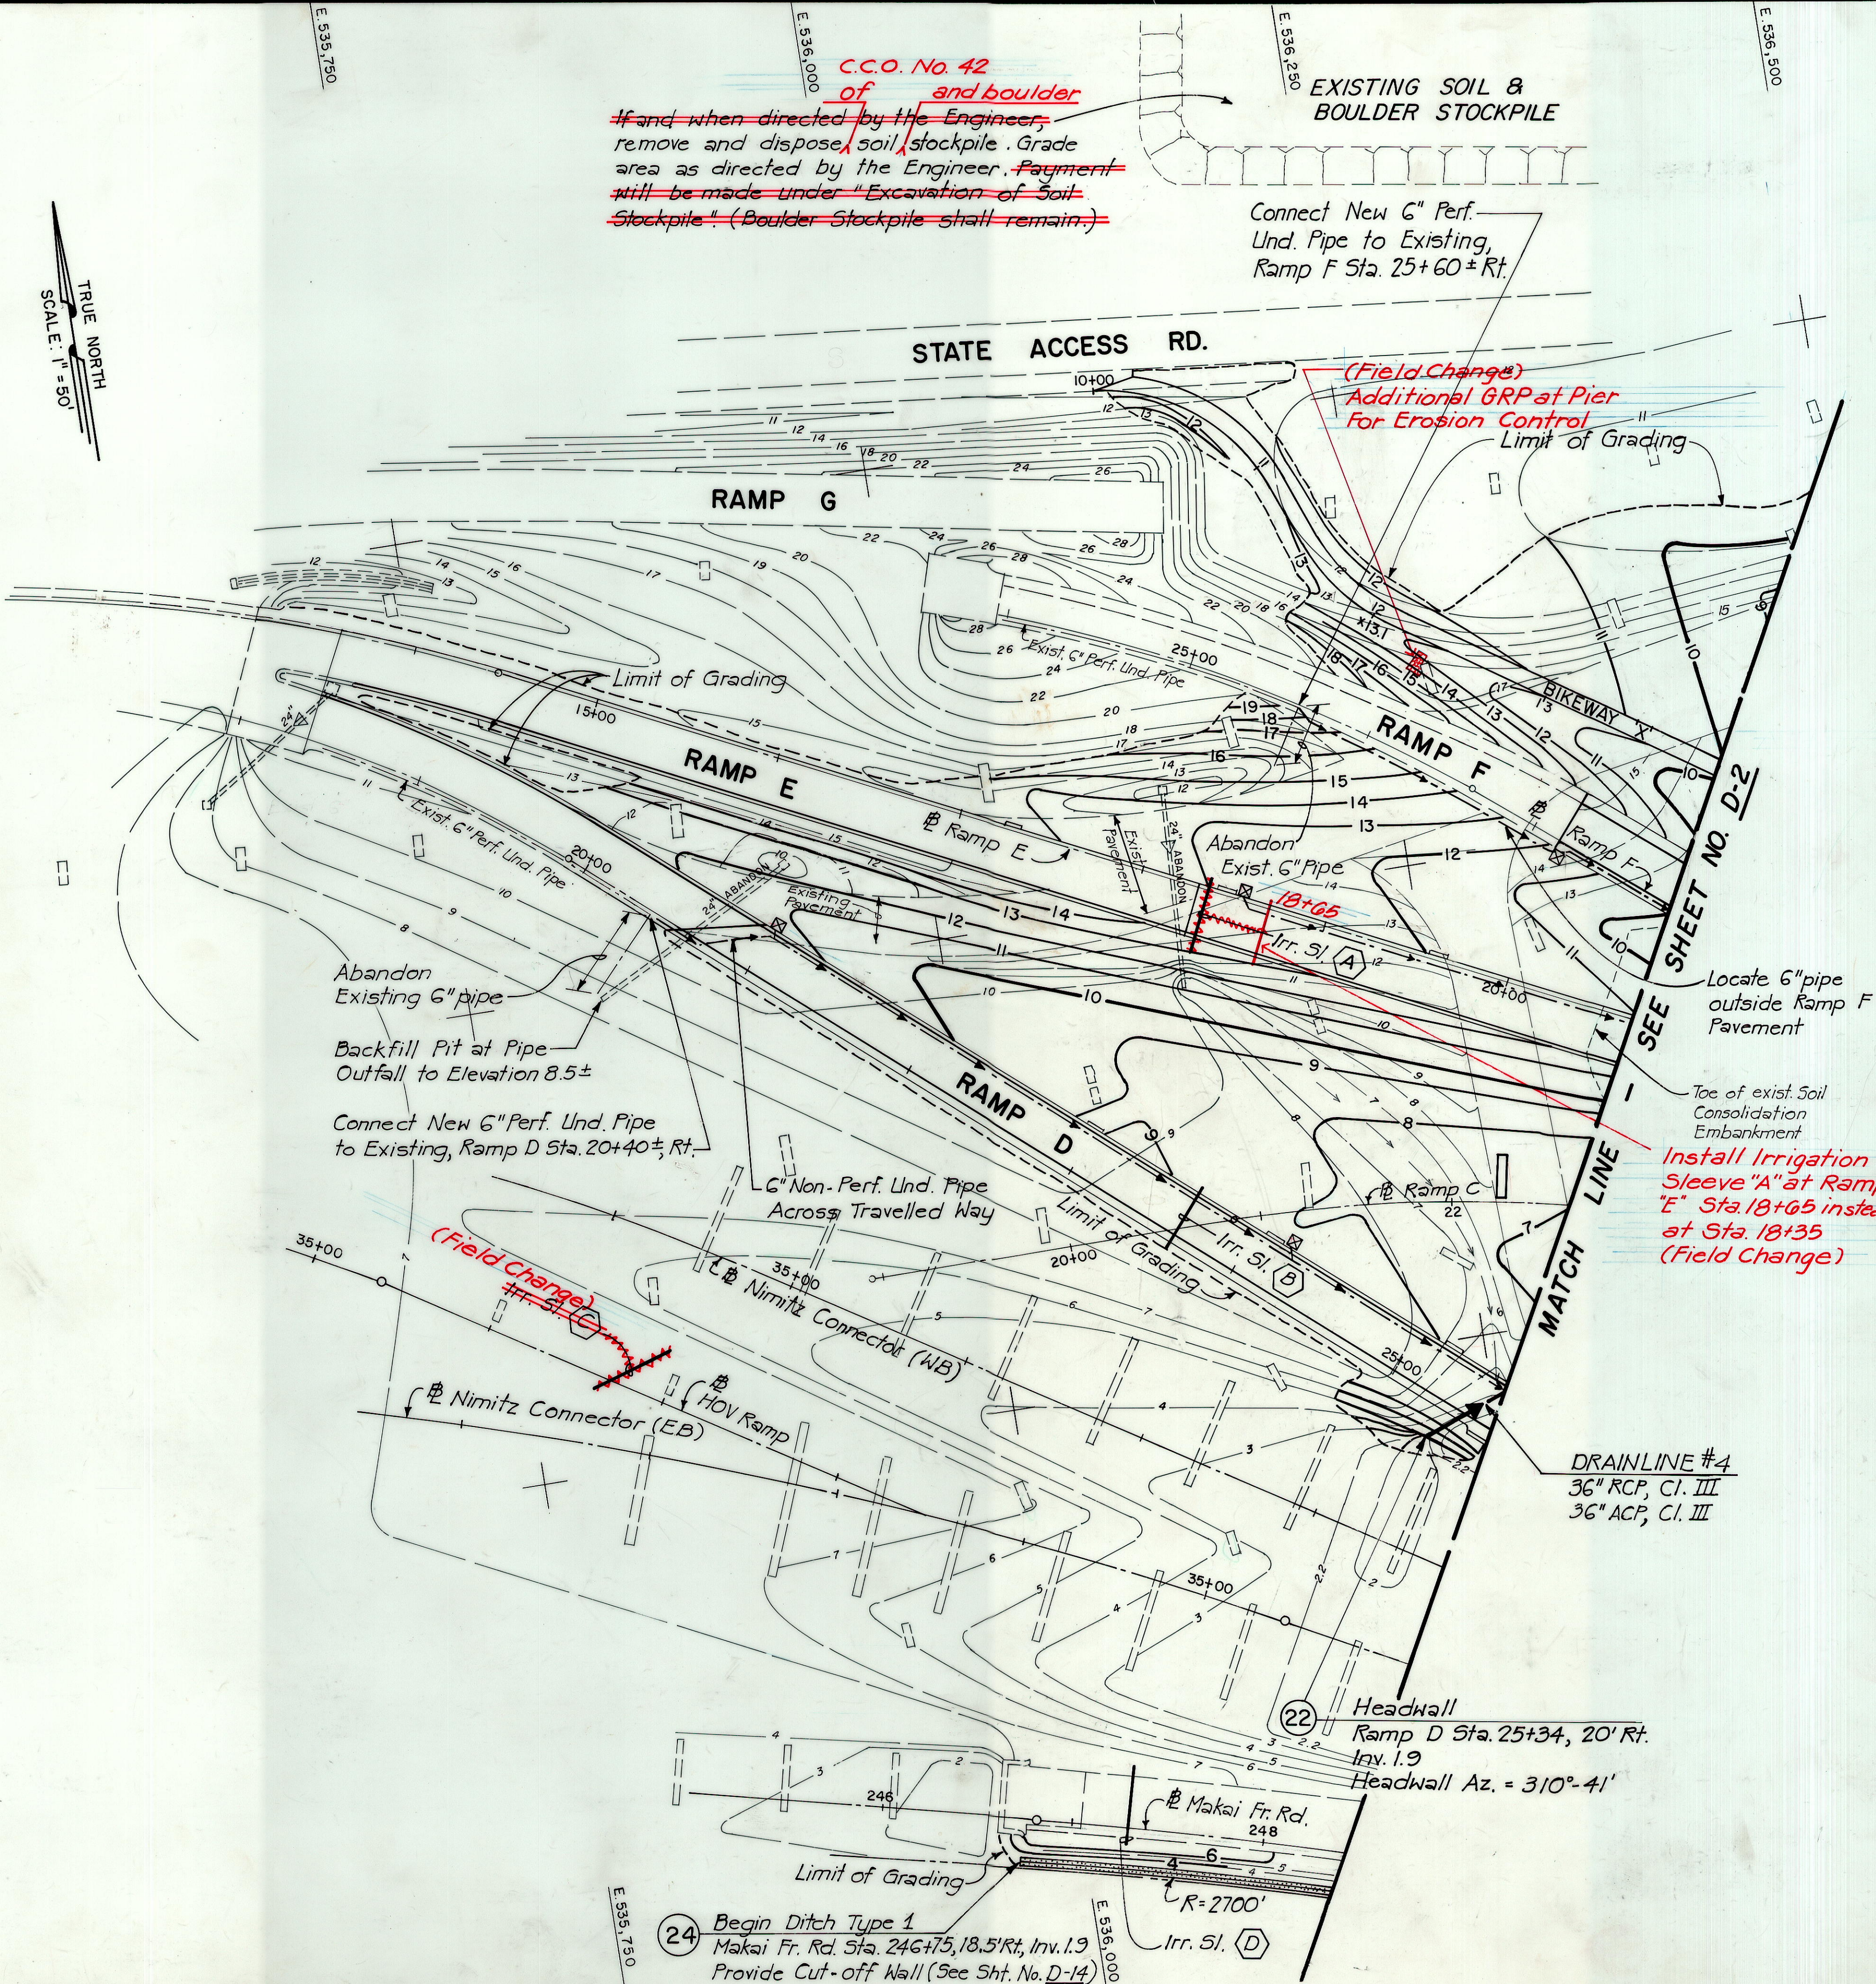


DATE	
SURVEY PLOTTED BY	
DRAWN BY	
DESIGNED BY	
QUANTITIES BY	
CHECKED BY	
ORIGINAL PLAN	
NOTE BOOK	
NO.	

FED. ROAD DIST. NO.	STATE	FED. AID PROJ. NO.	FISCAL YEAR	SHEET NO.	TOTAL SHEETS
HAWAII	HAW.	IR-HI-1(169)-17	1983	48	260

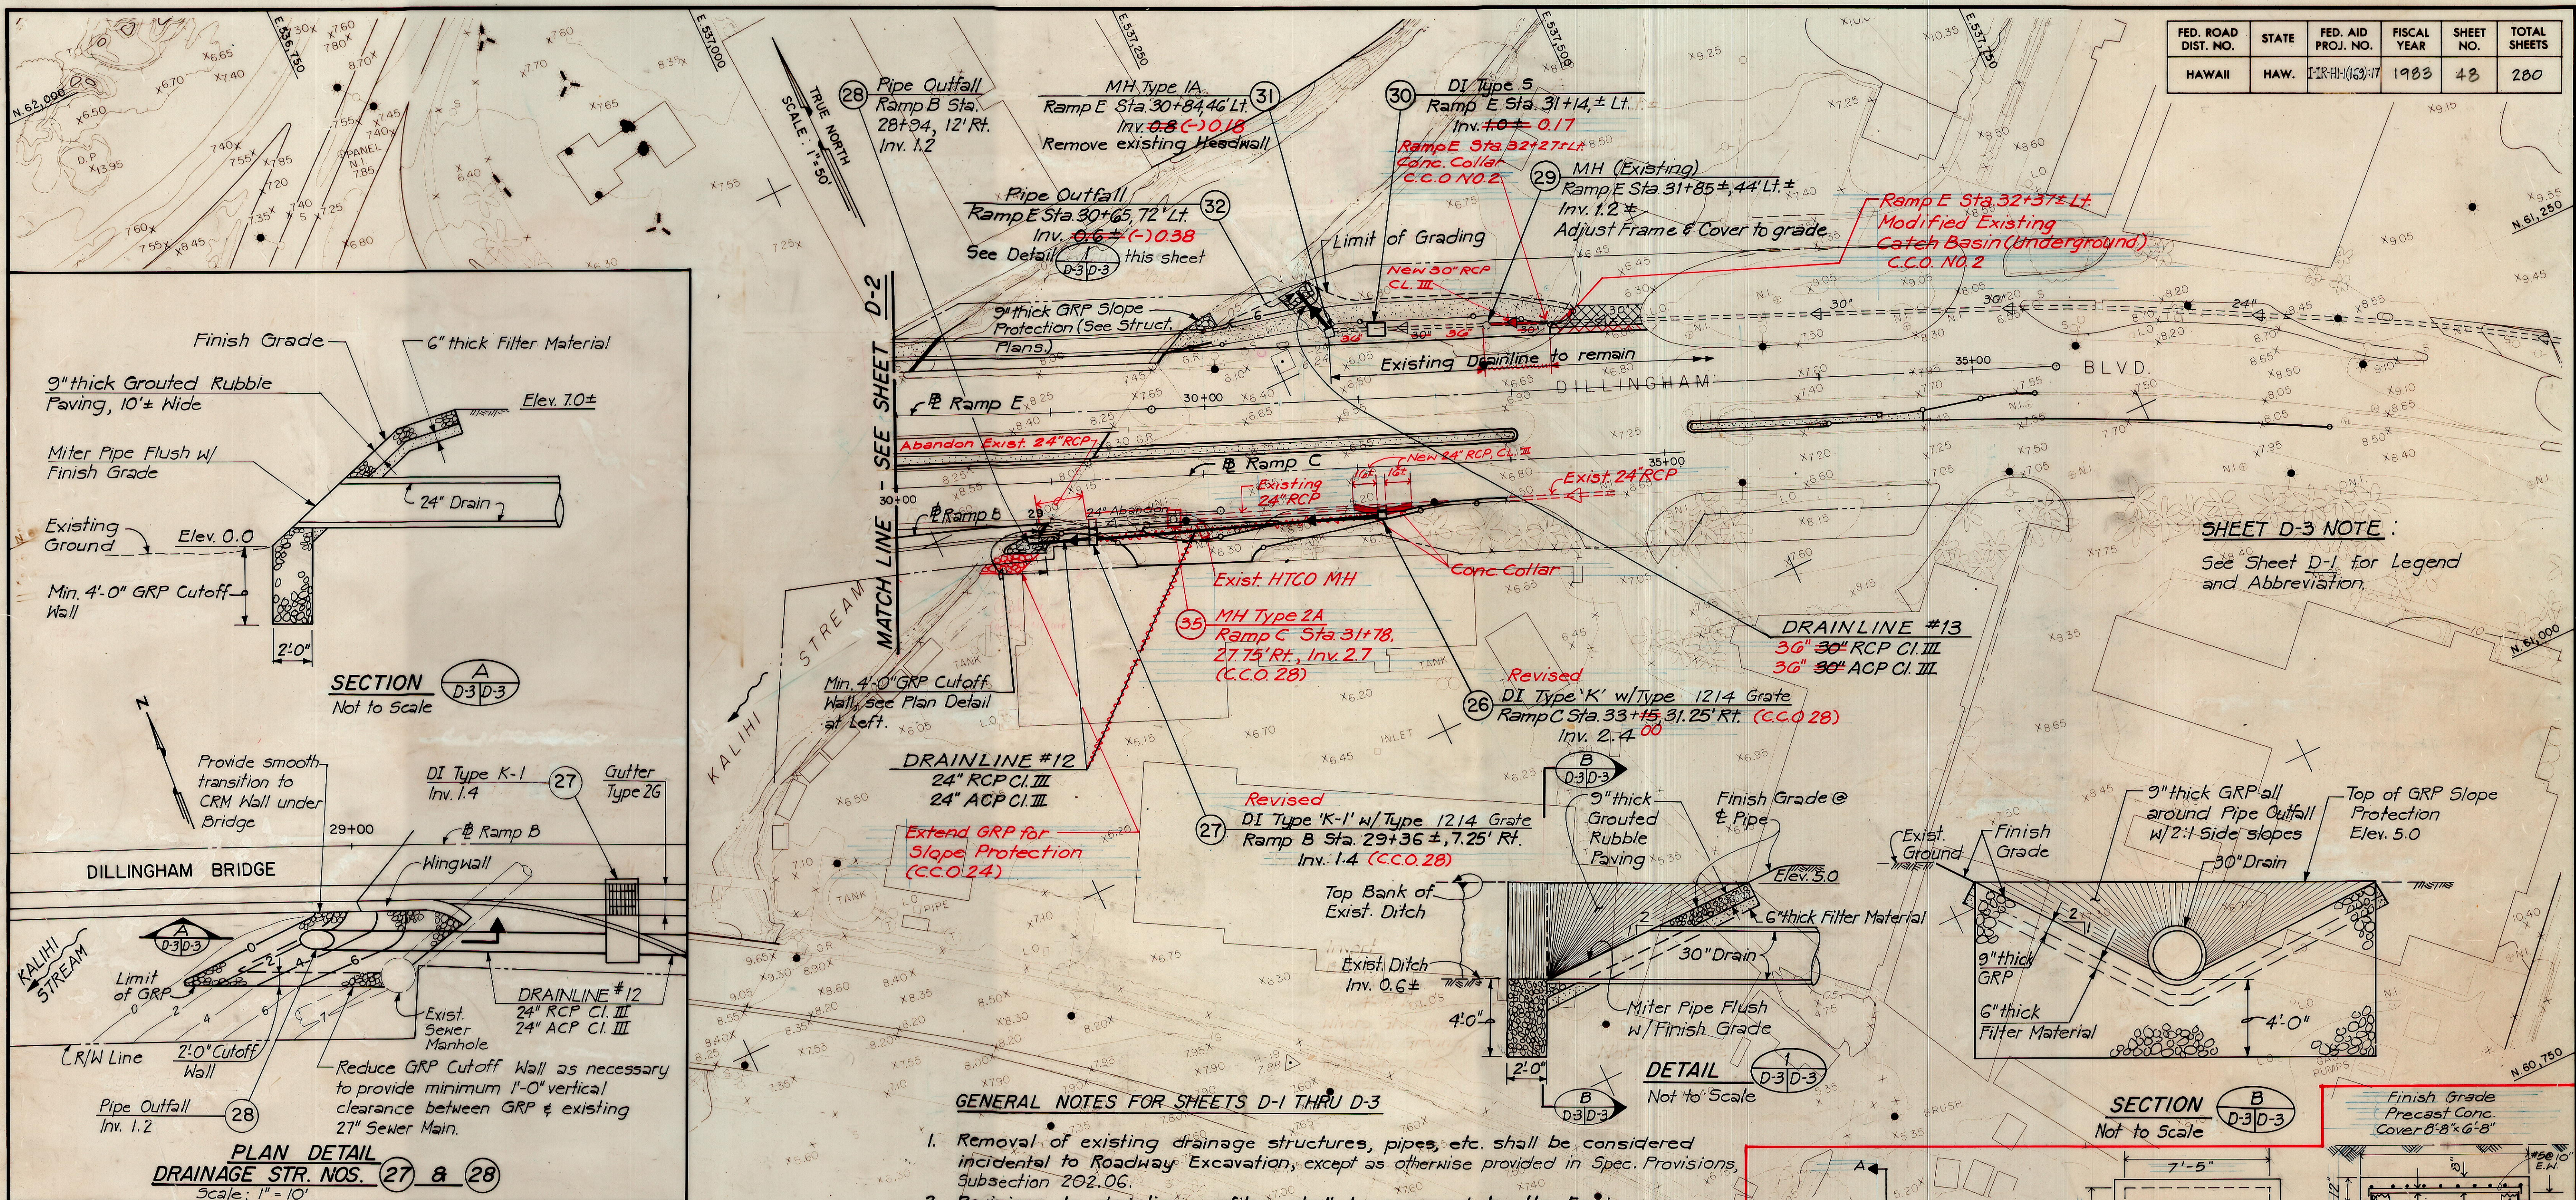

- For Irrigation Sleeve locations and Invert Elevations, see Sheet D-16.
- Unless otherwise indicated by contours, grading of traffic islands of Middle Street intersection shall be flush with top of curbs and shall follow a straight line from top of curb to top of curb.
- Remove existing riprap, filter fabric & sand blanket in Kalihi Stream as is necessary to facilitate construction of the Ramp B Structure and gasoline. Replace damaged filter fabric & restore riprap lining to its original condition. Payment shall be considered incidental to various contract items.
- Rock, boulders, silt deposits and other loose or soft sediments in Kalihi Stream under widened and existing Dillingham Bridges shall be excavated down to elevation -1.0, and all debris and vegetation shall be removed. Existing pile remnants within Right-of-Way on north side of existing outbound bridge, which project above stream invert, shall be cut-off at 1.0 foot below grade. Payment for excavation, removal and disposal of subject materials will not be paid separately, but will be considered incidental to various contract items.
- All culverts installed on project were RCP CL. III.

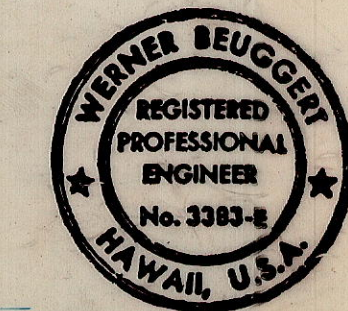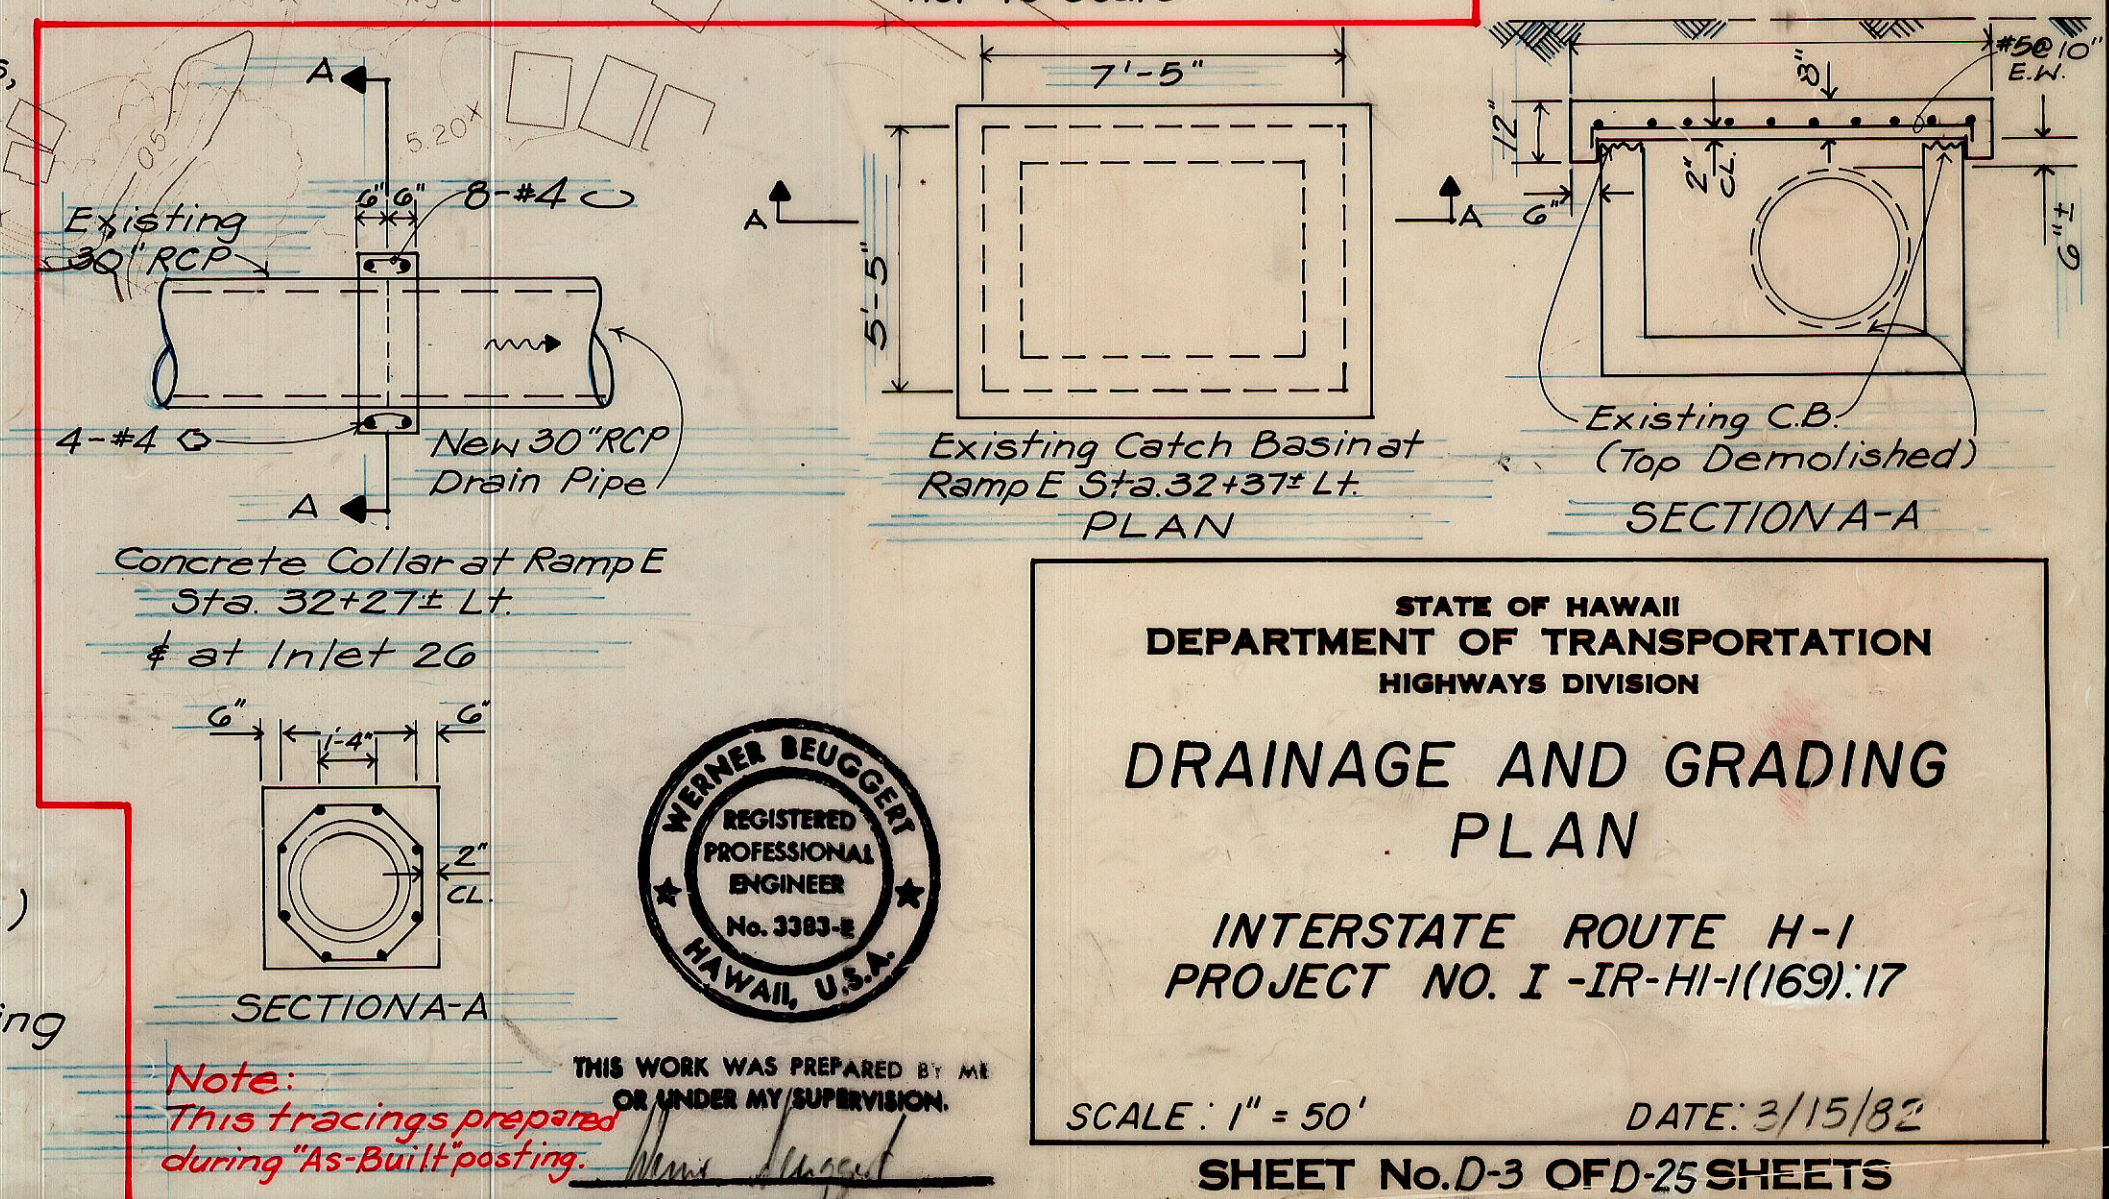

STATE OF HAWAII
DEPARTMENT OF TRANSPORTATION
HIGHWAYS DIVISION


DRAINAGE AND GRADING PLAN

INTERSTATE ROUTE H-1
PROJECT NO. 1-IR-HI-1(169)-17

SCALE: 1" = 50' DATE: 3/15/82
SHEET No. D-3 OF 25 SHEETS

"AS-BUILT"


FED. ROAD DIST. NO.	STATE	FED. AID PROJ. NO.	FISCAL YEAR	SHEET NO.	TOTAL SHEETS
HAWAII	HAW.	I-IR-HI-1(169):17	1983	49	280

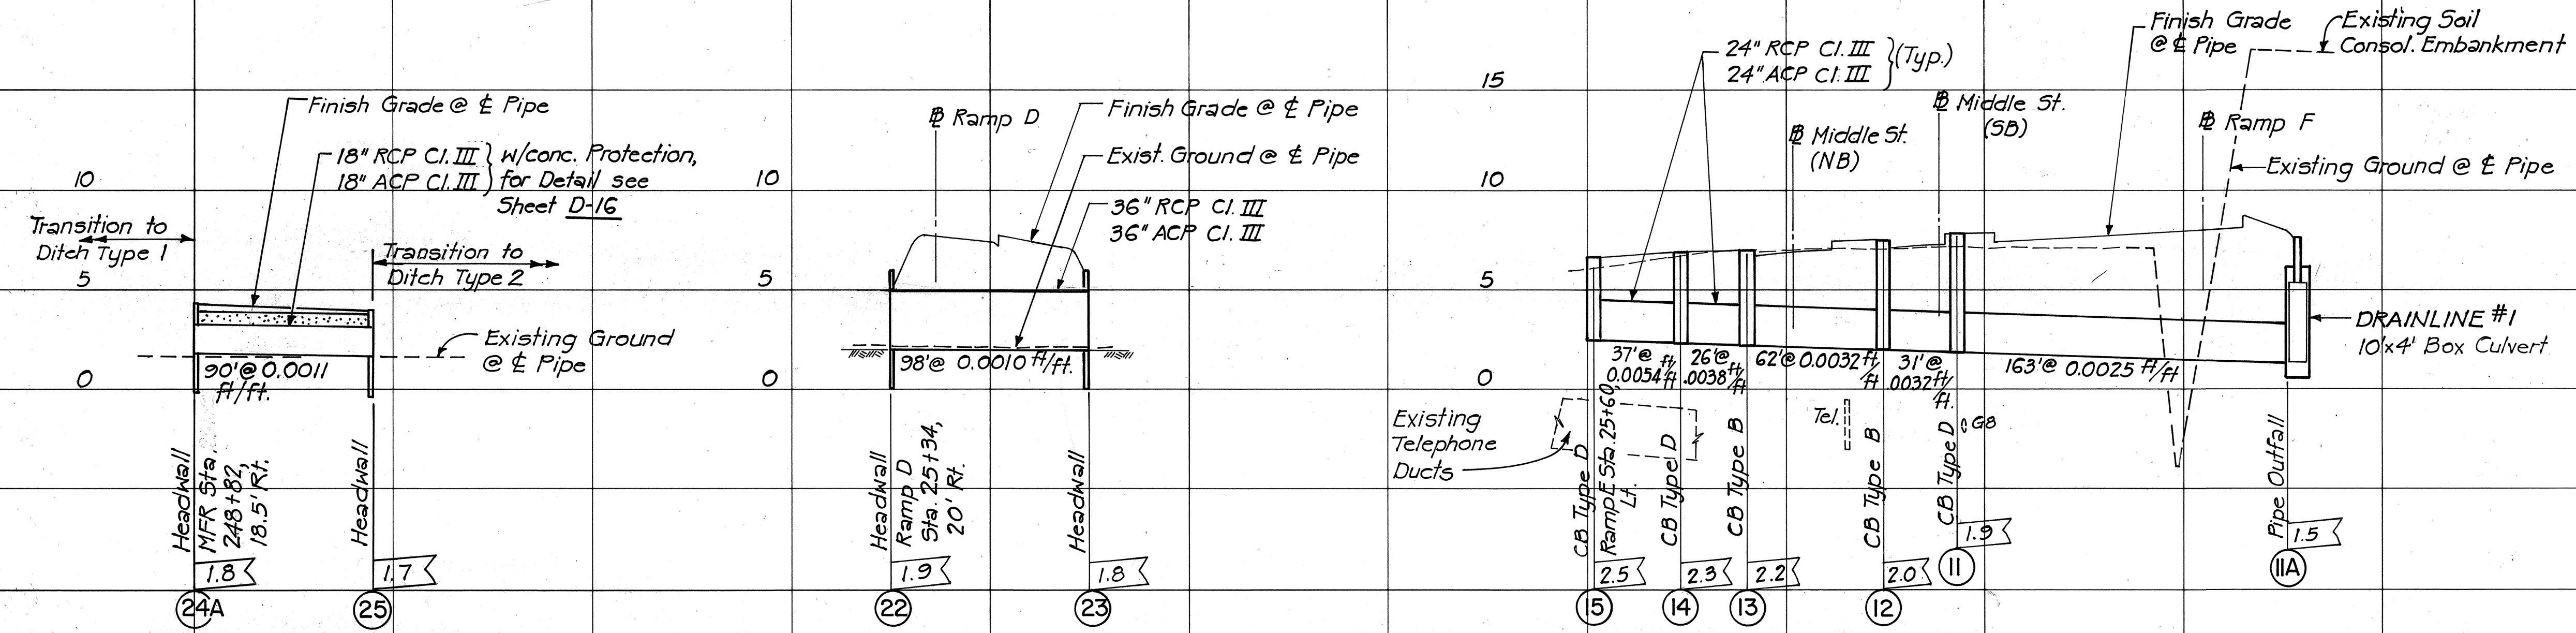

DRAINLINE #3

DRAINLINE #4

DRAINLINE #5

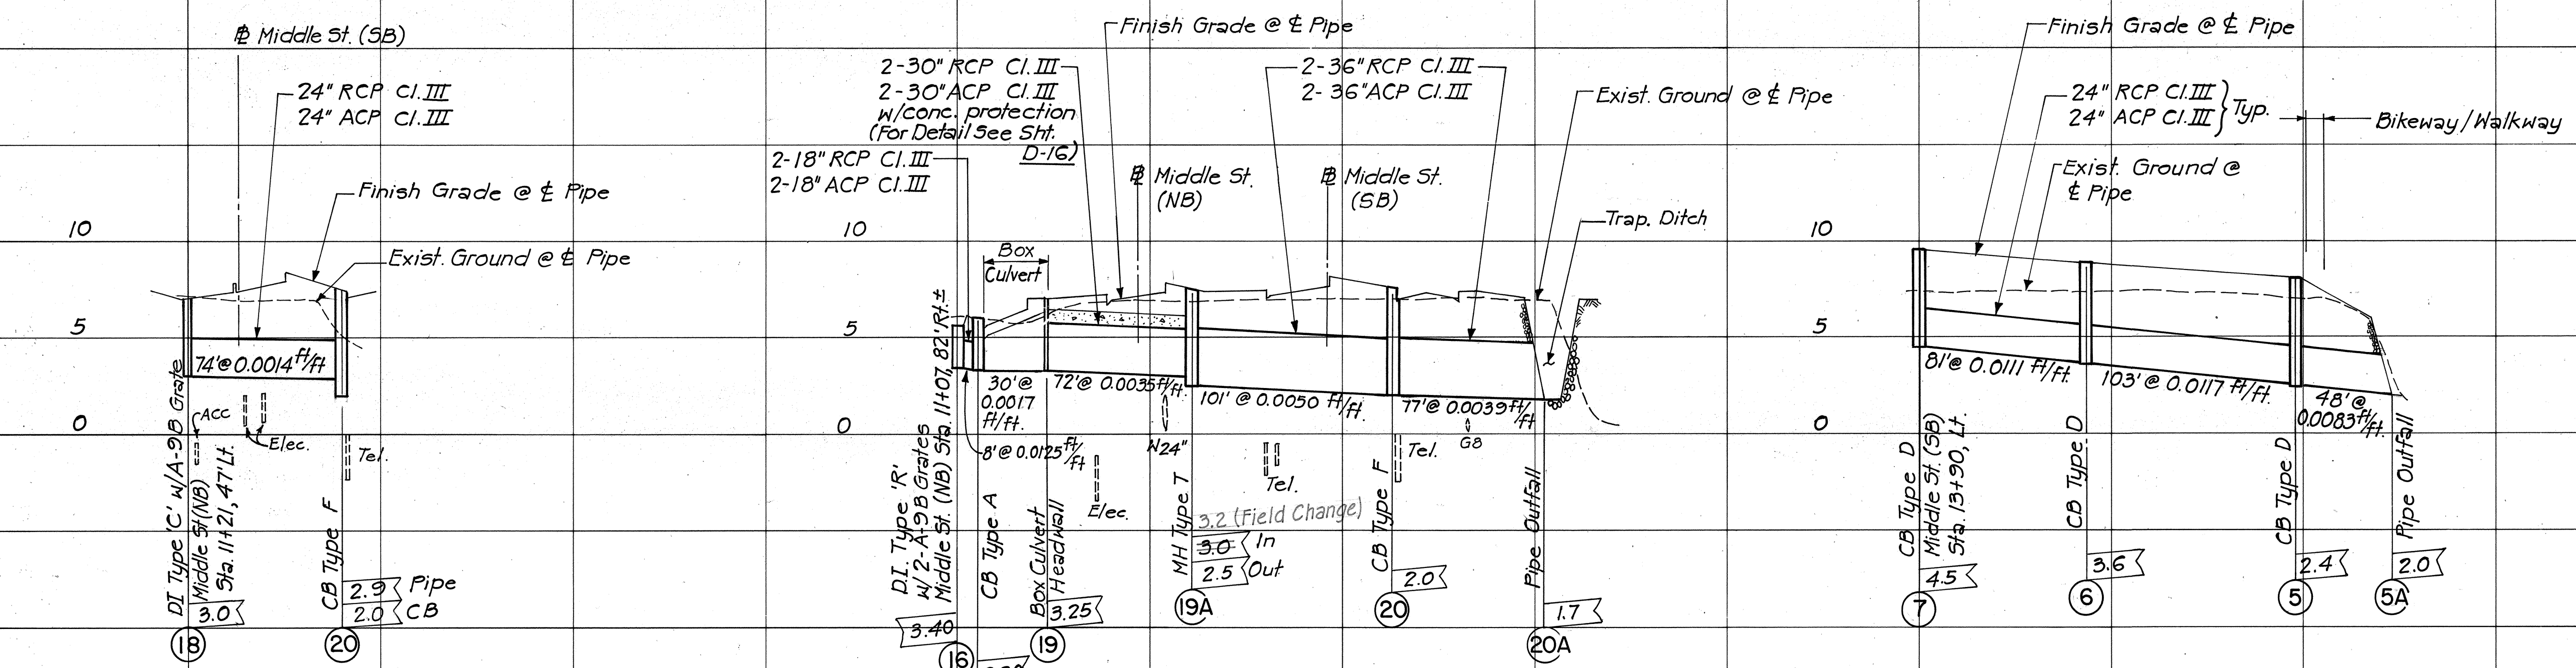


DRAINLINE #7

DRAINLINE #8

DRAINLINE #9

DRAINLINE #8 NOTE:
Contractor shall verify location and elevation of all existing utilities intersecting Drainline #8 prior to construction of any portion of Drainline #8.

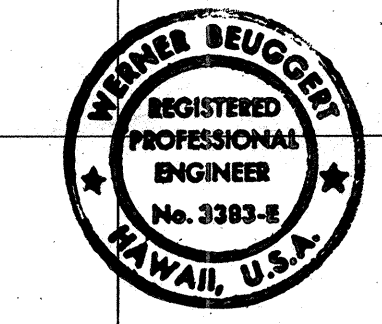

THIS WORK WAS PREPARED BY ME
OR UNDER MY SUPERVISION.
Werner Seuggert

STATE OF HAWAII
DEPARTMENT OF TRANSPORTATION
HIGHWAYS DIVISION


DRAINAGE PROFILES

INTERSTATE ROUTE H-1
PROJECT NO. I-IR-HI-1(169):17
SCALE: HORIZ.: 1"=50'
DATE: 3/15/82


SHEET No. D-4 OF D-25 SHEETS

DATE	
DESIGNED BY	
TRACED BY	
NOTED BY	
CHECKED BY	
ORIGINAL PLAN	
NOTE BOOK	
No.	

FED. ROAD DIST. NO.	STATE	FED. AID PROJ. NO.	FISCAL YEAR	SHEET NO.	TOTAL SHEETS
HAWAII	HAW.	IR-HI-1(169)17	1983	50	280

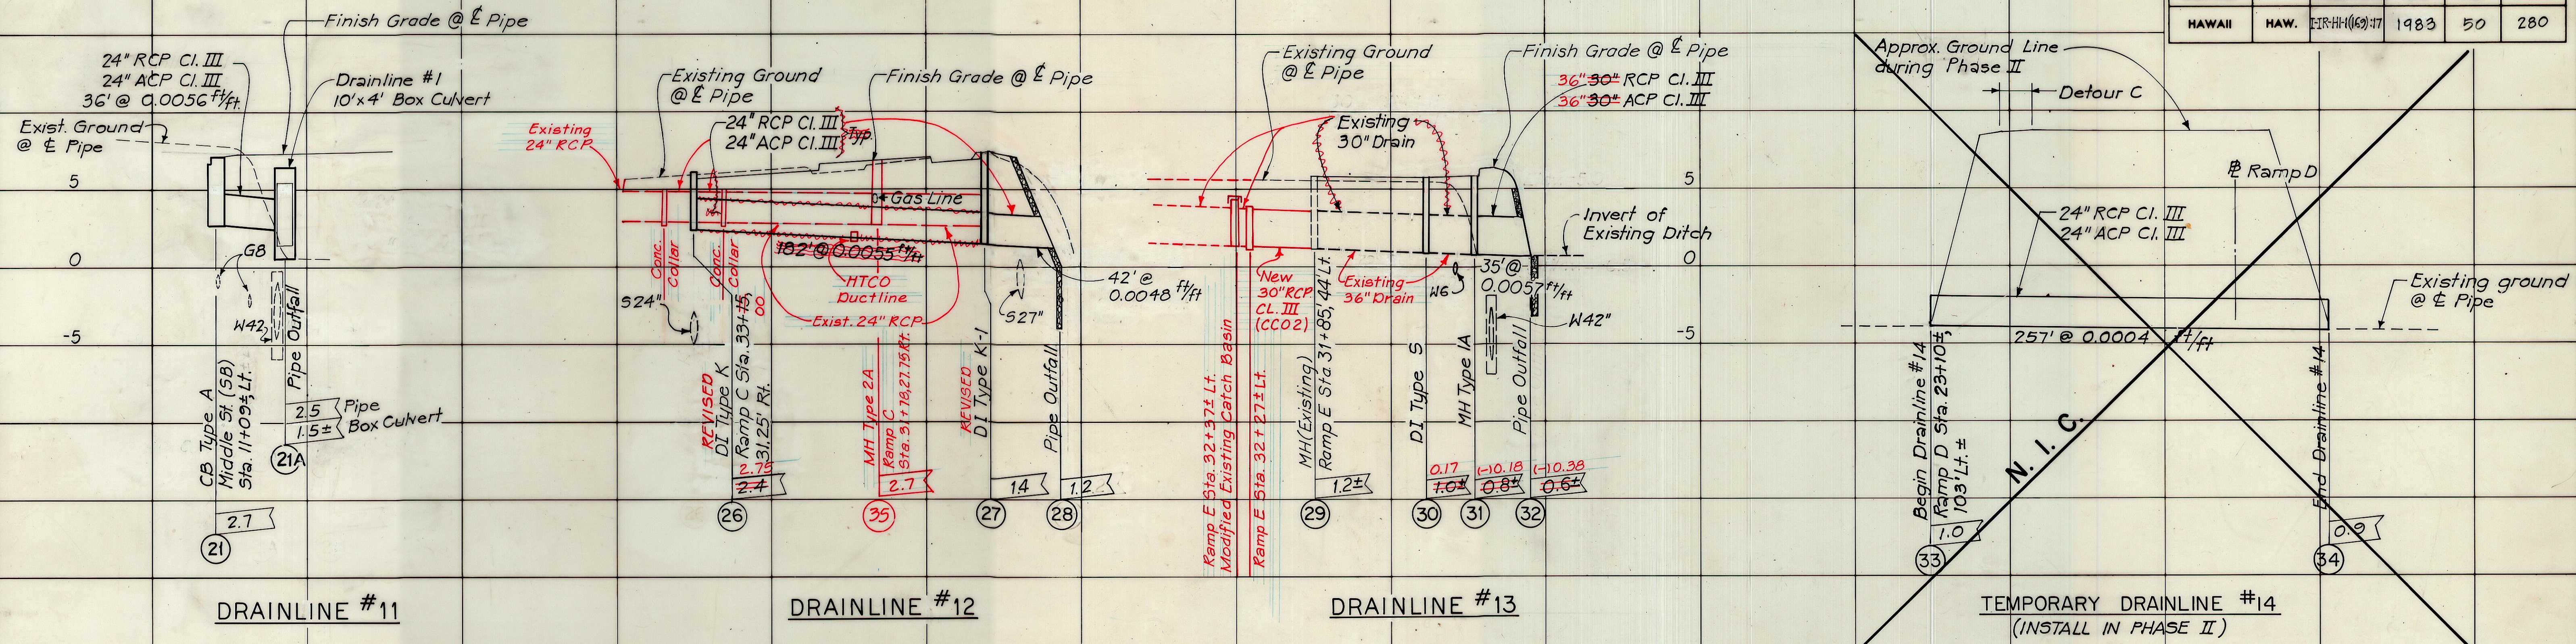

ORIGINAL PLAN	DATE
DRAWN BY	
DESIGNED BY	
CHECKED BY	
NOTED BY	
NO.	

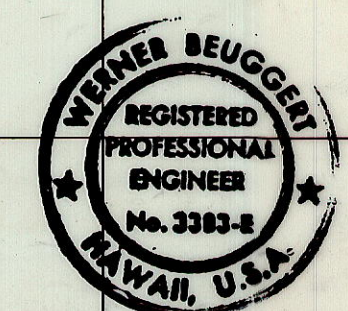

THIS WORK WAS PREPARED BY ME
 OR UNDER MY SUPERVISION.
W. Beuger

STATE OF HAWAII
 DEPARTMENT OF TRANSPORTATION
 HIGHWAYS DIVISION

DRAINAGE PROFILES

INTERSTATE ROUTE H-1
 PROJECT NO. I-IR-HI-1(169)17



SCALE: HORIZ.: 1"=50'
 VERTICAL: 1"=5'

DATE: 3/15/82

SHEET No. D-5 OF D-25 SHEETS

"AS-BUILT"



FED. ROAD DIST. NO.	STATE	FED. AID PROJ. NO.	FISCAL YEAR	SHEET NO.	TOTAL SHEETS
HAWAII	HAW.	IR-HI(169):17	1983	51	200

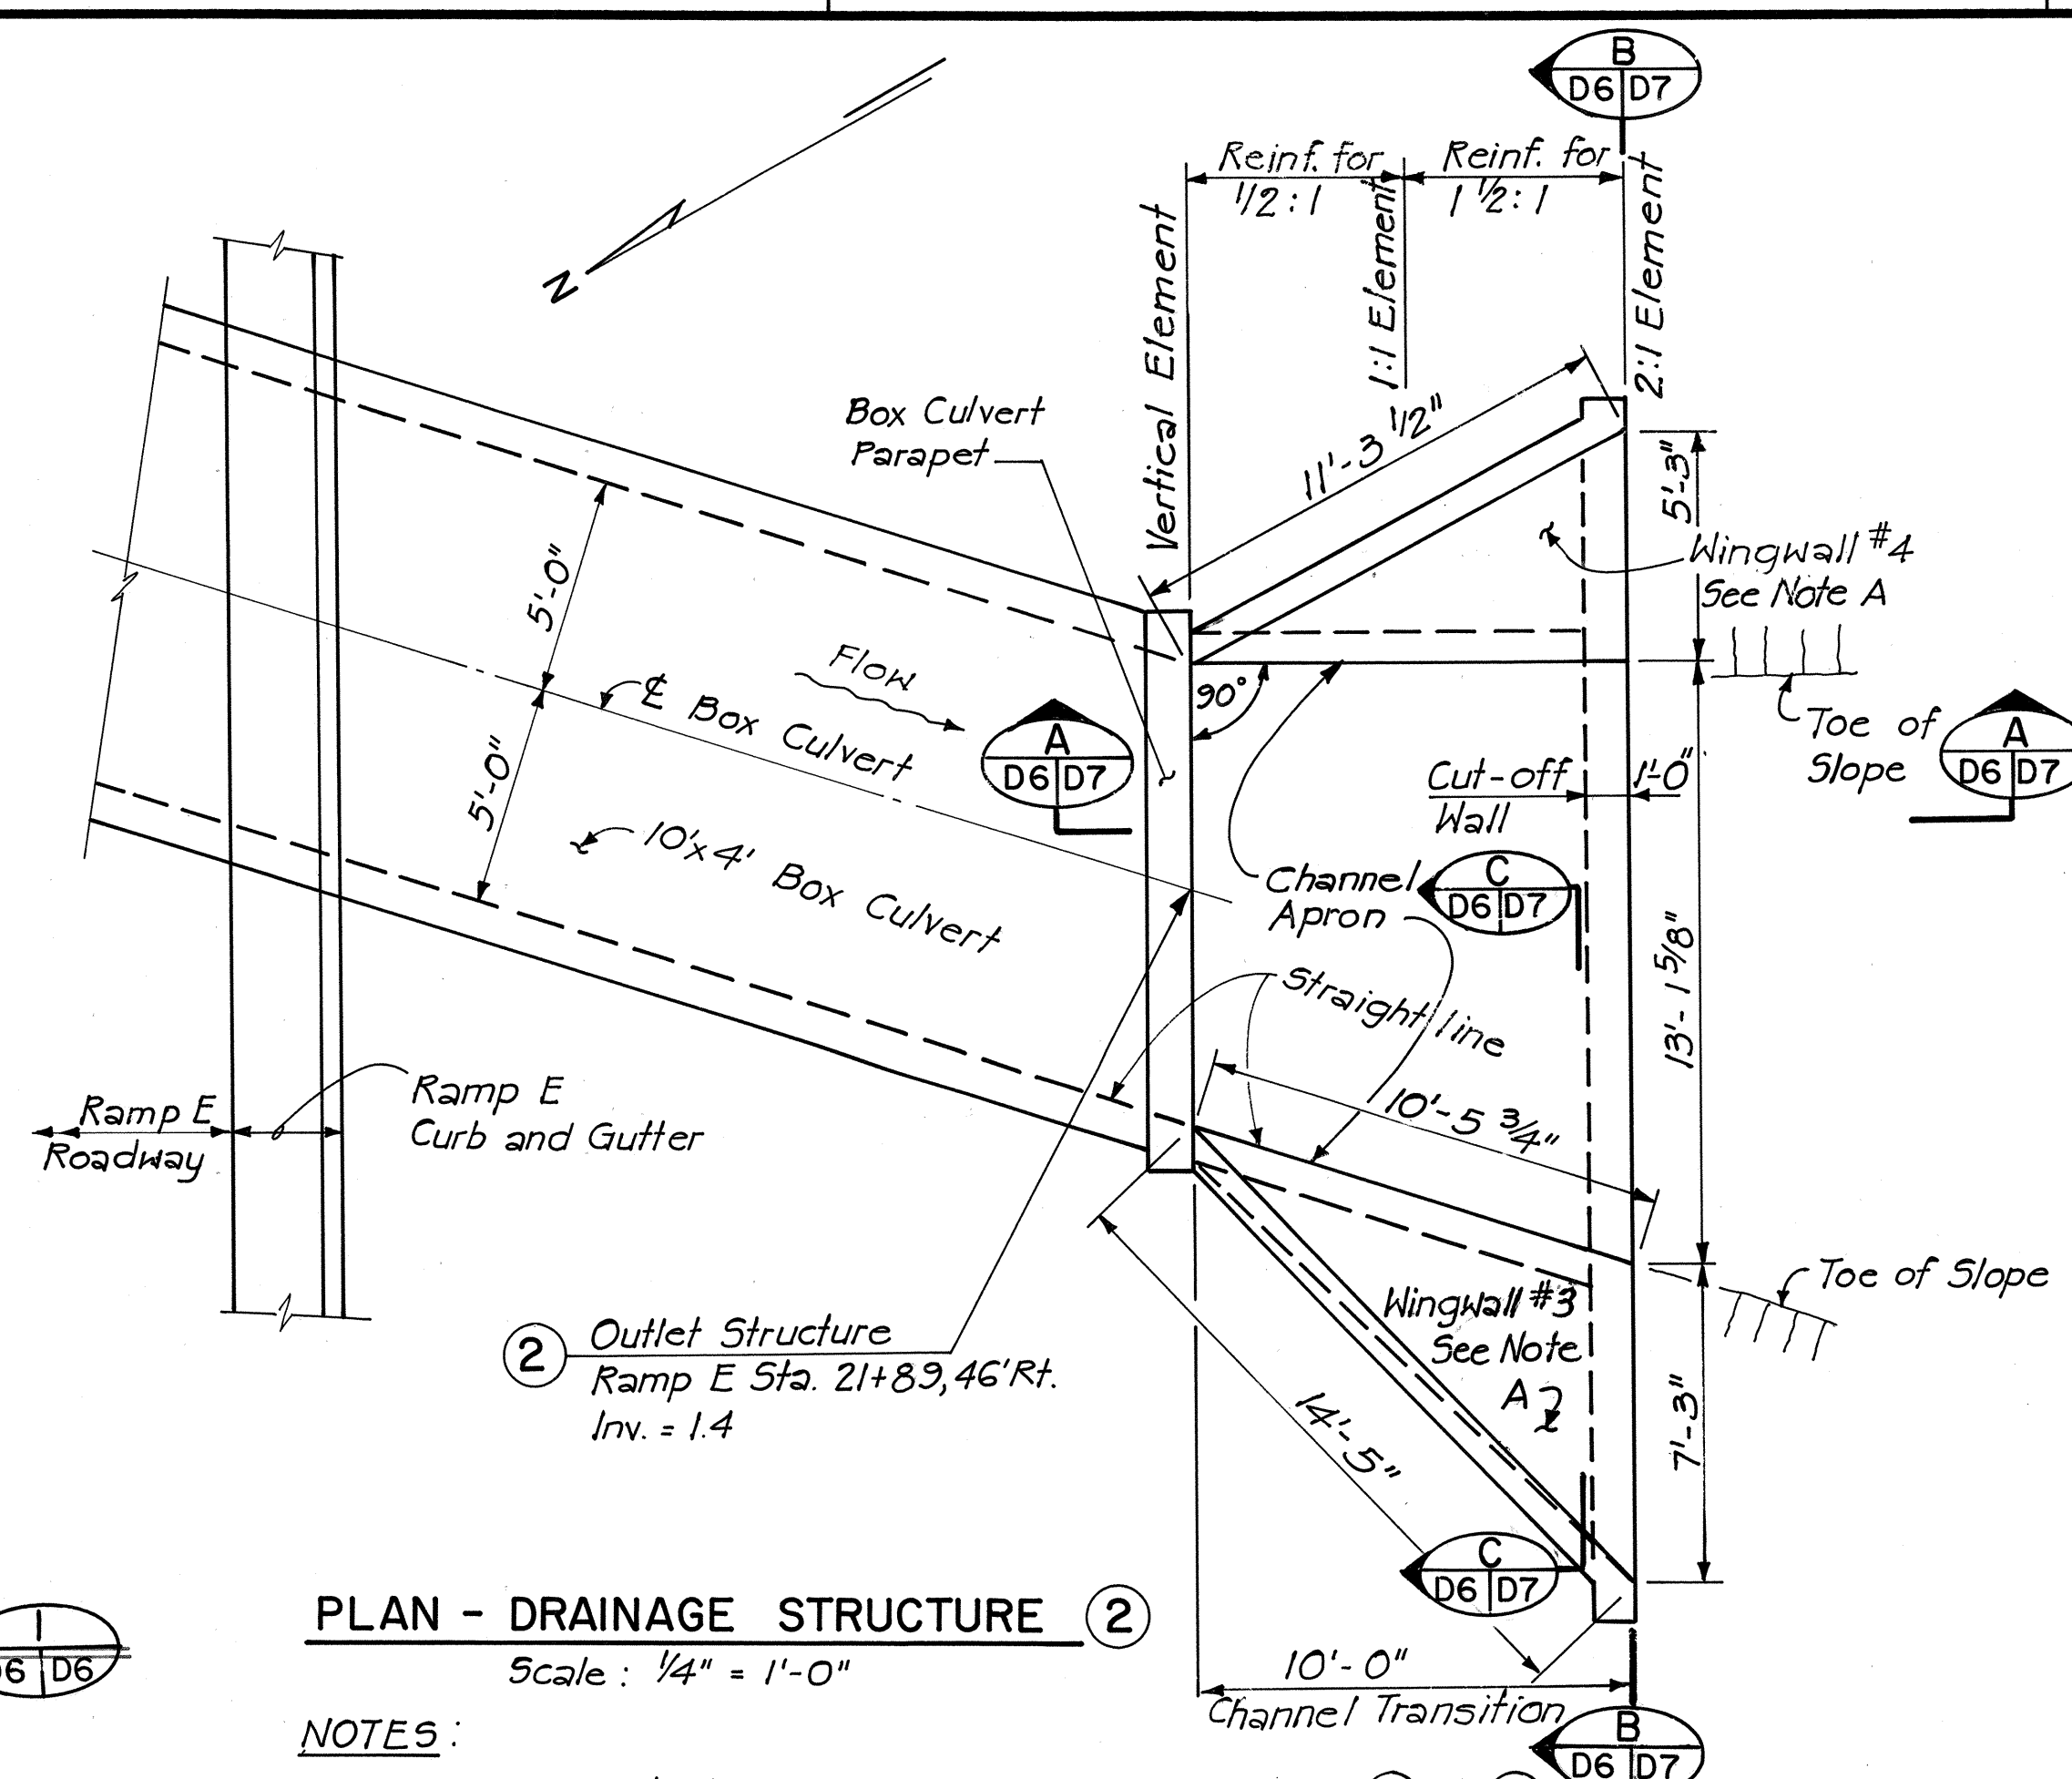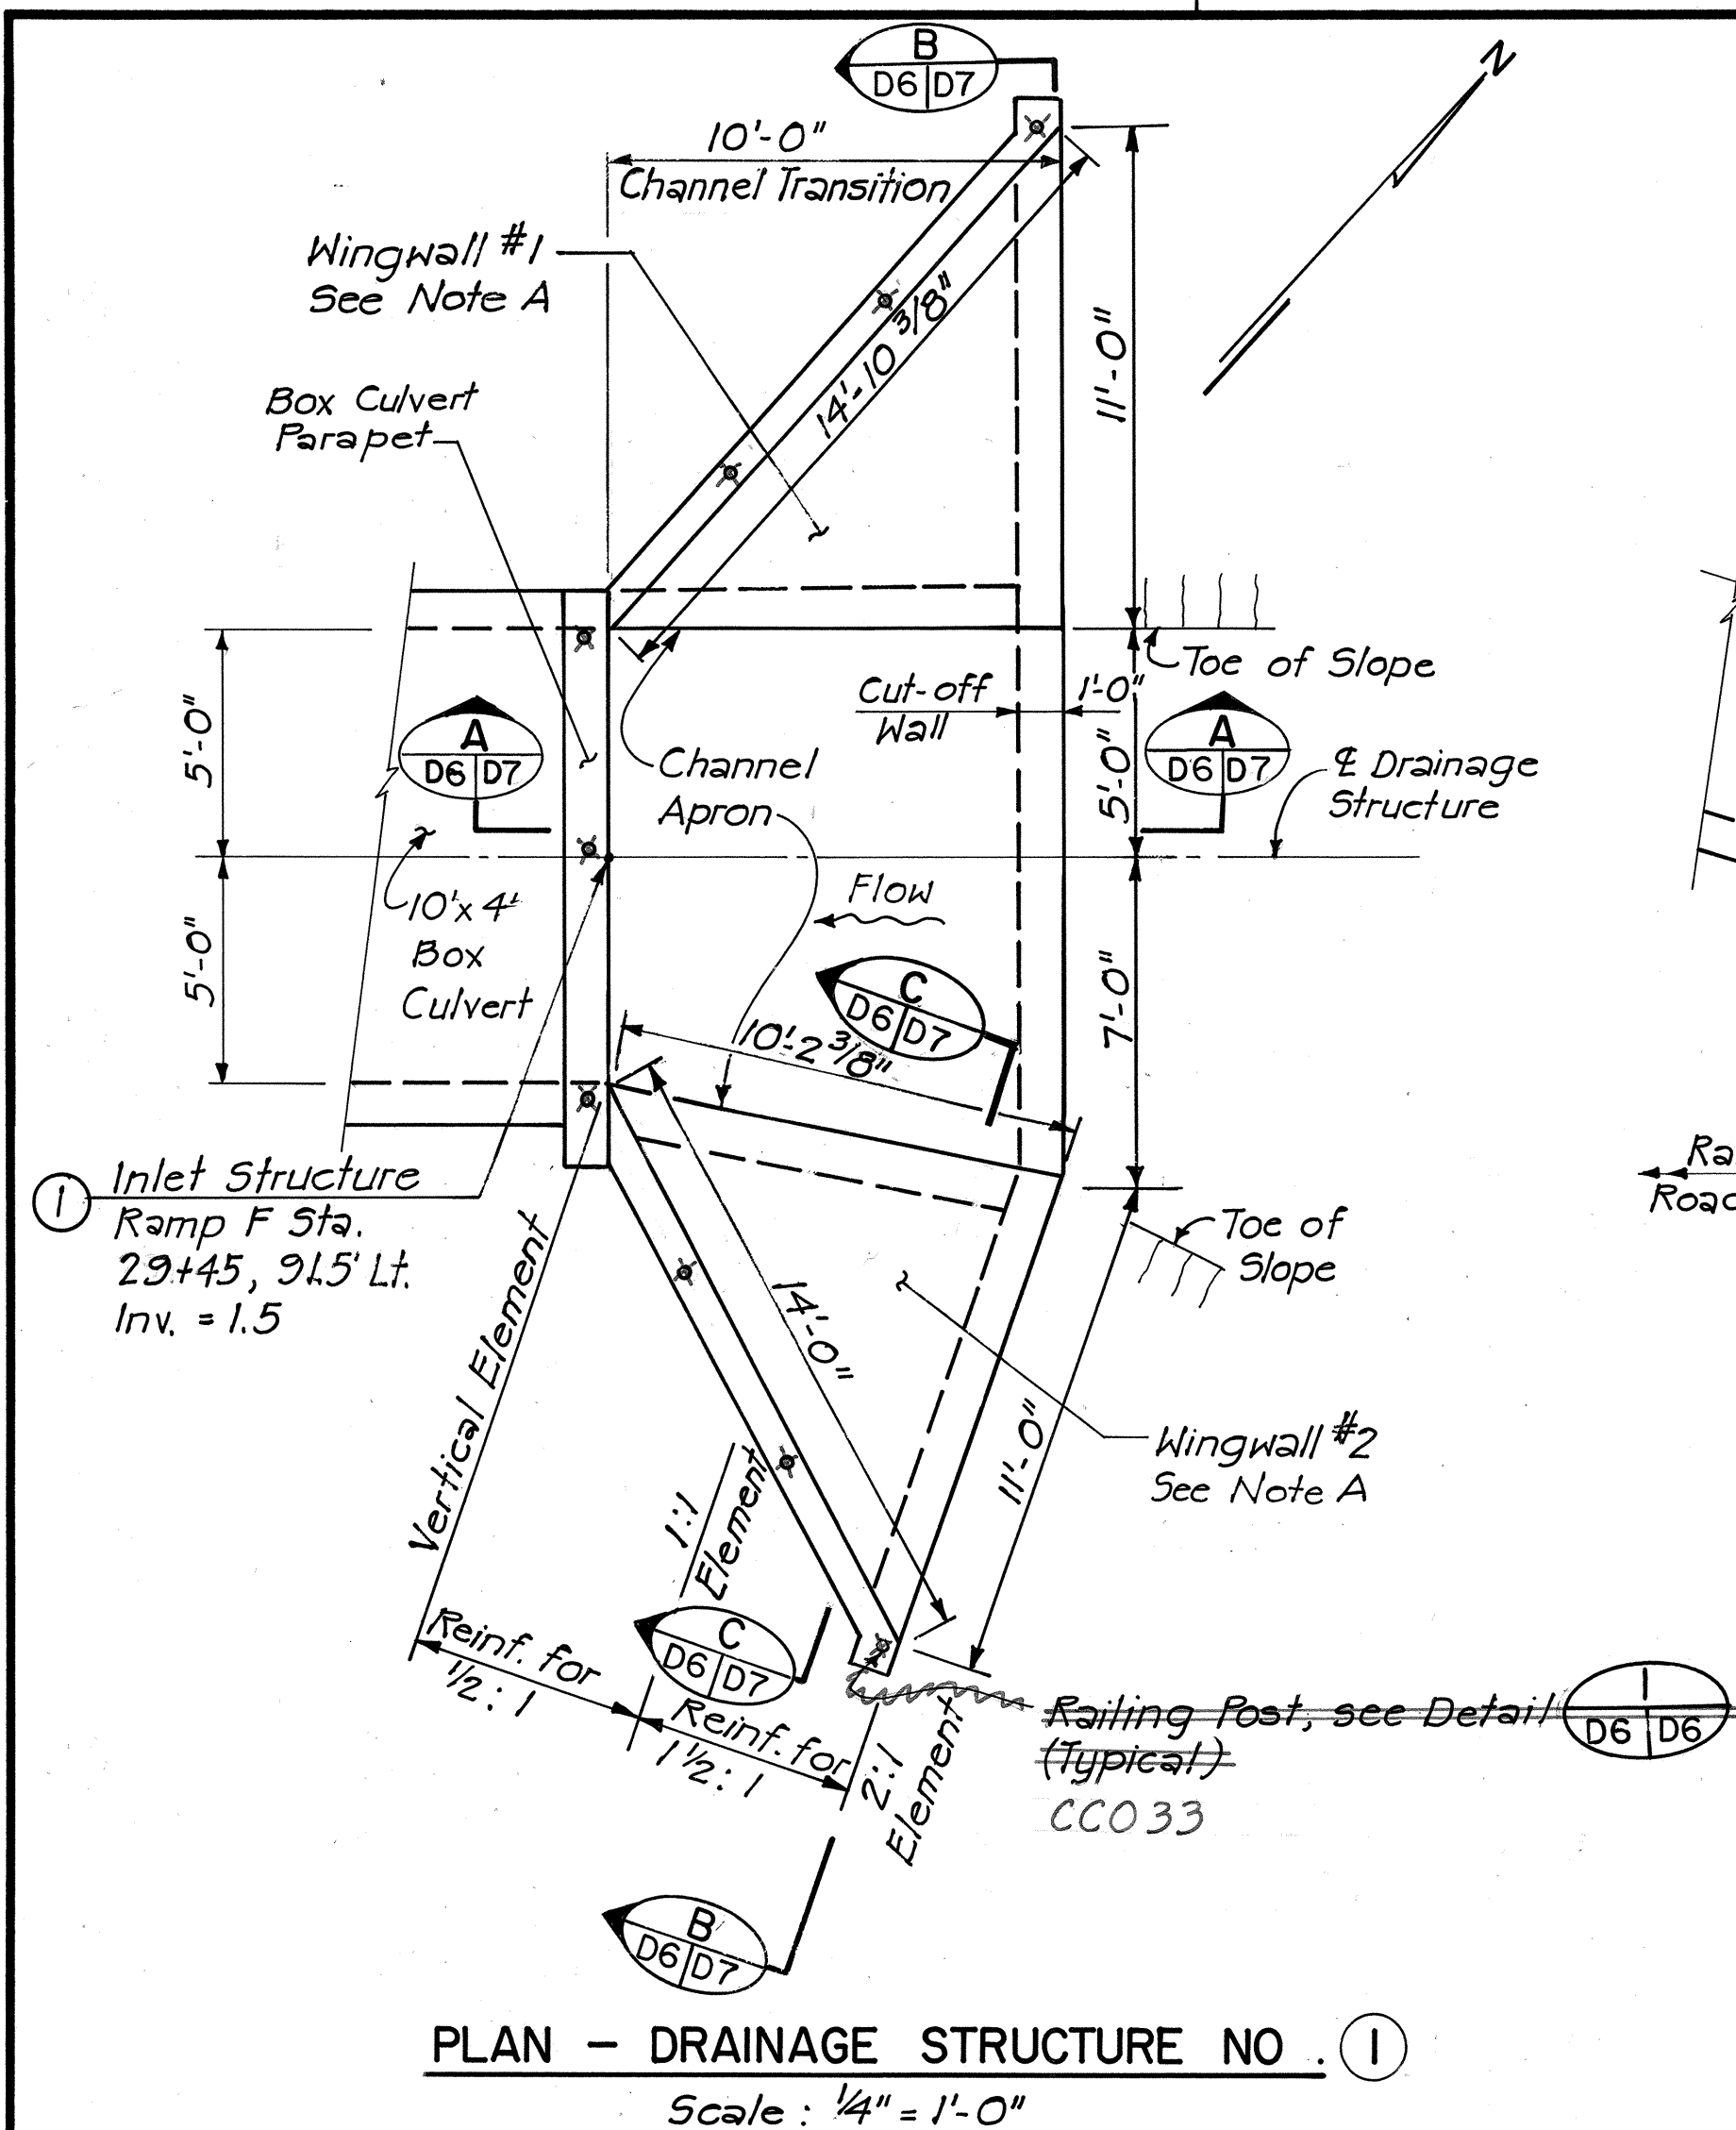

- NOTES:**
- For Reinforcement details of Drainage Structures ① & ②, See Sheets D-7 & D-8.
 - For Drainage Structure ② Construct Box Culvert Parapet & Channel Apron cut-off Wall parallel to Ramp E Curb & Gutter.



GENERAL NOTES FOR SHEETS D-6 THRU D-13.

- Design Specifications:**
Standard Specifications for Highway Bridges AASHTO Specifications and Interim Specifications of current edition.
- Design Stresses:** $f_c' = 3000$ psi, $f_c = 1200$ psi $n = 10$ for concrete
 $f_s = 20,000$ psi for Reinf. Steel
- Materials:**
(a) All Reinf. Steel shall be ASTM Designation A615 Grade 40.
(b) All Concrete shall be Class A, unless noted.
- All dimensions relating to Reinforcing are to centers of bars unless otherwise noted.
- Except as otherwise noted, all exterior corners and re-entrance angles in concrete work shall be chamfered 3/4" x 3/4".
- For Splices not detailed, overlap rebars 24 Bar Diameters or 12" minimum; stagger all splices as approved by the Engineer.
- The Contractor shall verify the locations and Elevations of all existing utility lines and notify the respective owners before commencing excavation work for drainlines.
- The Contractor shall have the option of furnishing and installing precast 10'x4' reinforced concrete box culvert sections in lieu of constructing 10'x4' cast-in-place box culvert for Drainline #1. Shop drawings shall be submitted to the Engineer for approval.
- For Drainline #1 Structure Excavation Limits & Joint Details sheet No. D-8.

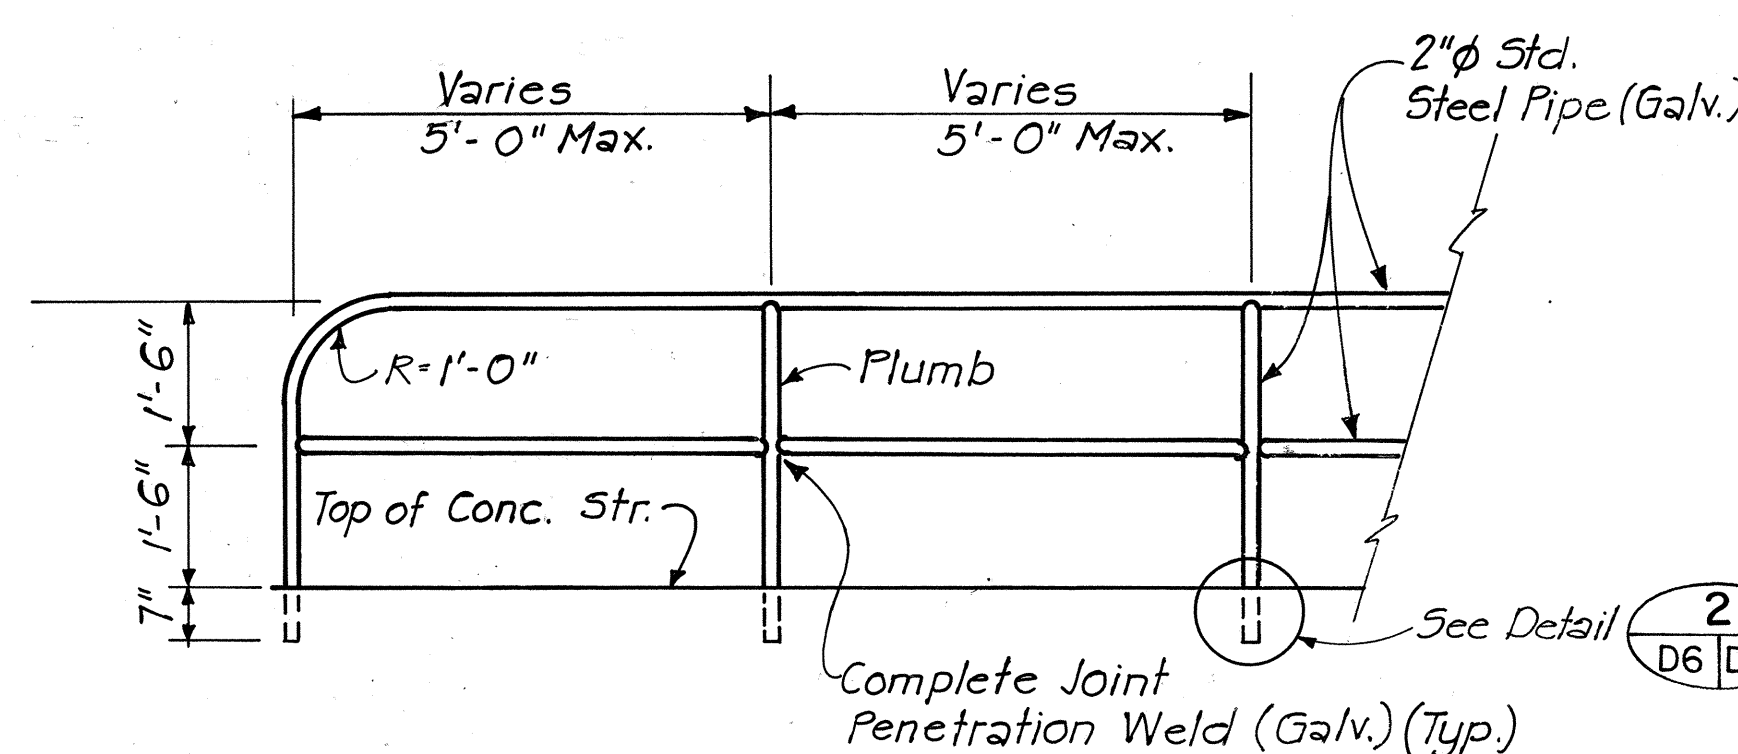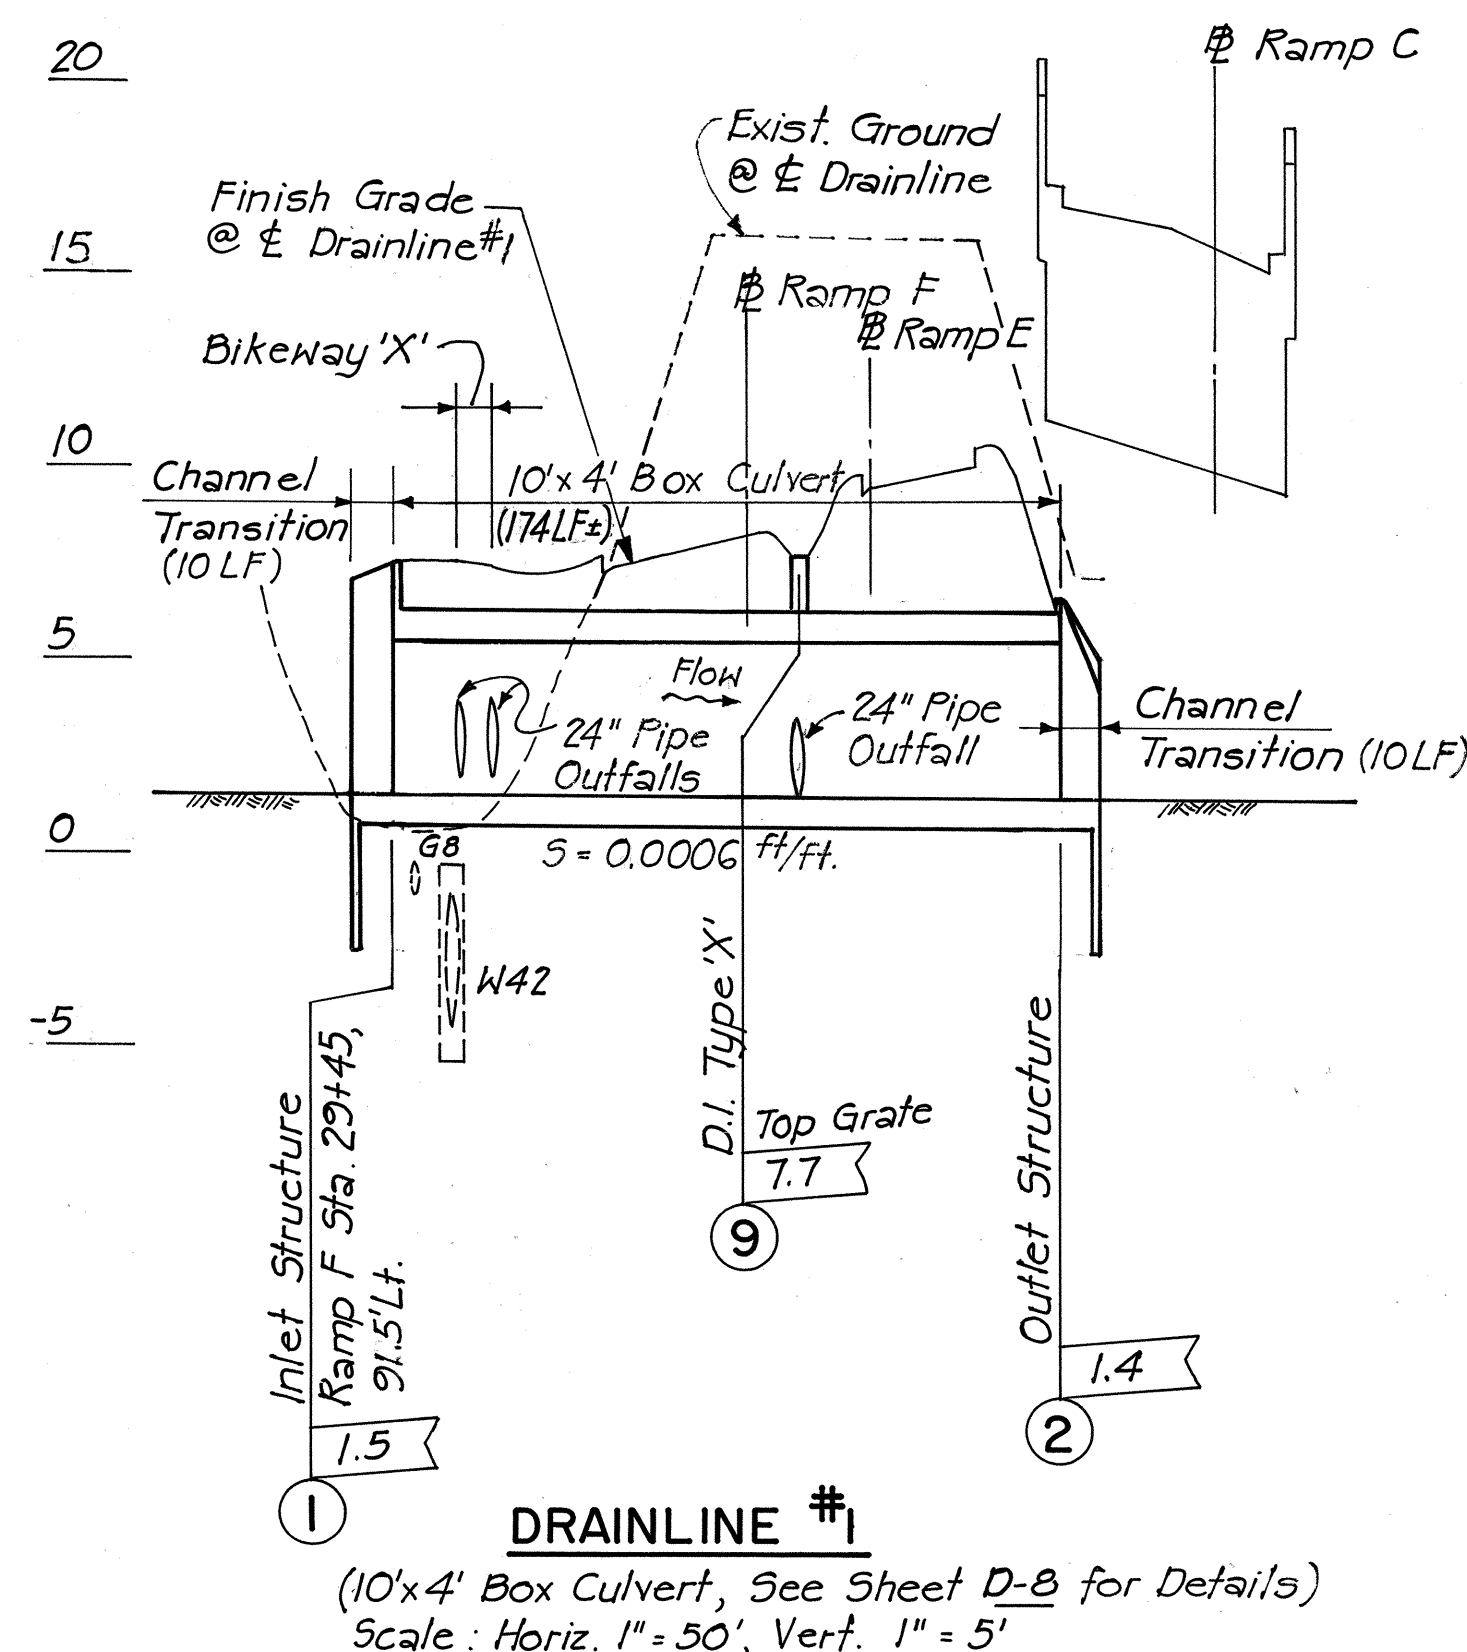

NOTE: Payment for railing will be considered incidental to various contract items.

ESTIMATED QUANTITIES FOR DRAINLINE #1 BOX CULVERT			
ITEM NO.	ITEMS	UNIT	QUANTITY
604.6500	Drainline #1 Box Culvert	L.S.	See below
—	Structure Excavation for Drainline #1 Box Culvert	—	(560 C.Y.)
—	Structure Backfill for Drainline #1 Box Culvert	—	(165 C.Y.)
—	Class A Concrete for Drainline #1 Box Culvert	—	(200 C.Y.)
—	Reinforcing Steel in Drainline #1 Box Culvert	—	(35,500 Lbs)
—	Bed Course Material for Drainline #1 Box Culvert	—	(52 C.Y.)
—	Drop Intake Type 'X'	—	(1 EA)

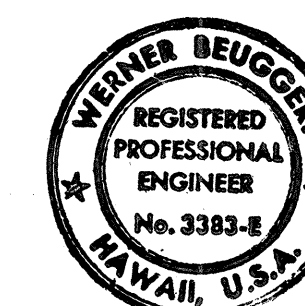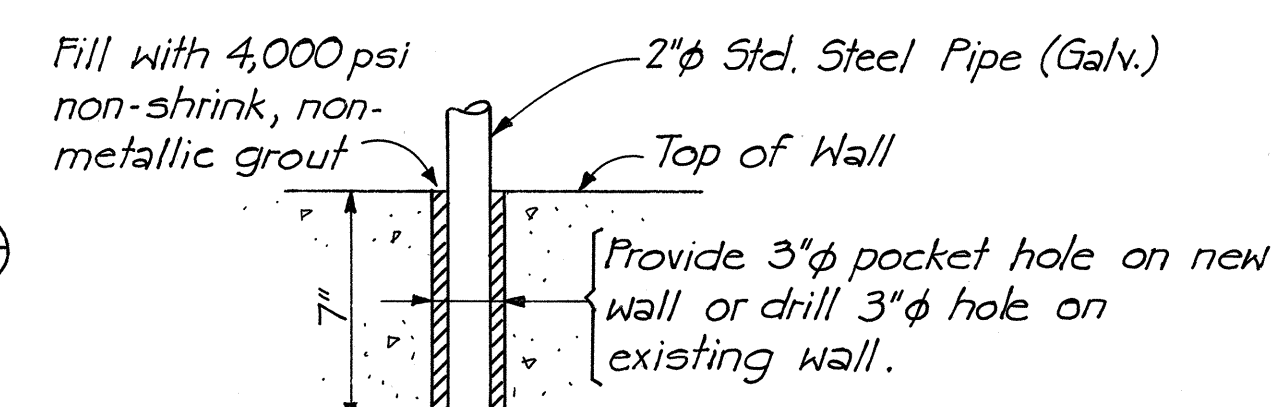

THIS WORK WAS PREPARED BY ME OR UNDER MY SUPERVISION.

STATE OF HAWAII
DEPARTMENT OF TRANSPORTATION
LAND TRANSPORTATION FACILITIES DIVISION







DRAINLINE #1 DETAILS AND GENERAL NOTES

INTERSTATE ROUTE H-1
PROJECT NO. I-IR-HI-1(169):17


SCALE: AS SHOWN DATE: 3/15/82
SHEET No. D-6 OF D-25 SHEETS

FED. ROAD DIST. NO.	STATE	AID NO.	FISCAL YEAR	SHEET NO.	TOTAL SHEETS
HAWAII	HAW	IR-HI-1(169):17	1983	52	280

WINGWALLS FOR CHANNEL TRANSITIONS					
ELEMENT SLOPE		DRAINAGE STR. ①		DRAINAGE STR. ②	
		Wingwall #1	Wingwall #2	Wingwall #3	Wingwall #4
1/2 : 1	Front & Rear Face Reinf.	#4 @ 12"	#4 @ 12"	#4 @ 12"	#4 @ 12"
1 1/2 : 1	Front Face Reinf.	#4 @ 12"	#4 @ 12"	#4 @ 12"	#4 @ 12"
	Rear Face Reinf.	#5 @ 9"	#5 @ 9"	#4 @ 9"	#4 @ 9"
	El. 'A'	7.50	7.50	6.80	6.80
	El. 'B'	7.00	7.00	5.00	4.00
	El. 'C' and El. 'D'	11.50	1.5	1.4	1.4

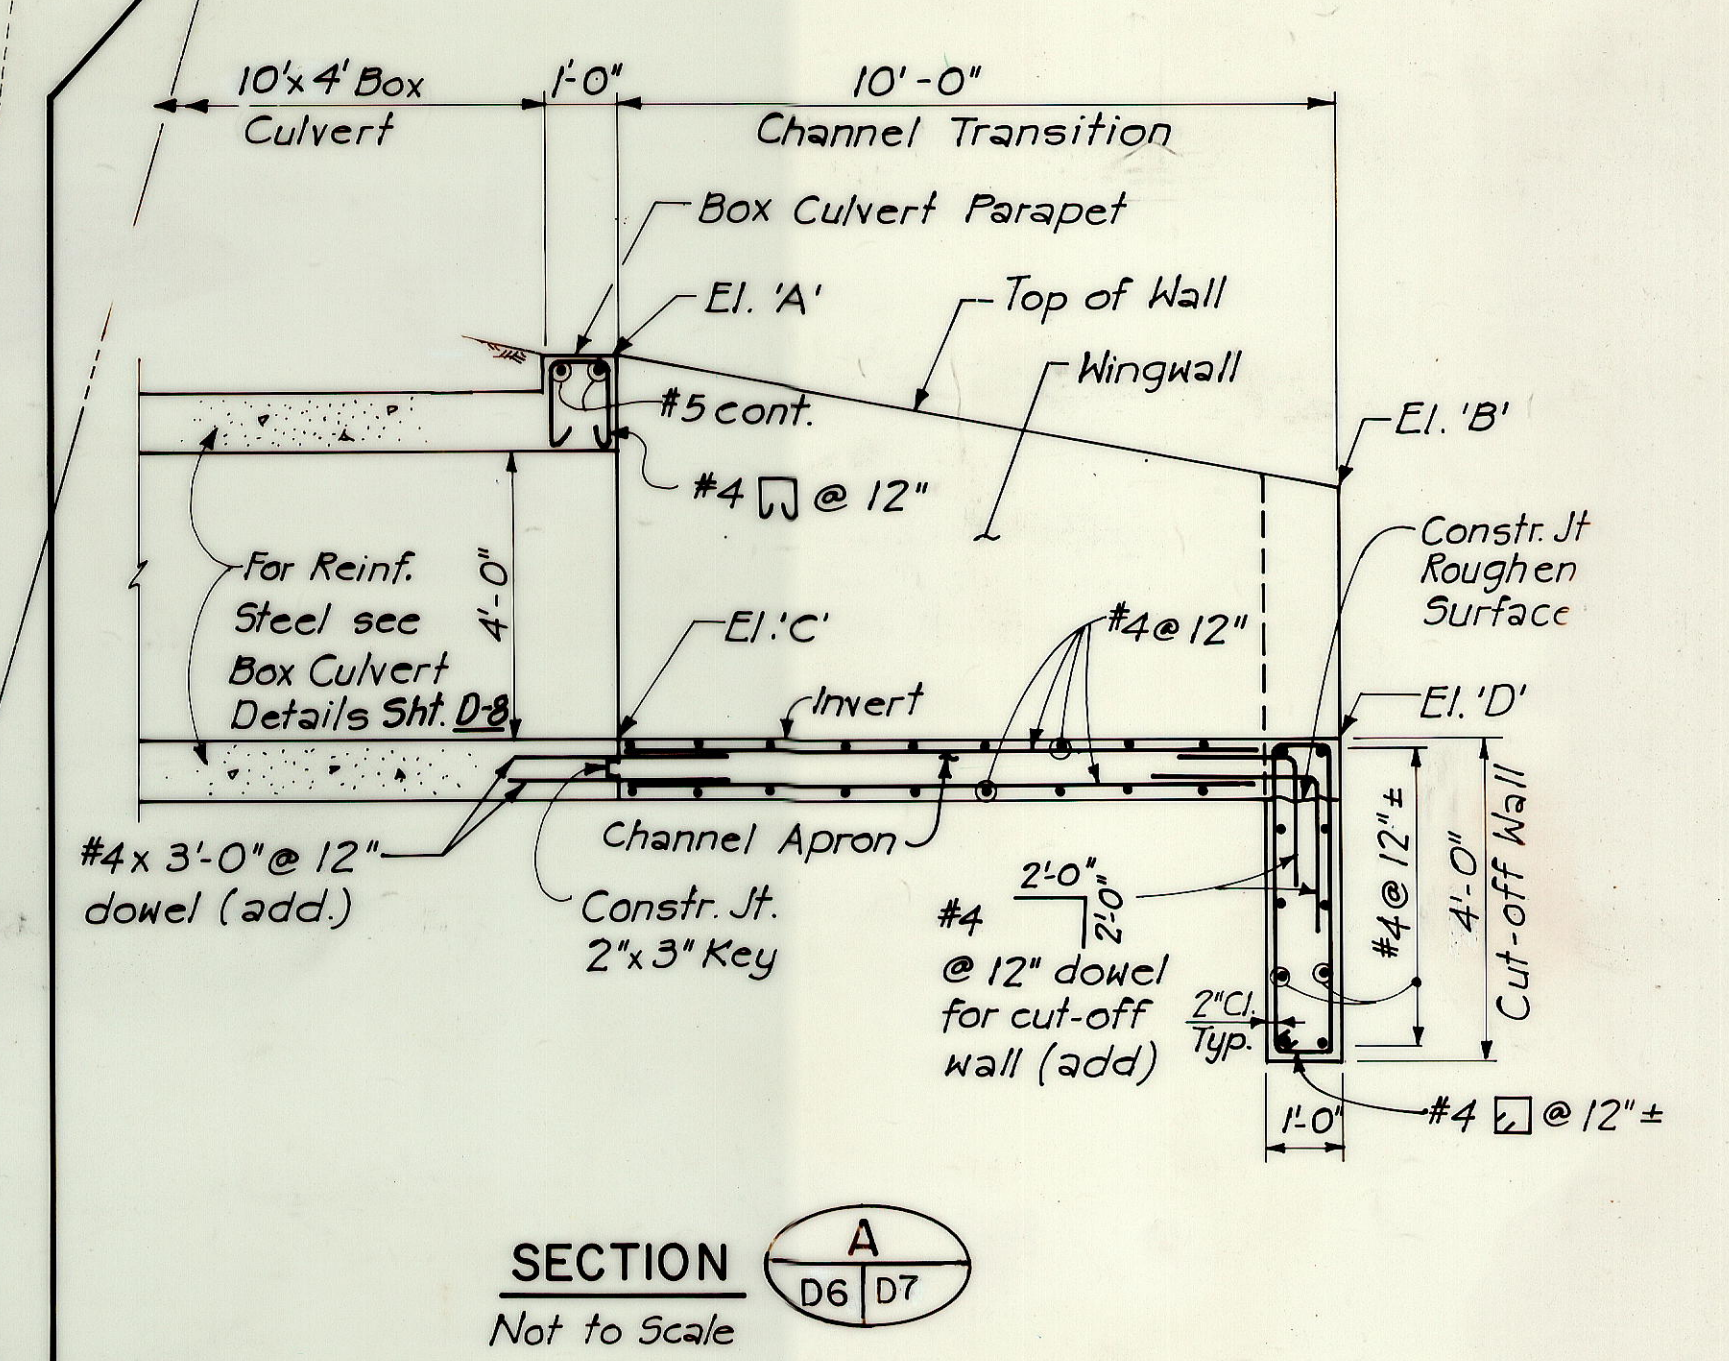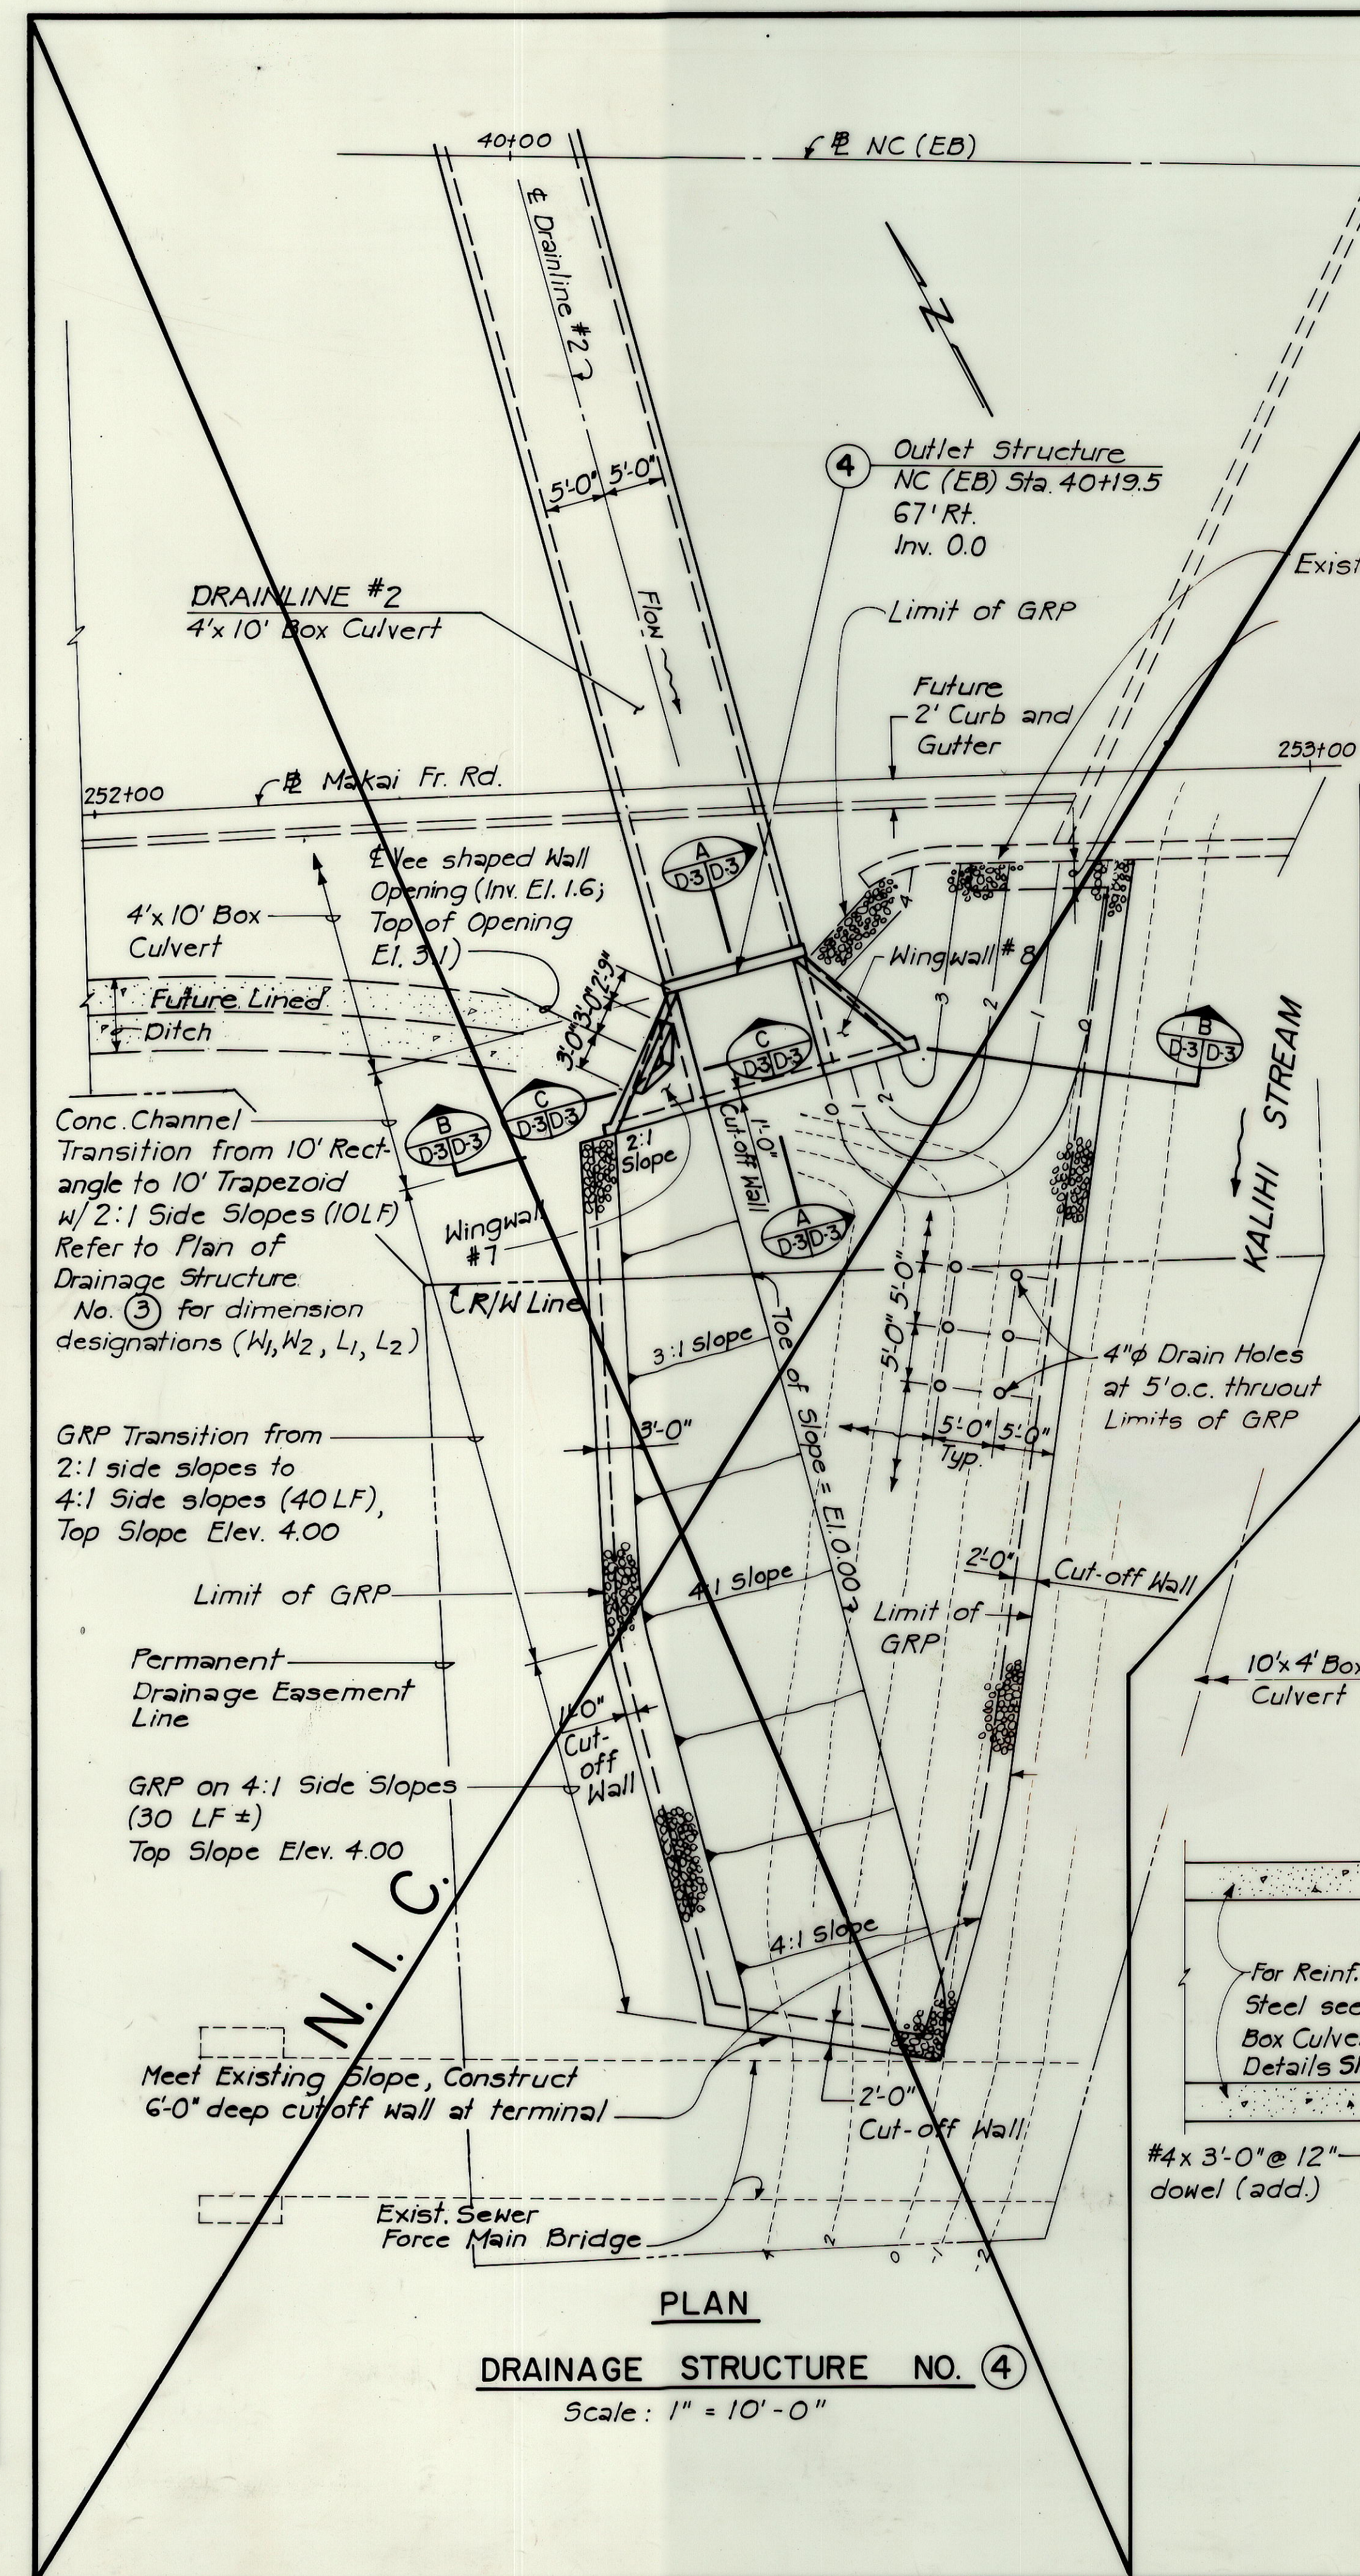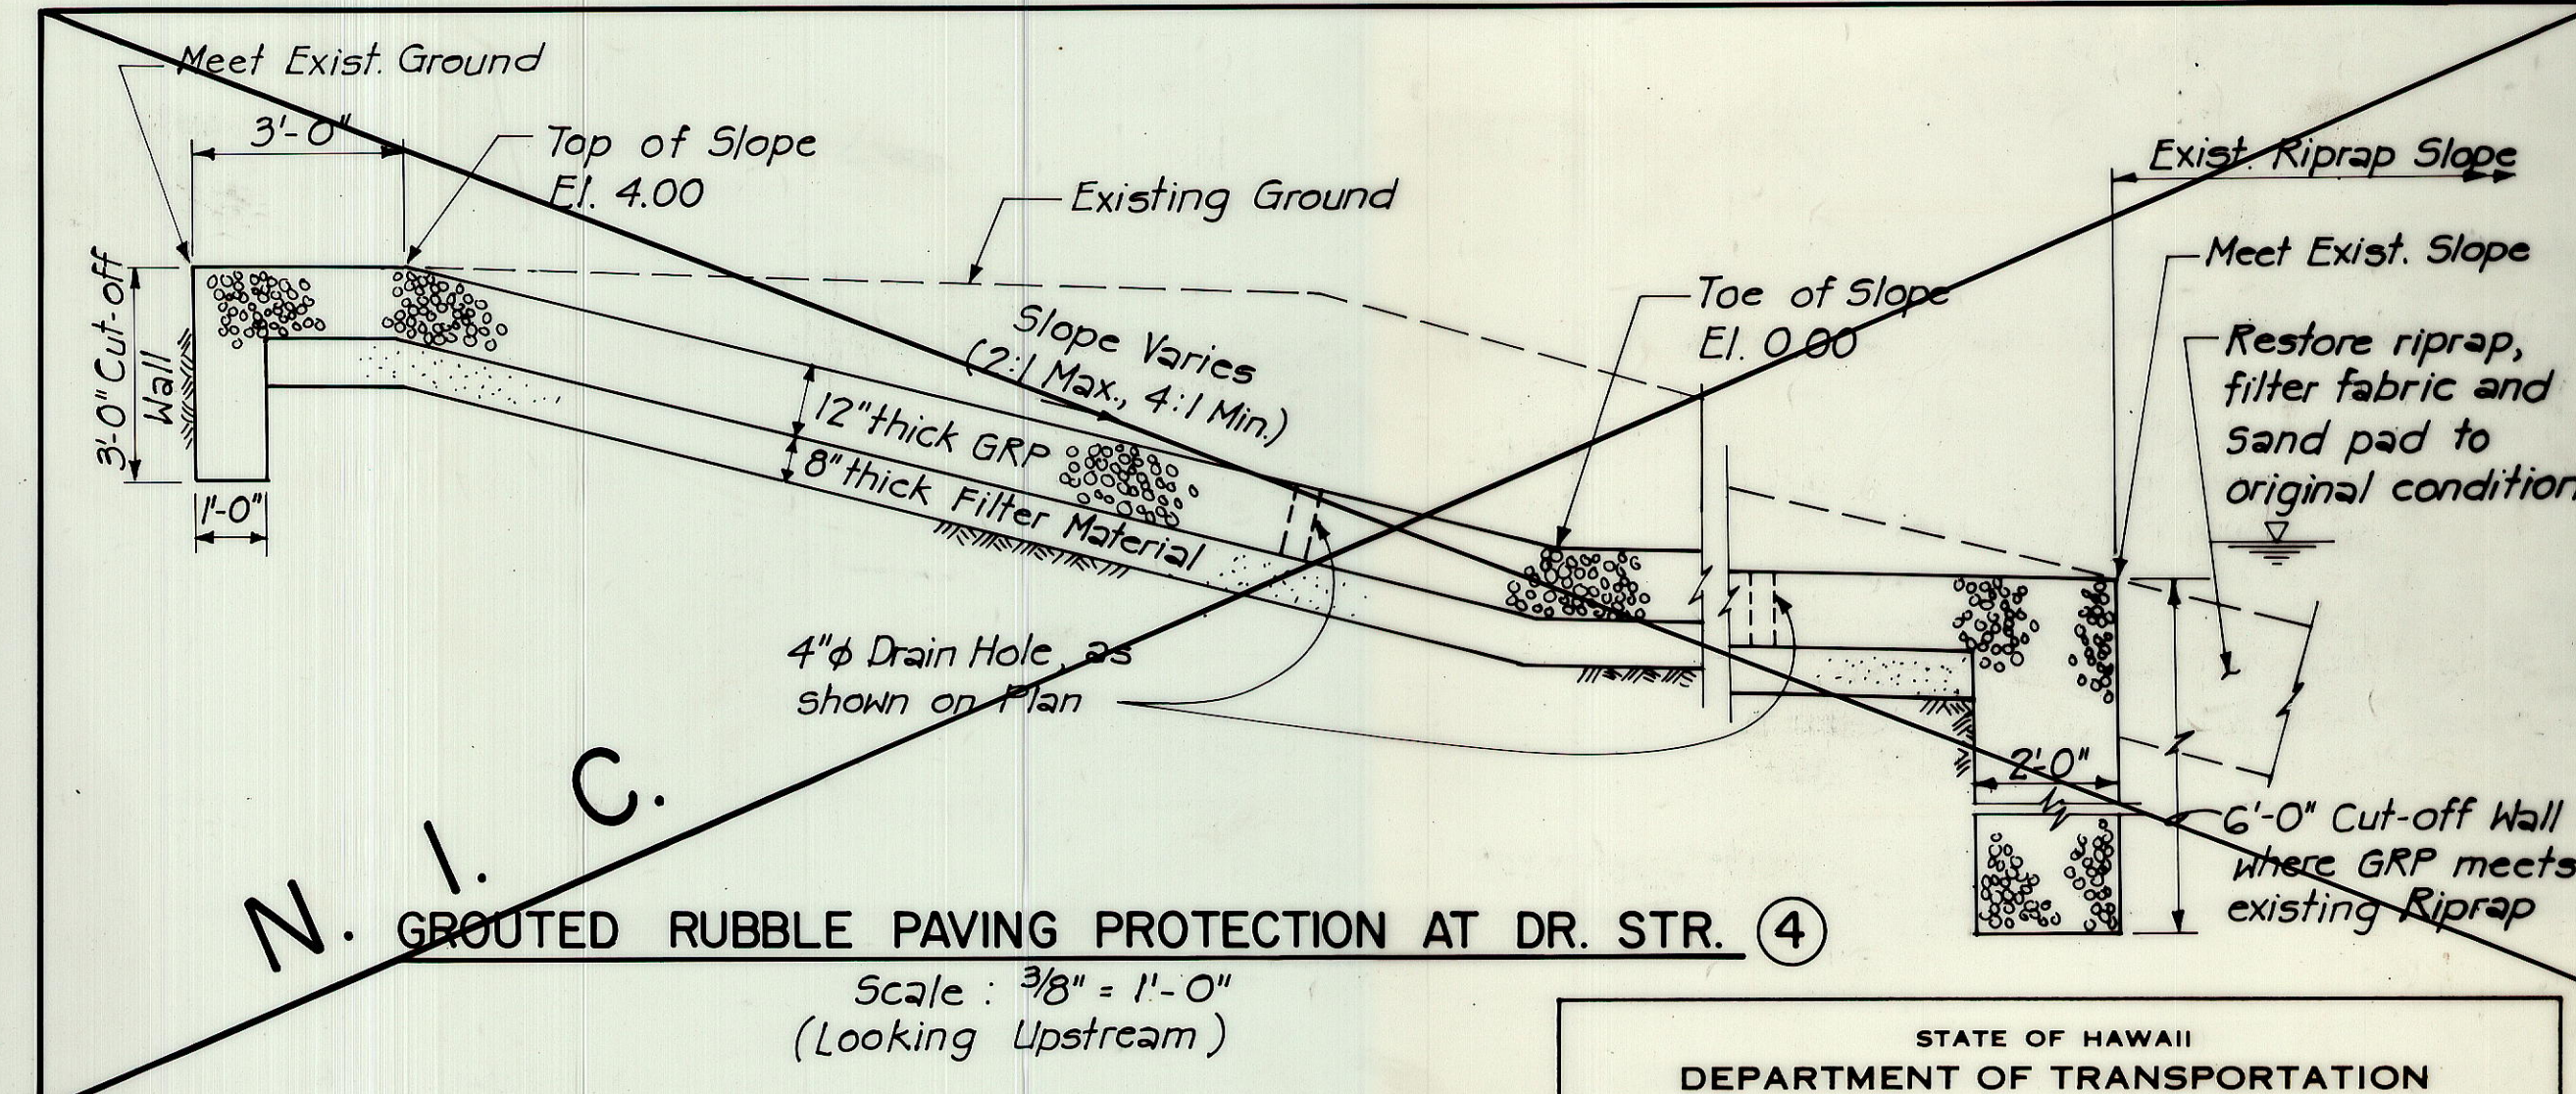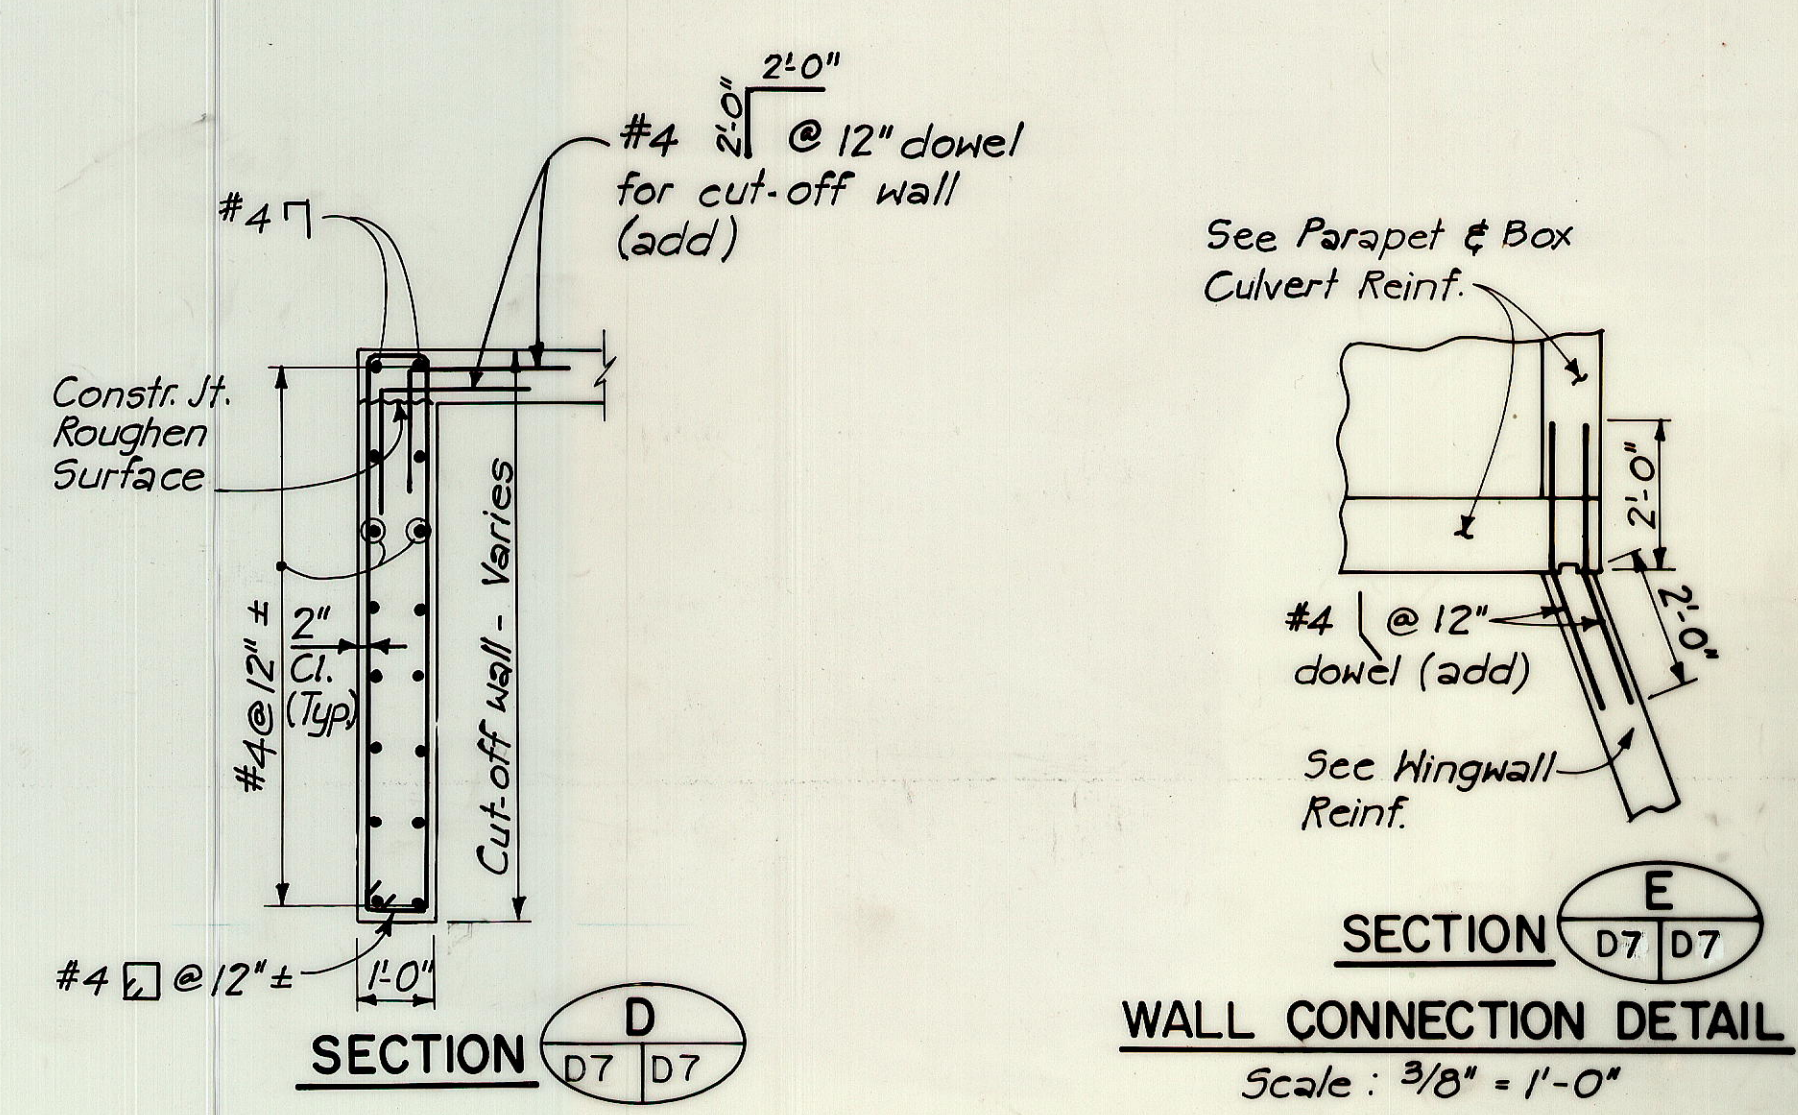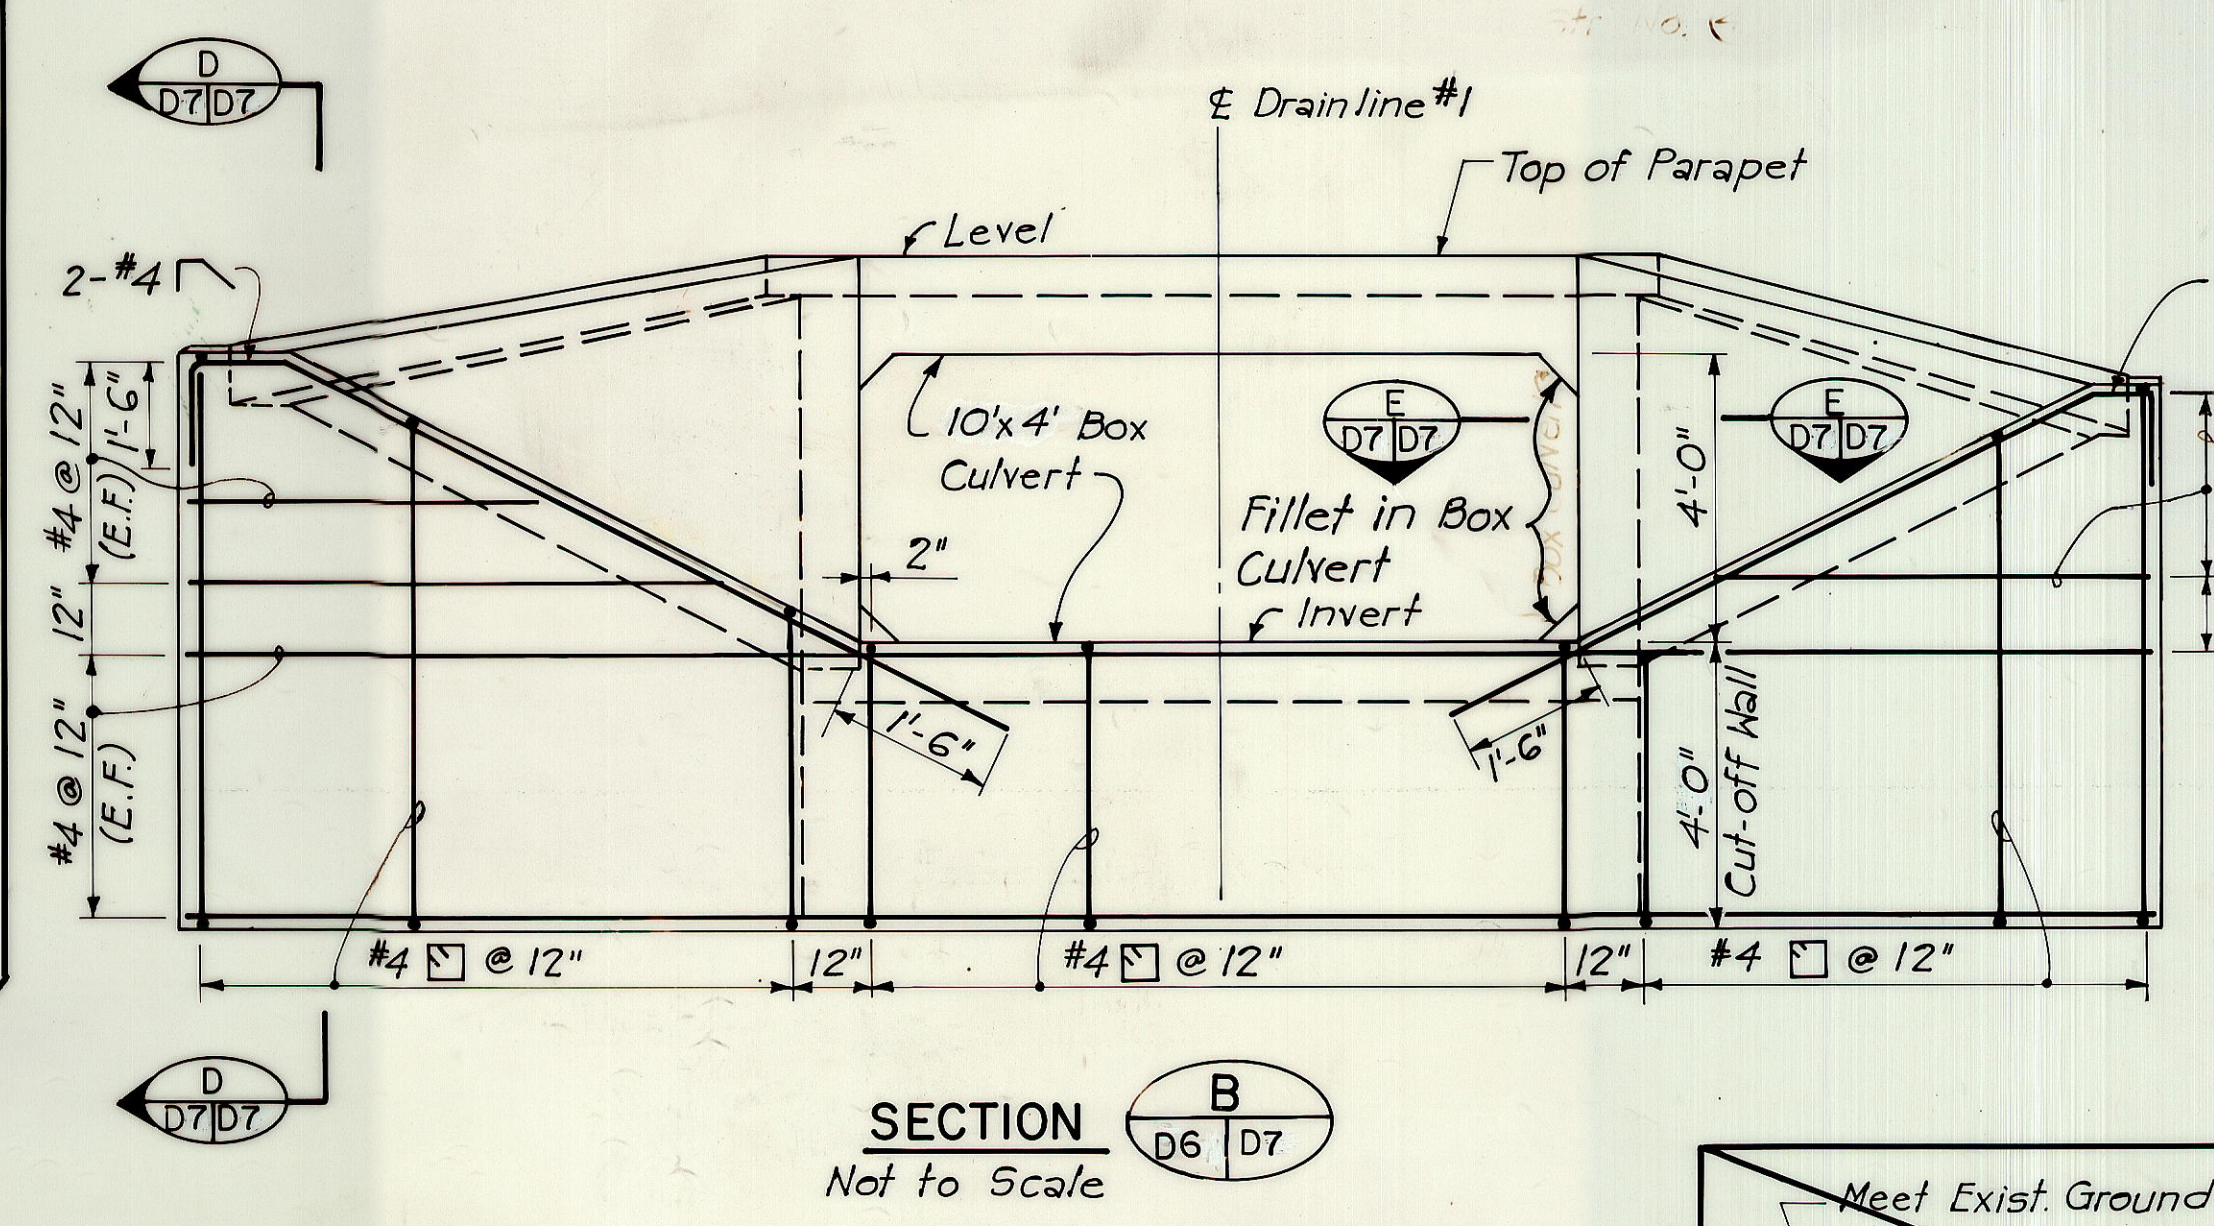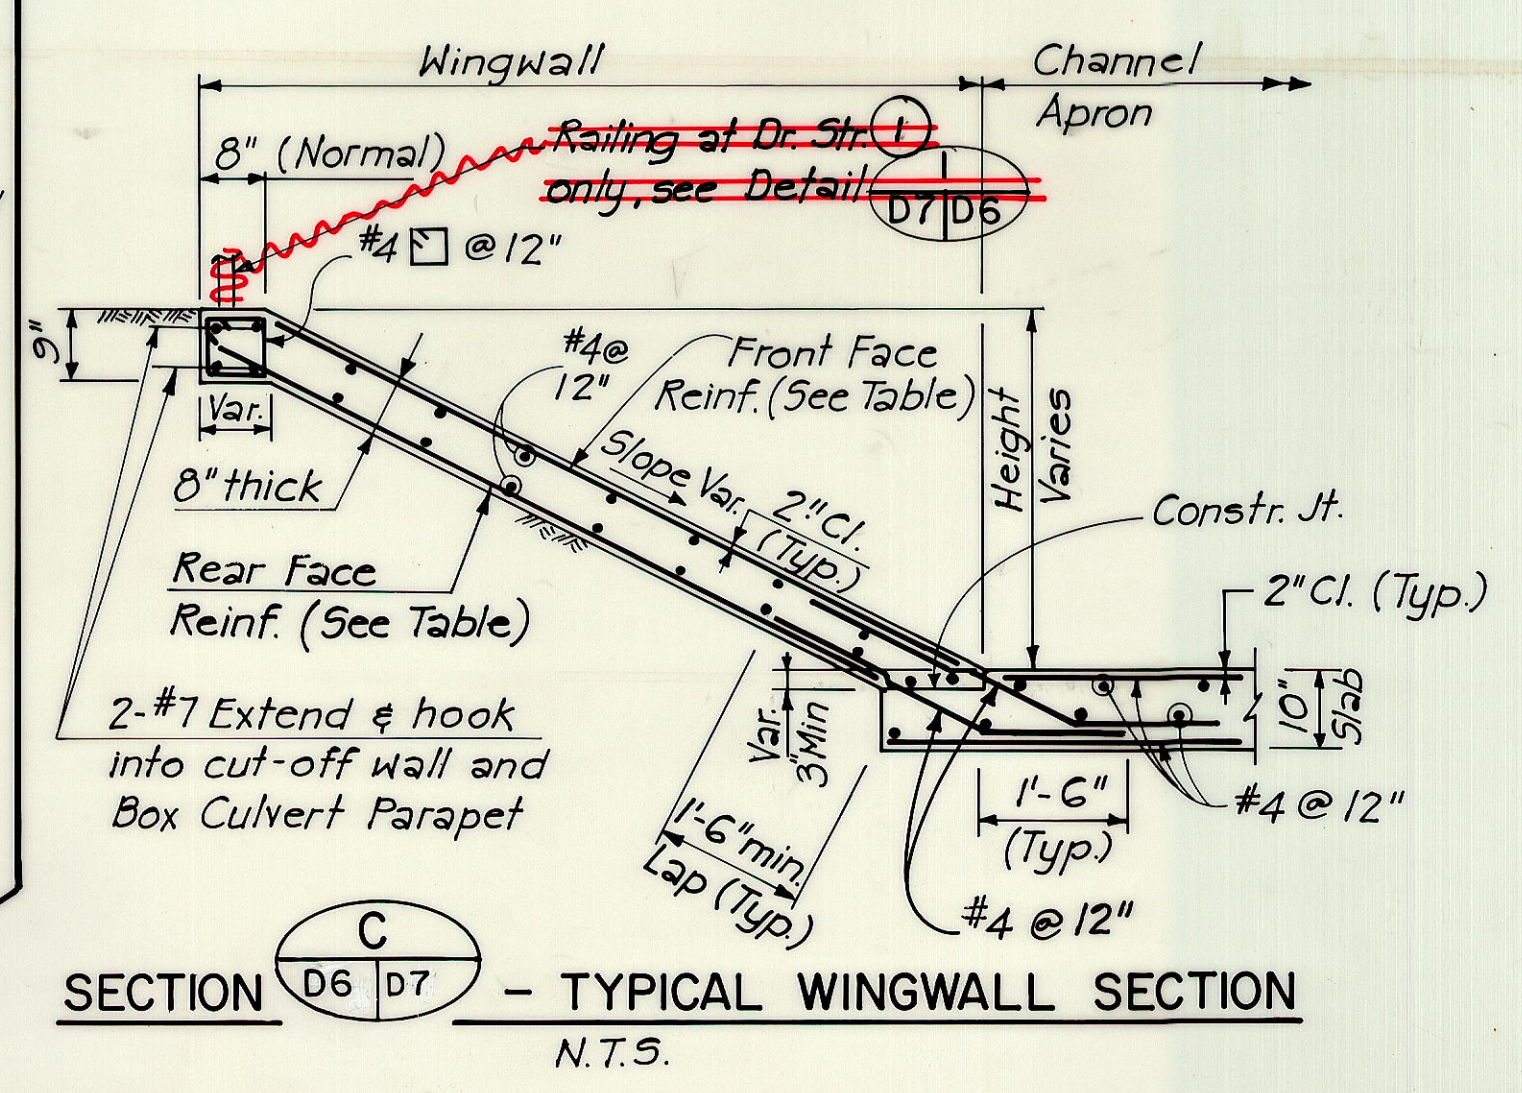

NOTE:
For General Notes see Sheet D-6.

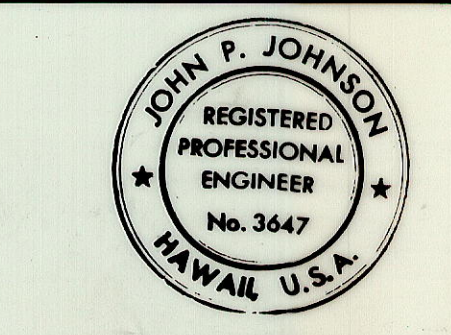

STATE OF HAWAII
DEPARTMENT OF TRANSPORTATION
HIGHWAYS DIVISION


DRAINLINE #1 DETAILS

INTERSTATE ROUTE H-1
PROJECT NO. I-IR-HI-1(169):17

SCALE: AS SHOWN DATE: 6/15/81
SHEET No. D-7 OF D-25 SHEETS


"AS-BUILT"

FED. ROAD DIST. NO.	STATE	FED. AID PROJ. NO.	FISCAL YEAR	SHEET NO.	TOTAL SHEETS
HAWAII	HAW.	IR-HI-1(169)17	1983	53	280

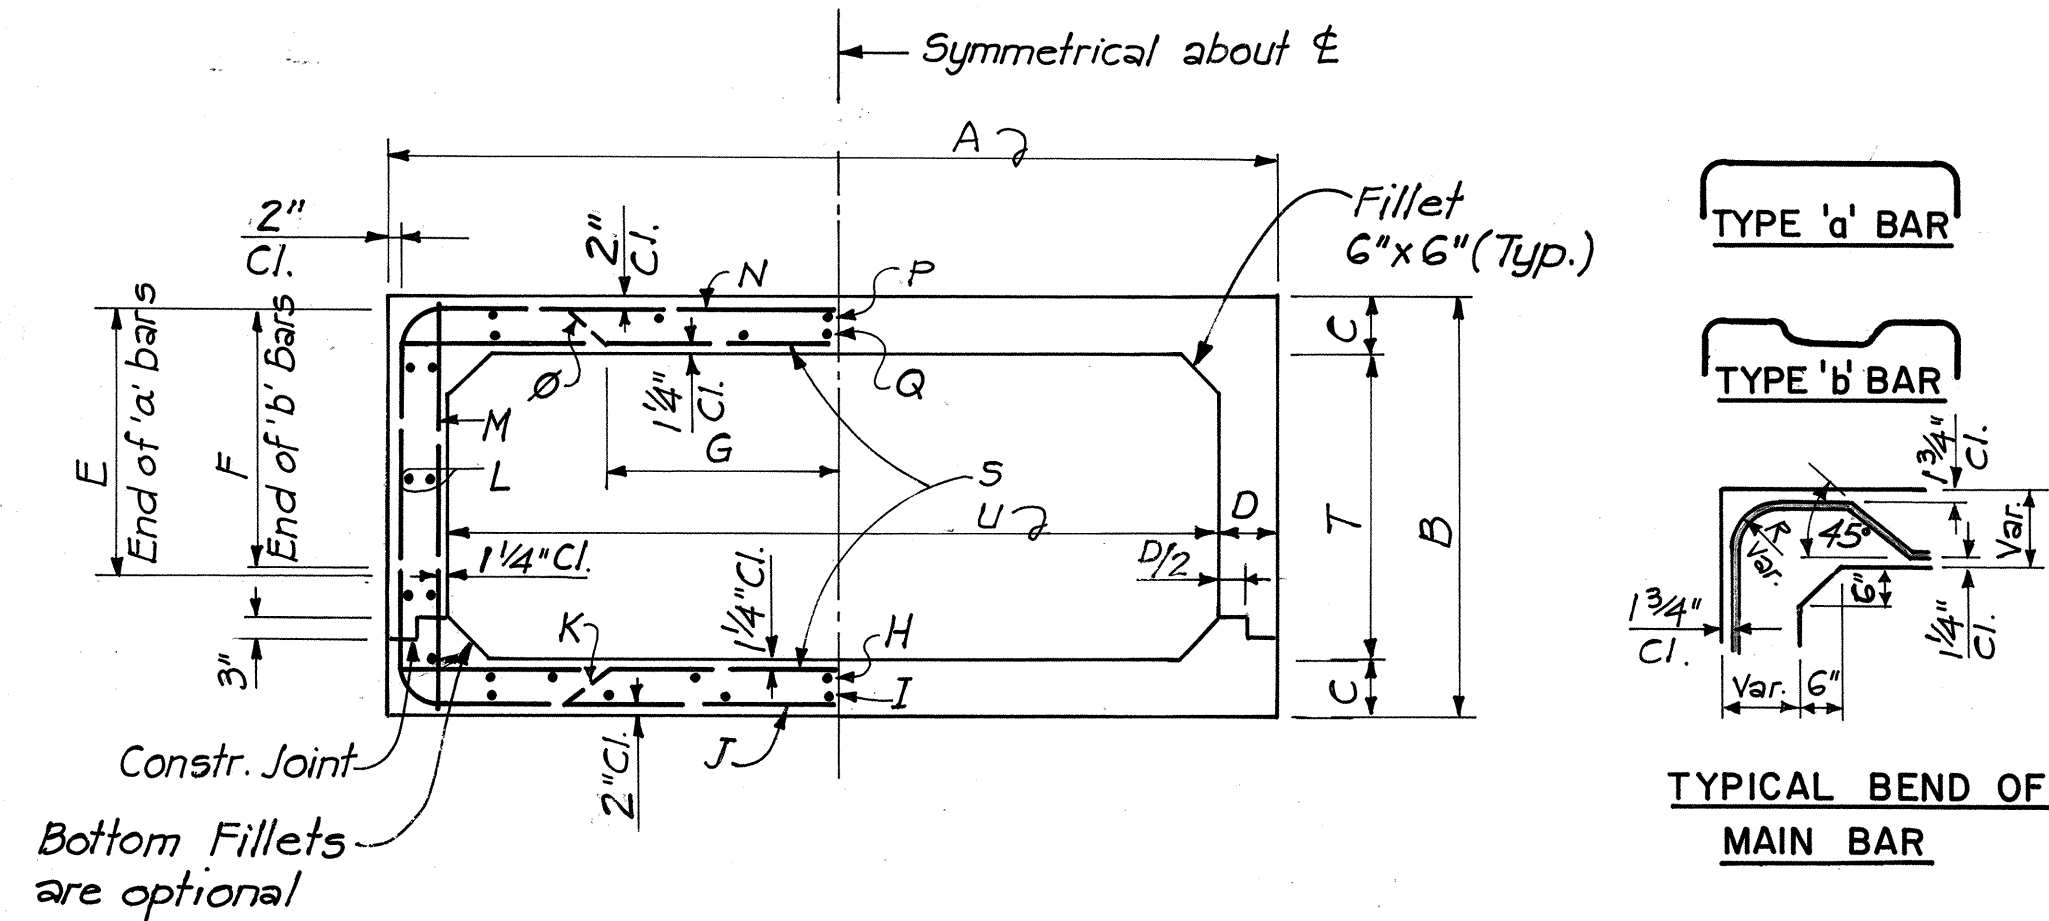

**TYPICAL BOX CULVERT SECTION
FOR DRAINLINE NOS. 1 & 8**


Not to Scale
(For General Notes, see Sheet D-6)

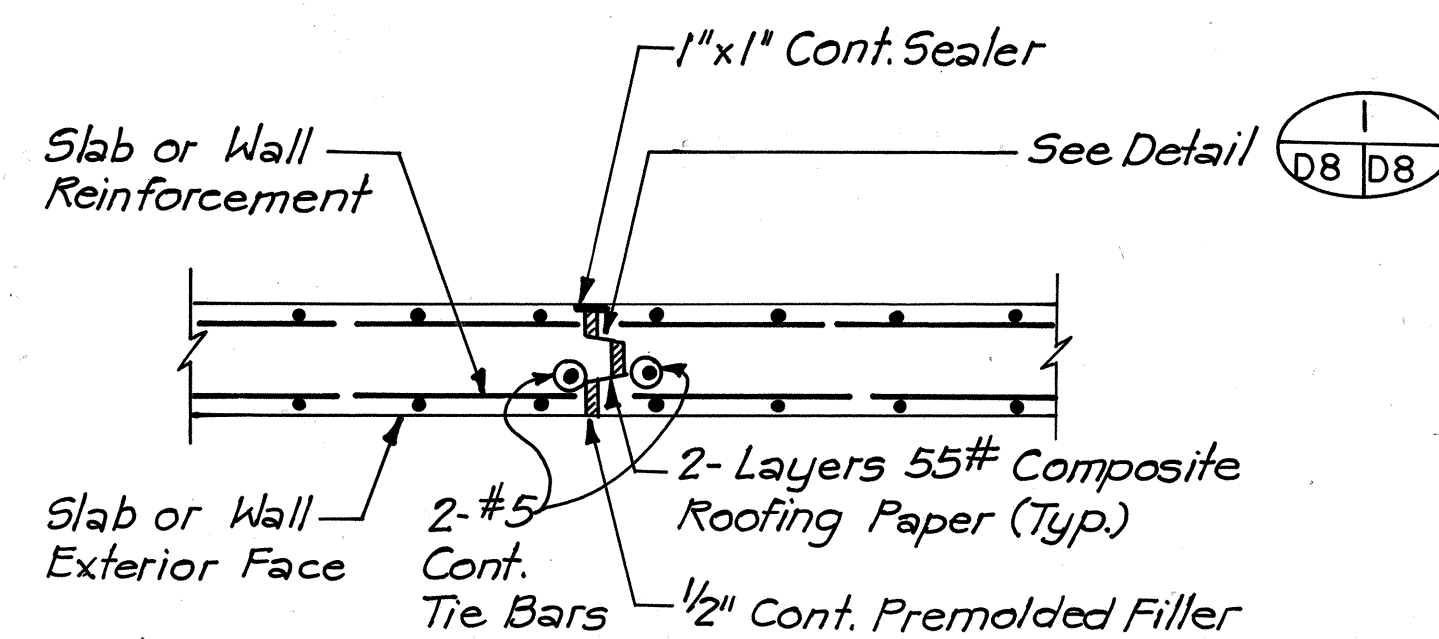

TYPICAL TRANSVERSE JOINT

Not to Scale


NOTE: Spacing of Joints @ 20'-0" max.

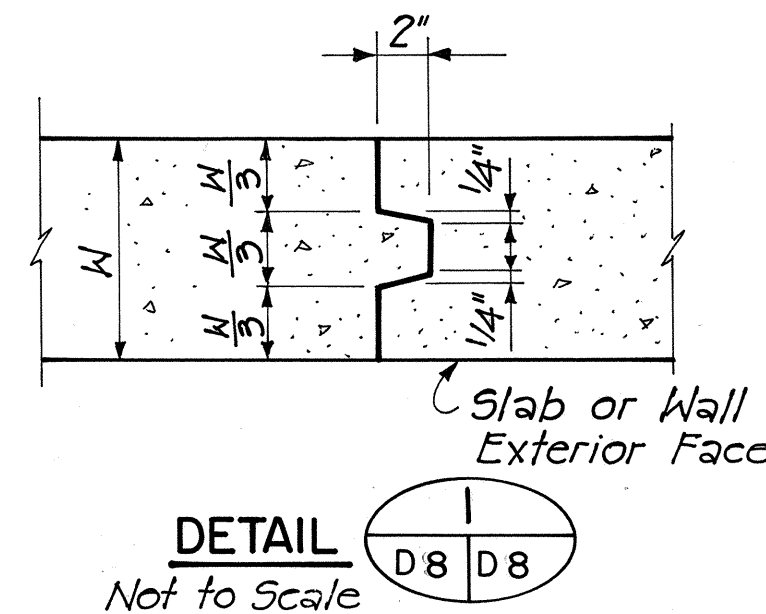

DETAIL D8 D8


Not to Scale

BOX CULVERT SCHEDULES			
MARK	BOX CULVERT Drainline #1	BOX CULVERT 'II' Drainline #8	BOX CULVERT 'III' Drainline #8
A	11' - 8"	5' - 3"	Varies, 9' - 6" Max.
B	5' - 8"	Varies, 3' - 8 1/4" Max.	Varies, 4' - 3 1/2" Max.
C	0' - 10"	0' - 7 1/2"	0' - 9 1/2"
D	0' - 10"	0' - 7 1/2"	0' - 9"
E	3' - 6"	2' - 7"	3' - 7"
F	3' - 6"	1' - 6"	3' - 3"
G	3' - 6"	1' - 6"	3' - 0"
R	0' - 7"	0' - 6"	0' - 7"
T	4' - 0"	Varies, 2' - 5 1/4" Max.	Varies, 3' - 3 1/2" Max.
U	10' - 0"	4' - 0"	8' - 0"
H	#4 @ 9"	#4 @ 8"	#4 @ 9"
I	#4 @ 18"	#4 @ 18"	#4 @ 18"
J (Type 'a' Bars)	#5 @ 12"	#4 @ 12"	#4 @ 10"
K (Type 'b' Bars)	#6 @ 12"	#4 @ 12"	#5 @ 10"
L	#4 @ 18"	#4 @ 14"	#4 @ 18"
M	#4 @ 18"	#4 @ 18"	#4 @ 15"
N (Type 'a' Bars)	#5 @ 12"	#4 @ 12"	#4 @ 10"
Ø (Type 'b' Bars)	#6 @ 12"	#4 @ 12"	#5 @ 10"
P	#4 @ 18"	#4 @ 18"	#4 @ 18"
Q	#6 @ 12"	#4 @ 8"	#5 @ 10"
S	#6 @ 6"	#4 @ 4"	#5 @ 5"
Transition	(Alt. Bars Bent)	(Every Third Bar Bent)	(Alt. Bars Bent)

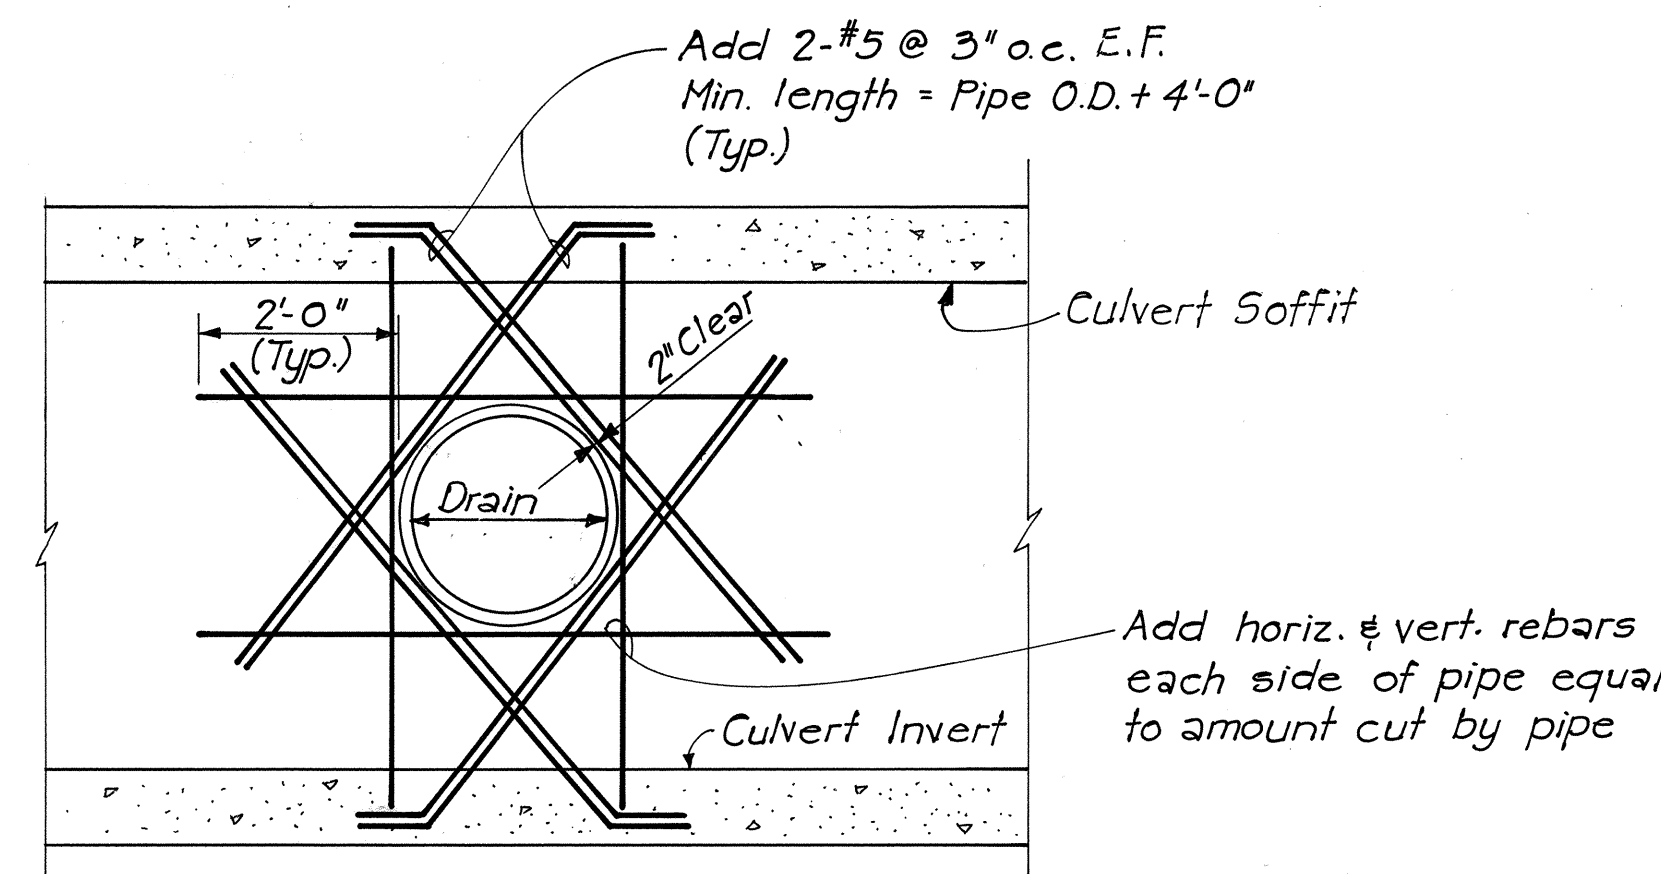


PIPE OUTFALL NOS. 8A, 11A & 21A

Not to Scale

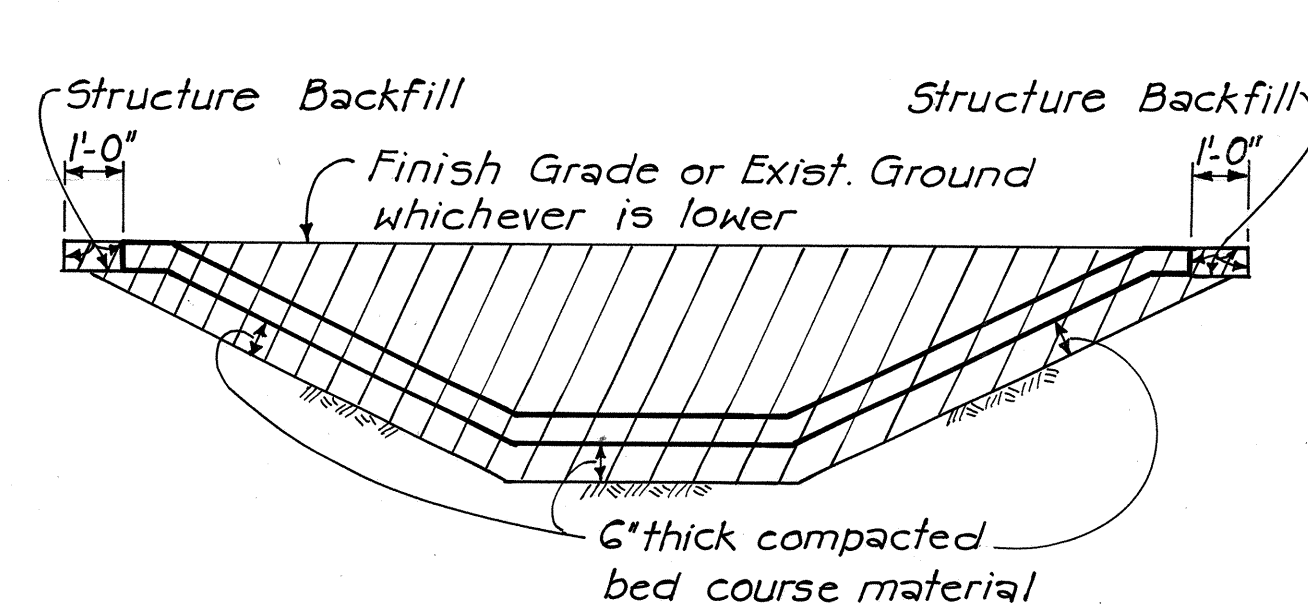

CHANNEL TRANSITION

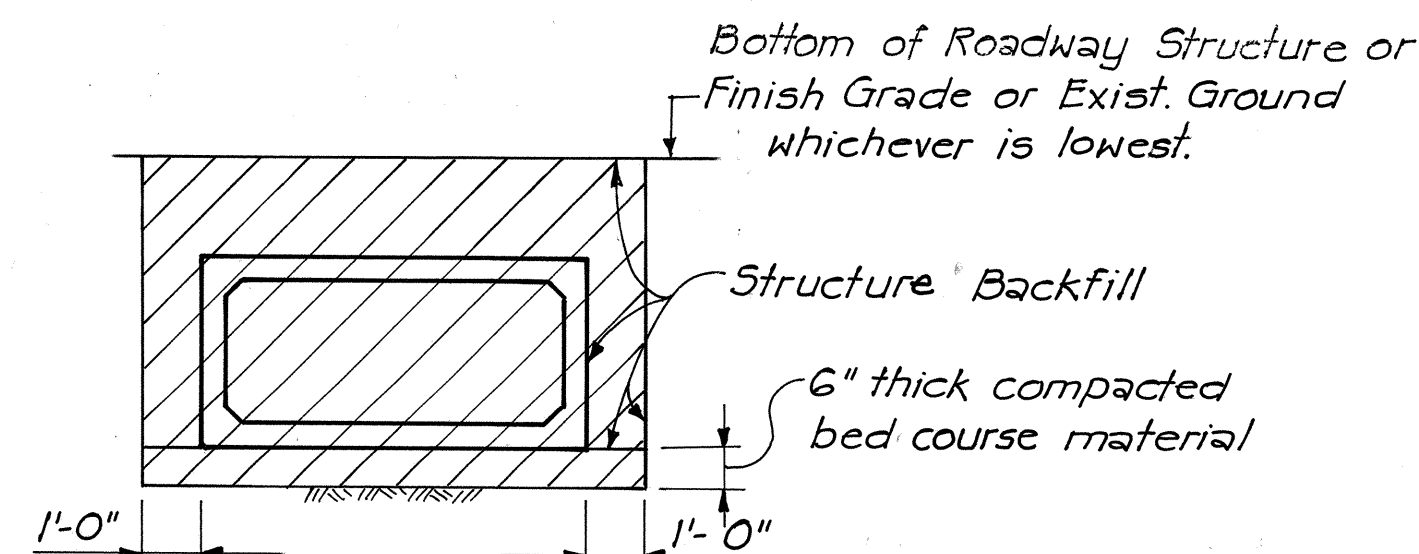


CONC. BOX CULVERT

NOTE A:


The Hatched Area denotes Limits of Structure Excavation.
All other excavation shall be Roadway Excavation except as otherwise noted.

STRUCTURE EXCAVATION LIMITS


Not to Scale

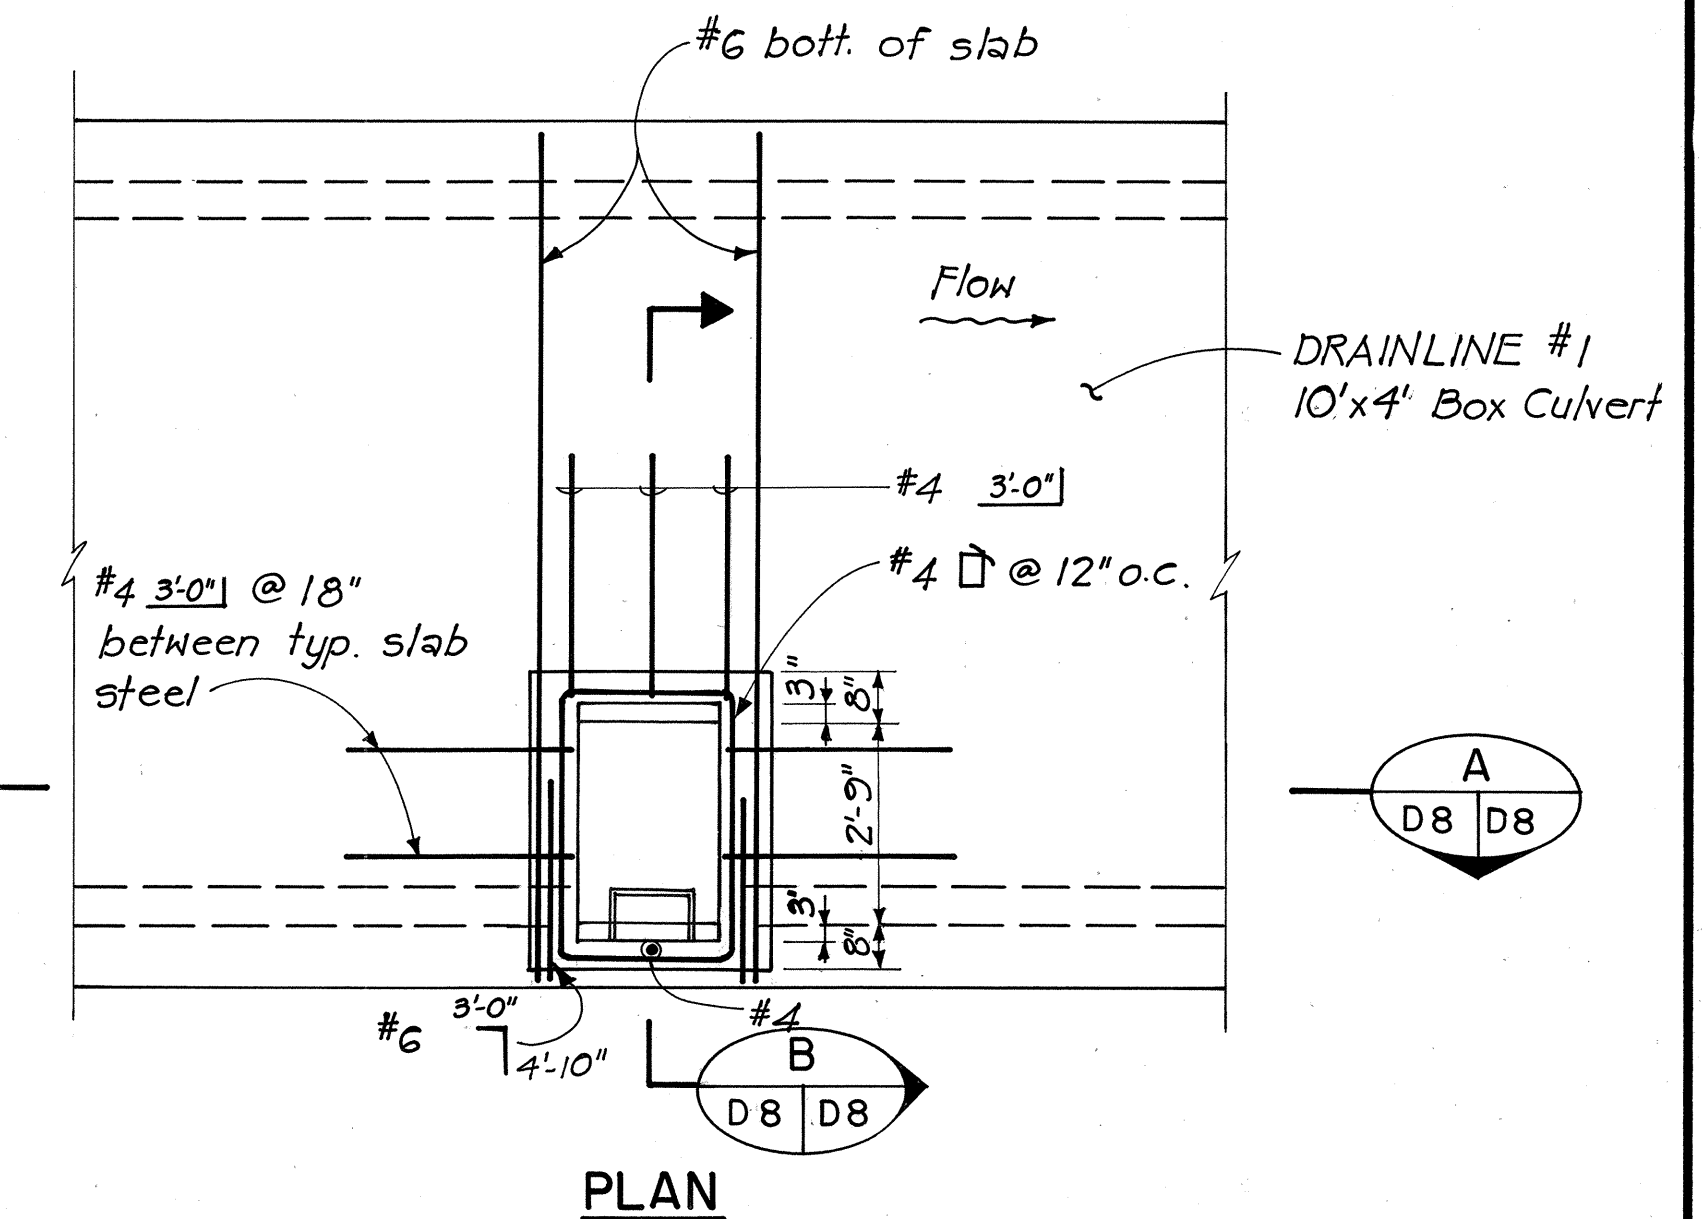

PLAN

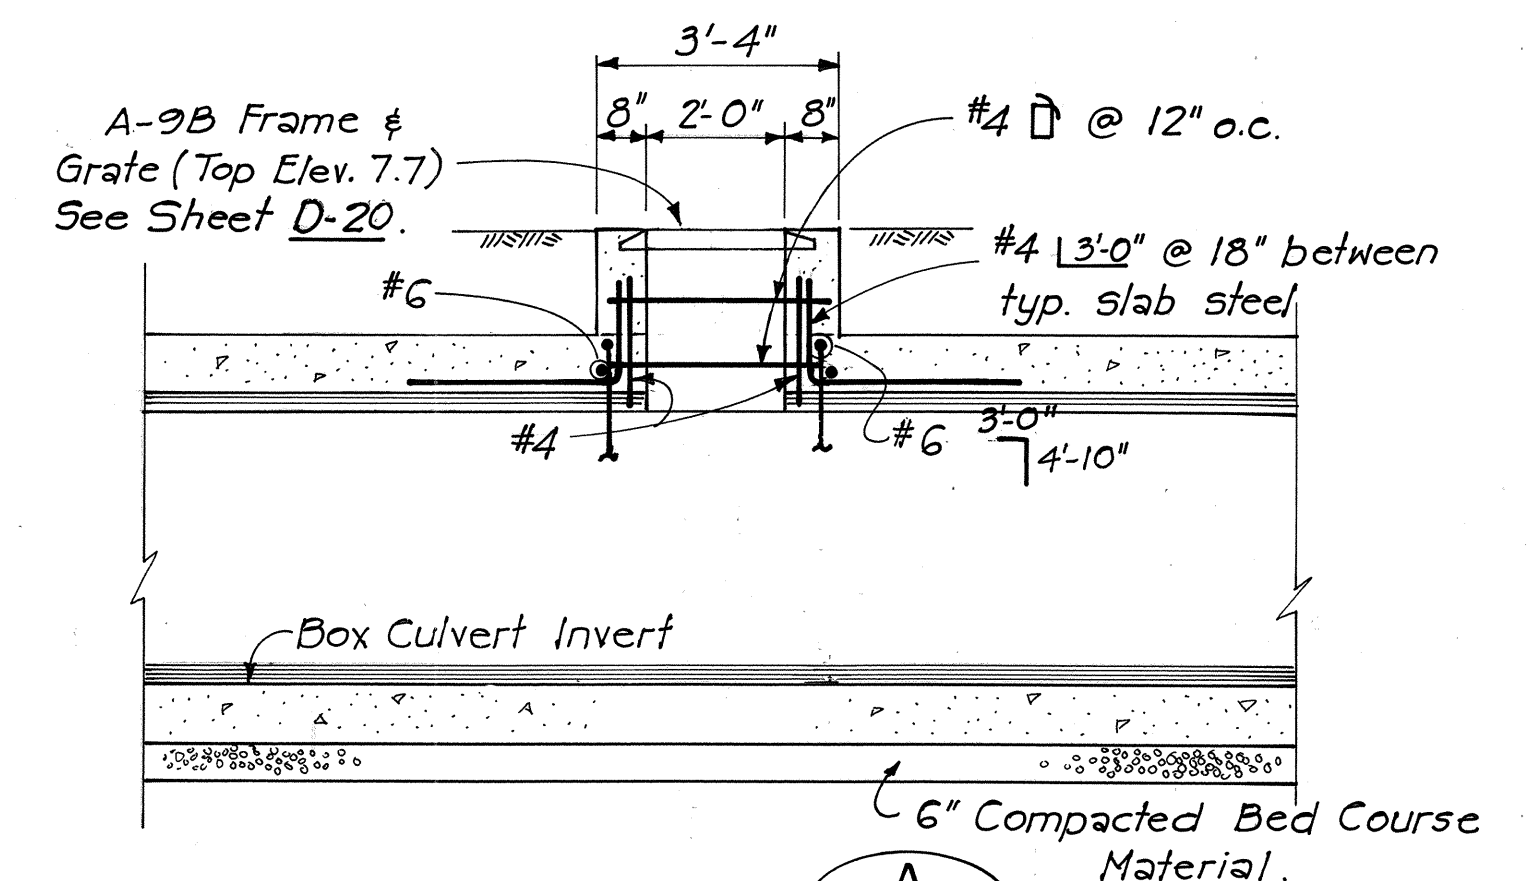

SECTION A D8 D8

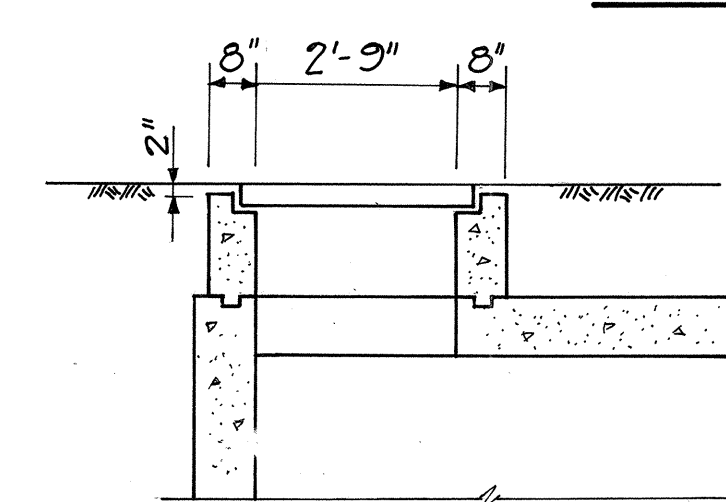


SECTION B D8 D8

NOTES:

1. All reinforcing symmetrical except as noted.
2. All reinforcing shown is in addition to typical box culvert reinforcing.
3. Cut or bend typical reinforcing as required to clear opening.
4. For General Notes see Sheet D-6.
5. Payment for DI Type 'X', including A-9B Frame and Grate, will be made under item 604.6500

DROP INTAKE TYPE 'X'

Scale: 3/8" = 1'-0"
(Drainage Structure No. 9)

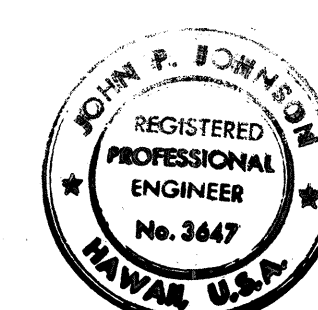

THIS WORK WAS PREPARED BY ME
OR UNDER MY SUPERVISION.
John P. Johnson


STATE OF HAWAII
DEPARTMENT OF TRANSPORTATION
LAND TRANSPORTATION FACILITIES DIVISION

DRAINLINE #1 & #8 DETAILS

INTERSTATE ROUTE H-1
PROJECT NO. I-IR-HI-1(169)17



SCALE: AS SHOWN DATE: 3/15/82
SHEET NO. D-8 OF D-25 SHEETS

FED. ROAD DIST. NO.	STATE	FED. AID PROJ. NO.	FISCAL YEAR	SHEET NO.	TOTAL SHEETS
HAWAII	HAW.	IR-HI-1(169)17	1983	54	280



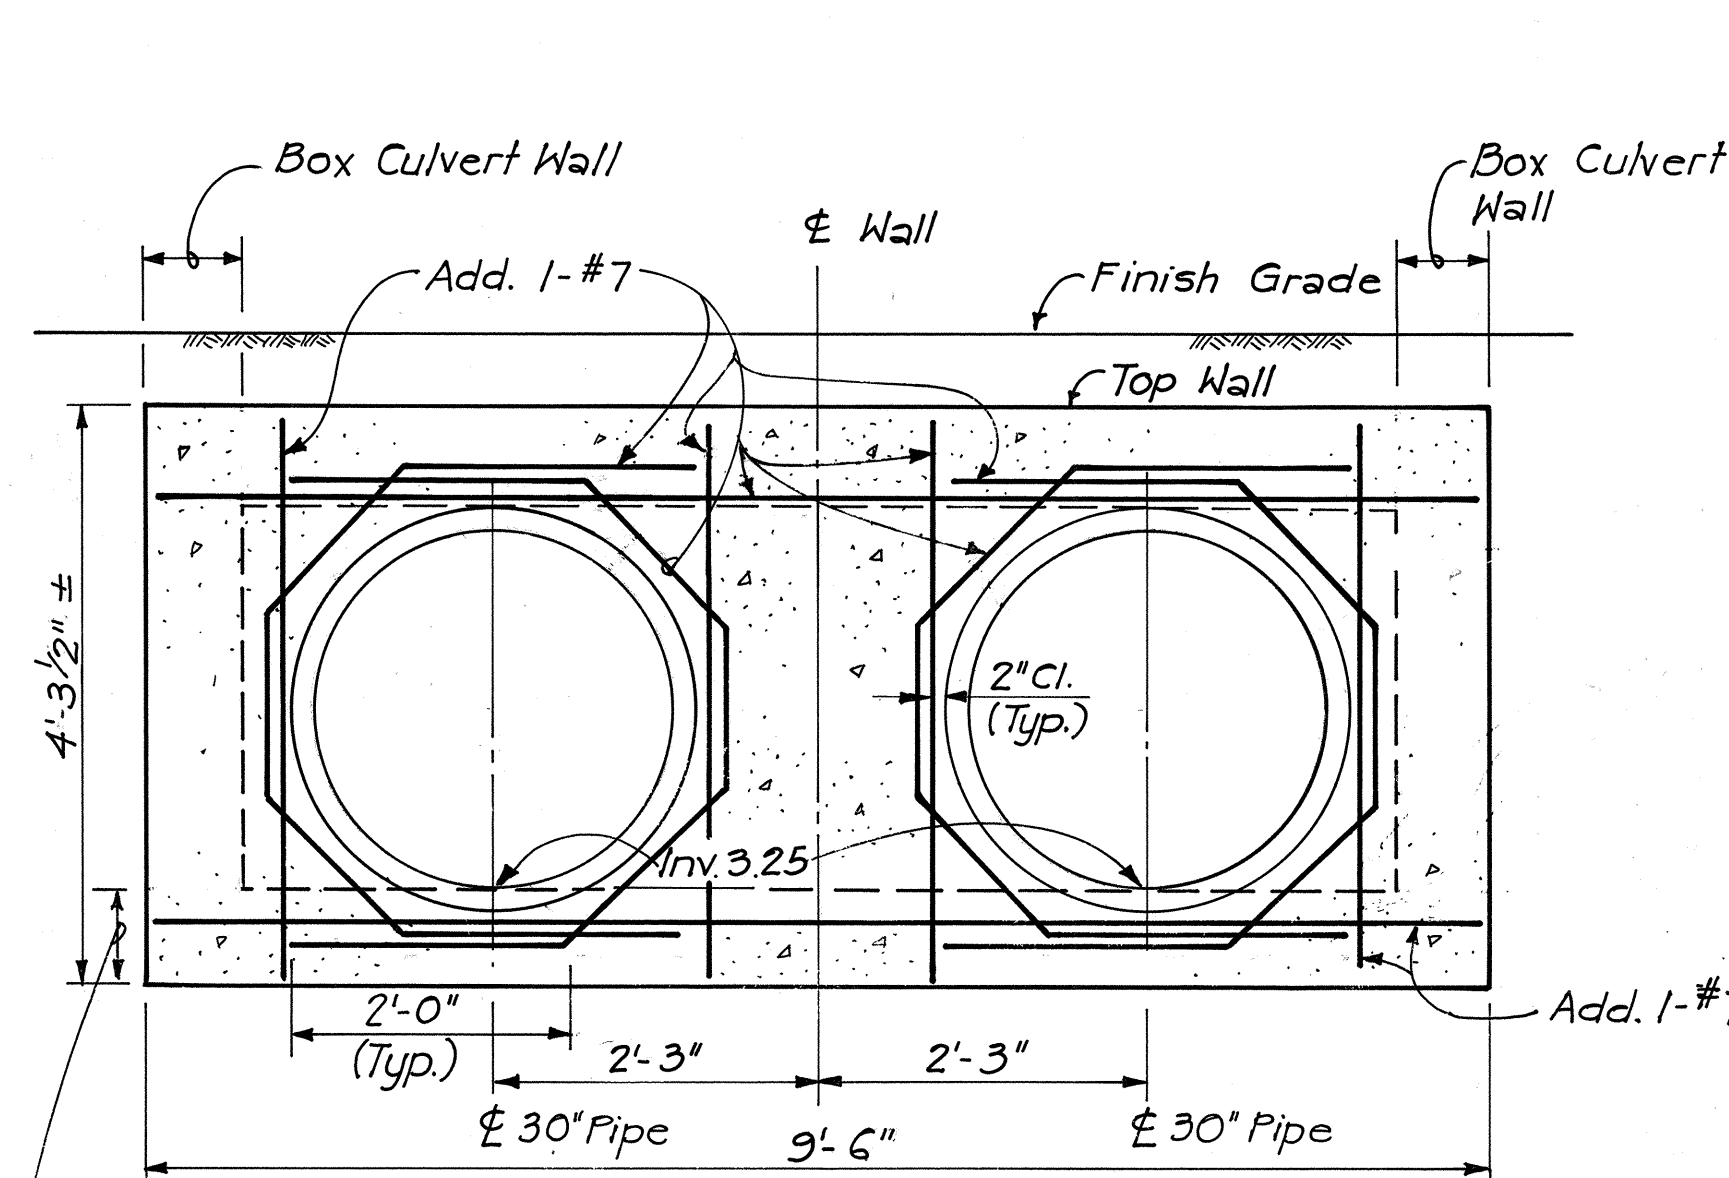


ELEVATIONS
BOX CULVERTS II & III
TOP OF DECK SLAB

Point	Elevation
A	5.11
B	5.11
C	5.61
D	5.61
E	6.32
F	6.32
G	6.75
H	6.75
I	6.75
J	6.53
K	6.53

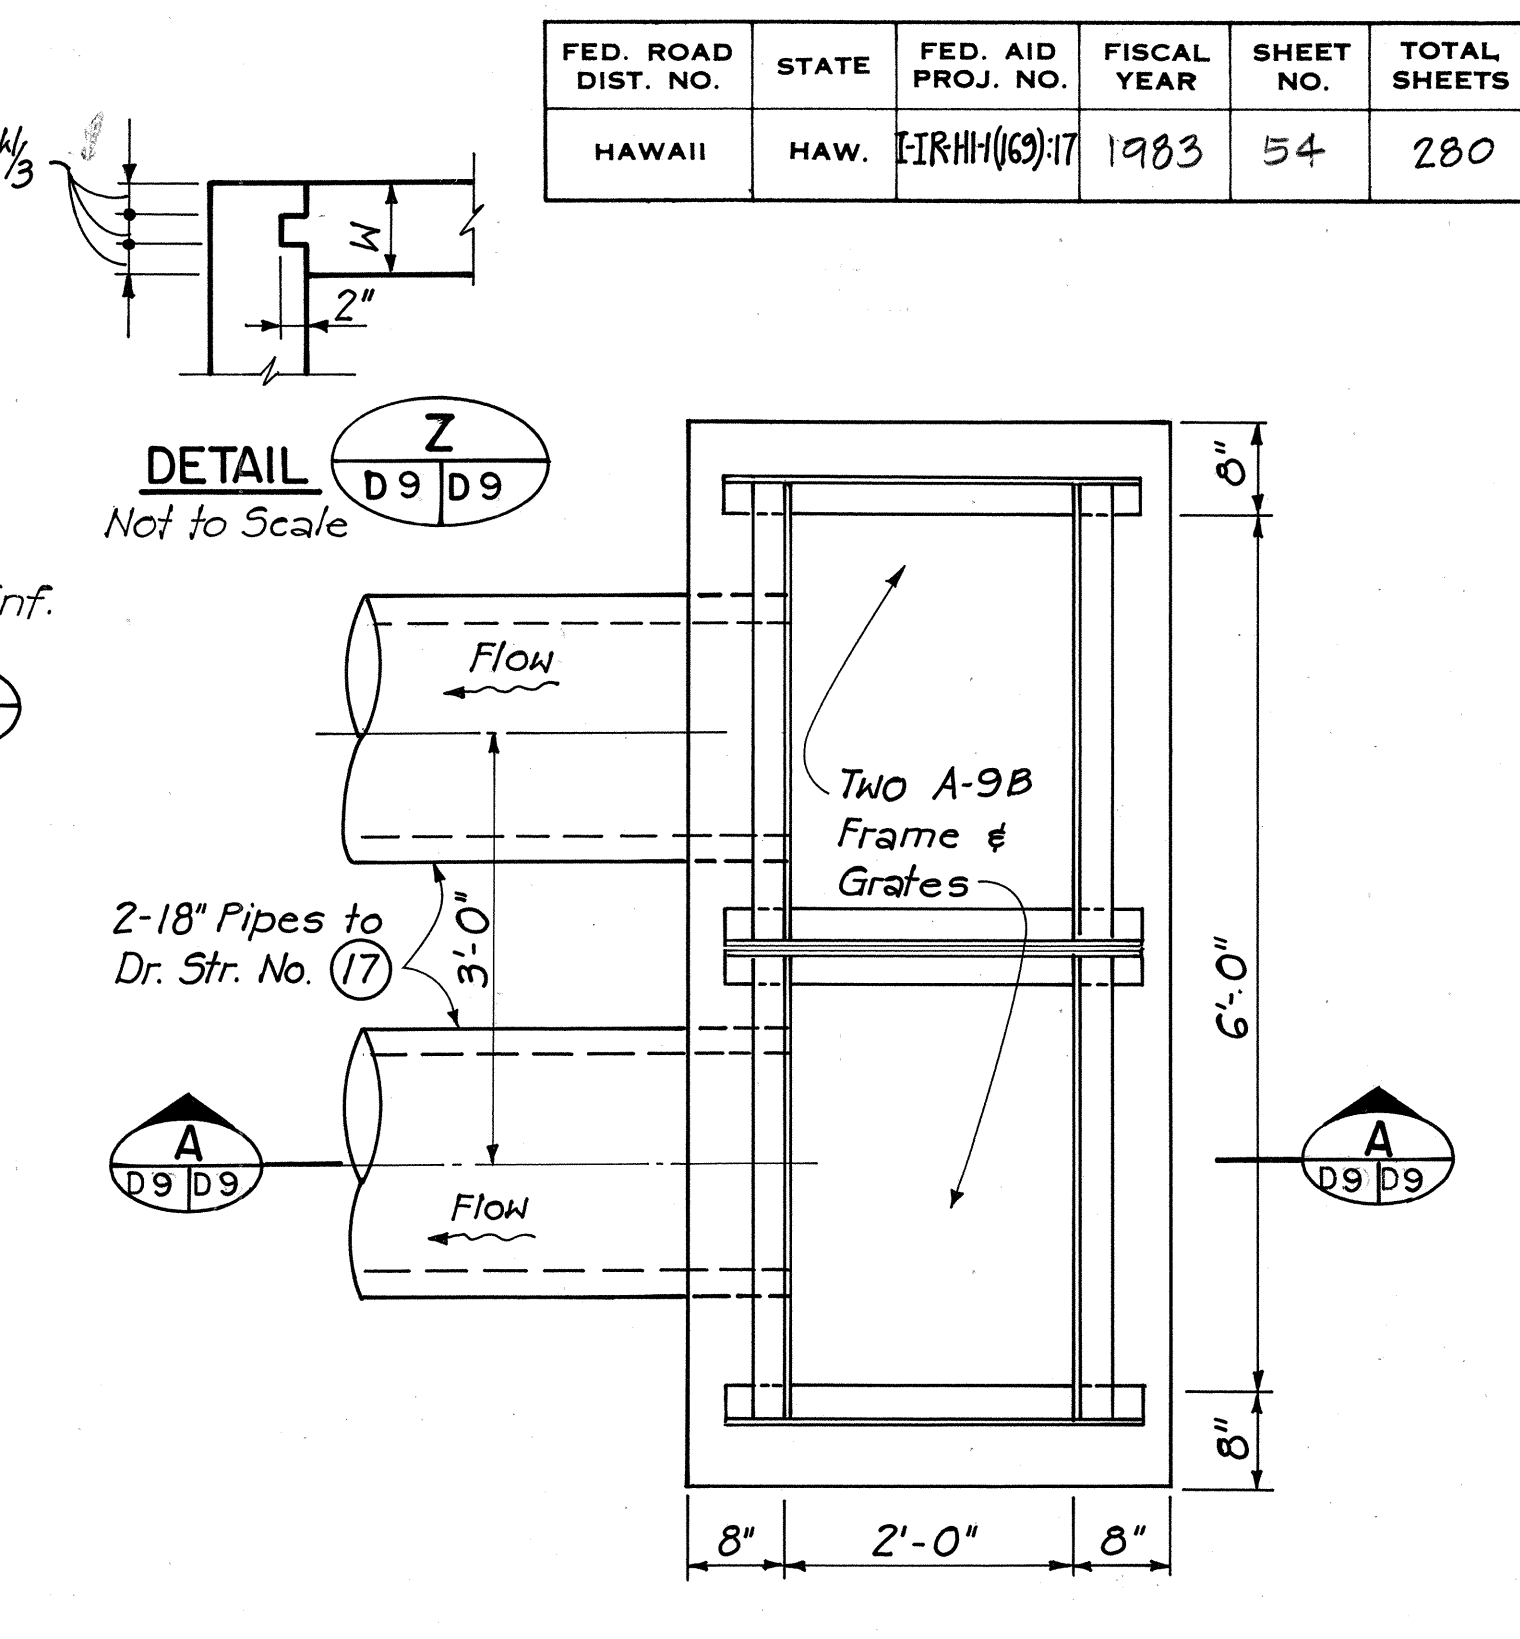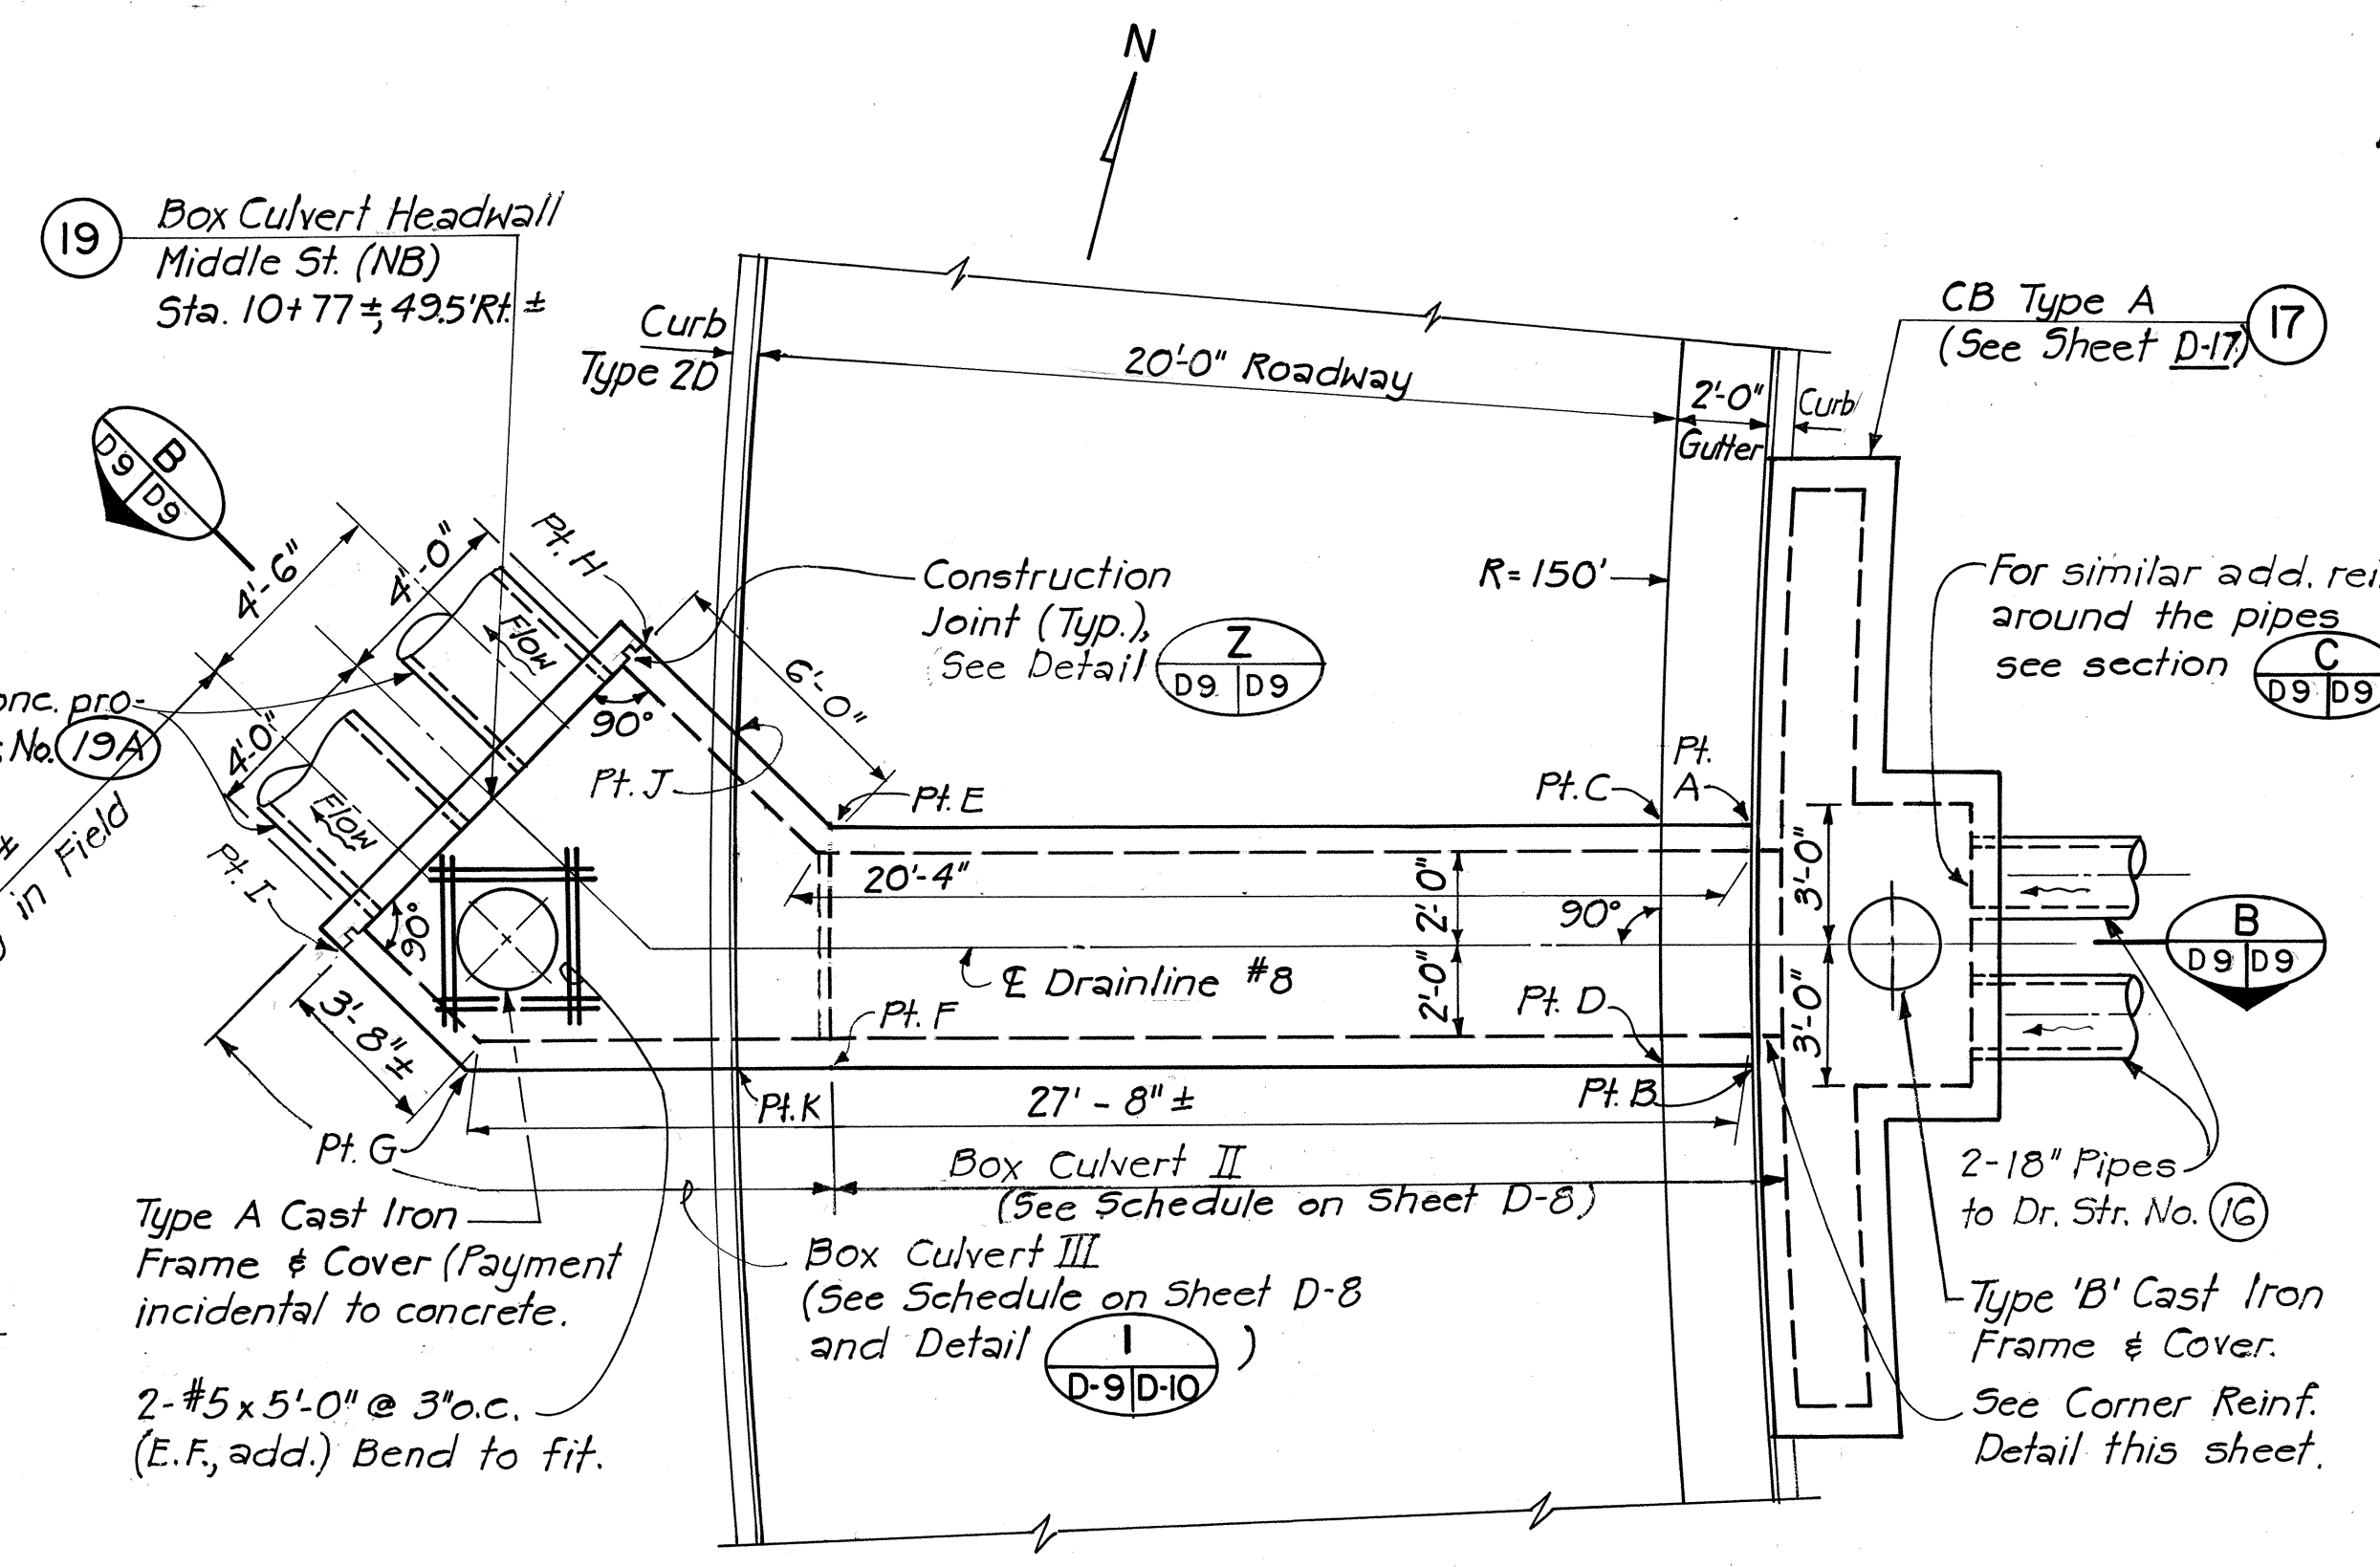


SECTION C
BOX CULVERT HEADWALL - DRAINAGE STRUCTURE NO. 19
Scale: 3/4" = 1'-0"

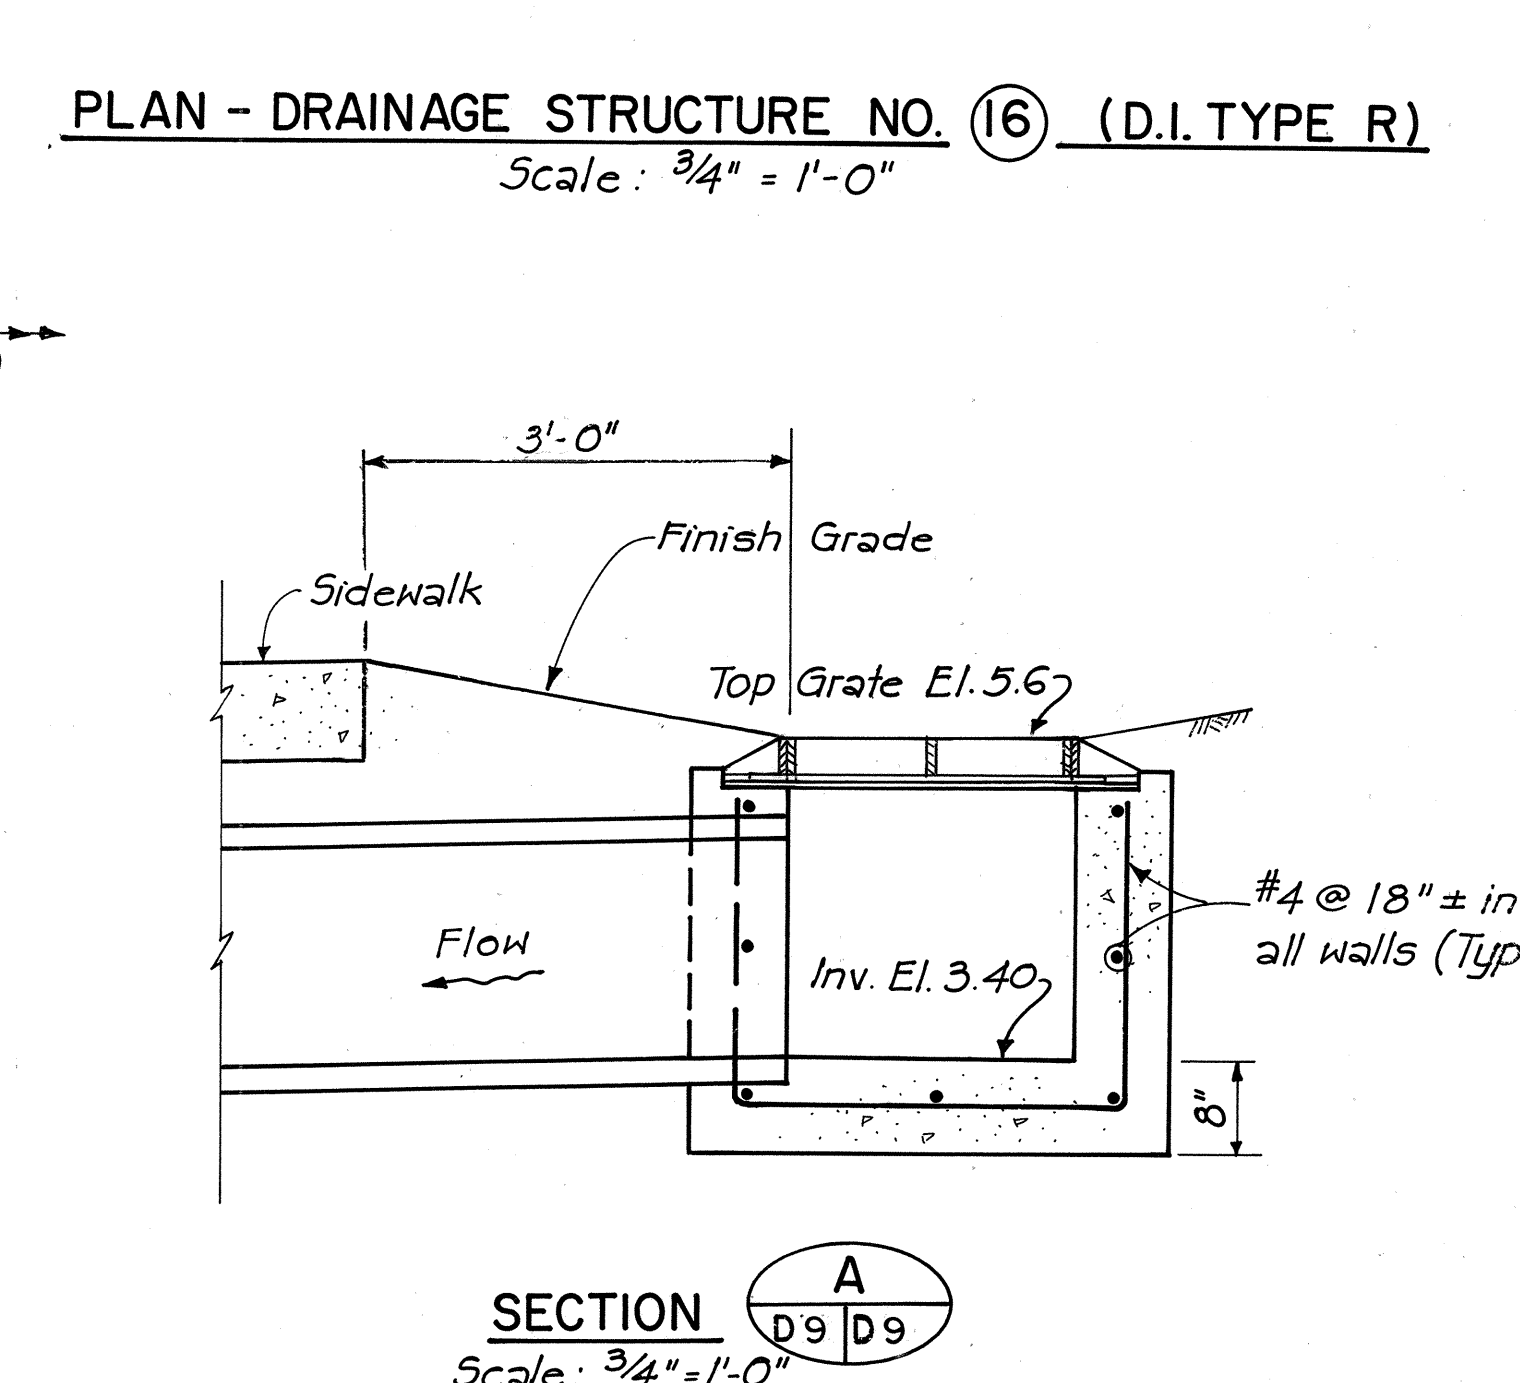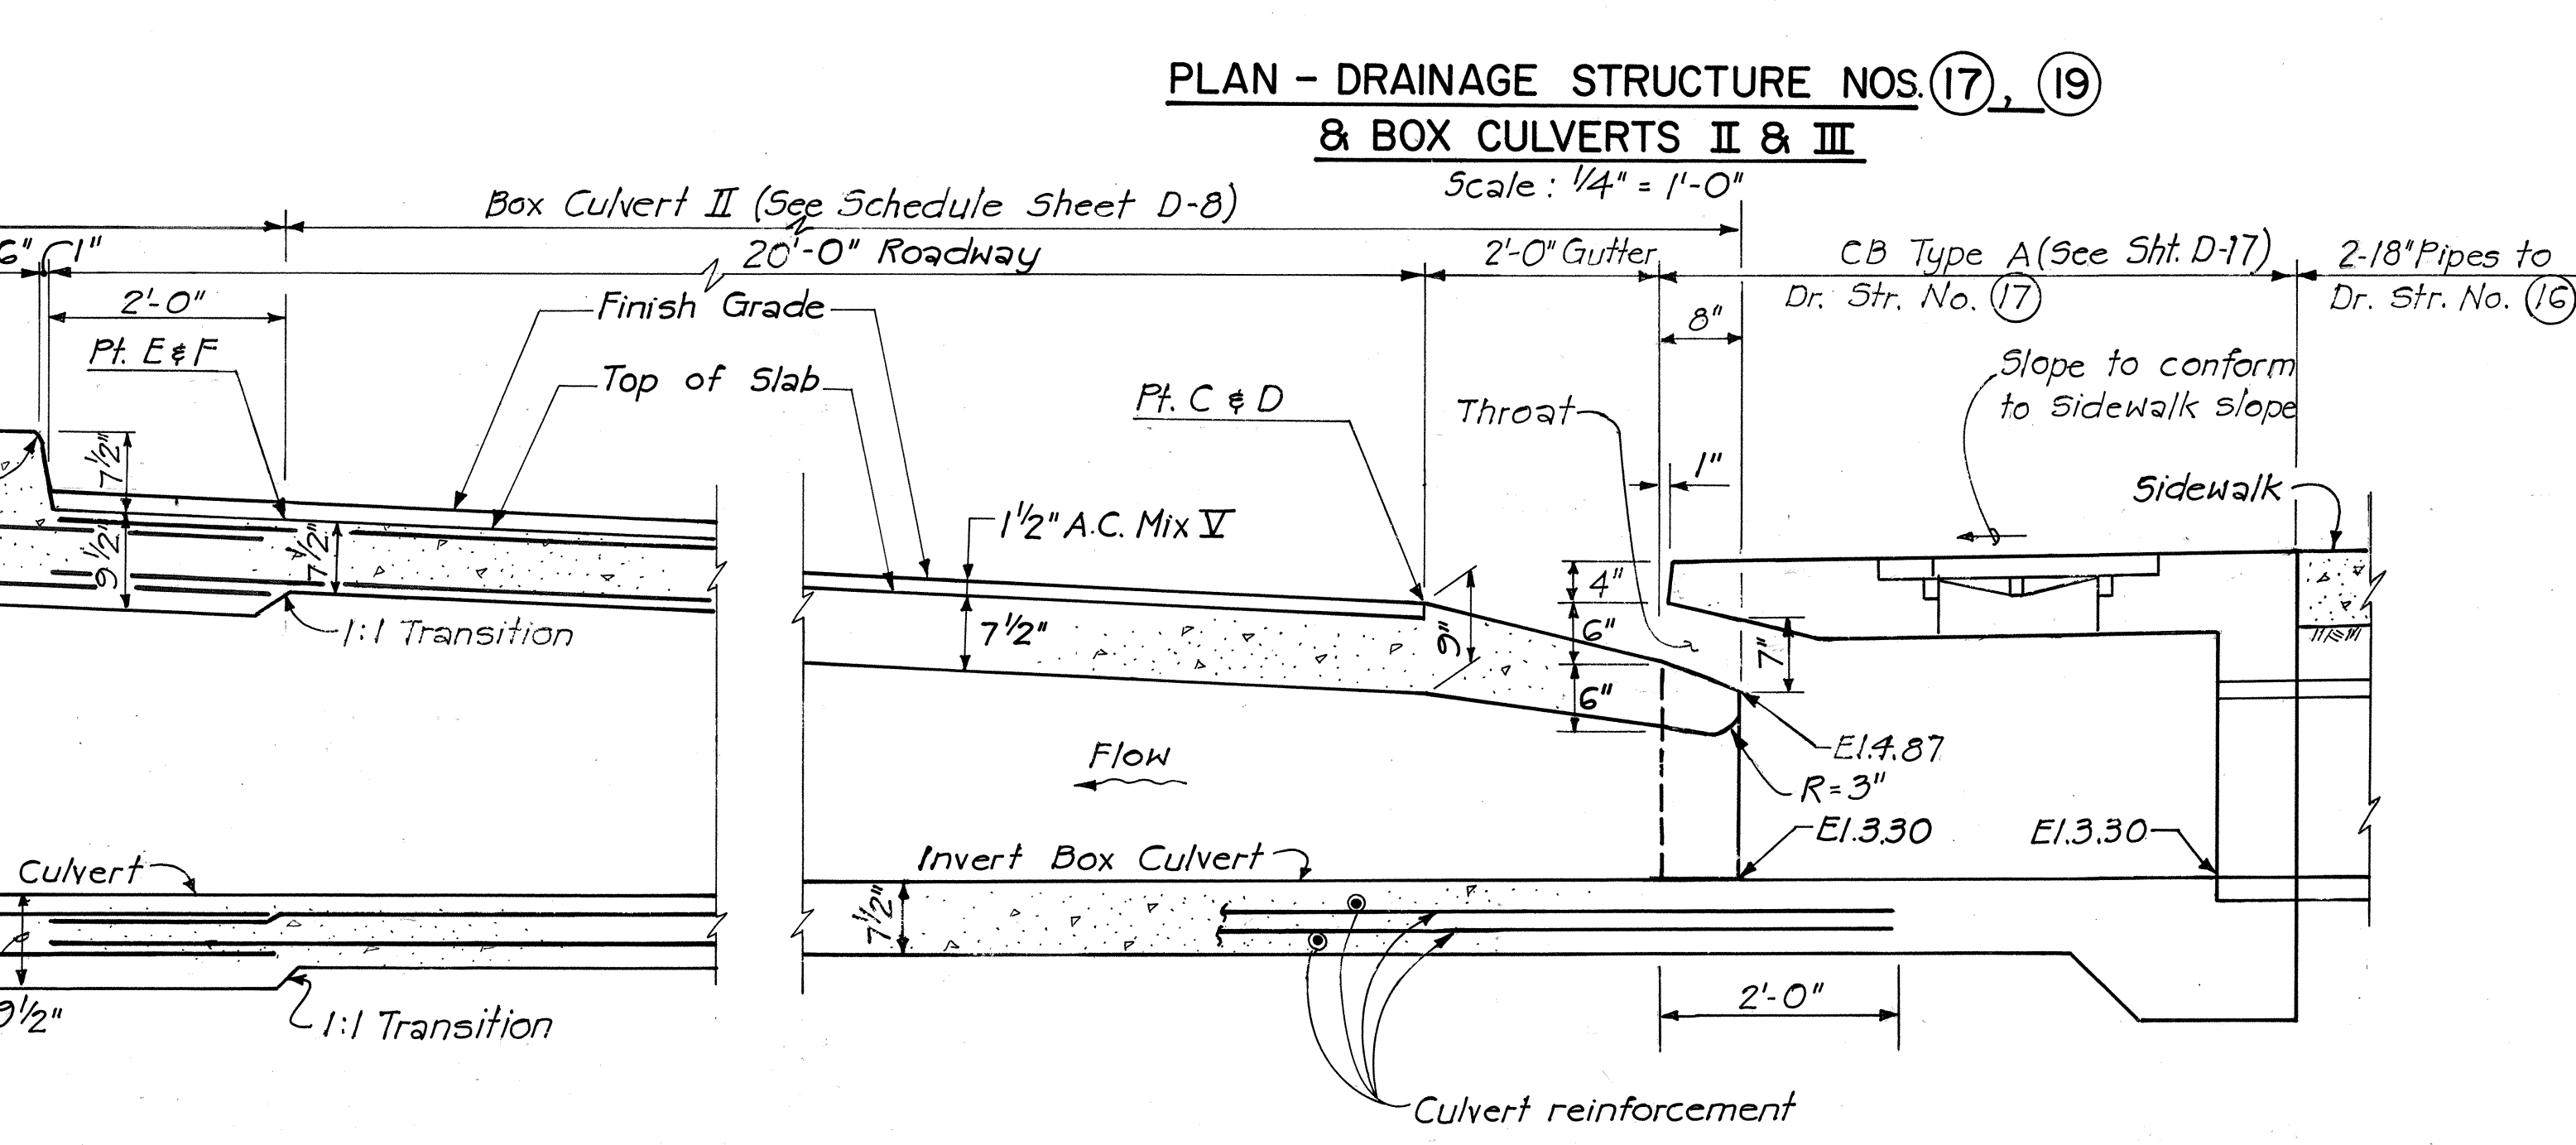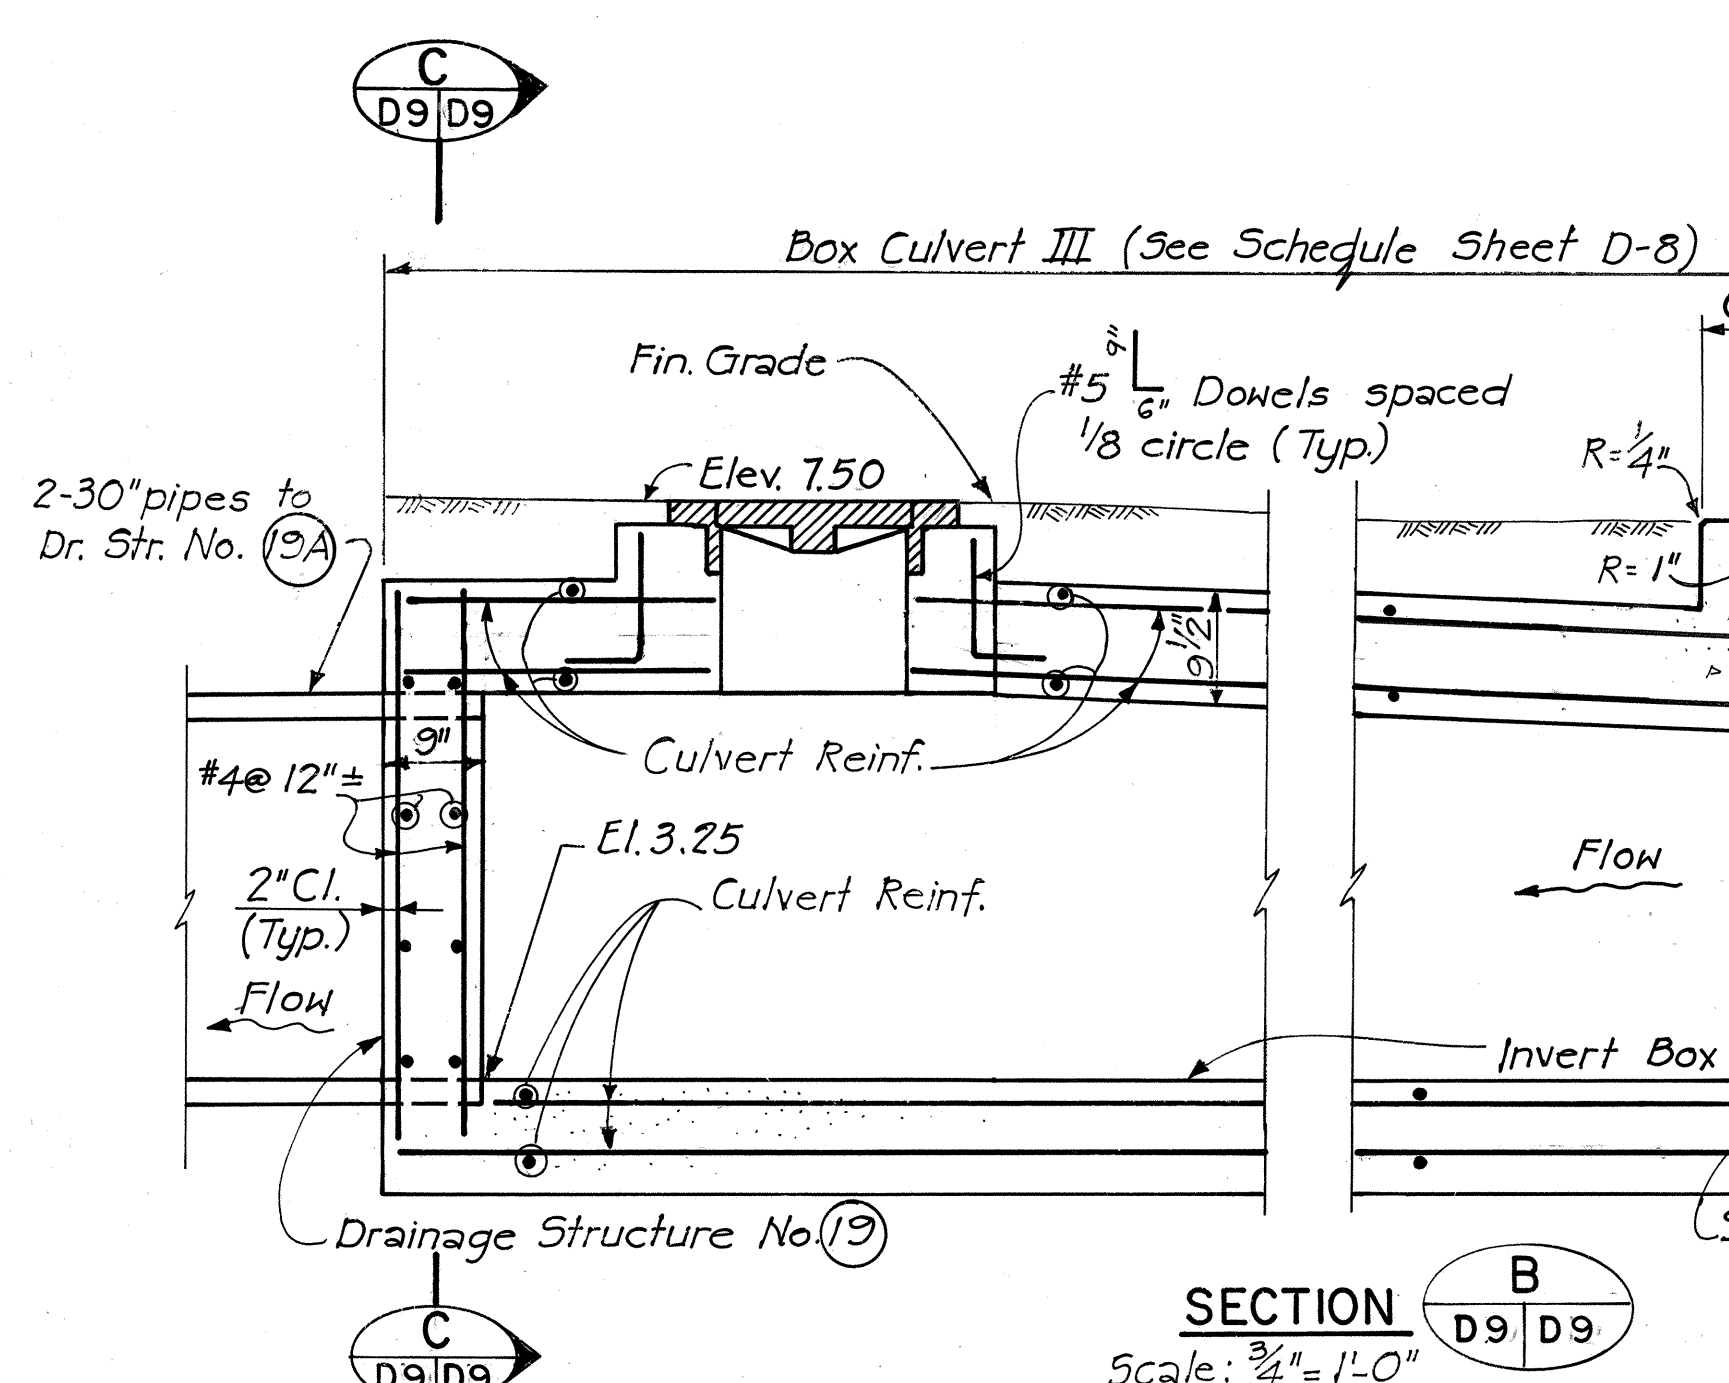


SECTION B
Scale: 3/4" = 1'-0"

SECTION A
Scale: 3/4" = 1'-0"

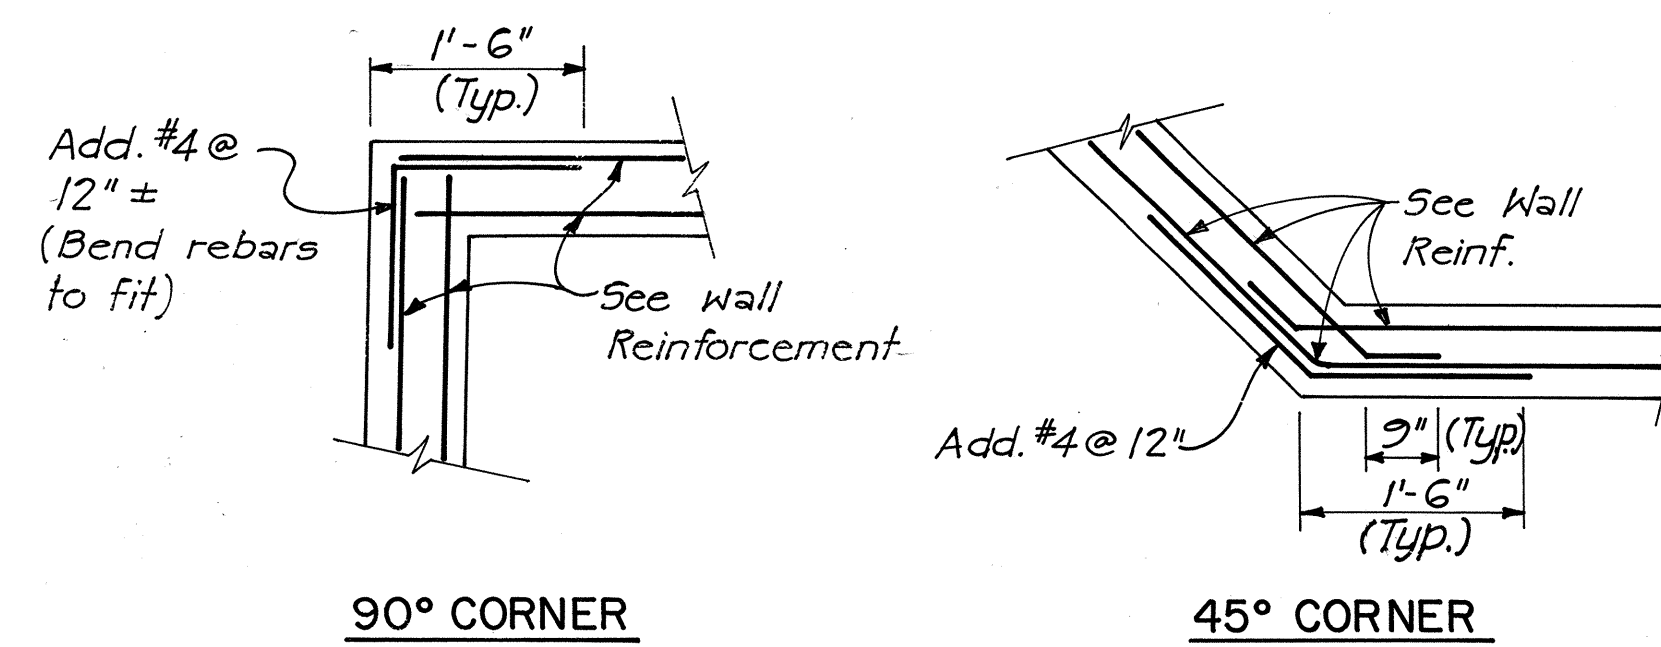

TYPICAL HORIZONTAL REINFORCEMENT AT CORNERS
Scale: 3/4" = 1'-0"

SHEET D-9 NOTE:
For General Notes see Sheet D-6.

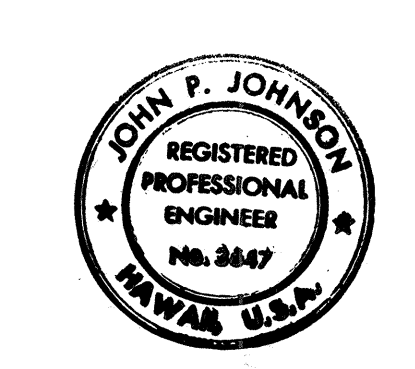

STATE OF HAWAII
DEPARTMENT OF TRANSPORTATION
LAND TRANSPORTATION FACILITIES DIVISION

DRAINLINE #8 DETAILS





INTERSTATE ROUTE H-1
PROJECT NO. I-IR-HI-1(169)17

SCALE: AS SHOWN DATE: 3/15/82
SHEET NO. D-9 OF D-25 SHEETS

FED. ROAD DIST. NO.	STATE	FED. AID PROJ. NO.	FISCAL YEAR	SHEET NO.	TOTAL SHEETS
HAWAII	HAW.	IR-H-1(169):17	1983	55	280


ESTIMATED QUANTITIES FOR DRAINLINE #8 BOX CULVERT

ITEM NO.	ITEMS	UNIT	QUANTITY
604.6600	Drainline #8 Box Culvert	L.S.	See below
—	Structure Excavation for Drainline #8 Box Culvert	—	(31C.Y.)
—	Structure Backfill for Drainline #8 Box Culvert	—	(10C.Y.)
—	Class A Concrete for Drainline #8 Box Culvert	—	(13C.Y.)
—	Reinforcing Steel in Drainline #8 Box Culvert	—	(2900LBS)
—	Bed Course Material for Drainline #8 Box Culvert	—	(5C.Y.)

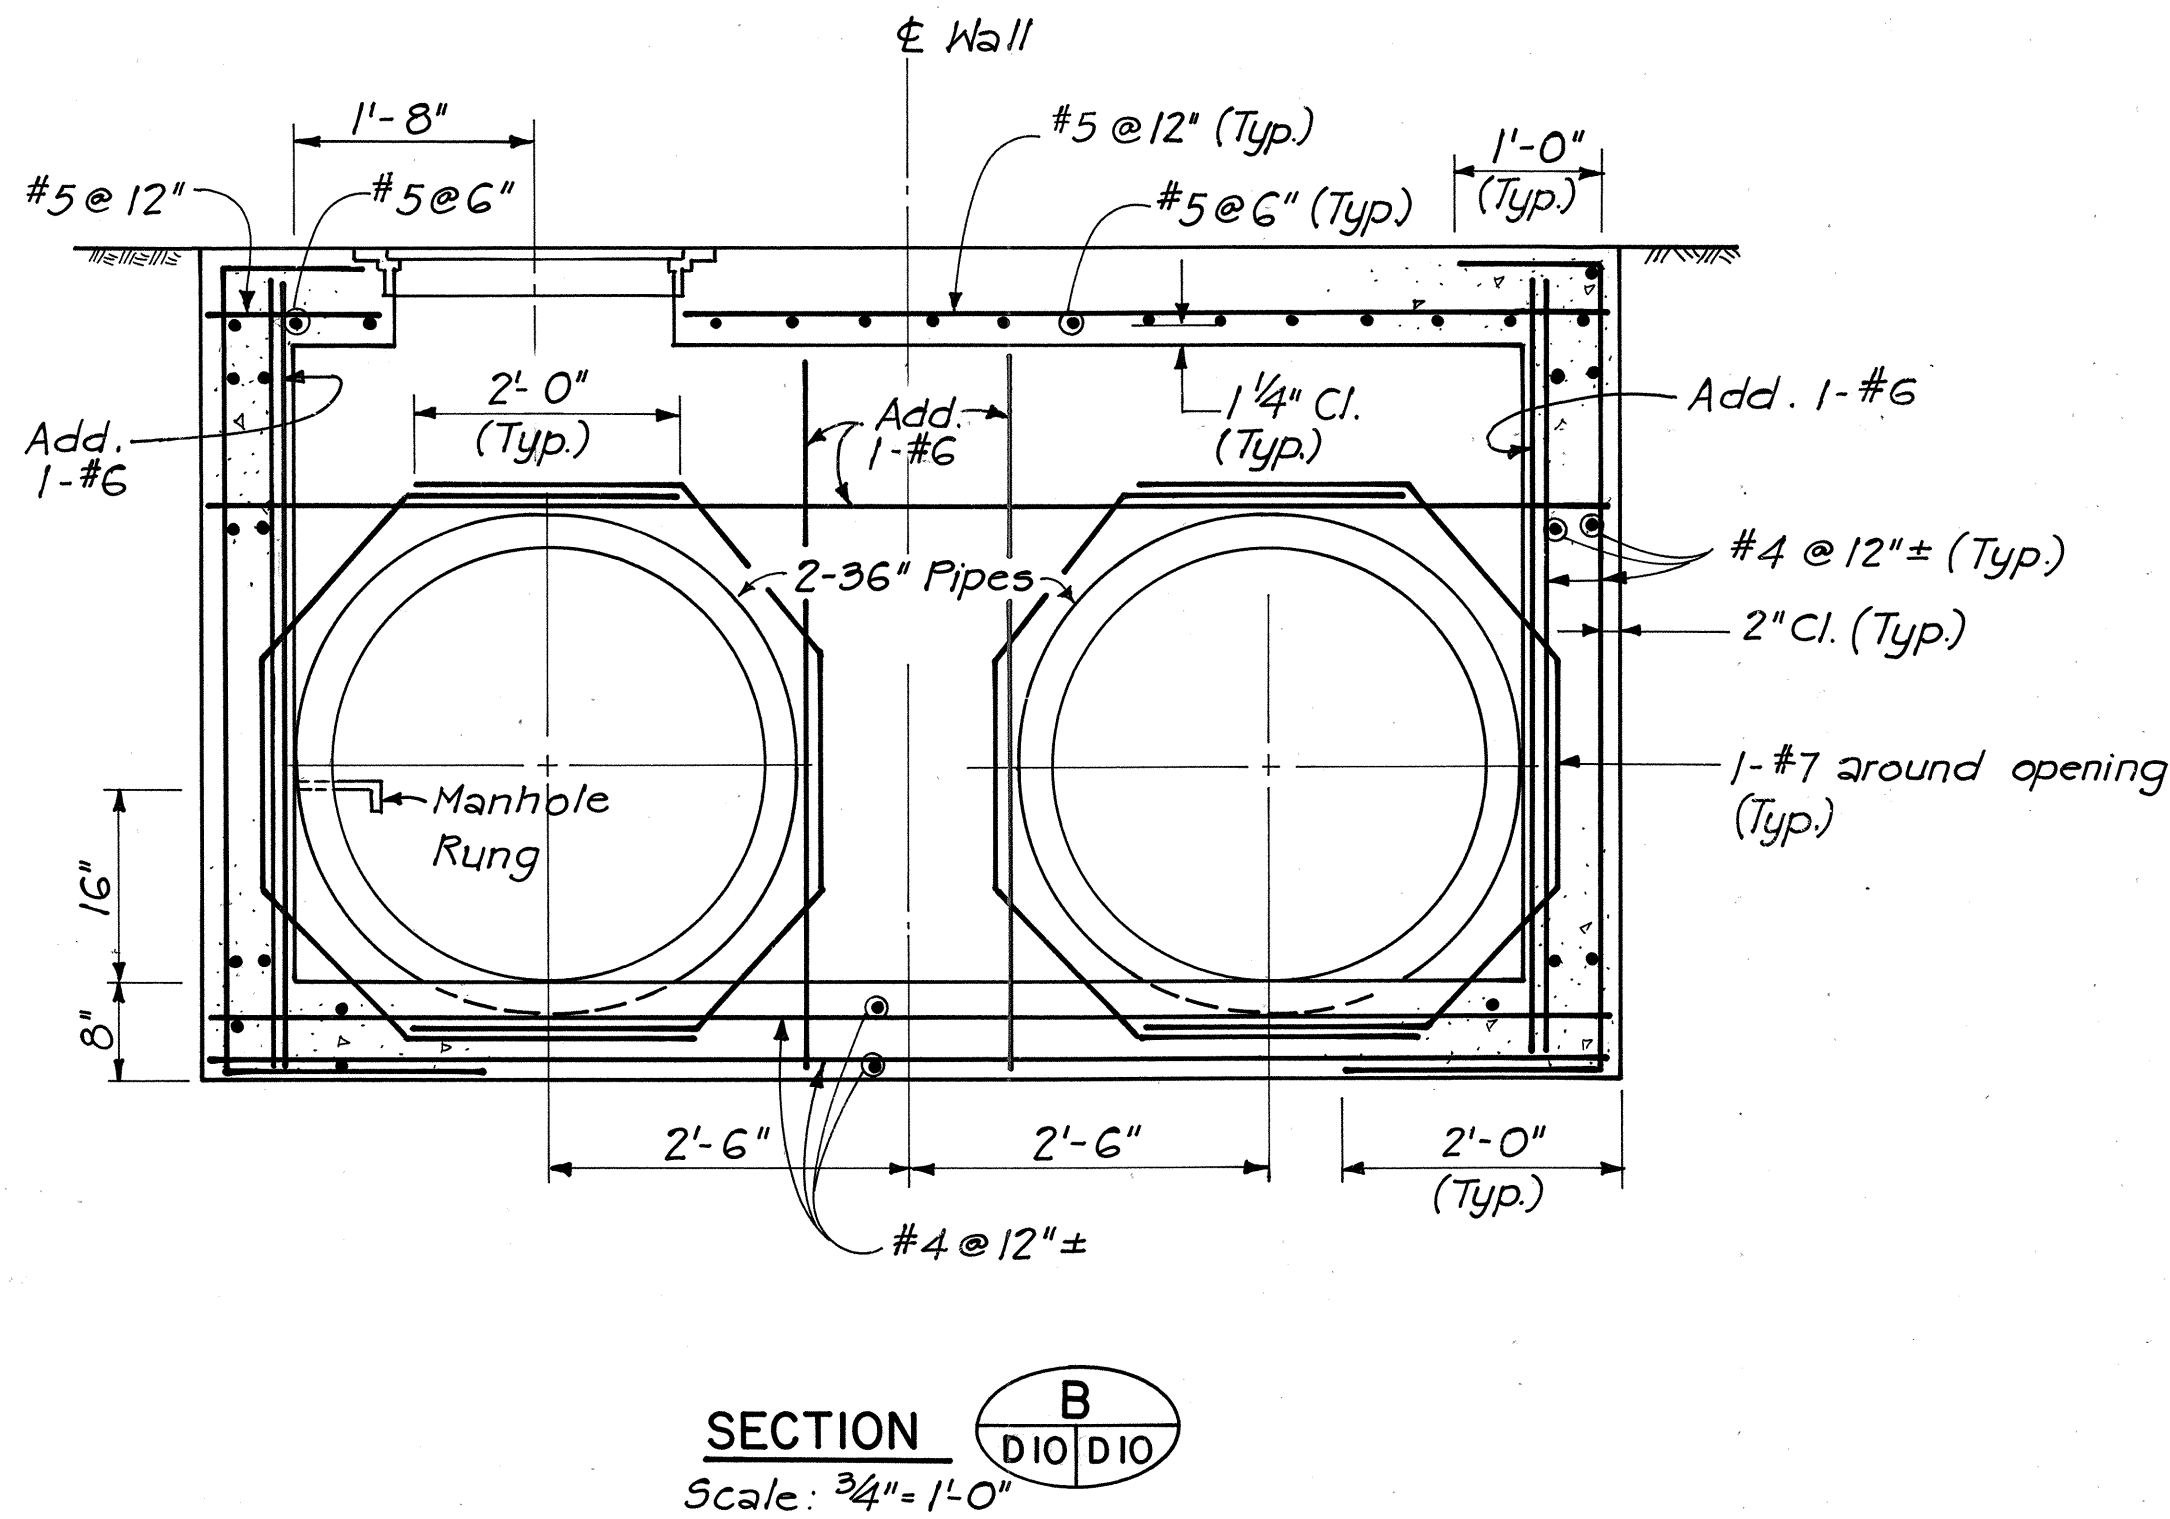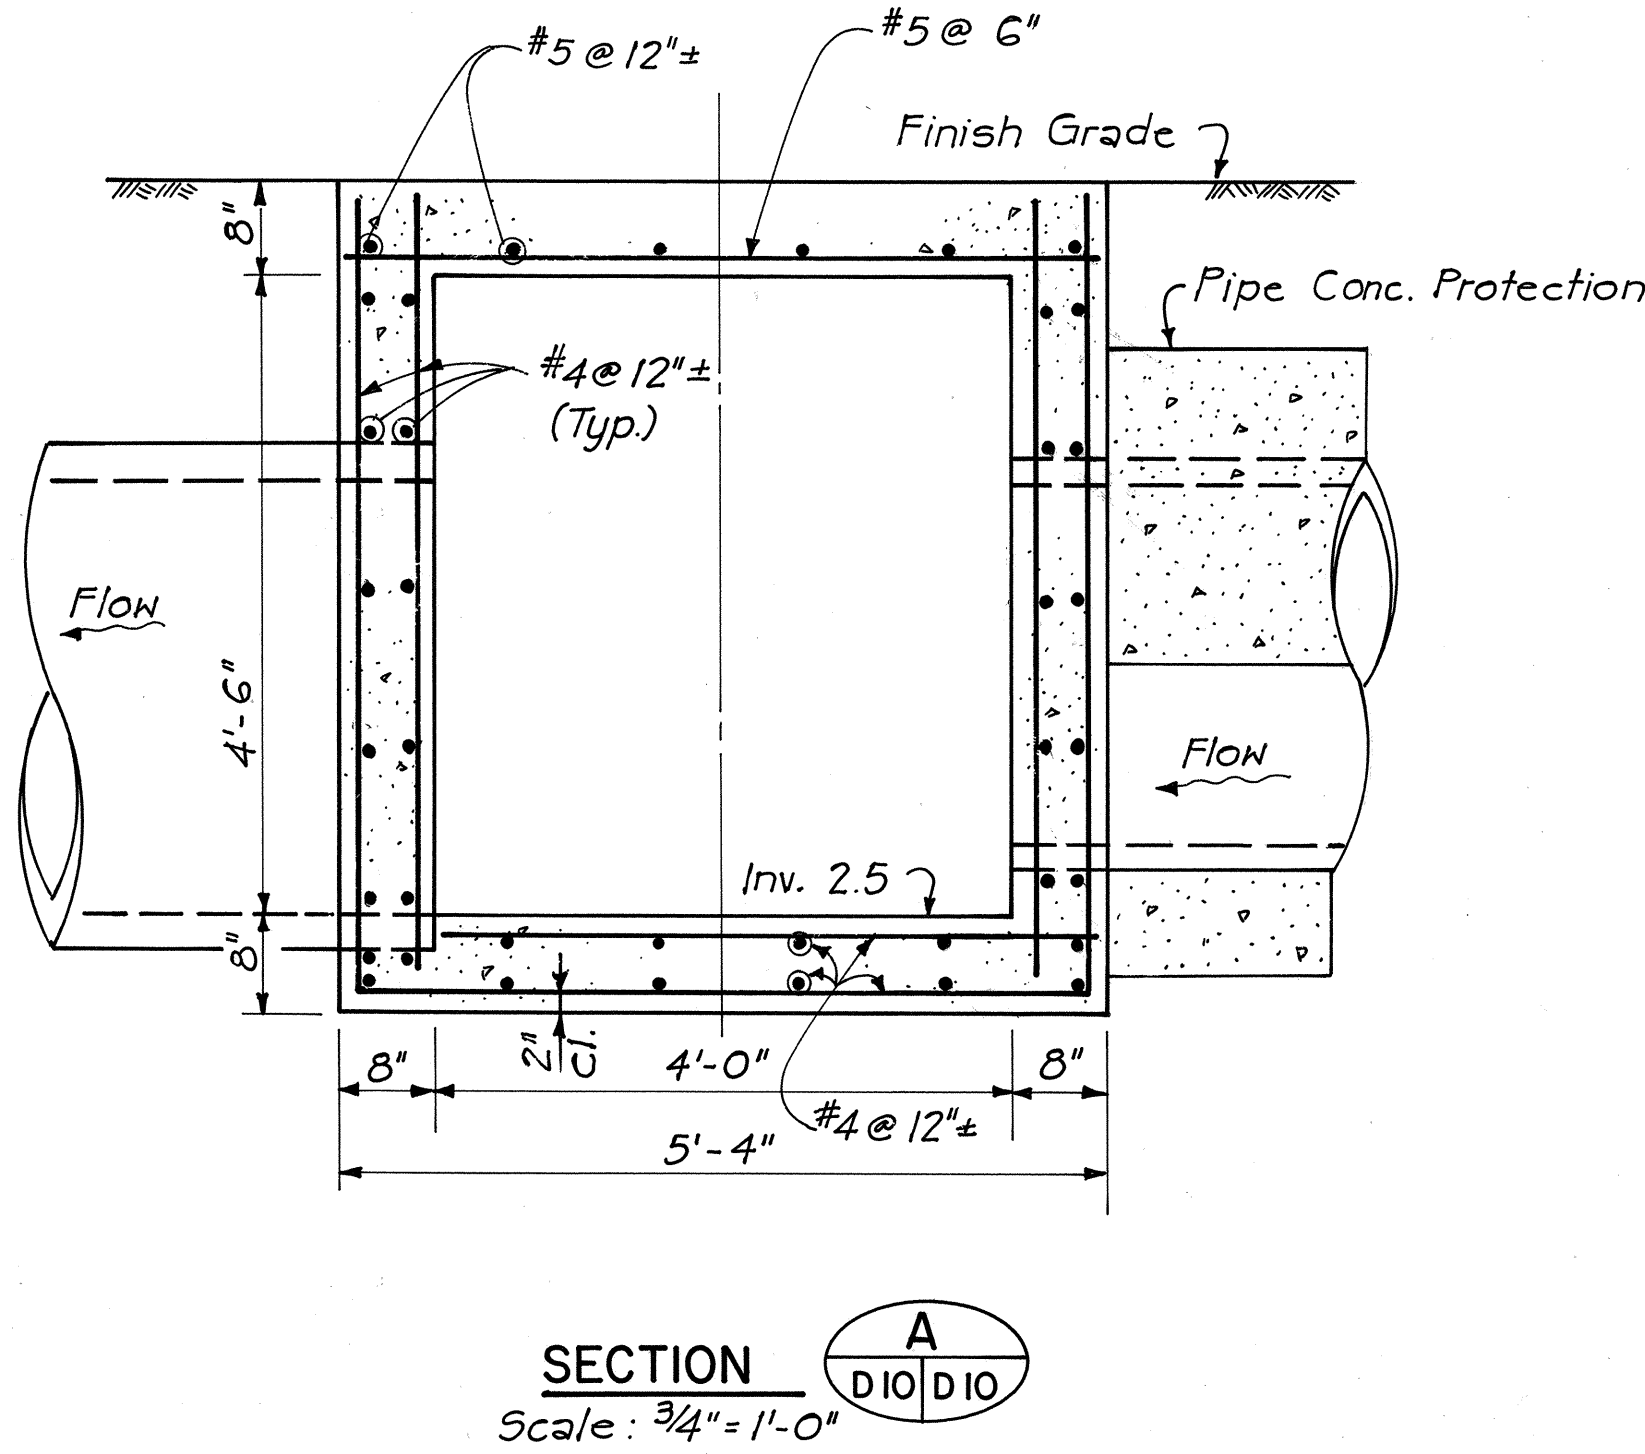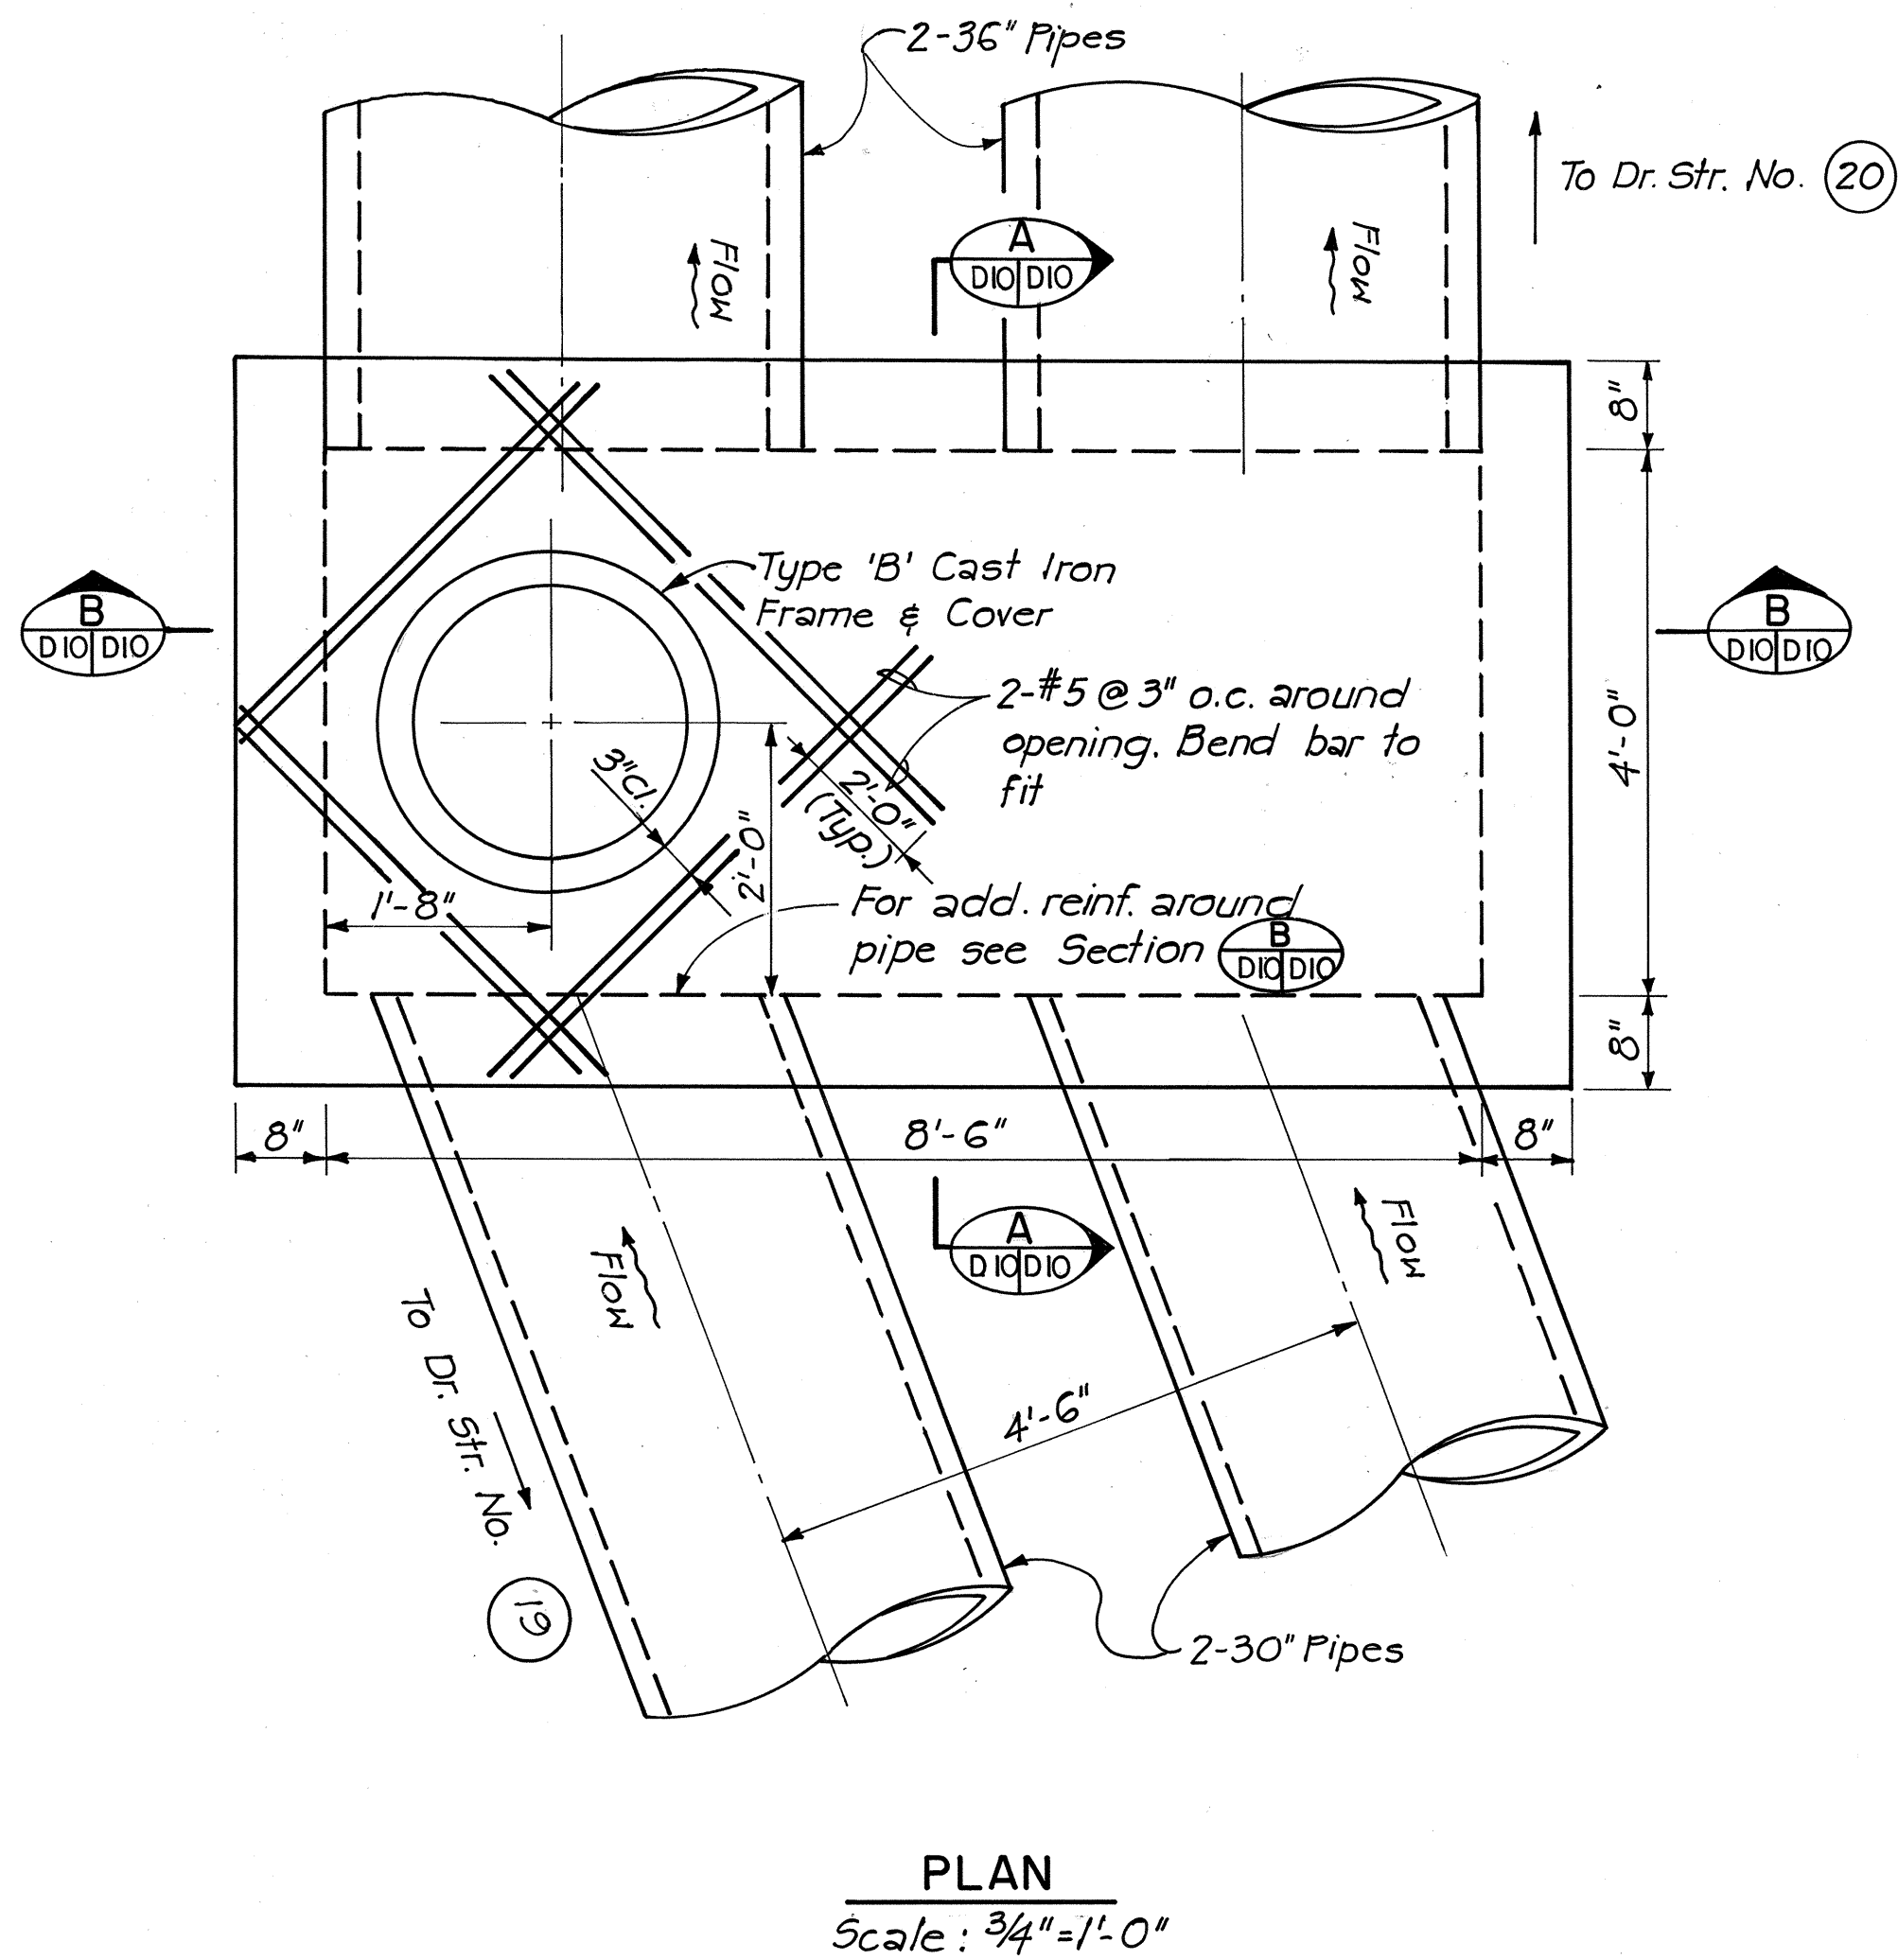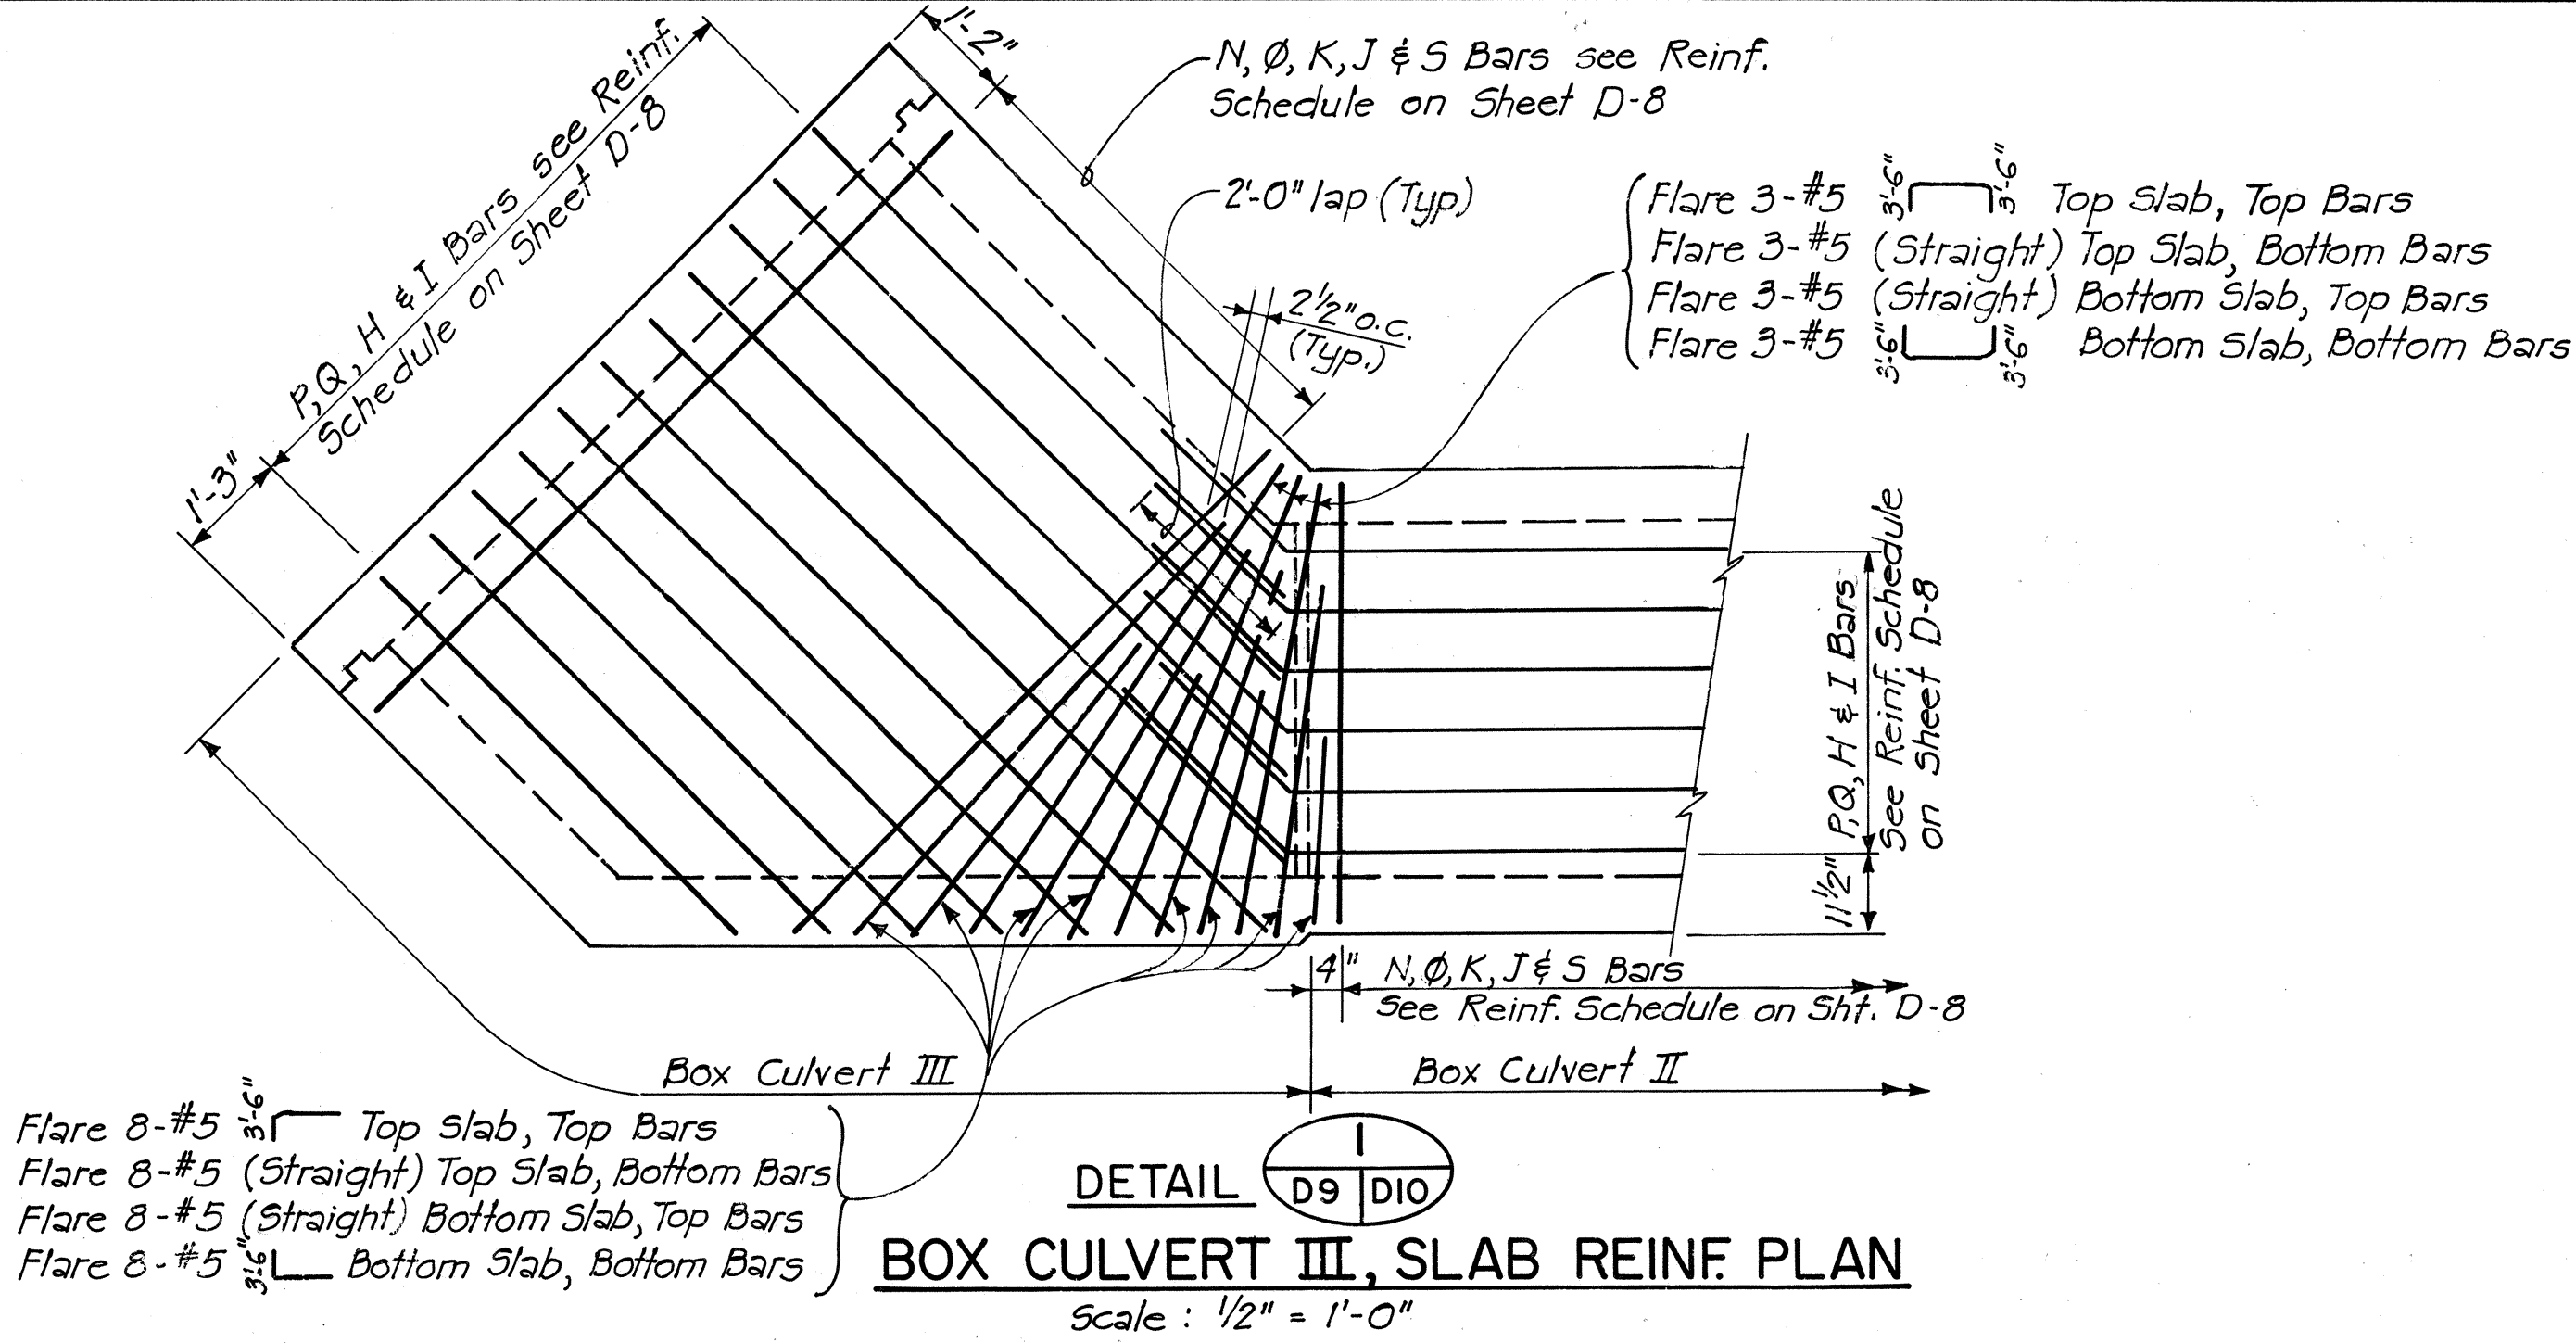

MANHOLE TYPE T DRAINAGE STRUCTURE NO. 19A

NOTE:
For General Notes see Sheet D-6.

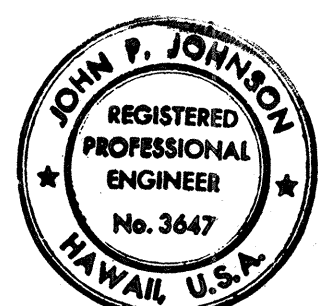

THIS WORK WAS PREPARED BY ME
OR UNDER MY SUPERVISION.
John P. Johnson






STATE OF HAWAII
DEPARTMENT OF TRANSPORTATION
LAND TRANSPORTATION FACILITIES DIVISION

DRAINLINE #8 DETAILS

INTERSTATE ROUTE H-1
PROJECT NO. I-IR-H-1(169):17

SCALE: AS SHOWN DATE: 3/15/82
SHEET NO. D-10 OF D-25 SHEETS

FED. ROAD DIST. NO.	STATE	FED. AID PROJ. NO.	FISCAL YEAR	SHEET NO.	TOTAL SHEETS
HAWAII	HAW.	IR-H-1(169):17	1983	56	280

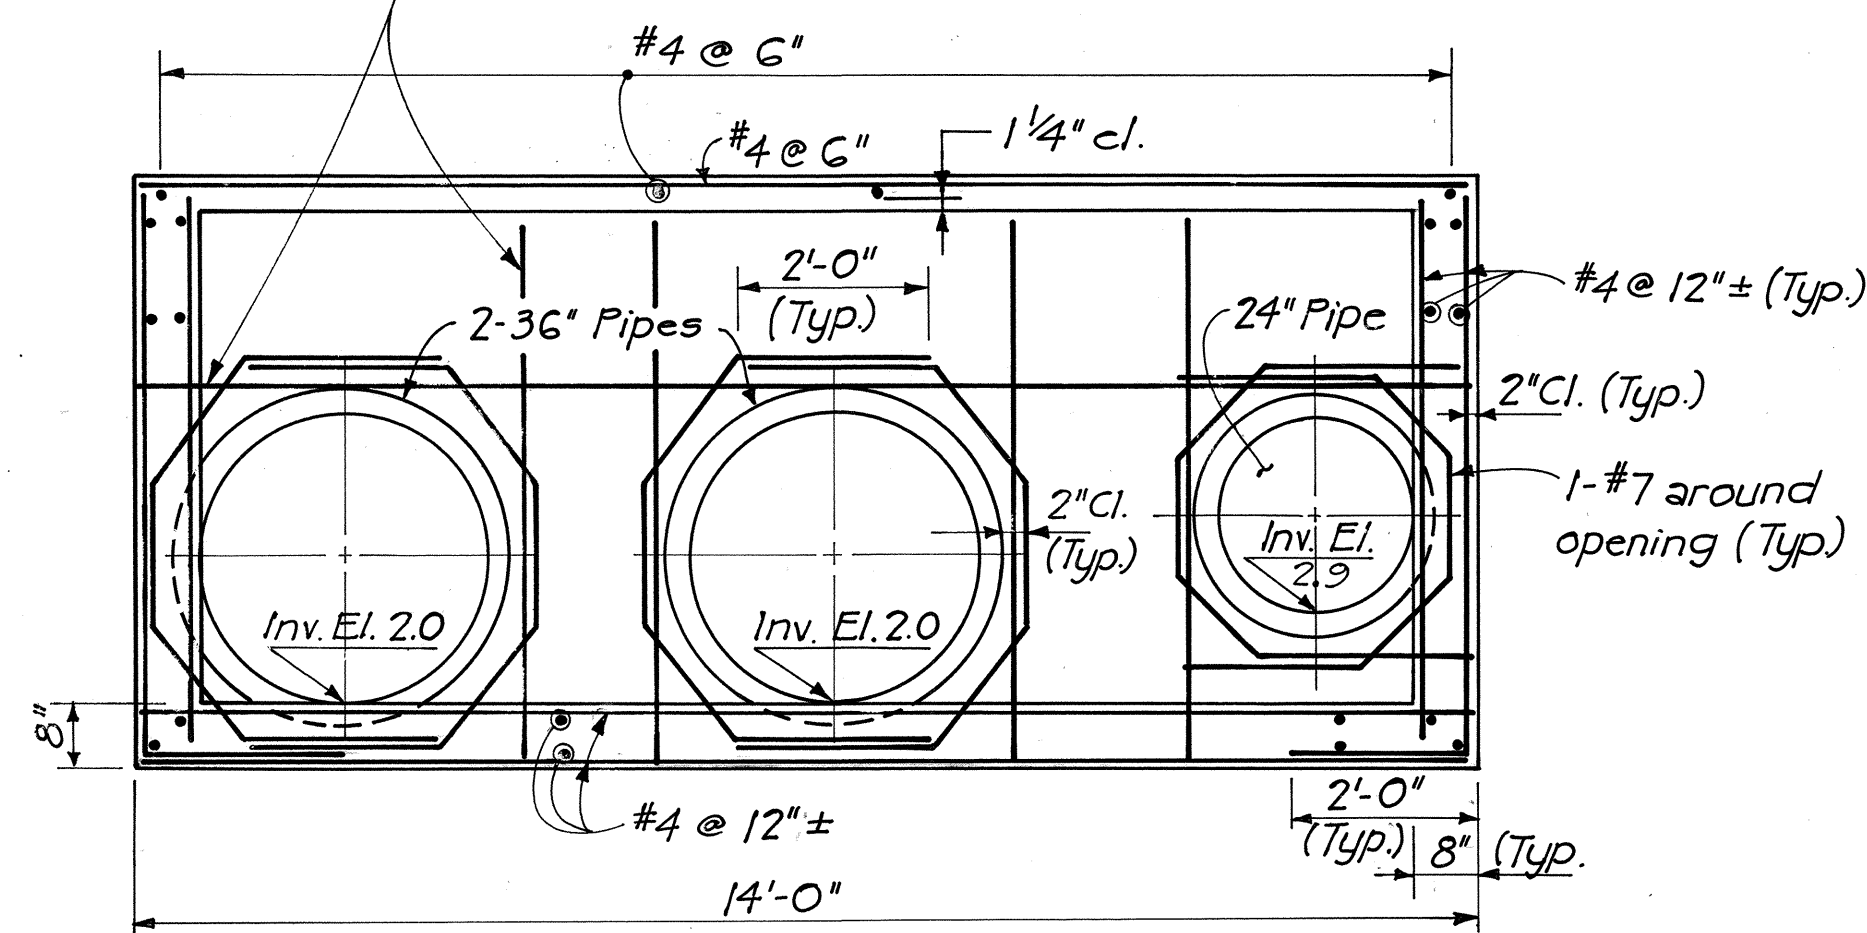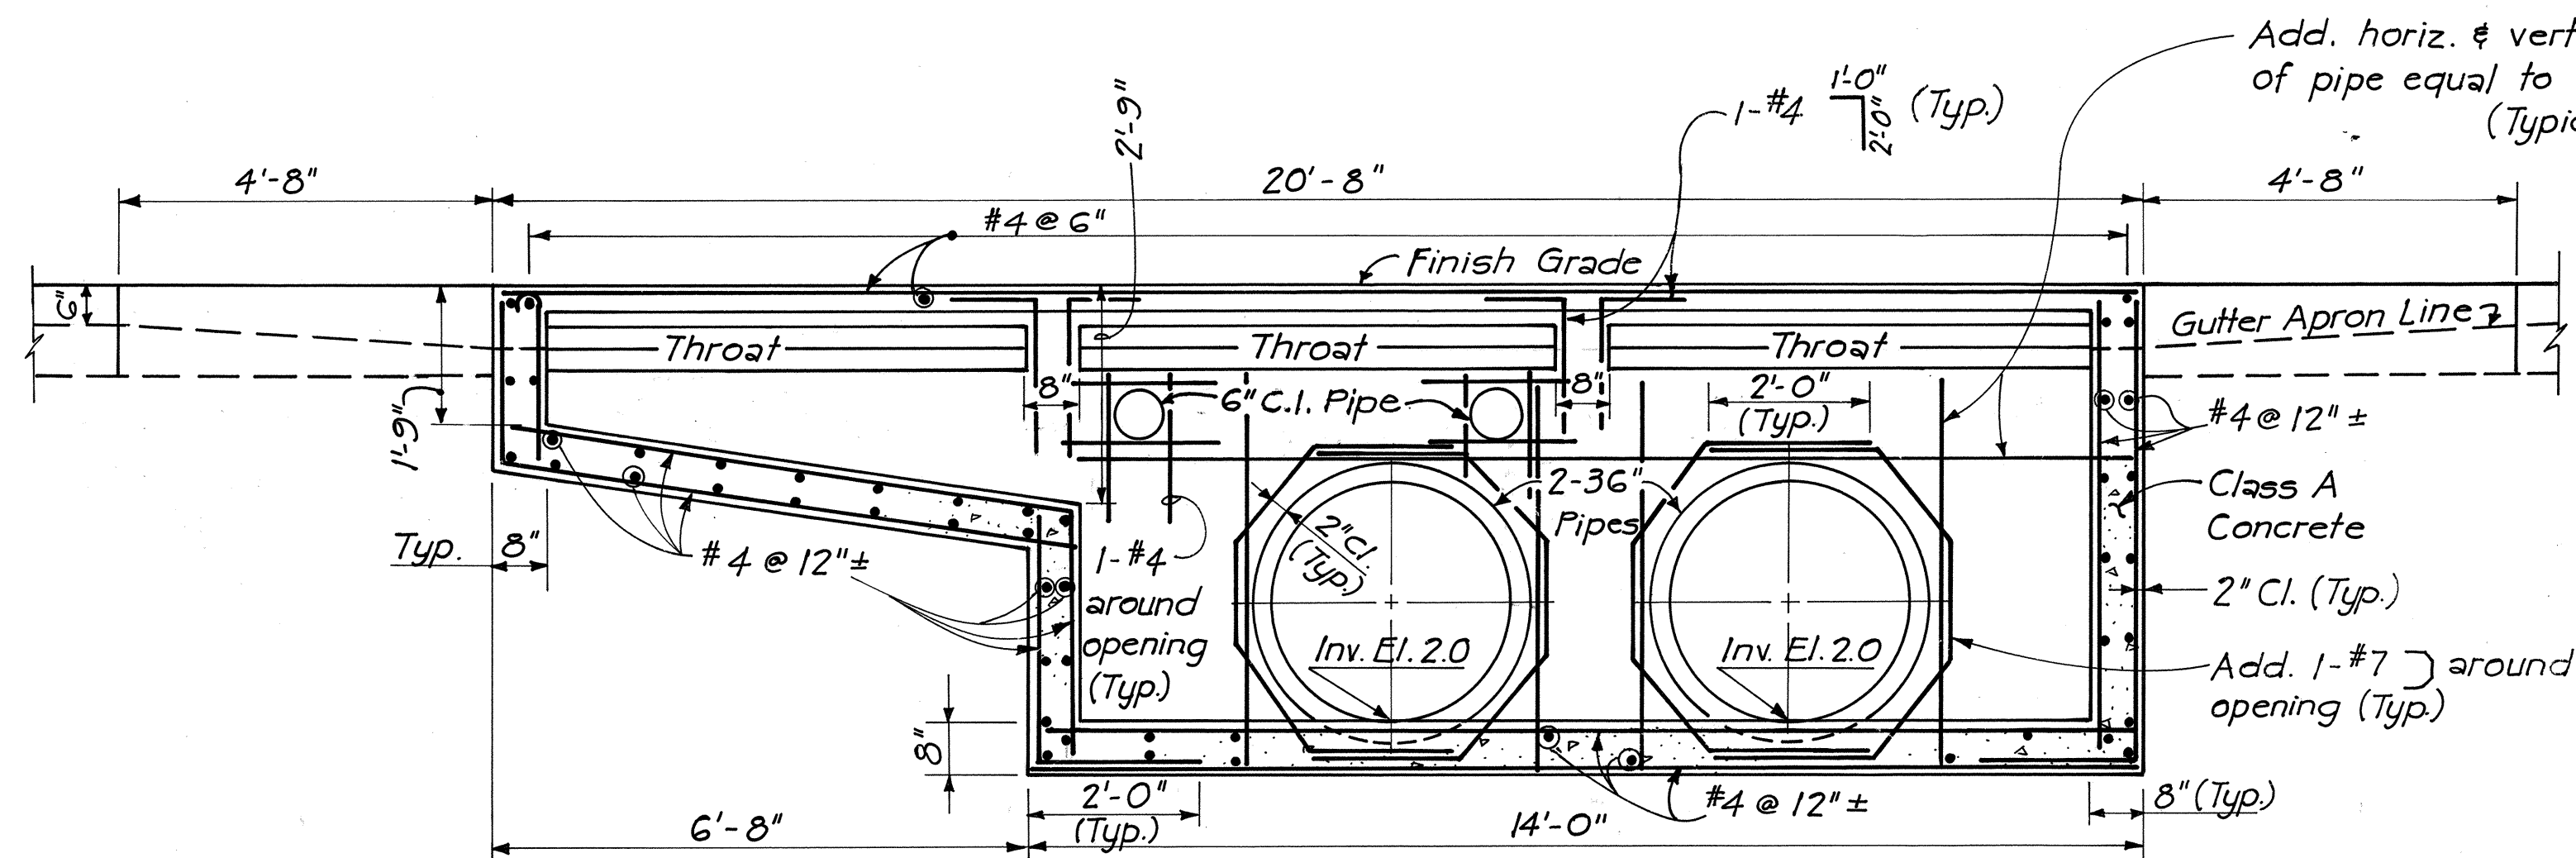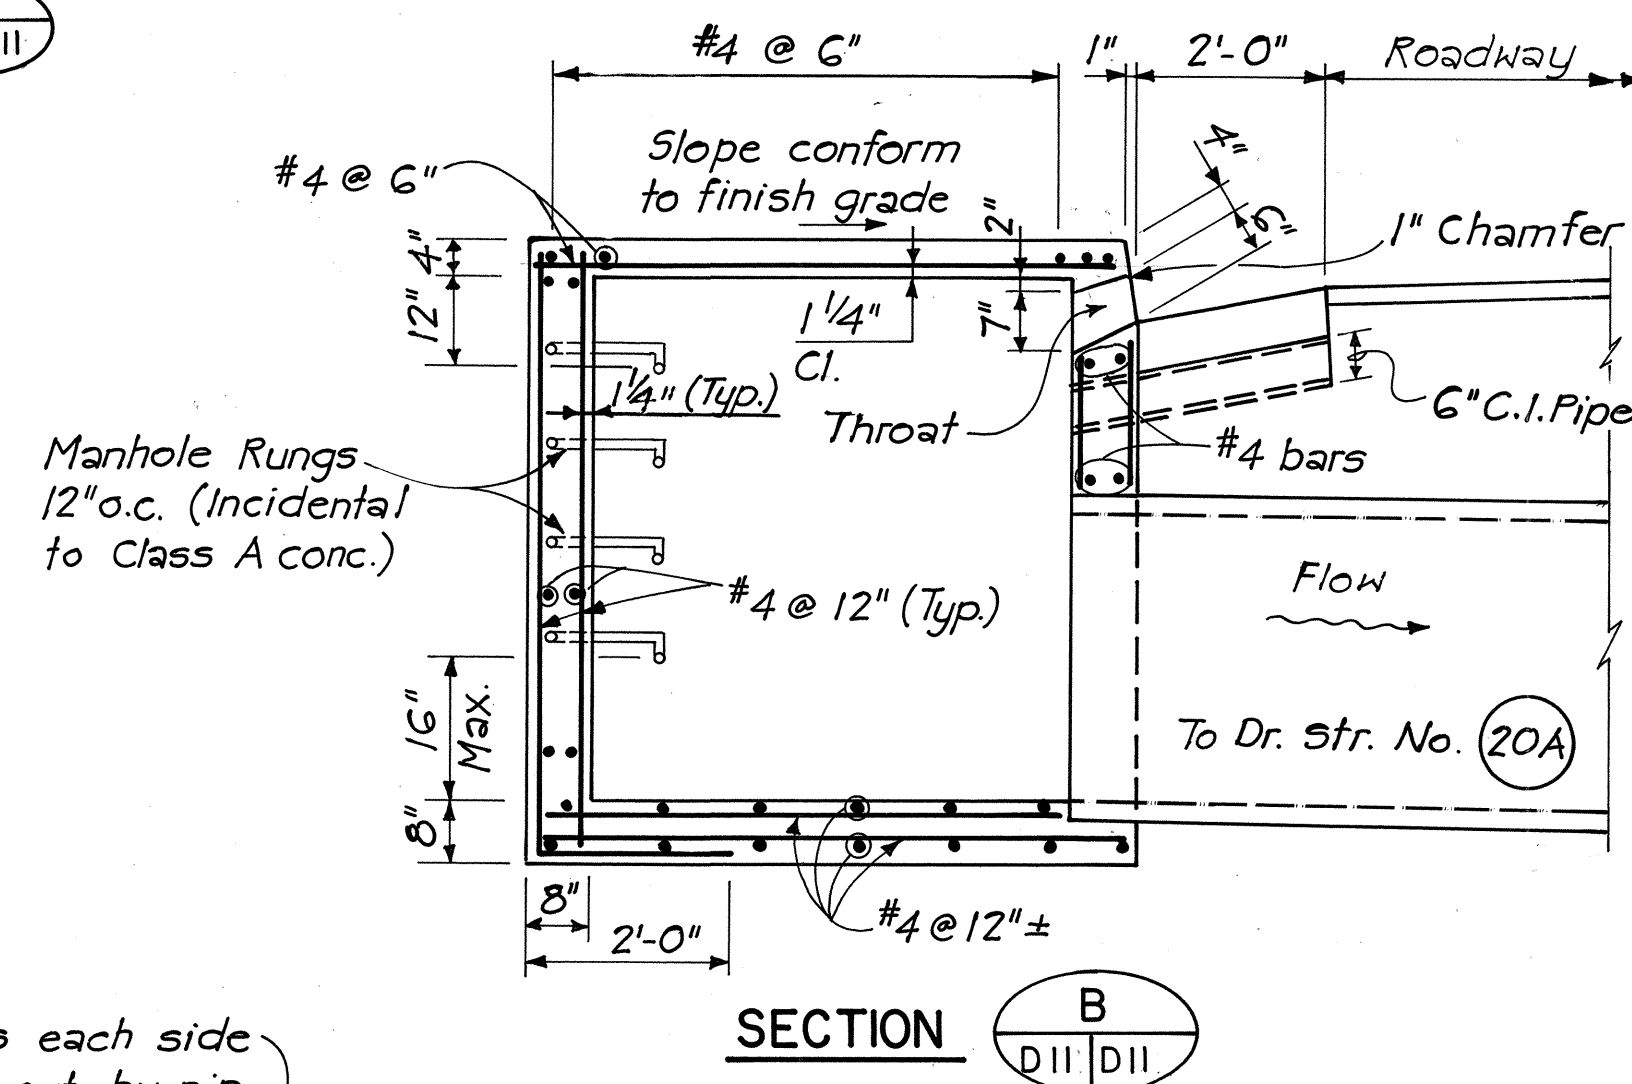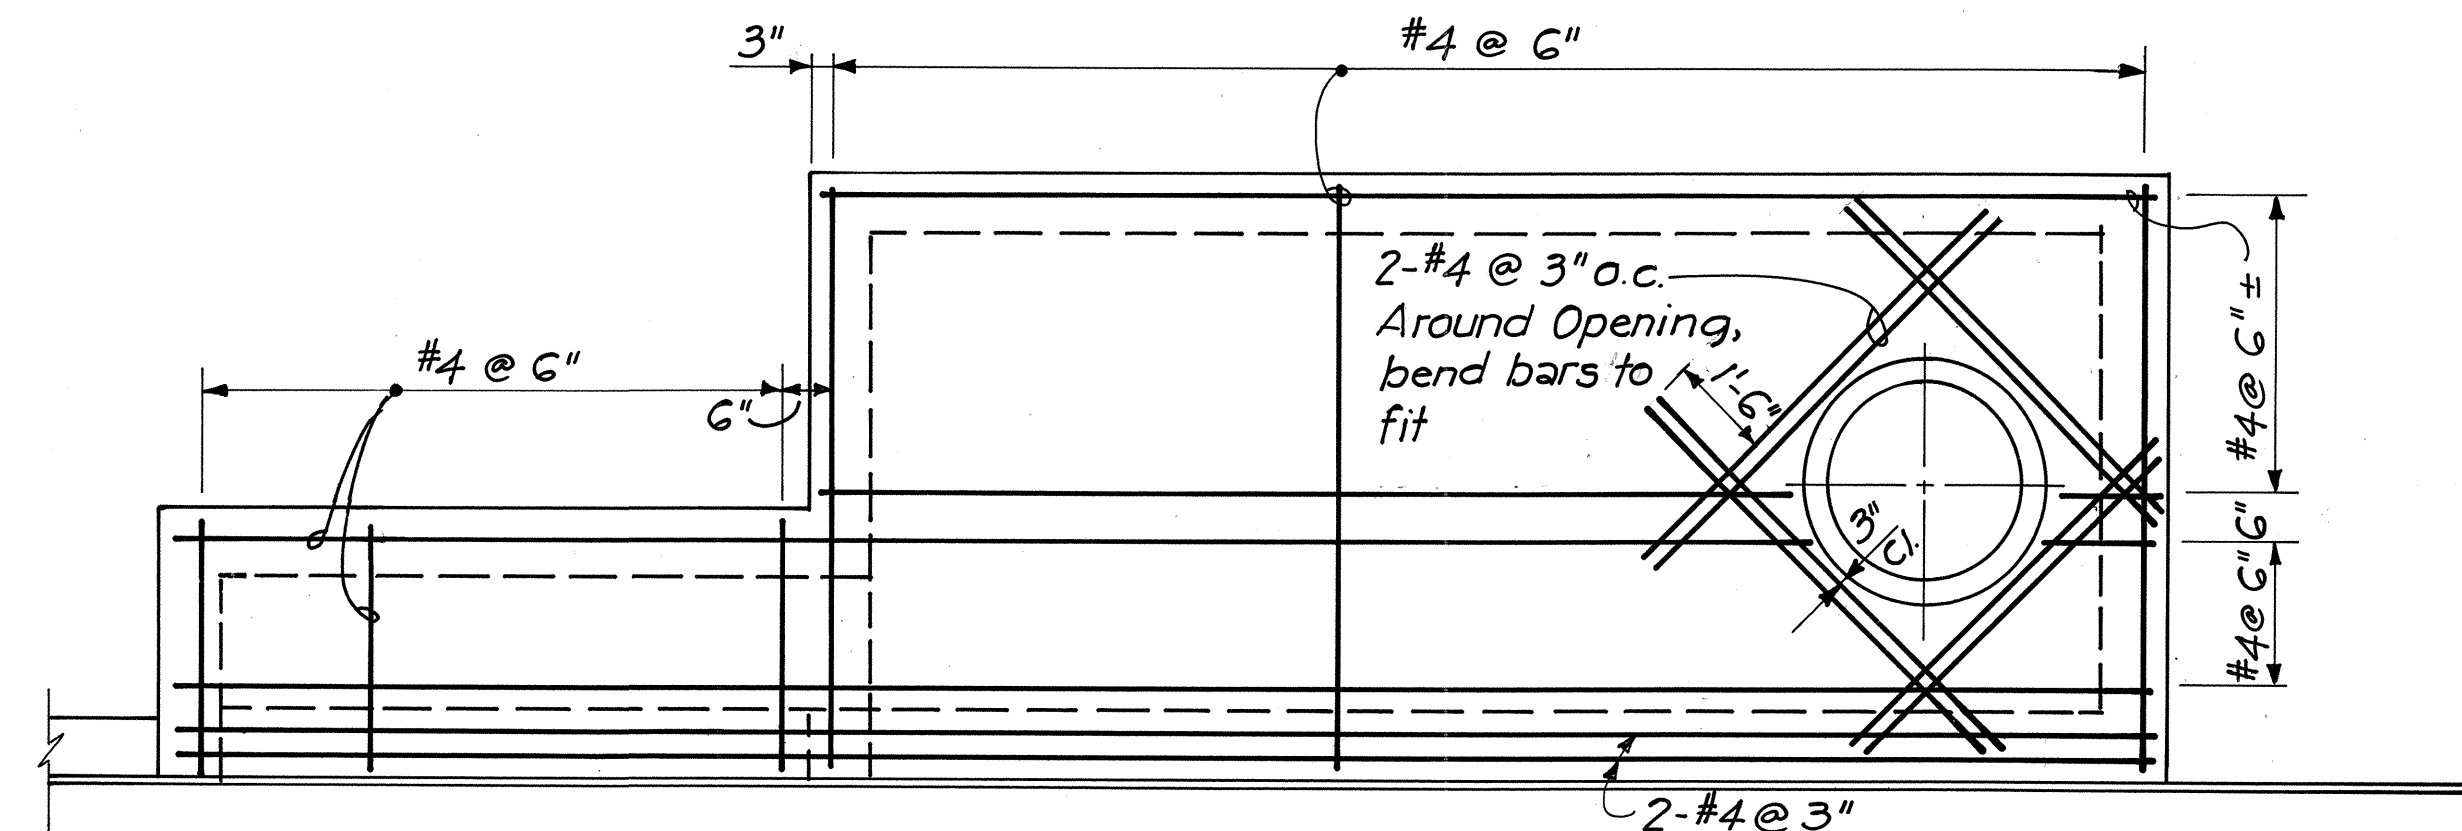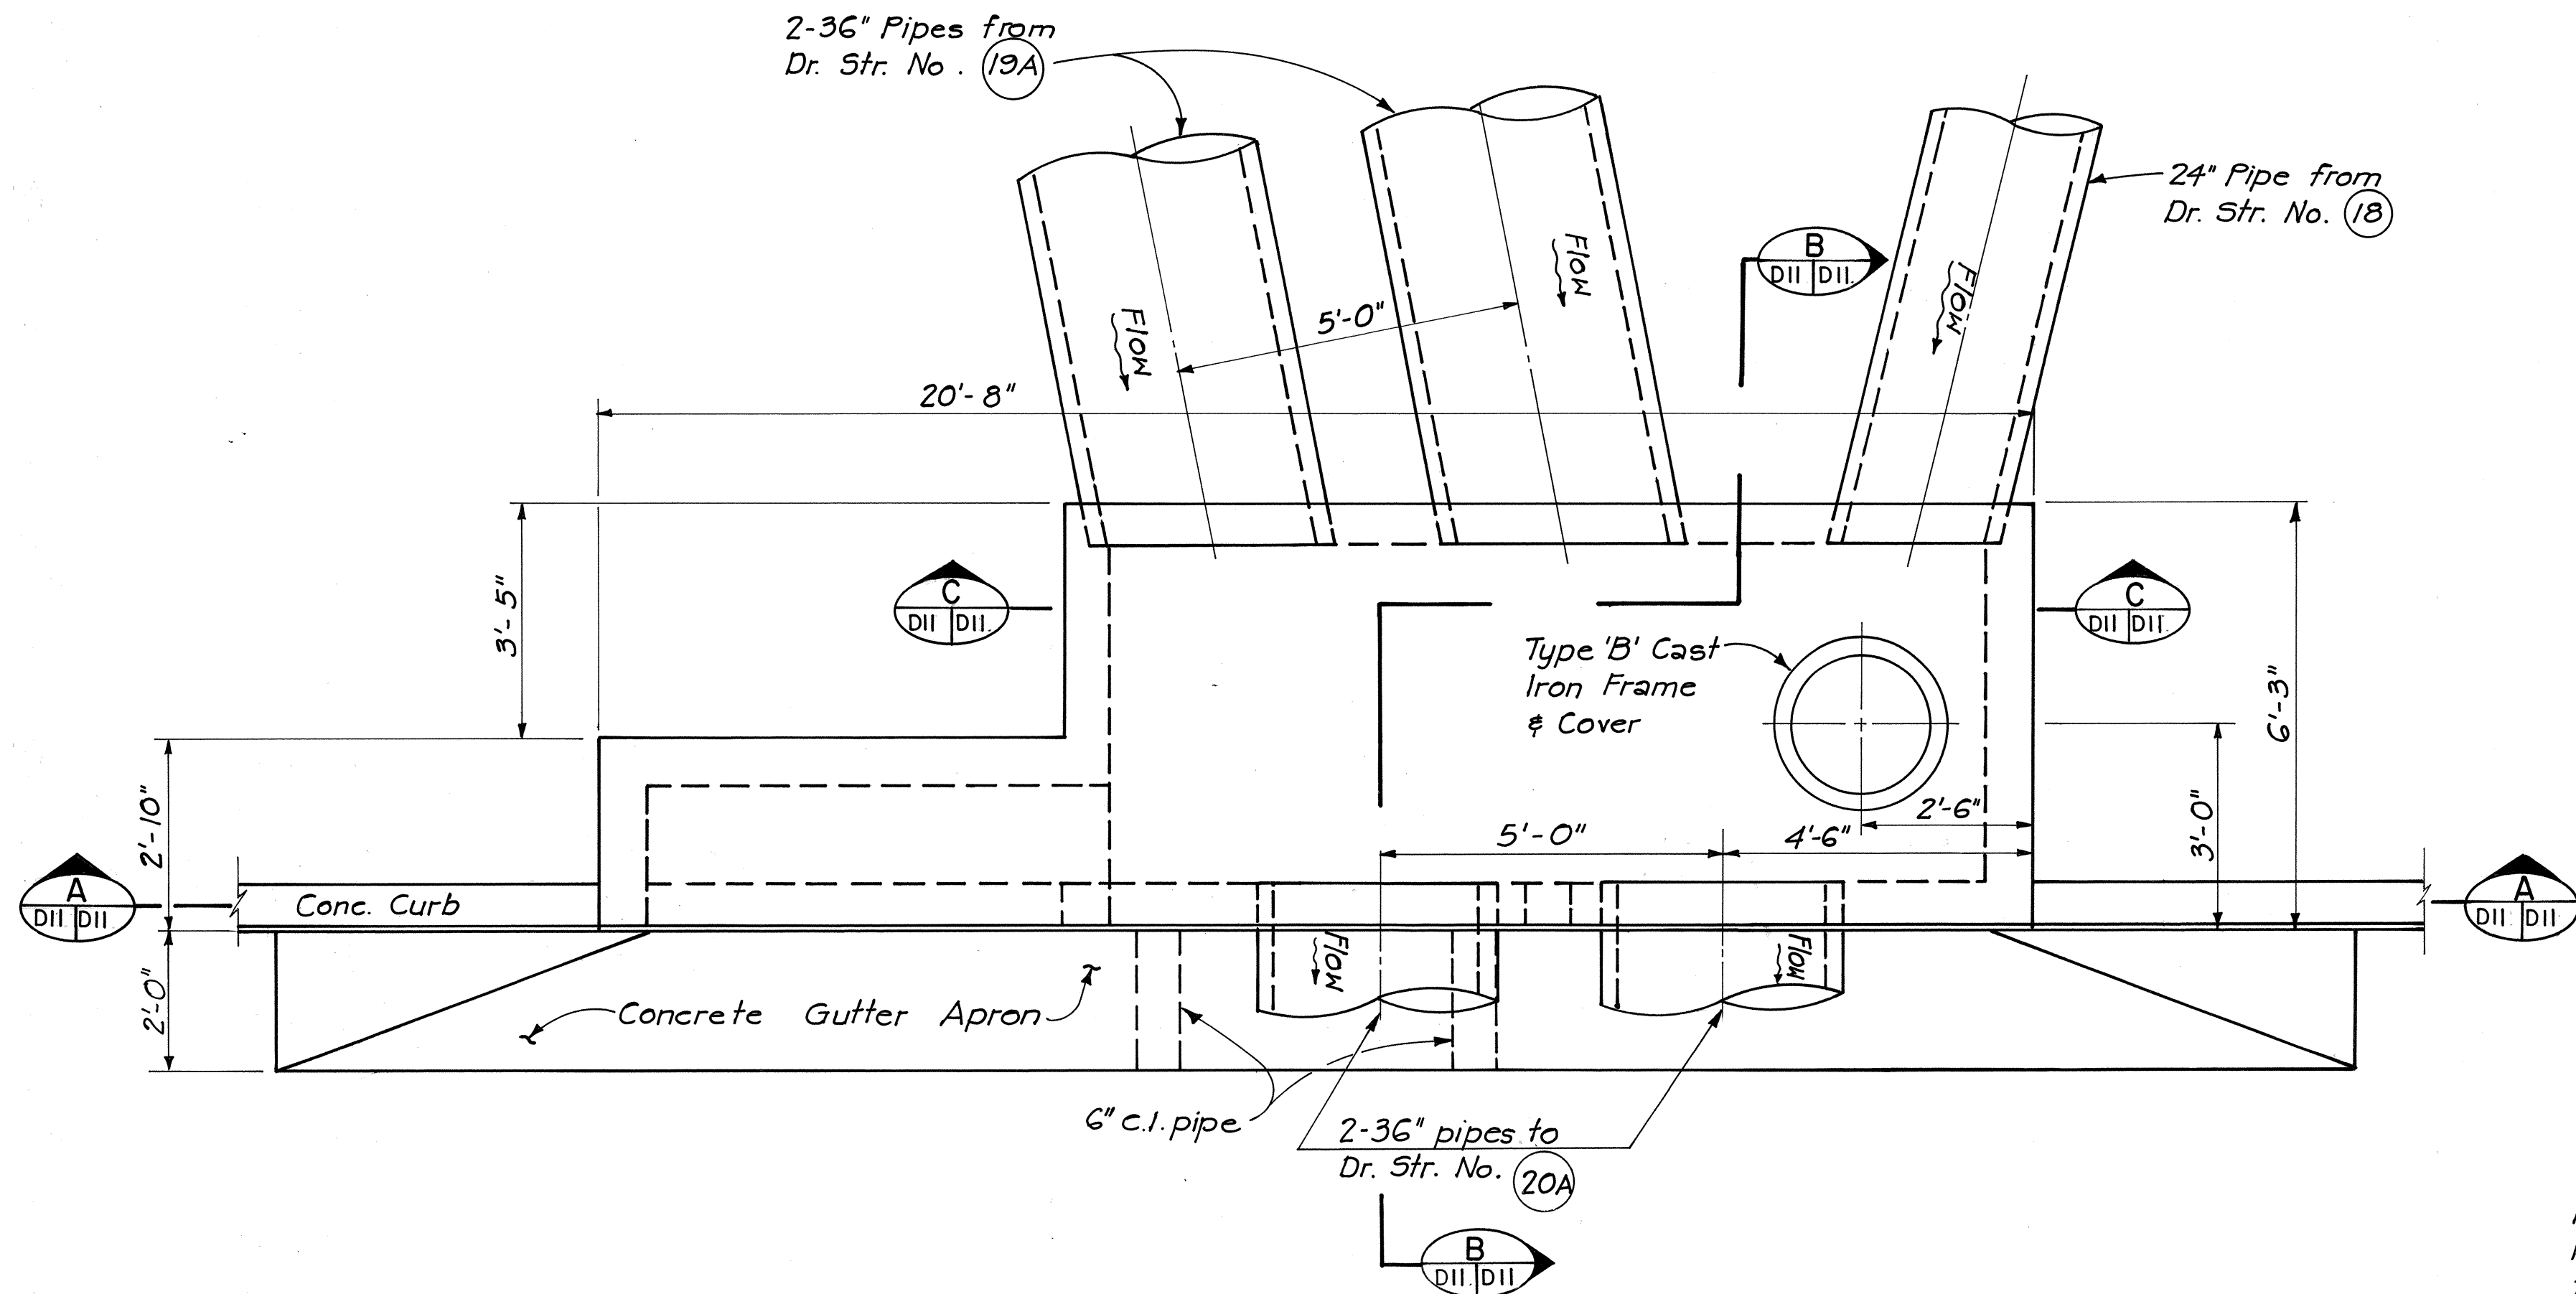

NOTES:

1. Payment for furnishing and installing 6" Cast Iron Pipes shall be considered incidental to the Various Contract Items.
2. For General Notes see Sheet D-6.


CATCH BASIN TYPE 'F' DRAINAGE STRUCTURE NO. (20)

DRAINLINE #8 DETAILS


INTERSTATE ROUTE H-1
PROJECT NO. I-IR-H-1(169):17

SCALE: AS SHOWN DATE: 3/15/82
SHEET NO. D-II OF D-25 SHEETS

FED. ROAD DIST. NO.	STATE	FED. AID PROJ. NO.	FISCAL YEAR	SHEET NO.	TOTAL SHEETS
HAWAII	HAW.	IR-HI-1169-17	1983	57	280

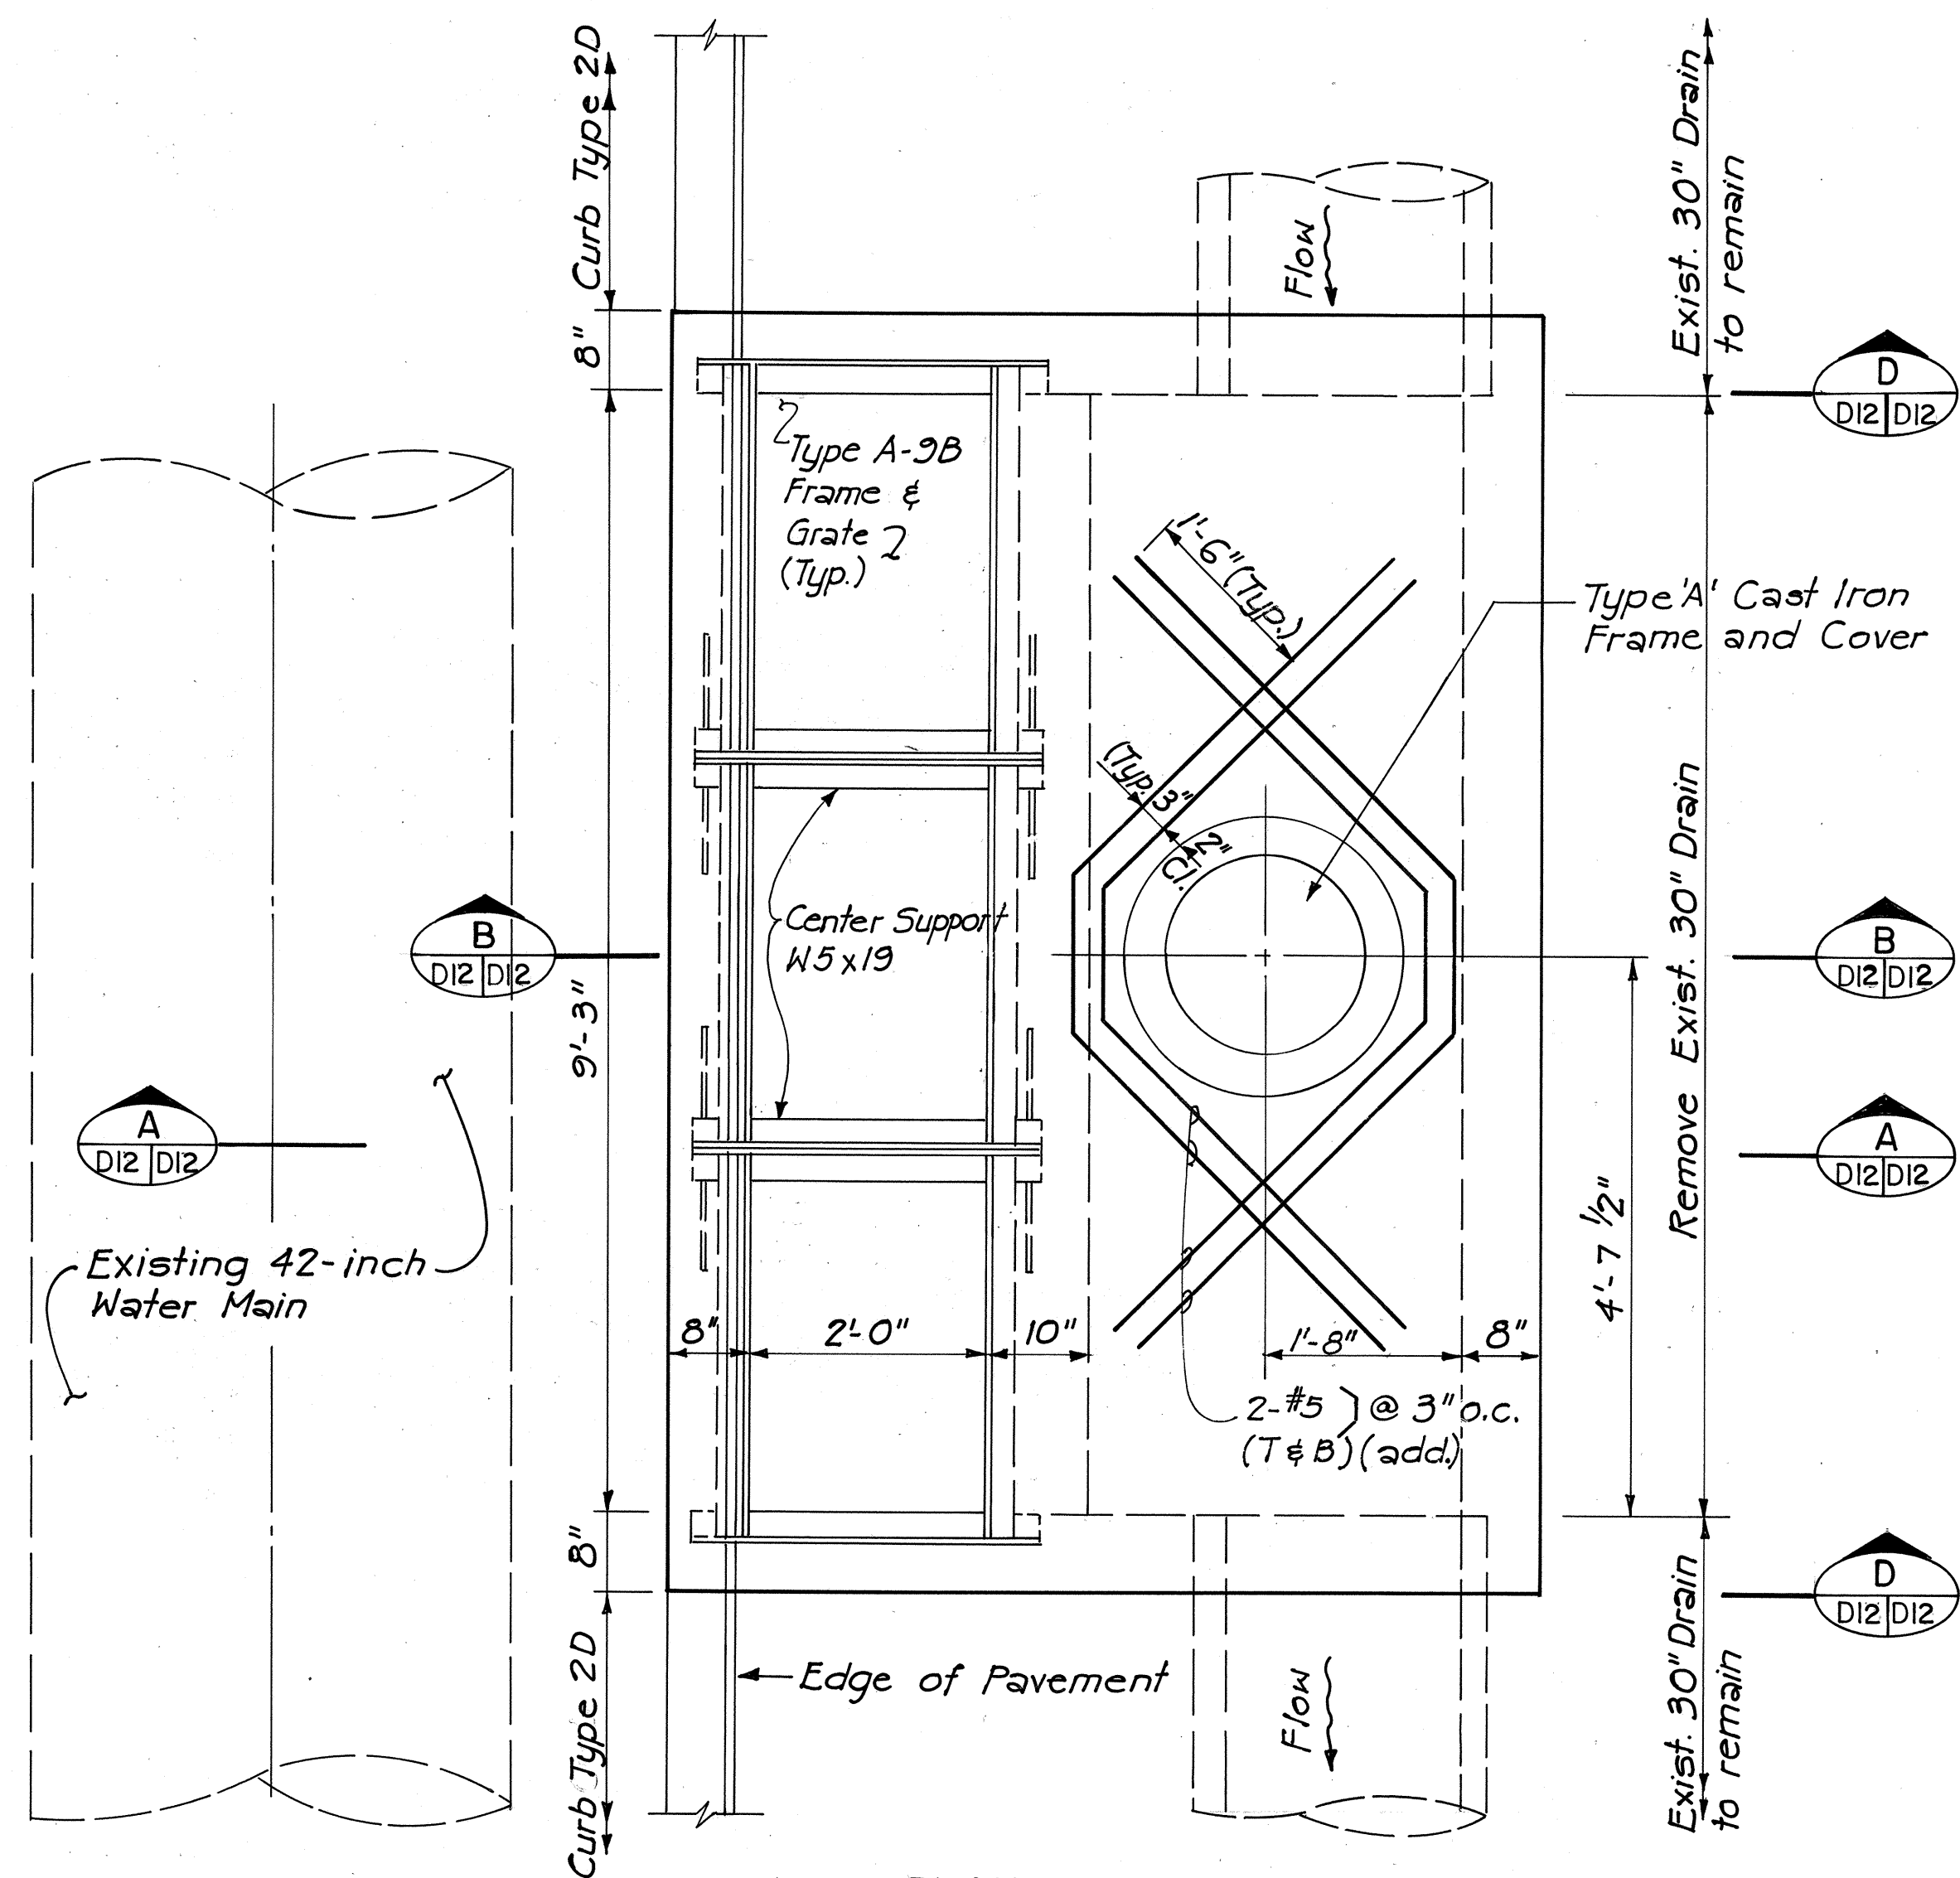


PLAN
Scale: 3/4"=1'-0"

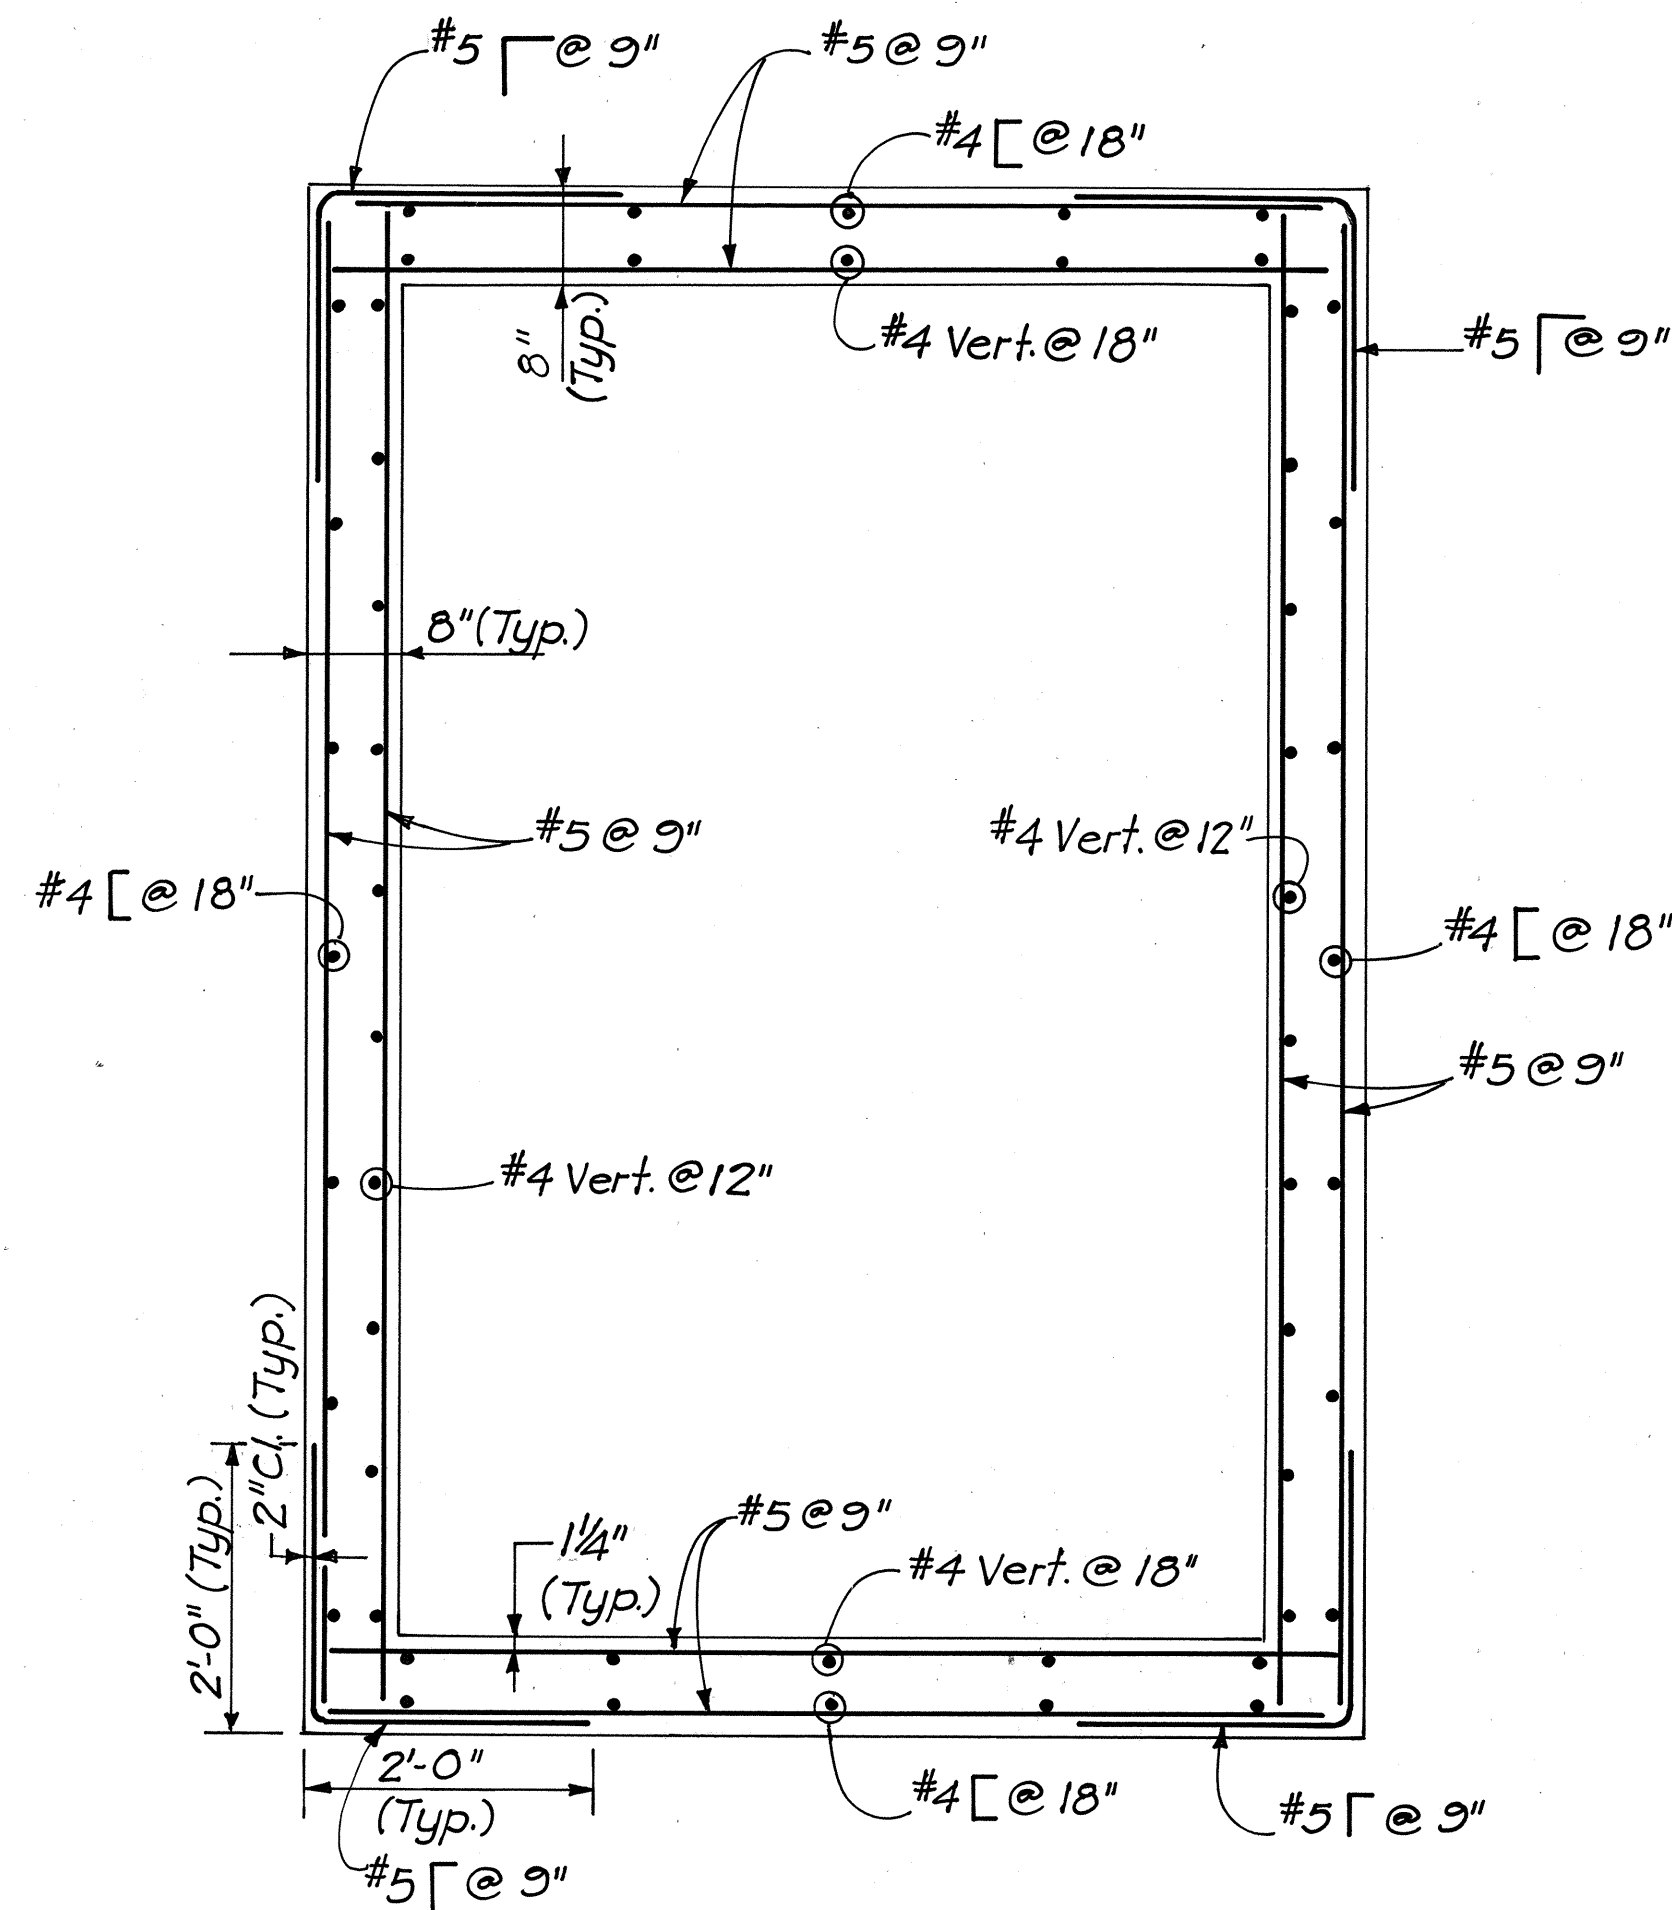


SECTION C
Scale: 3/4"=1'-0"


NOTE:
For General Notes see sheet D-6.

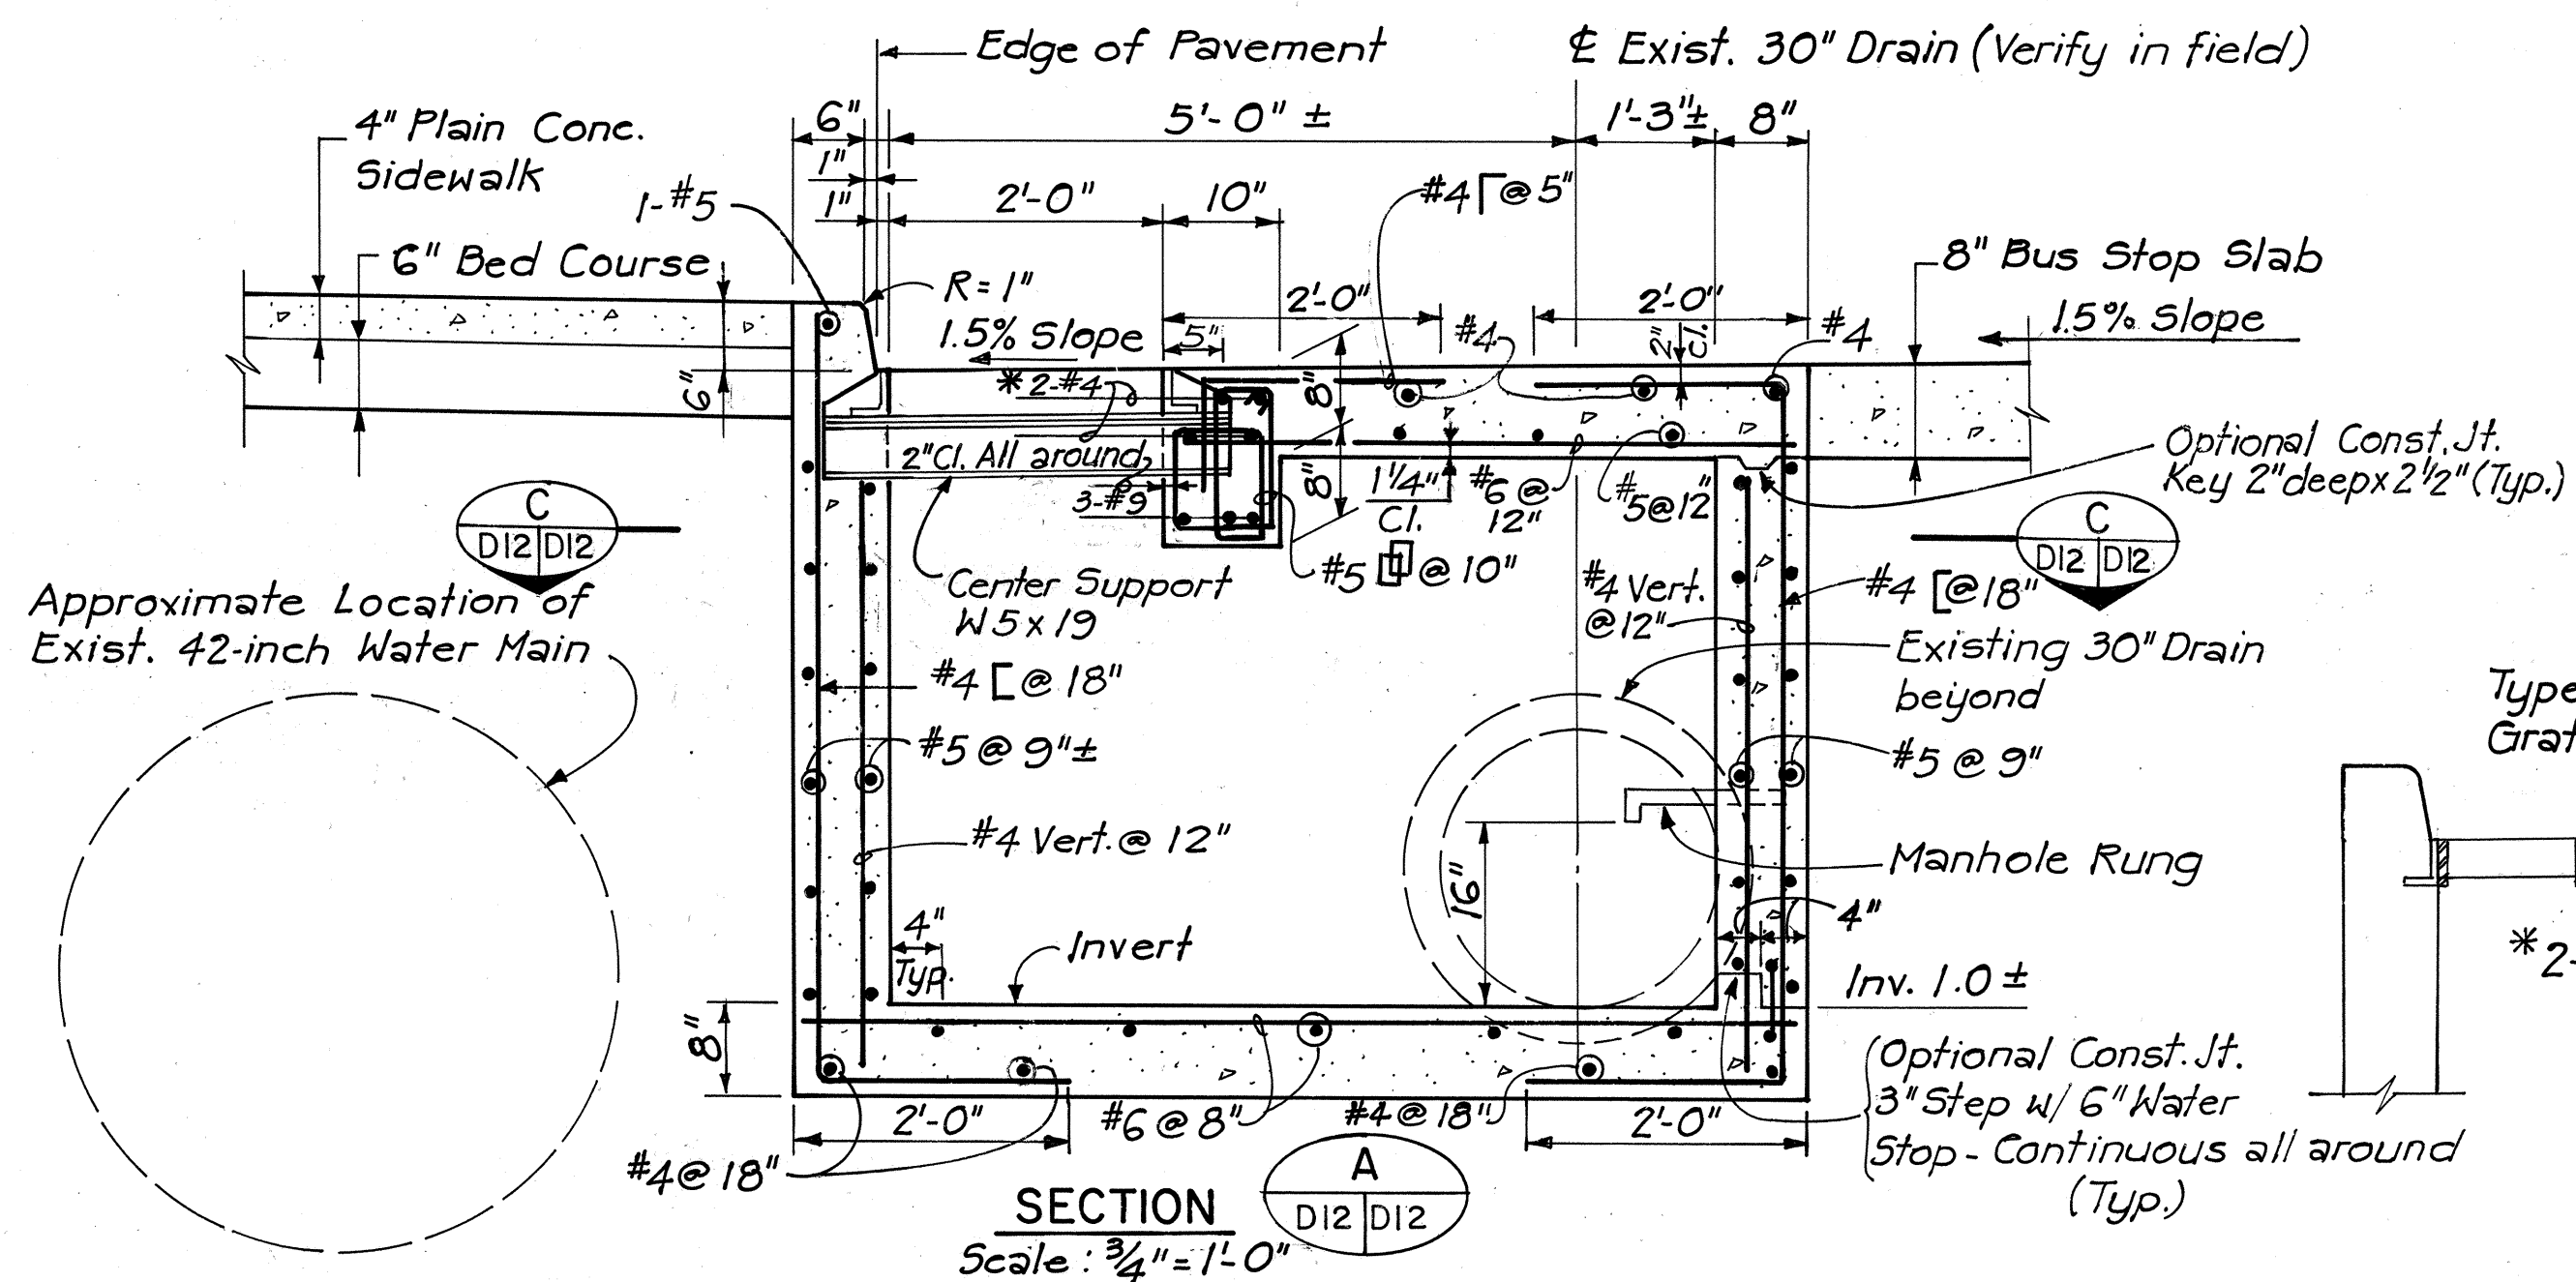


SECTION A
Scale: 3/4"=1'-0"

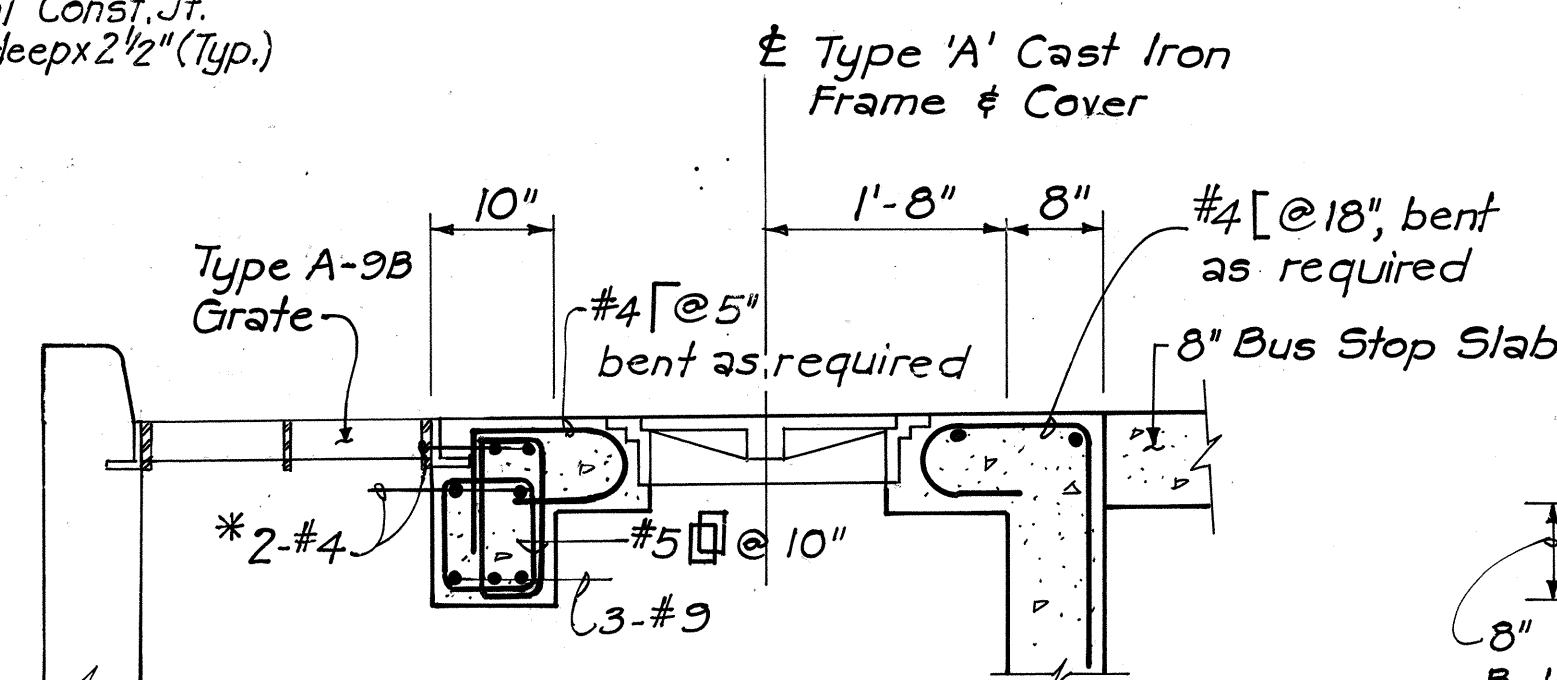

SECTION B
Scale: 3/4"=1'-0"

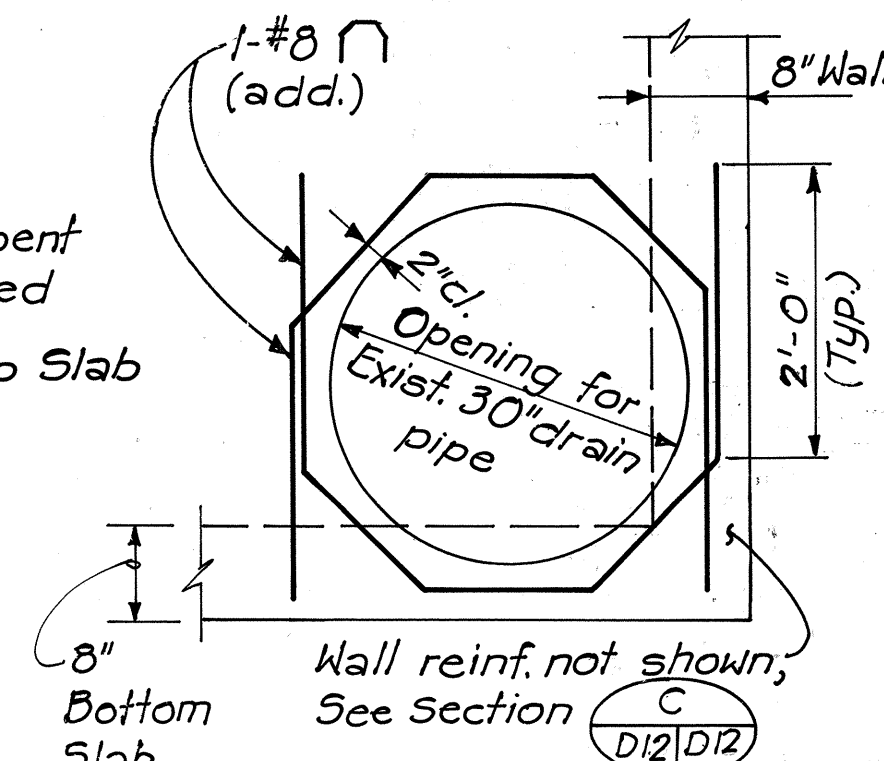

SECTION D
Scale: 3/4"=1'-0"

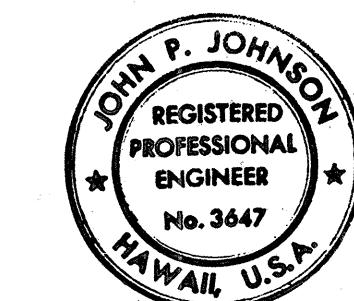

THIS WORK WAS PREPARED BY ME
OR UNDER MY SUPERVISION.
John P. Johnson


STATE OF HAWAII
DEPARTMENT OF TRANSPORTATION
HIGHWAYS DIVISION

DRAINAGE DETAILS


INTERSTATE ROUTE H-1
PROJECT NO. I-IR-HI-1169-17

SCALE: AS SHOWN
DATE: 3/15/82
SHEET NO. D-12 OF D-25 SHEETS



FED. ROAD DIST. NO.	STATE	FED. AID PROJ. NO.	FISCAL YEAR	SHEET NO.	TOTAL SHEETS
HAWAII	HAW.	IR-H-1(16)17	1983	58	280

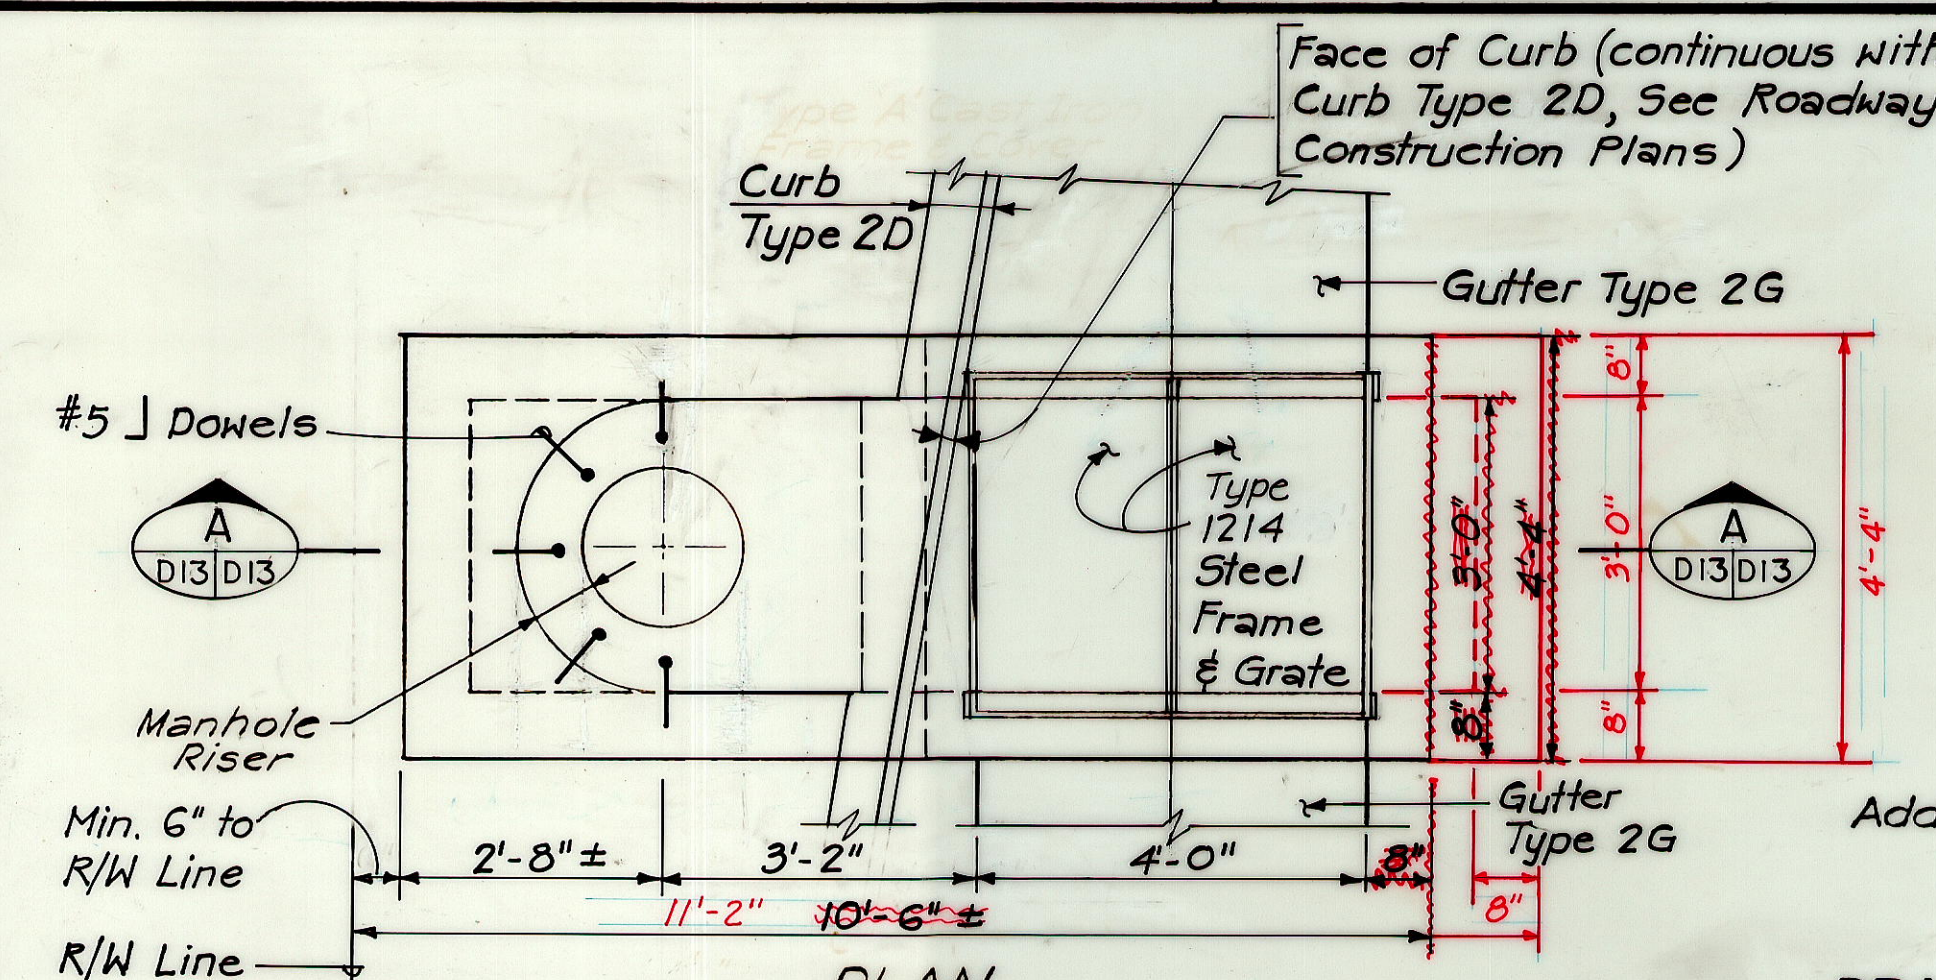



(NOTE : Only dowels around circular Manhole Riser shown, see Section A for other re-bars)

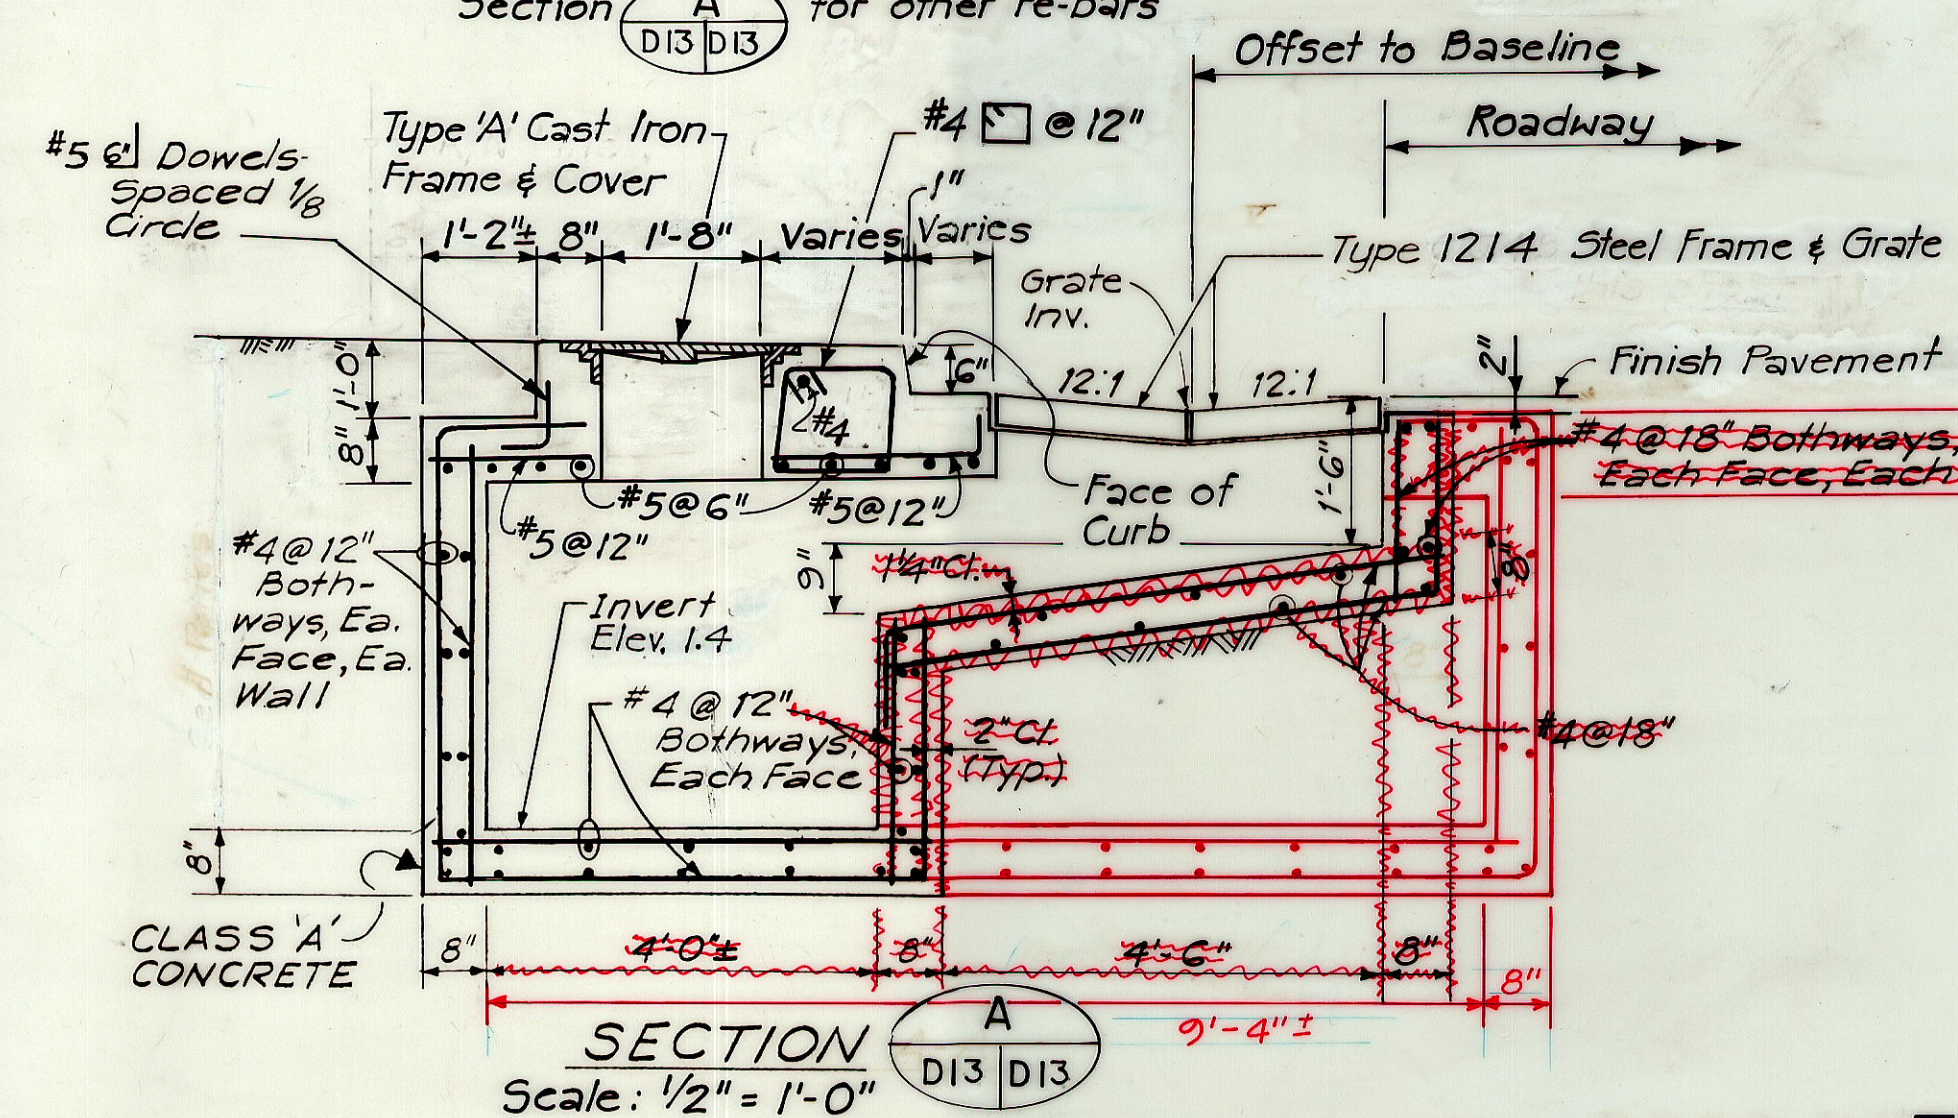


DRAINAGE STRUCTURE NO. (27)
REVISED DROP INTAKE TYPE 'K-I'
(C.C.O. 28)

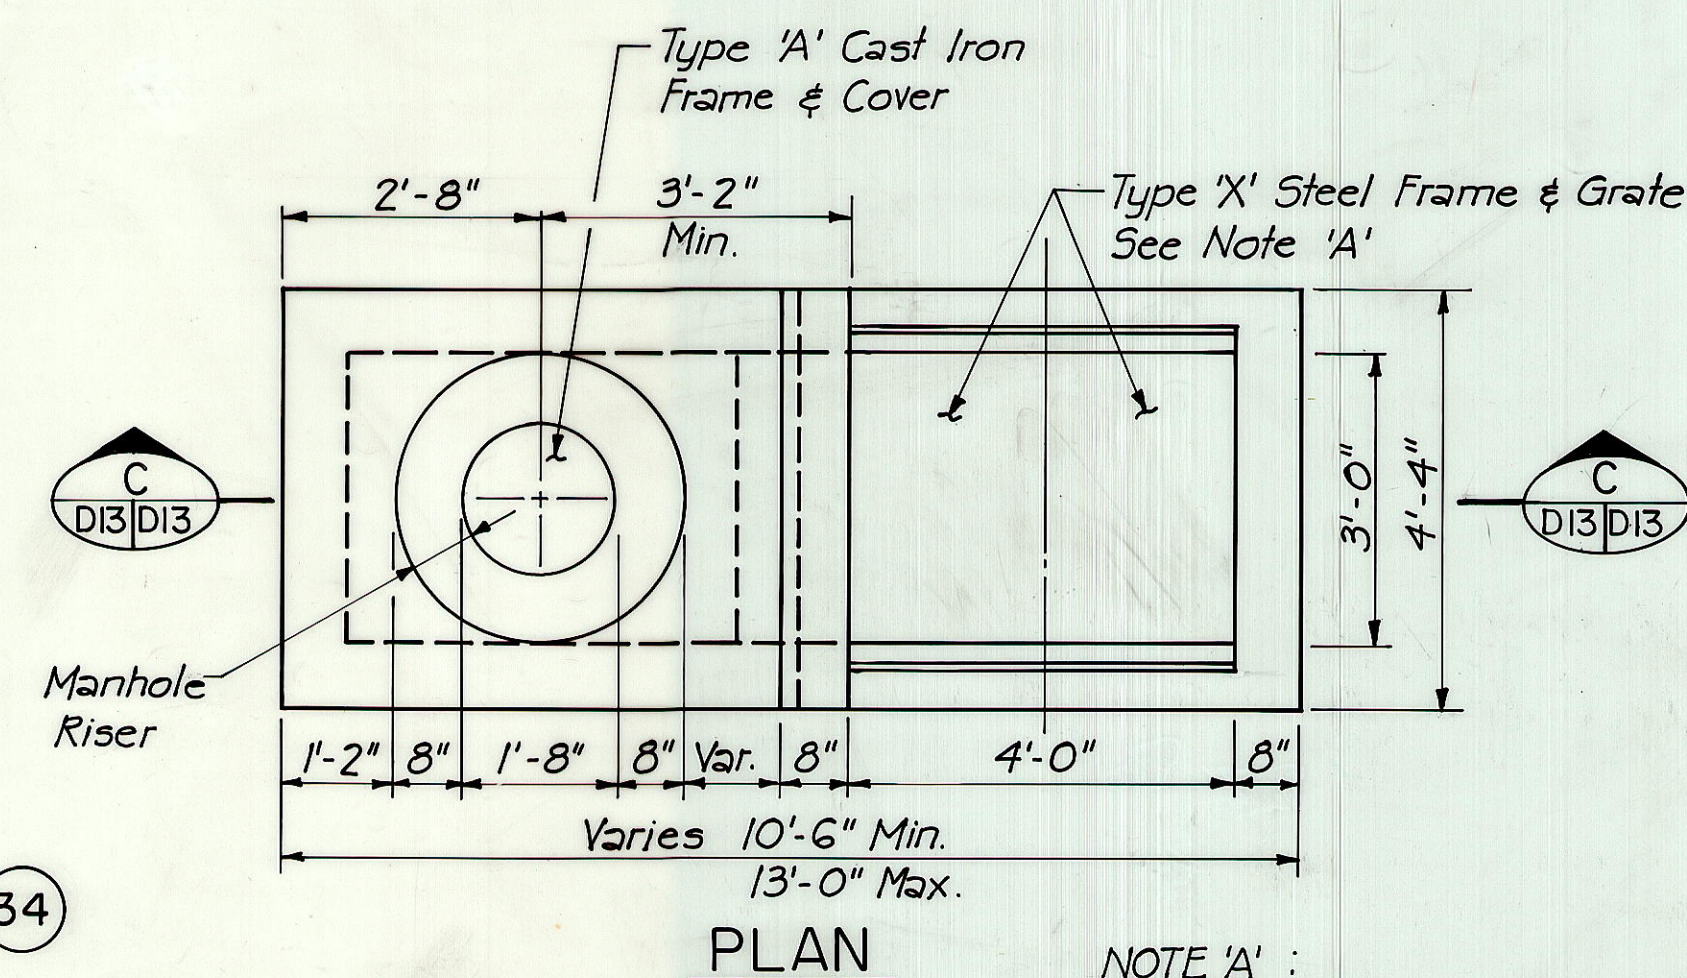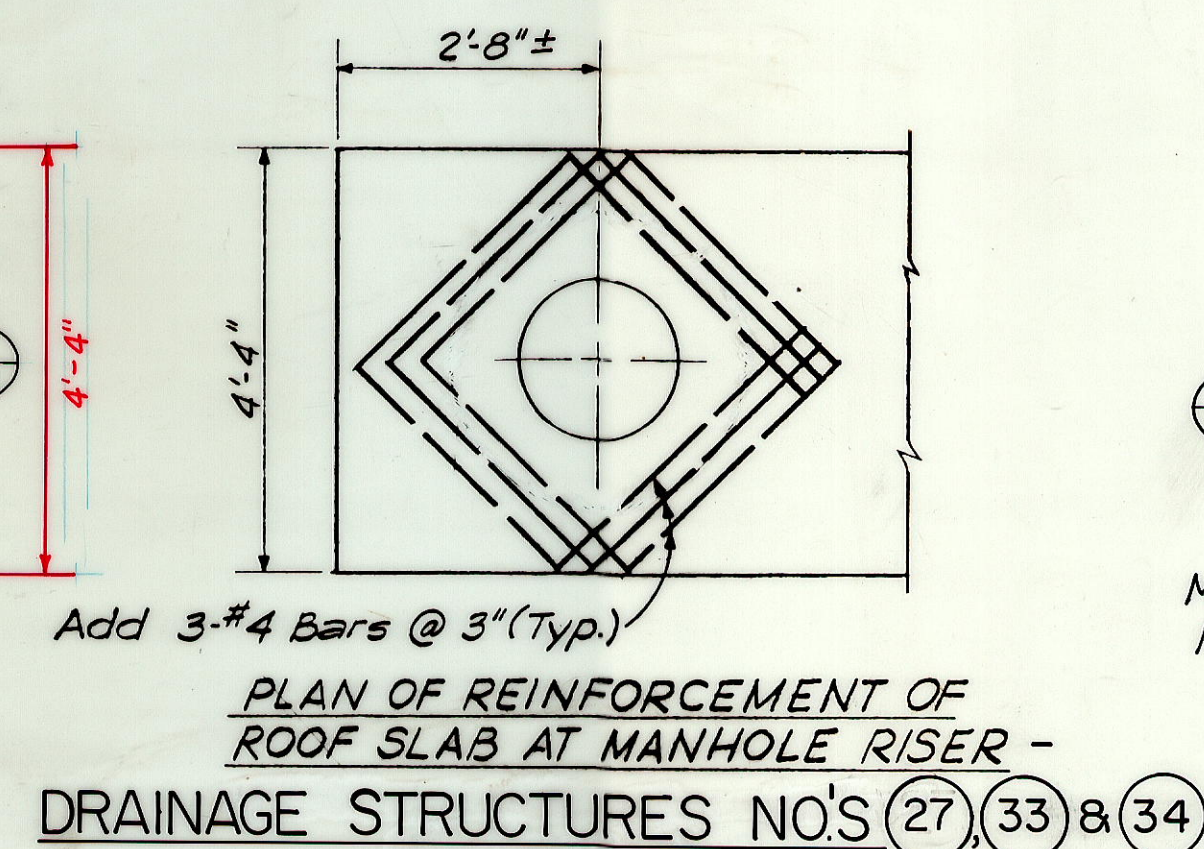

NOTE 'A' :
Type 'X' Steel Frame & Grate for Drainage Structures No.s (33) & (34) will be made available at the State Field Office at the corner of Kakoi Street and Kilihau Street. The Contractor shall modify the Steel Grates as shown in Detail (1)

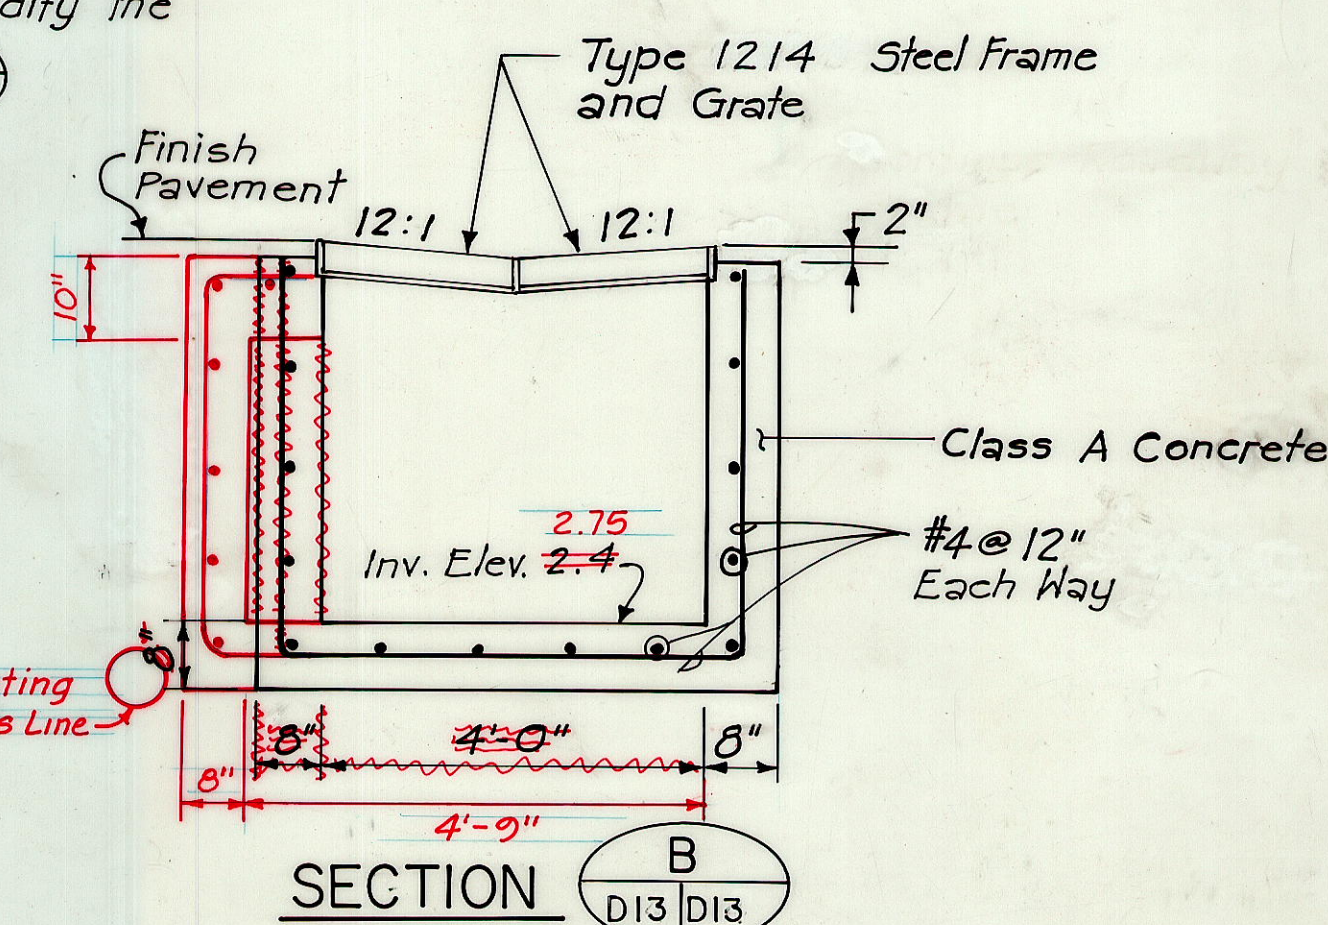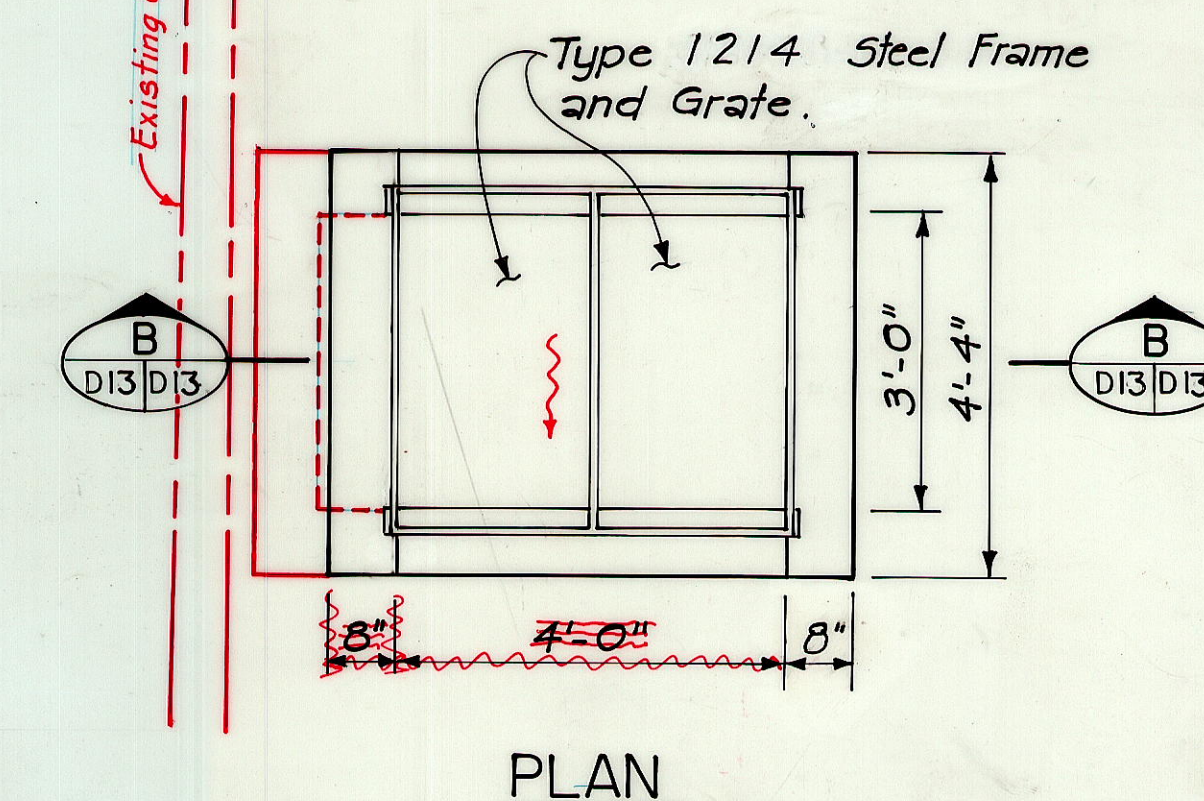


DRAINAGE STRUCTURE NO. (26)
REVISED DROP INTAKE TYPE 'K' (CCO28)
 Scale: $\frac{1}{2}'' = 1'-0''$

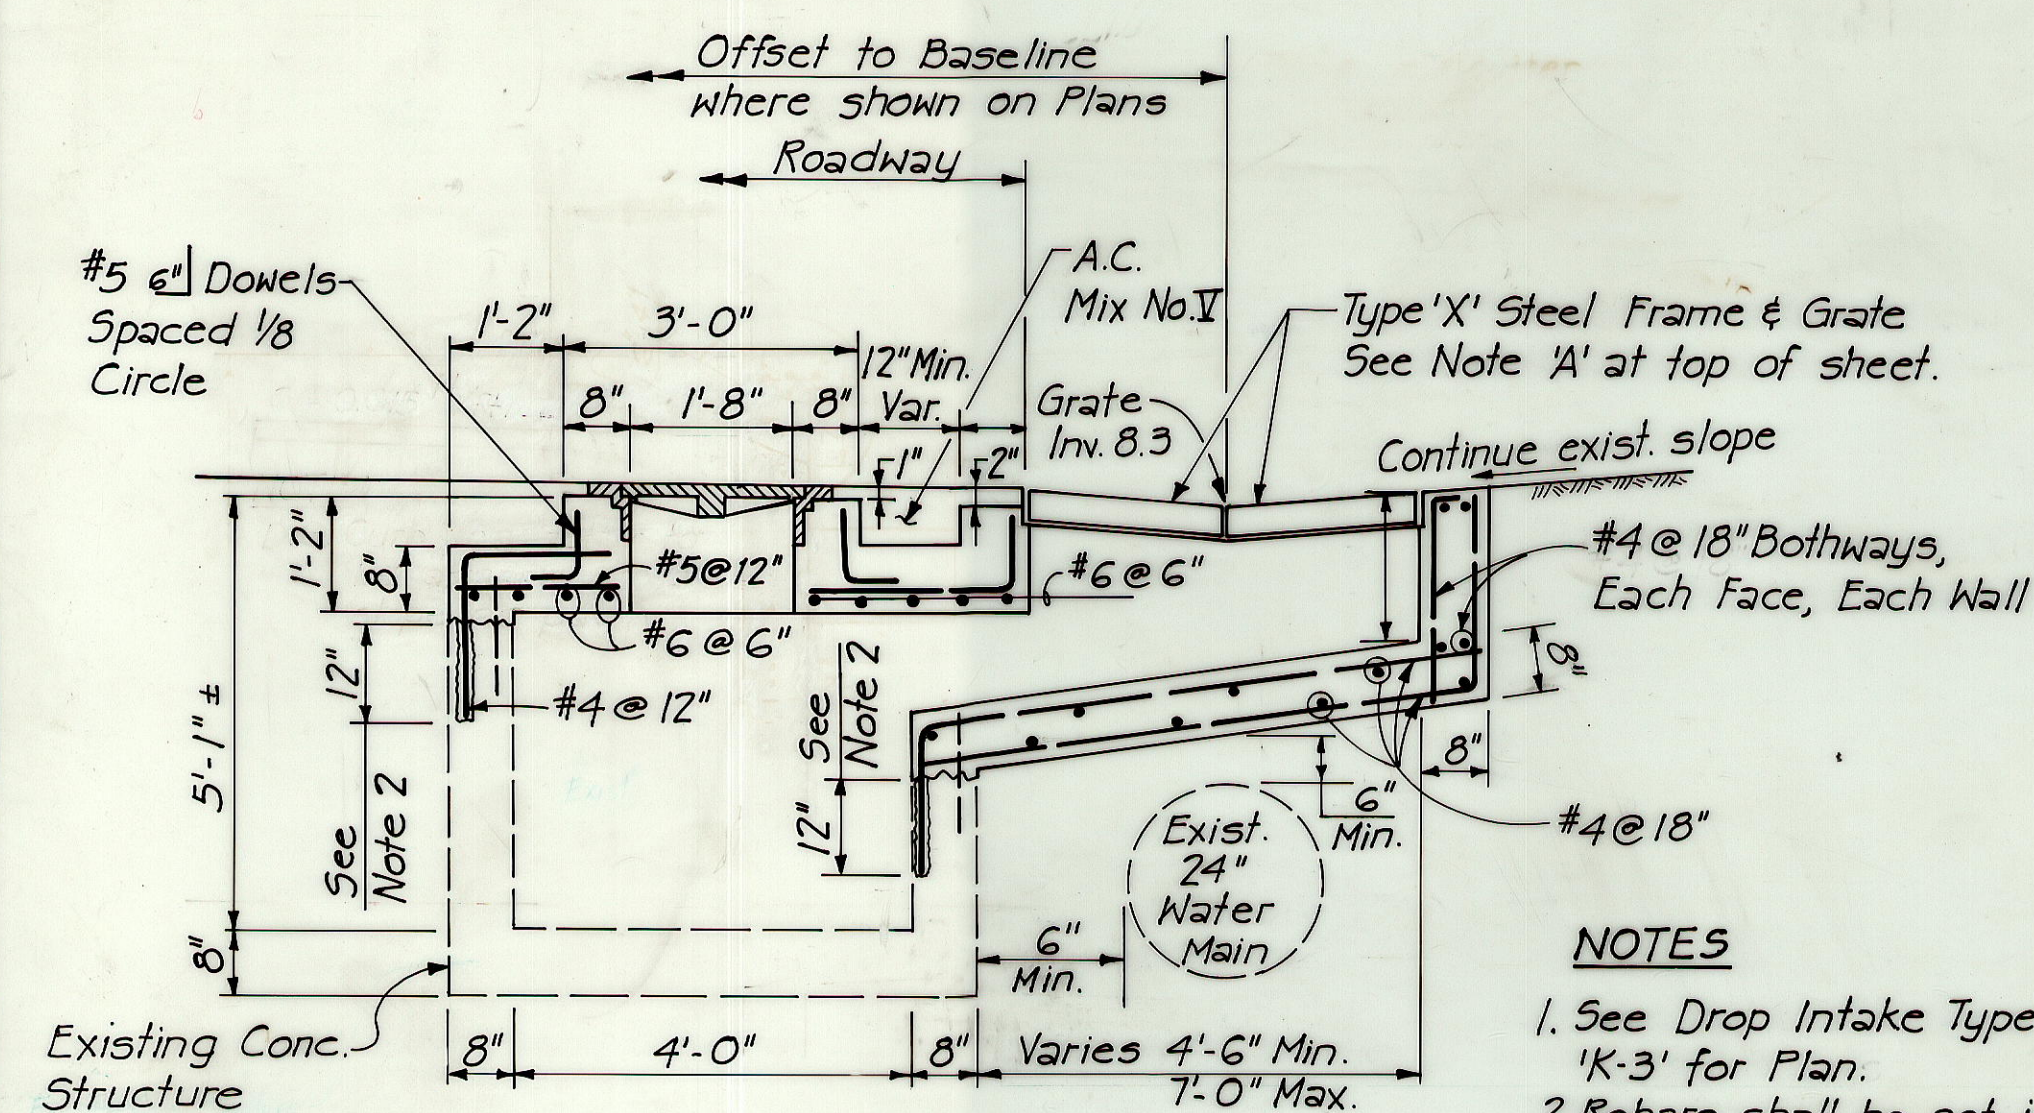


NOTES

DRAINAGE STRUCTURE NO. (33)
DROP INTAKE TYPE 'K-2'
 Scale: $1/2" = 1'-0"$

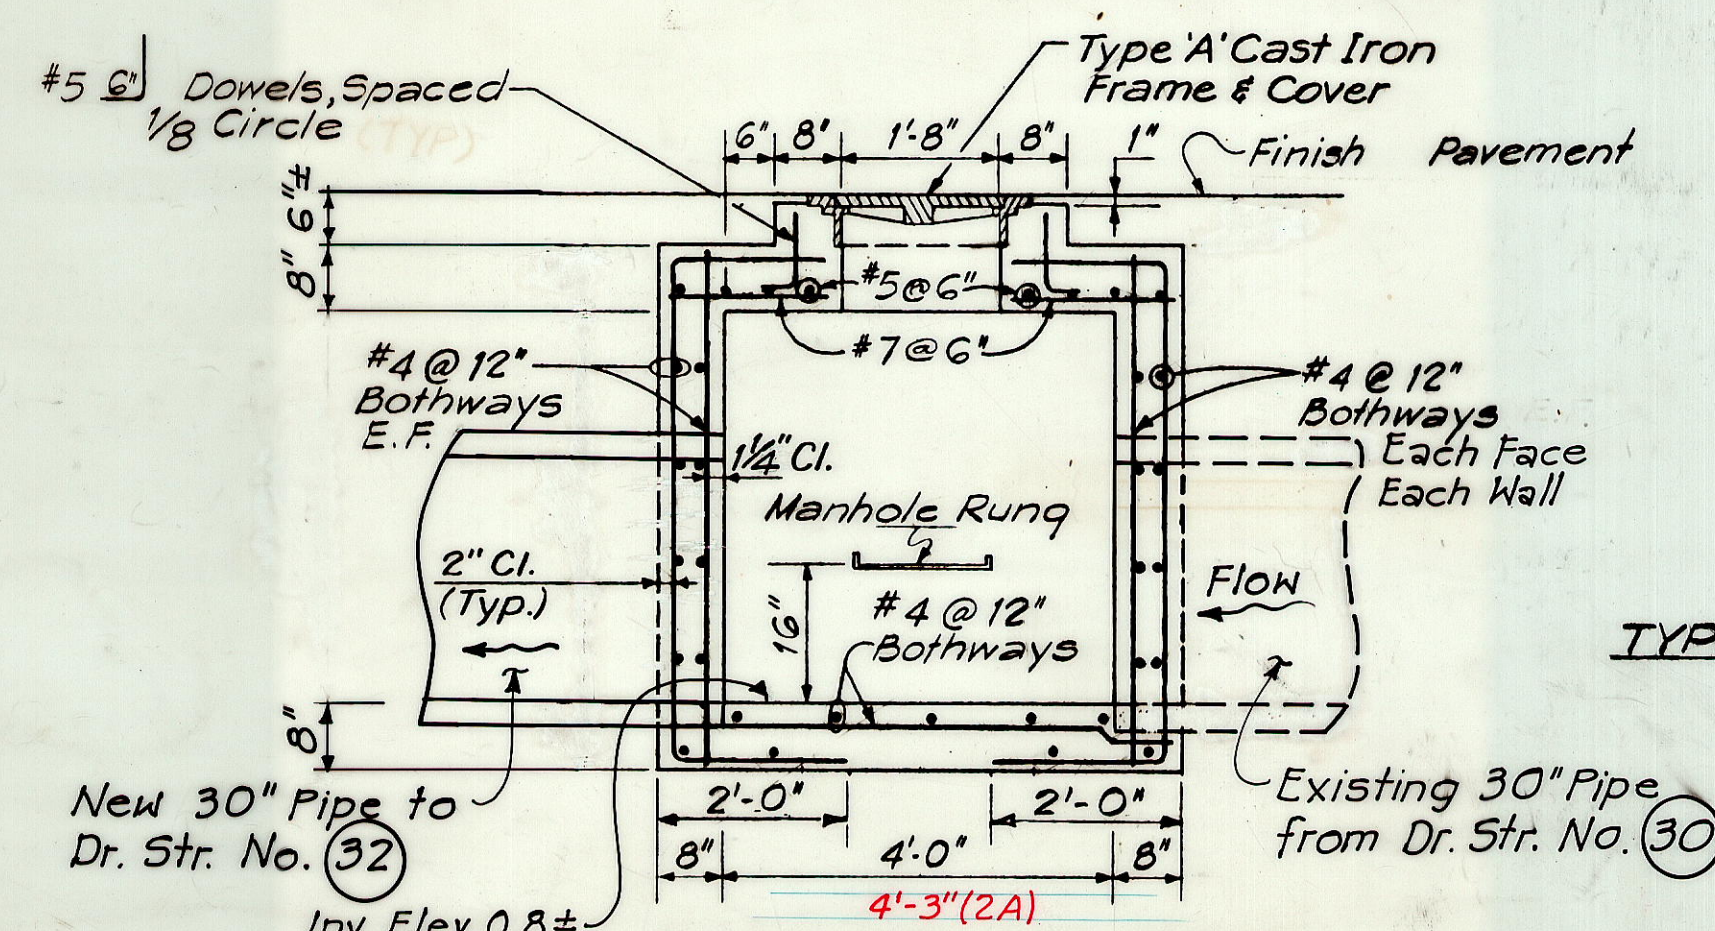

NOTE :
For General Notes regarding
concrete structures & reinforcing
steel, see Sheet D-6.

DRAINAGE STRUCTURE NO. 31 & 35
MANHOLE TYPE 'IA' & '2A' (SEC. A-A)
Scale: $1/2" = 1'-0"$

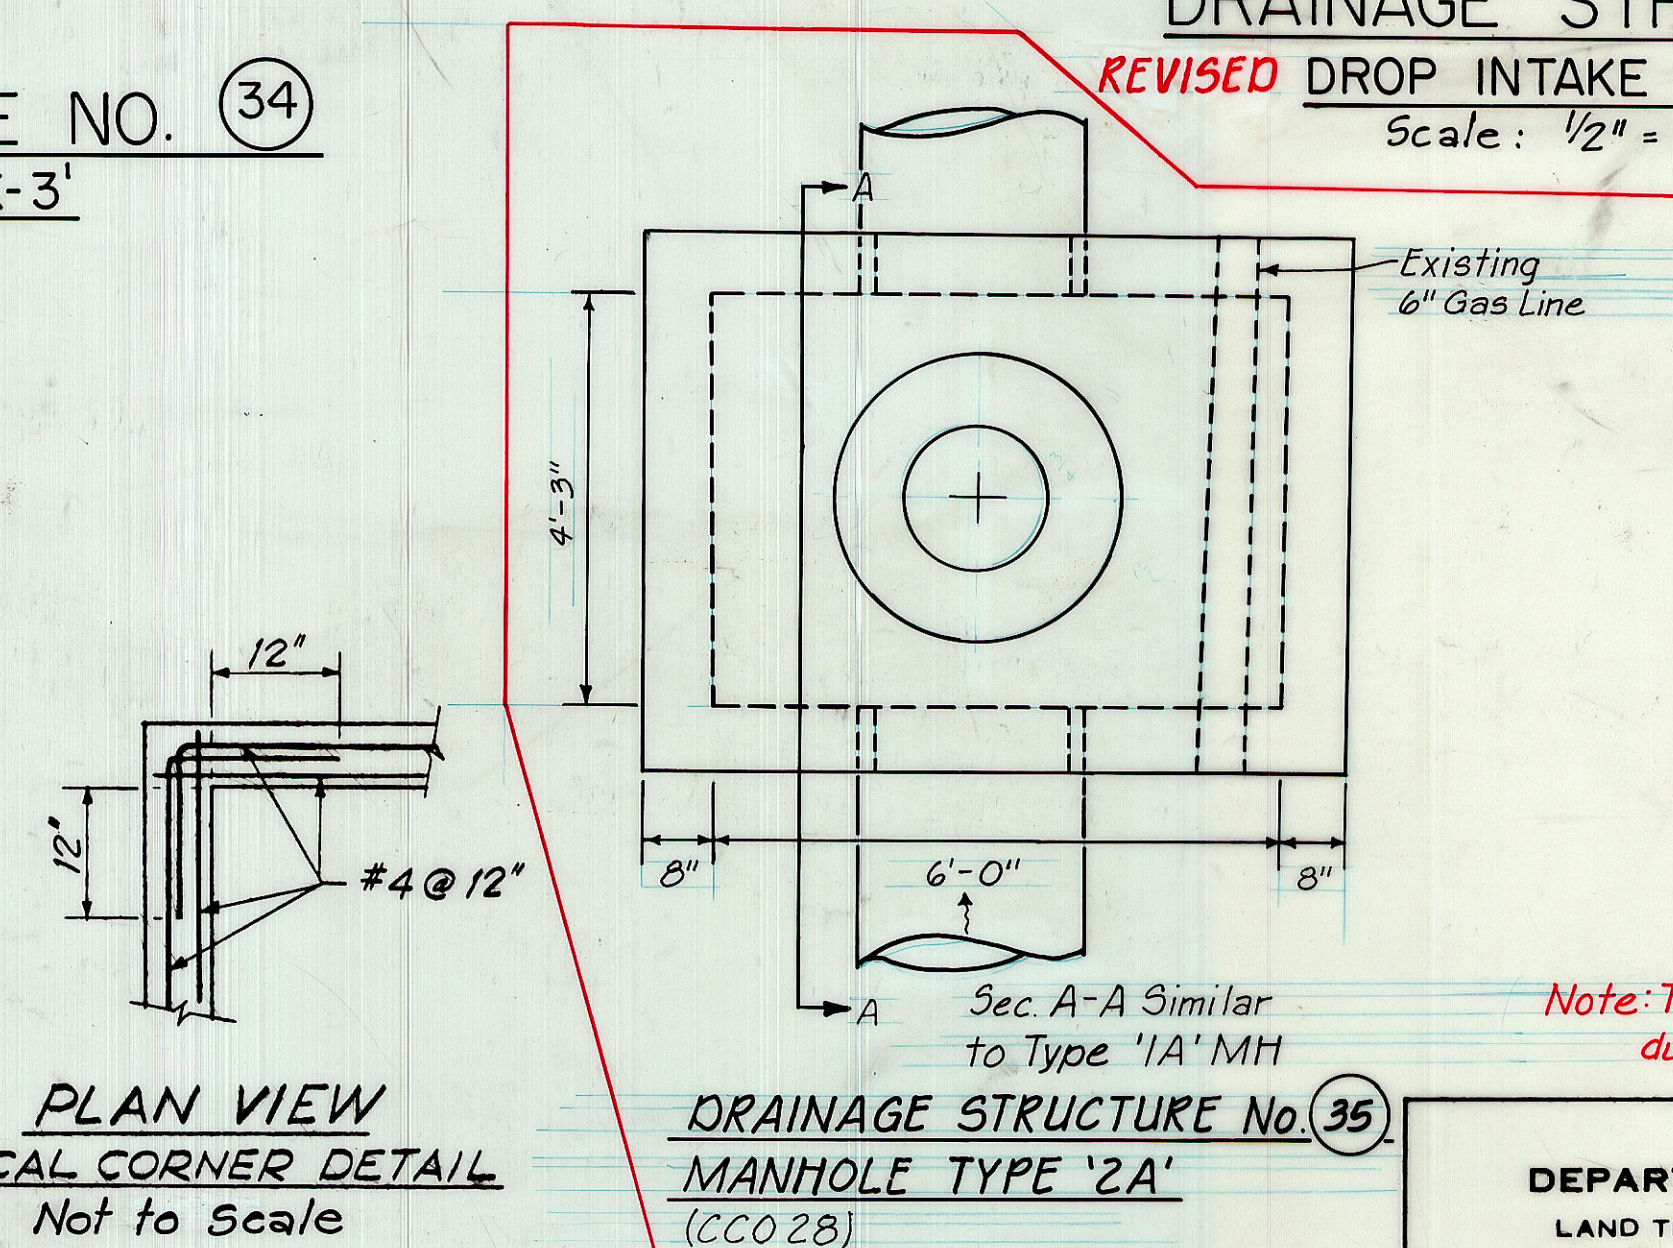

Note: This detail prepared during "As-Built" posting.

DRAINAGE STRUCTURE No. 39
MANHOLE TYPE '2A'
(CC028)



9

THIS WORK WAS PREPARED BY ME
OR UNDER MY SUPERVISION.


STATE OF HAWAII
DEPARTMENT OF TRANSPORTATION
LAND TRANSPORTATION FACILITIES DIVISION

DRAINAGE DETAILS


INTERSTATE ROUTE H-1
PROJECT NO. I-IR-HI-1(169).17

SCALE: AS SHOWN DATE: 3/15/82
SHEET No. D-13 OF D-25 SHEETS


FED. ROAD DIST. NO.	STATE	FED. AID PROJ. NO.	FISCAL YEAR	SHEET NO.	TOTAL SHEETS
HAWAII	HAW.	1R-HI-1(169):17	1983	59	280

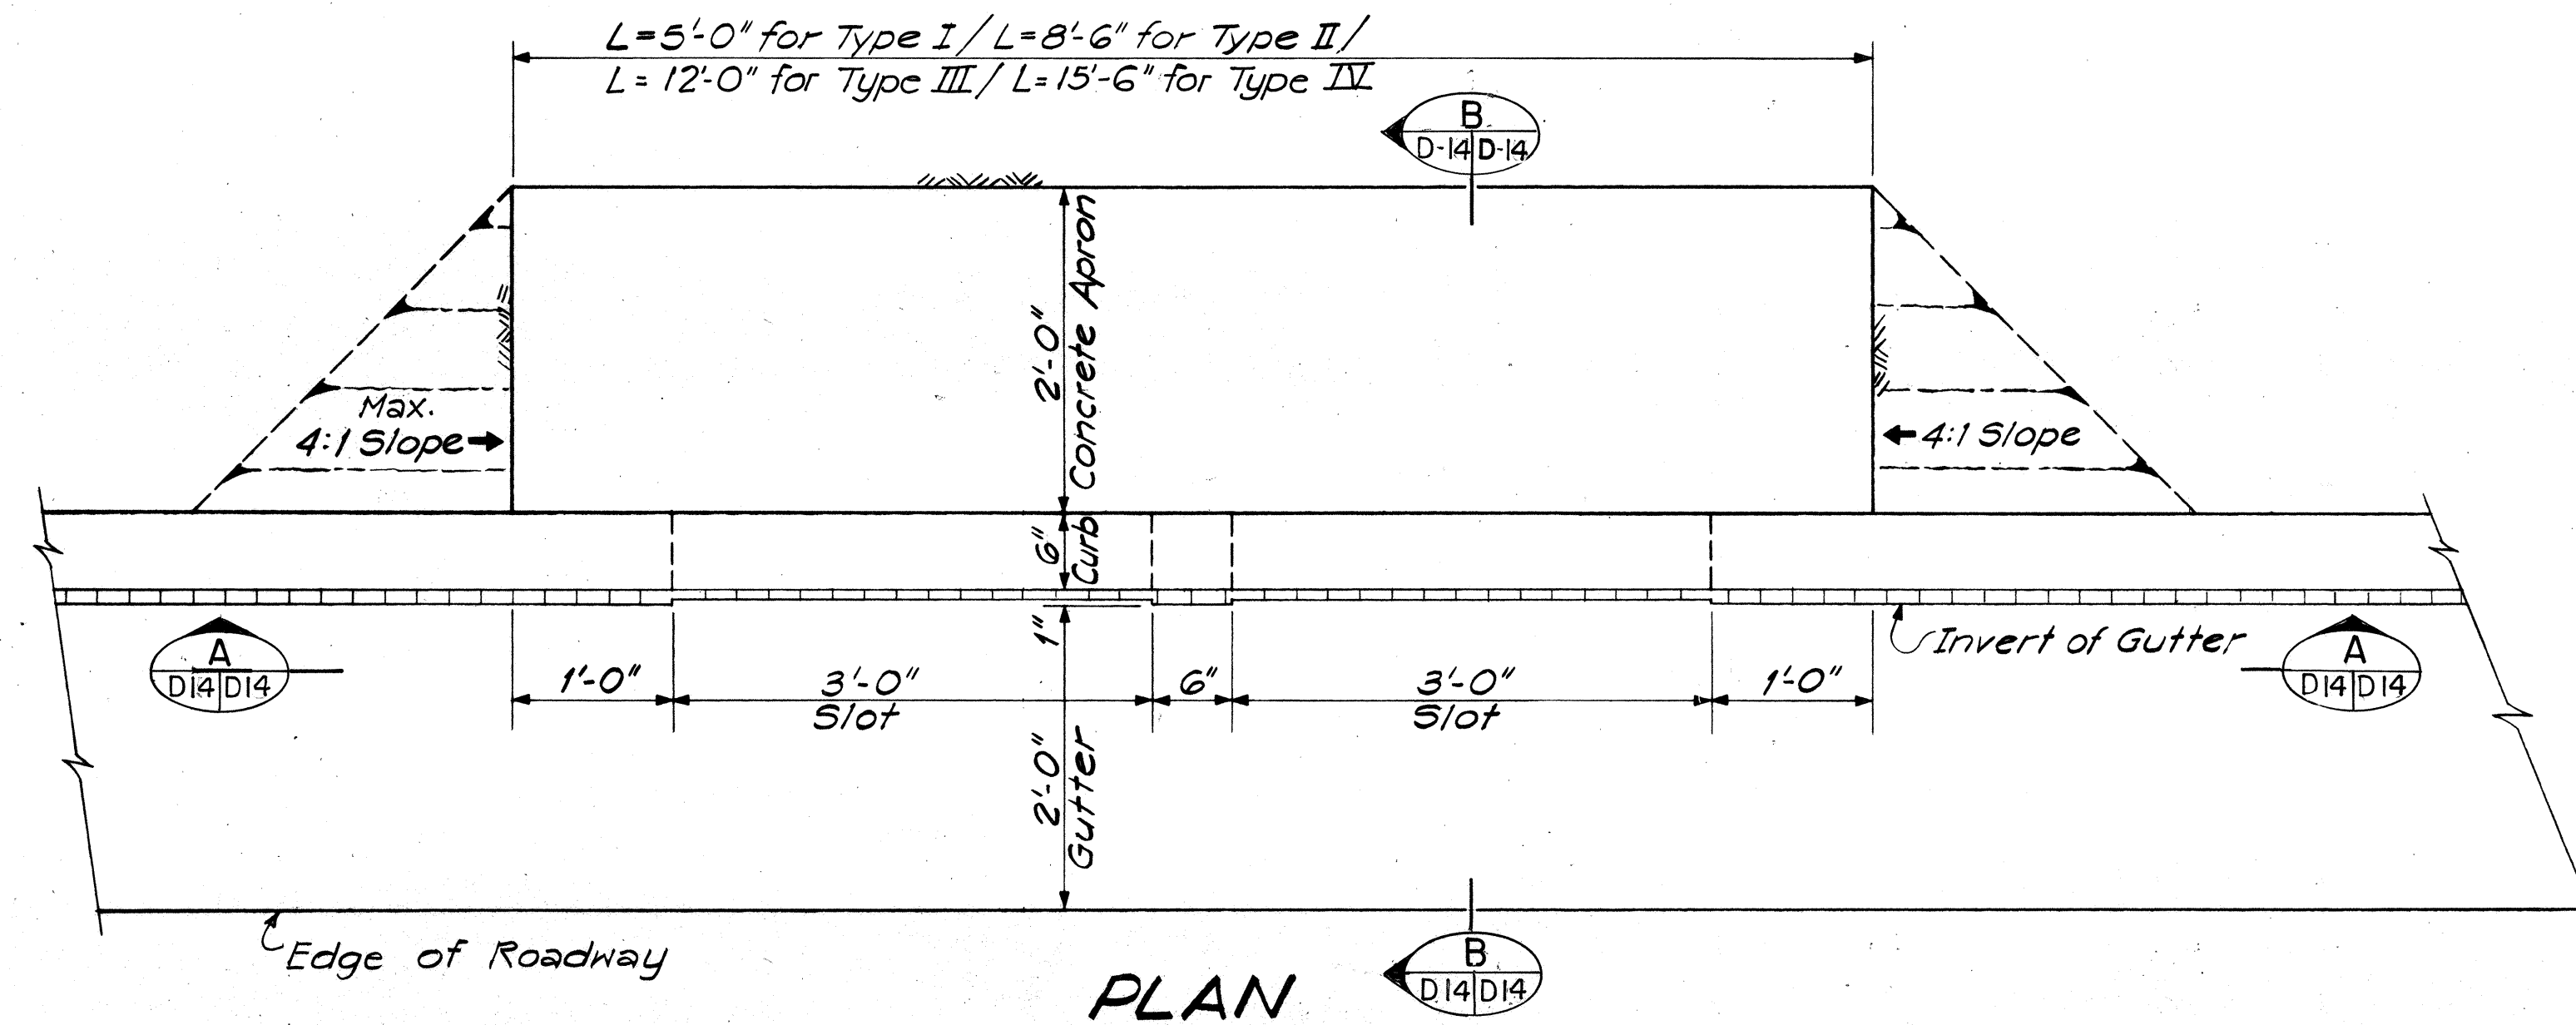

PLAN

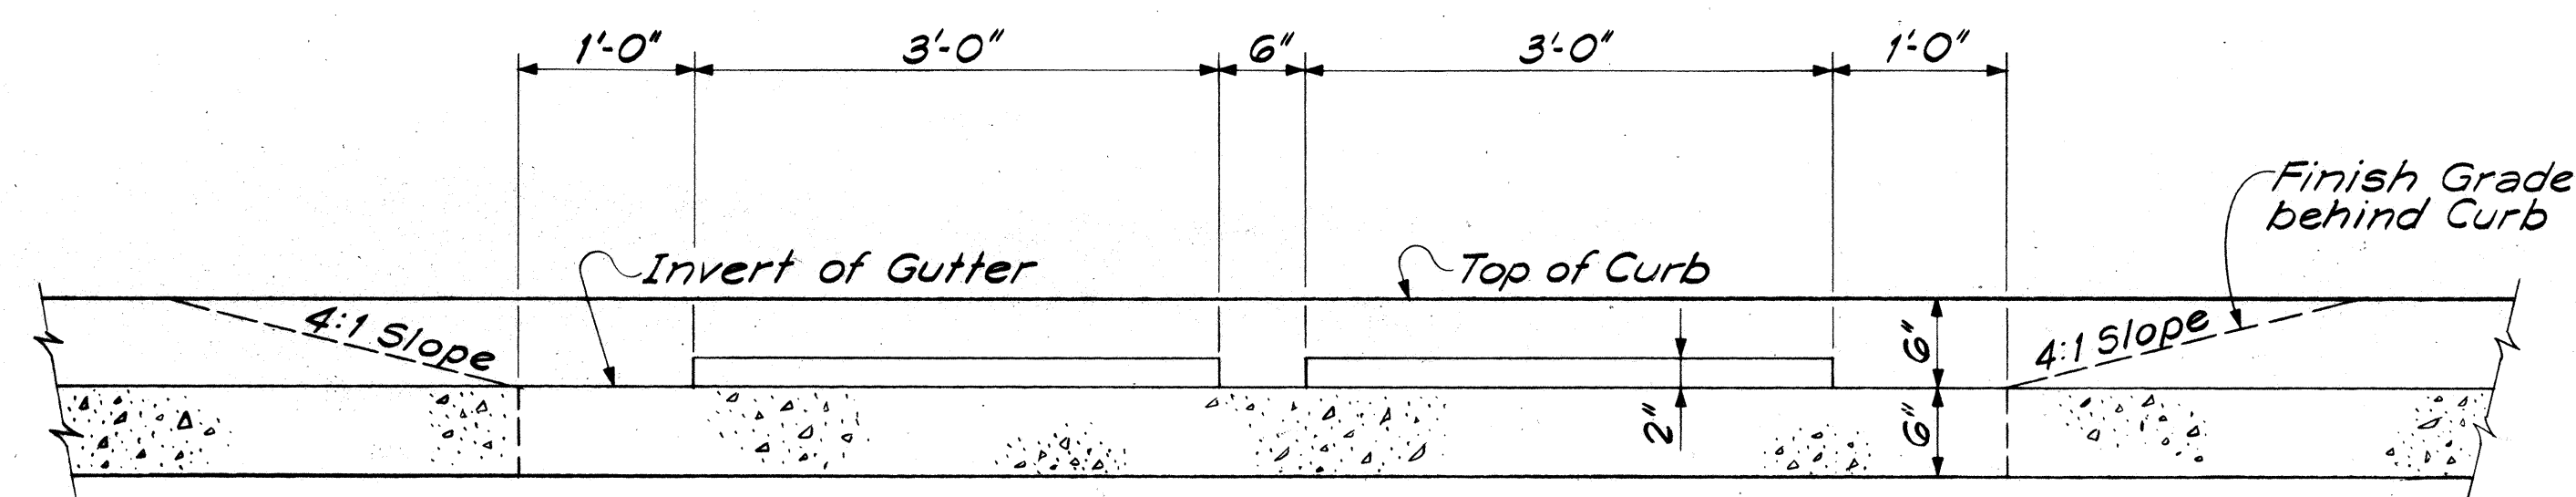

SECTION

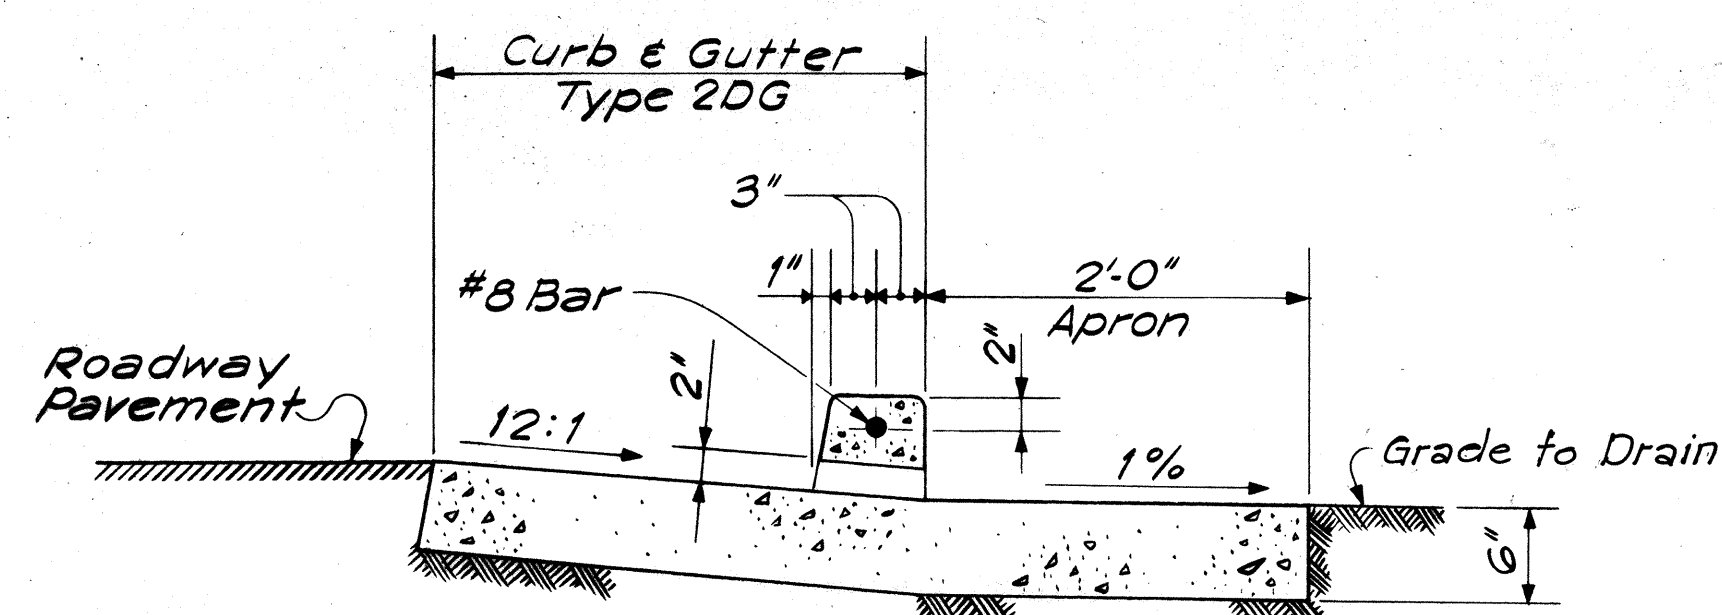


SECTION

CURB SLOT
SCALE: 1"=1'-0"

NOTES:


1. Curb Slot Type II (two slots) is shown. The number of slots for other types are as follows: Type I shall have one slot; Type III shall have 3 slots; and Type IV shall have 4 slots.
2. Concrete shall be Class A.
3. #8 Bar shall be continuous over all slots. Embedment at each end shall be 2'-0".
4. Payment for Curb Slot, including apron and #8 bar, will be considered incidental to "Curb & Gutter, Type 2 DG".

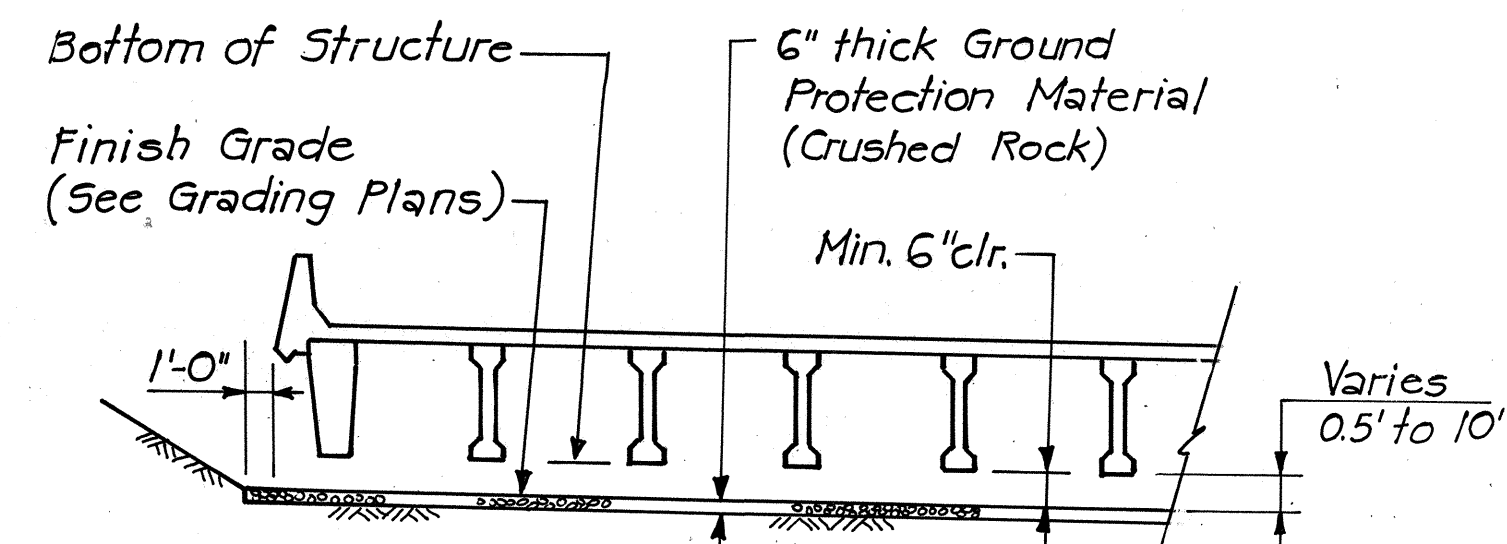


NOTE: Ground Protection Material shall be placed under all Structures with less than 10 feet vertical clearance from finish grade to bottom of Structure.

UNDER BRIDGE STRUCTURES
(Half Section Shown)


GROUND PROTECTION MATERIAL DETAILS
Not to Scale

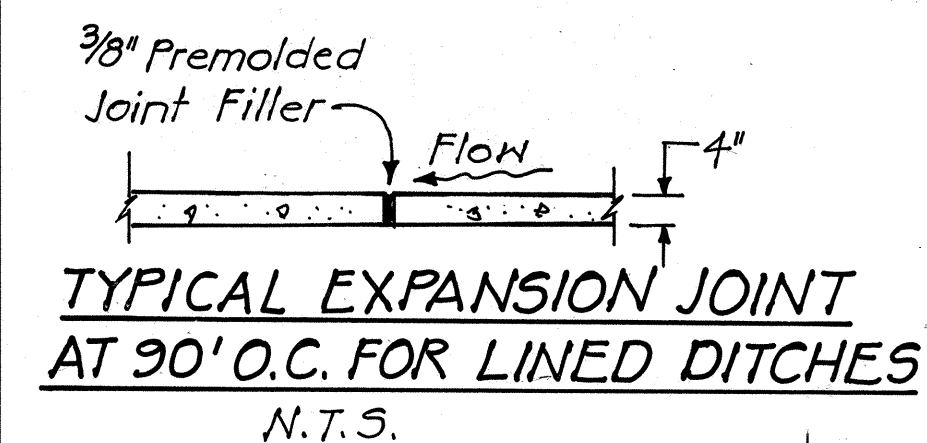

TYPICAL EXPANSION JOINT
AT 90' O.C. FOR LINED DITCHES
N.T.S.

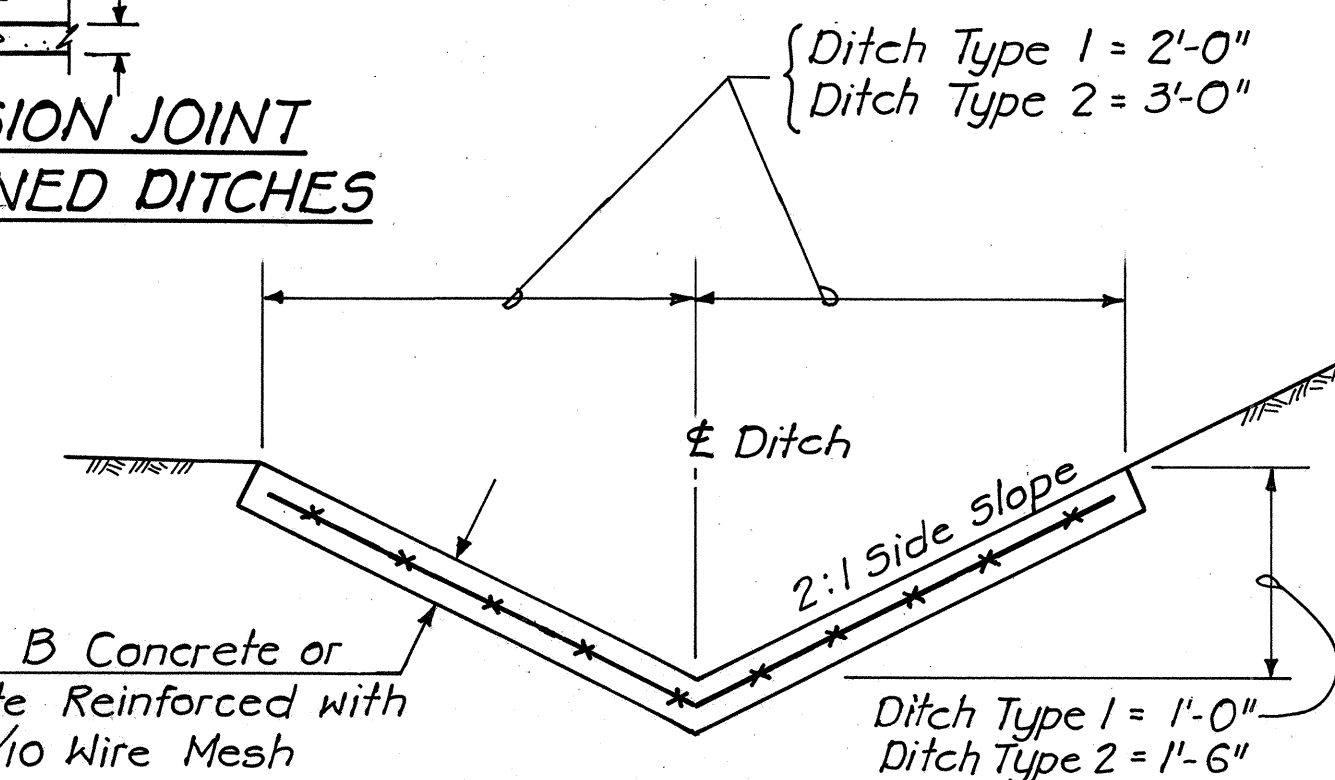


LINED DITCH TYPE 1 & 2
Not to Scale

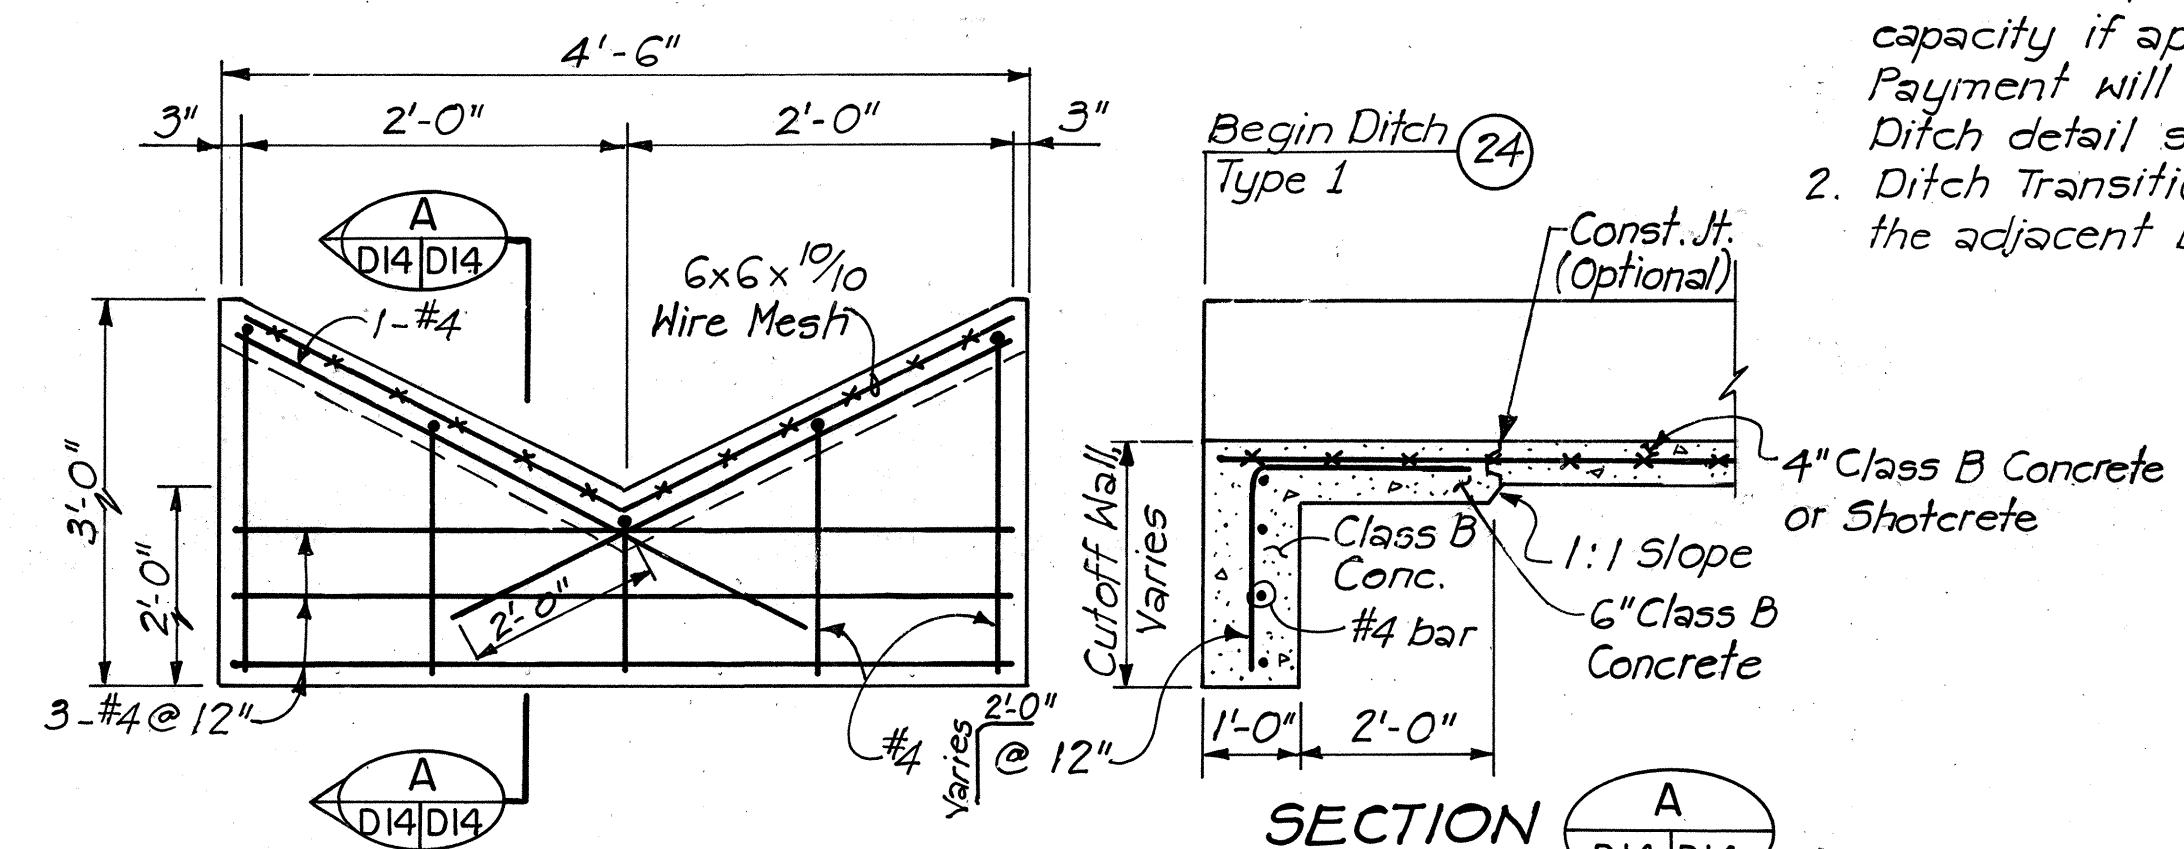


CUTOFF WALL FOR DITCH TYPE 1
(AT MAKAI FR. RD. STA. 246+75, 18.5' RT.)
Not to Scale


NOTE: Cutoff Wall will not be measured & paid for separately but shall be considered incidental to "Lined Drainage Ditch, Type 1".

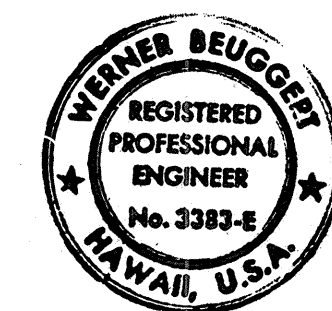

THIS WORK WAS PREPARED BY ME
OR UNDER MY SUPERVISION.

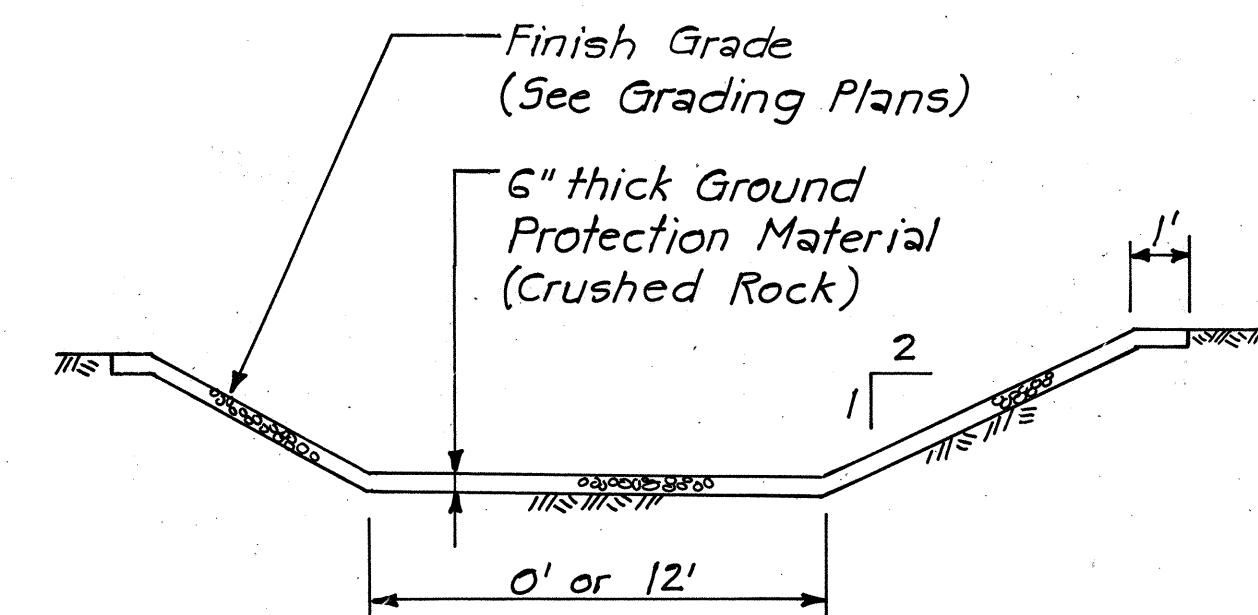

FOR 12' TRAP DITCH
OR VEE DITCH LINING
(As shown on Plans)

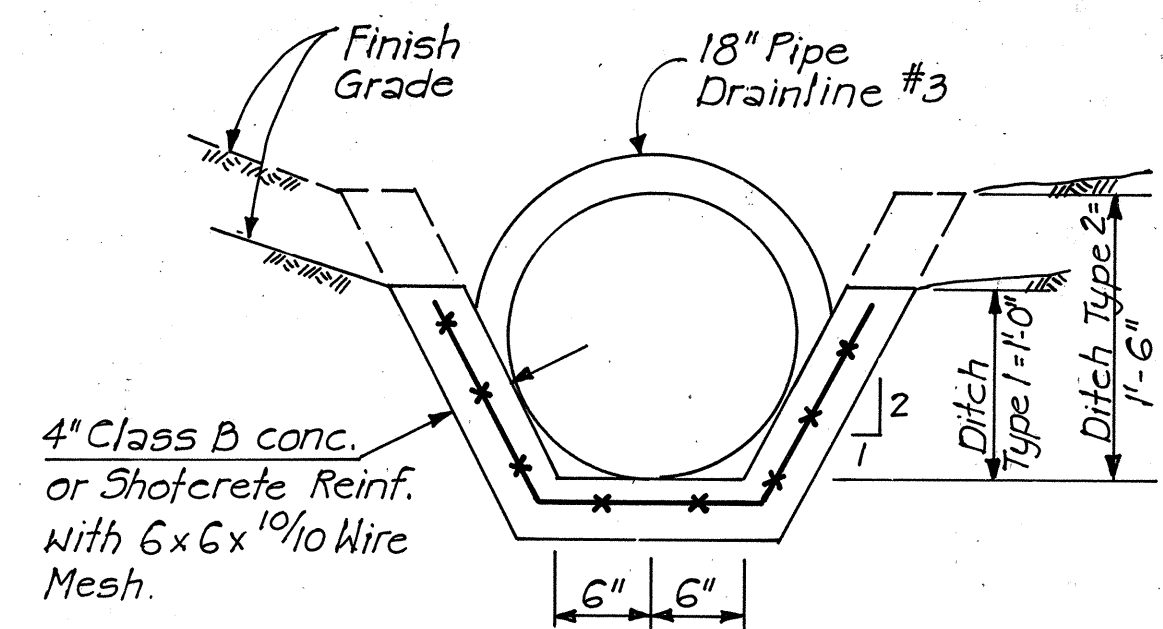

LINED DITCH AT HEADWALL
Not to Scale

NOTES


1. Contractor may substitute Lined Ditches of other shapes with equal or greater capacity, if approved by the Engineer. Payment will be in accordance with Ditch detail shown on the Plans.
2. Ditch Transitions shall be paid for under the adjacent Ditch Type.

STATE OF HAWAII
DEPARTMENT OF TRANSPORTATION
HIGHWAYS DIVISION

DRAINAGE DETAILS

INTERSTATE ROUTE H-1
PROJECT NO. 1-IR-HI-1(169):17
SCALE: As shown DATE: 3/15/83
SHEET NO. D-14 OF D-25 SHEETS


FED. ROAD DIST. NO.	STATE	FED. AID PROJ. NO.	FISCAL YEAR	SHEET NO.	TOTAL SHEETS
HAWAII	HAW.	IR-HI-1169	1983	60	280

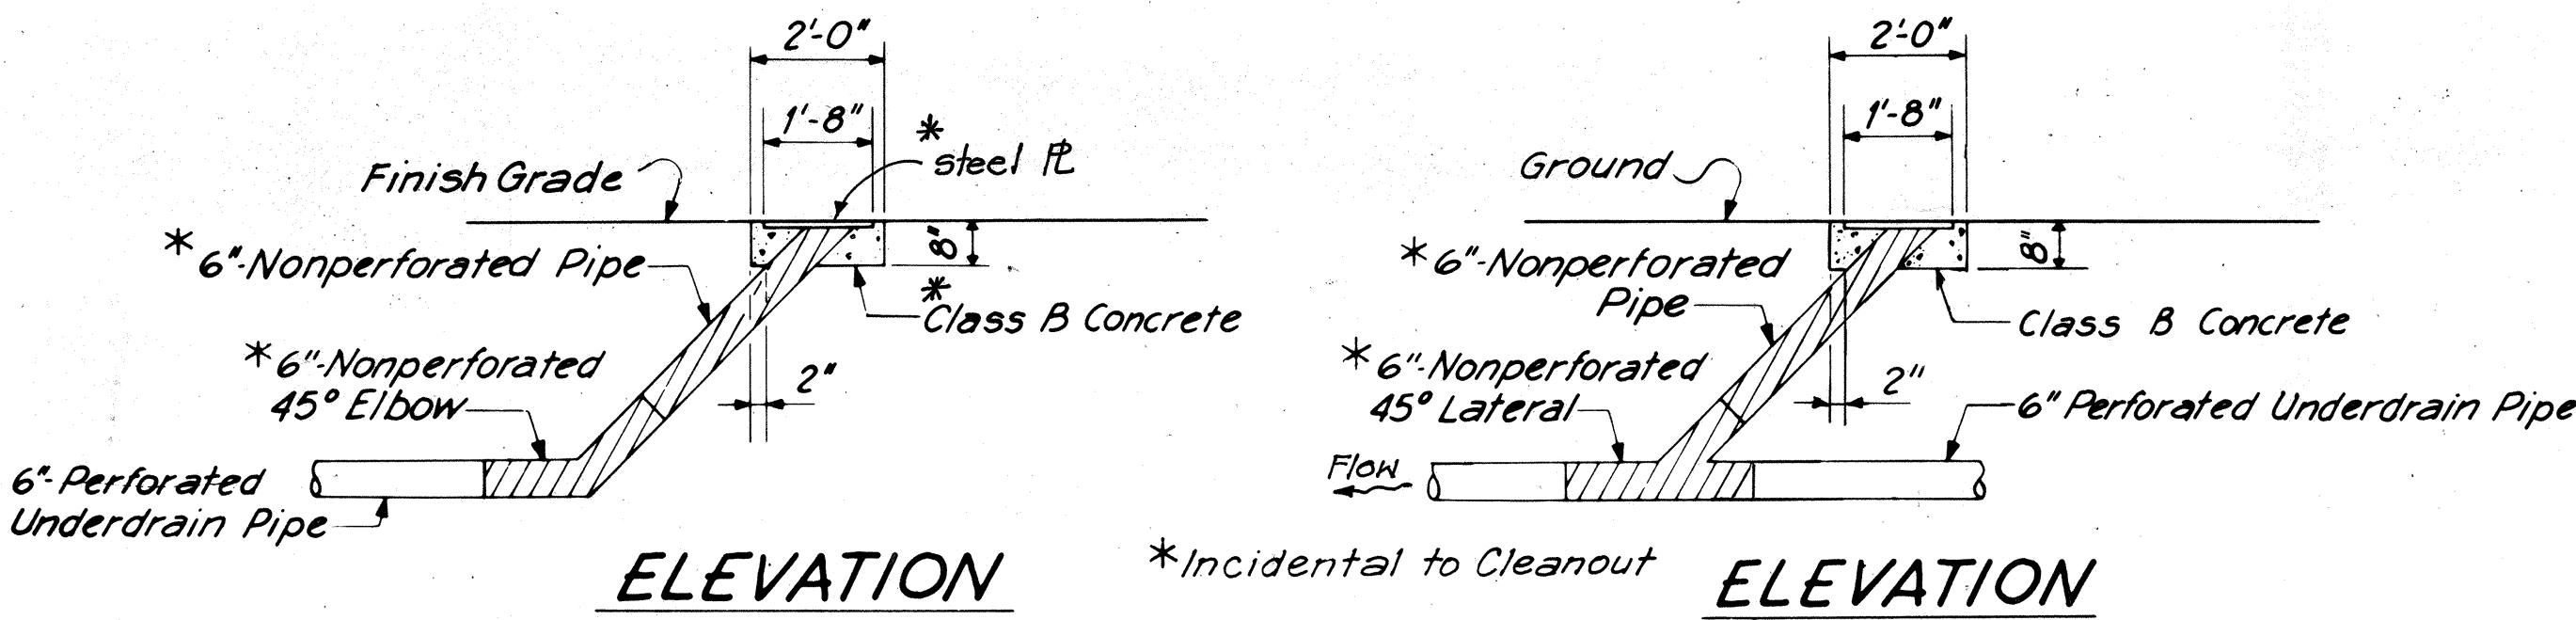

ELEVATION

ELEVATION


NOTE: Steel plate cover shall be fastened to the concrete with two 1/4" Flat Head Galvanized Machine Screws in diagonally opposite corners of the plate. Holes in plate are to be countersunk and the anchors in the concrete may be insert-type or metal drilled-in type.

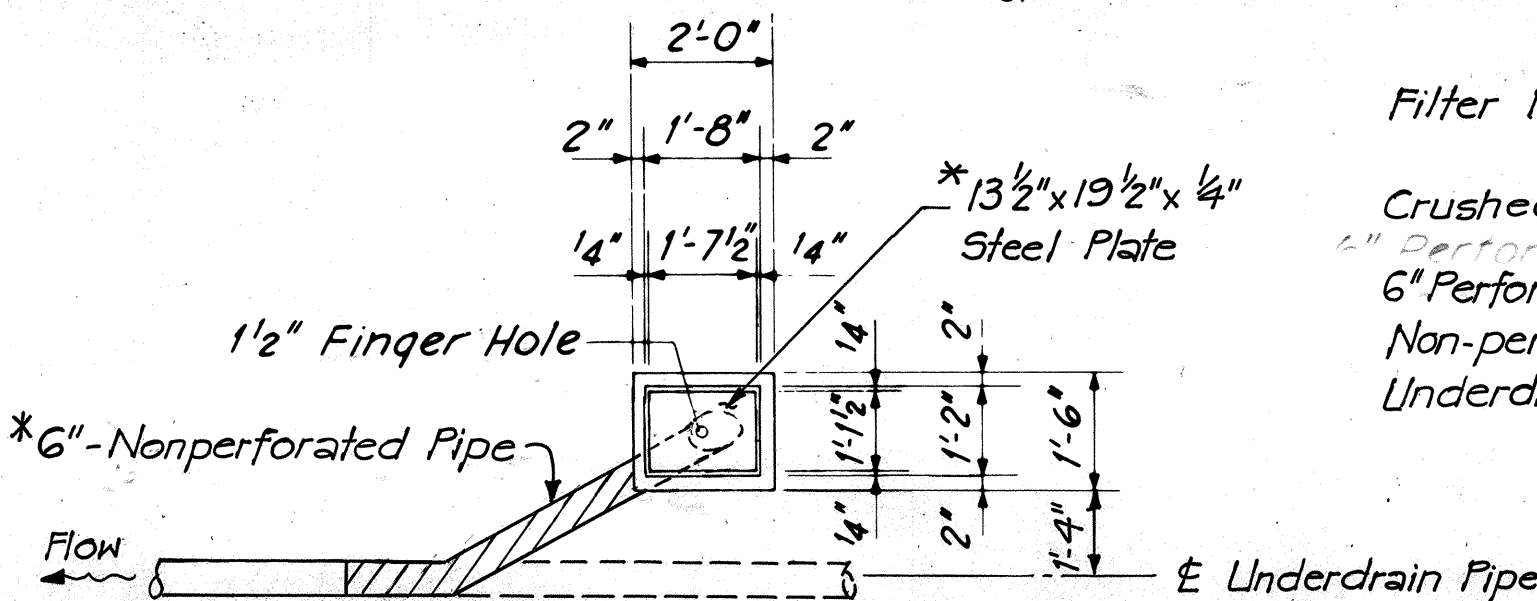

PLAN

UNDERDRAIN CLEANOUT DETAILS


Scale: 3/8" = 1'-0"

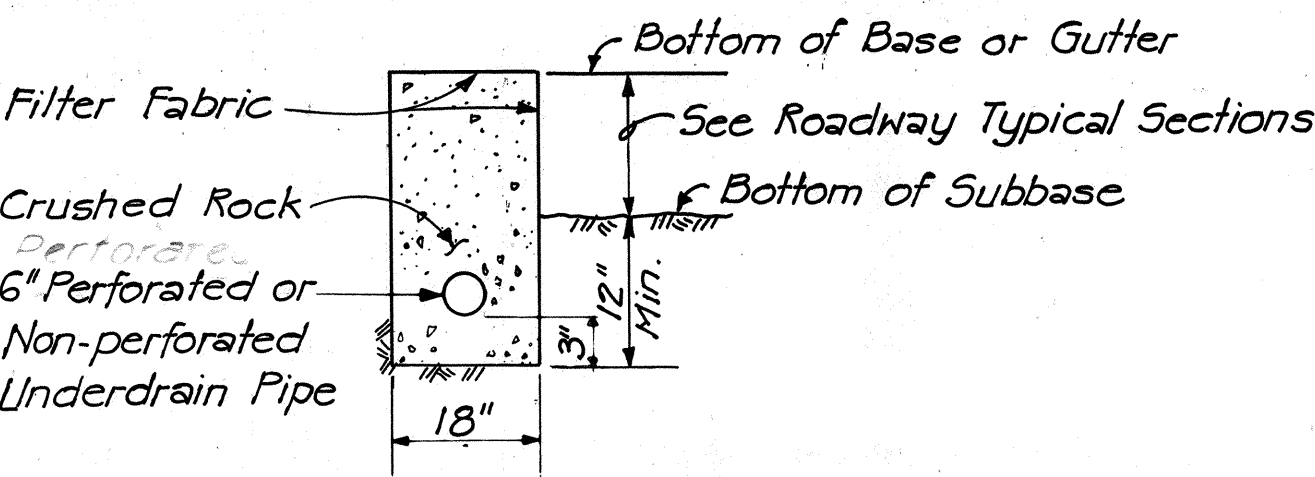

TYPICAL

UNDERDRAIN SECTION

Scale: 1/2" = 1'-0"

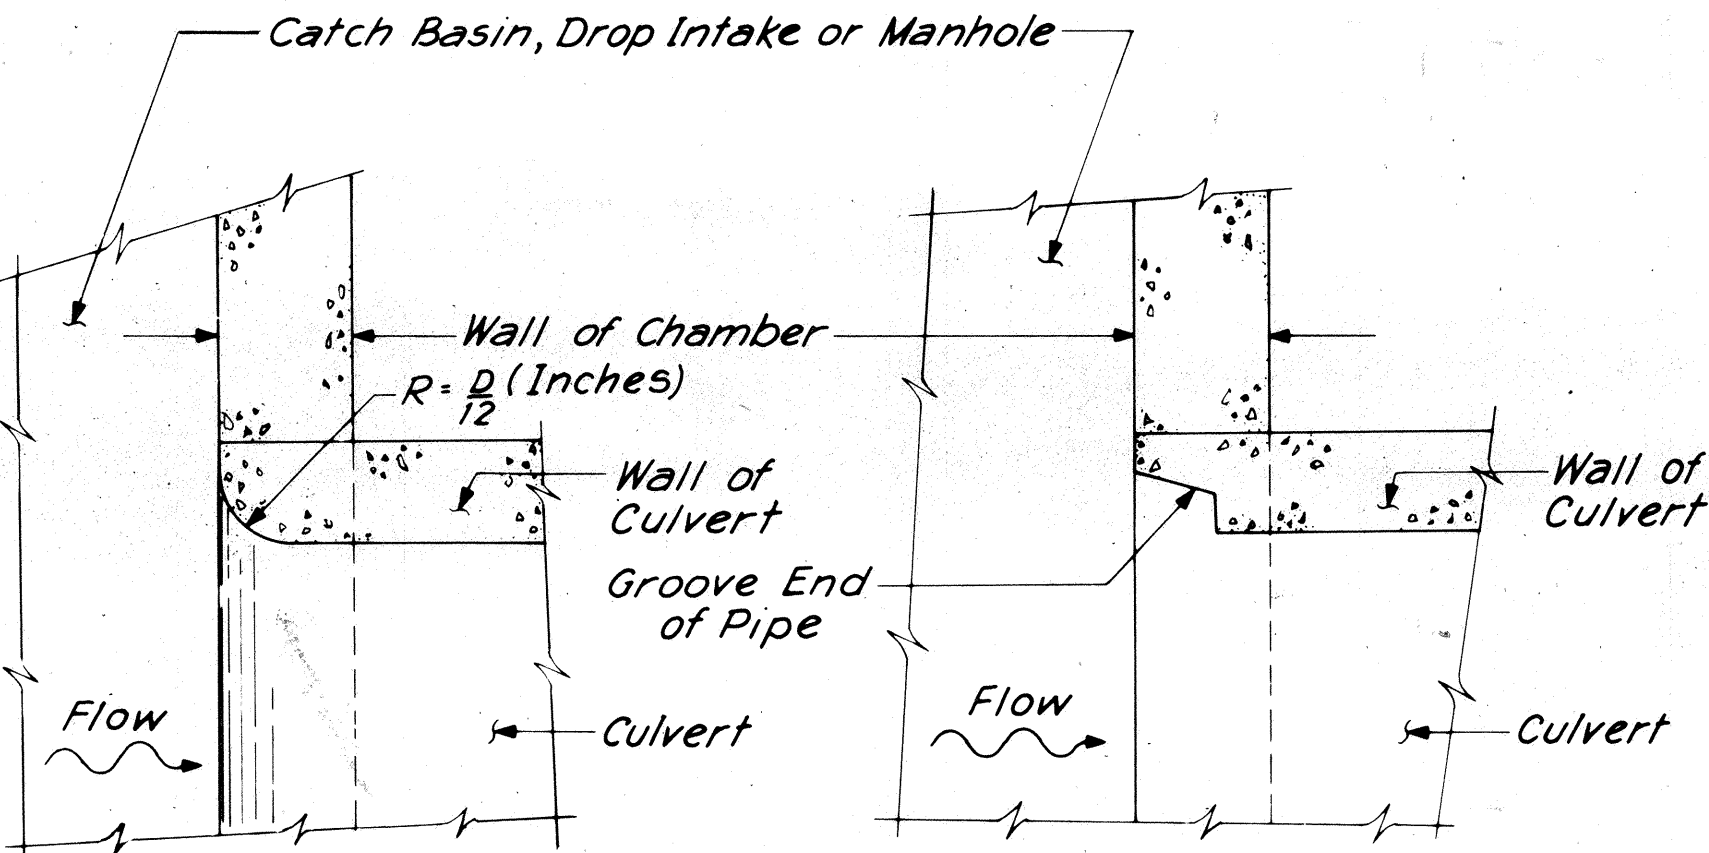


ROUNDED LIP

GROOVE END

PIPE CULVERT ENTRANCE DETAILS


Not to Scale

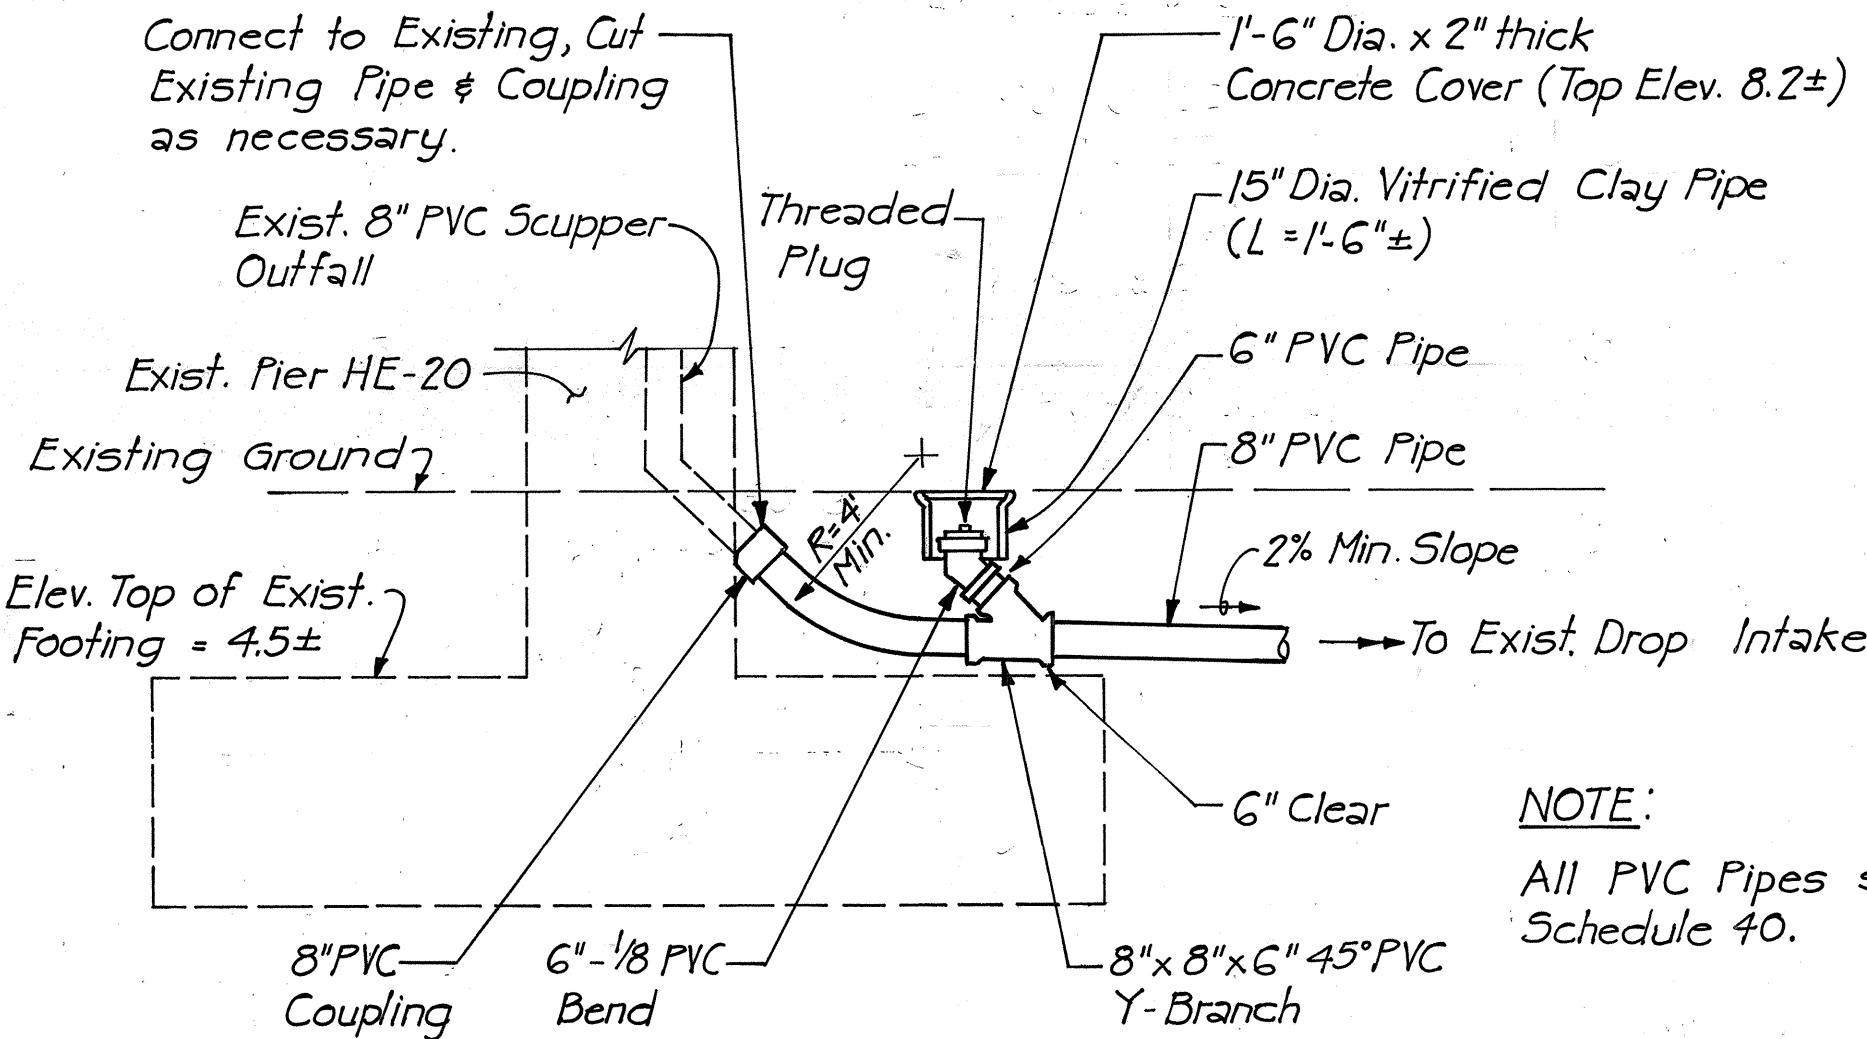

PIER HE-20 SCUPPER OUTFALL DETAIL

N.T.S.

NOTE:
All PVC Pipes shall be Type I, Schedule 40.

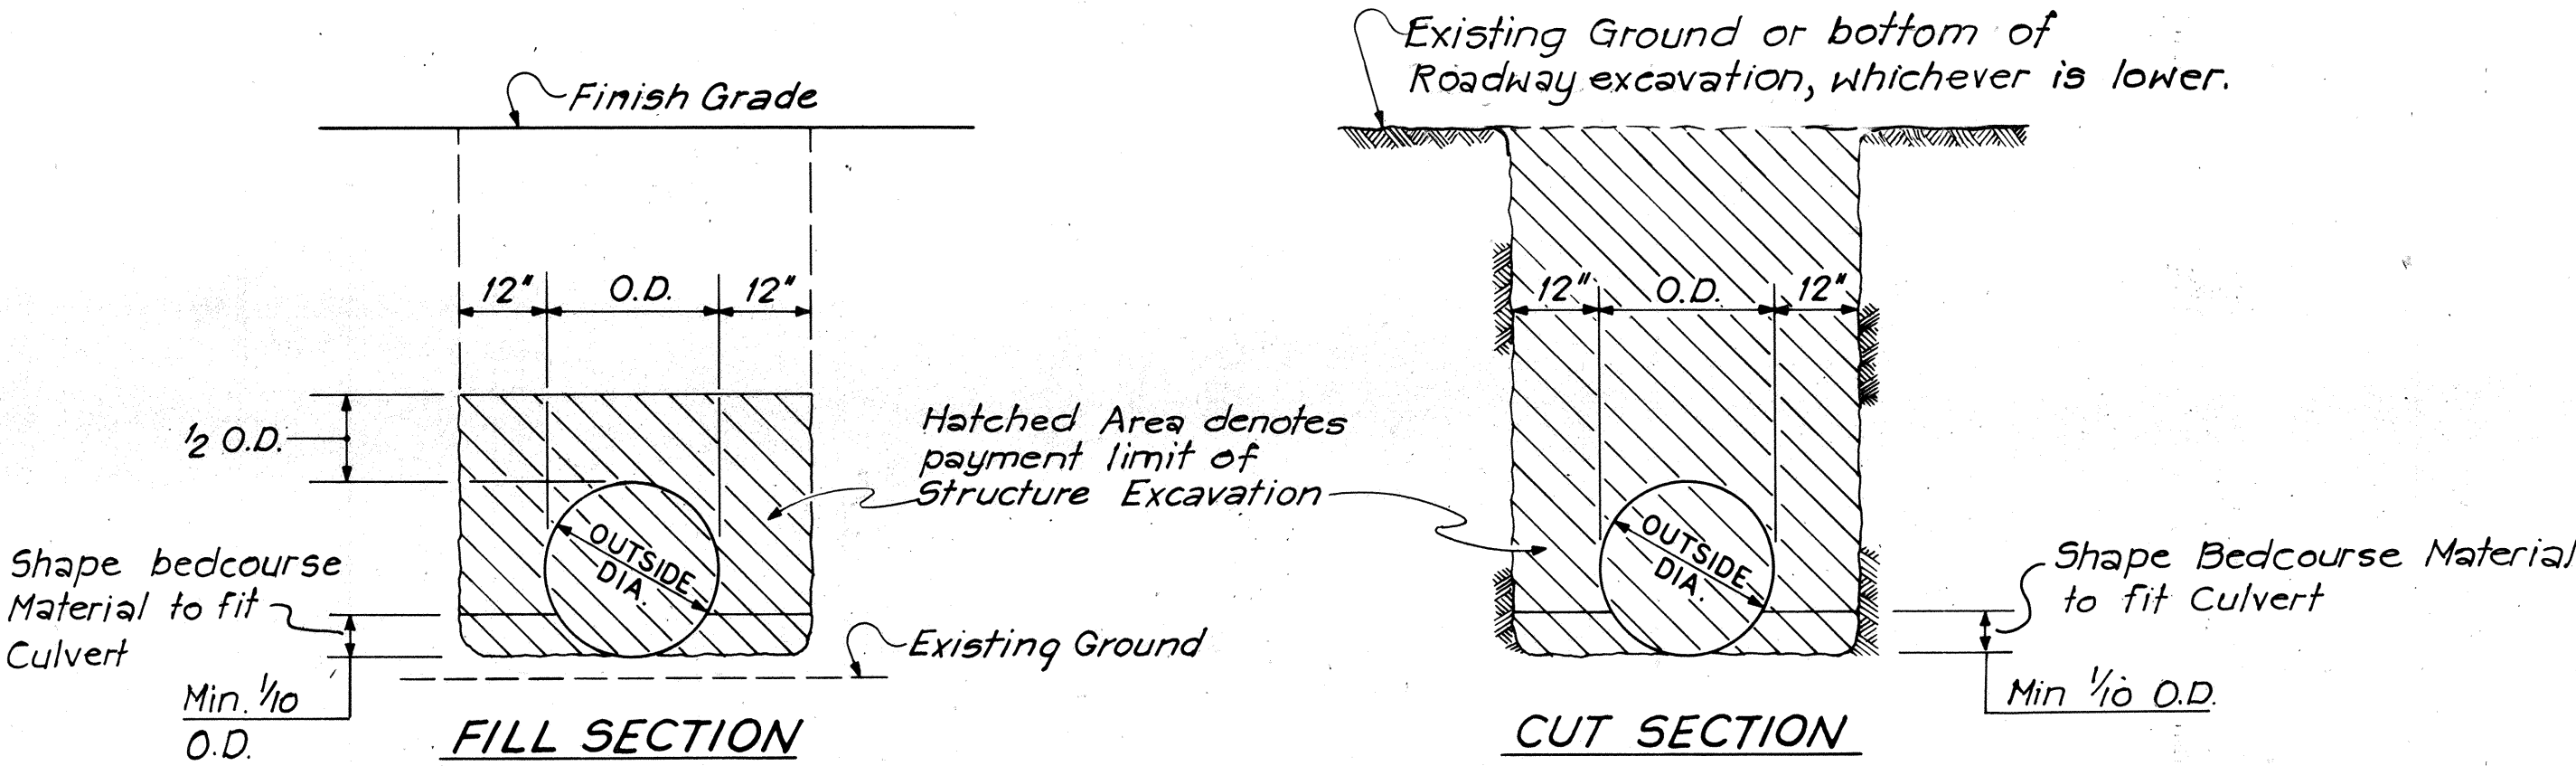


FILL SECTION

CUT SECTION

TRENCH EXCAVATION PAY LIMIT

Not to Scale
(Detail applicable for Drainage Pipes)

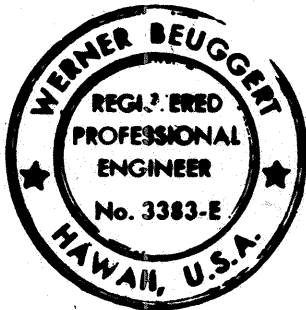


THIS WORK WAS PREPARED BY
ME OR UNDER MY SUPERVISION.
Werner Bruggen

STATE OF HAWAII
DEPARTMENT OF TRANSPORTATION
HIGHWAYS DIVISION



DRAINAGE DETAILS

INTERSTATE ROUTE H-1
PROJECT NO. I-IR-HI-1169
SCALE: AS SHOWN DATE: 3/15/82
SHEET NO D-15 OF D-25 SHEETS


FED. ROAD DIST. NO.	STATE	FED. AID PROJ. NO.	FISCAL YEAR	SHEET NO.	TOTAL SHEETS
HAWAII	HAW.	IR-H-1(69)-17	1983	62	280

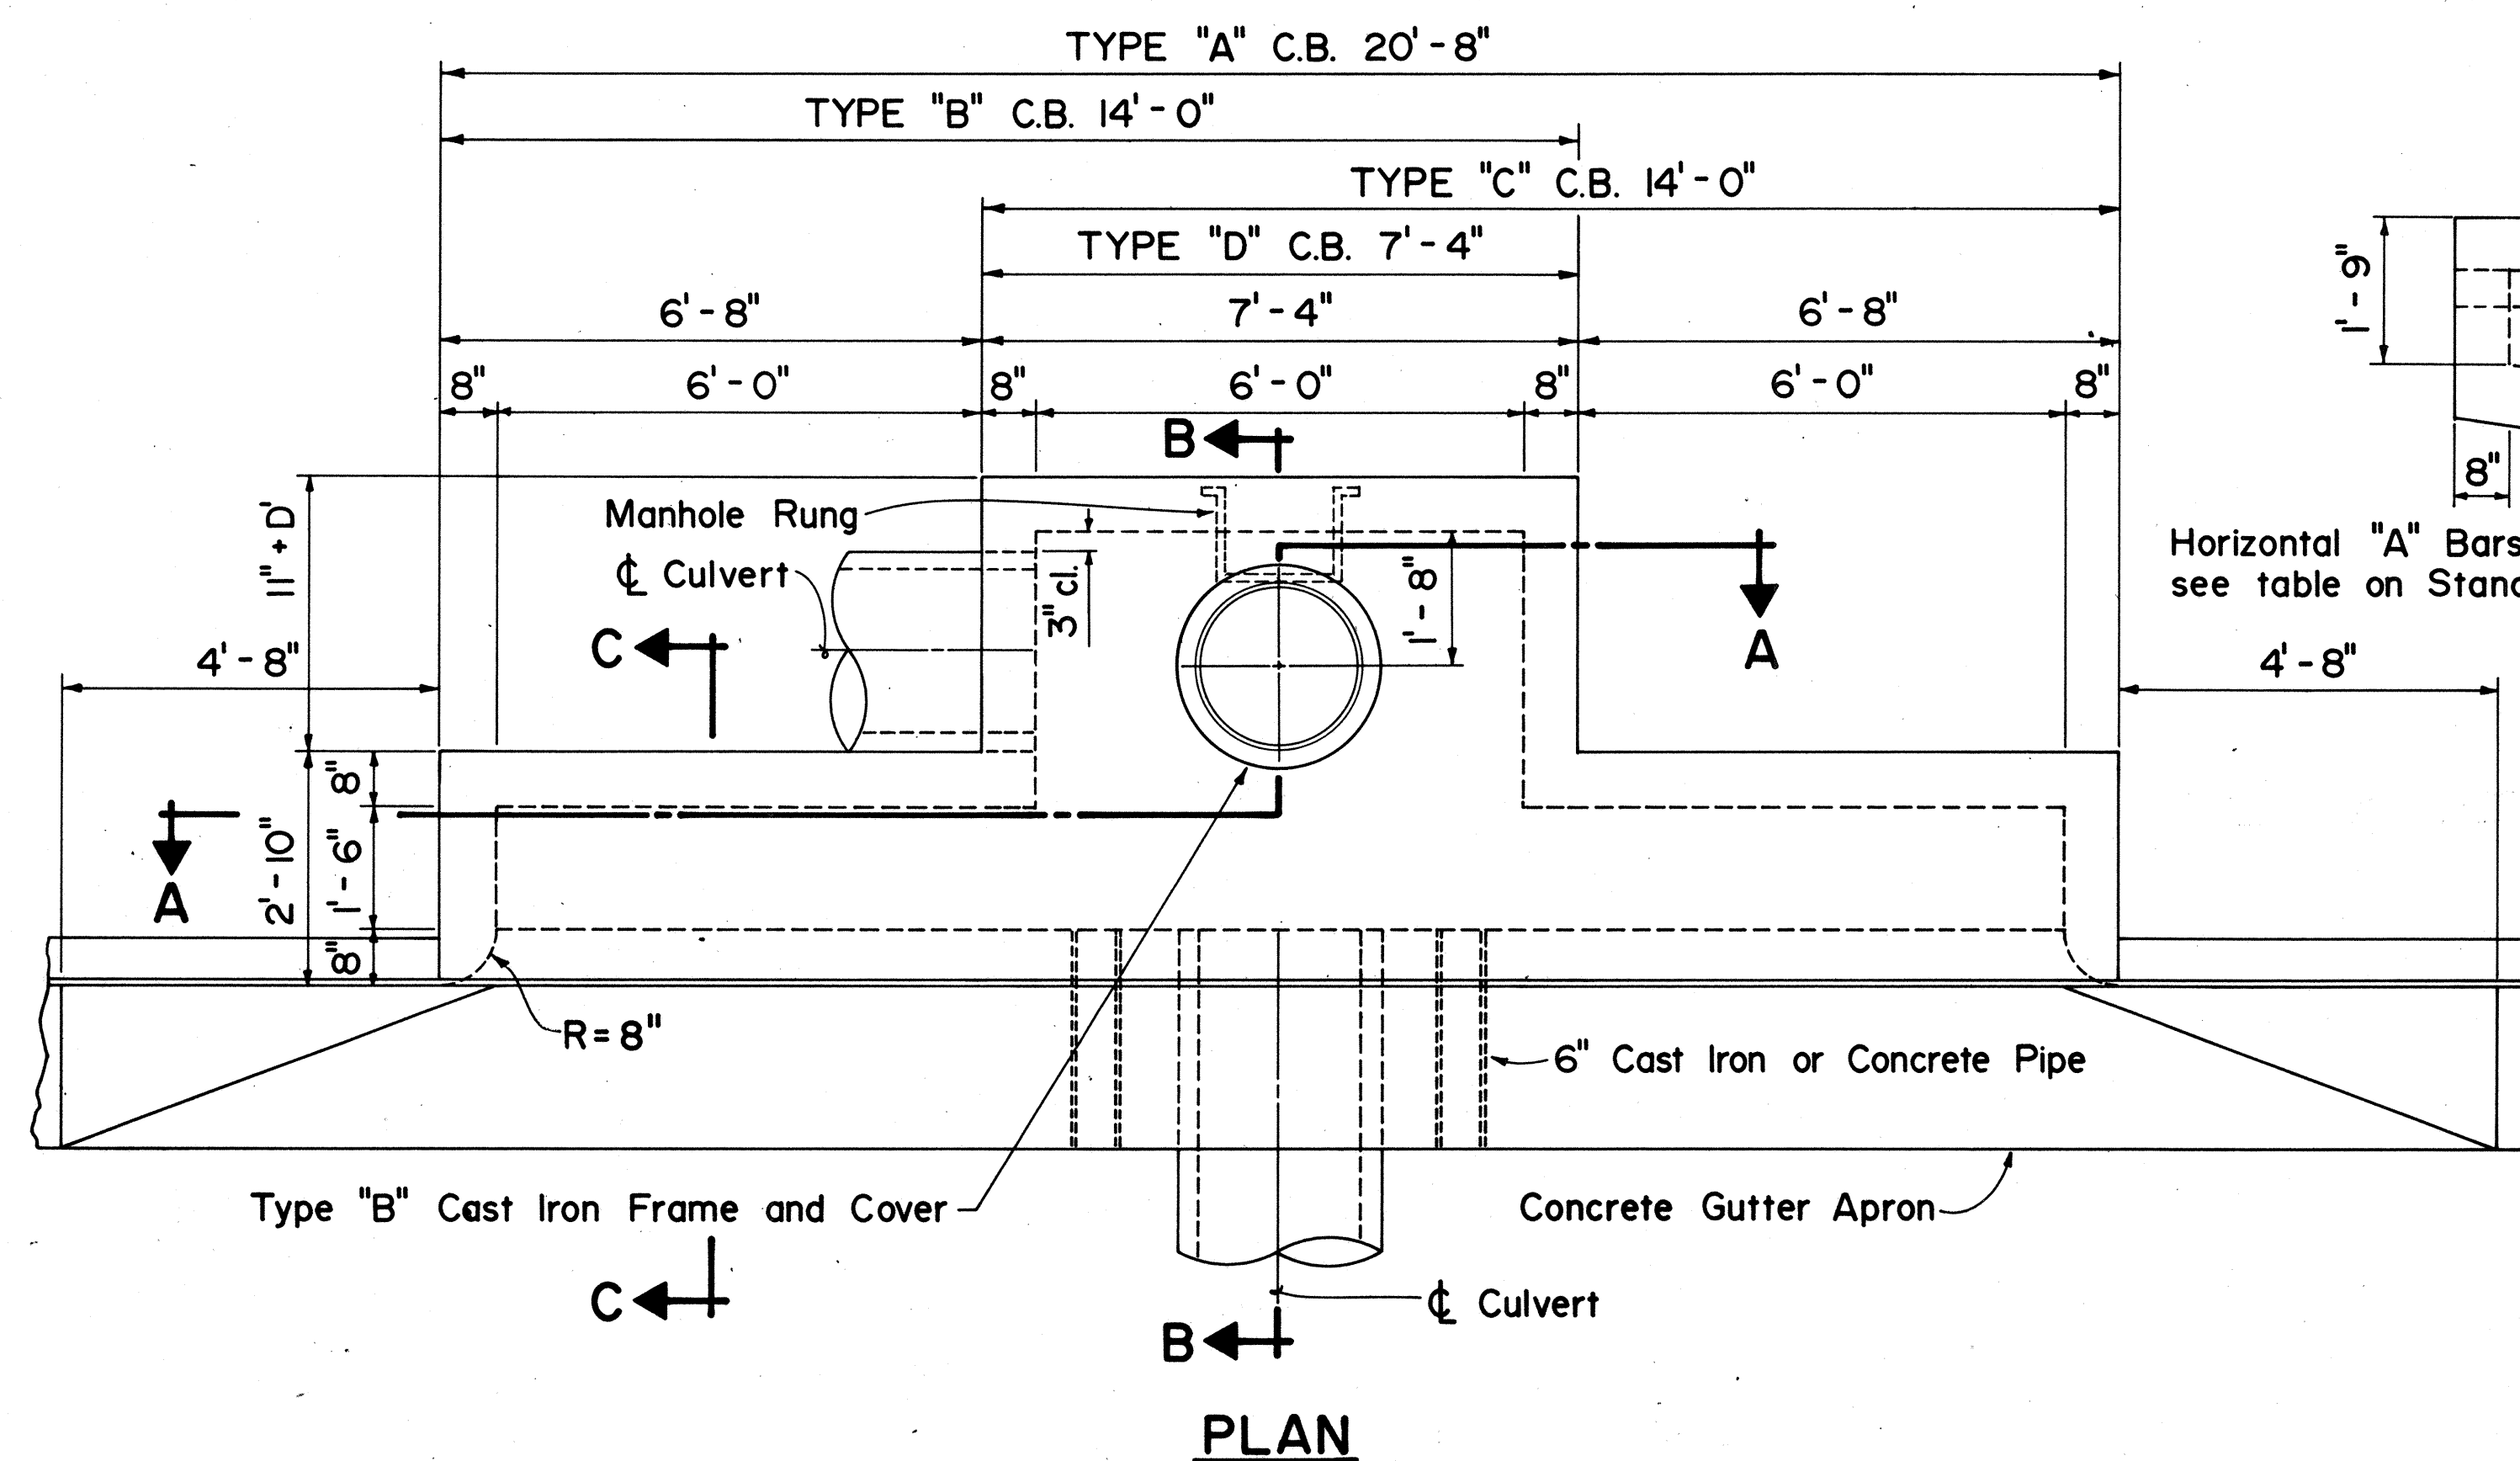


Opening for Type "B" Cast Iron Frame and Cover. For added reinforcing around hole see Standard Details sheet DH 4

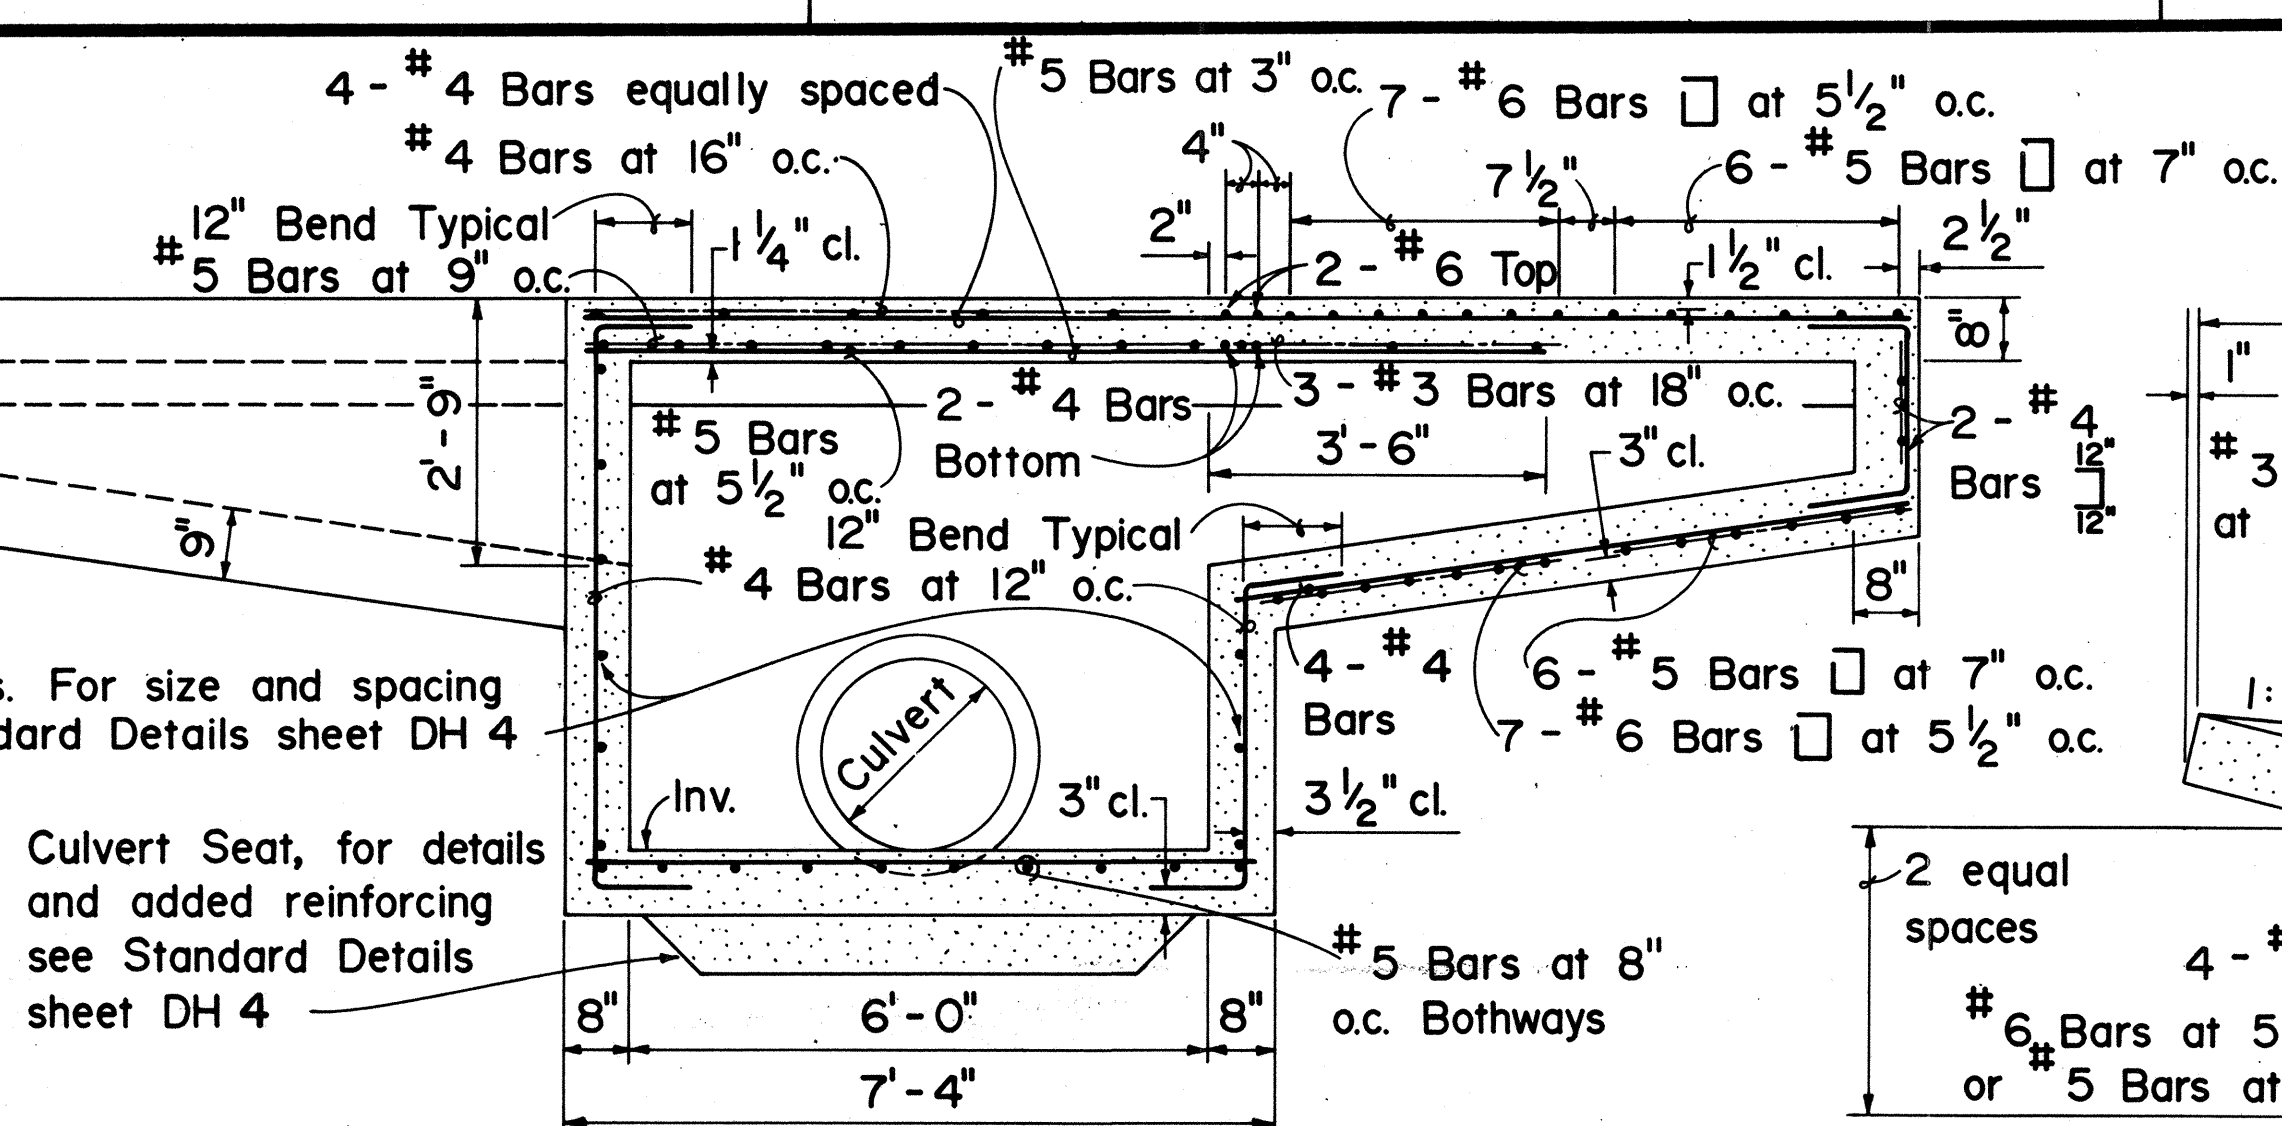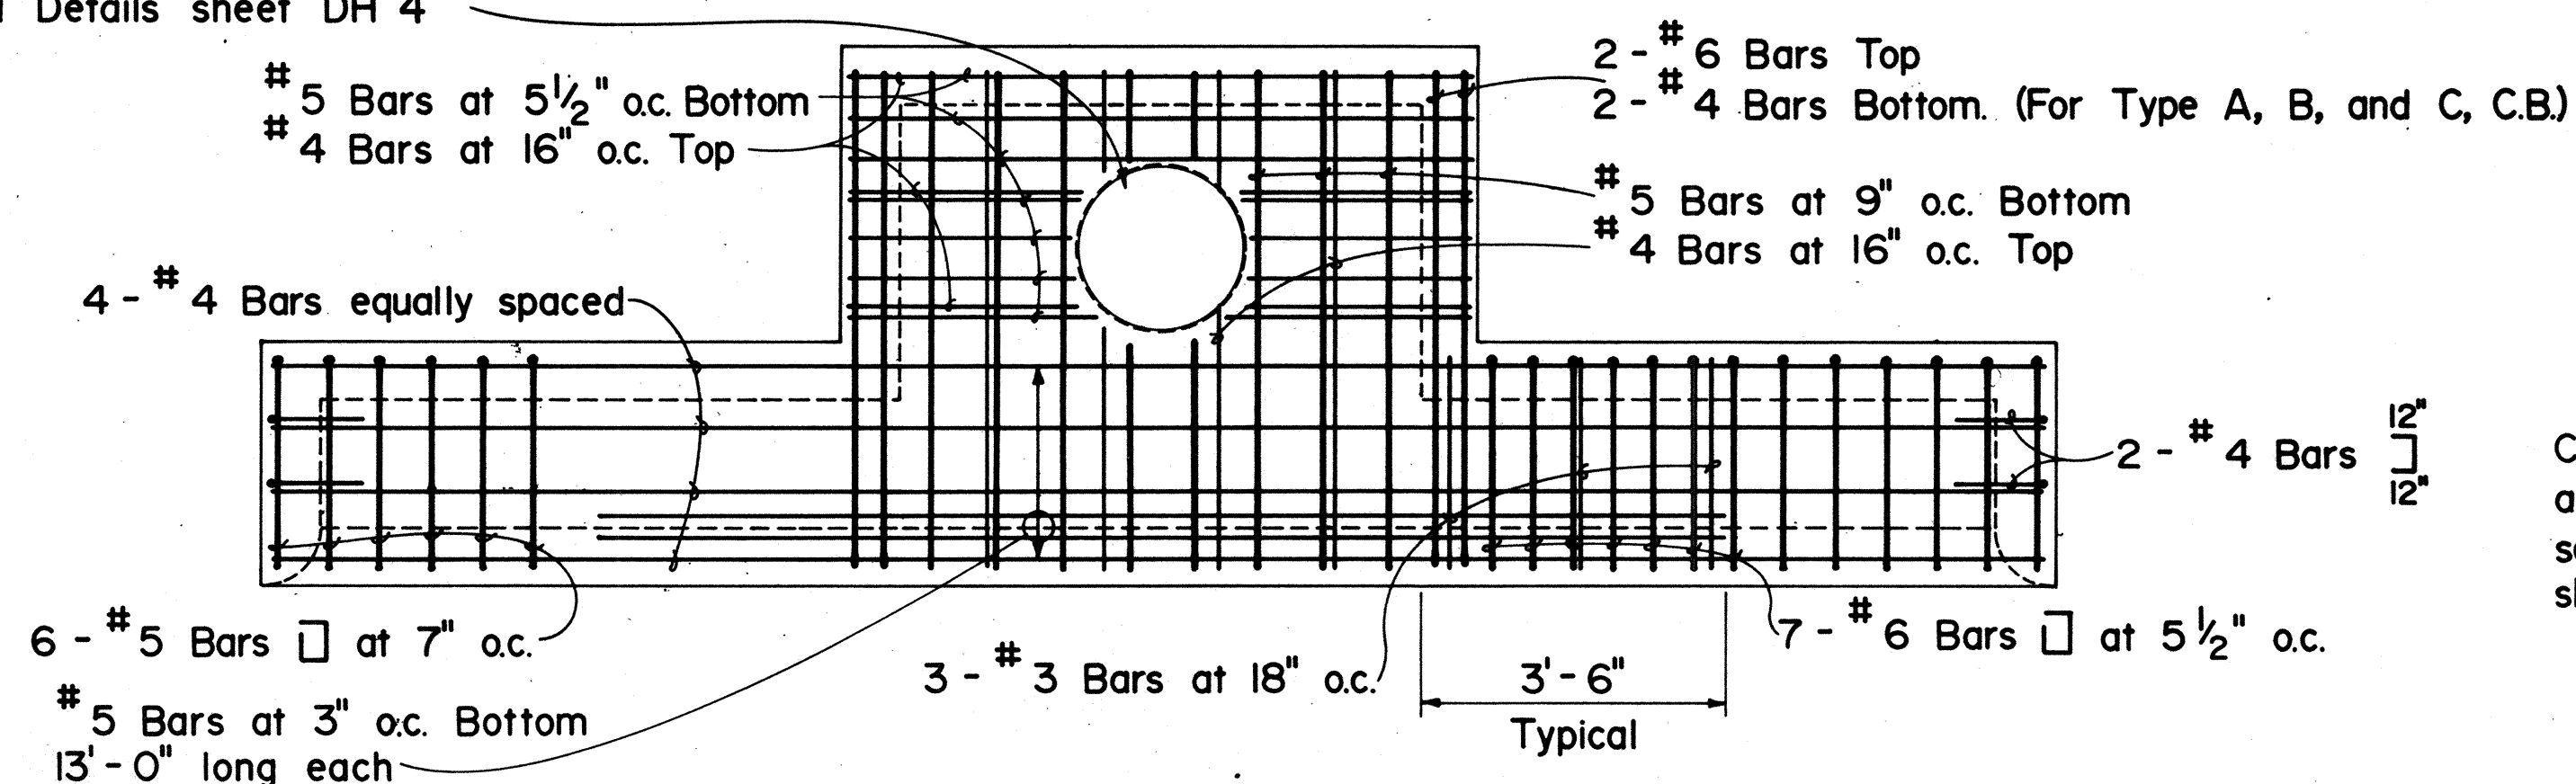


SECTION "A-A"

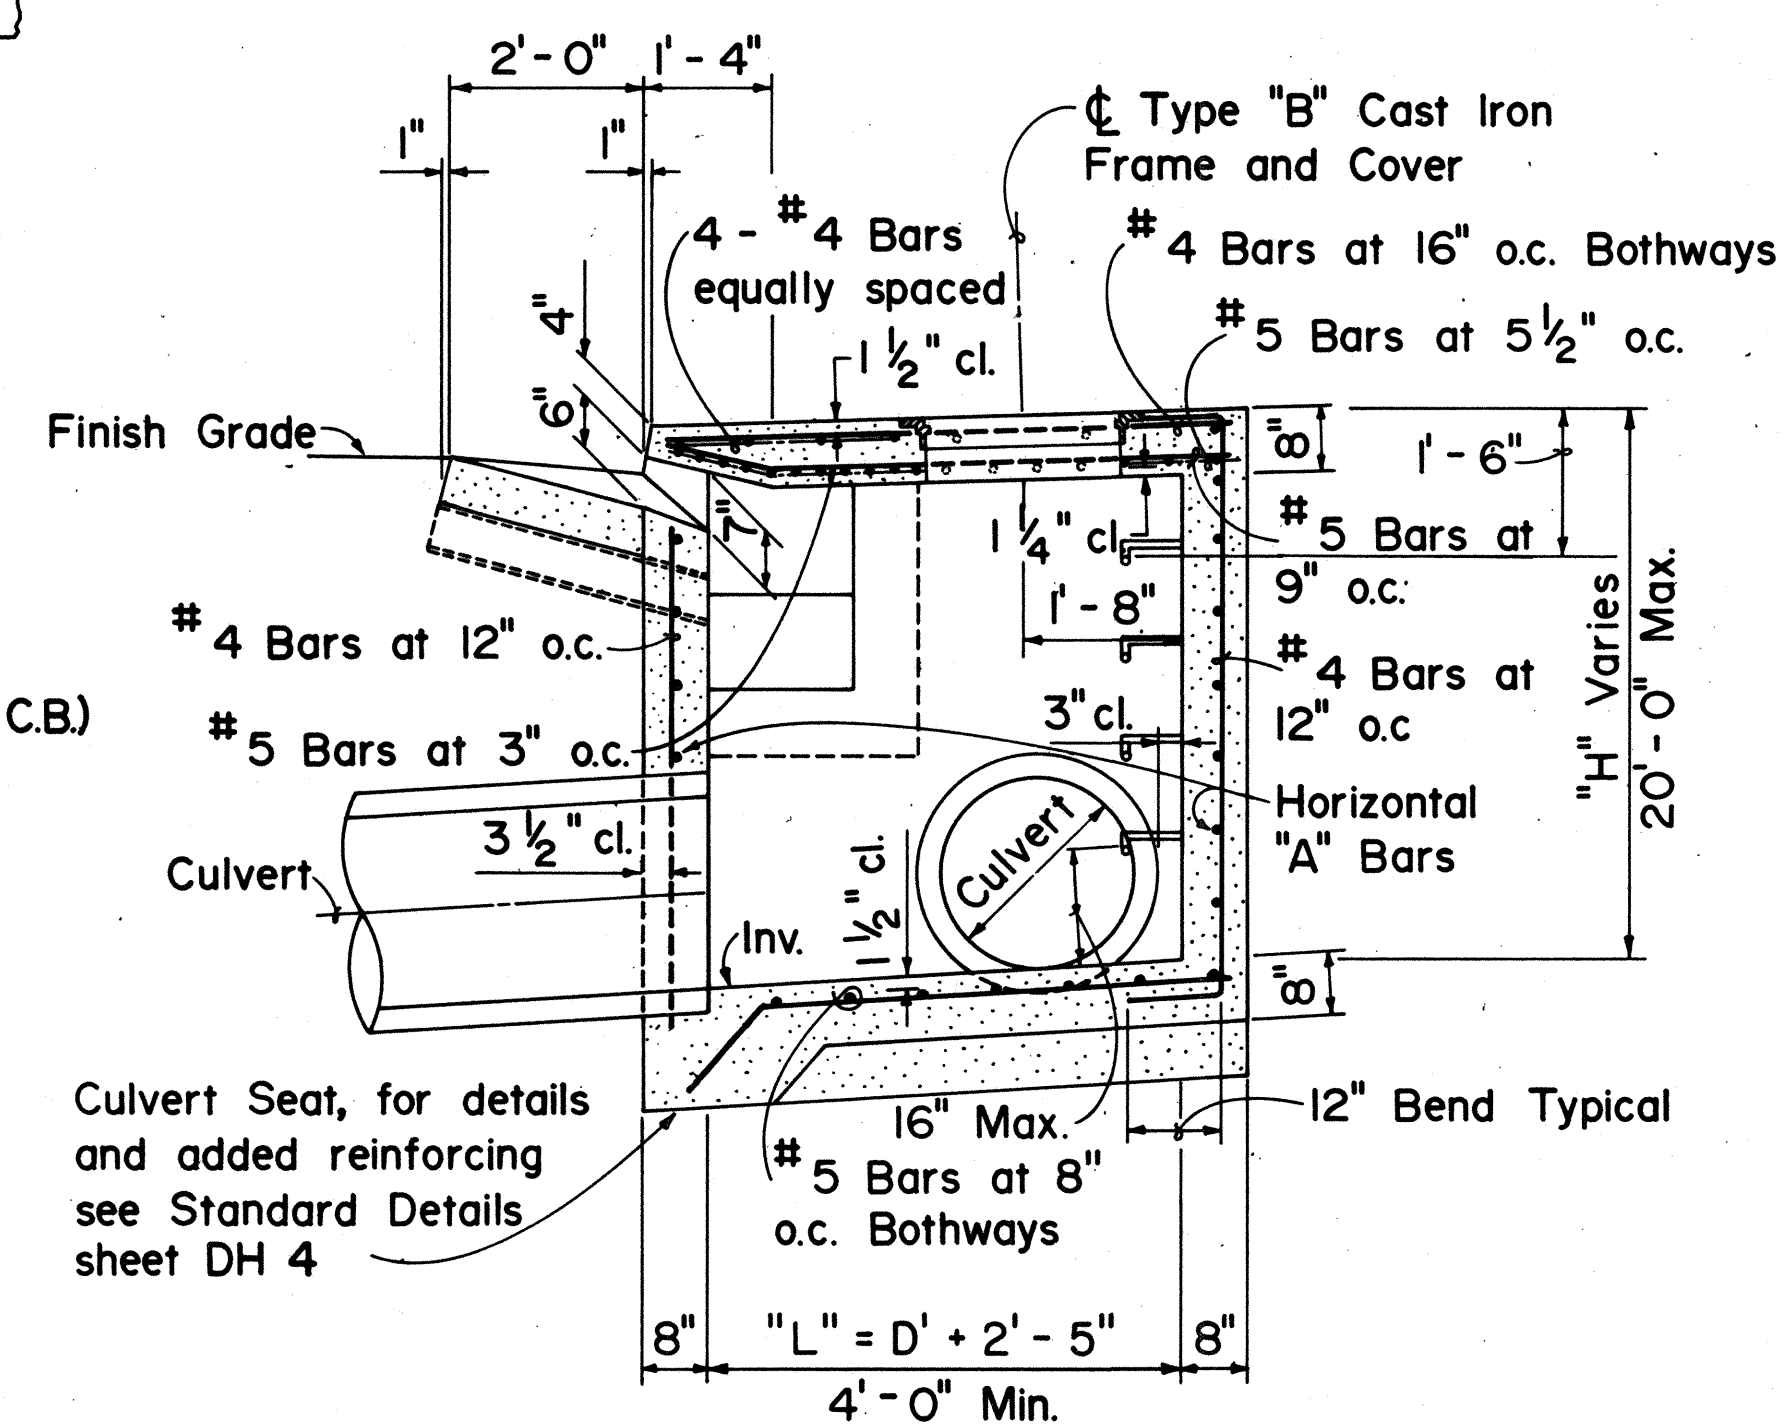


SECTION "B-B"

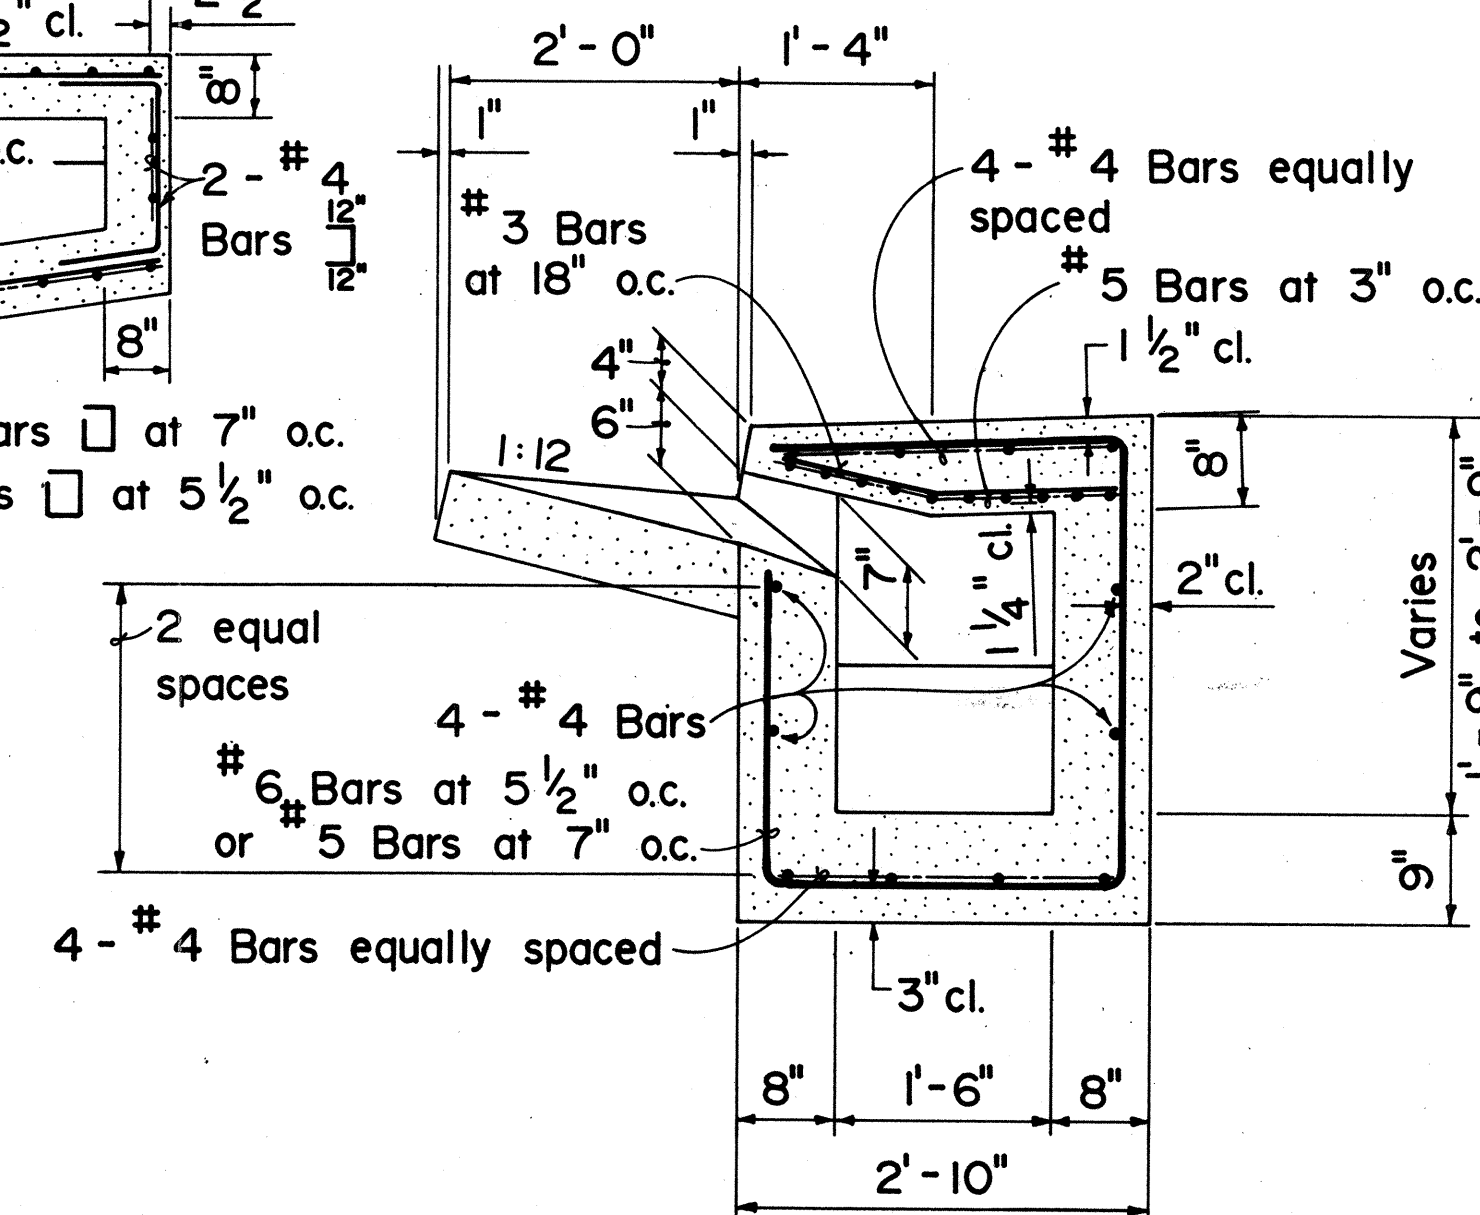

SECTION "C-C"
(2DG Curb and Gutter)

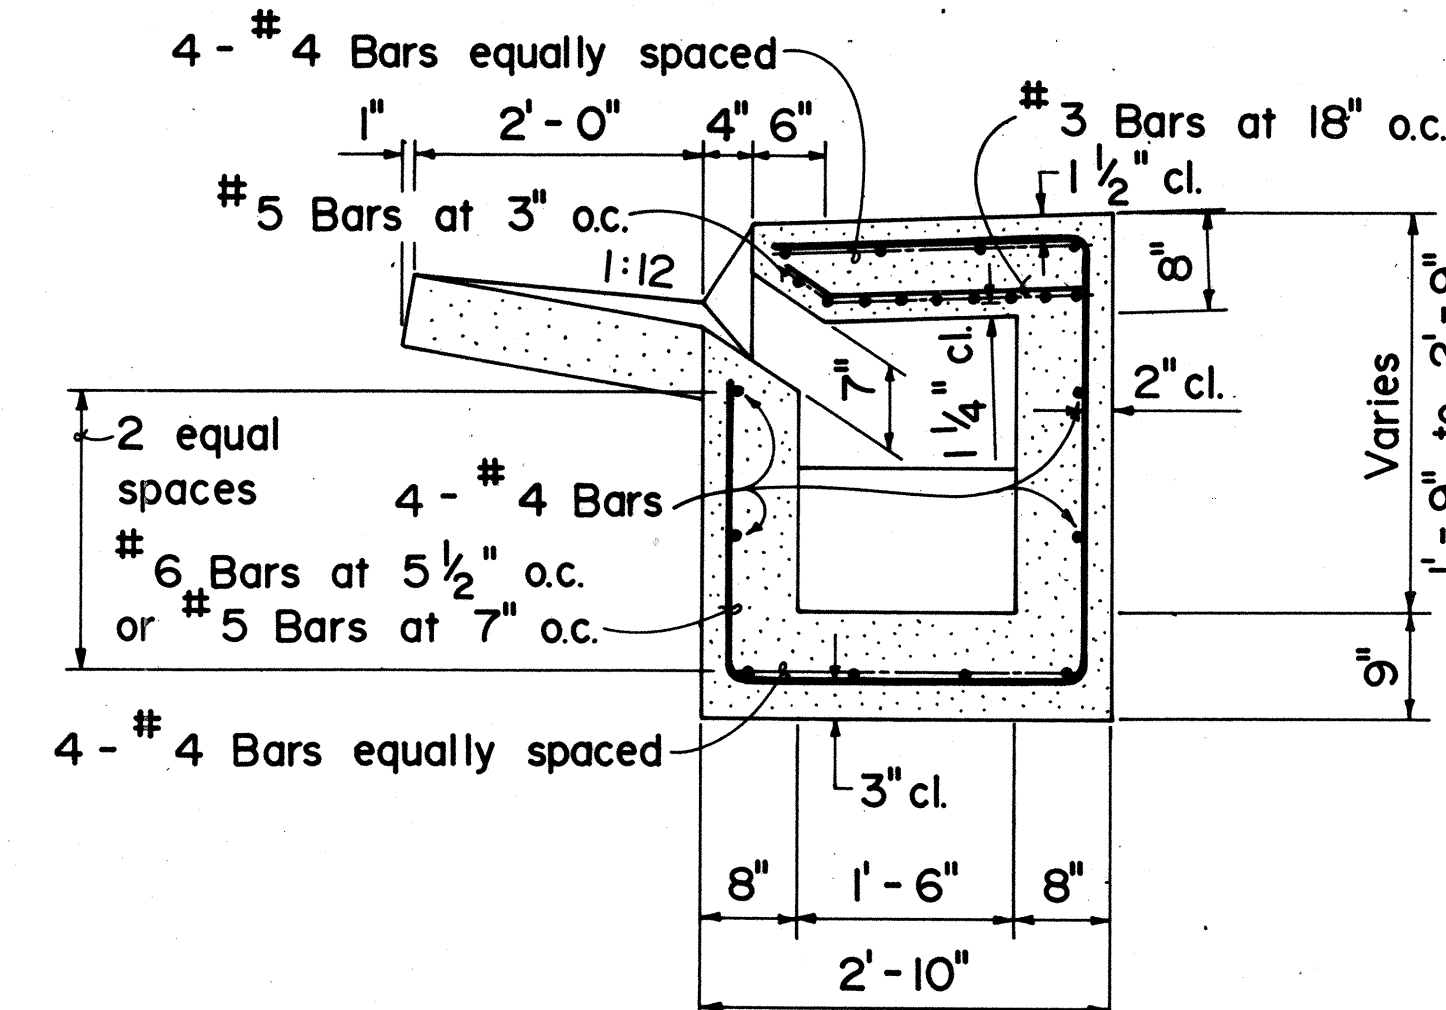

SECTION "C-C"
(2AG Curb and Gutter)

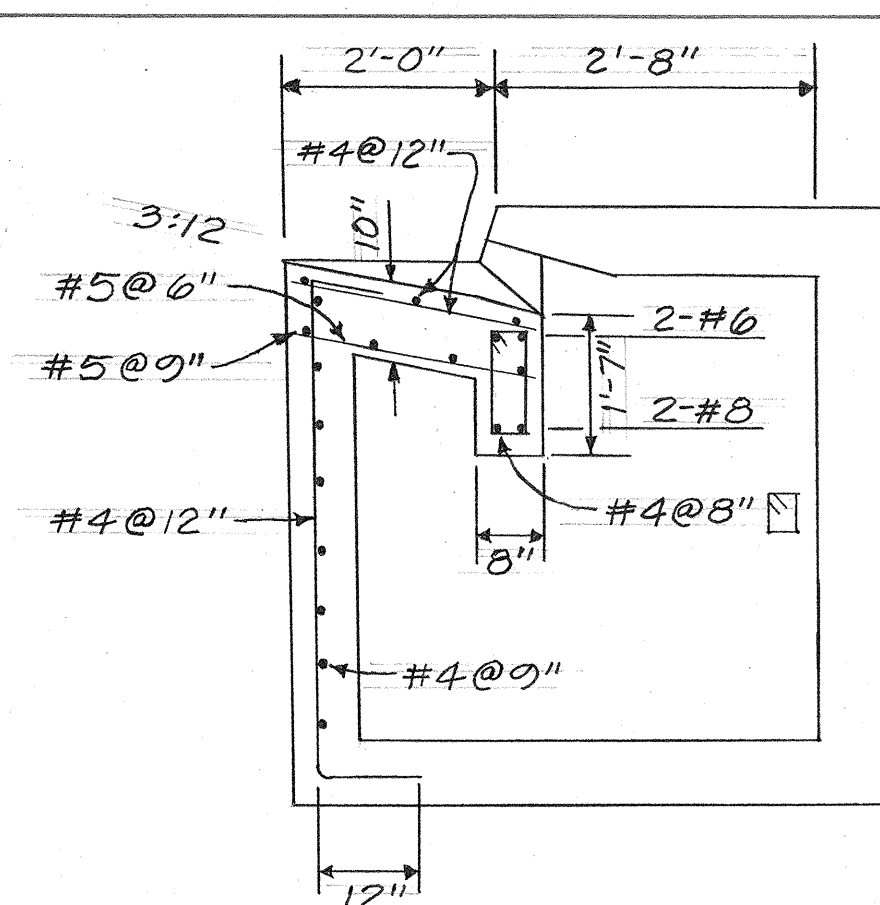

PLAN VIEW OF REINFORCING STEEL

TYPE "A", "B", "C" & "D" CATCH BASIN

APPROVAL RECOMMENDED:

Edward H. Lee 12/3/80
HYDRAULIC DESIGN ENGINEER DATE

APPROVED:

Herbert Zaleski 12/4/80
ASSISTANT CHIEF, ENGINEERING DATE

NO.	REVISION	APPROVED BY	DATE
1.	Supersedes Sht. DH I approved 12/17/69	H.P.	12/4/69
2.	Define "L" - Section "B-B", change bottom slab spacing 9" to 8" in Section "B-B"	<i>[Signature]</i>	3-10-69

STATE OF HAWAII
DEPARTMENT OF TRANSPORTATION
HIGHWAYS DIVISION

STANDARD DETAILS

TYPE A, B, C, & D

CATCH BASIN


Not To Scale Date: Dec. 1980

SHEET No.D-17 OF D-25 SHEETS DH I


MODIFIED TYPE D CATCH BASIN
Drainage Structures No. 5, 6, & 7
Details Not Shown Same As
For Type D Catch Basin
(Field Change)

Note: This detail prepared during "As-Built" posting.


FED. ROAD DIST. NO.	STATE	FED. AID PROJ. NO.	FISCAL YEAR	SHEET NO.	TOTAL SHEETS
HAWAII	HAW.	IRH-10917	1983	63	280

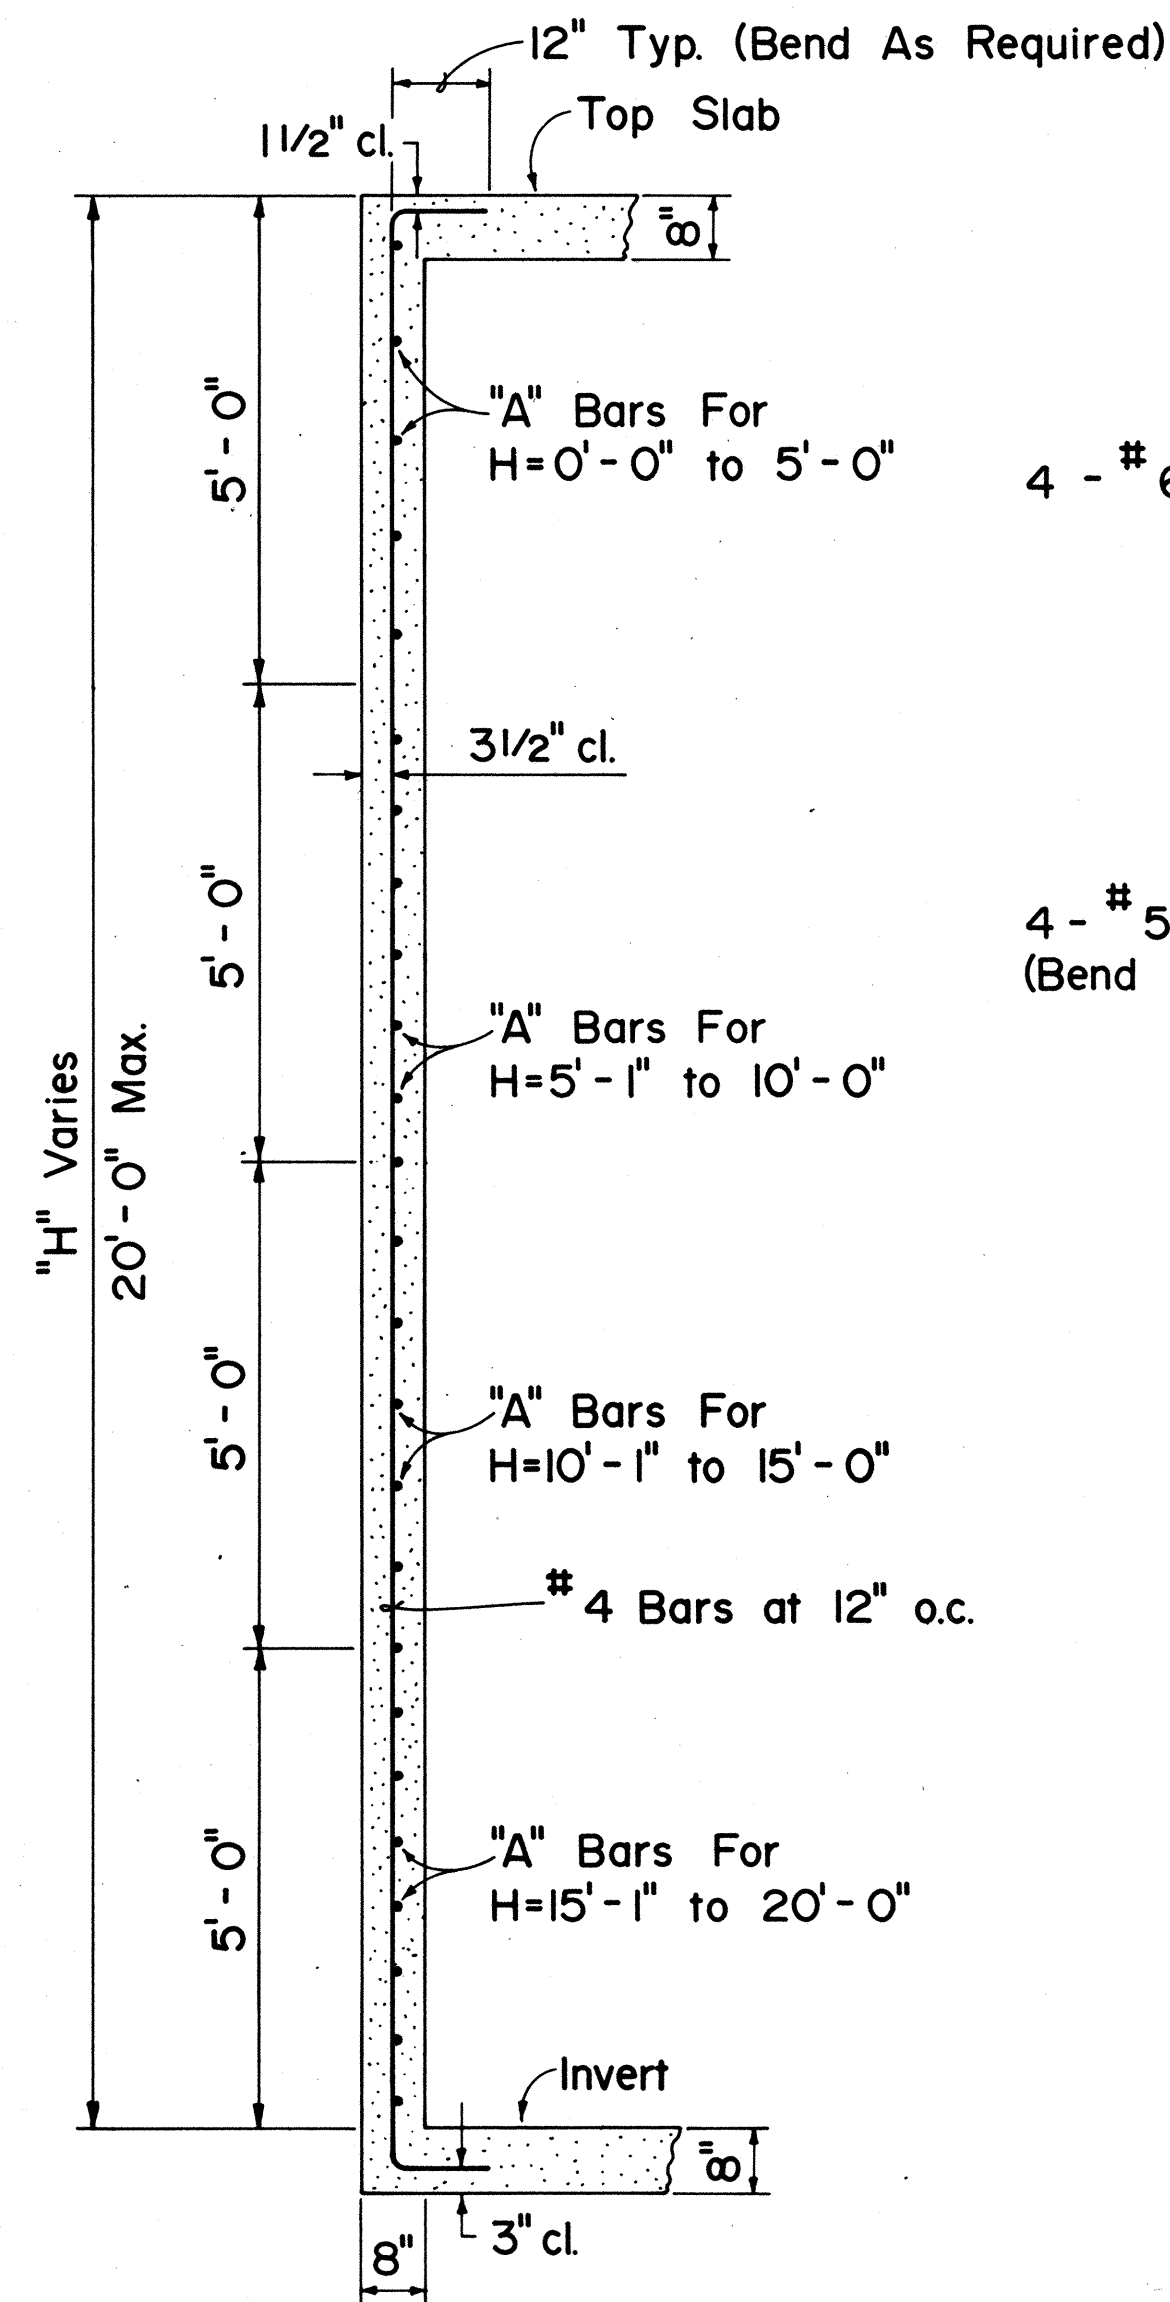


ELEVATION VIEW OF WALL SECTION

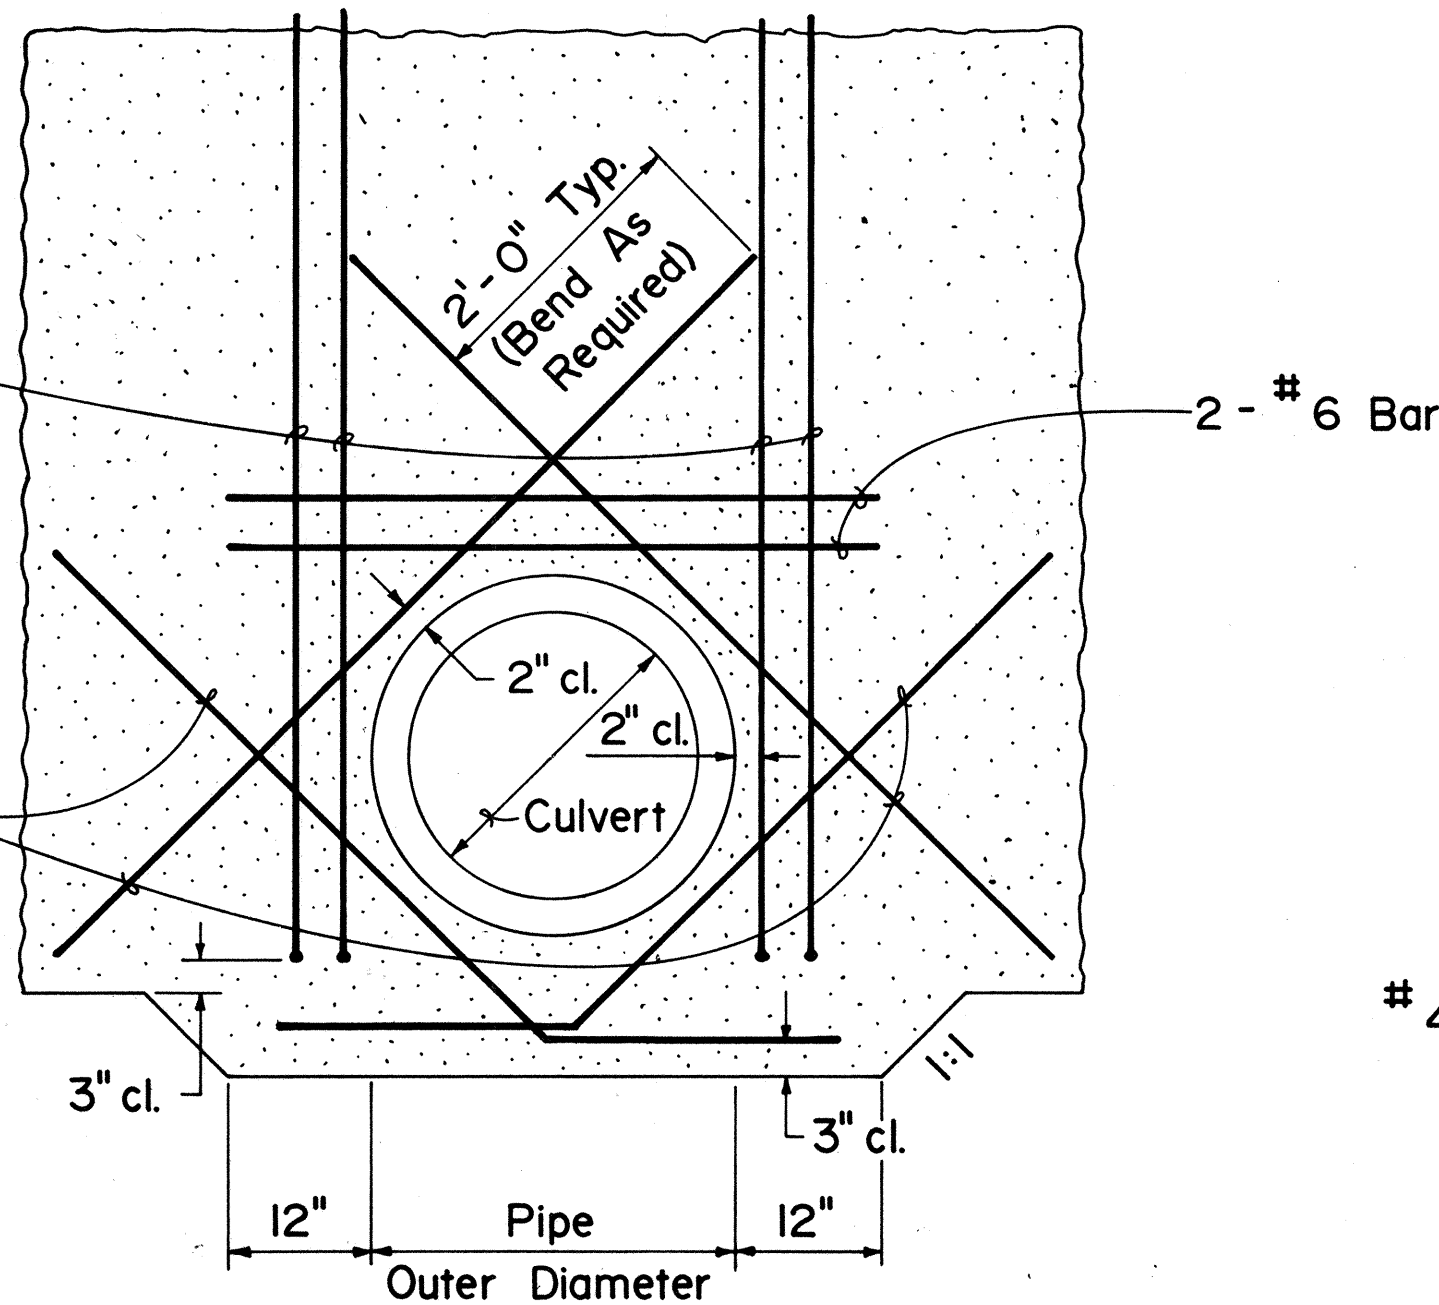

ADDED REINFORCING FOR CULVERT OPENINGS

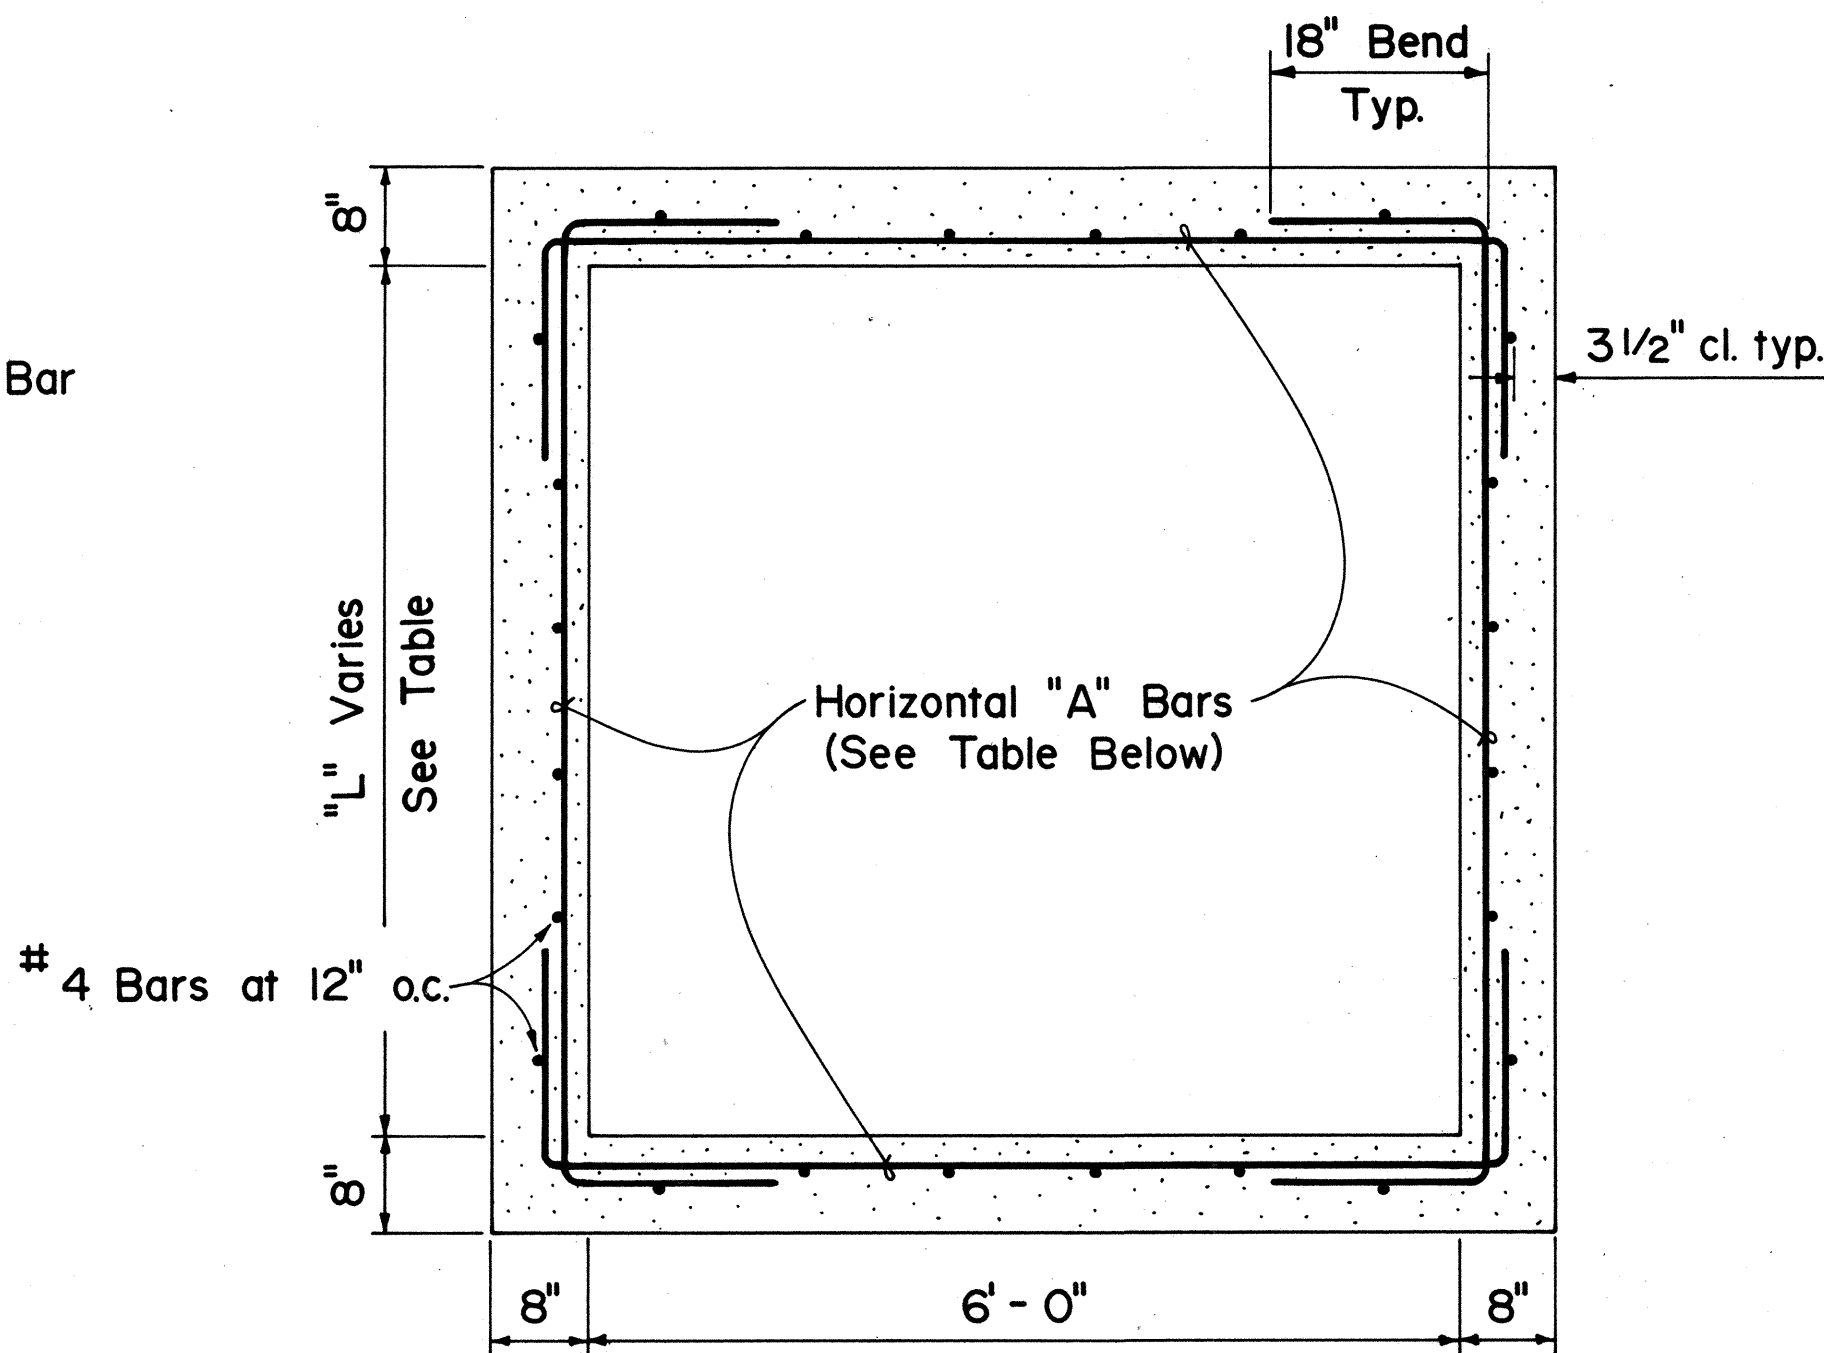


PLAN VIEW OF WALL SECTION

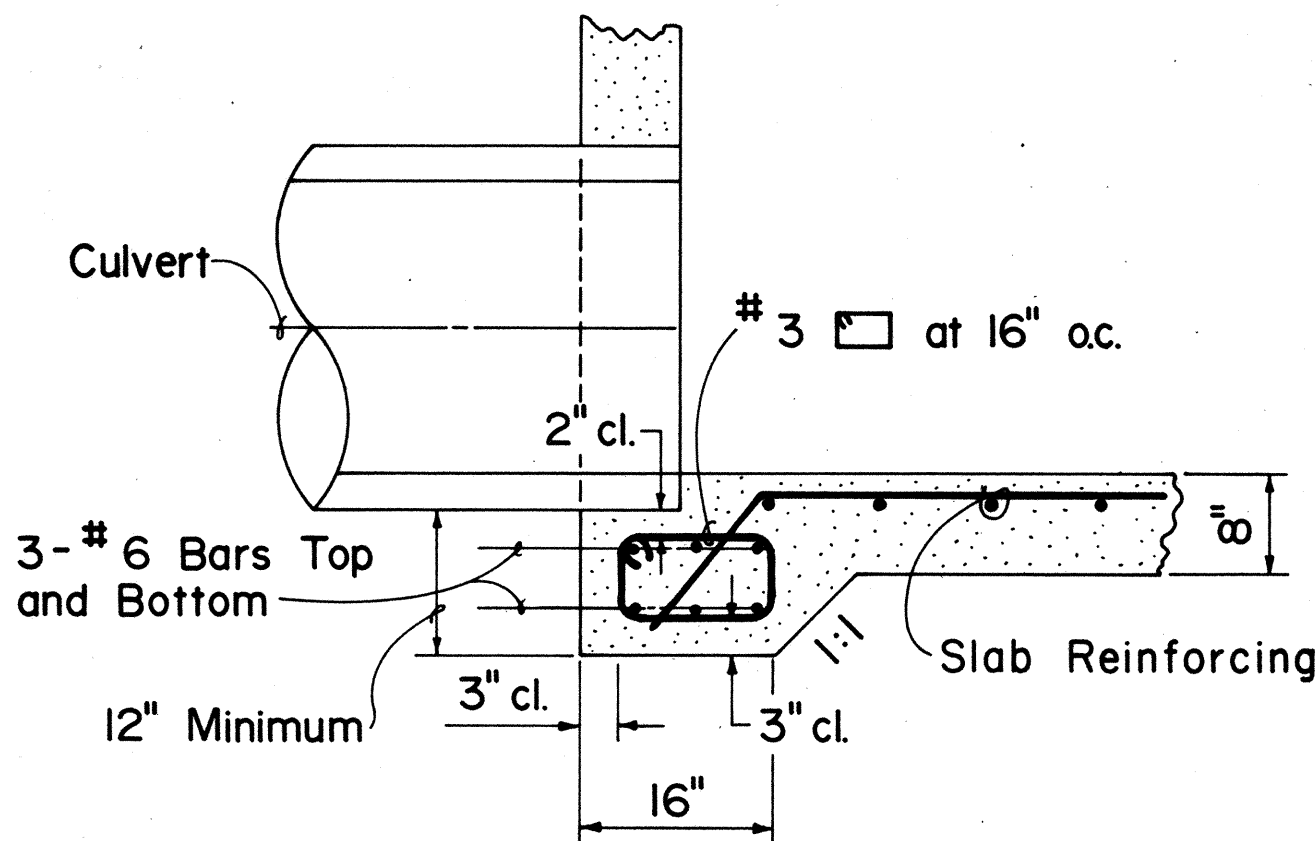

DETAIL OF CULVERT SEAT

HORIZONTAL "A" BARS					
"H" MAX. (FT.)	"L" MAX. (FT.)				
	4'-0"	6'-0"	7'-4"	8'-4"	9'-4"
0'-0" to 5'-0"	# 4 at 12" o.c.	# 4 at 10" o.c.	# 5 at 10" o.c.	# 5 at 8" o.c.	# 5 at 7" o.c.
5'-1" to 10'-0"	# 4 at 9" o.c.	# 5 at 9" o.c.	# 5 at 6" o.c.	N.A.	N.A.
10'-1" to 15'-0"	# 5 at 10" o.c.	# 5 at 6" o.c.	N.A.	N.A.	N.A.
15'-1" to 20'-0"	# 5 at 8" o.c.	N.A.	N.A.	N.A.	N.A.

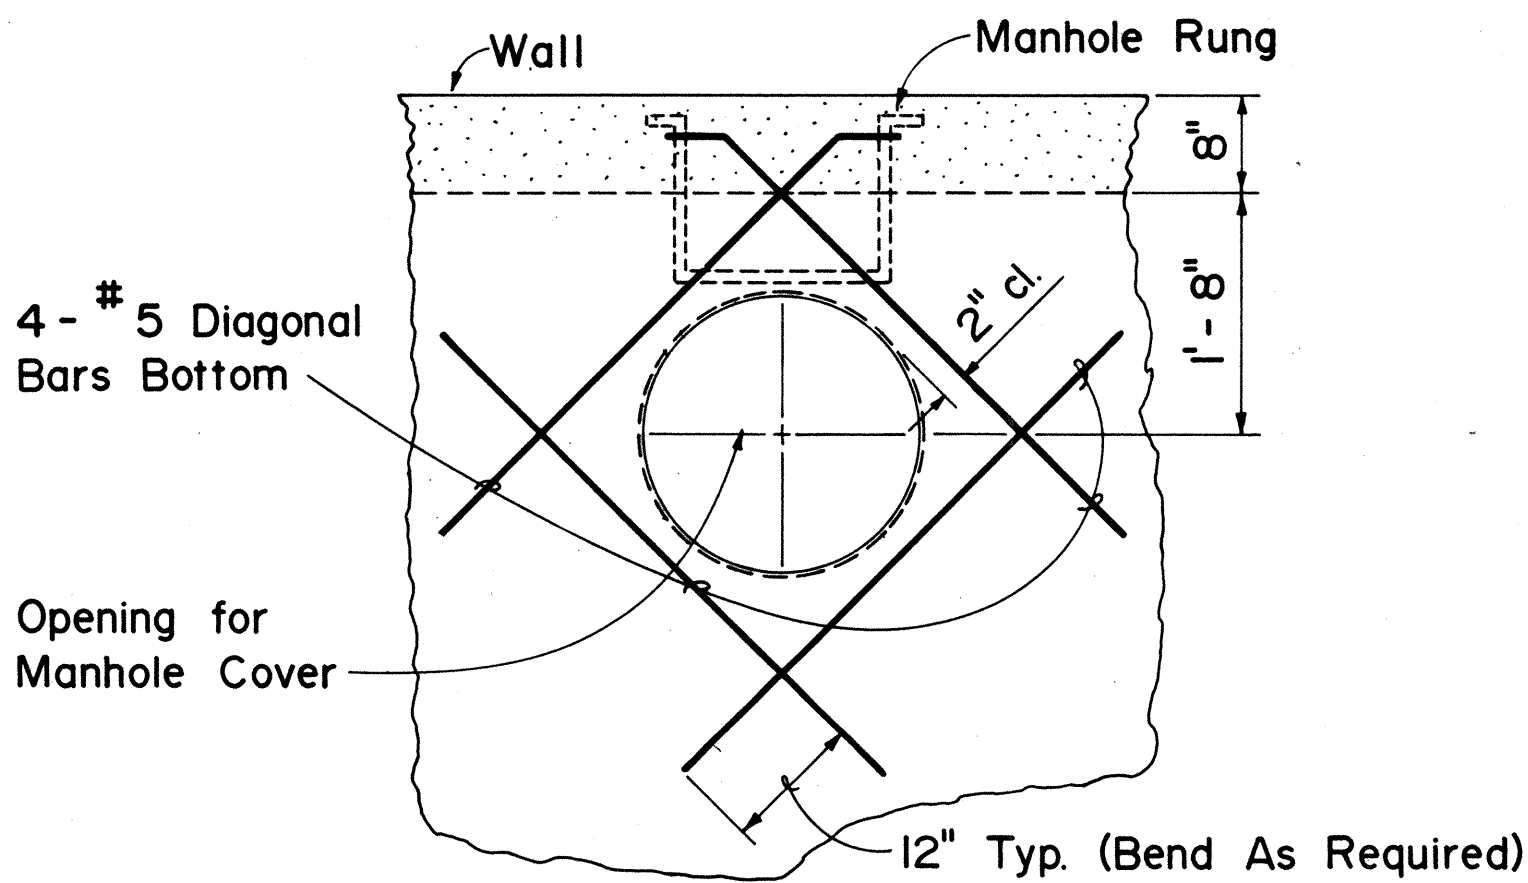

ADDED REINFORCING FOR MANHOLE OPENING

APPROVAL RECOMMENDED: 12/3/80
HYDRAULIC DESIGN ENGINEER DATE
APPROVED: 12/4/80
ASSISTANT CHIEF, ENGINEERING DATE

NO.	REVISION	APPROVED BY	DATE
1.	Replaces Sht. DH 4 approved 12-17-69	H.T.	12/4/80
2.	Delete bar clearance in Culvert Seat Detail, "slab reinforcing" in lieu of bar size and clearance in Culvert Seat Detail	J.D.	3-10-84


STATE OF HAWAII
DEPARTMENT OF TRANSPORTATION
HIGHWAYS DIVISION

STANDARD DETAILS
TYPICAL REINFORCING DETAILS
FOR CATCH BASINS
Not To Scale Date: Dec. 1980


SHEET No.D-18 OF D-25 SHEETS DH 4

DATE	
SURVEY PLOTTED BY	
DRAWN BY	
TRACED BY	
DESIGNED BY	
QUANTITIES BY	
CHECKED BY	
ORIGINAL PLAN	
NOTE BOOK	
No.	


FED. ROAD DIST. NO.	STATE	FED. AID PROJ. NO.	FISCAL YEAR	SHEET NO.	TOTAL SHEETS
HAWAII	HAW.	IRH-1(69)17	1983	64	280

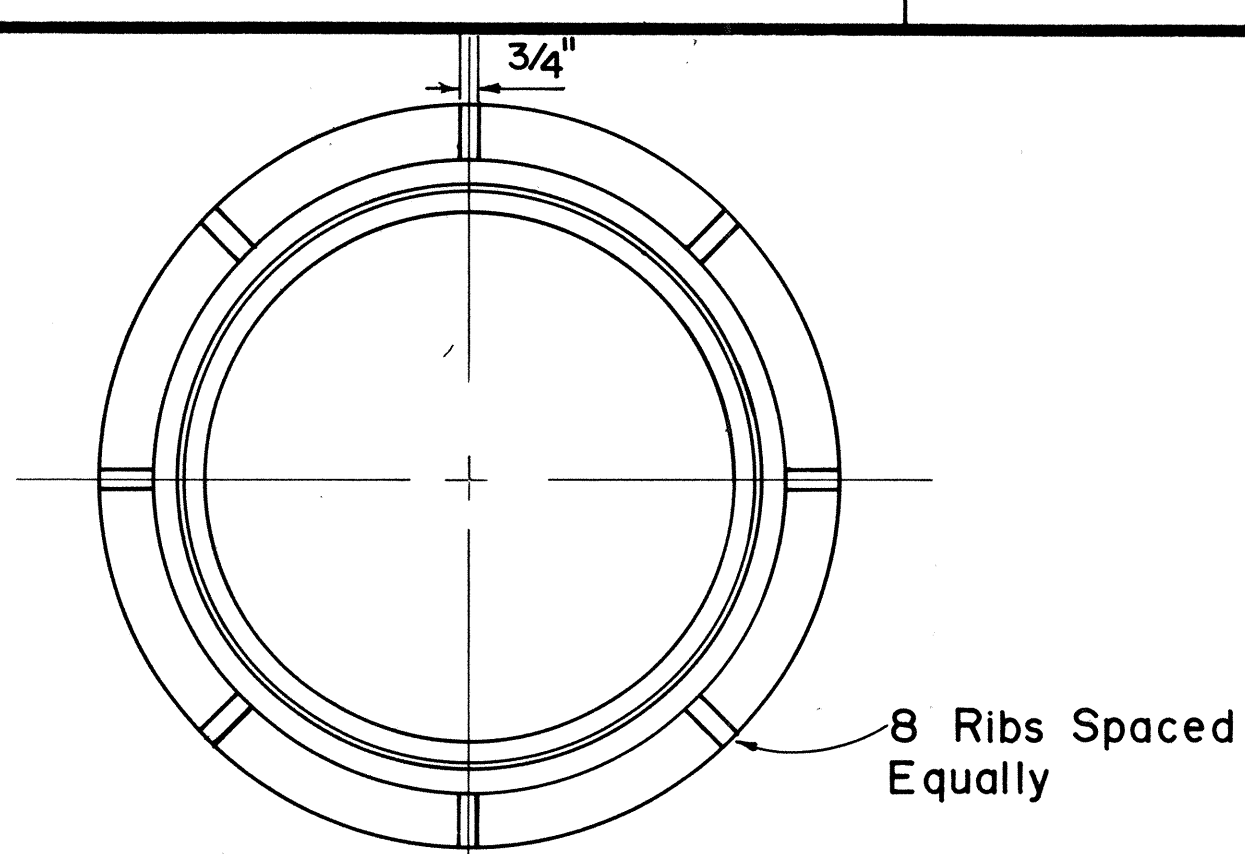


PLAN OF FRAME

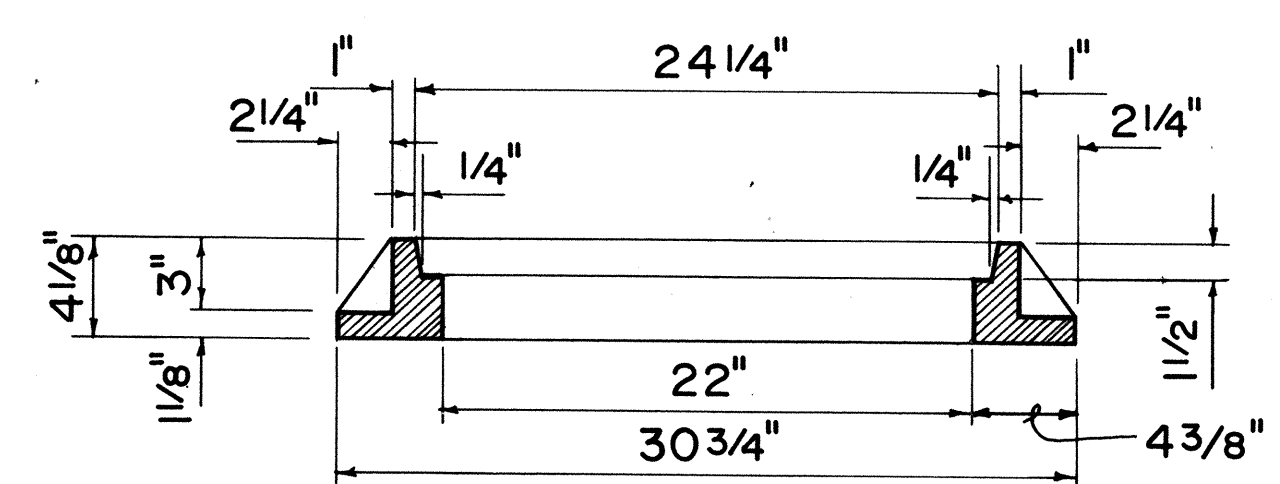


SECTION OF FRAME

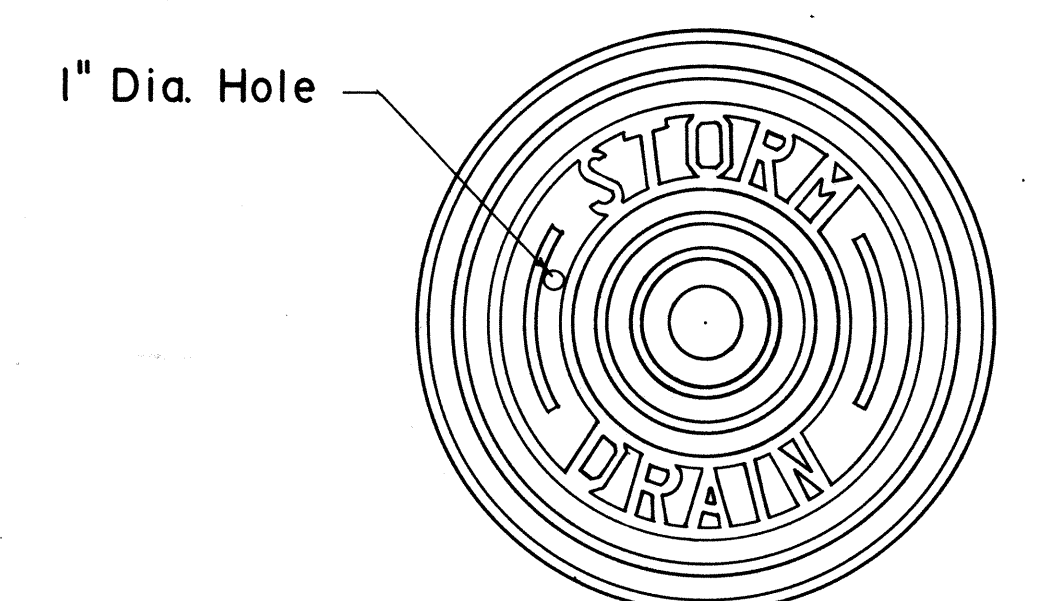

TOP VIEW OF COVER

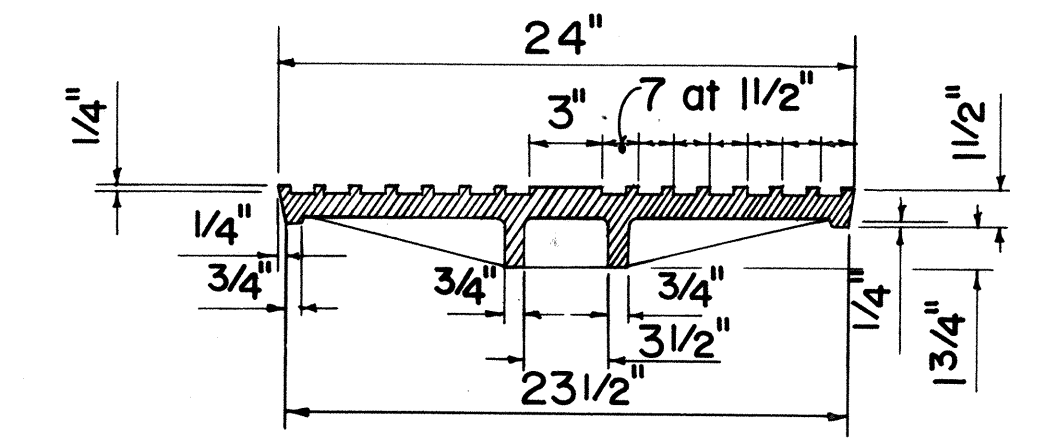


SECTION

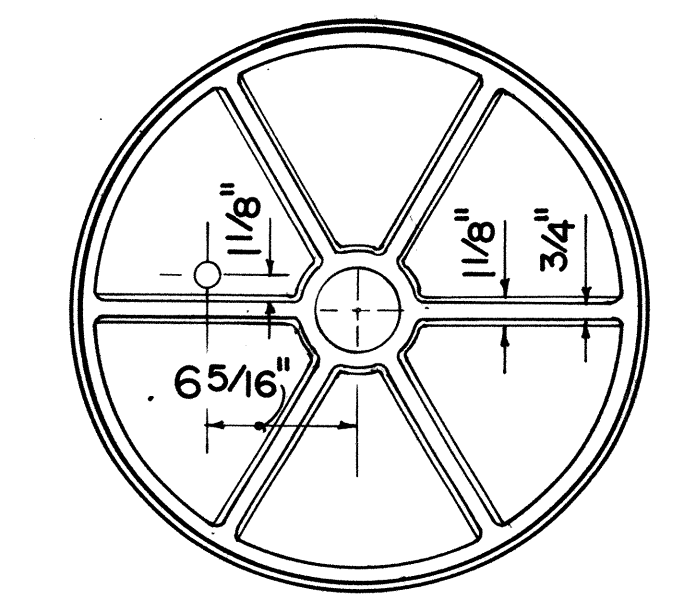


BOTTOM VIEW OF COVER


TYPE "P" CAST IRON FRAME AND COVER

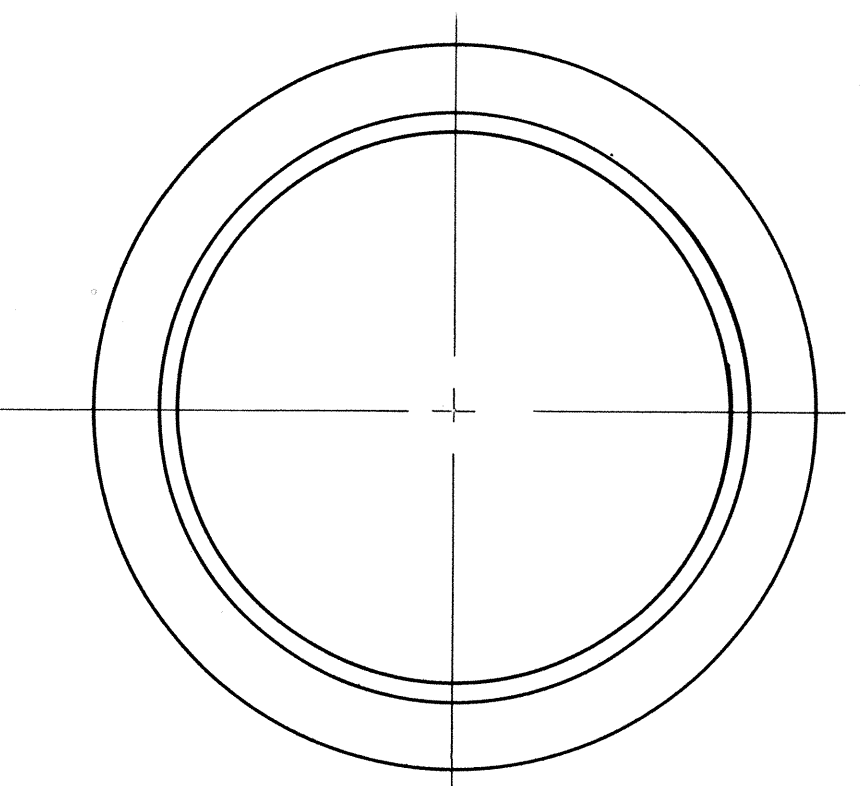


PLAN OF FRAME

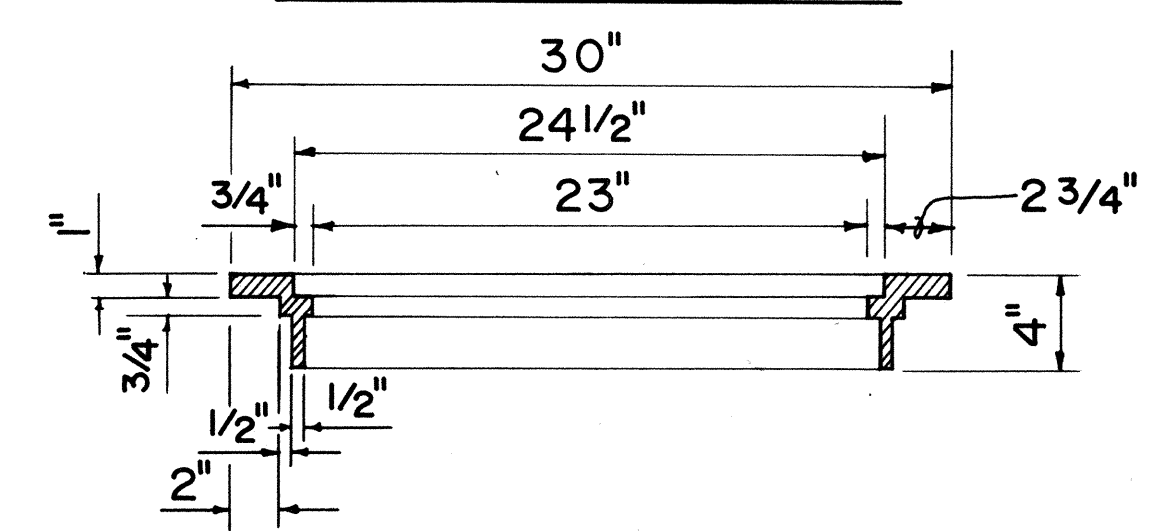


SECTION OF FRAME

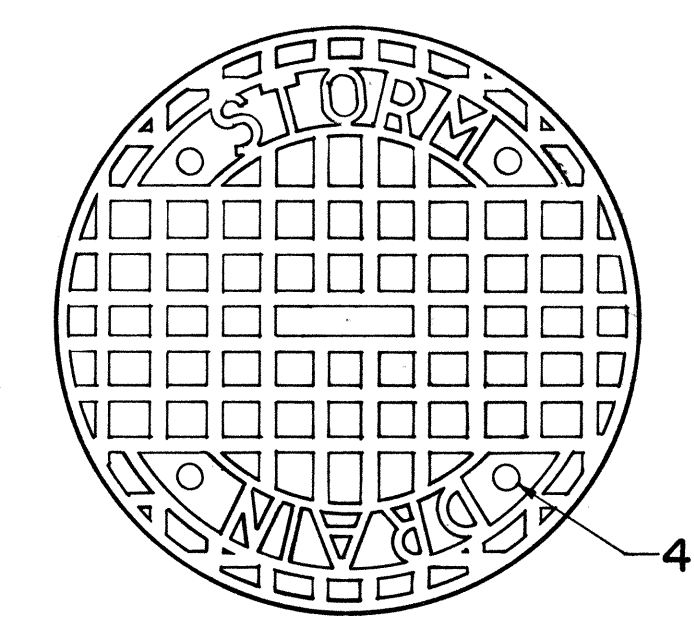

TOP VIEW OF COVER

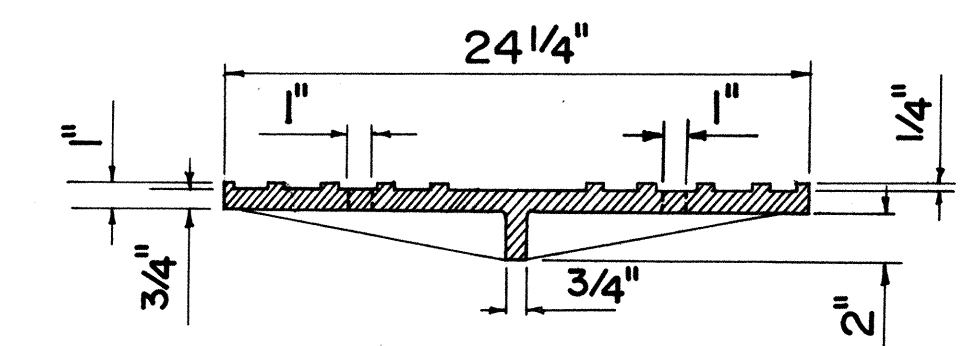


SECTION

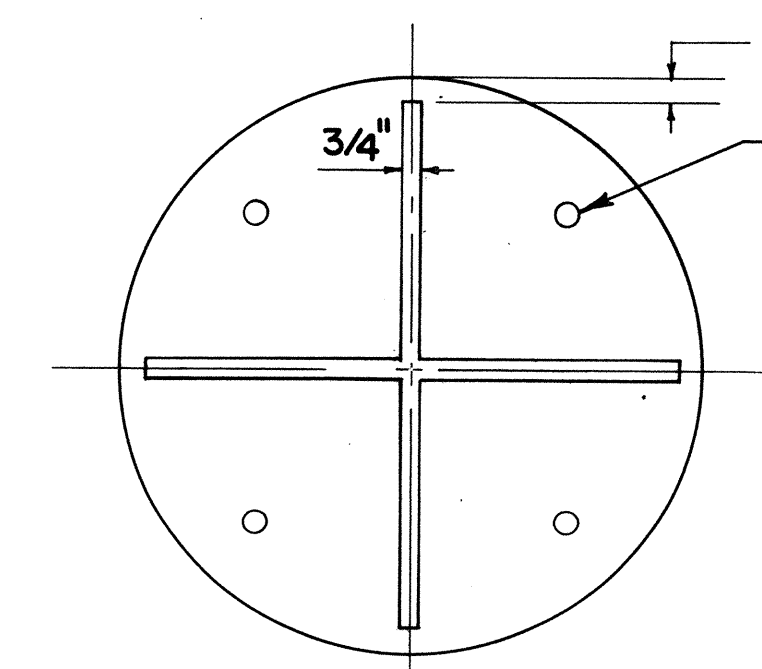


BOTTOM VIEW OF COVER


TYPE "B" CAST IRON FRAME AND COVER

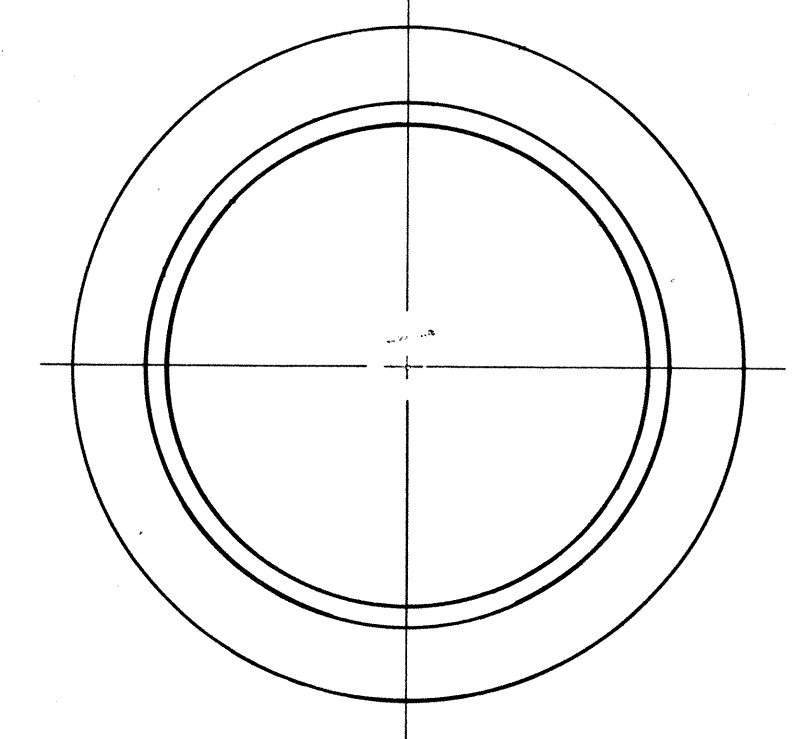


PLAN OF FRAME

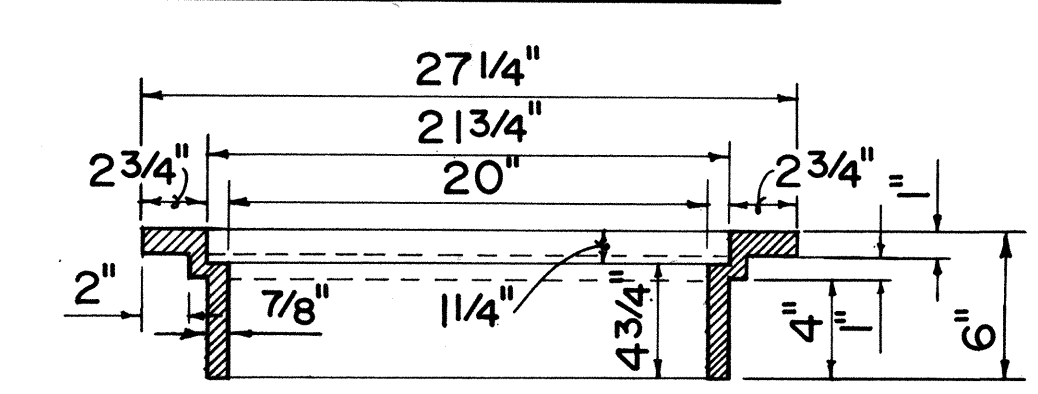


SECTION OF FRAME

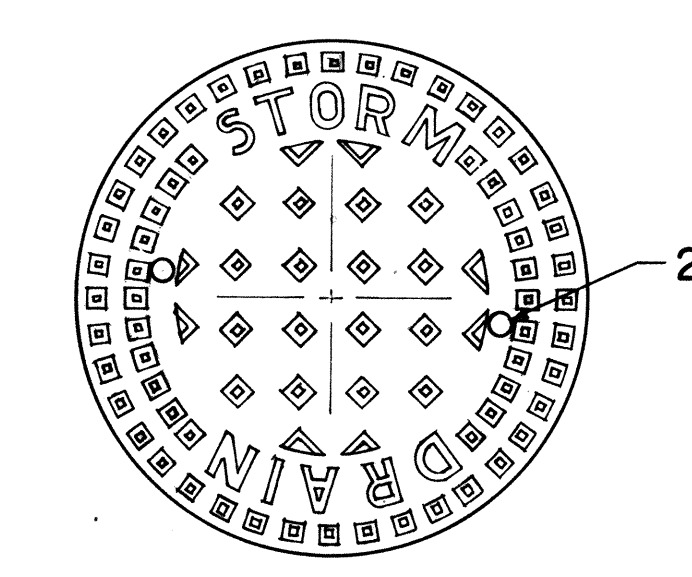

TOP VIEW OF COVER

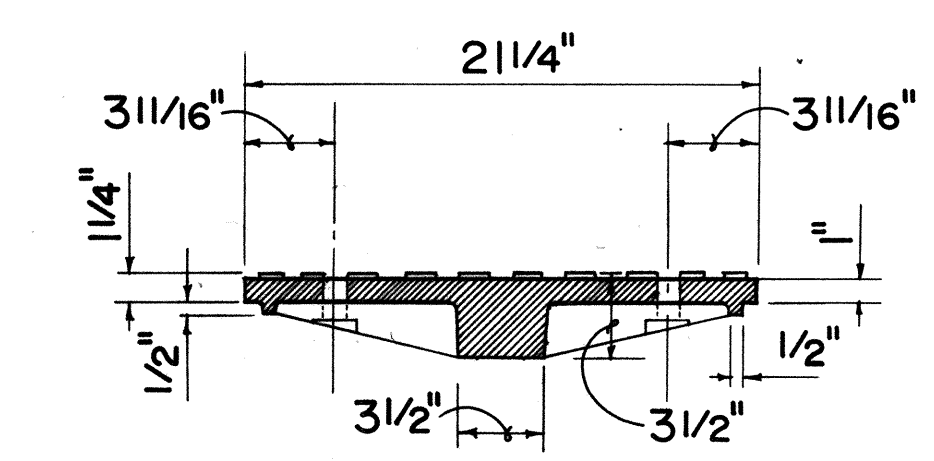


SECTION

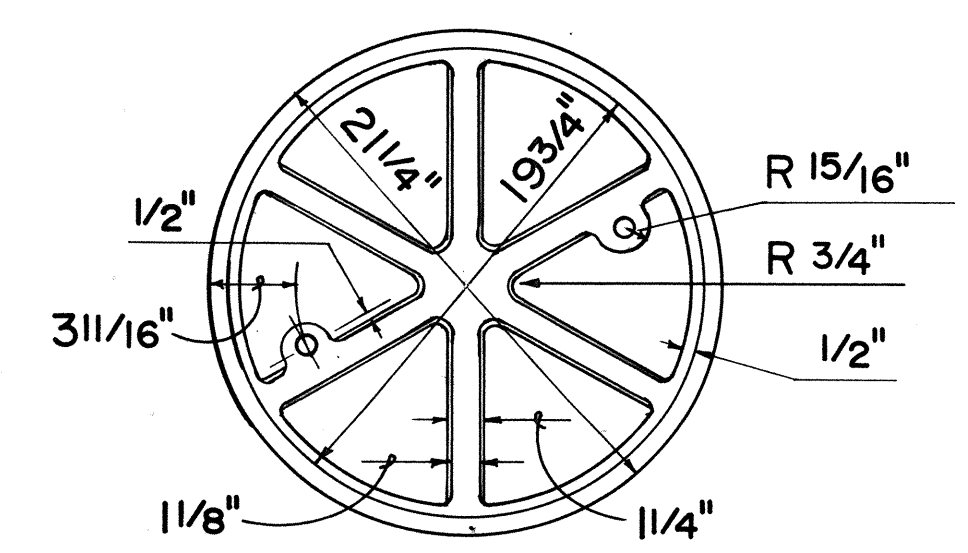


BOTTOM VIEW OF COVER


TYPE "A" CAST IRON FRAME AND COVER

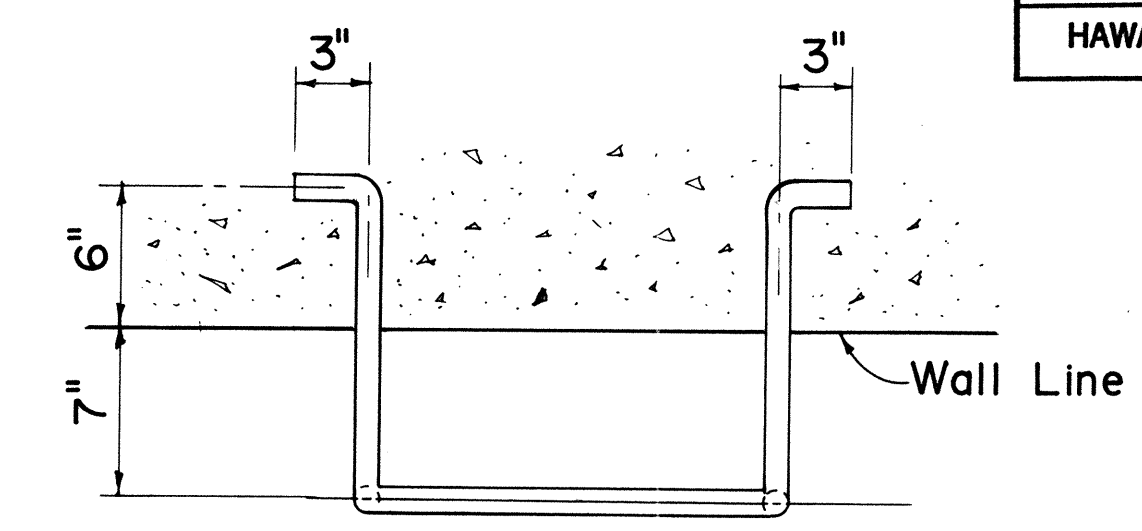

PLAN

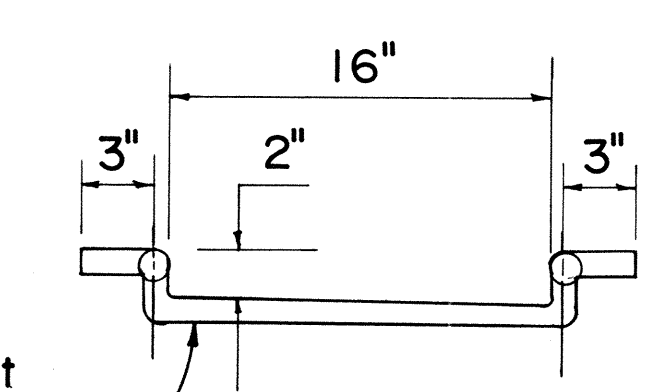

FRONT VIEW

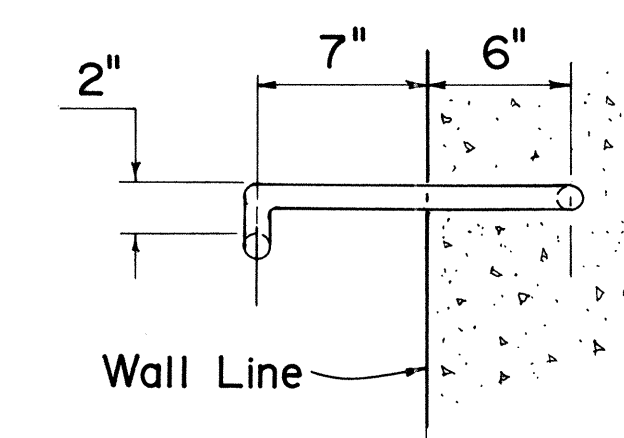

SIDE VIEW

MANHOLE RUNG

APPROVAL RECOMMENDED:
Takano
 HYDRAULIC DESIGN ENGINEER 6-19-79 DATE
 APPROVED:
Herbert Zakeishi
 ASSISTANT CHIEF, ENGINEERING 6-22-79 DATE

NO.	REVISION	APPROVED BY	DATE
1.	Supersedes Sht. DH 6 approved 12-17-69	H.T.	6/22/79

STATE OF HAWAII
 DEPARTMENT OF TRANSPORTATION
 HIGHWAYS DIVISION

STANDARD DETAILS
 CATCH BASIN AND
 MANHOLE CASTINGS

Not To Scale Date: Dec. 1977

ORIGINAL PLAN	DATE
DRAWN BY	
CHECKED BY	
NOTED BY	
QUANTITIES BY	
CHECKED BY	

GENERAL NOTES

- [illegible]

Diagram showing the elevation of a column. The column has a height of $3' - 15/8"$ and a width of $1' - 115/8"$. A detail callout points to the top right corner, labeled "See Detail A".

The diagram illustrates the test specimen, a horizontal beam with a total length of 6'-6". The beam is supported by a central support assembly. The distance from the left end to the center support is 3'-2", and the distance from the center support to the right end is also 3'-2". The beam has a height of 4". The reinforcement consists of #6-24 Reinf. Bar. The central support assembly is labeled as W5 x 19.0.

Diagram illustrating a bolted splice joint. The components labeled are: Bars, 1/2" Bolt, Cut washer, Spot Weld or peen, Spacer, and X (the gap between the bars).


Technical drawing of a rectangular frame. The drawing shows a top-down view of a rectangular structure with a central opening. The overall width is 3'-0" (3 feet 0 inches). The overall height is 2'-11" (2 feet 11 inches). The central opening has a width of 3'-3" (3 feet 3 inches) and a height of 2'-0" (2 feet 0 inches). The frame consists of two vertical members and two horizontal members. The vertical members are 3" (3 inches) wide. The horizontal members are 5 1/2" (5 and a half inches) high. The distance between the inner vertical members is 3'-3" (3 feet 3 inches). The distance between the inner horizontal members is 2'-0" (2 feet 0 inches). The overall dimensions are 3'-0" (3 feet 0 inches) by 2'-11" (2 feet 11 inches).

Technical drawing of a window frame showing dimensions and components:

- Top horizontal dimension: $l' - 115/8''$
- Right vertical dimension: $h' - 15/8''$
- Left vertical dimension: $3/16''$
- Bottom horizontal dimension: $l' - 115/8''$
- Bar dimensions: $3\frac{1}{2} \times \frac{1}{2}$
- Bar spacing: X
- Bar orientation: $3\frac{1}{2} \times \frac{1}{2}$

Diagram of a rectangular plate with a central hole. The plate has a total width of $3\frac{1}{2}$ inches. The central hole has a width of W . The distance from the left edge to the center of the hole is $\frac{3}{16}$ inches. The hole is shaded with diagonal lines.

ALTERNATIVE WELDED GRATE

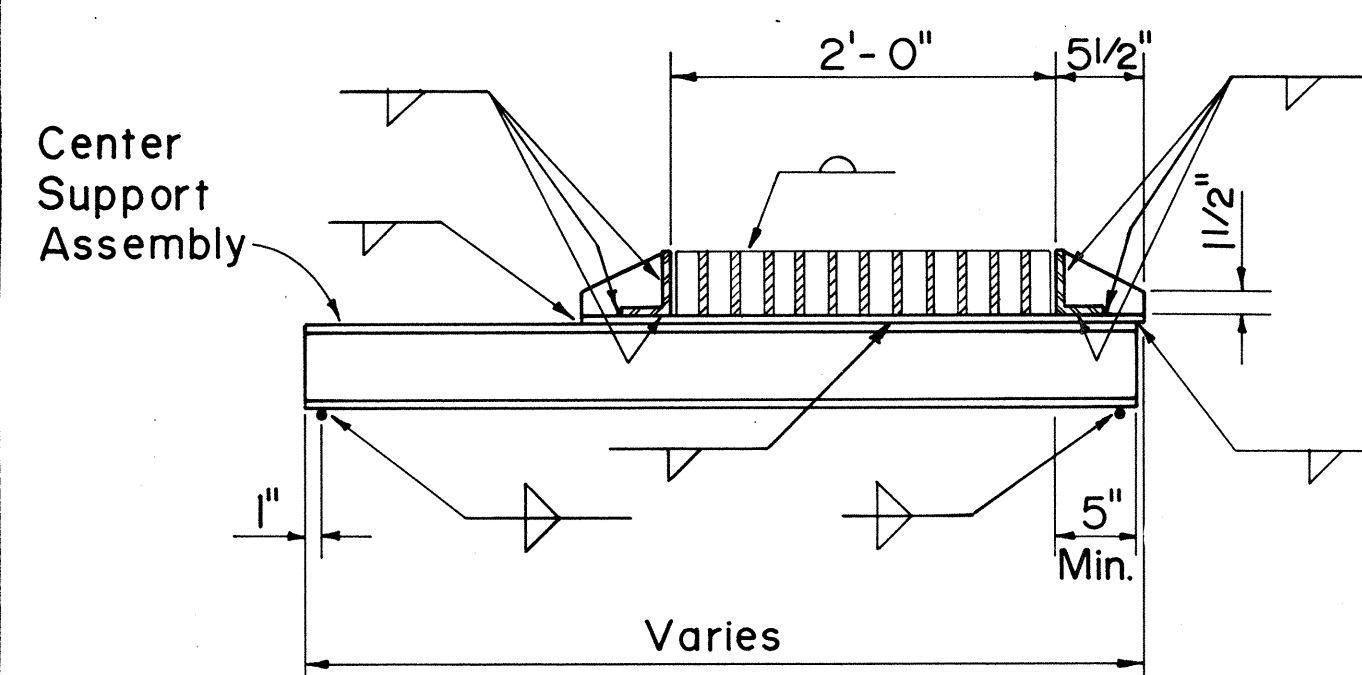

FRAME DETAILS

NO.	REVISION	APPROVED BY	DATE
1.	Supersedes Sht. DH 7 approved 12-17-69	H.T.	6/22
2.	Revise standard nomenclature for rolled steel shapes.	H.T.	4/21

APPROVAL RECOMMENDED:
J. Jakano 6-19-79
HYDRAULIC DESIGN ENGINEER DATE

APPROVED:
Herbert Zalewski 6-22-79
ASSISTANT CHIEF, ENGINEERING DATE

STATE OF HAWAII
DEPARTMENT OF TRANSPORTATION
HIGHWAYS DIVISION

STANDARD DETAILS
TYPE A-9 AND A-12
FRAMES AND GRATES


Not To Scale Date: Dec. 1977

SHEET No.D-20 OF D-25 SHEETS DH 7


FED. ROAD DIST. NO.	STATE	FED. AID PROJ. NO.	FISCAL YEAR	SHEET NO.	TOTAL SHEETS
HAWAII	HAW.	I-IR-H-1(169):17	1983	66	280

GENERAL NOTES


1. All welds $\frac{5}{16}$ " unless otherwise noted.
2. Grates and Frames shall be hot dip galvanized after fabrication.
3. Center Support Assembly shall be used when two or more grates are specified. Incidental to Steel Frame and Grates.
4. Use in locations off the road bed on all types of highway. (Bicycle Grates)

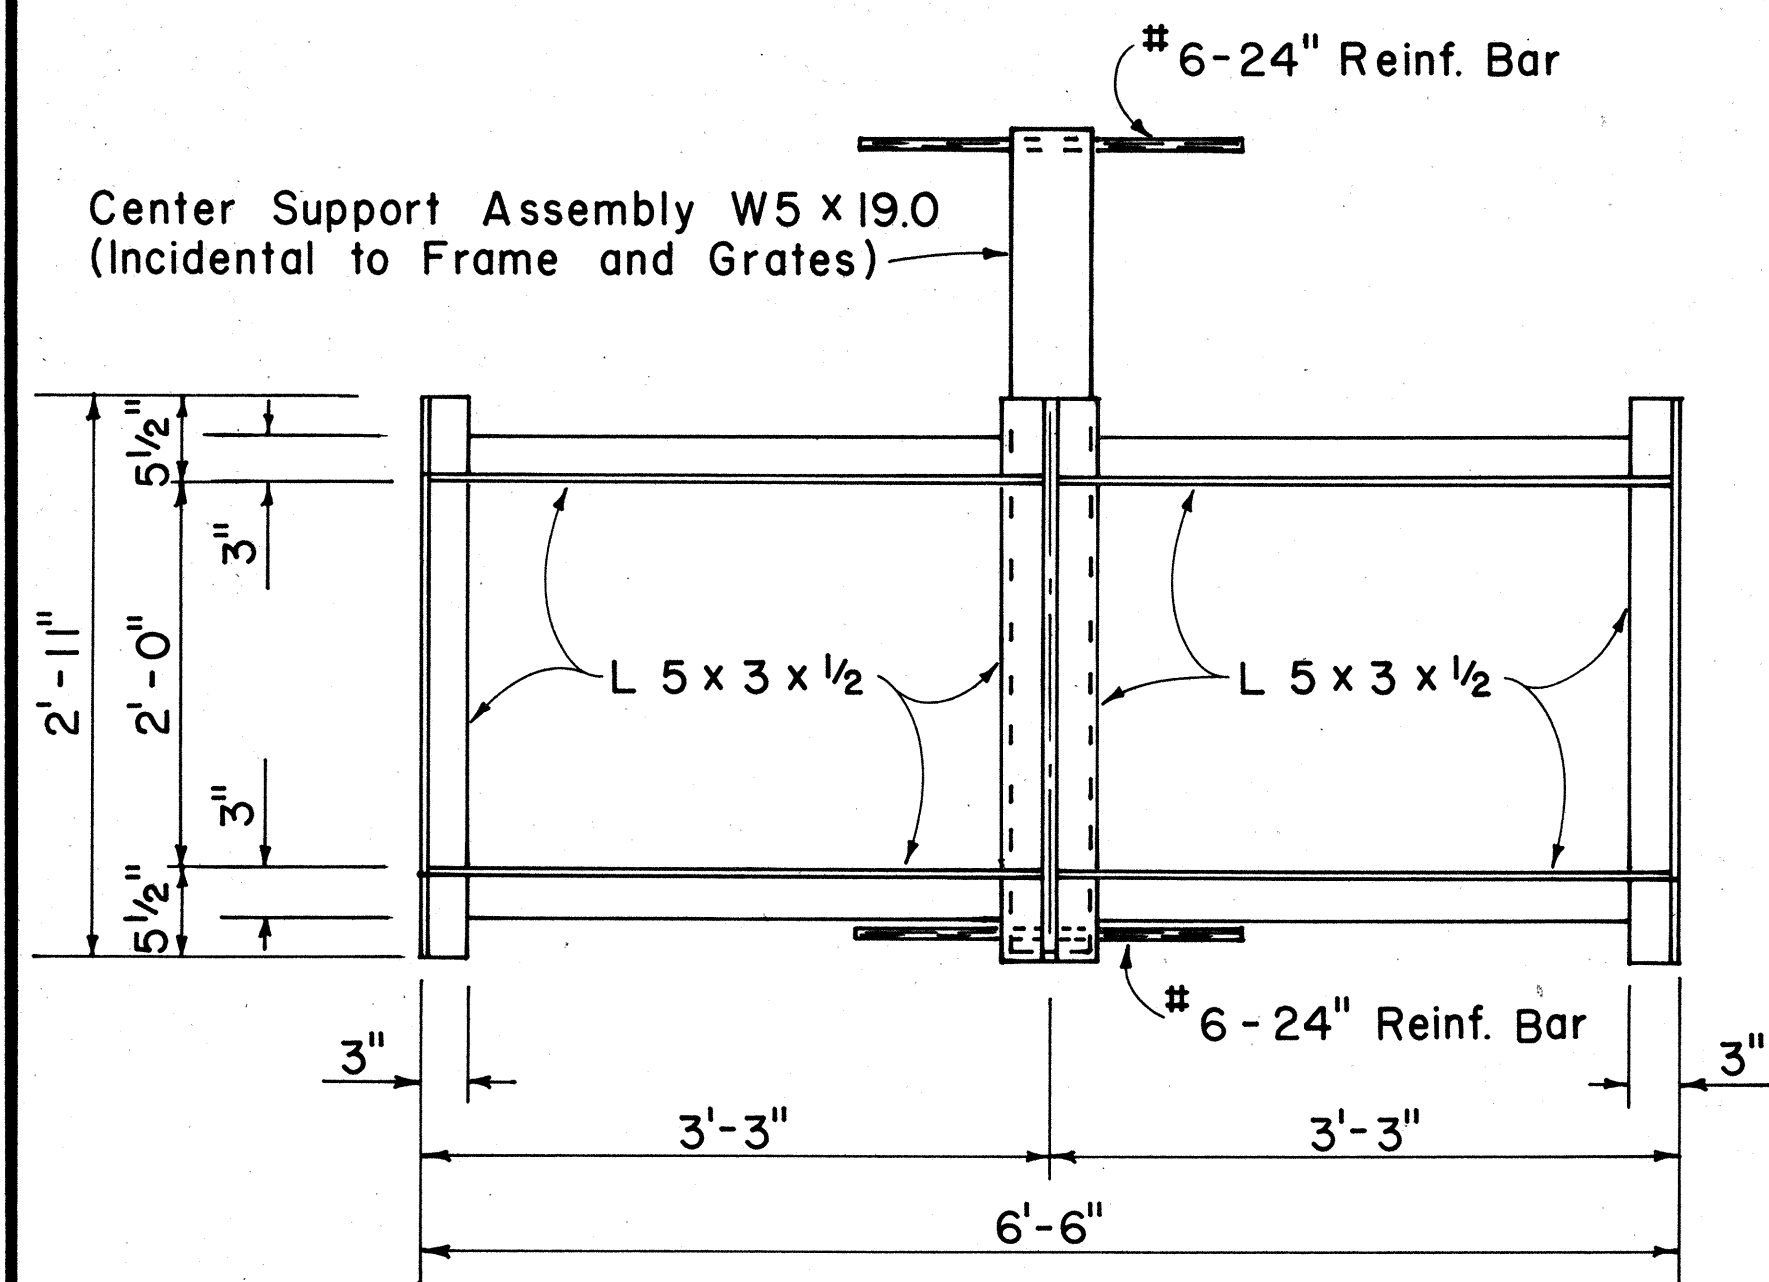


PLAN
(Two or More Grates)

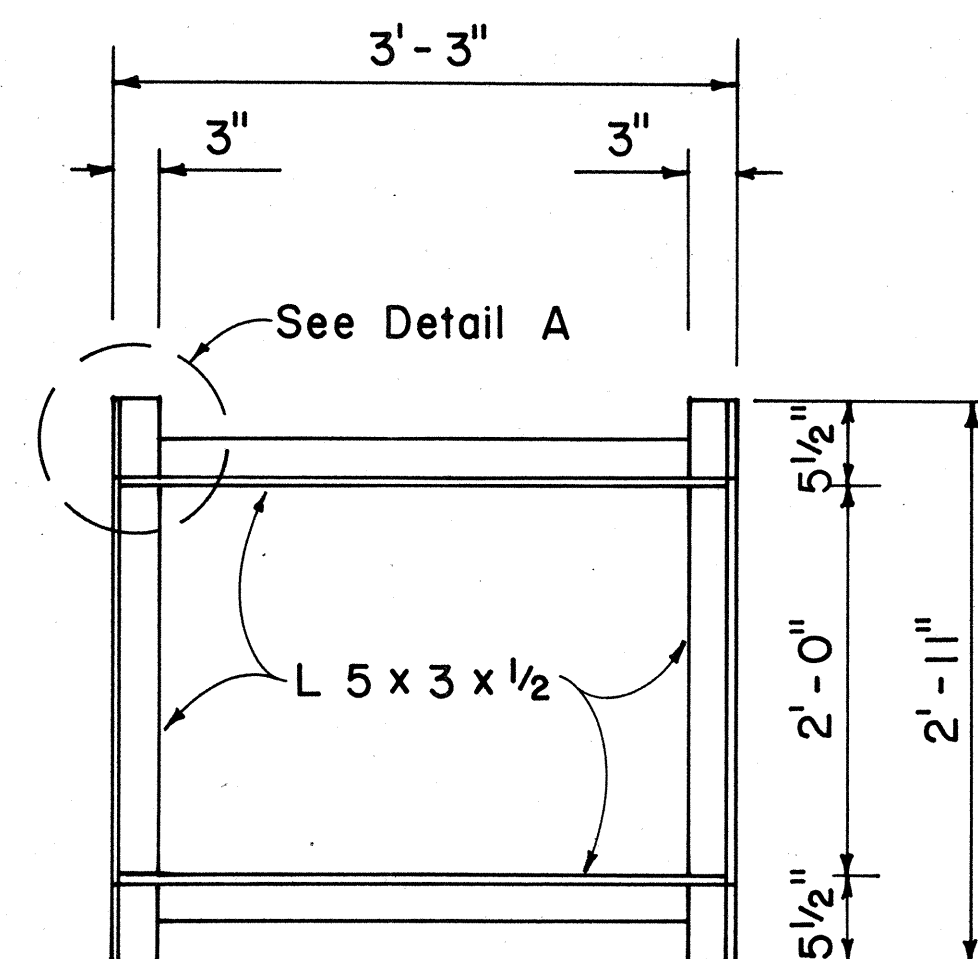


PLAN
(Single Grate)

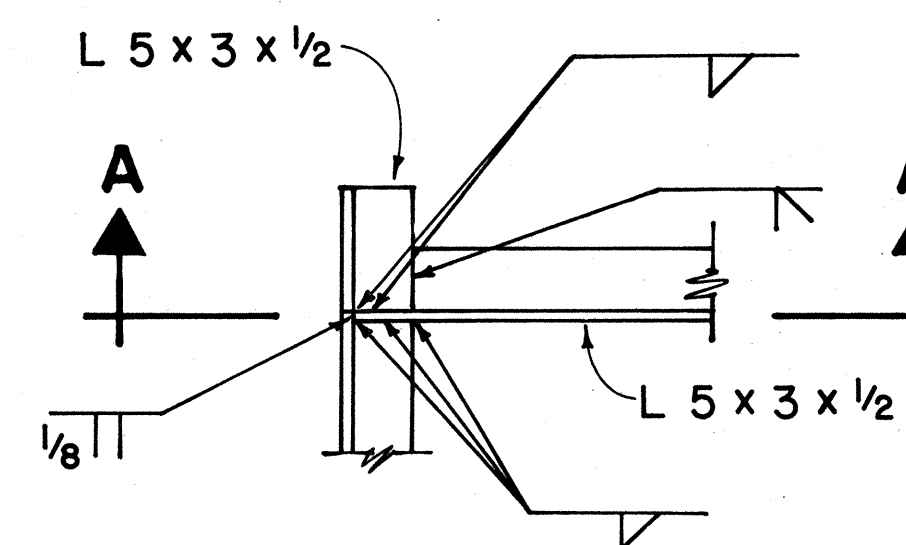


DETAIL A

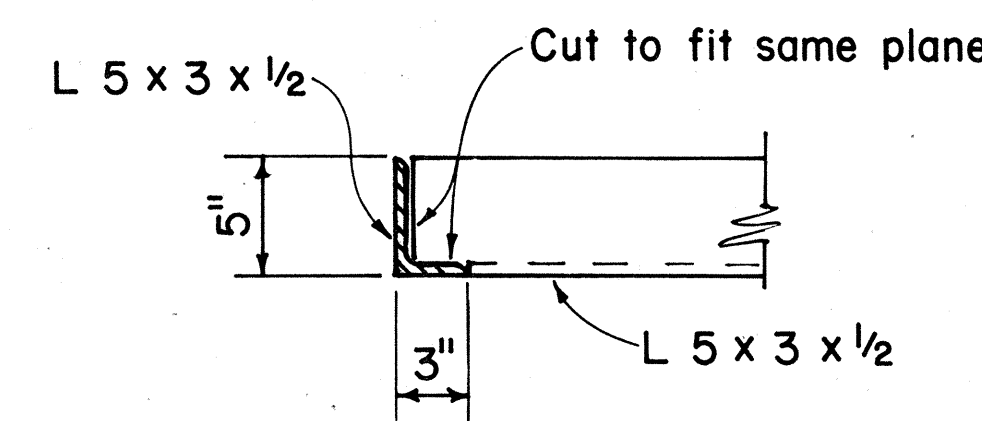

SECTION A-A

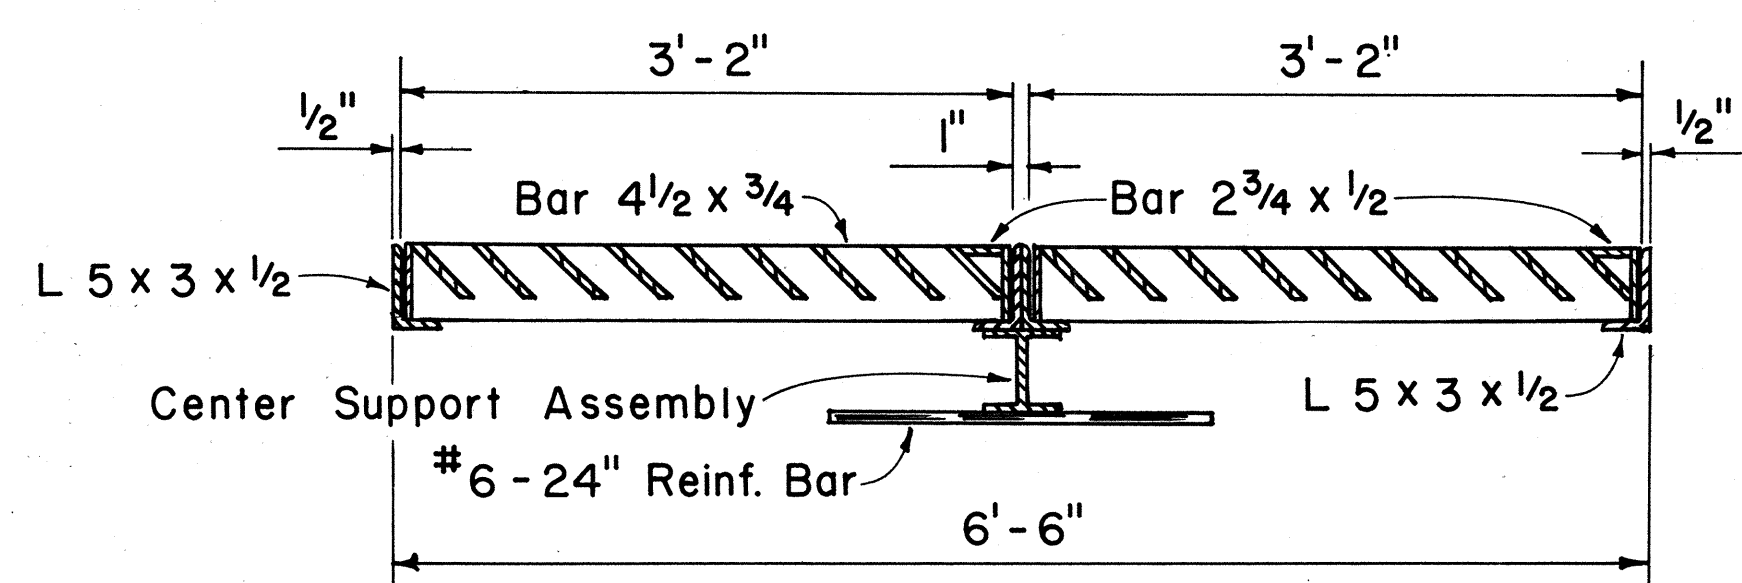


LONGITUDINAL SECTION
(Thru Frame & Grate)

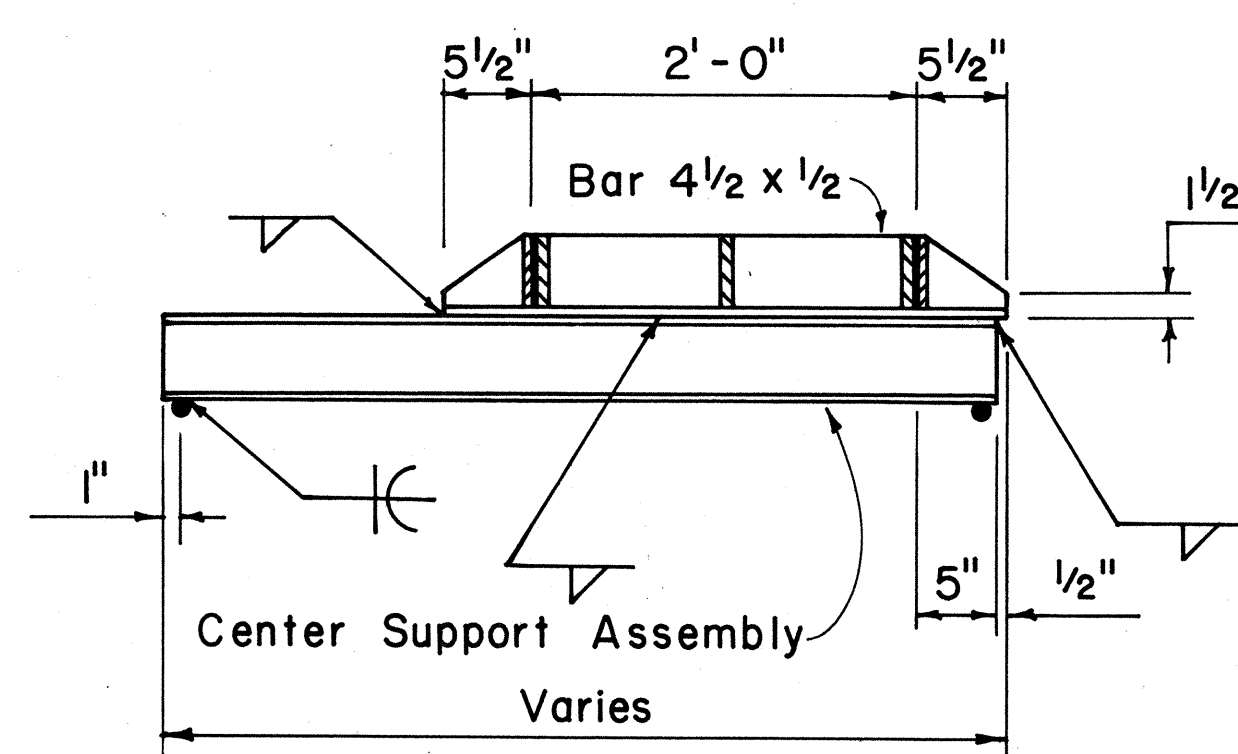


CROSS SECTION
(Thru Frame & Grate)

FRAME DETAILS

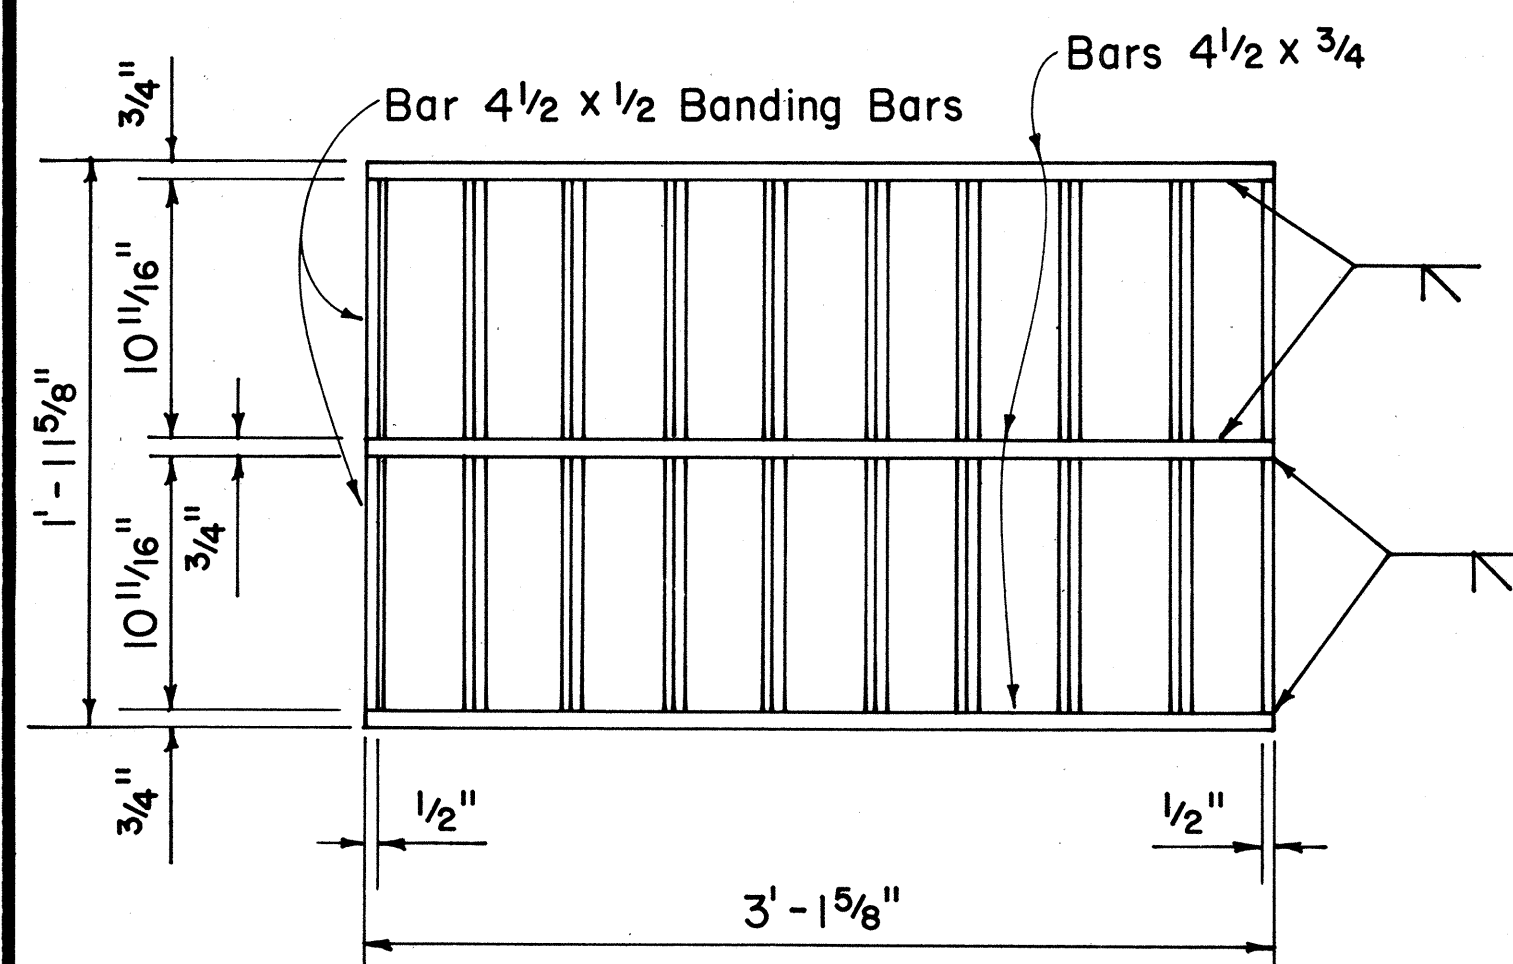

PLAN

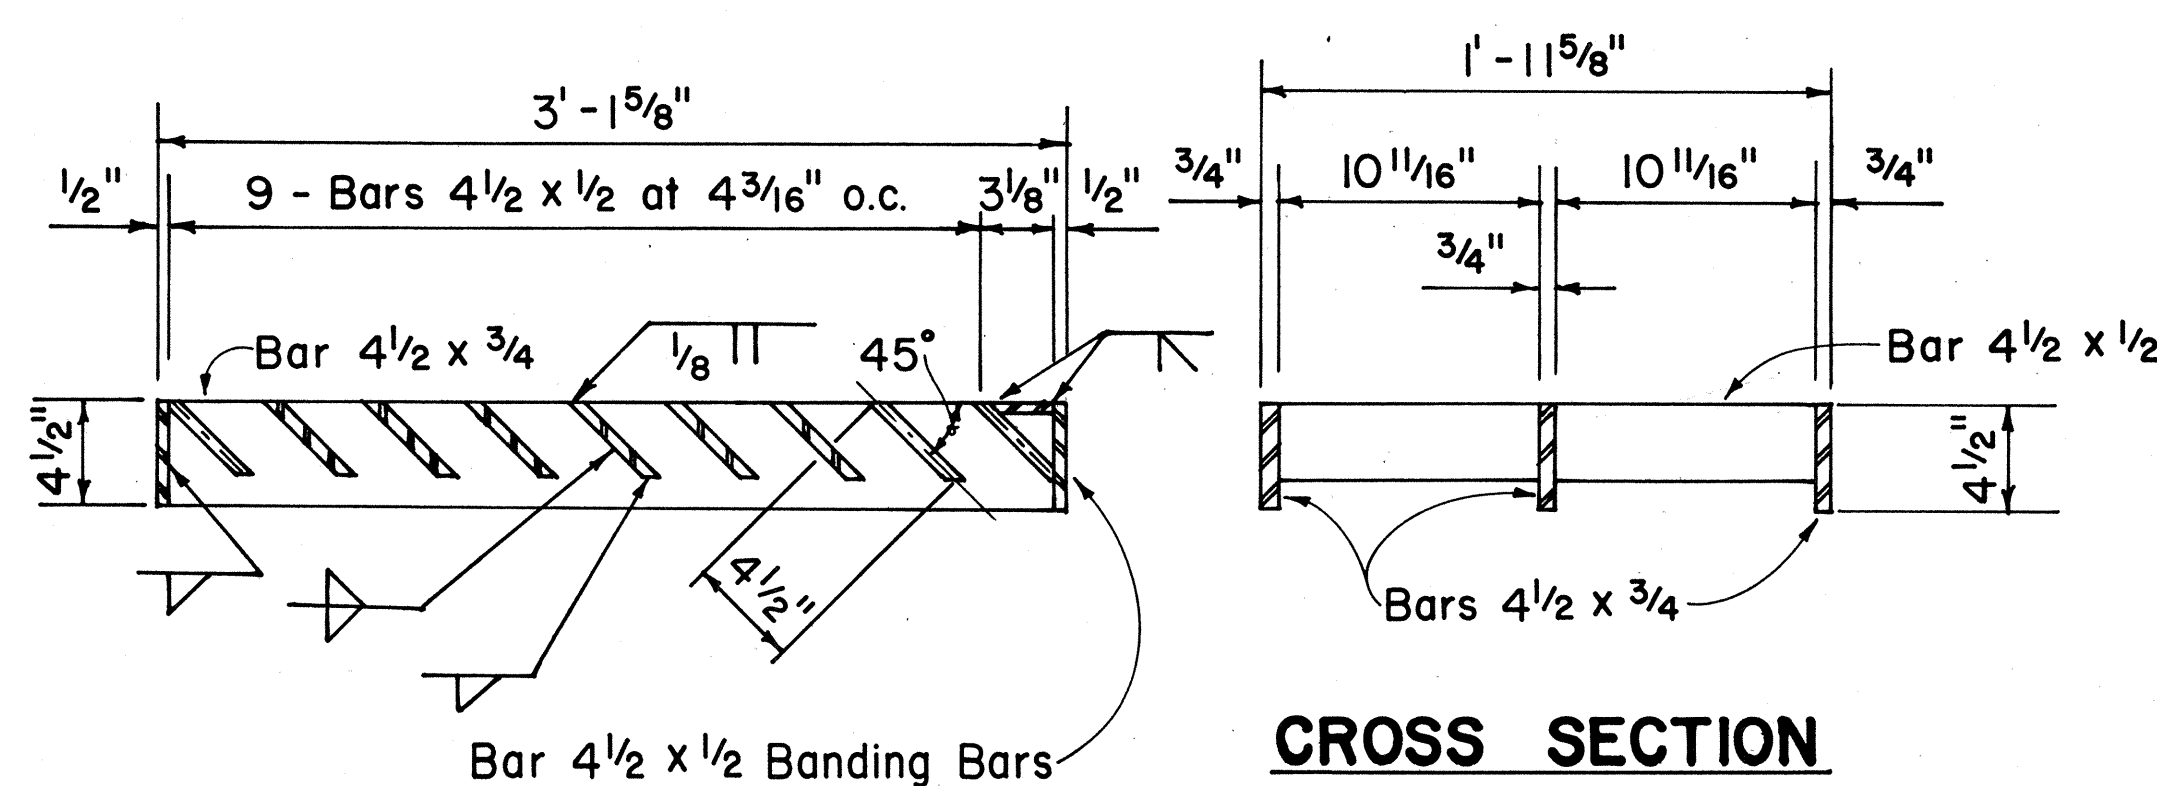

LONGITUDINAL SECTION

CROSS SECTION

GRATE DETAILS

APPROVAL RECOMMENDED:

 HYDRAULIC DESIGN ENGINEER DATE 2/4/83
 APPROVED:

 ASSISTANT CHIEF, ENGINEERING DATE 2-4-83


NO.	REVISION	APPROVED BY	DATE

STATE OF HAWAII DEPARTMENT OF TRANSPORTATION HIGHWAYS DIVISION	
STANDARD DETAILS TYPE A-9B FRAMES AND GRATES	
Not To Scale	Date: Feb. 1983
SHEET NO. D-20A OF D-25 SHEETS DH 7A	


FED. ROAD DIST. NO.	STATE	FED. AID PROJ. NO.	FISCAL YEAR	SHEET NO.	TOTAL SHEETS
HAWAII	HAW.	I-IR-HI-1(169):17	1983	67	280

GENERAL NOTES


1. All welds $\frac{5}{16}$ " unless otherwise noted.
2. Grates and Frames shall be hot dip galvanized after fabrication.
3. Use in locations off the road bed on all types of highway. (Bicycle Grates)

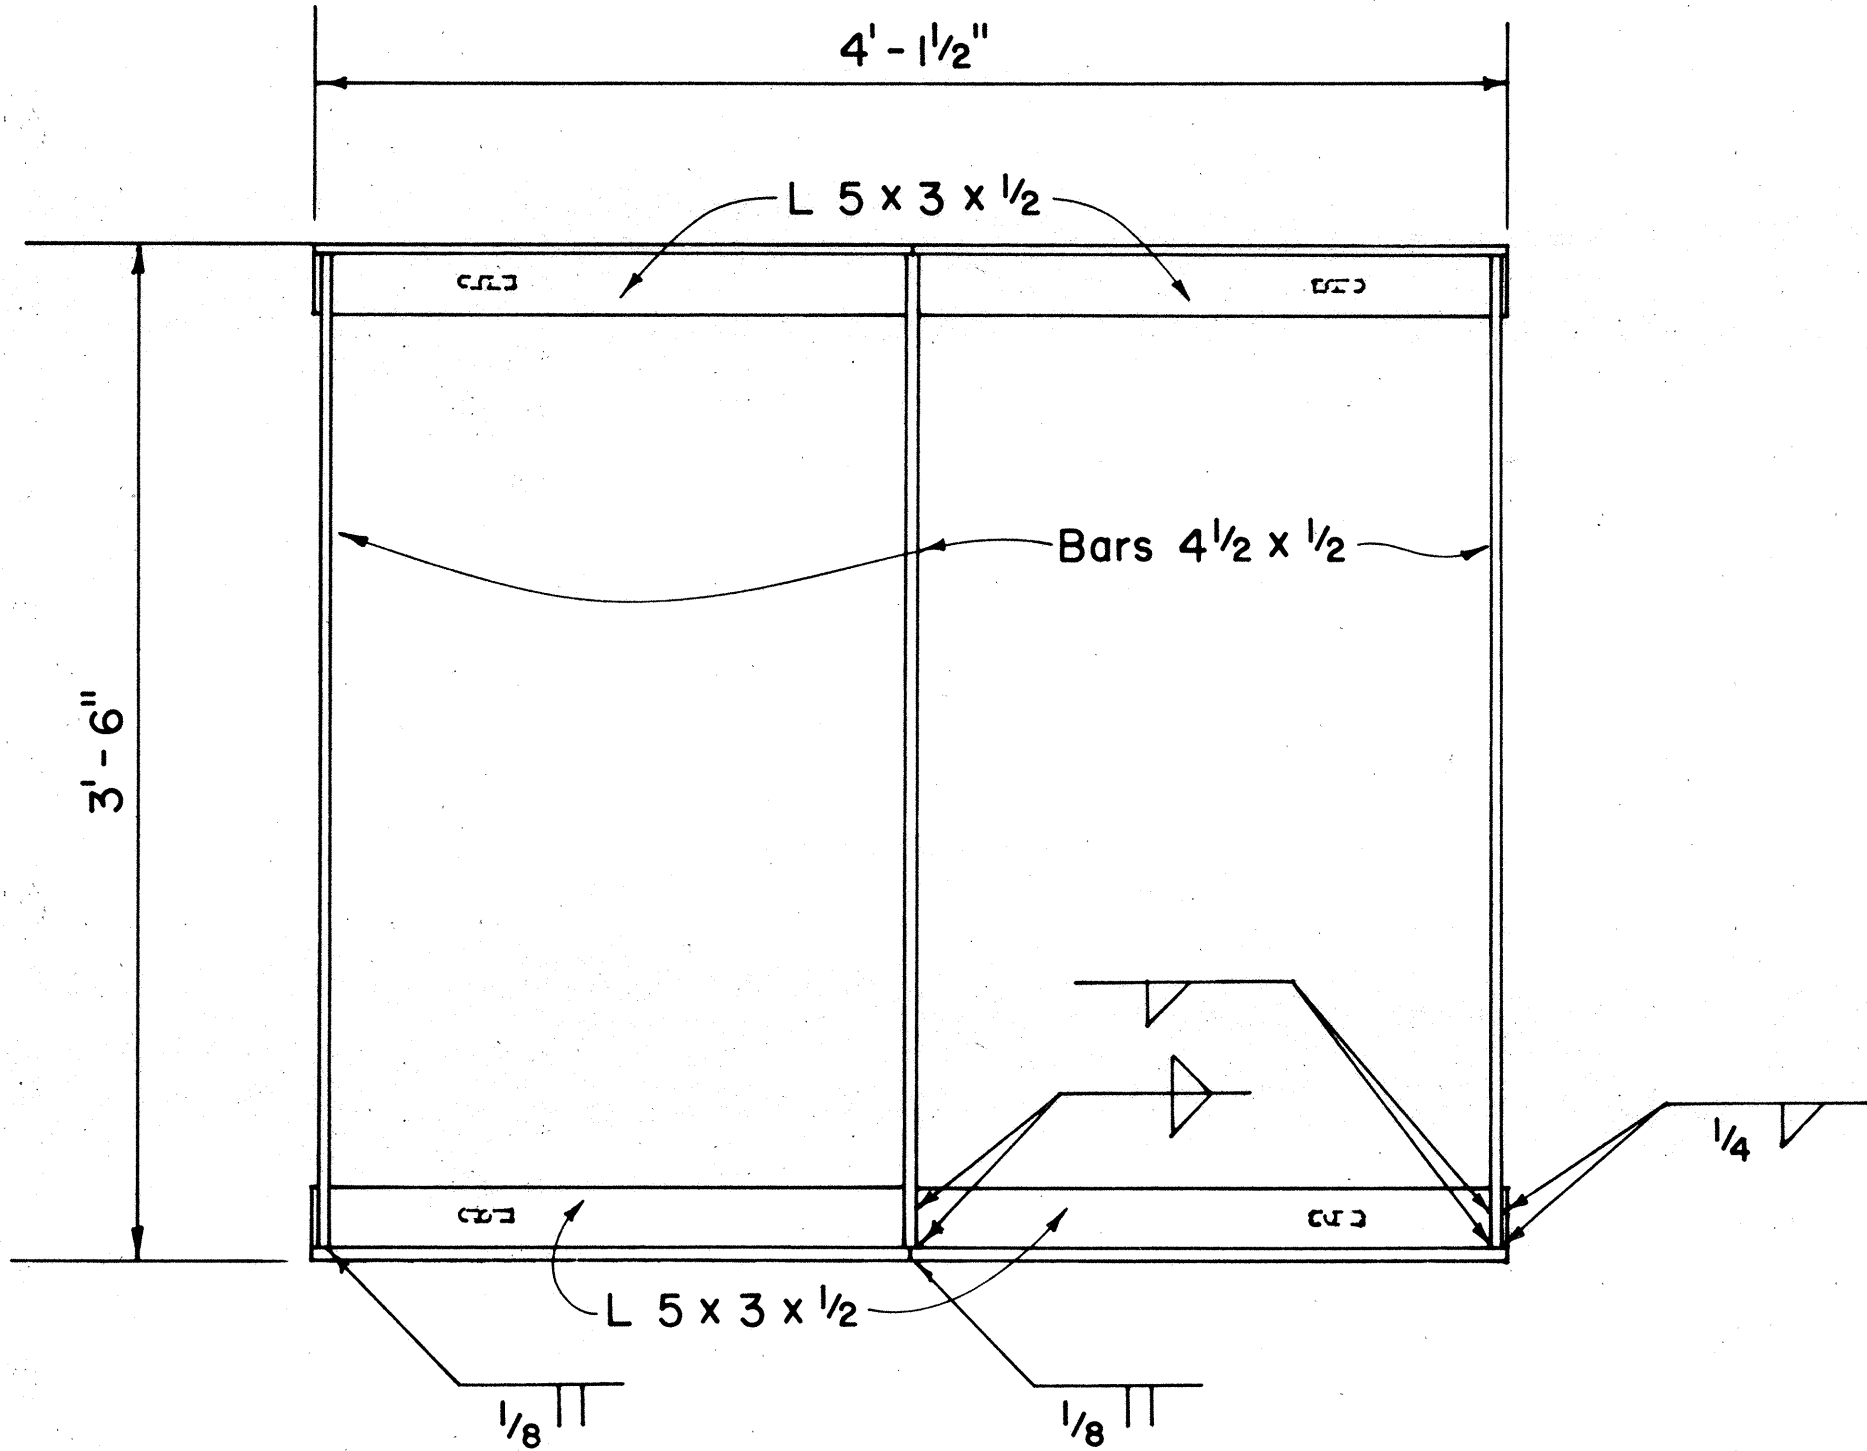


PLAN - FRAME

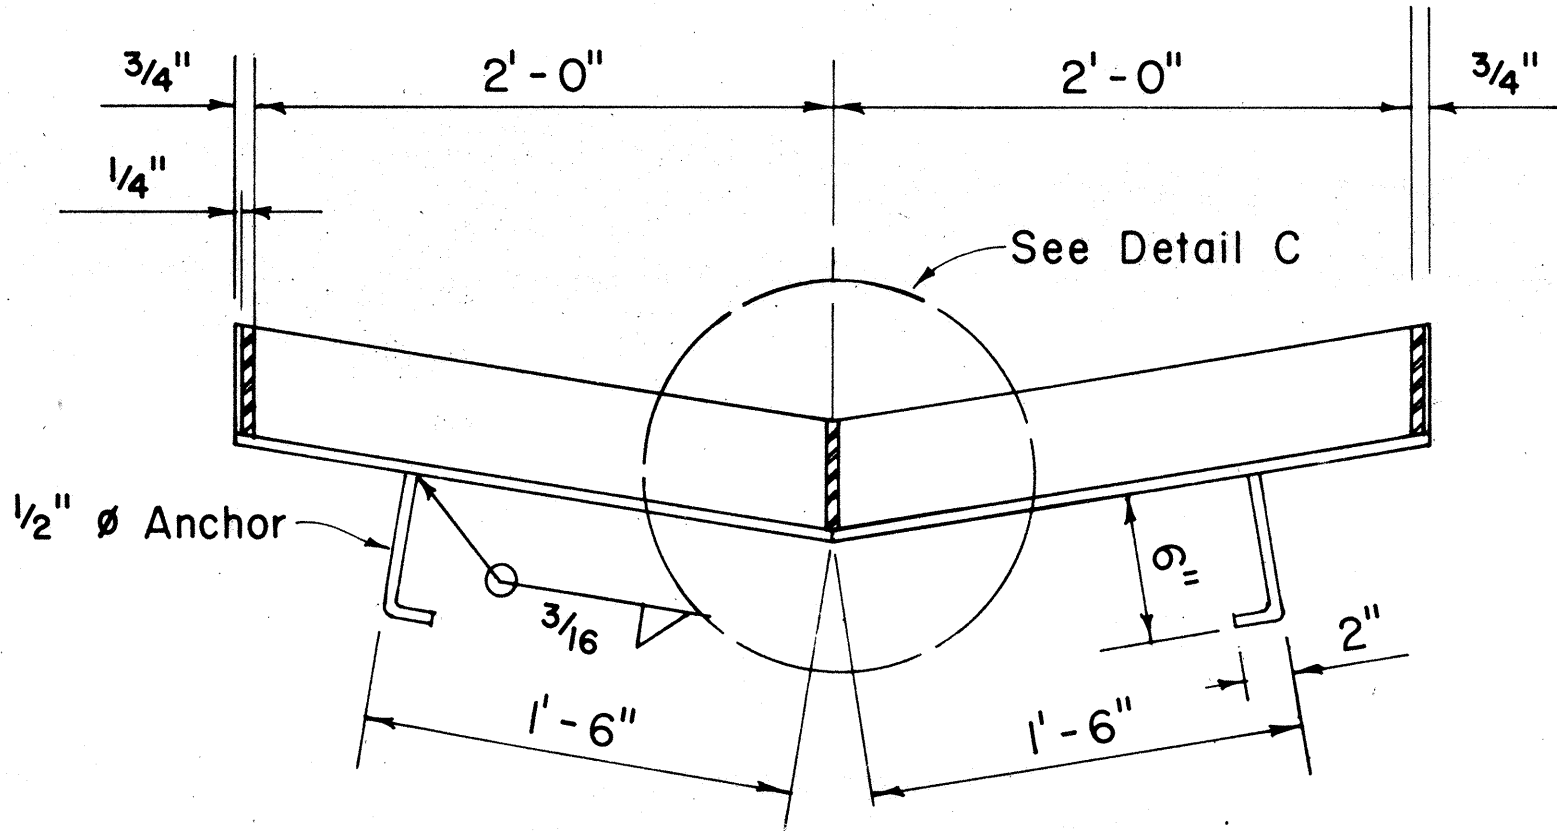


CROSS SECTION

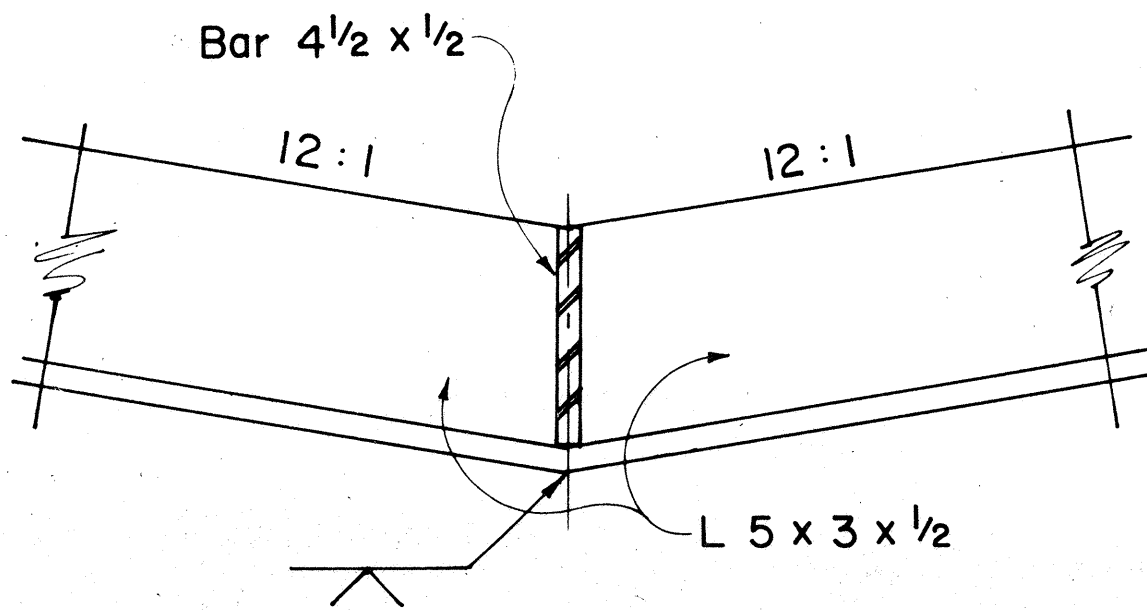


DETAIL C

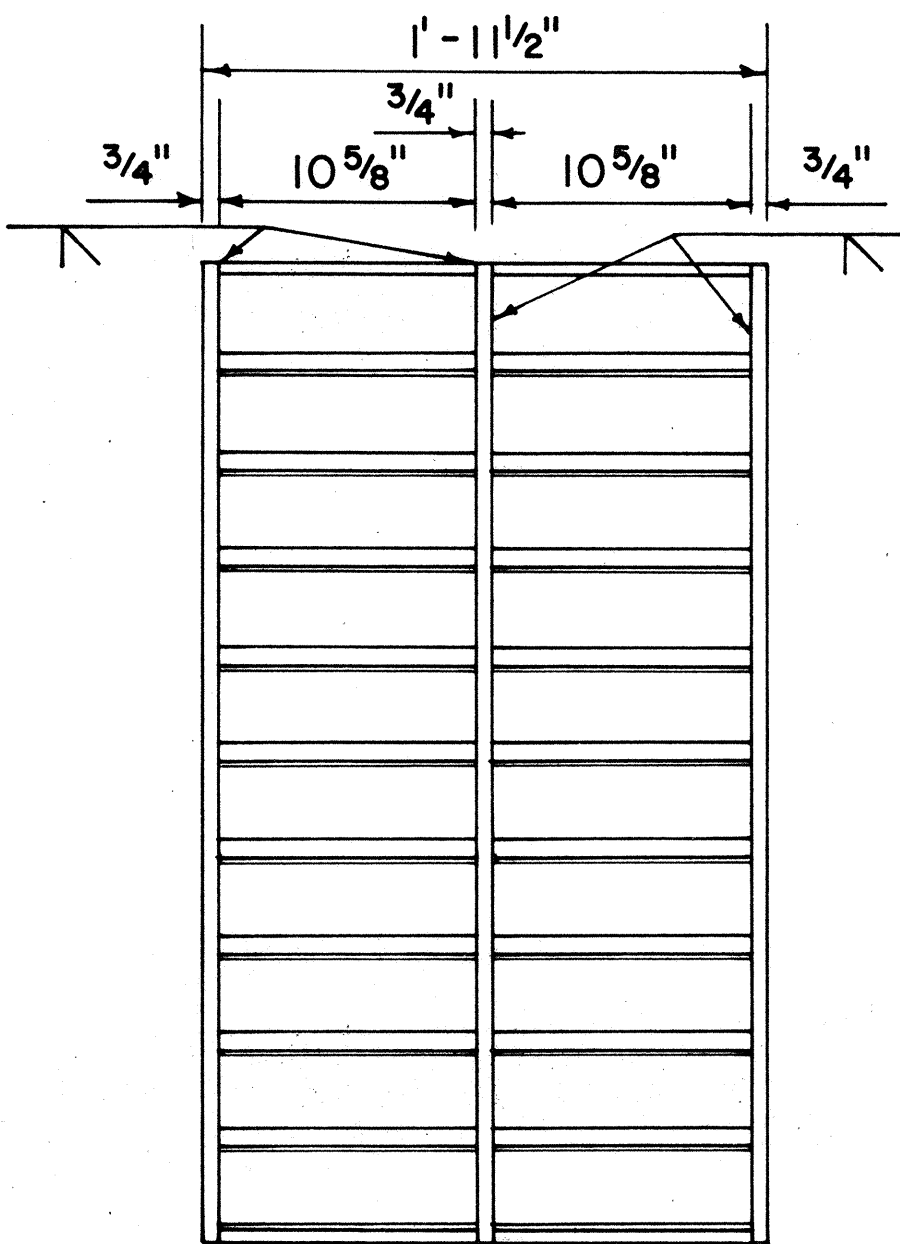

PLAN - GRATE

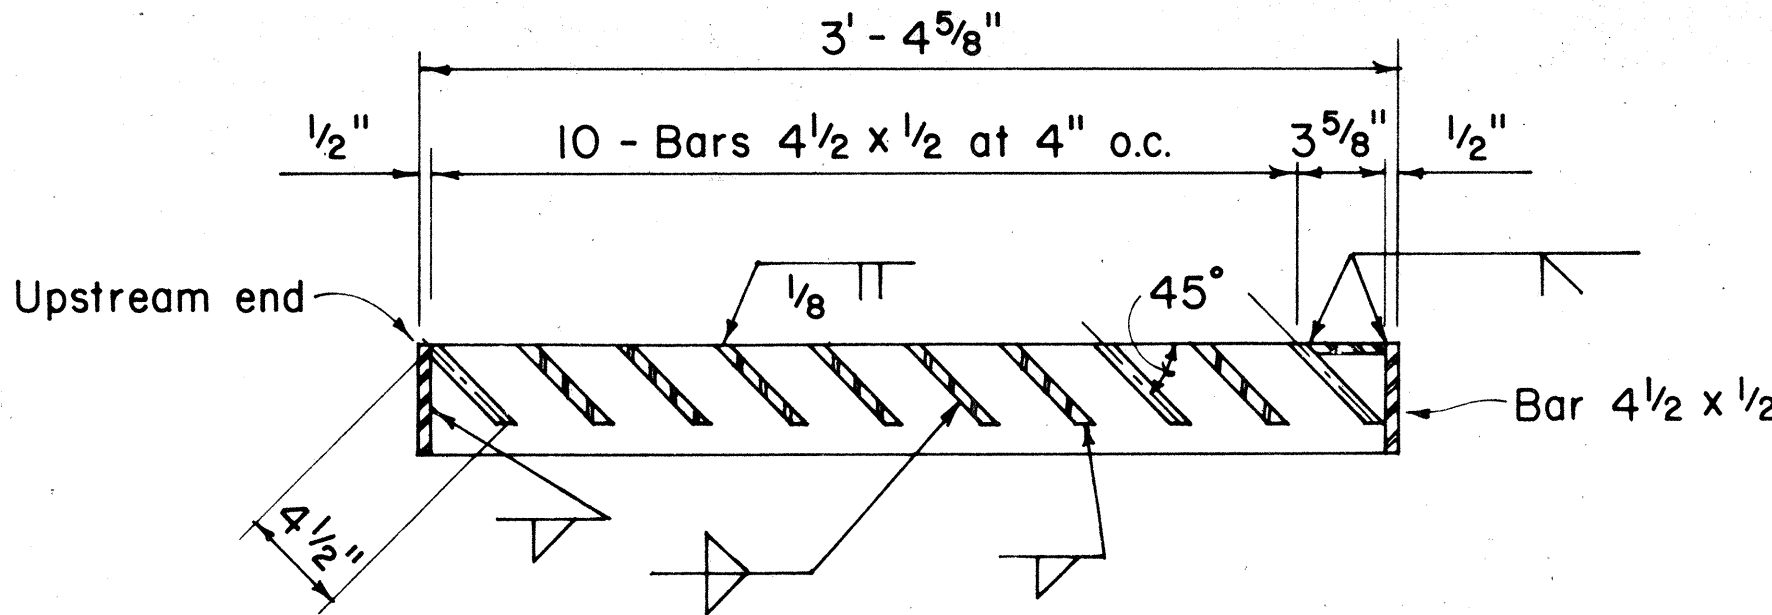

LONGITUDINAL SECTION

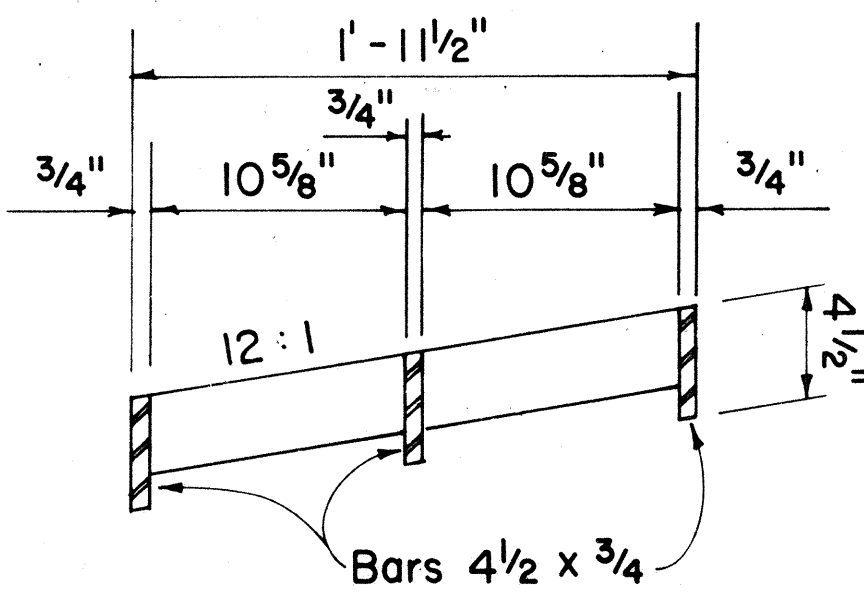


CROSS SECTION

NO.	REVISION	APPROVED BY	DATE

STATE OF HAWAII DEPARTMENT OF TRANSPORTATION HIGHWAYS DIVISION	
TYPE 1214 STEEL FRAME AND GRATES	
Not To Scale	Date: Feb. 1983

SHEET NO.D208OFD-25 SHEETS DH 8B

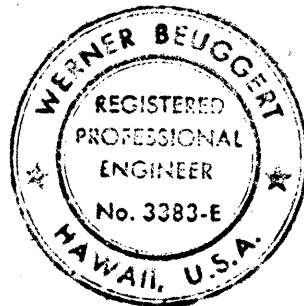


THIS WORK WAS PREPARED BY ME
ON UNDER MY SUPERVISION.

Werner Beugnot


TYPE 1214 FRAME AND GRATES

FED. ROAD DIST. NO.	STATE	FED. AID PROJ. NO.	FISCAL YEAR	SHEET NO.	TOTAL SHEETS
HAWAII	HAW.	11R-HH-1(69)-17	1983	68	280

Chamfer all exposed edges one inch

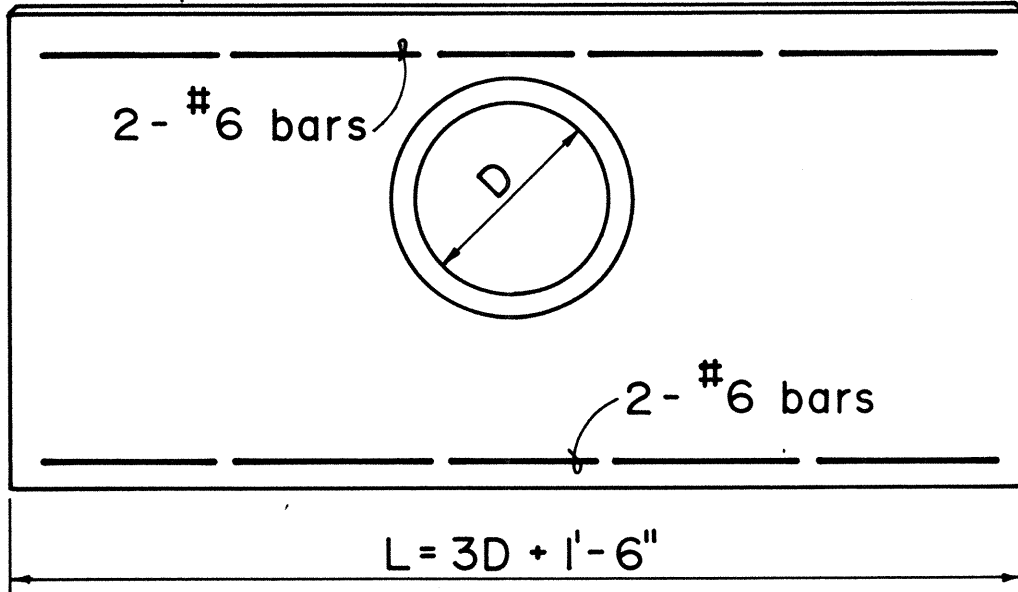

ELEVATION

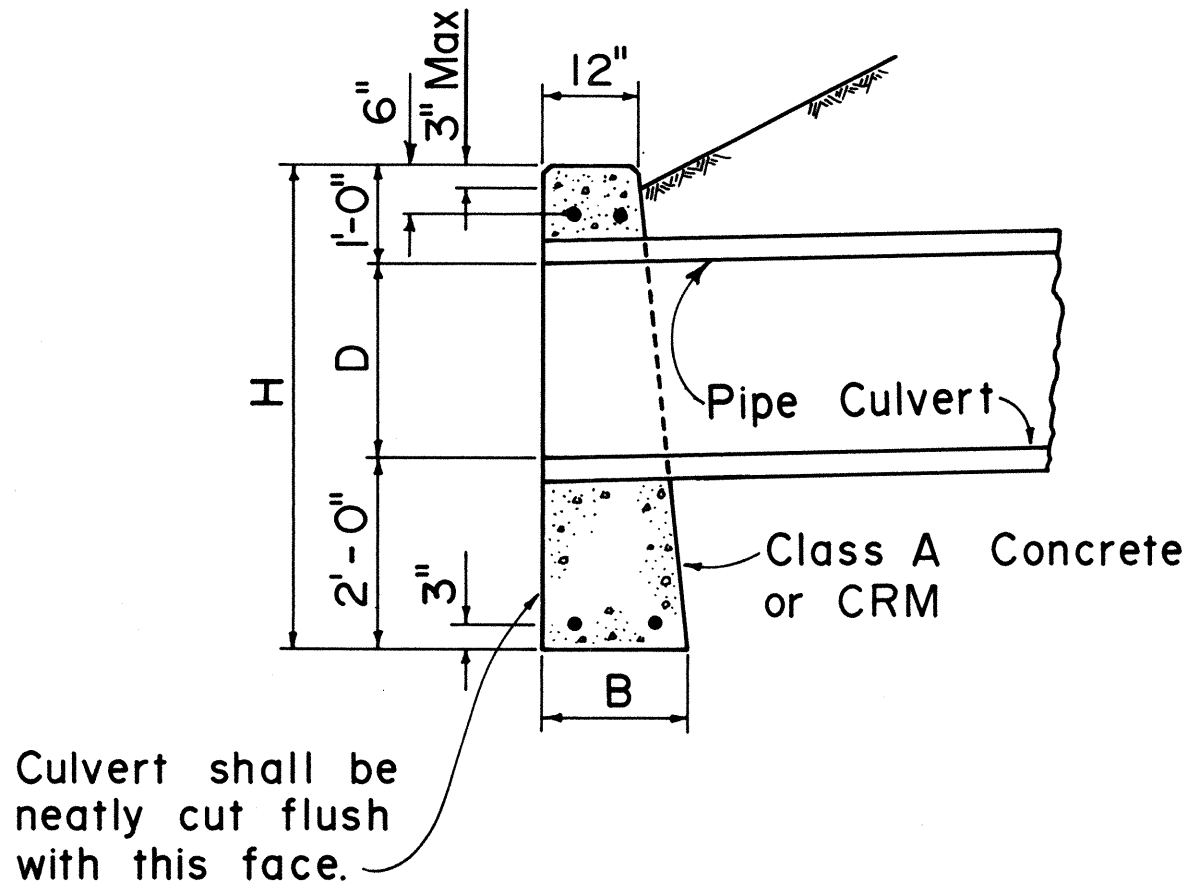

SECTION

DATA FOR CONC. HDWL.			
D	B	L	H
18"	1'-6"	6'-0"	4'-6"
24"	1'-6"	7'-6"	5'-0"
30"	2'-0"	9'-0"	5'-6"
36"	2'-0"	10'-6"	6'-0"
42"	2'-6"	12'-0"	6'-6"
48"	2'-6"	13'-6"	7'-0"

DATA FOR CRM HDWL.			
D	B	L	H
18"	1'-9"	6'-0"	4'-6"
24"	2'-0"	7'-6"	5'-0"
30"	2'-3"	9'-0"	5'-6"
36"	2'-6"	10'-6"	6'-0"

CONCRETE OR CRM HEADWALL

APPROVAL RECOMMENDED:
T. Nakano 6-19-79
 HYDRAULIC DESIGN ENGINEER DATE
 APPROVED:
Robert Zalewski 6-22-79
 ASSISTANT CHIEF, ENGINEERING DATE

NO.	REVISION	APPROVED BY	DATE
1.	Supersedes Sht. DH 10 approved 12-17-69	H.T.	6/22/79
2.	Change Class of concrete	H.T.	12/4/80

STATE OF HAWAII
 DEPARTMENT OF TRANSPORTATION
 HIGHWAYS DIVISION

STANDARD DETAILS
 CONCRETE OR CEMENT
 RUBBLE MASONRY HEADWALLS

Not To Scale
 Date: June 1979

SHEET No.D-21OFD-25SHEETS DH 10

SUMMARY

FED. ROAD DIST. NO.	STATE	FED. AID PROJ. NO.	FISCAL YEAR	SHEET NO.	TOTAL SHEETS
HAWAII	HAW.	1-IR-HI-1(69)-17	1983	69	280

[illegible]

ORIGINAL PLAN	SURVEY PLOTTED BY	DATE
NOTE BOOK	DRAWN BY	
	DESIGNED BY	
	QUANTITIES BY	
	CHECKED BY	
No.		

SUMMARY

FED. ROAD DIST. NO.	STATE	FED. AID PROJ. NO.	FISCAL YEAR	SHEET NO.	TOTAL SHEETS
HAWAII	HAW.	IR-HI-1(69)-17	1983	71	280

[illegible]

SHEET No.D-24 OF D-25 SHEETS

SUMMARY

FED. ROAD DIST. NO.	STATE	FED. AID PROJ. NO.	FISCAL YEAR	SHEET NO.	TOTAL SHEETS
HAWAII	HAW.	FIR-HH-1(16)-17	1983	72	280

[illegible]

SHEET No.D-25 OF D-25 SHEETS