


INDEX TO DRAWINGS	
SHEET NO.	DESCRIPTION
1	TITLE SHEET
2	CONSTRUCTION PHASING
3-4	TYPICAL ROADWAY SECTIONS
5-9	ALIGNMENT PLANS
10-15	RAMP TERMINAL & INTERSECTION DETAILS
16-27	ROADWAY PROFILES AND SUPERELEVATION DIAGRAMS
28-31	ROADWAY CONSTRUCTION PLANS
32-44	ROADWAY CONSTRUCTION DETAILS
45	EROSION CONTROL NOTES AND DETAILS
46-48	DRAINAGE AND GRADING PLANS
49-50	DRAINAGE PROFILES
51-72	DRAINAGE STRUCTURE DETAILS AND QUANTITIES SUMMARY
73-77	SIGNING AND PAVEMENT MARKING PLANS
78-97	SIGNING AND PAVEMENT MARKING DETAILS
97A, 98-109	OVERHEAD SIGN STRUCTURES
110-117	HIGHWAY LIGHTING AND TRAFFIC SIGNAL PLANS AND DETAILS
118-134	UTILITY PLANS AND DETAILS
135-143	BORING LOCATION AND LOGS
144-157	H-1 VIADUCT (E.B.) & RAMP C
158-176	RAMP A & RAMP B STRUCTURE
207-242, 242A	DILLINGHAM BLVD. BRIDGE WIDENING
242B, 242C	SIDEWALK AND MEDIAN ON RAMP D & G
243-259	STRUCTURAL STANDARD DETAILS
260	CROSS SECTION KEY SHEET
261-276	CROSS SECTIONS

- ① C.O.285-1, C.O.295-1, C.O.295-2.
② 1205-1, 1205-2, 1205-3, C.O.2225-1, C.O.2295-1.
③ C.O.1355-1.
④ 1595-1.
⑤ 1855-1, C.O.2065-1, C.O.2065-2.

NEW TOTAL = 293

STATE OF HAWAII
DEPARTMENT OF TRANSPORTATION
HIGHWAYS DIVISION
HONOLULU, HAWAII
"AS-BUILT"
PLANS FOR
CONSTRUCTION OF A PORTION OF
INTERSTATE ROUTE H-1
KEEHI INTERCHANGE
MIDDLE STREET AND DILLINGHAM BOULEVARD
FEDERAL AID INTERSTATE PROJECT NO. I-IR-HI-1(169):17

DISTRICT OF HONOLULU
ISLAND OF OAHU

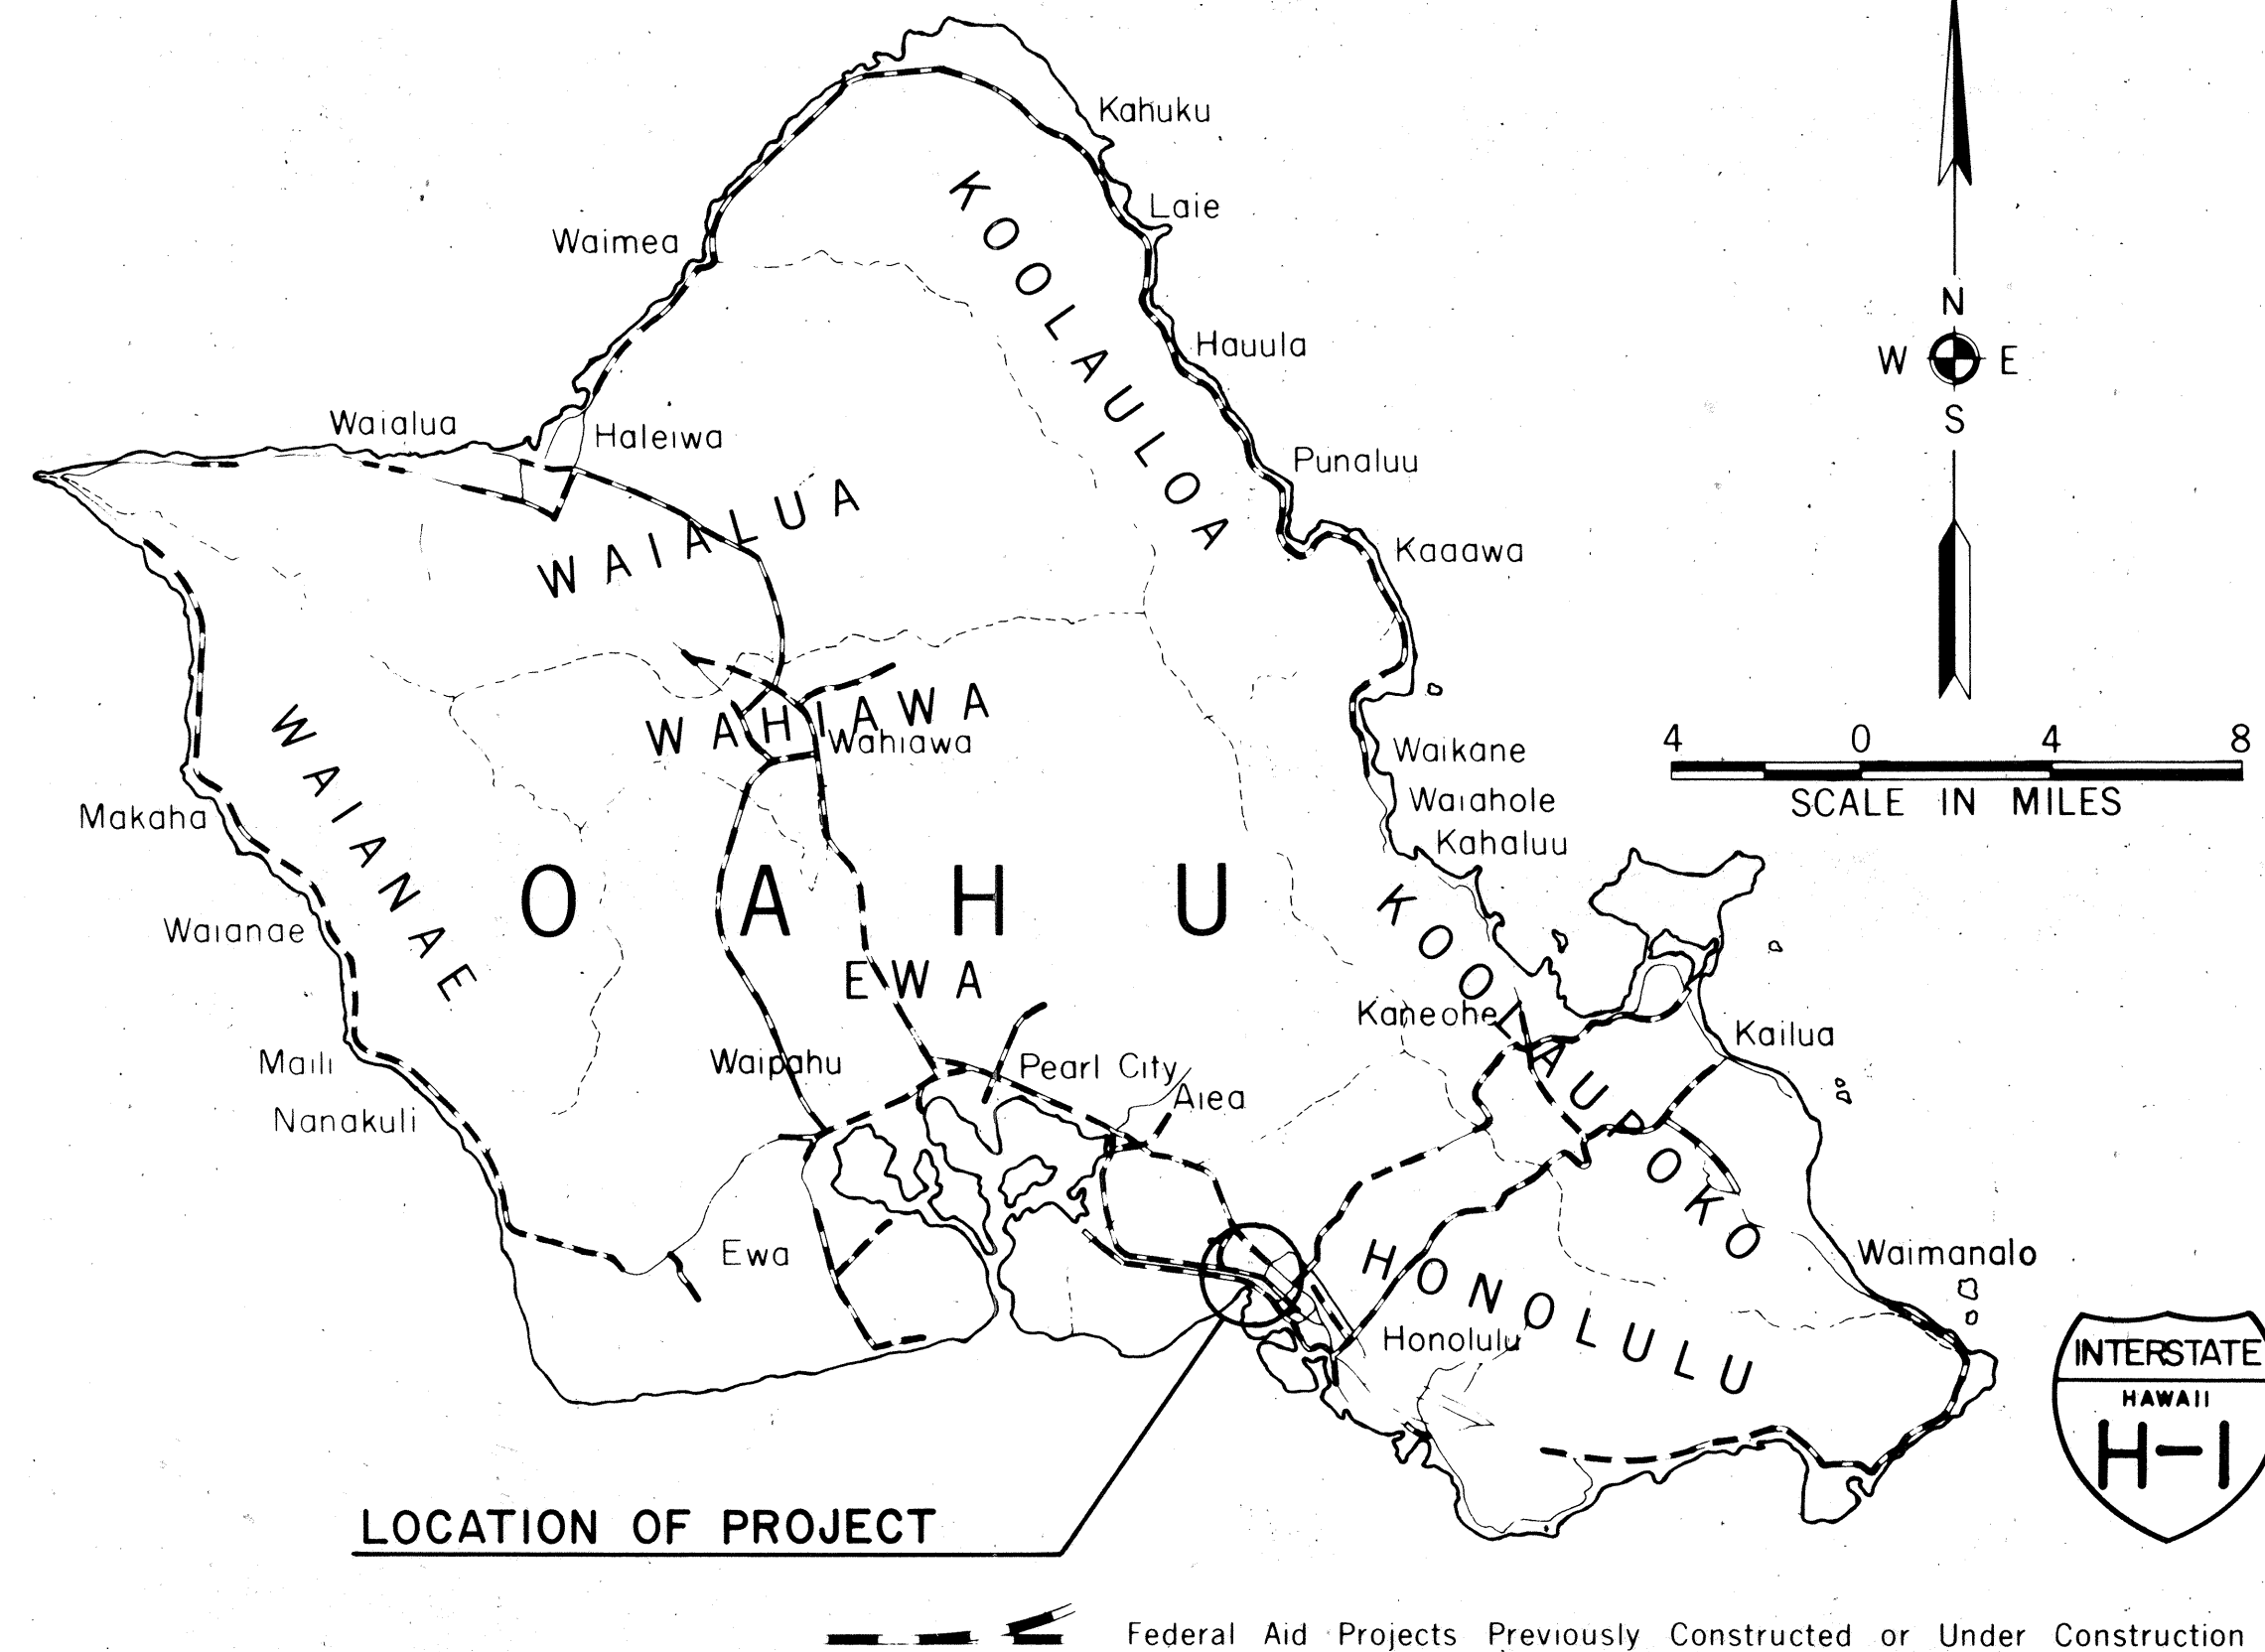

DESIGN CLASSIFICATION

DESIGN ADT (1994).....98,000
DHV.....10,800
D.....60/40
T.....5%
V.....60 MPH


CHANGES MADE DURING CONSTRUCTION HAVE BEEN INCORPORATED ON THESE PLANS EXCEPT CHANGES IN THE ORIGINAL THEORETICAL QUANTITIES. FOR ACTUAL QUANTITIES, REFER TO PROJECT LEDGER AND/OR COMPUTATION BOOK.

Melana B. Low
RESIDENT ENGINEER

12-28-88
DATE

DEPARTMENT OF TRANSPORTATION
FEDERAL HIGHWAY ADMINISTRATION
APPROVED:
W. H. H. H.
DIVISION ADMINISTRATOR
9/20/83
DATE

DEPARTMENT OF TRANSPORTATION
STATE OF HAWAII
APPROVED:
R. Higashimura
DIR. OF TRANSPORTATION
9/12/83
DATE

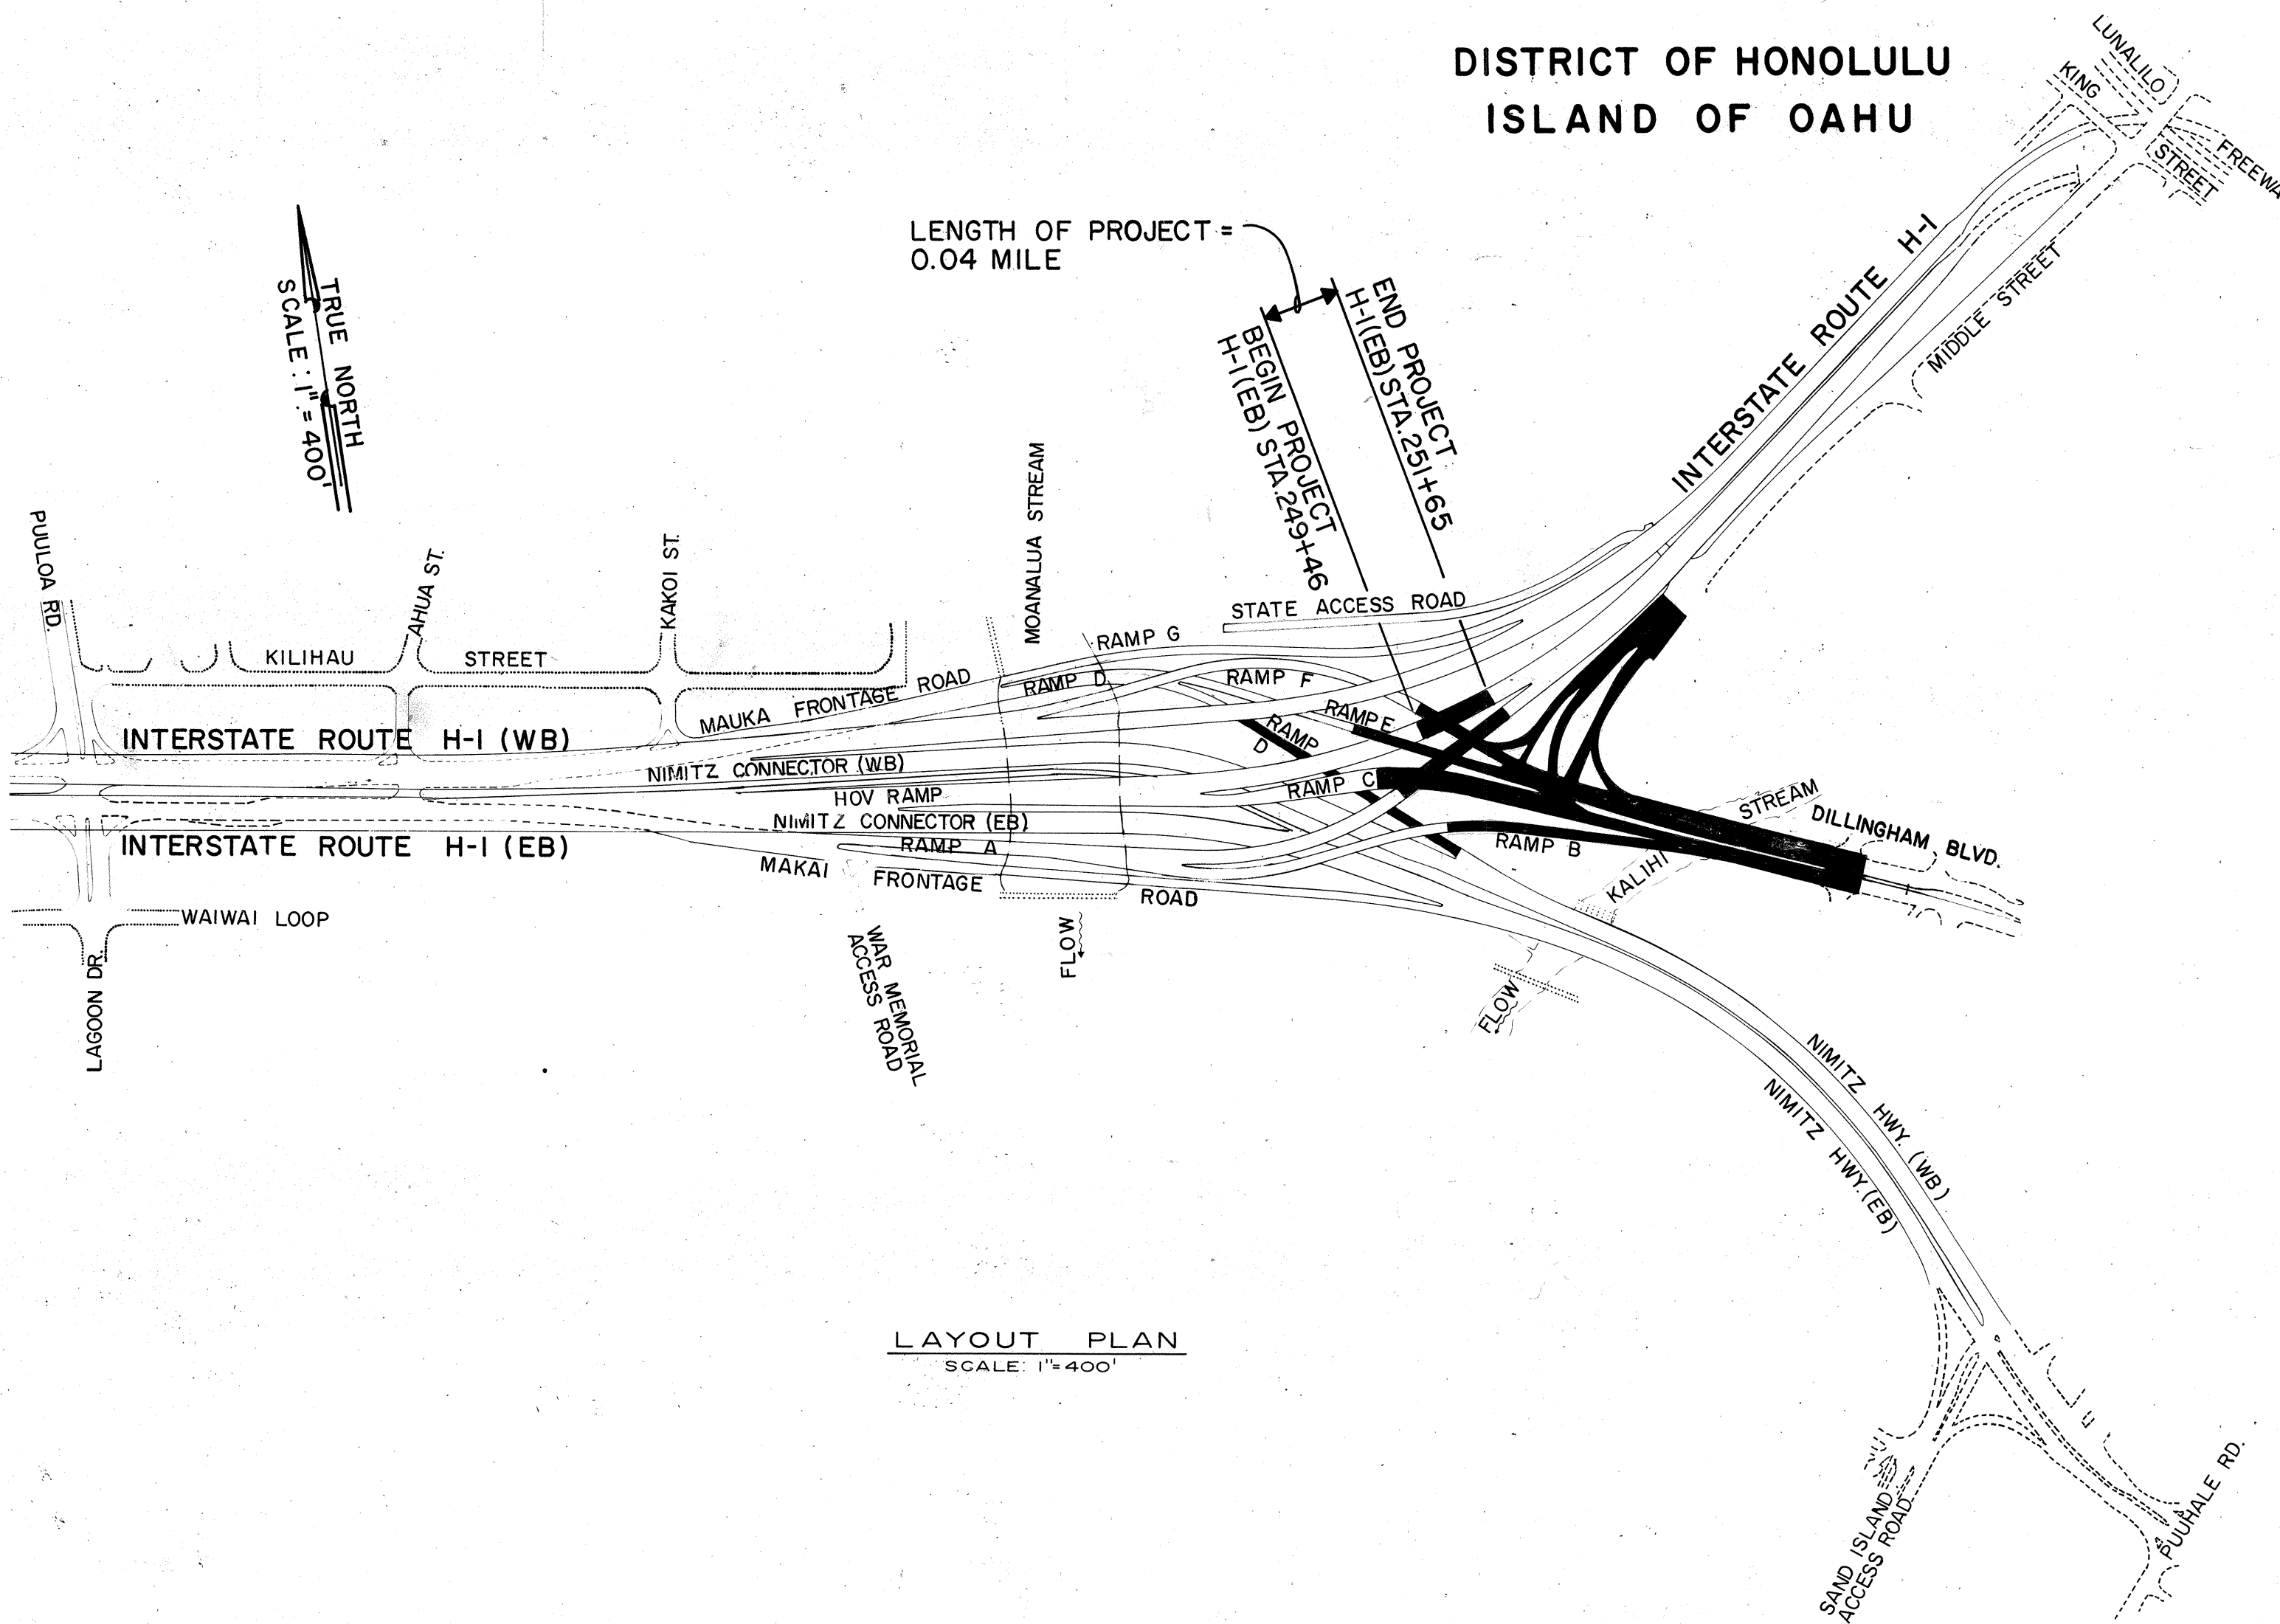

PARSONS BRINCKERHOFF-
HIROTA ASSOCIATES
DESIGNED BY
PAUL WOLF
P S & E BY
521-3051
PHONE
3/18/83
DATE