



FED. ROAD DIST. NO.	STATE	FED. AID PROJ. NO.	FISCAL YEAR	SHEET NO.	TOTAL SHEETS
HAWAII	HAW.	IR-HI-1(69)17	1983	3	280

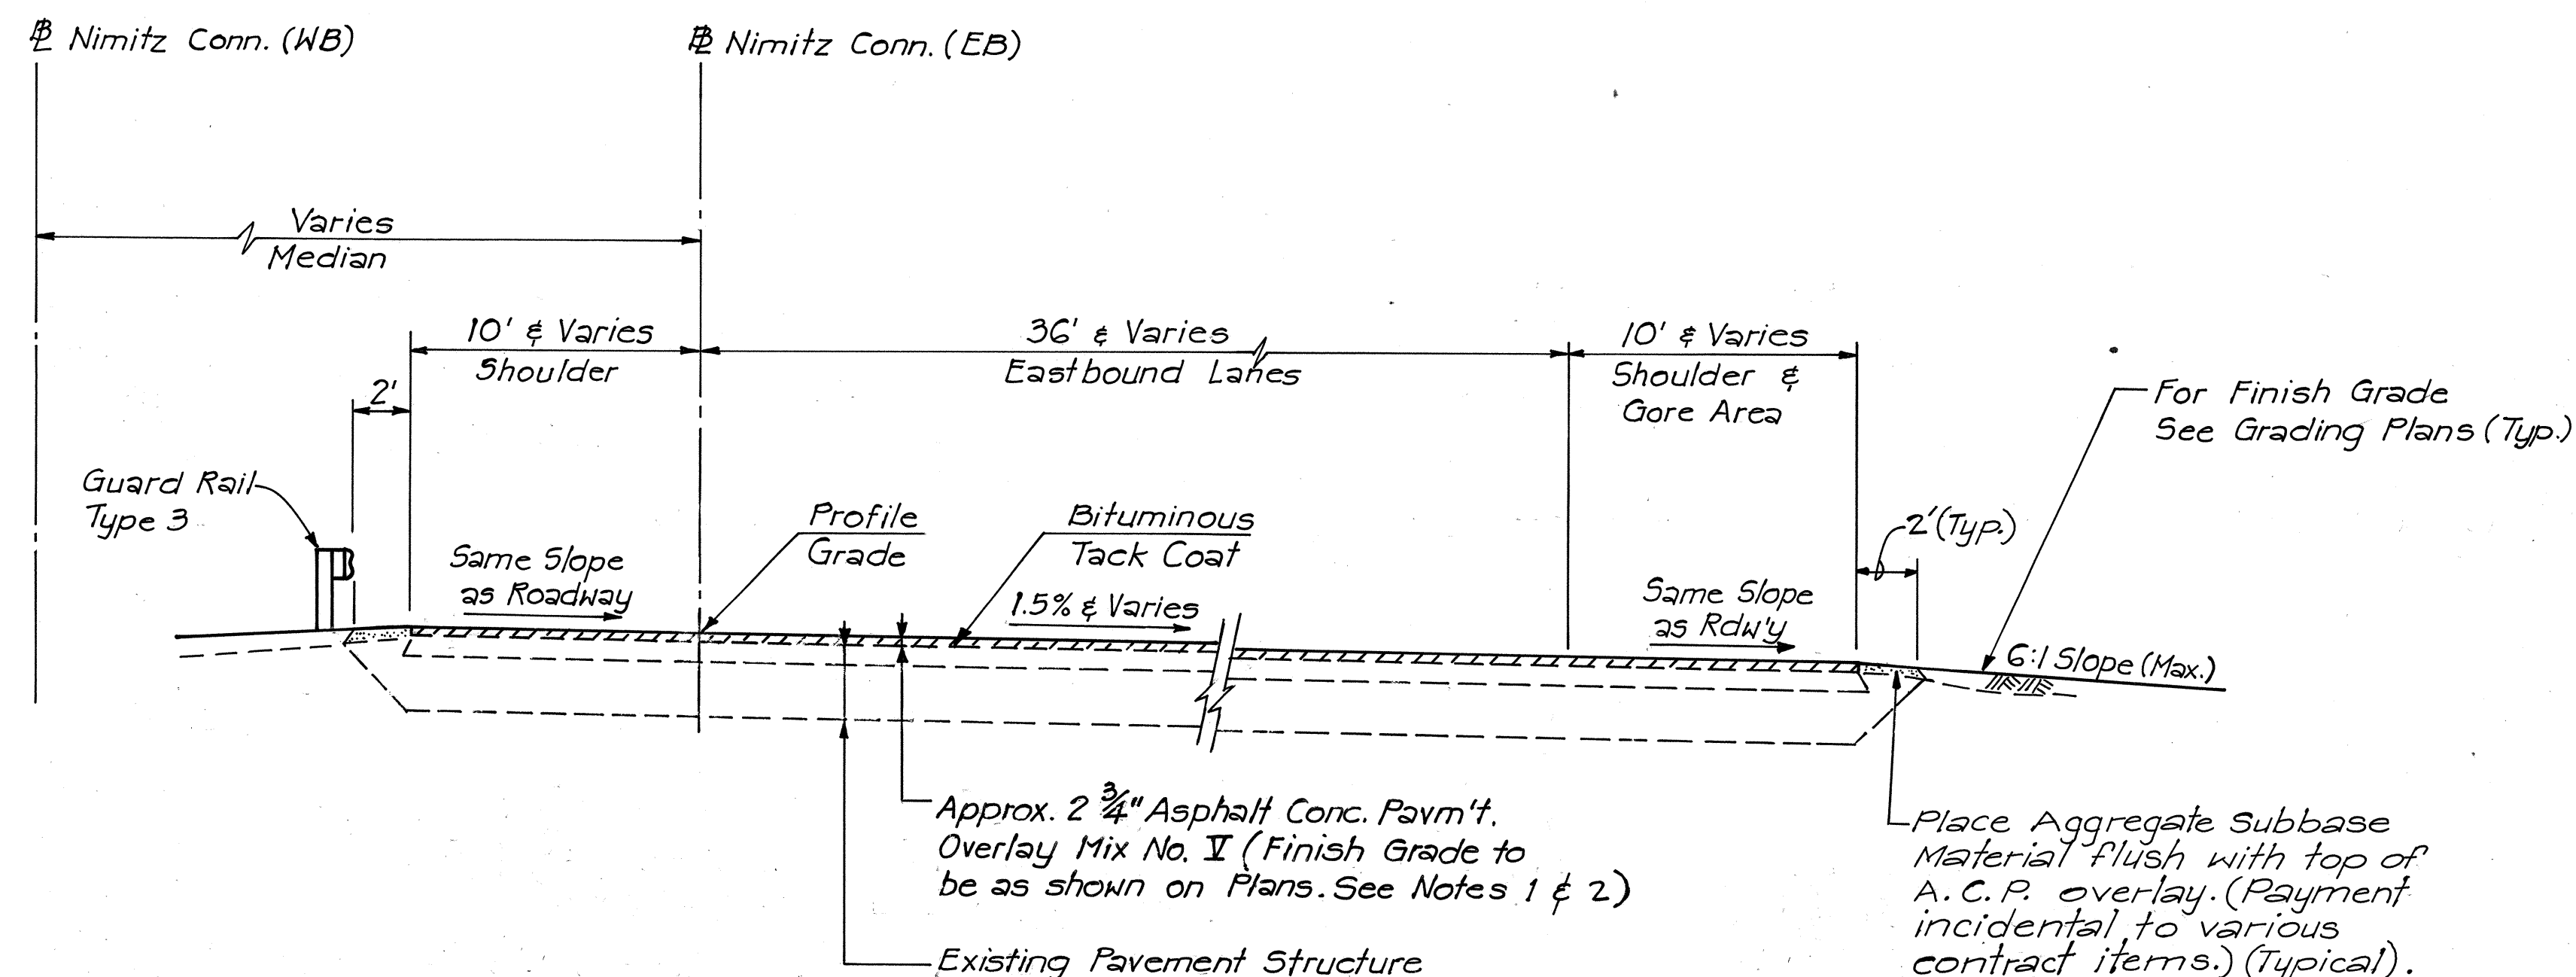

NOTE: Pavement Structure for Nimitz Conn. (WB) Roadway is similar to the one shown for Nimitz Conn. (EB) Roadway.


TYPICAL SECTION - NIMITZ CONNECTORS

Scale: 1" = 5'

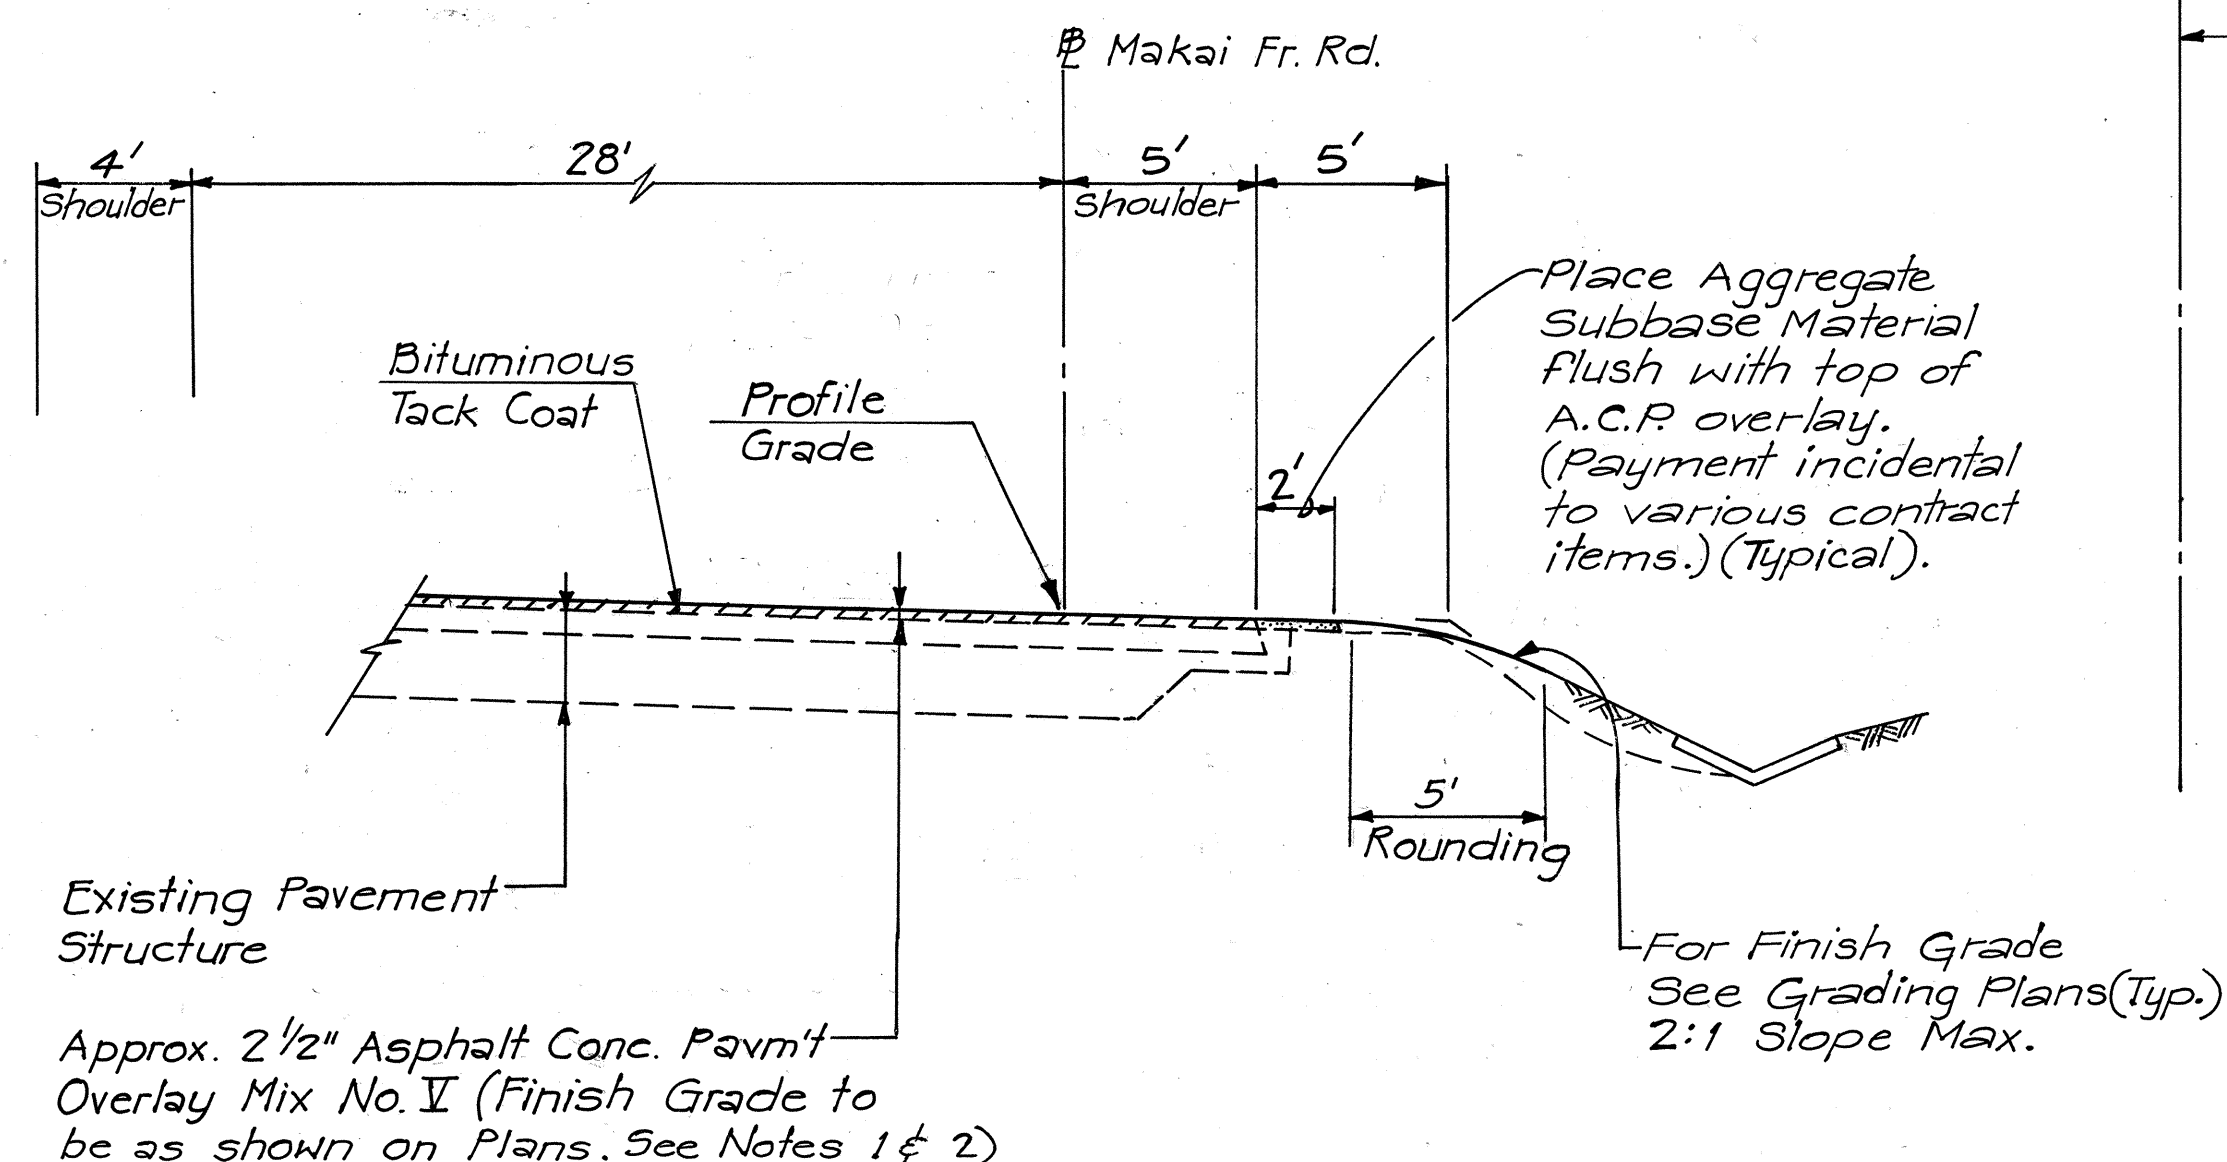

TYPICAL SECTION - MAKAI FRONTAGE ROAD

Scale: 1" = 5'

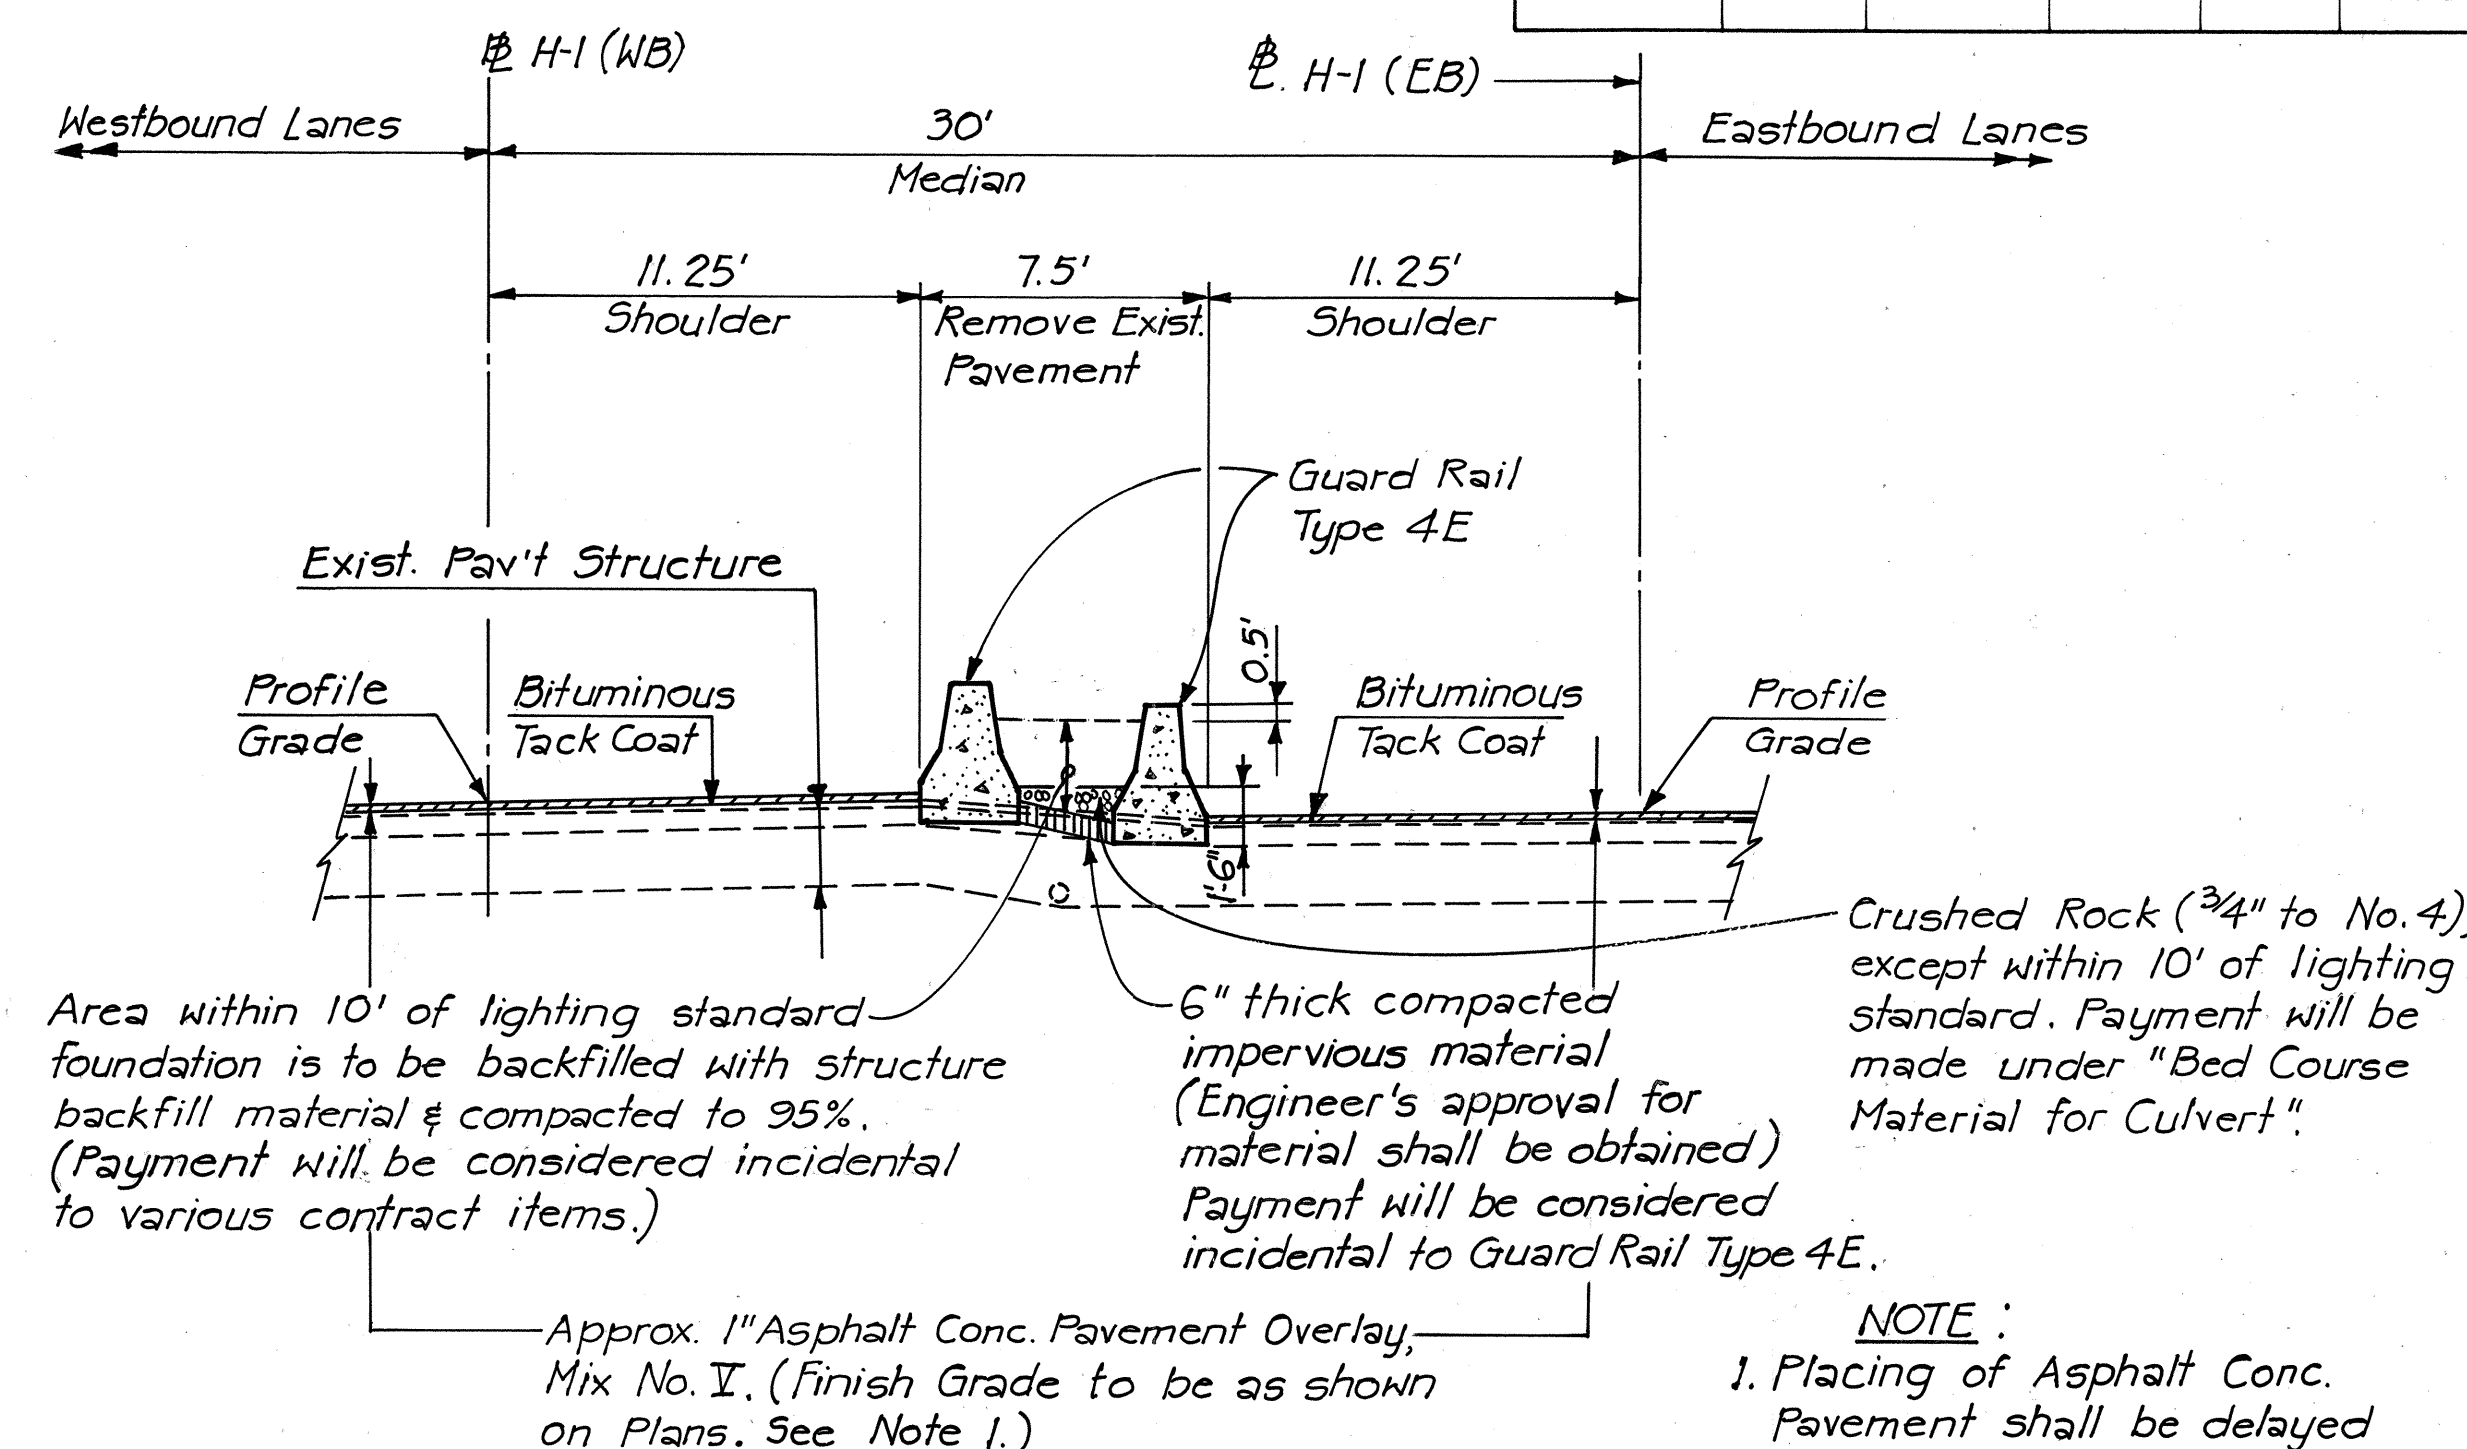


MEDIAN - INTERSTATE ROUTE H-1

From H-1 (WB) Sta. 261+50 to 264+50

Scale: 1" = 5'


- NOTE:
1. Placing of Asphalt Conc. Pavement shall be delayed until final pavement markings are to be installed.
 2. Where the pavement overlay exceeds the indicated thickness as a result of ground settlements, the overlay shall be as follows, unless otherwise directed by the Engineer:
 - a) Where overlay thickness is equal or less than 5":
A.C. Pavement Mix No. II.
 - b) Where overlay thickness exceeds 5":
Asphalt Concrete Base (thickness varies)
2" Asphalt Concrete Pavement Mix No. II

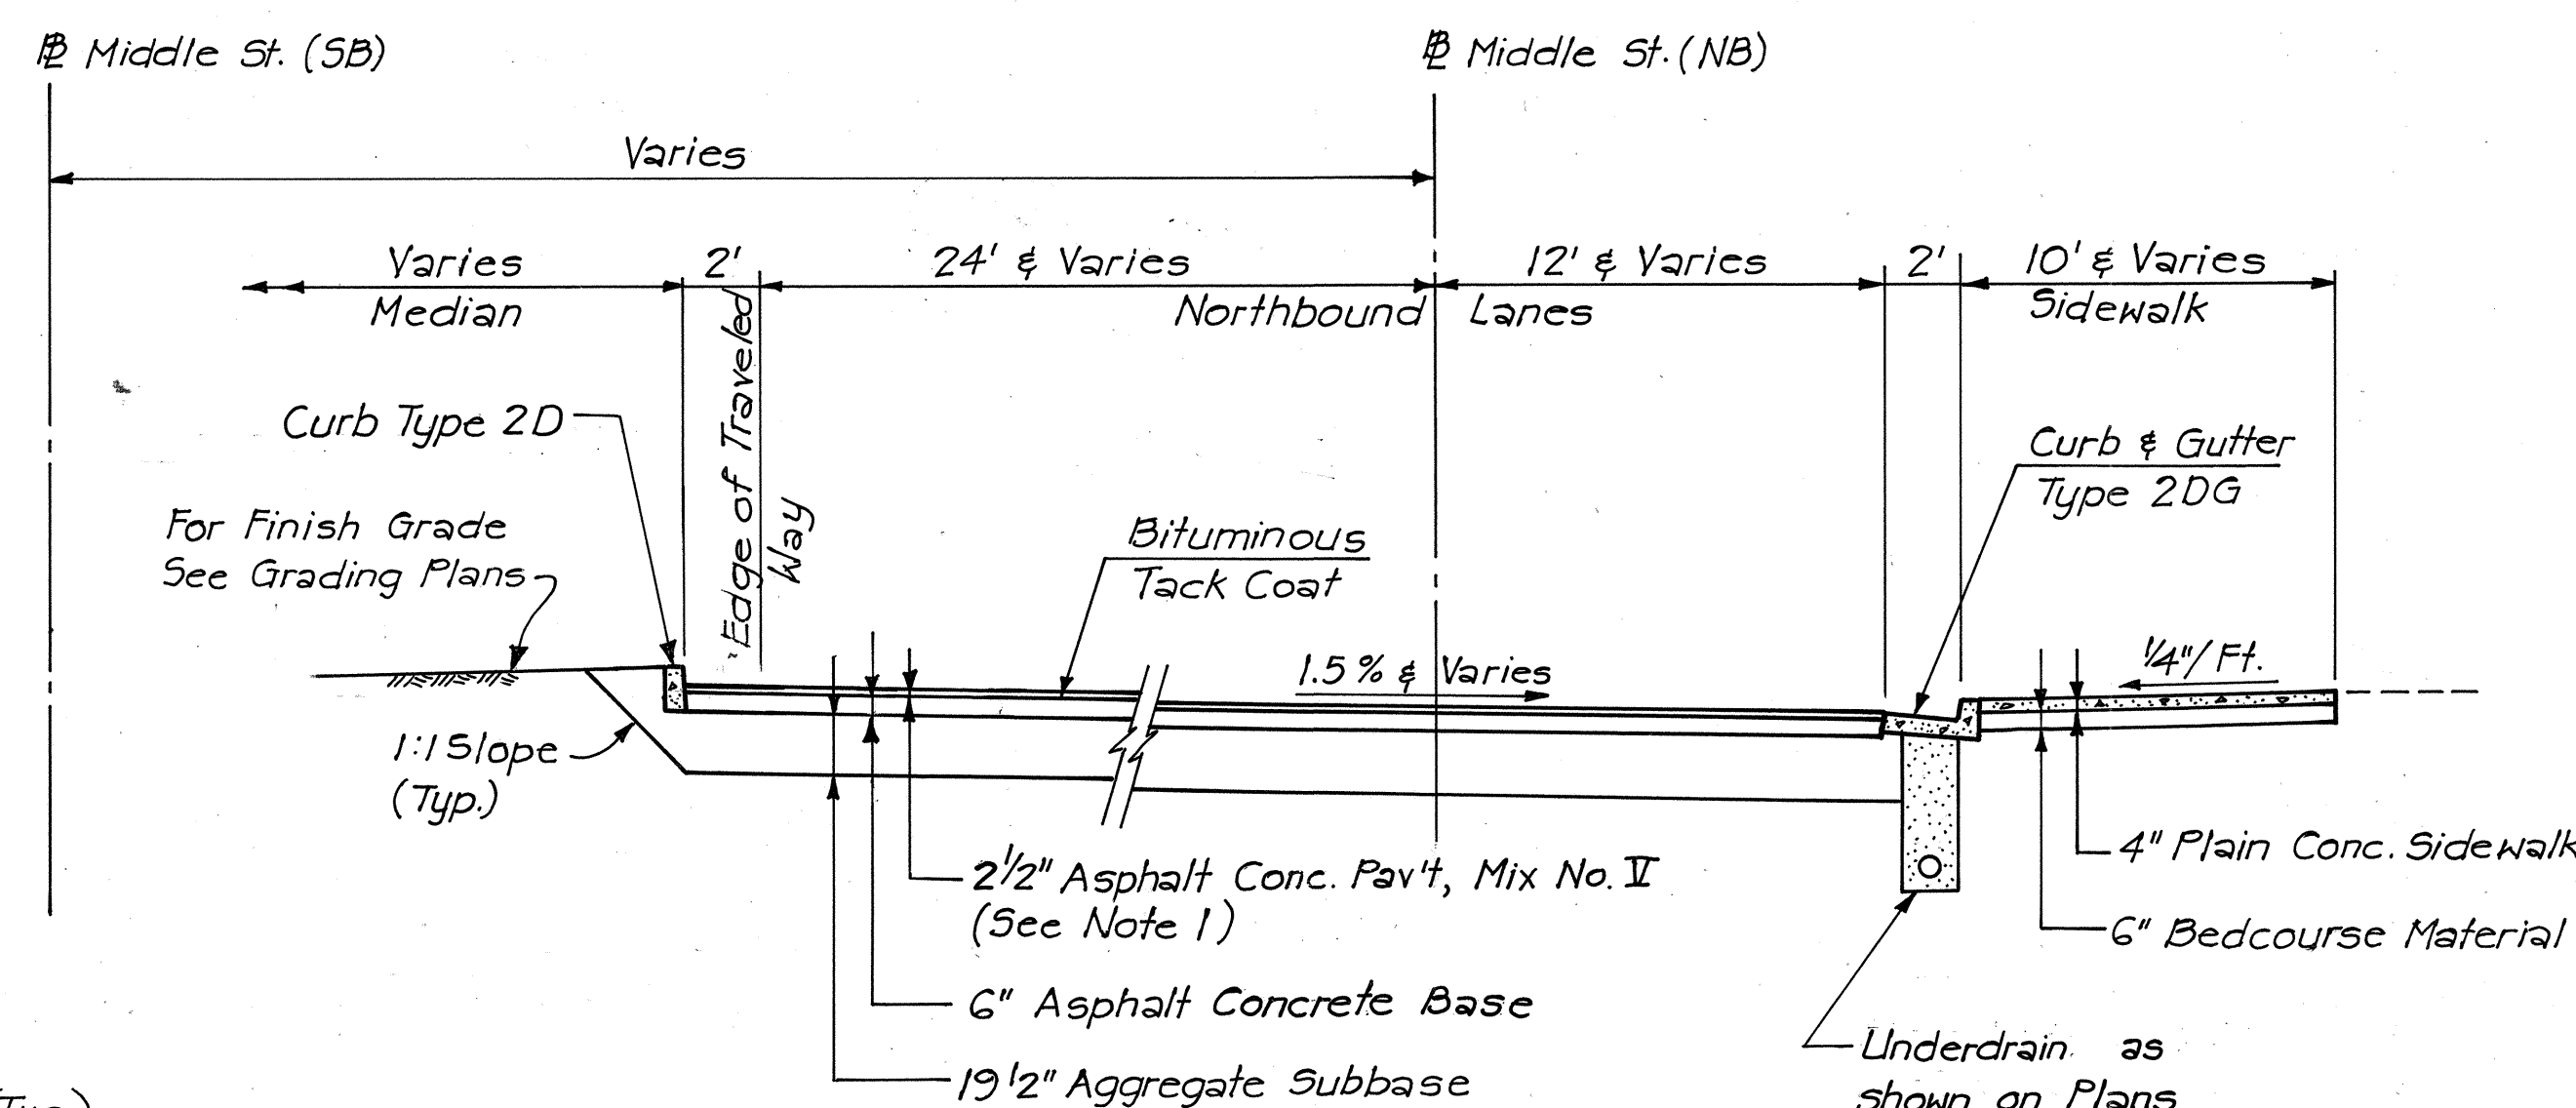

NOTE: Pavement Structure for Middle St. (SB) Roadway is identical to the one shown for Middle St. (NB) Roadway.

TYPICAL SECTION - MIDDLE STREET

Scale: 1" = 5'

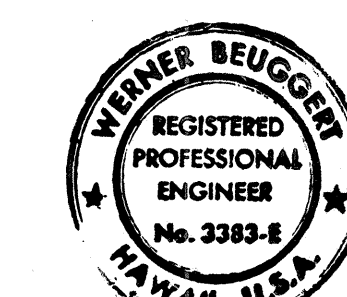

THIS WORK WAS PREPARED BY ME OR UNDER MY SUPERVISION.

STATE OF HAWAII
DEPARTMENT OF TRANSPORTATION
HIGHWAYS DIVISION

TYPICAL SECTIONS


INTERSTATE ROUTE H-1
PROJECT NO. I-IR-HI-1(69)17

SCALE: 1" = 5'


DATE: 3/15/82

SHEET No. TS-1 OF 2 SHEETS


FED. ROAD DIST. NO.	STATE	FED. AID PROJ. NO.	FISCAL YEAR	SHEET NO.	TOTAL SHEETS
HAWAII	HAW.	11R-H-1(169)17	1983	4	280

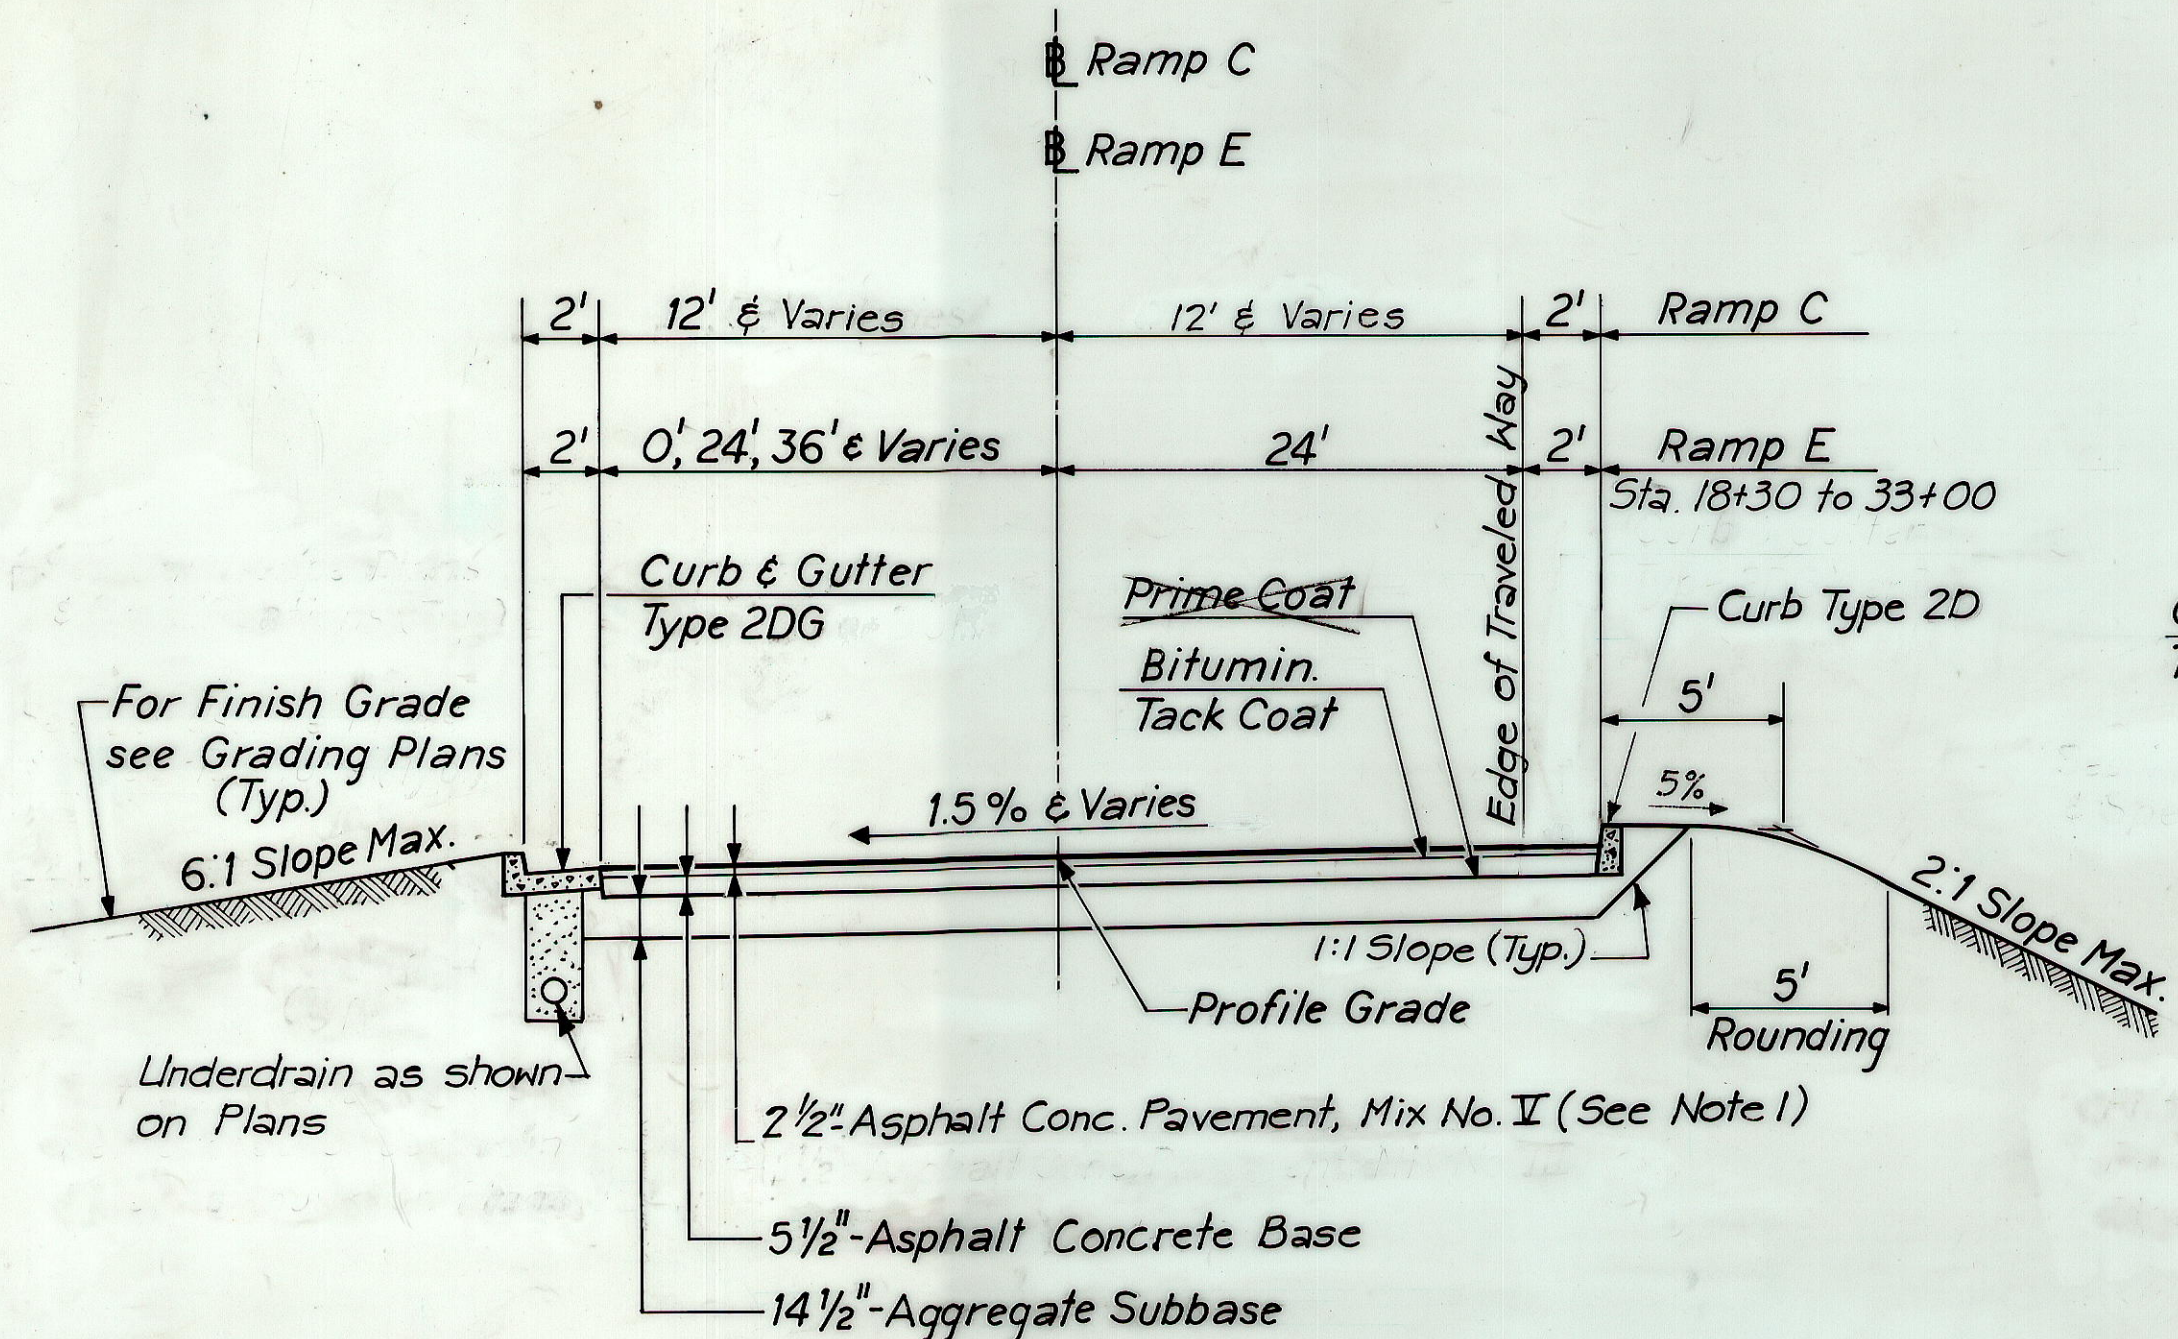


TYPICAL SECTION - RAMP C & RAMP E
SCALE: 1" = 5'

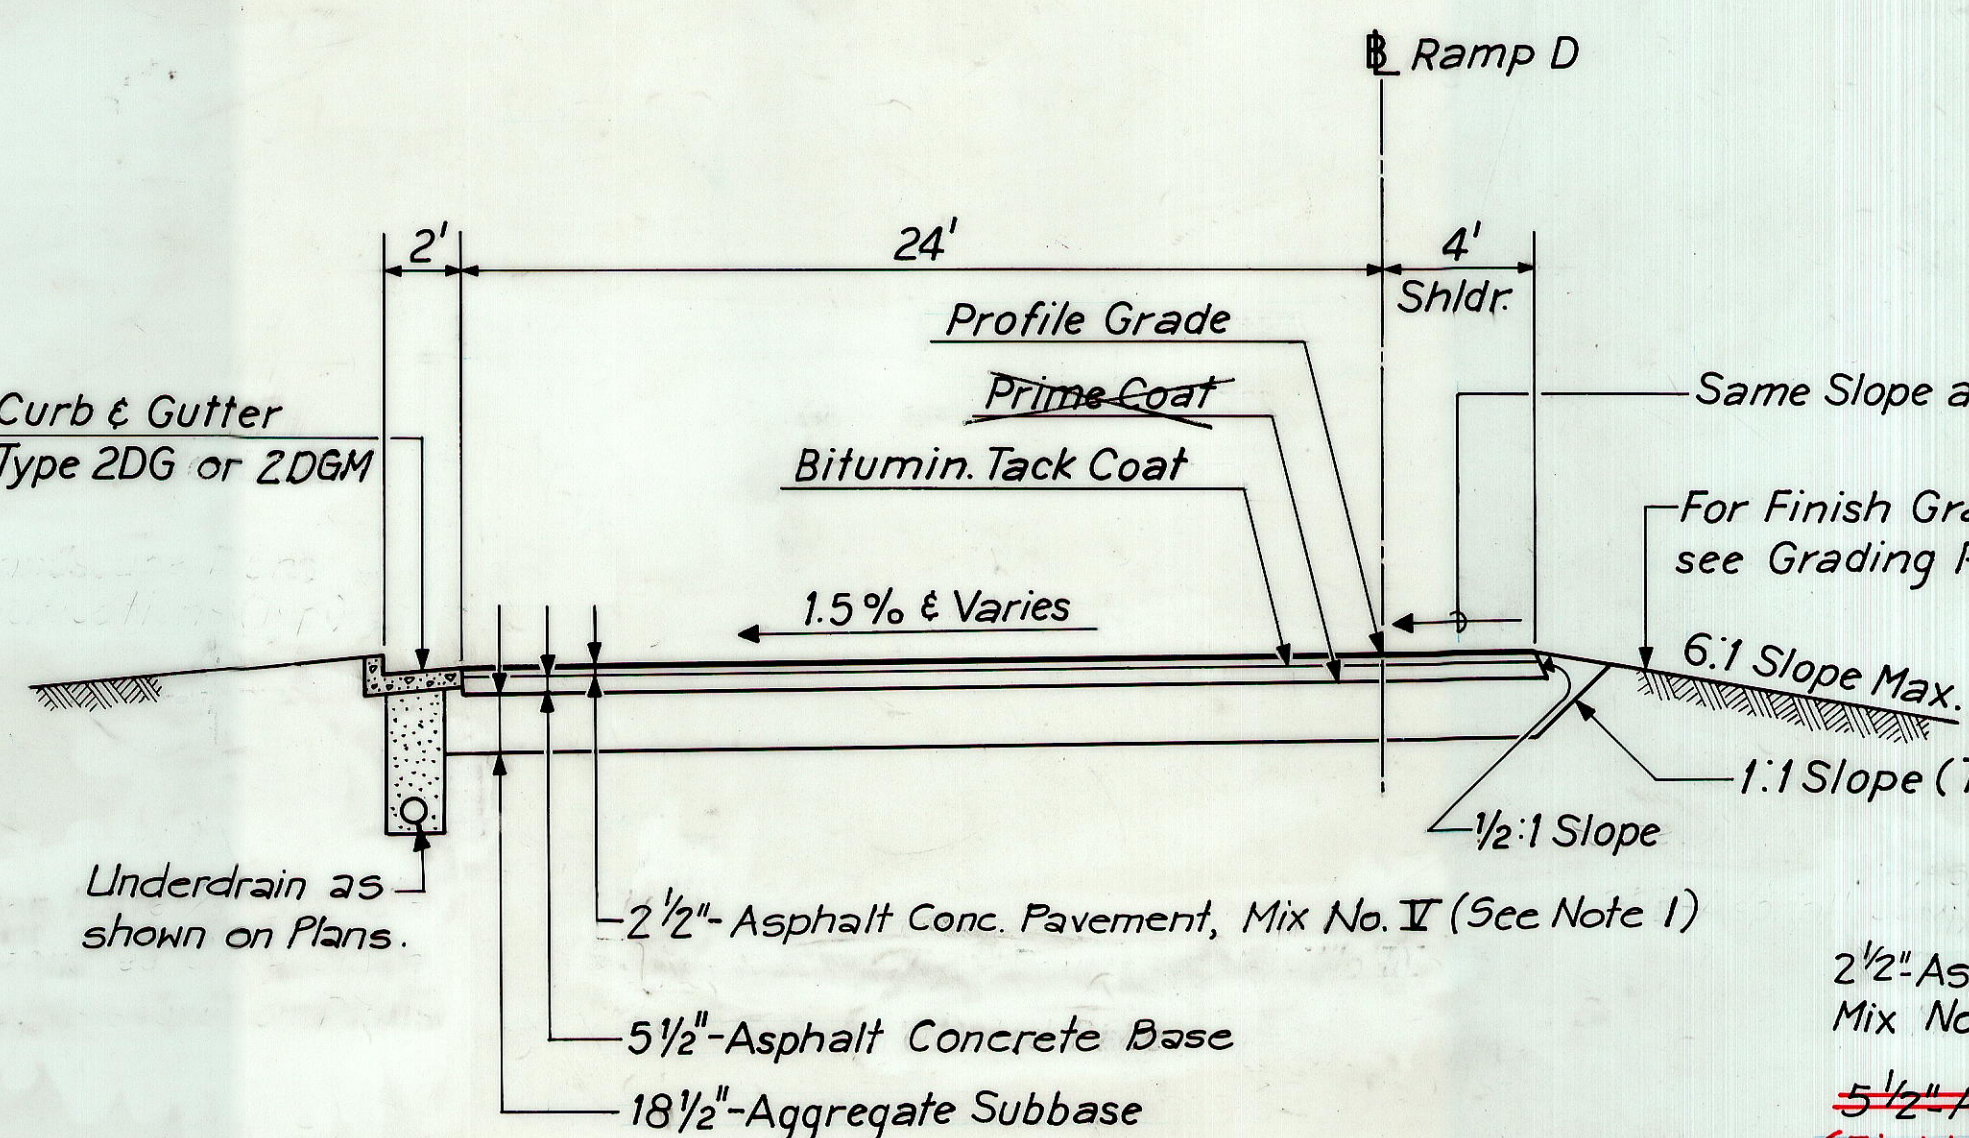

TYPICAL SECTION - RAMP D
(From Sta. 20+60 to Sta. 26+61)
Scale: 1" = 5'

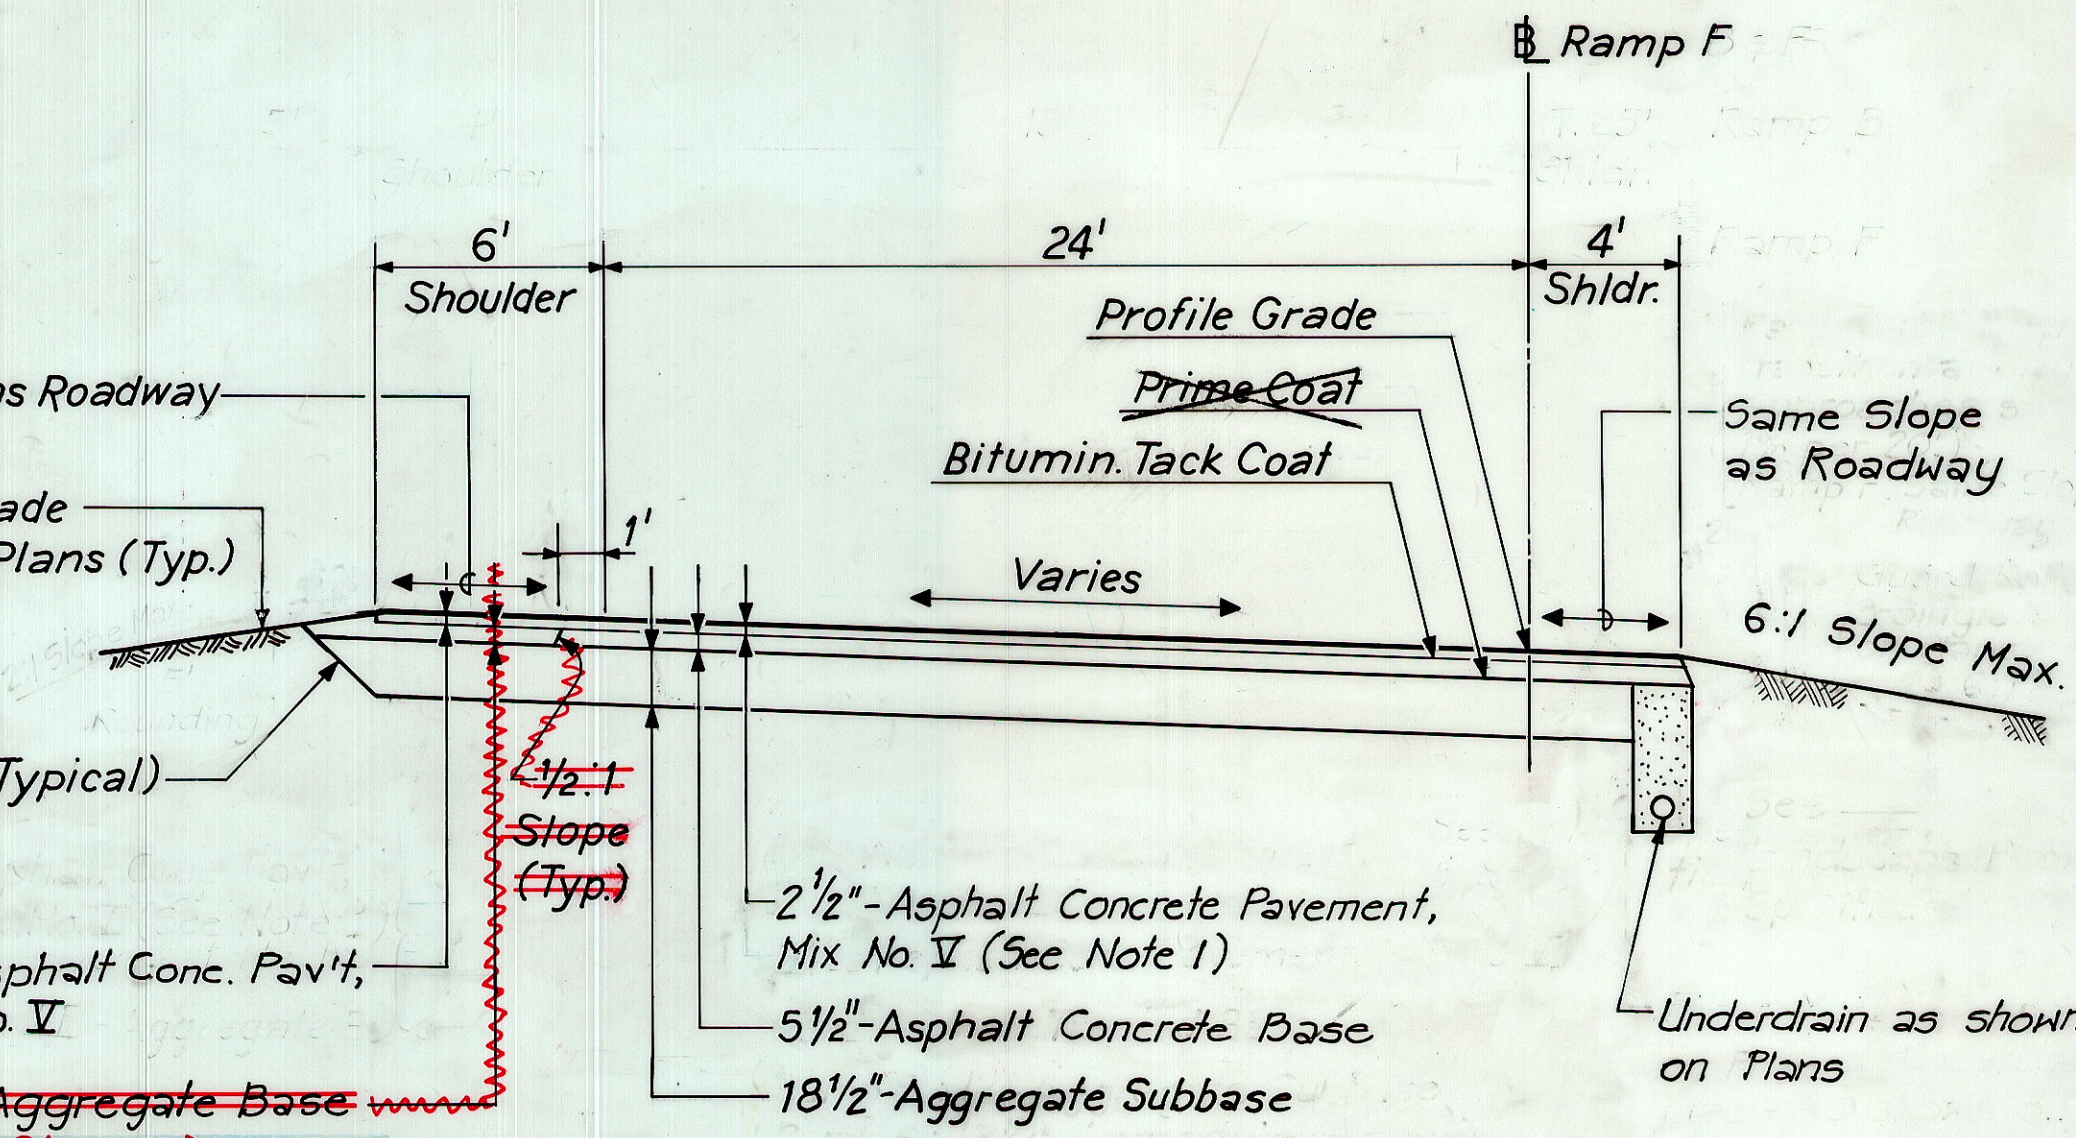


TYPICAL SECTION - RAMP F
(From Sta. 27+15 to Sta. 29+90 ±)
Scale: 1" = 5'

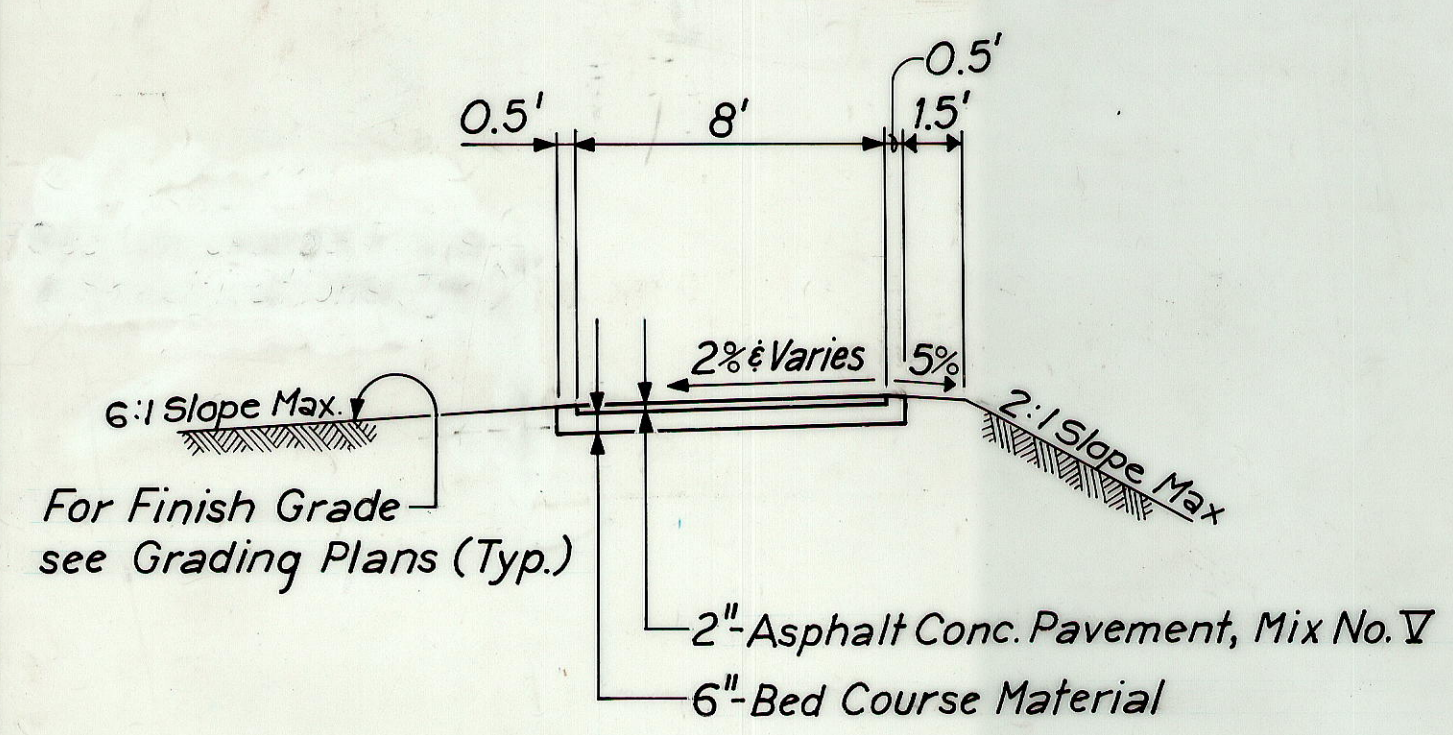


TYPICAL SECTION - BIKEWAY
SCALE: 1" = 5'

(Payment will be made in accordance with Section 608-Sidewalk)

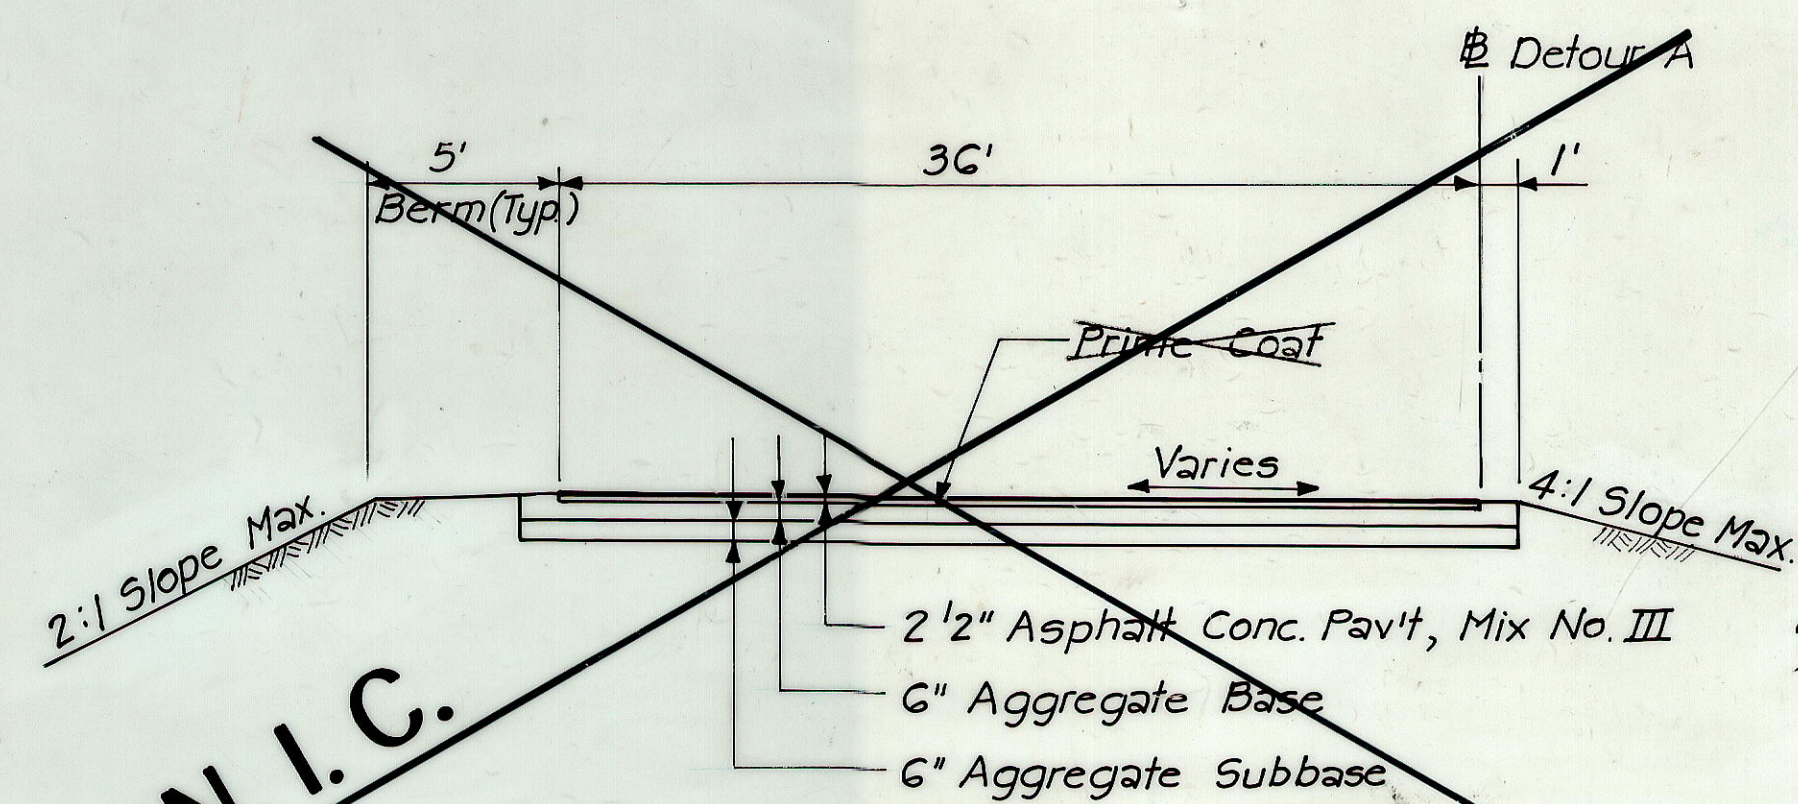


TYPICAL SECTION - DETOUR A & B
SCALE: 1" = 5'

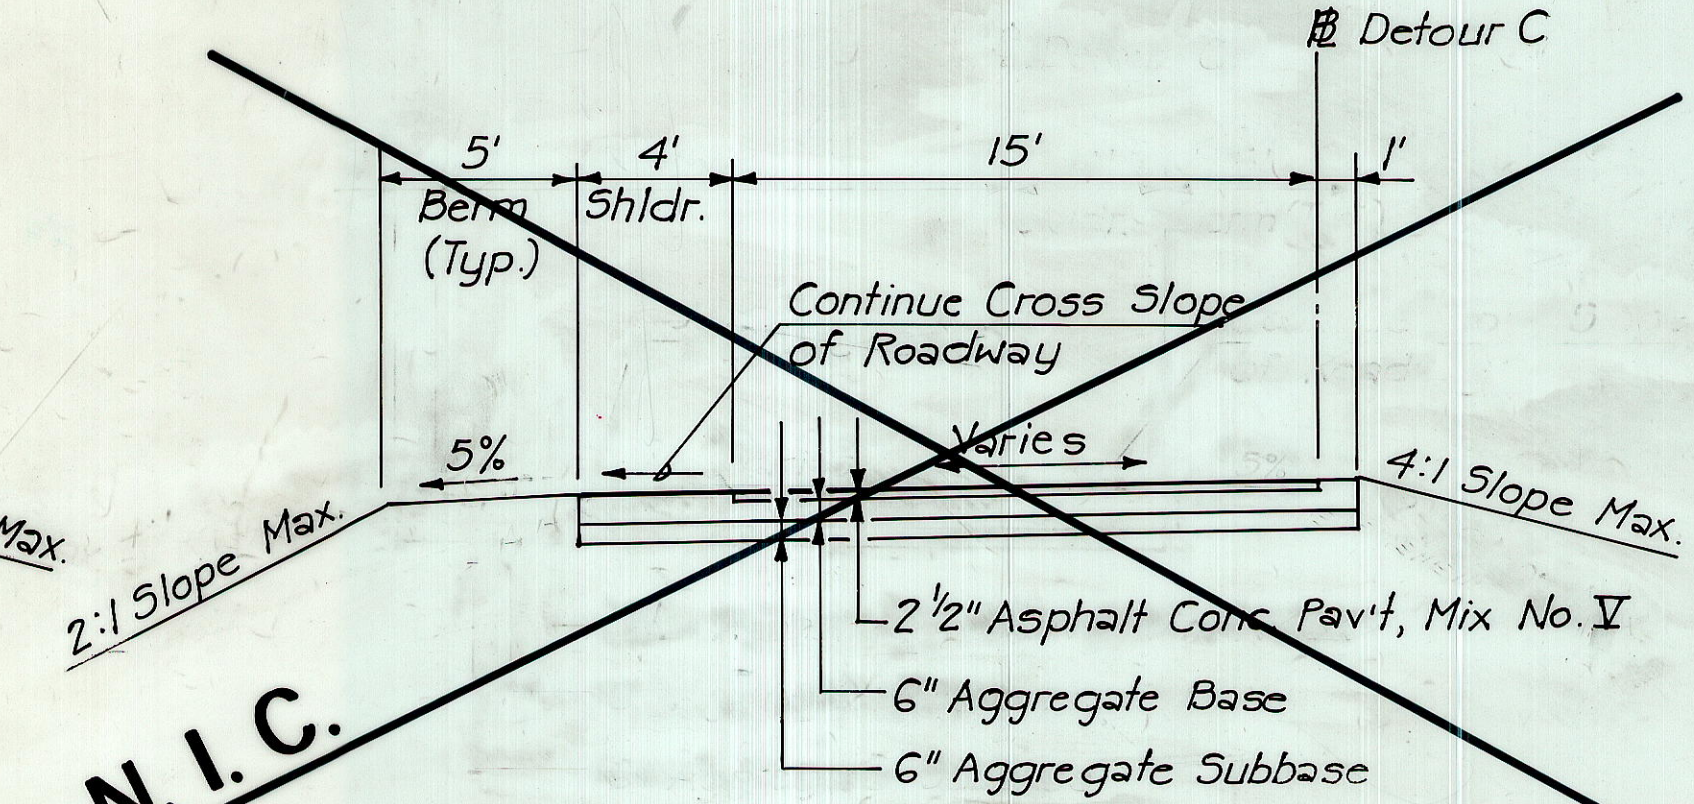


TYPICAL SECTION - DETOUR C
SCALE: 1" = 5'

NOTES:


1. Placing of Asphalt Concrete Pavement shall be delayed until final pavement markings are to be installed.

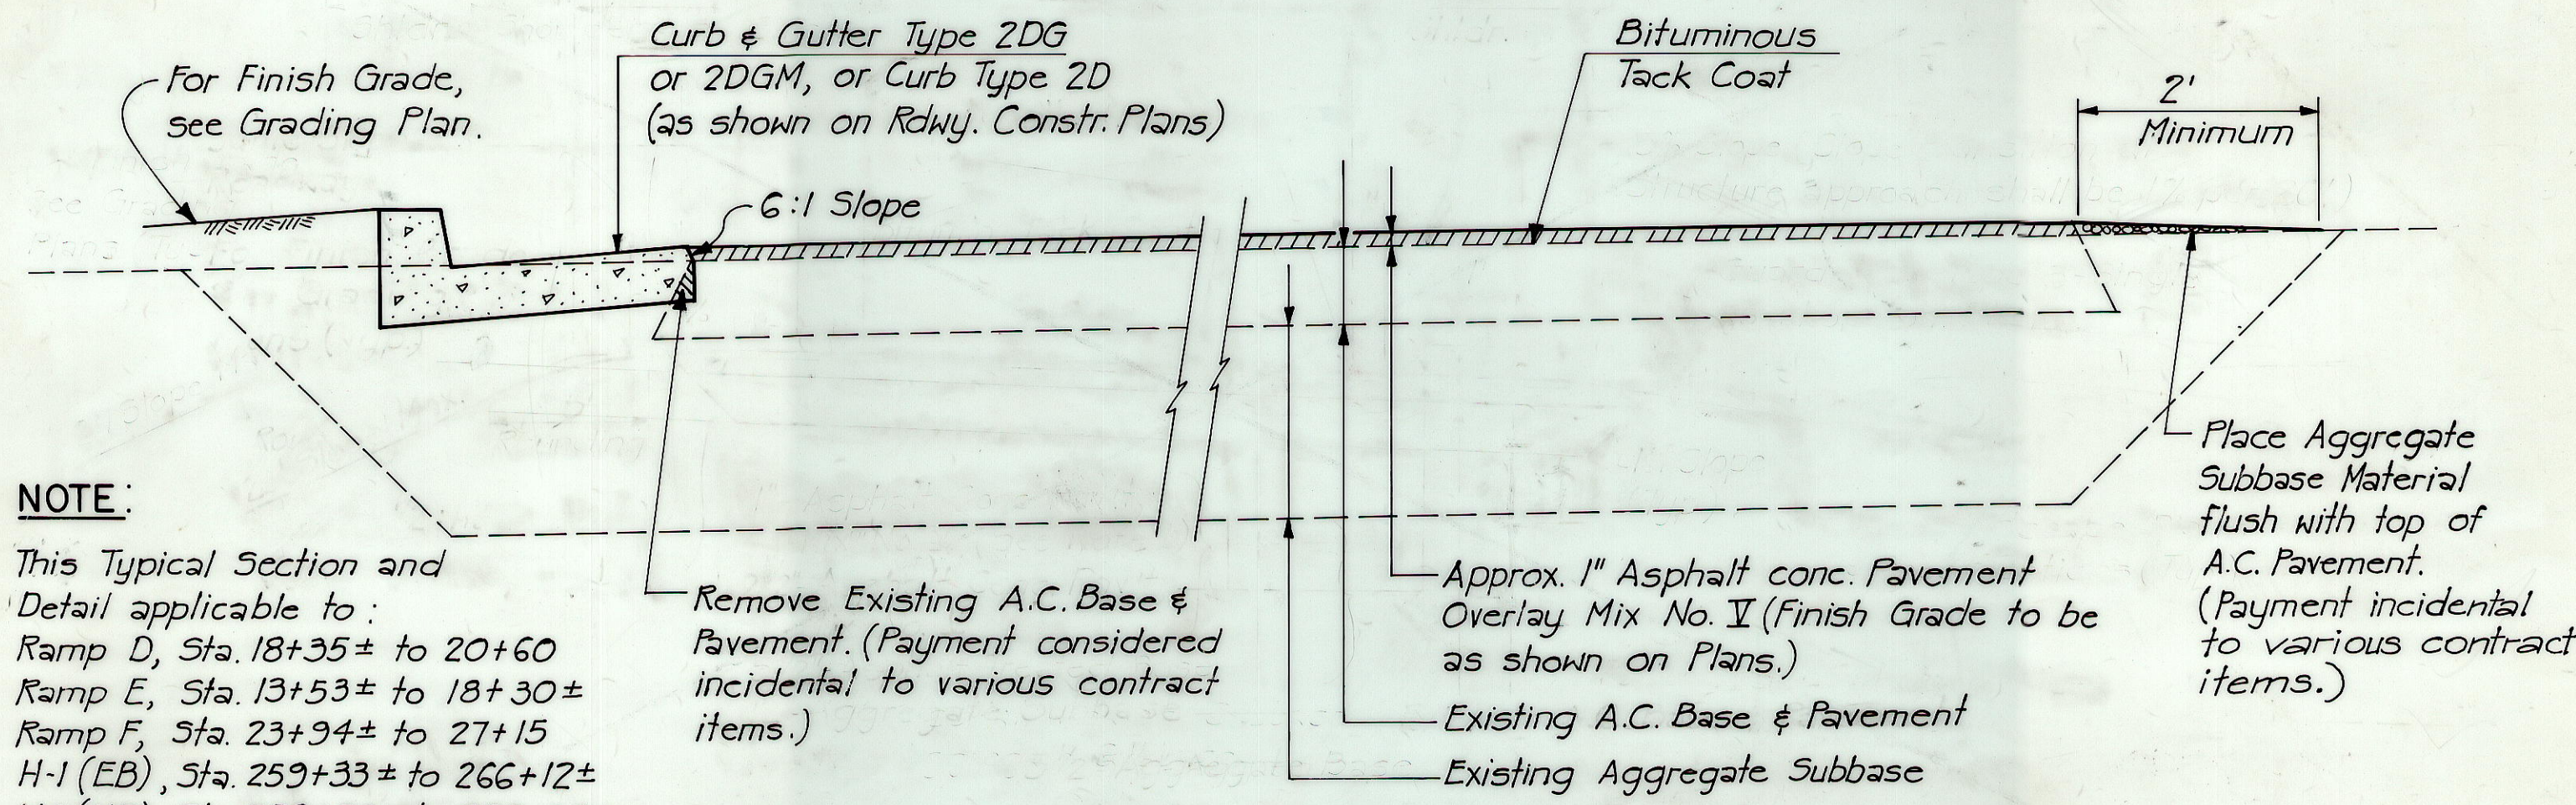

TYPICAL SECTION FOR PAVEMENT OVERLAYS & DETAIL FOR CONSTRUCTION OF CURB & GUTTER AT EXIST. ROADWAY
SCALE: 3/4" = 1'-0"

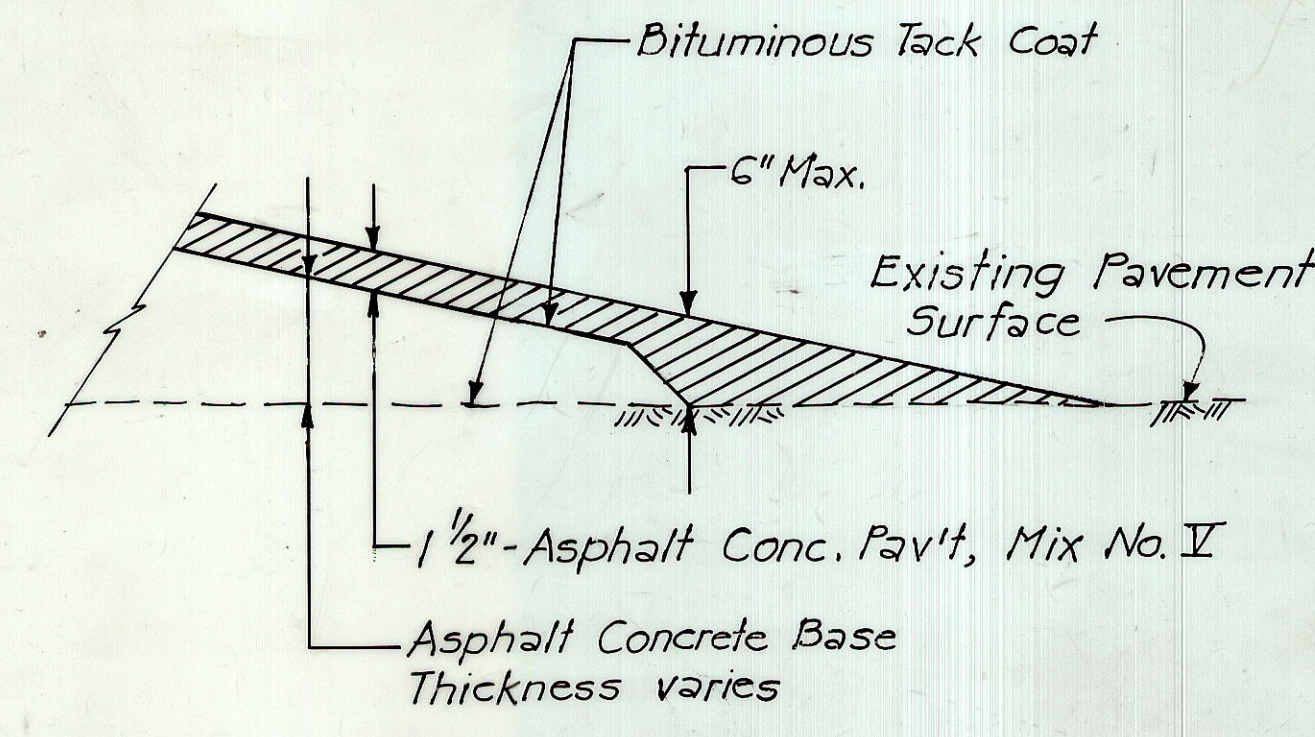

TYPICAL SECTION SMOOTH RIDING CONNECTION
N.T.S.

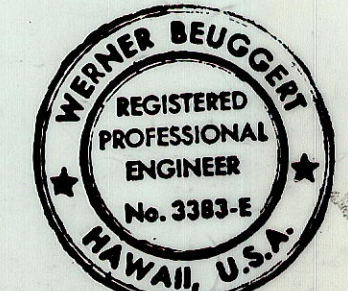

THIS WORK WAS PREPARED BY ME OR UNDER MY SUPERVISION.
Werner Beugger

STATE OF HAWAII
DEPARTMENT OF TRANSPORTATION
HIGHWAYS DIVISION

TYPICAL SECTIONS

INTERSTATE ROUTE H-1
PROJECT NO. I-IR-H-1(169)17

SCALE: 1" = 5' DATE: 3/15/82
SHEET No. TS-2 OF 2 SHEETS

"AS-BUILT"