

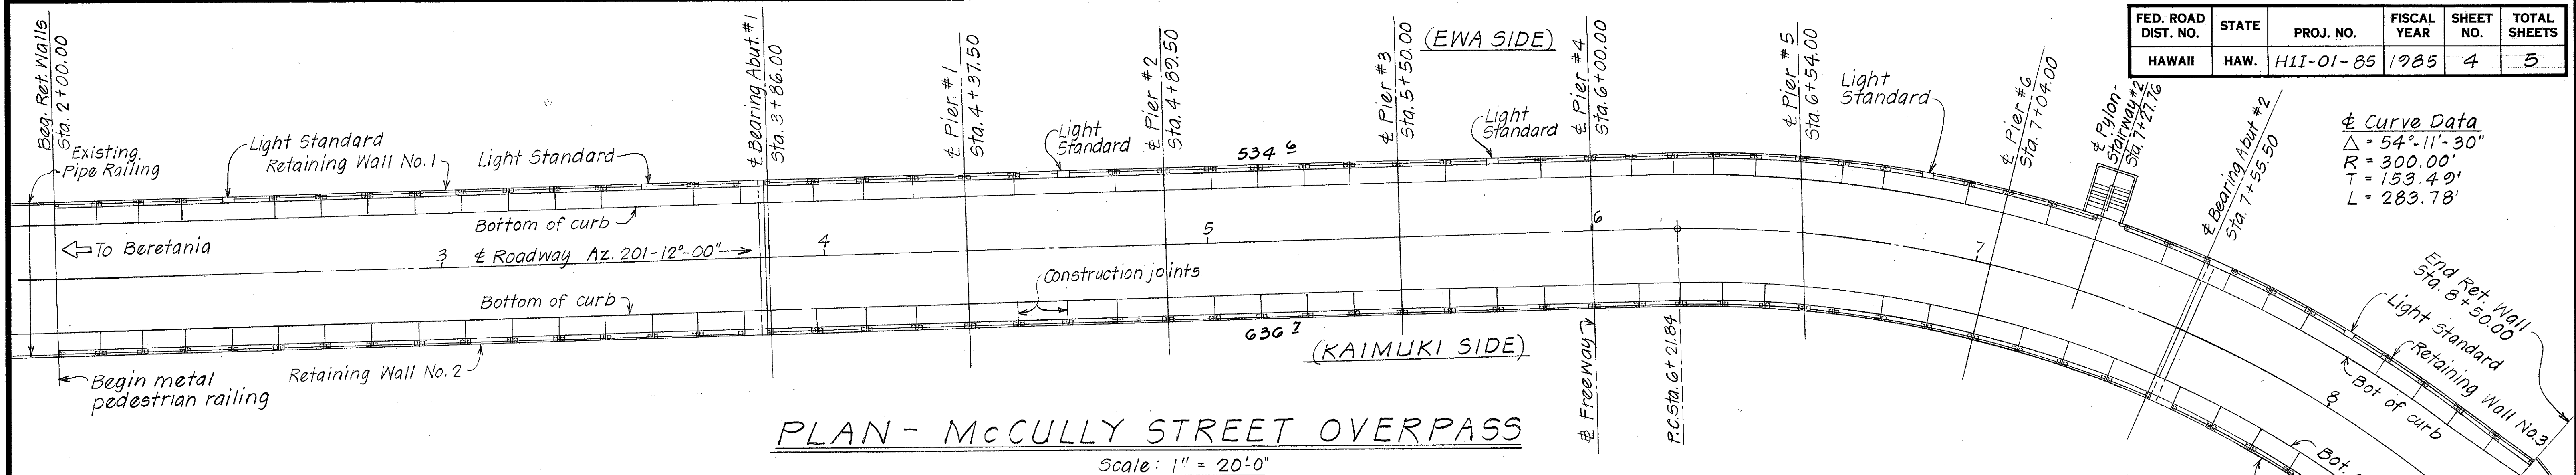


FED. ROAD DIST. NO.	STATE	PROJ. NO.	FISCAL YEAR	SHEET NO.	TOTAL SHEETS
HAWAII	HAW.	H11-01-85	1985	4	5

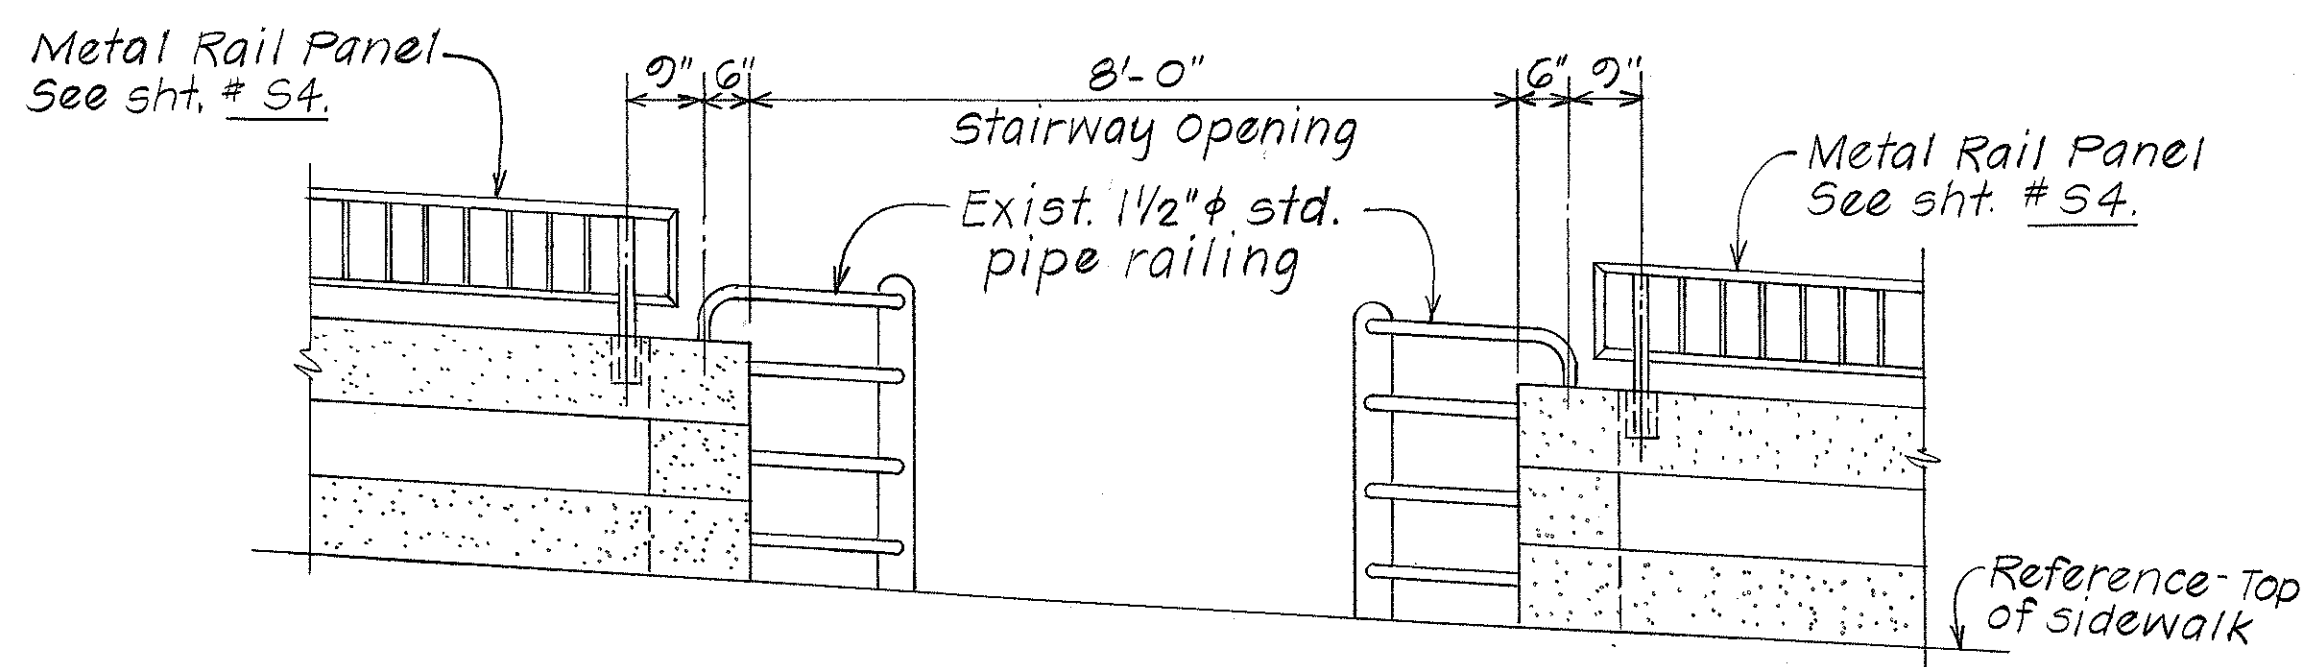

Curve Data
 $\Delta = 54^\circ-11'-30''$
 $R = 300.00'$
 $T = 153.49'$
 $L = 263.78'$

NOTE:
 Metal pedestrian rail on concrete rail not shown. See sht. #54 for details.

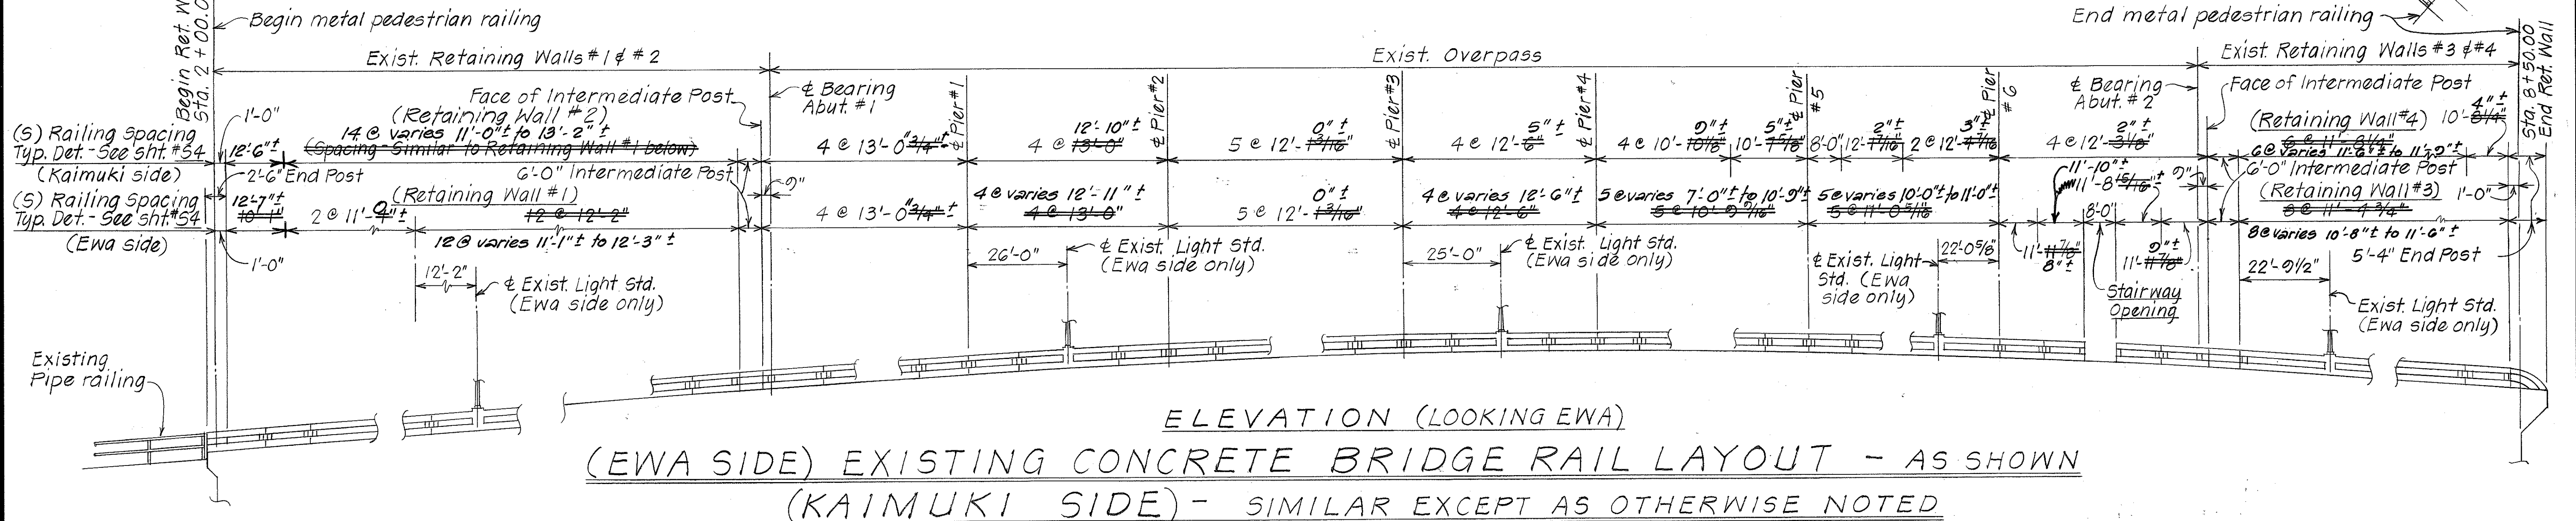

STATE OF HAWAII
 DEPARTMENT OF TRANSPORTATION
 HIGHWAYS DIVISION
McCULLY STREET OVERPASS
 PLAN & ELEV. OF EXIST. BRIDGE RAIL
 H1 SAFETY IMPROVEMENTS AT McCULLY ST.
 OVERPASS & PUNAHOU ST. OVERPASS
 Proj. No. H11-01-85
 Scale: As Shown Date: Nov. 1984
 SHEET NO. 53 OF 4 SHEETS