


NOTE: Metal pedestrian rail not shown, see sht. #54 for details.

FED. ROAD DIST. NO.	STATE	PROJ. NO.	FISCAL YEAR	SHEET NO.	TOTAL SHEETS
HAWAII	HAW.	H11-01-85	1985	3	5

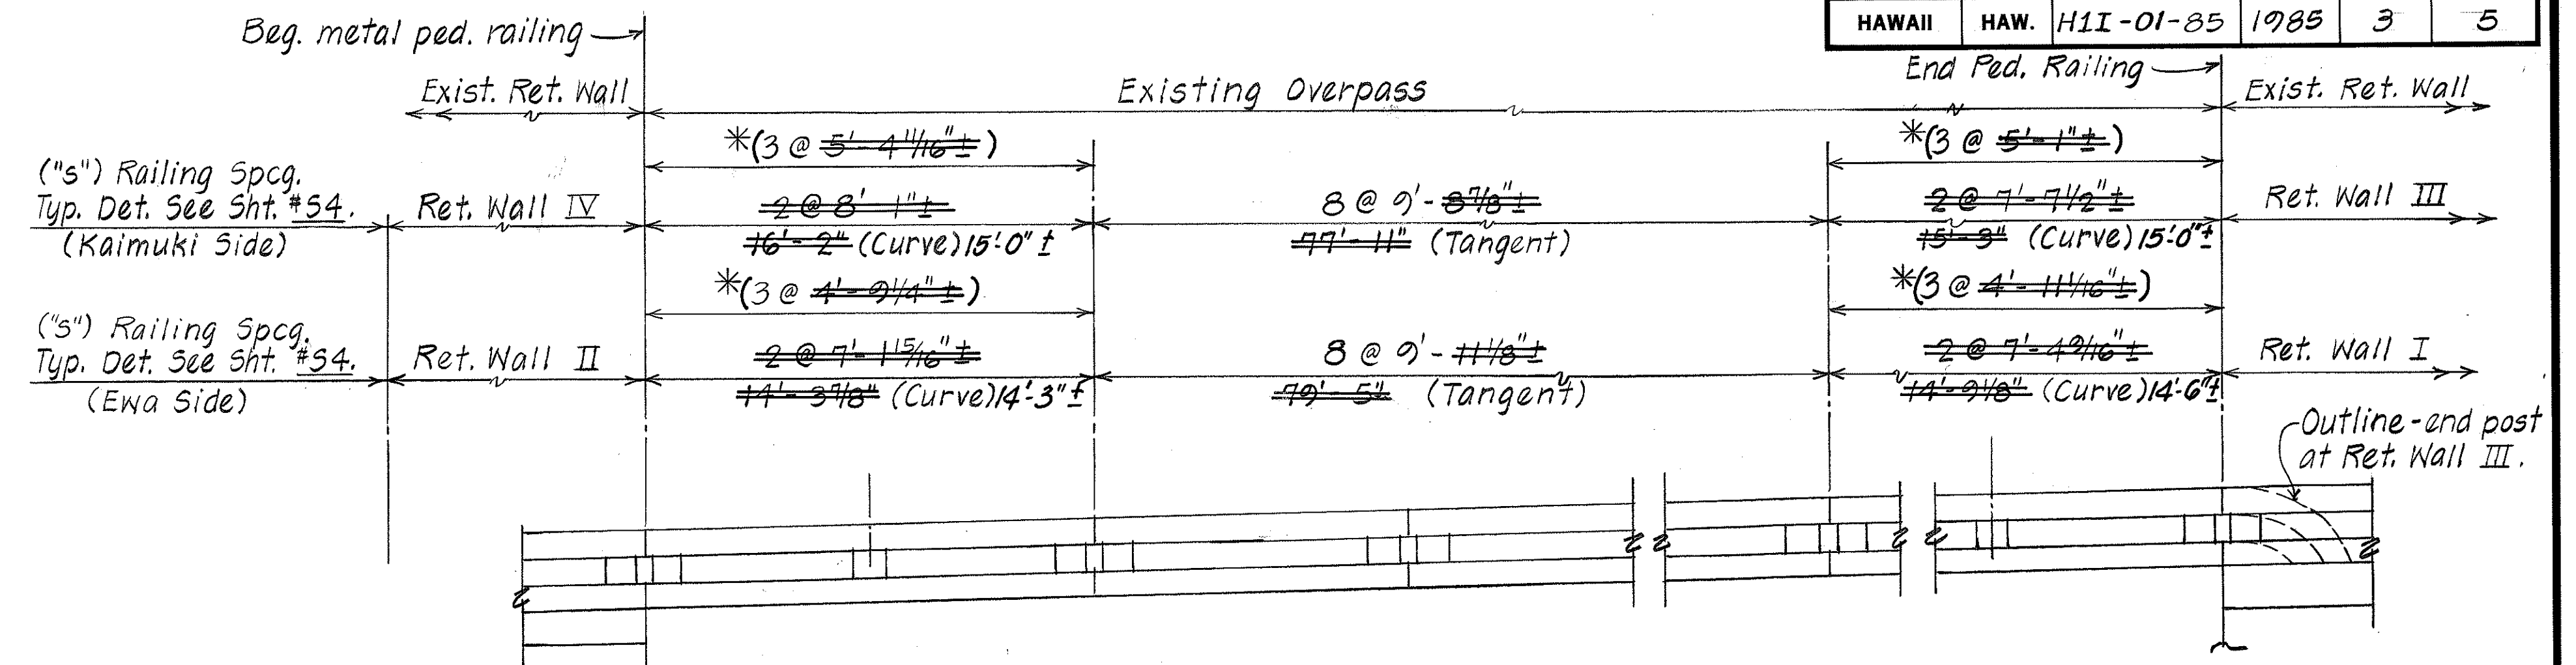


ELEVATION (LOOKING EWA)

(EWA SIDE) EXISTING CONCRETE BRIDGE RAIL LAYOUT - AS SHOWN

(KAIMUKI SIDE) SIMILAR EXCEPT AS OTHERWISE NOTED

Scale: 1/4" = 1'-0"

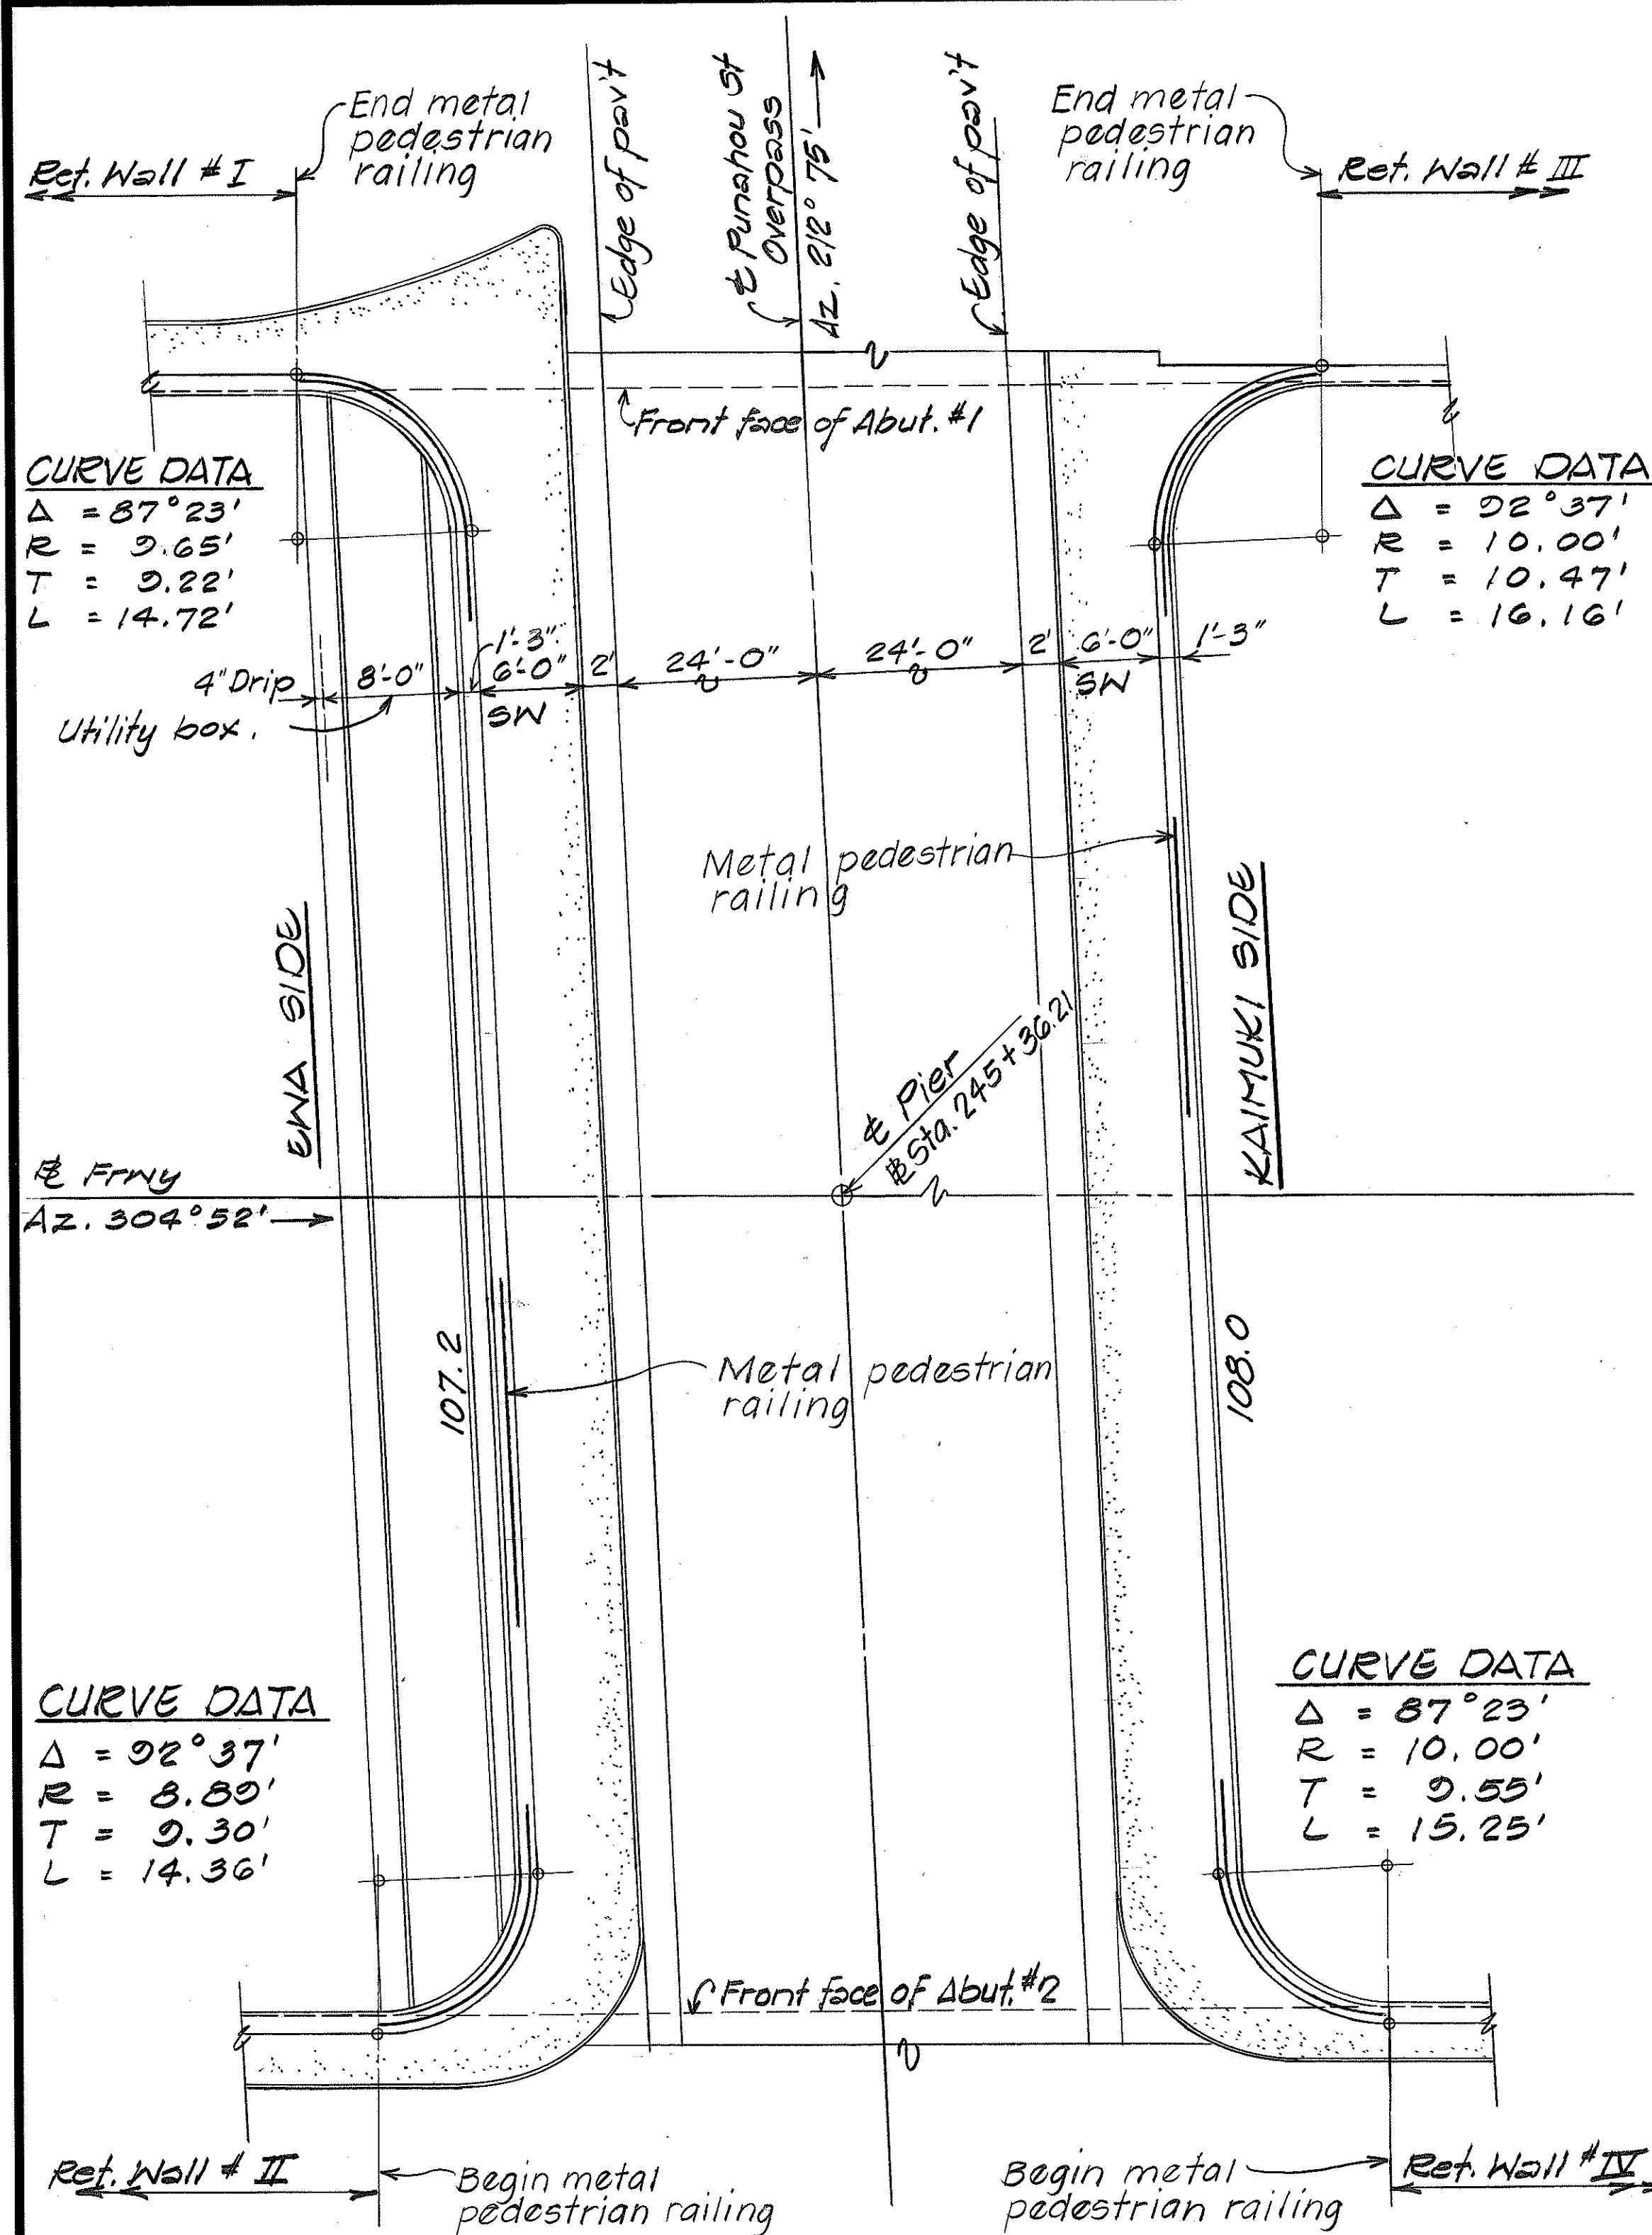

PLAN - PUNAHOU ST. OVERPASS

Scale: 1/8" = 1'-0"

DATE	10/84
SURVEY PLOTTED BY	9/9
DESIGNED BY	7/9
QUANTITIES BY	4/4
CHECKED BY	4/4
ORIGINAL PLAN	
NOTE BOOK	
No.	

STATE OF HAWAII DEPARTMENT OF TRANSPORTATION HIGHWAYS DIVISION
PUNAHOU ST. OVERPASS
PLAN & ELEVATION OF EXIST. BRIDGE RAIL
H1 SAFETY IMPROVEMENTS AT McCULLY ST. OVERPASS & PUNAHOU ST. OVERPASS
Proj. No. H11-01-85
Scale: As shown Date: Nov. 1984
SHEET No. 52 OF 4 SHEETS