
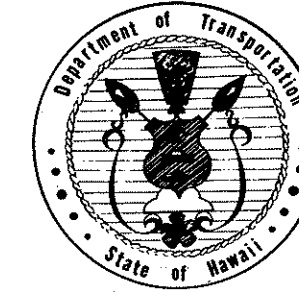
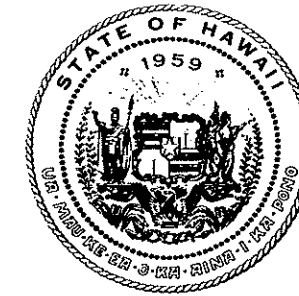


CHANGES MADE DURING CONSTRUCTION HAVE BEEN INCORPORATED ON THESE PLANS EXCEPT CHANGES IN THE ORIGINAL THEORETICAL QUANTITIES. FOR ACTUAL QUANTITIES, REFER TO PROJECT LEDGER AND/OR COMPUTATION BOOK.

DEPARTMENT OF TRANSPORTATION STATE OF HAWAII	
APPROVED: 	12/18/80
DIR. OF TRANSPORTATION	DATE

[illegible]

STATE OF HAWAII

DEPARTMENT OF TRANSPORTATION  
HIGHWAYS DIVISION


"AS-BUILT"

PLANS FOR

INTERSTATE ROUTE H-1  
SAFETY IMPROVEMENTS AT  
McCULLY ST. OVERPASS AND PUNAHOU ST. OVERPASS

PROJECT NO. HII-01-85

DISTRICT OF HONOLULU  
ISLAND OF OAHU

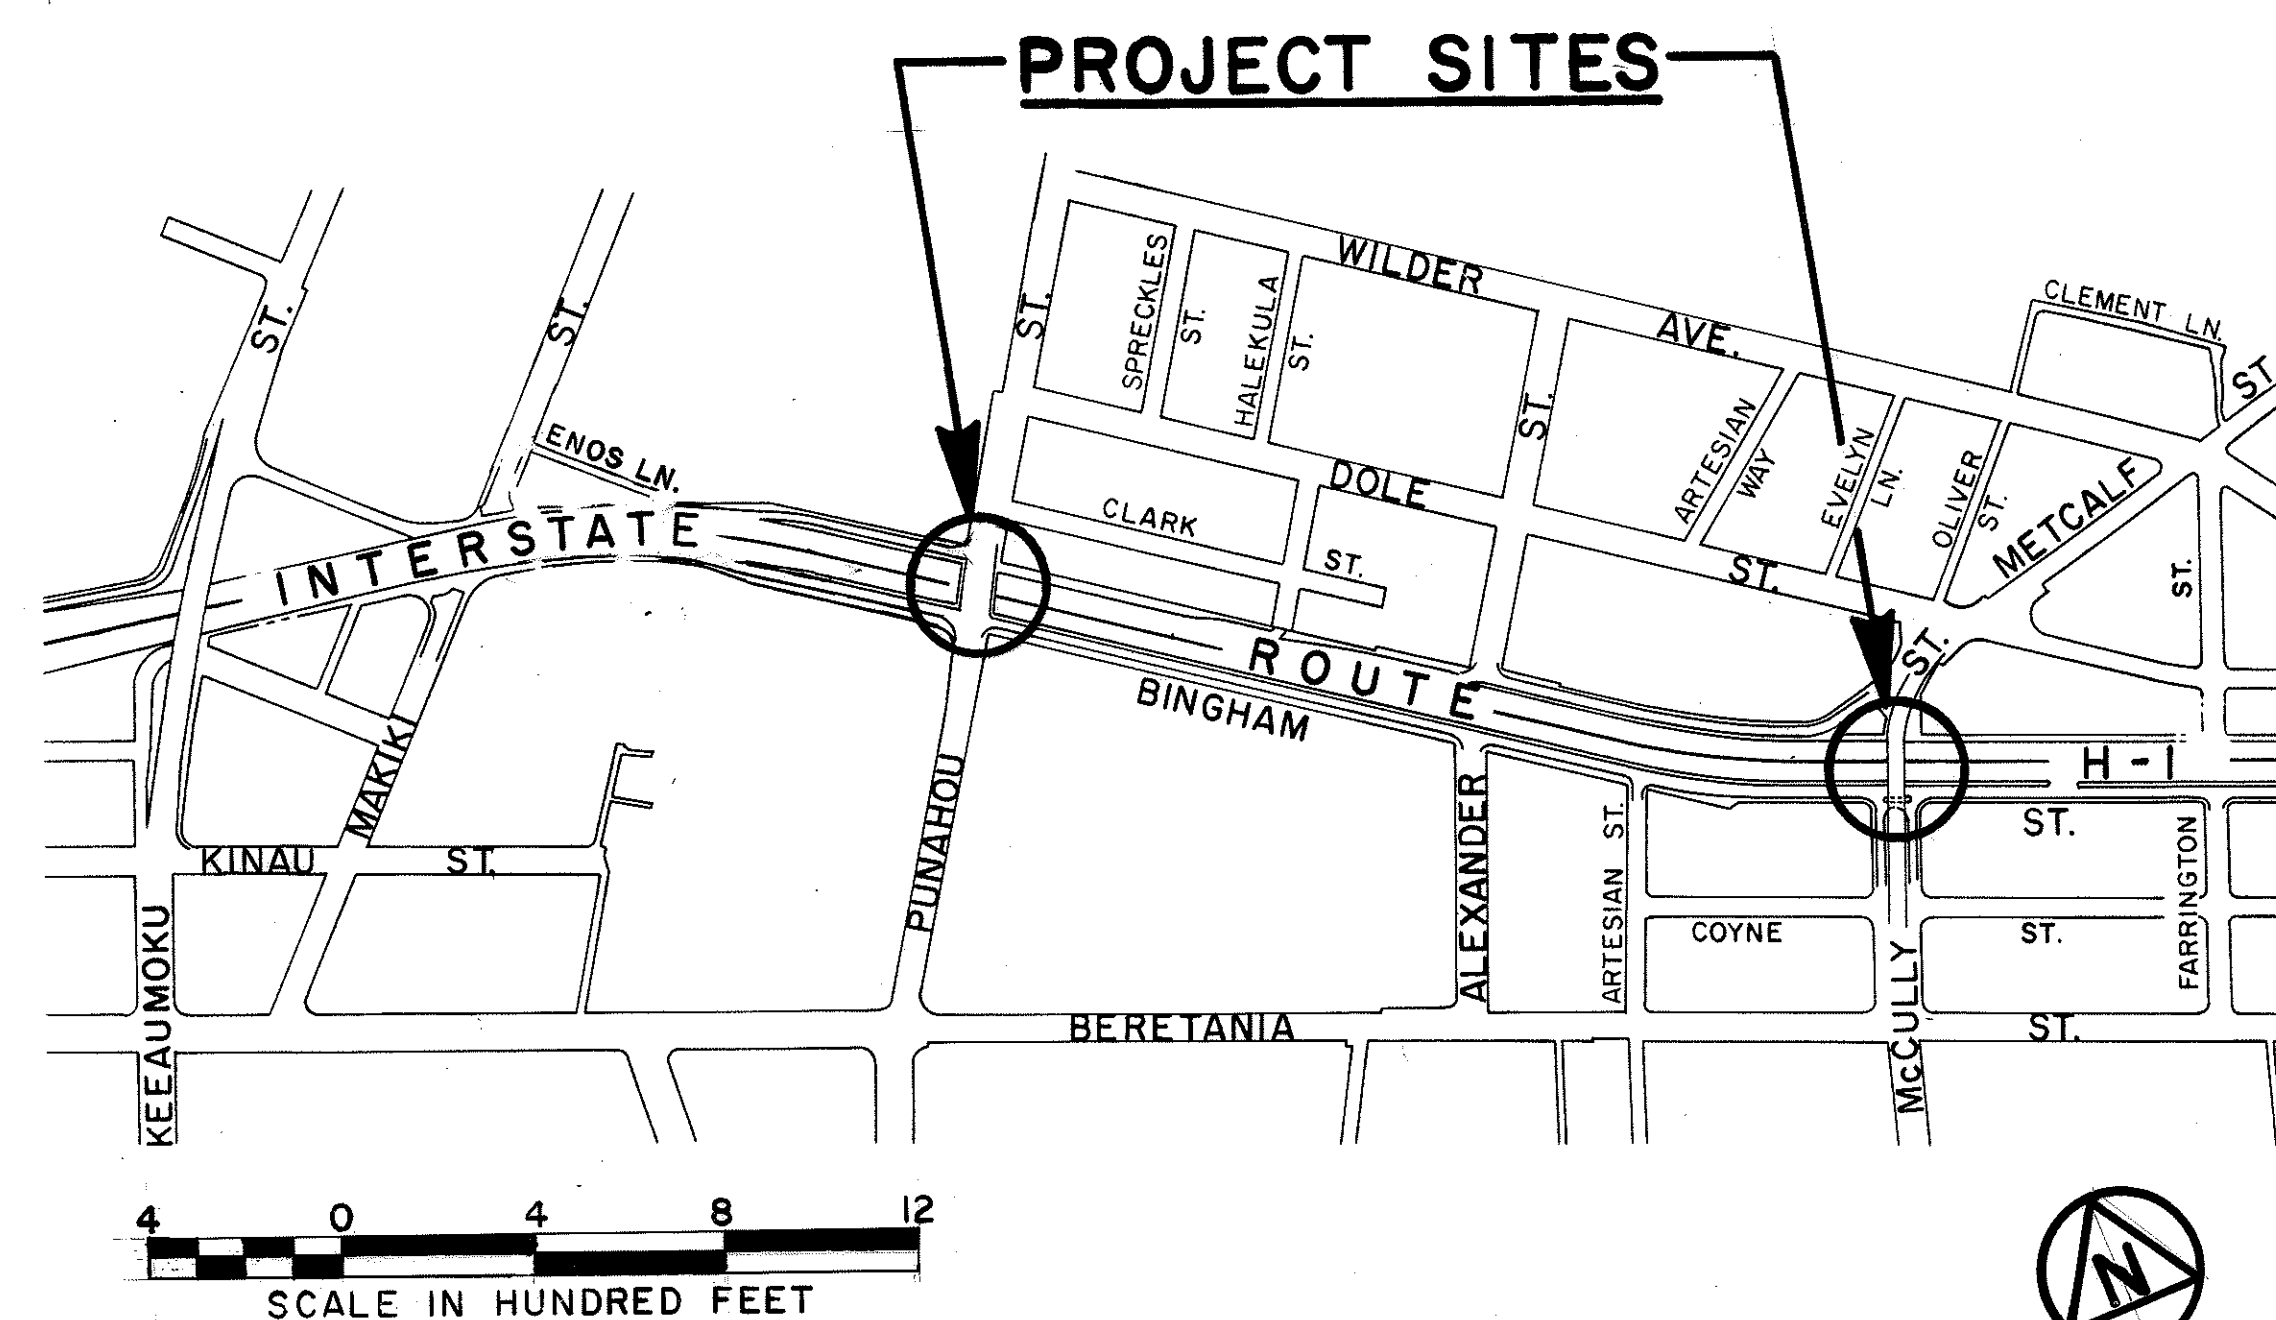

## LAYOUT PLAN

HWY - DB  
DESIGNED BY  
A. NISHIMURA  
P. S. & E. BY  
548-7490  
PHONE  
DEC., 1984  
DATE