


FED. ROAD DIST. NO.	STATE	FED-AID PROJ. NO.	FISCAL YEAR	SHEET NO.	TOTAL SHEETS
HAWAII	HAW.	HII-02-85	1985	2	15

GENERAL NOTES

- Construct approximately 265 lin. ft. of a six feet wide Asphaltic Concrete Walkway. Construction shall include lighting under the Keeaumoku Overpass along the walkway, a striped crosswalk, three (3) wheel chair ramps, removal and reconstruction of the fencing and signing of Keeaumoku Street.
- Remove chain link fence with poles, and salvage chain link fence with out poles, to be used for Item No. 607.0070 6-Foot Chain Link Fence with Top Rail and Concrete Footings. Remove and salvage chain link fence shall not be paid for separately but shall be considered incidental to Item No. 607.0060 6-Foot Chain Link Fence with Top Rail and Concrete Footings.
- Trim Mango Tree branches over walkway to give a minimum height clearance of 12 feet for pedestrians. Tree trimming shall not be paid for separately but shall be considered incidental to pay Item No. 608.2000 Bituminous Sidewalk.
- Remove two (2) Hibiscus bushes, shown on the plan, shall not be paid for separately but shall be considered incidental to pay Item No. 608.2000 Bituminous Sidewalk.
- Cut and plug sprinkler heads and remove sprinkler heads where ever necessary for the construction of walkway and sidewalk. Removal of sprinkler heads shall not be paid for separately but shall be considered incidental to pay Item No. 608.2000 Bituminous Sidewalk.

SURVEY PLOTTED BY	DATE
DESIGNED BY	
NOTED BY	
CHECKED BY	
ORIGINAL PLAN	
NOTE BOOK	
NO.	

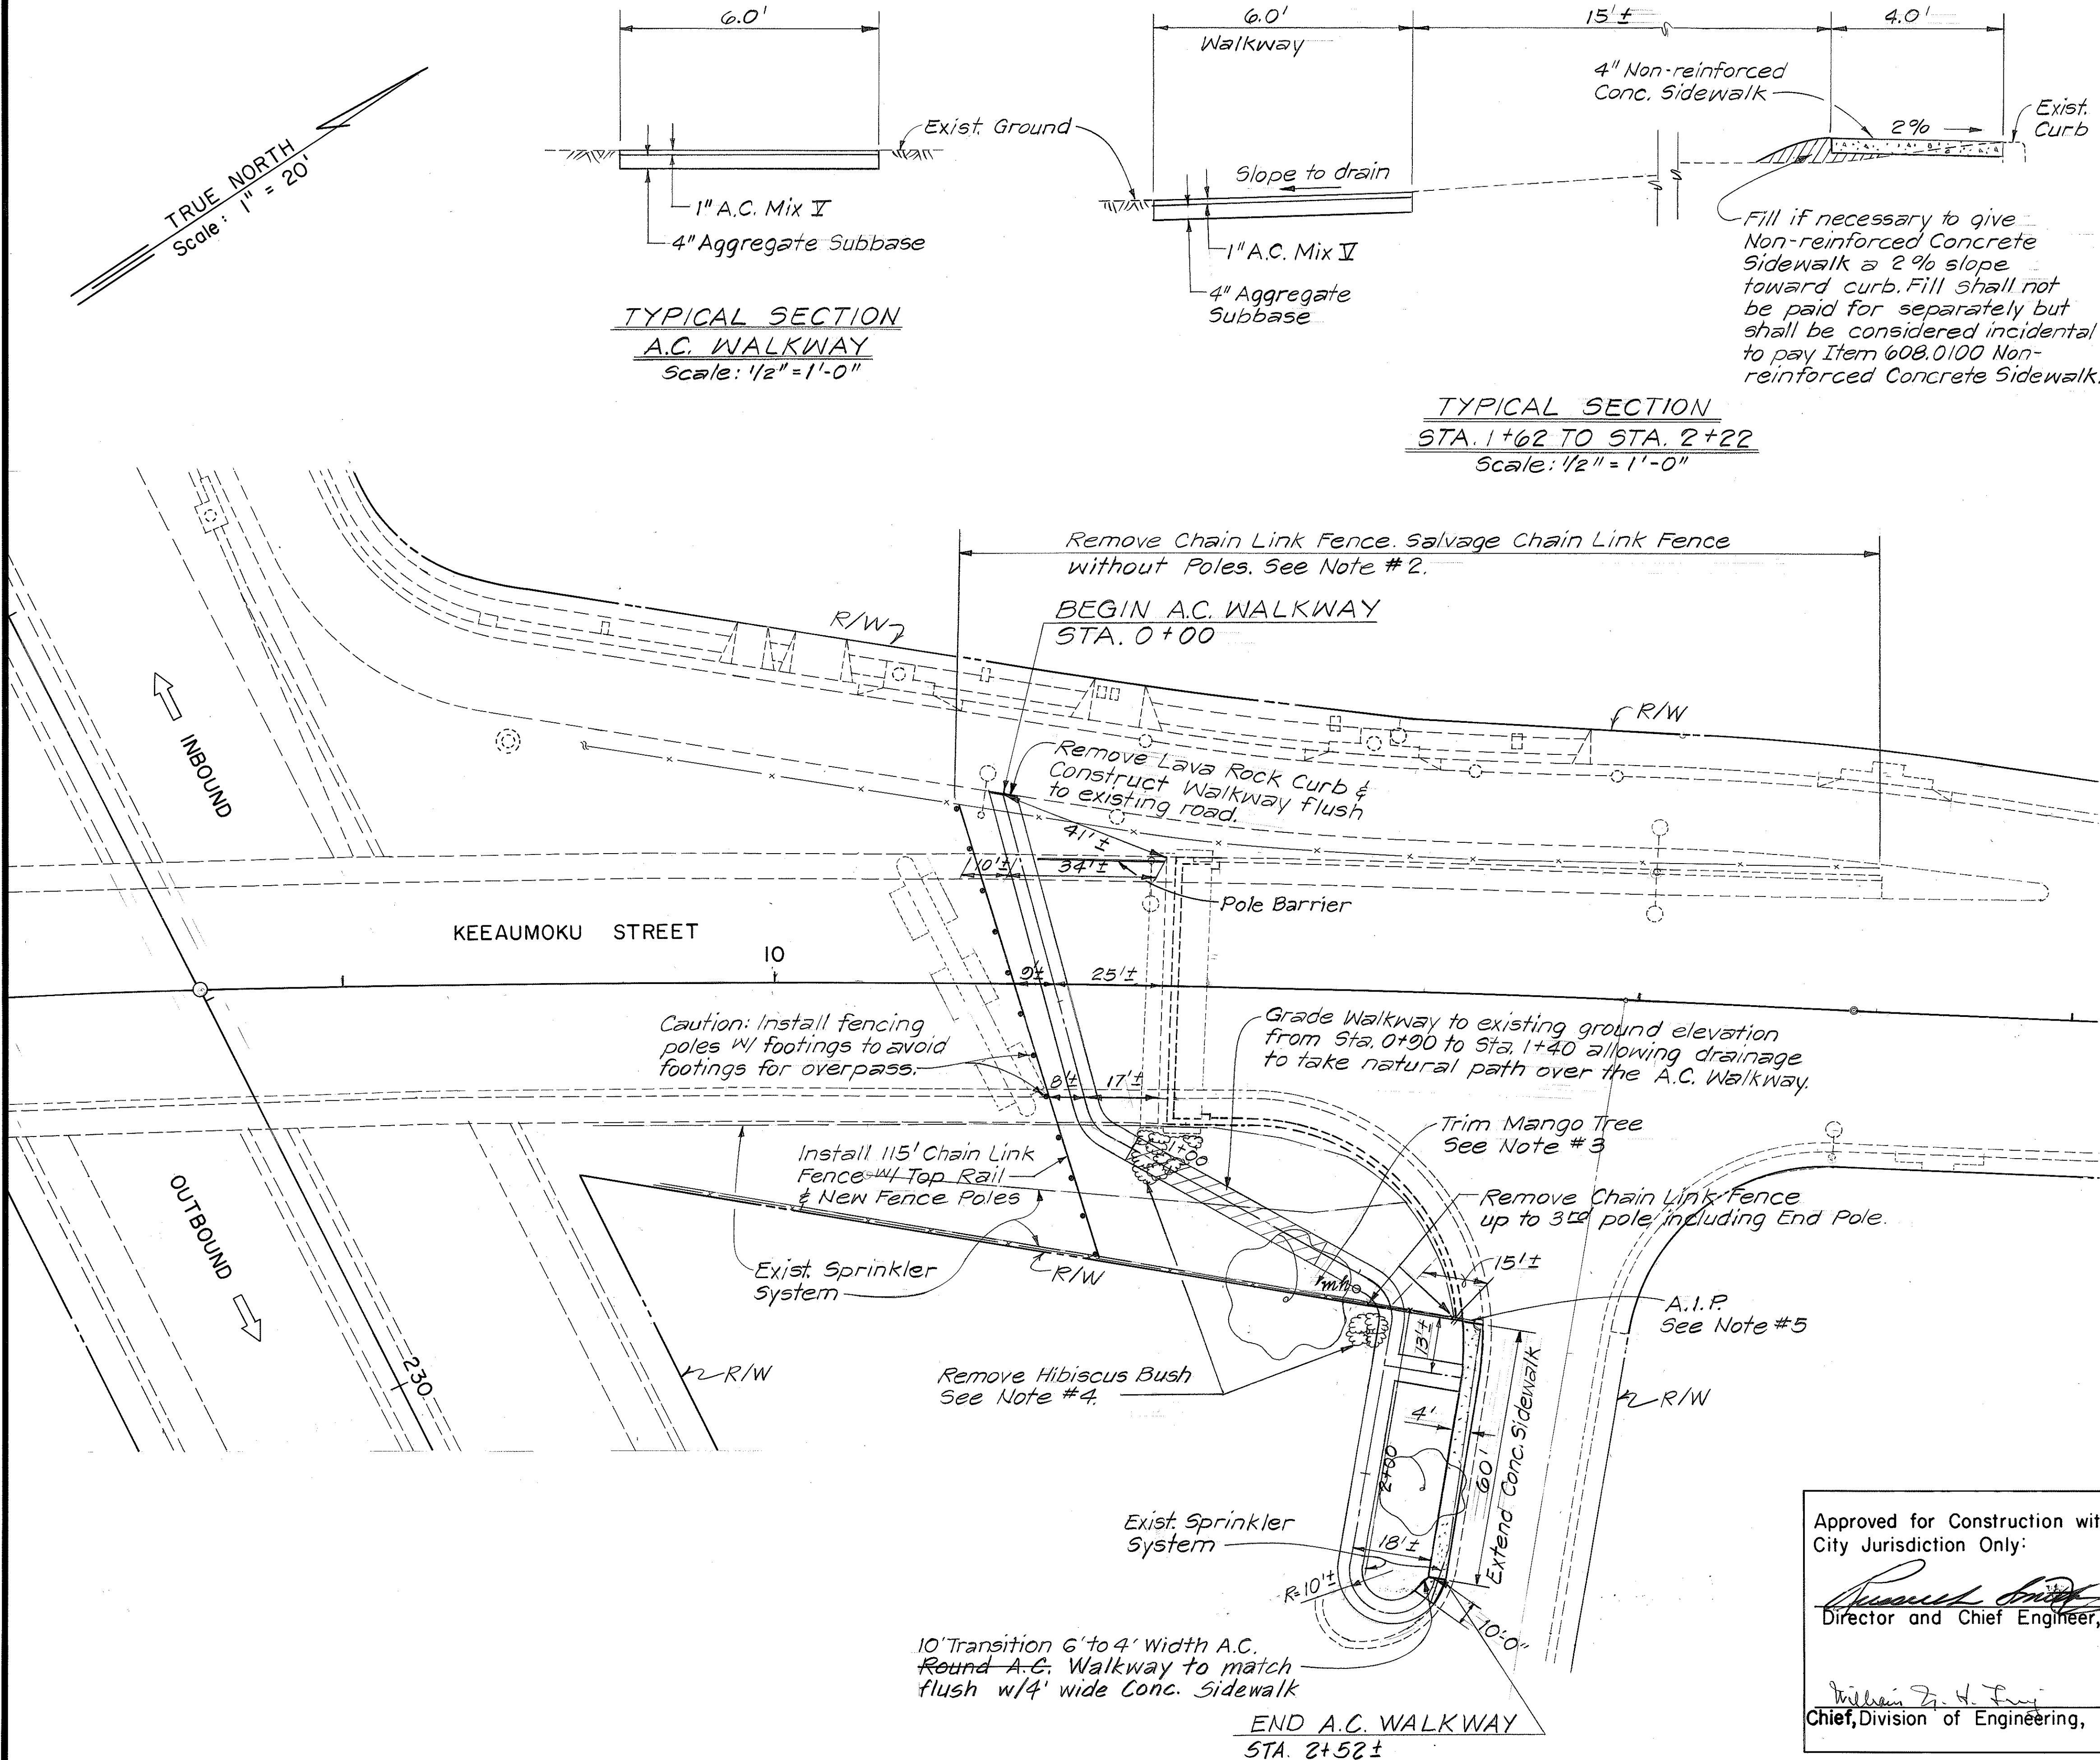

Approved for Construction within
City Jurisdiction Only:

[Signature]
Director and Chief Engineer, DPW

[Signature]
Chief, Division of Engineering, DPW

4/4/85
Date

4/1/85
Date

STATE OF HAWAII
DEPARTMENT OF TRANSPORTATION
HIGHWAYS DIVISION

WALKWAY PLAN
KEEAUMOKU OVERPASS
Walkway Under Mauka Side
PROJECT NO. HII-02-85

Scale: As Noted Date: Jan. 1985
SHEET No. 01 OF 2 SHEETS