
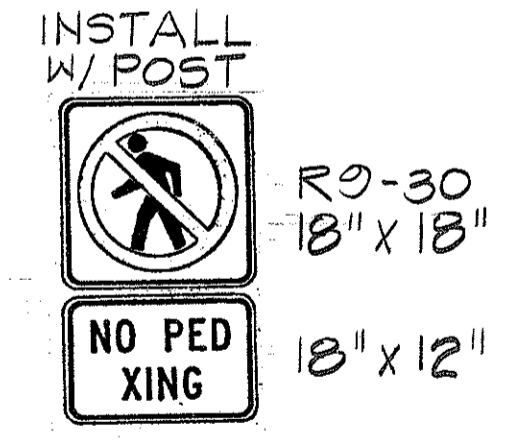
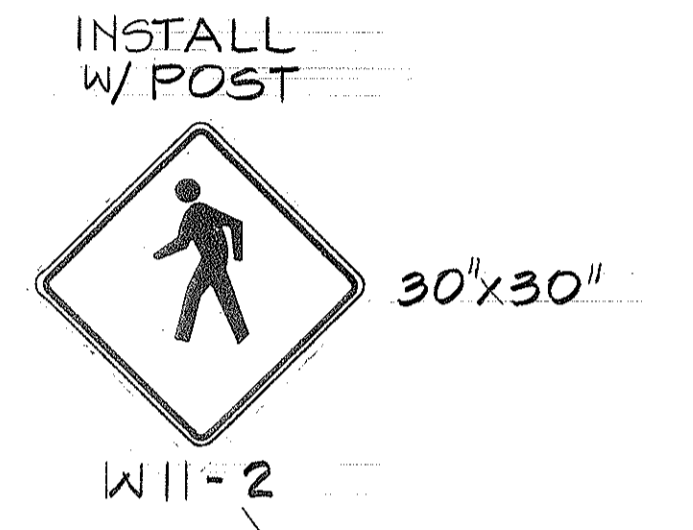
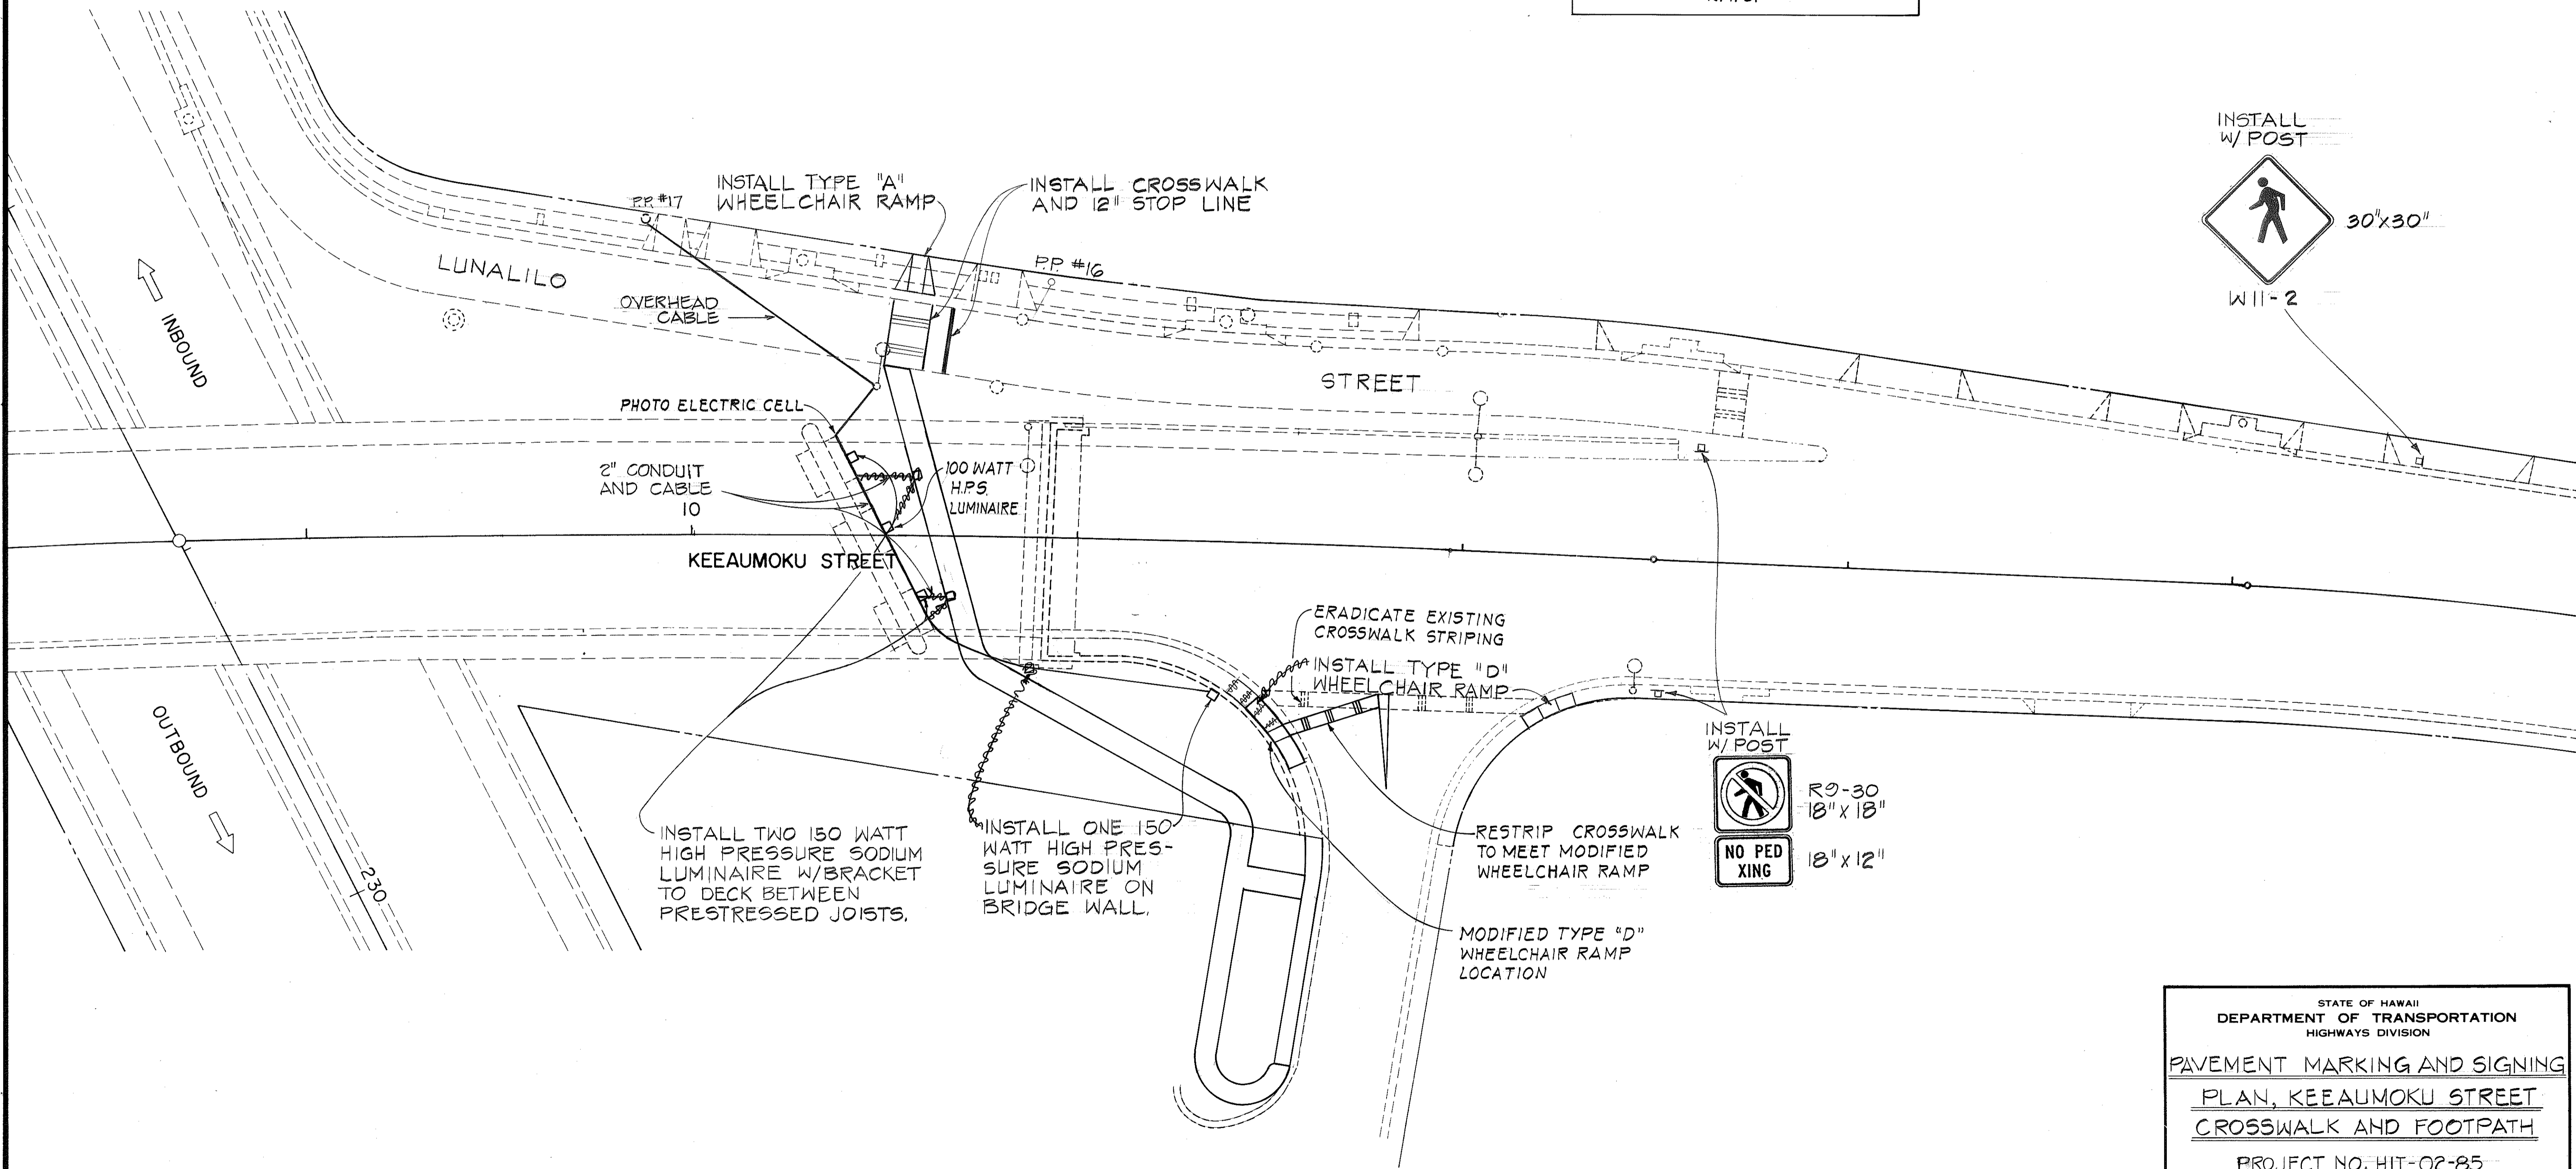


FED. ROAD DIST. NO.	STATE	FED. AID PROJ. NO.	FISCAL YEAR	SHEET NO.	TOTAL SHEETS
HAWAII	HAW.	HII-02-85	1985	4	15

TRUE NORTH
Scale: 1" = 20'

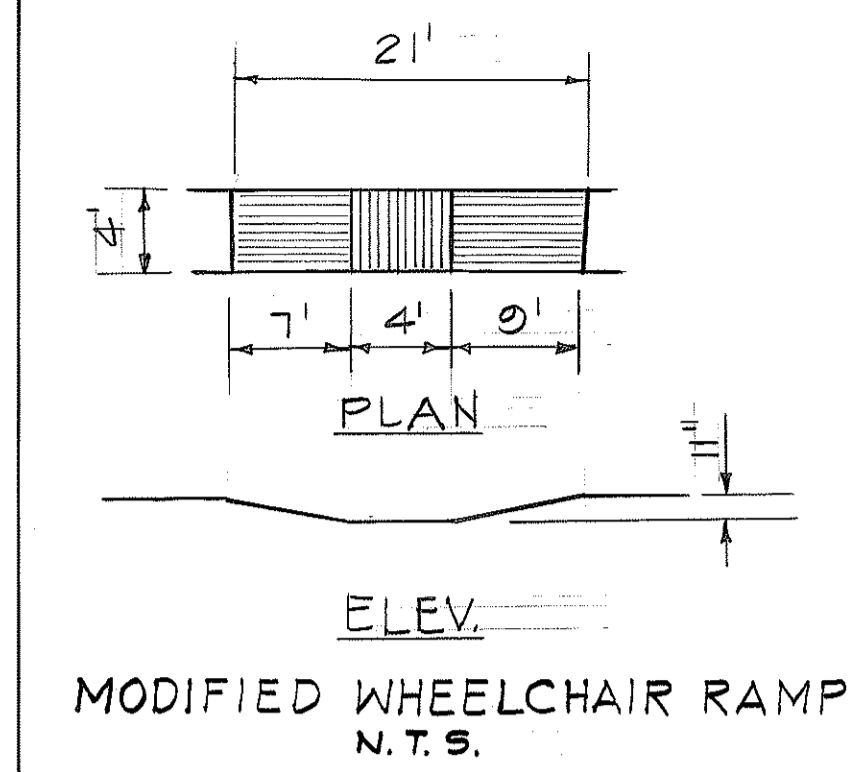

DATE	_____
SURVEY PLOTTED BY	_____
DRAWN BY	_____
DESIGNED BY	_____
CHECKED BY	_____
NOTE BOOK	_____
NO.	_____

STATE OF HAWAII
DEPARTMENT OF TRANSPORTATION
HIGHWAYS DIVISION
PAVEMENT MARKING AND SIGNING
PLAN, KEEAUMOKU STREET
CROSSWALK AND FOOTPATH
PROJECT NO. HII-02-85
SCALE: 1" = 20' DATE: FEB. 1985
SHEET No. 71 OF 12 SHEETS