	INDEX TO DRAWINGS
SHEET NO.	DESCRIPTION
i	TITLE SHEET
2	GENERAL NOTES & WALKWAY
	PLAN WITH TYPICAL SECTIONS
3	STANDARD DETAILS - CHAIN
	LINK FENCE
4	PAVEMENT MARKING AND
	SIGNING PLAN
5	UNDERPASS LIGHTING DETAILS
6-7	TYPICAL DETAILS OF WHEEL
	CHAIR RAMPS
8-15	STANDARD DETAILS
	•



STATE OF HAWAII



DEPARTMENT OF TRANSPORTATION


HIGHWAYS DIVISION HONOLULU, HAWAII

> "AS-BUILT" PLANS FOR

CONSTRUCTION OF

KEEAUMOKU OVERPASS WALKWAY UNDER MAUKA SIDE PROJECT NO. HII-02-85

> DISTRICT OF HONOLULU ISLAND OF OAHU

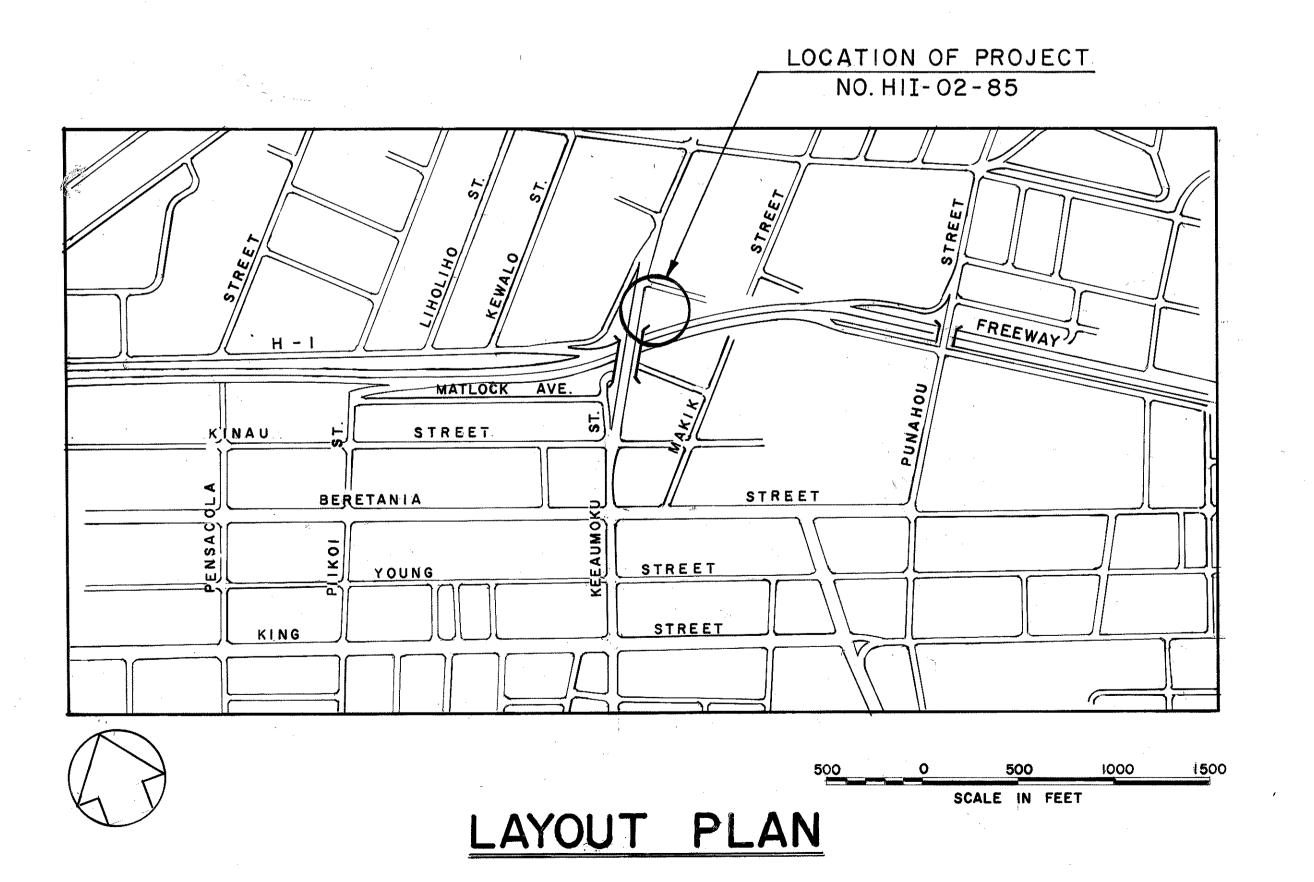

HII-02-85 STATE OF HAWAII LOCATION OF PROJECT NO. HII-02-85

FED. ROAD DIST. NO.

FISCAL YEAR

SHEET TOTAL NO. SHEETS

CHANGES MADE DURING CONSTRUCTION HAVE BEEN NOTED ON THESE PLANS AND CHECKED BY:

RESIDENT ENGINEER

///8/86 DATE

DEPARTMENT OF TRANSPORTATION STATE OF HAWAII APPROVED: 4/1/85