
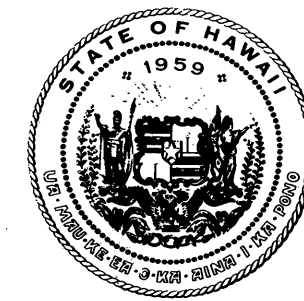


[illegible]

STATE OF HAWAII

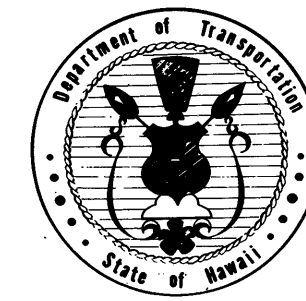

DEPARTMENT OF TRANSPORTATION
HIGHWAYS DIVISION

"AS-BUILT" PLANS FOR


INTERSTATE ROUTE H-1 REFURBISH DESTINATION SIGNS

PALAILAI I.C. TO WAIAU I.C.

F. A. I. PROJECT NO. IR-HI-1(199)

DISTRICT OF EWA
ISLAND OF OAHU

FED. ROAD DIST. NO.	STATE	FED. AID PROJ. NO.	FISCAL YEAR	SHEET NO.	TOTAL SHEETS
HAWAII	HAW.	IR-HI-1 (199)	1985	1	5

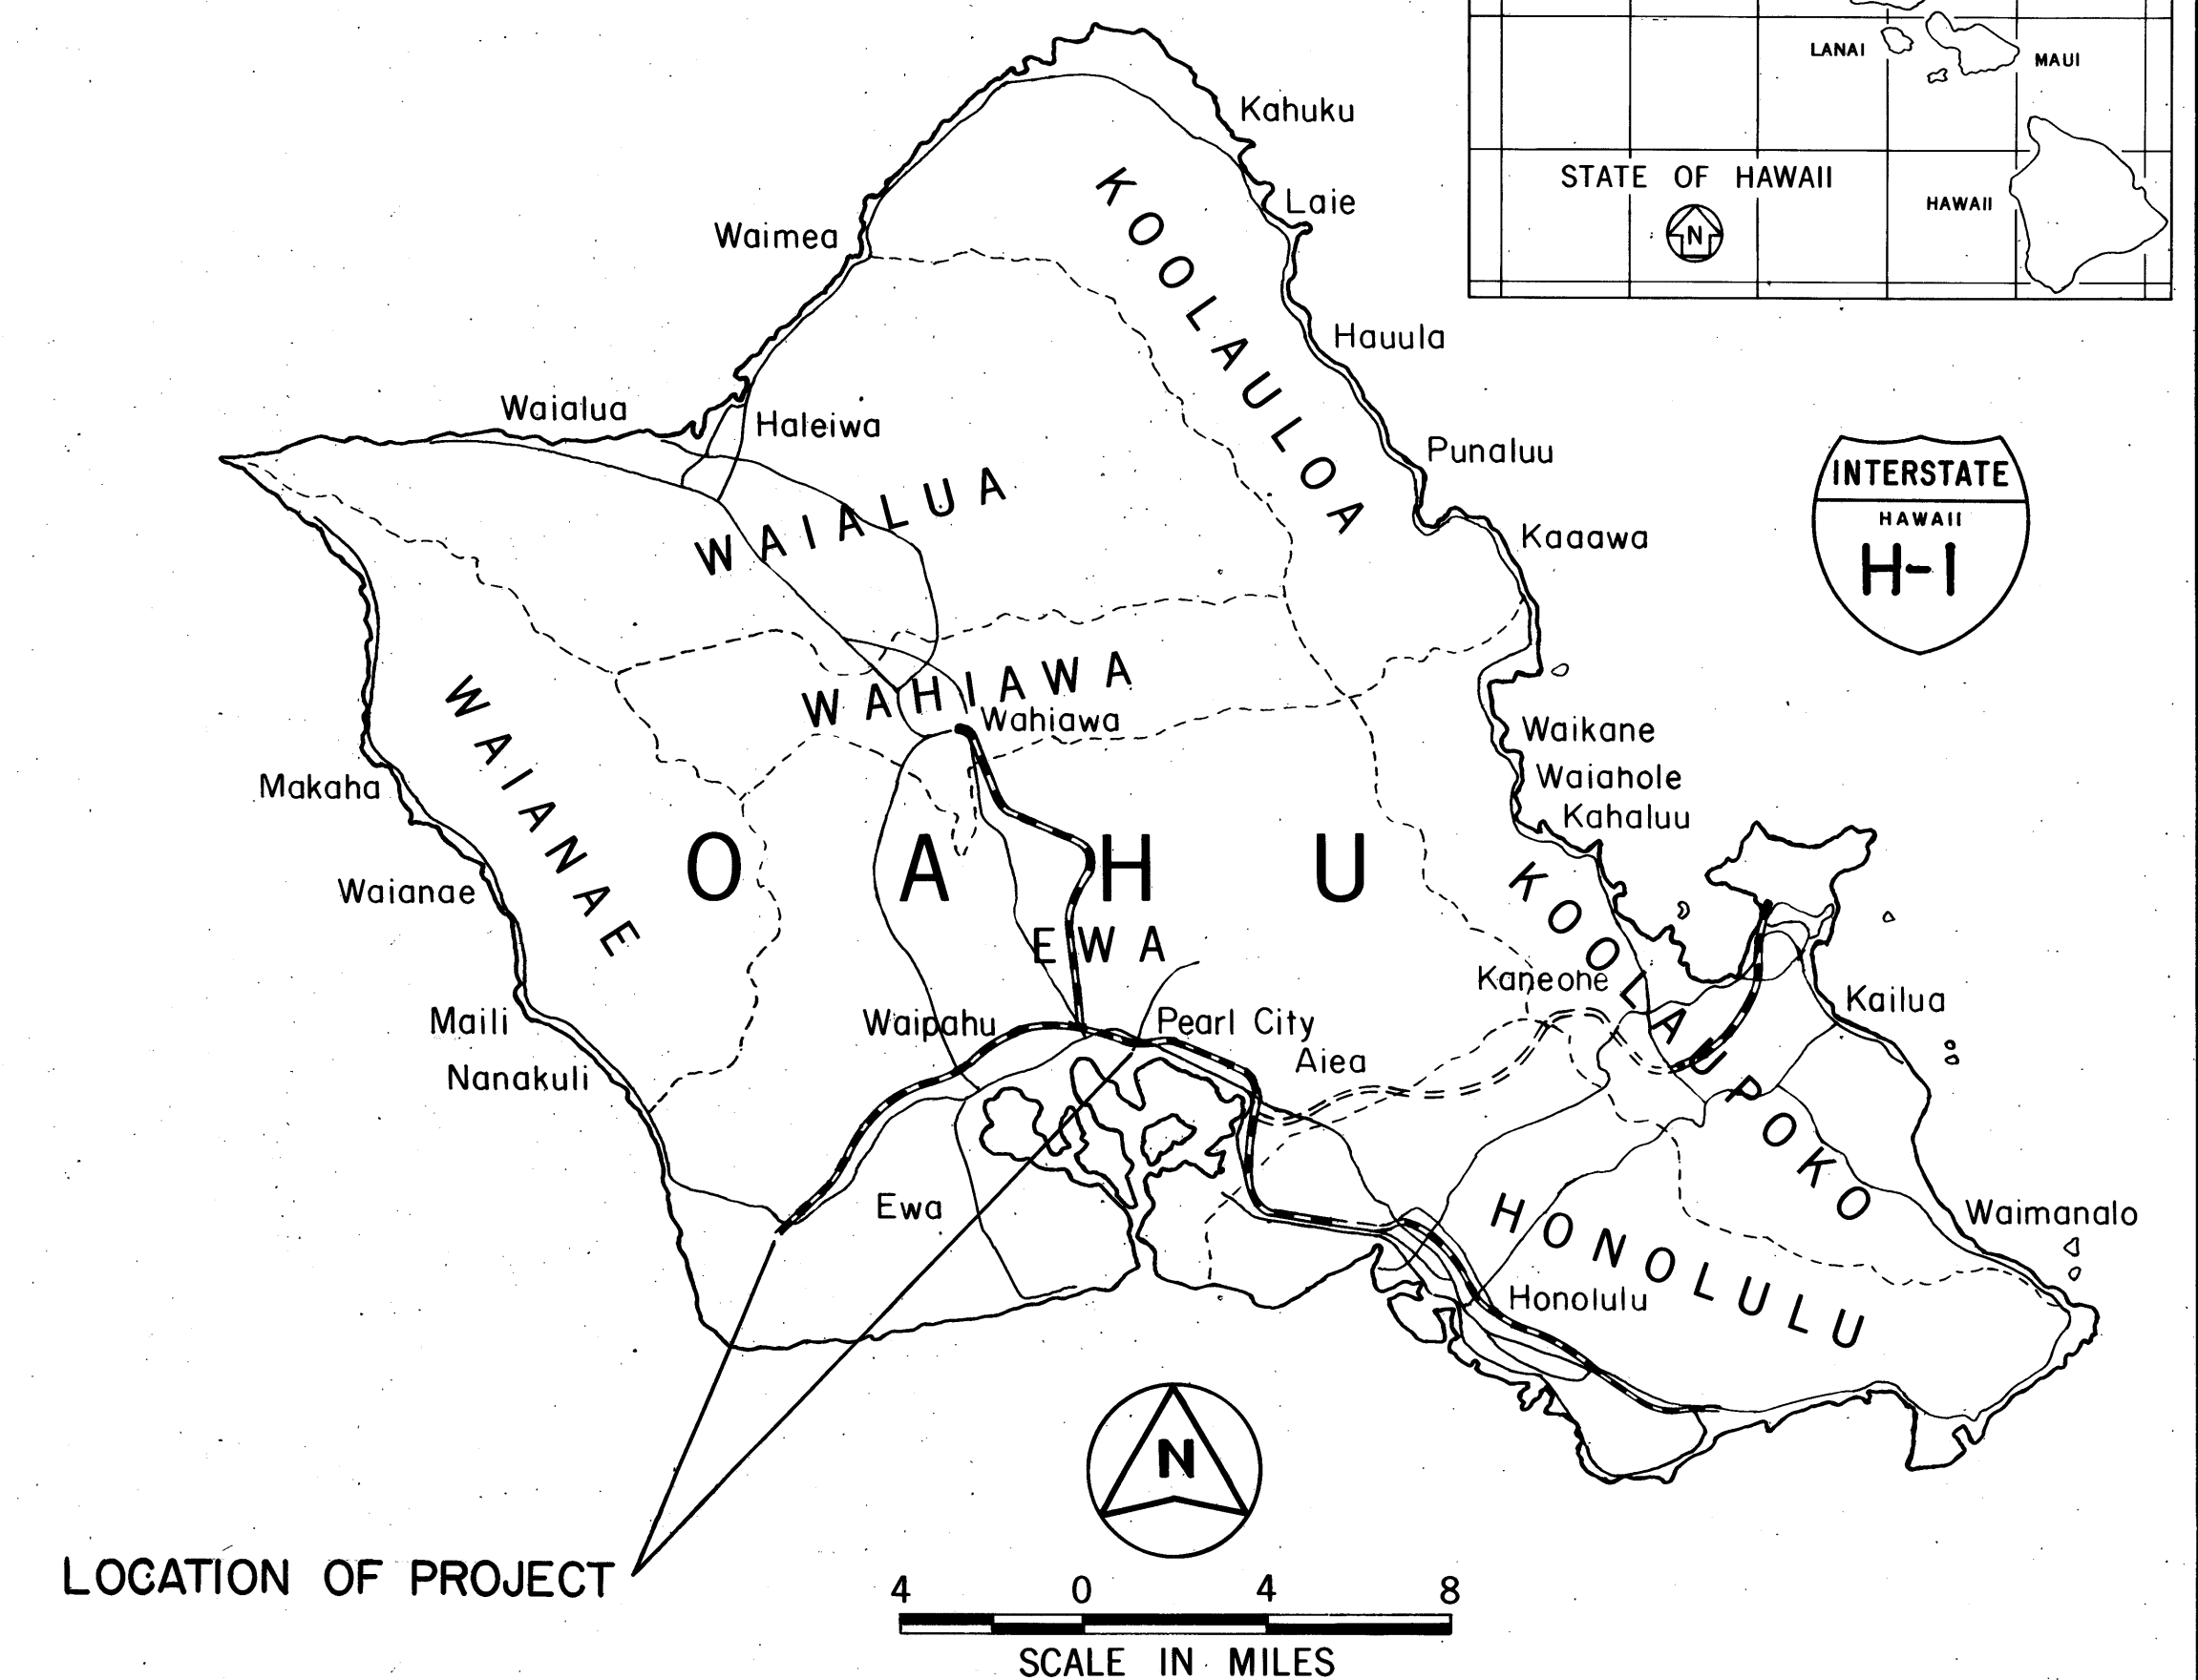

FEDERAL AID INTERSTATE PROJECTS PREVIOUSLY CONSTRUCTED
OR UNDER CONSTRUCTION

NO SIGNIFICANT CHANGES WERE MADE DURING CONSTRUCTION ON THESE PLANS EXCEPT CHANGES IN THE ORIGINAL THEORETICAL QUANTITIES. FOR ACTUAL QUANTITIES, REFER TO PROJECT LEDGER AND/OR COMPUTATION BOOK.

David Zamashero
RESIDENT ENGINEER

11/21/86
DATE

DEPARTMENT OF TRANSPORTATION
FEDERAL HIGHWAY ADMINISTRATION
APPROVED: W. Arthur 5/22/88
DIVISION ADMINISTRATOR DATE

DEPARTMENT OF TRANSPORTATION STATE OF HAWAII	
APPROVED:	
<i>Cheryl D. Boone</i> <u>for</u> DIR. OF TRANSPORTATION	<u>5/15/95</u> DATE

HWY-T
DESIGNED BY
A. NISHIMURA
P. S. & E. BY
548-7490
PHONE
MAY, 1985
DATE